



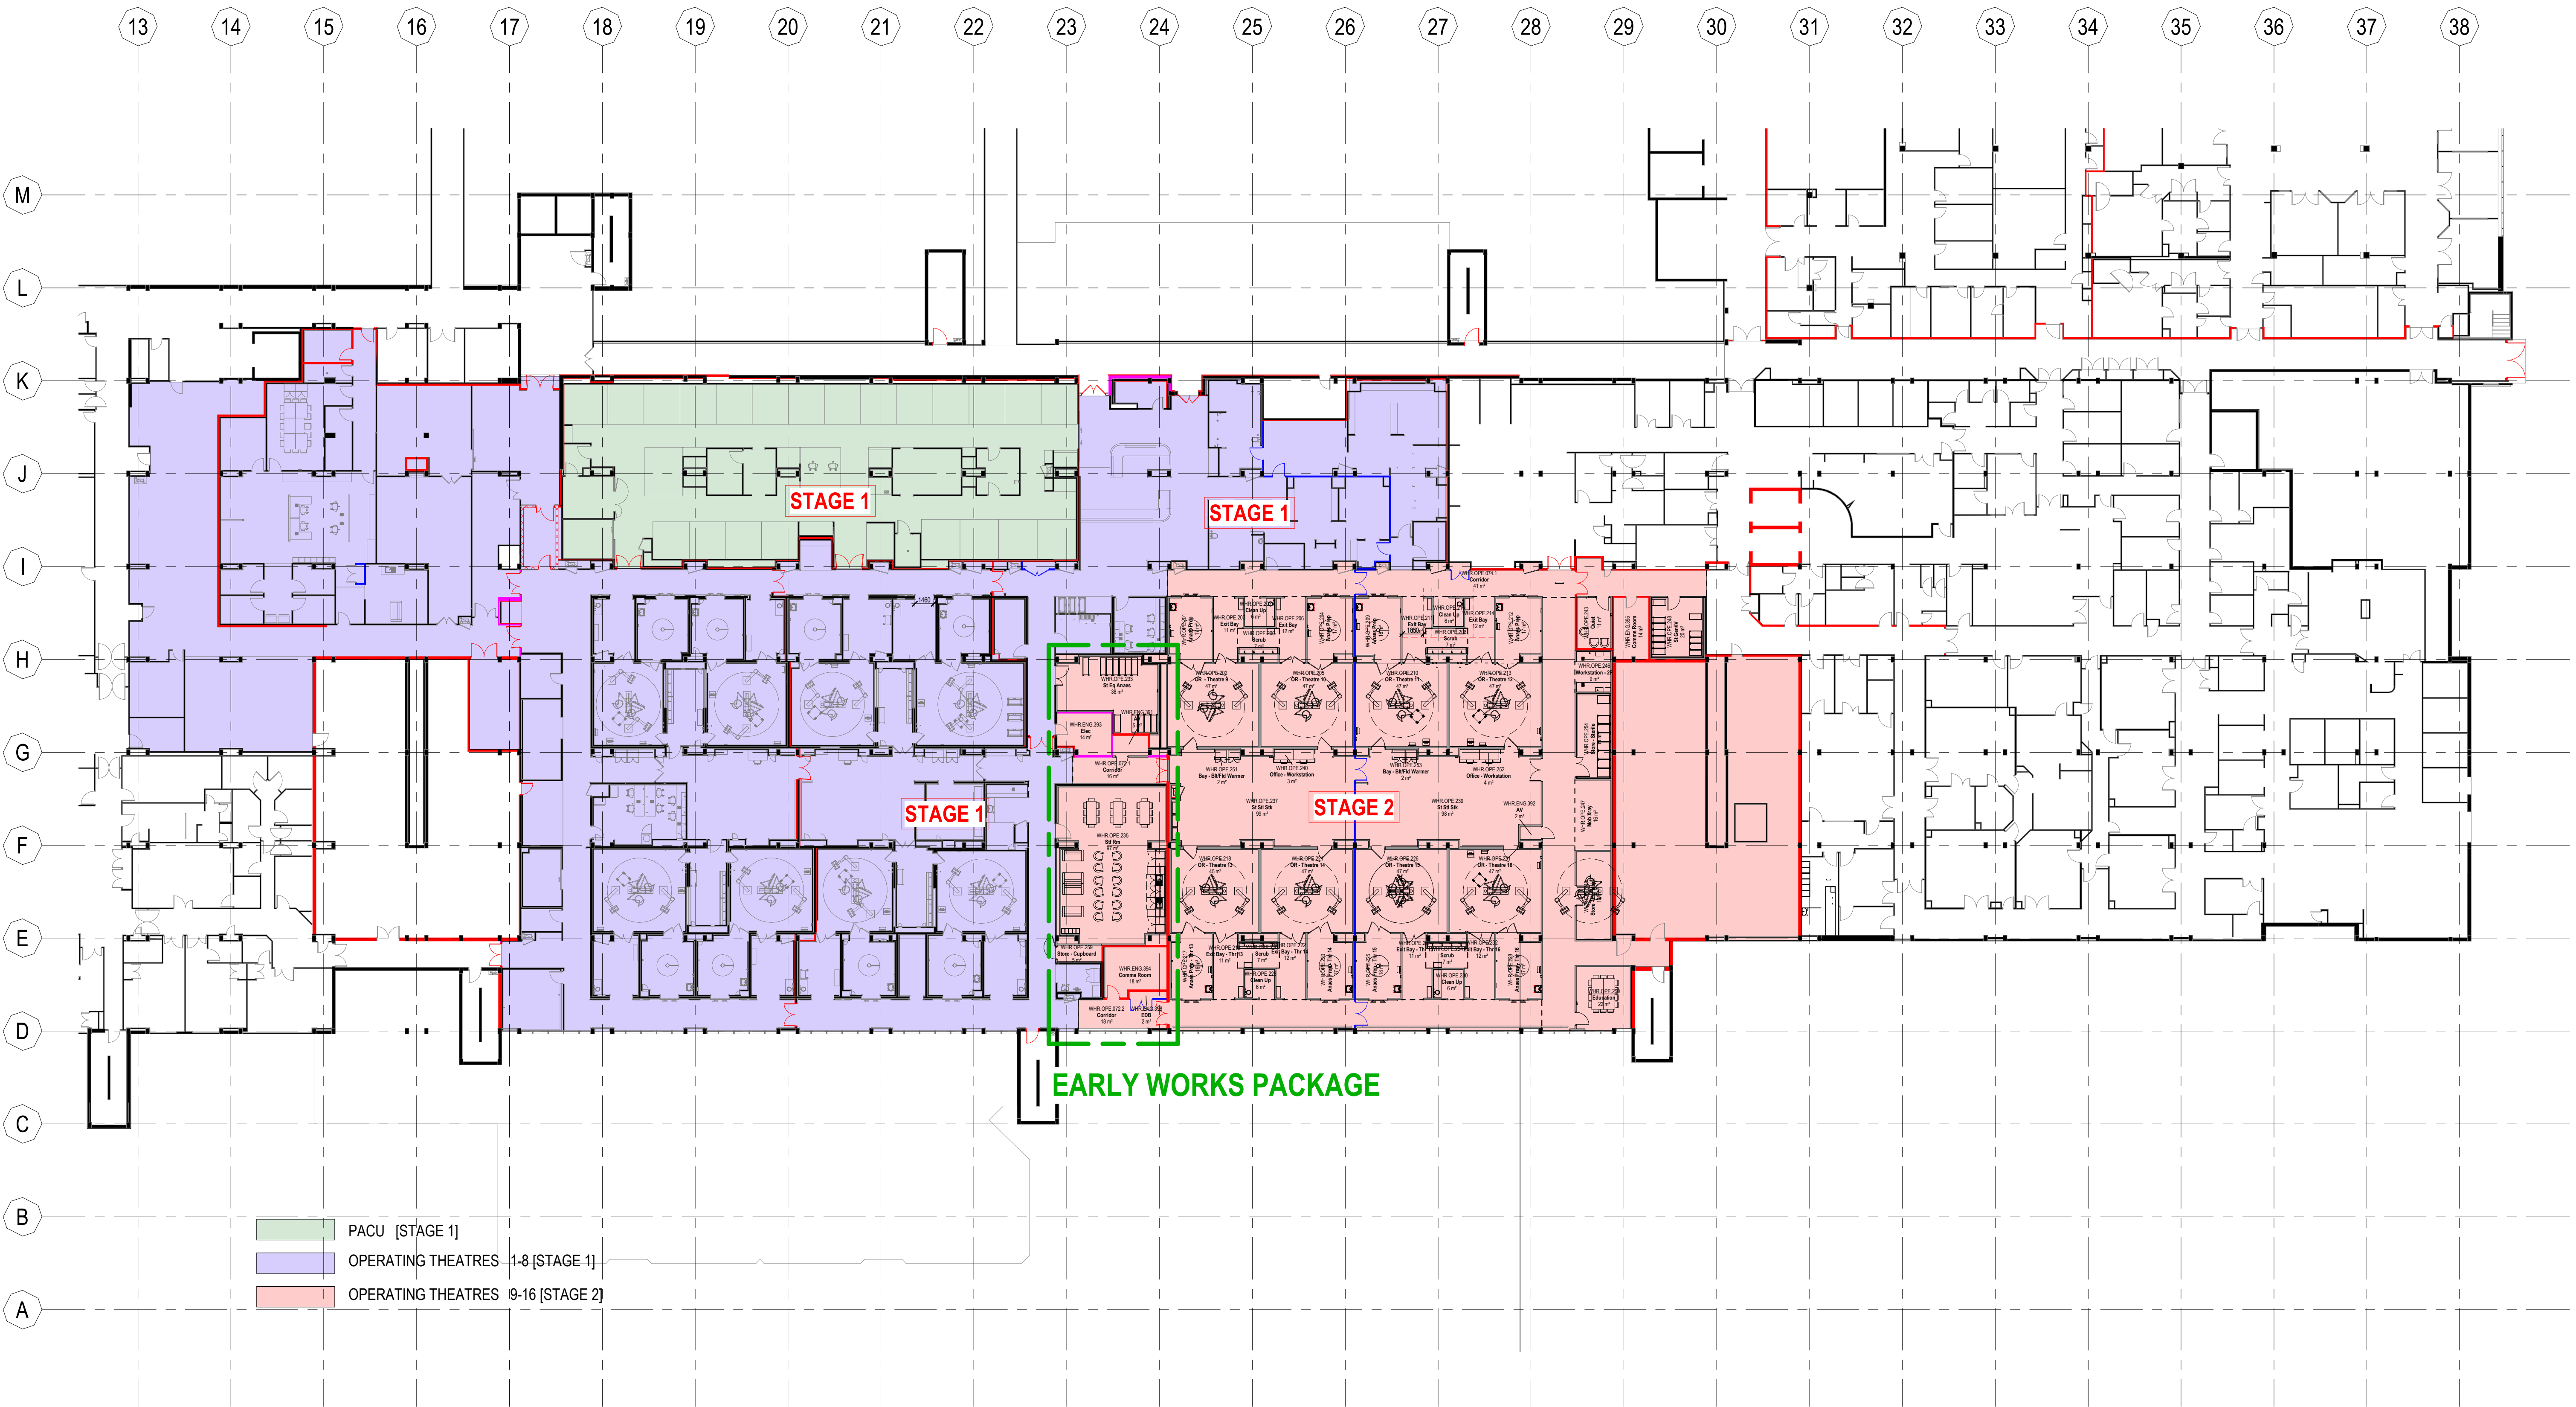

- PACU [STAGE 1]
- OPERATING THEATRES 1-8 [STAGE 1]
- OPERATING THEATRES 9-16 [STAGE 2]


24/03/2023 4:12:29 PM BIM 360://10324179_Westmead_Refurbishment_Variations_2019/WMH-HDR-AR-EM-WM_OT9-16.nvt

0 250 1000 2000
1:50mm

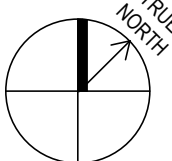

REV	DATE	DESCRIPTION	DWN	CHK
1	13/02/23	PRELIMINARY ISSUE	RH	RS
2	15/03/23	ISSUED FOR COORDINATION AND REVIEW OF EARLY WORKS ONLY	RH	DJM
3	24/03/23	ISSUED FOR EARLY WORKS PACKAGE DD	RH	DJM

KEY PLAN:

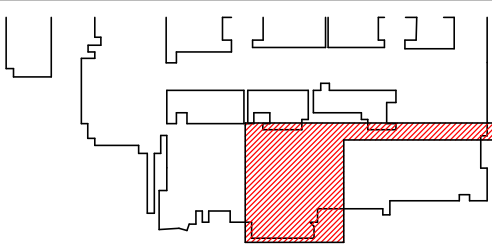

PROJECT:
WMH-HDR-AR-EM-MS1_2_3

DRAWING TITLE:
GENERAL ARRANGEMENT - LEVEL 3 - THEATRE 9-16

PROJECT NUMBER:
10324179

DRAWING NUMBER:
OAD-WHR-HDR-AR-DG-820303

STATUS:
FOR INFORMATION

REVISION:
3

SCALE:
1 : 250 @ A1

CLIENT:
Level 14, 77 Pacific Highway
North Sydney NSW 2060



Health
Infrastructure

PROJECT MANAGER:
One International Towers
Barangaroo NSW 2000




MAIN CONTRACTOR:
Level 4, 174 Pacific Highway,
St Leonards NSW 2065



ARCHITECT:



Level 24, 25 Martin Place - Sydney NSW 2000
+61299562666 | hdrinc.com
HDR Pty. Limited ABN 76 158 075 220 trading as HDR

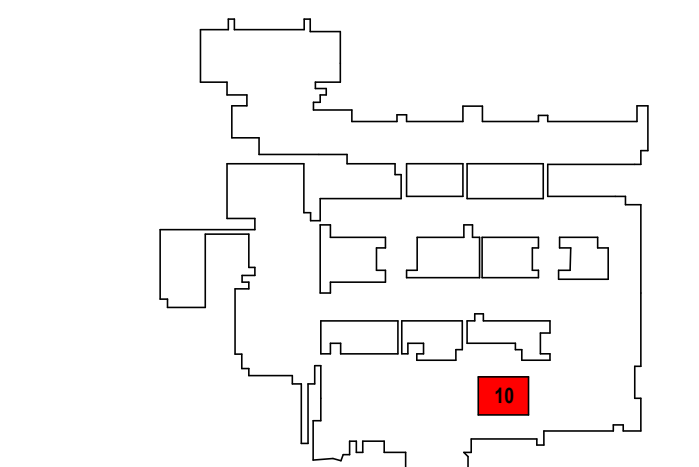

Westmead Redevelopment
Building health. Transforming lives.

תכנית



OUT OF REFURBISHMENT SCOPE

[illegible]


Project Status
PRELIMINARY-FOR INFORMATION

THIS DOCUMENT IS THE COPYRIGHT OF HDR.
ALL INFORMATION ILLUSTRATED ON THIS DOCUMENT IS TO BE CHECKED AND VERIFIED ON SITE. IN THE
EVENT OF DISCREPANCIES REFER TO ARCHITECT PRIOR TO COMMENCEMENT OF THE WORK. DO NOT
SCALE DRAWINGS MANUALLY OR ELECTRONICALLY.

ALL CEILING MOUNTED SERVICES AS SHOWN ON THIS
DRAWING ARE DOCUMENTED BY RENASCENT
SUBCONTRACTORS

BIM 360://10324179 Westmead Refurbishment Variations 2019/MMH-HDB-AB-FM-WM QT9-16.rvt

24/03/2023 4:10:42 PM

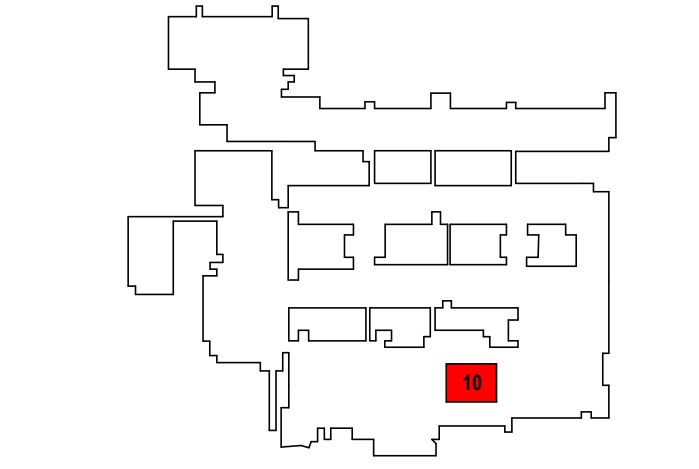

A horizontal scale bar with four vertical tick marks. Below the first two tick marks is the label "1:0mm".

PROJECT MANAGER:
One International Towers Sydney
Barangaroo NSW 2000
P: (02) 8266 0000
www.pwc.com.au

EARLY WORKS PACKAGE

WESTMEAD HOSPITAL
WMH-HDR-AR-EM-MS1_2_3
Hawkesbury Rd, Westmead, NSW, 2145


Scale
1 : 50@ A1

Sheet Number
OAD-WHR-HDR-AR-DG-300310

Revision
4

Project Status
PRELIMINARY-FOR INFORMATION

THIS DOCUMENT IS THE COPYRIGHT OF HDR.
ALL INFORMATION ILLUSTRATED ON THIS DOCUMENT IS TO BE CHECKED AND VERIFIED ON SITE. IN THE
EVENT OF DISCREPANCIES REFER TO ARCHITECT PRIOR TO COMMENCEMENT OF THE WORK. DO NOT
SCALE DRAWINGS MANUALLY OR ELECTRONICALLY.

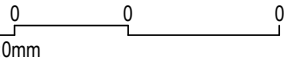

Level 24, 25 Martin Place - Sydney NSW 2000
+61299562666 | hdrinc.com
HDR Pty. Limited ABN 76 158 075 220 trading as HDR



LEGEND

- EXISTING WALLS, COLUMNS AND DOORS - ASSUMED**
(not surveyed all dimensions and wall heights to be checked on site)
- OUT OF REFURBISHMENT SCOPE**
- OPAQUE WHITE BLOCK OUT FILM APPLIED TO INTERNAL SIDE OF GLAZING WHERE EXTERNAL WINDOWS HAVE BEEN LINED OVER WITH INTERNAL PARTITIONS.
- PRESSURISED ROOM - ALL IN WALL AND CEILING SERVICE PENETRATION, WALL AND CEILING MOUNTED FRAE FIXTURES, ACCESS PANELS AND DOORS ARE TO BE FULLY SEALED. PARTITIONS THAT ARE NOTED TO BE FULL HEIGHT ARE TO BE FULLY SEAL TO FLOOR AND SOFFIT.

DOORS WITH EXISTING FRAMES TO BE CHECKED ON SITE FOR DDA COMPLIANCE.
WHERE REQUIRED DOOR FRAMES AND LEAVES ARE TO BE UPGRADED TO MEET
DDA REQUIREMENTS AS SETOUT BY ACCESS CONSULTANT REPORT.

GENERAL NOTES:

- TO ADDRESS ANY RISK FROM ASBESTOS ANY TENDERER SHOULD PROVIDE A COMPREHENSIVE RISK ASSESSMENT MANAGEMENT PLAN AND SAFE WORKING METHODOLOGY AS PART OF THEIR OVERALL TENDER SUBMISSION. NEW PAINT TO ALL EXISTING WALLS, DOORS AND FRAMES ON INTERNAL SIDE OF SCOPE BOUNDARY AND WITHIN THE SCOPE OF WORK AREA.

REFER TO:

- 390000 DRAWING SERIES FOR STRUCTURE COMPARTMENT PLANS
480000 FOR CEILING LEGEND COVER SHEET
480000 DRAWING SERIES FOR CEILING DETAILS
650000 DRAWING SERIES FOR WINDOW & DOOR DETAILS
650000 FOR PARTITION LEGEND COVER SHEET
650000 DRAWING SERIES FOR PARTITION DETAILS
680000 DRAWING SERIES FOR KOP DETAILS
9000000 DRAWING SERIES FOR ROOM LAYOUT SHEETS
FINISHES SCHEDULE FOR ALL FINISH DETAILS AND COLOURS

DISCLAIMER:

EXISTING DRAWING IS NOT SURVEYED AND ALL DIMENSIONS ARE GIVEN IN GOOD FAITH TO BE AS ACCURATE AS POSSIBLE.
IF IN DOUBT PLEASE CONSULT THE SITE ENGINEER.
NO RESPONSIBILITY CAN BE TAKEN WITH ANY ERRORS FOUND BY MEASURING OFF THIS DRAWING.

WESTMEAD HOSPITAL
WMH-HDR-AR-EM-MS1_2_3
Hawkesbury Rd, Westmead, NSW, 2145

PROJECT NUMBER
10324179

Sheet Name

PARTITION PLAN - LEVEL 3 -THEATERS





9-16 - ZONE 10

Scale
1 : 50@ A1

Sheet Number **OAD-WHR-HDR-AR-DG-460310** Revision **4**

PRELIMINARY-FOR INFORMATION

THIS DOCUMENT IS THE COPYRIGHT OF HDR.
ALL INFORMATION ILLUSTRATED ON THIS DOCUMENT IS TO BE CHECKED AND VERIFIED ON SITE. IN THE
EVENT OF DISCREPANCIES REFER TO ARCHITECT PRIOR TO COMMENCEMENT OF THE WORK. DO NOT
SCALE DRAWINGS MANUALLY OR ELECTRONICALLY.

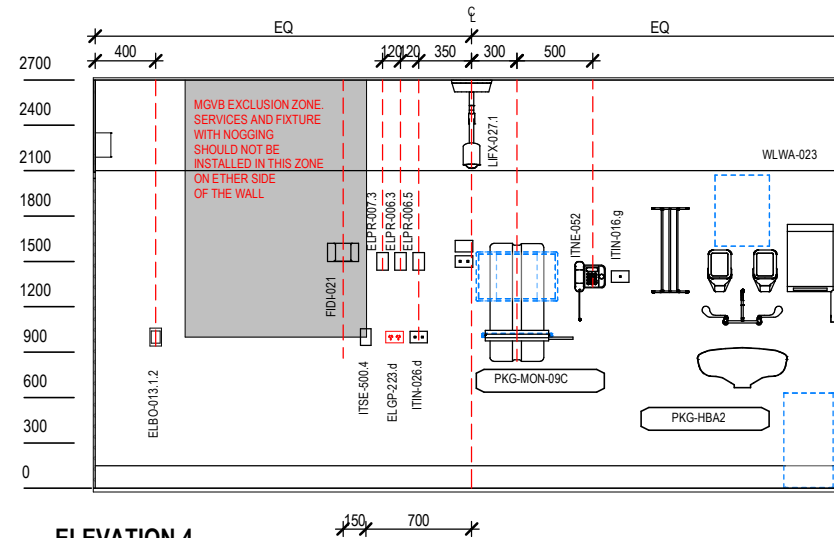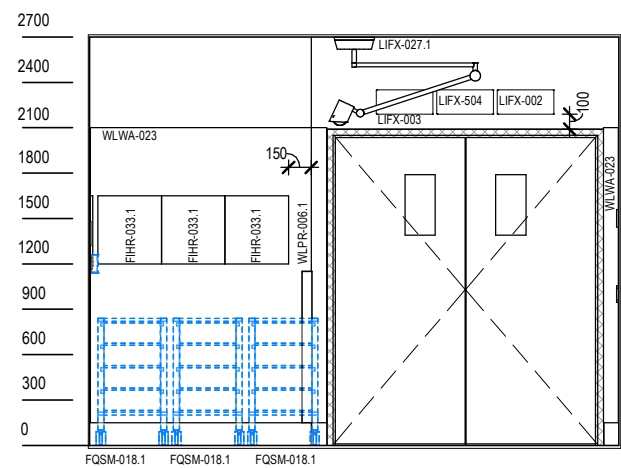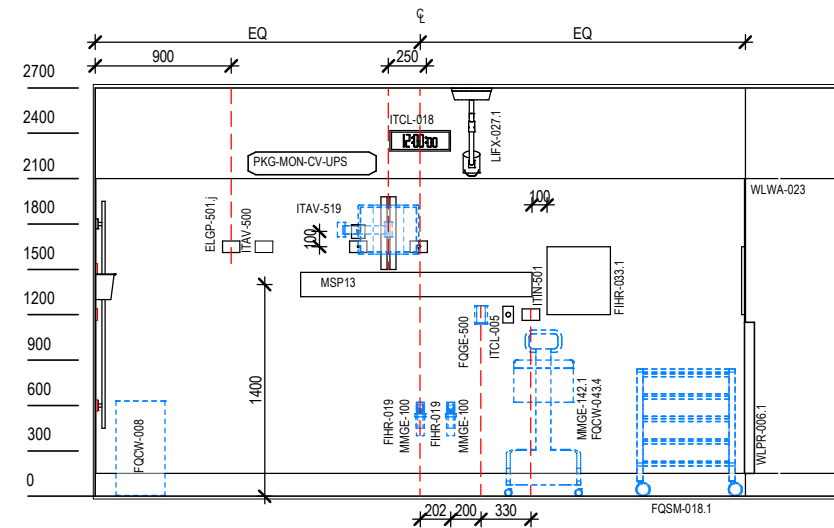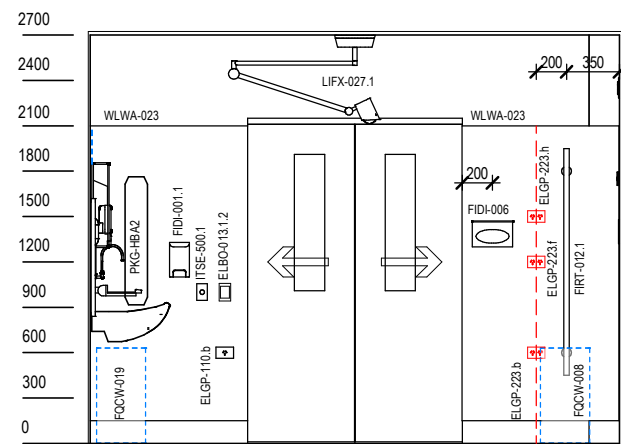

ROOM EQUIPMENT - WHR.OPE.204 - Anaesthetic Preparation Room	
Designation	Description
EL - Electrical Services	
ELBO-013.1.2	SWITCH: light, control panel, 4 button
ELGP-110.b	GPO: single, wall mounted, cleaner, 600AFFL
ELGP-223.b	GPO: essential power, double, wall mounted, 600AFFL
ELGP-223.d	GPO: emergency power, double, wall mounted, 1000AFFL
ELGP-223.f	GPO: emergency power, double, wall mounted, 1200AFFL
ELGP-223.h	GPO: emergency power, double, wall mounted, 1500AFFL
ELGP-501.j	GPO: double, UPS, wall mounted, 1650AFFL
ELPR-006.3	RCD: residual current device, UPS
ELPR-006.5	RCD: residual current device, essential
ELPR-007.3	UPS: status indicator, on wall
FI - Fixtures & Fittings	
FIDI-001.1	DISPENSER: alcohol based hand rub (ABHR)
FIDI-006	DISPENSER: cleaning wipes
FIDI-021	DISPENSER: mask
FIHR-019	BRACKET: for suction bottle
FIHR-033.1	PANEL: for storage bins, wire baskets, 420Wx450H
FIRT-012.1	RAIL: equipment, vertical, 1500 long

ROOM EQUIPMENT - WHR.OPE.204 - Anaesthetic Preparation Room	
Designation	Description
FQ - Furniture & Non-Medical Equipment	
FQCW-008	BIN: waste, clinical, 50L
FQCW-043.4	BIN: waste, sharps, mobile, 6.5L
FQGE-500	HOLDER: patient handset, caddy
FQSM-018.1	TROLLEY: basket 4 wire 650W x 455D x 840H
ITNE-052	TELEPHONE: handset, wall mount
IT - Information & Communication Services	
ITAV-500	AV: outlet, brush plate, wall mounted
ITAV-519	ADAPTER: DVI Input Adapter, OR, ITC
ITCL-005	BUTTON: OP assist call
ITIN-016.g	OUTLET: data, single RJ45, wall mounted, 1400AFFL
ITIN-026.d	OUTLET: data, double RJ45, wall mounted, 1000AFFL
ITIN-501	EARTH TEST POINT (ETP)
ITSE-500.1	DOOR RELEASE: access control, push to exit
ITSE-500.4	DOOR RELEASE: access control, 2 gang switch
LI - Lighting Systems	
LIFX-027.1	LIGHT: examination, ceiling mounted, type G
MM - Medical & Laboratory Equipment	
MMGE-100	SUCTION BOTTLE
MMGE-142.1	TROLLEY: sharps bin
PKG - Packages	

ROOM EQUIPMENT - WHR.OPE.204 - Anaesthetic Preparation Room	
Designation	Description
MSP13	SERVICES PANEL: wall mounted 13
PKG-HBA2	
FIDI-014.2	DISPENSER: disposable glove, quad
FIDI-025.1	DISPENSER: paper/hand towel, patient / public
FIDI-030	DISPENSER: soap
FIDI-031	DISPENSER: soap antiseptic
FIGE-500.1	SIGNAGE: handwash instruction
FQCW-019	BIN: waste, general, 50L
HYBA-009	BASIN: handwash, Type A, scrub
HYTP-037.1	TAPWARE: mixer, elbow, wall mounted
PKG-MON-09C	
ELGP-501	GPO: double, UPS, wall mounted, instance height
FIHR-512	BRACKET: Computer wall mount: Style View Vertical Lift
FIHR-513	BRACKET: Keyboard: Vertical Lift Auto-Retracting
ITIN-026.14	OUTLET: data, double RJ45, wall mounted, instance height
ITNE-504	MONITOR & KEYBOARD: OPE
PKG-MON-CV-UPS	

ROOM EQUIPMENT - WHR.OPE.204 - Anaesthetic Preparation Room	
Designation	Description
ELGP-135.j	GPO: UPS, single, wall mounted, 1650AFFL
FIHR-012.1	BRACKET: for monitor, cardiac, wall mounted
ITIN-016.j	OUTLET: data, single RJ45, wall mounted, 1650AFFL
MMHA-008.1	MONITOR: patient, cardiac with vital signs, wall mounted
WL - Walls & Wall Finishes	
WLPR-006.1	WALL PROTECTION: corner guards 1000H 90 degree, 1150mm AFFL to top of corner guards, prefinished PVC
WLWA-023	WALL FINISH: vinyl. to 2100 AFFL

[illegible]

CLIENT: P: (02) 9978 5427 F: (02) 8994 1217 www.health.health.nsw.gov.au Level 14, 77 Pacific Highway North Sydney NSW 2060  Health Infrastructure	ARCHITECT: Level 24, 25 Martin Place Sydney NSW 2000 Australia
PROJECT MANAGER: One International Towers Sydney Watermans Quay Barragans NSW 2000 P: (02) 8268 8000 F: (02) 8268 9999 www.pwc.com.au 	P: (02) 9956 2666 www.befinc.com HCN Pty. Limited ASN 78 158 075 20 


 PROJECT: Westmead Redevelopment Building health. Transforming lives. WMH-HDR-AR-EM-MS1_2_3 Hawkesbury Rd, Westmead, NSW, 2145	DRAWING NUMBER: OAD-WHR-HDR- DRAWING TITLE: WHR.OPE.204 - SHEET 2 OF 2
	PROJECT: Westmead Redevelopment Building health. Transforming lives. WMH-HDR-AR-EM-MS1_2_3 Hawkesbury Rd, Westmead, NSW, 2145

90PE204-2 etic Preparation Room -	PROJECT NUMBER: 10324179 STATUS: DESIGN DEVELOPMENT
---	---



ROOM EQUIPMENT-- WHR.OPE.205 - Operating Room - Theatre 10	
drofus_item_BIM_ID	drofus_item_name
MMGE-048	LINEN CARRIER: dirty, single
MMGE-087.1	SAFE: dangerous drugs, medium, 457W x 230D x 610H Right Hand
MMGE-122	TROLLEY: gowns, double
MMGE-123.3	TROLLEY: instrument, 500W x 500D x 900H
MMGE-142.1	TROLLEY: sharps bin
MMGE-164.2	WORKSTATION ON WHEELS: clinical, anaesthetic
MMGE-164.3	WORKSTATION ON WHEELS: clinical, nurse scout
MMGE-512	TROLLEY: clinical waste bin bag, mobile
MMGE-513	TROLLEY: general waste bin bag, mobile
MMMI-198	MACHINE: anaesthetic
MMOP-043	MACHINE: electrosurgical, diathermy
MMOP-068	STAND: bowl, double
MMOP-069	STAND: bowl, single
MMOP-071	STOOL: operating, mobile
MMOP-076	TABLE: mayo
MMOP-078	TABLE: operating, electric
MMOP-085	TROLLEY: anaesthetic
MMOP-100	WARMER: patient, intraoperative
MMOP-508	STACK: Instrument, with Monitor & Camera
MMSP-027.1	LIGHT: operating, 3 arm
MMSP-034	PENDANT: Single Articulated Arm, Surg/Anaes
PKG - Packages	
MSP14	SERVICES PANEL: wall mounted 14
MSP15	SERVICES PANEL: wall mounted 15
MSP16	SERVICES PANEL: wall mounted 16
MSP17-1	SERVICES PANEL: wall mounted
MSP18	SERVICES PANEL: wall mounted 18
MSP19	SERVICES PANEL: wall mounted 19
MSP20	SERVICES PANEL: wall mounted 20
MSP21	SERVICES PANEL: wall mounted 21
PKG-AV-1	
ITAV-051.3	DISPLAY SCREEN: audio visual, 55"
PKG-MON-08R	
ELGP-501	GPO: double, UPS, wall mounted, instance height
FIHR-515	BRACKET: Computer wall mount: Style View Vertical Lift, nurses station, MME
FIHR-516	BRACKET: Keyboard: Vertical Lift Auto-Retracting, nurses station, MME
ITAV-513	MME: Button - Light Control Panel, Theatre
ITAV-516	PANEL: AV, nurse station, MME
ITAV-518	TRANSMITTER: bluetooth, nurses station, MME
MMOP-505	MONITOR & KEYBOARD: nurses station, MME
PKG-MON-09D	
ELGP-501	GPO: double, UPS, wall mounted, instance height
FIHR-512	BRACKET: Computer wall mount: Style View Vertical Lift
FIHR-513	BRACKET: Keyboard: Vertical Lift Auto-Retracting
ITAV-519	ADAPTER: DVI Input Adapter, OR, ITC
ITIN-026.14	OUTLET: data, double RJ45, wall mounted, instance height
MMHA-504	MME: Monitor & keyboard, OPE
SE - Services	
ITAV-519	ADAPTER: DVI Input Adapter, OR, ITC
WL - Walls & Wall Finishes	
WLWA-019	WALL FINISH: vinyl, full height

PROJECT NUMBER:	REVISION:
10324179	2
STATUS:	SCALE:
DESIGN DEVELOPMENT	1:50 @ A3

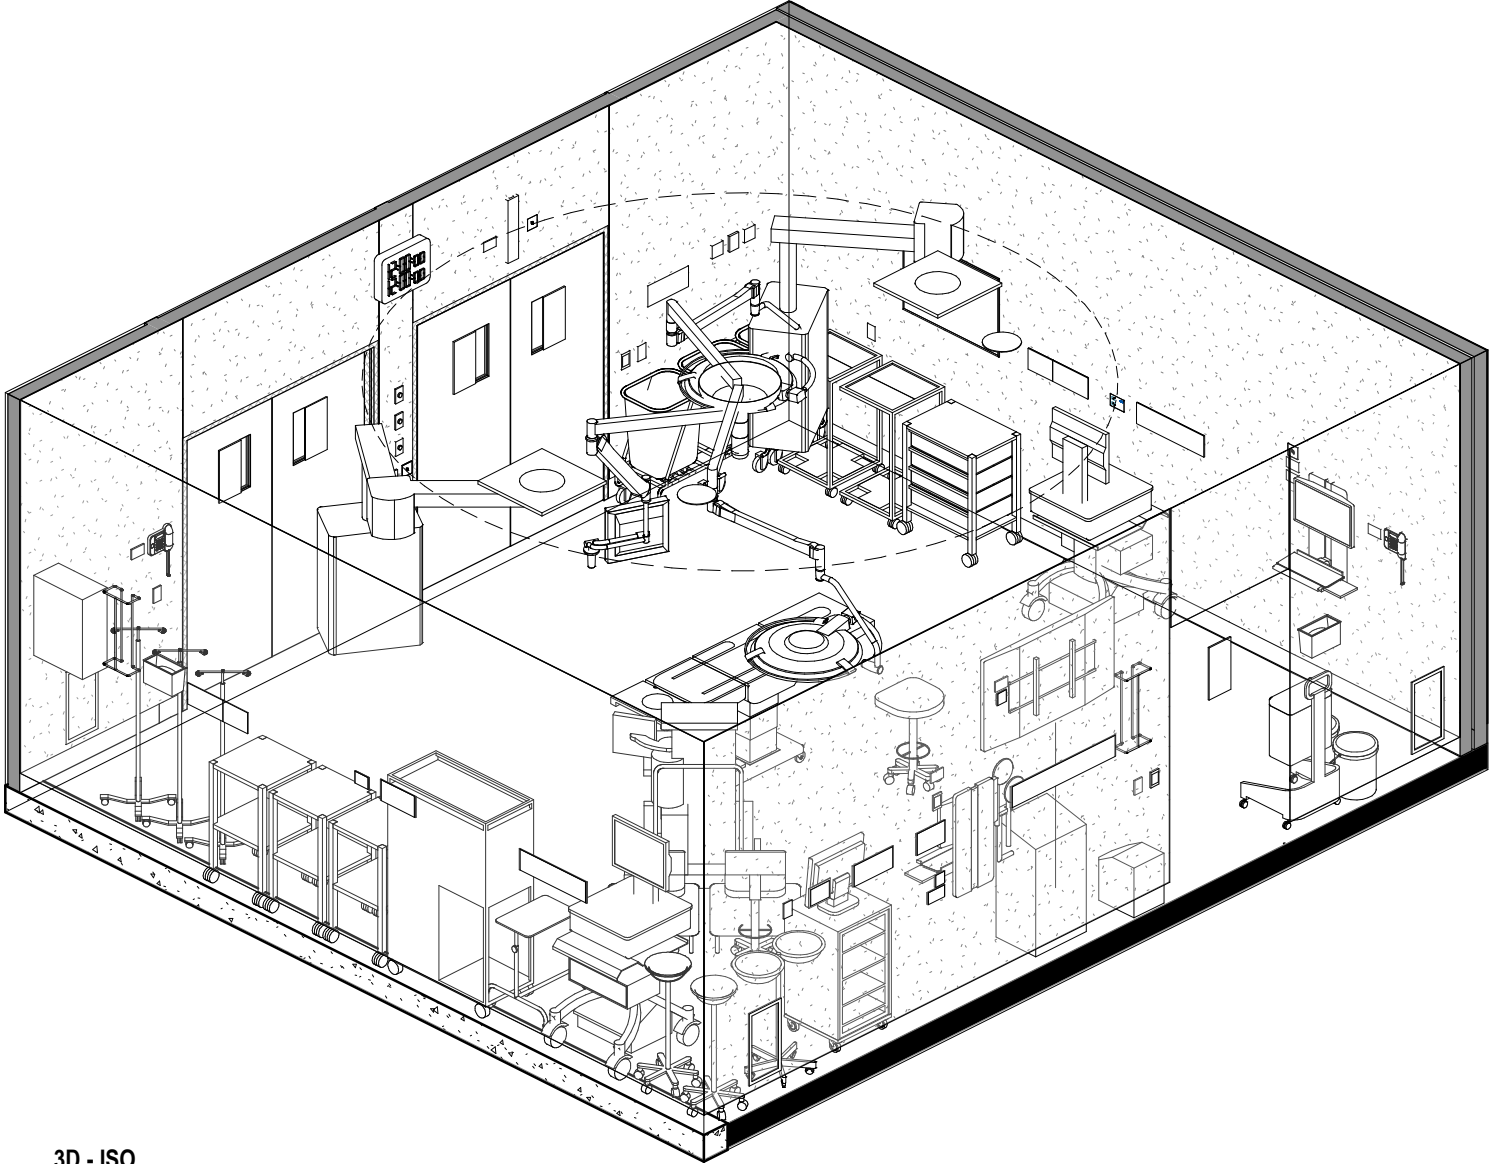

3D - ISO

REV	DATE	DESCRIPTION	DWN	CHK
1	31/03/23	ISSUE FOR COORDINATION - OTS-16	NN	MP
2	28/04/23	ISSUE FOR PRELIMINARY DO	SH	DJM

MAIN CONTRACTOR:	
0	250mm
1000mm	2000mm
1:50mm	


CLIENT:	
Level 14, 77 Pacific Highway North Sydney NSW 2060	P: (02) 9978 5427 F: (02) 8964 1377 www.health.nsw.gov.au
PROJECT MANAGER:	
One International Towers Sydney Watermark Quay Barrangaroo NSW 2000	P: (02) 8266 0000 F: (02) 8266 9999 www.pwc.com.au

ARCHITECT:	
Level 24, 25 Martin Place Sydney NSW 2000 Australia	P: (02) 9556 2666 www.hdr.com.au HDR Pty. Limited ABN 76 158 075 220


PROJECT:	
Westmead Redevelopment	Building health. Transforming lives.
WMH-HDR-AR-EM-MS1_2_3	
Hawkesbury Rd, Westmead, NSW, 2145	

DRAWING NUMBER:	
OAD-WHR-HDR-AR-RLS-90OPE205-2	
DRAWING TITLE:	
WHR.OPE.205 - Operating Room - Theatre 10 - SHEET 2 OF 3	

PROJECT NUMBER:	
10324179	
STATUS:	
DESIGN DEVELOPMENT	
REVISION:	
2	
SCALE:	
1:50 @ A3	

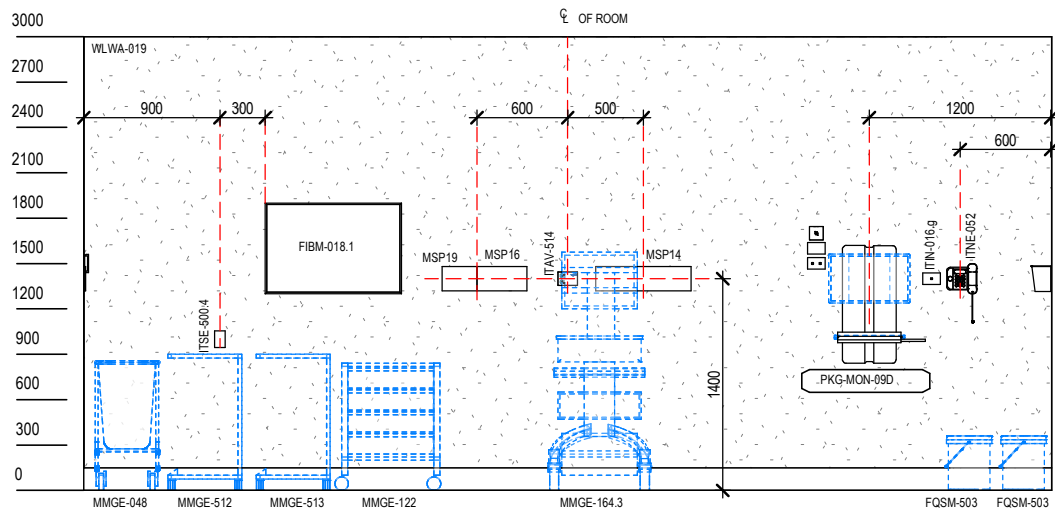


ELEVATION 2

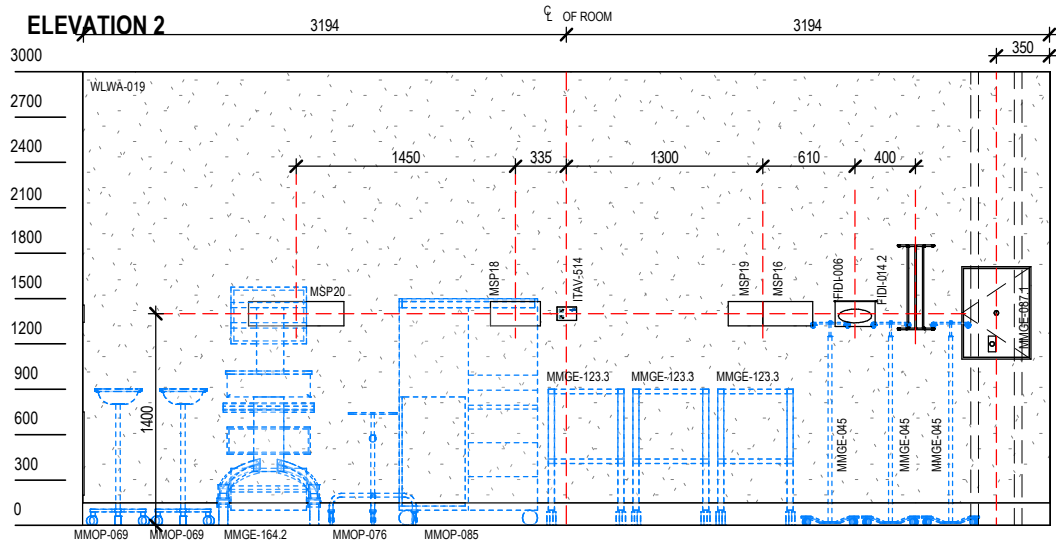


ELEVATION 4

ROOM EQUIPMENT-- WHR.OPE.205 - Operating Room - Theatre 10 Copy 1	
drofus_item_BIM_ID	drofus_item_name
PKG-AV-1	
ITAV-051.3	DISPLAY SCREEN: audio visual, 55"
PKG-MON-08R	
ELGP-501	GPO: double, UPS, wall mounted, instance height
FIHR-515	BRACKET: Computer wall mount: Style View Vertical Lift, nurses station, MME
FIHR-516	BRACKET: Keyboard: Vertical Lift Auto-Retracting, nurses station, MME
ITAV-513	MME: Button - Light Control Panel, Theatre
ITAV-516	PANEL: AV, nurse station, MME
ITAV-518	TRANSMITTER: bluetooth, nurses station, MME
MMOP-505	MONITOR & KEYBOARD: nurses station, MME
PKG-MON-09D	
ELGP-501	GPO: double, UPS, wall mounted, instance height
FIHR-512	BRACKET: Computer wall mount: Style View Vertical Lift
FIHR-513	BRACKET: Keyboard: Vertical Lift Auto-Retracting
ITAV-519	ADAPTER: DVI Input Adapter, OR, ITC
ITIN-026.14	OUTLET: data, double RJ45, wall mounted, instance height
MMHA-504	MME: Monitor & keyboard, OPE
SE - Services	
ITAV-519	ADAPTER: DVI Input Adapter, OR, ITC
WL - Walls & Wall Finishes	
WLWA-019	WALL FINISH: vinyl, full height


E205-3 m - Theatre 10 -	PROJECT NUMBER: 10324179 STATUS: DESIGN DEVELOPMENT 1:5
---	---

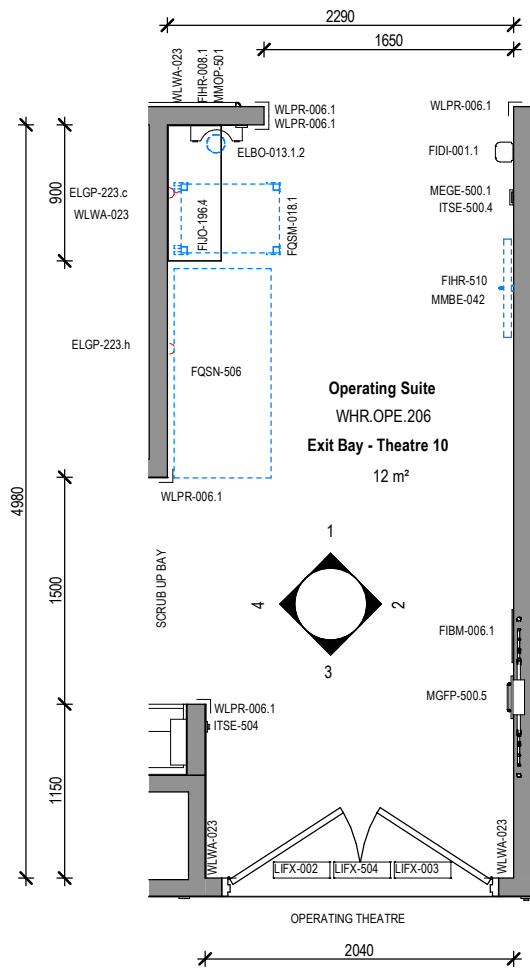


FLOOR PLAN

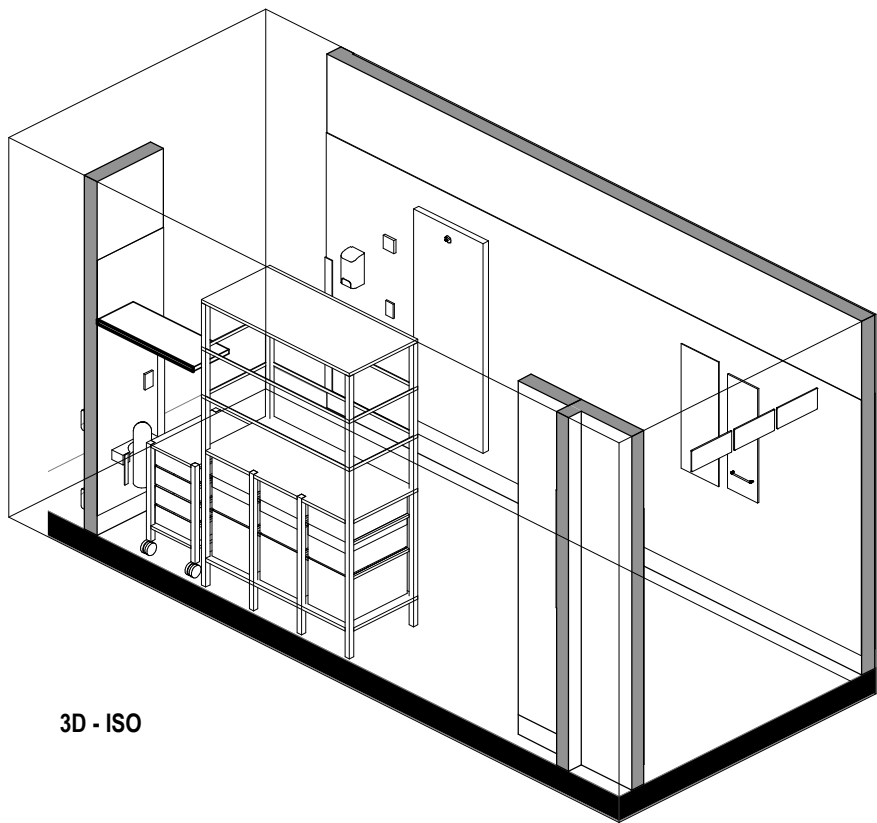


3D - ISO

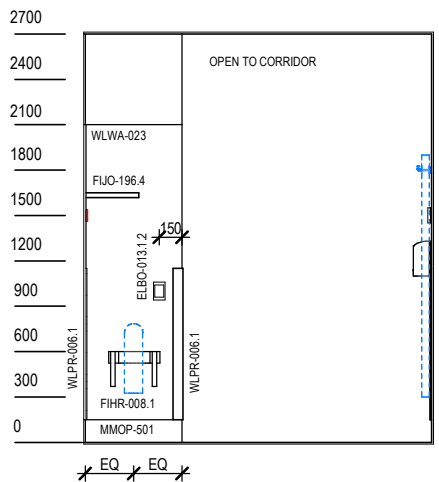


ELEVATION 1

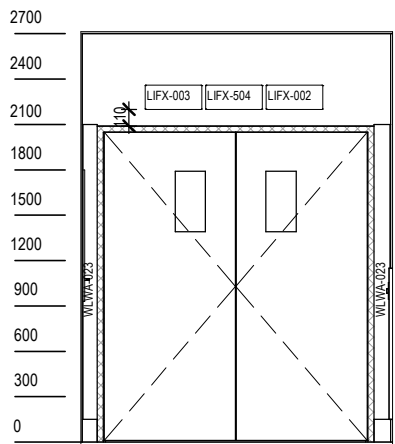

ELEVATION 3

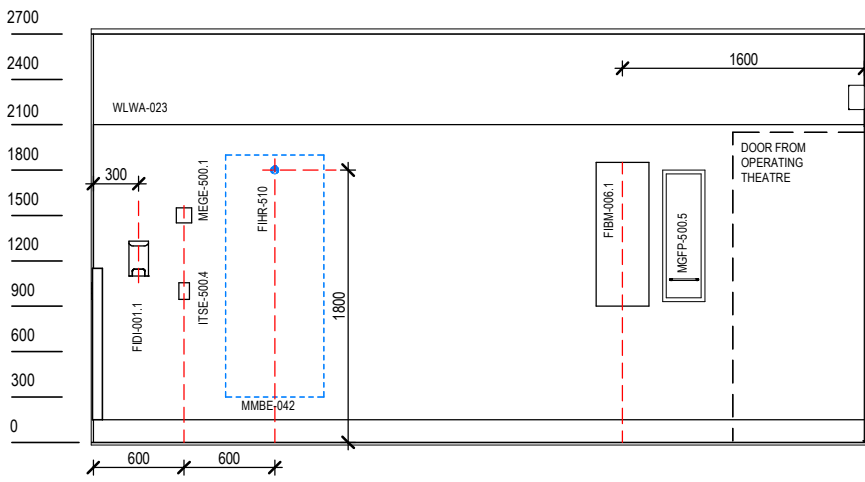

ELEVATION 2

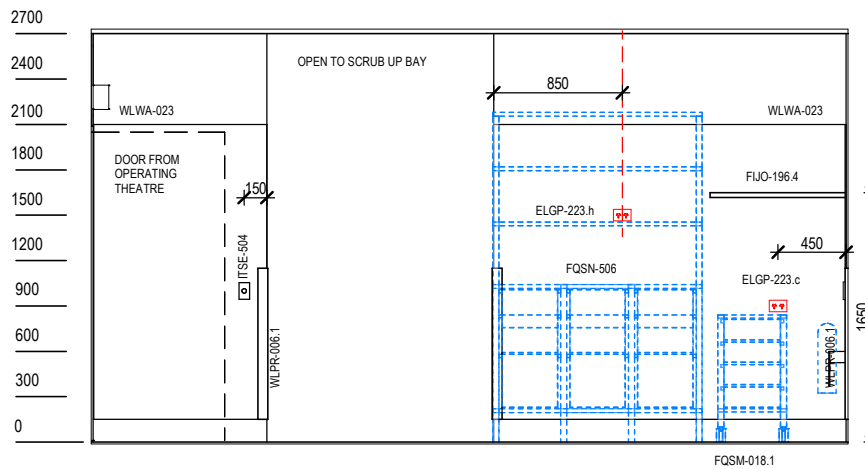

ELEVATION 4

ROOM EQUIPMENT-- WHR.OPE.206 - Exit Bay	
Designation	Description
EL - Electrical Services	
ELBO-013.1.2	SWITCH: light, control panel, 4 button
ELGP-223.c	GPO: emergency power, double, wall mounted, 900AFFL
ELGP-223.h	GPO: emergency power, double, wall mounted, 1500AFFL
FI - Fixtures & Fittings	
FIBM-006.1	MIRROR: fixed, glass, 350W x 950H
FIDI-001.1	DISPENSER: alcohol based hand rub (ABHR)
FIHR-008.1	BRACKET: for gas cylinder, 1 cylinder, C size
FIHR-510	HOOK: Slide board patient, wall mounted
FIJO-196.4	SHELF: stainless steel, overbench, wall mount, 350D
FQ - Furniture & Non-Medical Equipment	
FQSM-018.1	TROLLEY: basket 4 wire 650W x 455D x 840H
FQSN-506	SHELVING: 6 x 180H and 3 x 350H wire baskets with 3 flat shelf, 1384W x 640D x 2180H
IT - Information & Communication Services	
ITSE-500.4	DOOR RELEASE: access control, 2 gang switch
ITSE-504	SENSOR: motion detection, wave to open

ROOM EQUIPMENT-- WHR.OPE.206 - Exit Bay	
Designation	Description
ME - Mechanical Services	
MEGE-500.1	SENSOR: temperature
MG - Medical Gas Systems	
MGFP-500.5	VALVE BOX: medical gases, 5 pipe
MM - Medical & Laboratory Equipment	
MMBE-042	SLIDE: patient
MMOP-501	CYLINDER: gas, oxygen, C size
WL - Walls & Wall Finishes	
WLPR-006.1	WALL PROTECTION: corner guards 1000H 90 degree, 1150mm AFFL to top of corner guards, prefinished PVC
WLWA-023	WALL FINISH: vinyl, to 2100 AFFL

REV	DATE	DESCRIPTION	DWN	CHK
1	31/03/23	ISSUE FOR COORDINATION - OTS-16	JG	MP
2	28/04/23	ISSUE FOR PRELIMINARY DO	SH	DJM

MAIN CONTRACTOR:	


CLIENT:	
Level 14, 77 Pacific Highway North Sydney NSW 2060	P: (02) 9078 5427 F: (02) 8964 1377 www.health.nsw.gov.au
PROJECT MANAGER:	
One International Towers Sydney Watermark Quay Barrangaroo NSW 2000	P: (02) 8266 0000 F: (02) 8266 9999 www.pwc.com.au

ARCHITECT:	
Level 24, 25 Martin Place Sydney NSW 2000 Australia	P: (02) 9556 2666 www.hdr.com.au HDR Pty. Limited ABN 76 158 075 220



DRAWING NUMBER:	OAD-WHR-HDR-AR-RLS-90OPE206
DRAWING TITLE:	WHR.OPE.206 - Exit Bay - Theatre 10


PROJECT NUMBER:	10324179	REVISION:	2
STATUS:	DESIGN DEVELOPMENT	SCALE:	1:50 @ A3

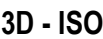


ROOM EQUIPMENT-- WHR.OPE.233 - Store - Equipment, Anaesthetic	
Designation	Description
IT - Information & Communication Services	
ITIN-016.g	OUTLET: data, single RJ45, wall mounted, 1400AFFL
ITSE-500.1	DOOR RELEASE: access control, push to exit
ITSE-500.5	DOOR RELEASE: access control, outside room
WL - Walls & Wall Finishes	
WLPR-013	WALL PROTECTION: corner guards, to 1500 AFFL, prefinished PVC
WRG-1500	WALL PROTECTION: rigid sheet, prefinished PVC, 1350H, 1500mm AFFL to top

NOTE:
ALL DOOR FUNCTIONALITY AND SECURITY
TO BE REVIEWED BY USER GROUP AND PwC


PROJECT NUMBER:	REVISION:
10324179	6
STATUS:	SCALE:
RECORD SET	1:50 @ A3

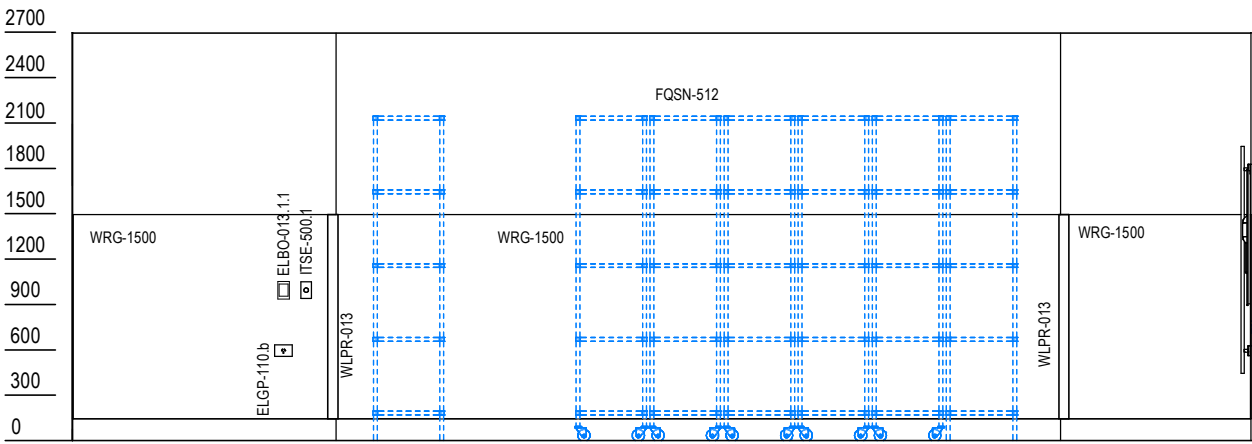


ELEVATION 1

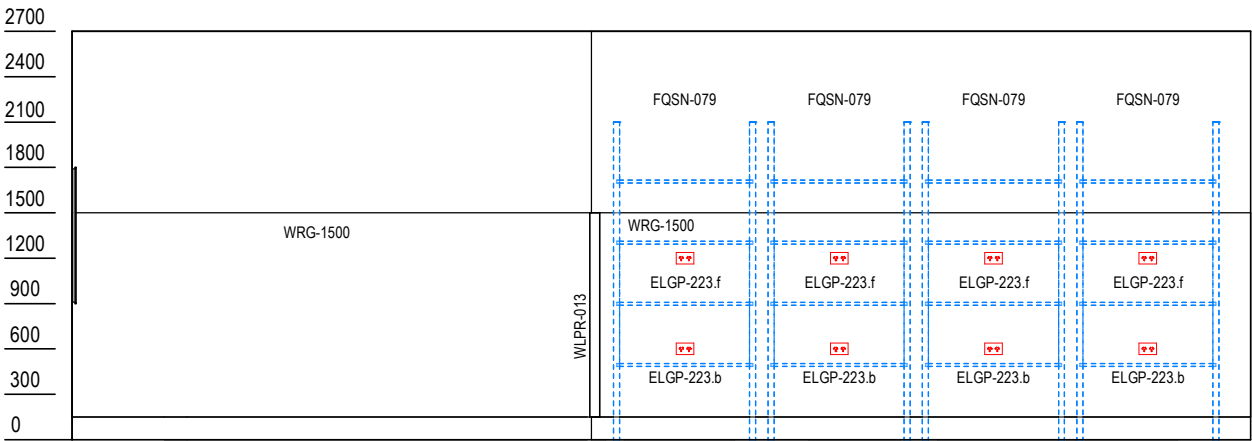

ELEVATION 3

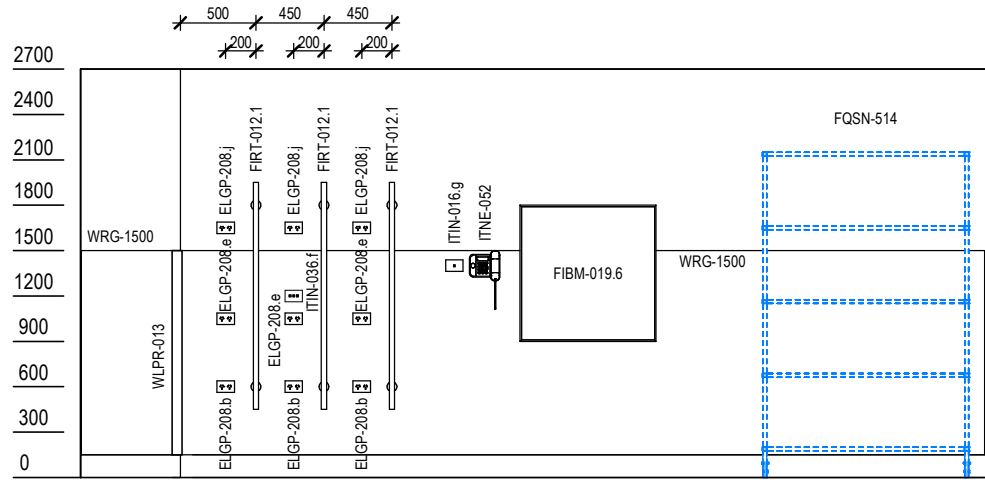

ELEVATION 2

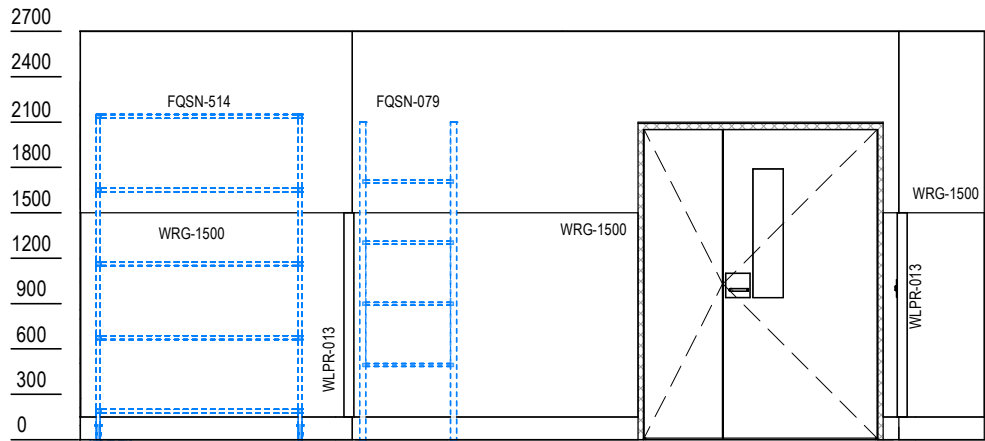

ELEVATION 4

ROOM EQUIPMENT-- WHR.OPE.233 - Store - Equipment, Anaesthetic	
Designation	Description
EL - Electrical Services	
ELBO-013.1.1	SWITCH: light, control panel, 2 button
ELGP-208.b	GPO: double, wall mounted, horiz, 600AFFL
ELGP-208.e	GPO: double, wall mounted, horiz, 1050AFFL
ELGP-208.j	GPO: double, wall mounted, horiz, 1650AFFL
ELGP-223.b	GPO: essential power, double, wall mounted, 600AFFL
ELGP-223.f	GPO: emergency power, double, wall mounted, 1200AFFL
ITIN-036.f	OUTLET: data, triple RJ45, wall mounted, 1200AFFL
FI - Fixtures & Fittings	
FIBM-019.6	WHITEBOARD: fixed, magnetic, 900W x 900H
FIRT-012.1	RAIL: equipment, vertical, 1500 long
FQ - Furniture & Non-Medical Equipment	
FQSN-079	SHELVING: floor standing, 900W x 600D x 2100H nom., wire
FQSN-512	SHELVING: compactus, wire with overhead rails, 1334W 2150H, 7 x 440D shelves
FQSN-514	SHELVING: compactus, wire with overhead rails, 1334W 2150H, 5 x 440D shelves
ITNE-052	TELEPHONE: handset, wall mount

ROOM EQUIPMENT-- WHR.OPE.233 - Store - Equipment, Anaesthetic	
Designation	Description
IT - Information & Communication Services	
ITIN-016.g	OUTLET: data, single RJ45, wall mounted, 1400AFFL
ITSE-500.1	DOOR RELEASE: access control, push to exit
ITSE-500.5	DOOR RELEASE: access control, outside room
WL - Walls & Wall Finishes	
WLPR-013	WALL PROTECTION: corner guards, to 1500 AFFL, prefinished PVC
WRG-1500	WALL PROTECTION: rigid sheet, prefinished PVC, 1350H, 1500mm AFFL to top

REV	DATE	DESCRIPTION	DWN	CHK
1	31/01/23	ISSUE FOR REVIEW	JG	MP
2	13/02/23	ISSUE FOR USER ENDORSEMENT	JG	MP
3	20/02/23	ISSUE FOR ENDORSEMENT	JG	MP
4	27/02/23	ISSUE FOR FINAL ENDORSEMENT	JG	MP
5	15/03/23	ISSUED FOR COORDINATION AND REVIEW OF EARLY WORKS ONLY	RH	DJM
6	24/03/23	ISSUED FOR EARLY WORKS PACKAGE DD	RH	DJM

MAIN CONTRACTOR:	
Level 4, 174 Pacific Highway St Leonards NSW 2065 P: (02) 9882 8588 www.renascent.com.au	

CLIENT:	
Level 14, 77 Pacific Highway F: (02) 8904 1377 North Sydney NSW 2060 www.hinfra.health.nsw.gov.au	

PROJECT MANAGER:	
One International Towers Sydney Watermans Quay Barangaroo NSW 2000	

ARCHITECT:	
Level 24, 25 Martin Place Sydney NSW 2000 Australia	

DRAWING NUMBER:	
OAD-WHR-HDR-AR-RLS-900PE233-2	
DRAWING TITLE:	
WHR.OPE.233 - Store - Equipment, Anaesthetic - SHEET 2 OF 2	

PROJECT NUMBER:	
10324179	
STATUS:	
FOR INFORMATION	

REVISION:	
6	
SCALE:	
1:50 @ A3	

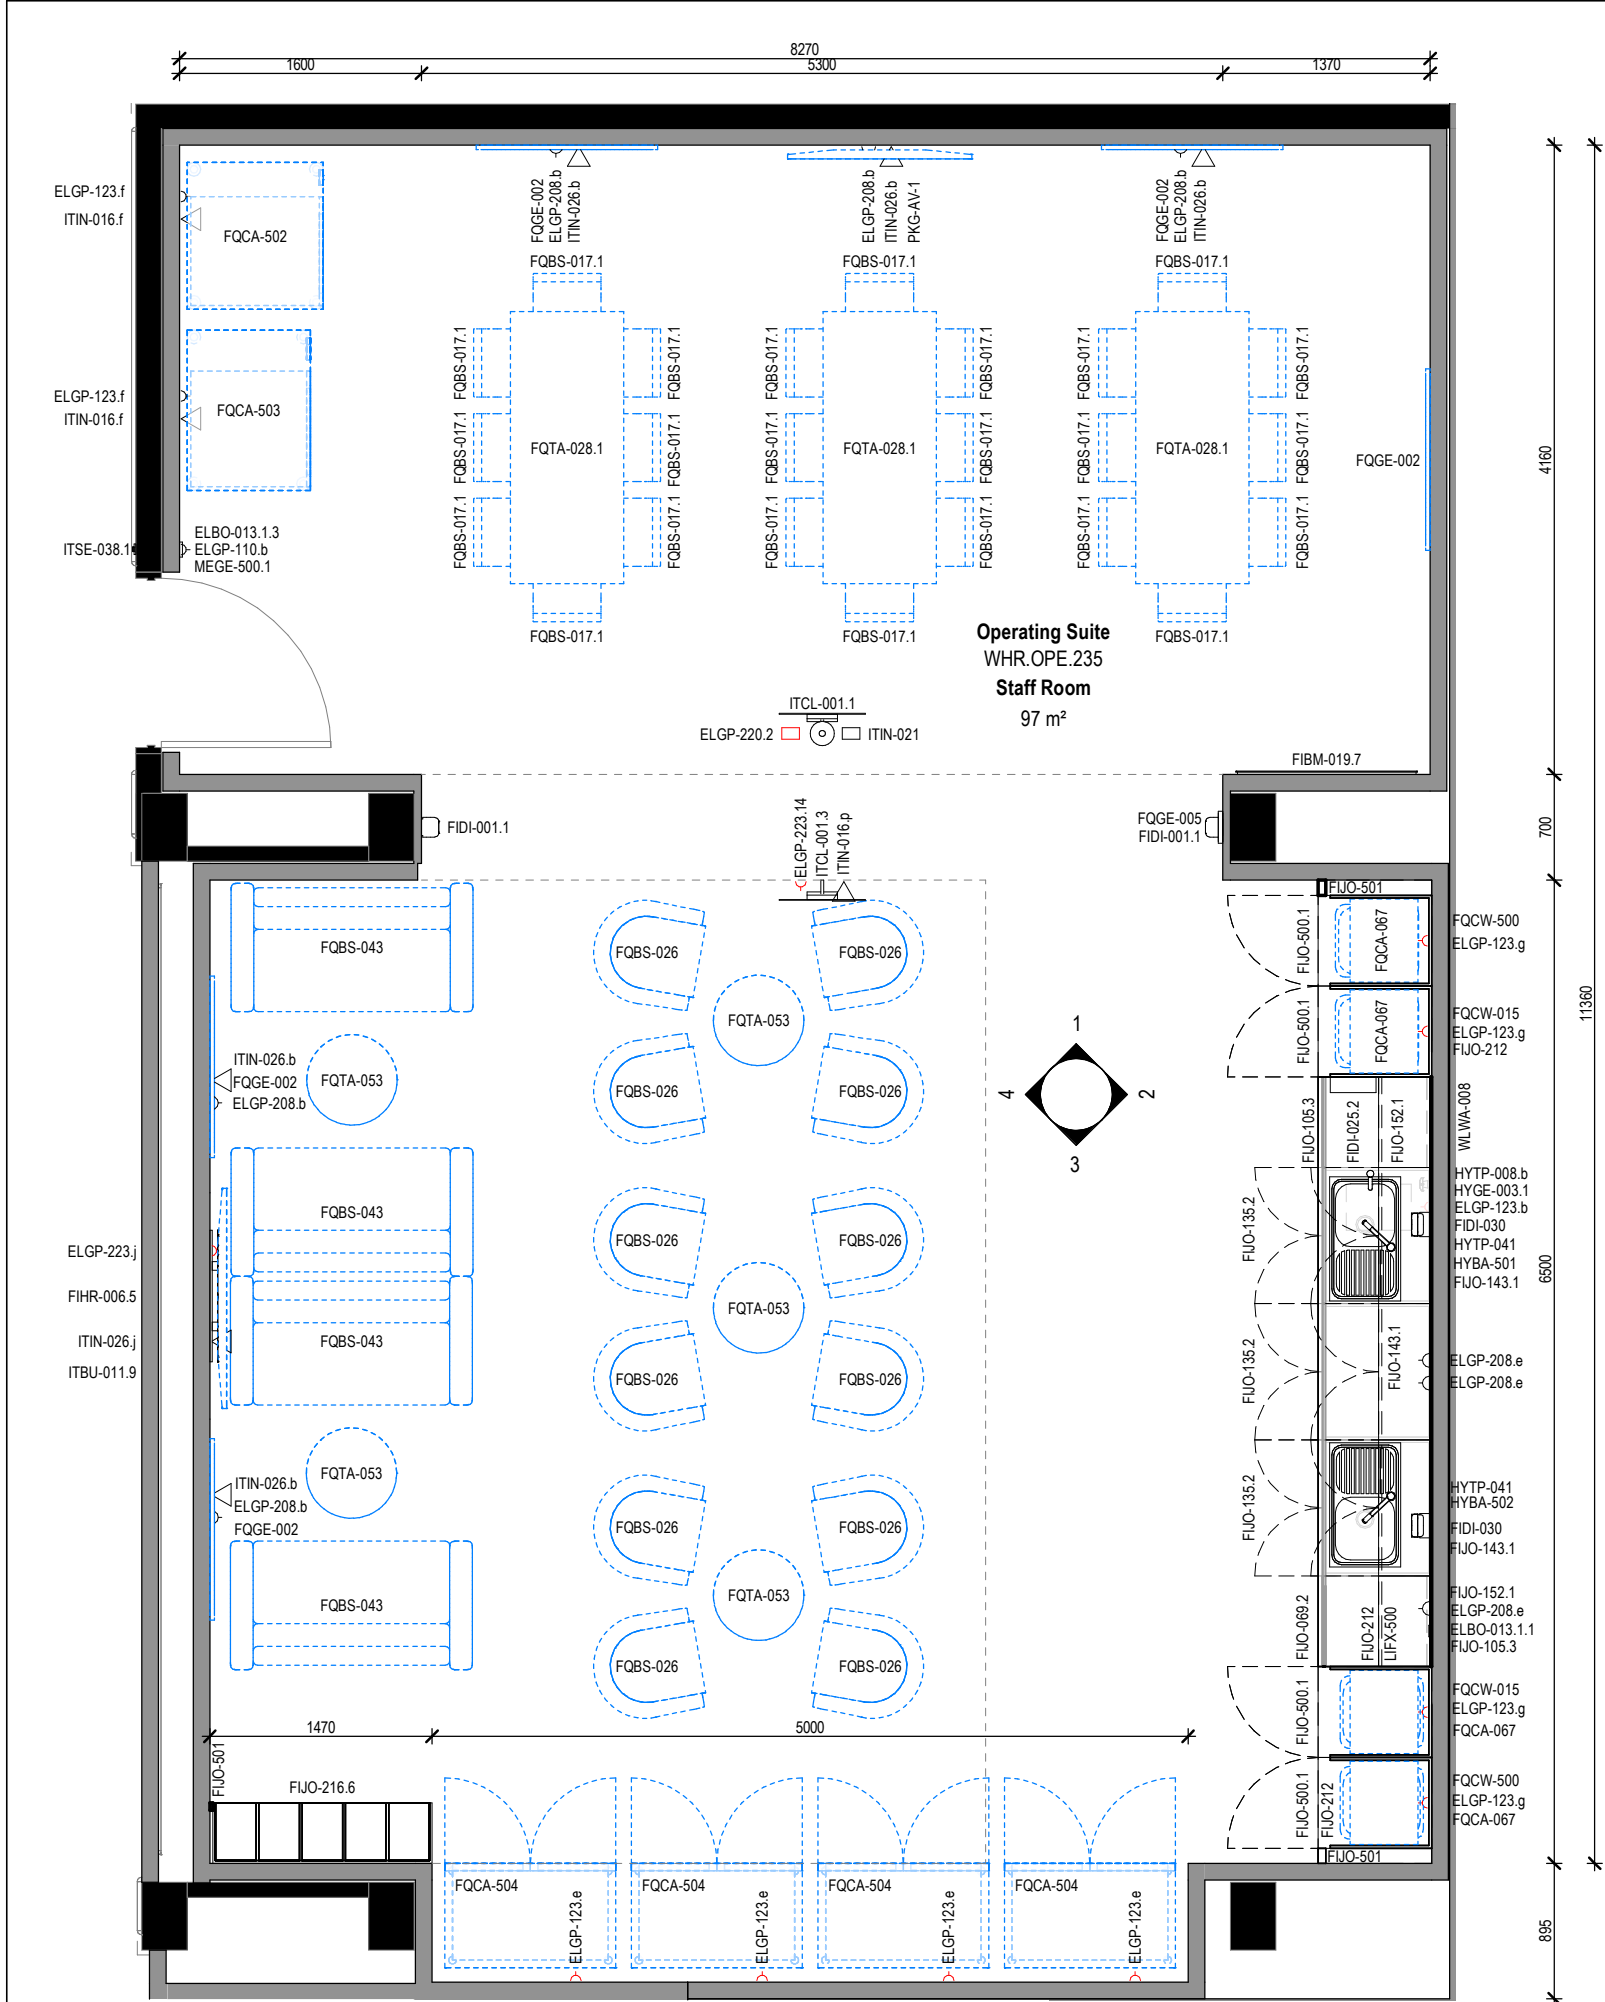

ROOM EQUIPMENT-- WHR.OPE.235 - Staff Room	
Designation	Description
EL - Electrical Services	
EL - Electrical Services	
ELBO-013.1.1	SWITCH: light, control panel, 2 button
ELBO-013.1.3	SWITCH: light, control panel, 6 button
ELGP-110.b	GPO: single, wall mounted, cleaner, 600AFFL
ELGP-123.b	GPO: emergency power, single, wall mounted, 600AFFL
ELGP-123.e	GPO: emergency power, single, wall mounted, 1050AFFL
ELGP-123.f	GPO: essential power, single, wall mounted, 1200AFFL
ELGP-123.g	GPO: emergency power, single, wall mounted, 1400AFFL
ELGP-208.b	GPO: double, wall mounted, 600AFFL
ELGP-208.e	GPO: double, wall mounted, 1050AFFL
ELGP-220.2	GPO: emergency power, double, ceiling mounted
ELGP-223.14	GPO: emergency power, double, wall mounted, instance height
ELGP-223.j	GPO: emergency power, double, wall mounted, 1650AFFL
FI - Fixtures & Fittings	
FIBM-019.7	WHITEBOARD: fixed, magnetic, 1200W x 900H
FIDI-001.1	DISPENSER: alcohol based hand rub (ABHR)
FIDI-025.2	DISPENSER: paper/hand towel, staff
FIDI-030	DISPENSER: soap
FIHR-006.5	BRACKET: for display screen, wall mounted, 65"
FIJO-069.2	BENCH TOP: 750D x 900H, joinery under, laminate finish, (refer to plans for length)
FIJO-105.3	CUPBOARD: drawer unit, 3+1, 600W x 720D x 870H
FIJO-135.2	CUPBOARD: underbench, double door, adj shelves, ventilated, lockable, fixed panel 900W x 720D x 870H
FIJO-143.1	CUPBOARD: wall mount, double door, adj shelves, 900Wx350Dx600H
FIJO-152.1	CUPBOARD: wall mount, shelf unit, adj shelves, 600Wx350Dx600H
FIJO-212	BULKHEAD: joinery
FIJO-216.6	CUPBOARD: pigeon holes, 30 holes, 1450W 400D 2100H
FIJO-500.1	CUPBOARD: tall, double door (vertical), 120L bin storage, microwave shelf 600W x 750D x 2100H
FIJO-501	PANEL: infill joinery, varies in extent
FQCW-500	BIN: waste, recycling, comingled , 120L
FQ - Furniture & Non-Medical Equipment	
FQBS-017.1	CHAIR: meeting room
FQBS-026	CHAIR: tub

ROOM EQUIPMENT-- WHR.OPE.235 - Staff Room	
Designation	Description
FQBS-043	LOUNGE: 2 seat, 1600 wide
FQCA-067	OVEN: microwave, domestic
FQCA-502	MACHINE: vending, snacks, transfer, 970W 900D 1845H
FQCA-503	MACHINE: vending, cold, drinks, transfer, 1060W 815D 1845H
FQCA-504	FRIDGE: commercial, floor standing, double door glass, transfer, 1130W 690D 2015H
FQCW-015	BIN: waste, general, 120L
FQCW-500	BIN: waste, recycling, comingled , 120L
FQGE-002	ARTWORK
FQGE-005	CLOCK: analogue, battery operated
FQTA-028.1	TABLE: rectangular, 1800L x 750W, dining height
FQTA-053	TABLE: round, 600 diam, low height
HYBA-501	SINK: drainer, single, 820mmL, LH bowl
HYBA-502	SINK: drainer, single, 820mmL, RH bowl
HYGE-003.1	BOILING/CHILLED WATER UNIT: Combination, under bench unit & tapware
HYTP-041	TAPWARE: mixer, sink, lever action
ITBU-011.9	DISPLAY SCREEN: television, 65"
HY - Hydraulic Services	
HYTP-008.b	OUTLET: cold water, 600AFFL
IT - Information & Communication Services	
ITCL-001.1	ANNUNCIATOR: nurse call, single sided
ITCL-001.3	ANNUNCIATOR: nurse call, wall mounted
ITIN-016.f	OUTLET: data, single RJ45, wall mounted, 1200AFFL
ITIN-016.p	OUTLET: data, single RJ45, wall mounted, 2700AFFL
ITIN-021	OUTLET: data, double RJ45, ceiling mounted
ITIN-026.b	OUTLET: data, double RJ45, wall mounted, 600AFFL
ITIN-026.j	OUTLET: data, double RJ45, wall mounted, 1650AFFL
ITSE-038.1	READER: access control, adjacent room
LI - Lighting Systems	
LIFX-500	LIGHT: task light, built in, beverage bay
ME - Mechanical Services	
MEGE-500.1	SENSOR: temperature
PKG-AV-1	
FIHR-006.4	BRACKET: for display screen, wall mounted, 55"
ITAV-051.3	DISPLAY SCREEN: audio visual, 55"
WL - Walls & Wall Finishes	
WLWA-008	WALL FINISH: splashback, glass

NOTE:
ALL DOOR FUNCTIONALITY AND SECURITY
TO BE REVIEWED BY USER GROUP AND PwC

FLOOR PLAN

REV	DATE	DESCRIPTION	DWN	CHK
1	13/02/23	ISSUE FOR USER ENDORSEMENT	JG	MP
2	20/02/23	ISSUE FOR ENDORSEMENT	JG	MP
3	27/02/23	ISSUED FOR FINAL ENDORSEMENT	JG	MP
4	15/03/23	ISSUED FOR COORDINATION AND REVIEW OF EARLY WORKS ONLY	RH	DJM
5	24/03/23	ISSUED FOR EARLY WORKS PACKAGE DD	RH	DJM

MAIN CONTRACTOR:	
Level 4, 174 Pacific Highway St Leonards NSW 2065 P: (02) 9882 8588 www.renascent.com.au	
CLIENT:	
Level 14, 77 Pacific Highway F: (02) 8904 1377 North Sydney NSW 2060 www.hinfra.health.nsw.gov.au	
PROJECT MANAGER:	
One International Towers Sydney Watermans Quay Barangaroo NSW 2000	P: (02) 8266 0000 F: (02) 8266 9999 www.pwc.com.au

ARCHITECT:	
Level 24, 25 Martin Place Sydney NSW 2000 Australia	
PROJECT:	
WMH-HDR-AR-EM-MS1_2_3 Hawkesbury Rd, Westmead, NSW, 2145	


DRAWING NUMBER:	
OAD-WHR-HDR-AR-RLS-900PE235	
DRAWING TITLE:	
WHR.OPE.235 - Staff Room - SHEET 1 OF 4	

PROJECT NUMBER:	
10324179	
STATUS:	
FOR INFORMATION	


REVISION:	
5	
SCALE:	
1:50 @ A3	

ROOM EQUIPMENT– WHR.OPE.235 - Staff Room	
Designation	Description
EL - Electrical Services	
ELBO-013.1.1	SWITCH: light, control panel, 2 button
ELBO-013.1.3	SWITCH: light, control panel, 6 button
ELGP-110.b	GPO: single, wall mounted, cleaner, 600AFL
ELGP-123.b	GPO: emergency power, single, wall mounted, 600AFL
ELGP-123.e	GPO: emergency power, single, wall mounted, 1050AFL
ELGP-123.f	GPO: essential power, single, wall mounted, 1200AFL
ELGP-123.g	GPO: emergency power, single, wall mounted, 1400AFL
ELGP-208.b	GPO: double, wall mounted, 600AFL
ELGP-208.e	GPO: double, wall mounted, 1050AFL
ELGP-220.2	GPO: emergency power, double, ceiling mounted
ELGP-223.14	GPO: emergency power, double, wall mounted, instance height
ELGP-223.j	GPO: emergency power, double, wall mounted, 1650AFL
FI - Fixtures & Fittings	
FIBM-019.7	WHITEBOARD: fixed, magnetic, 1200W x 900H
FIDI-001.1	DISPENSER: alcohol based hand rub (ABHR)
FIDI-025.2	DISPENSER: paper/hand towel, staff
FIDI-030	DISPENSER: soap
FIHR-006.5	BRACKET: for display screen, wall mounted, 65"
FIJO-069.2	BENCH TOP: 750D x 900H, joinery under, laminate finish, (refer to plans for length)
FIJO-105.3	CUPBOARD: drawer unit, 3+1, 600W x 720D x 870H
FIJO-135.2	CUPBOARD: underbench, double door, adj shelves, ventilated, lockable, fixed panel 900W x 720D x 870H
FIJO-143.1	CUPBOARD: wall mount, double door, adj shelves, 900Wx350Dx600H
FIJO-152.1	CUPBOARD: wall mount, shelf unit, adj shelves, 600Wx350Dx600H
FIJO-212	BULKHEAD: joinery
FIJO-216.6	CUPBOARD: pigeon holes, 30 holes, 1450W 400D 2100H
FIJO-500.1	CUPBOARD: tall, double door (vertical), 120L bin storage, microwave shelf 600W x 750D x 2100H
FIJO-501	PANEL: infill joinery, varies in extent
FQCW-500	BIN: waste, recycling, comingled , 120L
FQ - Furniture & Non-Medical Equipment	
FQBS-017.1	CHAIR: meeting room
FQBS-026	CHAIR: tub

ROOM EQUIPMENT– WHR.OPE.235 - Staff Room	
Designation	Description
FQBS-043	LOUNGE: 2 seat, 1600 wide
FQCA-067	OVEN: microwave, domestic
FQCA-502	MACHINE: vending, snacks, transfer, 970W 900D 1845H
FQCA-503	MACHINE: vending, cold, drinks, transfer, 1060W 815D 1845H
FQCA-504	FRIDGE: commercial, floor standing, double door glass, transfer, 1130W 690D 2015H
FQCW-015	BIN: waste, general, 120L
FQCW-500	BIN: waste, recycling, comingled , 120L
FQGE-002	ARTWORK
FQGE-005	CLOCK: analogue, battery operated
FQTA-028.1	TABLE: rectangular, 1800L x 750W, dining height
FQTA-053	TABLE: round, 600 diam, low height
HYBA-501	SINK: drainer, single, 820mmL, LH bowl
HYBA-502	SINK: drainer, single, 820mmL, RH bowl
HYGE-003.1	BOILING/CHILLED WATER UNIT: Combination, under bench unit & tapware
HYTP-041	TAPWARE: mixer, sink, lever action
ITBU-011.9	DISPLAY SCREEN: television, 65"
HY - Hydraulic Services	
HYTP-008.b	OUTLET: cold water, 600AFL
IT - Information & Communication Services	
ITCL-001.1	ANNUNCIATOR: nurse call, single sided
ITCL-001.3	ANNUNCIATOR: nurse call, wall mounted
ITIN-016.f	OUTLET: data, single RJ45, wall mounted, 1200AFL
ITIN-016.p	OUTLET: data, single RJ45, wall mounted, 2700AFL
ITIN-021	OUTLET: data, double RJ45, ceiling mounted
ITIN-026.b	OUTLET: data, double RJ45, wall mounted, 600AFL
ITIN-026.j	OUTLET: data, double RJ45, wall mounted, 1650AFL
ITSE-038.1	READER: access control, adjacent room
LI - Lighting Systems	
LIFX-500	LIGHT: task light, built in, beverage bay
ME - Mechanical Services	
MEGE-500.1	SENSOR: temperature
PKG-AV-1	
FIHR-006.4	BRACKET: for display screen, wall mounted, 55"
ITAV-051.3	DISPLAY SCREEN: audio visual, 55"
WL - Walls & Wall Finishes	
WLWA-008	WALL FINISH: splashback, glass

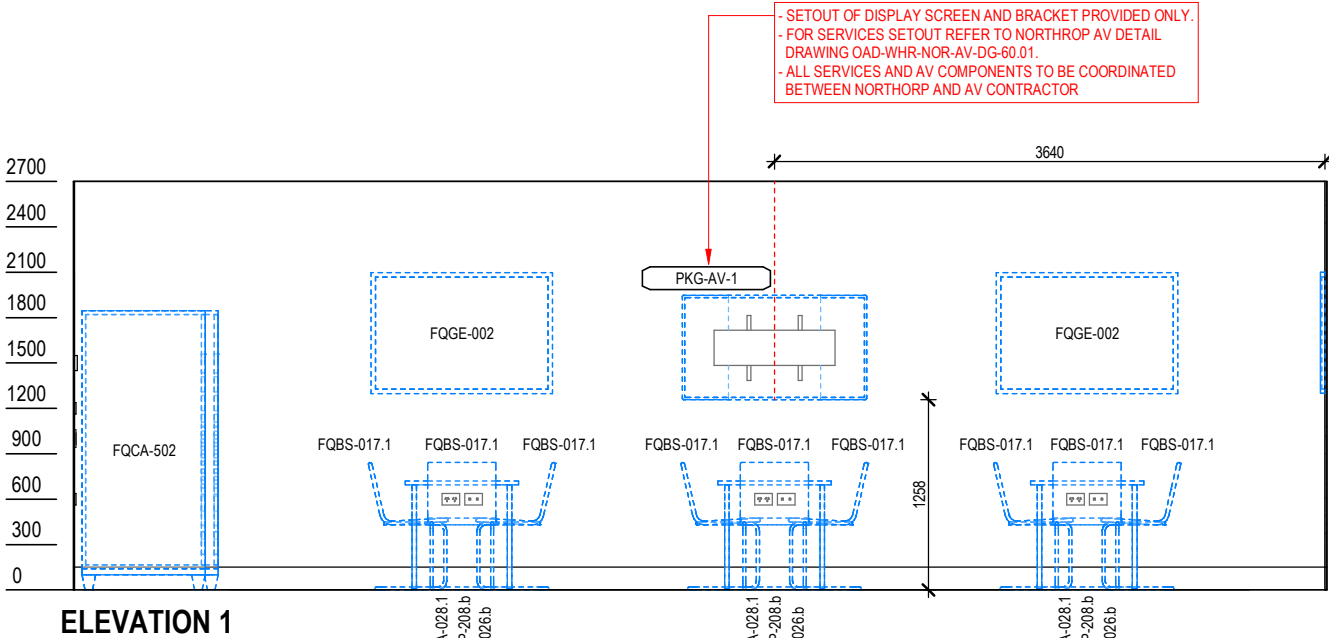

ELEVATION 1

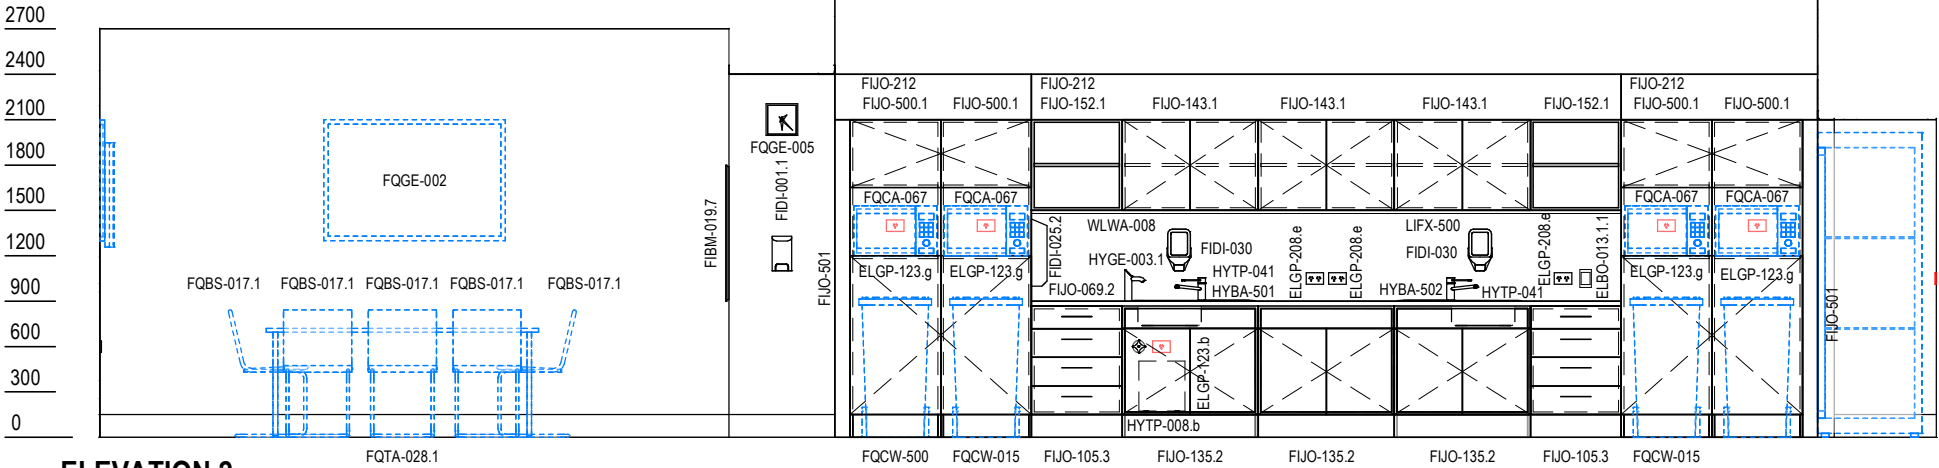

ELEVATION 2

REV	DATE	DESCRIPTION	DWN	CHK
1	13/02/23	ISSUE FOR USER ENDORSEMENT	JG	MP
2	20/02/23	ISSUE FOR ENDORSEMENT	JG	MP
3	27/02/23	ISSUED FOR FINAL ENDORSEMENT	JG	MP
4	15/03/23	ISSUED FOR COORDINATION AND REVIEW OF EARLY WORKS ONLY	RH	DJM
5	24/03/23	ISSUED FOR EARLY WORKS PACKAGE DO	RH	DJM

MAIN CONTRACTOR:	CLIENT:	ARCHITECT:
Level 4, 174 Pacific Highway St Leonards NSW 2065 P: (02) 9852 8588 www.renascent.com.au	P: (02) 9978 5427 F: (02) 8904 1377 North Sydney NSW 2060 www.hinfra.health.nsw.gov.au	Level 24, 25 Martin Place Sydney NSW 2000 Australia P: (02) 9956 2666 F: (02) 8266 9999 www.hdrinc.com HDR Pty. Limited ABN 76 158 075 220

PROJECT MANAGER:	ARCHITECT:
One International Towers Sydney Watermans Quay Barangaroo NSW 2000	P: (02) 9956 2666 F: (02) 8266 9999 www.hdrinc.com HDR Pty. Limited ABN 76 158 075 220

0	250mm	1000mm	2000mm
1:50mm			

MAIN CONTRACTOR:	CLIENT:	ARCHITECT:
Level 4, 174 Pacific Highway St Leonards NSW 2065 P: (02) 9852 8588 www.renascent.com.au	P: (02) 9978 5427 F: (02) 8904 1377 North Sydney NSW 2060 www.hinfra.health.nsw.gov.au	Level 24, 25 Martin Place Sydney NSW 2000 Australia P: (02) 9956 2666 F: (02) 8266 9999 www.hdrinc.com HDR Pty. Limited ABN 76 158 075 220


PROJECT MANAGER:	ARCHITECT:
One International Towers Sydney Watermans Quay Barangaroo NSW 2000	P: (02) 9956 2666 F: (02) 8266 9999 www.hdrinc.com HDR Pty. Limited ABN 76 158 075 220

ARCHITECT:	PROJECT:
Level 24, 25 Martin Place Sydney NSW 2000 Australia P: (02) 9956 2666 F: (02) 8266 9999 www.hdrinc.com HDR Pty. Limited ABN 76 158 075 220	Westmead Redevelopment Building health. Transforming lives. WMH-HDR-AR-EM-MS1_2_3 Hawkesbury Rd, Westmead, NSW, 2145


ARCHITECT:	PROJECT:
Level 24, 25 Martin Place Sydney NSW 2000 Australia P: (02) 9956 2666 F: (02) 8266 9999 www.hdrinc.com HDR Pty. Limited ABN 76 158 075 220	Westmead Redevelopment Building health. Transforming lives. WMH-HDR-AR-EM-MS1_2_3 Hawkesbury Rd, Westmead, NSW, 2145

DRAWING NUMBER:	PROJECT NUMBER:
OAD-WHR-HDR-AR-RLS-900PE235-2	10324179
DRAWING TITLE:	STATUS:
WHR.OPE.235 - Staff Room - SHEET 2 OF 4	FOR INFORMATION

PROJECT NUMBER:	REVISION:
10324179	5
STATUS:	SCALE:
FOR INFORMATION	1:50 @ A3

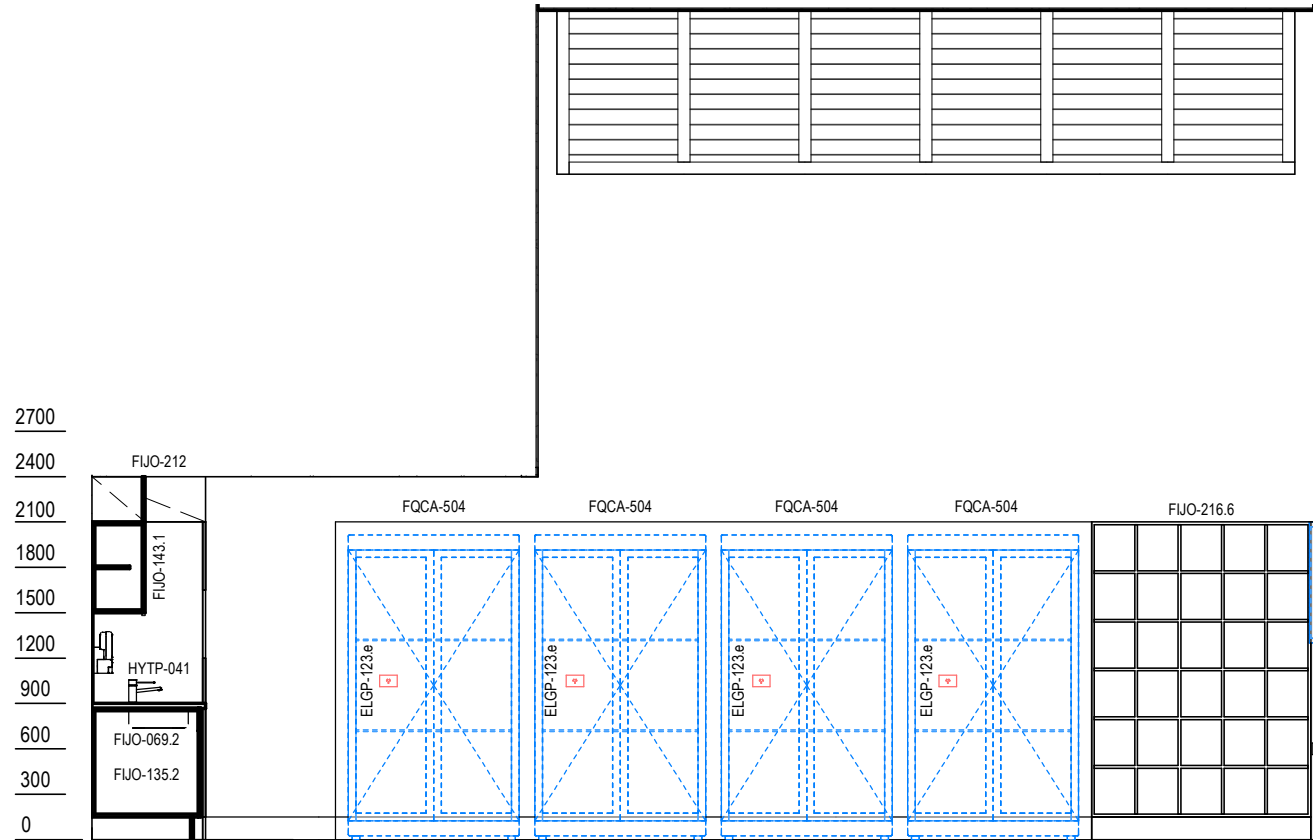


ELEVATION 3

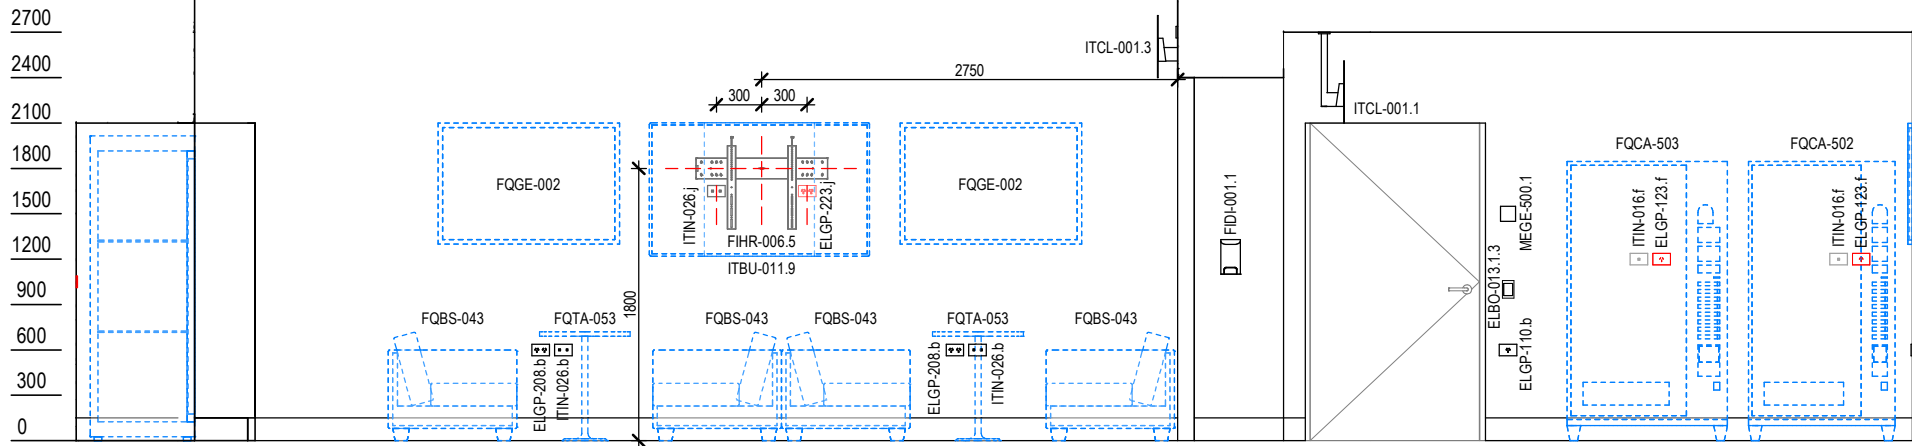







ELEVATION 4

ROOM EQUIPMENT-- WHR.OPE.235 - Staff Room	
Designation	Description
EL - Electrical Services	
ELBO-013.1.1	SWITCH: light, control panel, 2 button
ELBO-013.1.3	SWITCH: light, control panel, 6 button
ELGP-110.b	GPO: single, wall mounted, cleaner, 600AFL
ELGP-123.b	GPO: emergency power, single, wall mounted, 600AFL
ELGP-123.e	GPO: emergency power, single, wall mounted, 1050AFL
ELGP-123.f	GPO: essential power, single, wall mounted, 1200AFL
ELGP-123.g	GPO: emergency power, single, wall mounted, 1400AFL
ELGP-208.b	GPO: double, wall mounted, 600AFL
ELGP-208.e	GPO: double, wall mounted, 1050AFL
ELGP-220.2	GPO: emergency power, double, ceiling mounted
ELGP-223.14	GPO: emergency power, double, wall mounted, instance height
ELGP-223.j	GPO: emergency power, double, wall mounted, 1650AFL
FI - Fixtures & Fittings	
FIBM-019.7	WHITEBOARD: fixed, magnetic, 1200W x 900H
FIDI-001.1	DISPENSER: alcohol based hand rub (ABHR)
FIDI-025.2	DISPENSER: paper/hand towel, staff
FIDI-030	DISPENSER: soap
FIHR-006.5	BRACKET: for display screen, wall mounted, 65"
FIJO-069.2	BENCH TOP: 750D x 900H, joinery under, laminate finish, (refer to plans for length)
FIJO-105.3	CUPBOARD: drawer unit, 3+1, 600W x 720D x 870H
FIJO-135.2	CUPBOARD: underbench, double door, adj shelves, ventilated, lockable, fixed panel 900W x 720D x 870H
FIJO-143.1	CUPBOARD: wall mount, double door, adj shelves, 900Wx350Dx600H
FIJO-152.1	CUPBOARD: wall mount, shelf unit, adj shelves, 600Wx350Dx600H
FIJO-212	BULKHEAD: joinery
FIJO-216.6	CUPBOARD: pigeon holes, 30 holes, 1450W 400D 2100H
FIJO-500.1	CUPBOARD: tall, double door (vertical), 120L bin storage, microwave shelf 600W x 750D x 2100H
FIJO-501	PANEL: infill joinery, varies in extent
FQCW-500	BIN: waste, recycling, comingled , 120L
FQ - Furniture & Non-Medical Equipment	
FQBS-017.1	CHAIR: meeting room
FQBS-026	CHAIR: tub

ROOM EQUIPMENT-- WHR.OPE.235 - Staff Room	
Designation	Description
FQBS-043	LOUNGE: 2 seat, 1600 wide
FQCA-067	OVEN: microwave, domestic
FQCA-502	MACHINE: vending, snacks, transfer, 970W 900D 1845H
FQCA-503	MACHINE: vending, cold, drinks, transfer, 1060W 815D 1845H
FQCA-504	FRIDGE: commercial, floor standing, double door glass, transfer, 1130W 690D 2015H
FQCW-015	BIN: waste, general, 120L
FQCW-500	BIN: waste, recycling, comingled , 120L
FQGE-002	ARTWORK
FQGE-005	CLOCK: analogue, battery operated
FQTA-028.1	TABLE: rectangular, 1800L x 750W, dining height
FQTA-053	TABLE: round, 600 diam, low height
HYBA-501	SINK: drainer, single, 820mmL, LH bowl
HYBA-502	SINK: drainer, single, 820mmL, RH bowl
HYGE-003.1	BOILING/CHILLED WATER UNIT: Combination, under bench unit & tapware
HYTP-041	TAPWARE: mixer, sink, lever action
ITBU-011.9	DISPLAY SCREEN: television, 65"
HY - Hydraulic Services	
HYTP-008.b	OUTLET: cold water, 600AFL
IT - Information & Communication Services	
ITCL-001.1	ANNUNCIATOR: nurse call, single sided
ITCL-001.3	ANNUNCIATOR: nurse call, wall mounted
ITIN-016.f	OUTLET: data, single RJ45, wall mounted, 1200AFL
ITIN-016.p	OUTLET: data, single RJ45, wall mounted, 2700AFL
ITIN-021	OUTLET: data, double RJ45, ceiling mounted
ITIN-026.b	OUTLET: data, double RJ45, wall mounted, 600AFL
ITIN-026.j	OUTLET: data, double RJ45, wall mounted, 1650AFL
ITSE-038.1	READER: access control, adjacent room
LI - Lighting Systems	
LIFX-500	LIGHT: task light, built in, beverage bay
ME - Mechanical Services	
MEGE-500.1	SENSOR: temperature
PKG-AV-1	
FIHR-006.4	BRACKET: for display screen, wall mounted, 55"
ITAV-051.3	DISPLAY SCREEN: audio visual, 55"
WL - Walls & Wall Finishes	
WLWA-008	WALL FINISH: splashback, glass

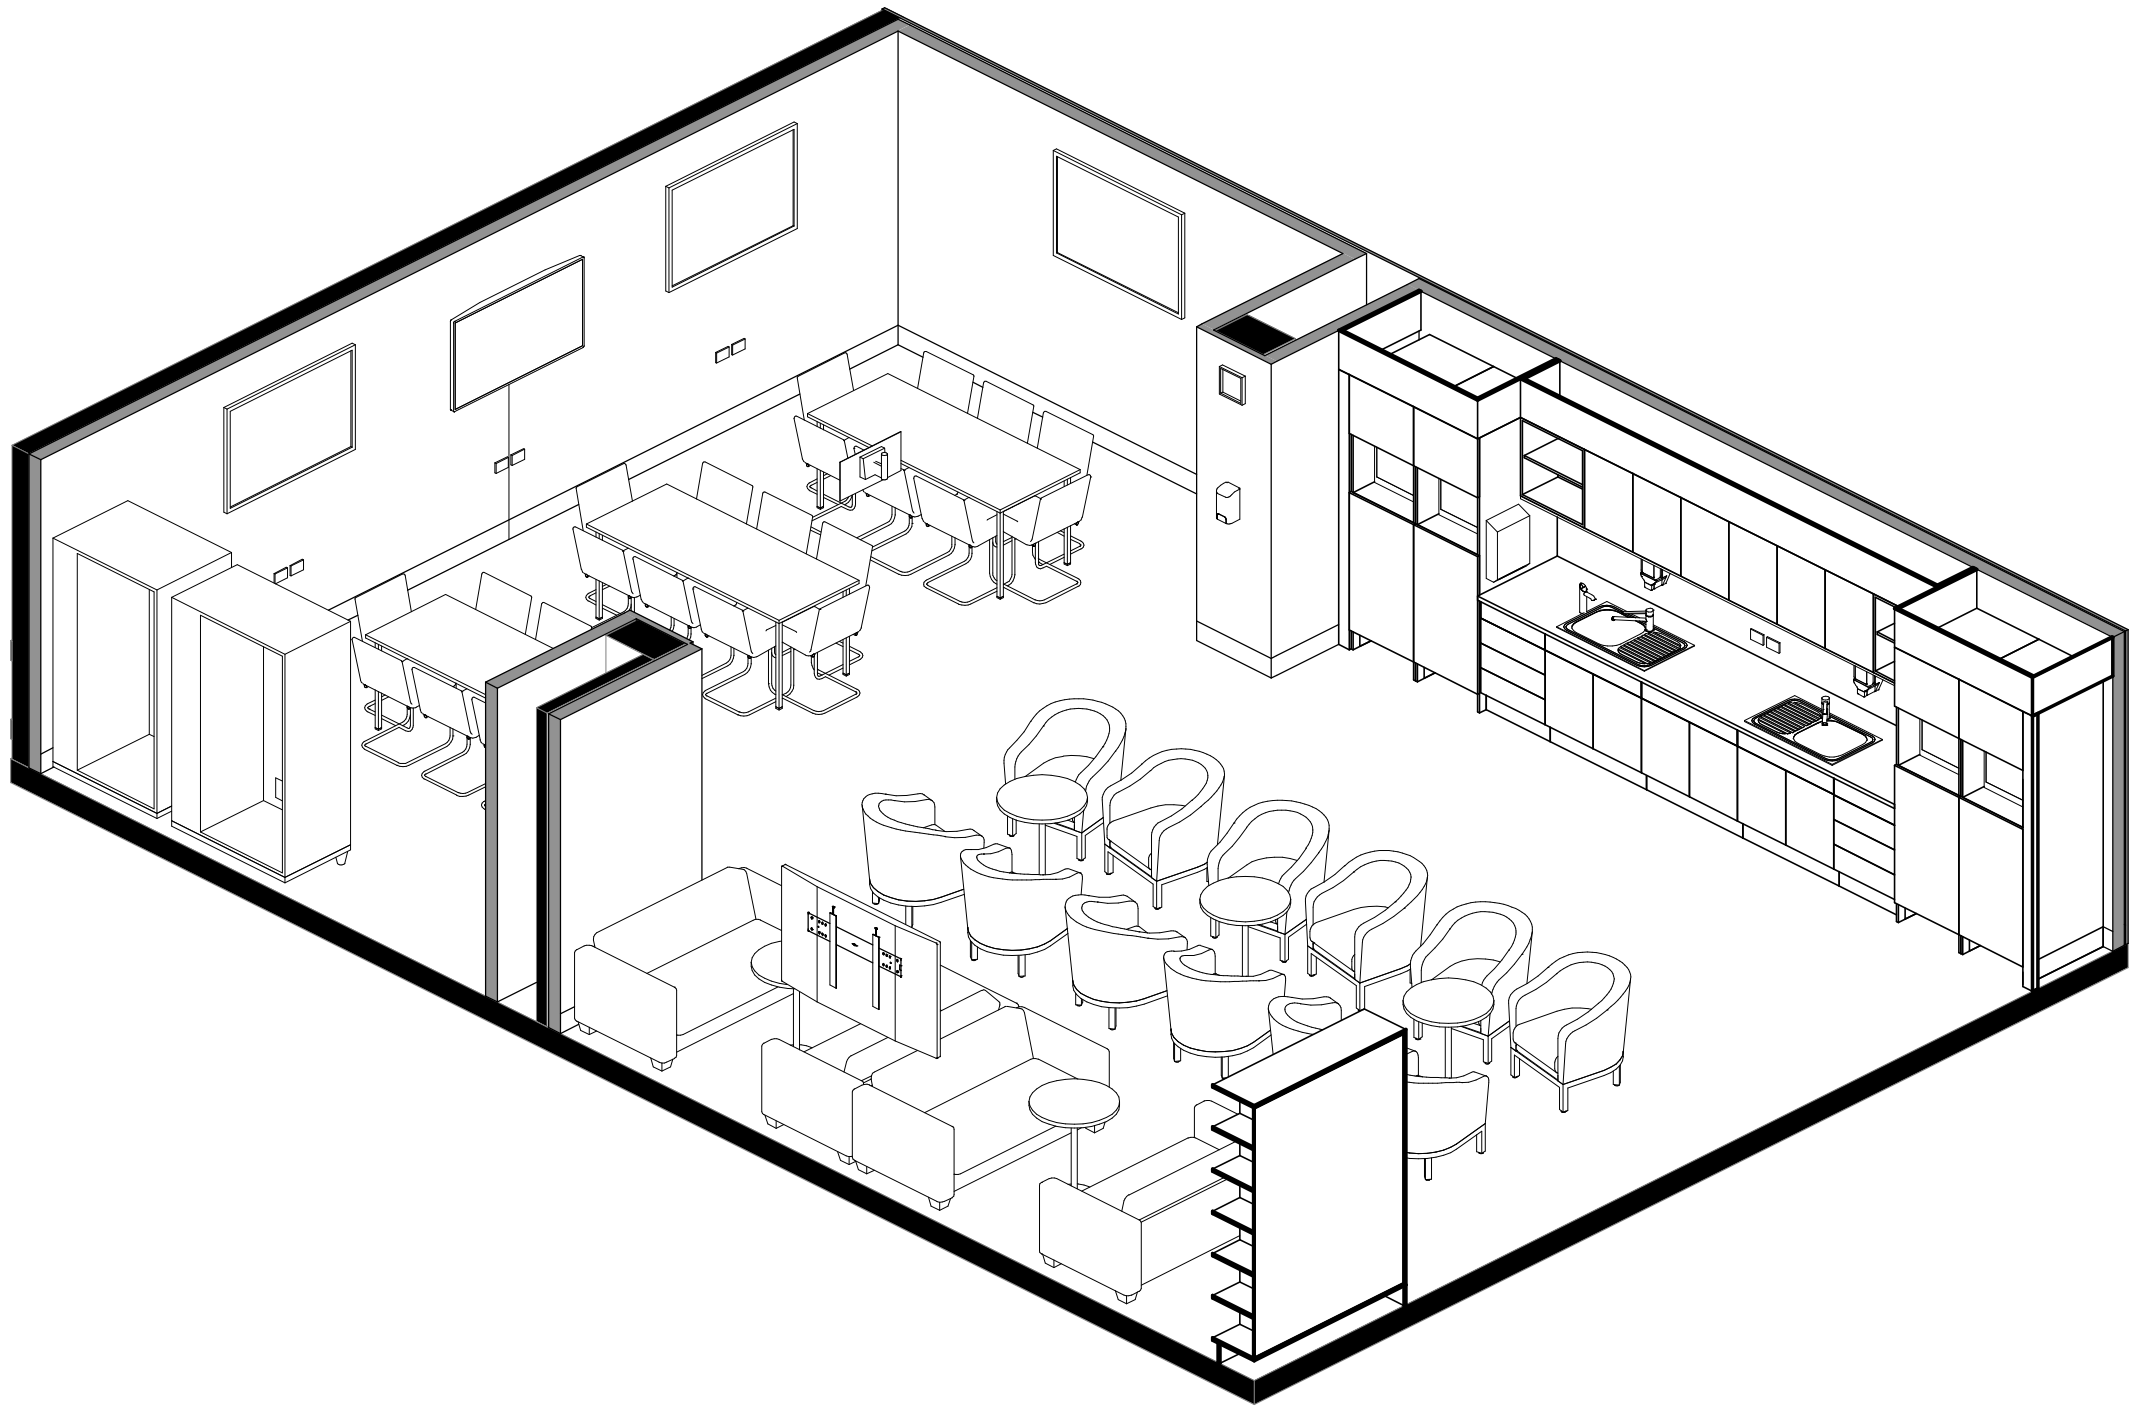

3D - ISO

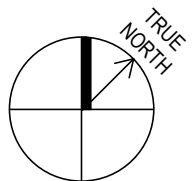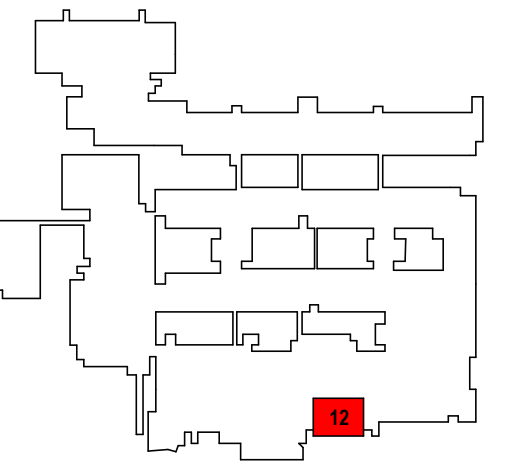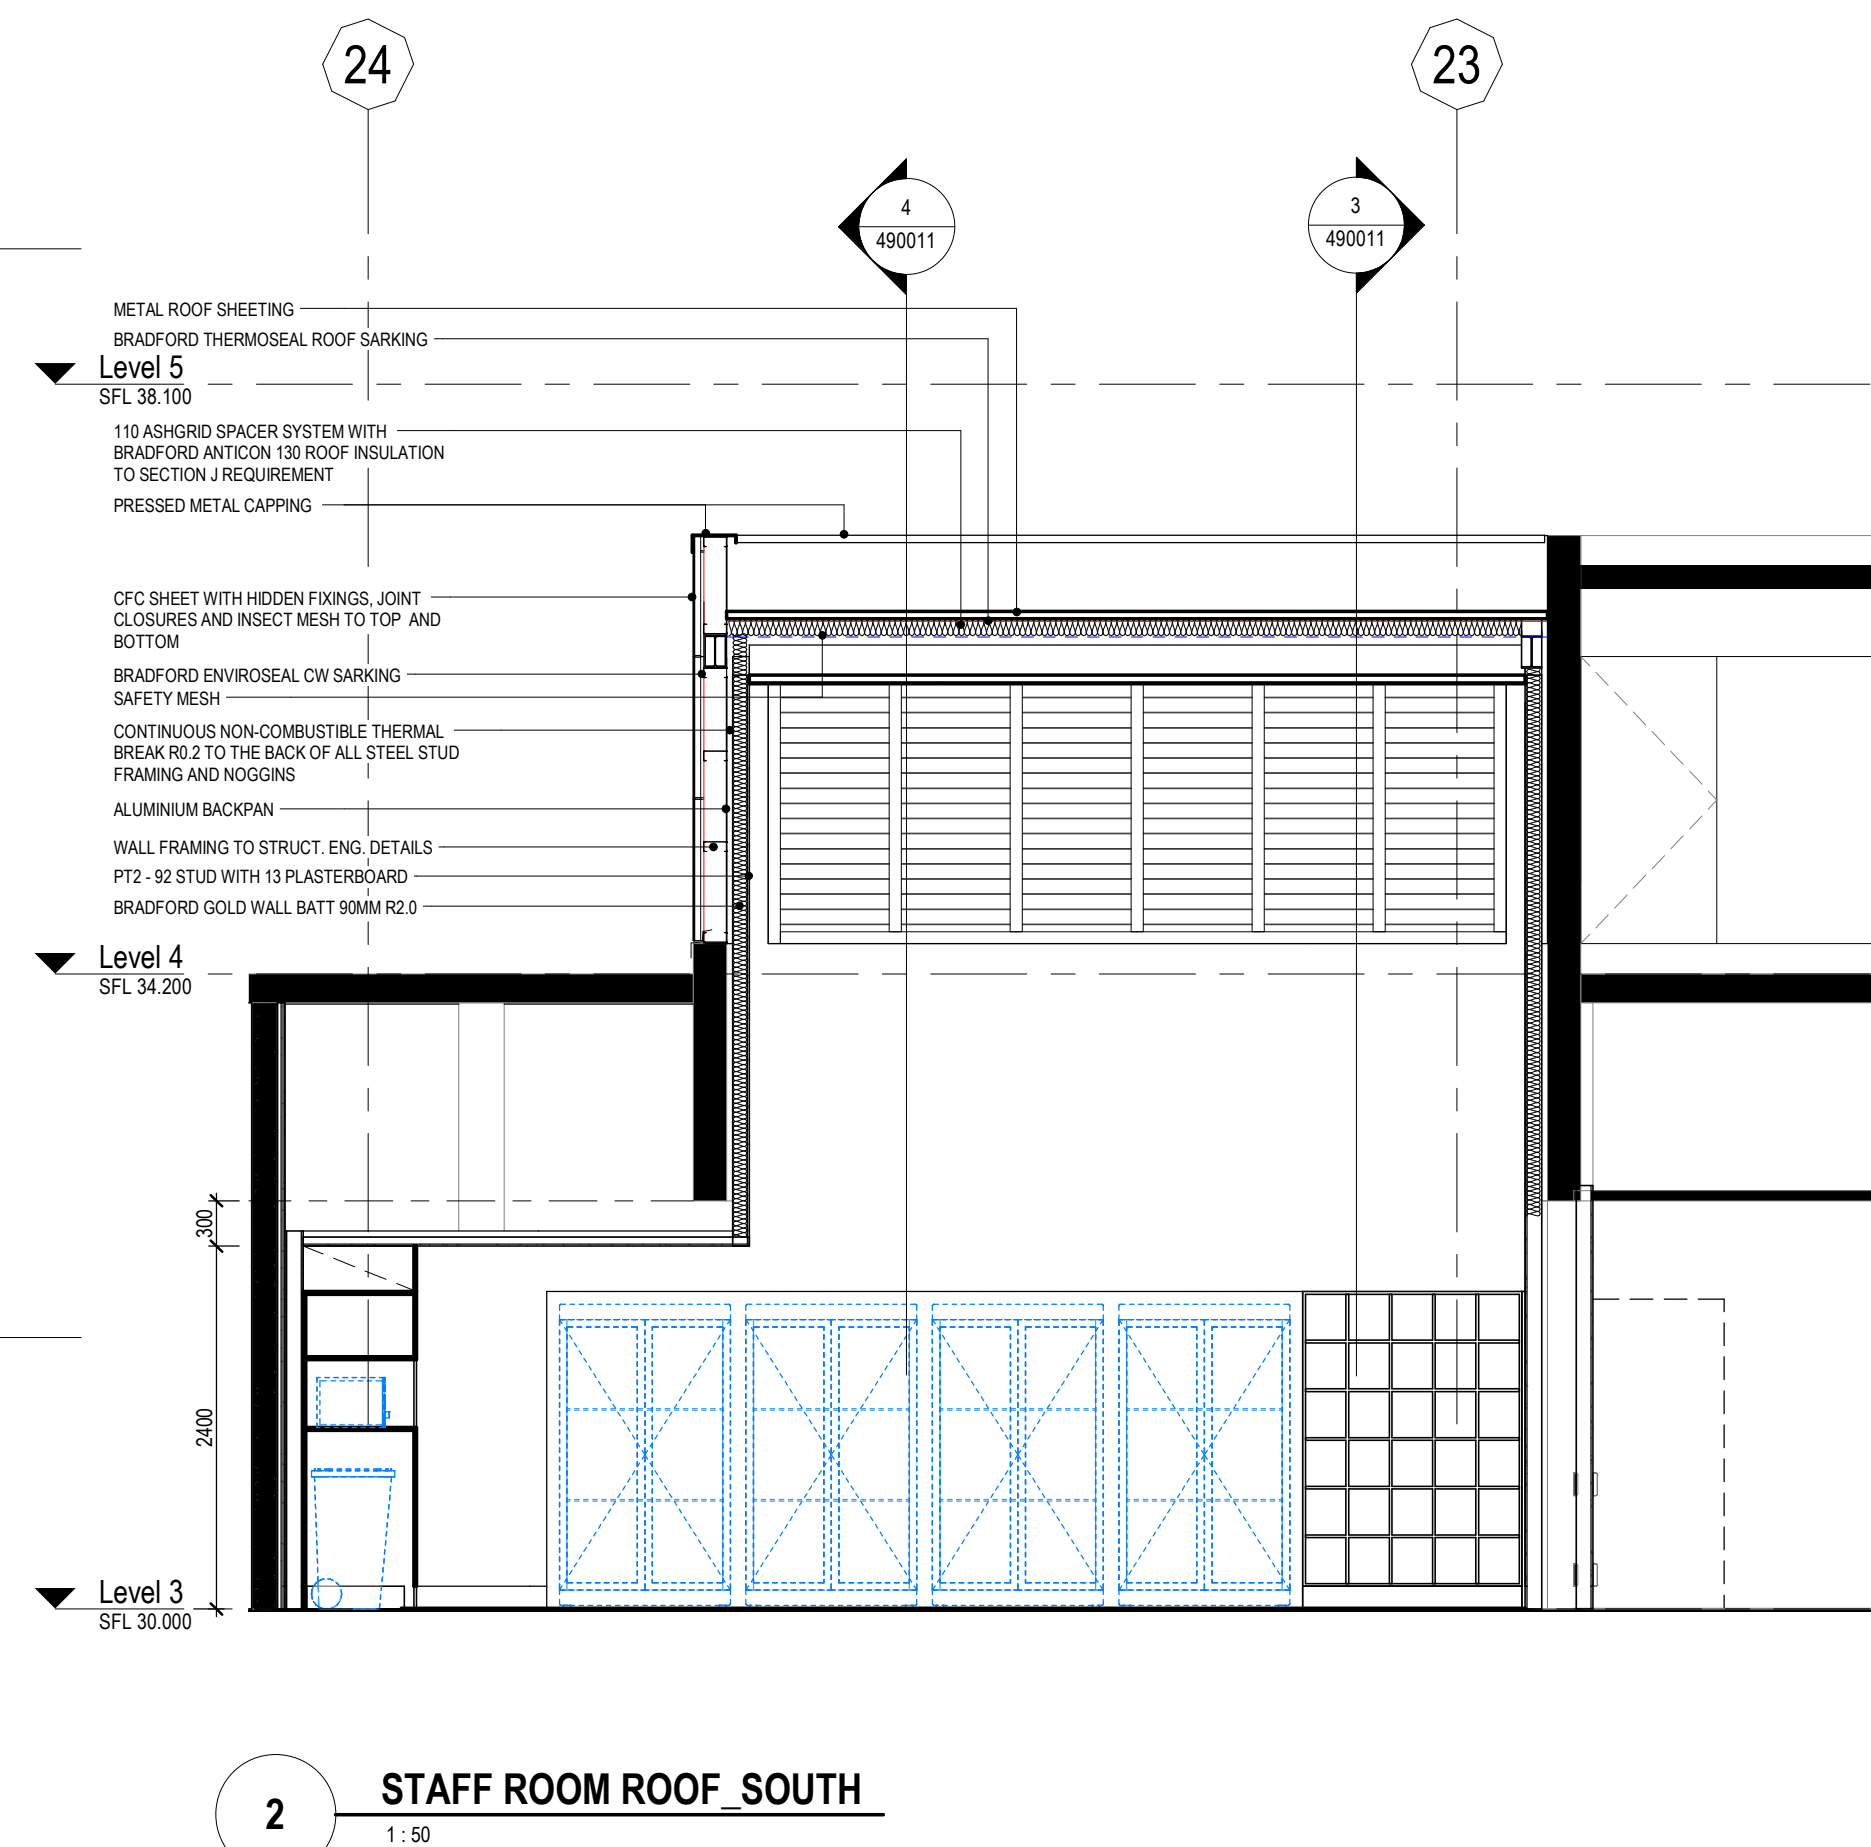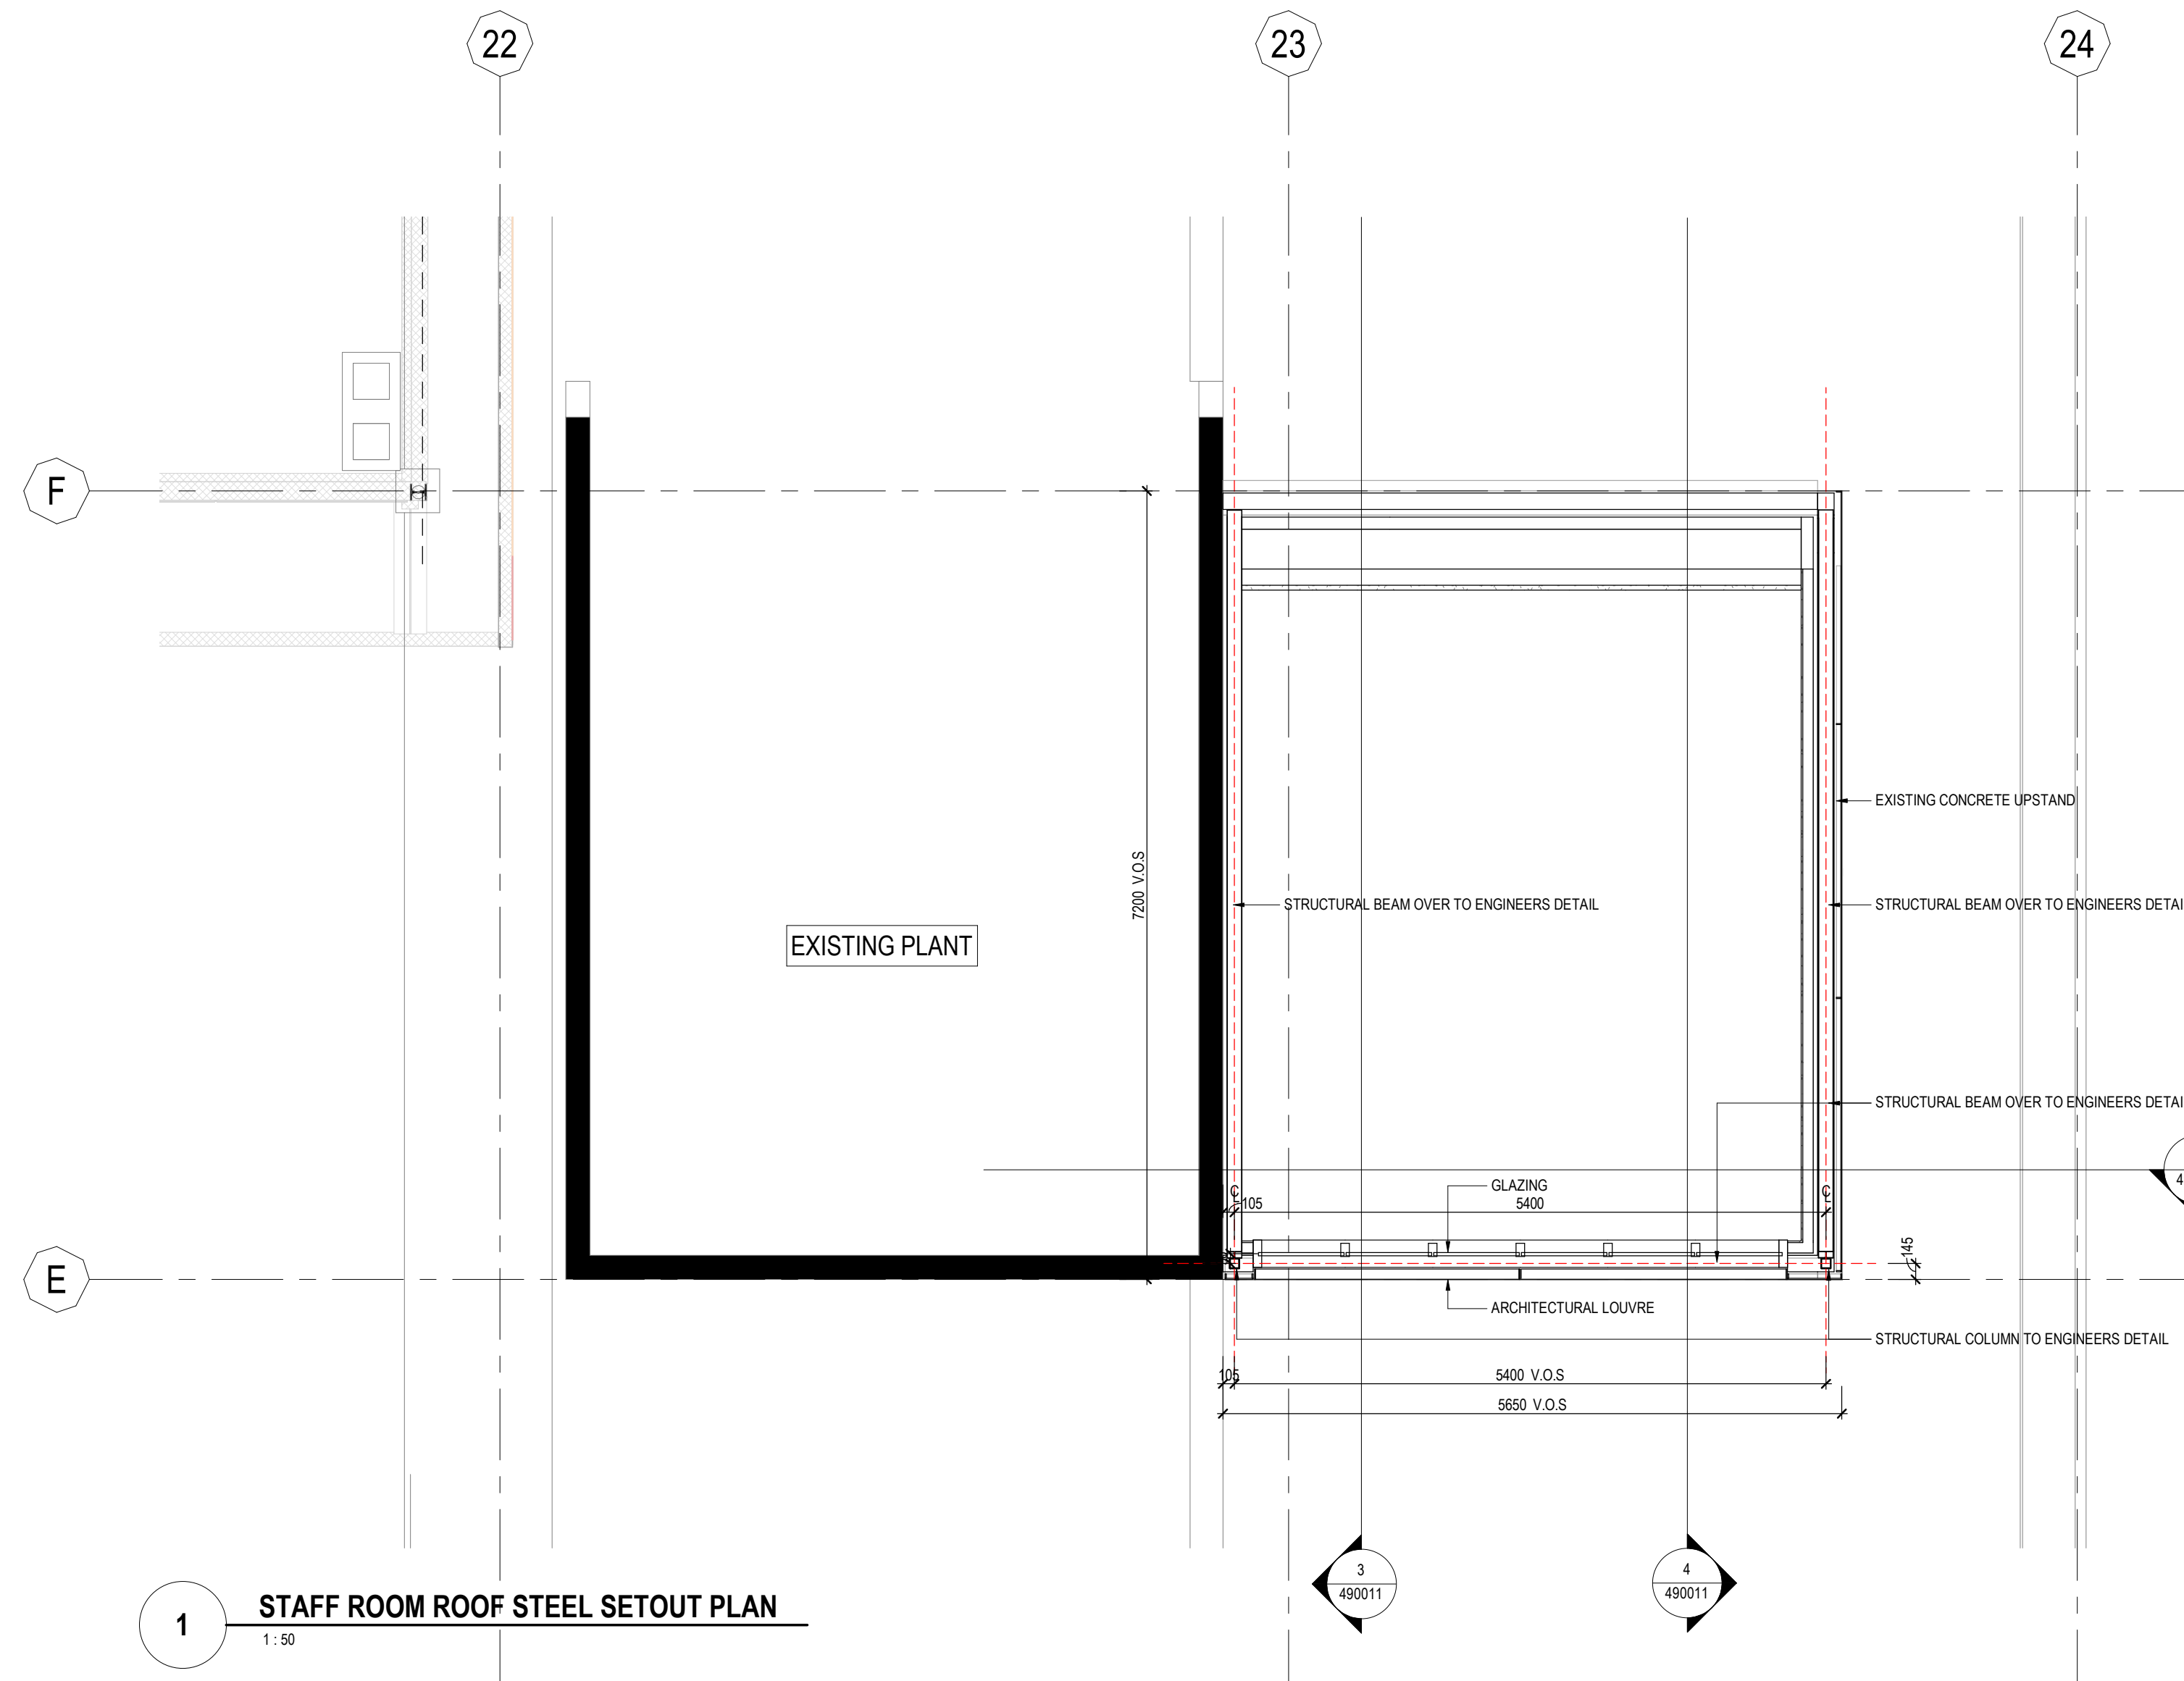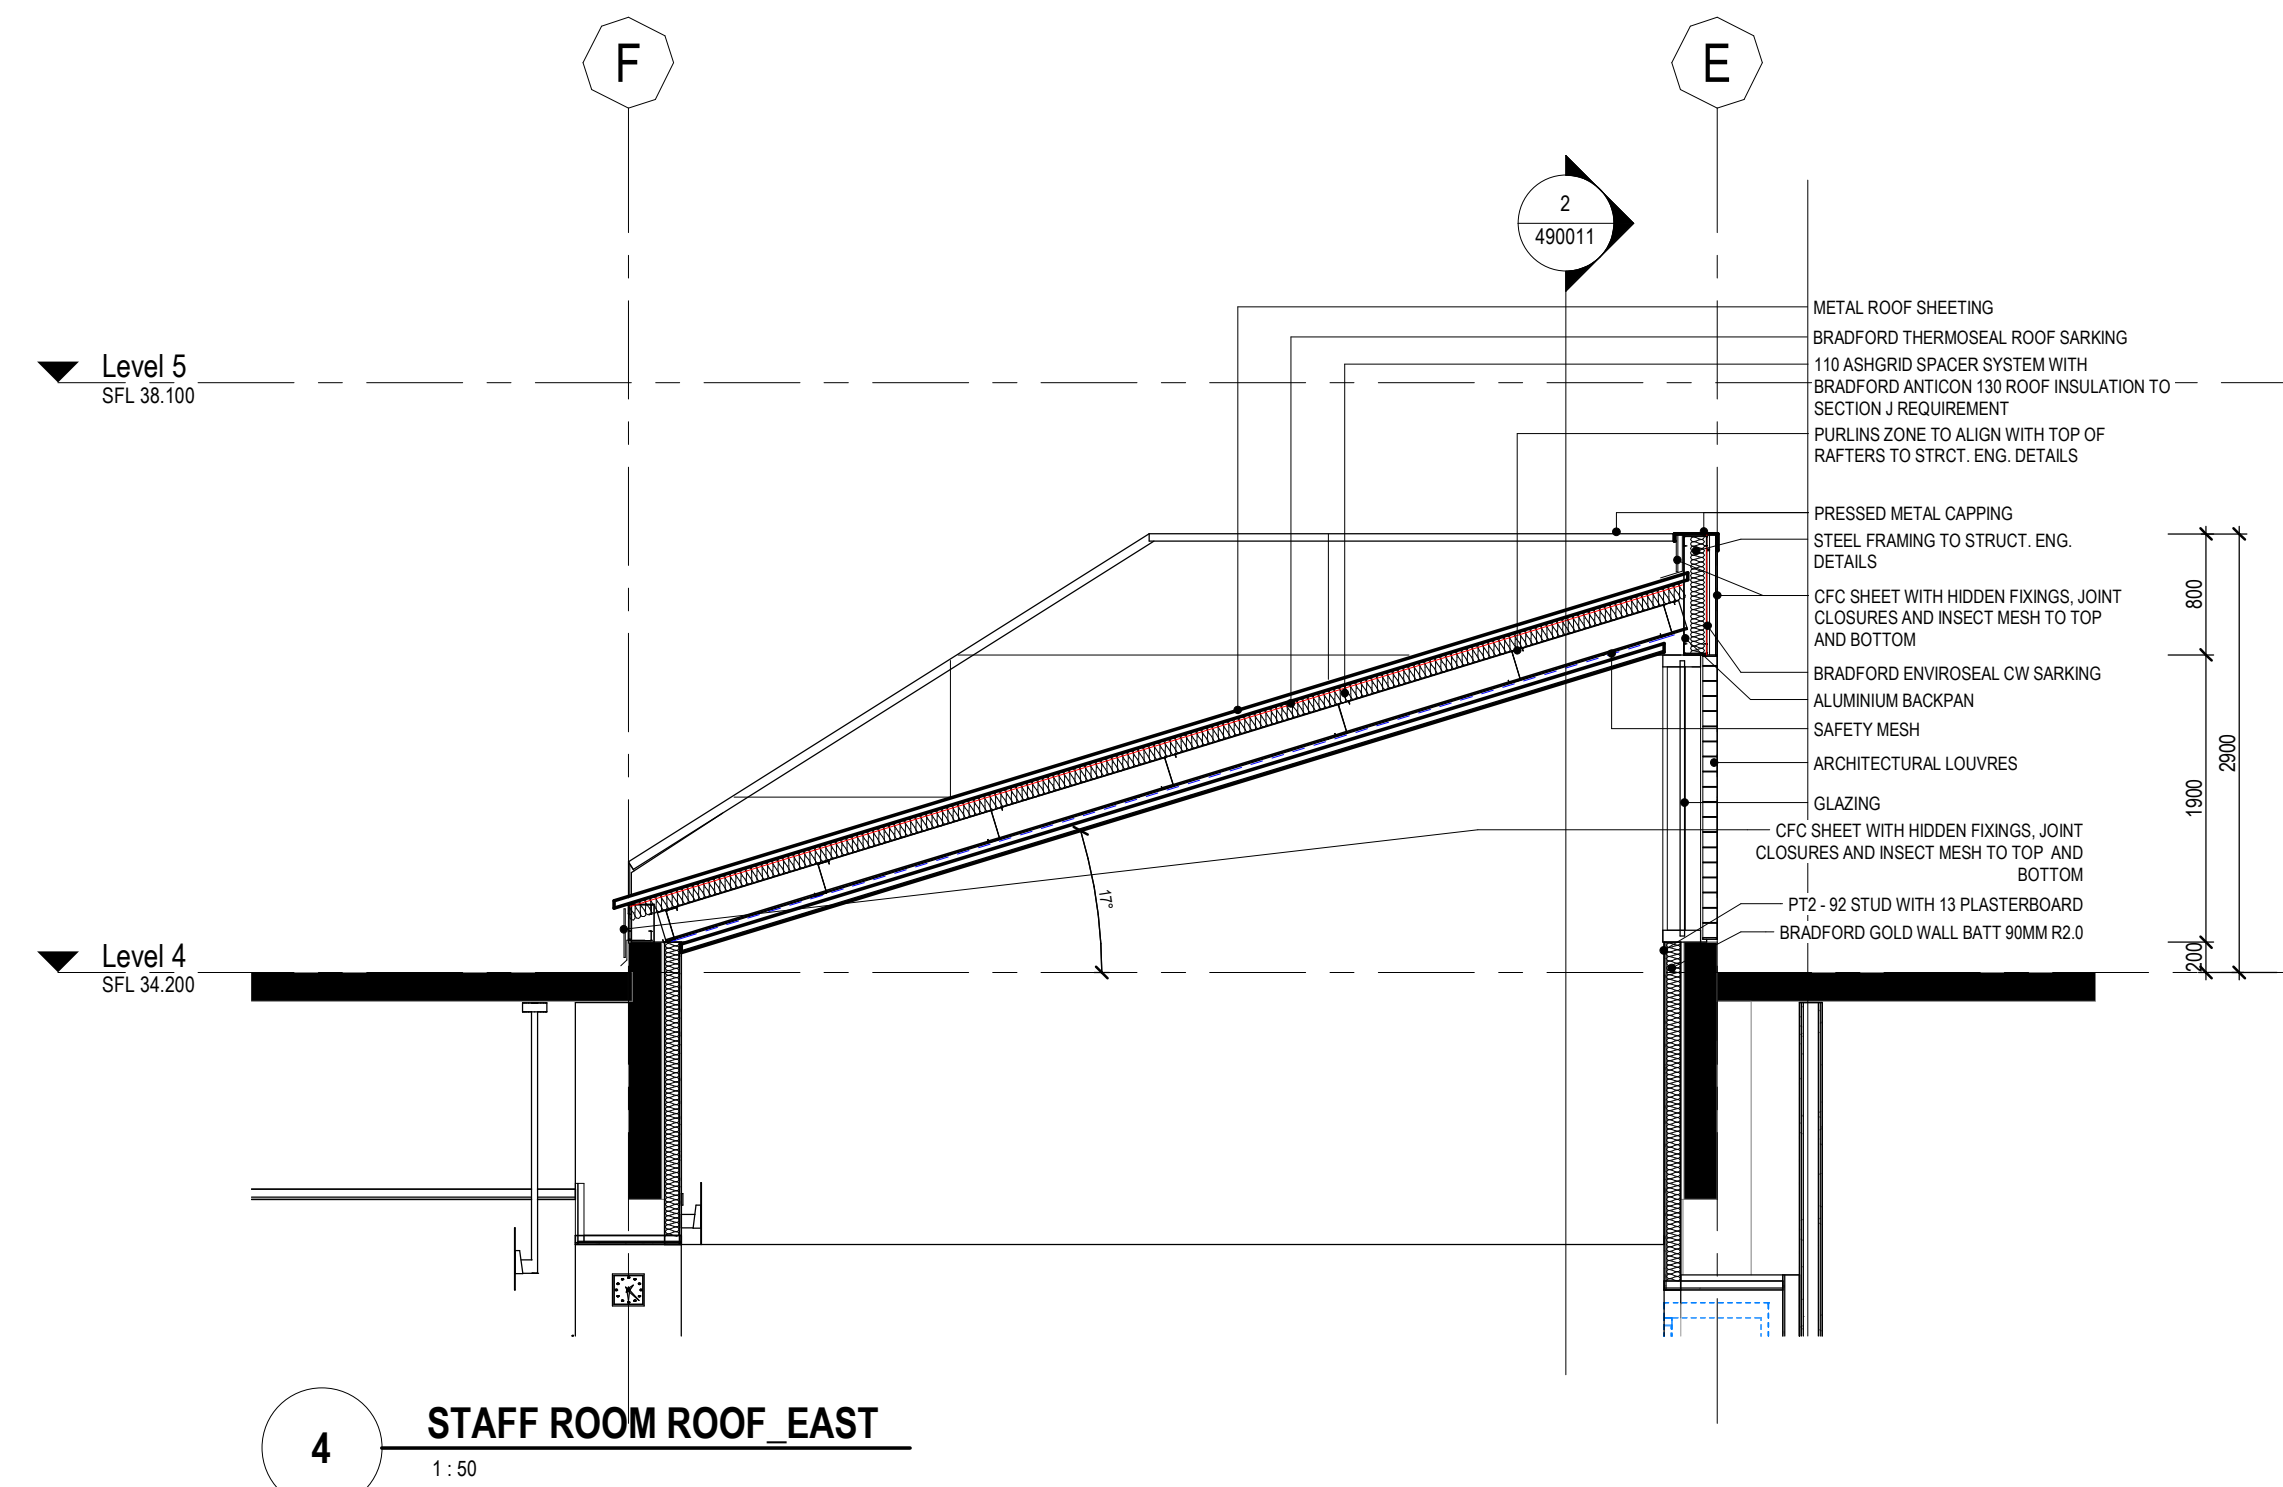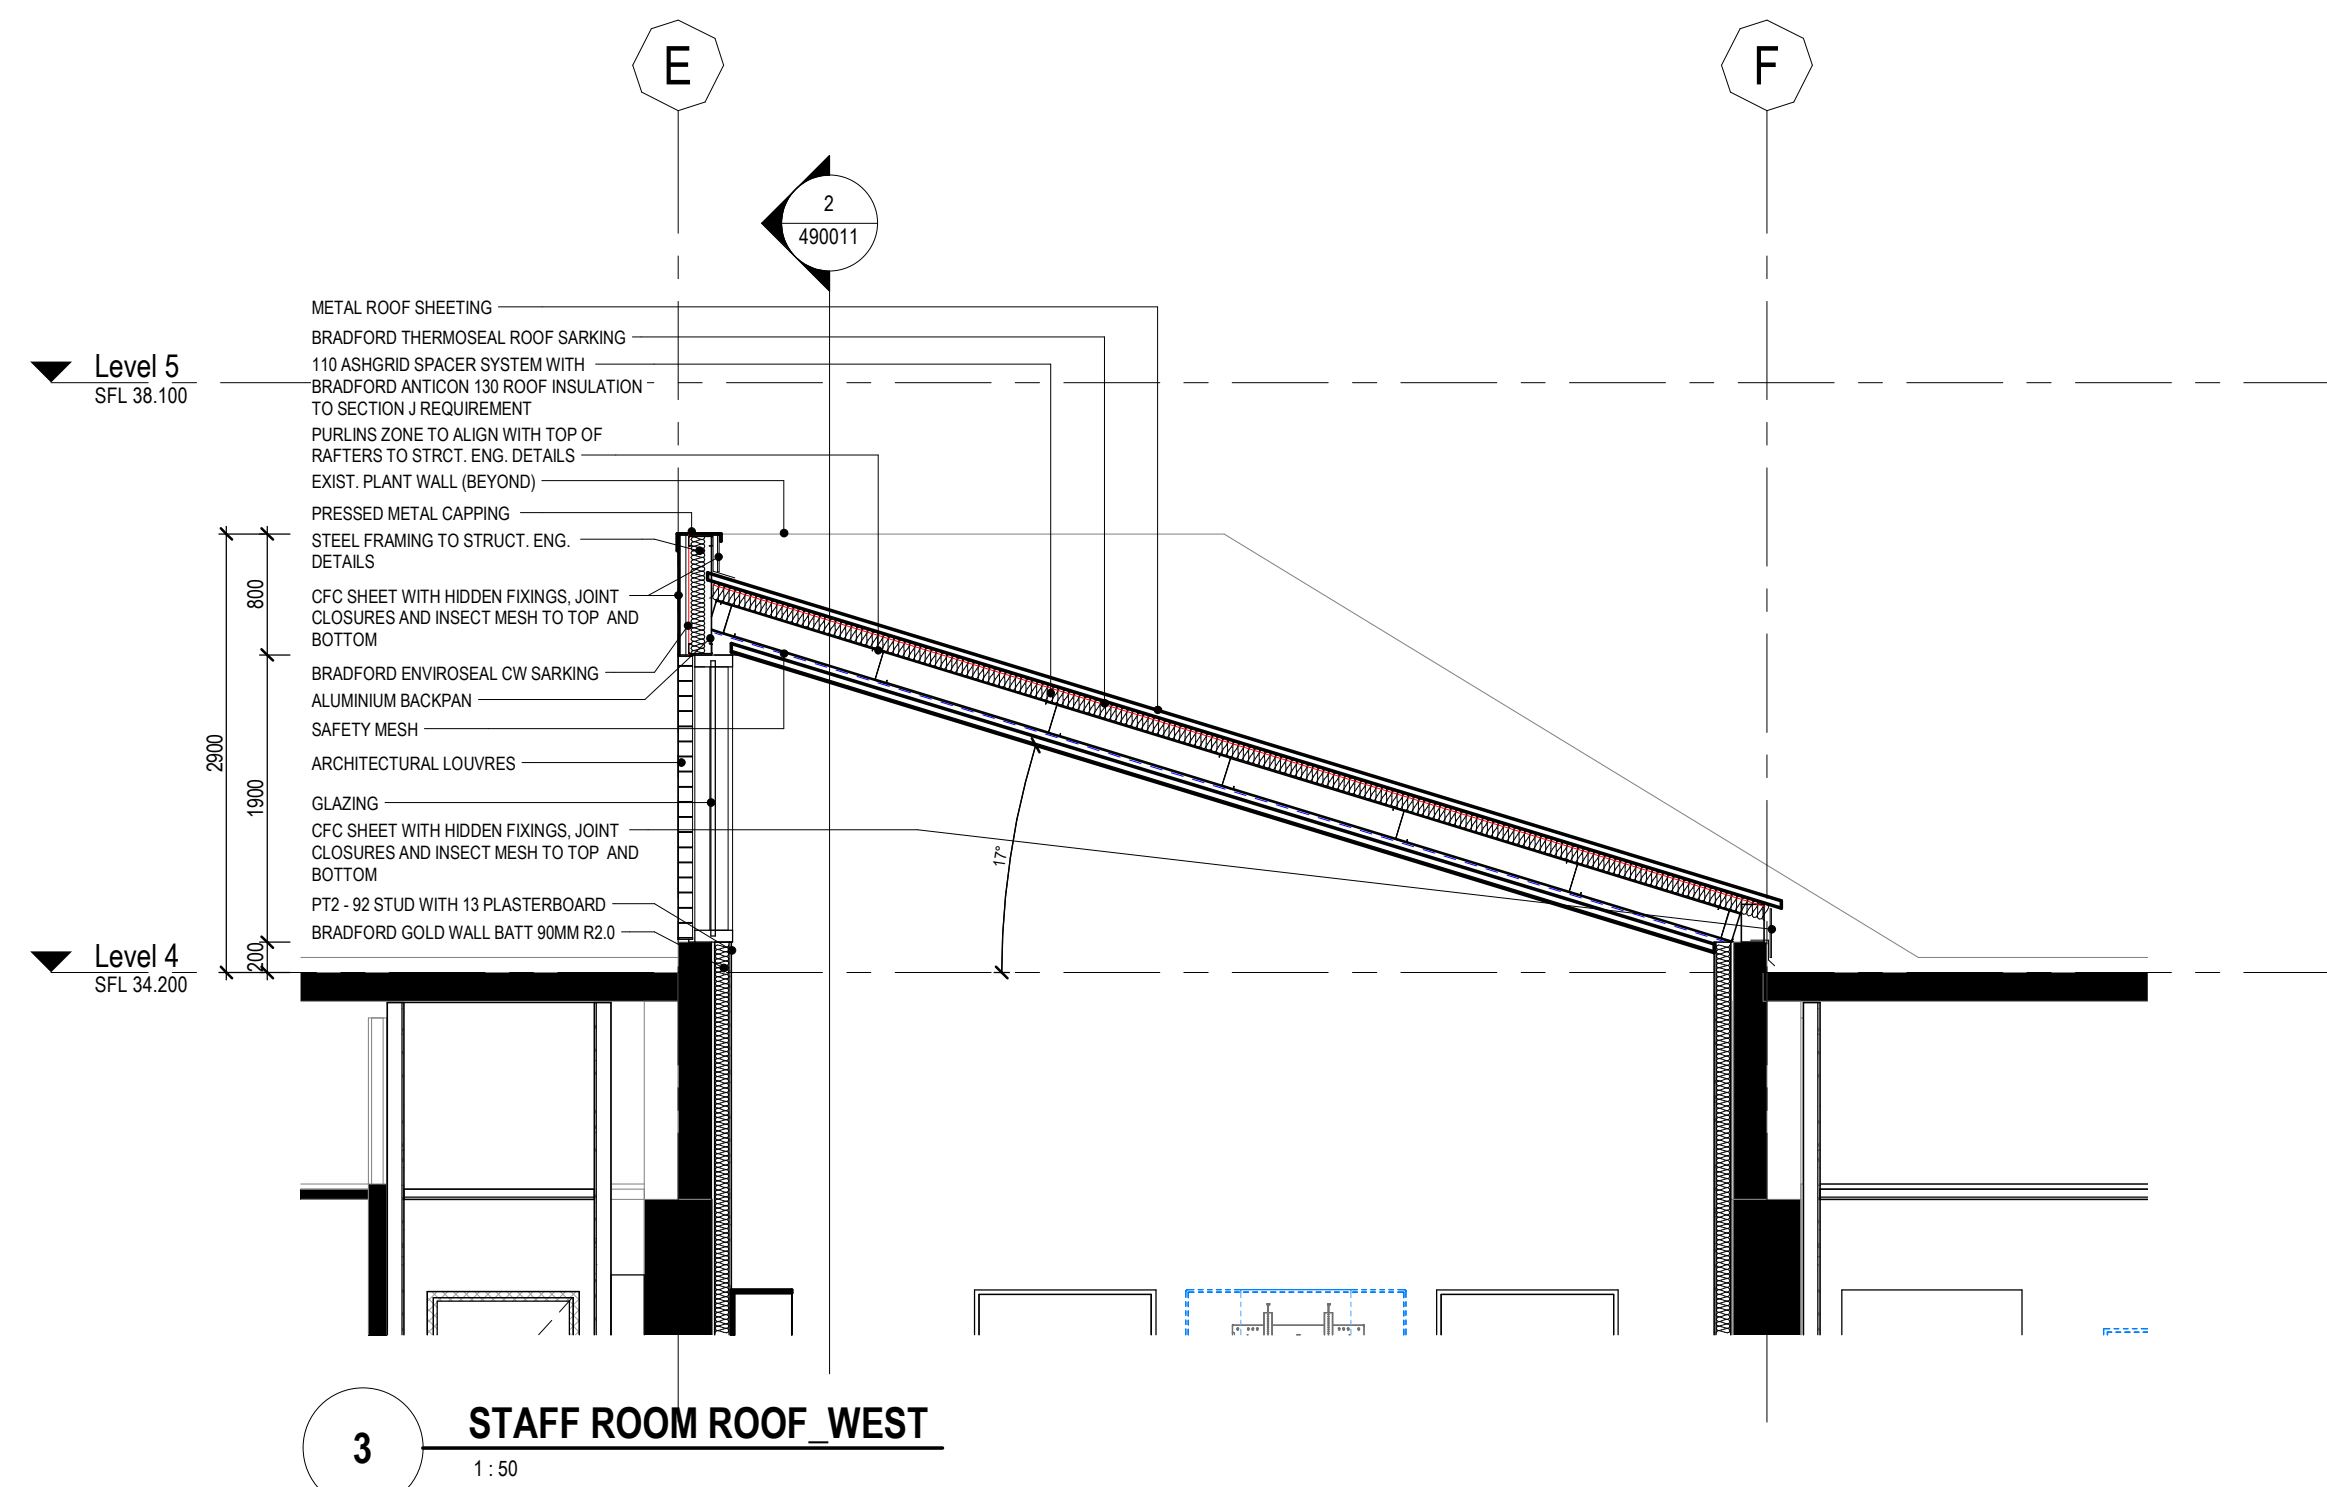

Westmead Redevelopment
Building health. Transforming lives.

ARCHITECT:

HDR

Level 24, 25 Martin Place - Sydney NSW 2000
+61299562666 | hdrinc.com
HDR Pty. Limited ABN 76 158 075 220 trading as HDR

CLIENT:
Level 14, 77 Pacific Highway
North Sydney NSW 2060
P: (02) 9978 5427
F: (02) 8904 1377
www.hinfra.health.nsw.gov.au

 **NSW**
GOVERNMENT

Health
Infrastructure

PROJECT MANAGER:
One International Towers Sydney
Barangaroo NSW 2000
P: (02) 8266 0000
www.pwc.com.au

[illegible]

WESTMEAD HOSPITAL
WMH-HDR-AR-EM-MS1_2_3
Hawkesbury Rd, Westmead, NSW, 2145

PROJECT NUMBER
10324179

Sheet Name
**L4 STAFF ROOM ROOF PLAN &
SECTIONS**

Scale
1 : 50 @ A1

Sheet Number
OAD-WHR-HDR-AR-DG-490011

Project Status
PRELIMINARY-FOR INFORMATION

Revision
3

THIS DOCUMENT IS THE COPYRIGHT OF HDR.
ALL INFORMATION ILLUSTRATED ON THIS DOCUMENT IS TO BE CHECKED AND VERIFIED ON SITE. IN THE
EVENT OF DISCREPANCIES REFER TO ARCHITECT PRIOR TO COMMENCEMENT OF THE WORK. DO NOT
SCALE DRAWINGS MANUALLY OR ELECTRONICALLY.