



26 October 2022

City of Parramatta Council  
PO Box 32  
Parramatta NSW 2124  
Attention: Duty Planner

**RE: Notification of Proposed Activity**  
**The Children's Hospital at Westmead (CHW)**  
***Interactive Piece of Playground Equipment for the Multistorey Car Park Sensory Playground***

To whom it may concern,

Health Infrastructure is proposing to install a sensory playground adjacent to the Multi Storey Carpark at The Children's Hospital Westmead, located at the corner of Hawkesbury Road and Hainsworth Street, Westmead 2145 (Lot 101 DP 1119583).

One item of proposed play equipment (the "Inclusive Spinner") cannot constitute Exempt Development given its proposed height. However, we are required to assess its likely impacts in accordance with Part 5 of the *Environmental Planning and Assessment Act 1979*. In accordance with Section 2.62 of the *State Environmental Planning Policy (Transport and Infrastructure) 2021*, we are notifying Council of our intention to carry out the activity and ask that you provide any comments on the proposal within 21 days from the date of this letter. These comments will then be considered in our assessment of the proposed activity.


For your information, a proposed set out plan, equipment plan, and sensory items plan of the proposed sensory playground are appended. The Inclusive Spinner is marked as "2" on the equipment plan. A data sheet of the Inclusive Spinner is also appended.

If you wish to comment on the proposal, please provide your feedback to Hossein Bidgoli at [hossein.bidgoli@health.nsw.gov.au](mailto:hossein.bidgoli@health.nsw.gov.au) or Health Infrastructure, Attention: Hossein Bidgoli, PO Box 1060, North Sydney, 2059.


Yours sincerely,

Hossein Bidgoli  
Project Director

Attachment A – Location and Extent of Work

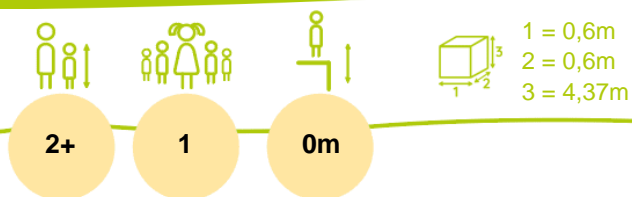

Motor inclusion  
Sensory inclusion  
Mental inclusion

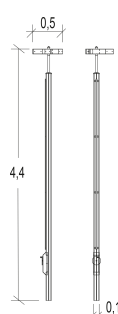

Play value : 5

meeting



x1

handling



x1

thinking



x1

sound  
stimulation




x1

visual  
stimulation



x1


## Components

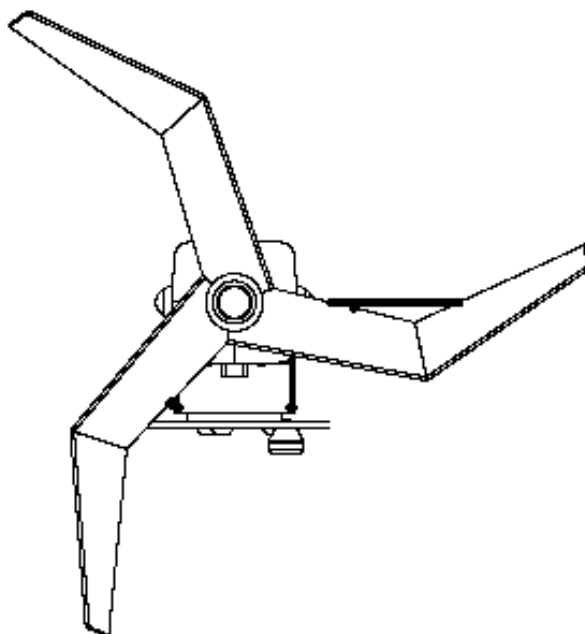

## Installation of equipment

Impact area =

— Impact area  
- - - Free space

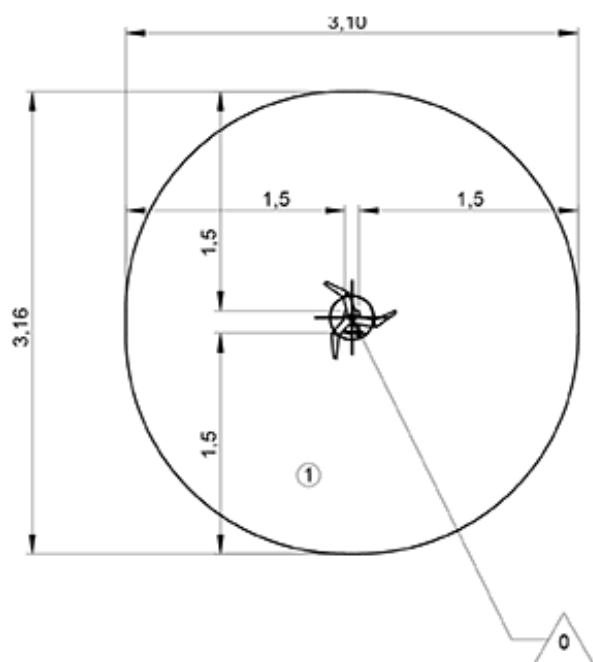

1	0m	8,5m <sup>2</sup>
---	----	-------------------



2

01h00

0.2m<sup>3</sup>

8.5m<sup>2</sup>

46kg


32kg

EN  
1176









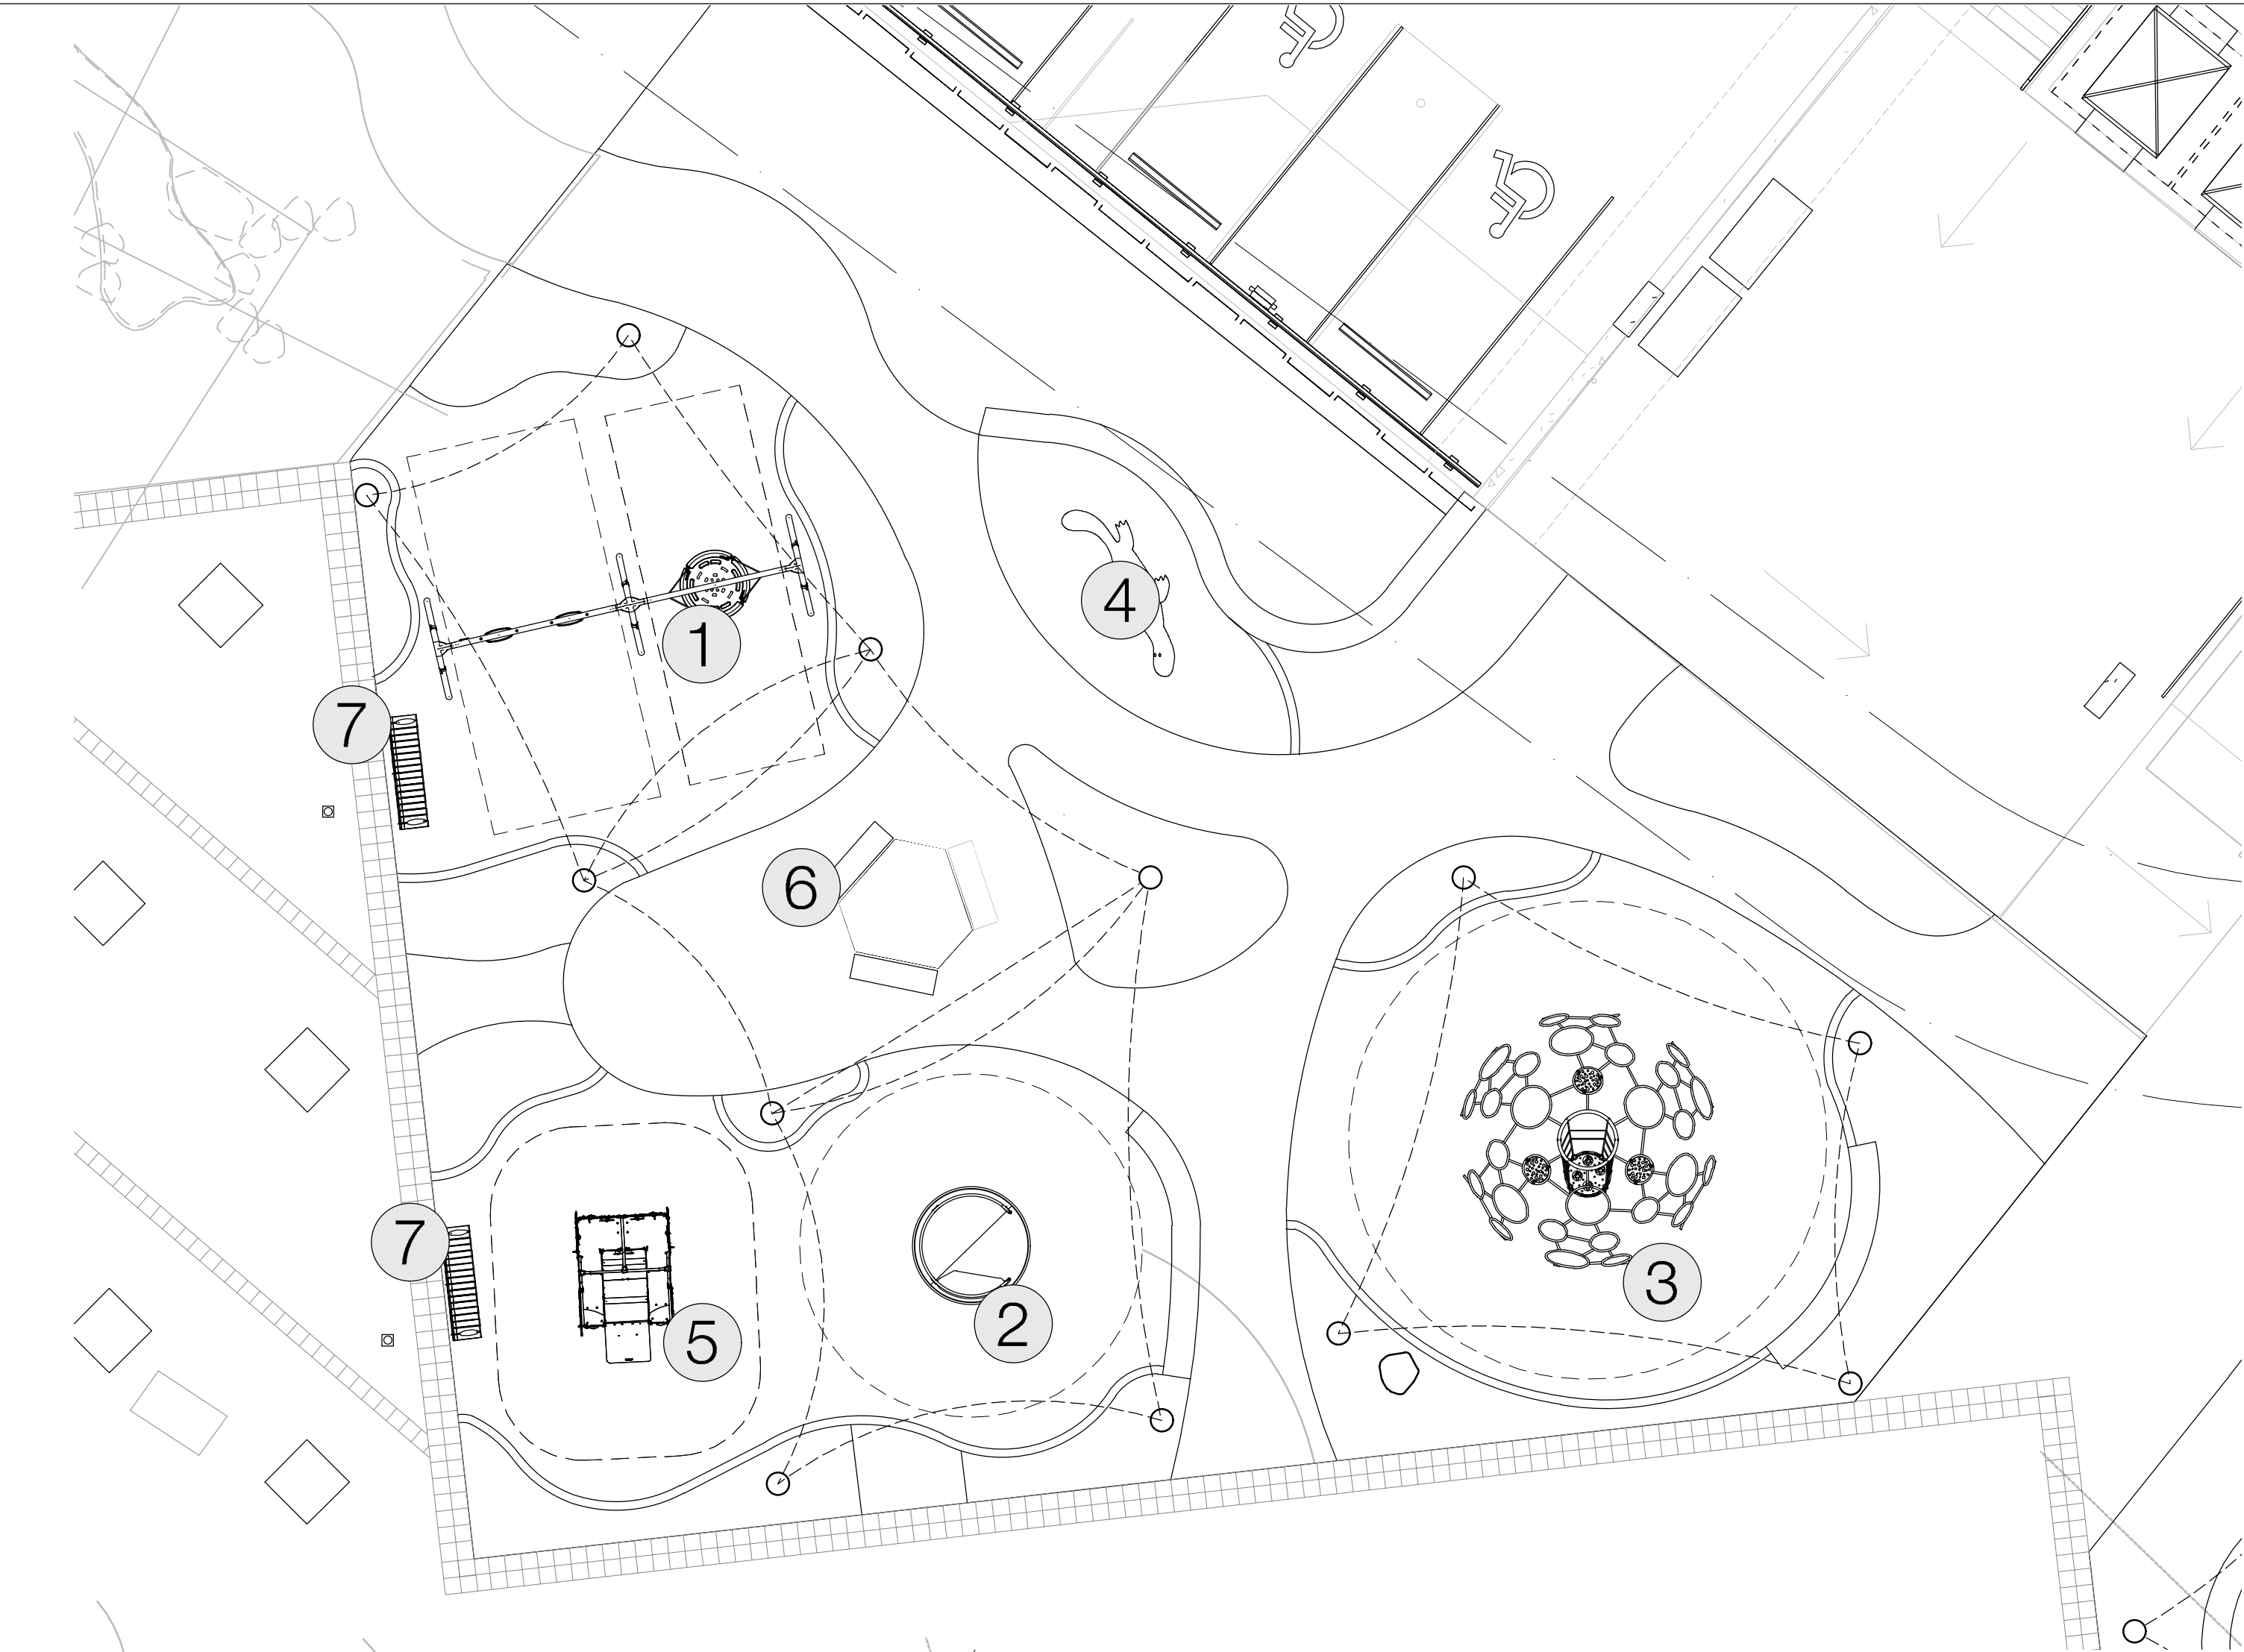


FREESPACE

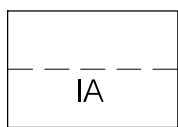

IMPACT AREA

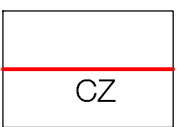


CIRCULATION ZONE

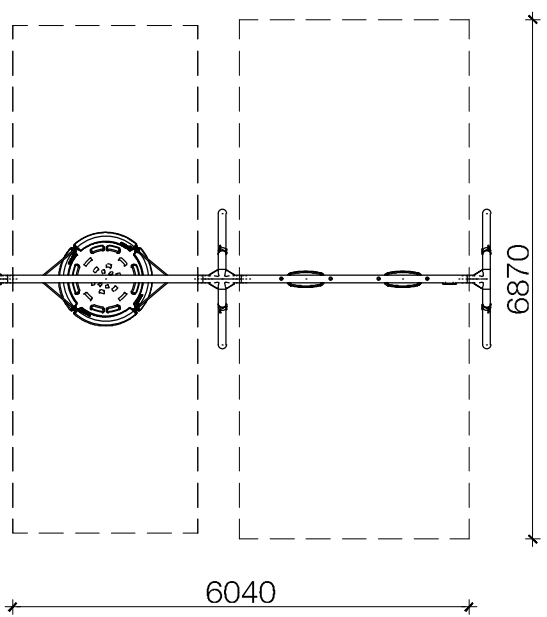

## 1 2 BAY SWING WITH NEST


DETAILED SET-OUT PLAN SCALE 1:100 @ A1  
Product No. KSW924-CUSTOM\_20166351  
Qty:1 FHF: 1.45m  
Manufacturer: Kompan  
Supplier: Play By Design Tel: 0457 787 816  
Swing seats:  
- 1x shell nest SW990091-05 (Kompan)  
- 1x strap seat PN500 (Playworks)  
- 1x all abilities harness PN975 (Playworks)

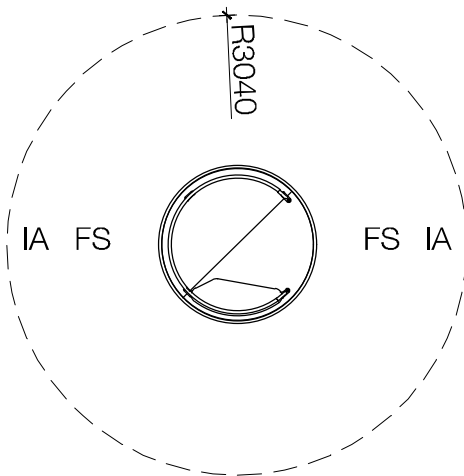

PLAN VIEW


## 2 INCLUSIVE SPINNER

DETAILED SET-OUT PLAN SCALE 1:100 @ A1  
Product No. PCM157 Qty: 1  
FHF: 1.0m  
Manufacturer: Kompan  
Supplier: Play by Design Tel: 0457 787 816

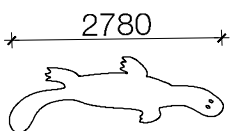

## 4 TIMBER BALANCING

DETAILED SET-OUT SCALE 1:100 @ A1  
Product No. Custom Qty: 1  
Max. FHF: <0.6m  
Manufacturer: Timber Creations  
Supplier: Timber Creations Tel: (02) 4372 1170

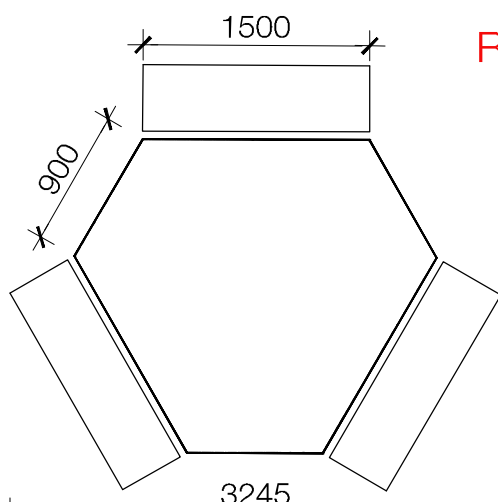


REV D. FURNITURE ADDED

## 6 ACCESSIBLE PICNIC TABLE

PLAN VIEW SCALE 1:50 @ A1





PRODUCT No: CMM605Tri  
MOUNTING: SURFACE FIXED  
BATTEN: ALUMINIUM WOODGRAIN  
SPOTTED GUM/ JARRAH  
FINISH: PALLADIUM SILVER  
MANUFACTURER: STREET FURNITURE AUSTRALIA  
SUPPLIER: STREET FURNITURE AUSTRALIA  
QUANTITY: 1  
TEL: 1300 027 799

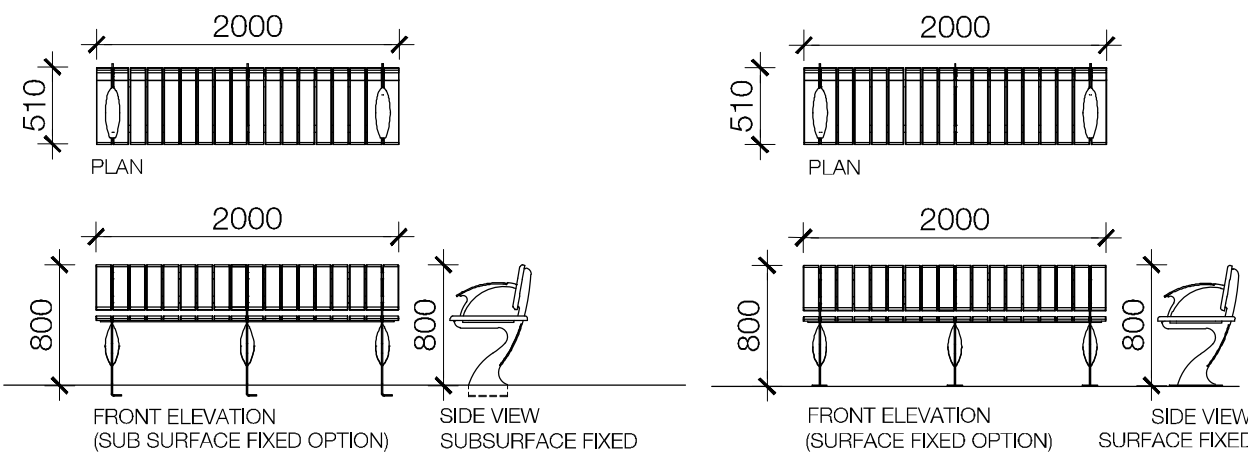

## 7 SEAT WITH ARM AND BACK REST

PLAN/ELEVATION VIEW SCALE 1:50 @ A1




PRODUCT No: ARC-S STRAIGHT (WITH BACK + ARM RESTS)  
MOUNTING: SURFACE FIXED (ON CONCRETE)  
SUBSURFACE FIXED (ON RUBBER)  
BATTEN: JARRAH HARDWOOD  
FINISH: STAINLESS 304 POWDER COATED- PALLADIUM SILVER  
MANUFACTURER: STREET FURNITURE AUSTRALIA  
SUPPLIER: STREET FURNITURE AUSTRALIA  
QUANTITY: 1 x SURFACE FIXED 2 x SUBSURFACE FIXED  
IN TOTAL - 3 TEL:1300 027 799

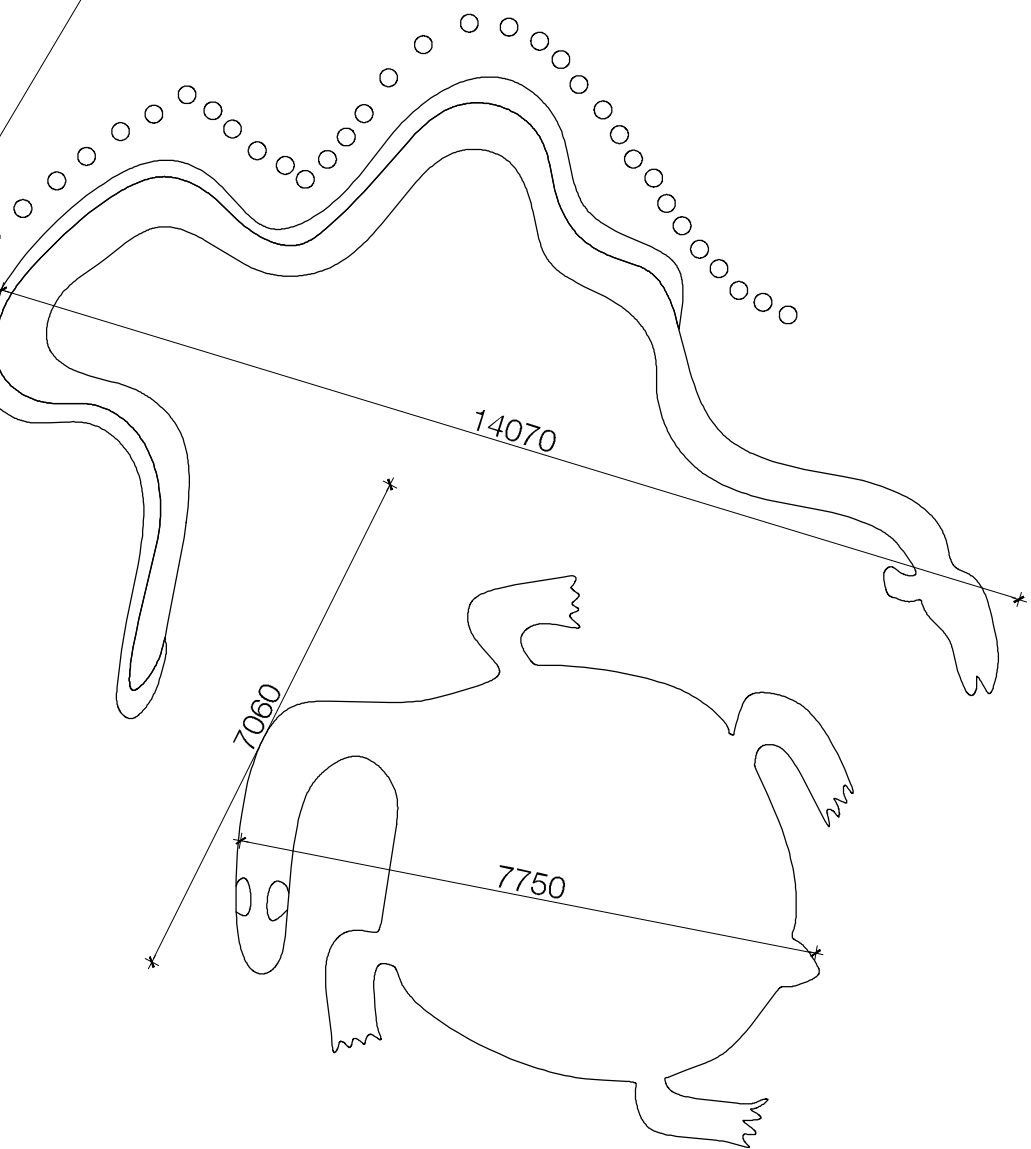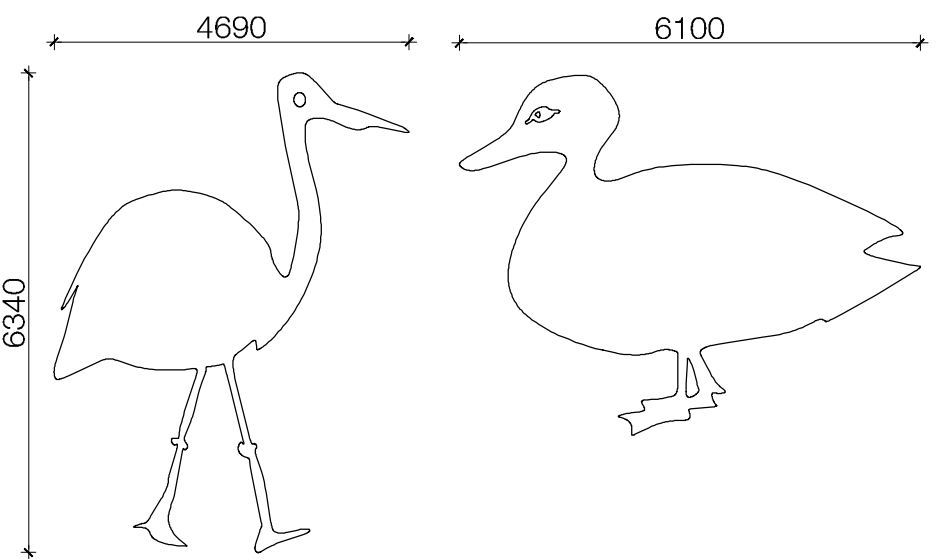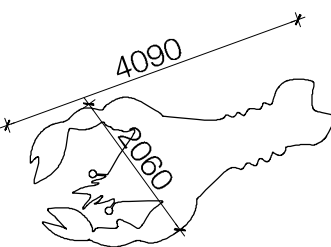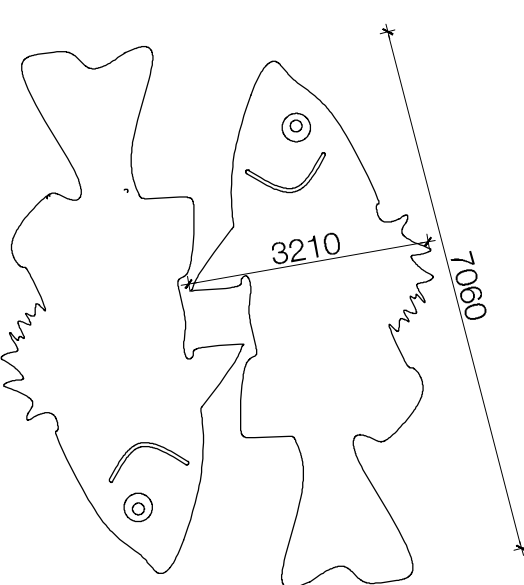

## A ARTWORKS

DETAILED SET-OUT SCALE 1:100 @ A1  
Rubber colours & Paint tbc

REV D. PATTERN REVISED

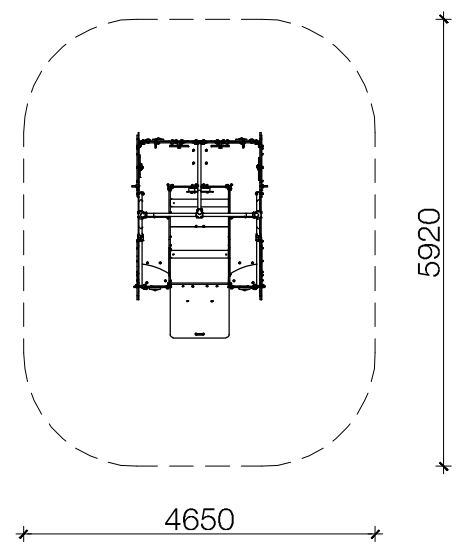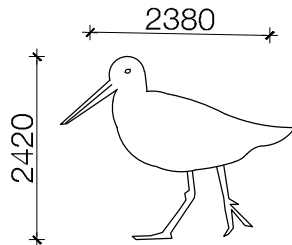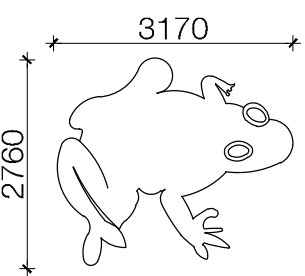

## 5 INCLUSIVE ALL TERRAIN

DETAILED SET-OUT PLAN SCALE 1:100 @ A1  
Product No. J952 Qty:1  
FHF: 0.6m  
Manufacturer: Proludic  
Supplier: Proludic Tel: 0409 748 3442

## 6 PLAY EQUIPMENT AND ITEMS PLAN

SCALE 1:100 @ A1

### Notes


- 1 ALL DIMENSIONS TO BE CHECKED ON SITE PRIOR TO CONSTRUCTION.
- 2 DO NOT SCALE THIS DRAWING
- 3 USE FIGURED DIMENSIONS ONLY
- 4 ALL DIMENSIONS ARE IN MILLIMETRES
- 5 LEVELS ARE IN METRES
- 6 A PERSON USING FIONA ROBBE DRAWINGS AND OTHER DATA ACCEPTS THE RISK OF:  
\* USING THE DRAWING OR OTHER DATA IN ELECTRONIC FORM WITHOUT REQUESTING AND CHECKING THEM FOR ACCURACY AGAINST THE ORIGINAL HARD COPY VERSION;  
\* USING THE DRAWINGS OR OTHER DATA FOR ANY PURPOSE NOT AGREED TO IN WRITING BY FIONA ROBBE.
- 7 WARNING - IF THIS DRAWING HAS BEEN PRINTED FROM A PDF FILE IT MAY NOT BE TO SCALE

### Amendments

A	FOR INFORMATION	3 JUNE 2022
B	UPDATED SWING & SPINNER	24 JUNE 2022
C	Coordination Issue	22 JULY 2022
D	For Construction Issue	10 AUGUST 2022

# CHILDREN'S HOSPITAL WESTMEAD - PLAYGROUNDS

KANE CONSTRUCTIONS

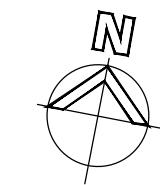

108 Arcadia Road, Arcadia NSW 2159  
Phone: 02 9653 1045

### Client

KANE  
CONSTRUCTIONS

### Project

CHILDREN'S HOSPITAL  
WESTMEAD - PLAYGROUNDS

### Title

EQUIPMENT PLAN

Scale: AS SHOWN

Job number: 2204


Date: 3 JUNE 2022

Drawing number:


LCD-06 D



© Fiona Robbé these drawings are copyright 2022

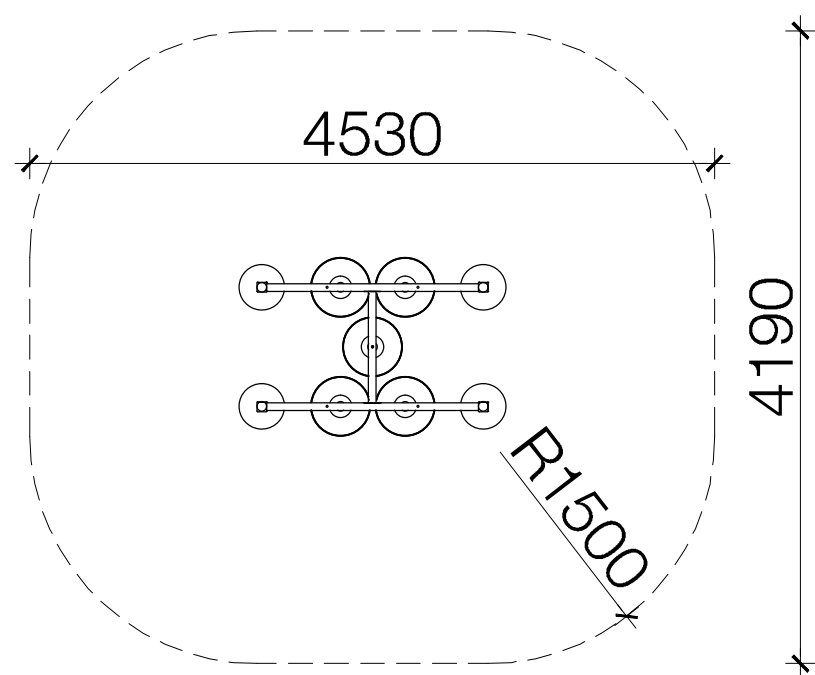


**5 SQUEEZE CYLINDERS (5 cylinders)**  
DETAILED SET-OUT  
Product No. Q1432-09  
Max. FHF: N/A  
Manufacturer: Moduplay  
Supplier: Moduplay  
SCALE 1:50 @ A1  
Qty: 1  
Tel: 4272 1644

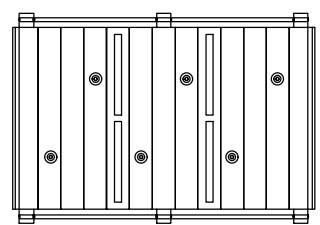


**9 INTERACTIVE 'BRIDGE' WITH SOUNDS (2m)**  
DETAILED SET-OUT  
Product No. Wobbly wood interactive bridge with sound. NO TIMBER POSTS  
Qty: 1  
Max. FHF: N/A  
Manufacturer: Playground Centre  
Supplier: Playground Centre  
SCALE 1:50 @ A1  
Tel: 1800 092 897


**6 SENSORY ITEMS PLAN**  
SCALE 1:100 @ A1

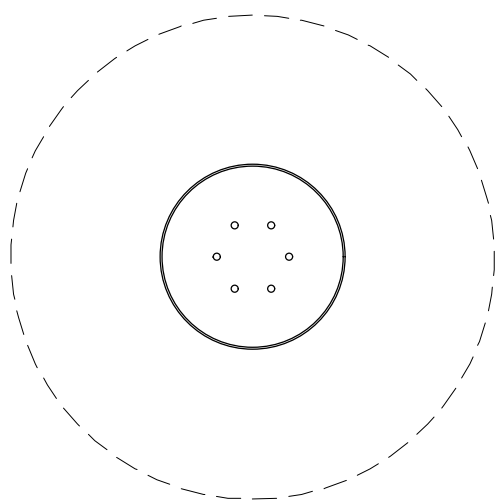


**6 PIPER**  
DETAILED SET-OUT  
Product No. 9.02660  
Max. FHF: N/A  
Manufacturer: Richter Spielgerate  
Supplier: Marcus Constructions  
SCALE 1:50 @ A1  
Qty: 1  
Tel: 0411 836 554

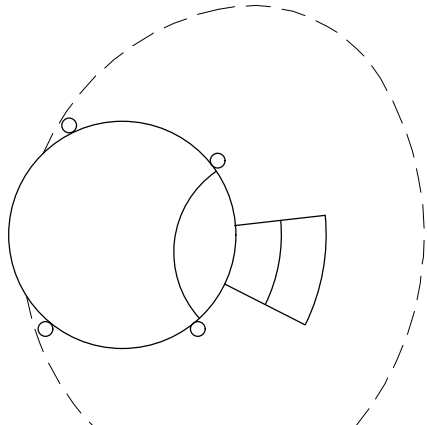


**10 ENCLOSED SEATING**  
DETAILED SET-OUT  
Product No. Custom  
Max. FHF: N/A  
Supplier: Timber Creations  
SCALE 1:50 @ A1  
Qty: 1  
Tel: (02) 4372 1170

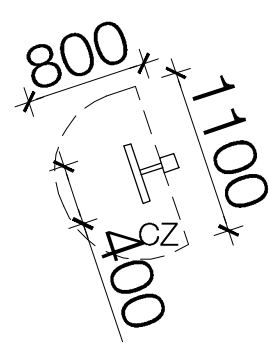


**1 ACCESSIBLE RAIN WHEEL**  
DETAILED SET-OUT  
Product No. Custom  
Qty: 1  
Max. FHF: N/A  
Supplier: Kim Bowman Music  
Tel: 0407 435 794  
SCALE 1:50 @ A1

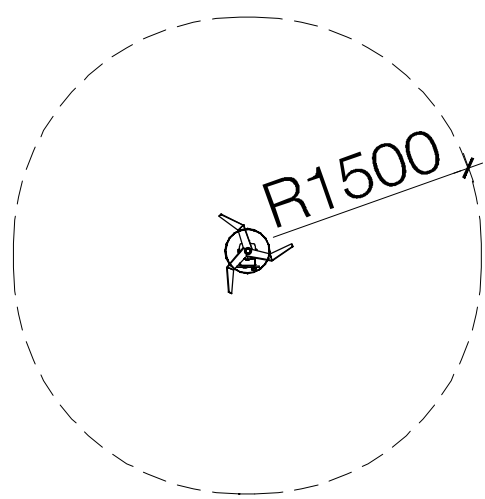

**3 LIGHT UP CHALLENGE**  
DETAILED SET-OUT PLAN  
Product No. J3451-R  
FHF: N/A  
Manufacturer: Proludic  
Supplier: Proludic  
SCALE 1:50 @ A1  
Qty: 1  
Tel: 0409 748 3442

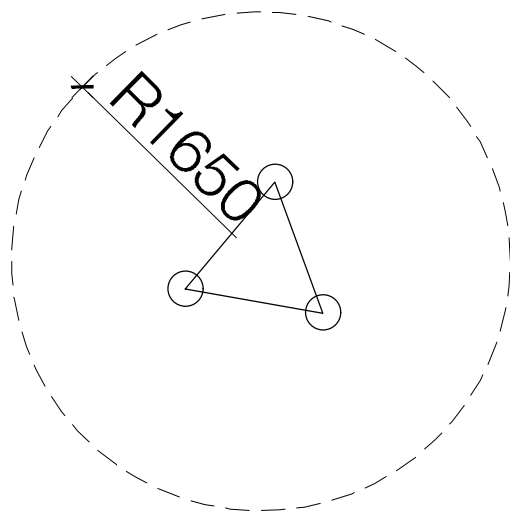


**7 CHIME TOWER**  
DETAILED SET-OUT  
Product No. Custom  
Qty: 1  
Max. FHF: N/A  
Supplier: Kim Bowman Music  
Tel: 0407 435 794  
SCALE 1:50 @ A1

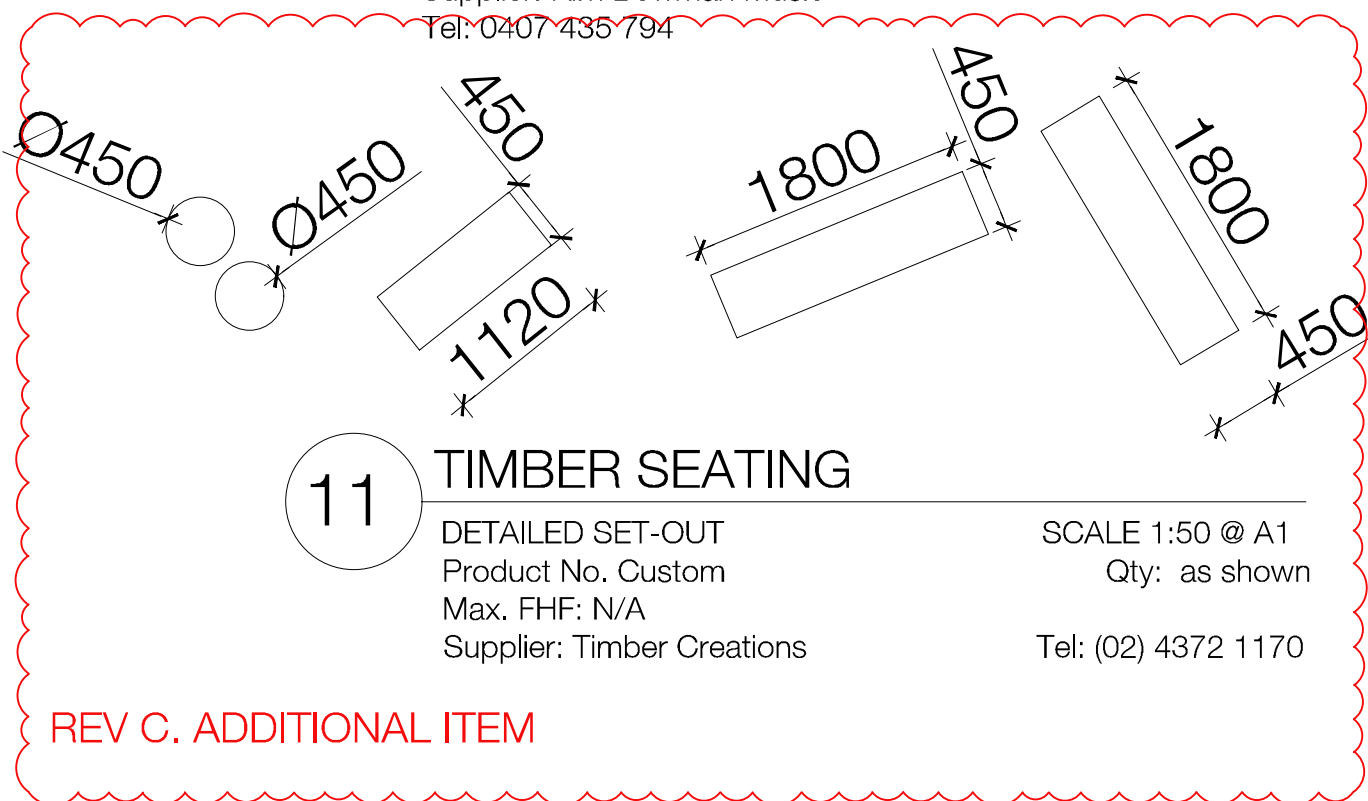


**11 TIMBER SEATING**  
DETAILED SET-OUT  
Product No. Custom  
Max. FHF: N/A  
Supplier: Timber Creations  
SCALE 1:50 @ A1  
Qty: as shown  
Tel: (02) 4372 1170


REV C. ADDITIONAL ITEM

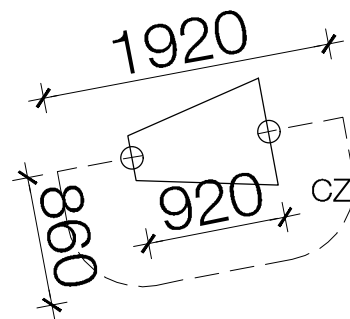


**2 ACCESSIBLE MARIMBA**  
DETAILED SET-OUT  
Product No. Custom  
Qty: 1  
Max. FHF: N/A  
Supplier: Kim Bowman Music  
Tel: 0407 435 794  
SCALE 1:50 @ A1

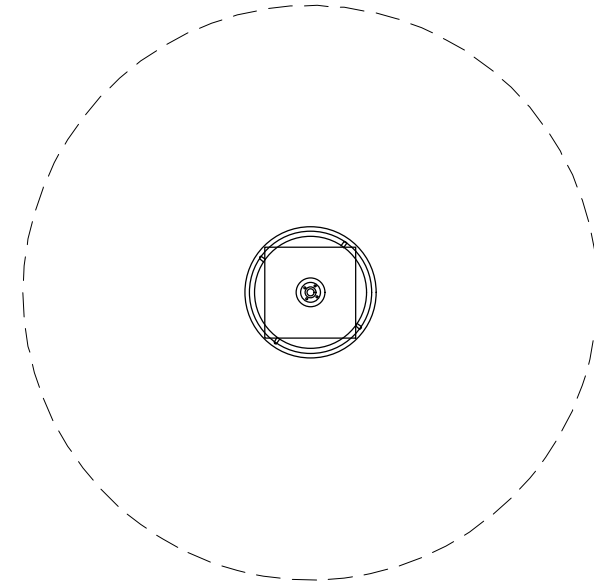

**4 MIRROR ROTUNDA**  
DETAILED SET-OUT  
Product No. 9.10020  
Max. FHF: N/A  
Manufacturer: Richter Spielgerate  
Supplier: Marcus Constructions  
SCALE 1:50 @ A1  
Qty: 1  
Tel: 0411 836 554

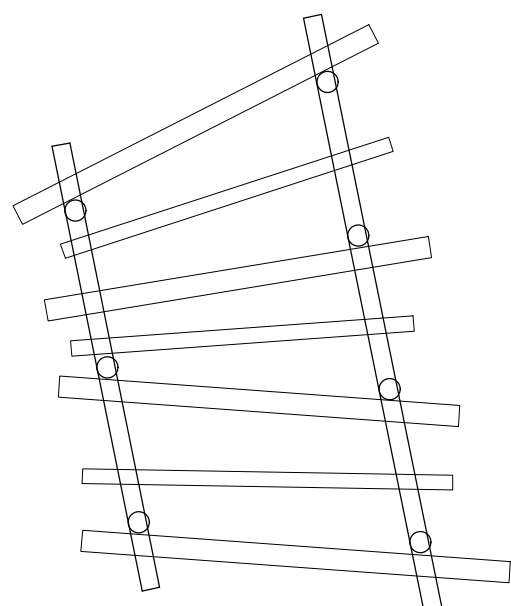

**8 ARBOR**  
DETAILED SET-OUT  
Product No. Custom  
Max. FHF: N/A  
Supplier: Timber Creations  
SCALE 1:50 @ A1  
Qty: 1  
Tel: (02) 4372 1170

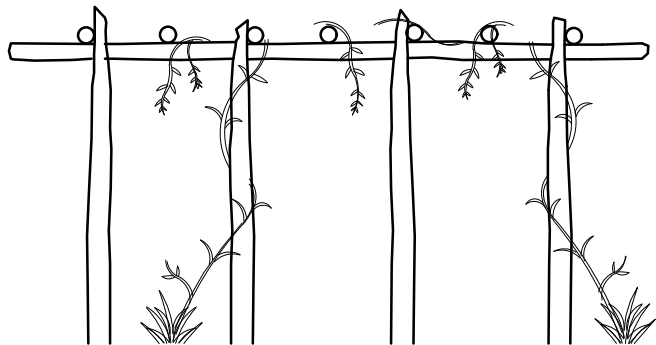

#### Notes


- 1 ALL DIMENSIONS TO BE CHECKED ON SITE PRIOR TO CONSTRUCTION.
- 2 DO NOT SCALE THIS DRAWING
- 3 USE FIGURED DIMENSIONS ONLY
- 4 ALL DIMENSIONS ARE IN MILLIMETRES
- 5 LEVELS ARE IN METRES
- 6 A PERSON USING FIONA ROBBE DRAWINGS AND OTHER DATA ACCEPTS THE RISK OF:  
\* USING THE DRAWING OR OTHER DATA IN ELECTRONIC FORM WITHOUT REQUESTING AND CHECKING THEM FOR ACCURACY AGAINST THE ORIGINAL HAND COPY VERSION;  
\* USING THE DRAWINGS OR OTHER DATA FOR ANY PURPOSE NOT AGREED TO IN WRITING BY FIONA ROBBE.
- 7 WARNING - IF THIS DRAWING HAS BEEN PRINTED FROM A PDF FILE IT MAY NOT BE TO SCALE

#### Amendments

- | A | FOR INFORMATION        |
|---|------------------------|
| B | FOR INFORMATION        |
| C | FOR CONSTRUCTION ISSUE |

#### Date

- | 3 JUNE 2022    |
|----------------|
| 19 JULY 2022   |
| 11 AUGUST 2022 |

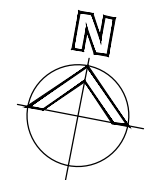

## CHILDREN'S HOSPITAL WESTMEAD - PLAYGROUNDS

KANE CONSTRUCTIONS



108 Arcadia Road, Arcadia NSW 2159  
Phone: 02 9653 1045

#### Client

**KANE  
CONSTRUCTIONS**

#### Project

**CHILDREN'S HOSPITAL  
WESTMEAD - PLAYGROUNDS**

#### Title

**SENSORY ITEMS PLAN**

Scale: AS SHOWN

Job number: 2204

Date: 3 JUNE 2022

Drawing number:

LCD-07

Rev

C