

ST GEORGE HOSPITAL

KOGARAH

SHEET 2	DETAIL AND LEVEL SHEET LAYOUT PLAN
SHEET 3-15	DETAIL AND LEVEL PLANS
SHEET 16-20	ROOF PLANS
SHEET 21	TUNNEL NETWORK, SECTION, ELEVATION AND INTERNAL LAYOUT LOCATION PLAN
SHEET 22-25	TUNNEL NETWORK PLANS
SHEET 26-27	TUNNEL SECTIONS
SHEET 28	TWB SOUTHERN ELEVATION, GRAY STREET CAR PARK SECTION AND PIT DIAGRAMS
SHEET 29	DETENTION TANK DIAGRAMS AND SECTIONS
SHEET 30	GRAY STREET CAR PARK DETAIL AND SECTION
SHEET 31	"TOWER WARD BLOCK" LOWER GROUND
SHEET 32	AST FLOOR PLAN - "TOWER WARD BLOCK" GROUND AND LEVEL 1
SHEET 33	AST FLOOR PLAN - "TOWER WARD BLOCK" LEVEL 2, LEVEL 3 & LEVEL 4
SHEET 34	AST FLOOR PLAN - "CSB" GROUND FLOOR, "SSSD" GROUND FLOOR", "KITCHEN" GROUND FLOOR
SHEET 35	AST FLOOR PLAN - "CSB" LEVEL 1
SHEET 36	AST FLOOR PLAN - "BURT NIELSON WING" LEVEL 1 & LEVEL 2
SHEET 37	AST FLOOR PLAN - "OPERATING THEATRES" ZONE 13 LEVEL 2 FLOOR PLAN "CLINICAL SERVICES BUILDING"
SHEET 38	"PHARMACY" AND "INFILL" GROUND FLOOR DETAIL
SHEET 39-40	"INFILL" BUILDING BASEMENT DETAIL
SHEET 41	CONTOURS PLAN
SHEET 42	TITLING PLAN
SHEET 43	TREE LOCATION PLAN
SHEET 44-48	DETAIL AND LEVEL OF SERVICES PLANS
SHEET 49-52	ELEVATIONS 1A-1G

EASEMENTS

(A) EASEMENT FOR SERVICES AND TO DRAIN WATER (DP 800476)

(B) RESTRICTION AS TO USER (DP 800476)

PROPOSED EASEMENTS

(C) PROPOSED EASEMENT FOR ELECTRICITY AND OTHER PURPOSES 2 & 5 WIDE (AWAITING REGISTRATION)

(D) PROPOSED RIGHT OF CARRIAGEWAY 4.5 WIDE AND VARIABLE (AWAITING REGISTRATION)

NOTES

1) THE BOUNDARIES HAVE NOT BEEN MARKED.

2) ALL AREAS AND DIMENSIONS HAVE BEEN COMPILED FROM PLANS MADE AVAILABLE BY THE OFFICE of LAND & PROPERTY INFORMATION (NSW) AND ARE SUBJECT TO FINAL SURVEY.

3) ORIGIN OF LEVELS ON A.H.D. IS TAKEN FROM **SSM 90255** R.L. **31.776** (A.H.D.) IN **KENSINGTON ROAD** ORIGIN OF COORDINATES HAVE BEEN TAKEN FROM SSM 90255 AND SSM 58680

4) CONTOUR INTERVAL **0.5 m**

5) CONTOURS ARE INDICATIVE ONLY. ONLY SPOT LEVELS SHOULD BE USED FOR CALCULATIONS OF QUANTITIES WITH CAUTION.

6) KERB LEVELS ARE TO THE TOP OF KERB UNLESS SHOWN OTHERWISE.

7) AN INVESTIGATION OF UNDERGROUND SERVICES HAS BEEN MADE. UNDERGROUND SERVICES HAVE BEEN REMOTELY DETECTED BY "DOWN UNDER DETECTION SERVICES" AND ARE APPROXIMATE ONLY. TECHNIQUES EMPLOYED ARE GROUND PENETRATING RADAR AND ELECTROMAGNETIC INDUCTION. SOME SERVICES SUCH AS FIRE & WATER SUPPLY, GAS AND OPTICAL FIBRE CABLING DO NOT HAVE METALLIC TRACING WIRES OR METAL PIPES AND MAY NOT HAVE BEEN DETECTED. 'DIAL BEFORE YOU DIG' ENQUIRY 7213519 OF 12/03/2014 HAS BEEN USED AS A REFERENCE SOURCE FOR UNDERGROUND SERVICES WITHIN THE EXTERNAL ROAD RESERVES. AS SUCH THESE SERVICES WITHIN THE ROAD RESERVES HAVE NOT BEEN ELECTRONICALLY DETECTED AND ARE IN MOST CASES DIAGRAMMATIC ONLY.

8 8/4/7 DENOTES TREE SPREAD OF 8m, TRUNK DIAMETER OF 0.4m & APPROX HEIGHT OF 7m.

9) SERVICES WITHIN THE CONSTRUCTION FOOTPRINT OF THE NEW EMERGENCY DEPARTMENT HAVE BEEN DRAWN USING DESIGN DRAWINGS ONLY. THESE SERVICES HAVE NOT BEEN LOCATED OR SURVEYED.

10) LEGEND NOTE: THIS UNDERGROUND OR INTERNAL SERVICE HAS NOT BEEN LOCATED DUE TO INACCESSIBILITY. LOCATION DIAGRAMS, PLANS AND SKETCHES SUPPLIED BY RELEVANT CONSULTANTS OR AUTHORITIES HAVE BEEN USED TO ILLUSTRATE THE INTERCONNECTIVITY BETWEEN THE MAJOR SERVICE HUB WITHIN EACH BUILDING AND THE POINT AT WHICH THE SERVICE EXITS THE BUILDING OR THE ASSUMED CONNECTIONS BETWEEN EXTERNAL UNDERGROUND SERVICES.

11) LEGEND NOTE: THIS UNDERGROUND OR INTERNAL SERVICE HAS NOT BEEN LOCATED DUE TO INACCESSIBILITY. LOCATION DIAGRAMS, PLANS AND SKETCHES SUPPLIED BY RELEVANT CONSULTANTS OR AUTHORITIES HAVE BEEN USED TO ILLUSTRATE THE ASSUMED CONNECTIONS TO EXTERNAL UNDERGROUND SERVICES.


LEGEND

BENCH MARK		ELECTRICITY (OVERHEAD OR INTERNAL)	
TELSTRA PIT		ELECTRICITY (U'GROUND)	
ELECTRIC LIGHT POLE		ELECTRICITY (U'GROUND) DISUSED	
ELECTRICITY BOX		ELECTRICITY HIGH VOLTAGE (U'GROUND)	
METAL LIGHT POLE		ELECTRICITY HIGH VOLTAGE (NOT SURVEYED SEE NOTE 10)	
POWER POLE		ELECTRICITY LOW VOLTAGE (U'GROUND)	
TRAFFIC LIGHT		ELECTRICITY LOW VOLTAGE (NOT SURVEYED SEE NOTE 10)	
STREET SIGN		ELECTRICITY (NOT SURVEYED SEE NOTE 10)	
GRADED INLET PIT		ELECTRICITY (U'GROUND) (DETECTED)	
KERB INLET PIT		WATER	
FIRE HYDRANT		WATER (DETECTED)	
DRAINAGE PIT		STORMWATER	
SEWER INSPECTION POINT		STORMWATER (CCTV)	
LAMP HOLE		DRAINAGE	
SEWER MANHOLE		STORMWATER (NOT SURVEYED SEE NOTE 10)	
STOP VALVE		STORMWATER	
HYDRANT		SEWER	
WATER METER		SEWER (CCTV)	
WATER TAP		TRADE WASTE (NOT SURVEYED SEE NOTE 10)	
WATER VALVE		SEWER (NOT SURVEYED SEE NOTE 10)	
IRRIGATION CONTROL VALVE		SEWER (DETECTED)	
GAS VALVE		FIRE MAIN	
GAS METER		FIRE SPRINKLER	
MICROWAVE TRANSMITTER		RADIO	DRY FIRE (NOT SURVEYED SEE NOTE 11)
WIND SOCK		WSOCK	FIRE HYDRANT (NOT SURVEYED SEE NOTE 11)
NOT DETECTED	(ND)	RISING MAIN	
VEHICLE CROSSING		TRENCH LINE	
PRAM CROSSING		CONDENSATE	
GAS		STEAM	
TELSTRA		UNKNOWN SERVICE	
OPTUS		MECHANICAL_ACETYLENE	
OPTIC FIBRE		MECHANICAL_BREATHINAIR	
OPTIC FIBRE (NOT SURVEYED SEE NOTE 10)		MECHANICAL_CHILLED	
VOICE		MECHANICAL_CO2	
VOICE (NOT SURVEYED SEE NOTE 10)		MECHANICAL_HPTOOL AIR	
COMMUNICATION		MECHANICAL_HYDROGEN	
COMMUNICATION (DETECTED)		MECHANICAL_MEDOOXYGEN	
		MECHANICAL_NITROGEN	
		MECHANICAL_PROPANE	

Y	05/07/21	ELEVATIONS ADDED SHEETS 49-52	026	E	22-9-11	ADDITIONAL DETAIL & LEVEL AND PIPE VIDEO DETECTION (CCTV) - STORMWATER	34344	D	09-9-11	ADDITIONAL DETAIL & LEVEL	34305	THIS IS THE PLAN REFERRED TO IN MY LETTER DATED: Registered Surveyor NSW	 Registered Surveyors NSW www.ltsl.com.au	Suite 1, Level 1 810 Pacific Highway Gordon NSW 2072 Locked Bag 5 Gordon NSW 2072 P 1300 587 000 F 02 9499 7760	Client HEALTH INFRASTRUCTURE	Drawing title PLAN OF DETAIL AND LEVELS OVER LOT 1-6 DP1130879 & LOT 12 DP800476 KNOWN AS "ST GEORGE HOSPITAL" AT KOGARAH	datum AHD site Area 5.179ha LGA KOGARAH	project number 33459 scale 1:500 @A1 OF	reference number 33459DT date of survey 24/06/15 SHEET 52 SHEETS	1
X	31/05/21	SHEETS 4-8 UPDATED, SHEETS 44-48 ADDED	026	I	07-03-12	ADDITIONAL DETAIL & LEVEL AND PIPE VIDEO DETECTION (CCTV) - STORMWATER - ADJACENT TO CAFE	34603	C	30-8-11	SURVEY ALONG GRAY STREET AND SHORT STREET ADDED	34252									
W	24/06/15	COMMUNICATIONS AND DRY FIRE AMENDED ON SHEET 4	40954	H	24-02-12	EXTRA INTERNAL DETAIL & LEVELS ADDED	34603	B	31-5-11	EXTRA DETAILS ADDED AROUND MENTAL HEALTH UNIT, SOUTH STREET	34068									
V	14/10/14	COMMUNICATIONS AND DRY FIRE AMENDED ON SHEET 4	40954	G	13-01-12	ADDITIONAL SERVICES ADDED	34554	A	1-2-11	SURVEY ALONG GRAY STREET ADDED	33774									
U	01/10/14	COMMUNICATIONS AND ELECTRICITY ADDED	40954	F	16-12-11	ADDITIONAL DETAIL & LEVEL AND PIPE VIDEO DETECTION (CCTV) - STORMWATER	34547	0	18-10-10	ORIGINAL SURVEY	33459	Reference								
T	24/09/14	SICIM FINAL MASTER SURVEY UPDATE 2	40954																	
S	05/09/14	SICIM FINAL MASTER SURVEY UPDATE	40954																	
R	18/08/14	SICIM FINAL MASTER SURVEY	40954																	
Q	11/07/14	SICIM ELEMENT 2 - DELIVERY 3	40698																	
P	18/06/14	SICIM ELEMENT 2 - DELIVERY 2	40698																	
O	02/06/14	SICIM ELEMENT 2 - DELIVERY 1	40698																	
N	27-03-14	BUILDINGS PLOTTED (NOT SURVEYED)	34305																	
M	12-10-12	ADDITIONAL UNDERGROUND SERVICE DETECTION AND GPRBY DURING CONSTRUCTION P/L CSB & FIRE STATION AREA	34252																	
L	20-09-12	ADDITIONAL CEILING SPACE SERVICES ADDED (SHEET 21)	34068																	
K	30-07-12	EXTRA INTERNAL & EXTERNAL DETAIL & LEVELS ADDED	33774																	
J	07-05-12	EXTRA DETAIL ADDED - CARPARK CROSS SECTION AND SHORT STREET DETENTION TANK	34840																	
Revision	Date	Description		Revision	Date	Description		Revision	Date	Description	Reference									

DETAIL AND LEVEL PLAN

SEE SHEETS 16-20 FOR ROOF TOP DETAILS
SEE SHEET 1 FOR LEGEND AND NOTES
SEE SHEET 28 FOR SERVICE PIT DIAGRAM

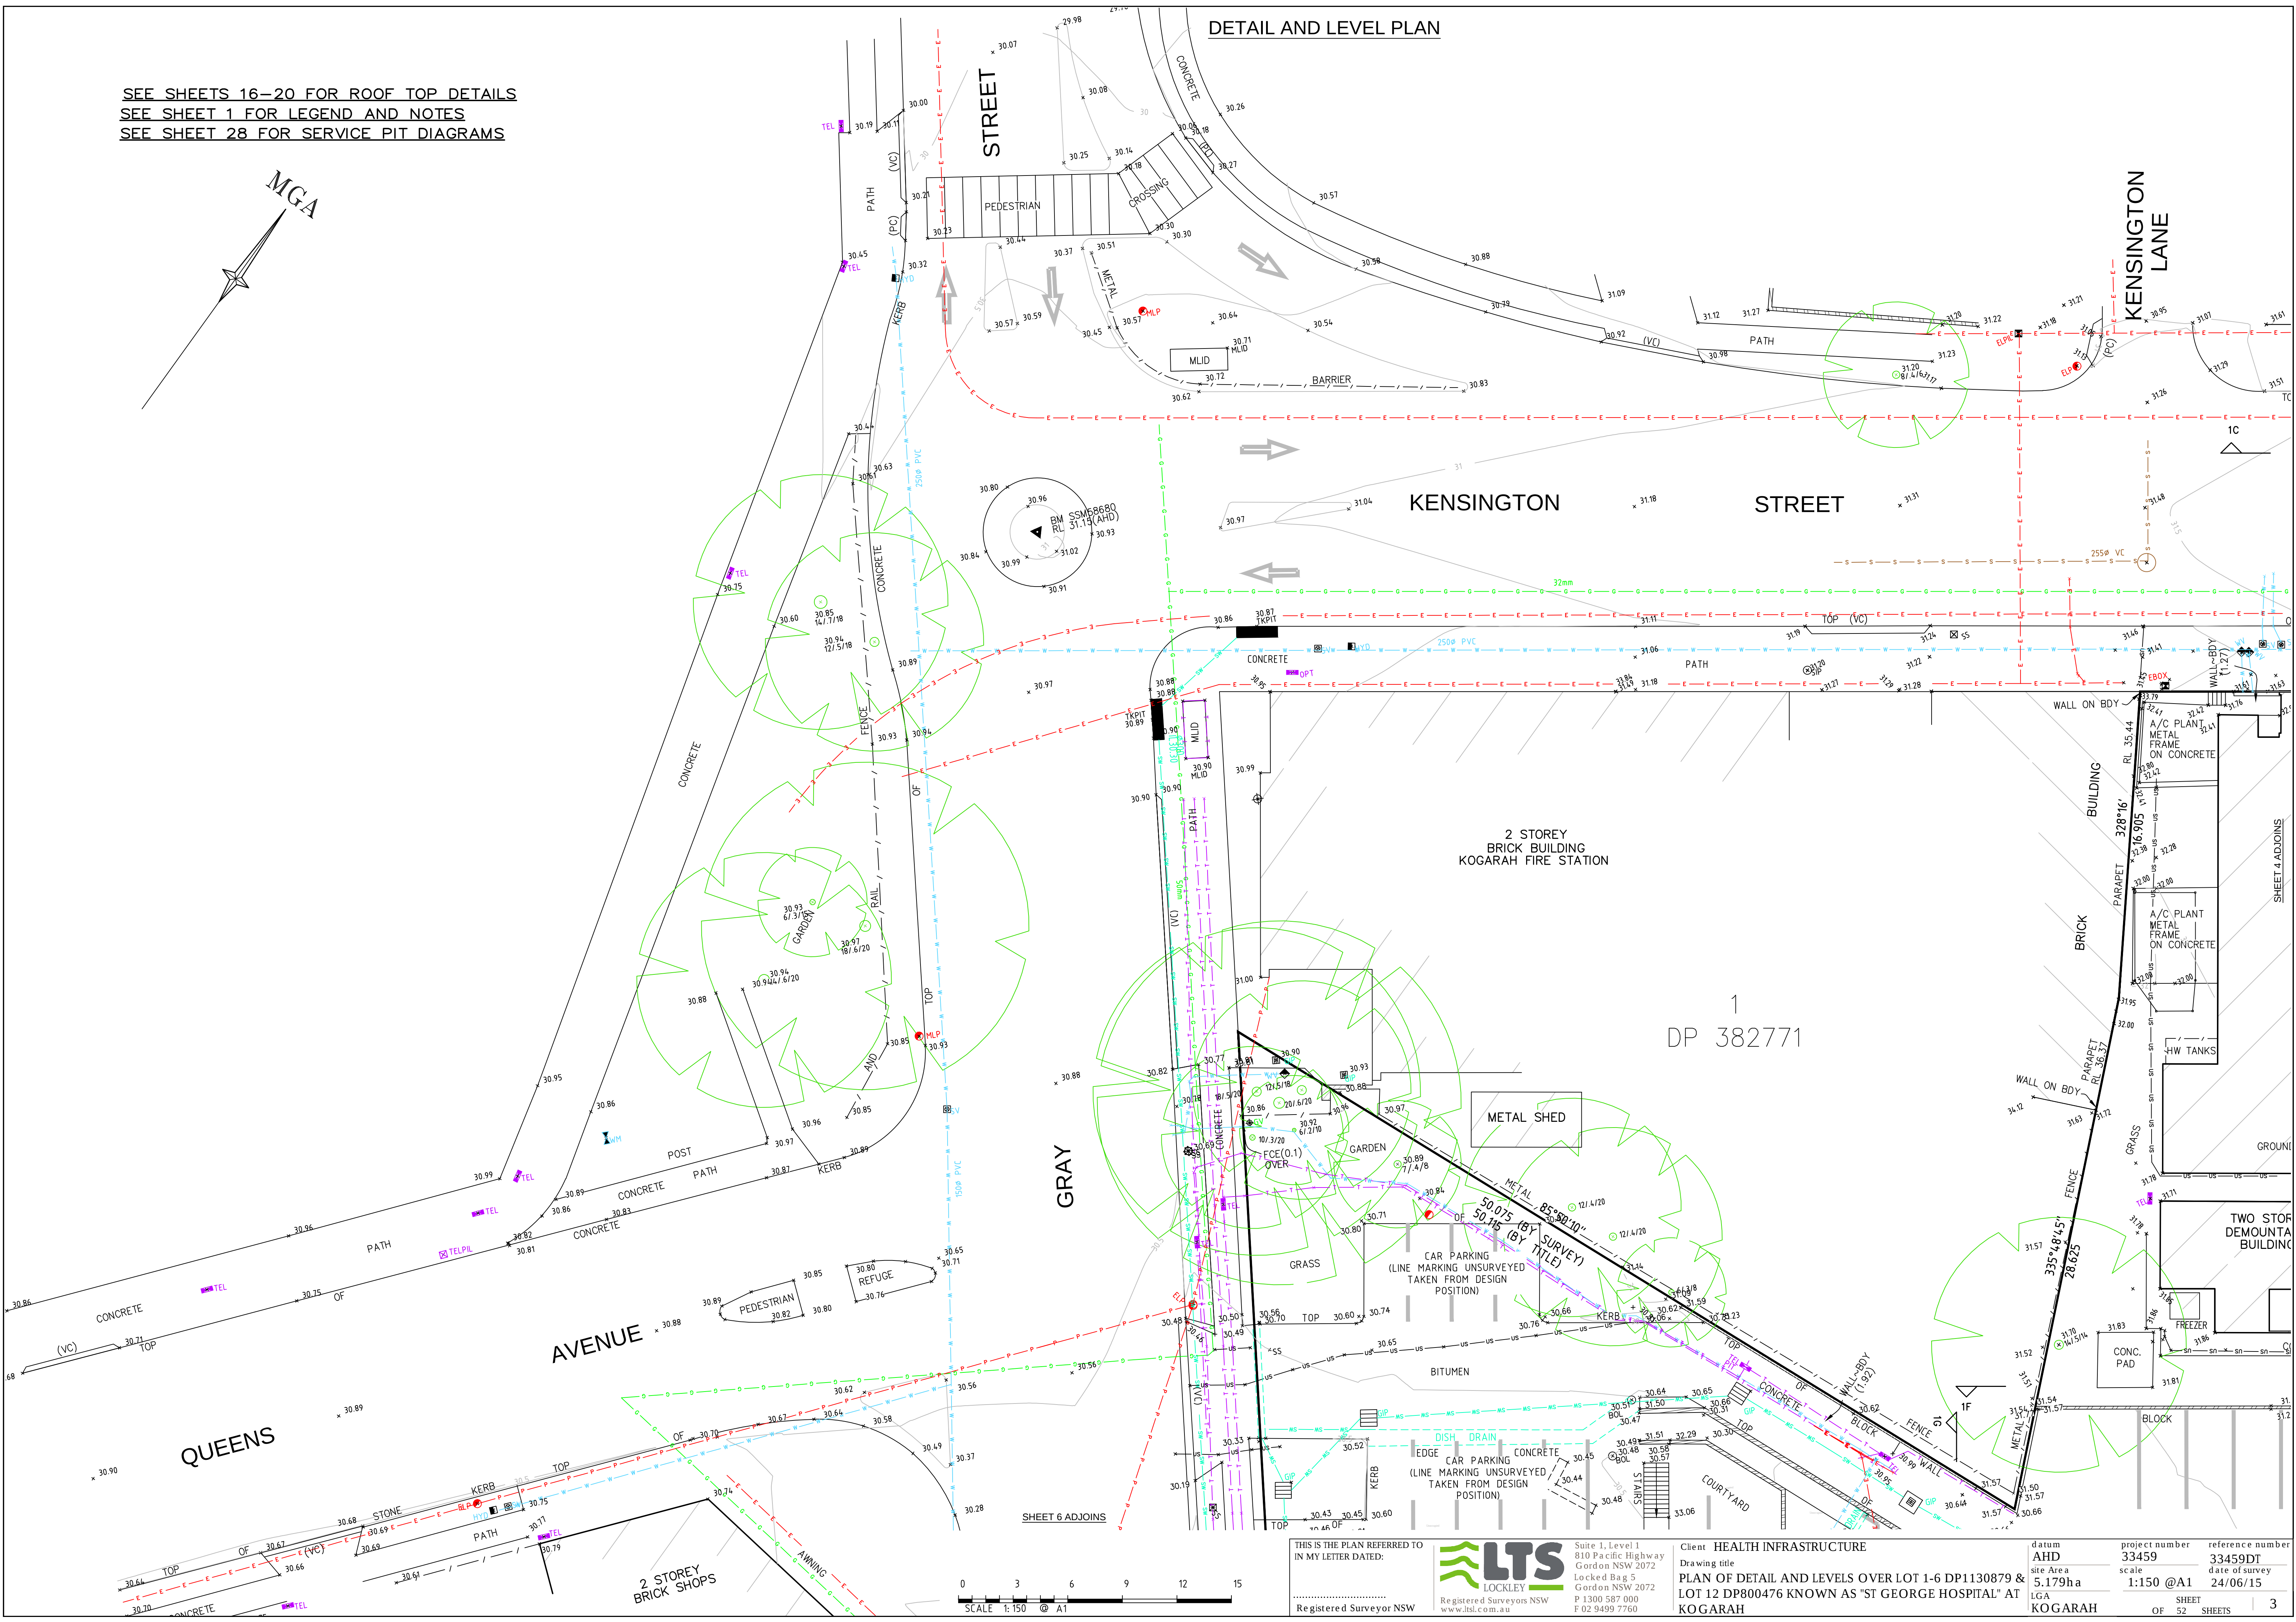

THIS IS THE PLAN REFERRED TO
IN MY LETTER DATED:
.....
Registered Surveyor NSW

LTS
LOCKLEY
Registered Surveyors NSW
www.ltsl.com.au

Suite 1, Level 1
810 Pacific Highway
Gordon NSW 2072
Locked Bag 5
Gordon NSW 2072
P 1300 587 000
F 02 9499 7760


Client **HEALTH INFRASTRUCTURE**
Drawing title
**PLAN OF DETAIL AND LEVELS OVER LOT 1-6 DP1130879 &
LOT 12 DP800476 KNOWN AS "ST GEORGE HOSPITAL" AT
KOGARAH**

datum AHD	project number 33459	reference number 33459DT
site Area 5.179ha	scale 1:150 @A1	date of survey 24/06/15
LGA KOGARAH	SHEET 52	SHEETS 3

DETAIL AND LEVEL PLAN

SEE SHEET 44 FOR
ADDITIONAL DETAIL & LEVELS
OF UNDERGROUND SERVICES

SEE SHEETS 16-20 FOR ROOF TOP DETAILS
SEE SHEET 1 FOR LEGEND AND NOTES
SEE SHEET 28 FOR SERVICE PIT DIAGRAMS

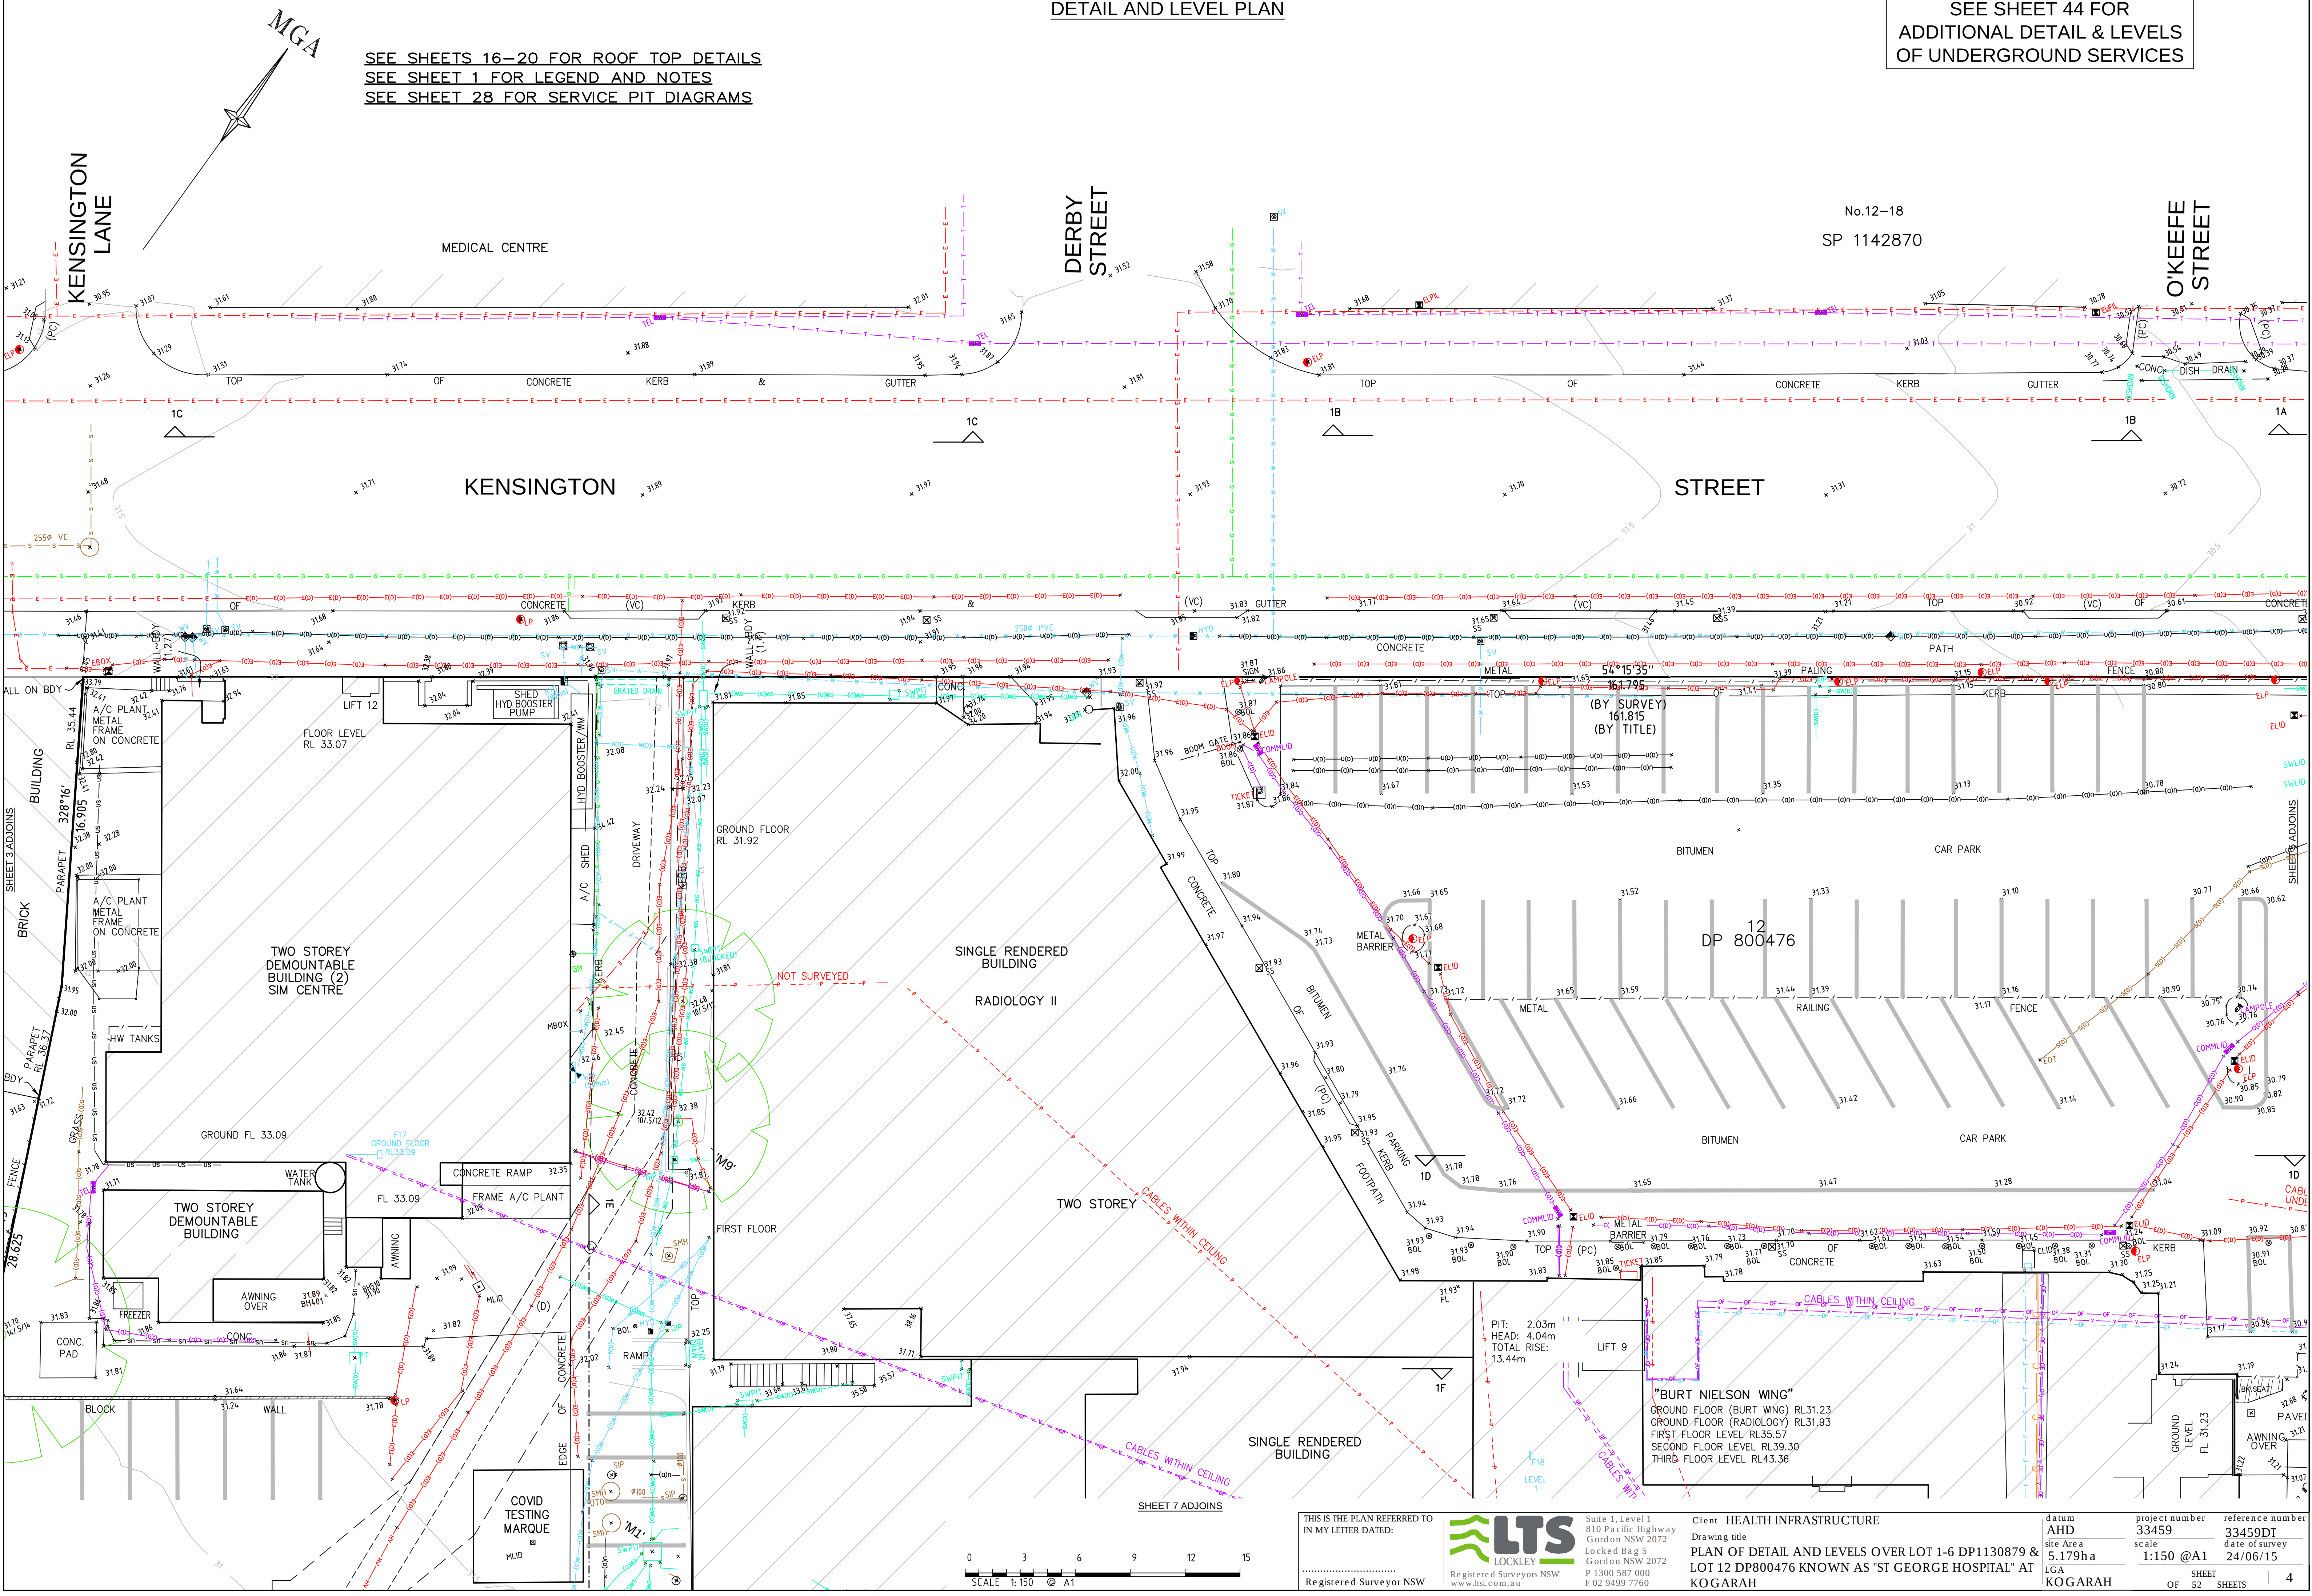

THIS IS THE PLAN REFERRED TO
IN MY LETTER DATED:

Registered Surveyor NSW



Suite 1, Level 1
810 Pacific Highway
Gordon NSW 2072
Locked Bag 5
Gordon NSW 2072
P 1300 587 000
F 02 9499 7760

Client HEALTH INFRASTRUCTURE
Drawing title
PLAN OF DETAIL AND LEVELS OF
LOT 12 DP800476 KNOWN AS "S
KOGARAH


datum	AHD
site Area	5.179ha
LGA	KOGARAH

project number	reference number
33459	33459DT
scale	date of survey
1:150 @A1	24/06/15
OF 52 SHEETS 4	

DETAIL AND LEVEL PLAN

SEE SHEET 45 FOR
ADDITIONAL DETAIL & LEVELS
OF UNDERGROUND SERVICES

MGA

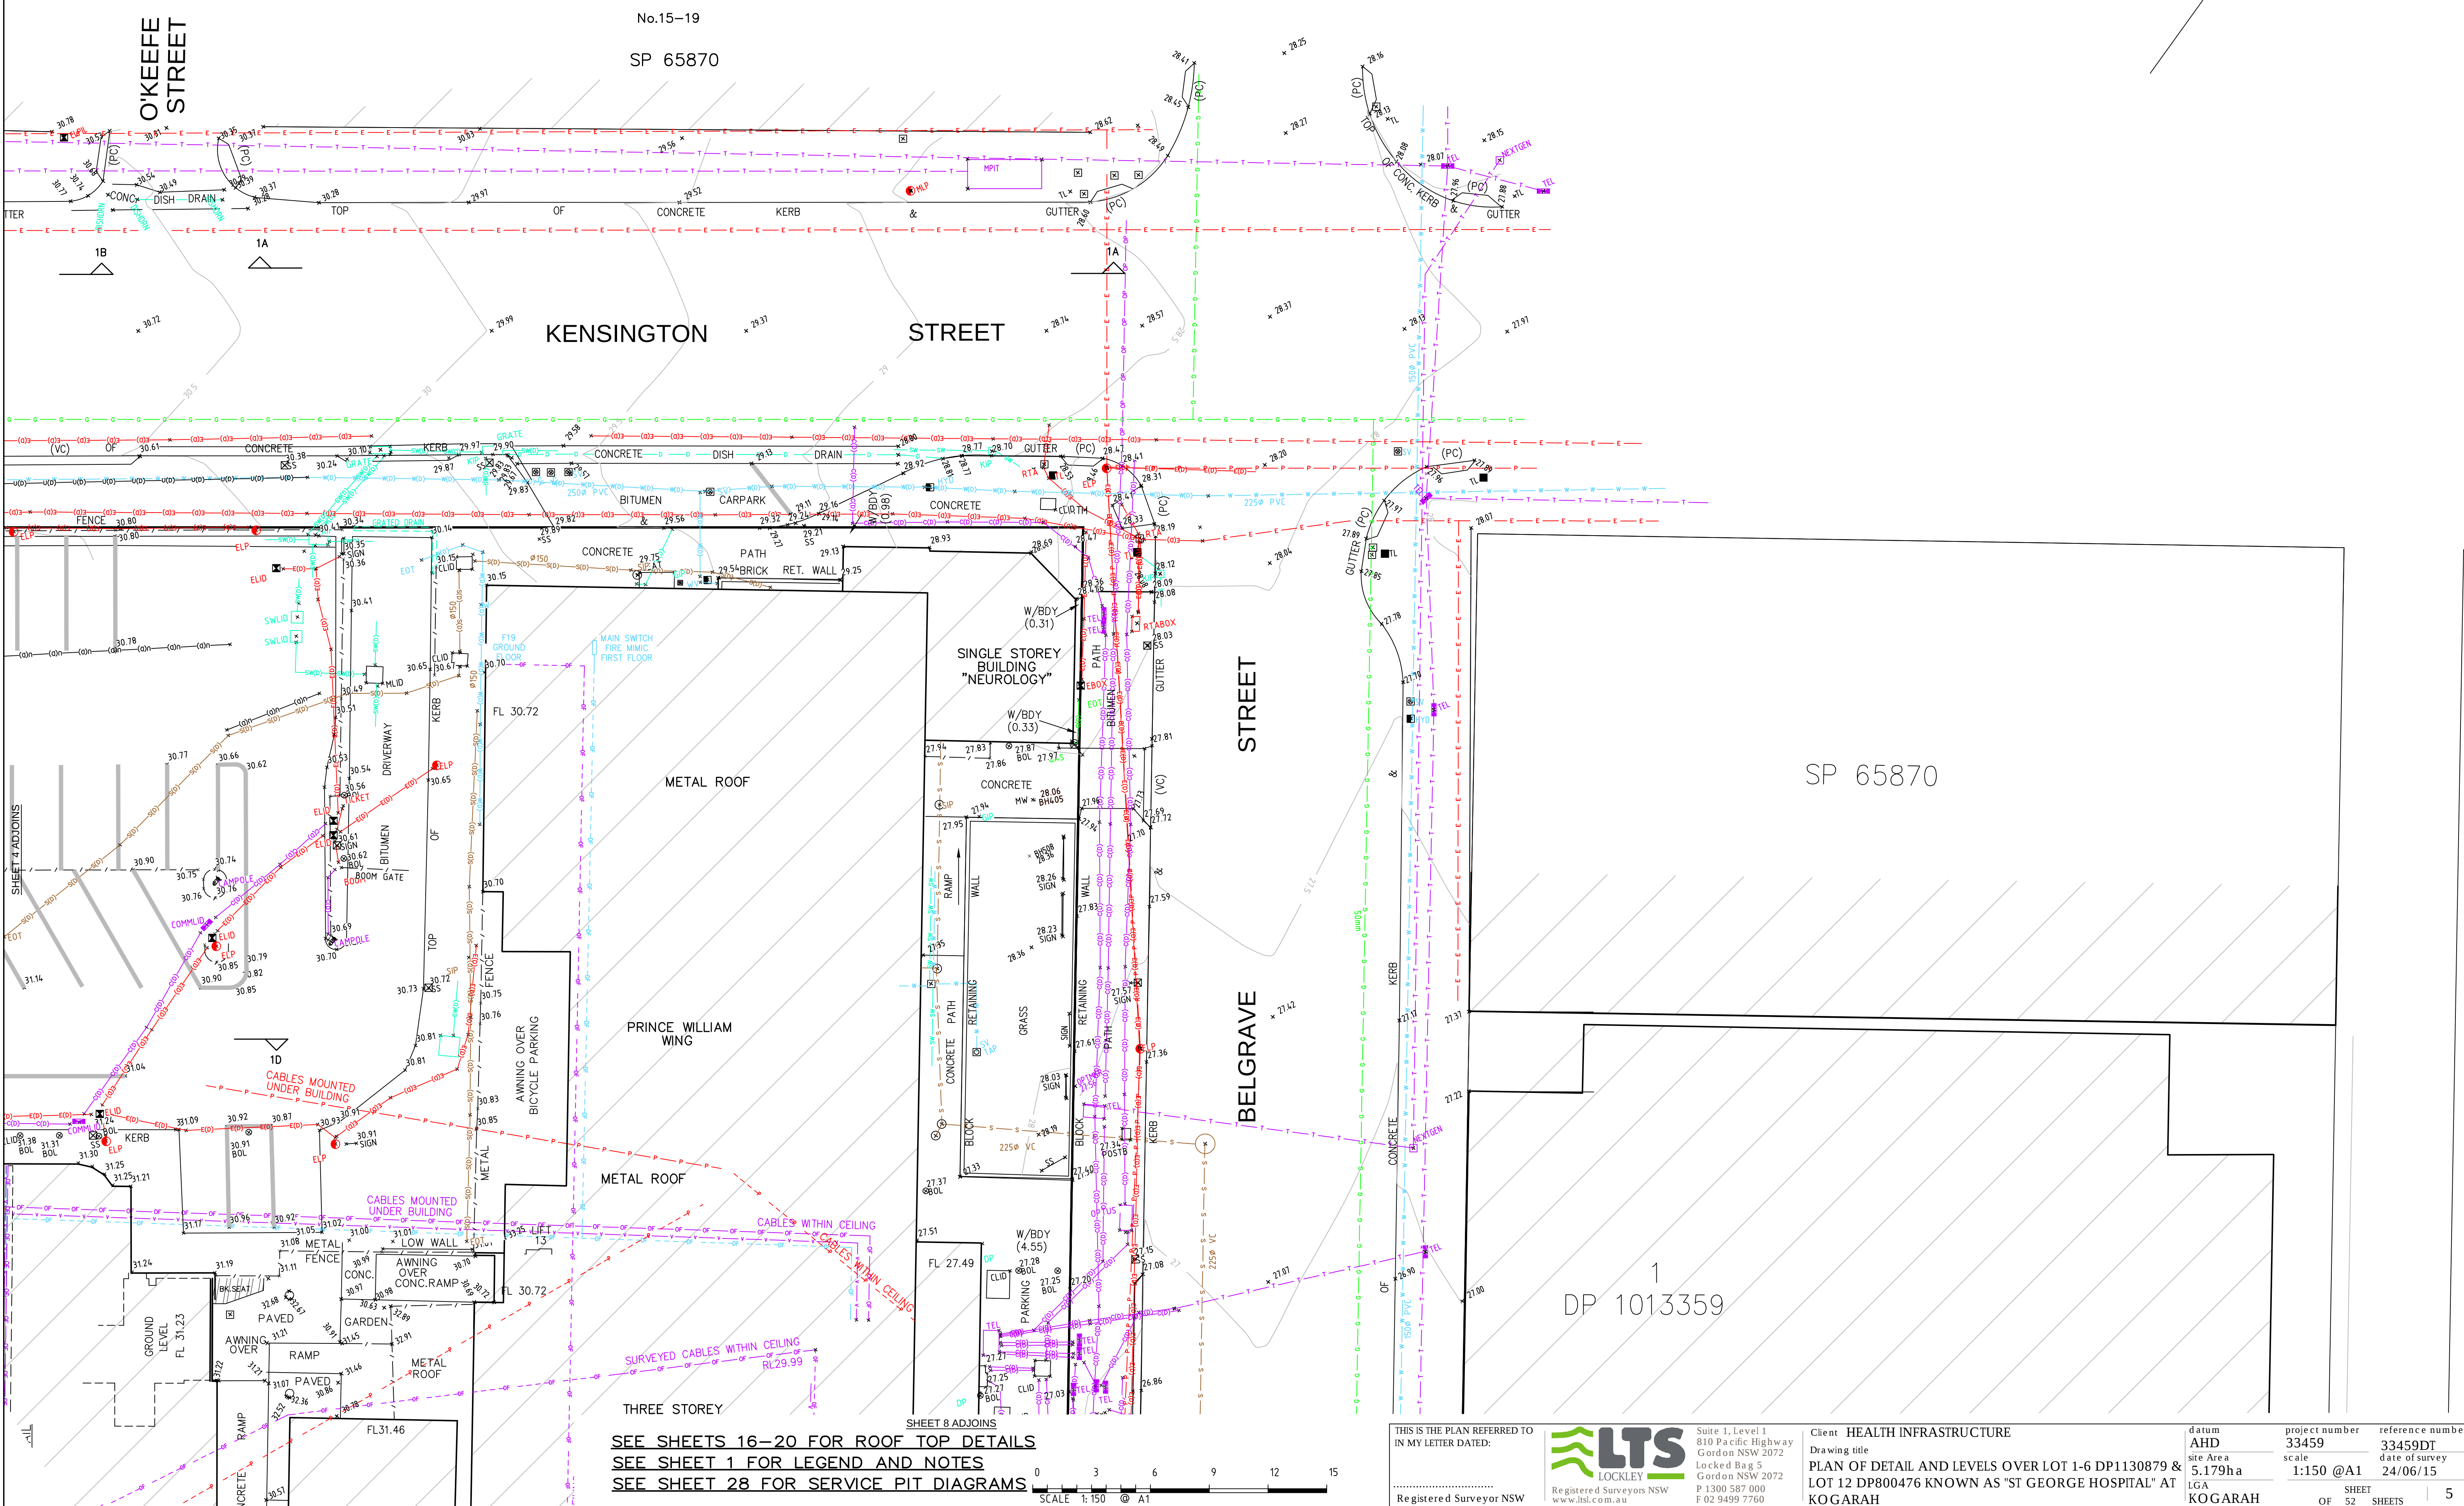

SEE SHEETS 16-20 FOR ROOF TOP DETAILS
SEE SHEET 1 FOR LEGEND AND NOTES
SEE SHEET 28 FOR SERVICE PIT DIAGRAM



THIS IS THE PLAN REFERRED TO
IN MY LETTER DATED:



Suite 1, Level 1
810 Pacific Highway
Gordon NSW 2072
Locked Bag 5
Gordon NSW 2072
P 1300 587 000
F 02 9499 7760


Client HEALTH INFRASTRUCTURE

Drawing title
PLAN OF DETAIL AND LEVELS OVER LOT 1-6 DP1130879 &
LOT 12 DP800476 KNOWN AS "ST GEORGE HOSPITAL" AT
KOGARAH

datum
AHD
site Area
5.179ha
LGA
KOGARAH

project number
33459
scale
1:150 @A1
OF 52 SHEETS

reference number
33459DT
date of survey
24/06/15
5

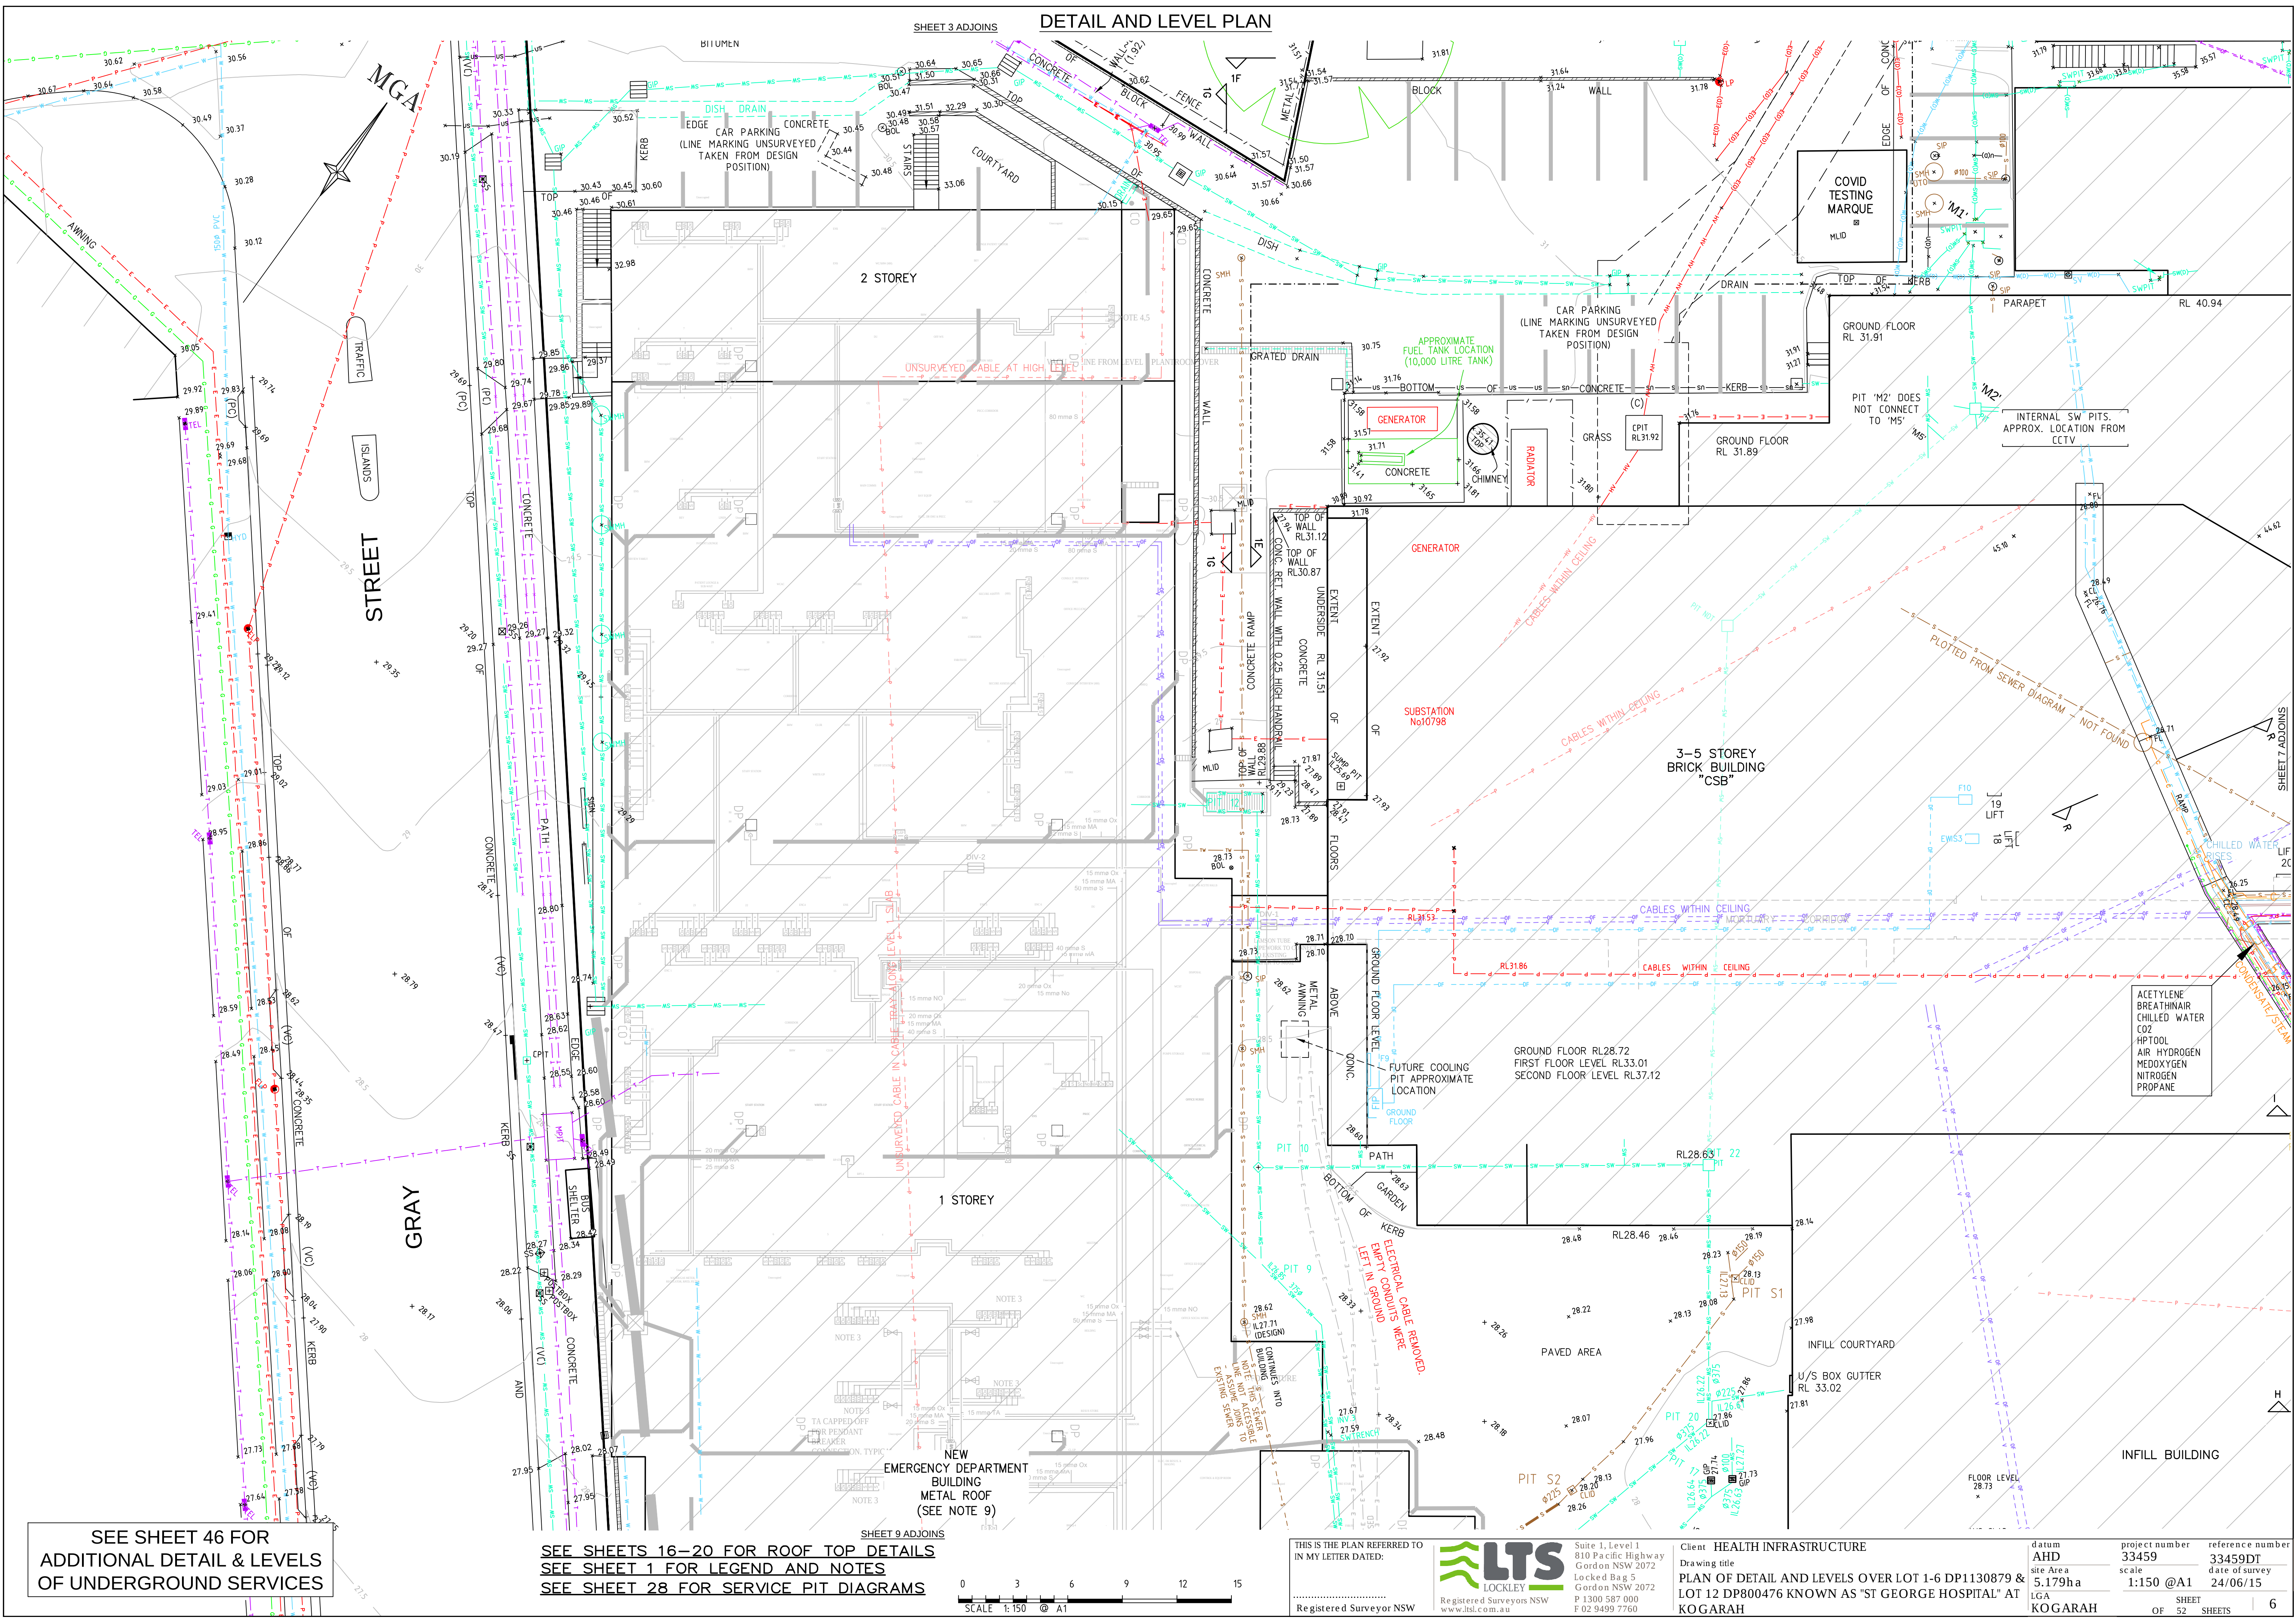

SEE SHEET 46 FOR
ADDITIONAL DETAIL & LEVELS
OF UNDERGROUND SERVICES

SEE SHEETS 16-20 FOR ROOF TOP DETAILS
SEE SHEET 1 FOR LEGEND AND NOTES
SEE SHEET 28 FOR SERVICE PIT DIAGRAMS




THIS IS THE PLAN REFERRED TO
IN MY LETTER DATED:

Registered Surveyor NSW

LTS
LOCKLEY
Suite 1, Level 1
810 Pacific Highway
Gordon NSW 2072
Locked Bag 5
Gordon NSW 2072
P 1300 587 000
F 02 9499 7760
www.ltsl.com.au

Client HEALTH INFRASTRUCTURE Drawing title PLAN OF DETAIL AND LEVELS OVER LOT 1-6 DP1130879 & LOT 12 DP800476 KNOWN AS "ST GEORGE HOSPITAL" AT KOGARAH	datum AHD	project number 33459	reference number 33459DT
	site Area 5.179ha	scale 1:150 @A1	date of survey 24/06/15
	LGA KOGARAH	OF 52	SHEETS 1

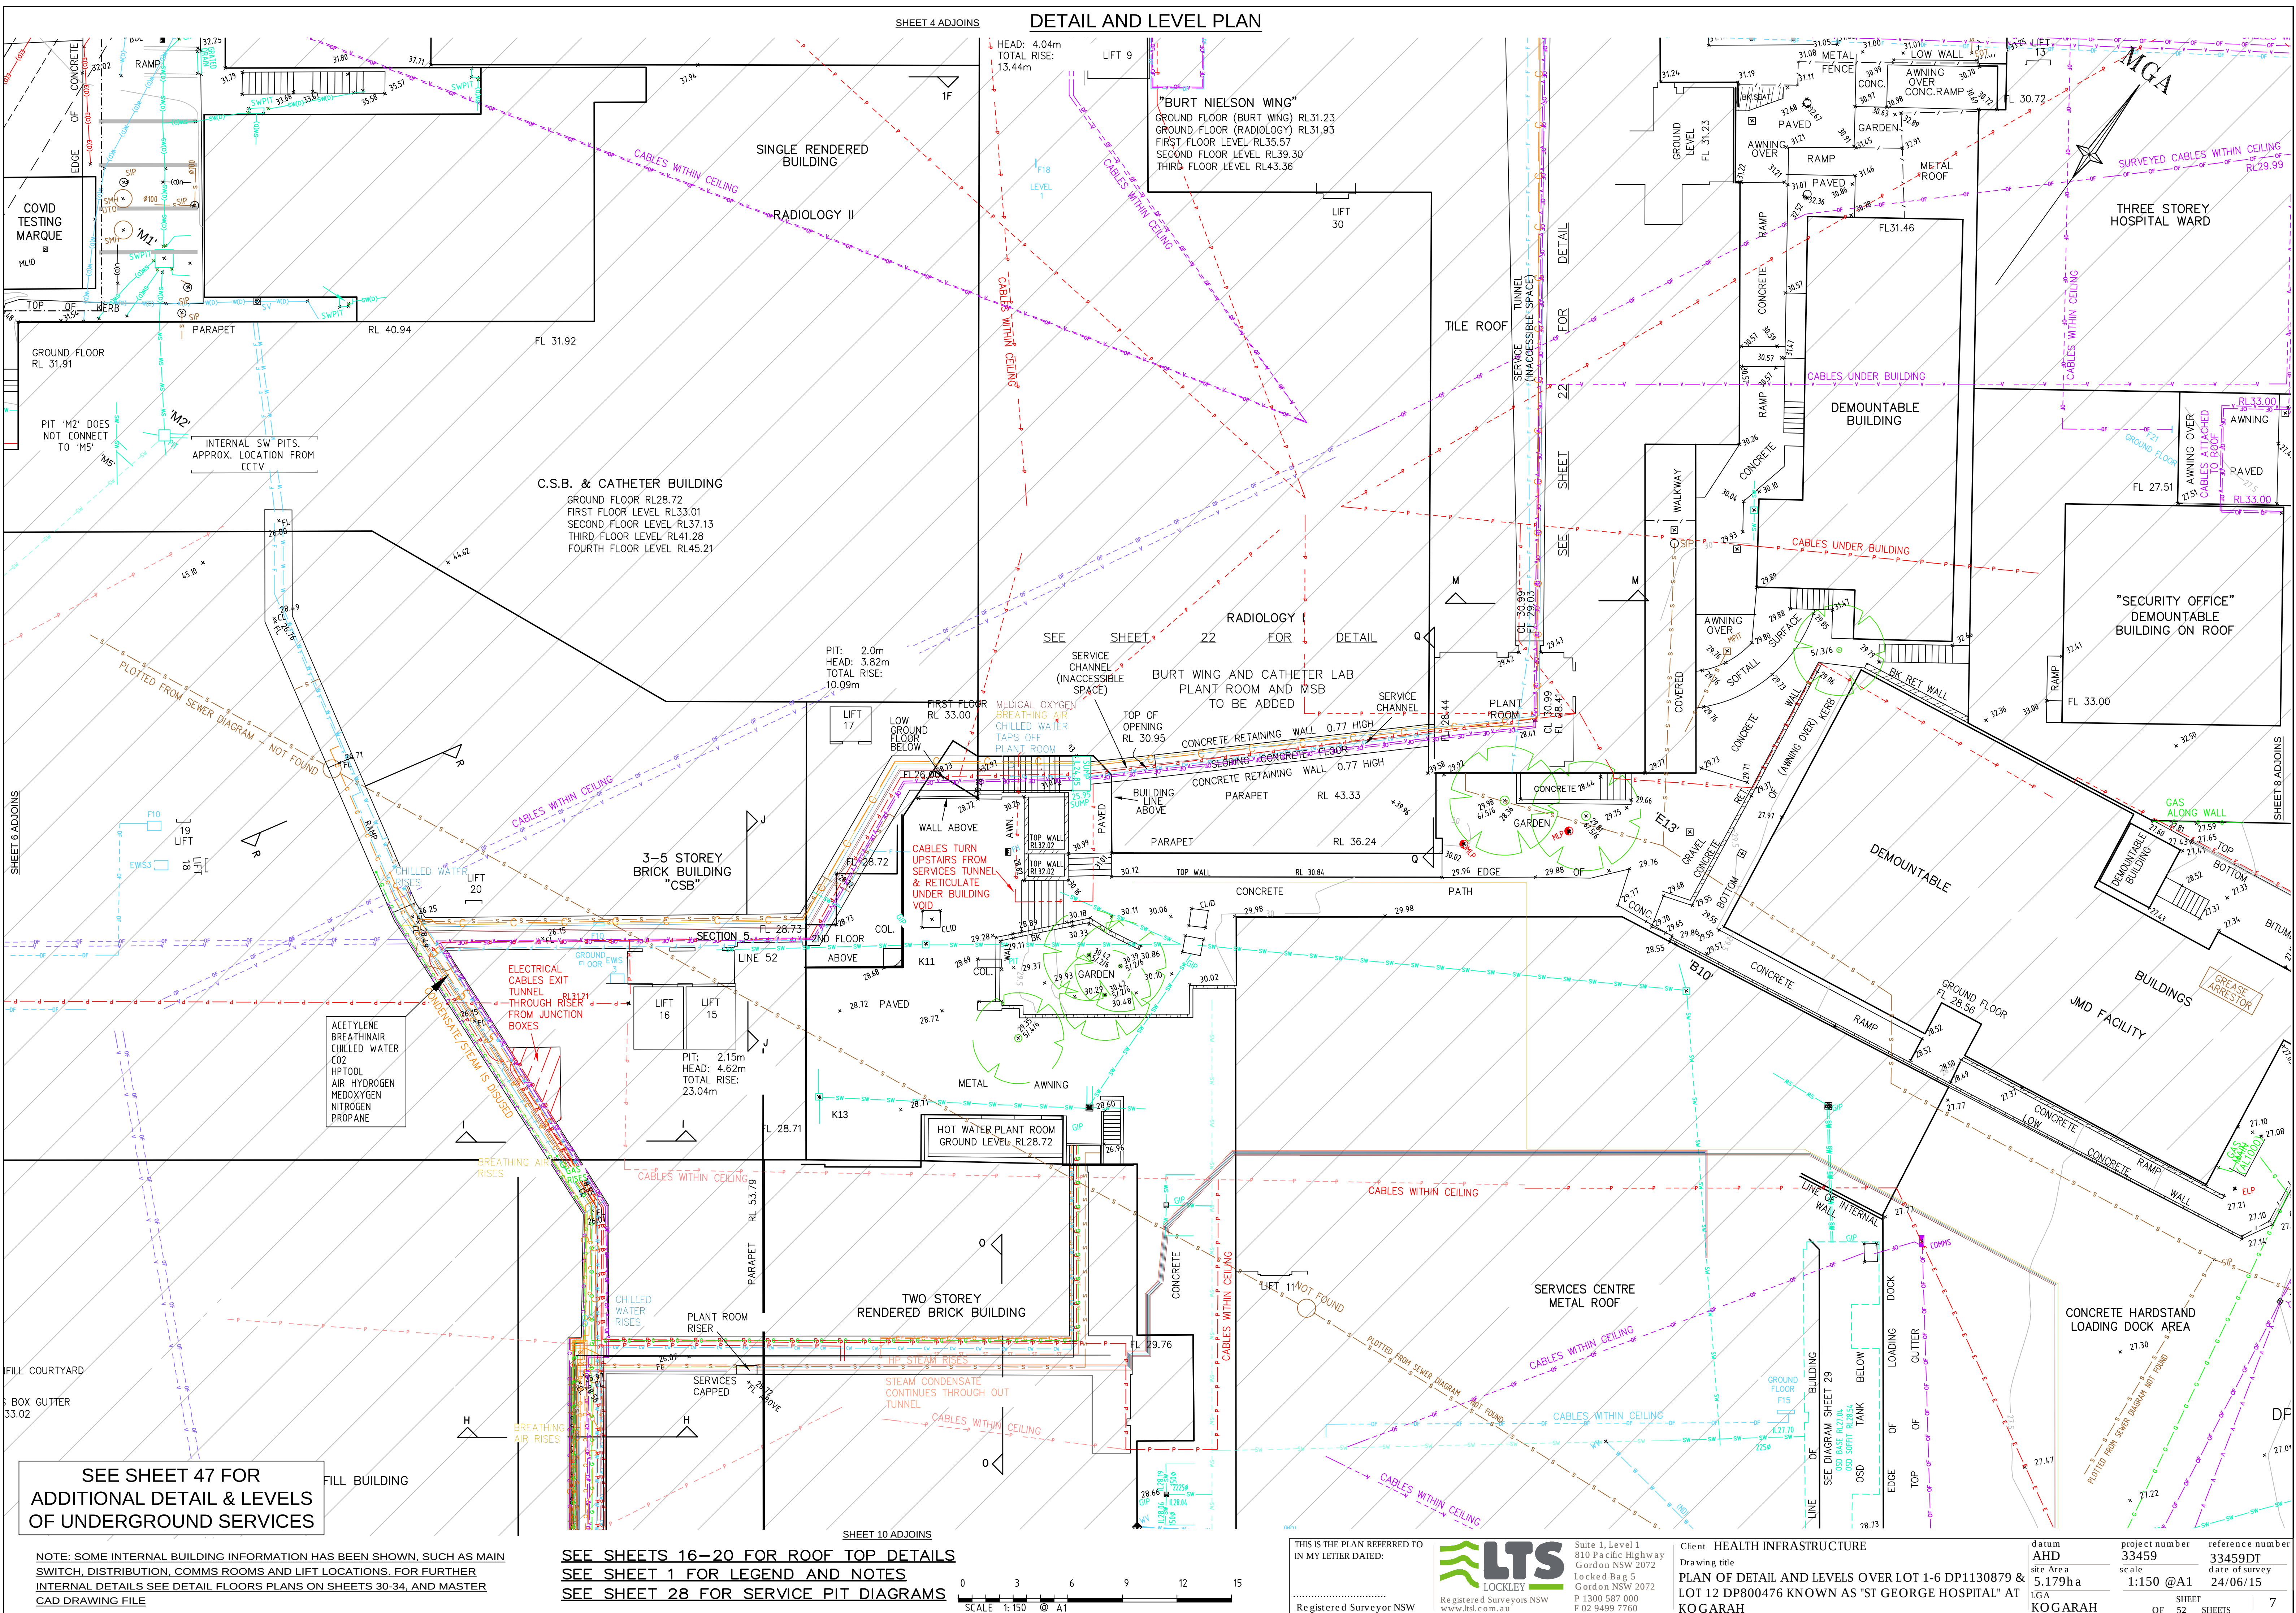

SEE SHEET 47 FOR
ADDITIONAL DETAIL & LEVELS
OF UNDERGROUND SERVICES

NOTE: SOME INTERNAL BUILDING INFORMATION HAS BEEN SHOWN, SUCH AS MAIN
SWITCH, DISTRIBUTION, COMMS ROOMS AND LIFT LOCATIONS. FOR FURTHER
INTERNAL DETAILS SEE DETAIL FLOOR PLANS ON SHEETS 30-34, AND MASTER
CAD DRAWING FILE

SEE SHEETS 16-20 FOR ROOF TOP DETAILS
SEE SHEET 1 FOR LEGEND AND NOTES
SEE SHEET 28 FOR SERVICE PIT DIAGRAMS




THIS IS THE PLAN REFERRED TO
IN MY LETTER DATED:
Registered Surveyor NSW



Suite 1, Level 1
810 Pacific Highway
Gordon NSW 2072
Locked Bag 5
Gordon NSW 2072
P 1300 587 000
F 02 9499 7760

Client HEALTH INFRASTRUCTURE
Drawing title
PLAN OF DETAIL AND LEVELS OVER LOT 1-6 DP1130879 &
LOT 12 DP800476 KNOWN AS "ST GEORGE HOSPITAL" AT
KOGARAH
datum
AHD
site Area
5.179ha
LGA
KOGARAH
project number
33459
scale
1:150 @A1
reference number
33459DT
date of survey
24/06/15
OF 52 SHEETS

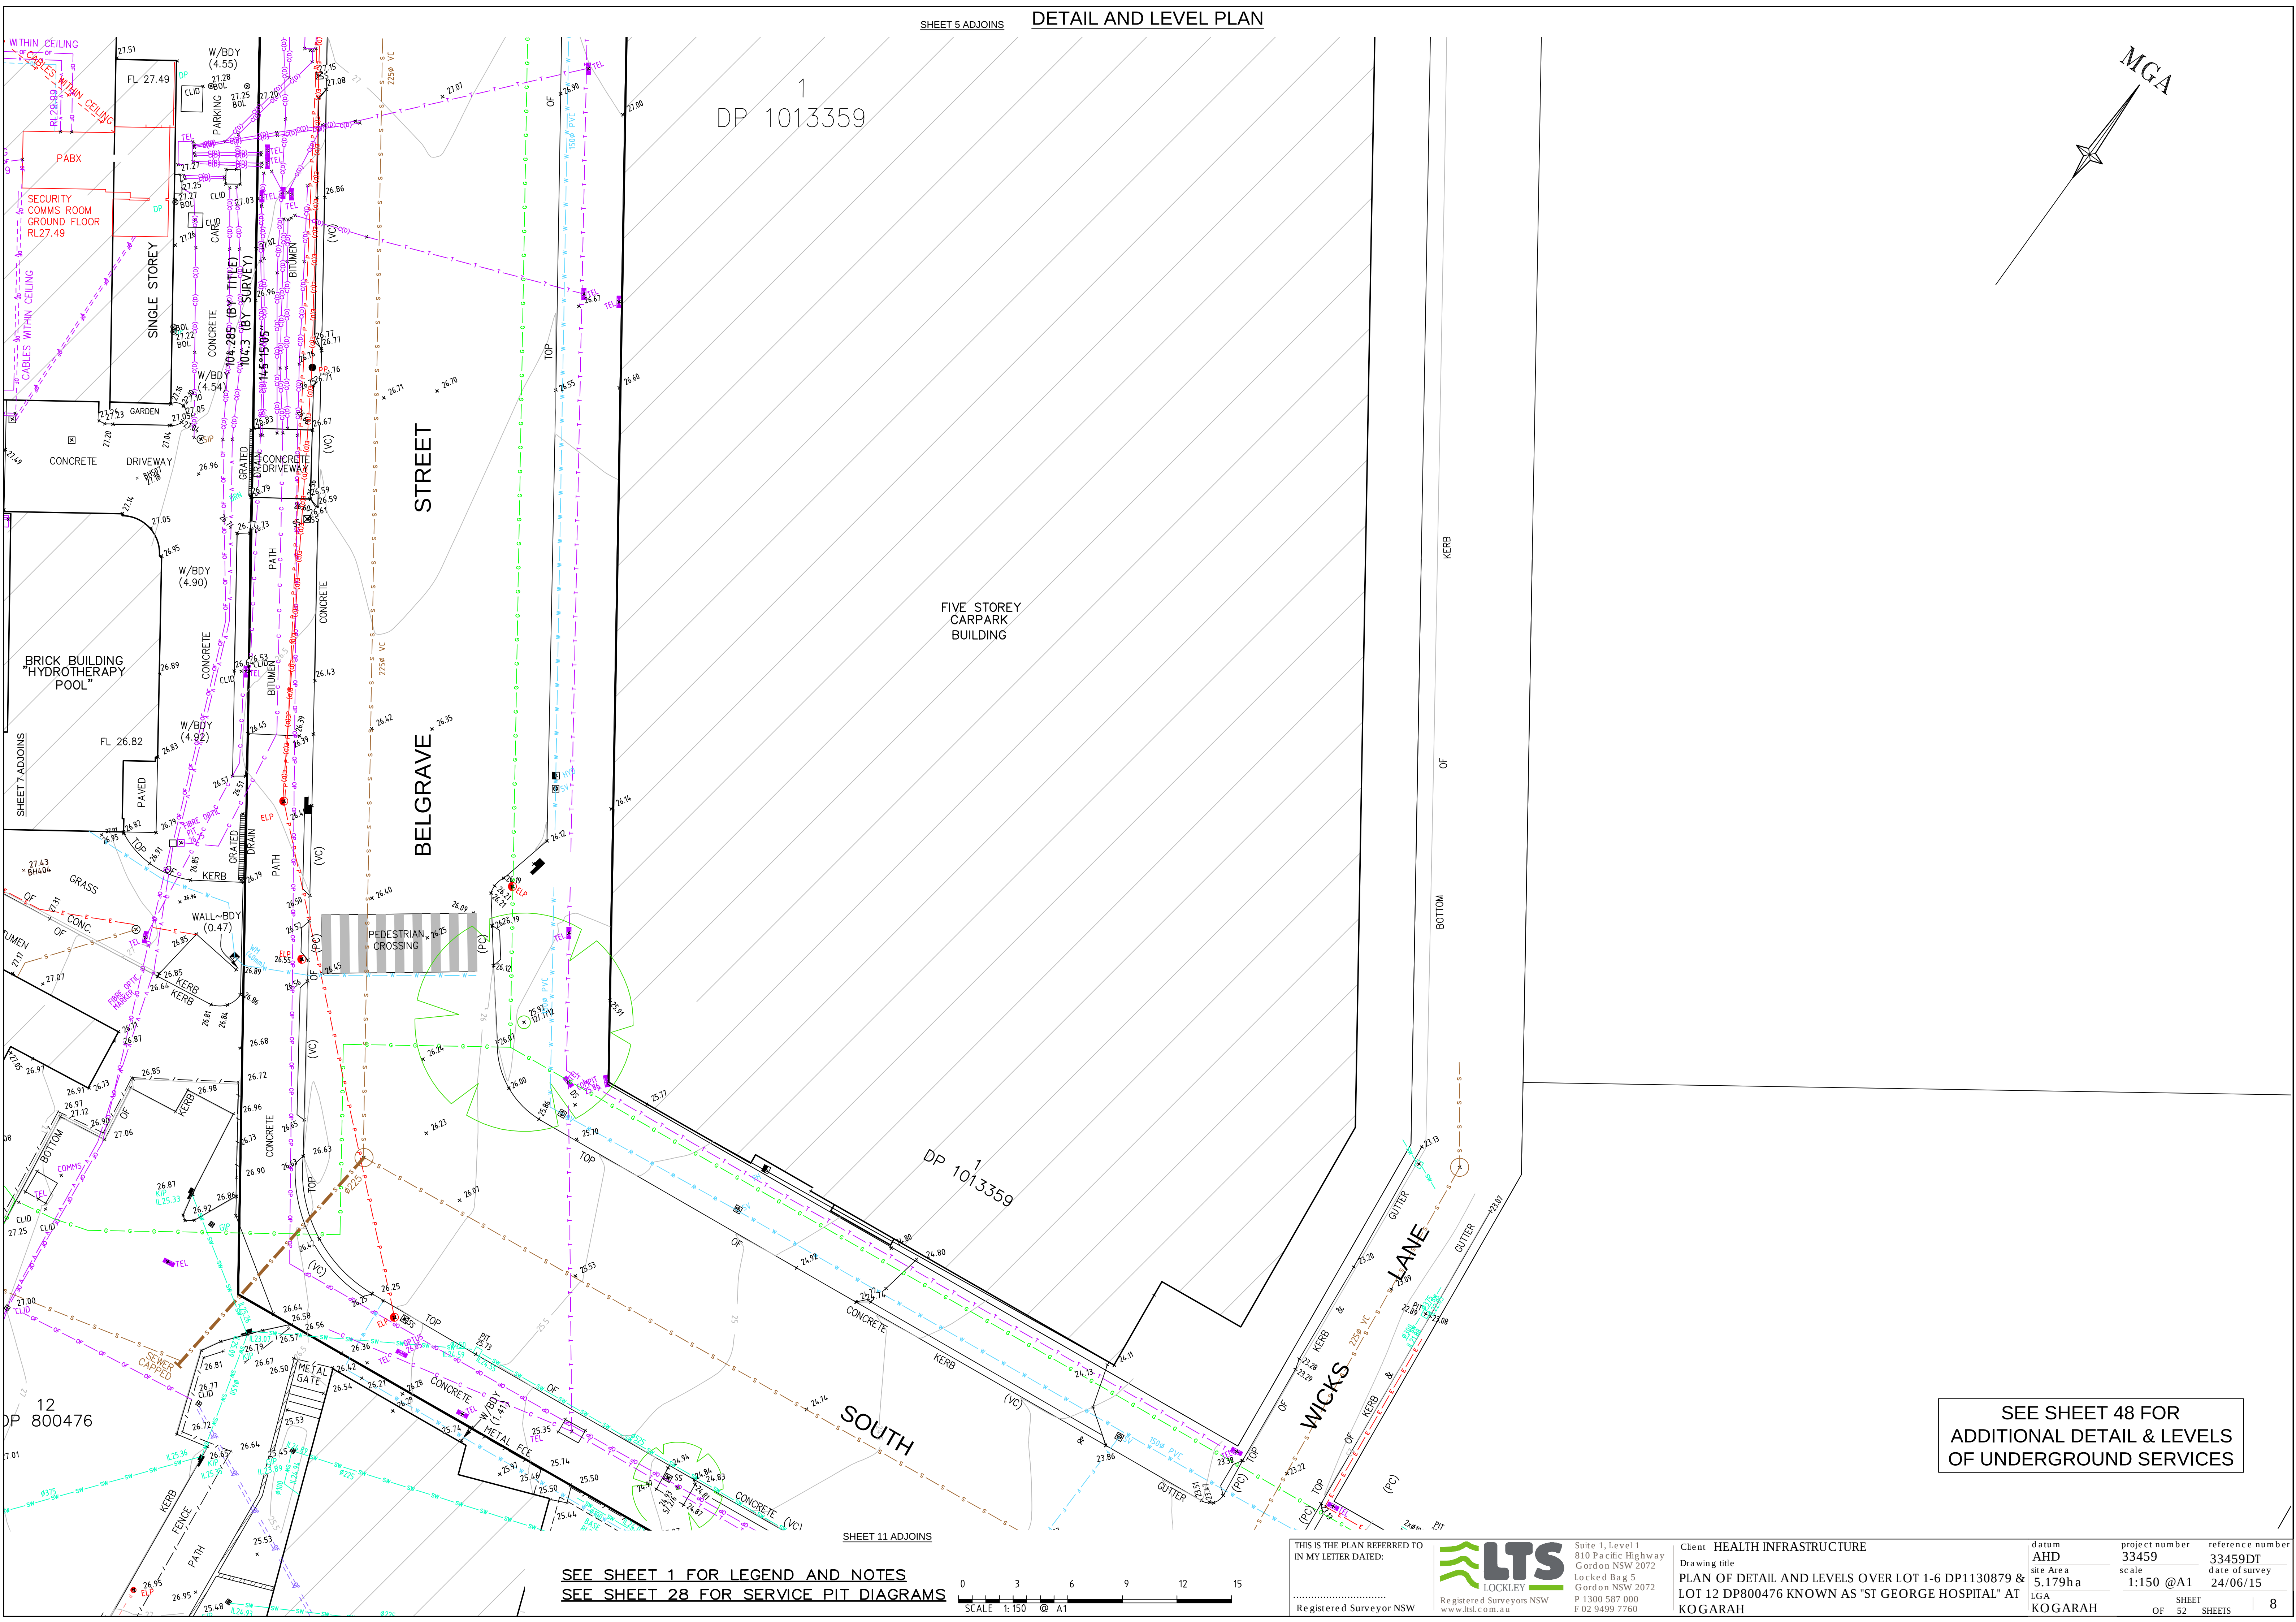

SEE SHEET 48 FOR
ADDITIONAL DETAIL & LEVELS
OF UNDERGROUND SERVICES

SEE SHEET 1 FOR LEGEND AND NOTES
SEE SHEET 28 FOR SERVICE PIT DIAGRAMS



THIS IS THE PLAN REFERRED TO
IN MY LETTER DATED:
.....
Registered Surveyor NSW


LTS
LOCKLEY
Registered Surveyors NSW
www.ltsl.com.au

Suite 1, Level 1
810 Pacific Highway
Gordon NSW 2072
Locked Bag 5
Gordon NSW 2072
P 1300 587 000
F 02 9499 7760

Client **HEALTH INFRASTRUCTURE**
Drawing title
**PLAN OF DETAIL AND LEVELS OVER LOT 1-6 DP1130879 &
LOT 12 DP800476 KNOWN AS "ST GEORGE HOSPITAL" AT
KOGARAH**

datum AHD	project number 33459	reference number 33459DT
site Area 5.179ha	scale 1:150 @A1	date of survey 24/06/15
LGA KOGARAH	SHEET 52	SHEETS 8

DETAIL AND LEVEL PLAN

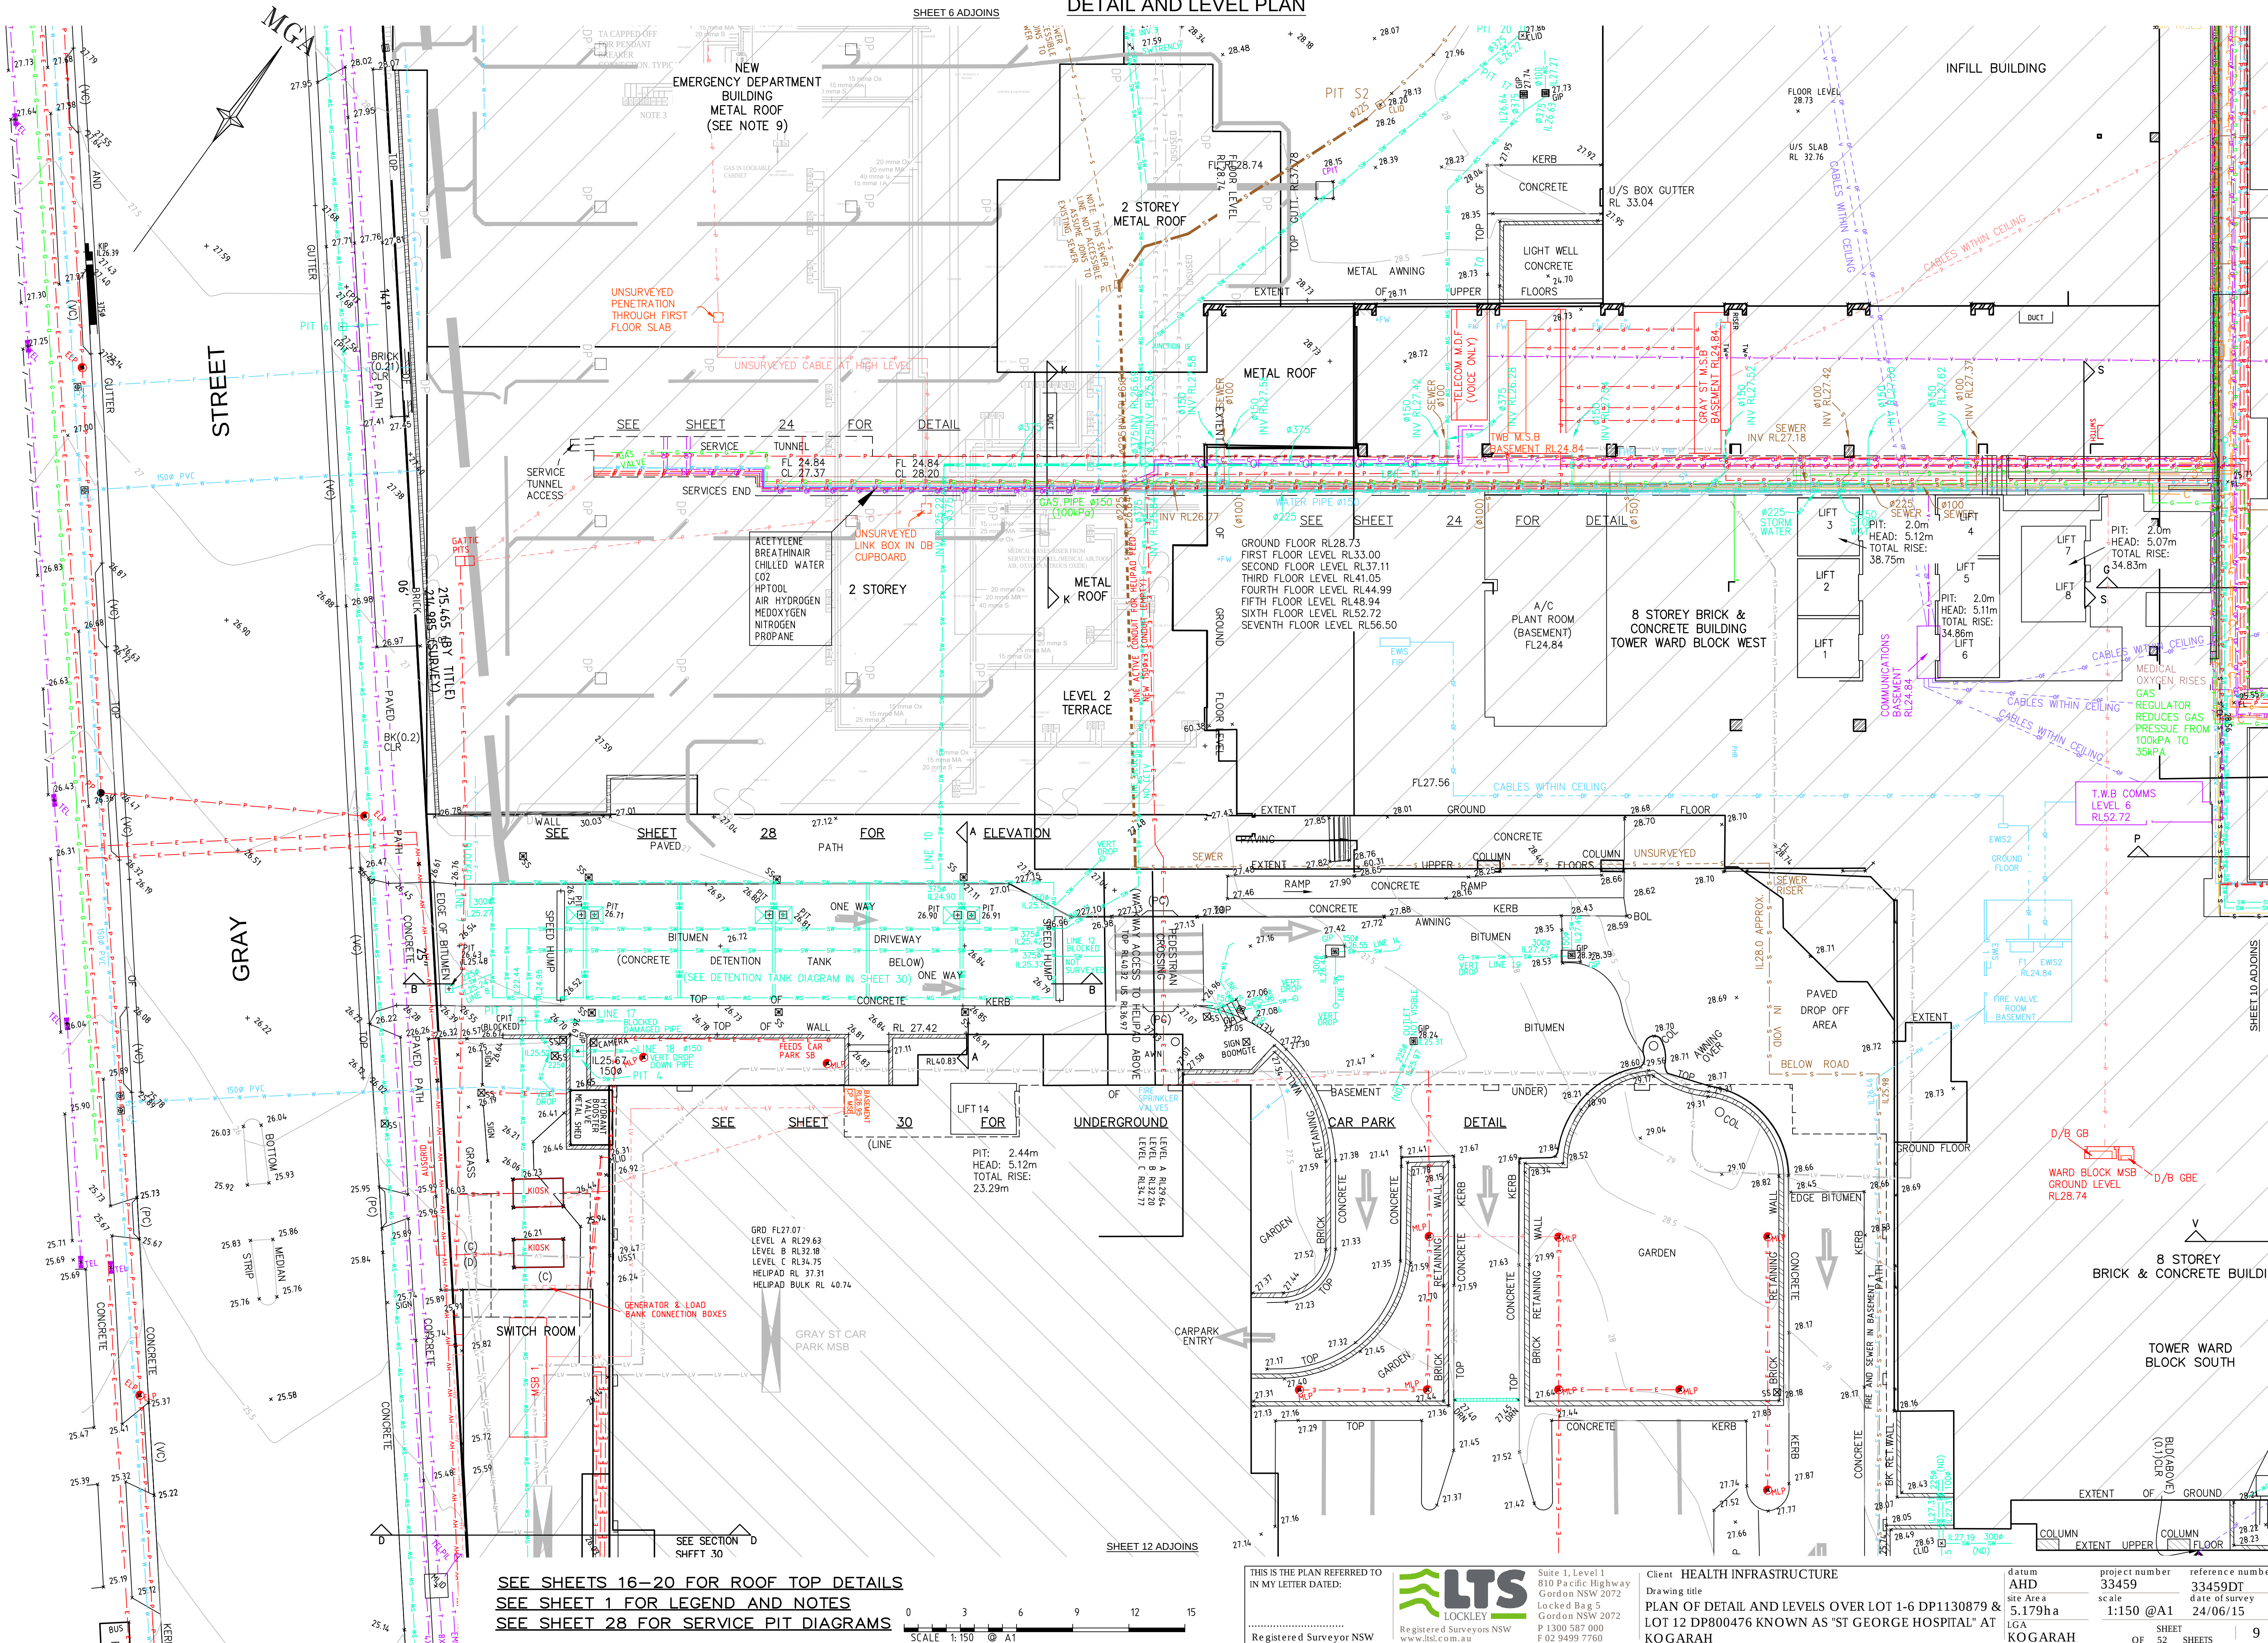

SEE SHEETS 16-20 FOR ROOF TOP DETAILS
 SEE SHEET 1 FOR LEGEND AND NOTES
 SEE SHEET 28 FOR SERVICE PIT DIAGRAMS



THIS IS THE PLAN REFERRED TO
 IN MY LETTER DATED:

Registered Surveyor NSW


LTS
 LOCKLEY
 Registered Surveyors NSW
 www.lts.com.au

Suite 1, Level 1
 810 Pacific Highway
 Gordon NSW 2072
 Locked Bag 5
 Gordon NSW 2072
 P 1300 587 000
 F 02 9499 7760

Client **HEALTH INFRASTRUCTURE**

Drawing title
PLAN OF DETAIL AND LEVELS OVER LOT 1-6 DP1130879 & LOT 12 DP800476 KNOWN AS "ST GEORGE HOSPITAL" AT KOGARAH

datum AHD	project number 33459	reference number 33459DT
site Area 5.179ha	scale 1:150 @A1	date of survey 24/06/15
LGA KOGARAH	SHEET OF 52 SHEETS	

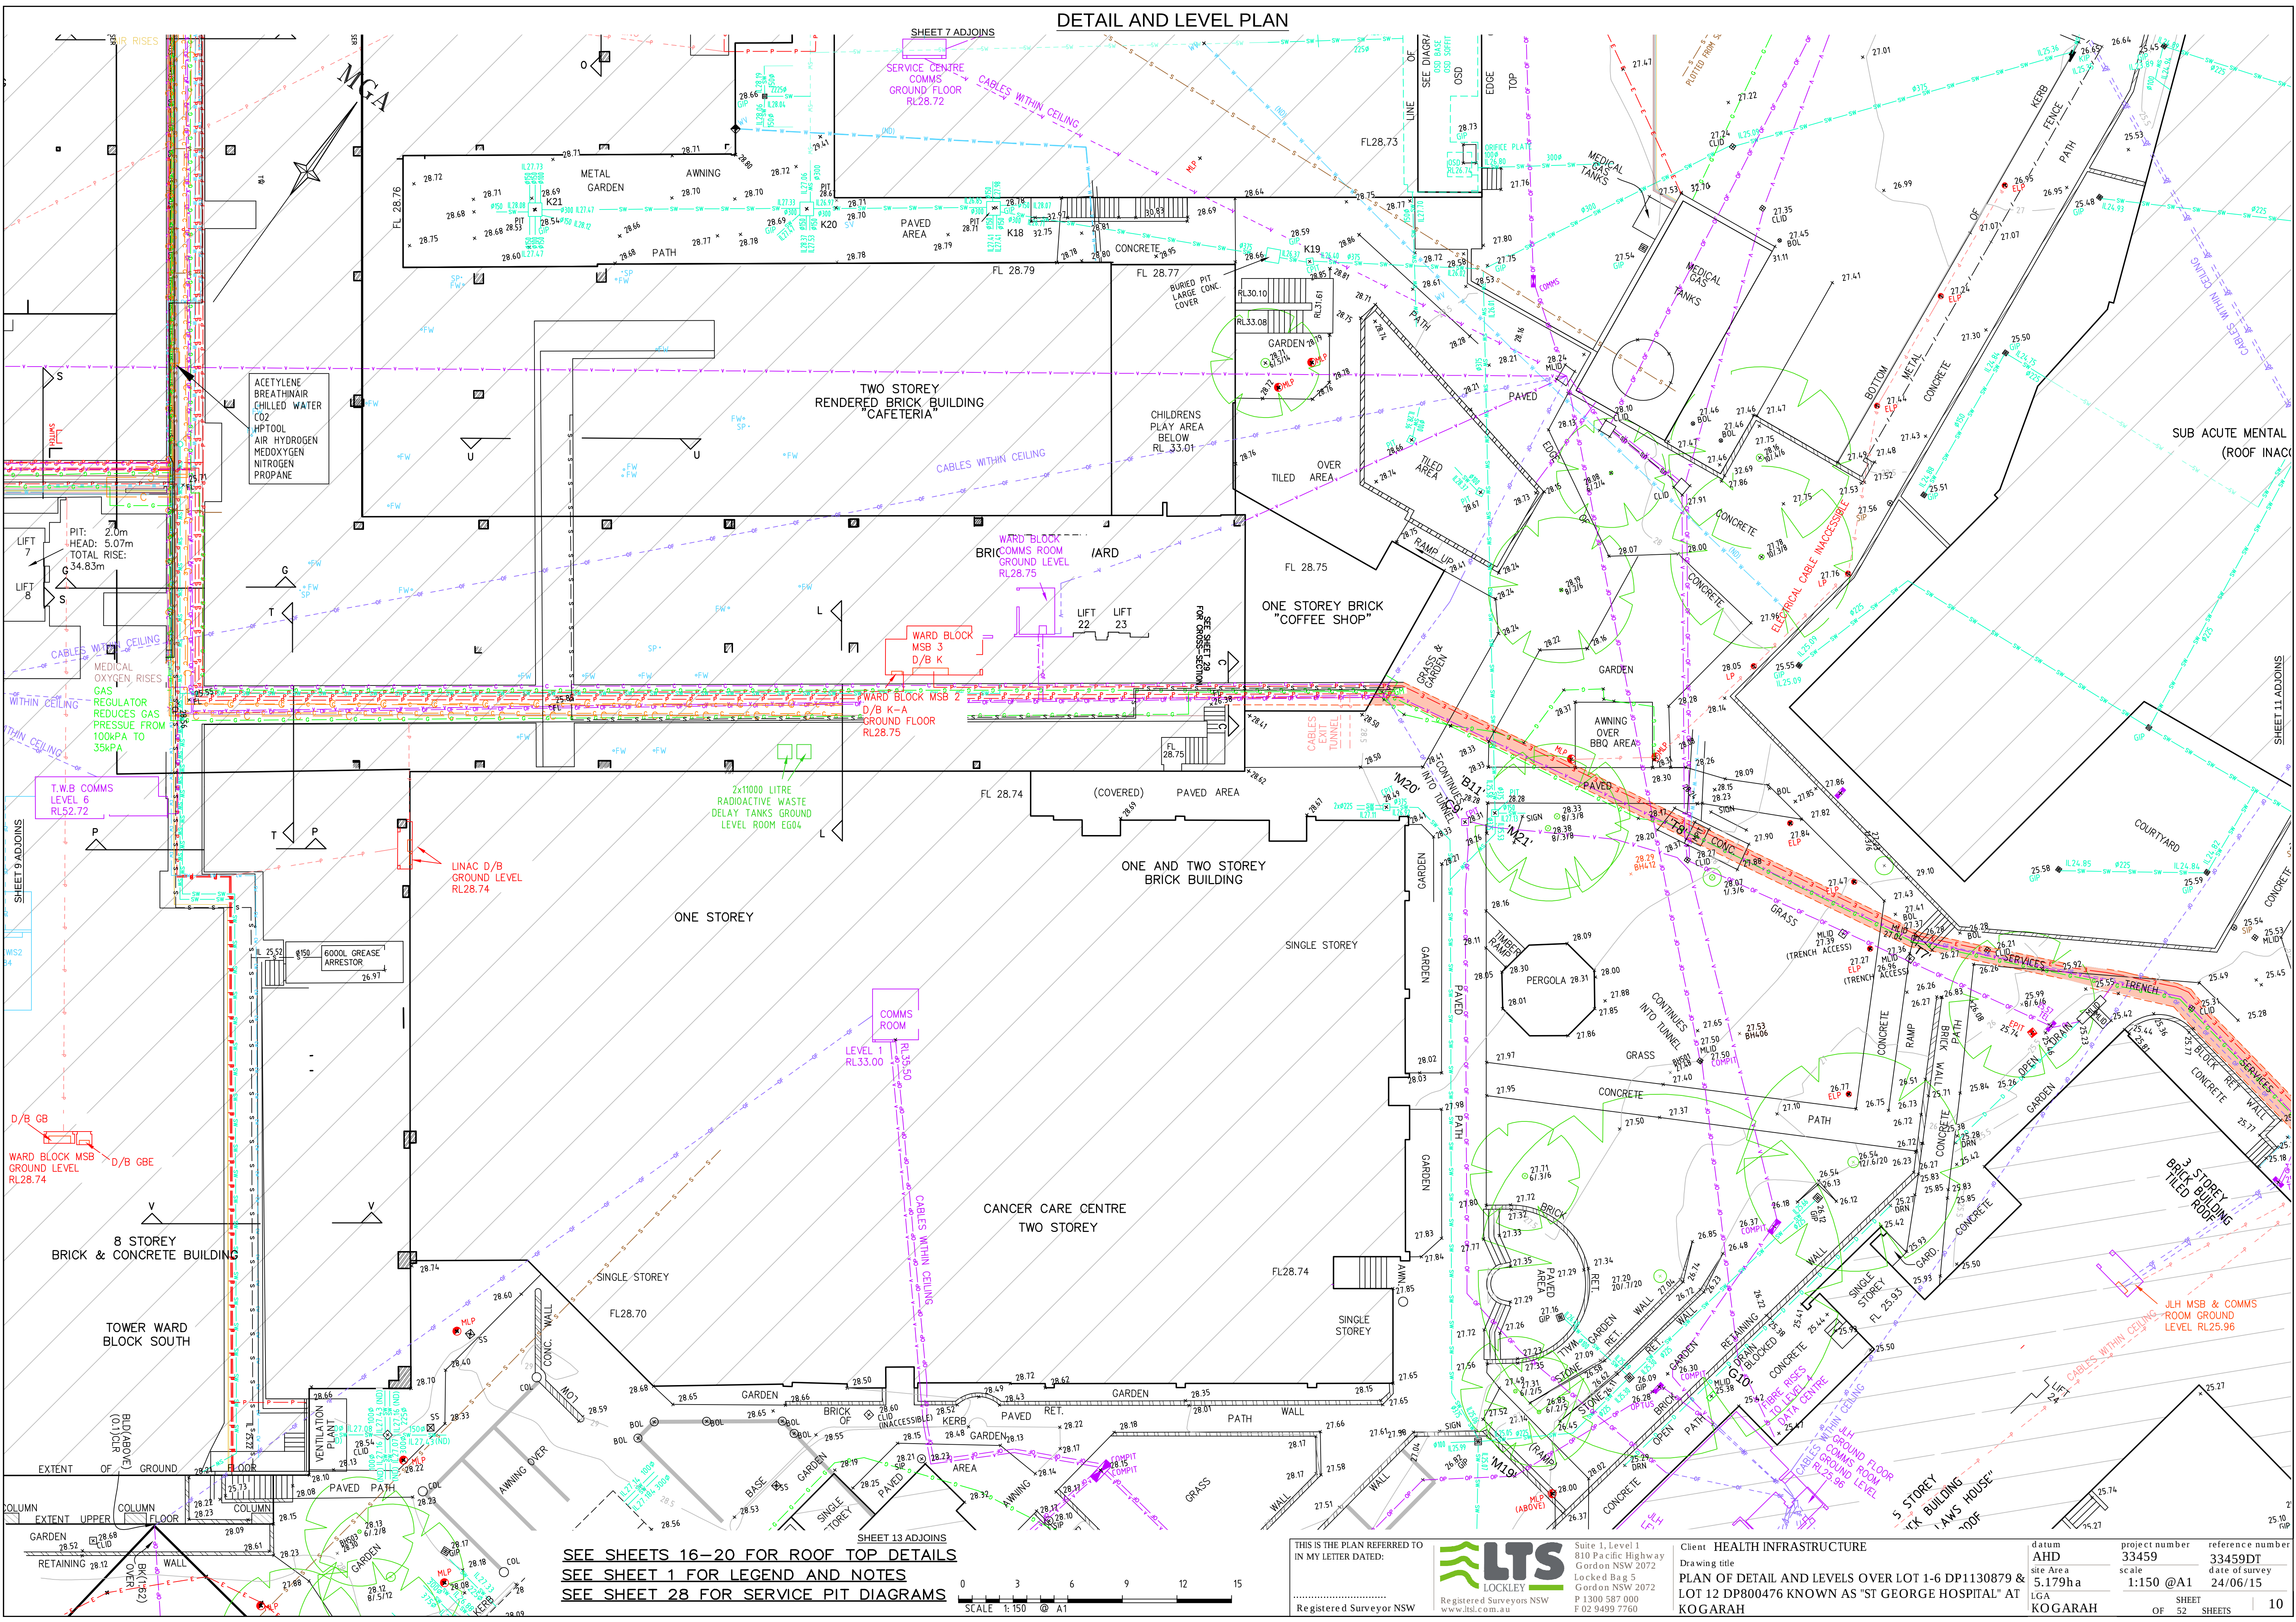

DETAIL AND LEVEL PLAN

SEE SHEETS 16-20 FOR ROOF TOP DETAILS
SEE SHEET 1 FOR LEGEND AND NOTES
SEE SHEET 28 FOR SERVICE PIT DIAGRAMS




THIS IS THE PLAN REFERRED TO
IN MY LETTER DATED:
.....
Registered Surveyor NSW




Suite 1, Level 1
810 Pacific Highway
Gordon NSW 2072
Locked Bag 5
Gordon NSW 2072
P 1300 587 000
F 02 9499 7760

Client HEALTH INFRASTRUCTURE
Drawing title
PLAN OF DETAIL AND LEVELS OVER LOT 1-6 DP1130879 &
LOT 12 DP800476 KNOWN AS "ST GEORGE HOSPITAL" AT
KOGARAH

datum AHD	project number 33459	reference number 33459DT
site Area 5.179ha	scale 1:150 @A1	date of survey 24/06/15
LGA KOGARAH	OF 52	SHEETS 10

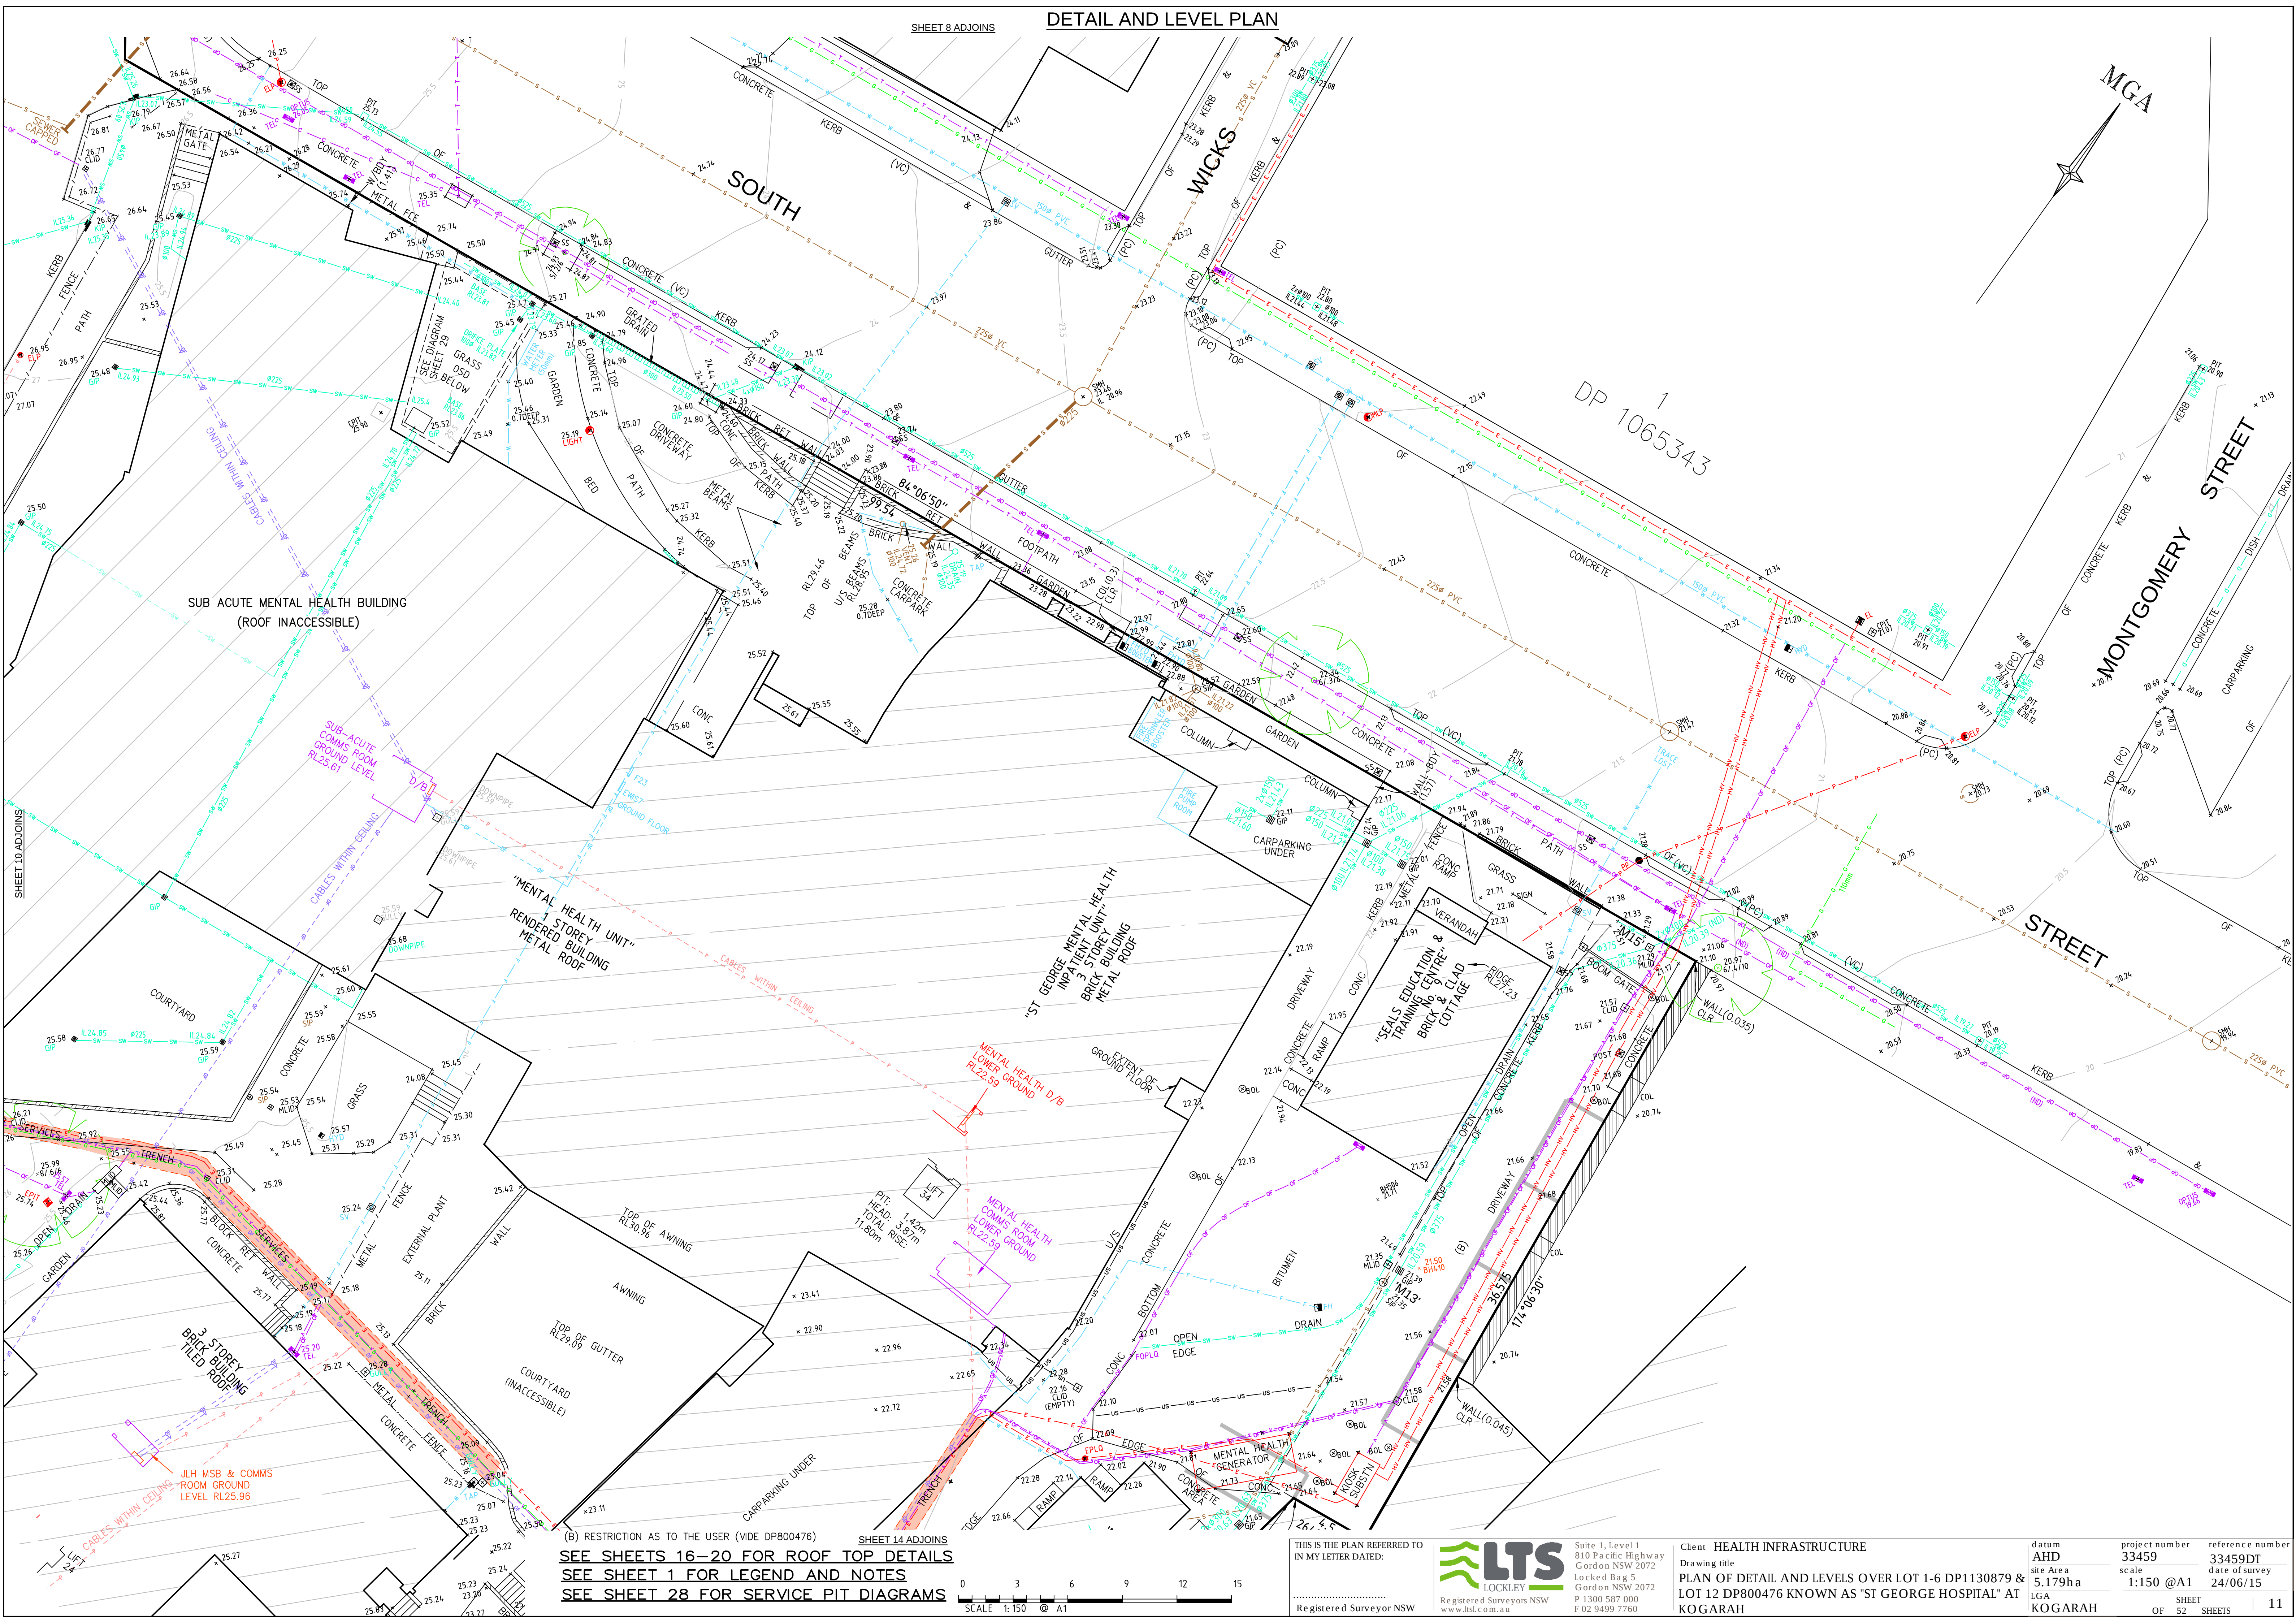

(B) RESTRICTION AS TO THE USER (VIDE DP800476)
SEE SHEETS 16-20 FOR ROOF TOP DETAILS
SEE SHEET 1 FOR LEGEND AND NOTES
SEE SHEET 28 FOR SERVICE PIT DIAGRAMS

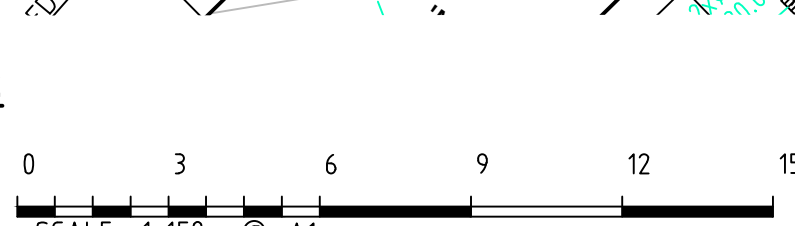

THIS IS THE PLAN REFERRED TO
IN MY LETTER DATED:
Registered Surveyor NSW




Client HEALTH INFRASTRUCTURE
Drawing title
PLAN OF DETAIL AND LEVELS OVER LOT 1-6 DP1130879 &
LOT 12 DP800476 KNOWN AS "ST GEORGE HOSPITAL" AT
KOGARAH

datum AHD	project number 33459	reference number 33459DT
site Area 5.179ha	scale 1:150 @A1	date of survey 24/06/15
LGA KOGARAH	SHEET 52	SHEETS 1

DETAIL AND LEVEL PLAN

SHEET 9 ADJOINS

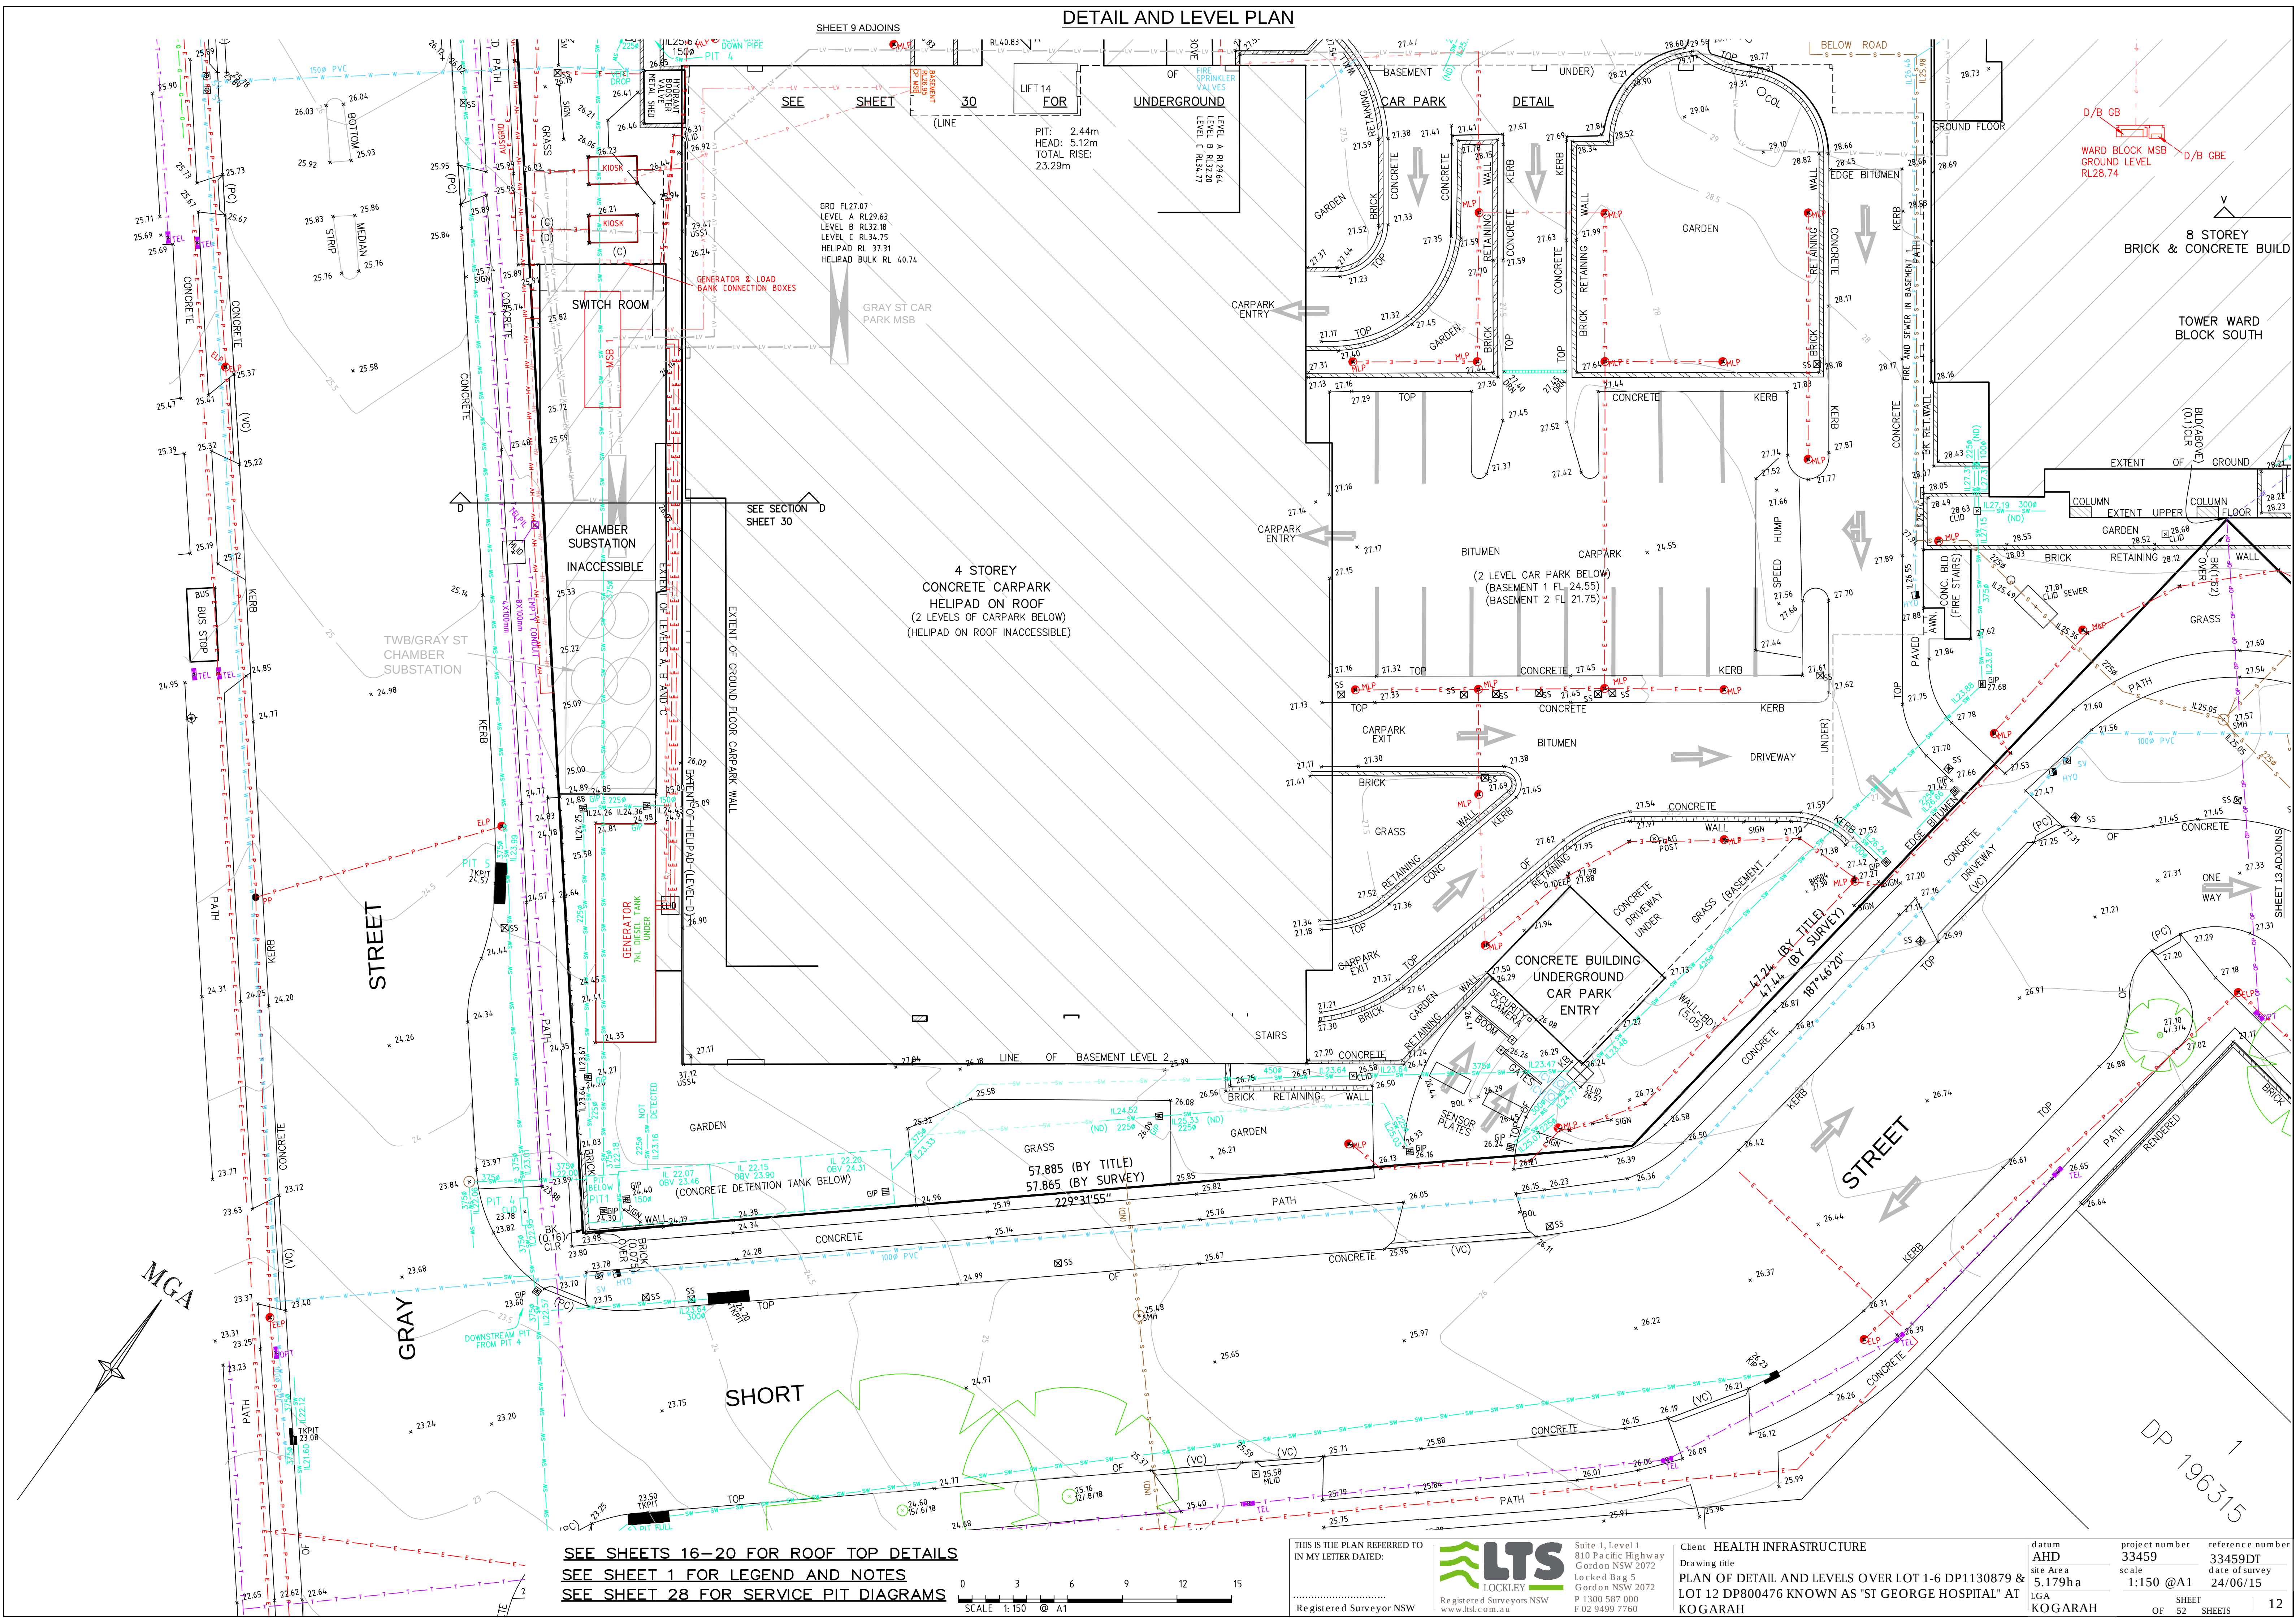

SEE SHEETS 16-20 FOR ROOF TOP DETAILS
SEE SHEET 1 FOR LEGEND AND NOTES
SEE SHEET 28 FOR SERVICE PIT DIAGRAMS

0 3 6 9 12 15
SCALE 1:150 @ A1

THIS IS THE PLAN REFERRED TO
IN MY LETTER DATED:

LTS
LOCKLEY
Registered Surveyors NSW
www.lts.com.au


Suite 1, Level 1
810 Pacific Highway
Gordon NSW 2072
Locked Bag 5
Gordon NSW 2072
P 1300 587 000
F 02 9499 7760

Client **HEALTH INFRASTRUCTURE**
Drawing title
PLAN OF DETAIL AND LEVELS OVER LOT 1-6 DP1130879 & LOT 12 DP800476 KNOWN AS "ST GEORGE HOSPITAL" AT KOGARAH

datum
AHD
site Area
5.179ha
LGA
KOGARAH


project number
33459
scale
1:150 @A1
OF 52 SHEETS

reference number
33459DT
date of survey
24/06/15

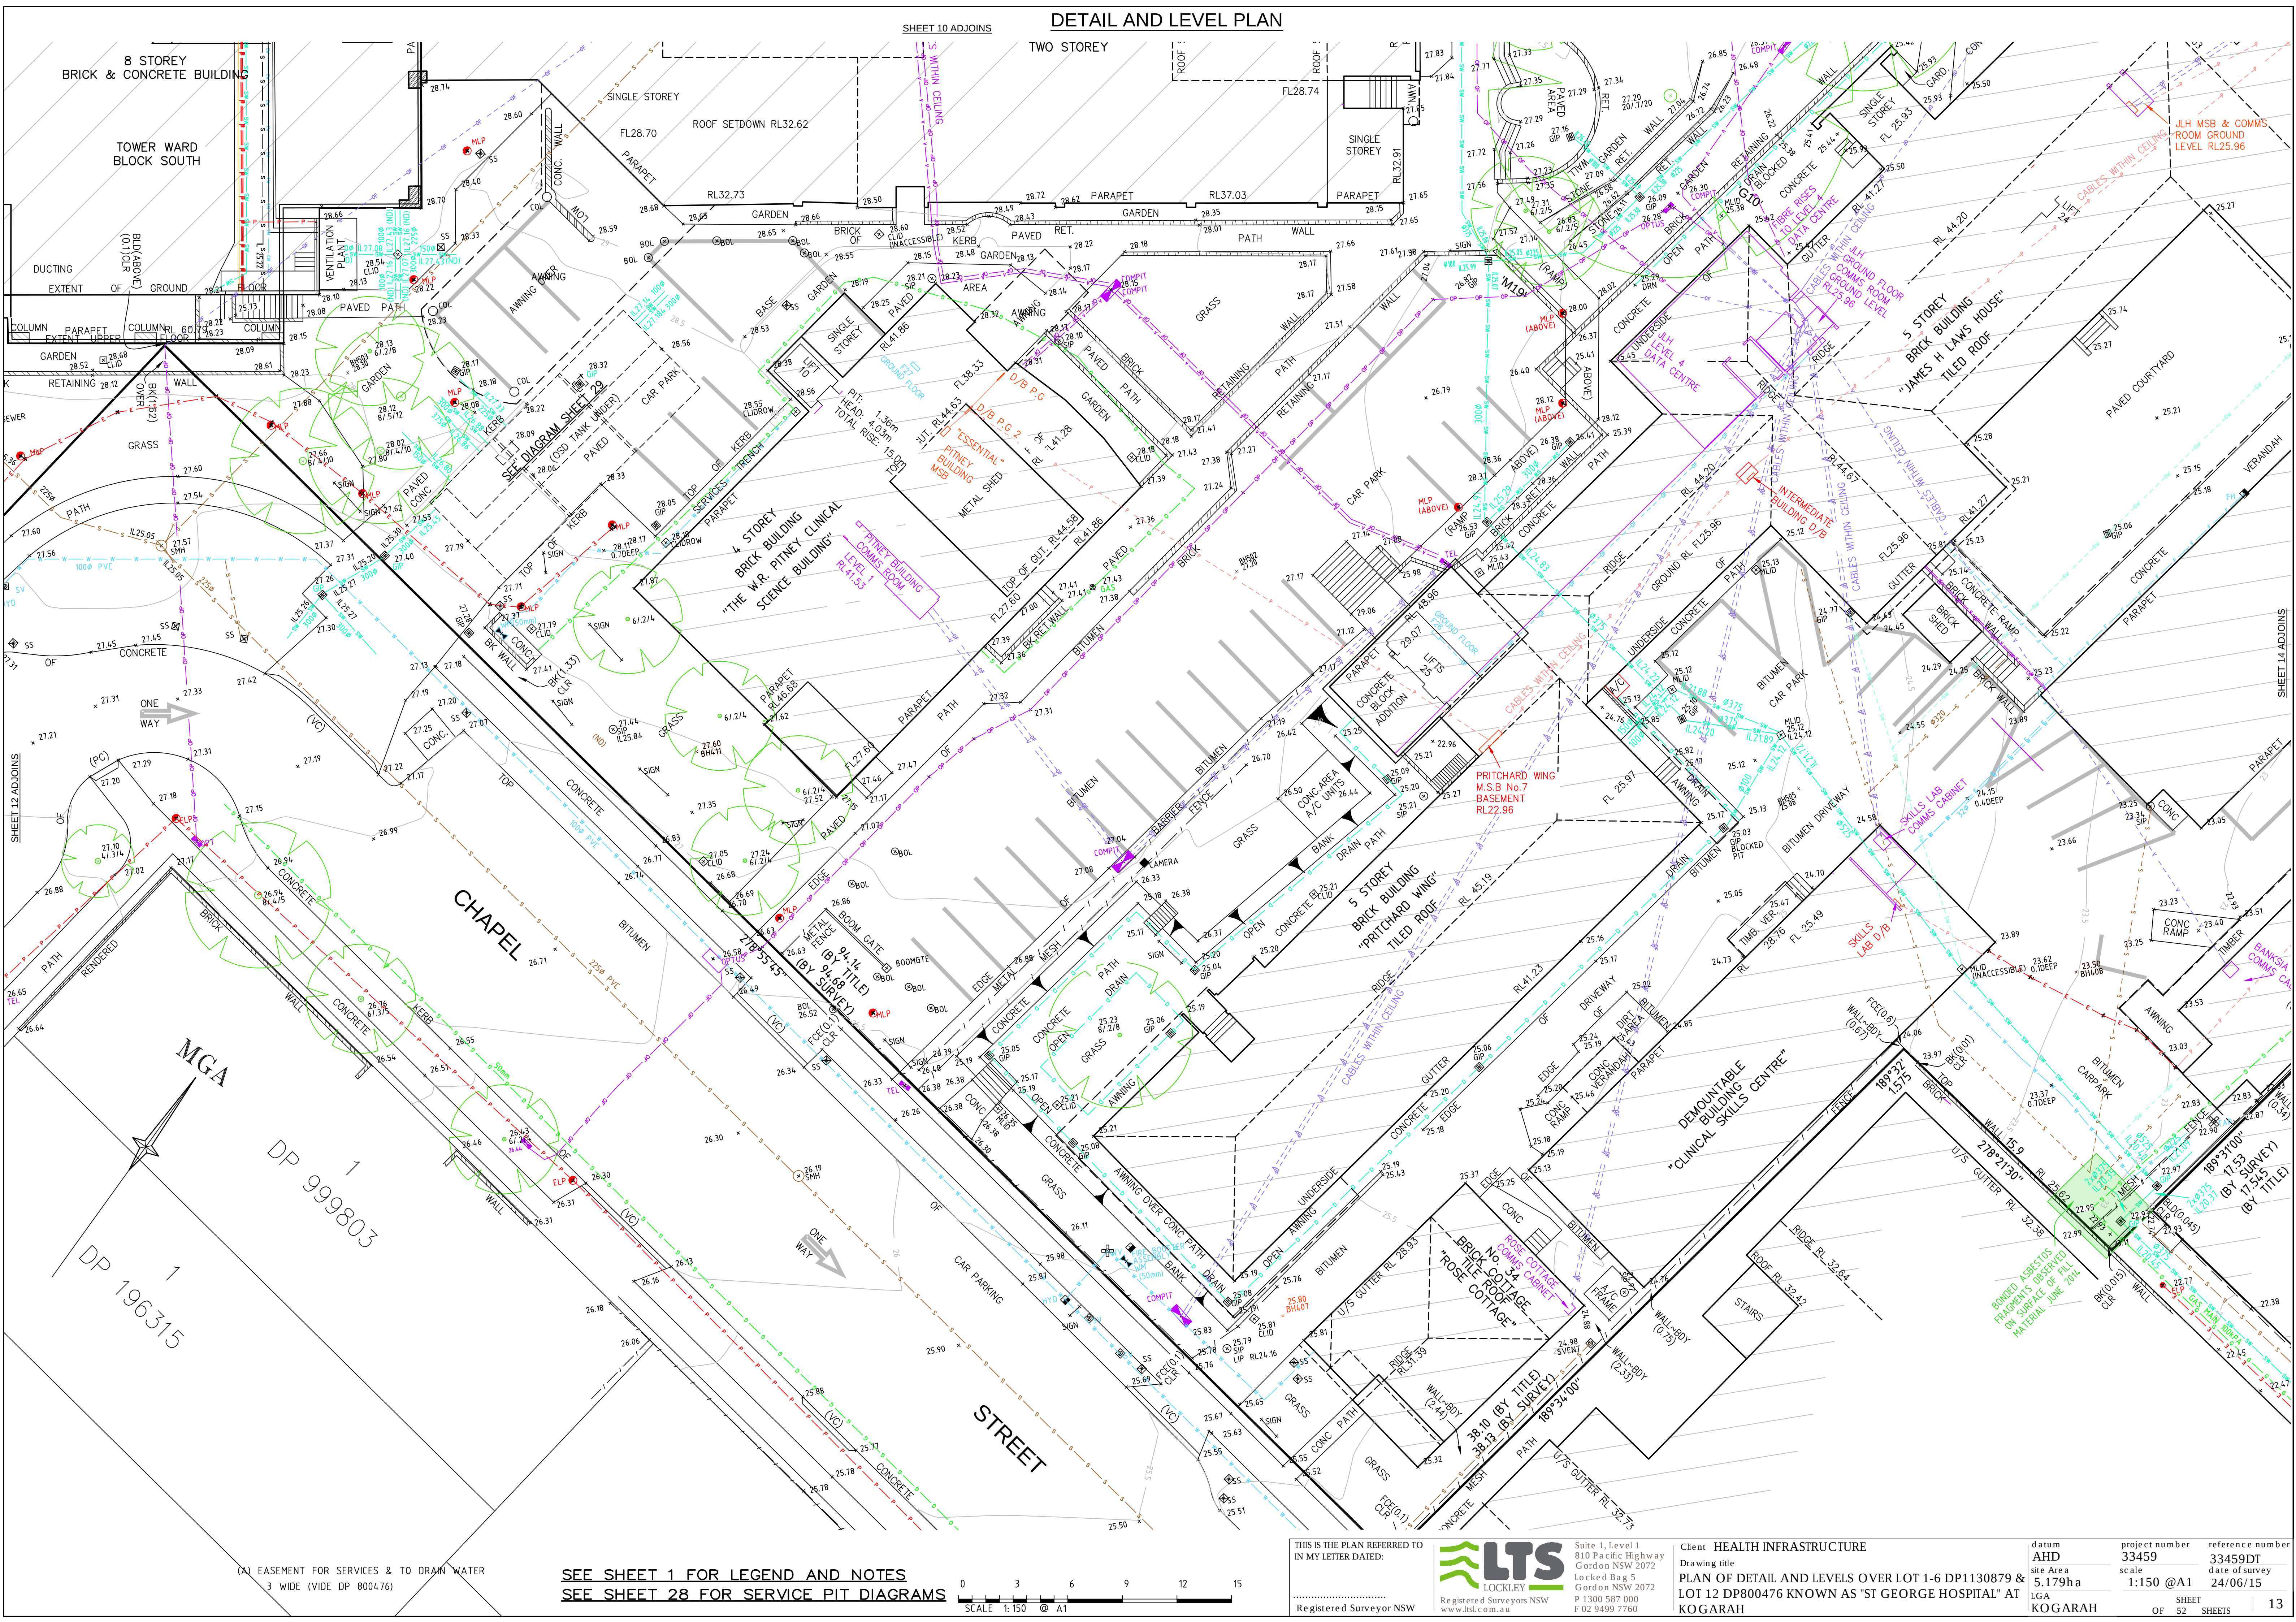

(A) EASEMENT FOR SERVICES & TO DRAIN WATER
3 WIDE (VIDE DP 800476)

SEE SHEET 1 FOR LEGEND AND NOTES
SEE SHEET 28 FOR SERVICE PIT DIAGRAMS

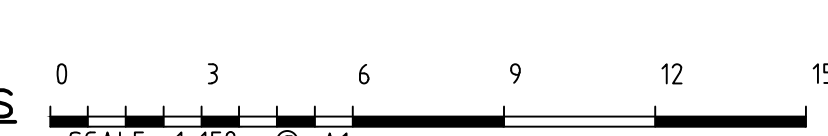

THIS IS THE PLAN REFERRED TO
IN MY LETTER DATED:

Registered Surveyor NSW

Lockley
Registered Surveyors NSW
www.lts.com.au


Suite 1, Level 1
810 Pacific Highway
Gordon NSW 2072
Locked Bag 5
Gordon NSW 2072
P 1300 587 000
F 02 9499 7760

Client **HEALTH INFRASTRUCTURE**
Drawing title
**PLAN OF DETAIL AND LEVELS OVER LOT 1-6 DP1130879 &
LOT 12 DP800476 KNOWN AS "ST GEORGE HOSPITAL" AT
KOGARAH**

datum
AHD
site Area
5.179ha
LGA
KOGARAH

project number
33459
scale
1:150 @A1
OF 52 SHEETS

reference number
33459DT
date of survey
24/06/15
13

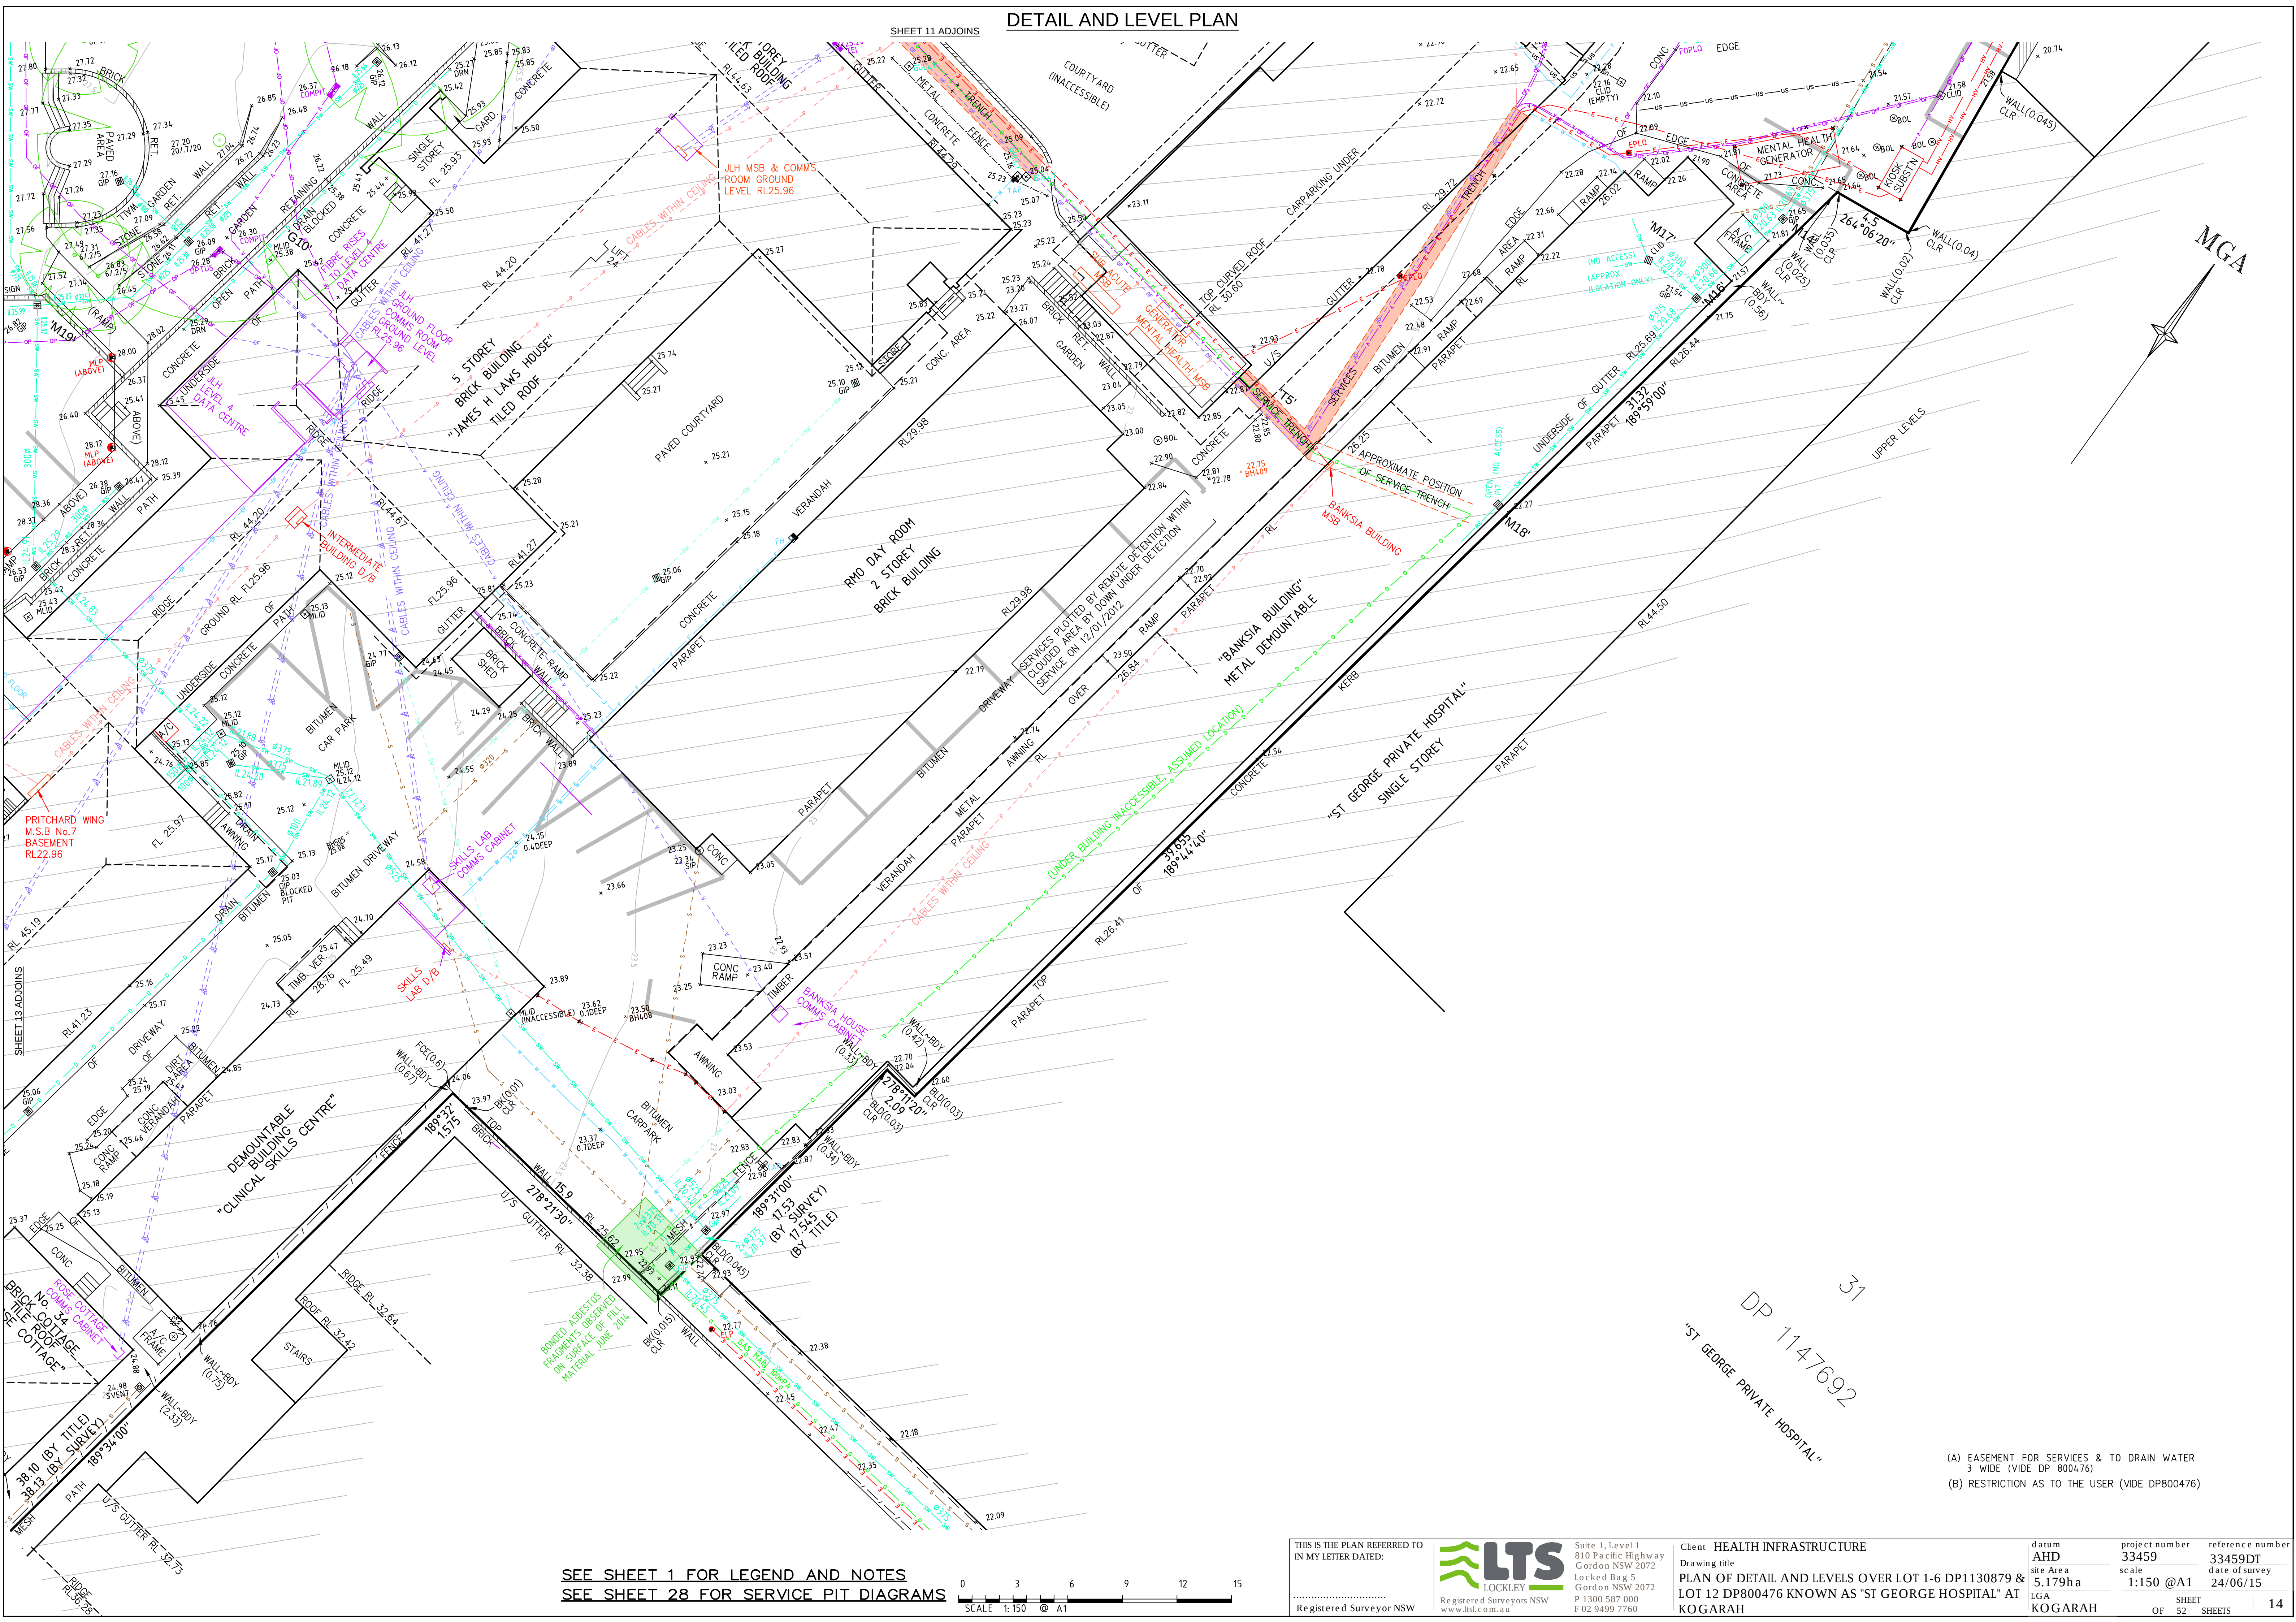

SEE SHEET 1 FOR LEGEND AND NOTES
SEE SHEET 28 FOR SERVICE PIT DIAGRAMS



THIS IS THE PLAN REFERRED TO
IN MY LETTER DATED:
.....
Registered Surveyor NSW



Suite 1, Level 1
810 Pacific Highway
Gordon NSW 2072
Locked Bag 5
Gordon NSW 2072
P 1300 587 000
F 02 9499 7760

Client HEALTH INFRASTRUCTURE
Drawing title
PLAN OF DETAIL AND LEVELS OVER LOT 1-6 DP1130879 &
LOT 12 DP800476 KNOWN AS "ST GEORGE HOSPITAL" AT
KOGARAH

datum AHD	project number 33459	reference number 33459DT
site Area 5.179ha	scale 1:150 @A1	date of survey 24/06/15
LGA KOGARAH	SHEET 52	SHEETS 14

(A) EASEMENT FOR SERVICES & TO DRAIN WATER
3 WIDE (VIDE DP 800476)
(B) RESTRICTION AS TO THE USER (VIDE DP800476)

DETAIL AND LEVEL PLAN


MGA

37
DP 1147692
"ST GEORGE PRIVATE HOSPITAL"

(A) EASEMENT FOR SERVICES & TO DRAIN WATER
3 WIDE (VIDE DP 800476)

(B) RESTRICTION AS TO THE USER (VIDE DP800476)

SEE SHEET 1 FOR LEGEND AND NOTES
SEE SHEET 28 FOR SERVICE PIT DIAGRAM

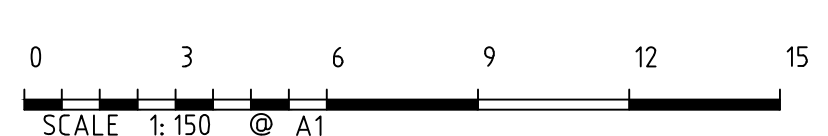

THIS IS THE PLAN REFERRED TO
IN MY LETTER DATED:

.....

Registered Surveyor NSW




Suite 1, Level 1
810 Pacific Highway
Gordon NSW 2072
Locked Bag 5
Gordon NSW 2072
P 1300 587 000
F 02 9499 7760

Client **HEALTH INFRASTRUCTURE**
Drawing title
**PLAN OF DETAIL AND LEVELS OVER LOT 1-6 DP1130879 &
LOT 12 DP800476 KNOWN AS "ST GEORGE HOSPITAL" AT
KOGARAH**

datum	project number	reference number
AHD	33459	33459DT
site Area	scale	date of survey
5.179ha	1:150 @A1	24/06/15
LGA	SHEET	15
KOGARAH	OF 52 SHEETS	

ROOF PLAN

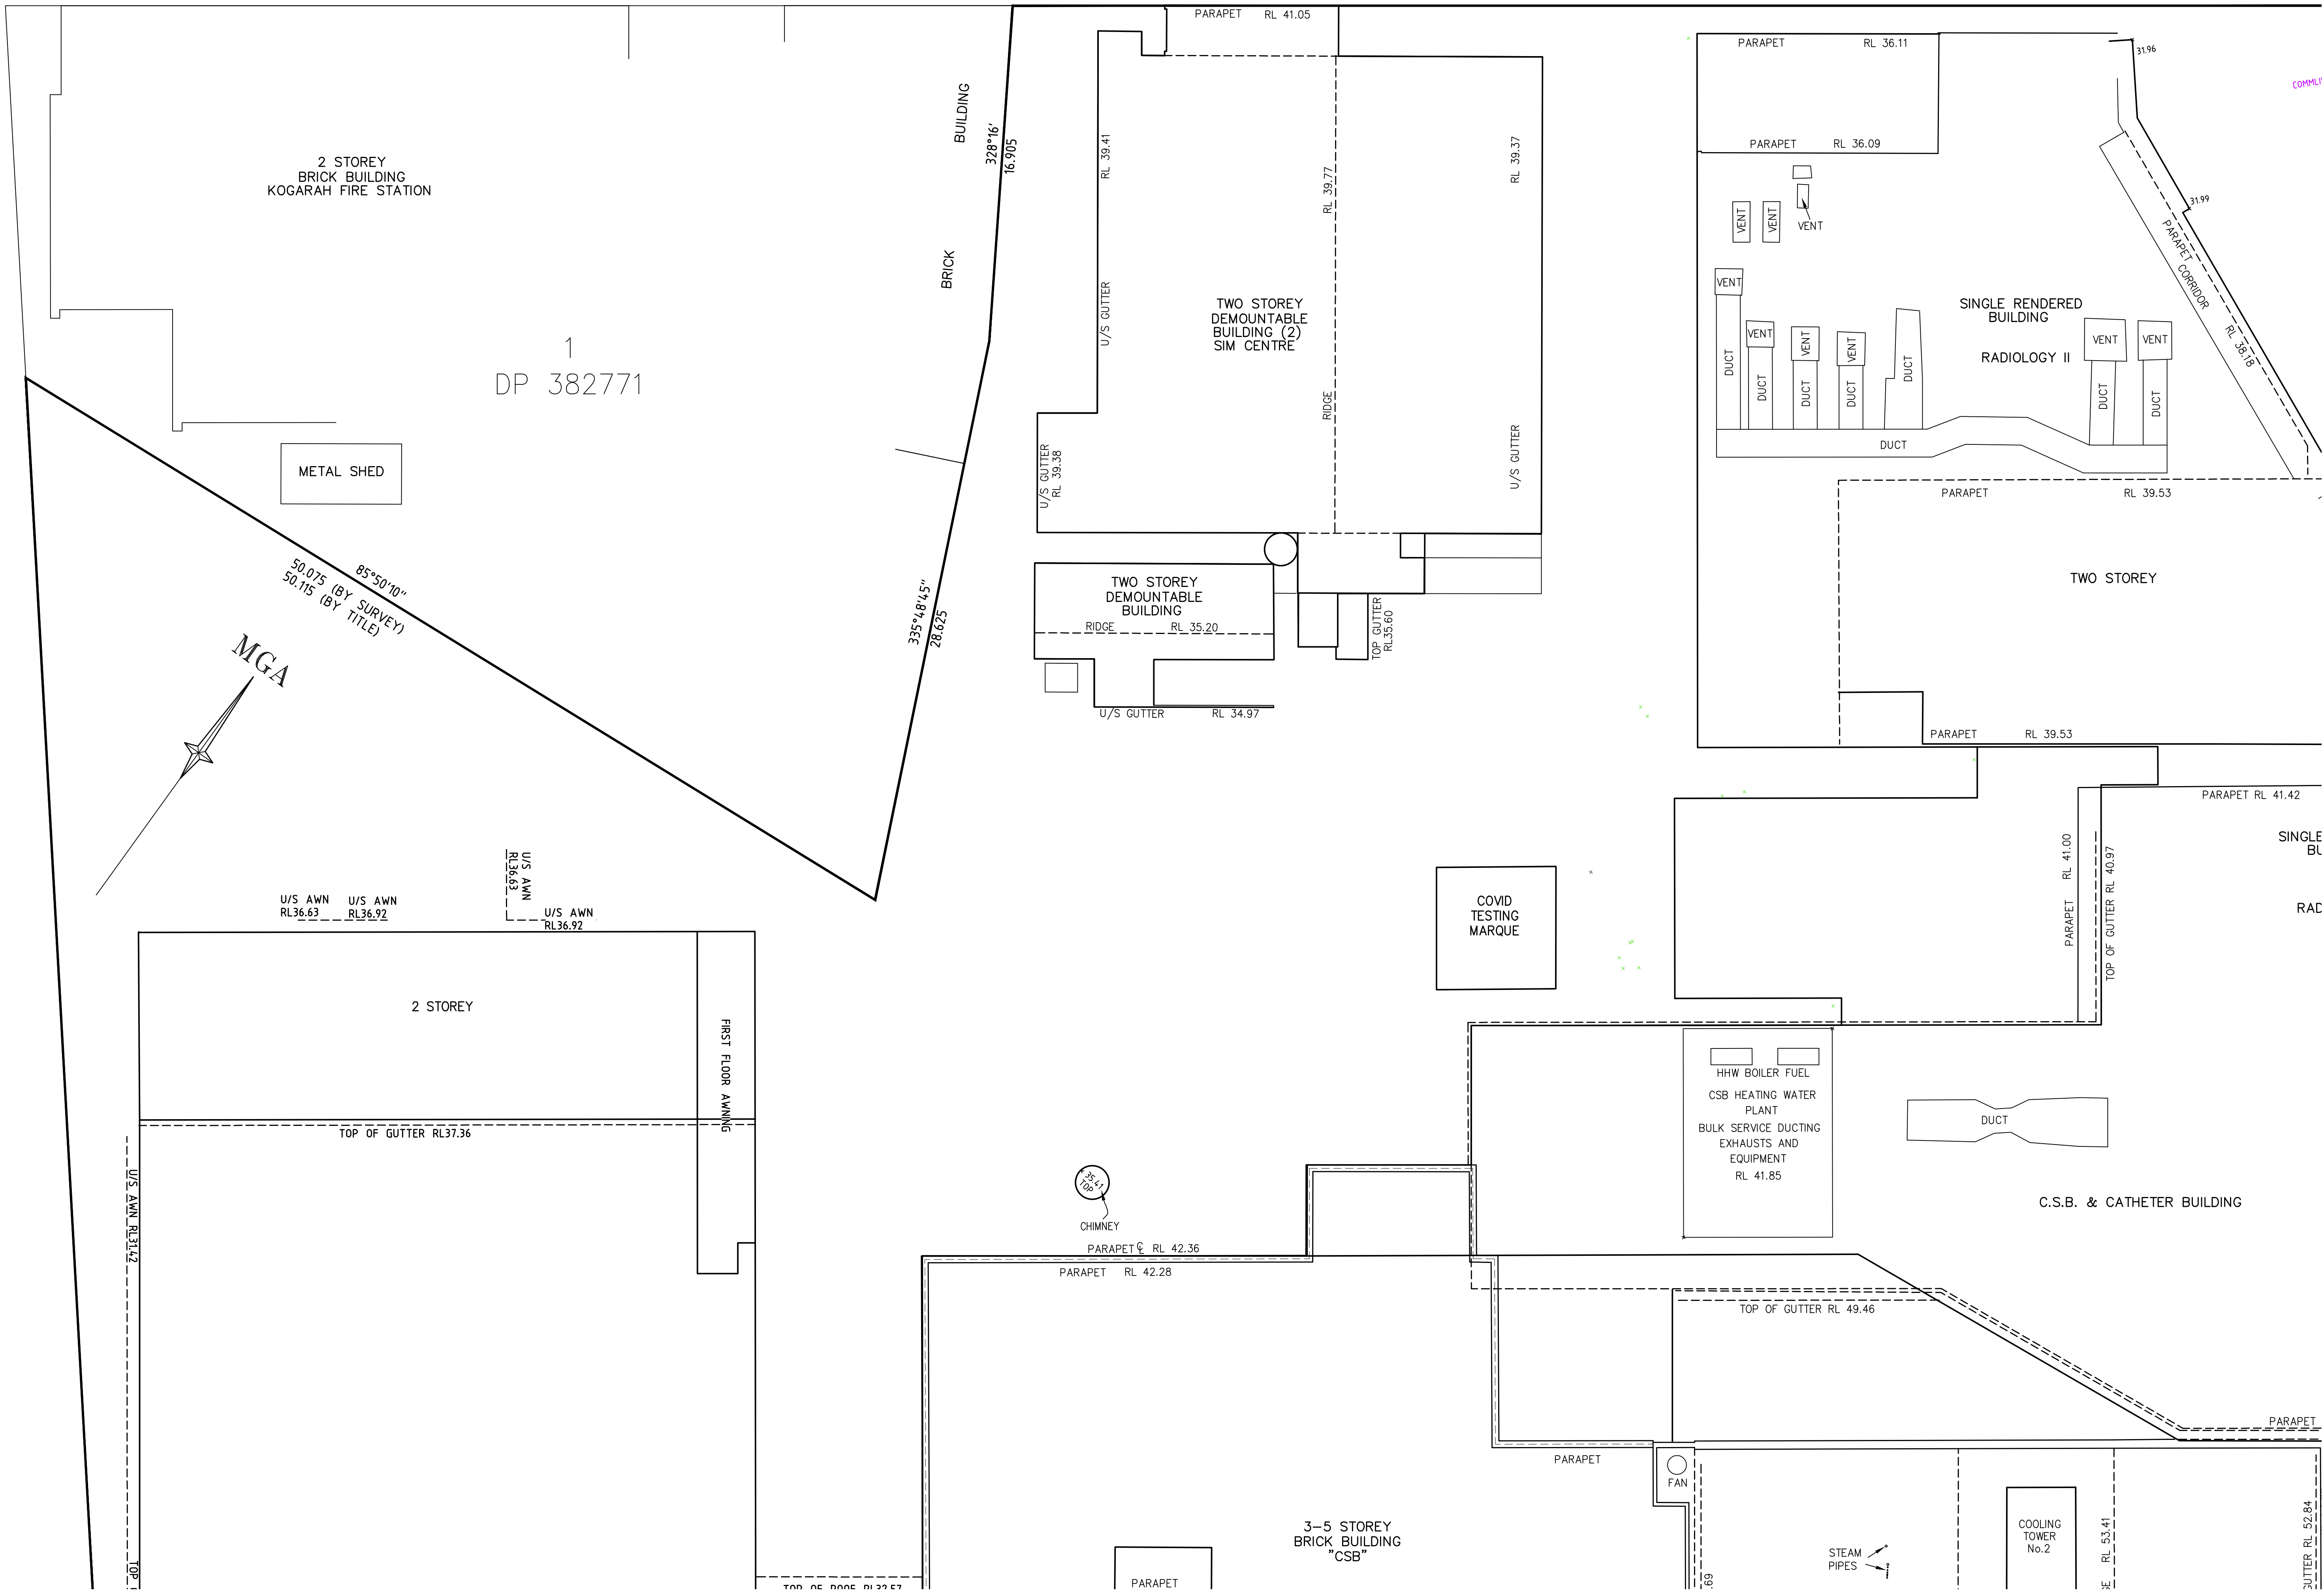

ADJOINS
SHEET 17

SEE SHEET 1 FOR LEGEND AND NOTES




THIS IS THE PLAN REFERRED TO
IN MY LETTER DATED:
.....
Registered Surveyor NSW

LTS
LOCKLEY
Registered Surveyors NSW
www.ltsl.com.au

Suite 1, Level 1
810 Pacific Highway
Gordon NSW 2072
Locked Bag 5
Gordon NSW 2072
P 1300 587 000
F 02 9499 7760

Client	HEALTH INFRASTRUCTURE			datum	AHD	project number	33459	reference number	33459DT
	Drawing title			site Area	5.179ha	scale	1:150 @A1	date of survey	24/06/15
	PLAN OF DETAIL AND LEVELS OVER LOT 1-6 DP1130879 & LOT 12 DP800476 KNOWN AS "ST GEORGE HOSPITAL" AT KOGARAH			LGA	KOGARAH				

ROOF PLAN

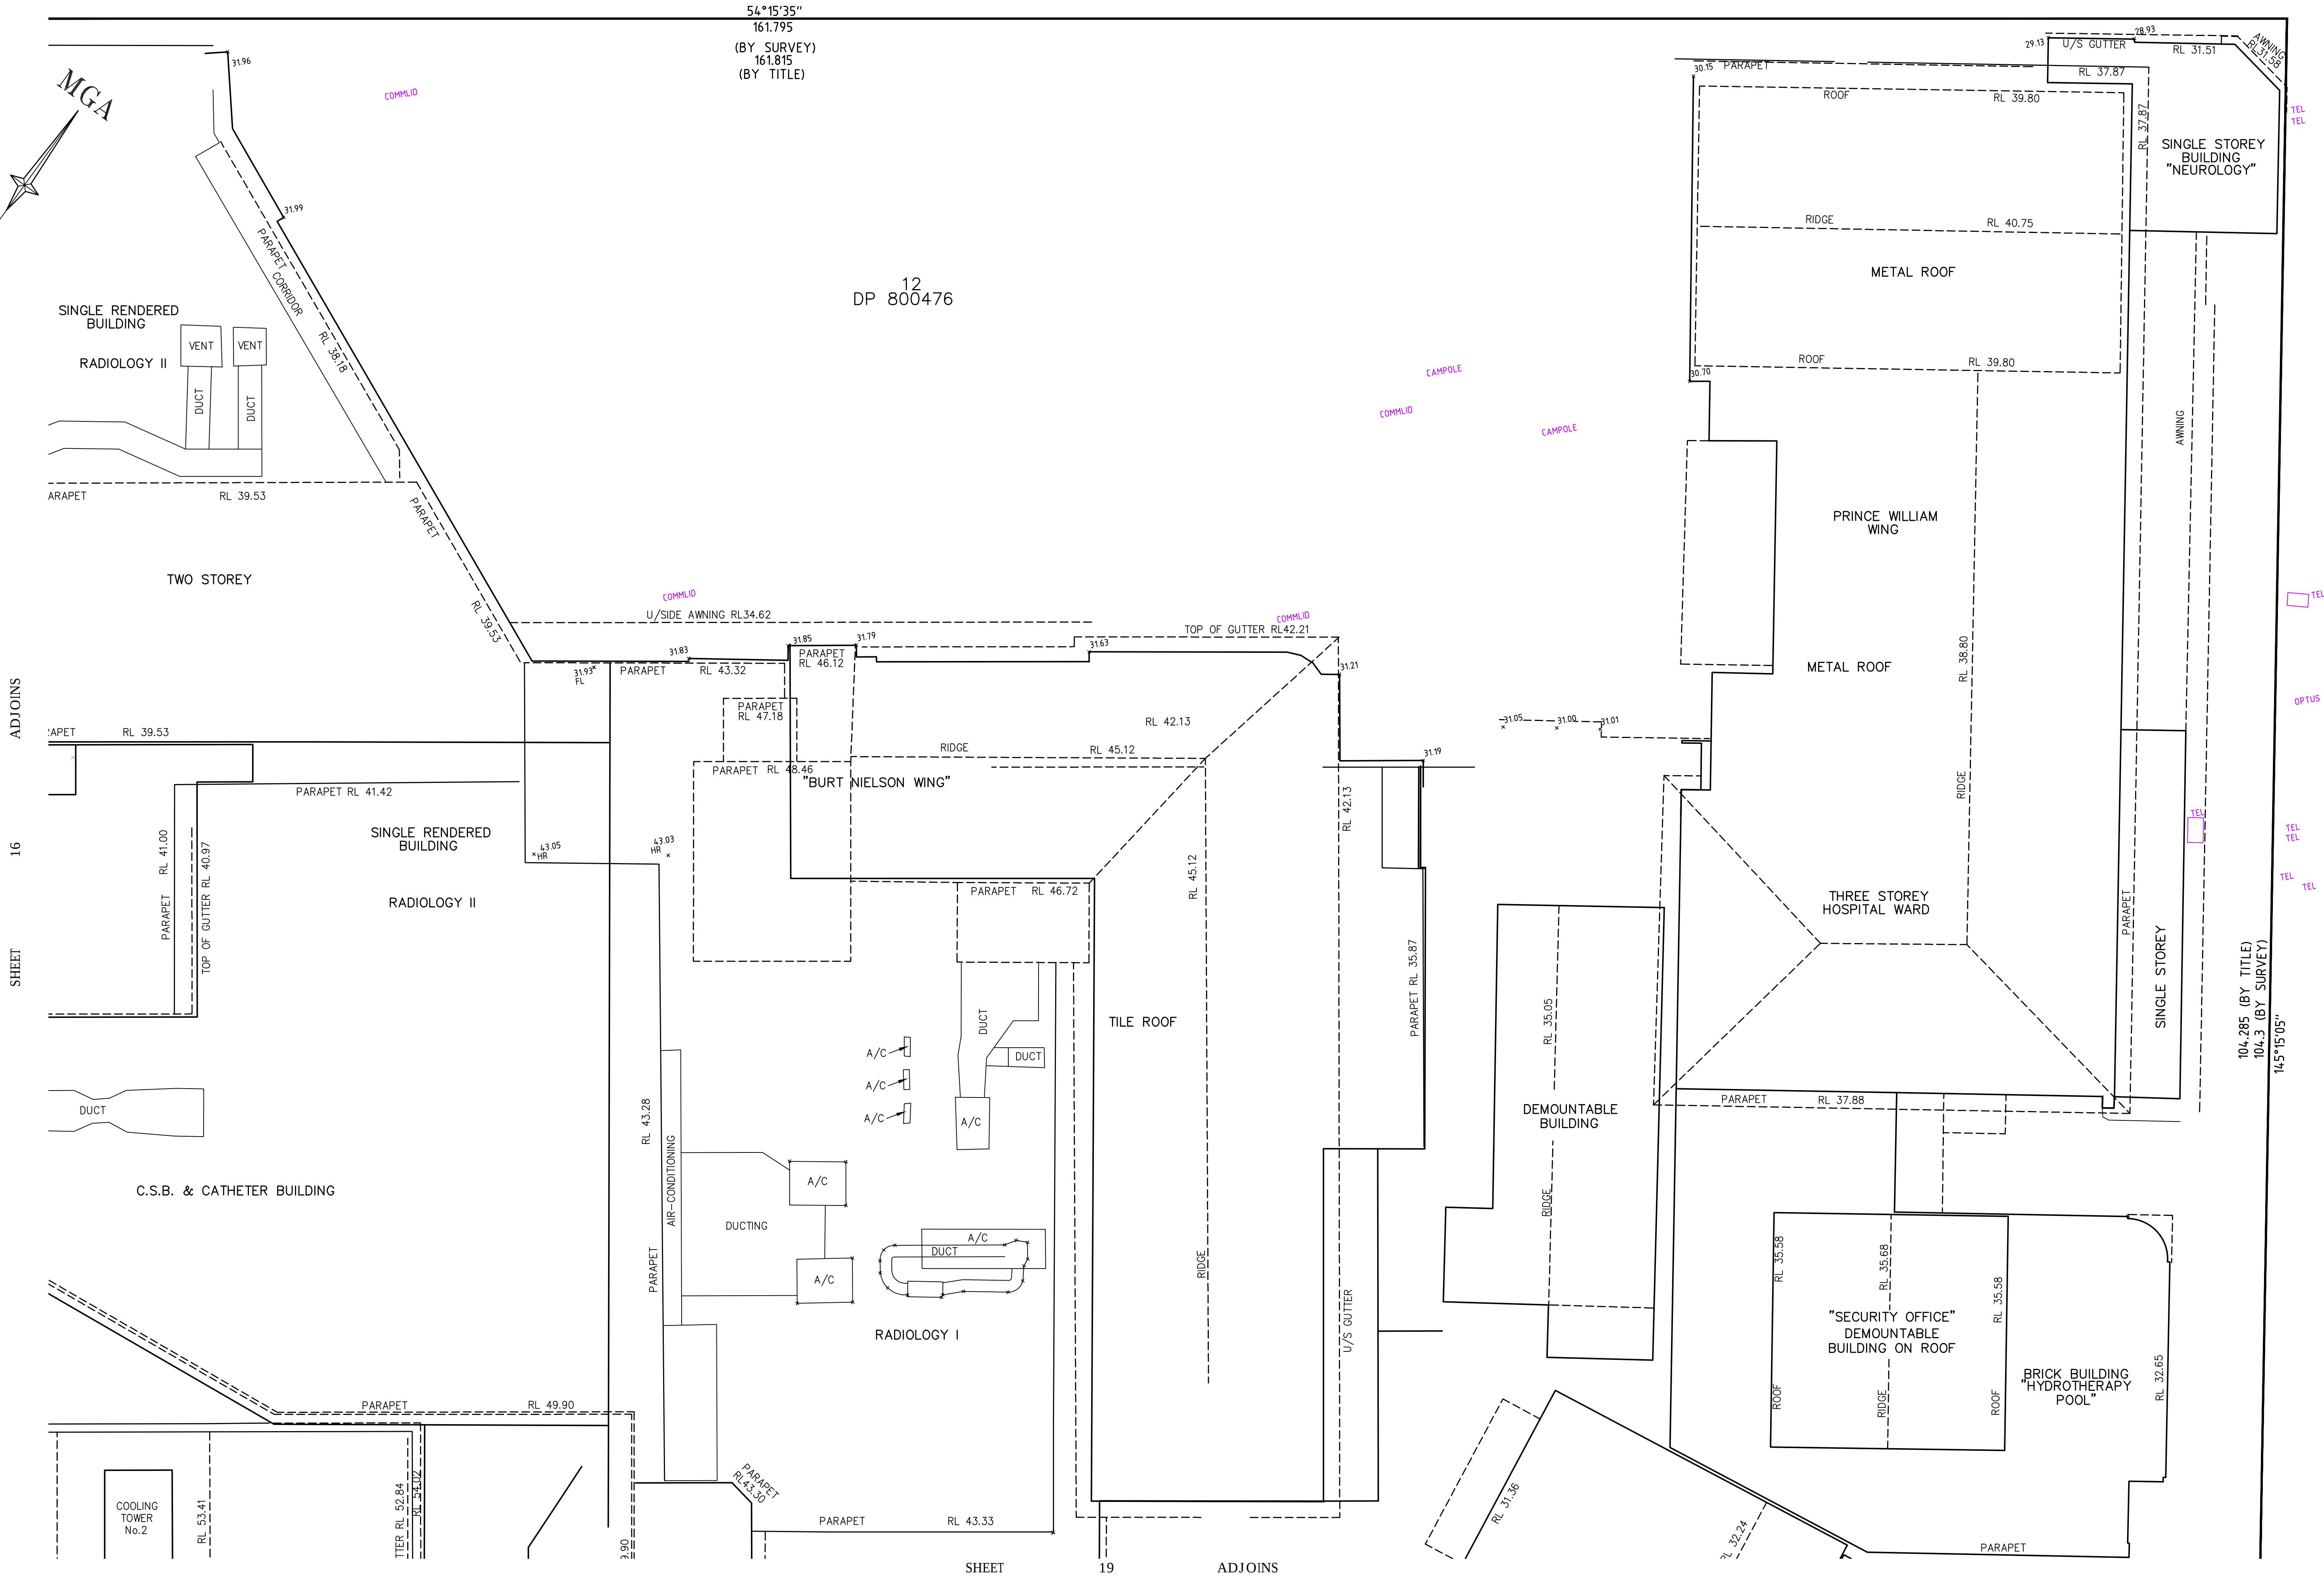

SEE SHEET 1 FOR LEGEND AND NOTES



THIS IS THE PLAN REFERRED TO
IN MY LETTER DATED:
.....
Registered Surveyor NSW

LTS
LOCKLEY
Registered Surveyors NSW
www.ltsl.com.au

Suite 1, Level 1
810 Pacific Highway
Gordon NSW 2072
Locked Bag 5
Gordon NSW 2072
P 1300 587 000
F 02 9499 7760


Client **HEALTH INFRASTRUCTURE**
Drawing title
**PLAN OF DETAIL AND LEVELS OVER LOT 1-6 DP1130879 &
LOT 12 DP800476 KNOWN AS "ST GEORGE HOSPITAL" AT
KOGARAH**

datum
AHD
site Area
5.179ha
LGA
KOGARAH

project number
33459
scale
1:150 @A1
OF 52 SHEETS

reference number
33459DT
date of survey
24/06/15
17

ROOF PLAN

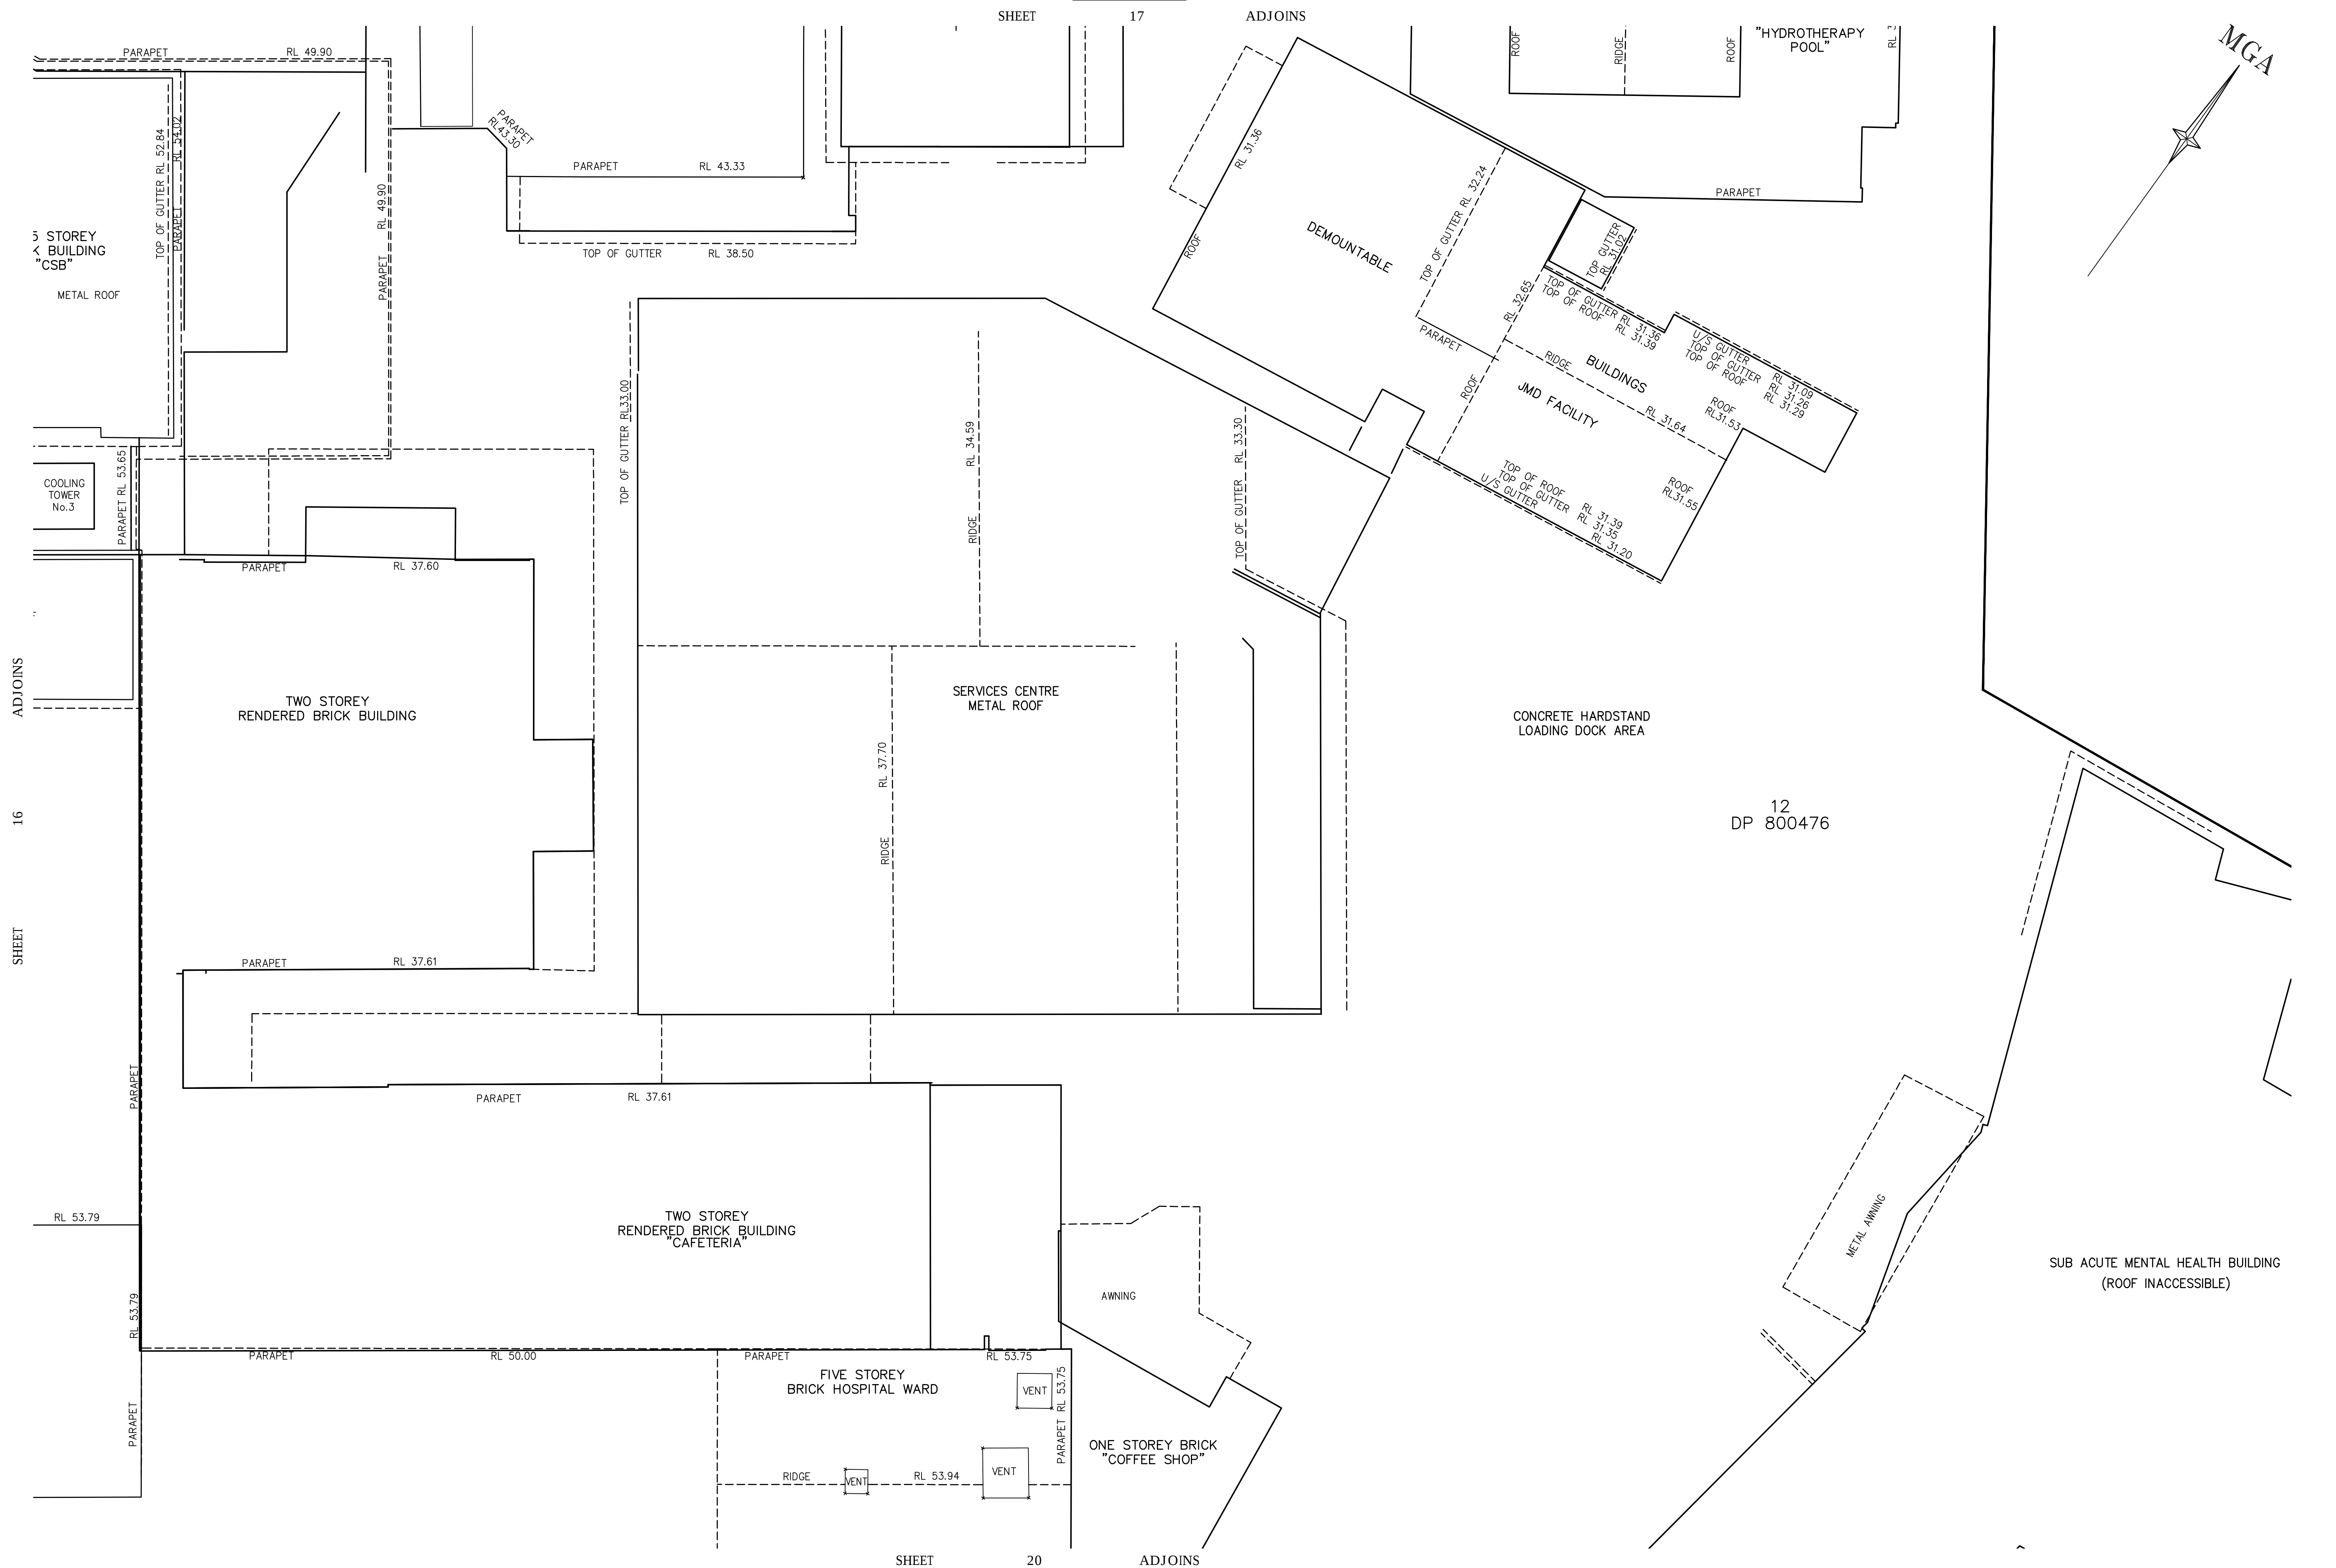

SEE SHEET 1 FOR LEGEND AND NOTES



THIS IS THE PLAN REFERRED TO
IN MY LETTER DATED:

Registered Surveyor NSW



Suite 1, Level 1
810 Pacific Highway
Gordon NSW 2072
Locked Bag 5
Gordon NSW 2072
P 1300 587 000
F 02 9499 7760

Client HEALTH INFRASTRUCTURE

Drawing title

PLAN OF DETAIL AND LEVELS OVER LOT 1-6 DP1130879 &
LOT 12 DP800476 KNOWN AS "ST GEORGE HOSPITAL" AT
KOGARAH

datum
AHD
site Area
5.179ha
LGA
KOGARAH

project number
33459
scale
1:100 @A1


OF 52 SHEETS

reference number
33459DT
date of survey
24/06/15

ROOF PLAN

SHEET 19

ADJOINS

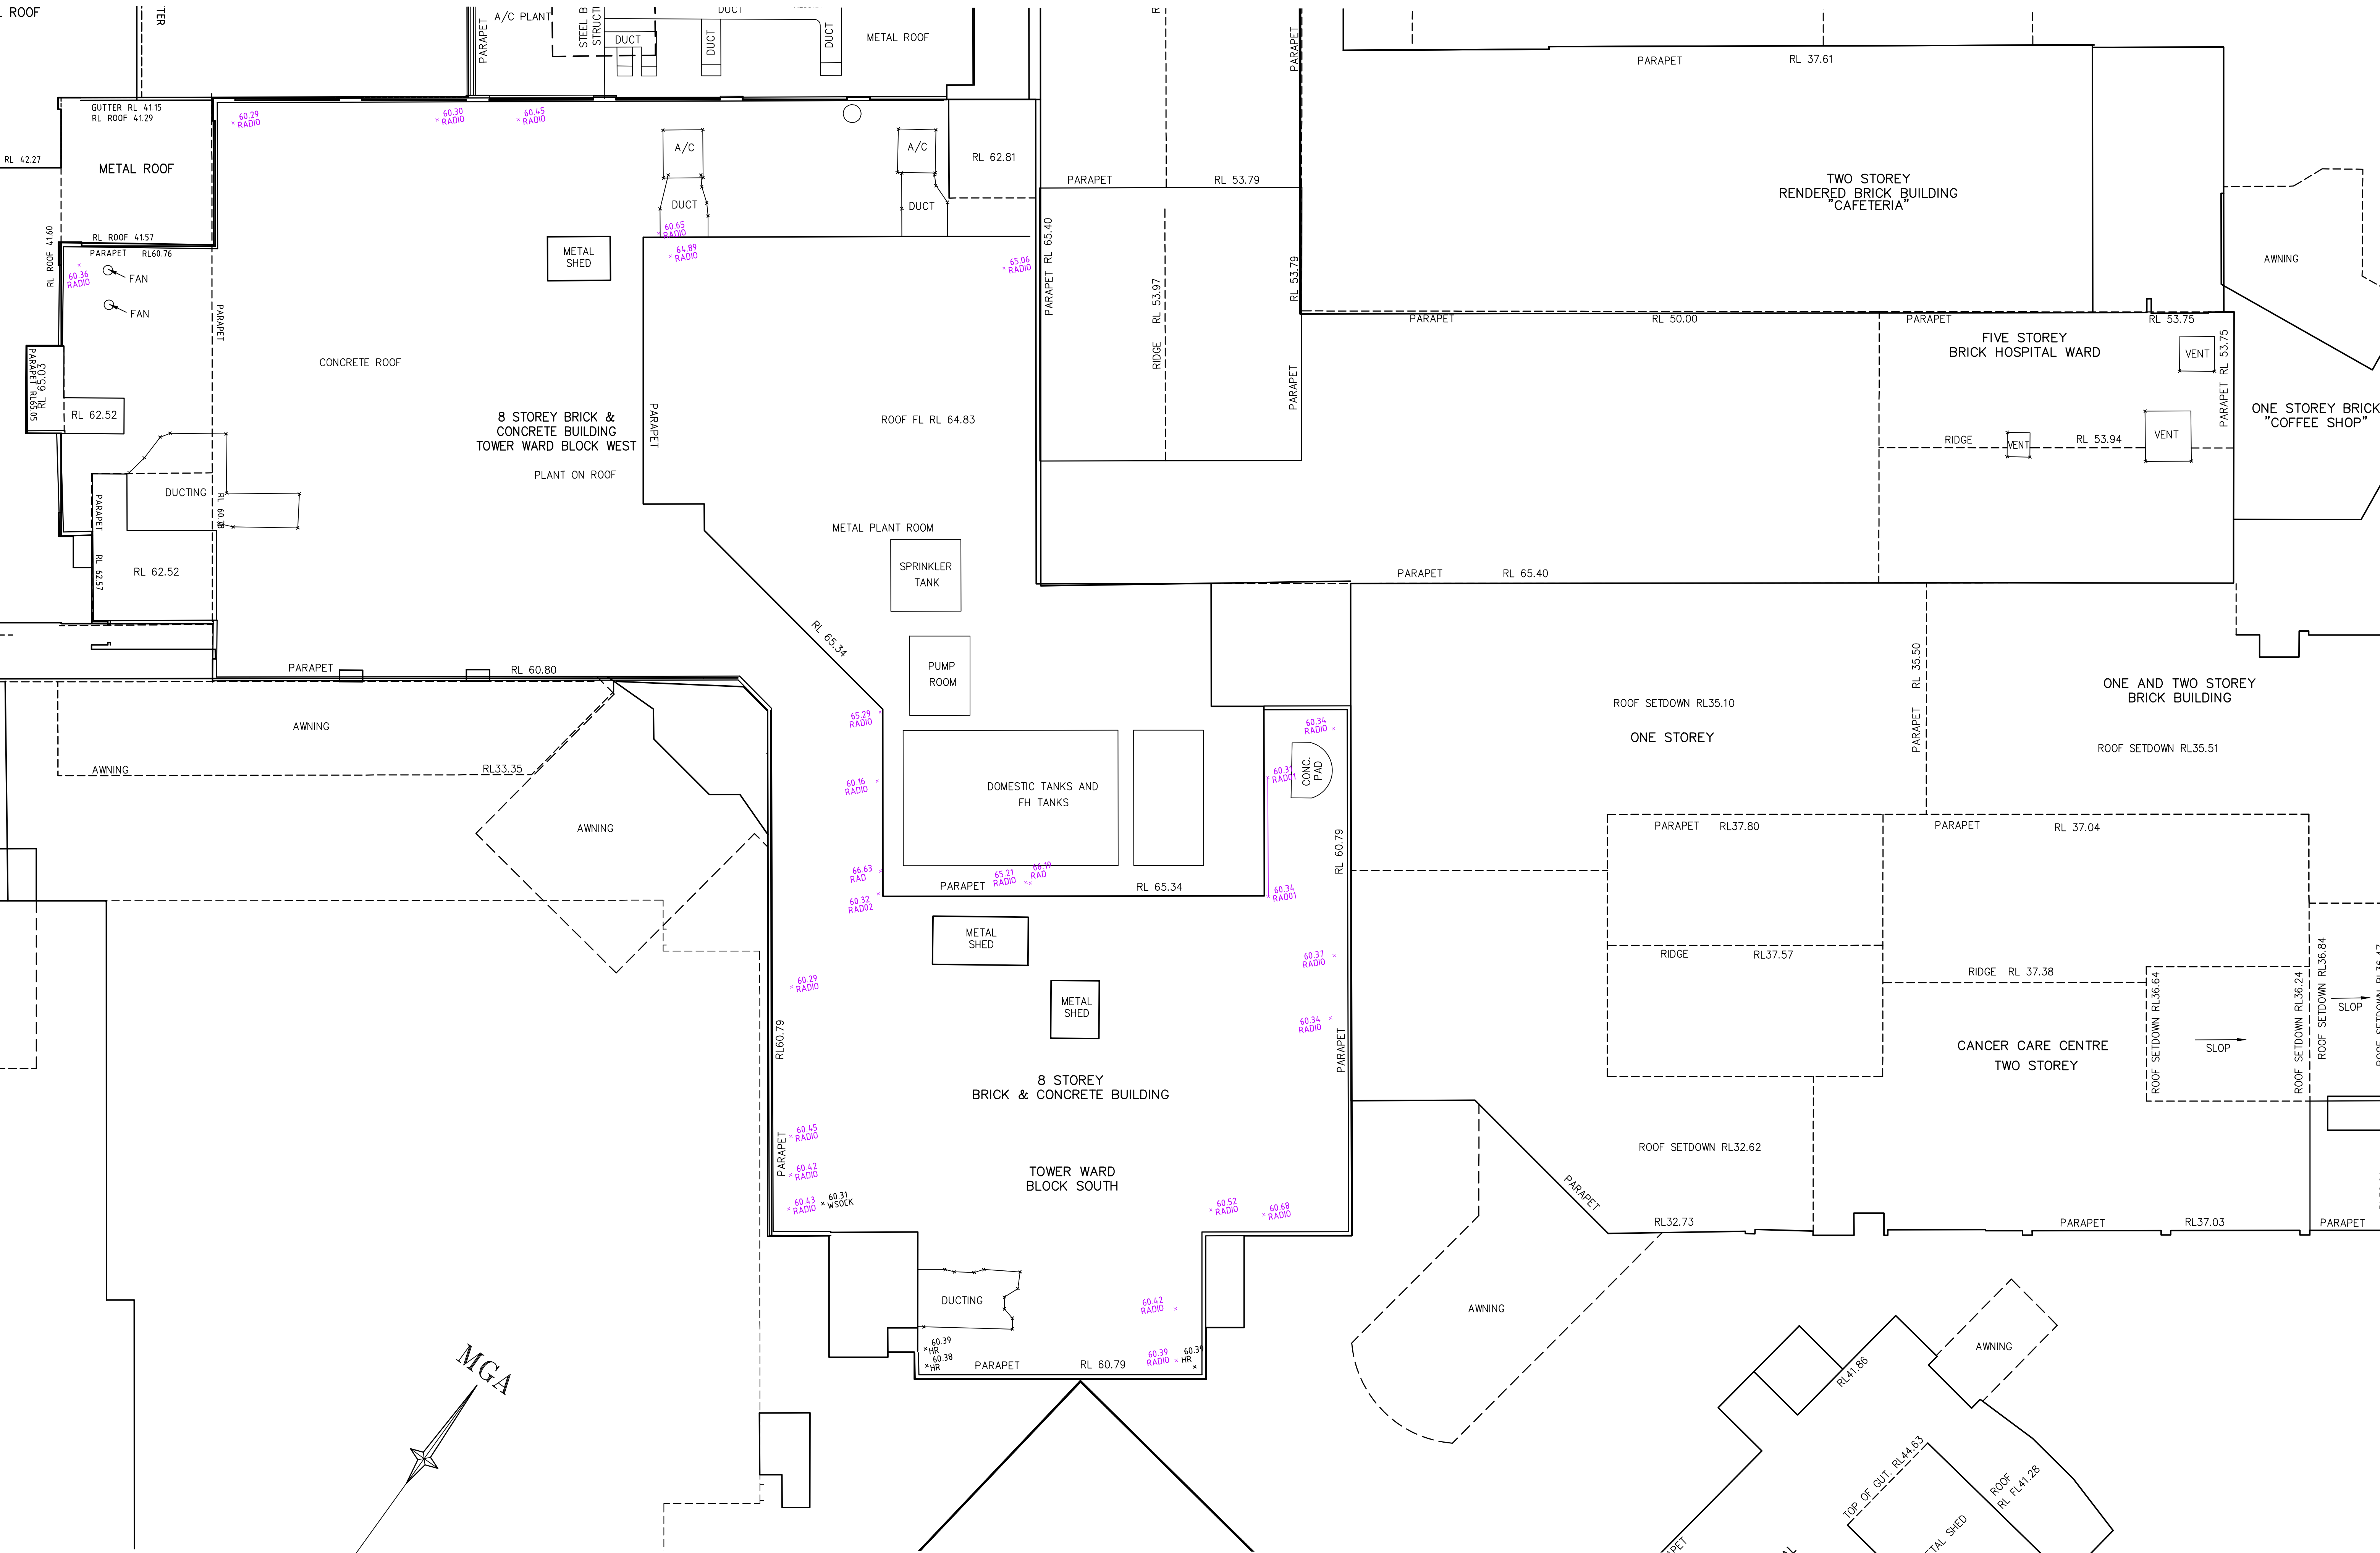

MGA

SEE SHEET 1 FOR LEGEND AND NOTES




THIS IS THE PLAN REFERRED TO
IN MY LETTER DATED:
.....
Registered Surveyor NSW



Client HEALTH INFRASTRUCTURE
Drawing title
PLAN OF DETAIL AND LEVELS OVER LOT 1-6 DP1130879 &
LOT 12 DP800476 KNOWN AS "ST GEORGE HOSPITAL" AT
KOGARAH

datum AHD	project number 33459	reference number 33459DT
site Area 5.179ha	scale 1:150 @A1	date of survey 24/06/15
LGA KOGARAH	SHEET 52	SHEETS 20

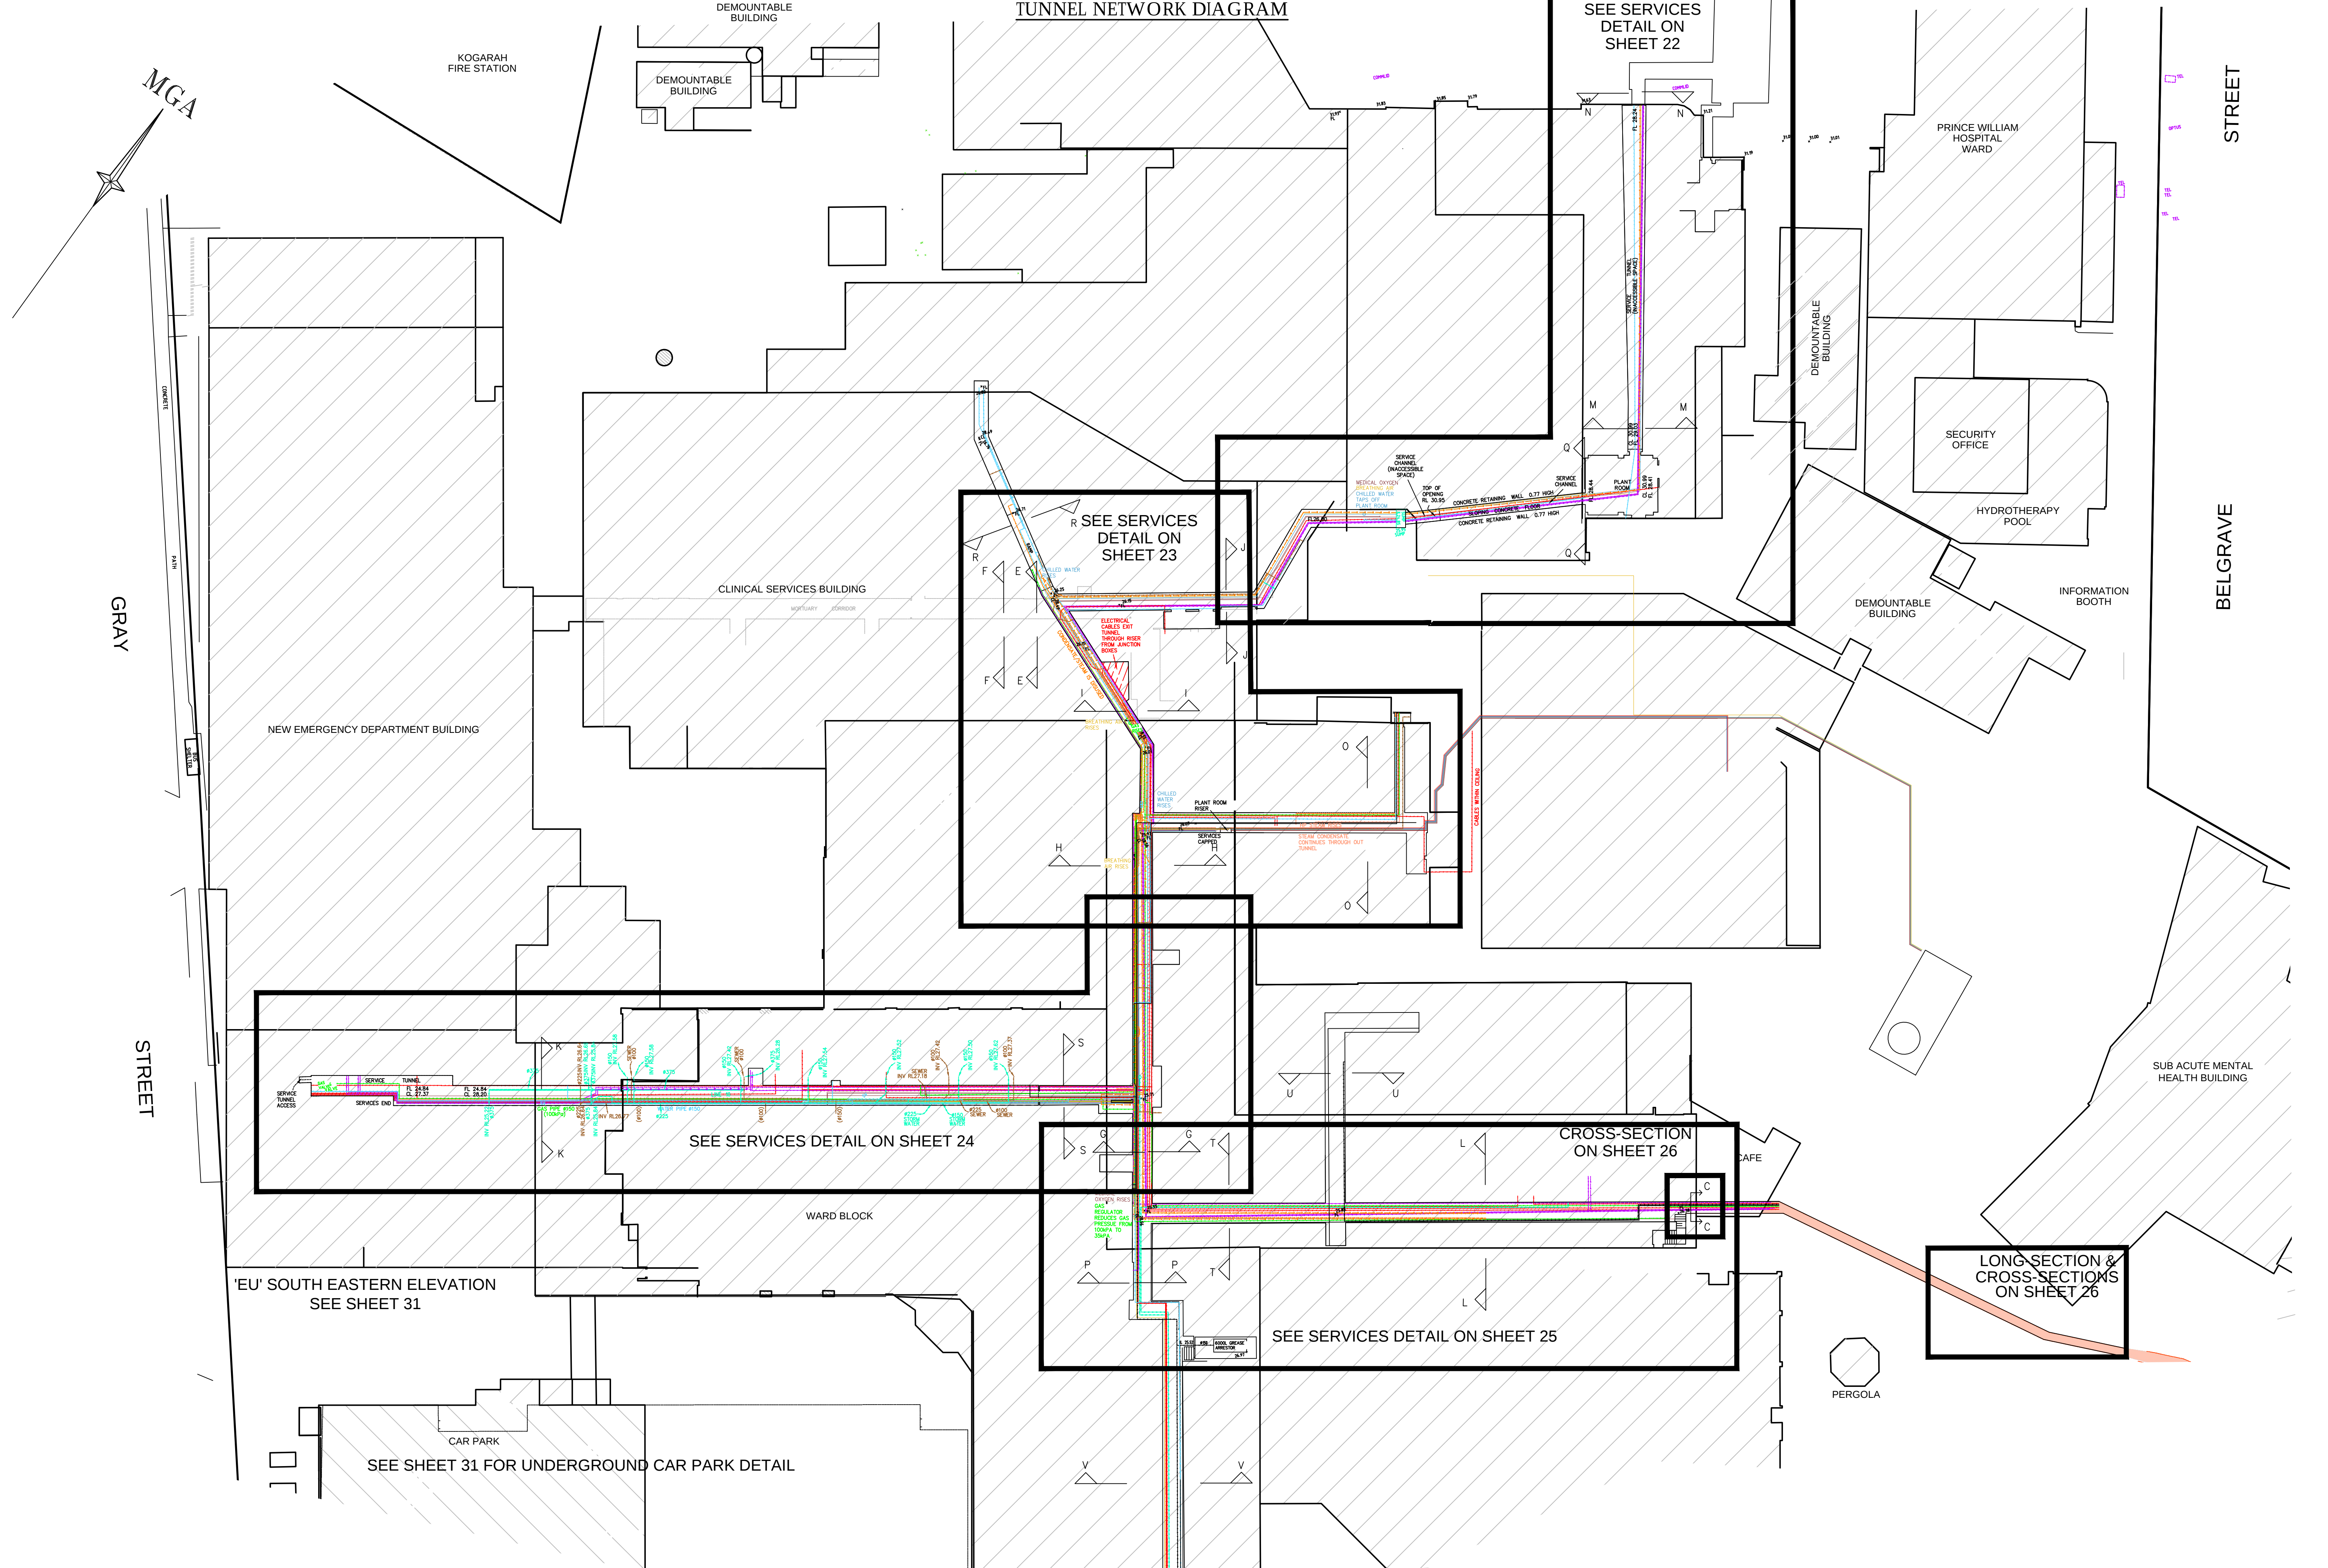

SEE SHEET 1 FOR LEGEND AND NOTES
SEE SHEET 28 FOR SERVICE PIT DIAGRAMS
SEE SHEET 26-27 FOR TUNNEL CROSS SECTIONS



THIS IS THE PLAN REFERRED TO
IN MY LETTER DATED:
.....
Registered Surveyor NSW


LTS
LOCKLEY
Registered Surveyors NSW
www.ltsl.com.au

Suite 1, Level 1
810 Pacific Highway
Gordon NSW 2072
Locked Bag 5
Gordon NSW 2072
P 1300 587 000
F 02 9499 7760

Client **HEALTH INFRASTRUCTURE**
Drawing title
**PLAN OF DETAIL AND LEVELS OVER LOT 1-6 DP1130879 &
LOT 12 DP800476 KNOWN AS "ST GEORGE HOSPITAL" AT
KOGARAH**

datum AHD	project number 33459	reference number 33459DT
site Area 5.179ha	scale 1:300 @A1	date of survey 24/06/15
LGA KOGARAH	SHEET 52	OF SHEETS

TUNNEL NETWORK PLAN

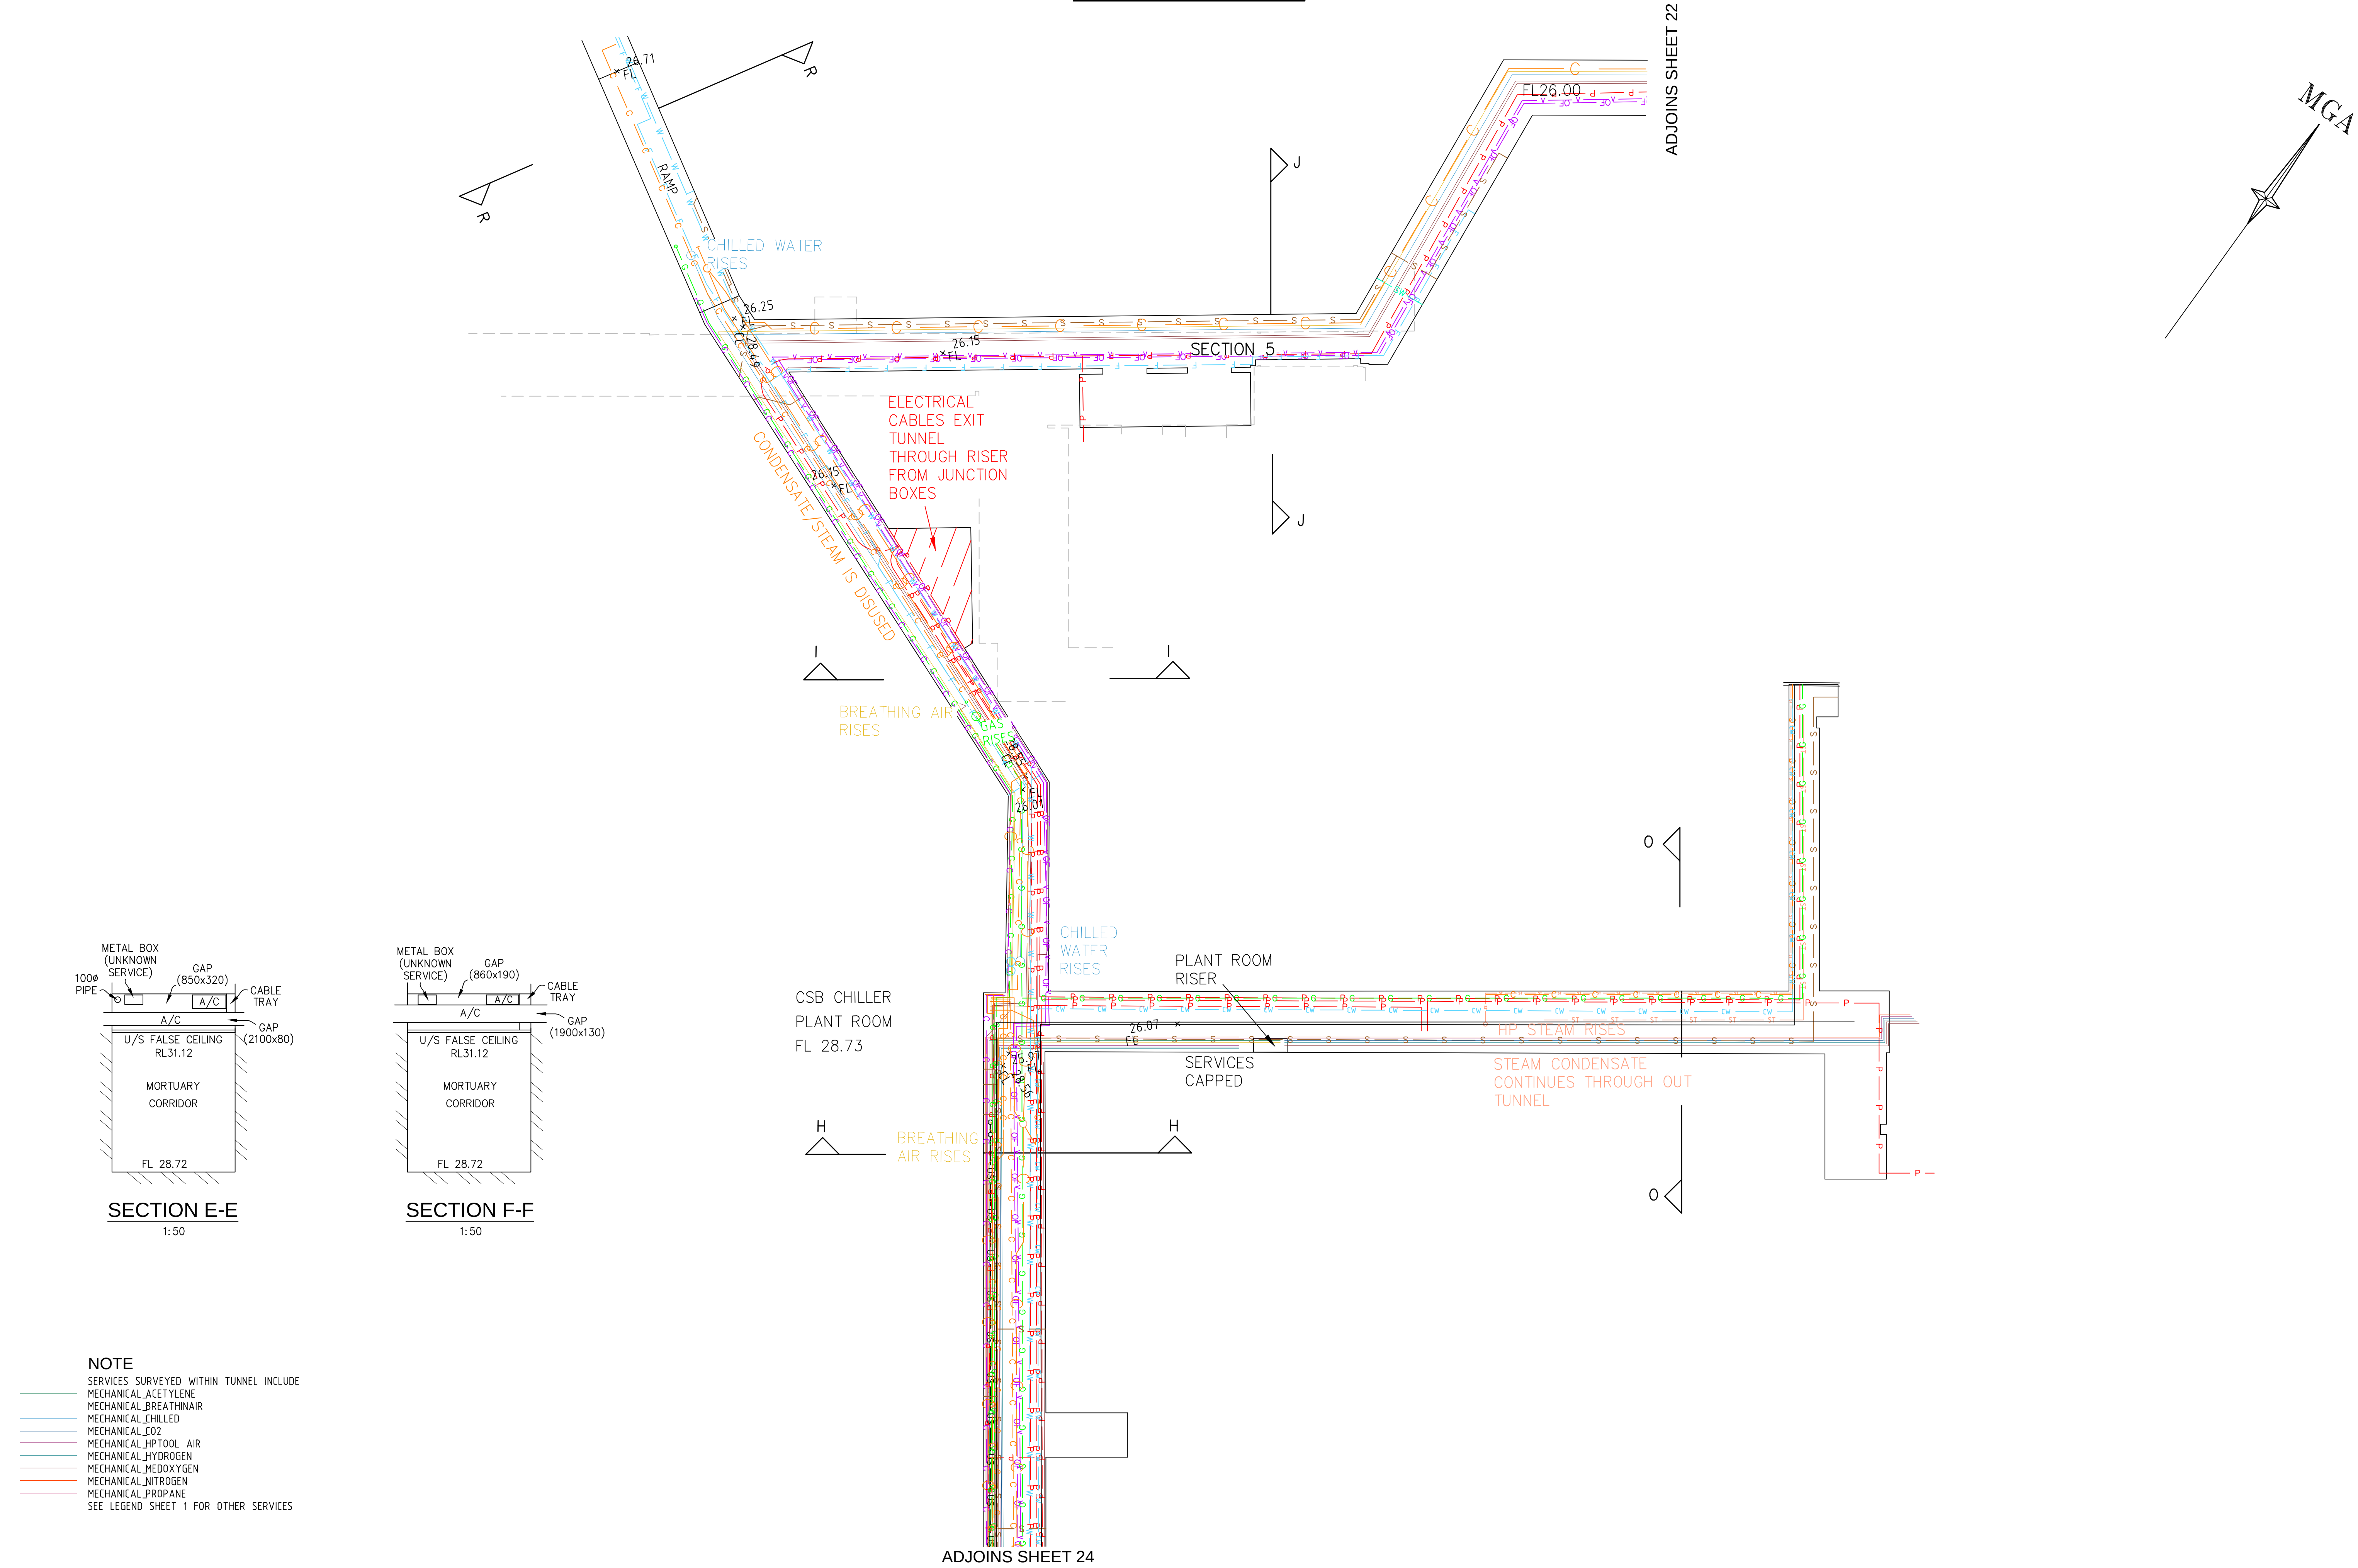

SEE SHEET 1 FOR LEGEND AND NOTES
SEE SHEET 28 FOR SERVICE PIT DIAGRAMS
SEE SHEET 26-27 FOR TUNNEL CROSS SECTIONS



THIS IS THE PLAN REFERRED TO
IN MY LETTER DATED:

Registered Surveyor NSW

LTS
LOCKLEY
Registered Surveyors NSW
www.ltsl.com.au

Suite 1, Level 1
810 Pacific Highway
Gordon NSW 2072
Locked Bag 5
Gordon NSW 2072
P 1300 587 000
F 02 9499 7760


Client **HEALTH INFRASTRUCTURE**
Drawing title
**PLAN OF DETAIL AND LEVELS OVER LOT 1-6 DP1130879 &
LOT 12 DP800476 KNOWN AS "ST GEORGE HOSPITAL" AT
KOGARAH**

datum
AHD
site Area
5.179ha
LGA
KOGARAH

project number
33459
scale
1:100 @A1
OF SHEETS

reference number
33459DT
date of survey
24/06/15
23

NOTE
SERVICES SURVEYED WITHIN TUNNEL INCLUDE
MECHANICAL_ACETYLENE
MECHANICAL_BREATHINGAIR
MECHANICAL_CHILLED
MECHANICAL_CO2
MECHANICAL_HPTOOL_AIR
MECHANICAL_HYDROGEN
MECHANICAL_MEDDOXYGEN
MECHANICAL_NITROGEN
MECHANICAL_PROPAANE
SEE LEGEND SHEET 1 FOR OTHER SERVICES

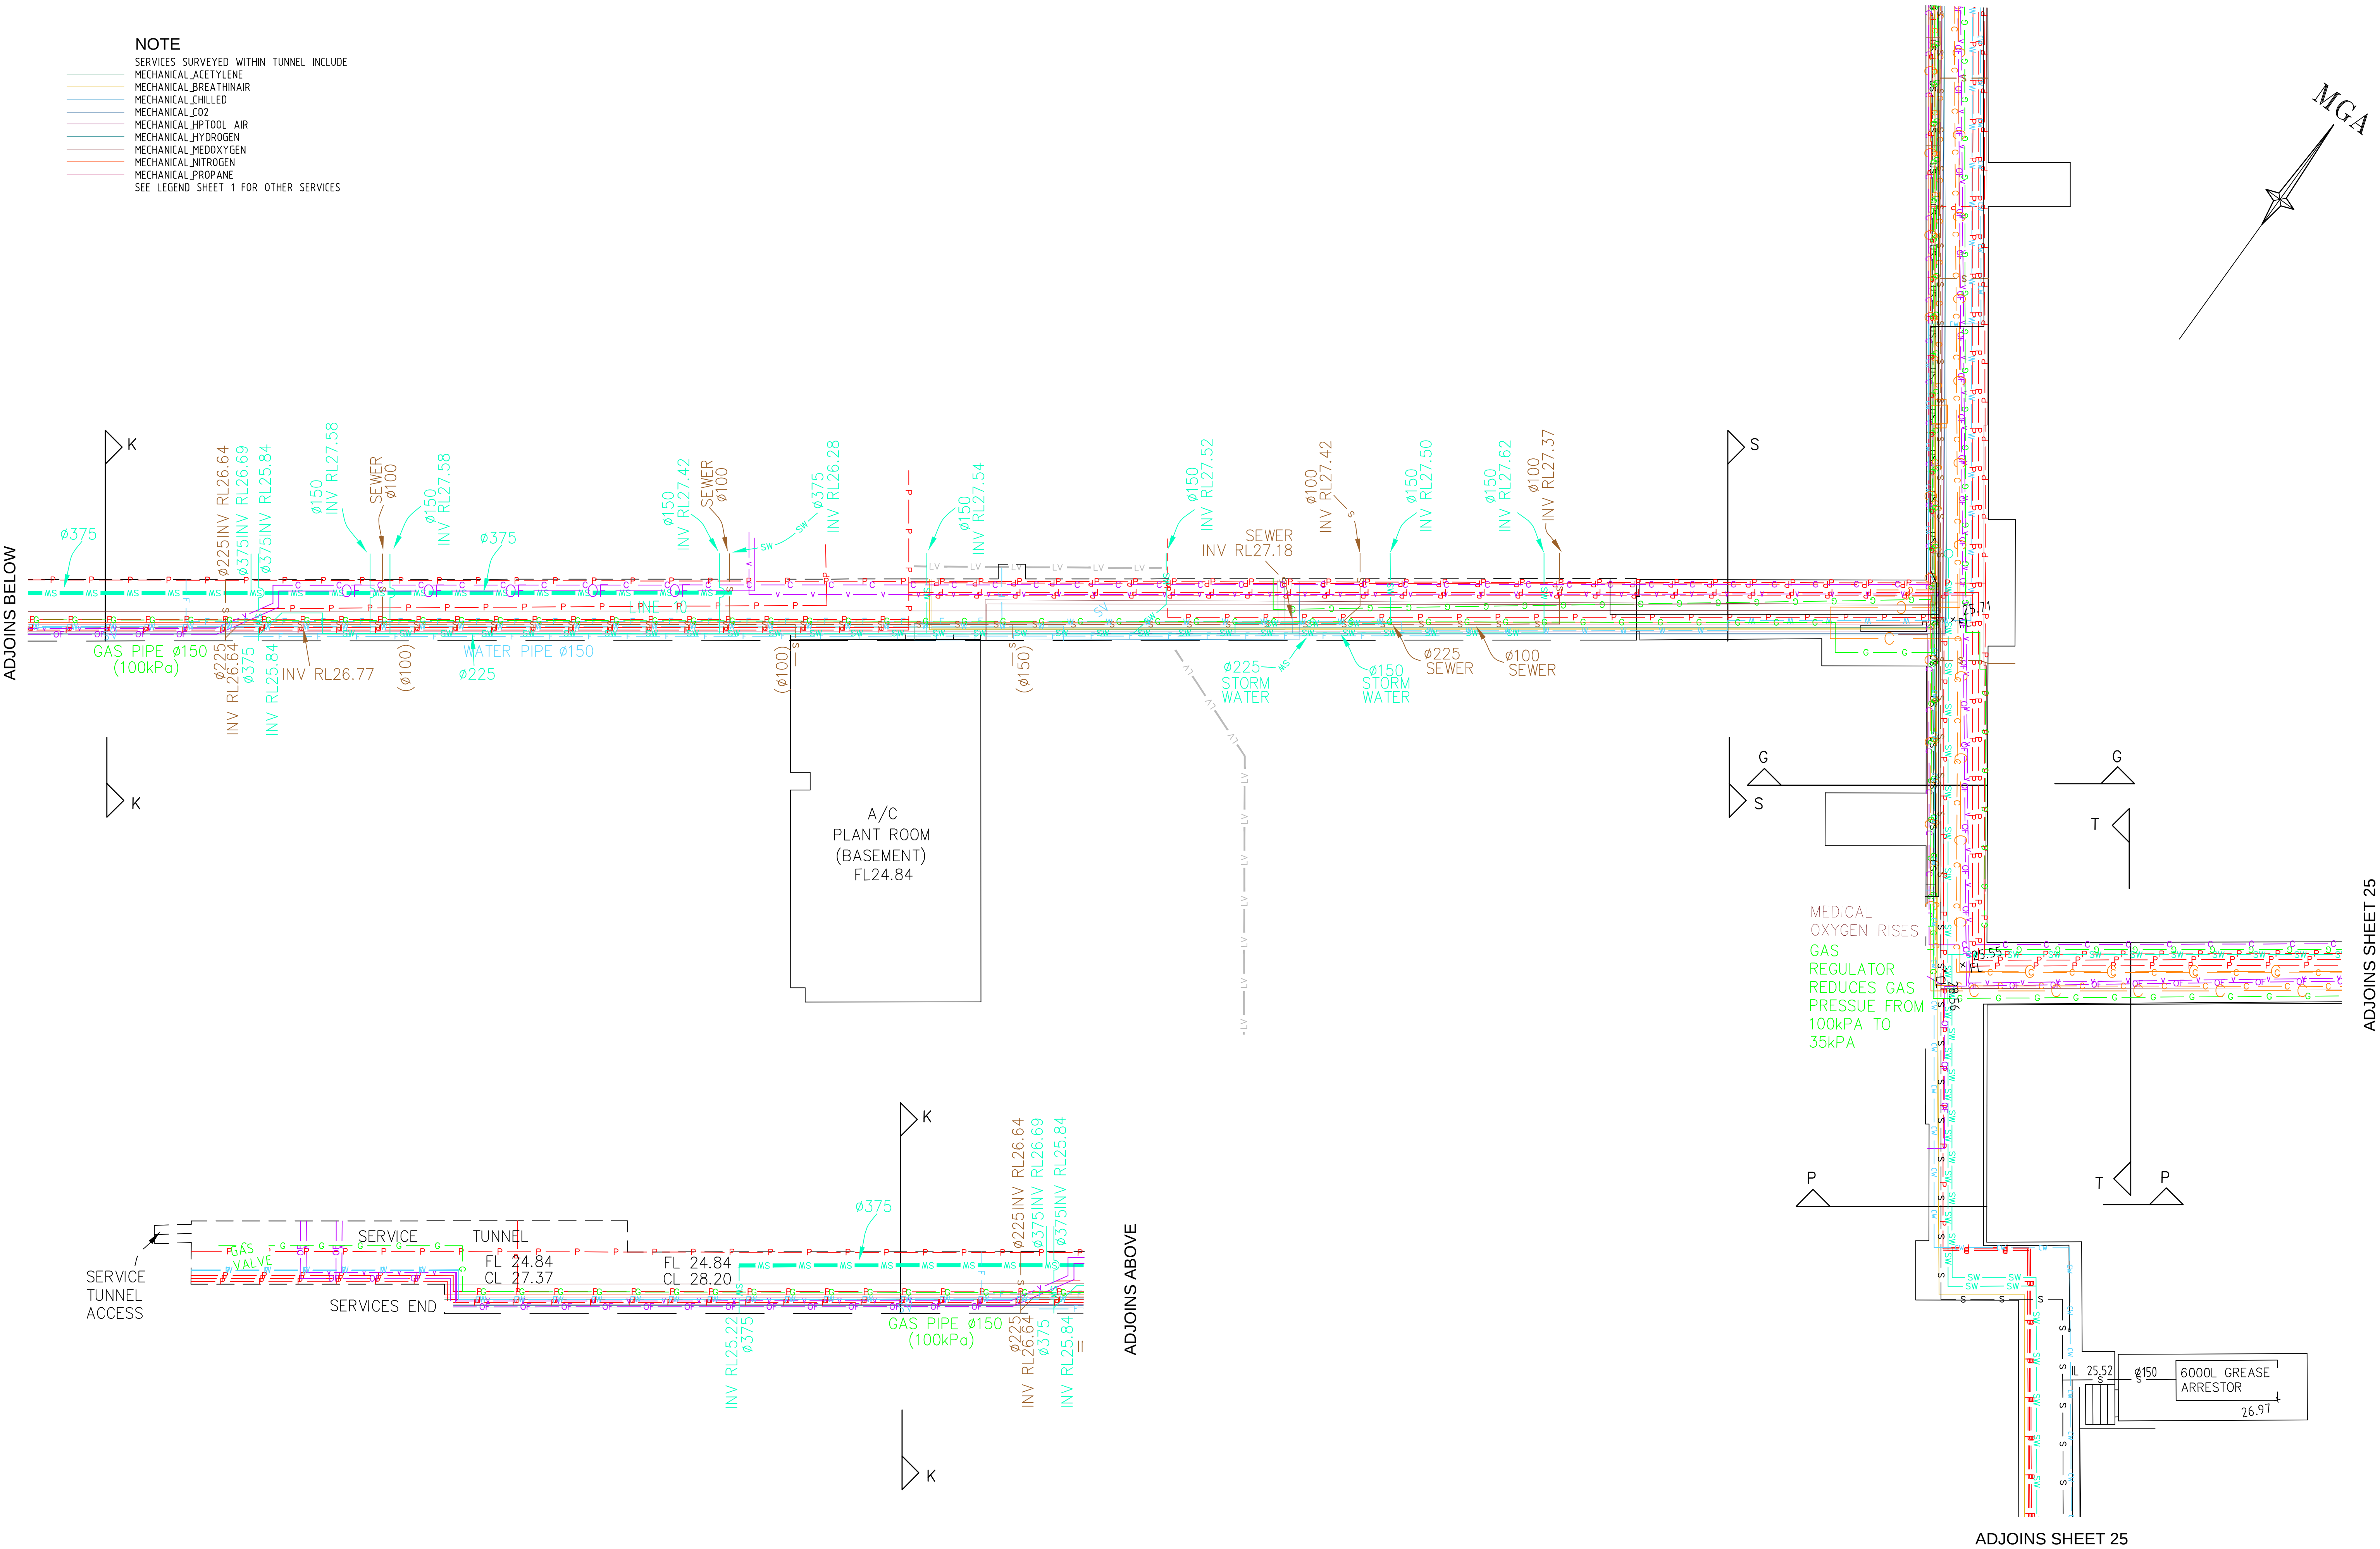

SEE SHEET 1 FOR LEGEND AND NOTES
SEE SHEET 28 FOR SERVICE PIT DIAGRAMS
SEE SHEET 26-27 FOR TUNNEL CROSS SECTIONS


THIS IS THE PLAN REFERRED TO
IN MY LETTER DATED:
Registered Surveyor NSW

LTS
LOCKLEY
Registered Surveyors NSW
www.ltsl.com.au
Suite 1, Level 1
810 Pacific Highway
Gordon NSW 2072
Locked Bag 5
Gordon NSW 2072
P 1300 587 000
F 02 9499 7760

Client **HEALTH INFRASTRUCTURE**
Drawing title
PLAN OF DETAIL AND LEVELS OVER LOT 1-6 DP1130879 & LOT 12 DP800476 KNOWN AS "ST GEORGE HOSPITAL" AT KOGARAH

datum AHD	project number 33459	reference number 33459DT
site Area 5.179ha	scale 1:100 @A1	date of survey 24/06/15
LGA KOGARAH	SHEET 52	SHEETS 24

TUNNEL NETWORK PLAN

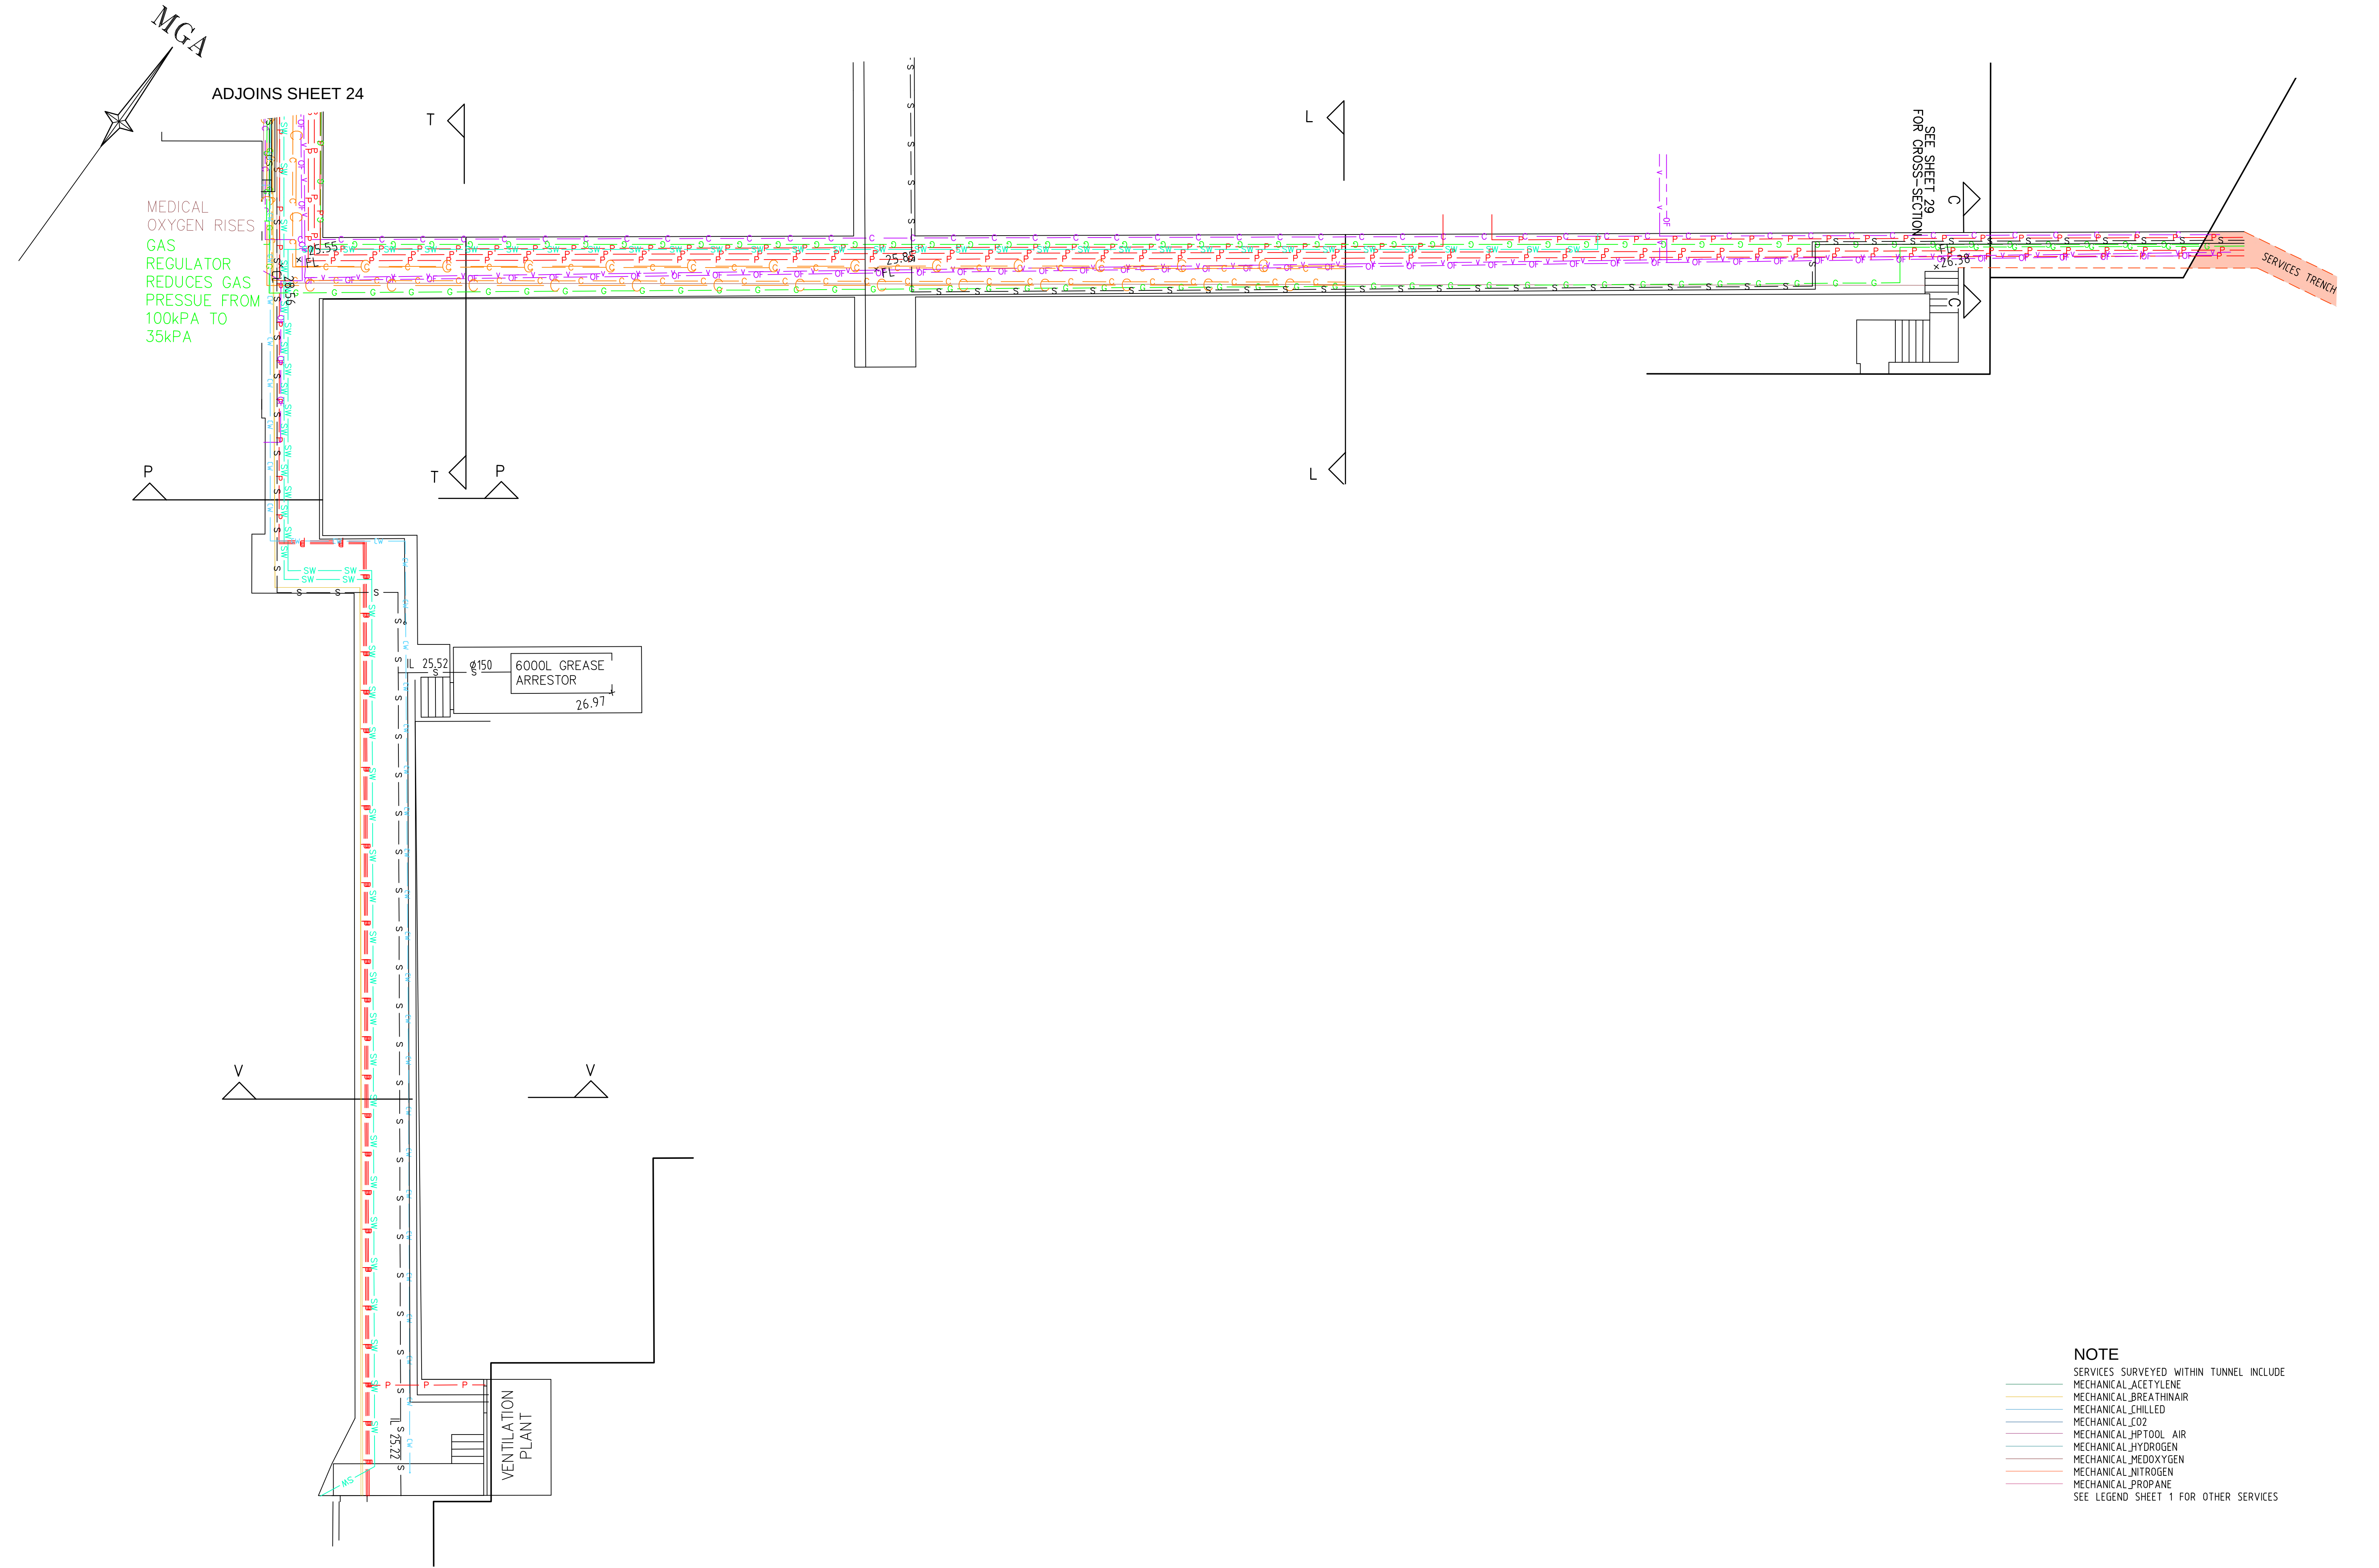

- NOTE
- SERVICES SURVEYED WITHIN TUNNEL INCLUDE
 - MECHANICAL_ACETYLENE
 - MECHANICAL_BREATHINAIR
 - MECHANICAL_CHILLED
 - MECHANICAL_CO2
 - MECHANICAL_HPTOOL_AIR
 - MECHANICAL_HYDROGEN
 - MECHANICAL_MEDOXYGEN
 - MECHANICAL_NITROGEN
 - MECHANICAL_PROPANE
 - SEE LEGEND SHEET 1 FOR OTHER SERVICES

SEE SHEET 1 FOR LEGEND AND NOTES
SEE SHEET 28 FOR SERVICE PIT DIAGRAMS
SEE SHEET 26-27 FOR TUNNEL CROSS SECTIONS



THIS IS THE PLAN REFERRED TO
IN MY LETTER DATED:
.....
Registered Surveyor NSW


LTS
LOCKLEY
Registered Surveyors NSW
www.ltsl.com.au

Suite 1, Level 1
810 Pacific Highway
Gordon NSW 2072
Locked Bag 5
Gordon NSW 2072
P 1300 587 000
F 02 9499 7760

Client **HEALTH INFRASTRUCTURE**
Drawing title
**PLAN OF DETAIL AND LEVELS OVER LOT 1-6 DP1130879 &
LOT 12 DP800476 KNOWN AS "ST GEORGE HOSPITAL" AT
KOGARAH**


datum AHD	project number 33459	reference number 33459DT
site Area 5.179ha	scale 1:100 @A1	date of survey 24/06/15
LGA KOGARAH	OF SHEET 52 SHEETS	25

TUNNEL SECTIONS

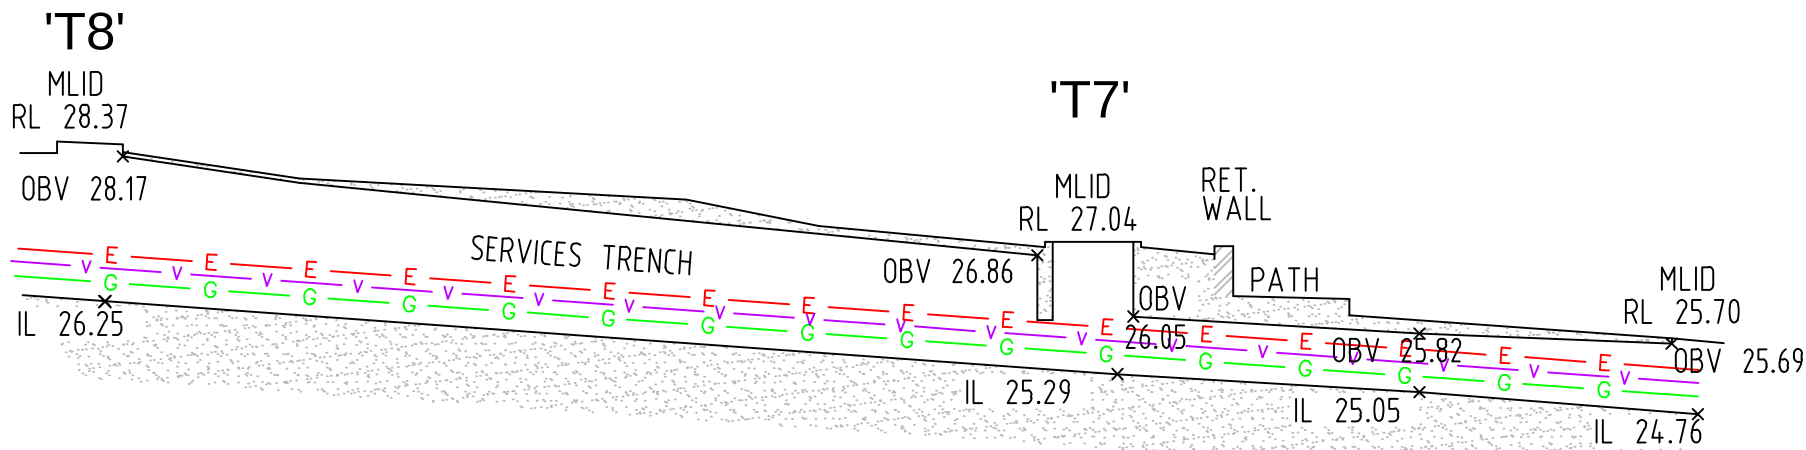


LONG SECTION (SERVICE TUNNEL)

N.T.S.
SURVEYED IN 2011
(SERVICE POSITION WITHIN TRENCH SHOWN DIAGRAMMATICALLY)

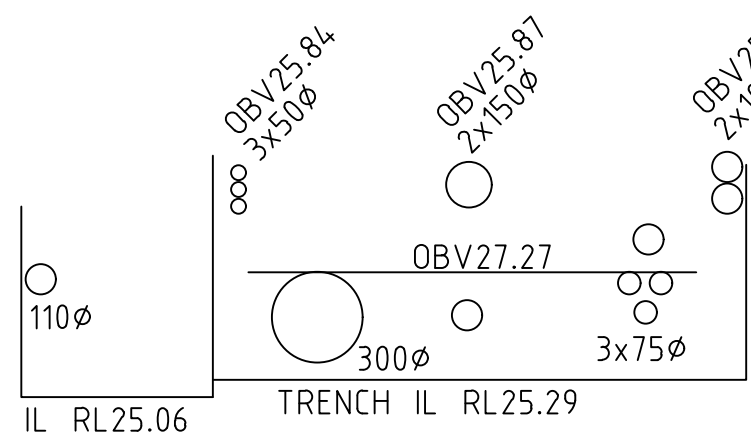


'T7' CROSS SECTION

N.T.S.
SURVEYED IN 2011
NOW INACCESSIBLE

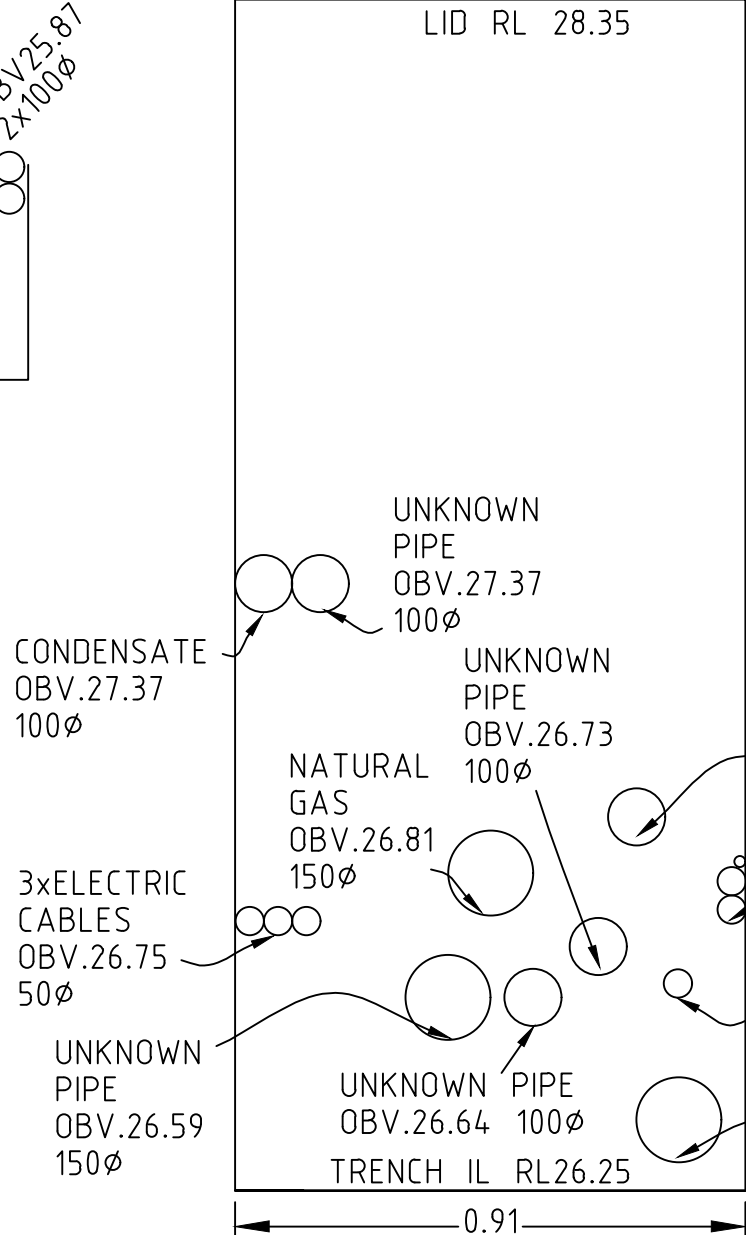


'T8' SECTION

1:15

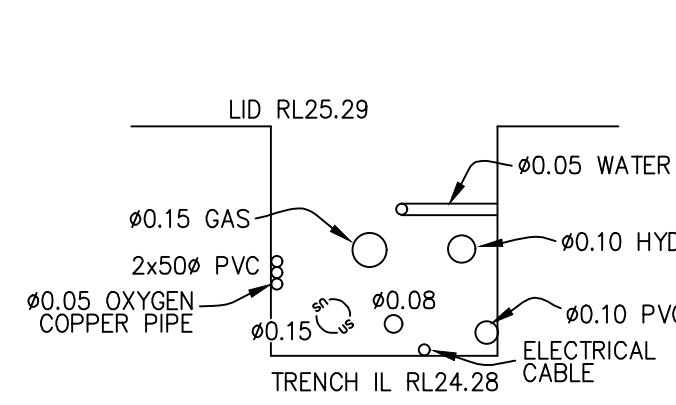


'T6' CROSS SECTION

1:50
(LOOKING WEST)

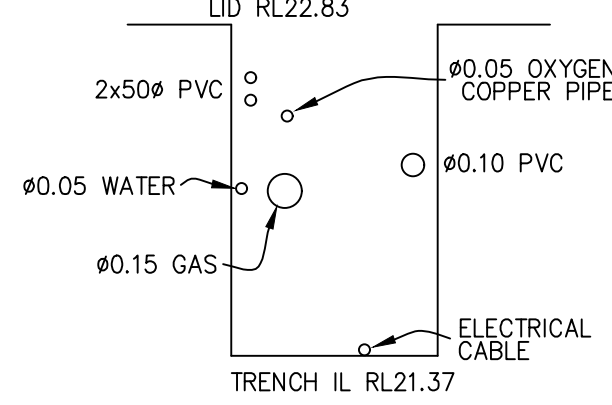


'T5' CROSS SECTION

1:50
(LOOKING WEST)

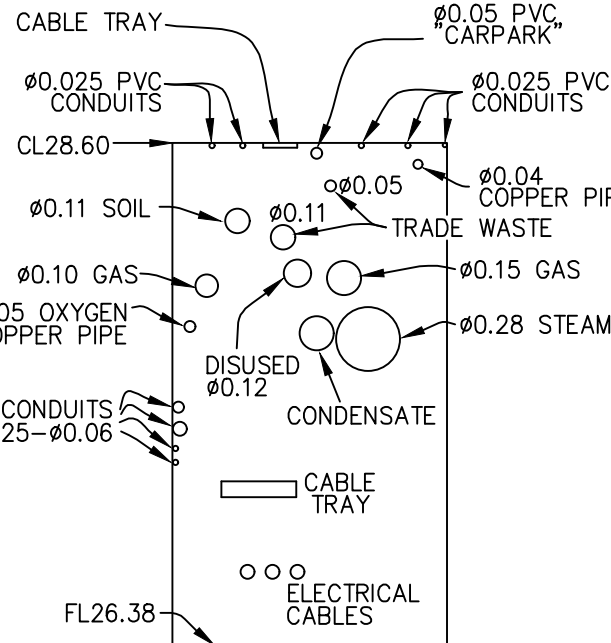


SECTION C-C

SERVICE TUNNEL NEAR COFFEE SHOP
1:50

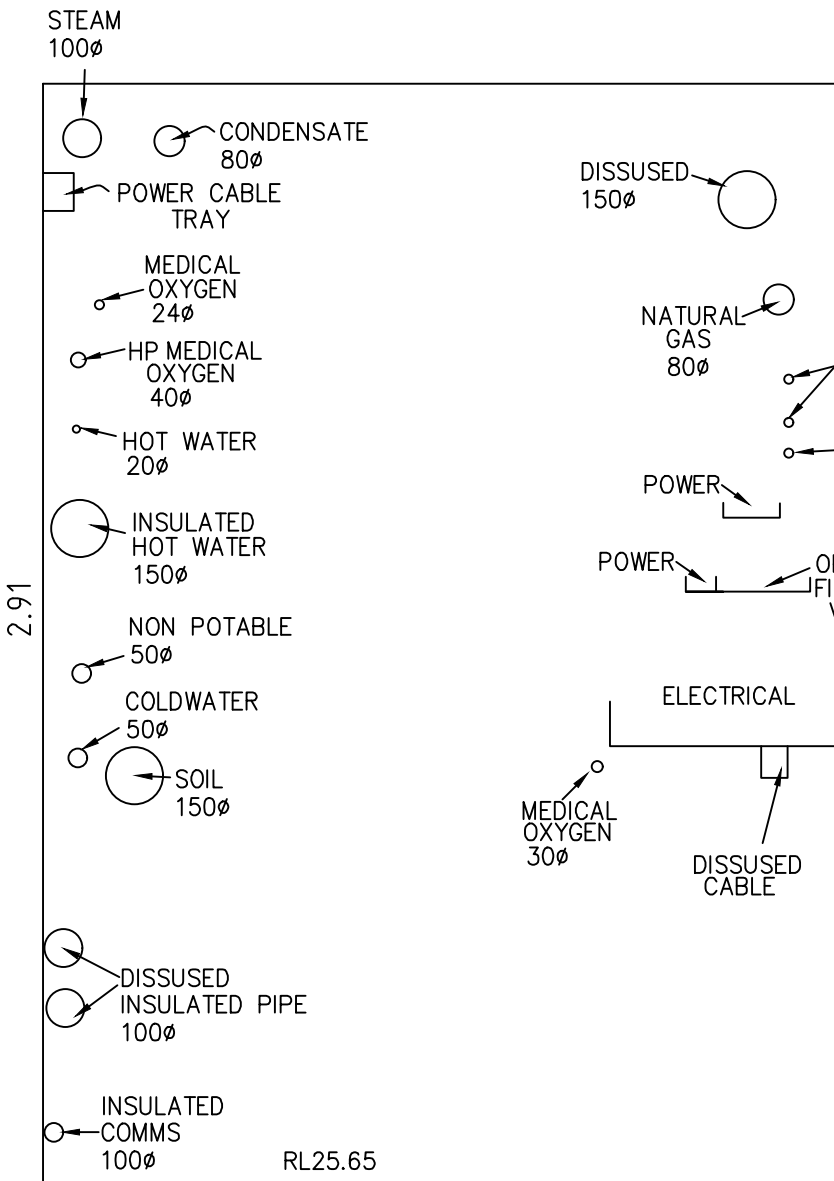


SECTION G-G

1:20

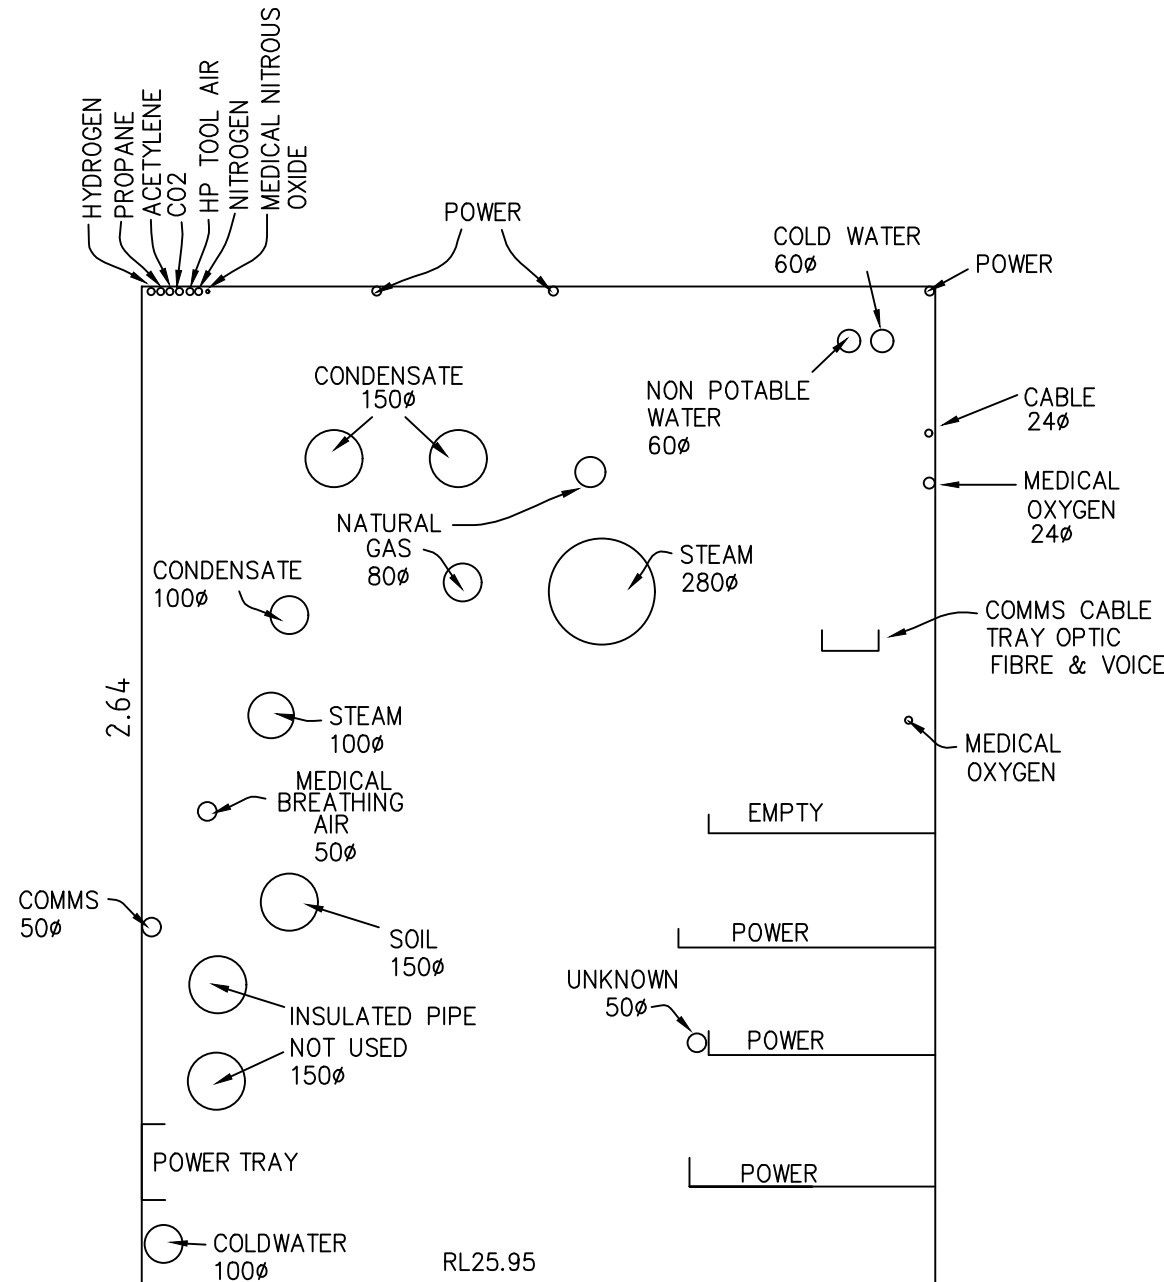


SECTION H-H

1:20

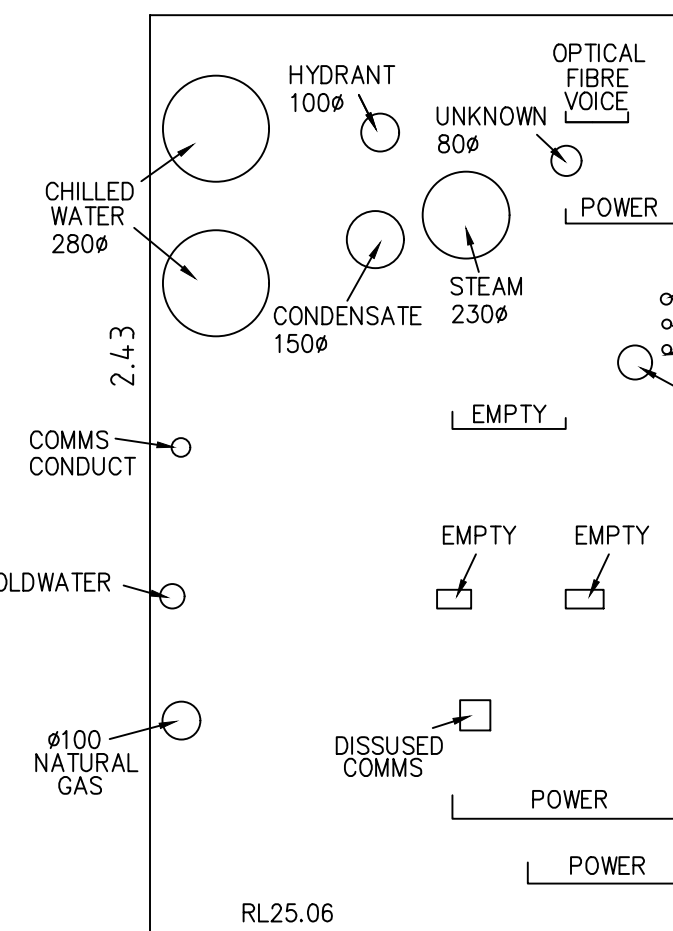


SECTION I-I

1:20

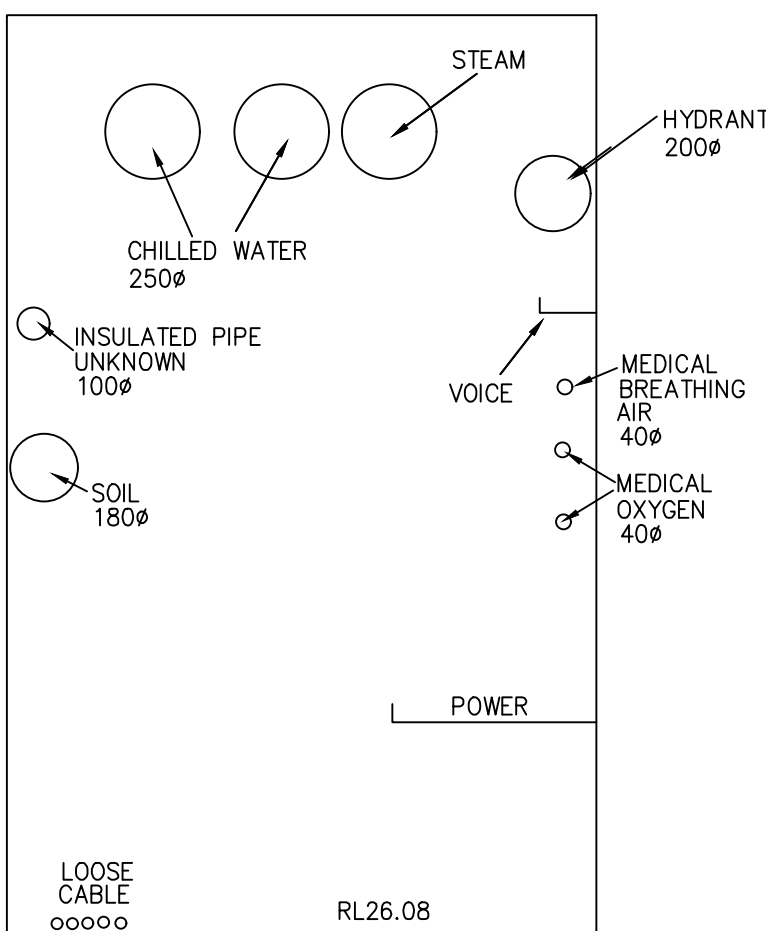


SECTION J-J

1:20

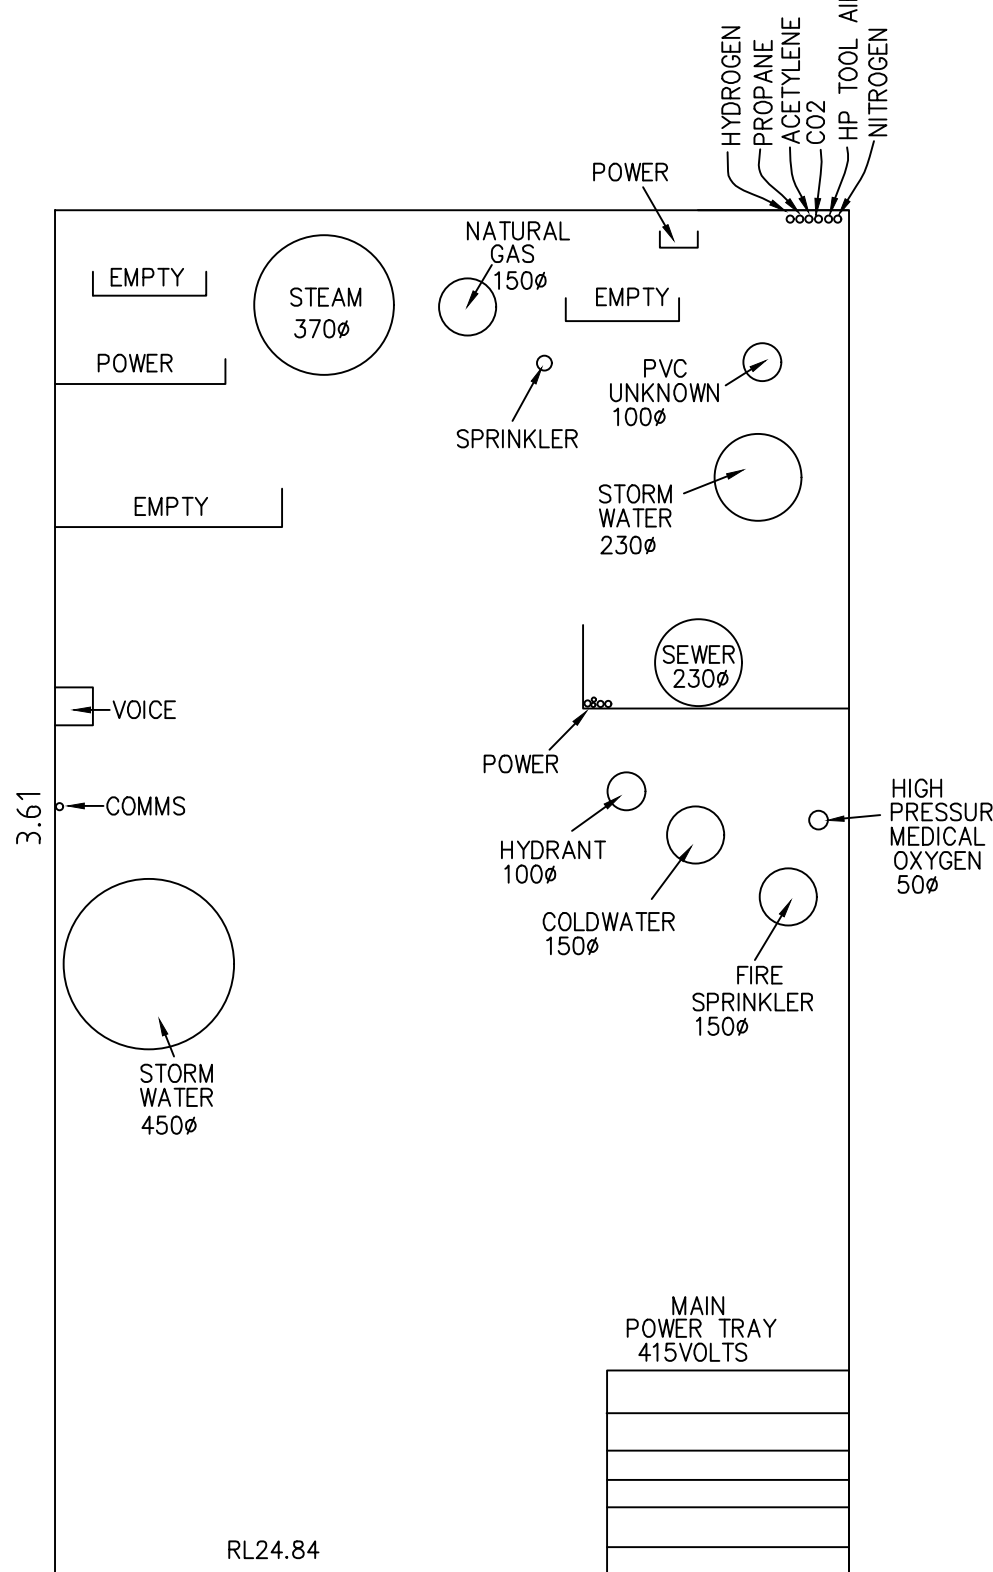


SECTION K-K

1:20

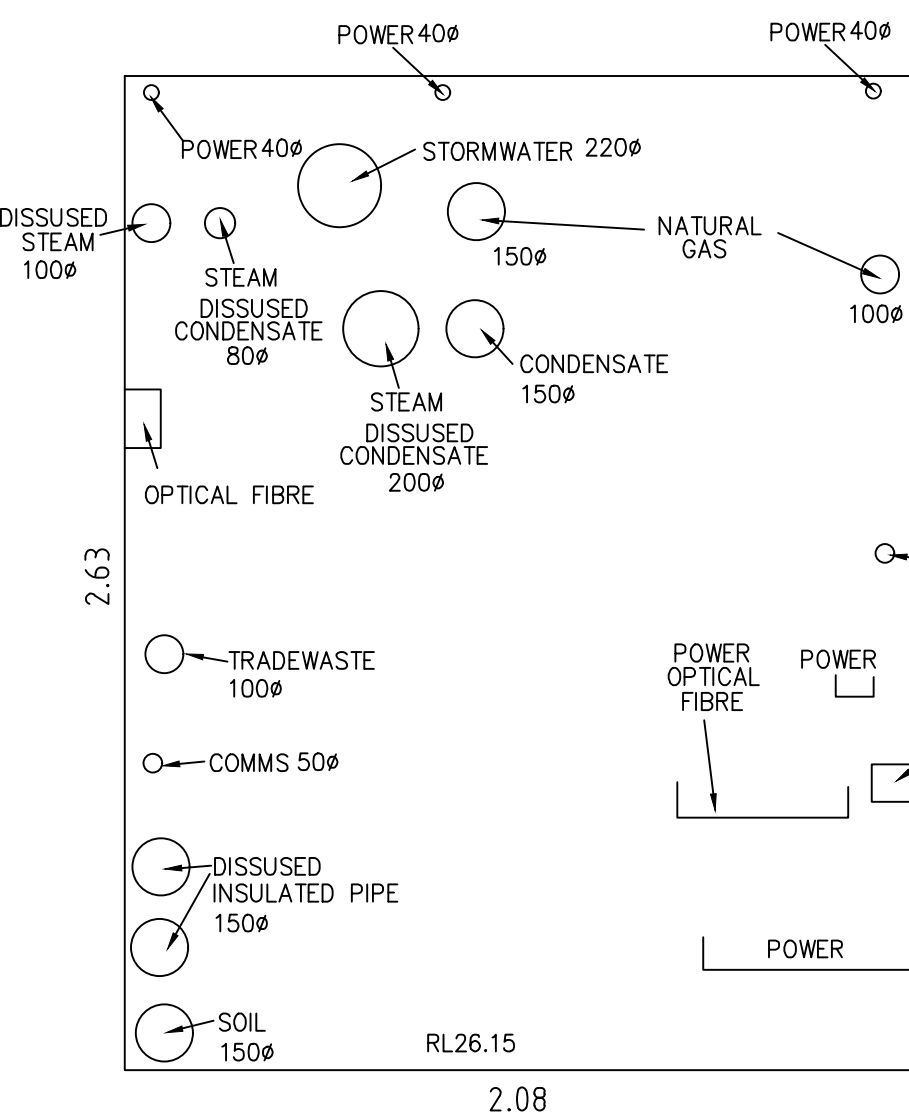


SECTION L-L

1:20

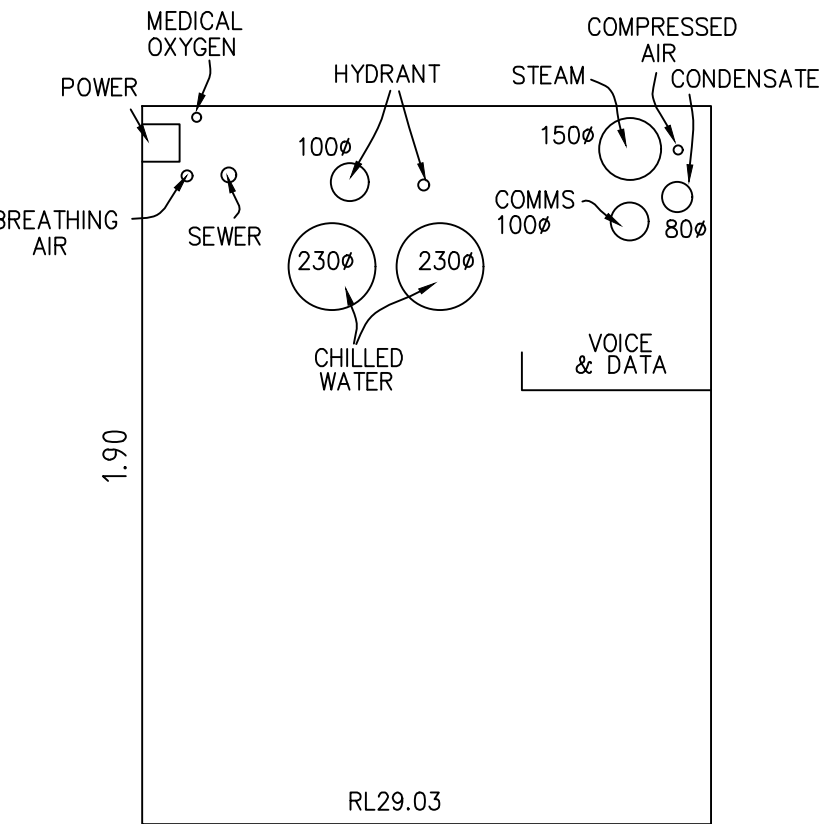


SECTION M-M

1:20

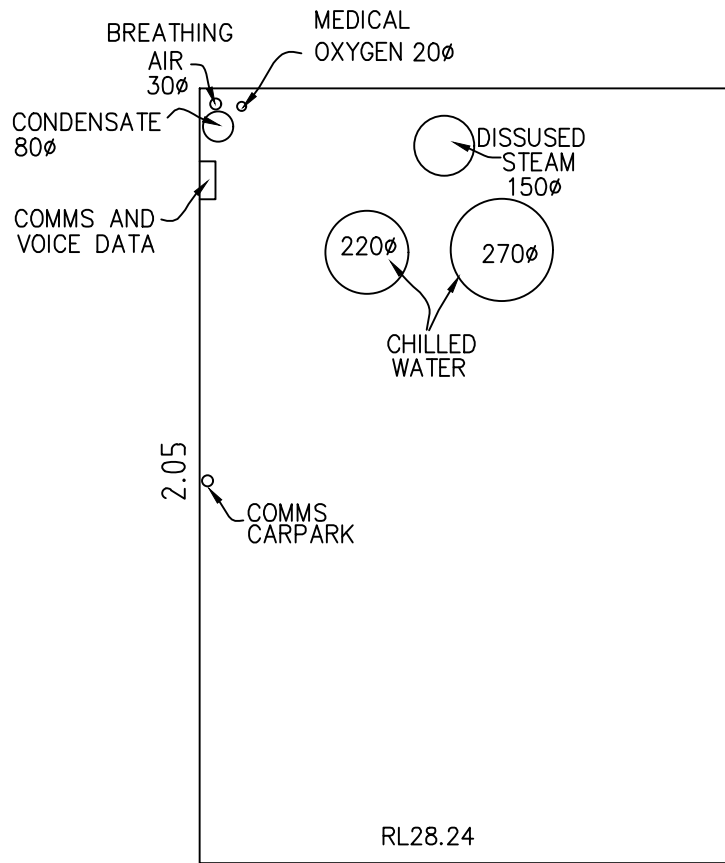


SECTION N-N

1:20

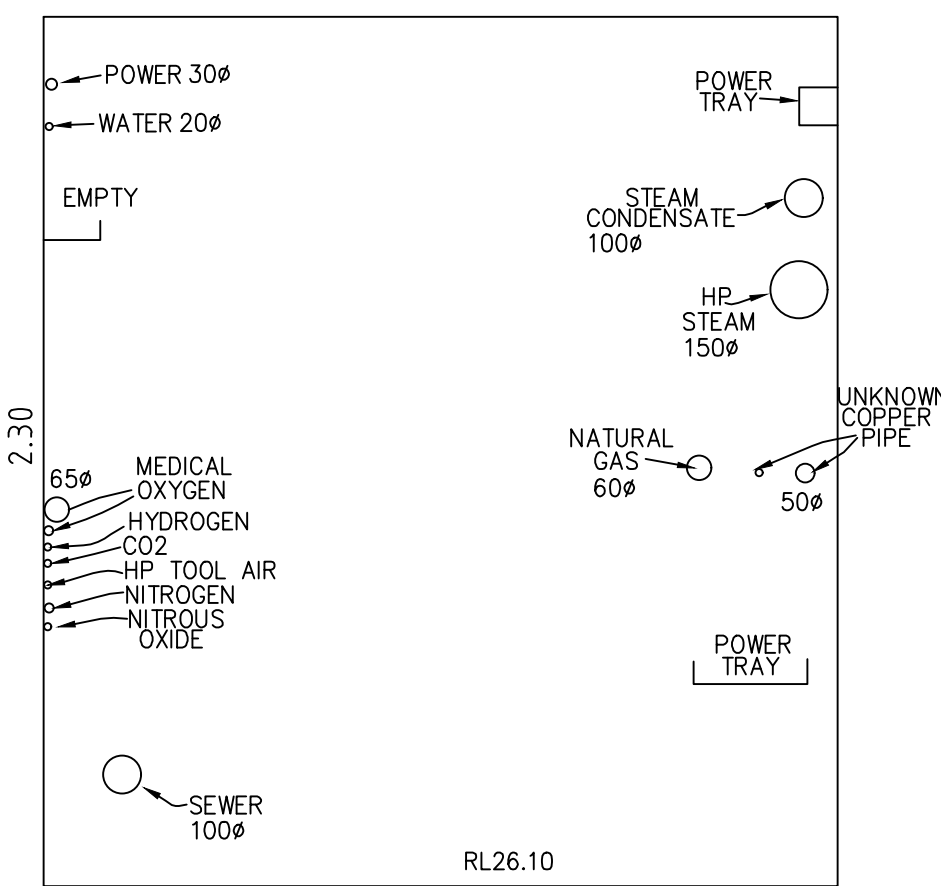

SECTION O-O

1:20

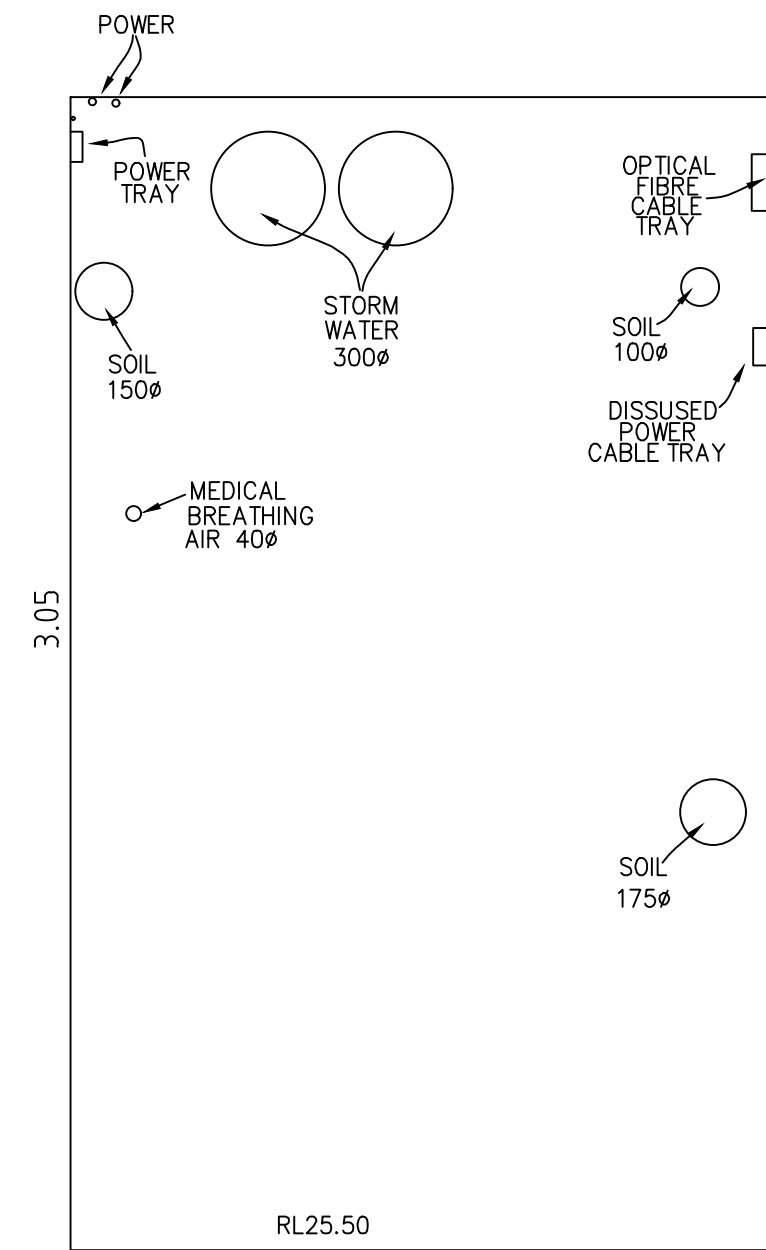

SECTION P-P

1:20

NOTE: SECTIONS 'T8', GG-PP ARE TO SCALE ONLY IN REGARD TO TUNNEL WALL AND PIPE DIAMETER DIMENSIONS. RELATIVE POSITIONS OF SERVICES ARE DIAGRAMMATIC ONLY

SEE SHEET 1 FOR LEGEND AND NOTES



THIS IS THE PLAN REFERRED TO IN MY LETTER DATED:
Registered Surveyor NSW


LTS
LOCKLEY
Registered Surveyors NSW
www.ltsl.com.au

Suite 1, Level 1
810 Pacific Highway
Gordon NSW 2072
Locked Bag 5
Gordon NSW 2072
P 1300 587 000
F 02 9499 7760

Client HEALTH INFRASTRUCTURE
Drawing title
PLAN OF DETAIL AND LEVELS OVER LOT 1-6 DP1130879 & LOT 12 DP800476 KNOWN AS "ST GEORGE HOSPITAL" AT KOGARAH


datum AHD
site Area 5.179ha
LGA KOGARAH
project number 33459
scale 1:20 @A1
reference number 33459DT
date of survey 24/06/15
SHEET 52 OF SHEETS

TUNNEL SECTIONS

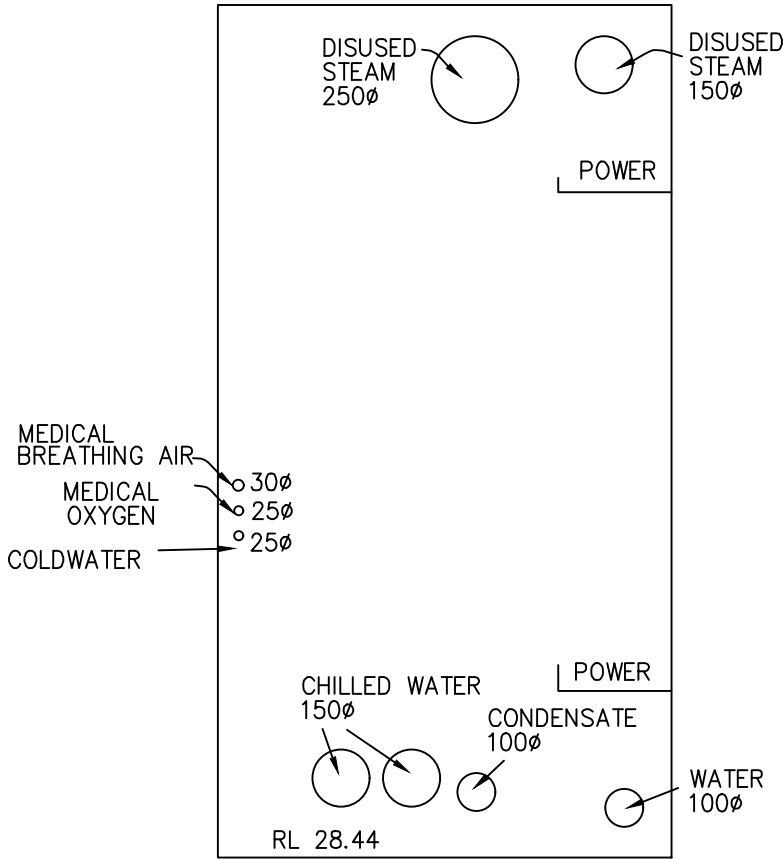


SECTION Q-Q

1:20

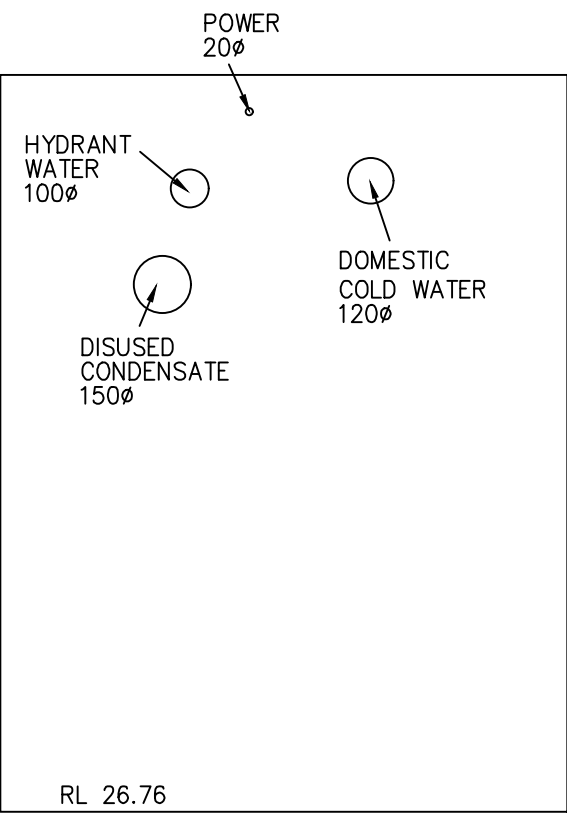


SECTION R-R

1:20

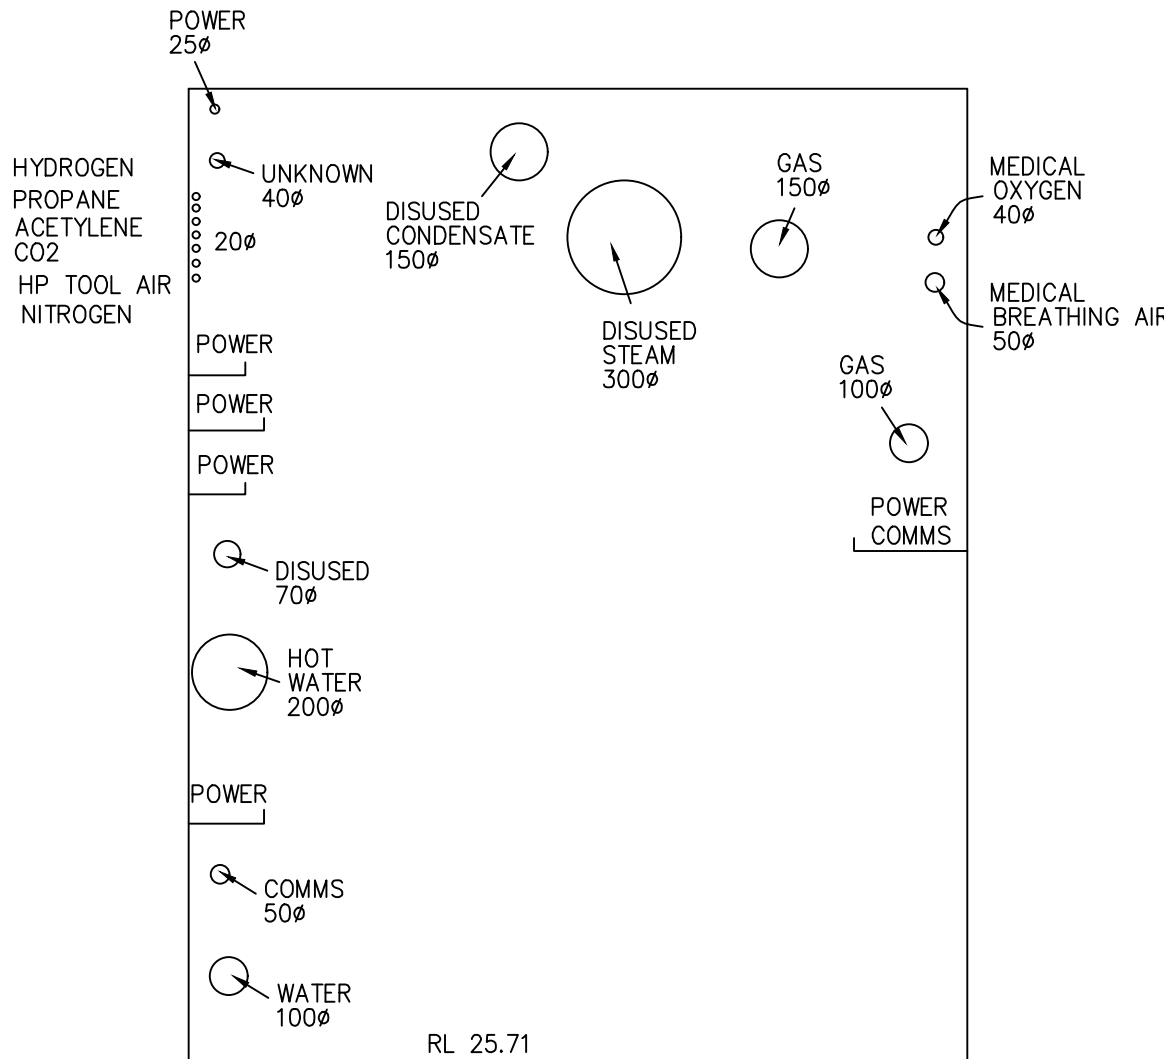


SECTION S-S

1:20

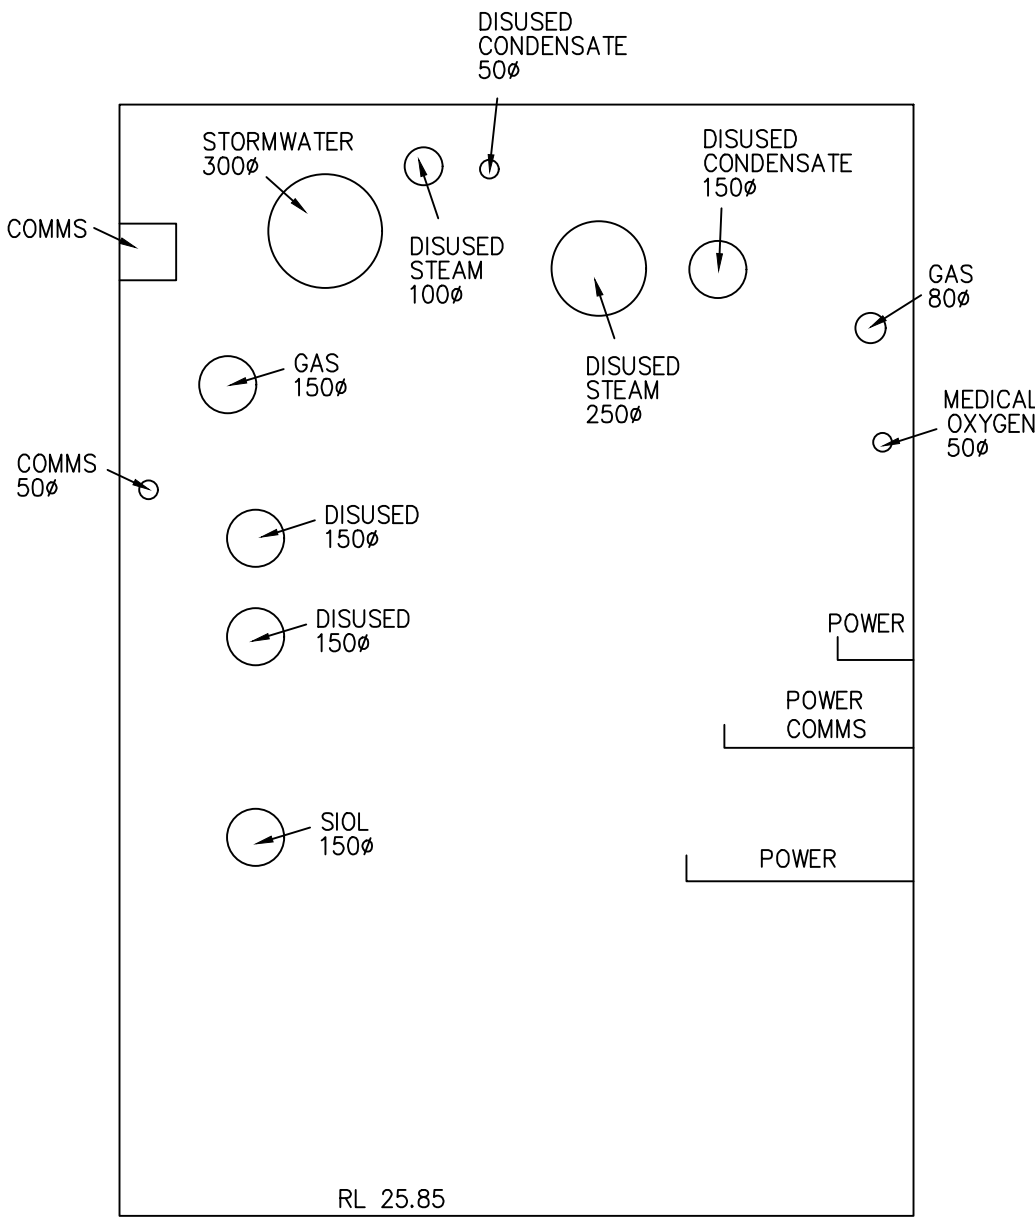


SECTION T-T

1:20

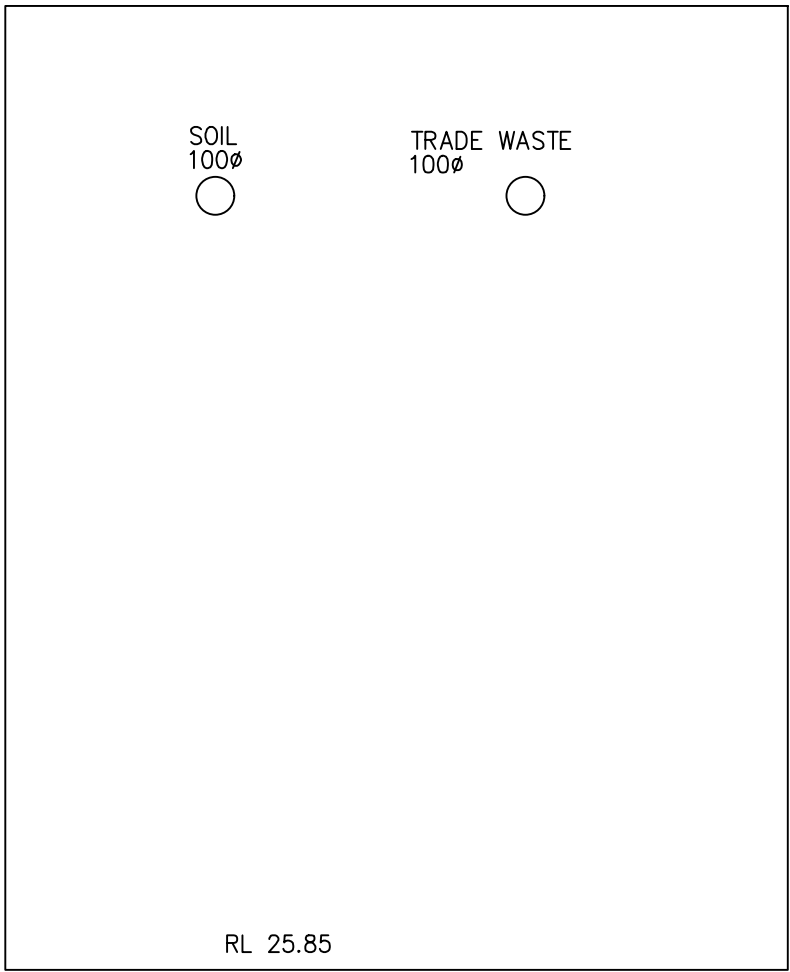

SECTION U-U

1:20

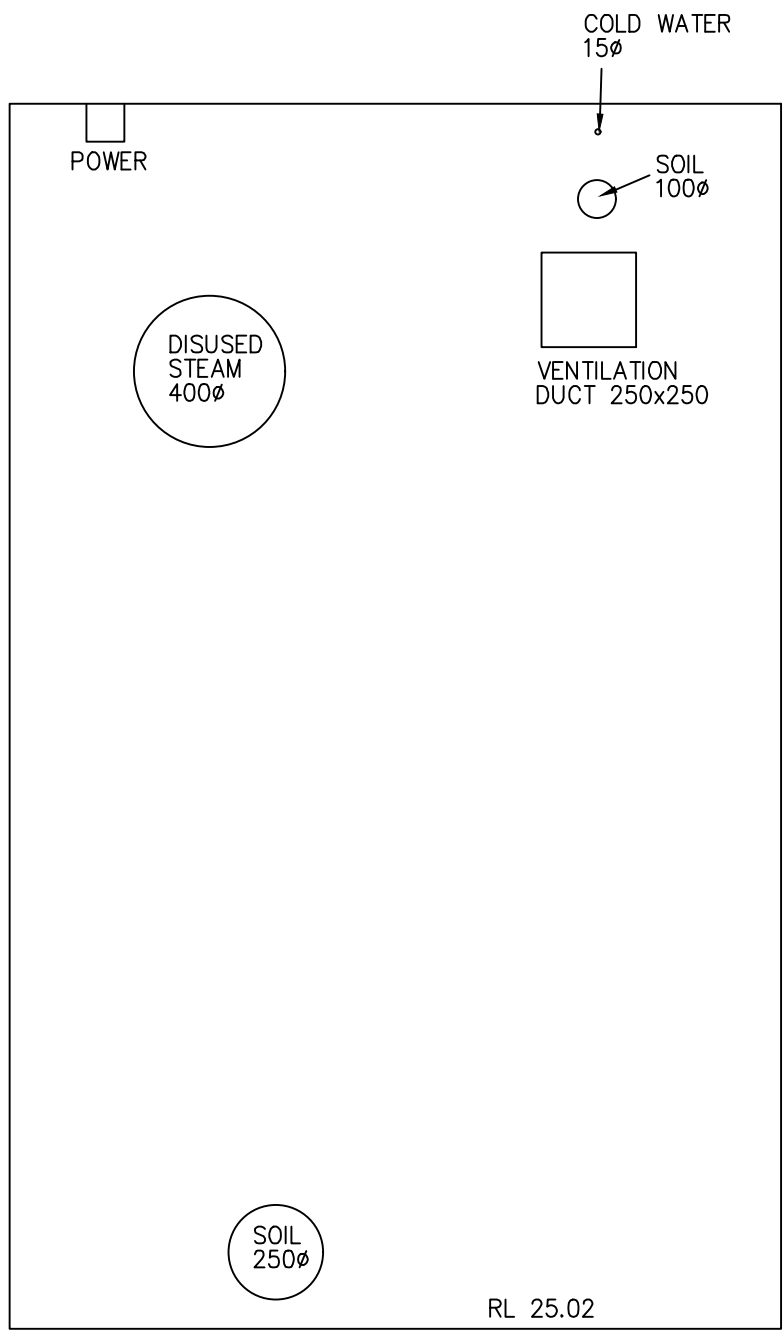

SECTION V-V

1:20

NOTE: SECTIONS 'T8', GG-PP ARE TO SCALE ONLY IN REGARD TO TUNNEL WALL AND PIPE DIAMETER DIMENSIONS. RELATIVE POSITIONS OF SERVICES ARE DIAGRAMMATIC ONLY

SEE SHEET 1 FOR LEGEND AND NOTES



THIS IS THE PLAN REFERRED TO IN MY LETTER DATED:
Registered Surveyor NSW

LTS
LOCKLEY
Registered Surveyors NSW
www.ltsl.com.au

Suite 1, Level 1
810 Pacific Highway
Gordon NSW 2072
Locked Bag 5
Gordon NSW 2072
P 1300 587 000
F 02 9499 7760



Client **HEALTH INFRASTRUCTURE**
Drawing title
PLAN OF DETAIL AND LEVELS OVER LOT 1-6 DP1130879 & LOT 12 DP800476 KNOWN AS "ST GEORGE HOSPITAL" AT KOGARAH

datum
AHD
site Area
5.179ha
LGA
KOGARAH

project number
33459
scale
1:20 @A1
OF 52 SHEETS


reference number
33459DT
date of survey
24/06/15
27

TWB SOUTHERN ELEVATION, GRAY STREET CAR PARK SECTION AND PIT DIAGRAMS

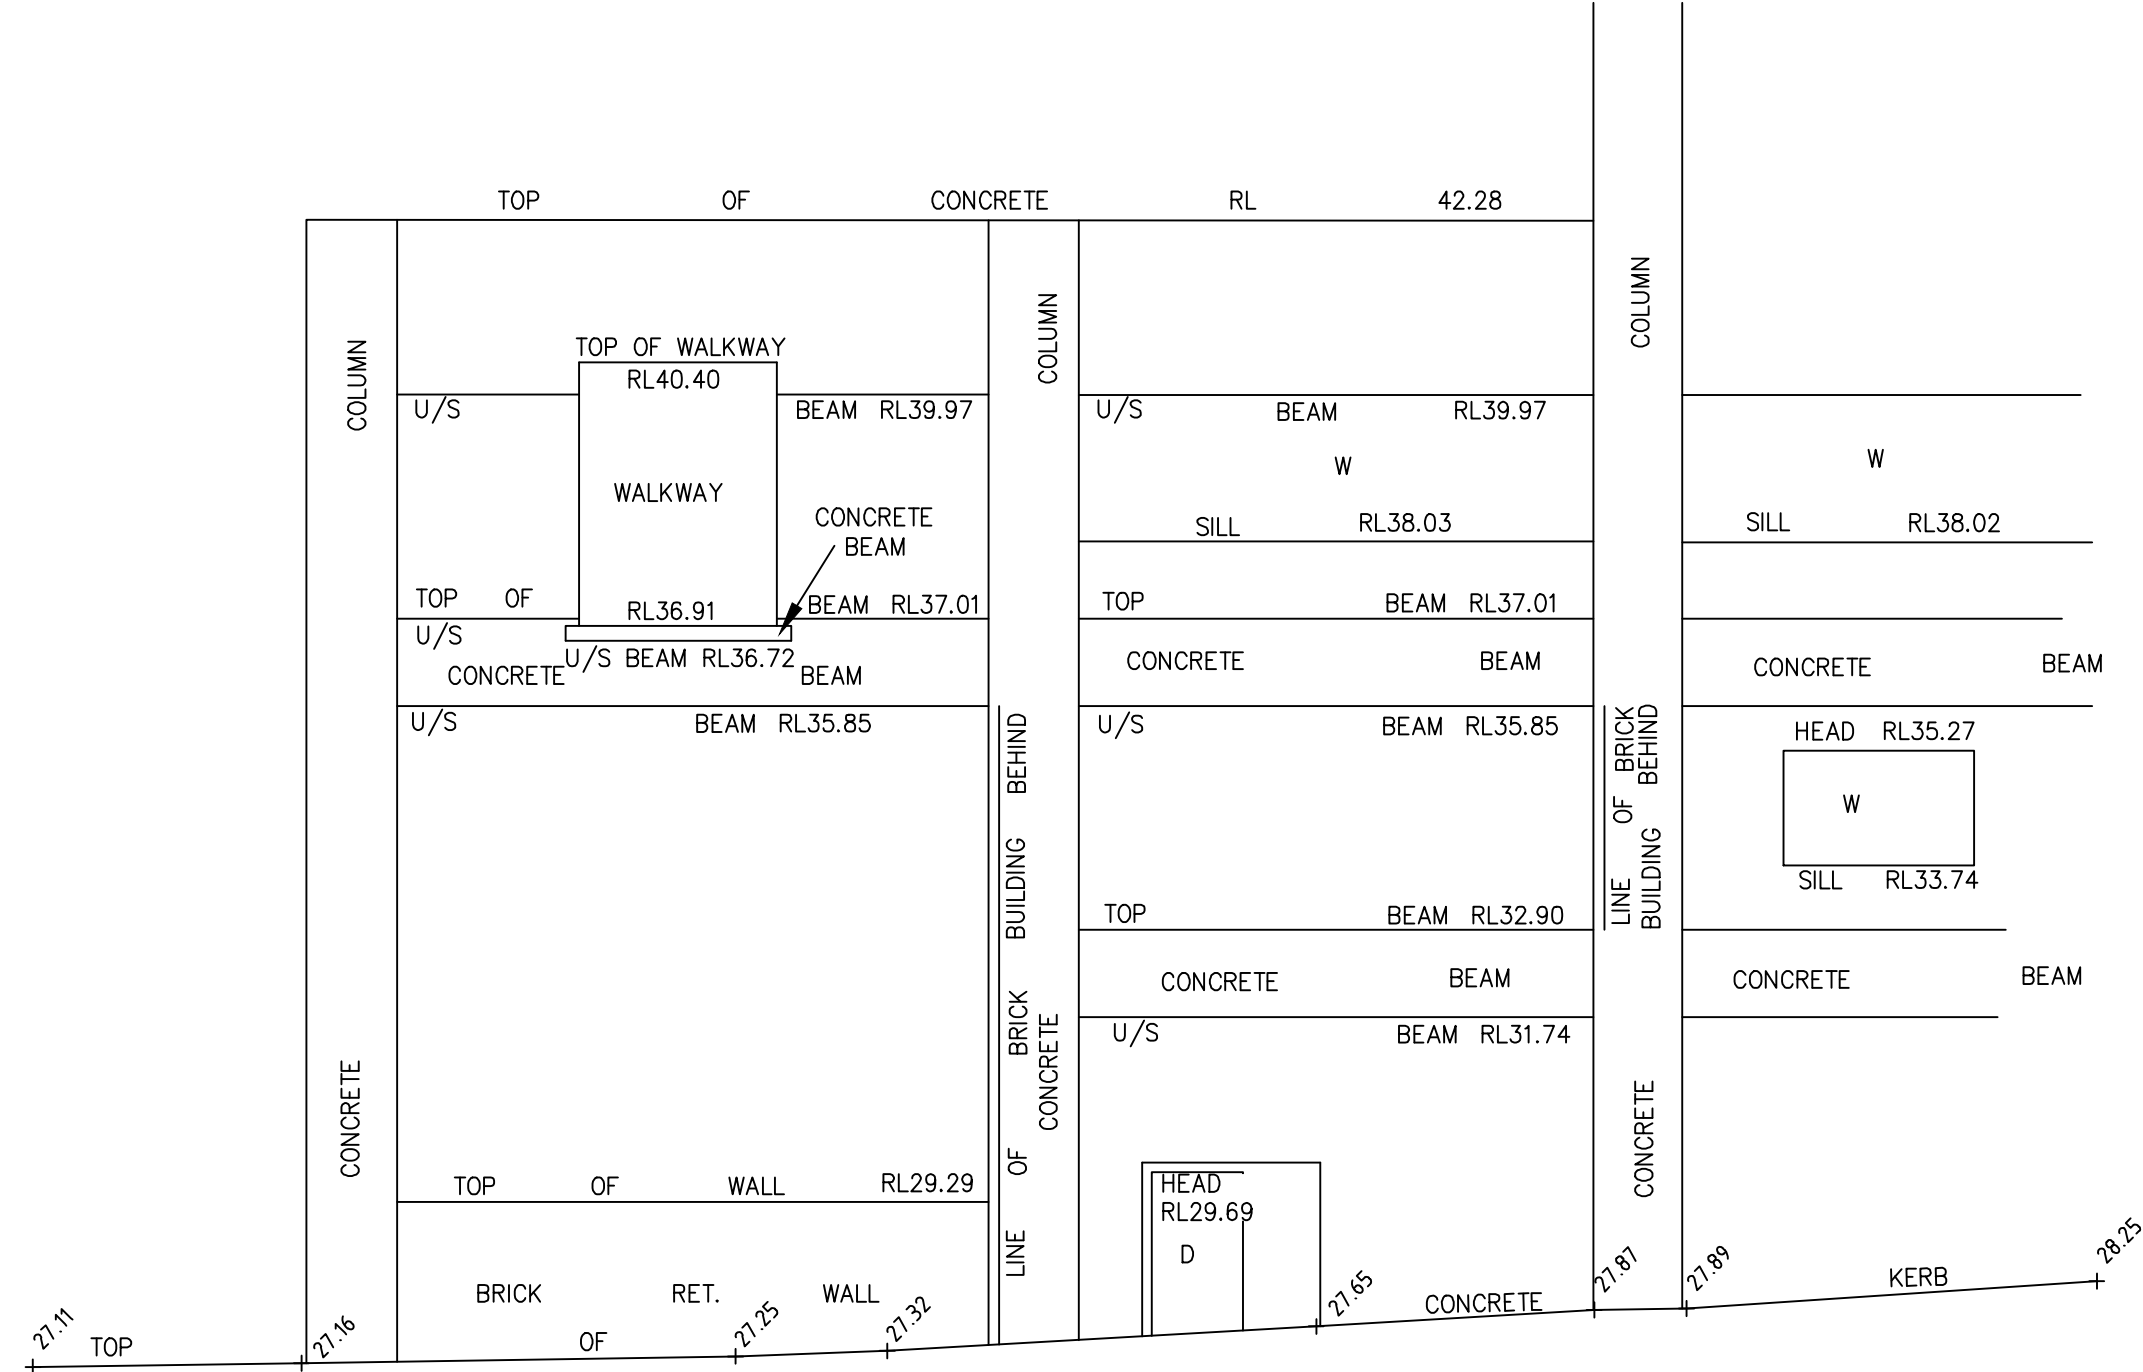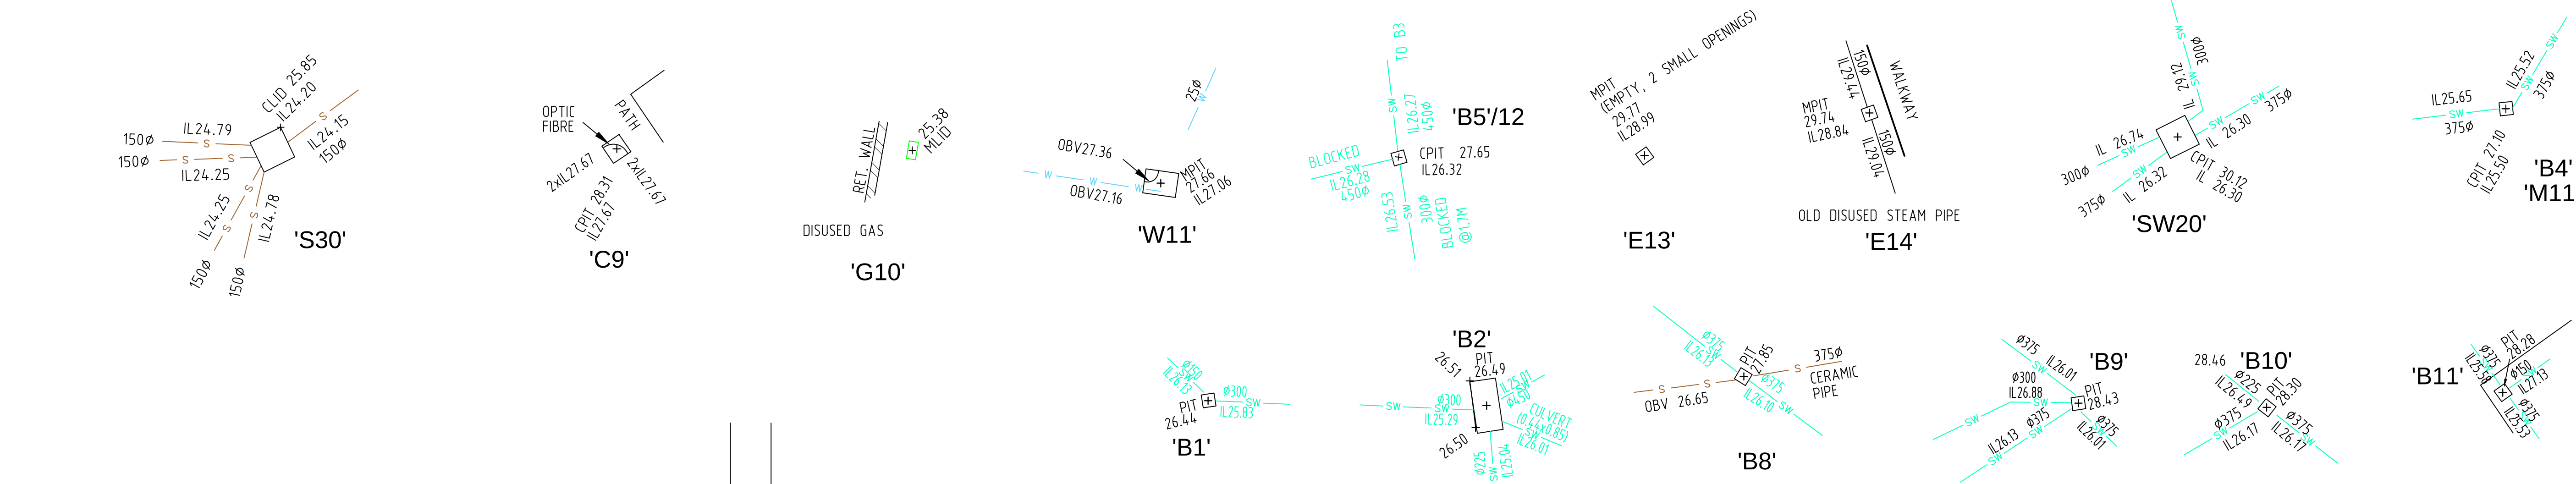


TWB SOUTH EASTERN ELEVATION

SEE SHEET 9
1:100
SURVEYED IN 2011

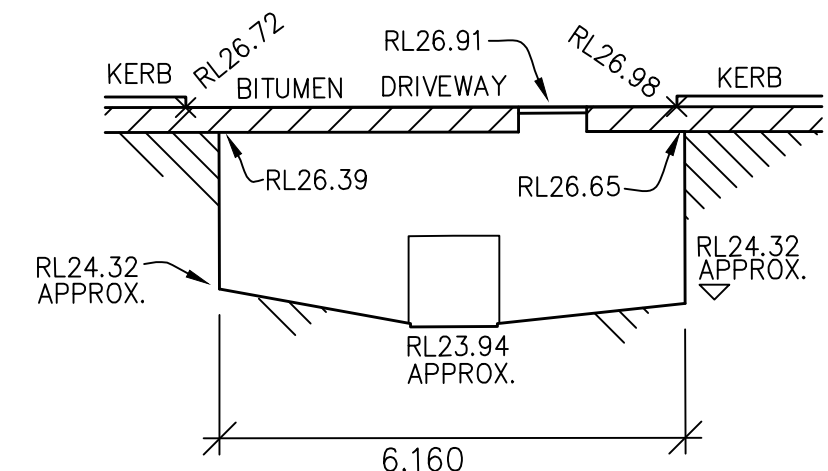


SECTION A-A
SEE SHEET 9
1:100


GRAY STREET

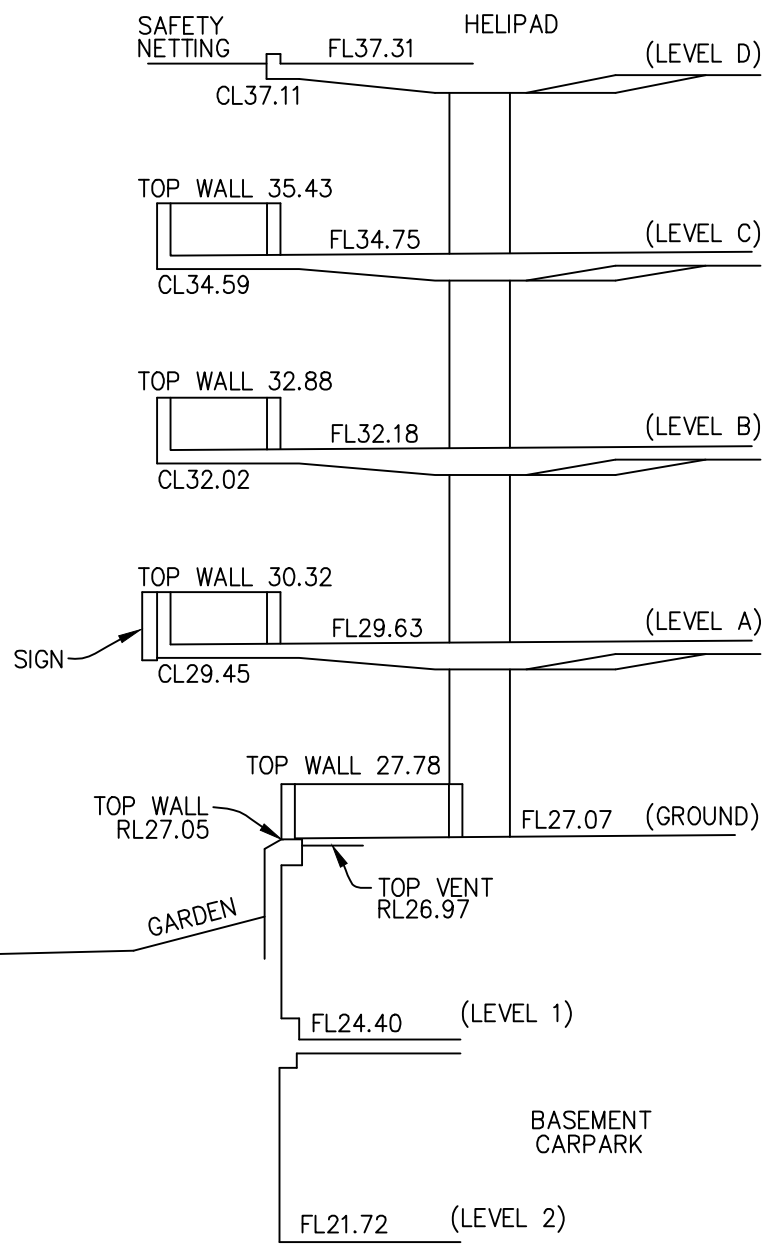

SECTION D-D
SEE SHEET 9
1:100

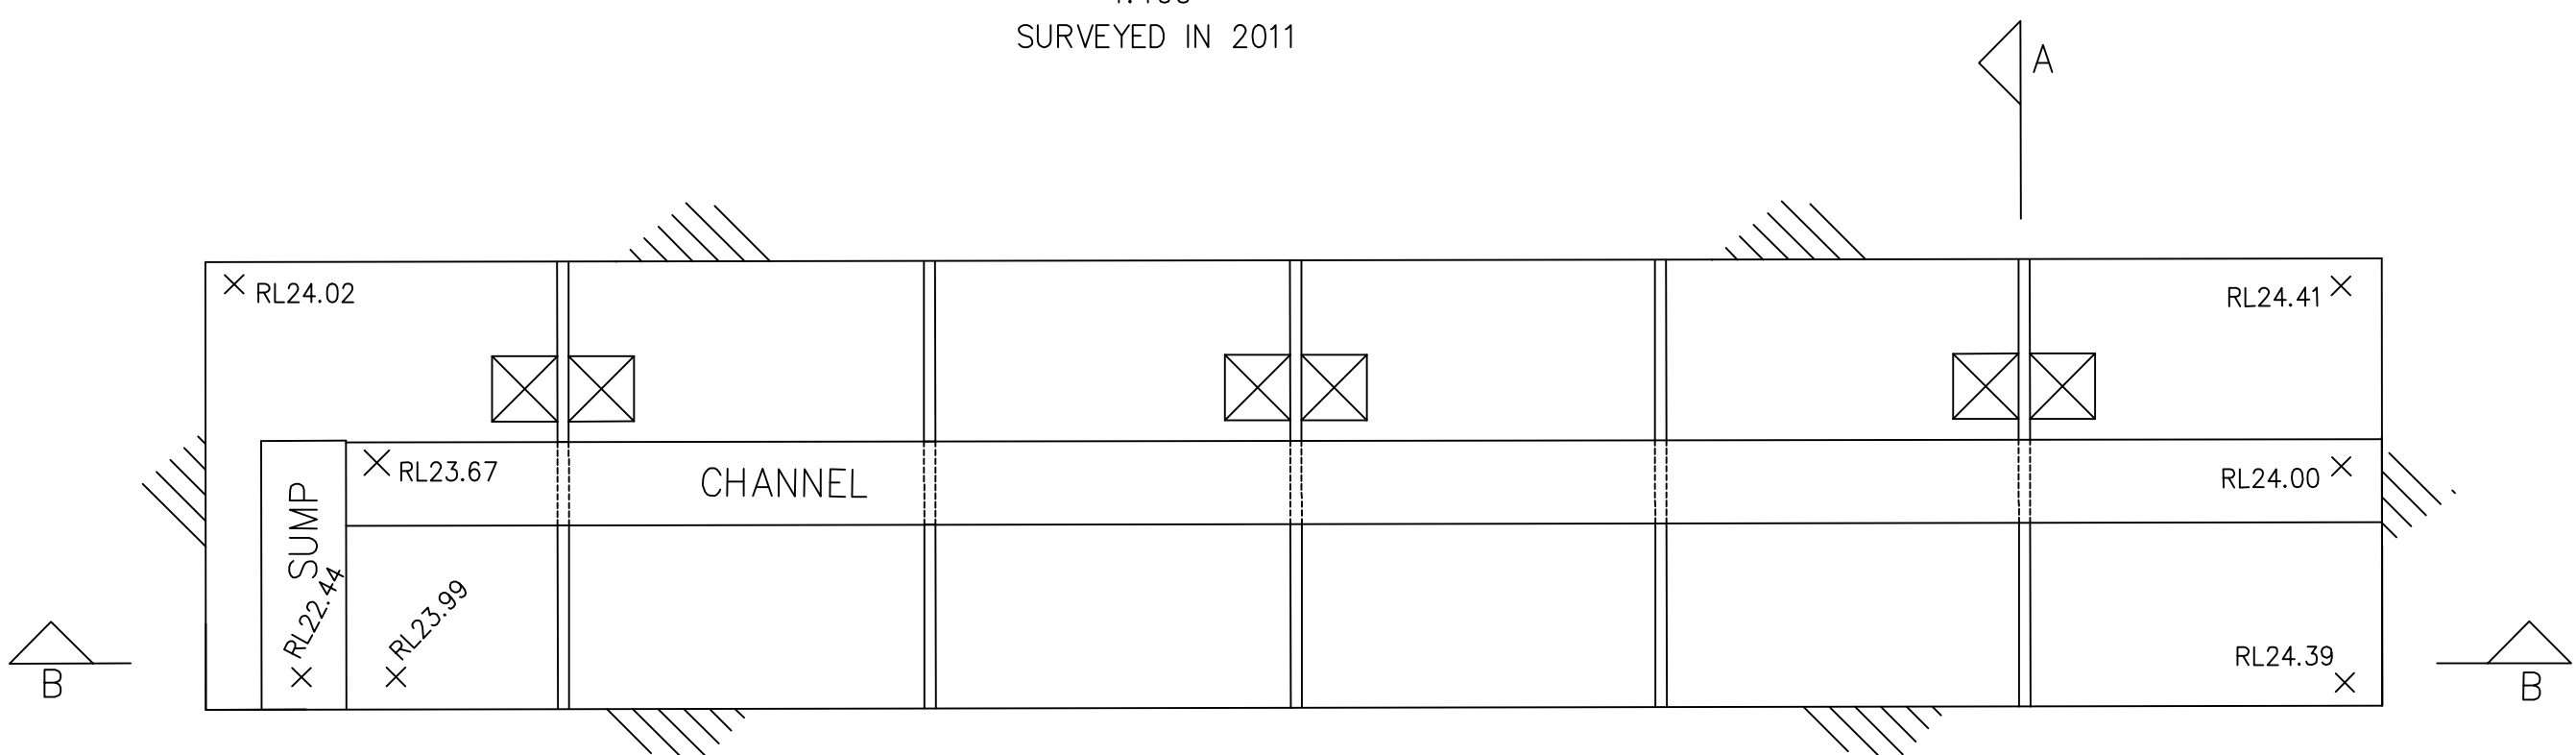

DETENTION TANK DIAGRAM
SEE SHEET 9
1:100

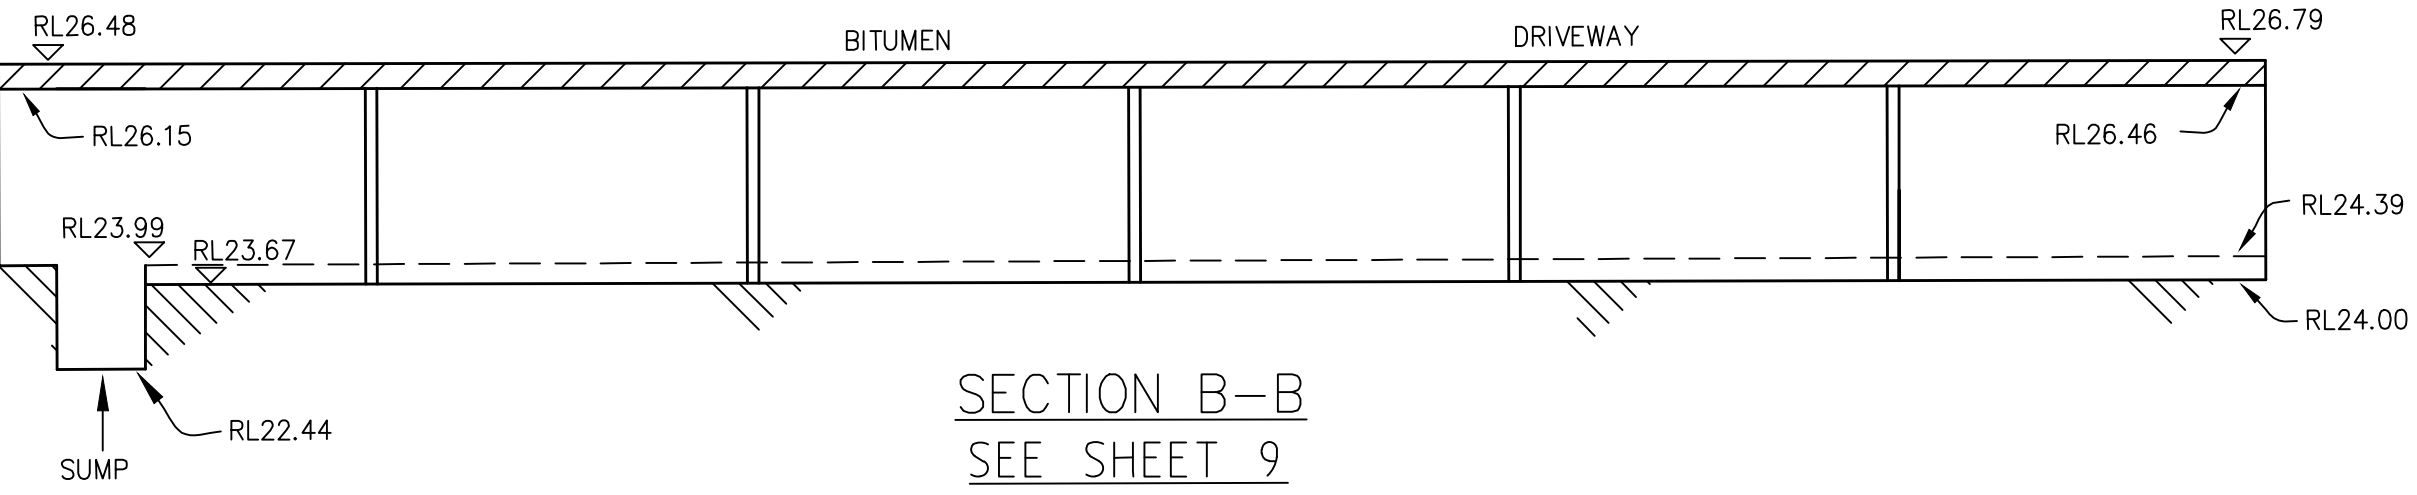

SECTION B-B
SEE SHEET 9
1:100

SEE SHEET 1 FOR LEGEND AND NOTES



THIS IS THE PLAN REFERRED TO
IN MY LETTER DATED:
Registered Surveyor NSW



Suite 1, Level 1
810 Pacific Highway
Gordon NSW 2072
Locked Bag 5
Gordon NSW 2072
P 1300 587 000
F 02 9499 7760


Client HEALTH INFRASTRUCTURE
Drawing title
PLAN OF DETAIL AND LEVELS OVER LOT 1-6 DP1130879 &
LOT 12 DP800476 KNOWN AS "ST GEORGE HOSPITAL" AT
KOGARAH

datum
AHD
site Area
5.179ha
LGA
KOGARAH


project number
33459
scale
1:100 @A1
OF 52 SHEETS

reference number
33459DT
date of survey
24/06/15
SHEET 28


DETENTION TANK DIAGRAMS AND SECTIONS

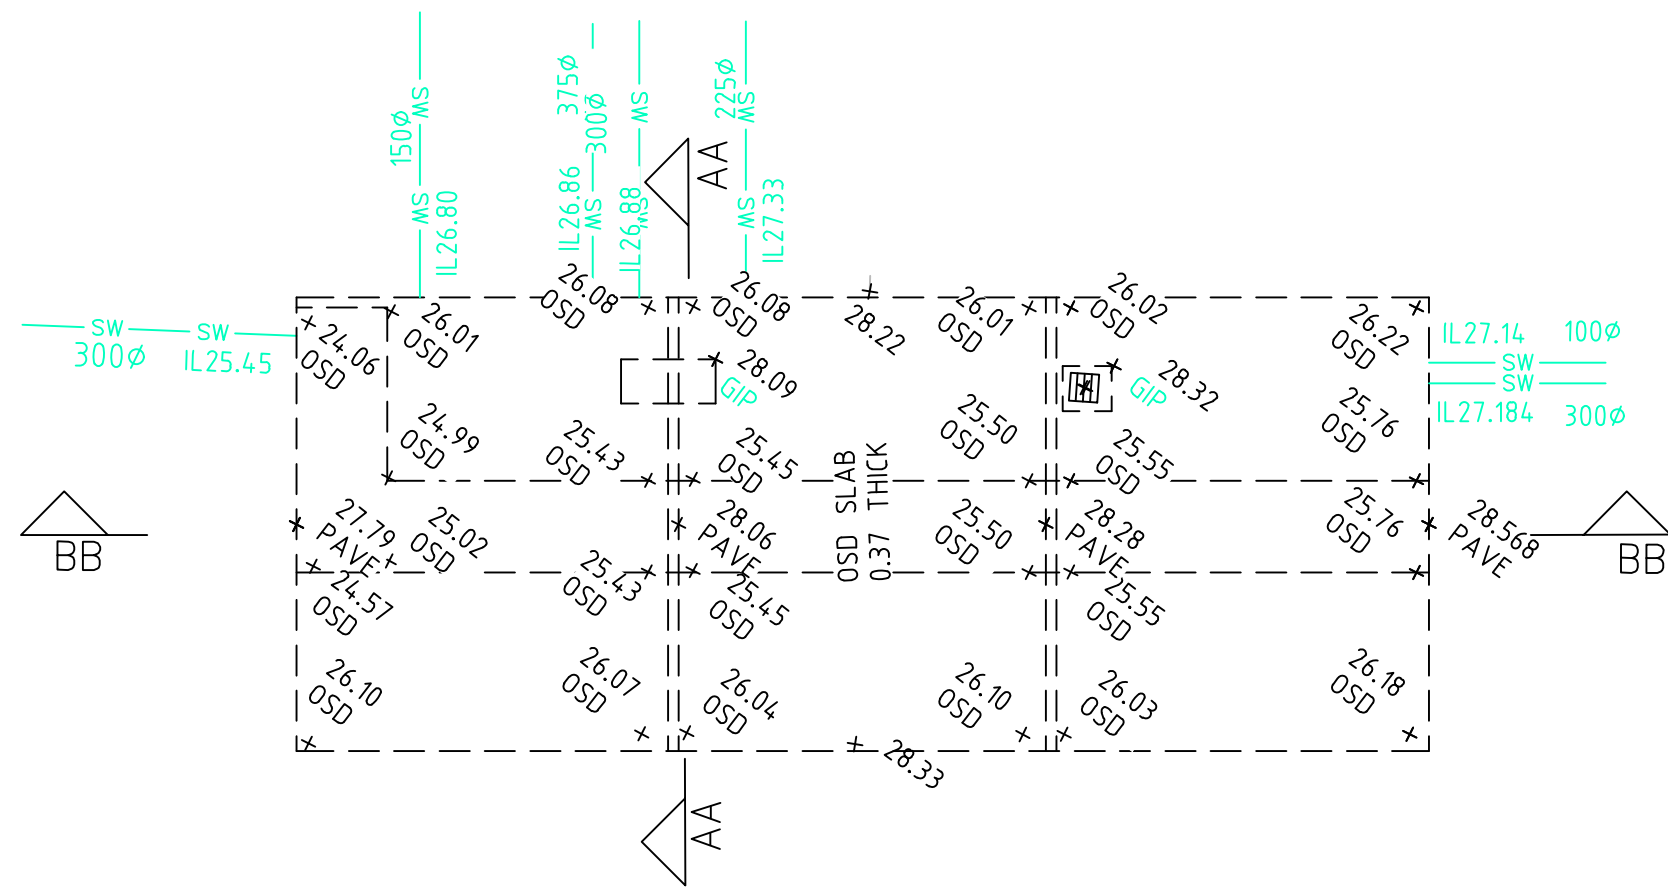


CANCER CARE OSD DIAGRAM
SEE SHEET 13
1:100

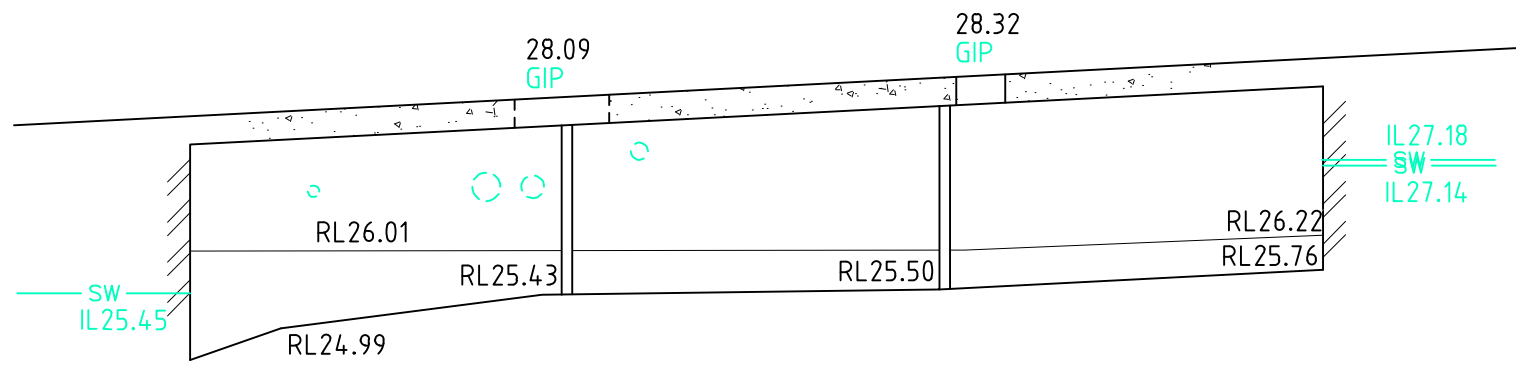


CANCER CARE OSD SECTION BB-BB
SEE SHEET 13
1:100

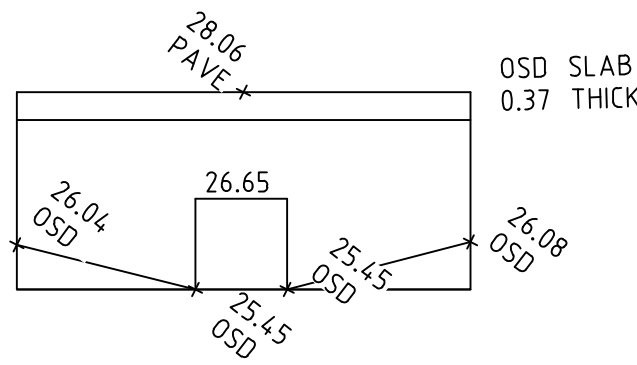


CANCER CARE OSD SECTION AA-AA
SEE SHEET 13
1:100

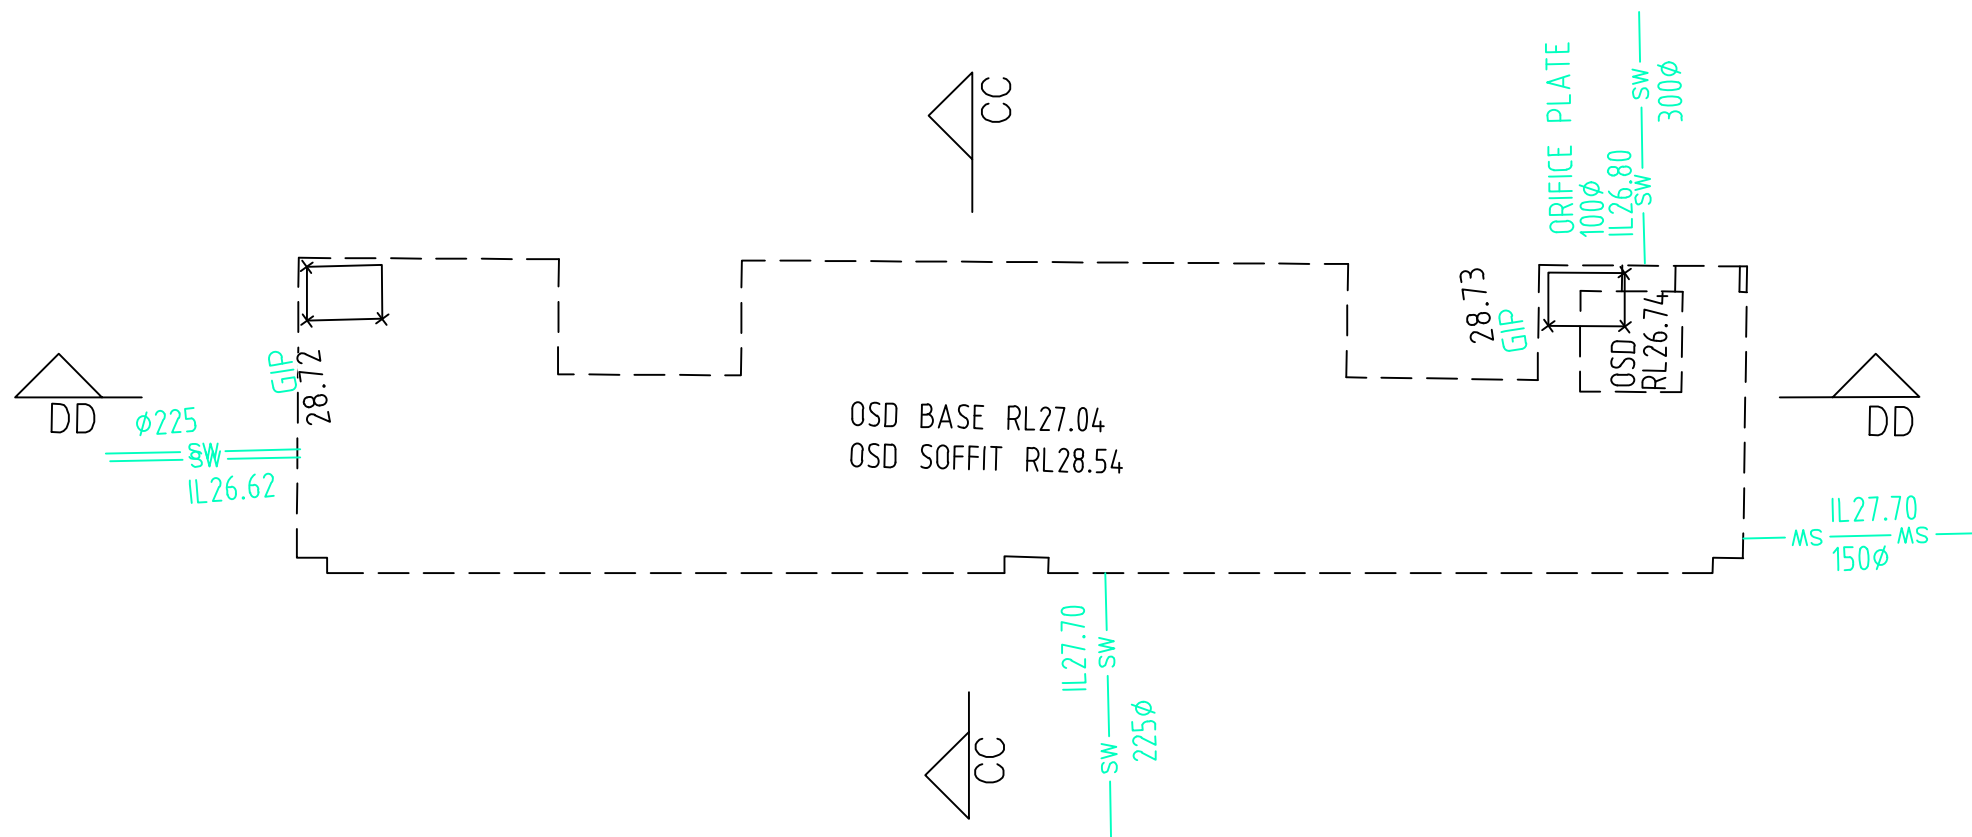


SERVICES CENTRE OSD DIAGRAM
SEE SHEET 7
1:100

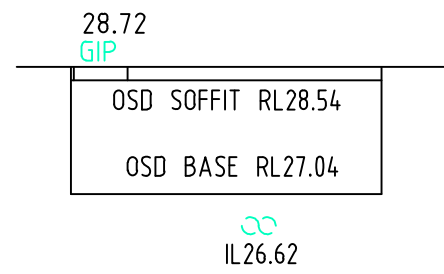


SERVICES CENTRE OSD SECTION CC-CC
SEE SHEET 7
1:100

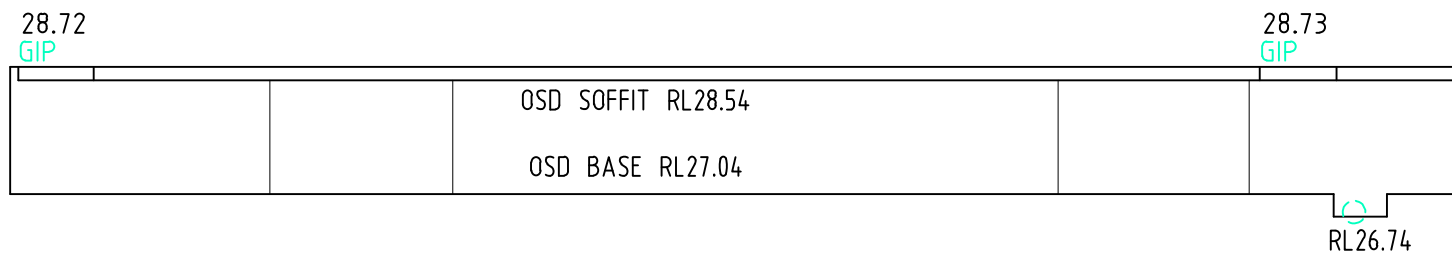


SERVICES CENTRE OSD SECTION DD-DD
SEE SHEET 7
1:100

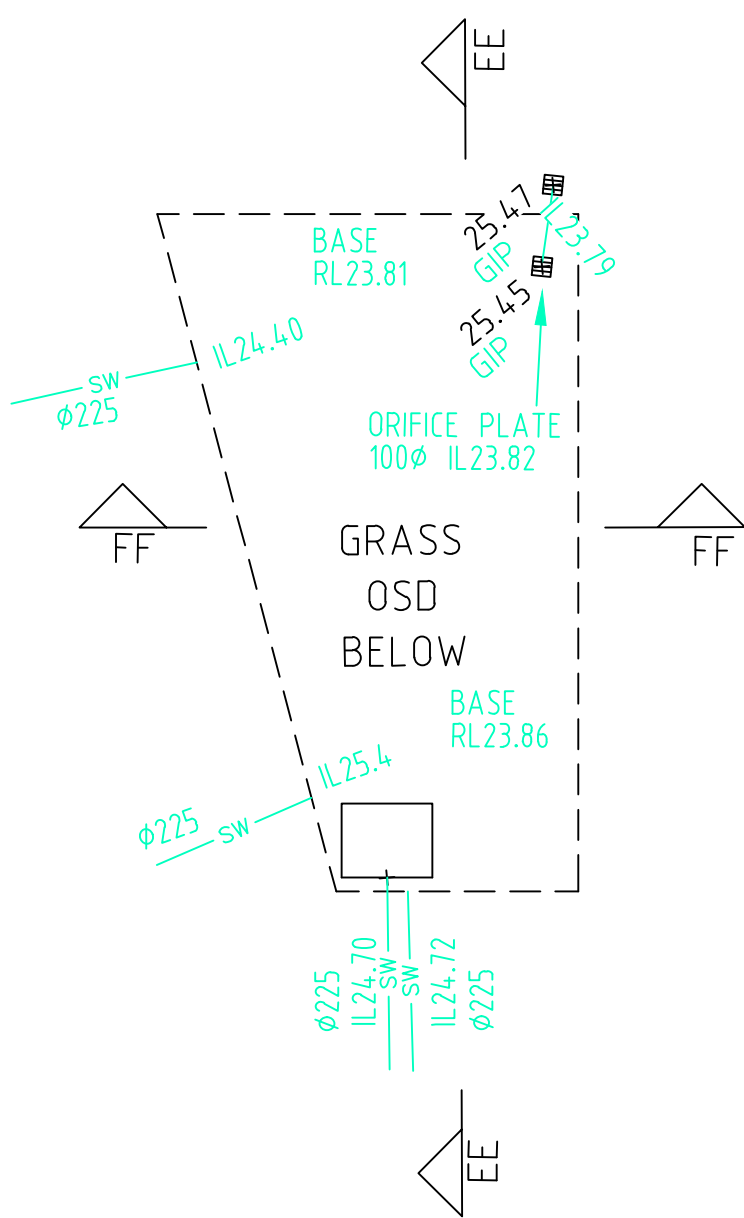

SUB ACUTE MENTAL HEALTH OSD DIAGRAM
SEE SHEET 11
1:100

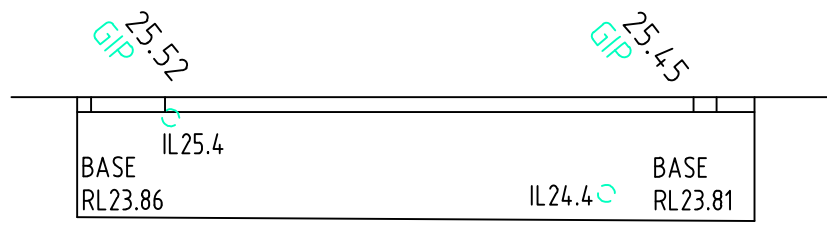

SUB ACUTE MENTAL HEALTH OSD SECTION EE-EE
SEE SHEET 11
1:100

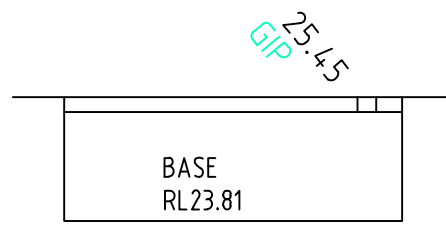

SUB ACUTE MENTAL HEALTH OSD SECTION FF-FF
SEE SHEET 11
1:100

SEE SHEET 1 FOR LEGEND AND NOTES



THIS IS THE PLAN REFERRED TO
IN MY LETTER DATED:
.....
Registered Surveyor NSW

LTS
LOCKLEY
Registered Surveyors NSW
www.ltsl.com.au

Suite 1, Level 1
810 Pacific Highway
Gordon NSW 2072
Locked Bag 5
Gordon NSW 2072
P 1300 587 000
F 02 9499 7760


Client **HEALTH INFRASTRUCTURE**
Drawing title
**PLAN OF DETAIL AND LEVELS OVER LOT 1-6 DP1130879 &
LOT 12 DP800476 KNOWN AS "ST GEORGE HOSPITAL" AT
KOGARAH**

datum
AHD
site Area
5.179ha
LGA
KOGARAH

project number
33459
scale
1:100 @A1
reference number
33459DT
date of survey
24/06/15
SHEET
52
SHEETS
29


GRAY STREET CAR PARK PLAN

SHEET 31 ADJOINS

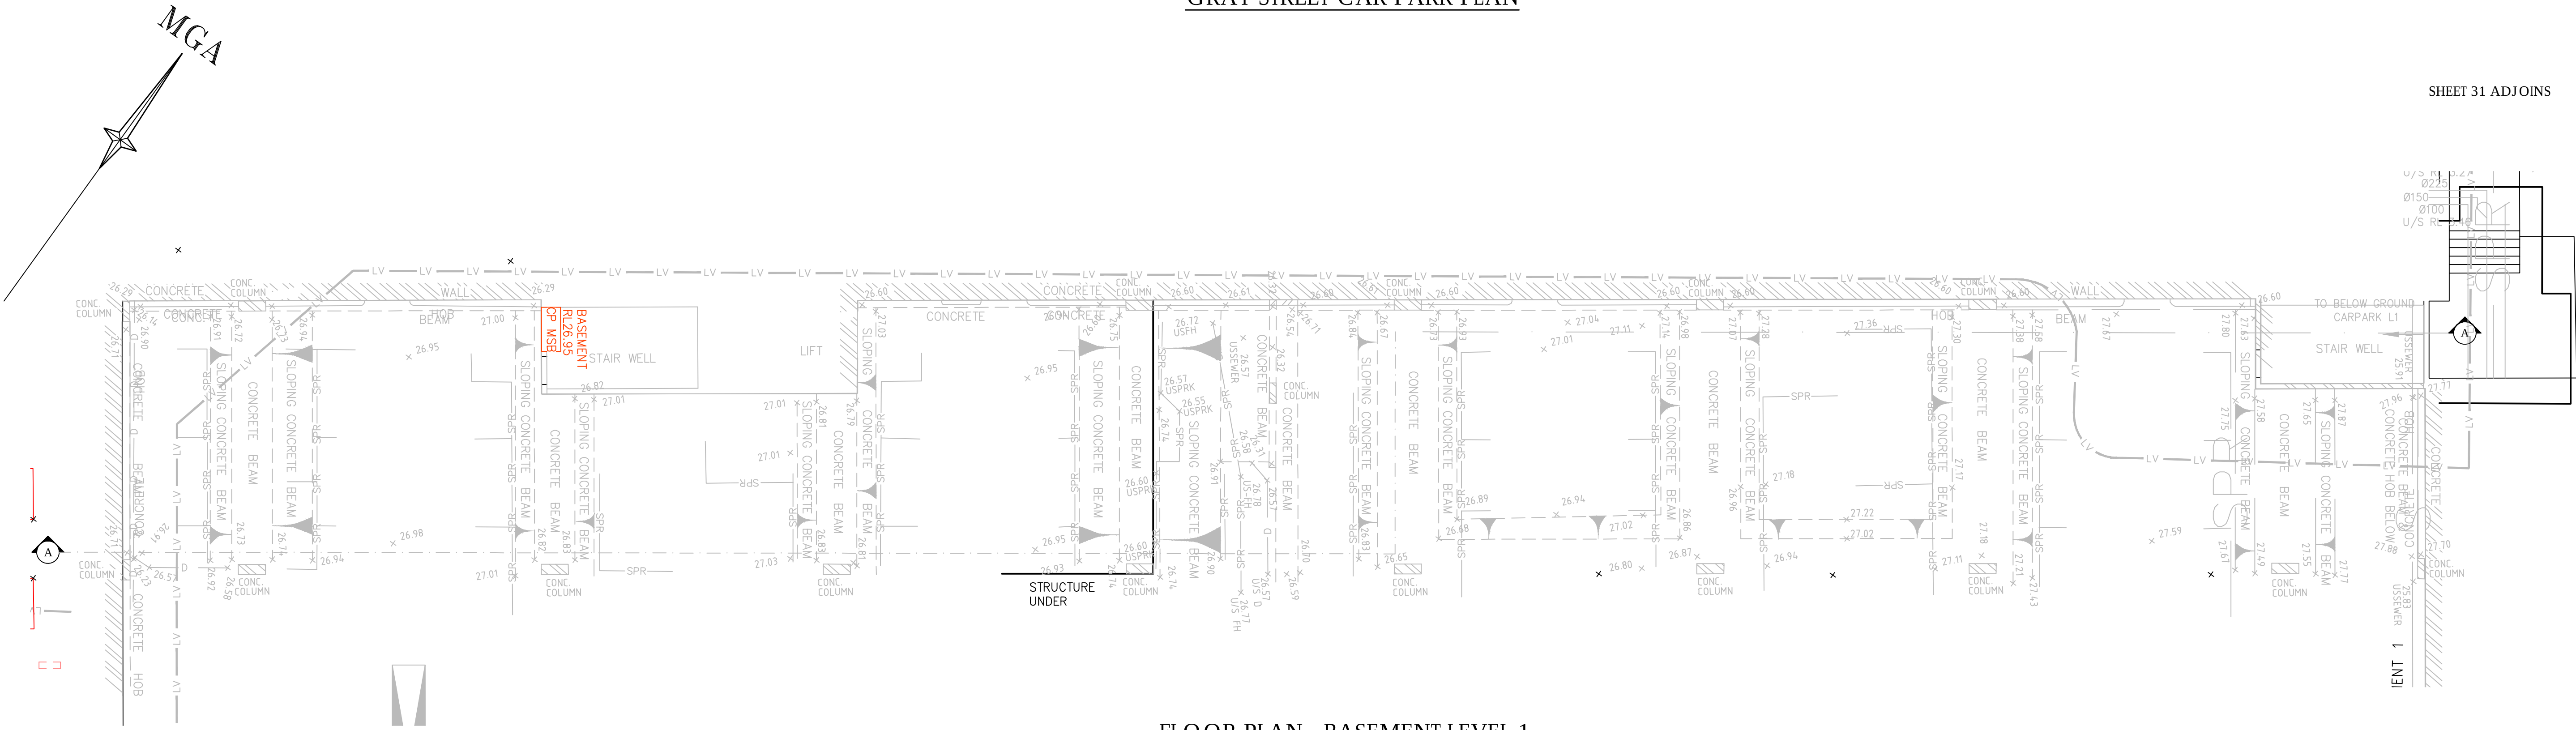


FLOOR PLAN - BASEMENT LEVEL 1

SHEET 31 ADJOINS

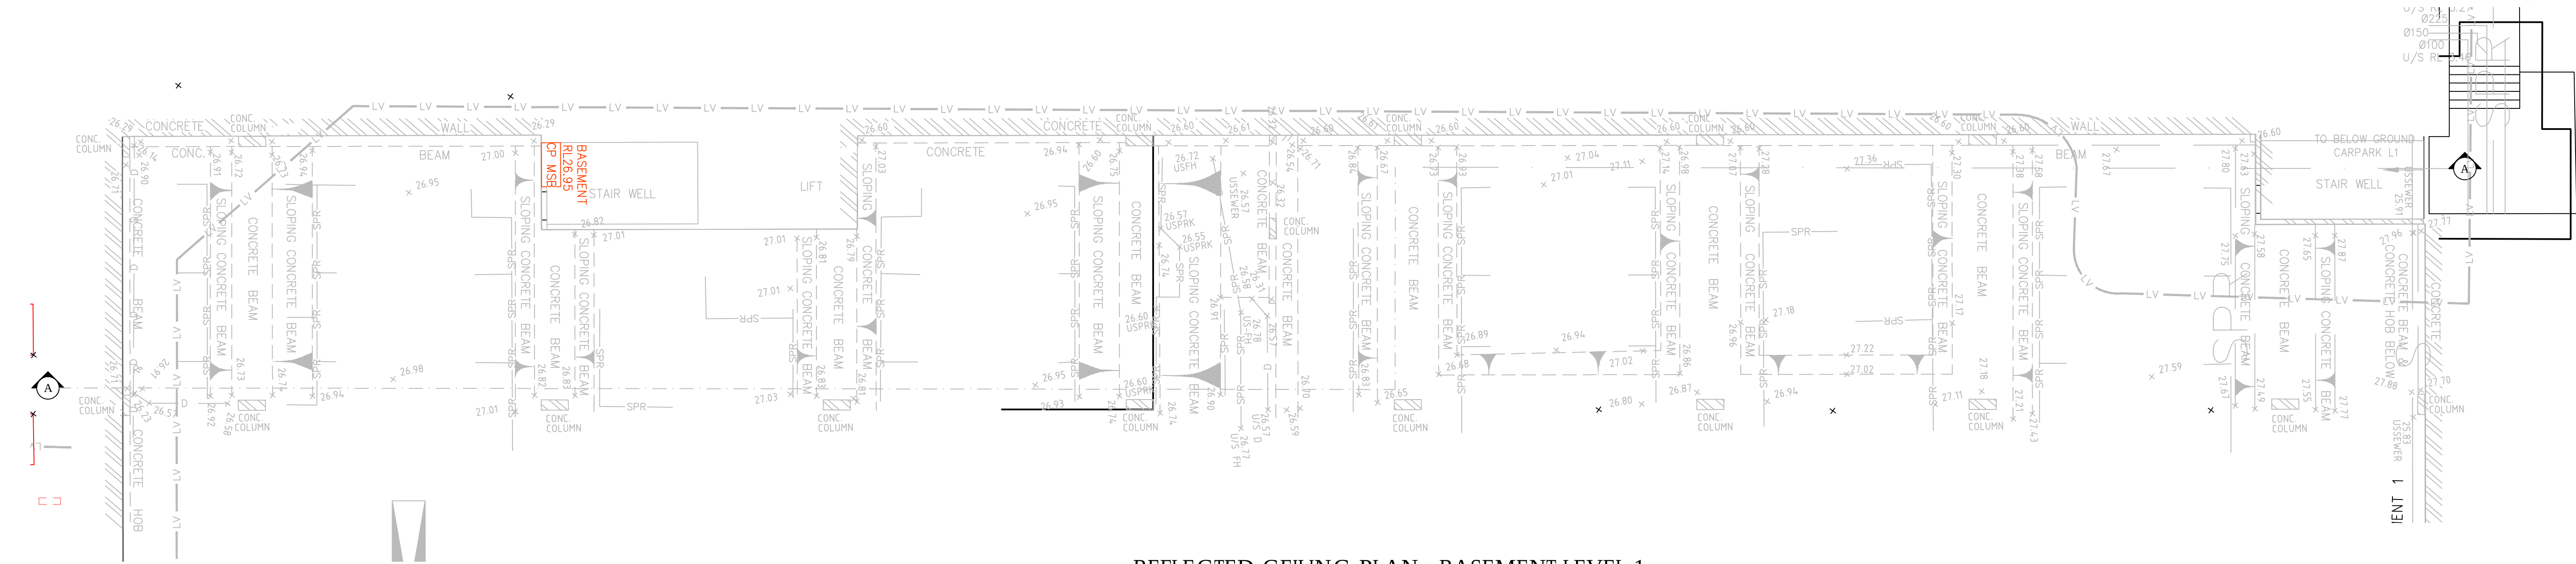

REFLECTED CEILING PLAN - BASEMENT LEVEL 1

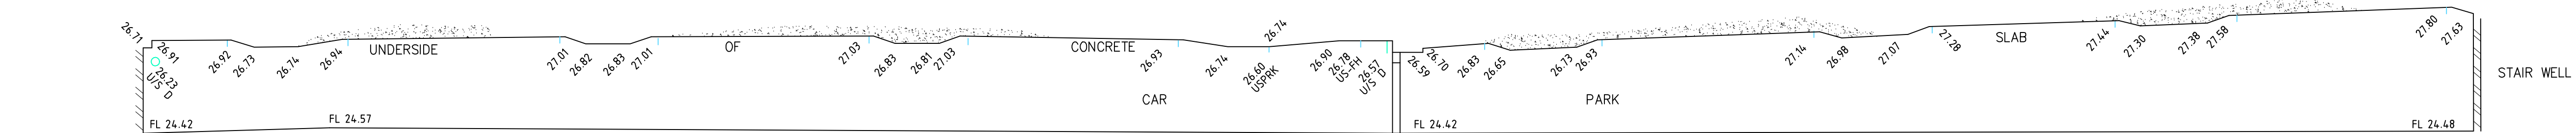

SECTION A-A

NOTE INTERNAL INFORMATION HAS BEEN SURVEYED PRIOR TO ELEMENT 1
FLOOR PLAN SHOWN GREY SURVEYED AUGUST 2012

SEE SHEET 1 FOR LEGEND AND NOTES



THIS IS THE PLAN REFERRED TO
IN MY LETTER DATED:
Registered Surveyor NSW

LTS
LOCKLEY
Registered Surveyors NSW
www.ltsl.com.au


Suite 1, Level 1
810 Pacific Highway
Gordon NSW 2072
Locked Bag 5
Gordon NSW 2072
P 1300 587 000
F 02 9499 7760

Client **HEALTH INFRASTRUCTURE**
Drawing title
**PLAN OF DETAIL AND LEVELS OVER LOT 1-6 DP1130879 &
LOT 12 DP800476 KNOWN AS "ST GEORGE HOSPITAL" AT
KOGARAH**


datum
AHD
site Area
5.179ha
LGA
KOGARAH

project number
33459
scale
1:100 @A1
OF SHEETS

reference number
33459DT
date of survey
24/06/15
30

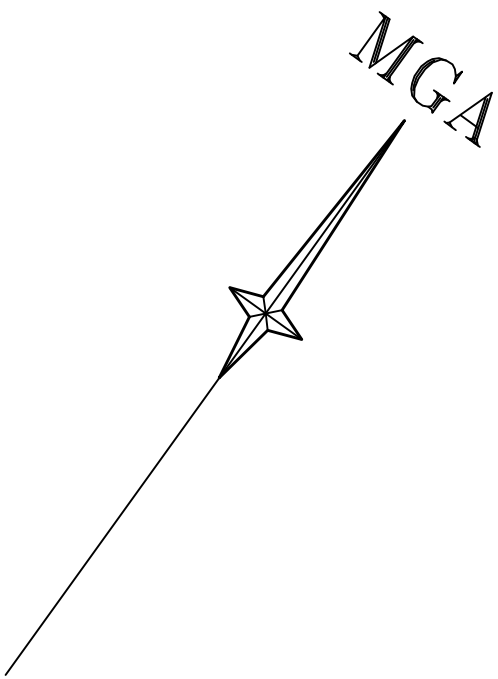

TOWER WARD BLOCK
LOWER GROUND CORRIOR

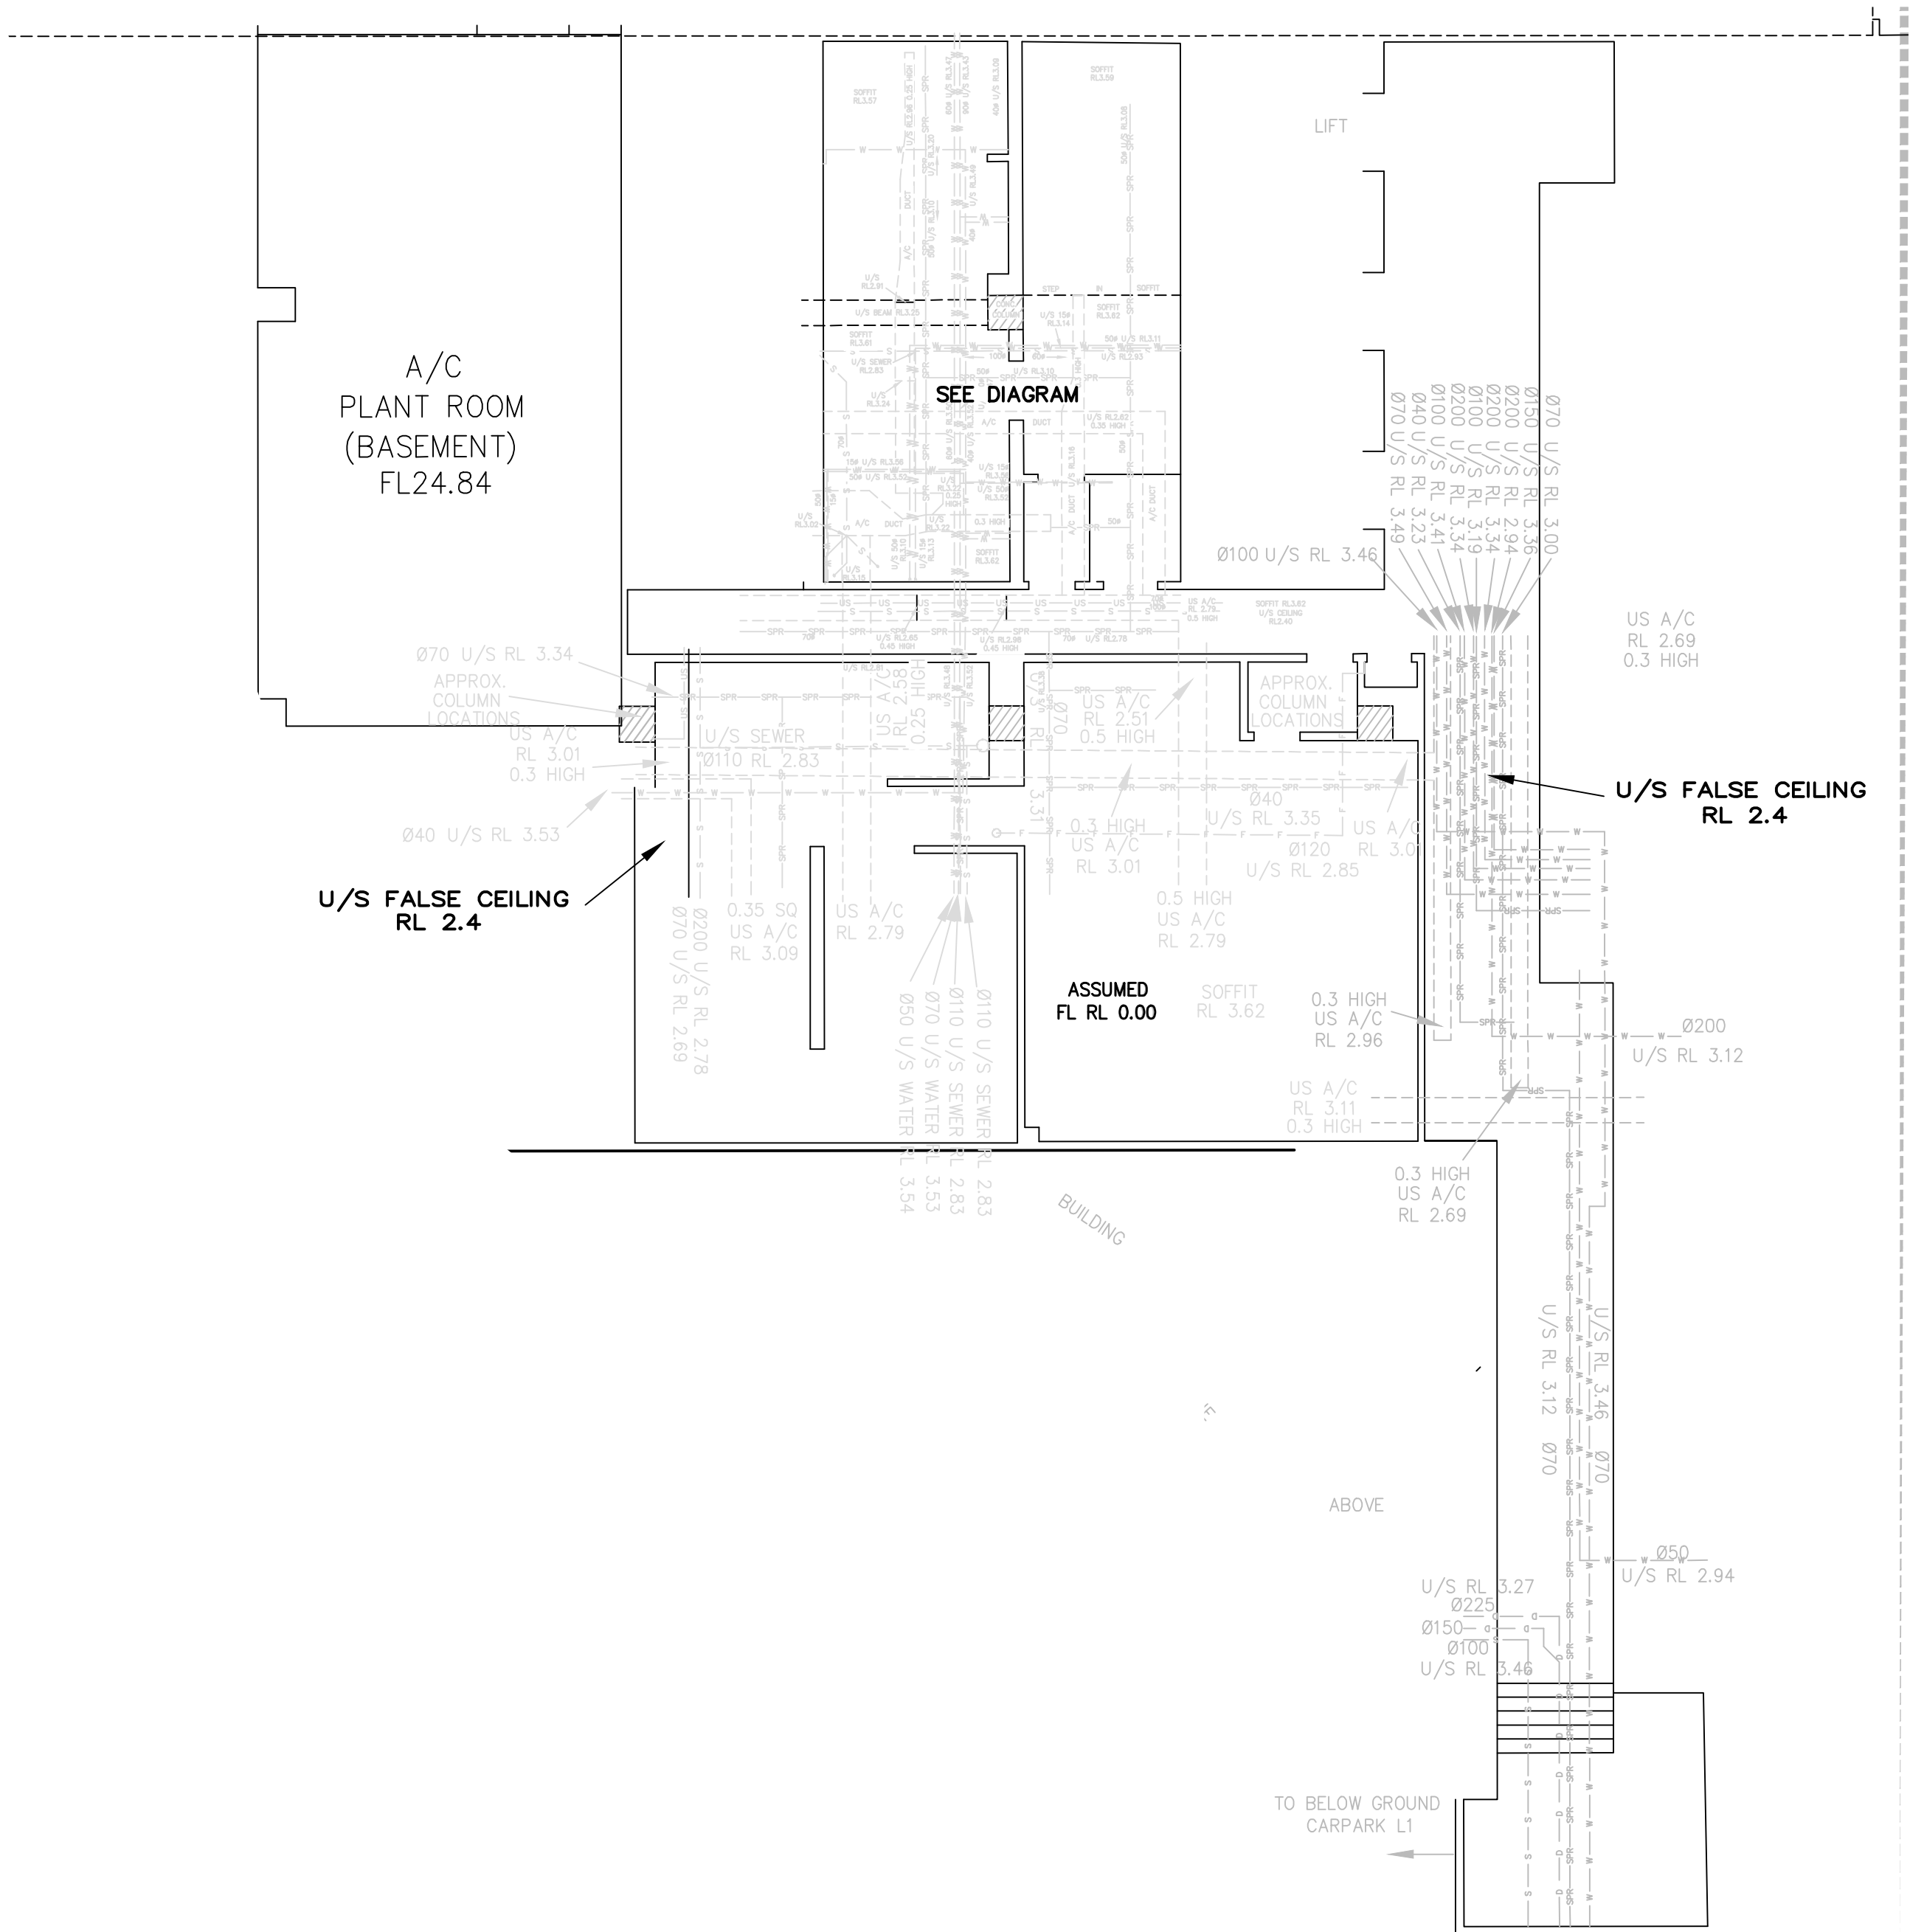

GRAY STREET
CAR PARK
BASEMENT LEVEL 1

SHEET 30 ADJOINS

NOTE: LEVELS ARE ON ASSUMED
DATUM RL.0.00 AS SHOWN, FOR
THIS AREA ONLY UNLESS STATED
OTHERWISE

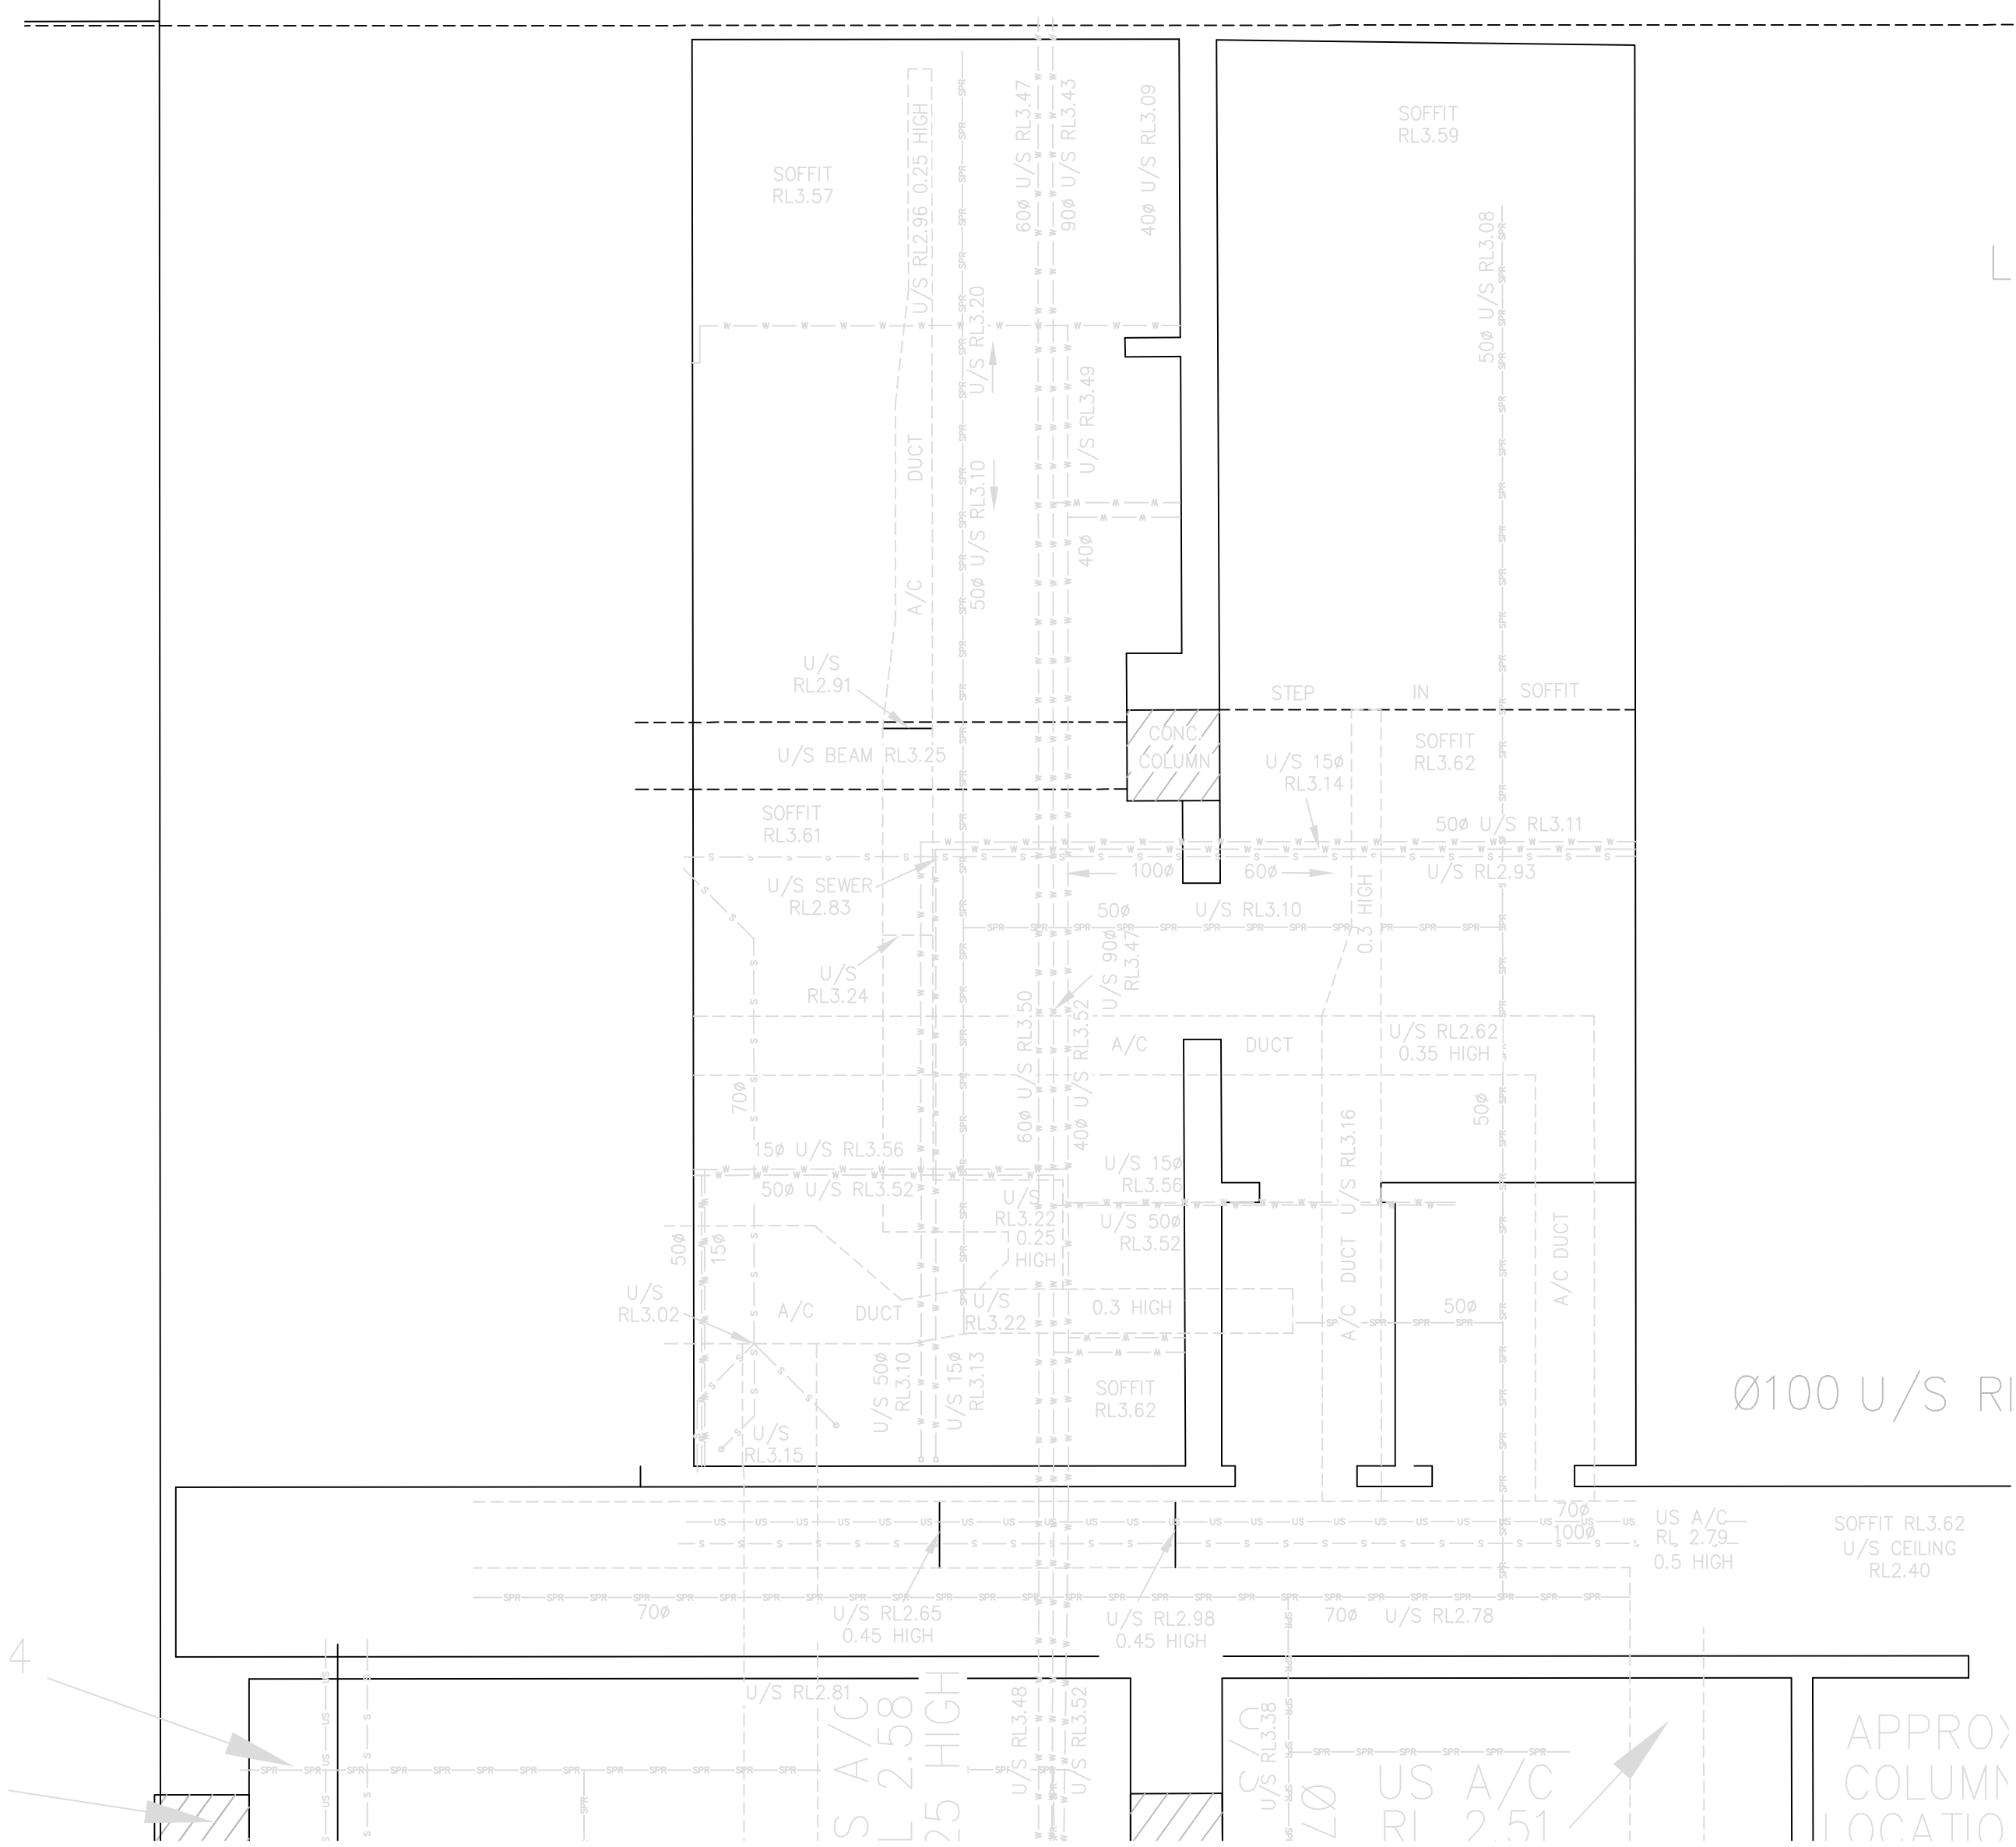


DIAGRAM
1:40

NOTE INTERNAL INFORMATION HAS BEEN SURVEYED PRIOR TO ELEMENT 1
FLOOR PLAN SHOWN GREY SURVEYED AUGUST 2012

SEE SHEET 1 FOR LEGEND AND NOTES

THIS IS THE PLAN REFERRED TO
IN MY LETTER DATED:
.....
Registered Surveyor NSW

LTS
LOCKLEY
Registered Surveyors NSW
www.ltsl.com.au

Suite 1, Level 1
810 Pacific Highway
Gordon NSW 2072
Locked Bag 5
Gordon NSW 2072
P 1300 587 000
F 02 9499 7760


Client HEALTH INFRASTRUCTURE
Drawing title
PLAN OF DETAIL AND LEVELS OVER LOT 1-6 DP1130879 &
LOT 12 DP800476 KNOWN AS "ST GEORGE HOSPITAL" AT
KOGARAH

datum
AHD
site Area
5.179ha
LGA
KOGARAH


project number
33459
scale
1:100 @A1

reference number
33459DT
date of survey
24/06/15
SHEET
OF 52 SHEETS




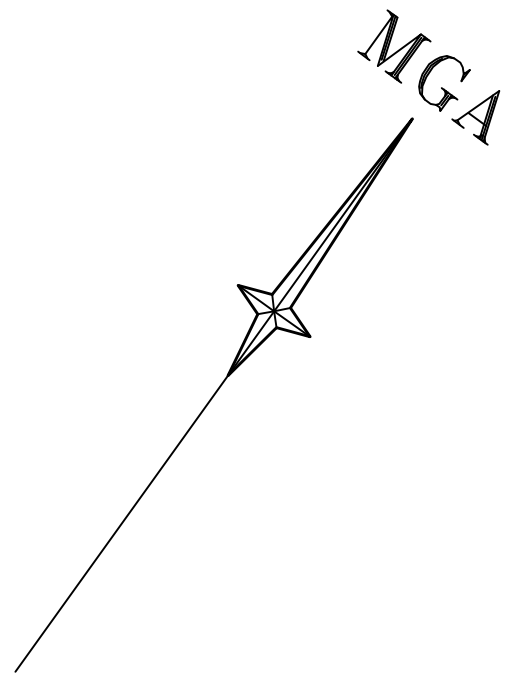

"MAIN ENTRY" ZONE 1 GROUND FLOOR
"TOWER WARD BLOCK"

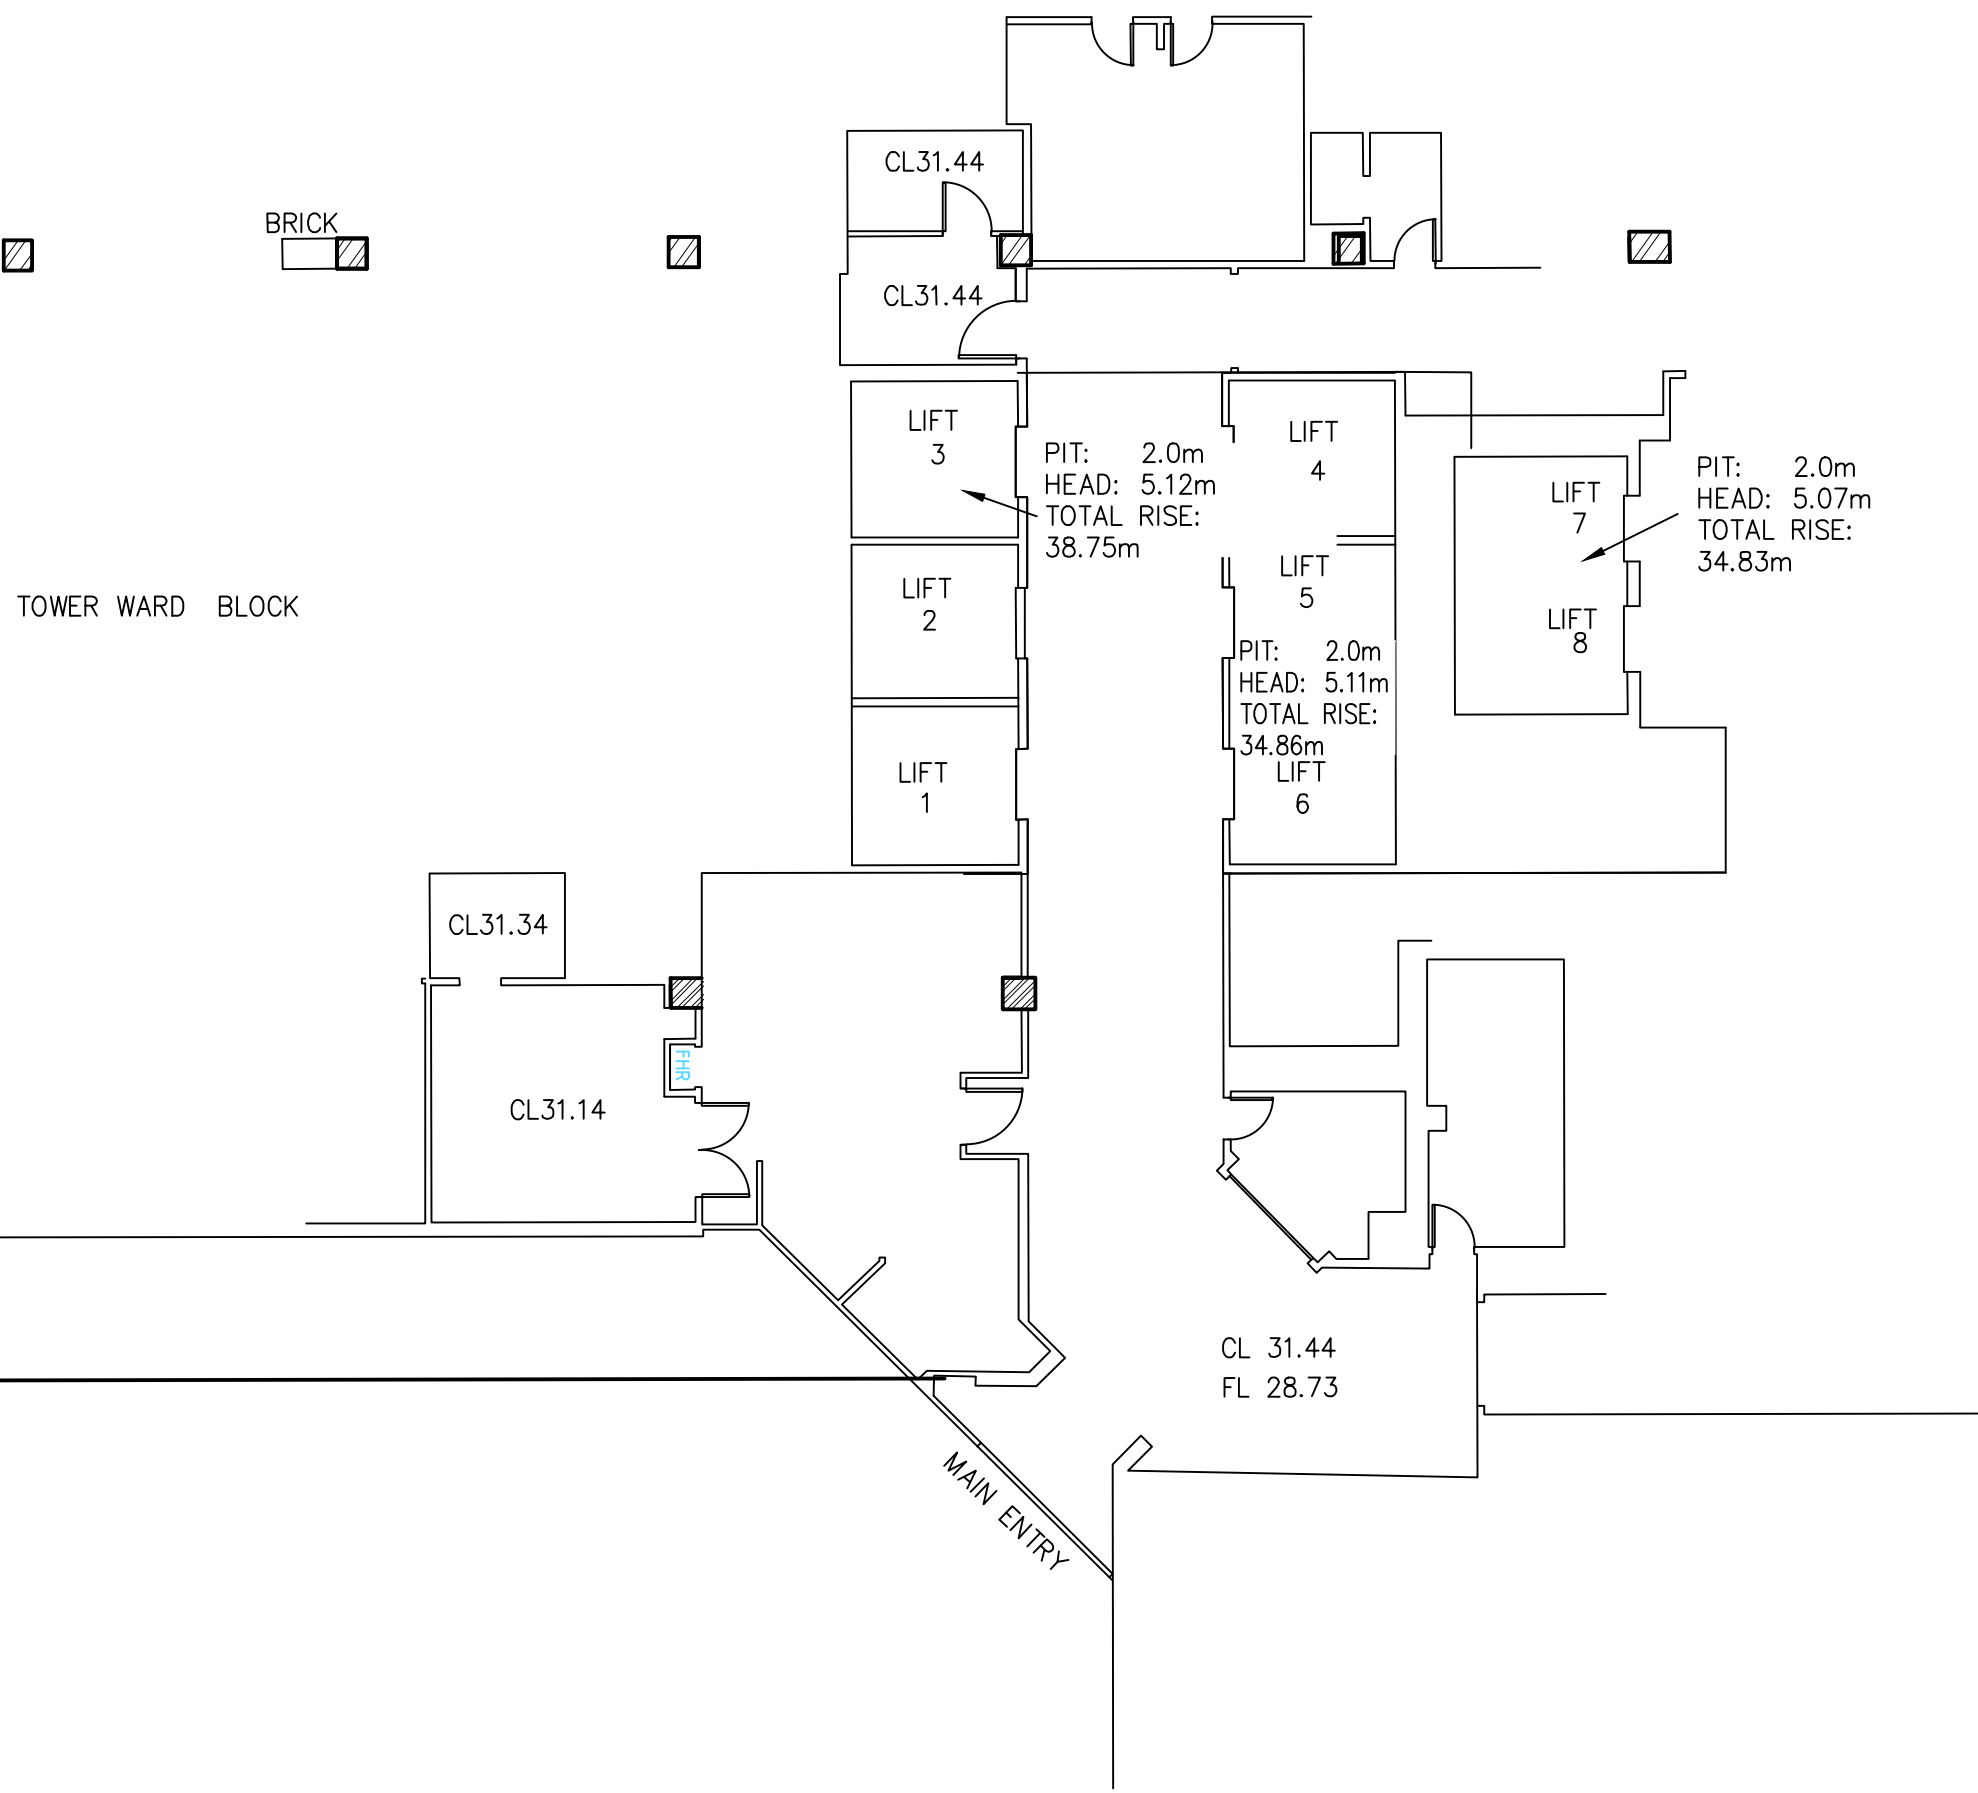

ZONE 6 LEVEL 1
"TOWER WARD BLOCK"

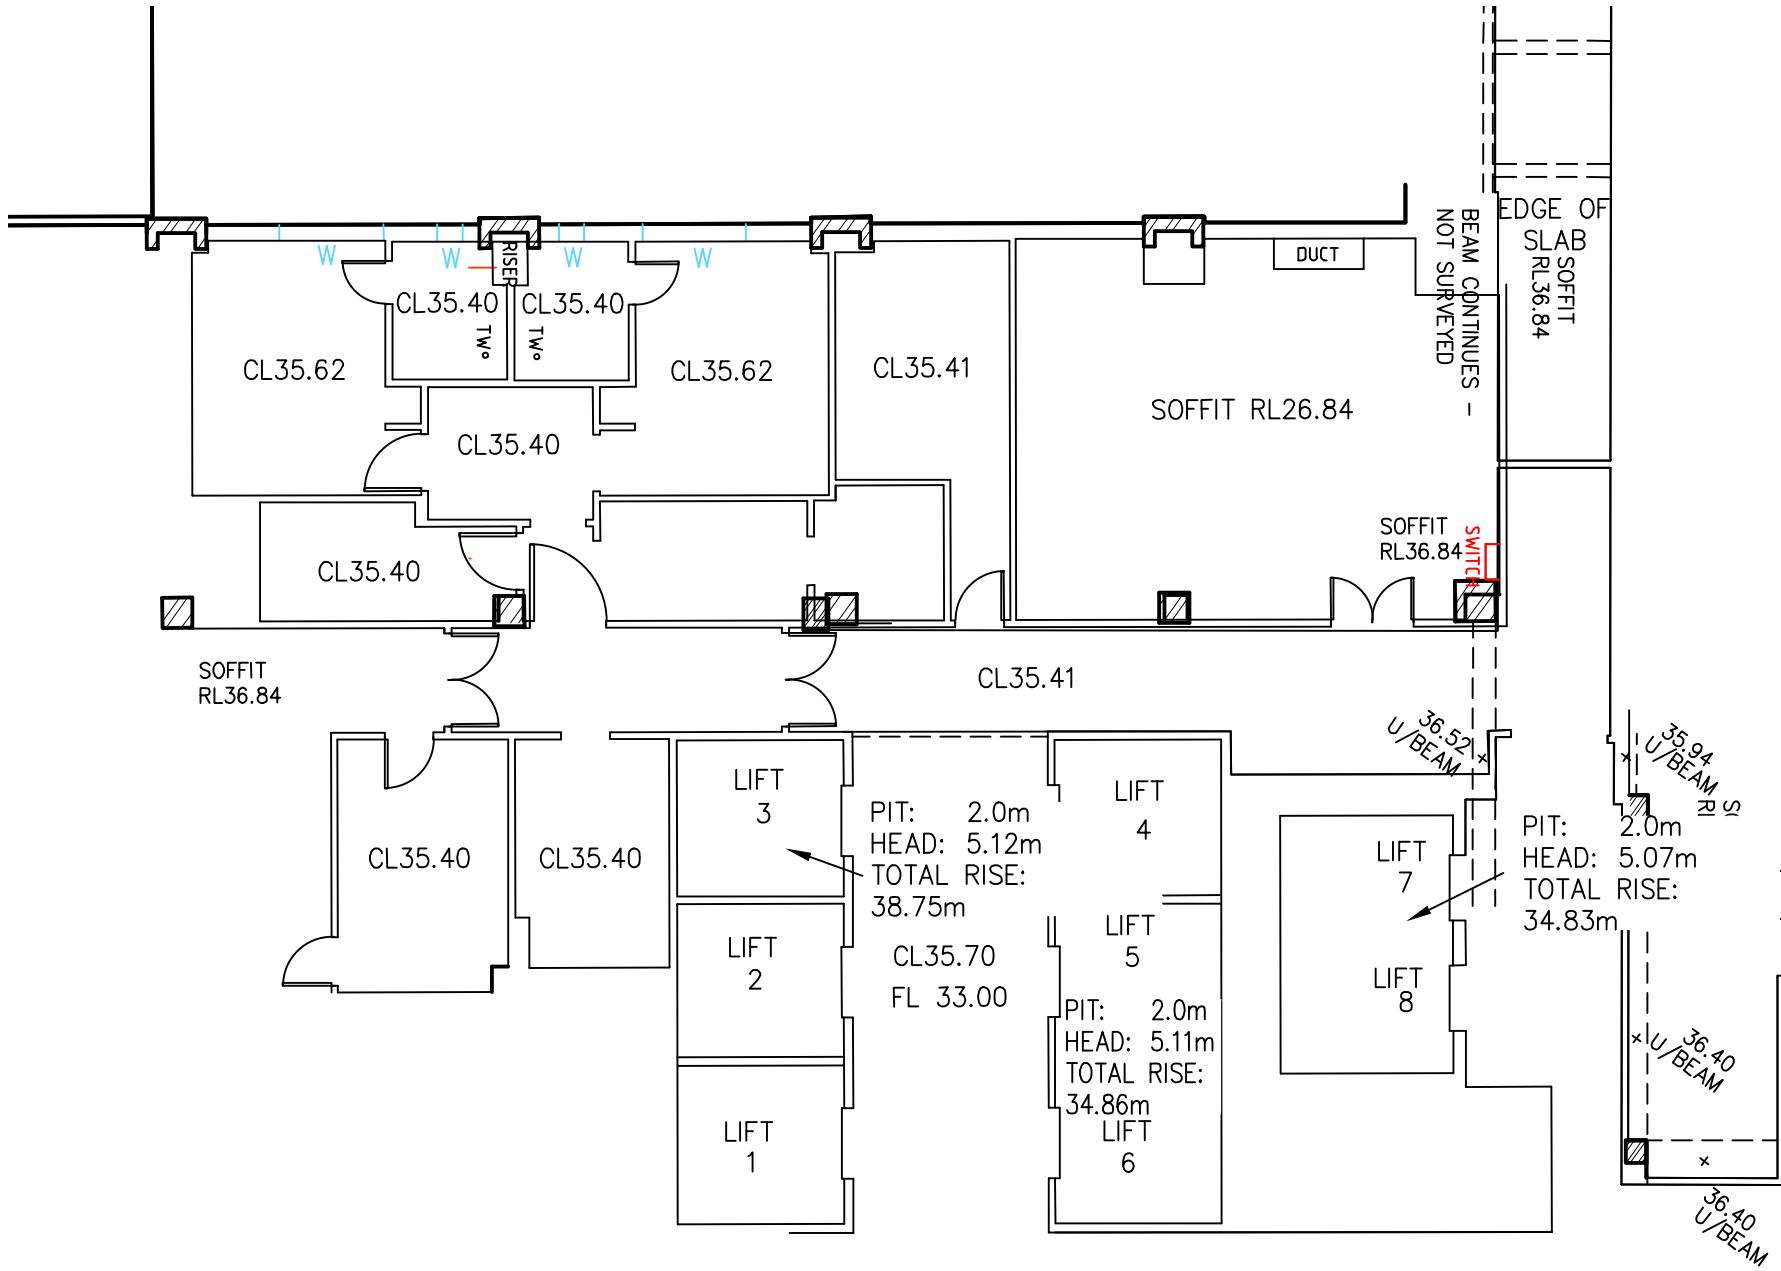

LEGEND

CL ~ UNDERSIDE OF CEILING LEVEL
USB ~ UNDERSIDE OF BEAM LEVEL
FL ~ FLOOR LEVEL
TW ~ TRADE WASTE
FHR ~ FIRE HOSE REEL
IA ~ INACCESSIBLE



D	00/00/00	-		00
C	00/00/00	-		00
B	00/00/00	-		00
A	00/00/00	-		00
Revision	Date	Description	Reference	

THIS IS THE PLAN REFERRED TO
IN MY LETTER DATED:
.....
Registered Surveyor NSW

LTS

LOCKLEY


Registered Surveyors NSW
www.ltsl.com.au

Suite 1, Level 1
810 Pacific Highway
Gordon NSW 2072
Locked Bag 5
Gordon NSW 2072
P 1300 587 000
F 02 9499 7760


Client HEALTH INFRASTRUCTURE
Drawing title
PLAN OF DETAIL AND LEVELS OVER LOT 1-6 DP1130879 &
LOT 12 DP800476 KNOWN AS "ST GEORGE HOSPITAL" AT
KOGARAH

datum
AHD
site Area
5.179ha
LGA
KOGARAH


project number	33459	reference number	33459DT
scale	1:150 @A1	date of survey	24/06/15
OF	SHEET 52	SHEETS	32

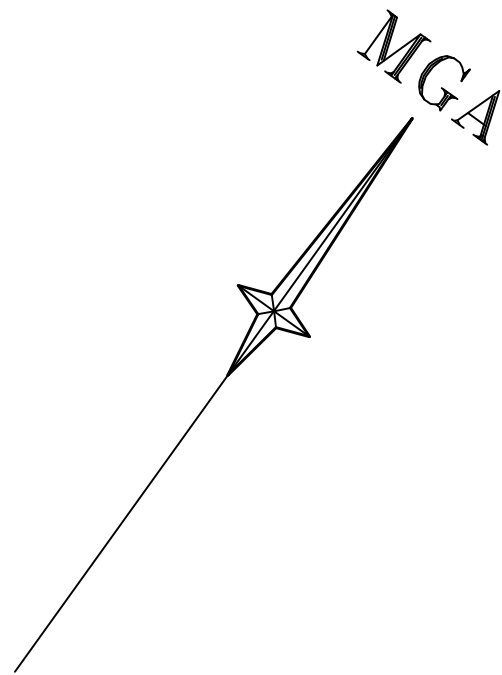


"I.C.U." ZONE 12 LEVEL 2
"TOWER WARD BLOCK"

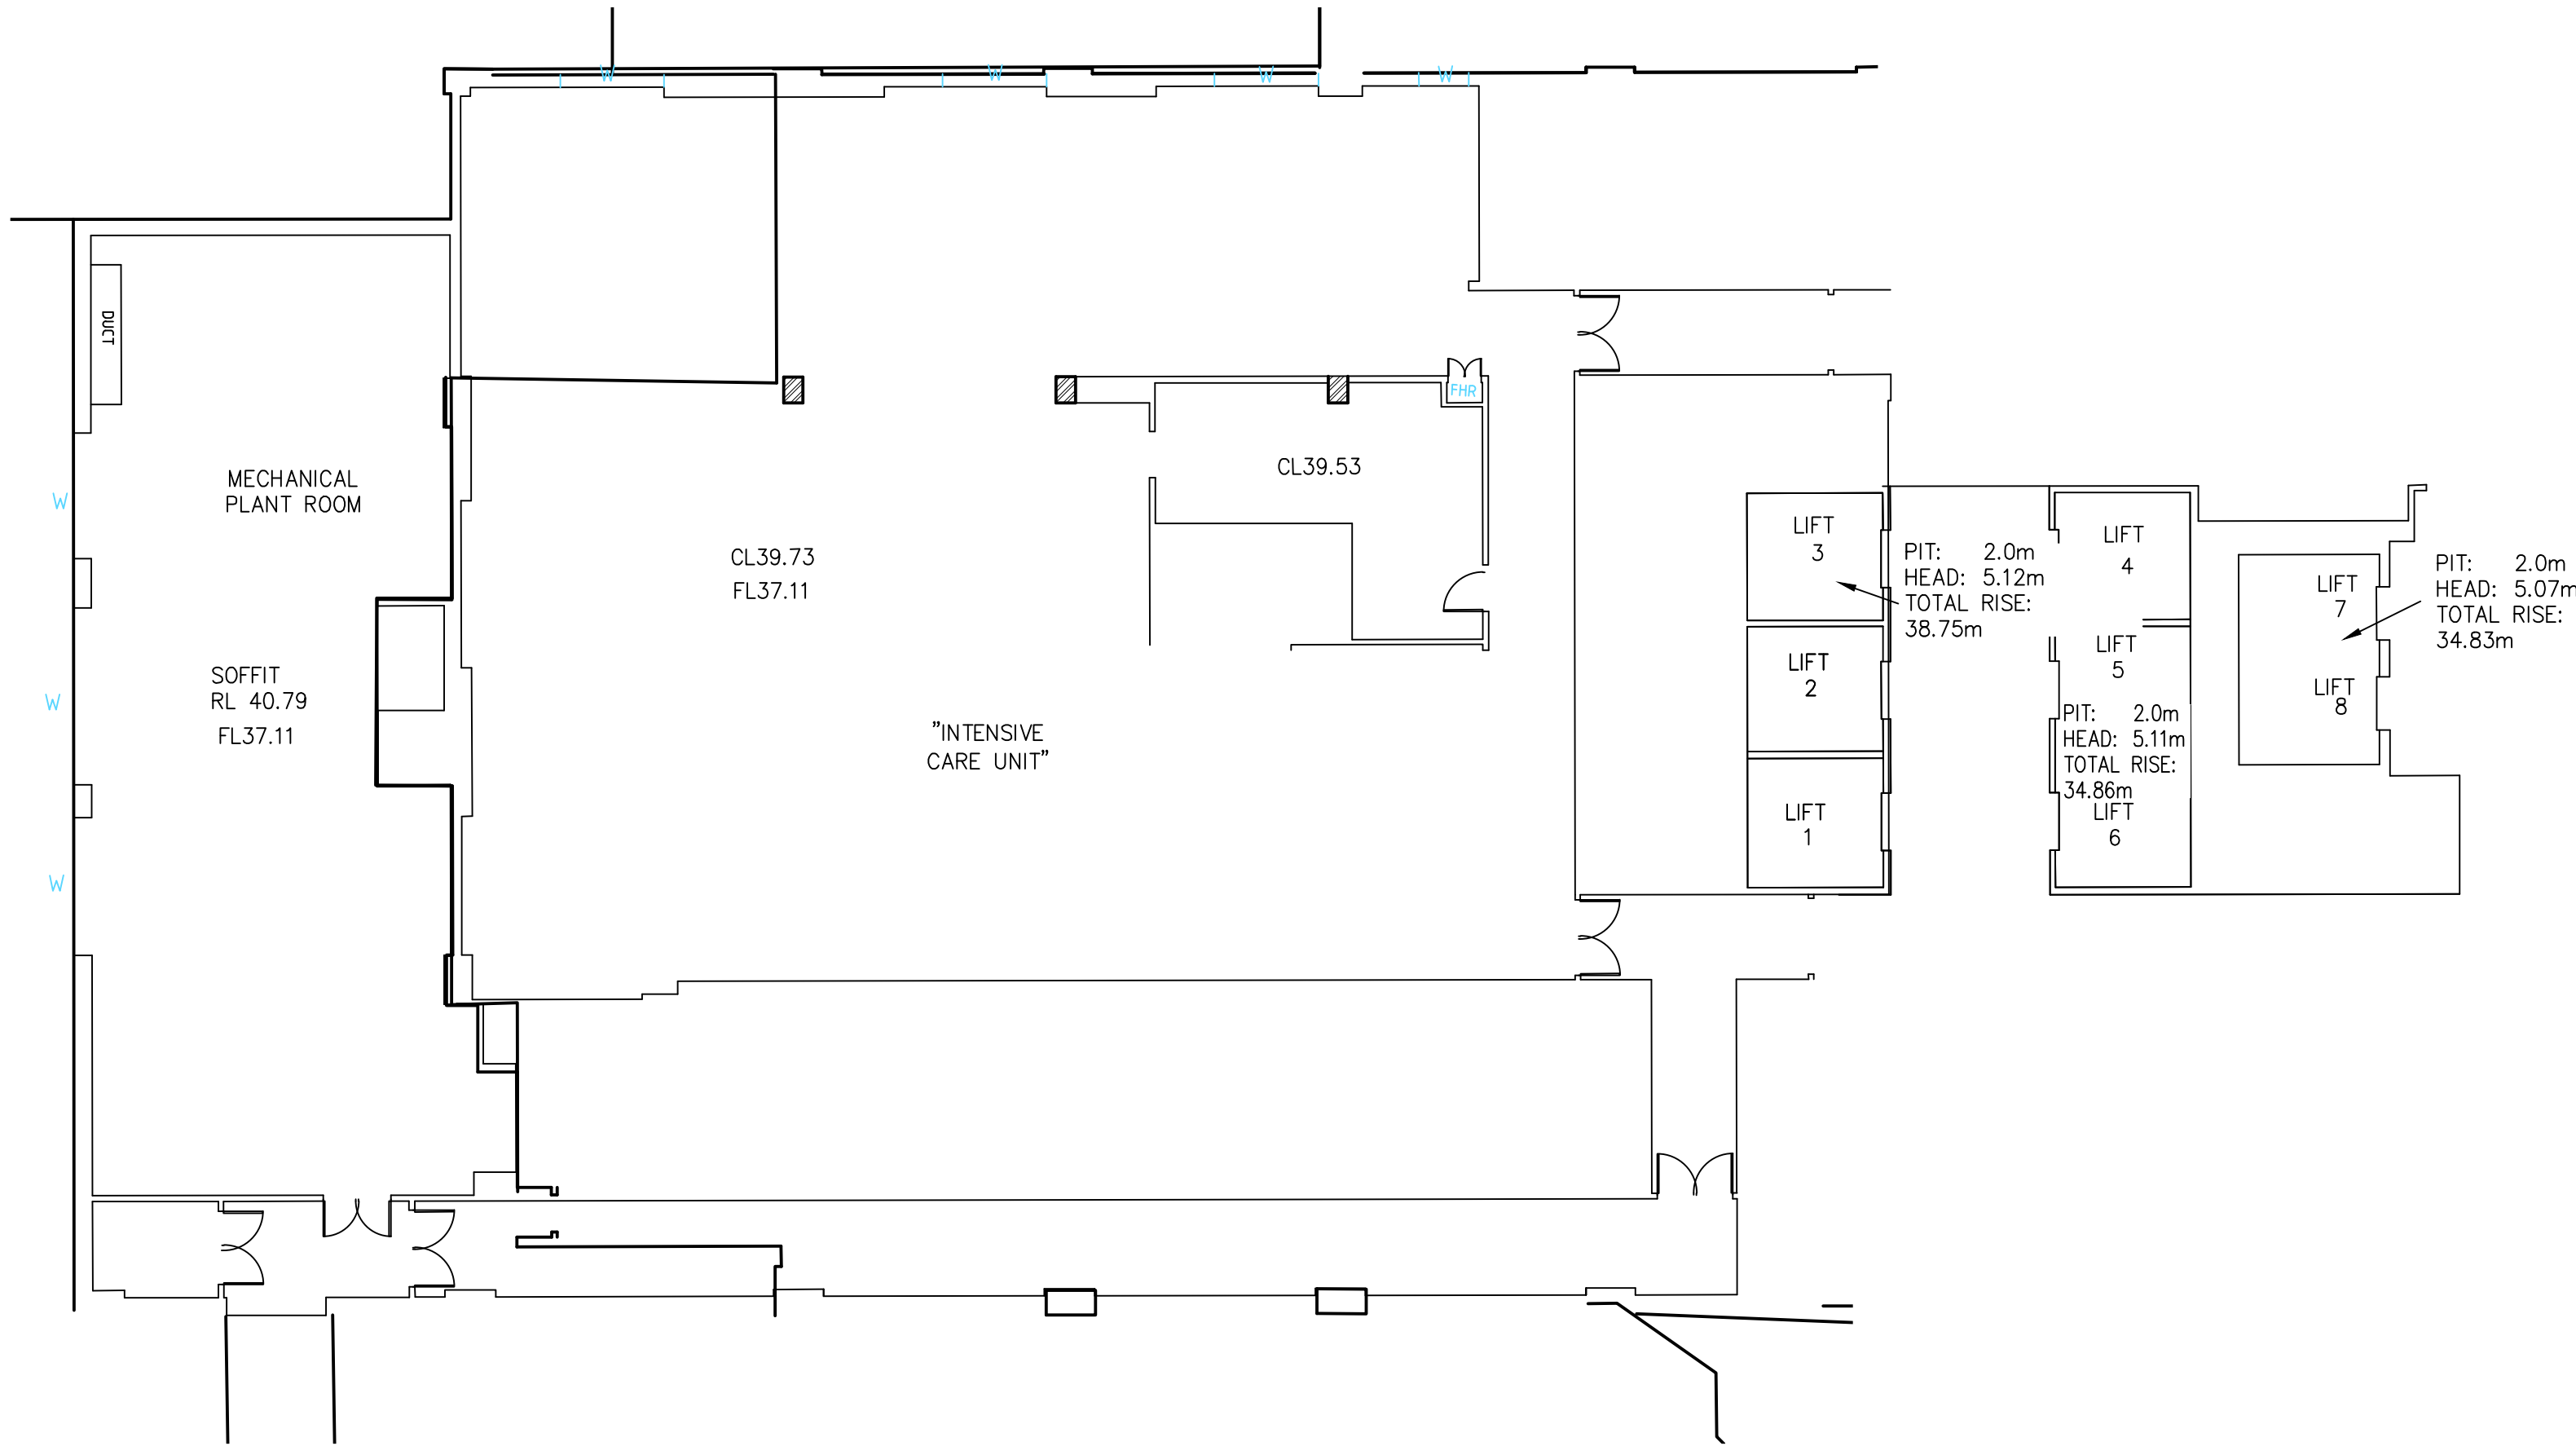

ZONE 16 LEVEL 3
"TOWER WARD BLOCK"

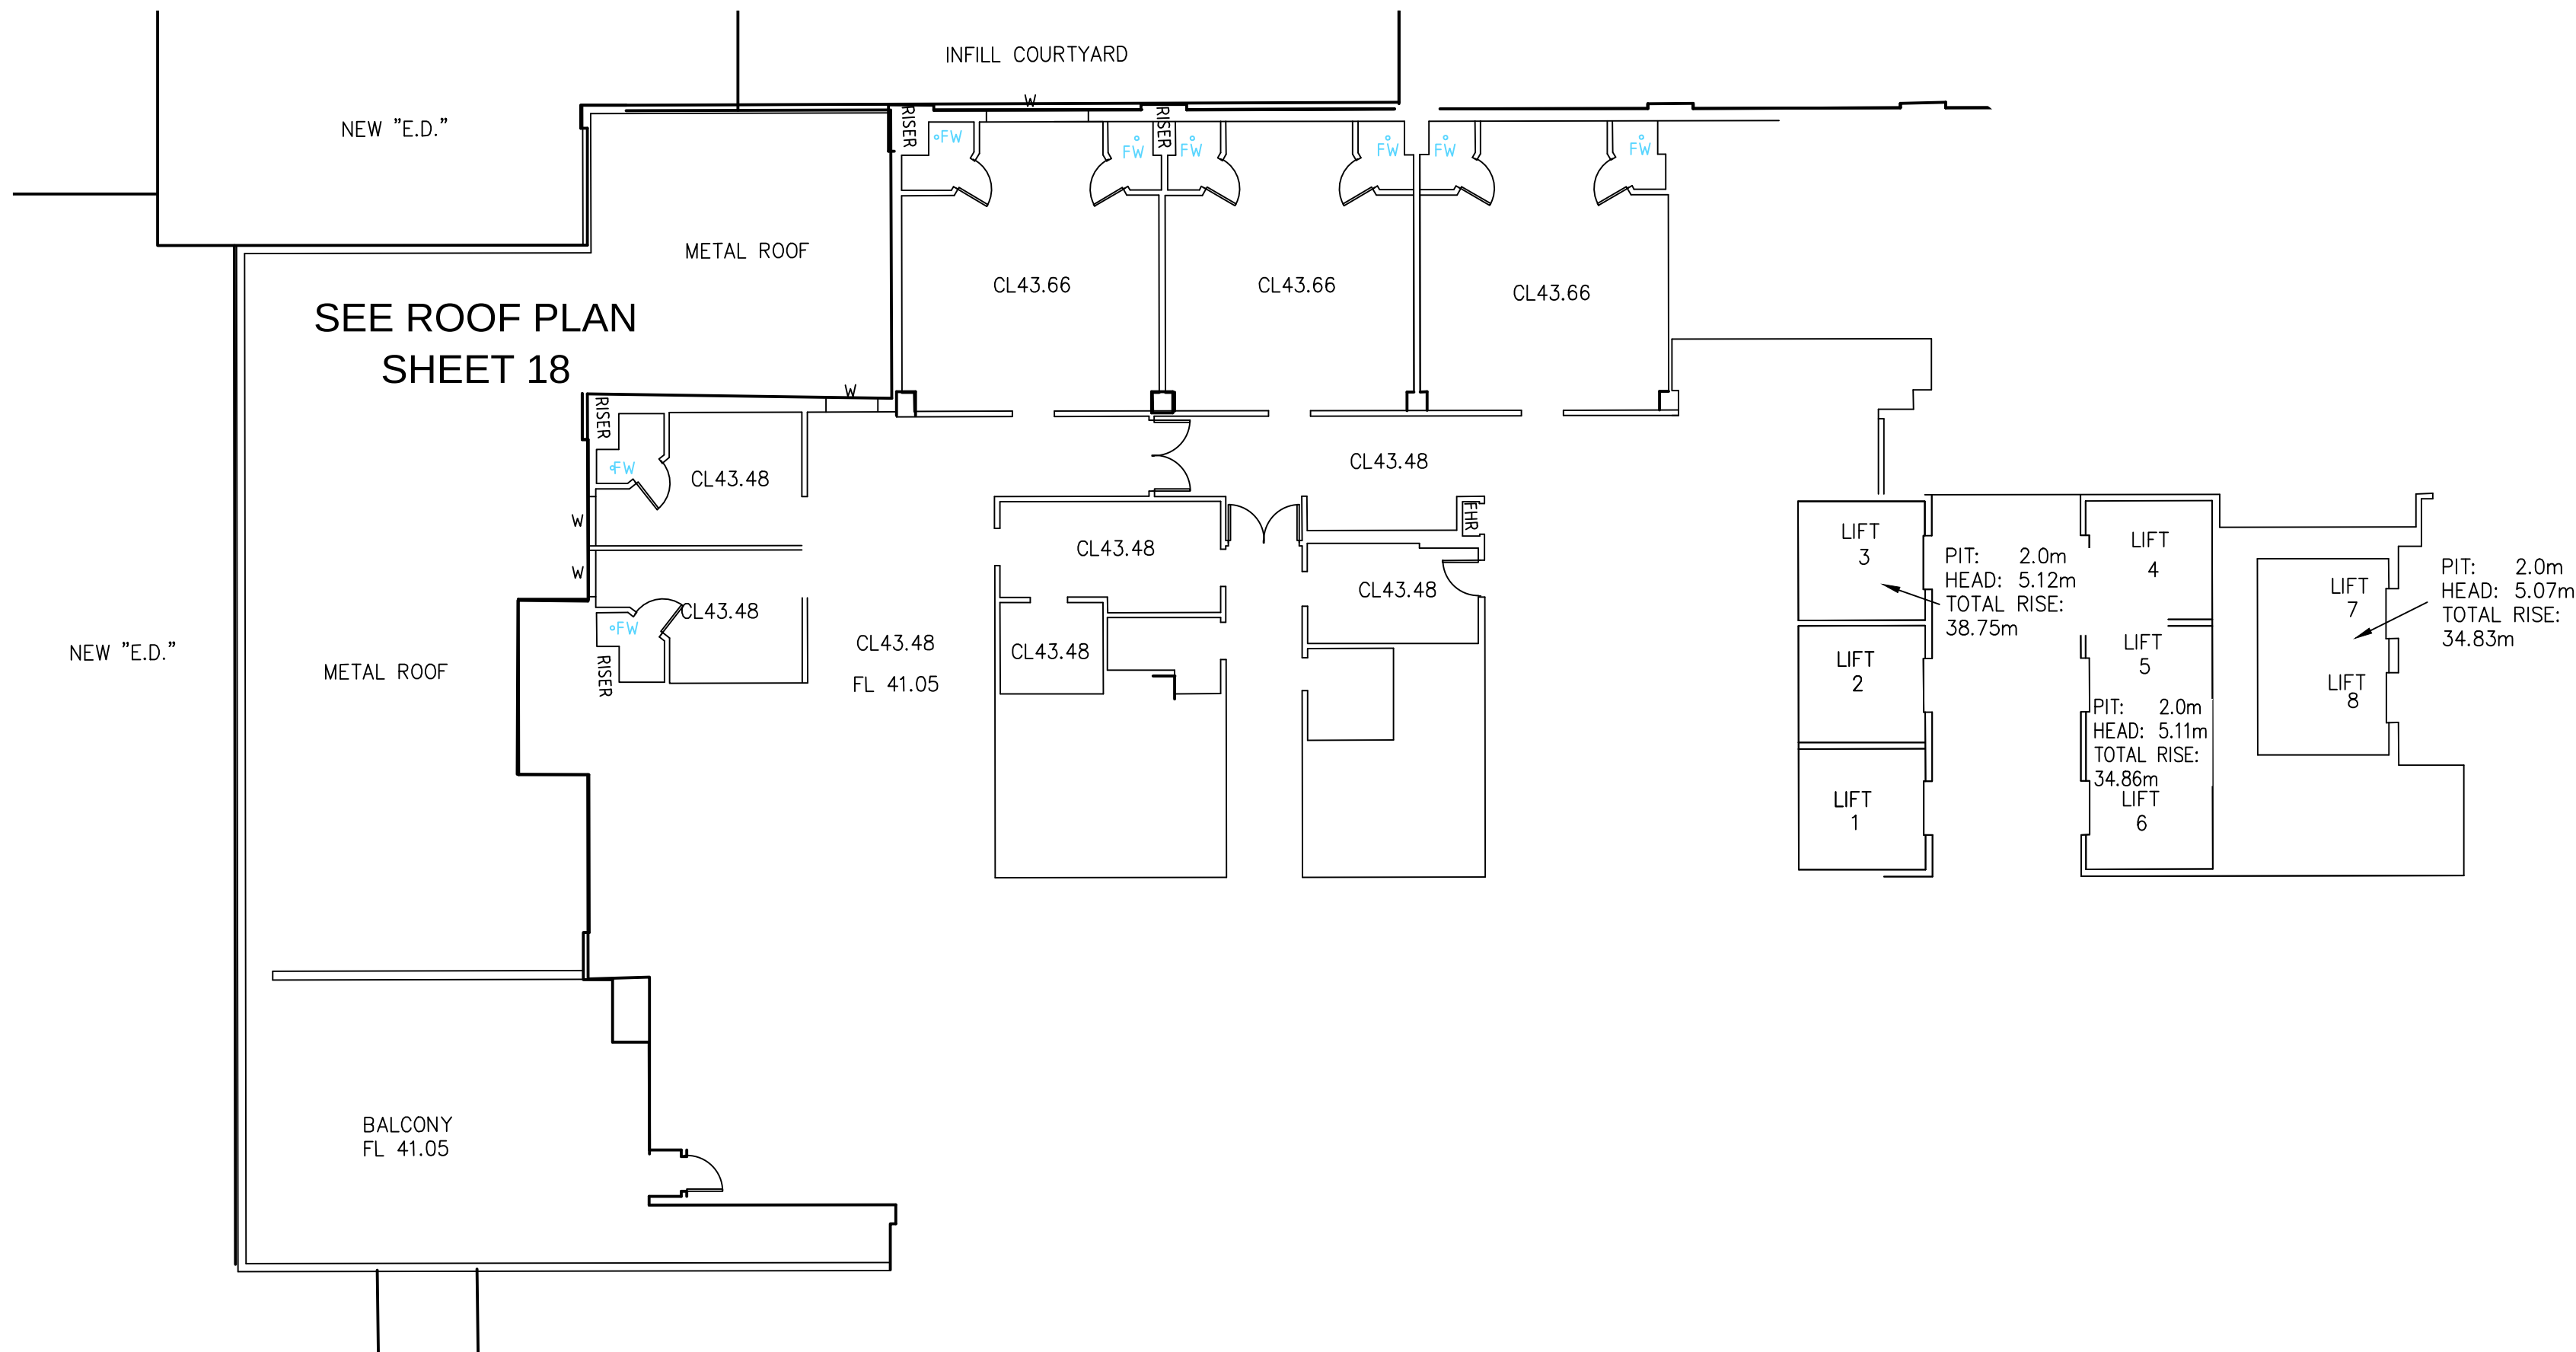

ZONE 18 LEVEL 4
"TOWER WARD BLOCK"

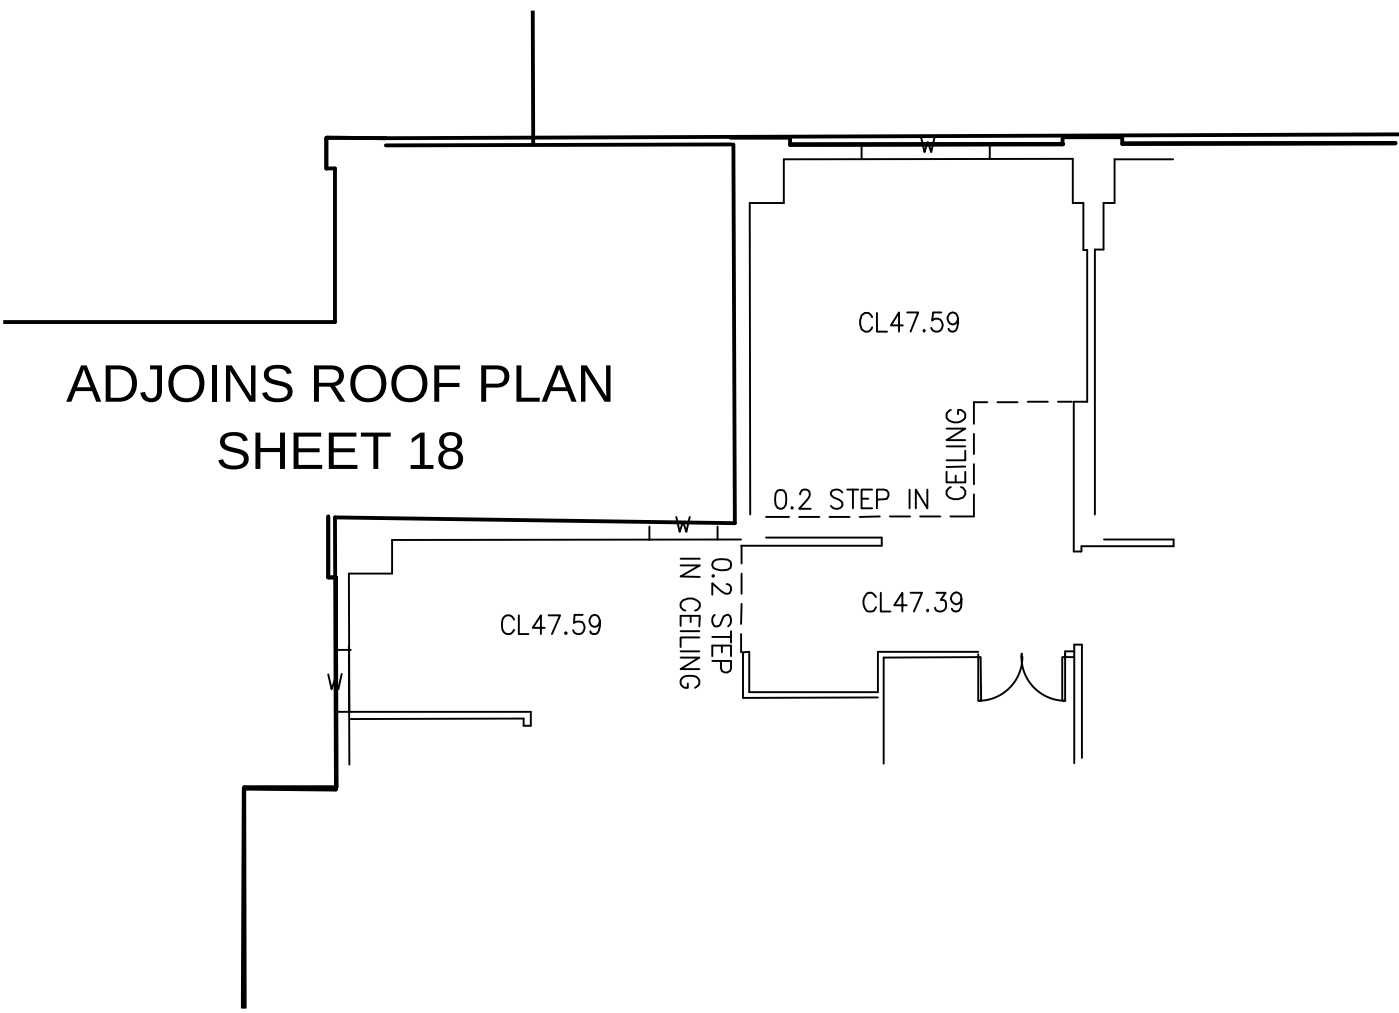

LEGEND

CL ~ UNDERSIDE OF CEILING LEVEL
USB ~ UNDERSIDE OF BEAM LEVEL
FL ~ FLOOR LEVEL
FW ~ FLOOR WASTE
FHR ~ FIRE HOSE REEL
IA ~ INACCESSIBLE



D	00/00/00	-	00
C	00/00/00	-	00
B	00/00/00	-	00
A	00/00/00	-	00
Revision	Date	Description	Reference

THIS IS THE PLAN REFERRED TO
IN MY LETTER DATED:
.....
Registered Surveyor NSW




Suite 1, Level 1
810 Pacific Highway
Gordon NSW 2072
Locked Bag 5
Gordon NSW 2072
P 1300 587 000
F 02 9499 7760

Client HEALTH INFRASTRUCTURE
Drawing title
PLAN OF DETAIL AND LEVELS OVER LOT 1-6 DP1130879 &
LOT 12 DP800476 KNOWN AS "ST GEORGE HOSPITAL" AT
KOGARAH


datum
AHD
site Area
5.179ha
LGA
KOGARAH

project number	33459	reference number	33459DT
scale	1:150 @A1	date of survey	24/06/15
OF	SHEET 52	SHEETS	33


"CSB" ZONE 8 GROUND FLOOR

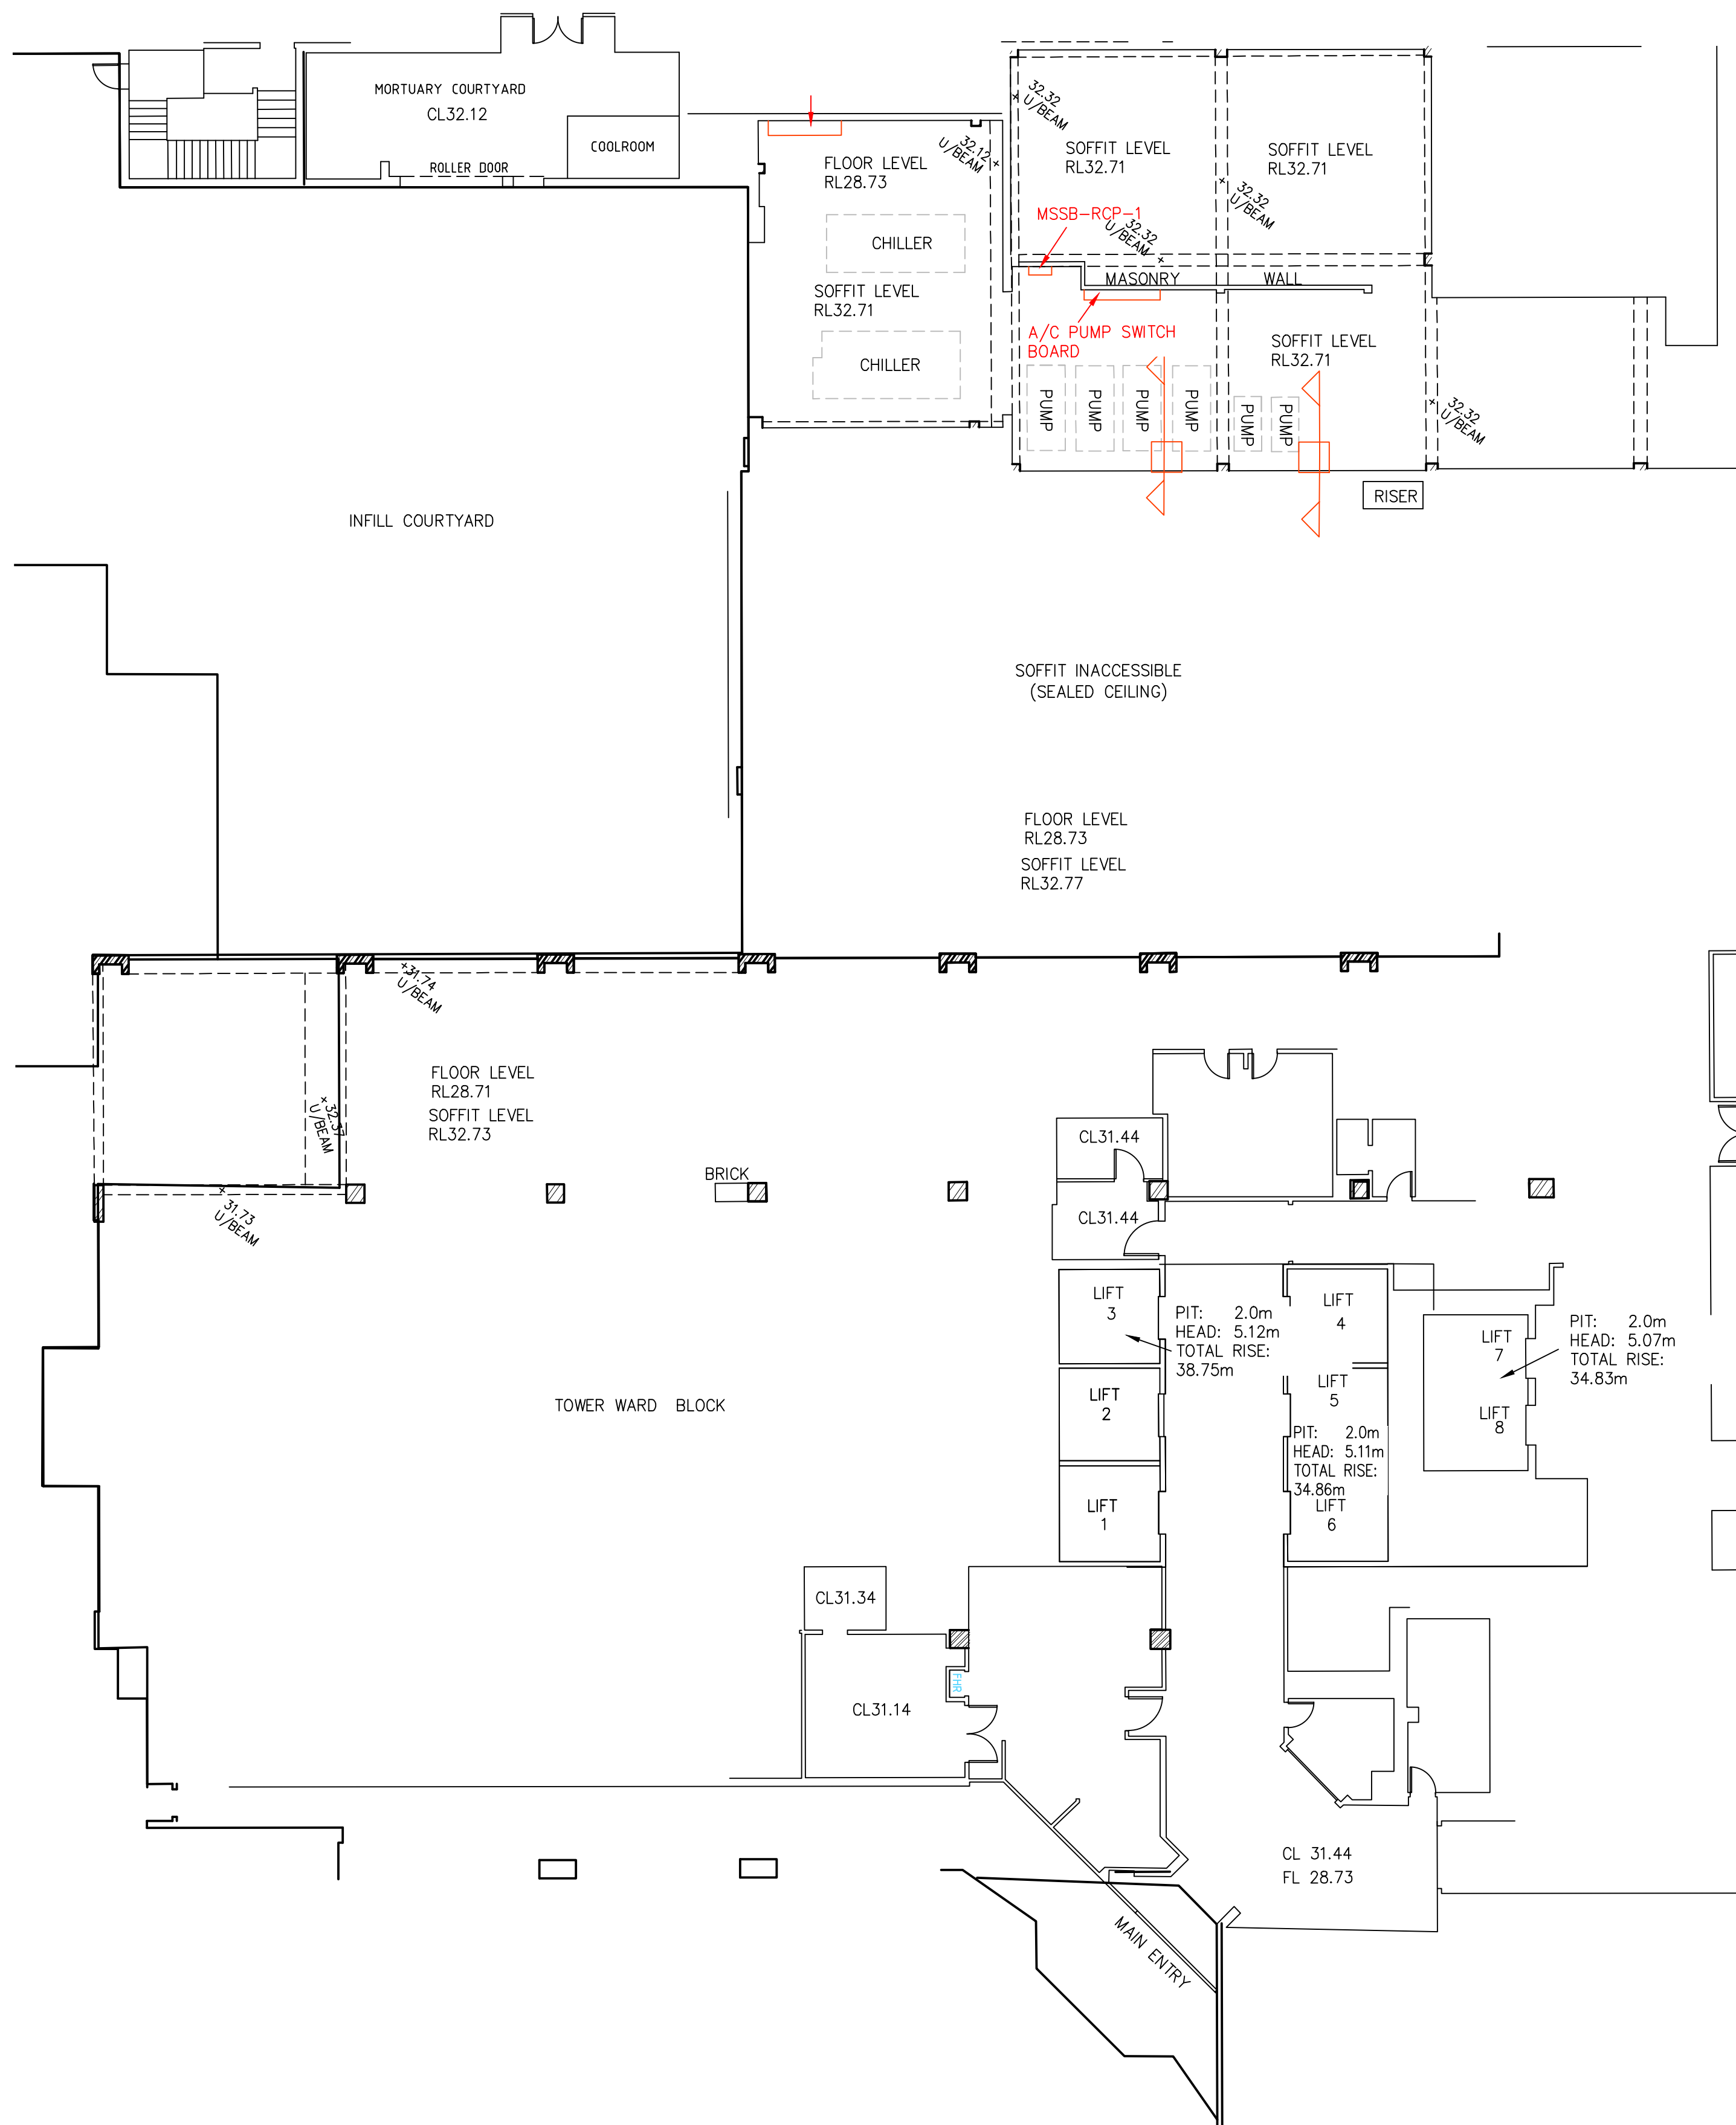

"SSSD" ZONE 4 GROUND FLOOR
"STERALIZING DEPT"

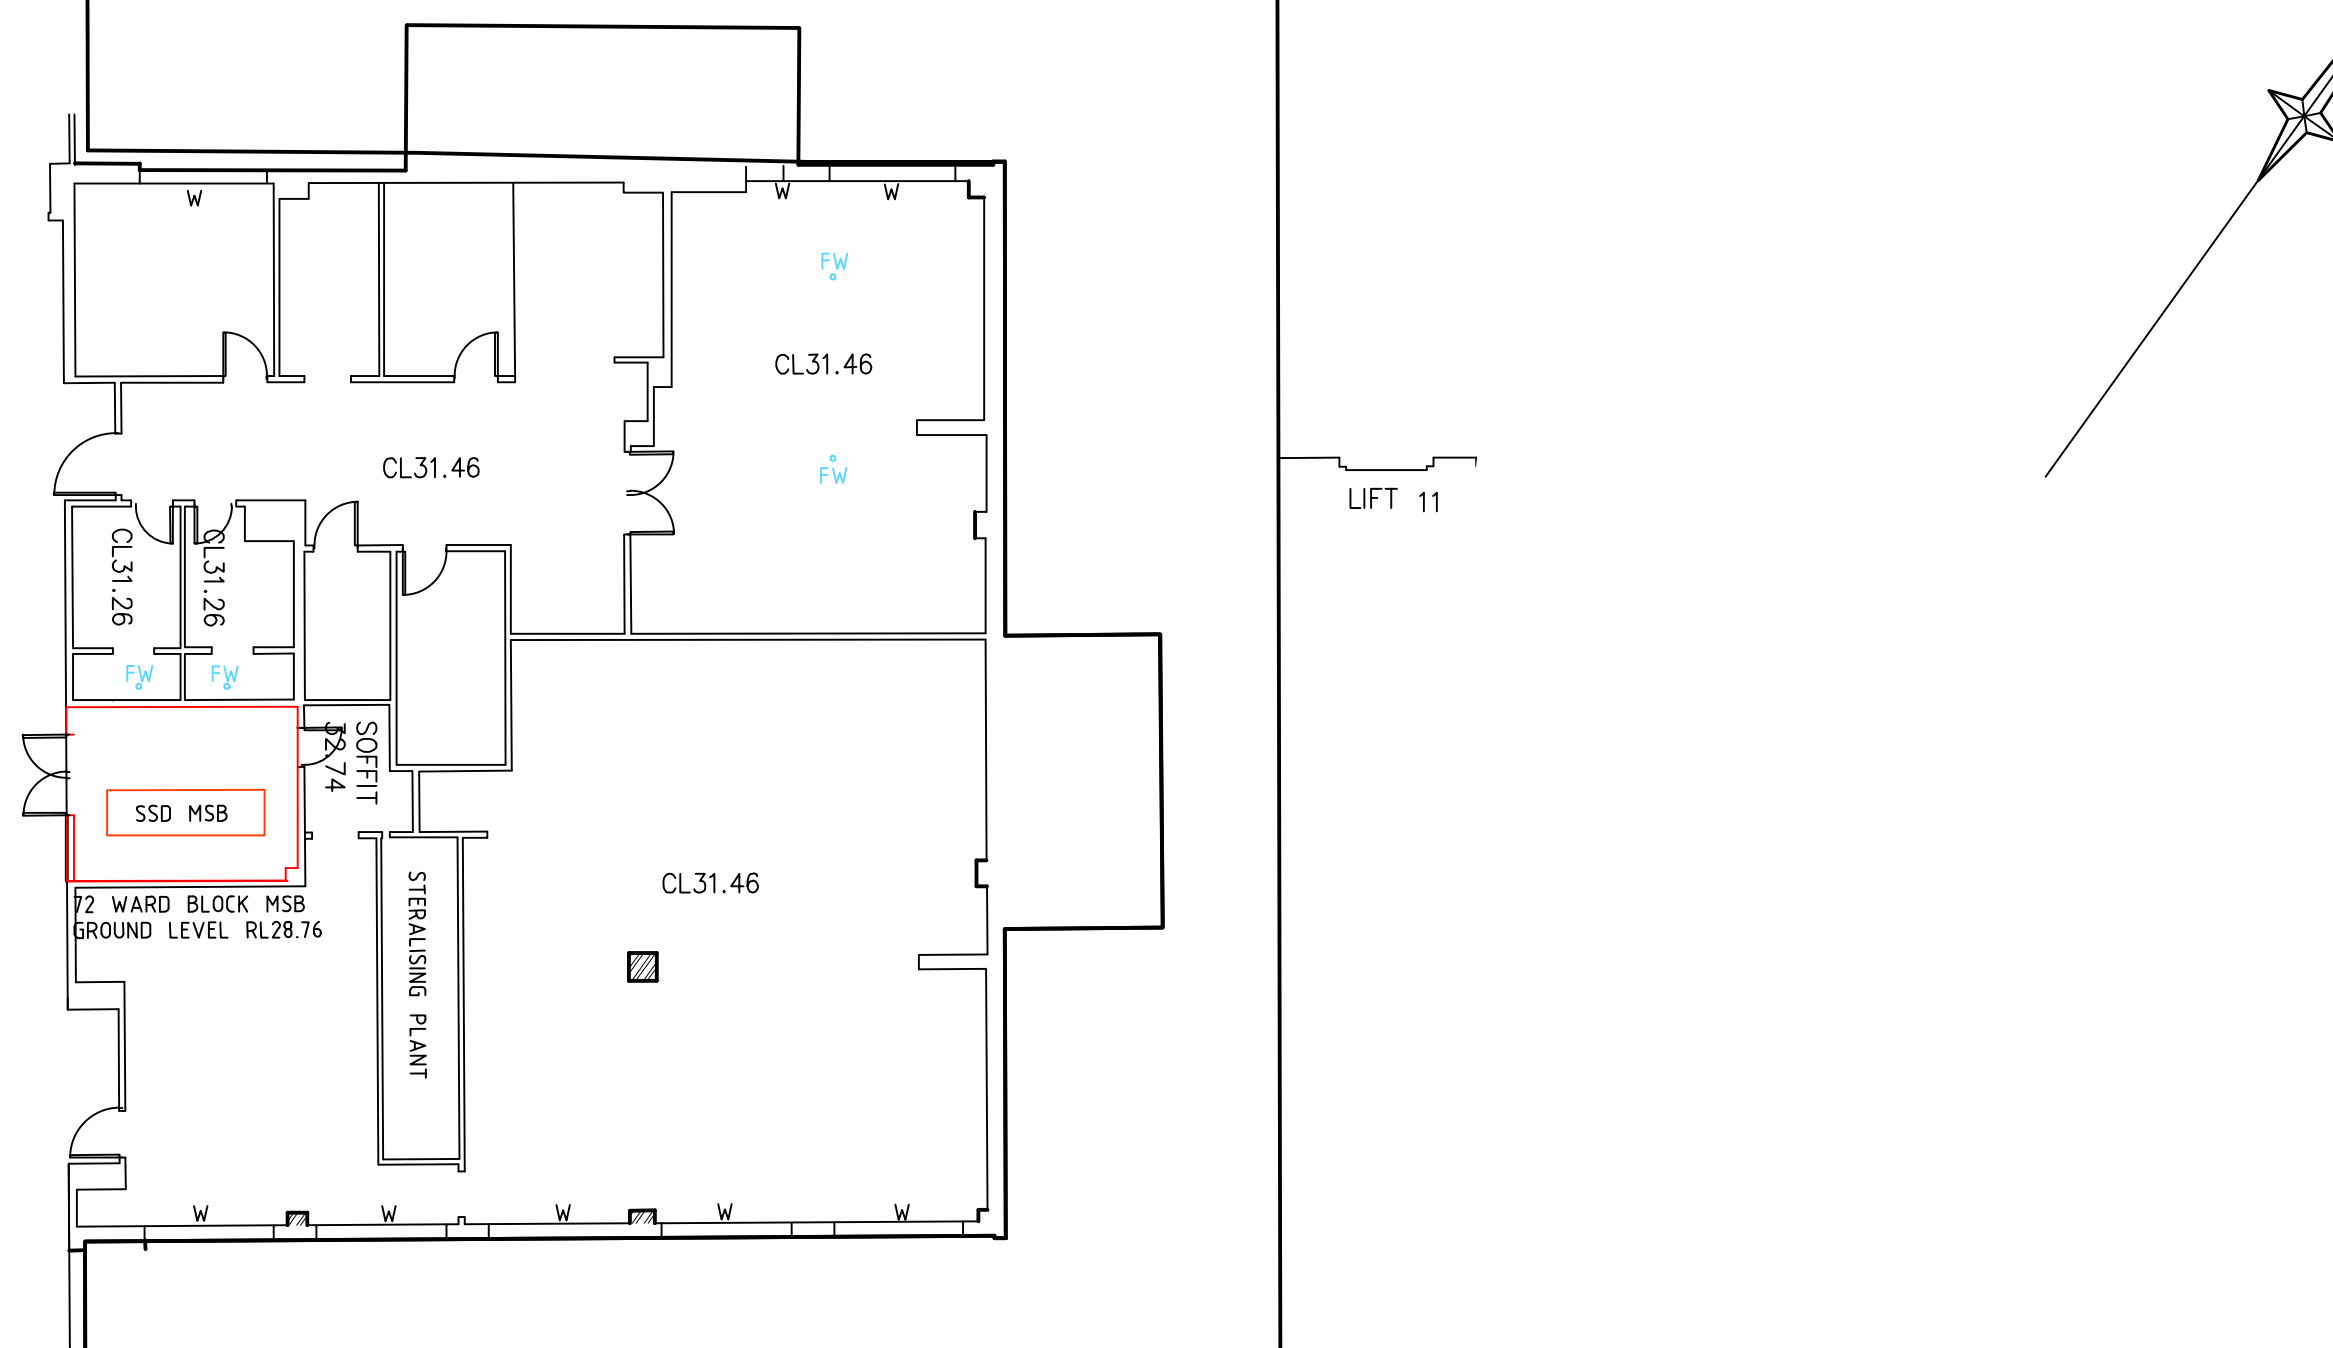

"KITCHEN" ZONE 3 GROUND FLOOR

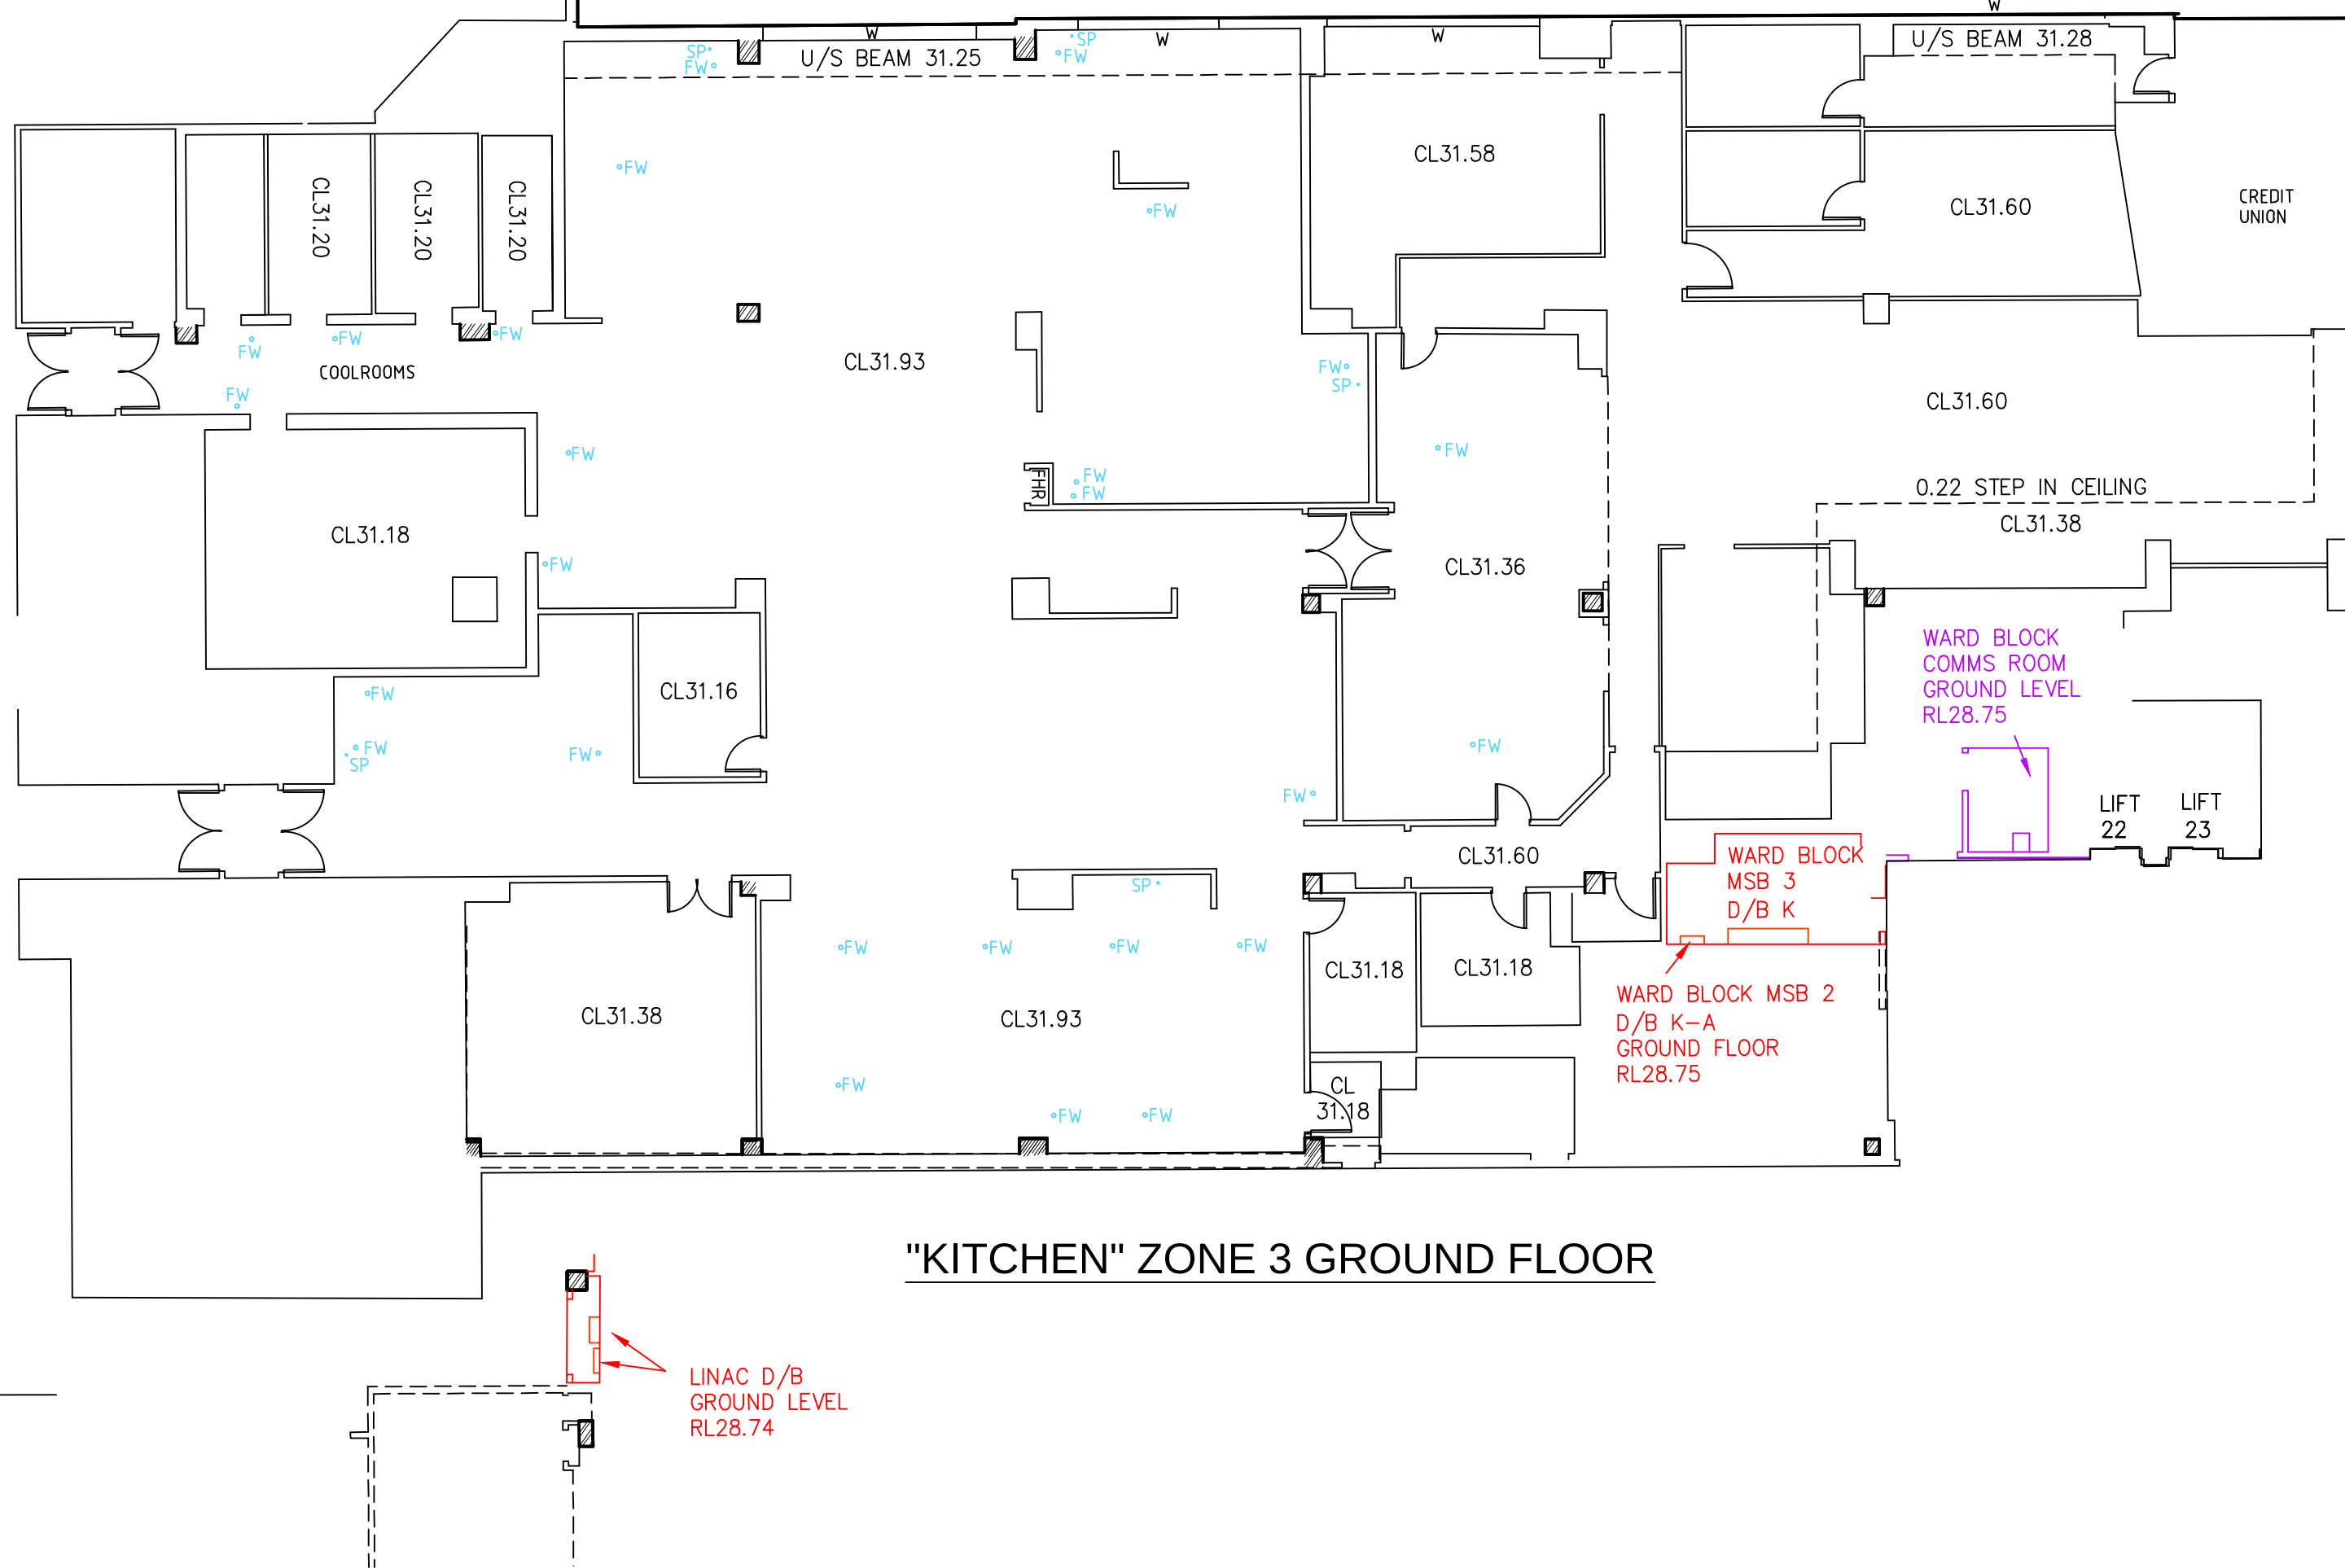

LEGEND

CL ~ UNDERSIDE OF CEILING LEVEL
USB ~ UNDERSIDE OF BEAM LEVEL
FL ~ FLOOR LEVEL
FW ~ FLOOR WASTE
SP ~ SLAB PENETRATION
FHR ~ FIRE HOSE REEL
IA ~ INACCESSIBLE



D	00/00/00	-	00
C	00/00/00	-	00
B	00/00/00	-	00
A	00/00/00	-	00
Revision	Date	Description	Reference

THIS IS THE PLAN REFERRED TO
IN MY LETTER DATED:
.....
Registered Surveyor NSW




Suite 1, Level 1
810 Pacific Highway
Gordon NSW 2072
Locked Bag 5
Gordon NSW 2072
P 1300 587 000
F 02 9499 7760

Client HEALTH INFRASTRUCTURE
Drawing title
PLAN OF DETAIL AND LEVELS OVER LOT 1-6 DP1130879 &
LOT 12 DP800476 KNOWN AS "ST GEORGE HOSPITAL" AT
KOGARAH

datum
AHD
site Area
5.179ha
LGA
KOGARAH

project number
33459
scale
1:150 @A1
OF SHEET
52 SHEETS

reference number
33459DT
date of survey
24/06/15
34

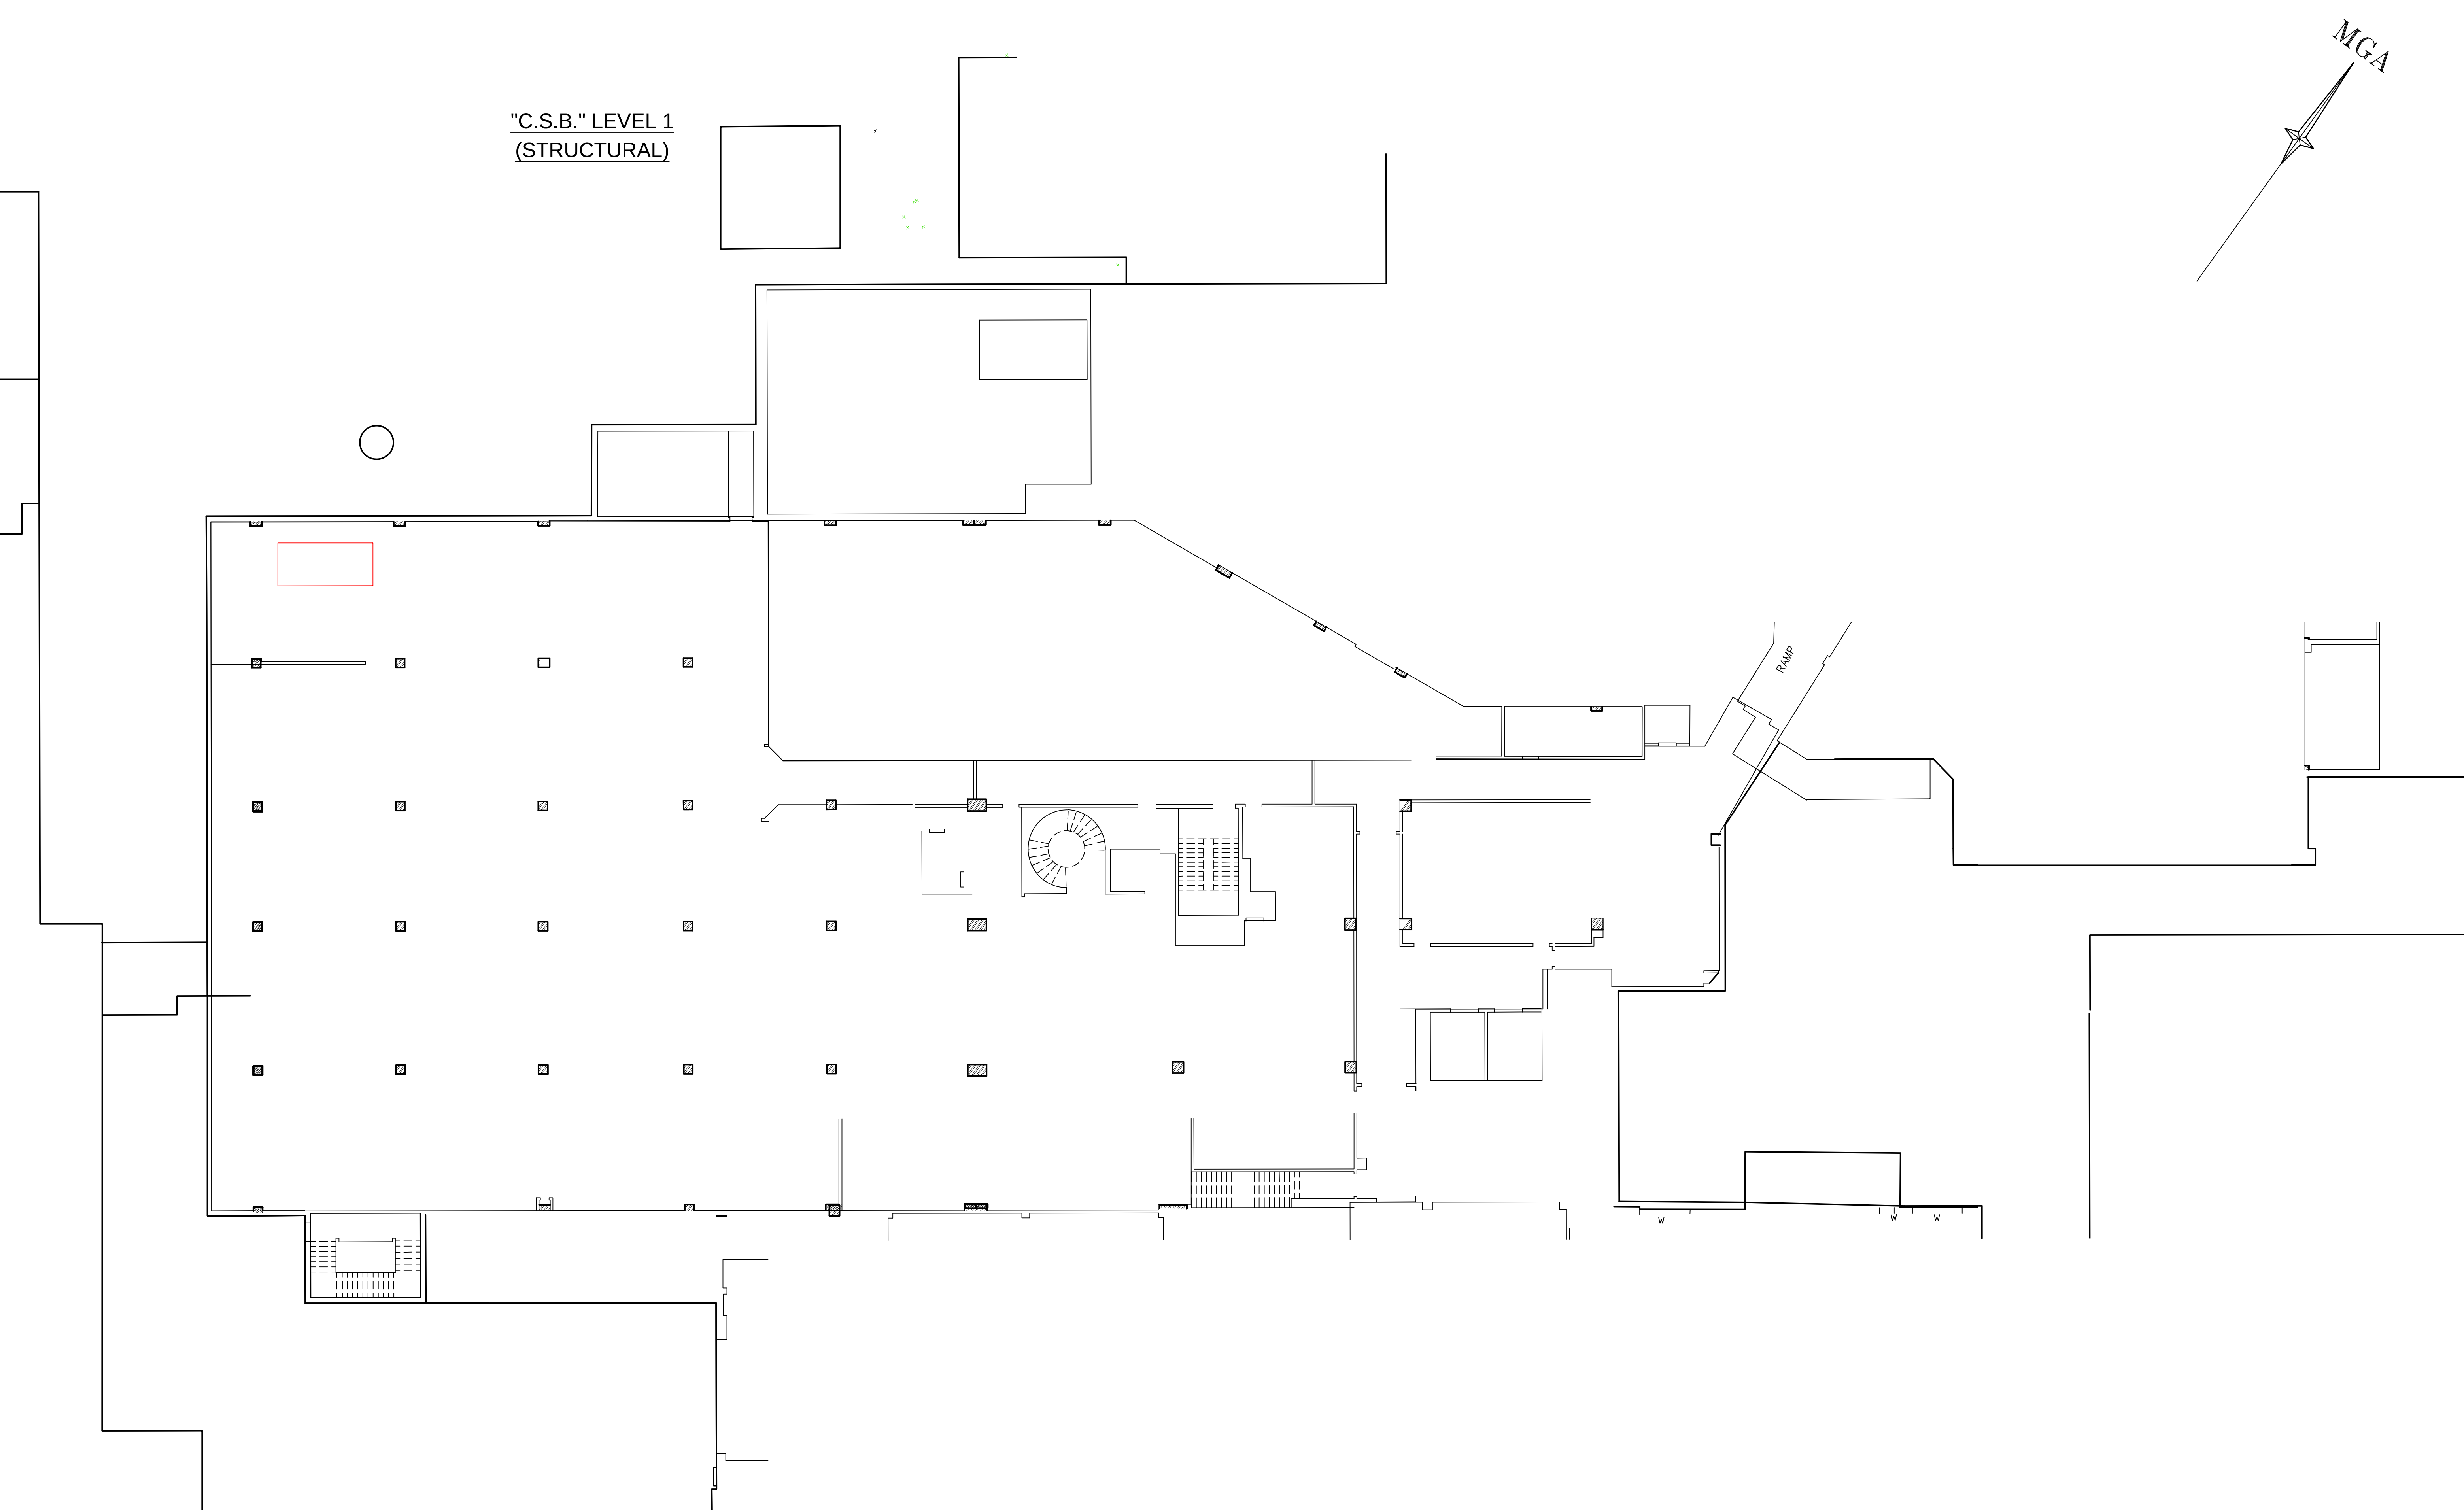

"C.S.B." LEVEL 1
(STRUCTURAL)

LEGEND

CL ~ UNDERSIDE OF CEILING LEVEL
USB ~ UNDERSIDE OF BEAM LEVEL
FL ~ FLOOR LEVEL
FW ~ FLOOR WASTE
SP ~ SLAB PENETRATION
FHR ~ FIRE HOSE REEL
IA ~ INACCESSIBLE

0 3 5 6 9 12 15
SCALE 1:150 @ A1

D	00/00/00	-		00
C	00/00/00	-		00
B	00/00/00	-		00
A	00/00/00	-		00
Revision	Date	Description		Reference

THIS IS THE PLAN REFERRED TO
IN MY LETTER DATED:

.....
Registered Surveyor NSW


LTS
LOCKLEY
Registered Surveyors NSW
www.ltsl.com.au

Suite 1, Level 1
810 Pacific Highway
Gordon NSW 2072
Locked Bag 5
Gordon NSW 2072
P 1300 587 000
F 02 9499 7760

Client **HEALTH INFRASTRUCTURE**


Drawing title
**PLAN OF DETAIL AND LEVELS OVER LOT 1-6 DP1130879 &
LOT 12 DP800476 KNOWN AS "ST GEORGE HOSPITAL" AT
KOGARAH**

datum AHD	project number 33459	reference number 33459DT
site Area 5.179ha	scale 1:150 @A1	date of survey 24/06/15
LGA KOGARAH	OF 52 SHEETS	35

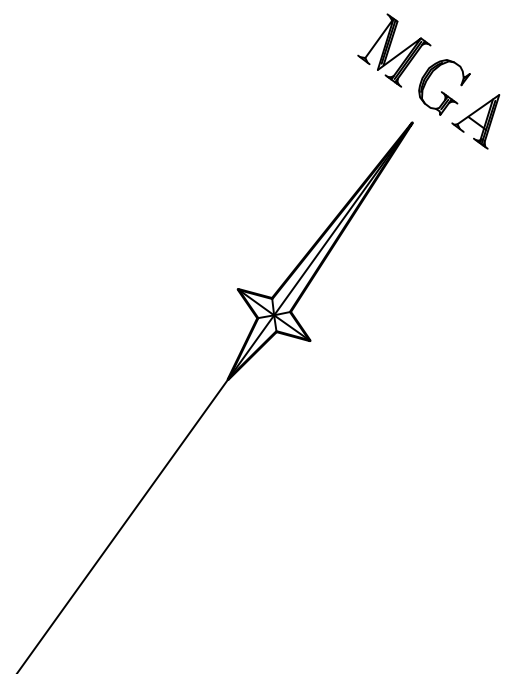


DAY SURGERY M.S.B
LEVEL 1/LEVEL 2
RL 38.27

ADJOINS SHEET 37

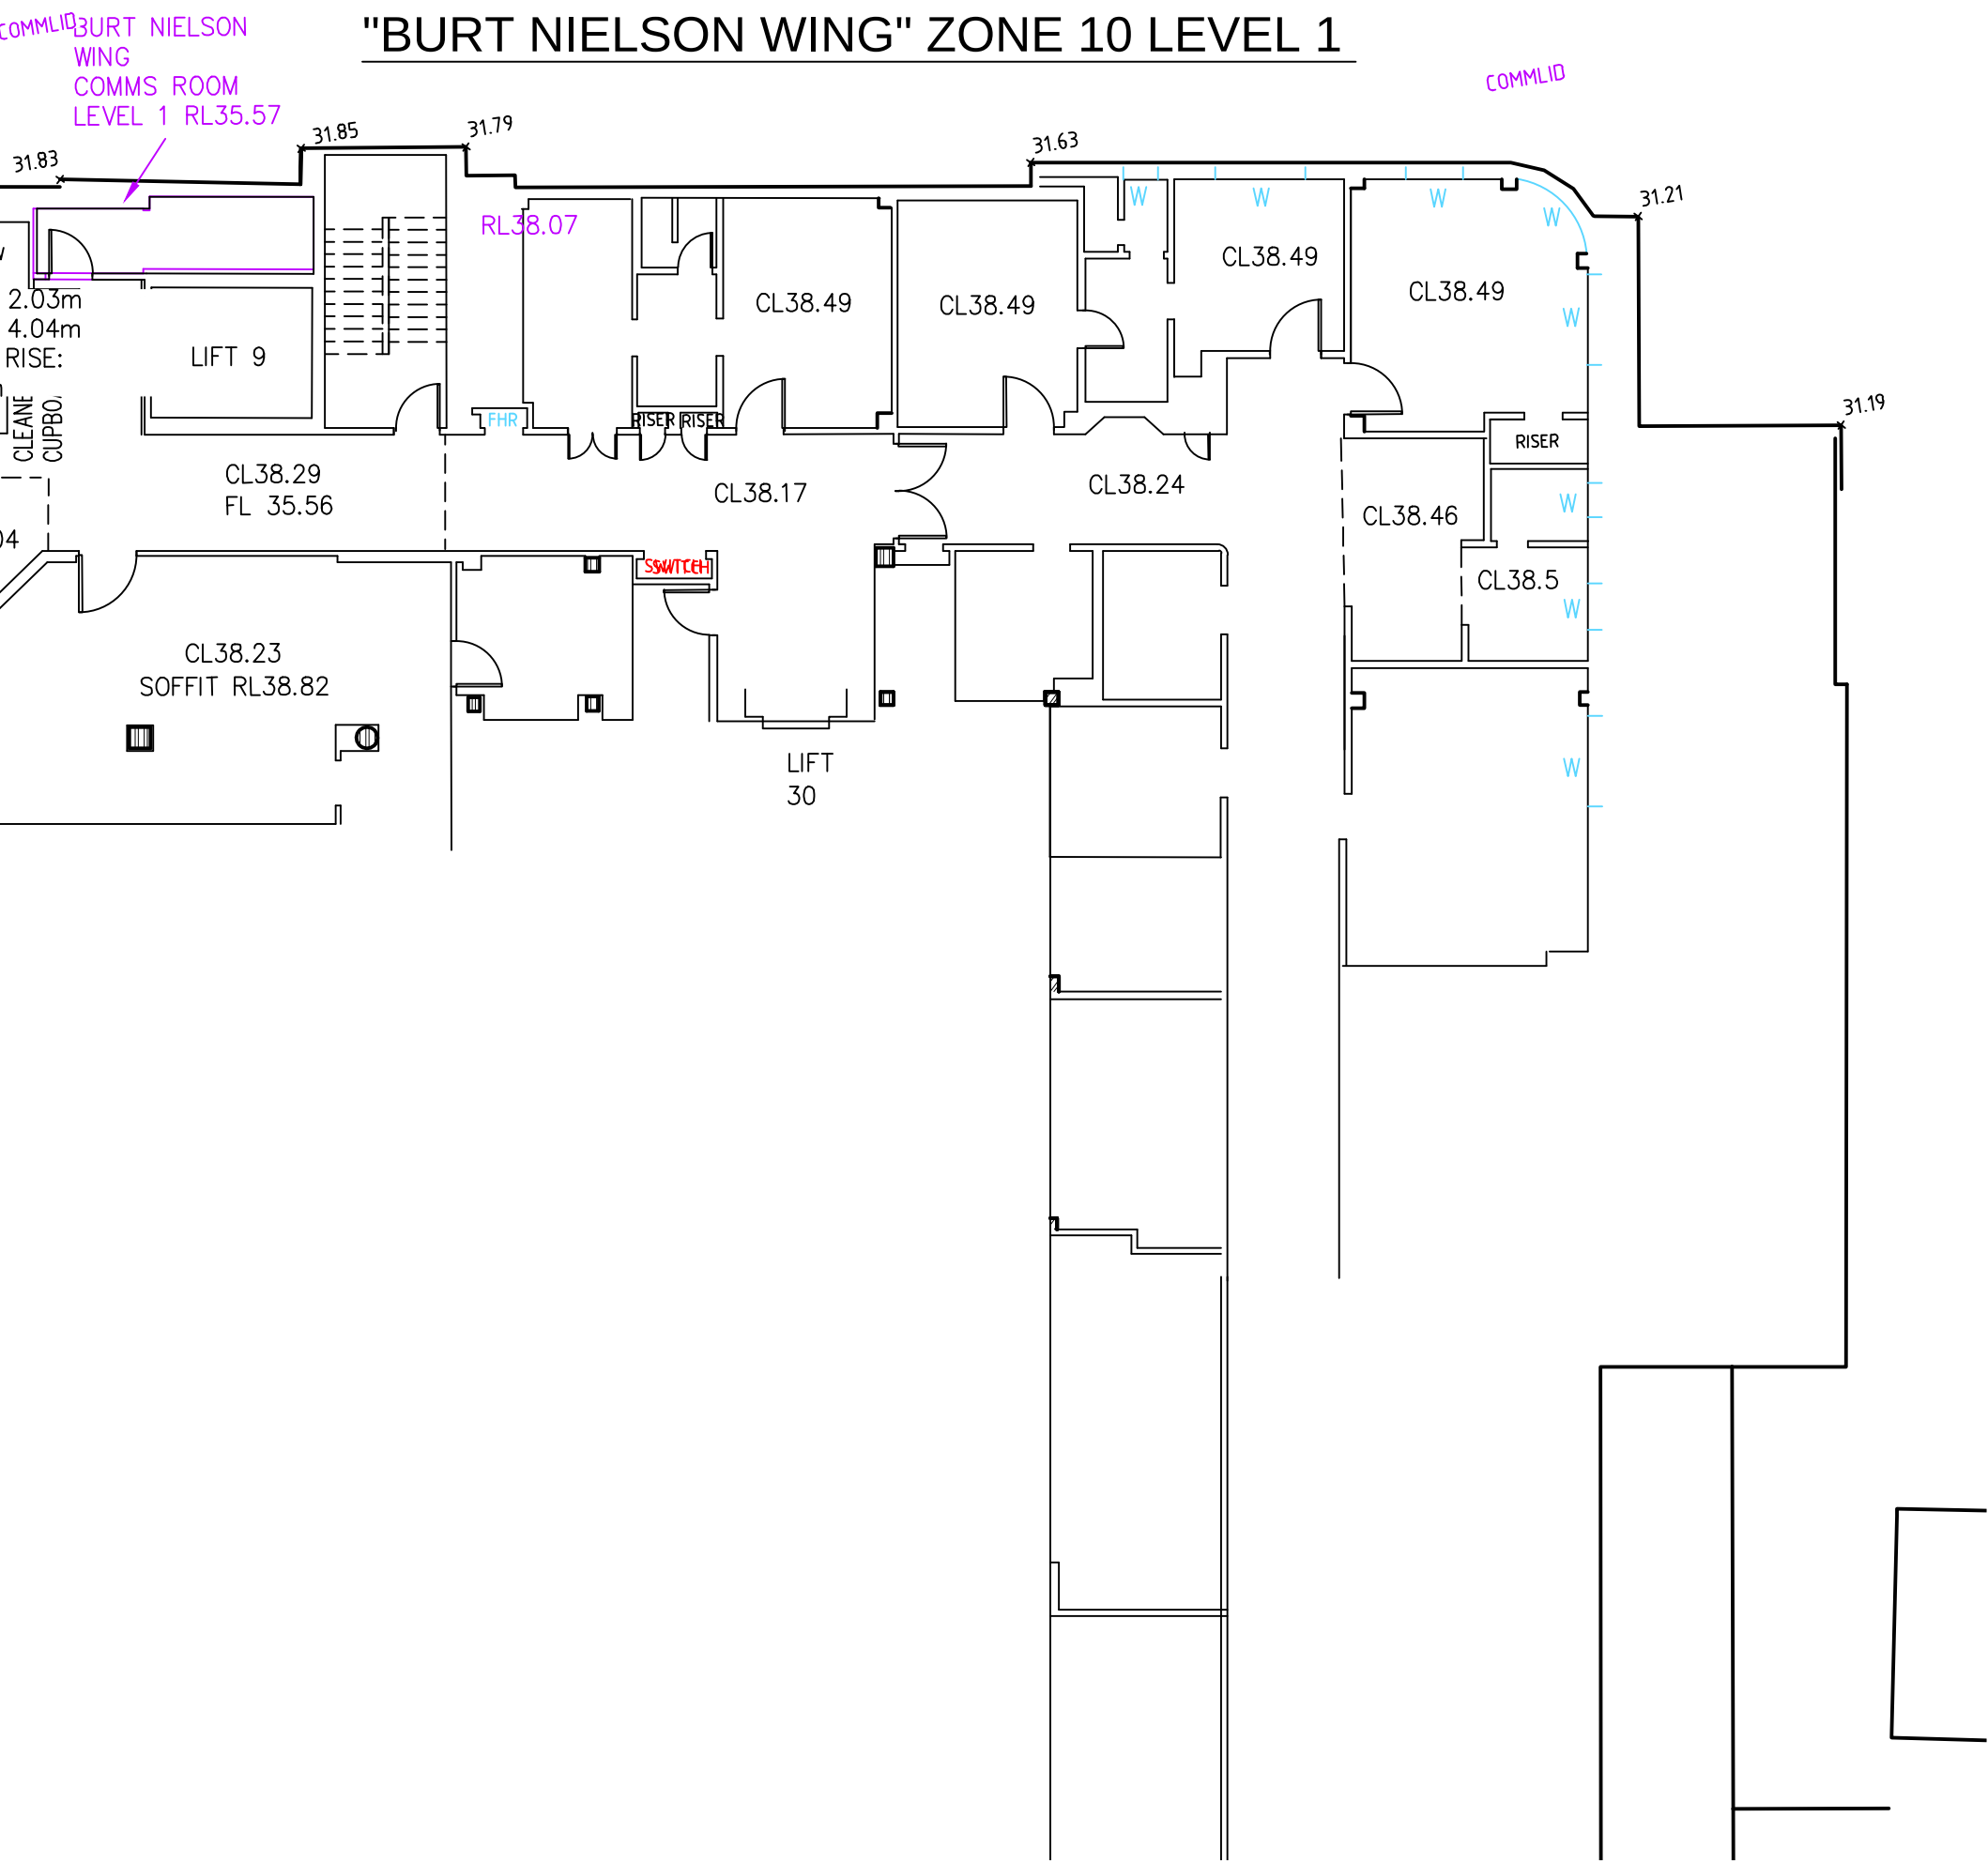

"BURT NIELSON WING" ZONE 14 LEVEL 2

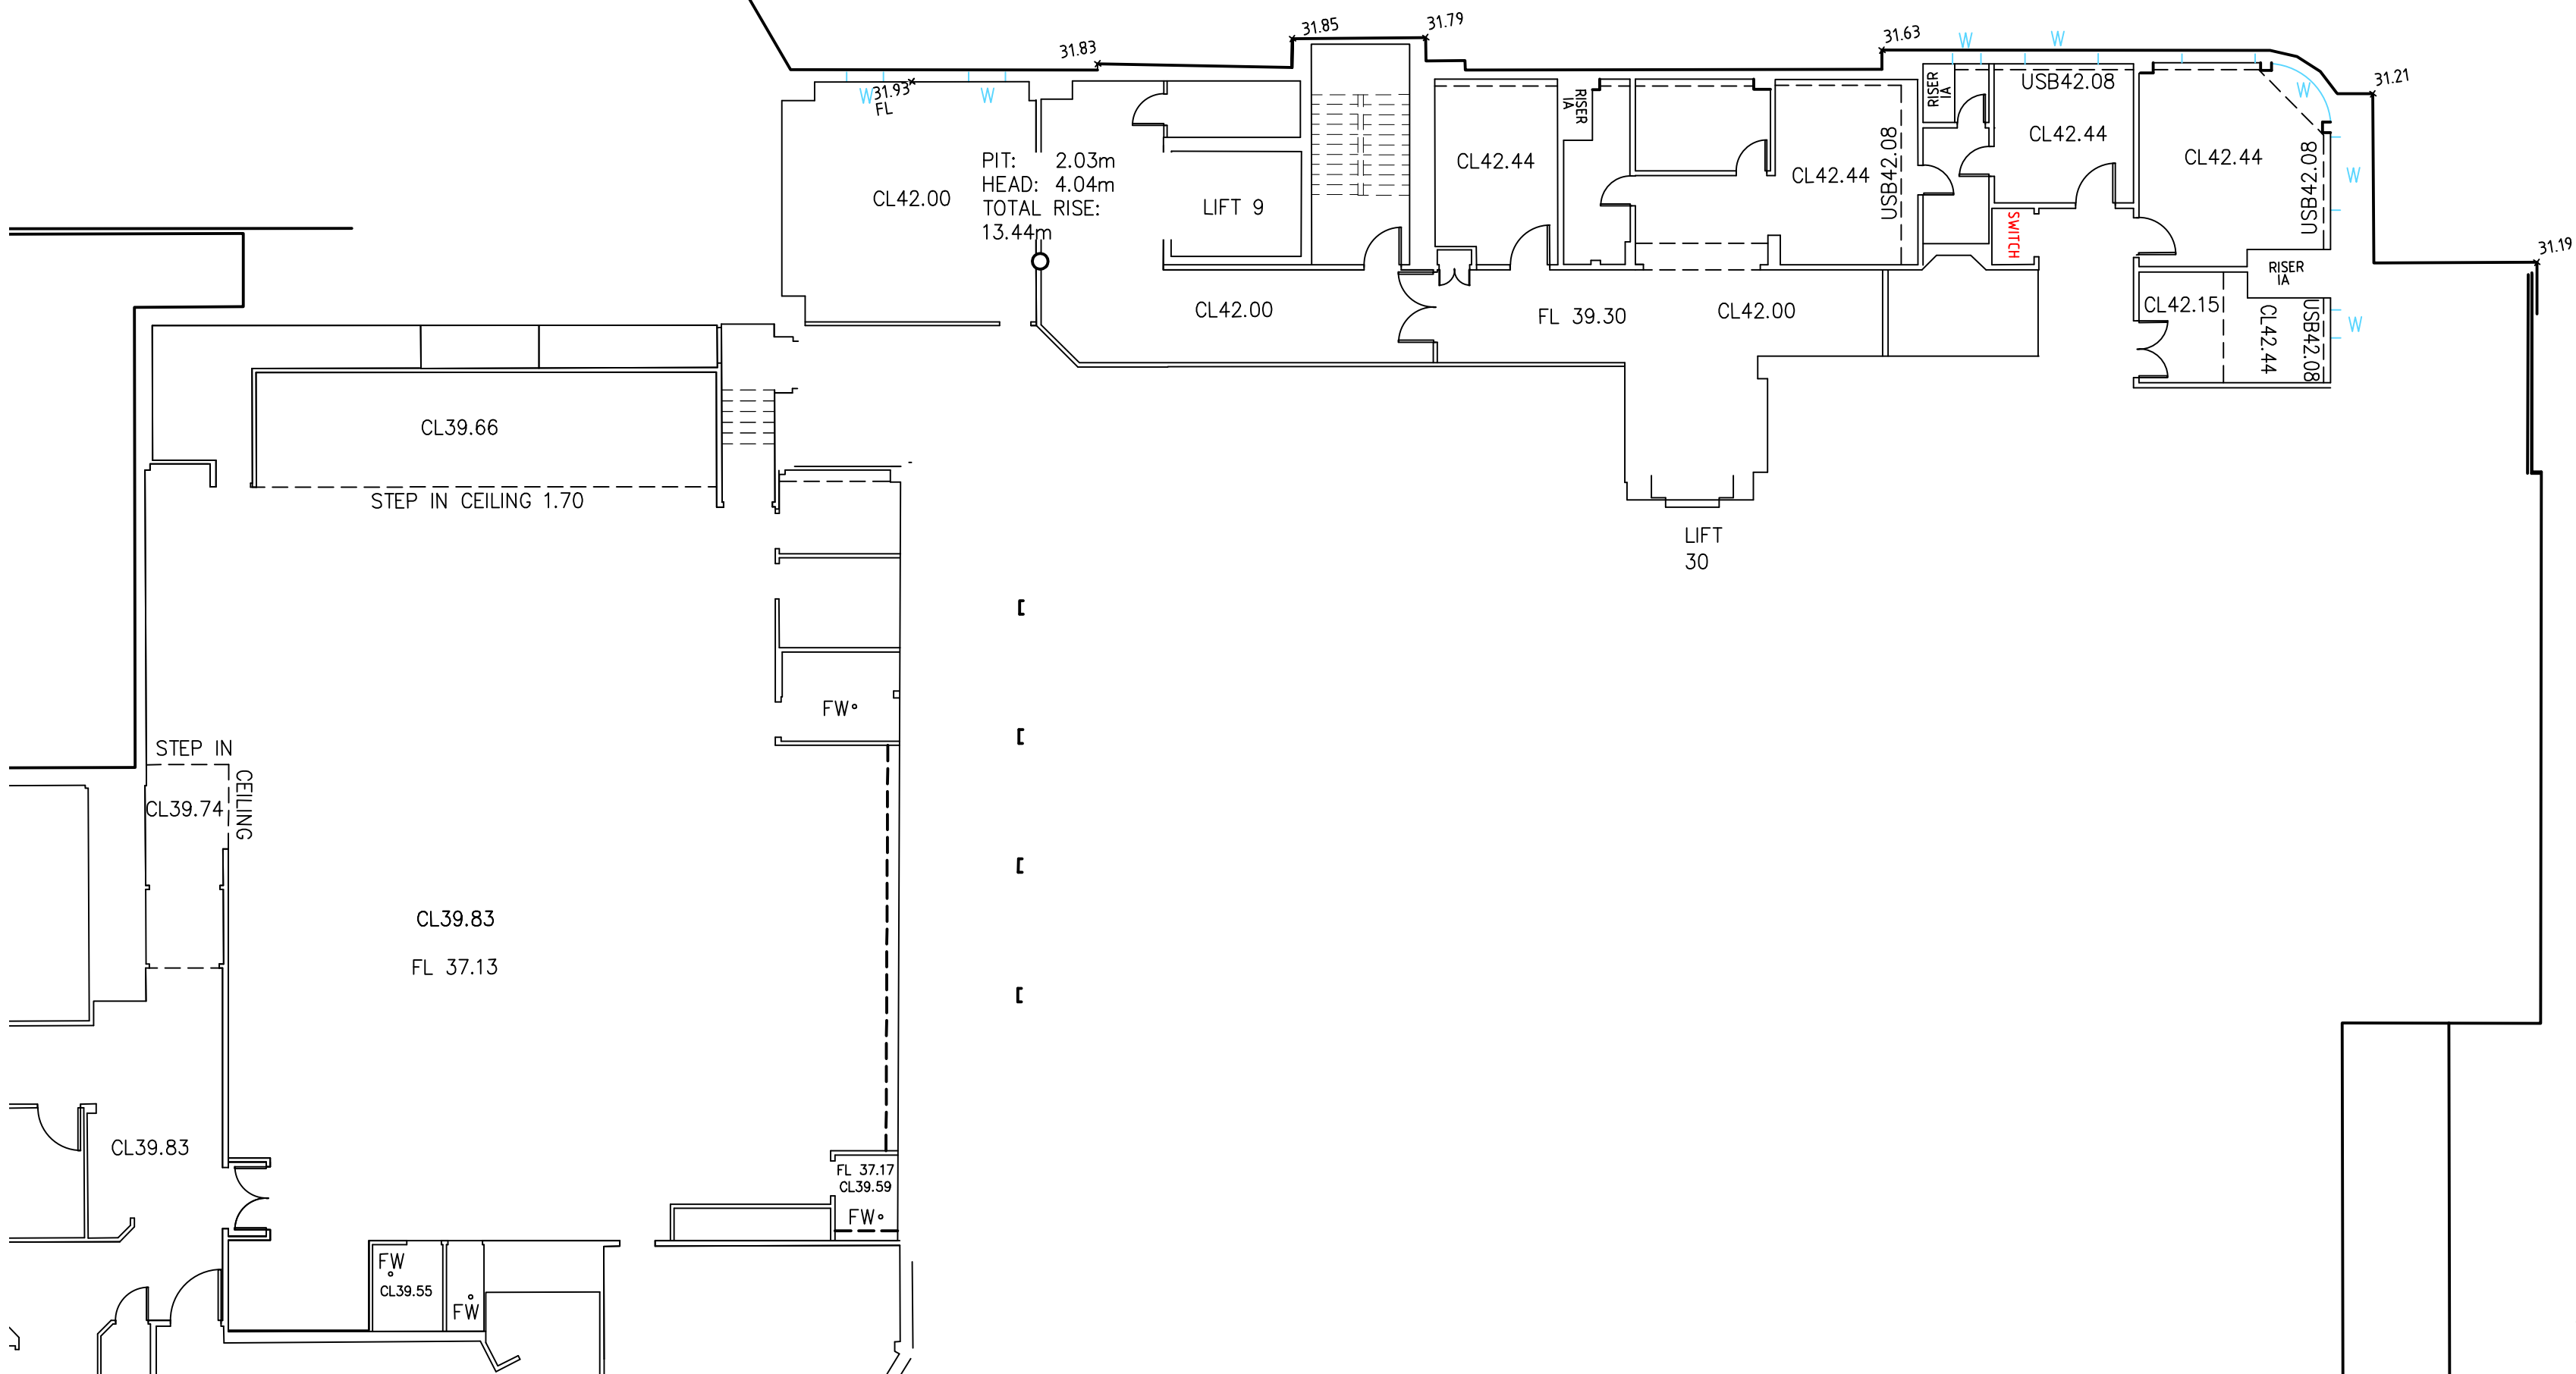

LEGEND

CL ~ UNDERSIDE OF CEILING LEVEL
USB ~ UNDERSIDE OF BEAM LEVEL
FL ~ FLOOR LEVEL
TW ~ TRADE WASTE
FHR ~ FIRE HOSE REEL
IA ~ INACCESSIBLE



D	00/00/00	-	00
C	00/00/00	-	00
B	00/00/00	-	00
A	00/00/00	-	00
Revision	Date	Description	Reference

THIS IS THE PLAN REFERRED TO
IN MY LETTER DATED:
.....
Registered Surveyor NSW

LTS

LOCKLEY


Registered Surveyors NSW
www.ltsl.com.au

Suite 1, Level 1
810 Pacific Highway
Gordon NSW 2072
Locked Bag 5
Gordon NSW 2072
P 1300 587 000
F 02 9499 7760

Client HEALTH INFRASTRUCTURE
Drawing title
PLAN OF DETAIL AND LEVELS OVER LOT 1-6 DP1130879 &
LOT 12 DP800476 KNOWN AS "ST GEORGE HOSPITAL" AT
KOGARAH

datum AHD	project number 33459	reference number 33459DT
site Area 5.179ha	scale 1:150 @A1	date of survey 24/06/15
LGA KOGARAH	OF SHEET 52 SHEETS	36

"CLINICAL SERVICES BUILDING"

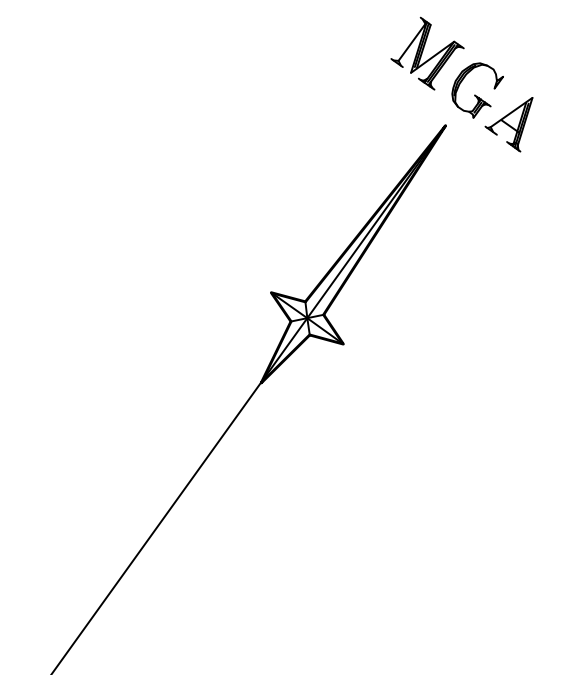


GROUND LEVEL STAIRWELL


CL ~ UNDERSIDE OF CEILING LEVEL
 USB ~ UNDERSIDE OF BEAM LEVEL
 FL ~ FLOOR LEVEL
 TW ~ TRADE WASTE
 FHR ~ FIRE HOSE REEL
 IA ~ INACCESSIBLE



.....
e Registered Surveyor NSW

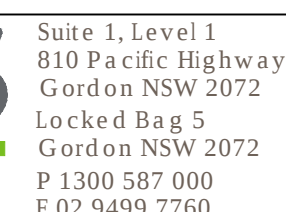

datum	project number	reference number
AHD	33459	33459DT
site Area	scale	date of survey
5.179ha	1:150 @A1	24/06/15
LGA	SHEET	37
KOGARAH	OF 52 SHEETS	

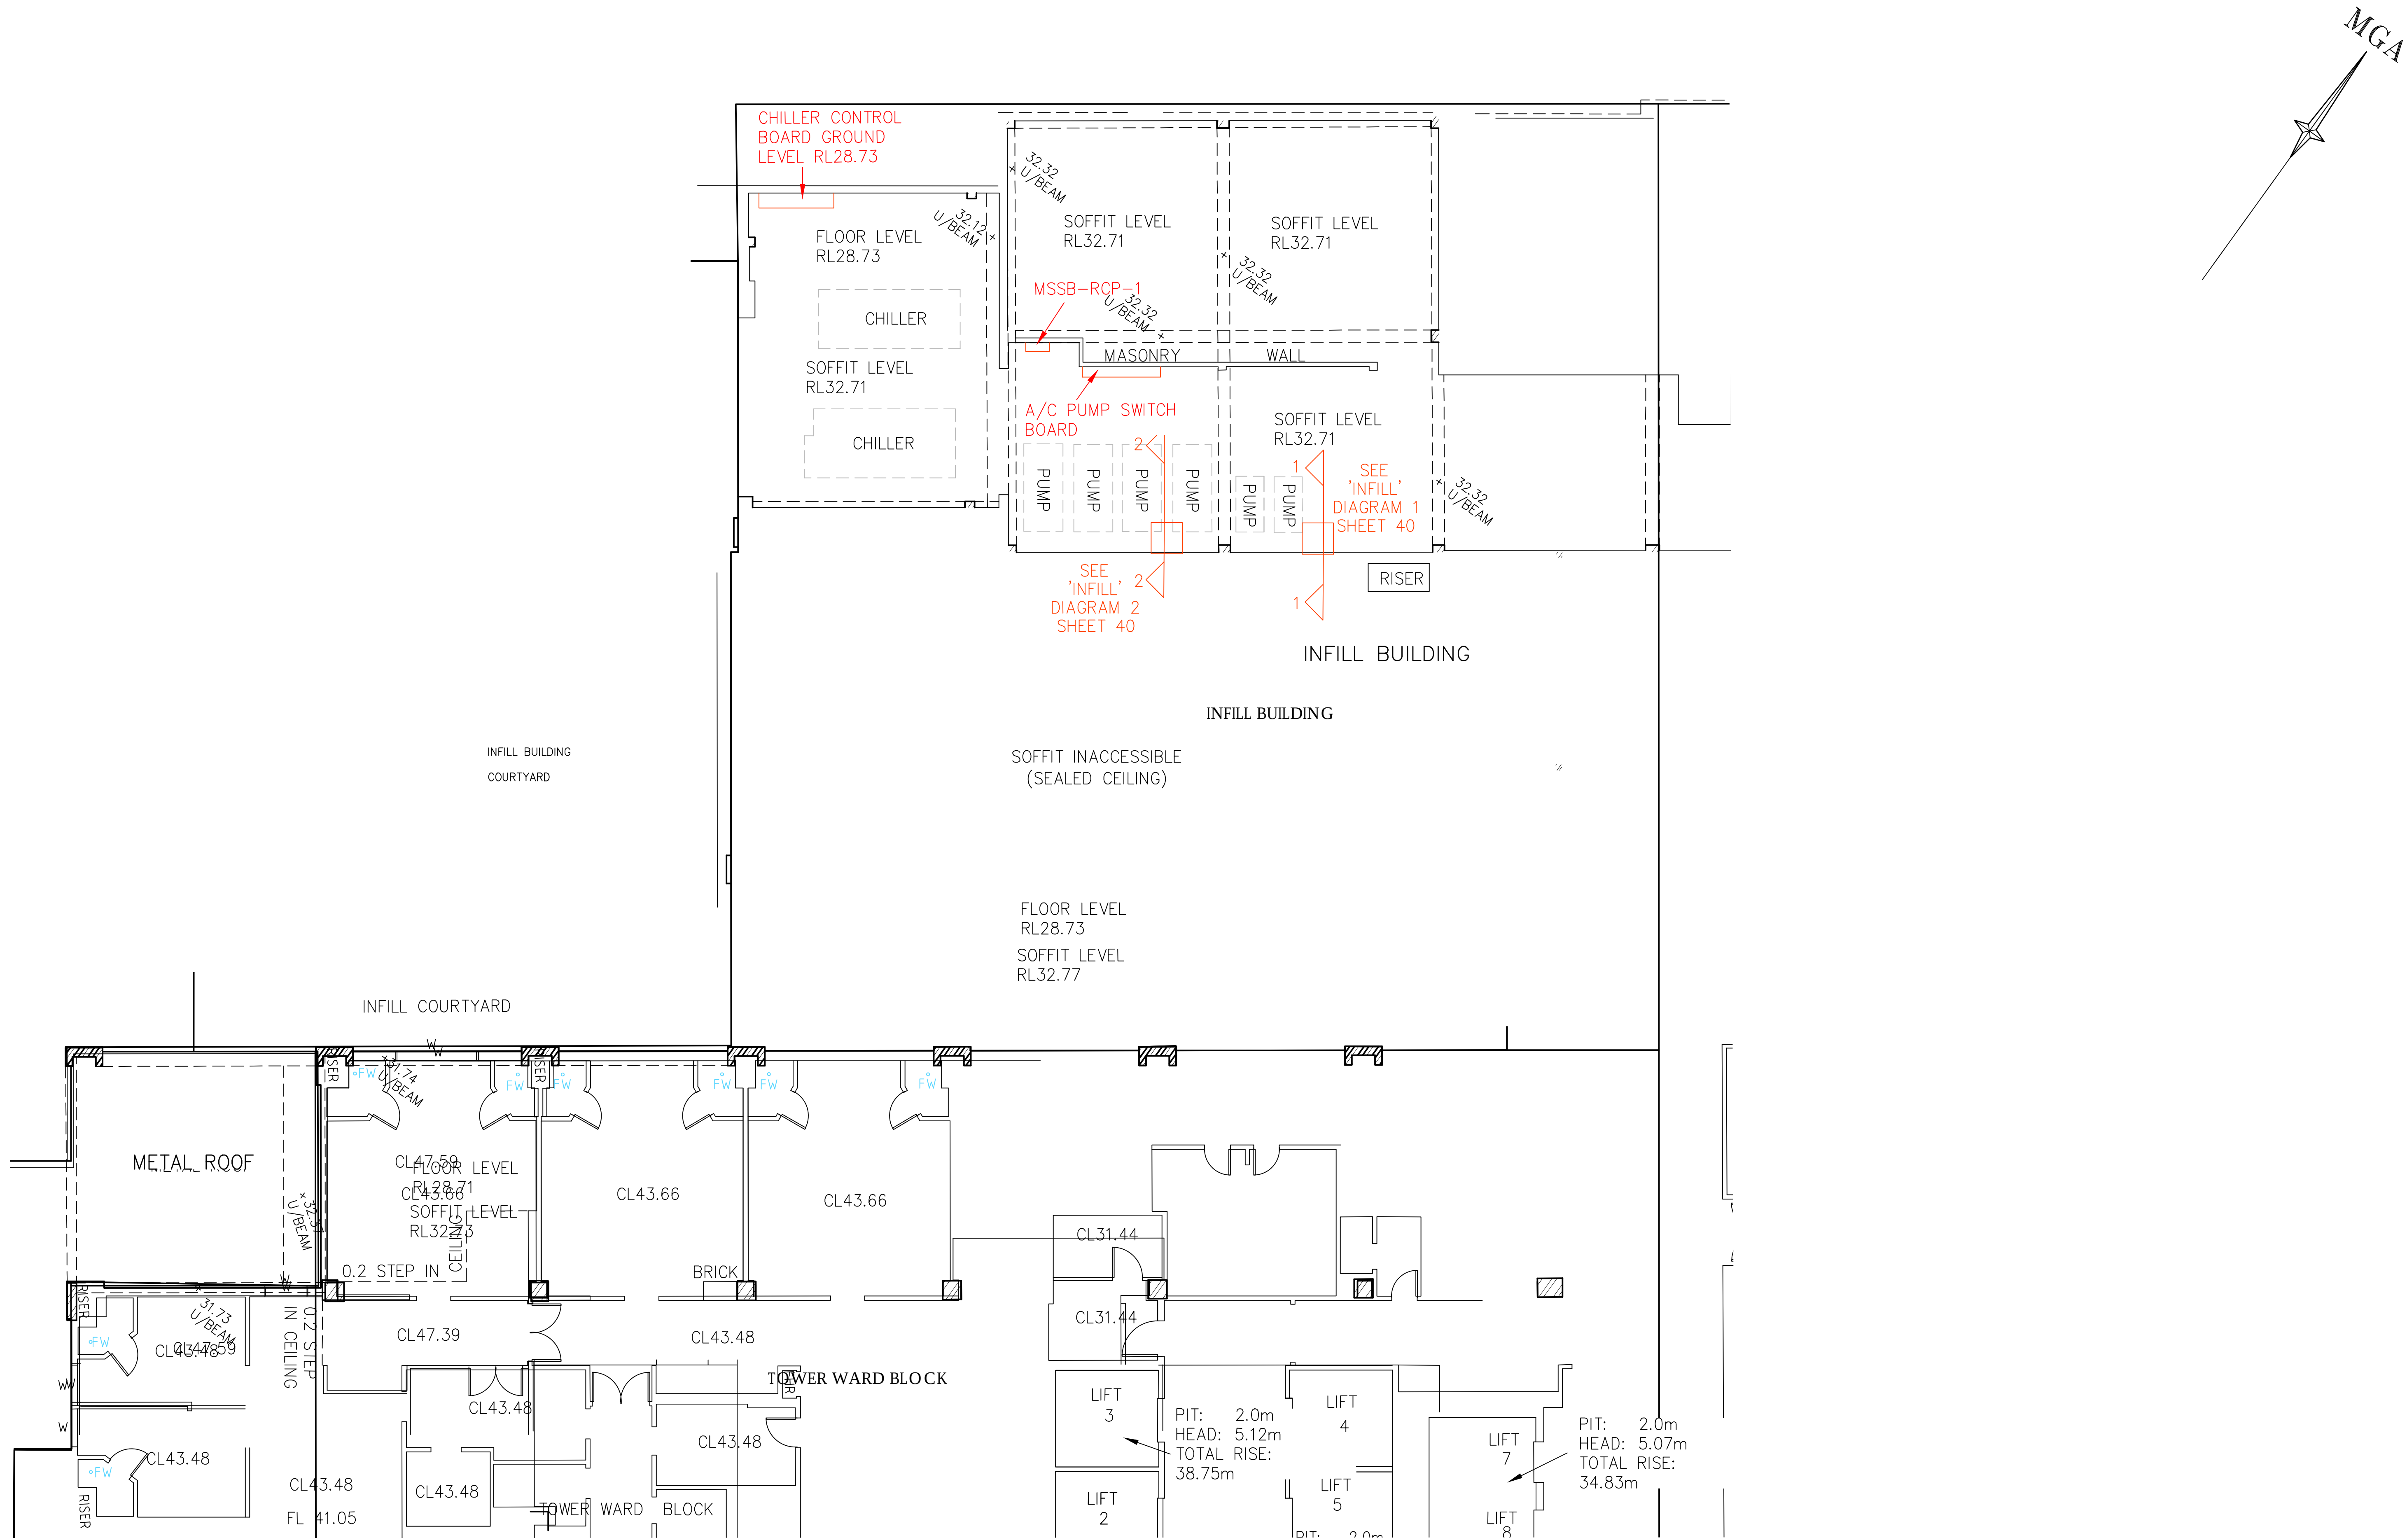

SEE SHEET 1 FOR LEGEND AND NOTES



THIS IS THE PLAN REFERRED TO
IN MY LETTER DATED:
.....
Registered Surveyor NSW



Suite 1, Level 1
810 Pacific Highway
Gordon NSW 2072
Locked Bag 5
Gordon NSW 2072
P 1300 587 000
F 02 9499 7760


Client HEALTH INFRASTRUCTURE
Drawing title
PLAN OF DETAIL AND LEVELS OVER LOT 1-6 DP1130879 &
LOT 12 DP800476 KNOWN AS "ST GEORGE HOSPITAL" AT
KOGARAH

datum
AHD
site Area
5.179ha
LGA
KOGARAH


project number
33459
scale
1:100 @A1
OF 52 SHEETS

reference number
33459DT
date of survey
24/06/15
38

'INFILL' BUILDING BASEMENT FLOOR PLAN

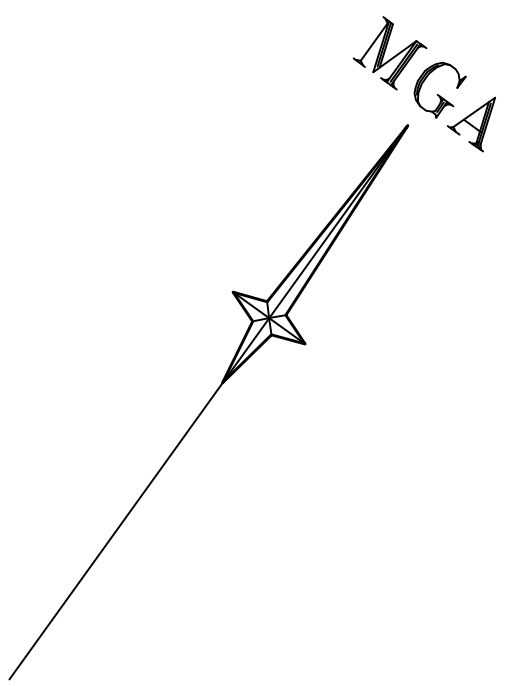

SEE SHEET 1 FOR LEGEND AND NOTES
NOTE: INTERNAL INFORMATION HAS BEEN SURVEYED PRIOR TO ELEMENT 1
FLOOR PLAN SHOWN GREY SURVEYED AUGUST 2012

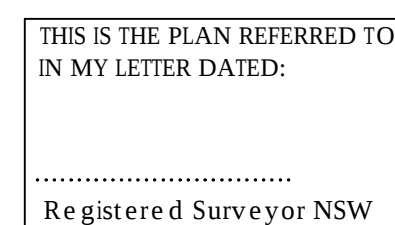


Suite 1, Level 1
810 Pacific Highway
Gordon NSW 2072
Locked Bag 5
Gordon NSW 2072
P 1300 587 000
F 02 9499 7760


Client HEALTH INFRASTRUCTURE
Drawing title
PLAN OF DETAIL AND LEVELS OVER LOT 1-6 DP1130879 &
LOT 12 DP800476 KNOWN AS "ST GEORGE HOSPITAL" AT
KOGARAH

datum	project number	reference number
AHD	33459	33459DT
site Area	scale	date of survey
5.179ha	1:100 @A1	24/06/15
LGA	SHEET	39
KOGARAH	OF 52 SHEETS	

INFILL BUILDING DETAIL PLAN

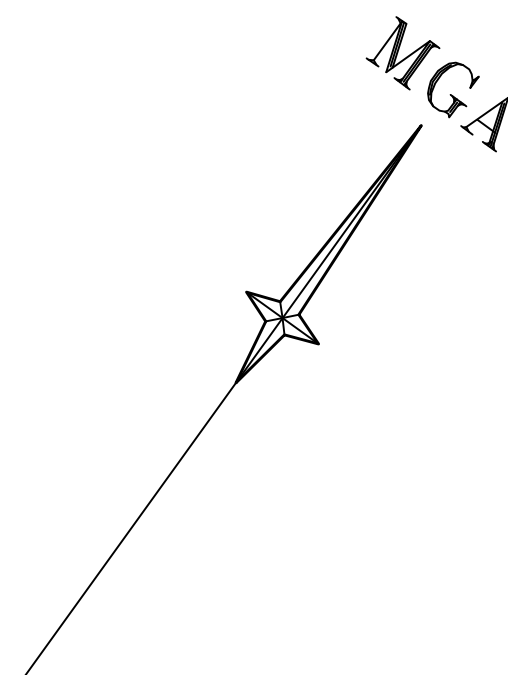


'INFILL' LEVEL 1 FLOOR PLAN

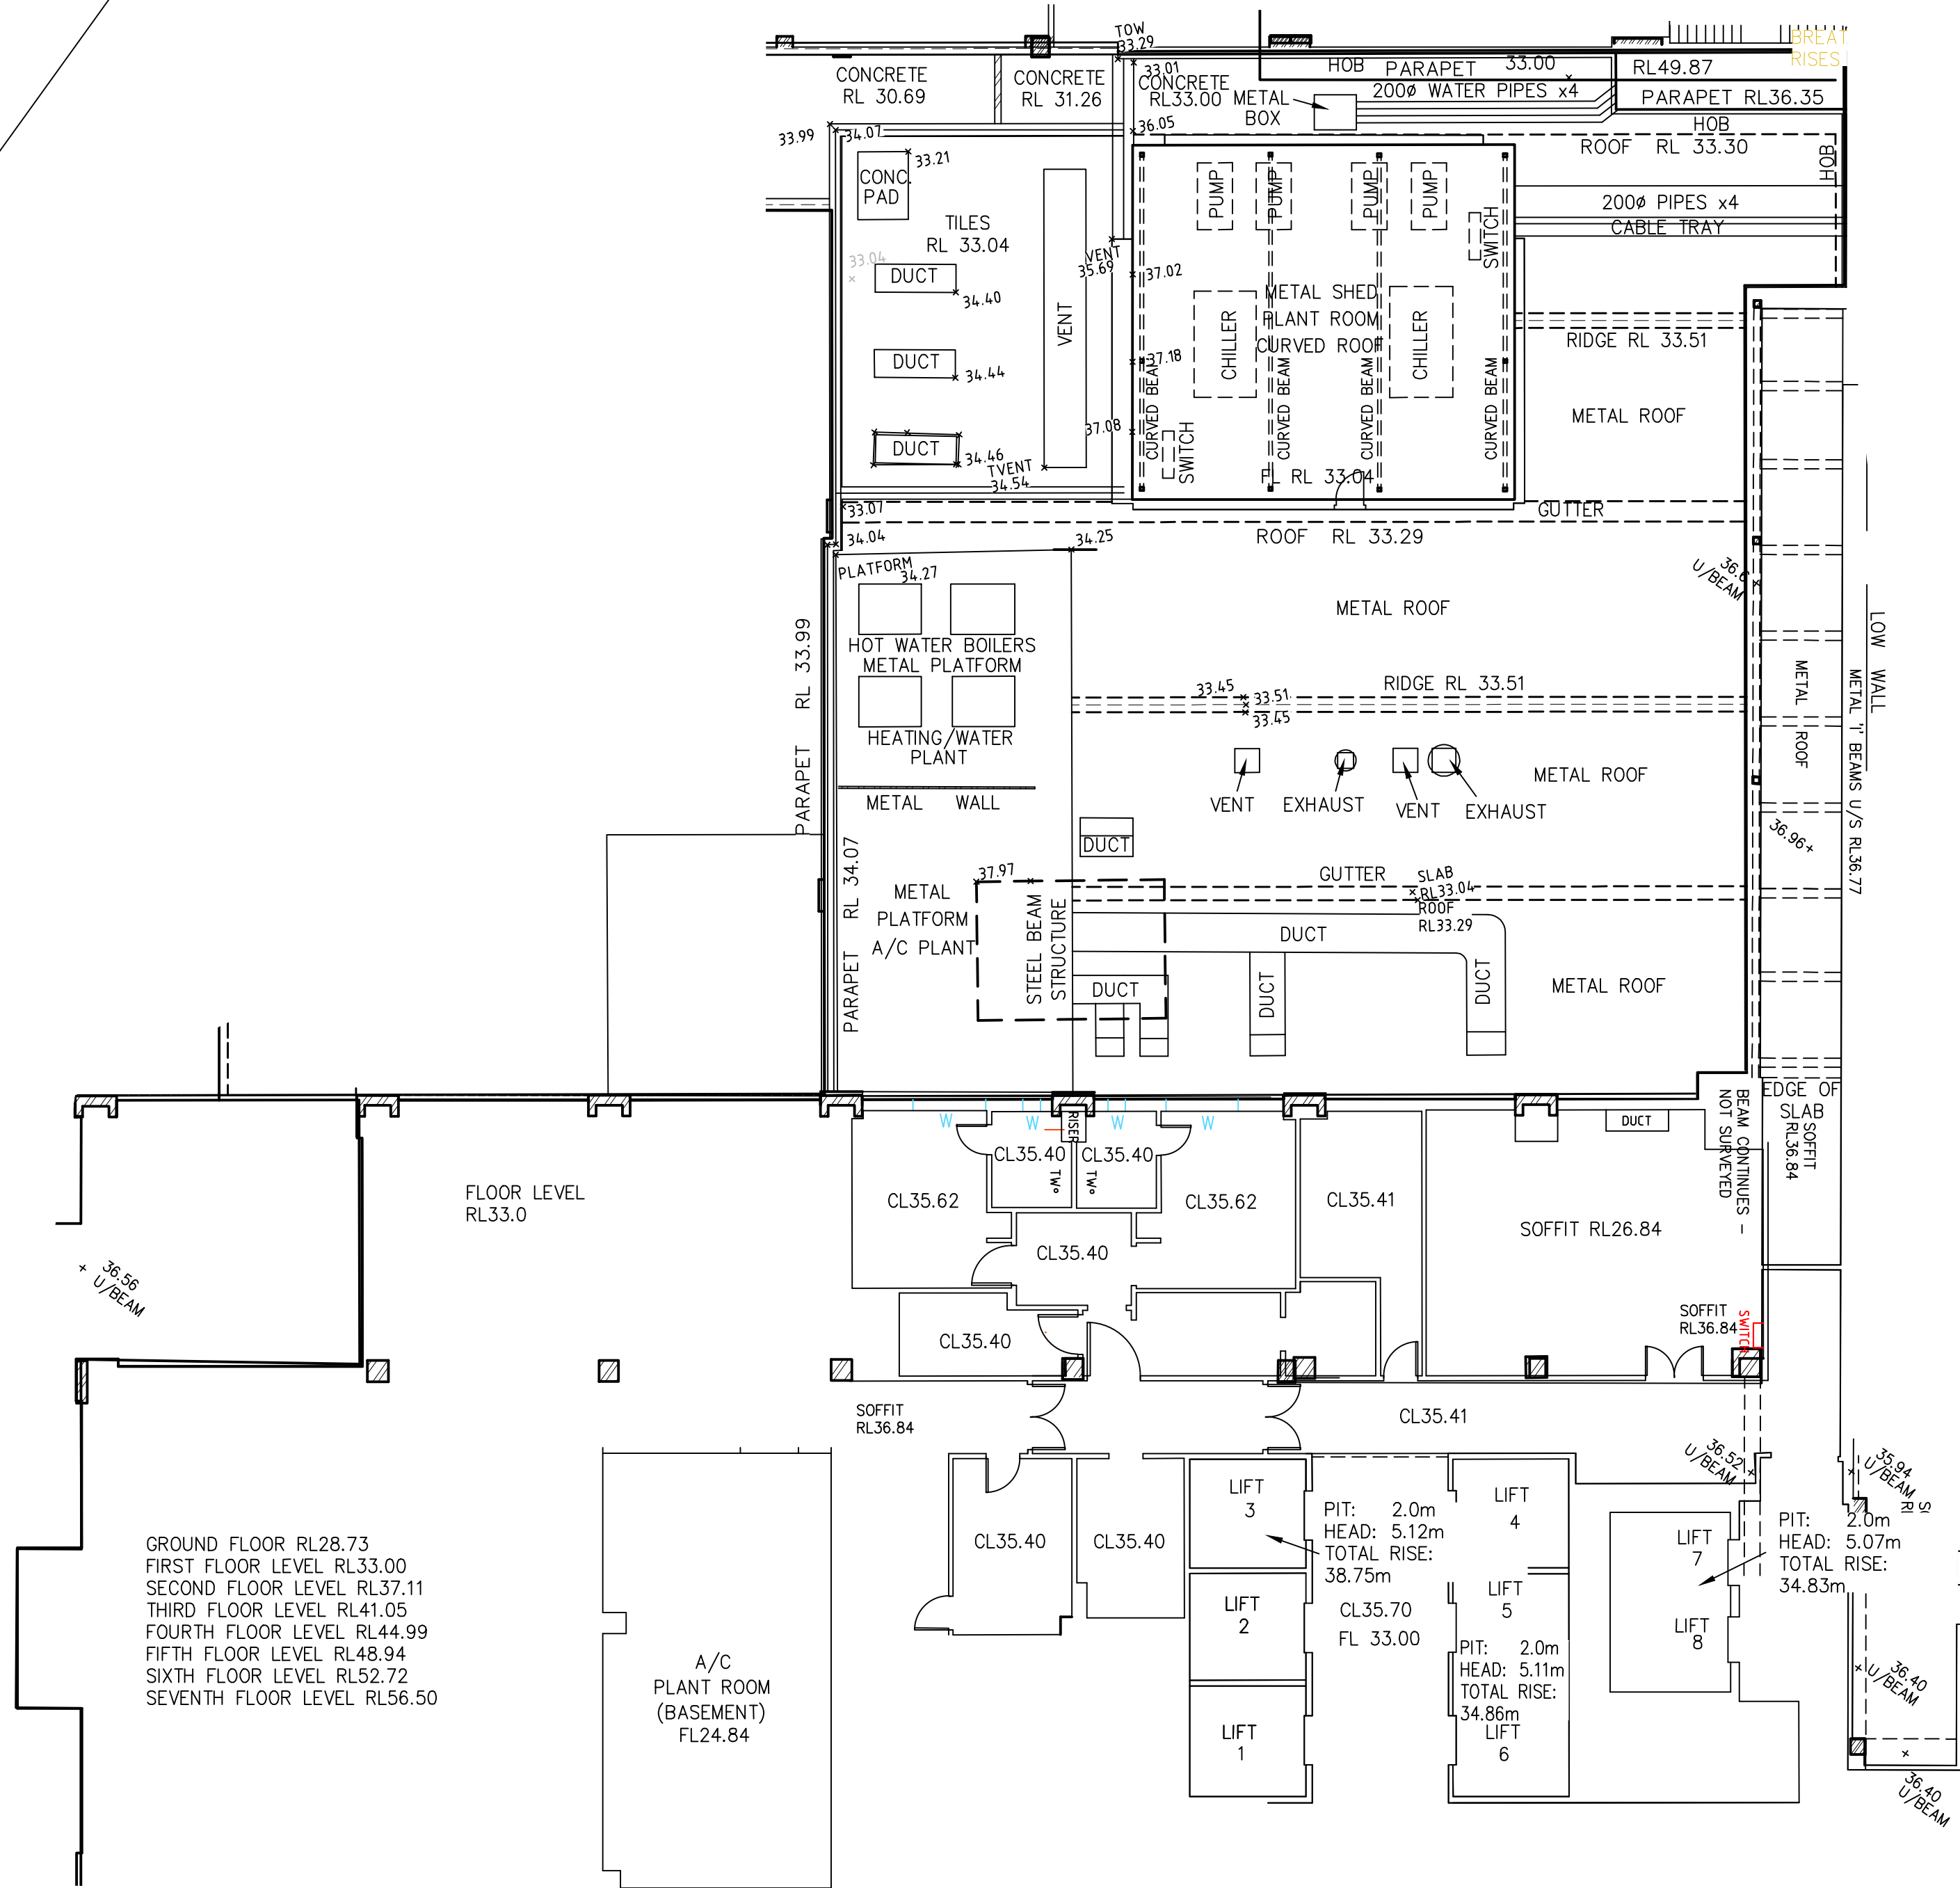

U/BEAM ~ DENOTES UNDERSIDE OF BEAM


SEE SHEET 1 FOR LEGEND AND NOTES

NOTE INTERNAL INFORMATION HAS BEEN SURVEYED PRIOR TO ELEMENT 1
FLOOR PLAN SHOWN GREY SURVEYED AUGUST 2012

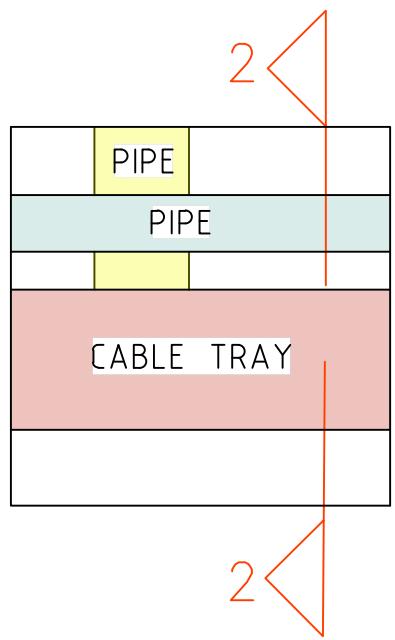


'INFILL' DIAGRAM 2

1:20

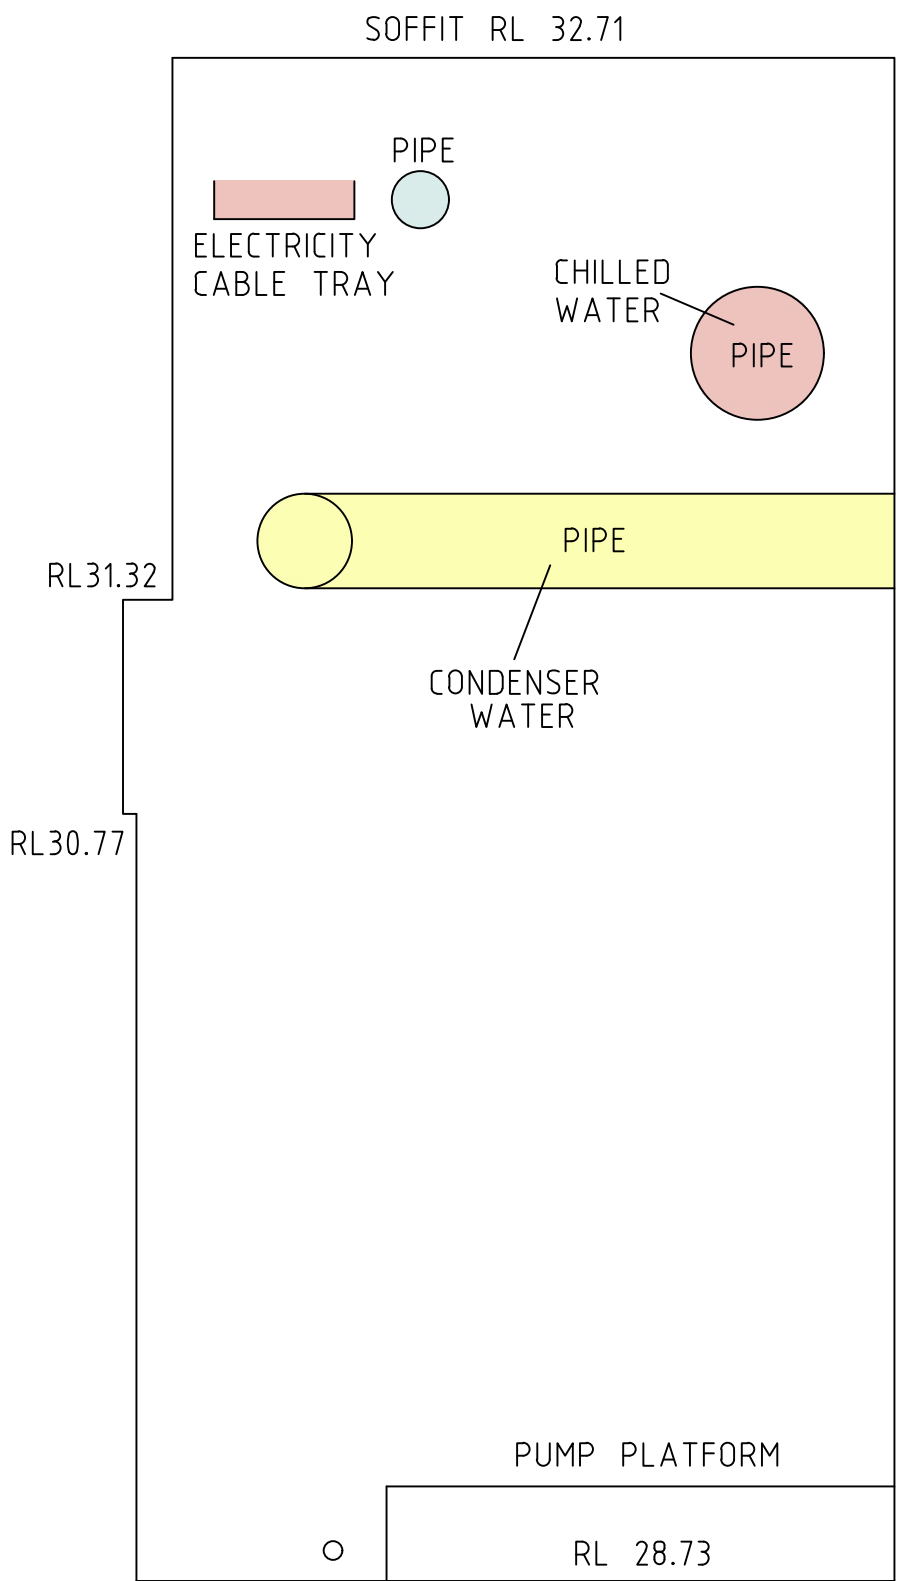


'INFILL' SECTION 2

1:20

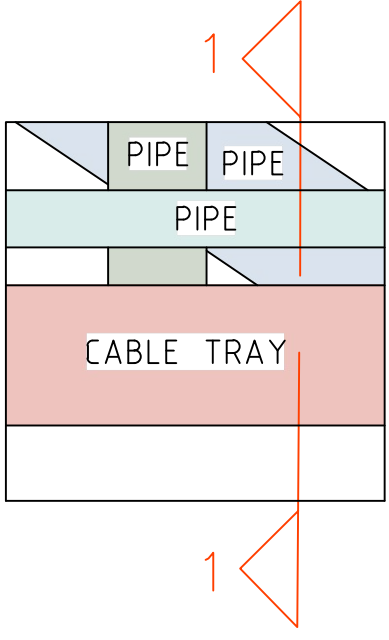

'INFILL' DIAGRAM 1

1:20

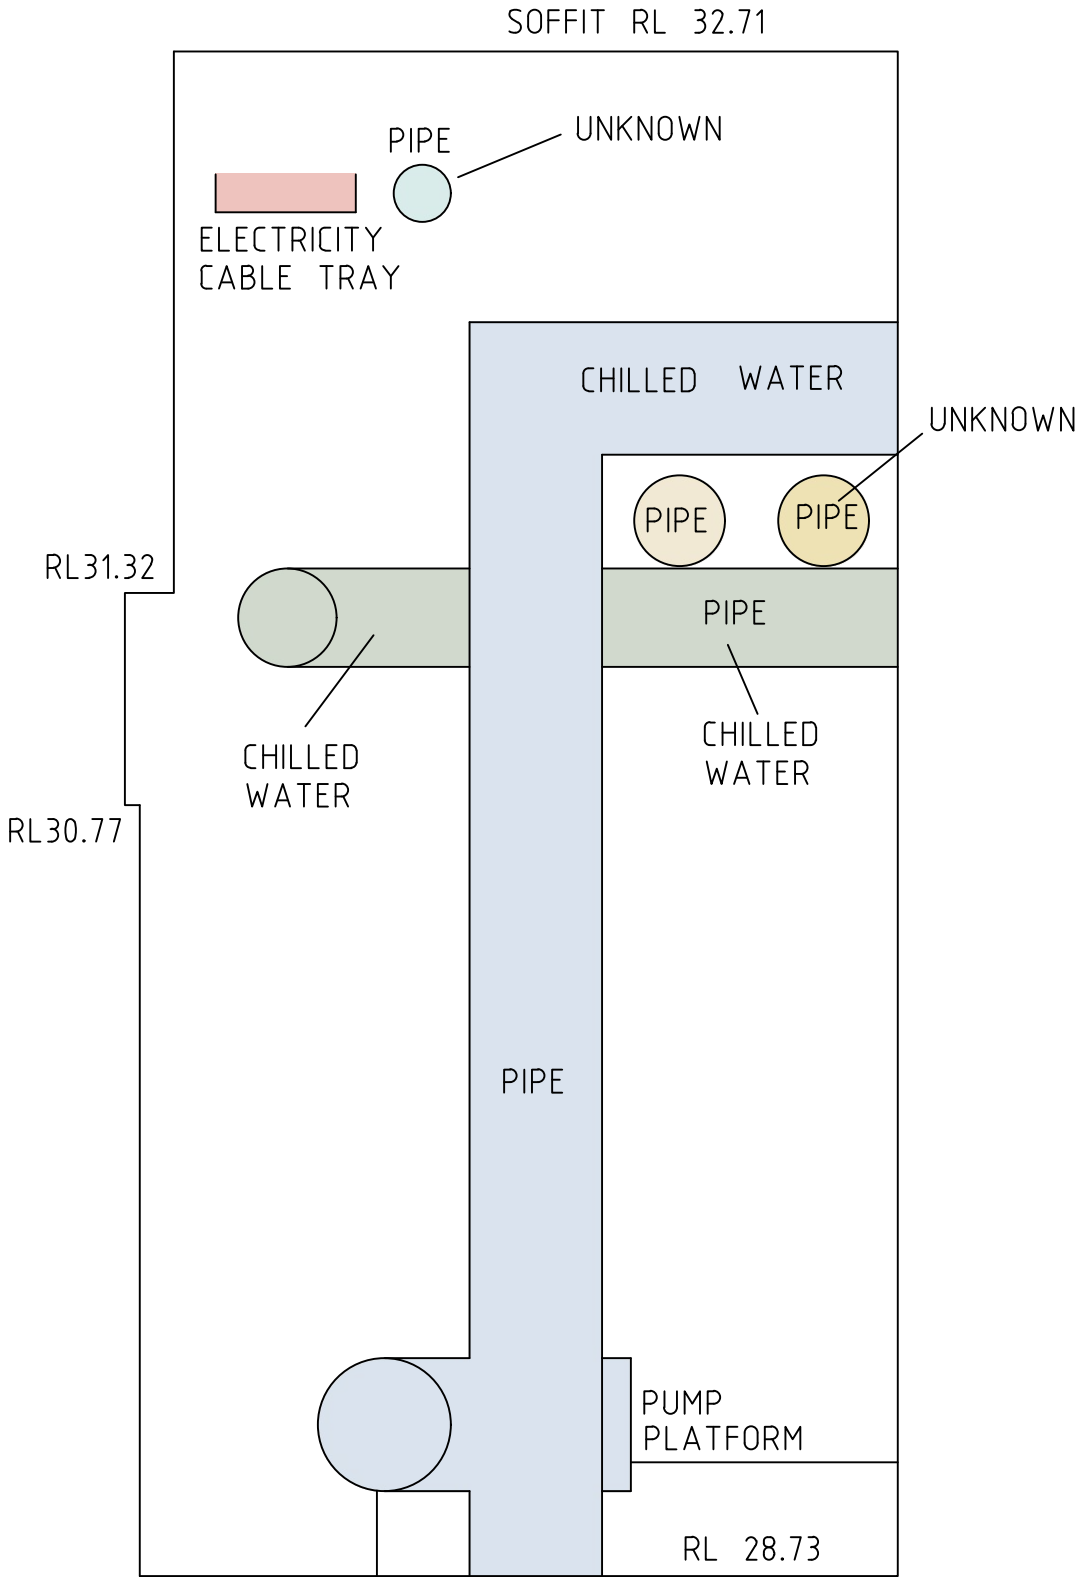

'INFILL' SECTION 1

1:20

THIS IS THE PLAN REFERRED TO
IN MY LETTER DATED:
.....
Registered Surveyor NSW

LTS
LOCKLEY
Registered Surveyors NSW
www.ltsl.com.au

Suite 1, Level 1
810 Pacific Highway
Gordon NSW 2072
Locked Bag 5
Gordon NSW 2072
P 1300 587 000
F 02 9499 7760


Client HEALTH INFRASTRUCTURE
Drawing title
PLAN OF DETAIL AND LEVELS OVER LOT 1-6 DP1130879 &
LOT 12 DP800476 KNOWN AS "ST GEORGE HOSPITAL" AT
KOGARAH

datum
AHD
site Area
5.179ha
LGA
KOGARAH

project number
33459
scale
1:100 @A1
OF 52 SHEETS

reference number
33459DT
date of survey
24/06/15
40

MGA

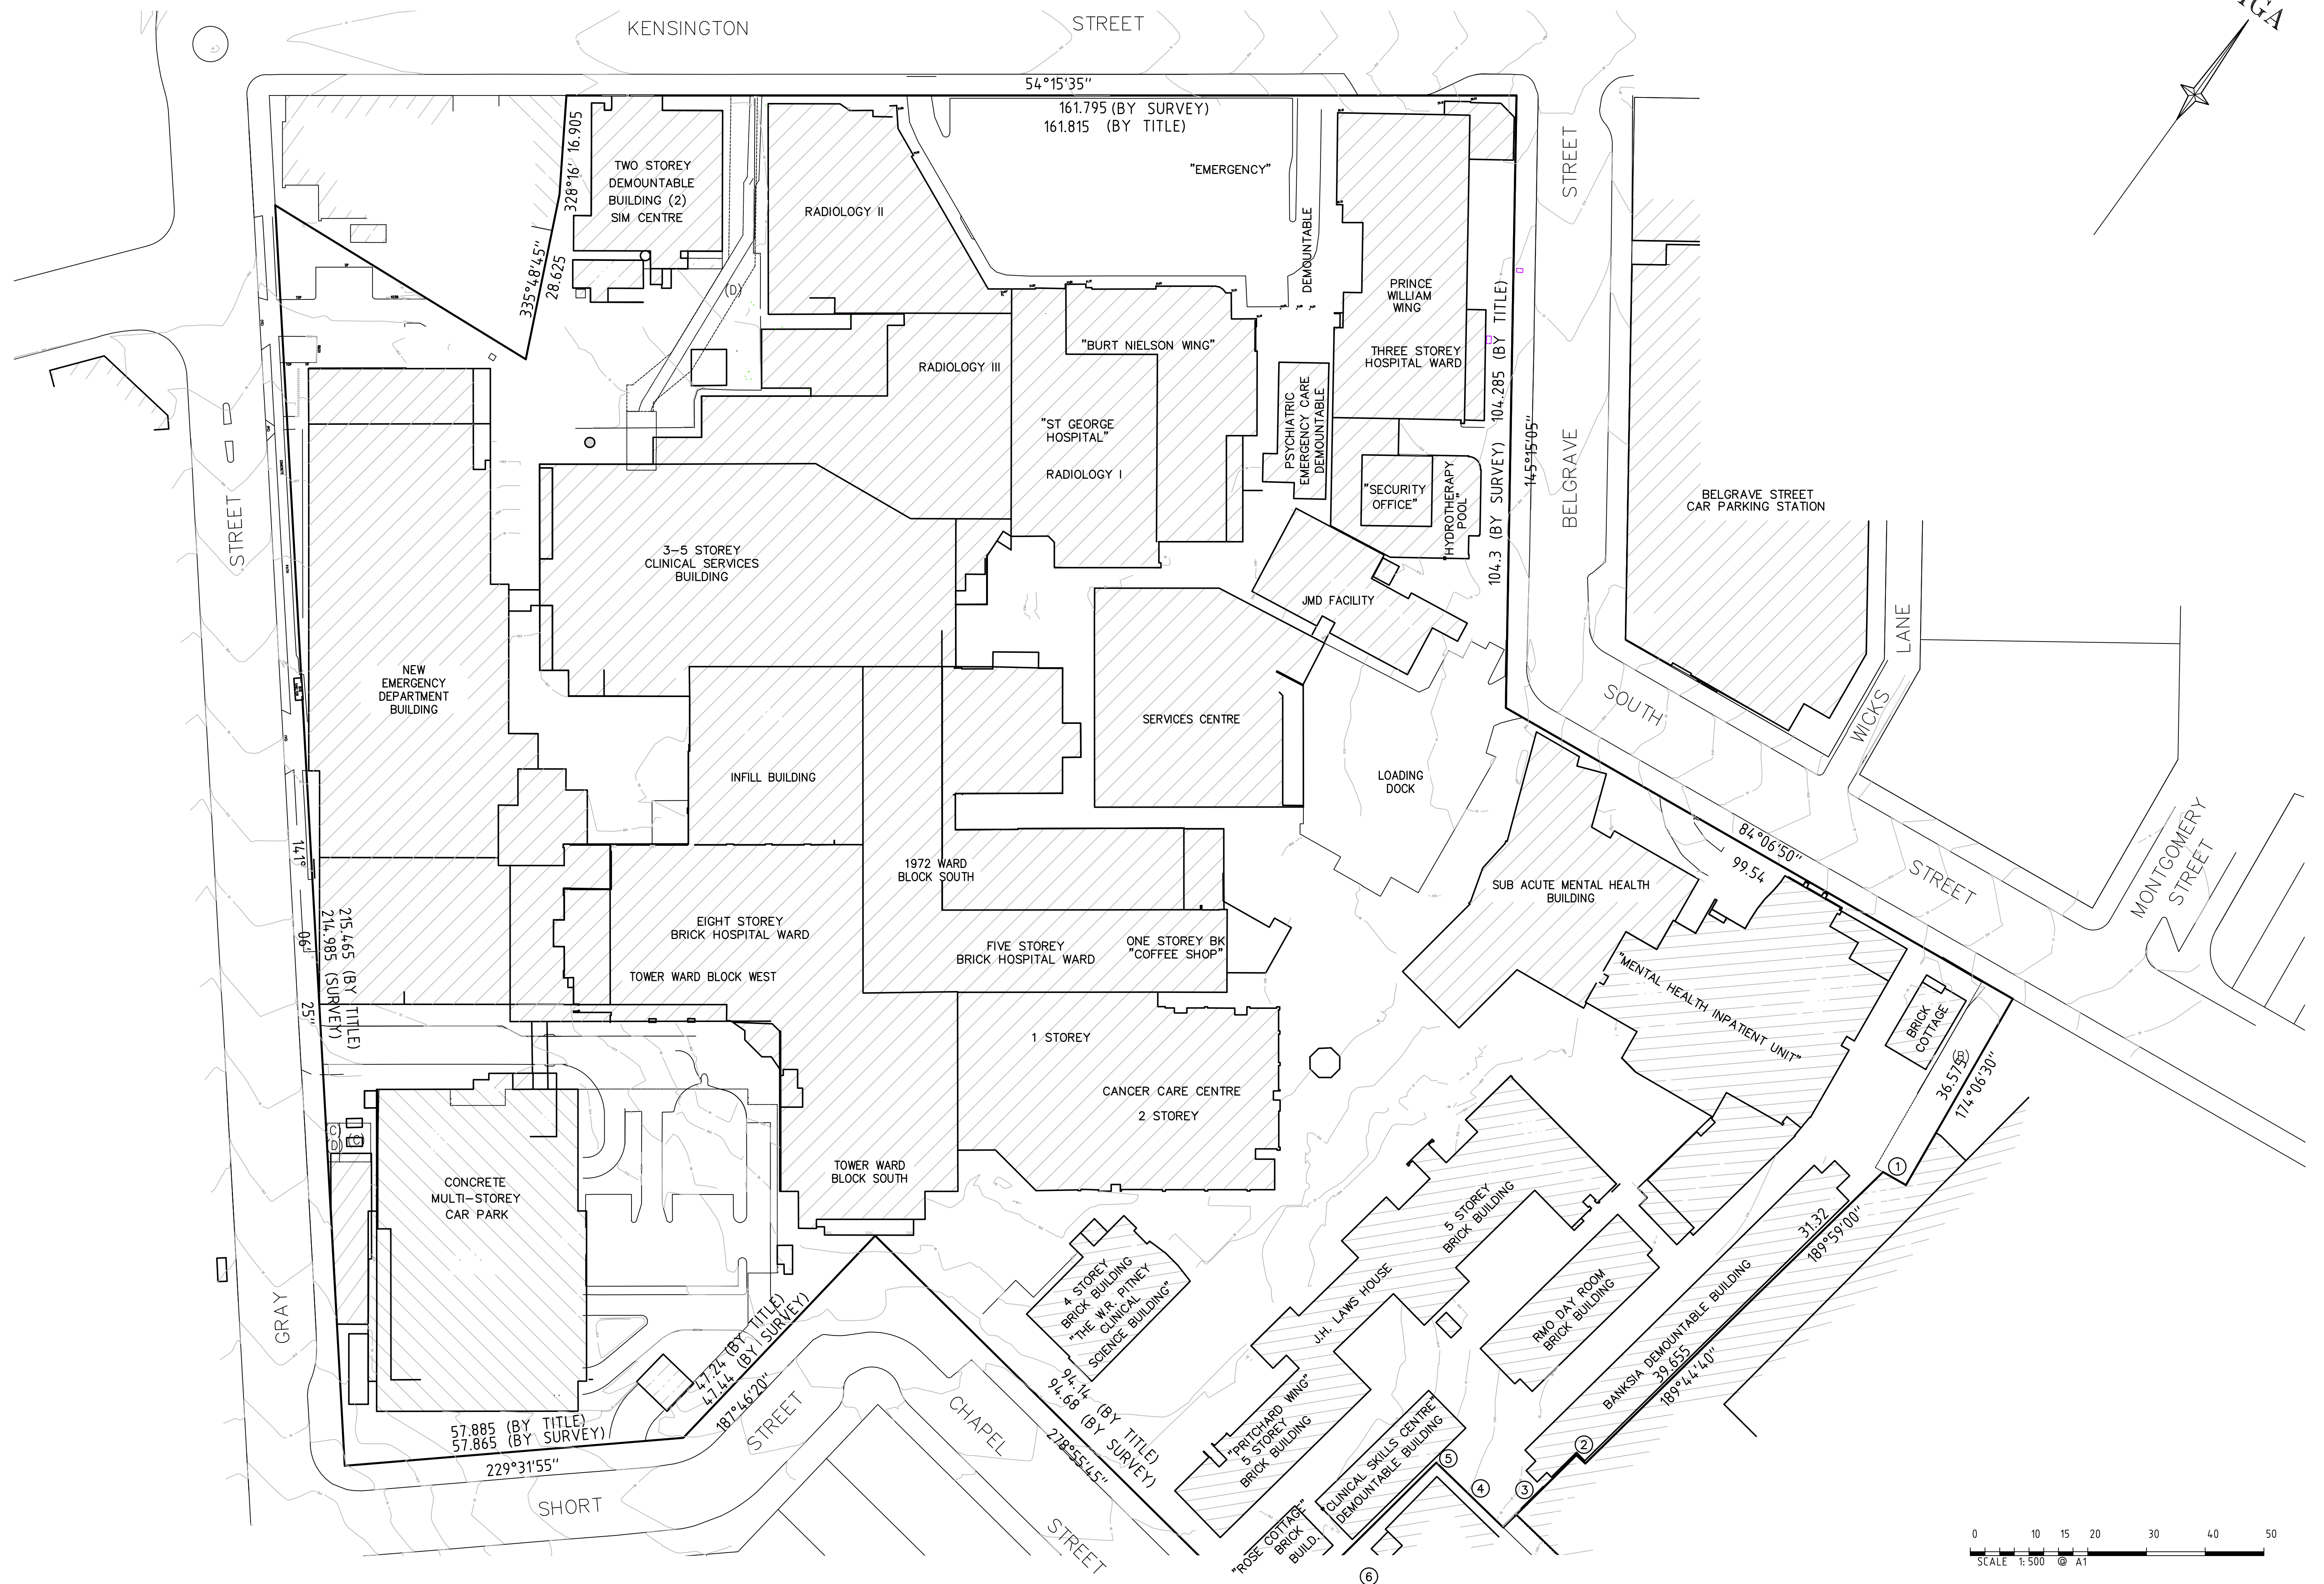


Registered Surveyors NSW
www.ltsj.com.au

Drawing title
PLAN OF DETAIL AND LEVELS OVER LOT 1-6 DP1130879 &
LOT 12 DP800476 KNOWN AS "ST GEORGE HOSPITAL" AT
KOGARAH

datum	project number	reference number
AHD	33459	33459DT
site Area	scale	date of survey
5.179ha	1:500 @A1	24/06/15
LGA	SHEET	41
KOGARAH	OF 52 SHEETS	

TITLING PLAN

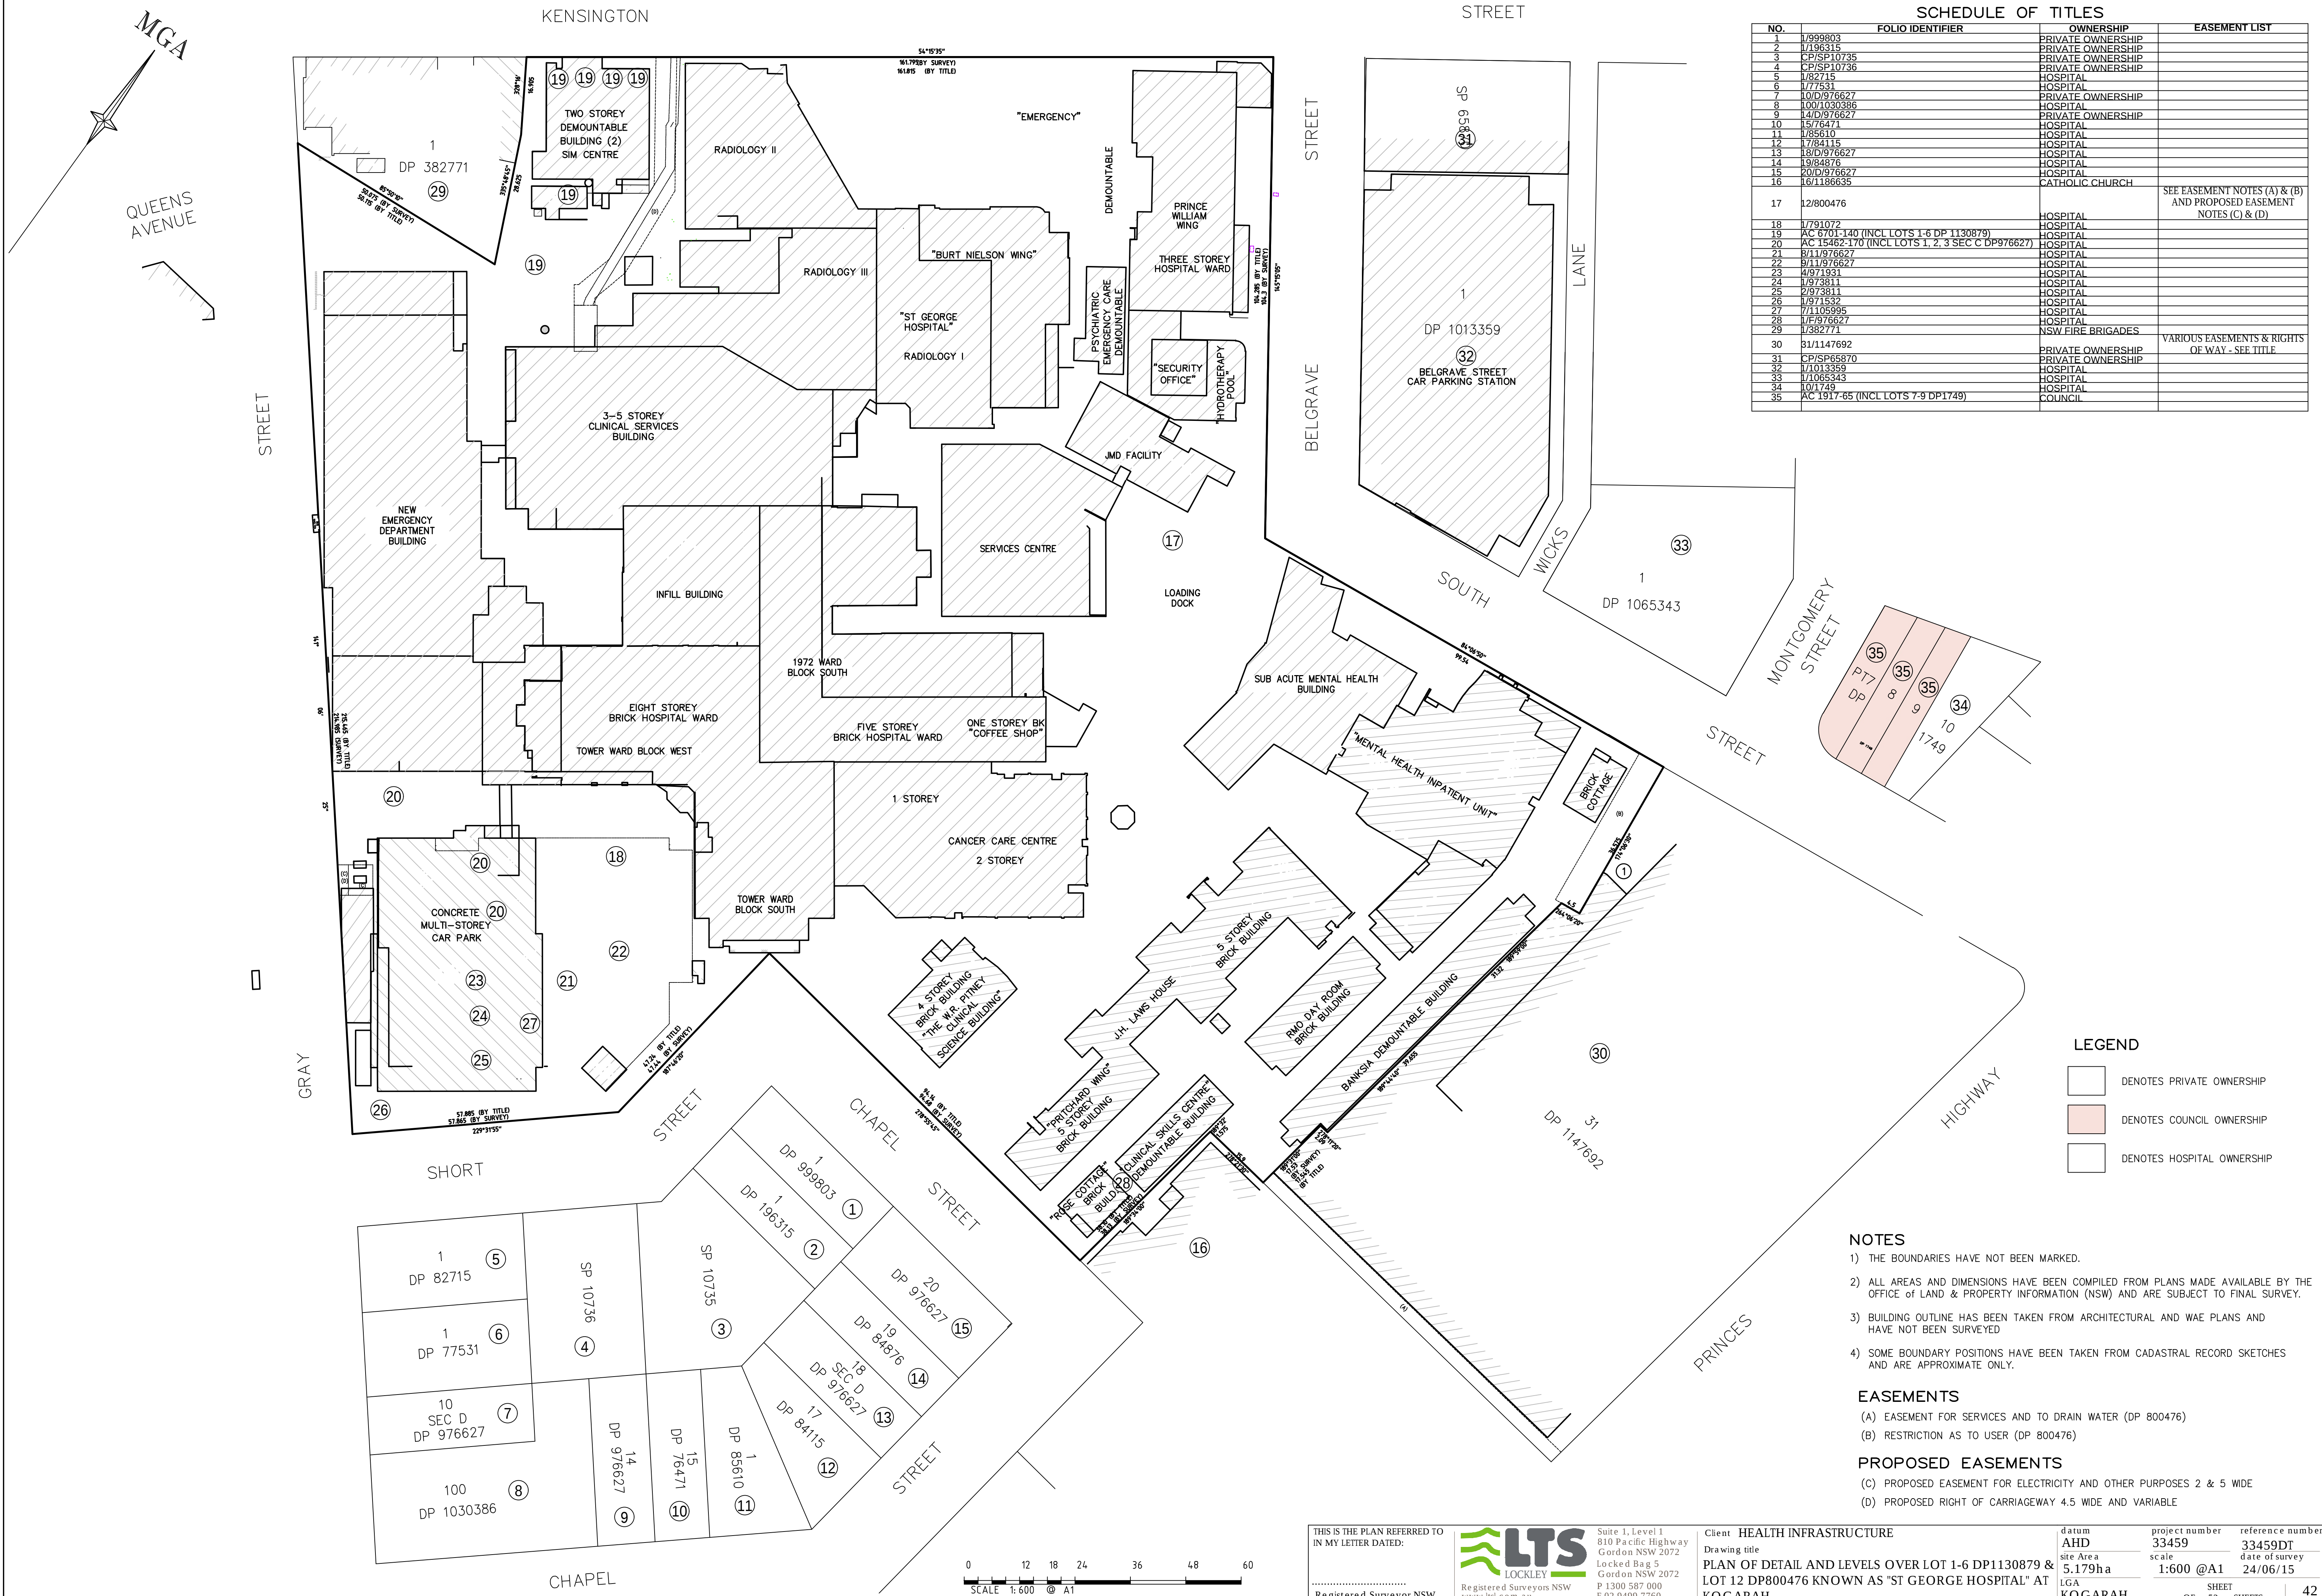

TREE PLAN

- 1 TREES SHOWN IN GREEN ARE CONSIDERED OF HIGH RETENTION VALUE
2 TREES SHOWN IN ORANGE ARE CONSIDERED OF MEDIUM RETENTION VALUE
3 TREES SHOWN IN BLACK ARE CONSIDERED FOR REMOVAL
4 TREES SHOWN IN BLUE ARE RECOMMENDED TO BE REMOVED



Tree No.	Genus & Species/ Common Name	Tree Retention Priority		Tree Protection Zone (TPZ) = 12 x DBH From centre of trunk (COT) in metres (Minimum 2.0 metres)
		High - Priority for retention	Medium - Consider for retention	
1	Eucalyptus microcorys Tallow Wood	High		7.2
2	Eucalyptus microcorys Tallow Wood	High		7.2
3	Eucalyptus microcorys Tallow Wood	High		3.6
4	Eucalyptus microcorys Tallow Wood	High		5.9
5	Eucalyptus microcorys Tallow Wood	High		8.4
6	Melaleuca laurifolia Snow in Summer	High		4.8
7-Feb	Corymbia citrifolia Lemon Scented Gum	High		7.2
8	Corymbia maculata Spotted Gum	High		3.6
9	Casuarina cunninghamiana Black Bean	Medium		4.4
10	Corymbia maculata Spotted Gum	High		5.2
11	Corymbia maculata Spotted Gum	High		5.2
12	Banksia integrifolia Flowering Banksia	Medium		4.4
13	Platanus x hispanica London Plane Tree	High		5.9
14	Cupressus macrocarpa Monterey Cypress	Medium		3.6
15	Eucalyptus microcorys Tallow Wood	High		7.2
16	Eucalyptus microcorys Tallow Wood	High		6
17	Tristania laurina Water Gum	Medium		3.6
18	Tristania laurina Water Gum	Medium		3.6
19	Tristania laurina Water Gum	Medium		3.6
20	Tristania laurina Water Gum	Medium		3.6
21	Eucalyptus microcorys Tallow Wood	High		4.8
22	Eucalyptus microcorys Tallow Wood	High		4.8
23	Eucalyptus microcorys Tallow Wood	Low		2.4
24	Callistemon viminalis 'Captain Cook' Captain Cook Bottlebrush	Medium		2.4
25	Callistemon viminalis 'Captain Cook' Captain Cook Bottlebrush	Medium		2.4
26	Callistemon viminalis 'Captain Cook' Captain Cook Bottlebrush	Medium		2.4
27	Callistemon viminalis 'Captain Cook' Captain Cook Bottlebrush	Medium		2.4
28	Gleichenia linearis 'Sundara' Honey Locust	Medium		2.4
29	Cupressus macrocarpa Monterey Cypress	Medium		4.8
30	Banksia marginata Silver Banksia	Medium		3
31	Banksia marginata Silver Banksia	Medium		2.4
32	Lophosiphon confusus Queensland Brush Box	High		5.9
33	Waterhousea floribunda (c2) Weeping Lily Pilly	Medium		2.4
34	Ficus benjamina Weeping Fig	High		8.4
35	Cedrus deodora Cedar	Low		9.1
36	Melaleuca laurifolia Snow in Summer	Medium		6.2
37	Ulmus parvifolia (c2) Chinese Elm	Medium		3.6
38	Ulmus parvifolia (c3) Chinese Elm	Medium		3.8
39	Ulmus parvifolia Chinese Elm	Medium		3.6
40	Ulmus parvifolia Chinese Elm	Medium		3.6
41	Livistonia chinensis Chinese Fan Palm	Medium		4.8
42	Waterhousea floribunda Weeping Lily Pilly	Medium		3.6
43	Ulmus parvifolia Chinese Elm	Medium		4.4
44	Livistonia chinensis Chinese Fan Palm	Medium		4.7
45	Syzygium cascade (c2) Pink Cascade Weeping Lily Pilly	Medium		2.5
46	Livistonia chinensis (c2) Chinese Fan Palm	Medium		4.7
47	Syzygium cascade Cascade Weeping Lily Pilly	Medium		4.9
48	Eucalyptus sp. Eucalypt	Remove		5.4
49	Syzygium leucomela Weeping Lily Pilly	Medium		2.9

THIS IS THE PLAN REFERRED TO IN MY LETTER DATED:

Registered Surveyor NSW

LTS LOCKLEY
Registered Surveyors NSW
www.ltsl.com.au

Suite 1, Level 1
810 Pacific Highway
Gordon NSW 2072
Locked Bag 5
Gordon NSW 2072
P 1300 587 000
F 02 9499 7760

Client HEALTH INFRASTRUCTURE
Drawing title
PLAN OF DETAIL AND LEVELS OVER LOT 1-6 DP1130879 & LOT 12 DP800476 KNOWN AS "ST GEORGE HOSPITAL" AT KOGARAH


datum
AHD
site Area
5.179ha
LGA
KOGARAH

project number
33459
scale
1:500 @A1
OF 52 SHEETS

reference number
33459DT
date of survey
24/06/15
43

UNDERGROUND SERVICES - DETAIL & LEVELS
SEE SHEET 4 FOR ADDITIONAL DETAIL & LEVELS

SEE SHEET 1 FOR LEGEND AND NOTES
SEE SHEET 28 FOR SERVICE PIT DIAGRAMS

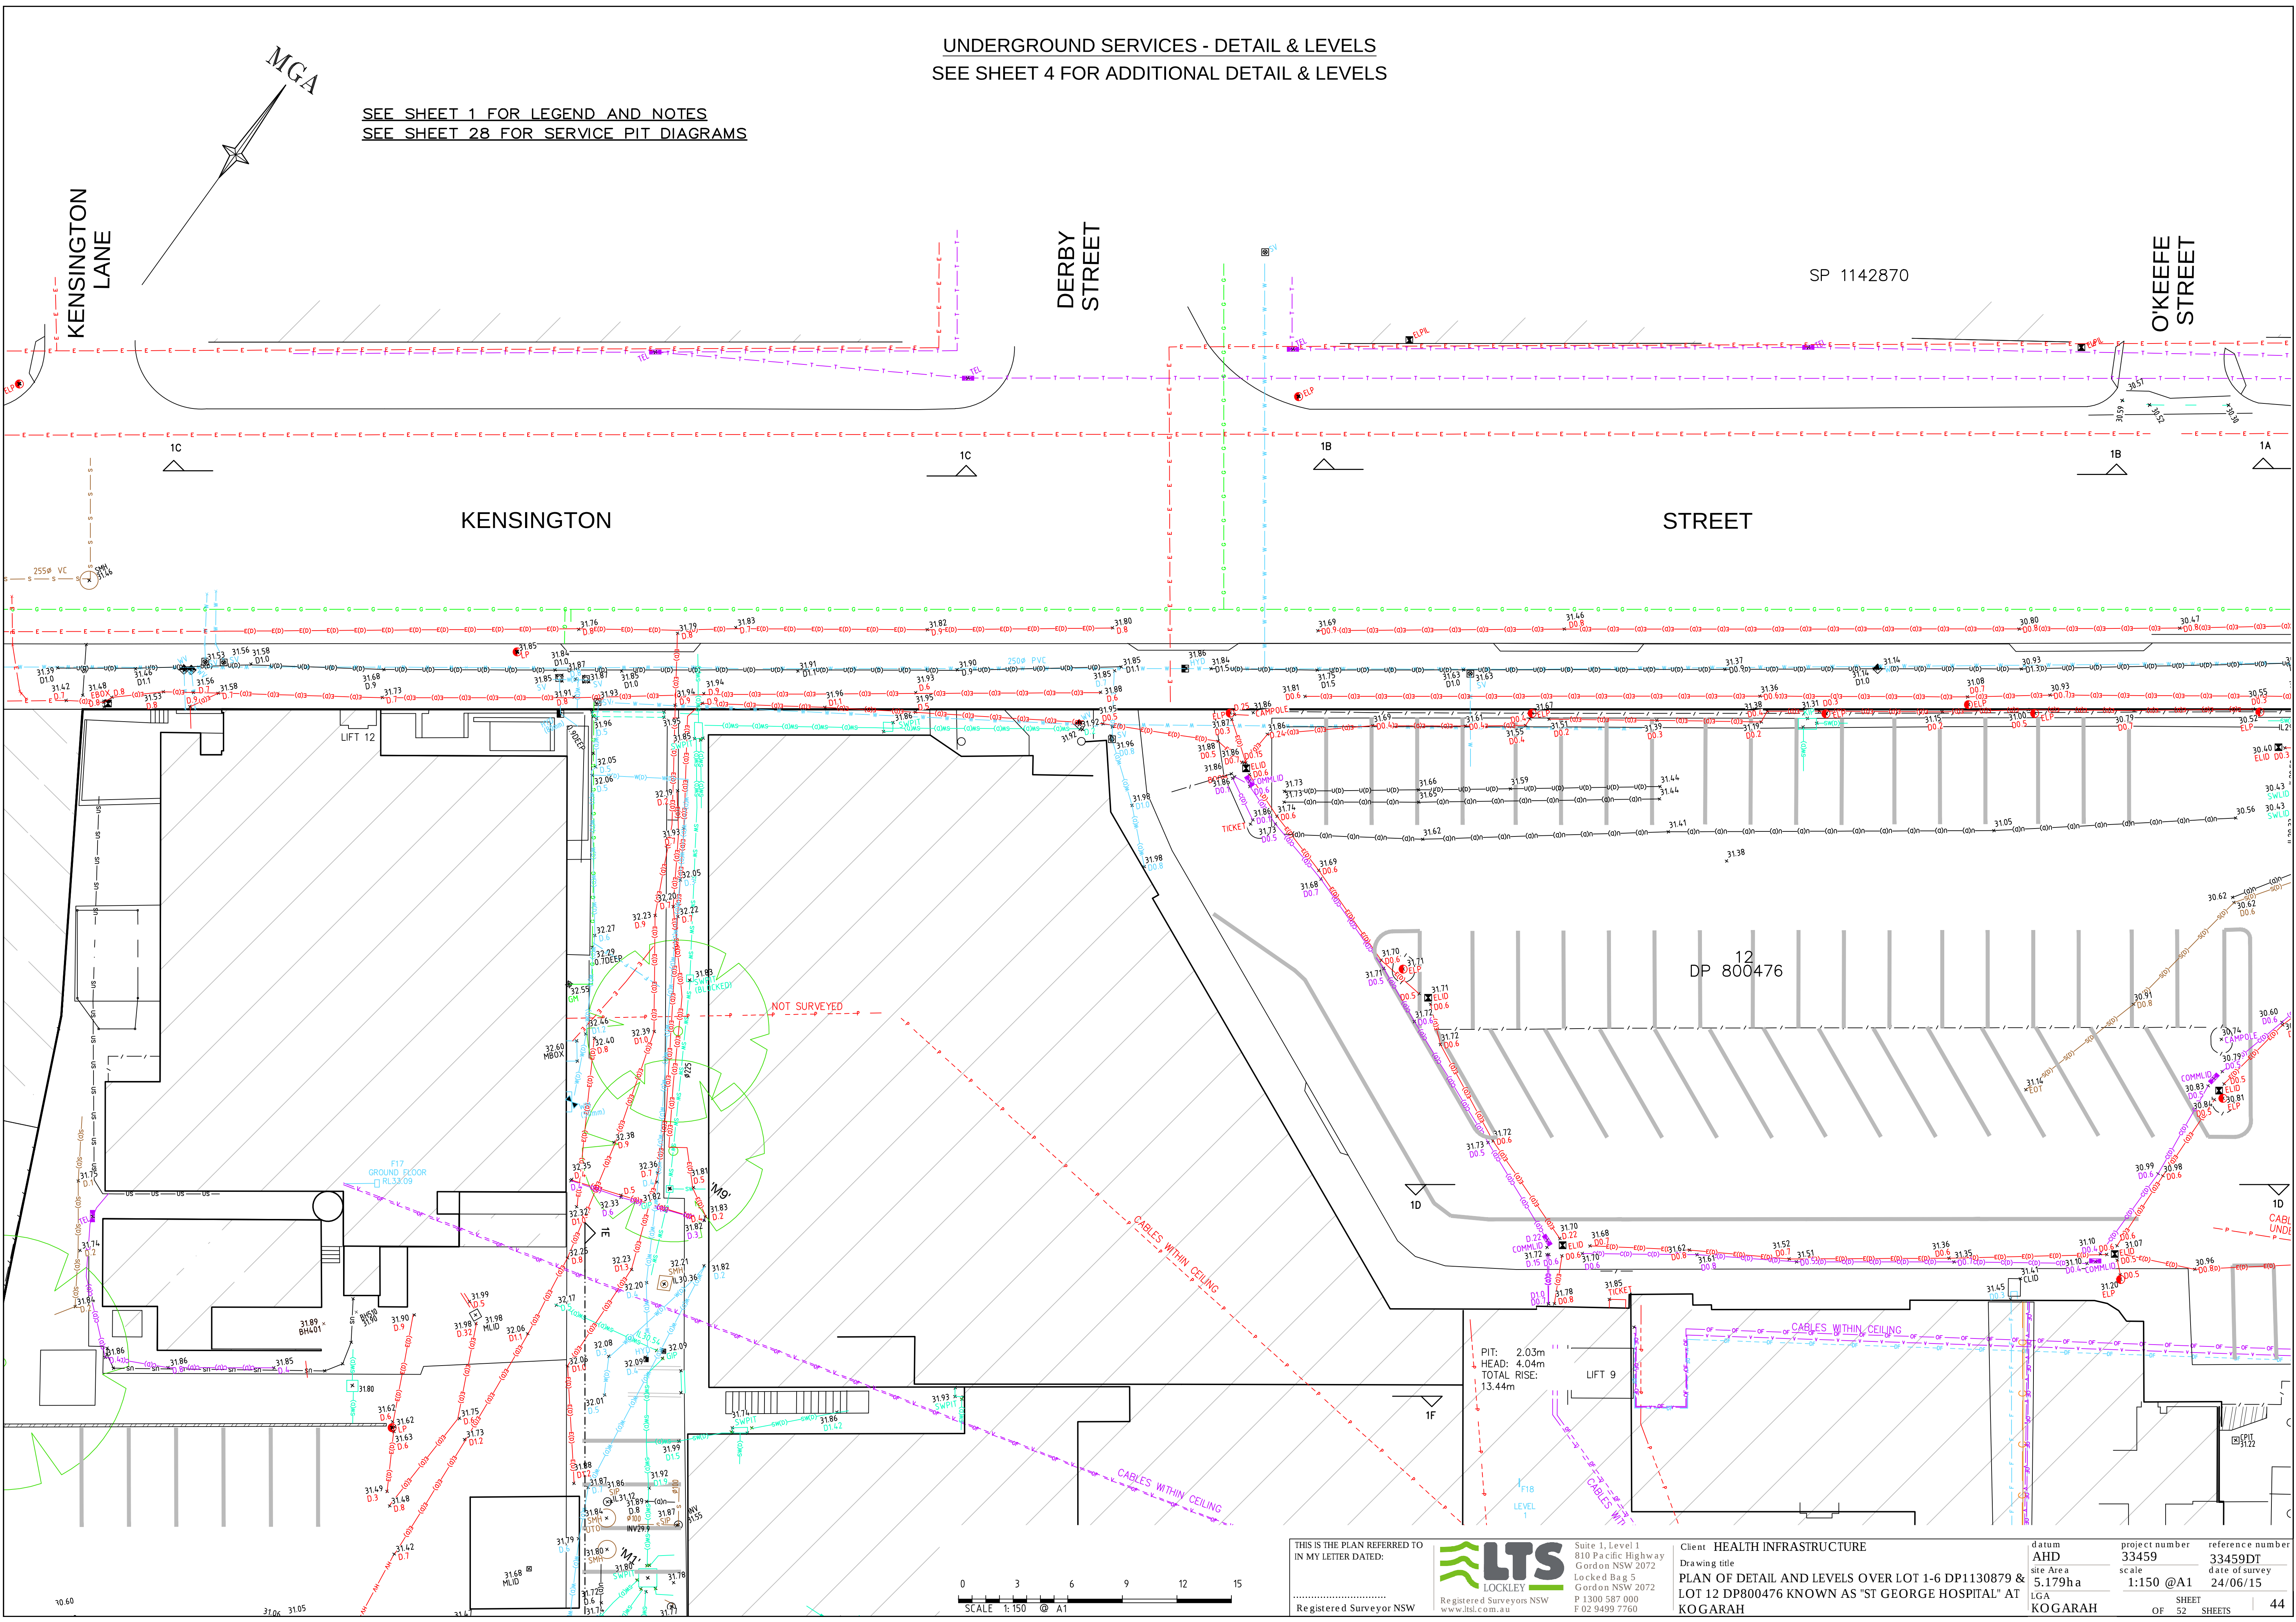

THIS IS THE PLAN REFERRED TO
IN MY LETTER DATED:

Registered Surveyor NSW

LTS
LOCKLEY
Registered Surveyors NSW
www.lts.com.au



Suite 1, Level 1
810 Pacific Highway
Gordon NSW 2072
Locked Bag 5
Gordon NSW 2072
P 1300 587 000
F 02 9499 7760

Client **HEALTH INFRASTRUCTURE**
Drawing title
**PLAN OF DETAIL AND LEVELS OVER LOT 1-6 DP1130879 &
LOT 12 DP800476 KNOWN AS "ST GEORGE HOSPITAL" AT
KOGARAH**


datum
AHD
site Area
5.179ha
LGA
KOGARAH

project number
33459
scale
1:150 @A1
sheet
52
reference number
33459DT
date of survey
24/06/15
OF SHEETS
44

UNDERGROUND SERVICES - DETAIL & LEVELS
SEE SHEET 5 FOR ADDITIONAL DETAIL & LEVELS

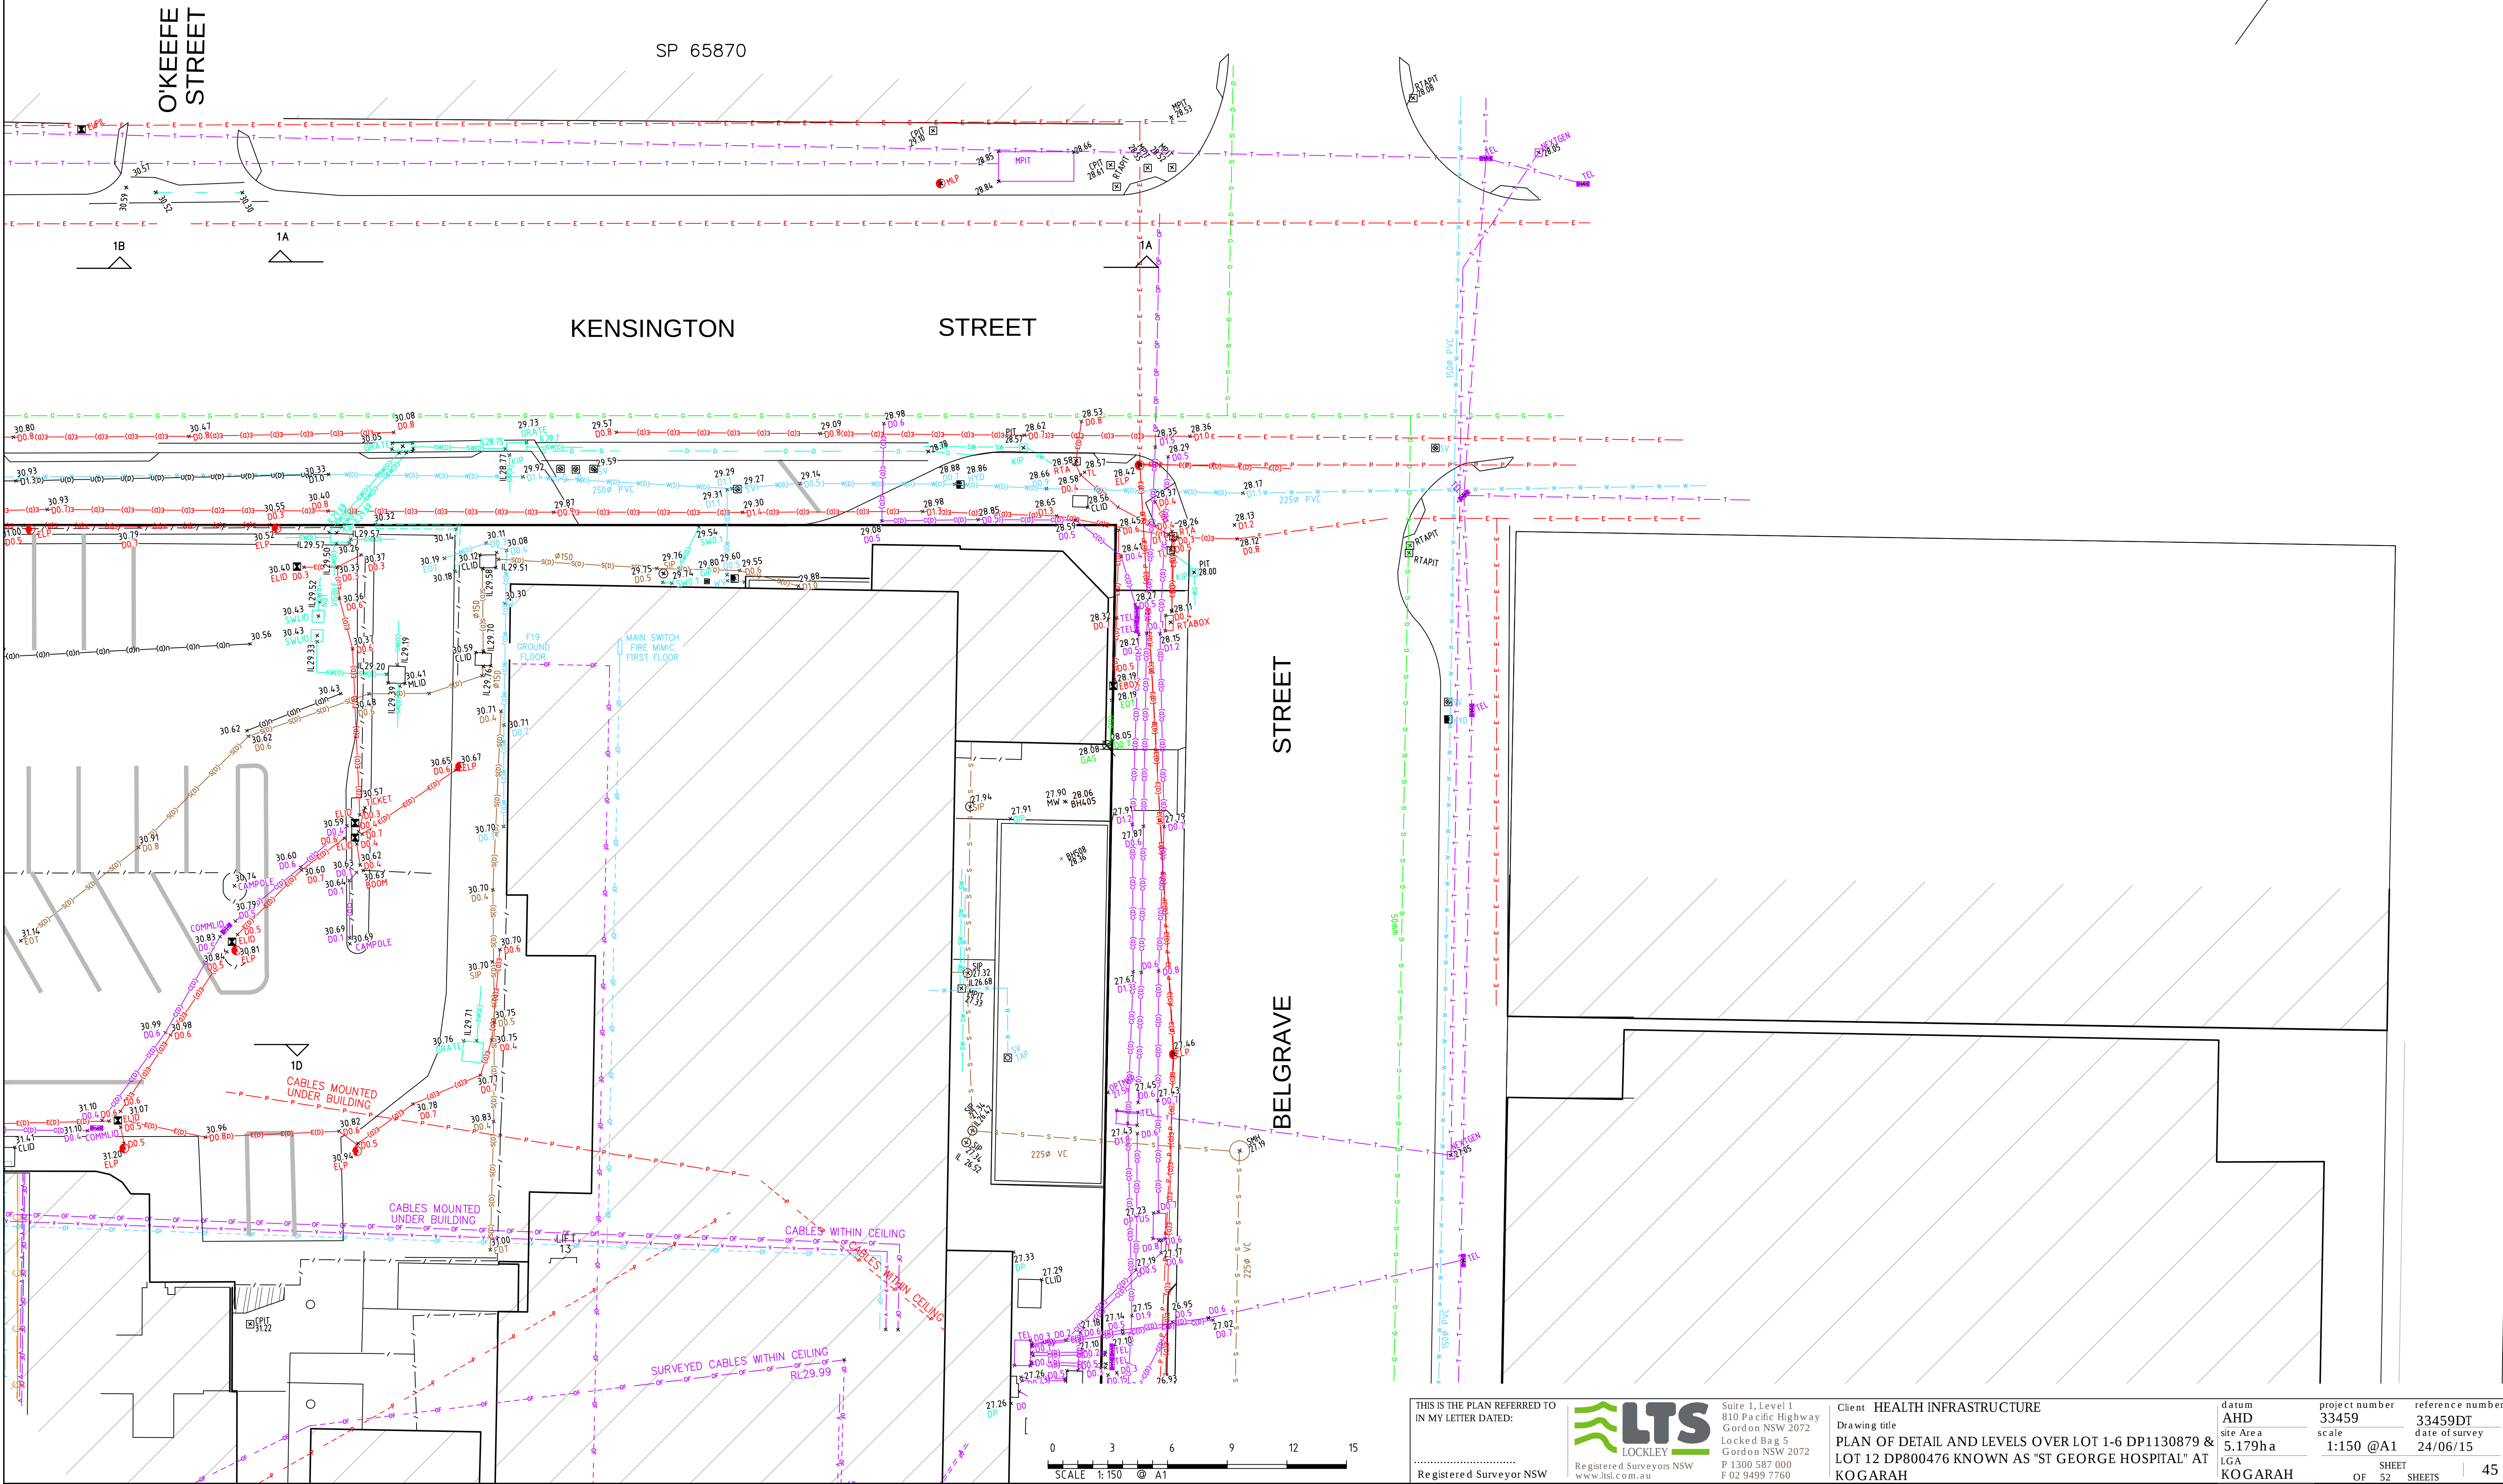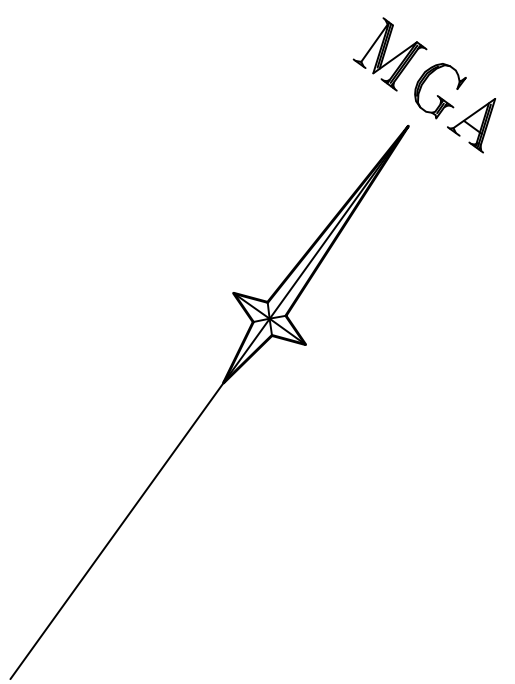

UNDERGROUND SERVICES - DETAIL & LEVELS
SEE SHEET 6 FOR ADDITIONAL DETAIL & LEVELS

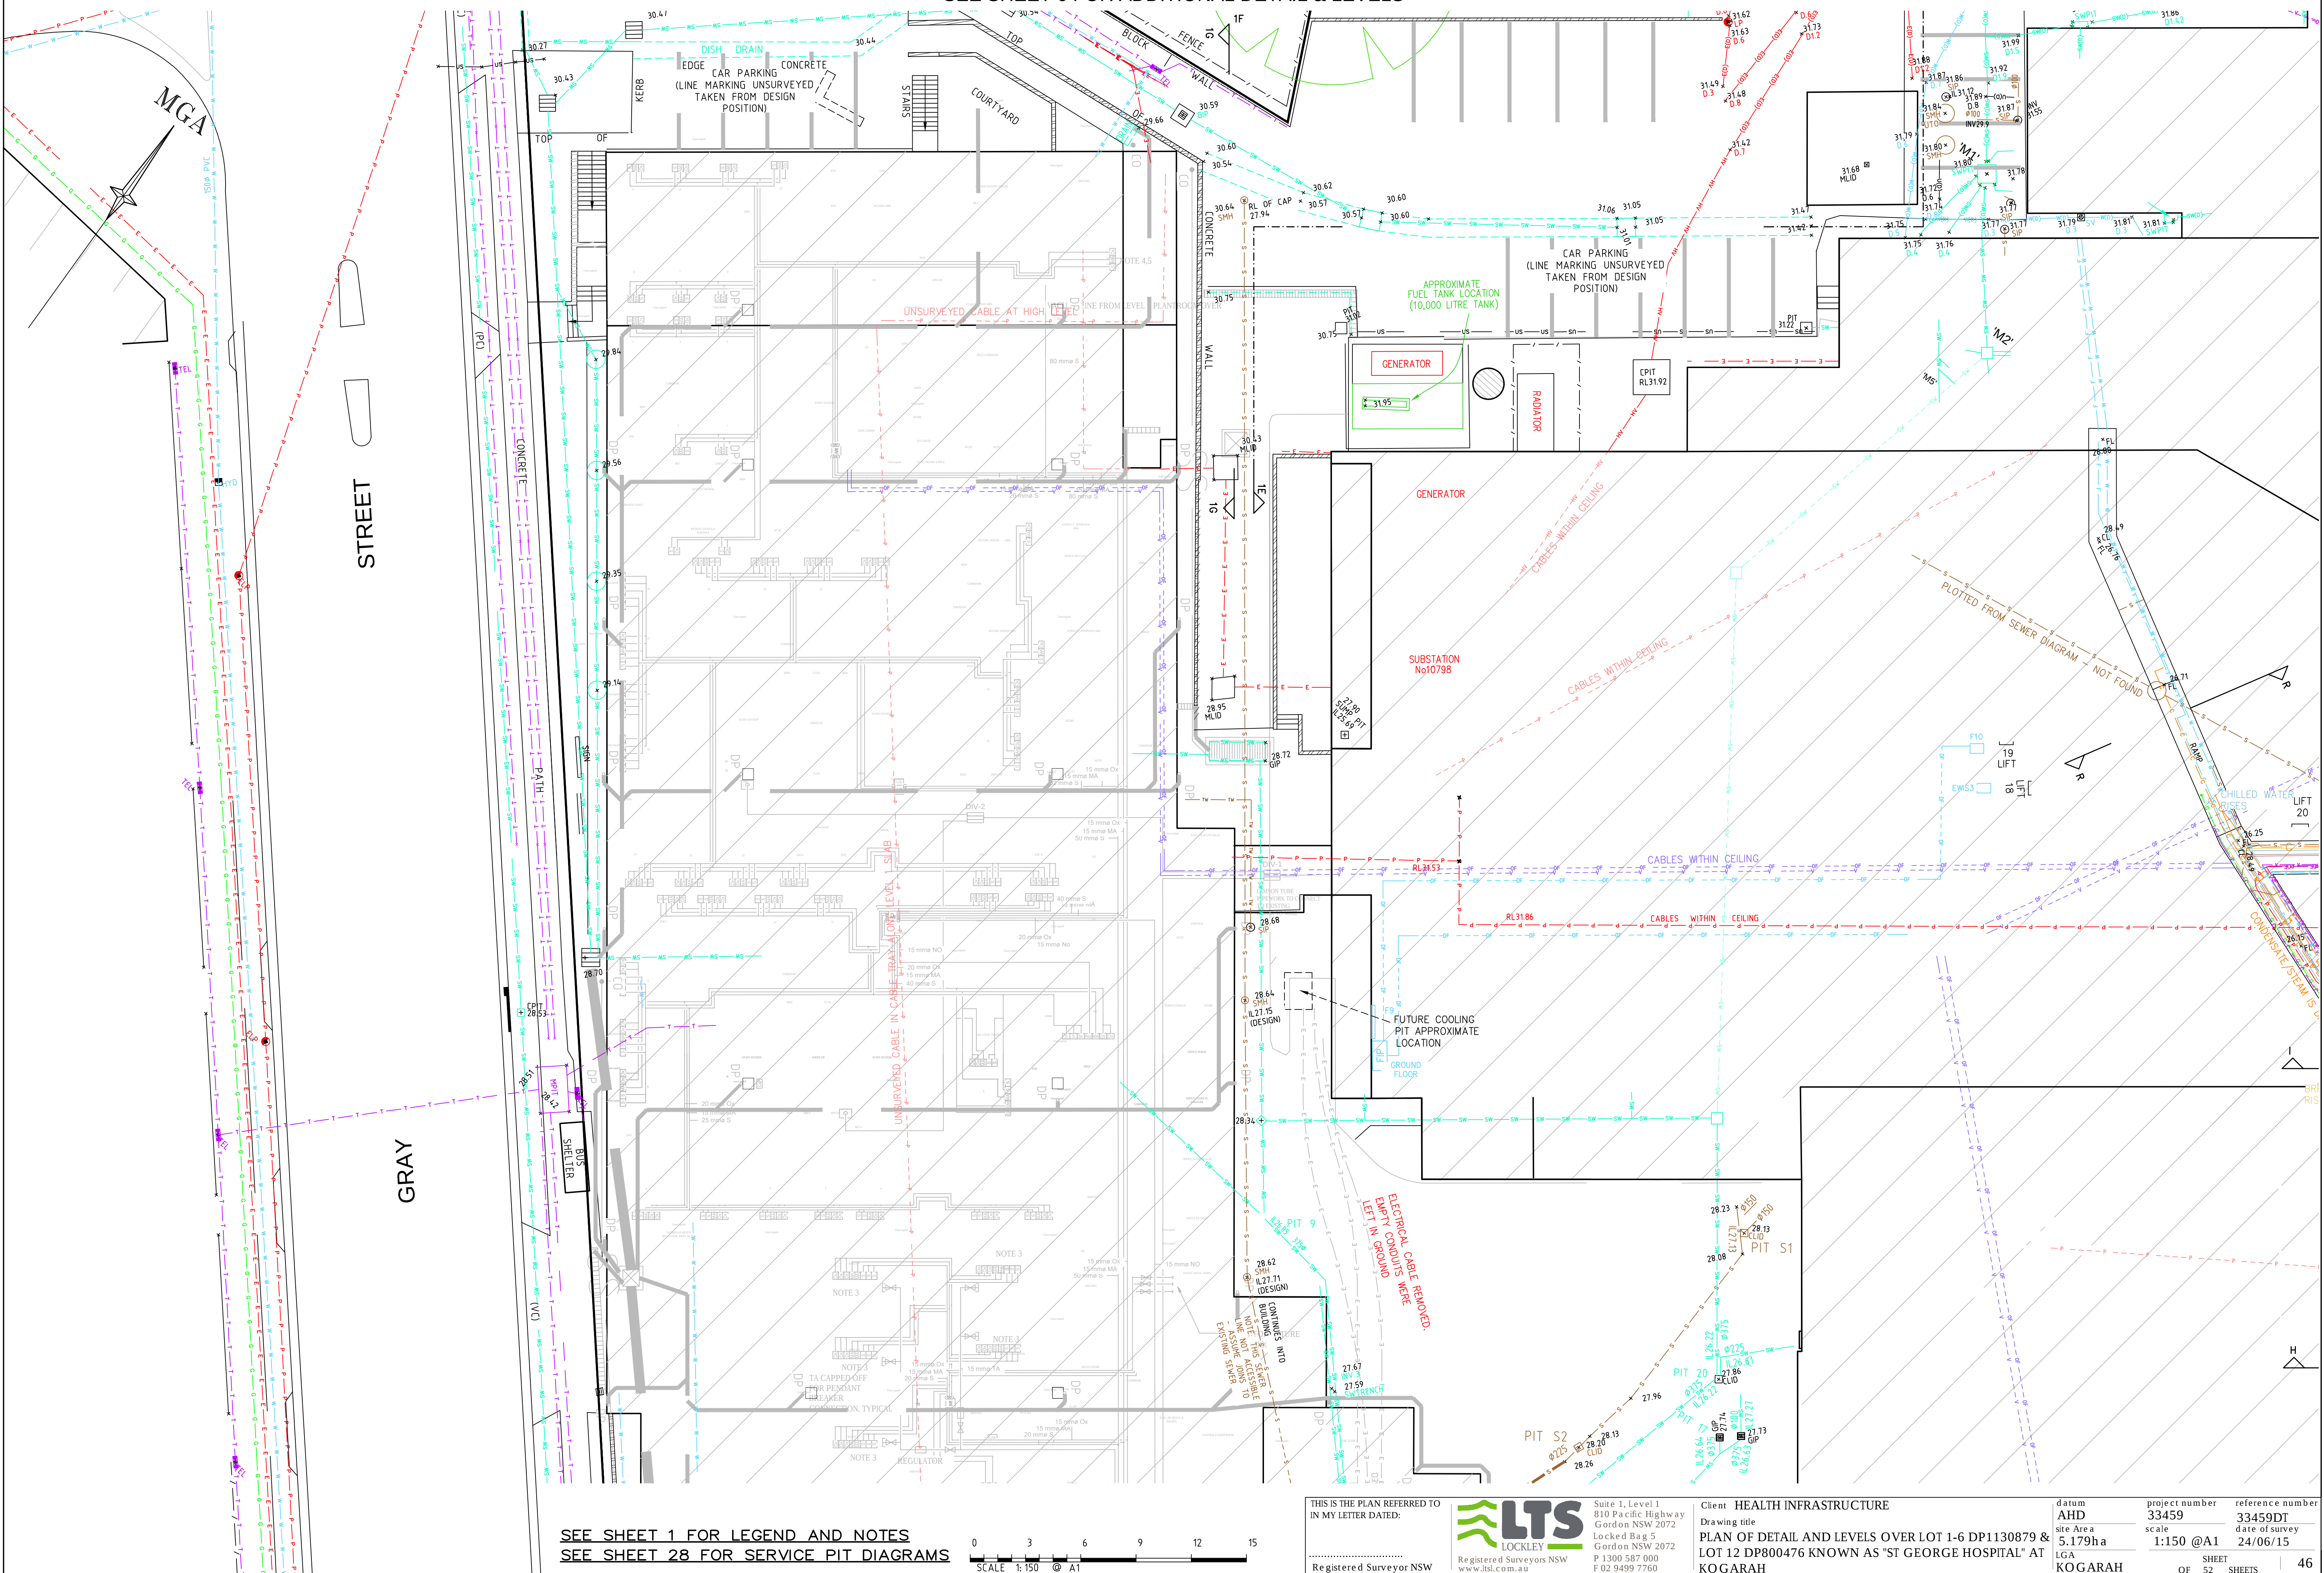

SEE SHEET 1 FOR LEGEND AND NOTES
SEE SHEET 28 FOR SERVICE PIT DIAGRAMS



THIS IS THE PLAN REFERRED TO
IN MY LETTER DATED:

Registered Surveyor NSW




Suite 1, Level 1
810 Pacific Highway
Gordon NSW 2072
Locked Bag 5
Gordon NSW 2072
P 1300 587 000
F 02 9499 7760

Client	HEALTH INFRASTRUCTURE
Drawing title	PLAN OF DETAIL AND LEVELS OVER LOT 1-6 DP1130879 & LOT 12 DP800476 KNOWN AS "ST GEORGE HOSPITAL" AT KOGARAH

datum	project number	reference number
AHD	33459	33459DT
site Area	scale	date of survey
5.179ha	1:150 @A1	24/06/15
LGA	SHEET	46
KOGARAH	OF 52 SHEETS	

UNDERGROUND SERVICES - DETAIL & LEVELS
SEE SHEET 7 FOR ADDITIONAL DETAIL & LEVELS

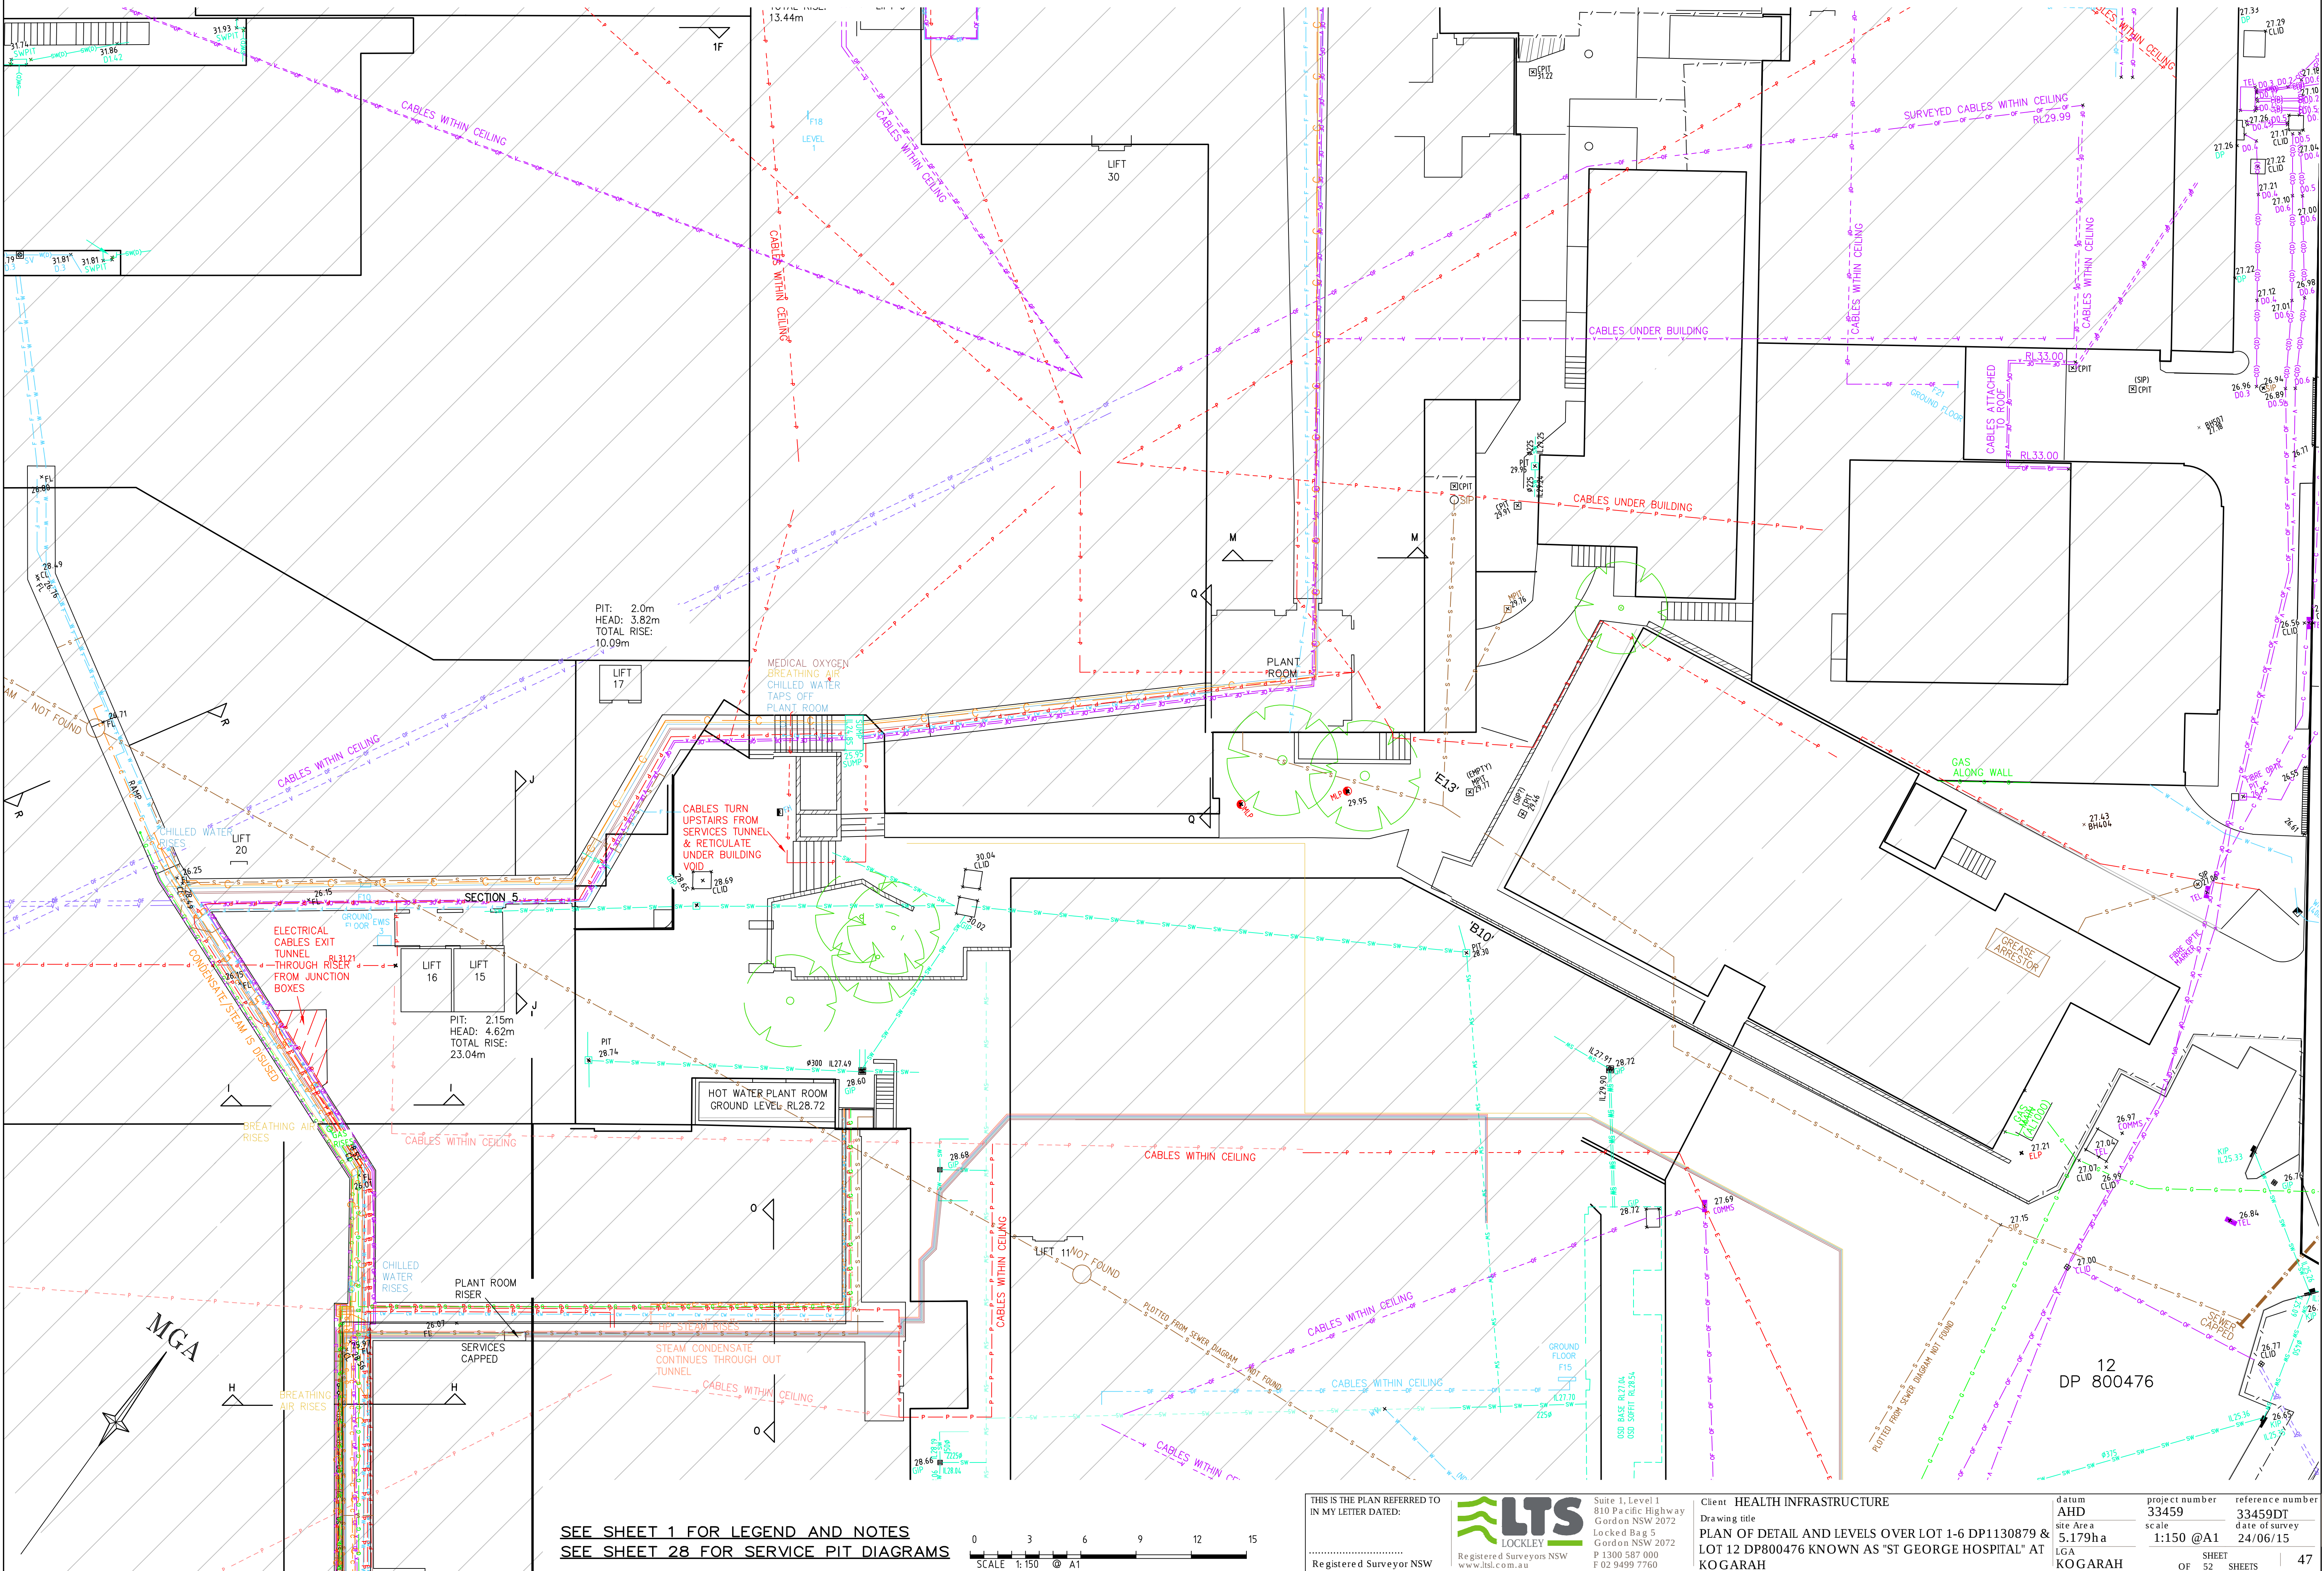

SEE SHEET 1 FOR LEGEND AND NOTES
SEE SHEET 28 FOR SERVICE PIT DIAGRAMS



THIS IS THE PLAN REFERRED TO
IN MY LETTER DATED:
.....
Registered Surveyor NSW

LTS
LOCKLEY
Registered Surveyors NSW
www.ltsl.com.au



Suite 1, Level 1
810 Pacific Highway
Gordon NSW 2072
Locked Bag 5
Gordon NSW 2072
P 1300 587 000
F 02 9499 7760

Client **HEALTH INFRASTRUCTURE**
Drawing title
**PLAN OF DETAIL AND LEVELS OVER LOT 1-6 DP1130879 &
LOT 12 DP800476 KNOWN AS "ST GEORGE HOSPITAL" AT
KOGARAH**

datum
AHD
site Area
5.179ha
LGA
KOGARAH

project number
33459
scale
1:150 @A1
OF 52 SHEETS

reference number
33459DT
date of survey
24/06/15
SHEETS
47

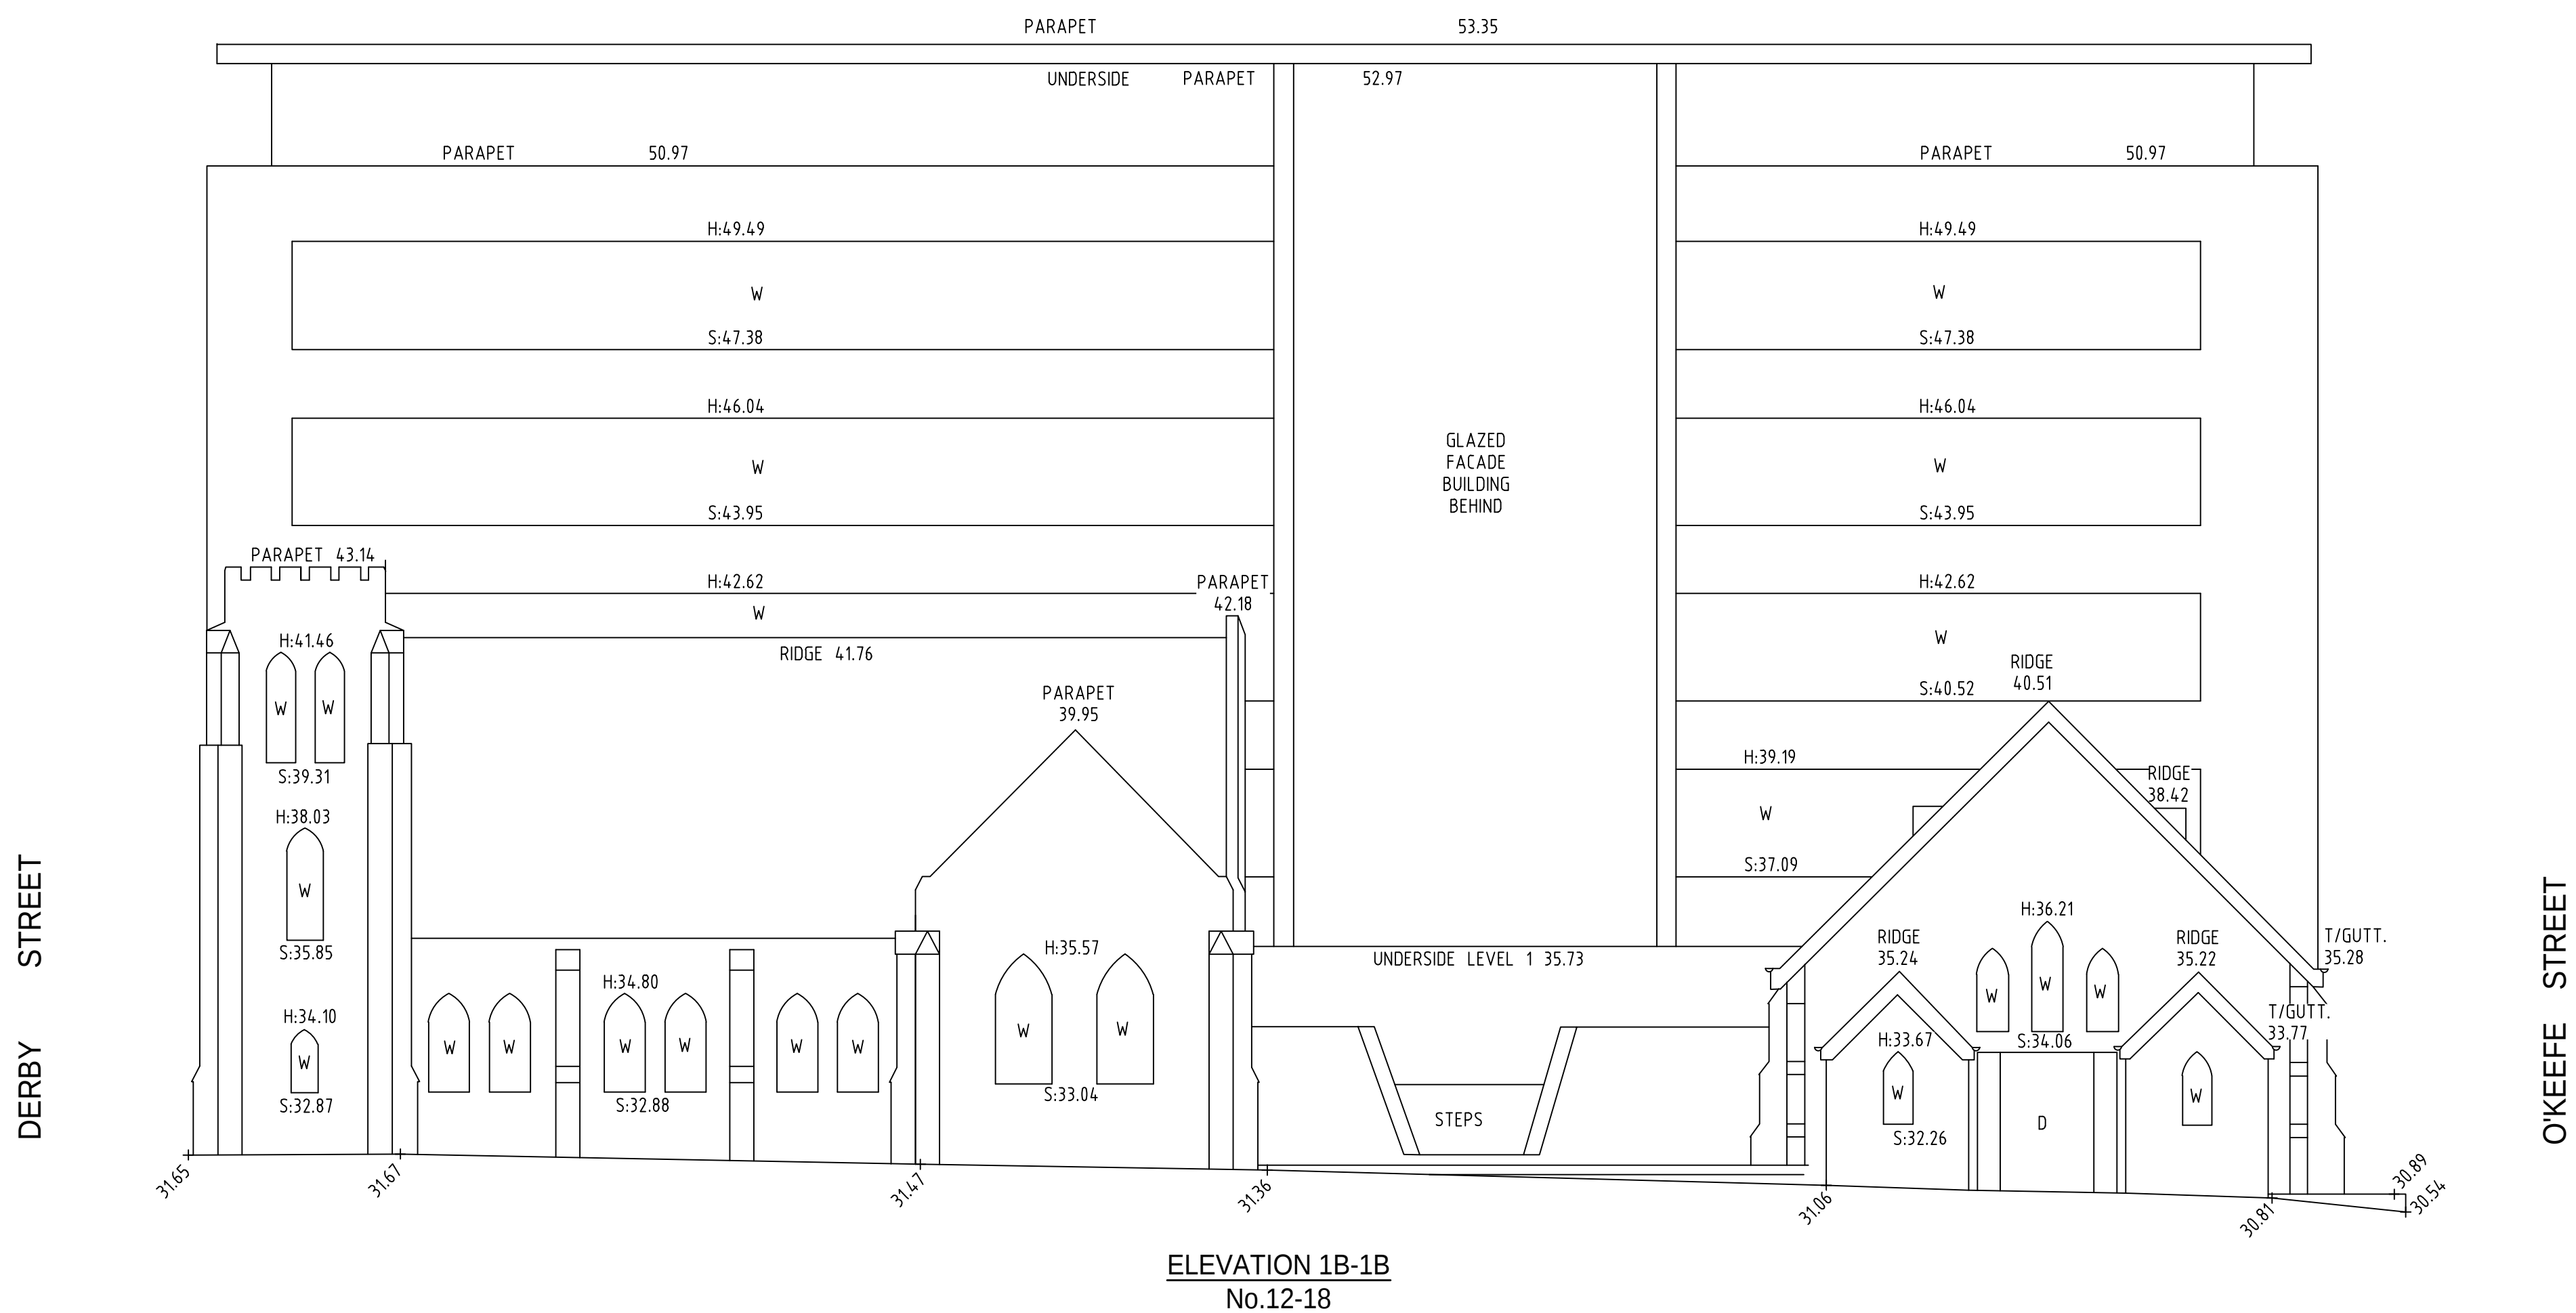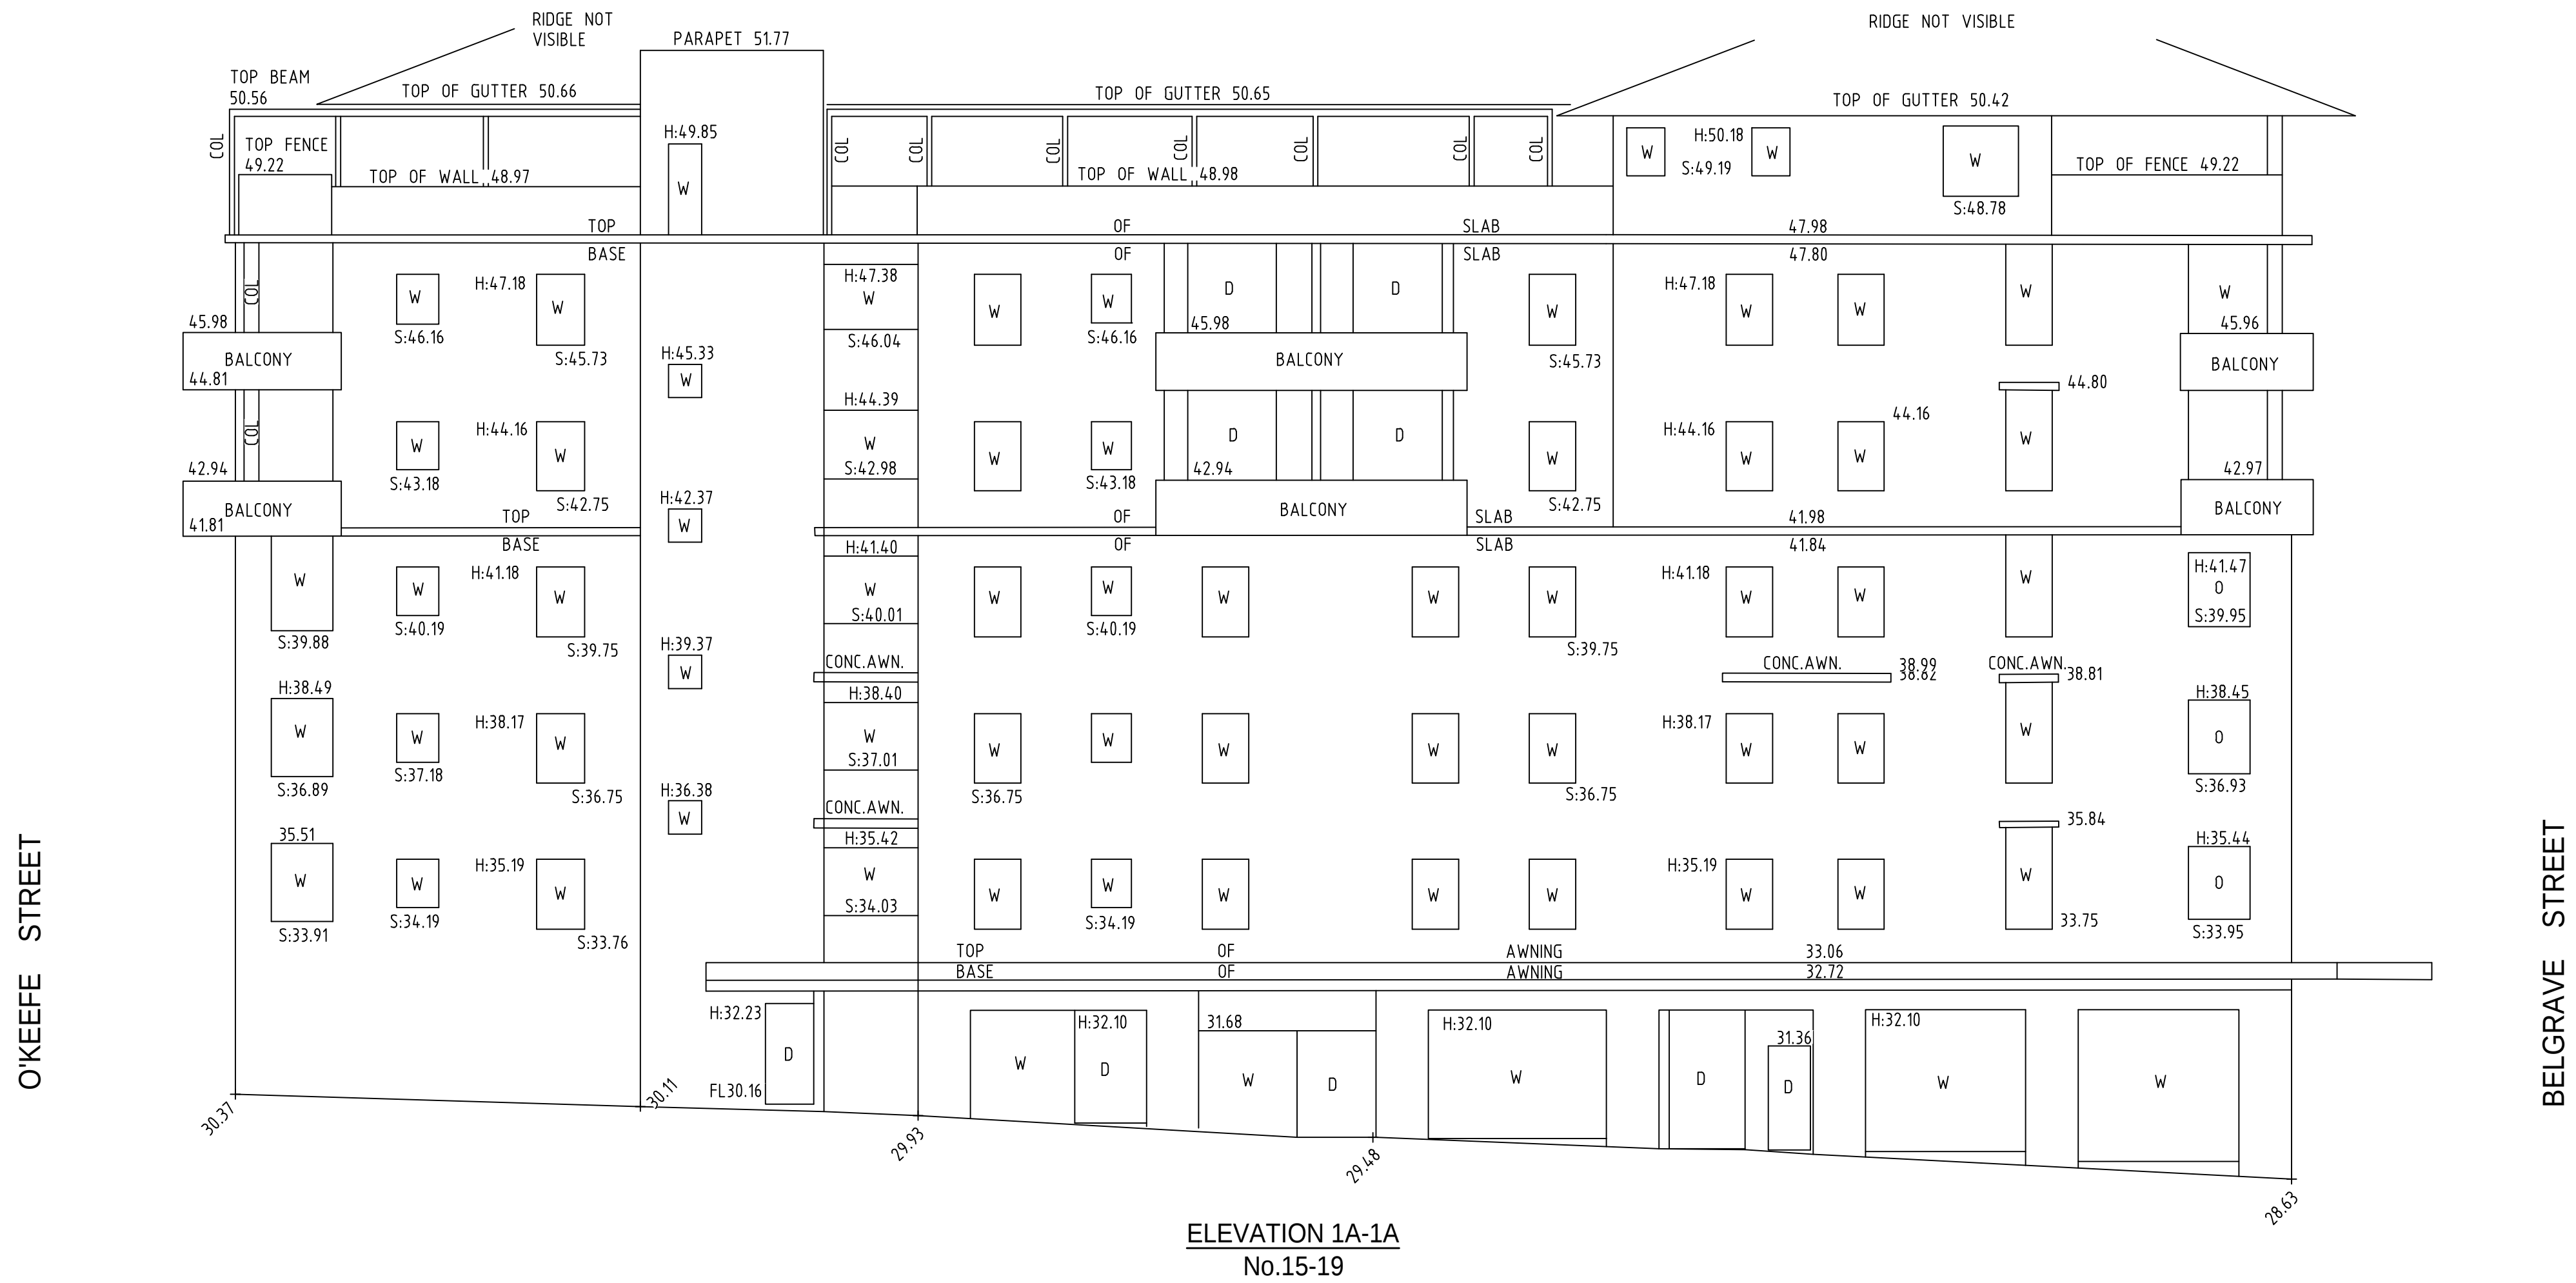

LEGEND

- W ~ WINDOW
D ~ DOOR
H ~ HEAD
S ~ SILL
O ~ OPENING
V ~ VENT

SEE SHEET 1 FOR LEGEND AND NOTES





THIS IS THE PLAN REFERRED TO
IN MY LETTER DATED:
.....
Registered Surveyor NSW



Client HEALTH INFRASTRUCTURE
Drawing title
PLAN OF DETAIL AND LEVELS OVER LOT 1-6 DP1130879 &
LOT 12 DP800476 KNOWN AS "ST GEORGE HOSPITAL" AT
KOGARAH

datum AHD	project number 33459	reference number 33459DT
site Area 5.179ha	scale 1:100 @A1	date of survey 24/06/15
LGA KOGARAH	SHEET 52	OF SHEETS

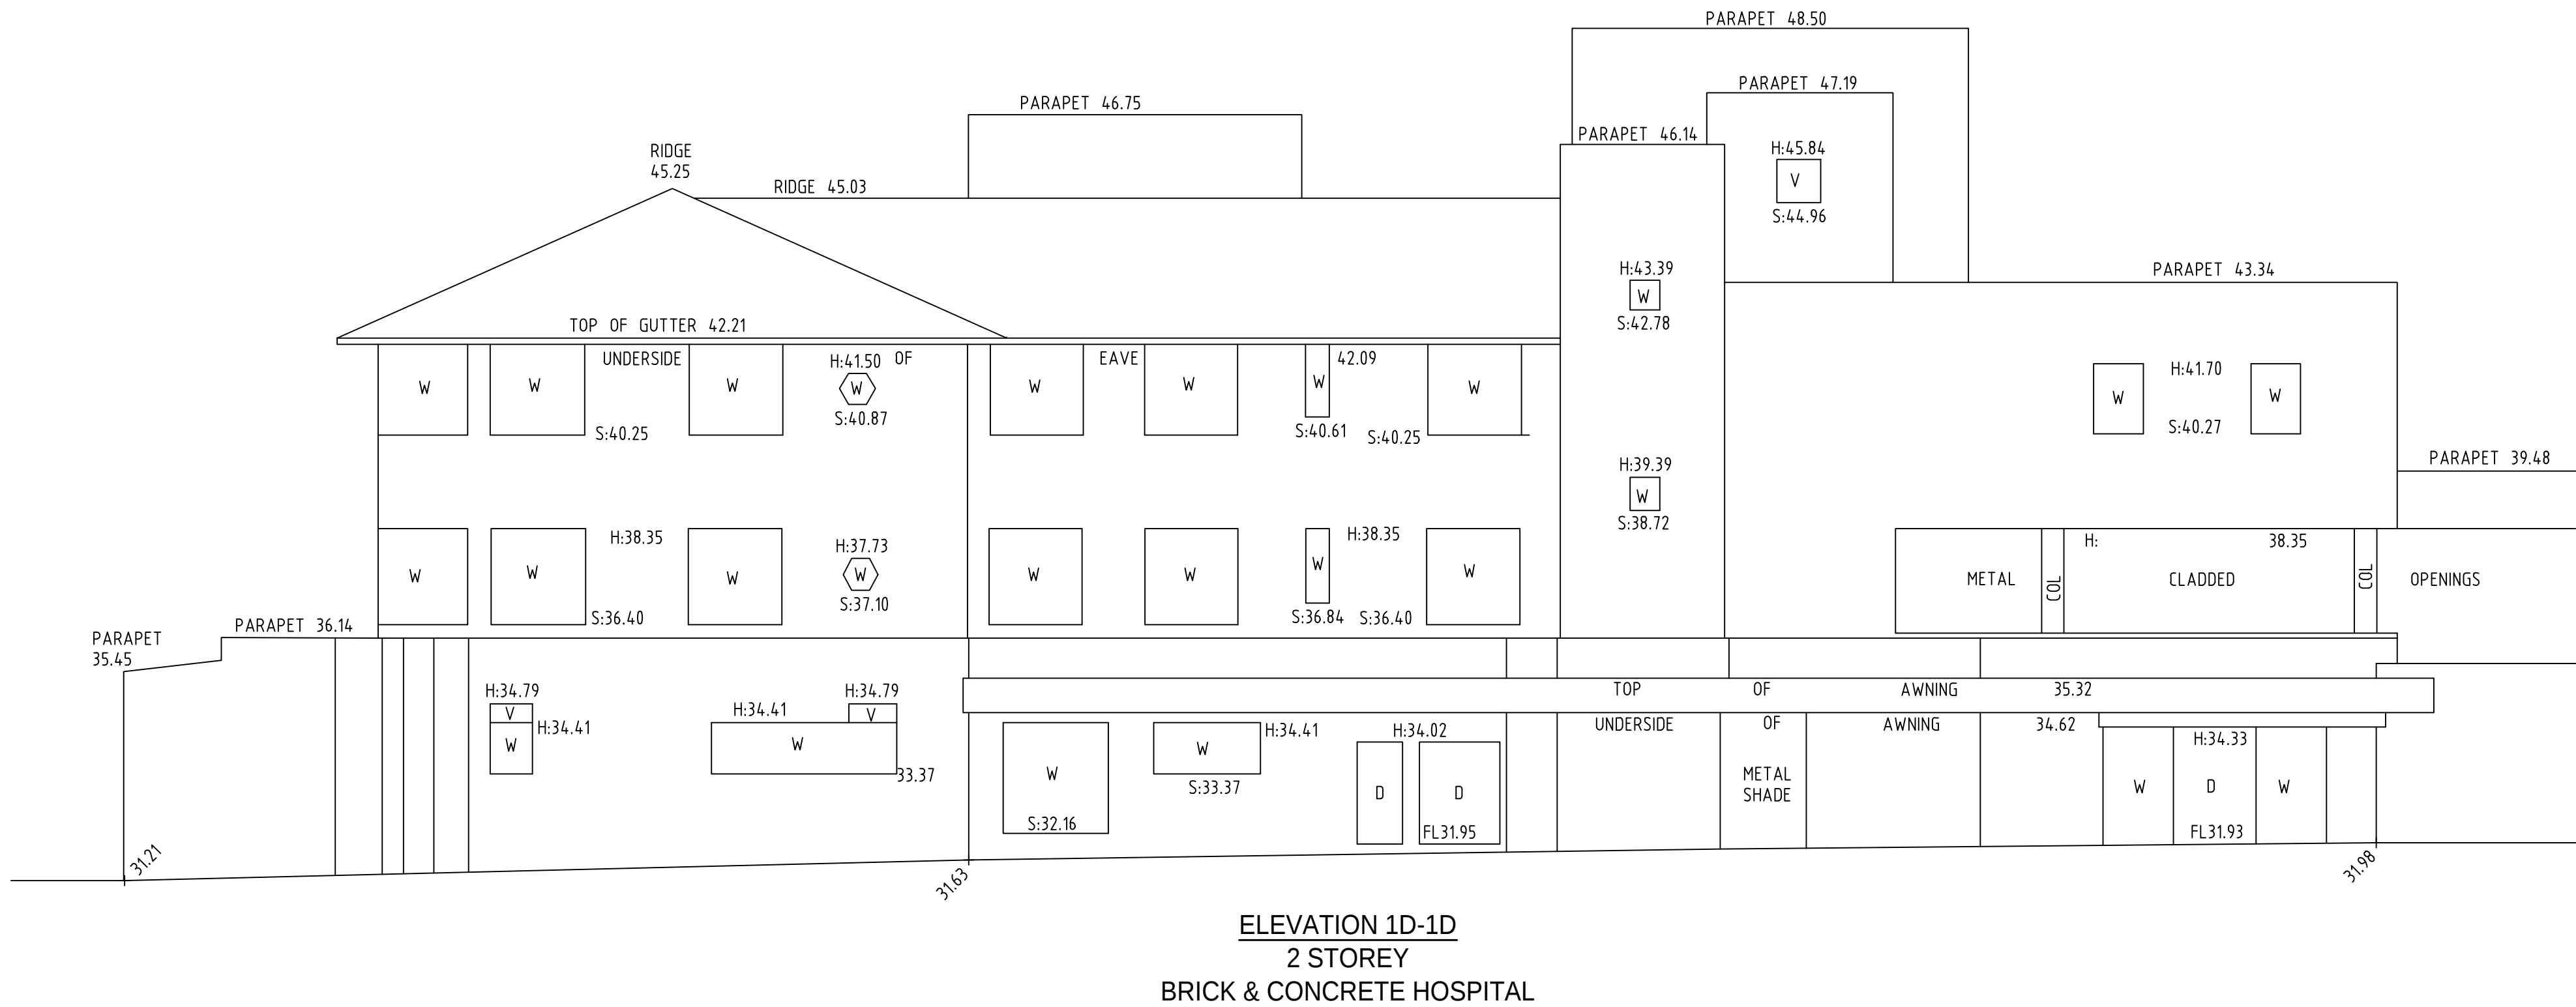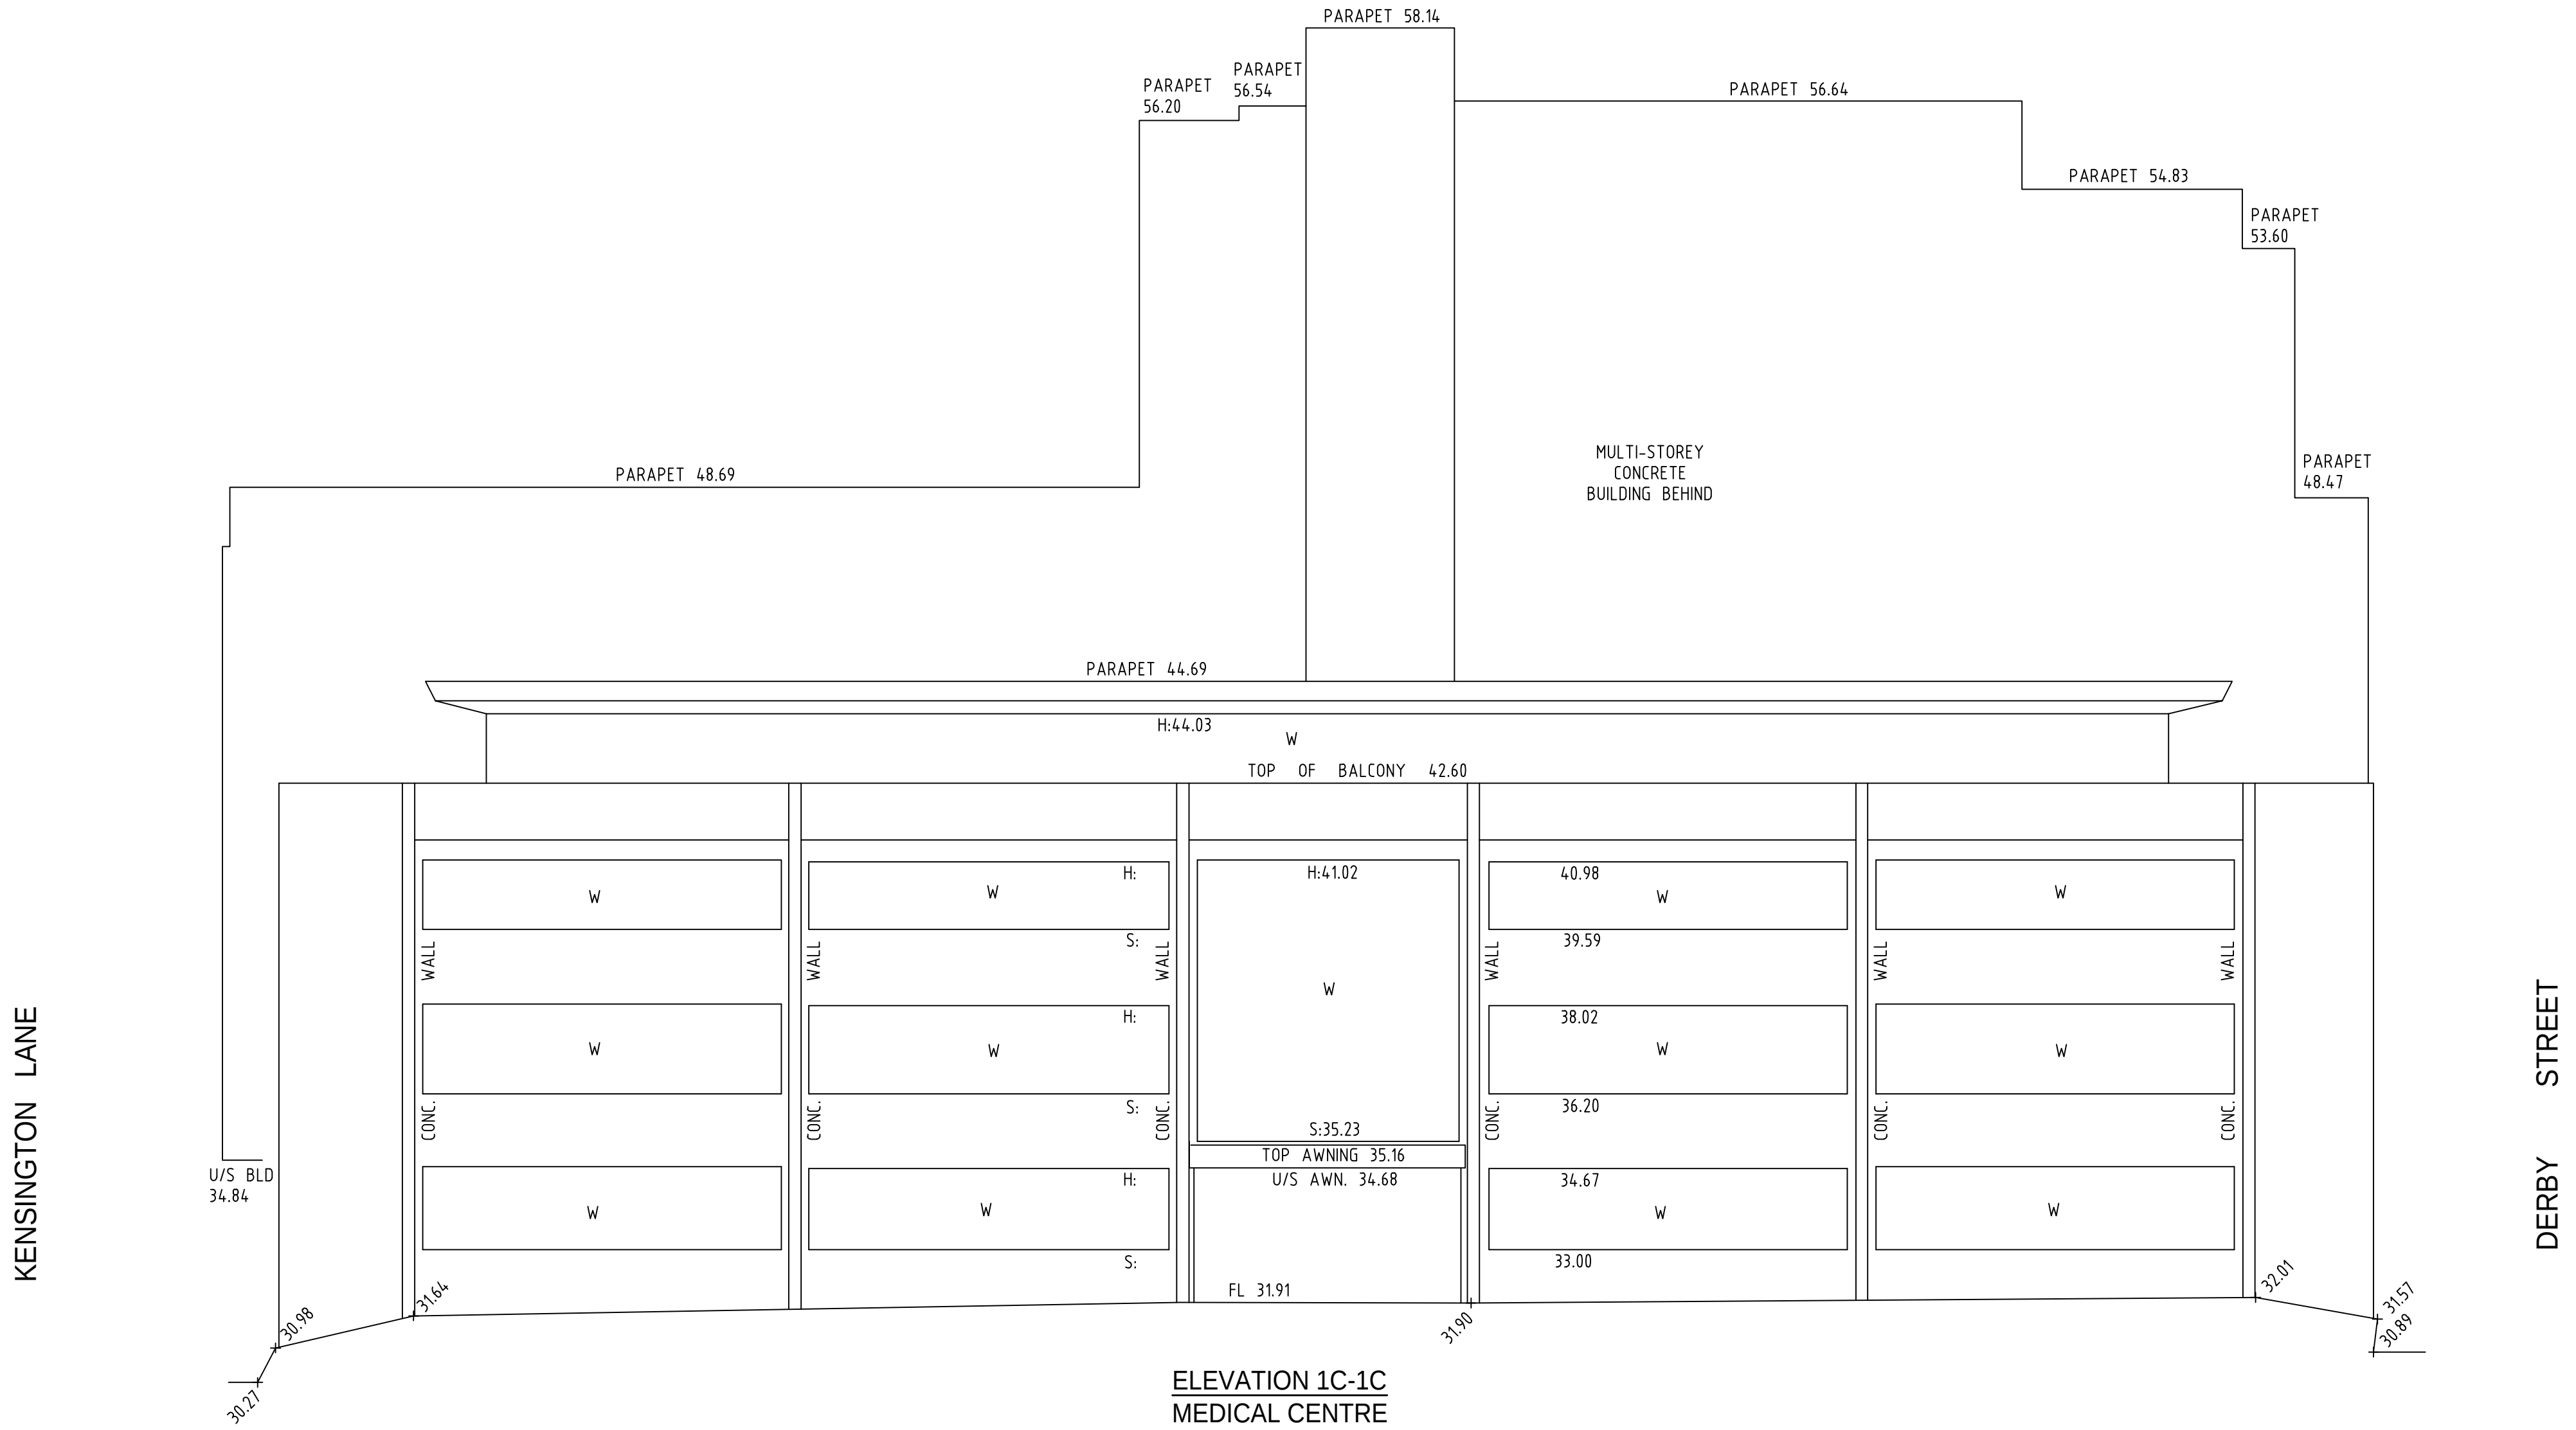

LEGEND

- W ~ WINDOW
- D ~ DOOR
- H ~ HEAD
- S ~ SILL
- O ~ OPENING
- V ~ VENT

SEE SHEET 1 FOR LEGEND AND NOTES



THIS IS THE PLAN REFERRED TO
IN MY LETTER DATED:
.....
Registered Surveyor NSW




Suite 1, Level 1
810 Pacific Highway
Gordon NSW 2072
Locked Bag 5
Gordon NSW 2072
P 1300 587 000
F 02 9499 7760

Client HEALTH INFRASTRUCTURE
Drawing title
PLAN OF DETAIL AND LEVELS OVER LOT 1-6 DP1130879 &
LOT 12 DP800476 KNOWN AS "ST GEORGE HOSPITAL" AT
KOGARAH


datum
AHD
site Area
5.179ha
LGA
KOGARAH

project number
33459
scale
1:100 @A1
OF 52 SHEETS

reference number
33459DT
date of survey
24/06/15
50

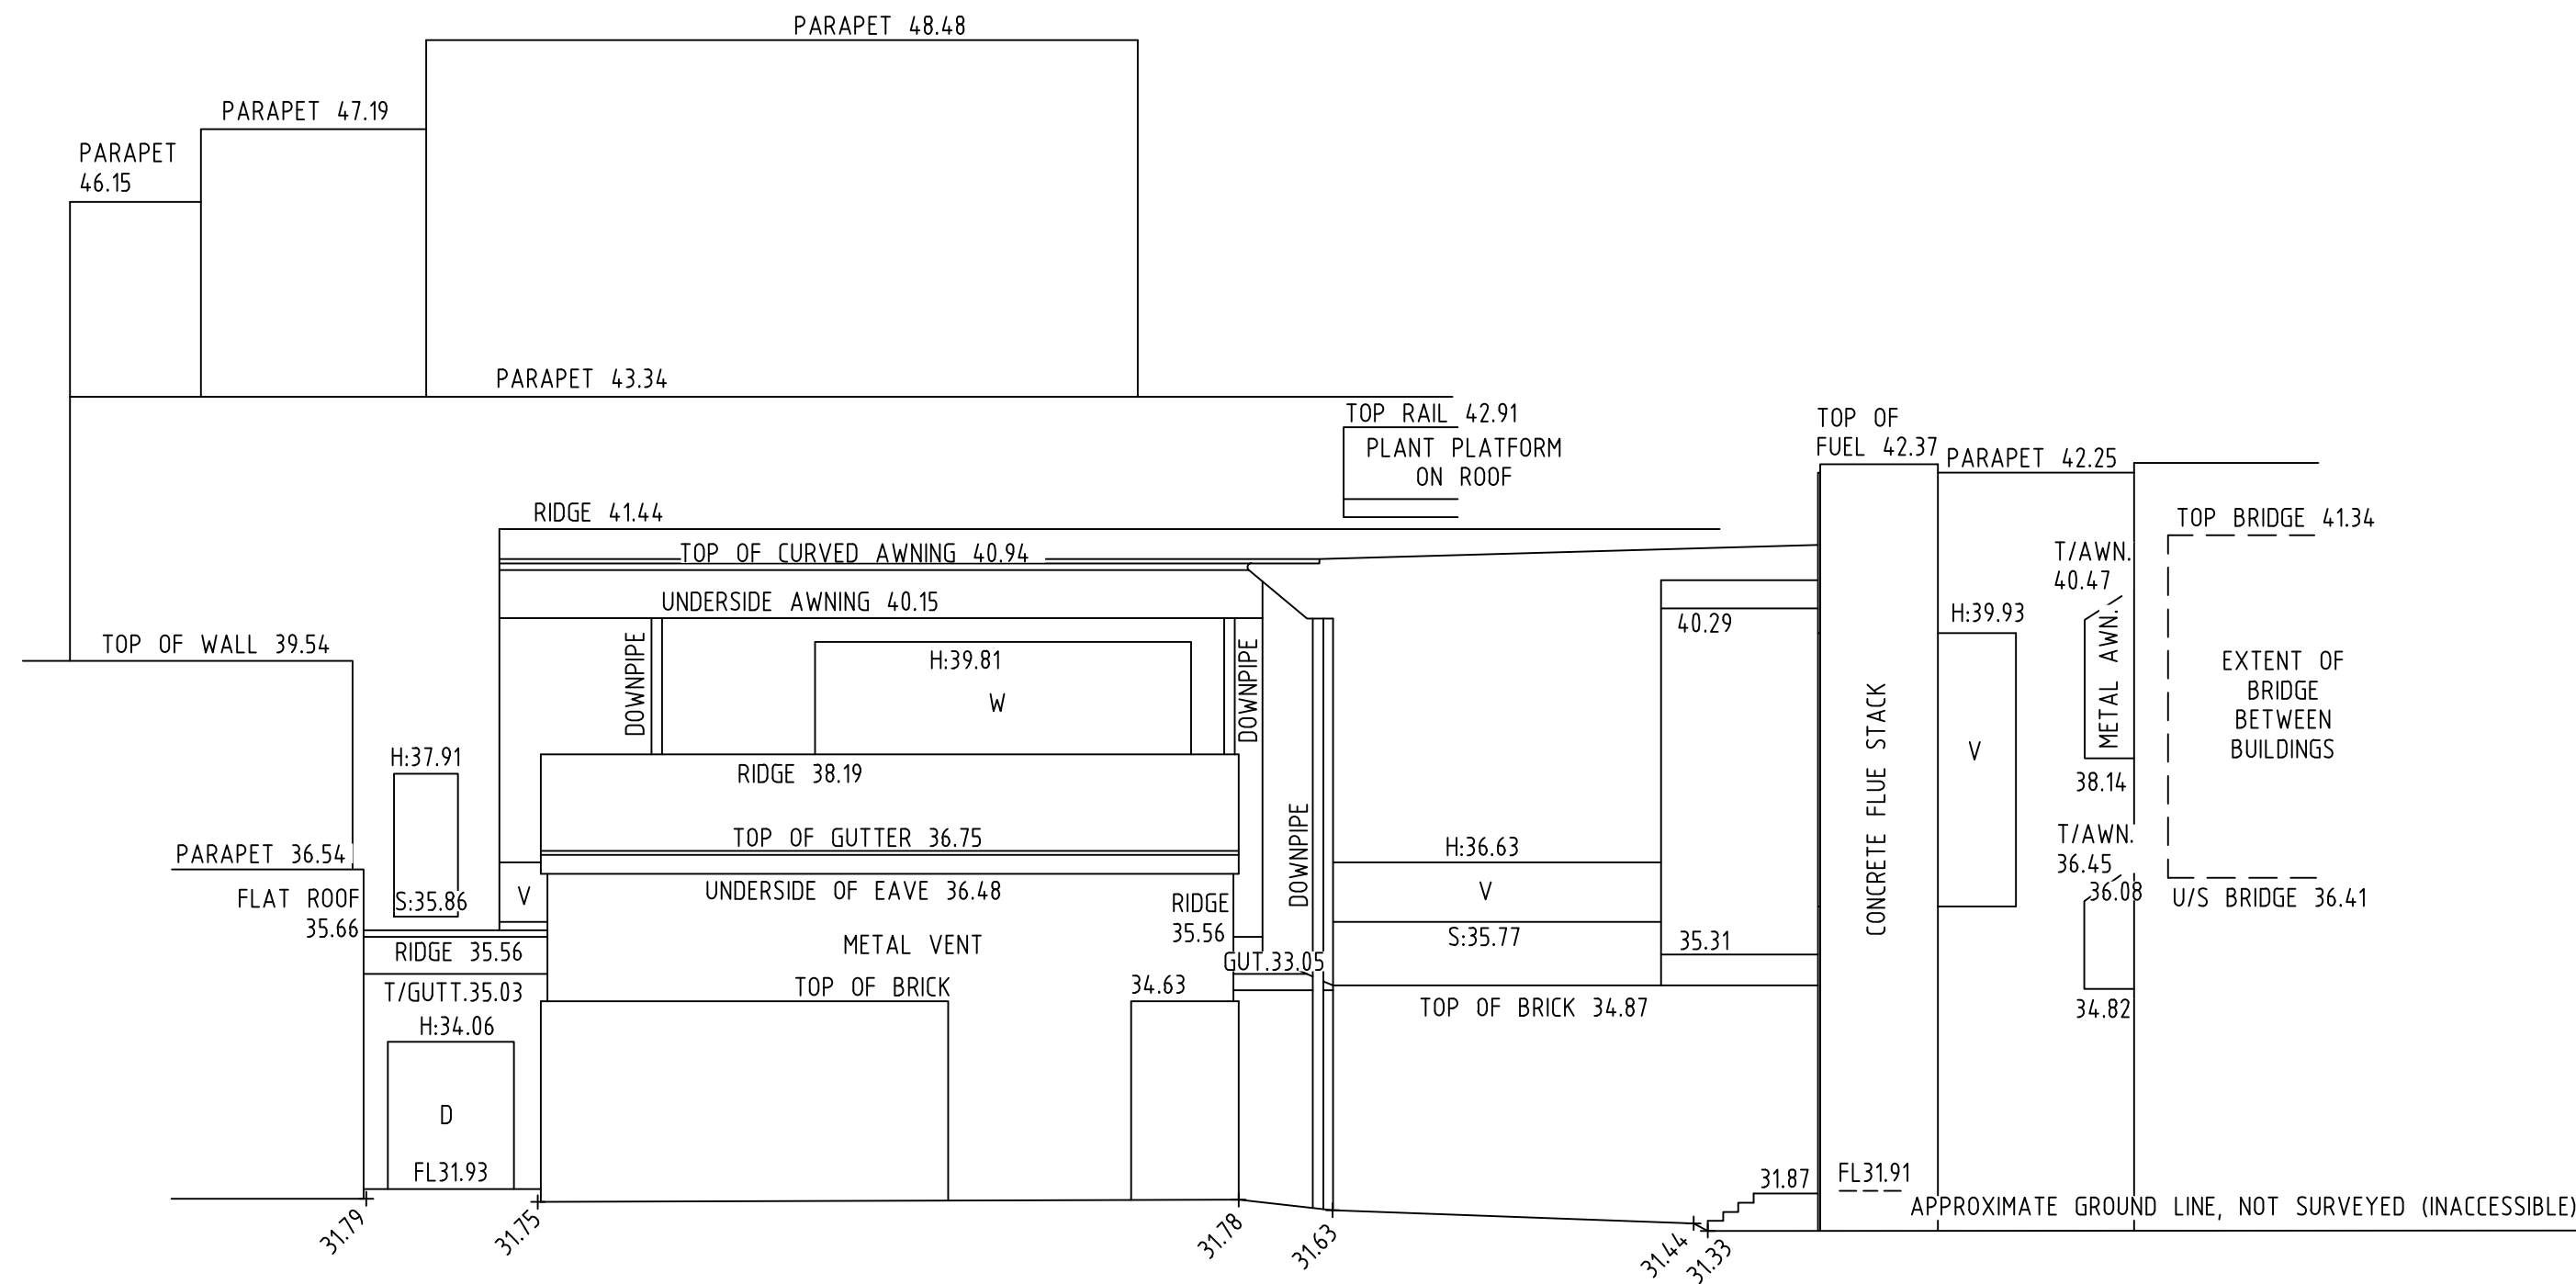

ELEVATION 1E-1E
HOSPITAL STAFF CAR PARK

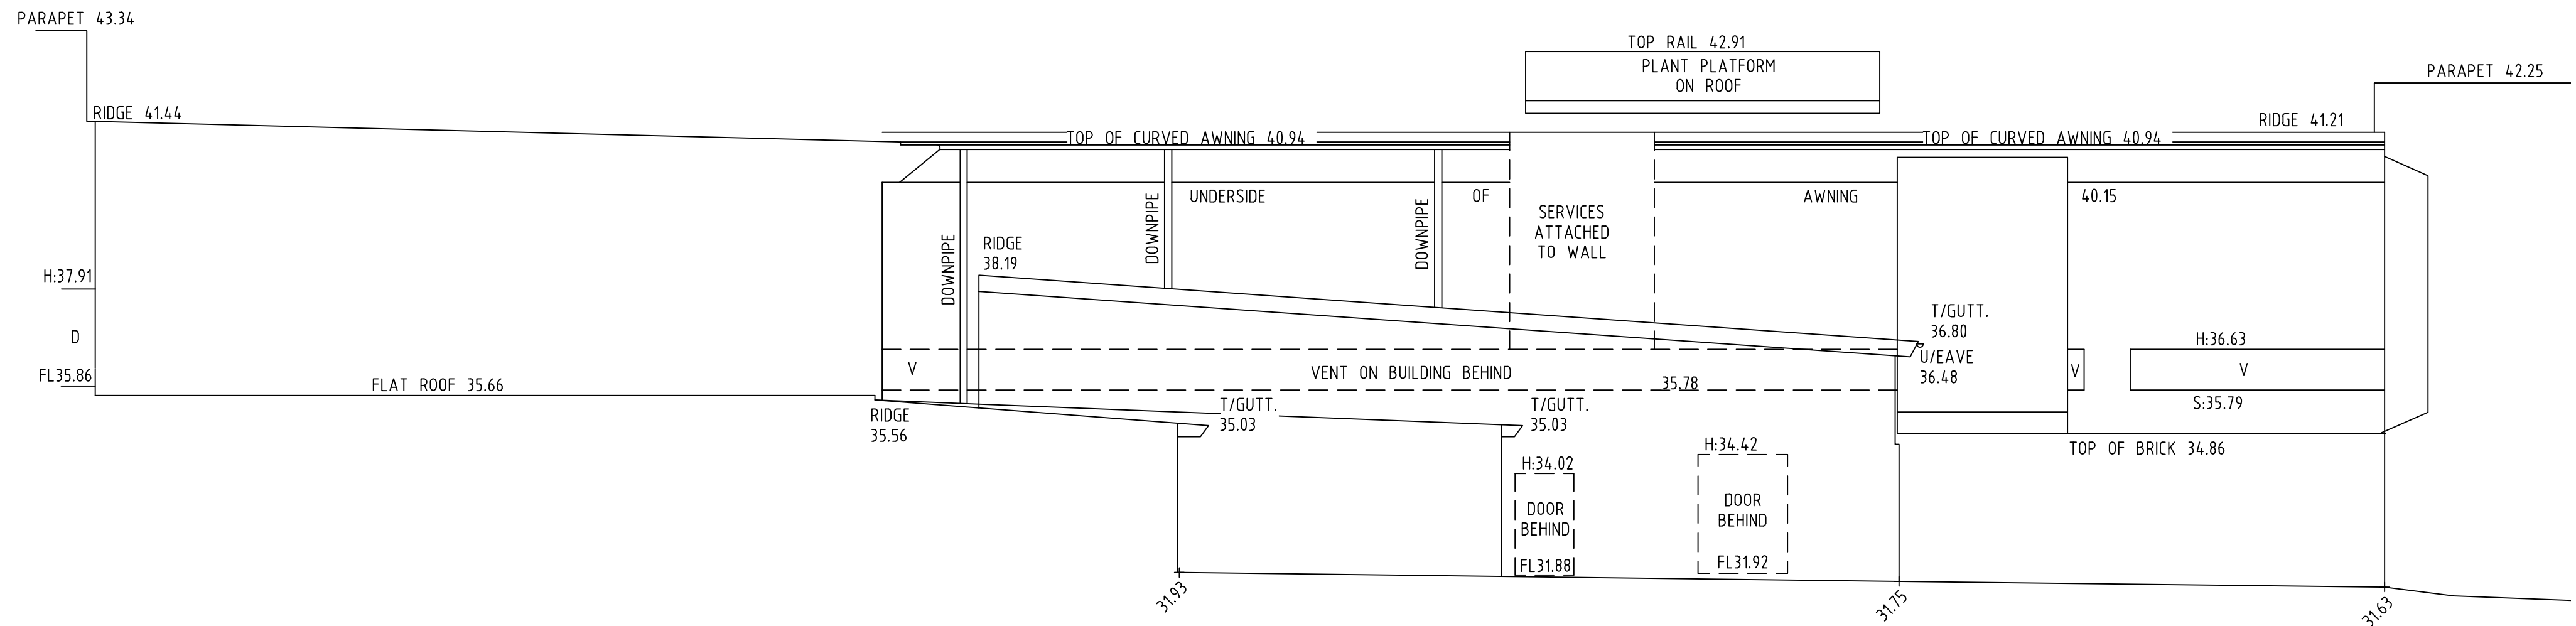

ELEVATION 1F-1F
MULTI-LEVEL BRICK & GYROCK
HOSPITAL

LEGEND

W ~ WINDOW
D ~ DOOR
H ~ HEAD
S ~ SILL
O ~ OPENING
V ~ VENT

SEE SHEET 1 FOR LEGEND AND NOTES



THIS IS THE PLAN REFERRED TO
IN MY LETTER DATED:

Registered Surveyor NSW



Suite 1, Level 1
810 Pacific Highway
Gordon NSW 2072
Locked Bag 5
Gordon NSW 2072
P 1300 587 000
F 02 9499 7760

Client HEALTH INFRASTRUCTURE

Drawing title

PLAN OF DETAIL AND LEVELS OVER LOT 1-6 DP1130879 &
LOT 12 DP800476 KNOWN AS "ST GEORGE HOSPITAL" AT
KOGARAH


datum
AHD
site Area
5.179ha
LGA
KOGARAH

project number
33459
scale
1:100 @A1

reference number
33459DT
date of survey
24/06/15

SHEET
52 OF 52 SHEETS

51

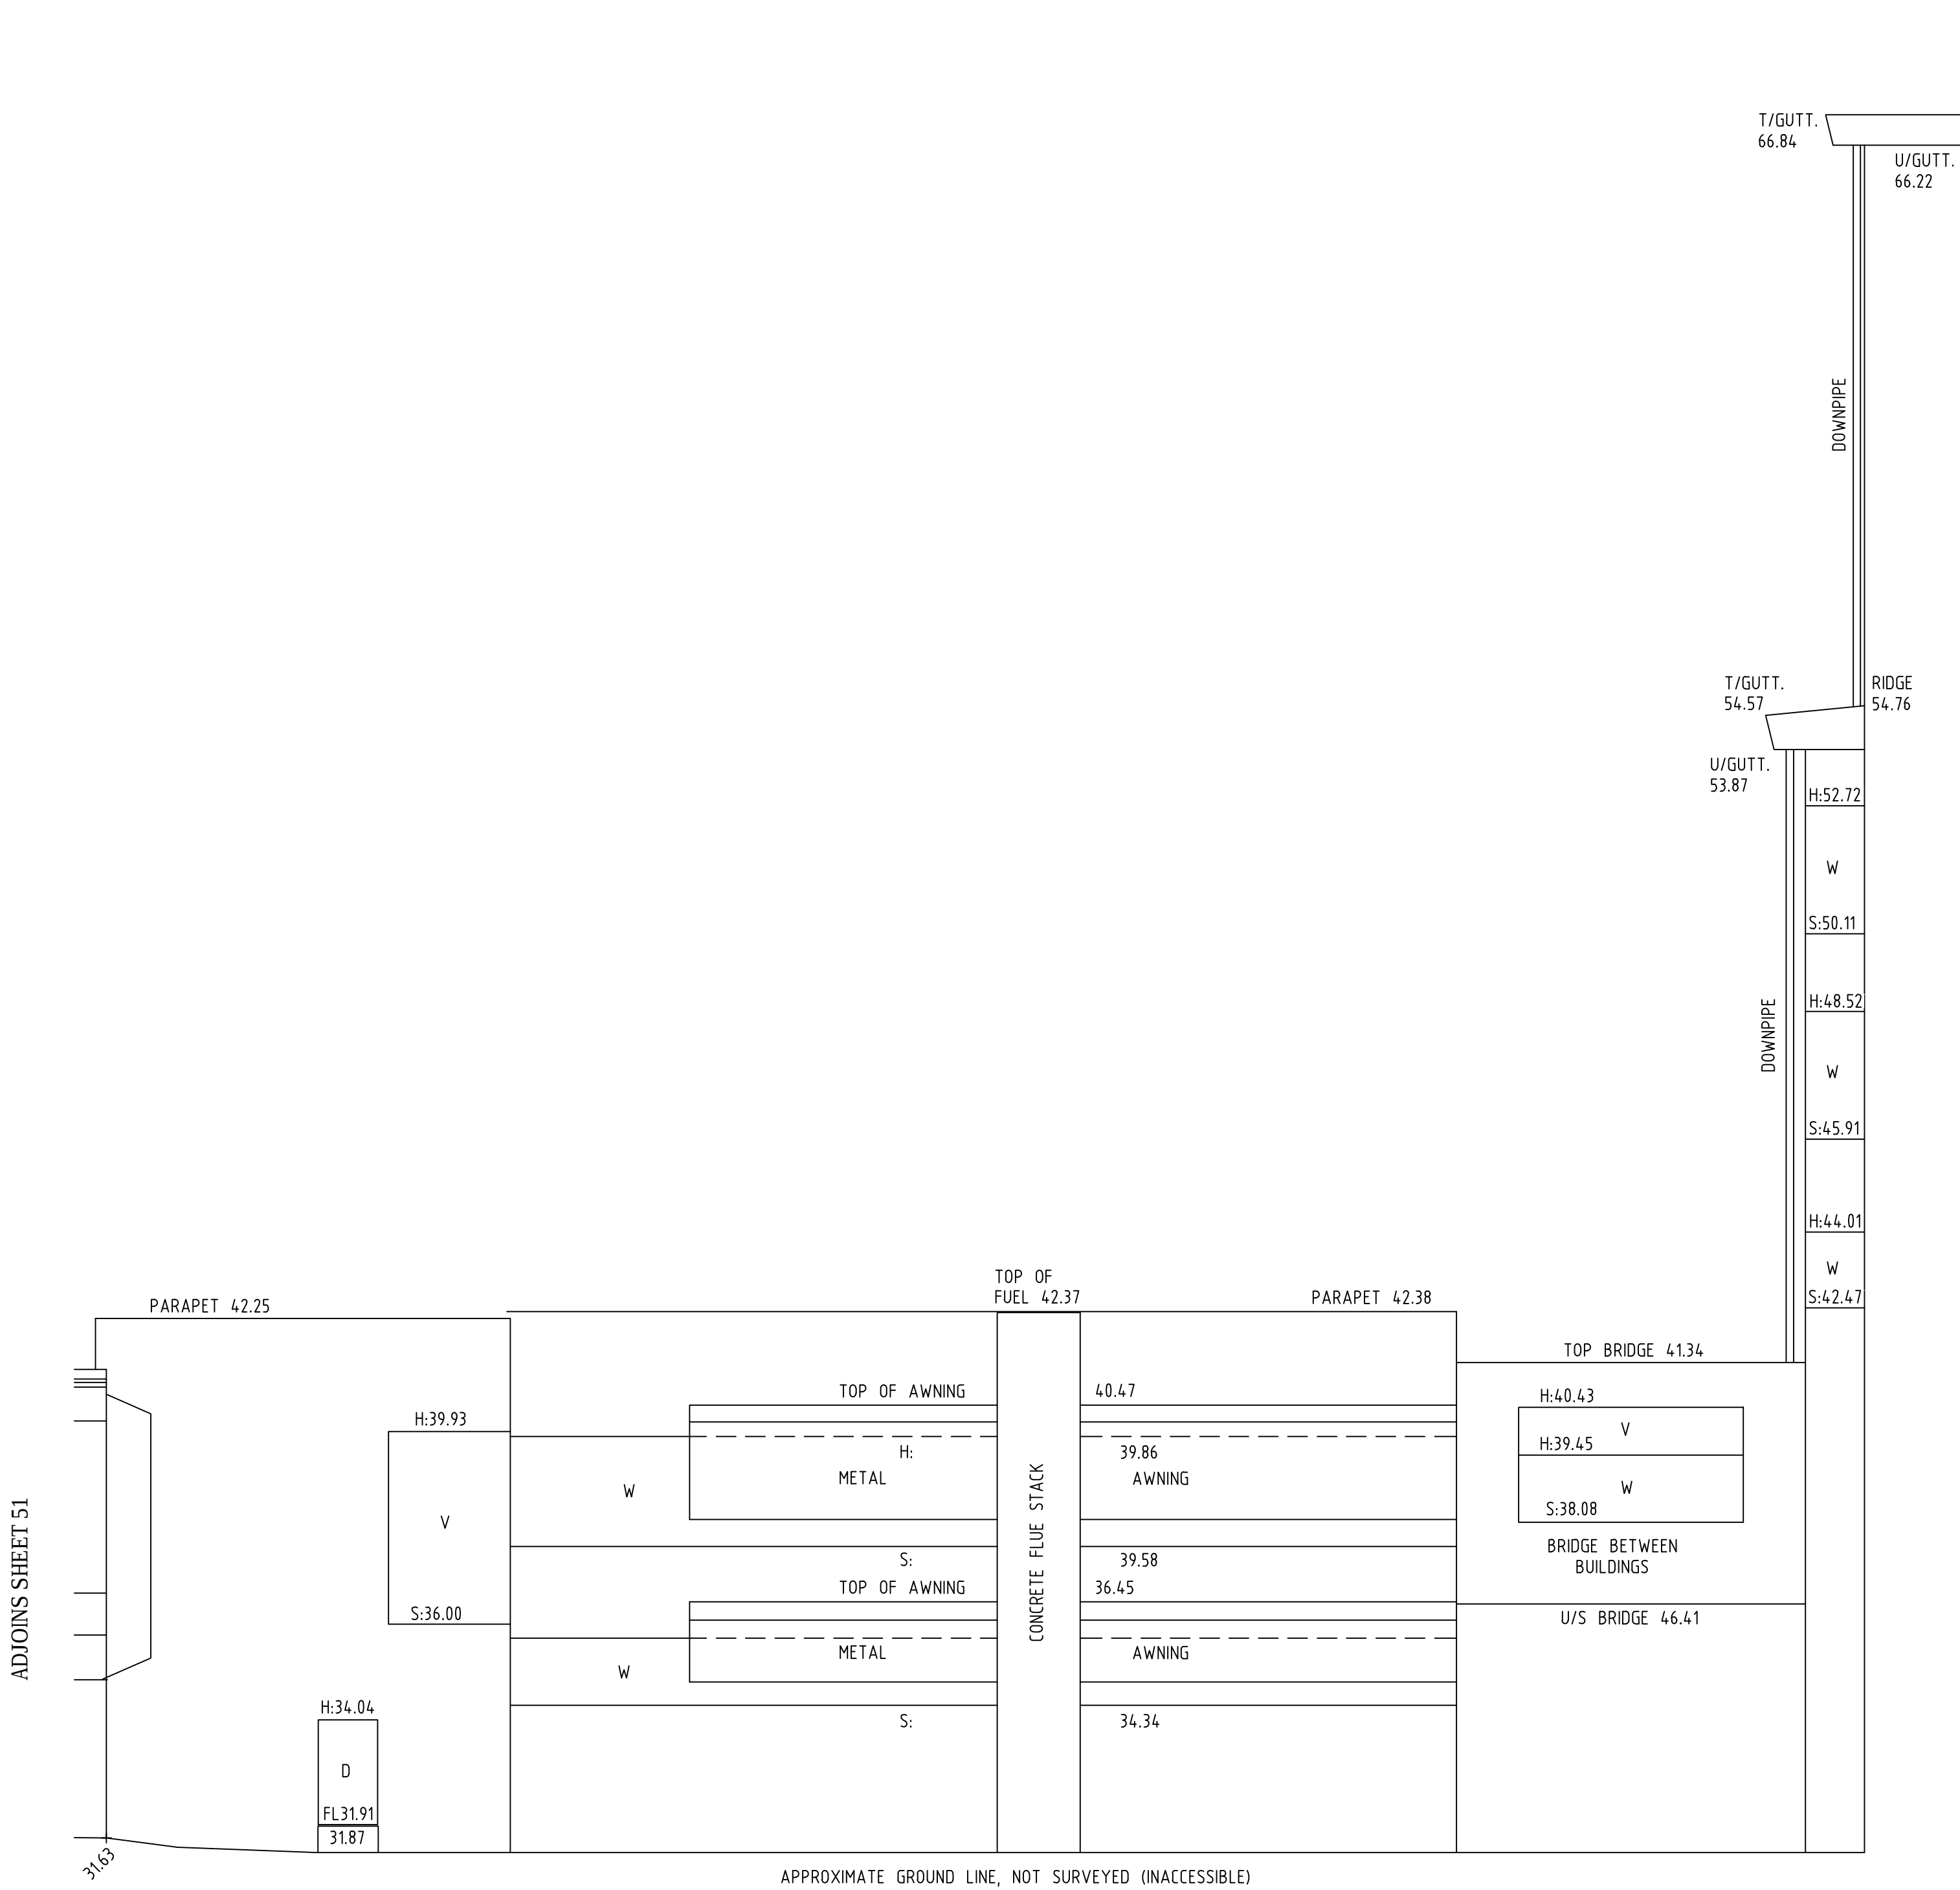


ELEVATION 1F-1F - (CONTINUATION)
HOSPITAL STAFF CAR PARK

LEGEND

- W ~ WINDOW
D ~ DOOR
H ~ HEAD
S ~ SILL
O ~ OPENING
V ~ VENT

SEE SHEET 1 FOR LEGEND AND NOTES

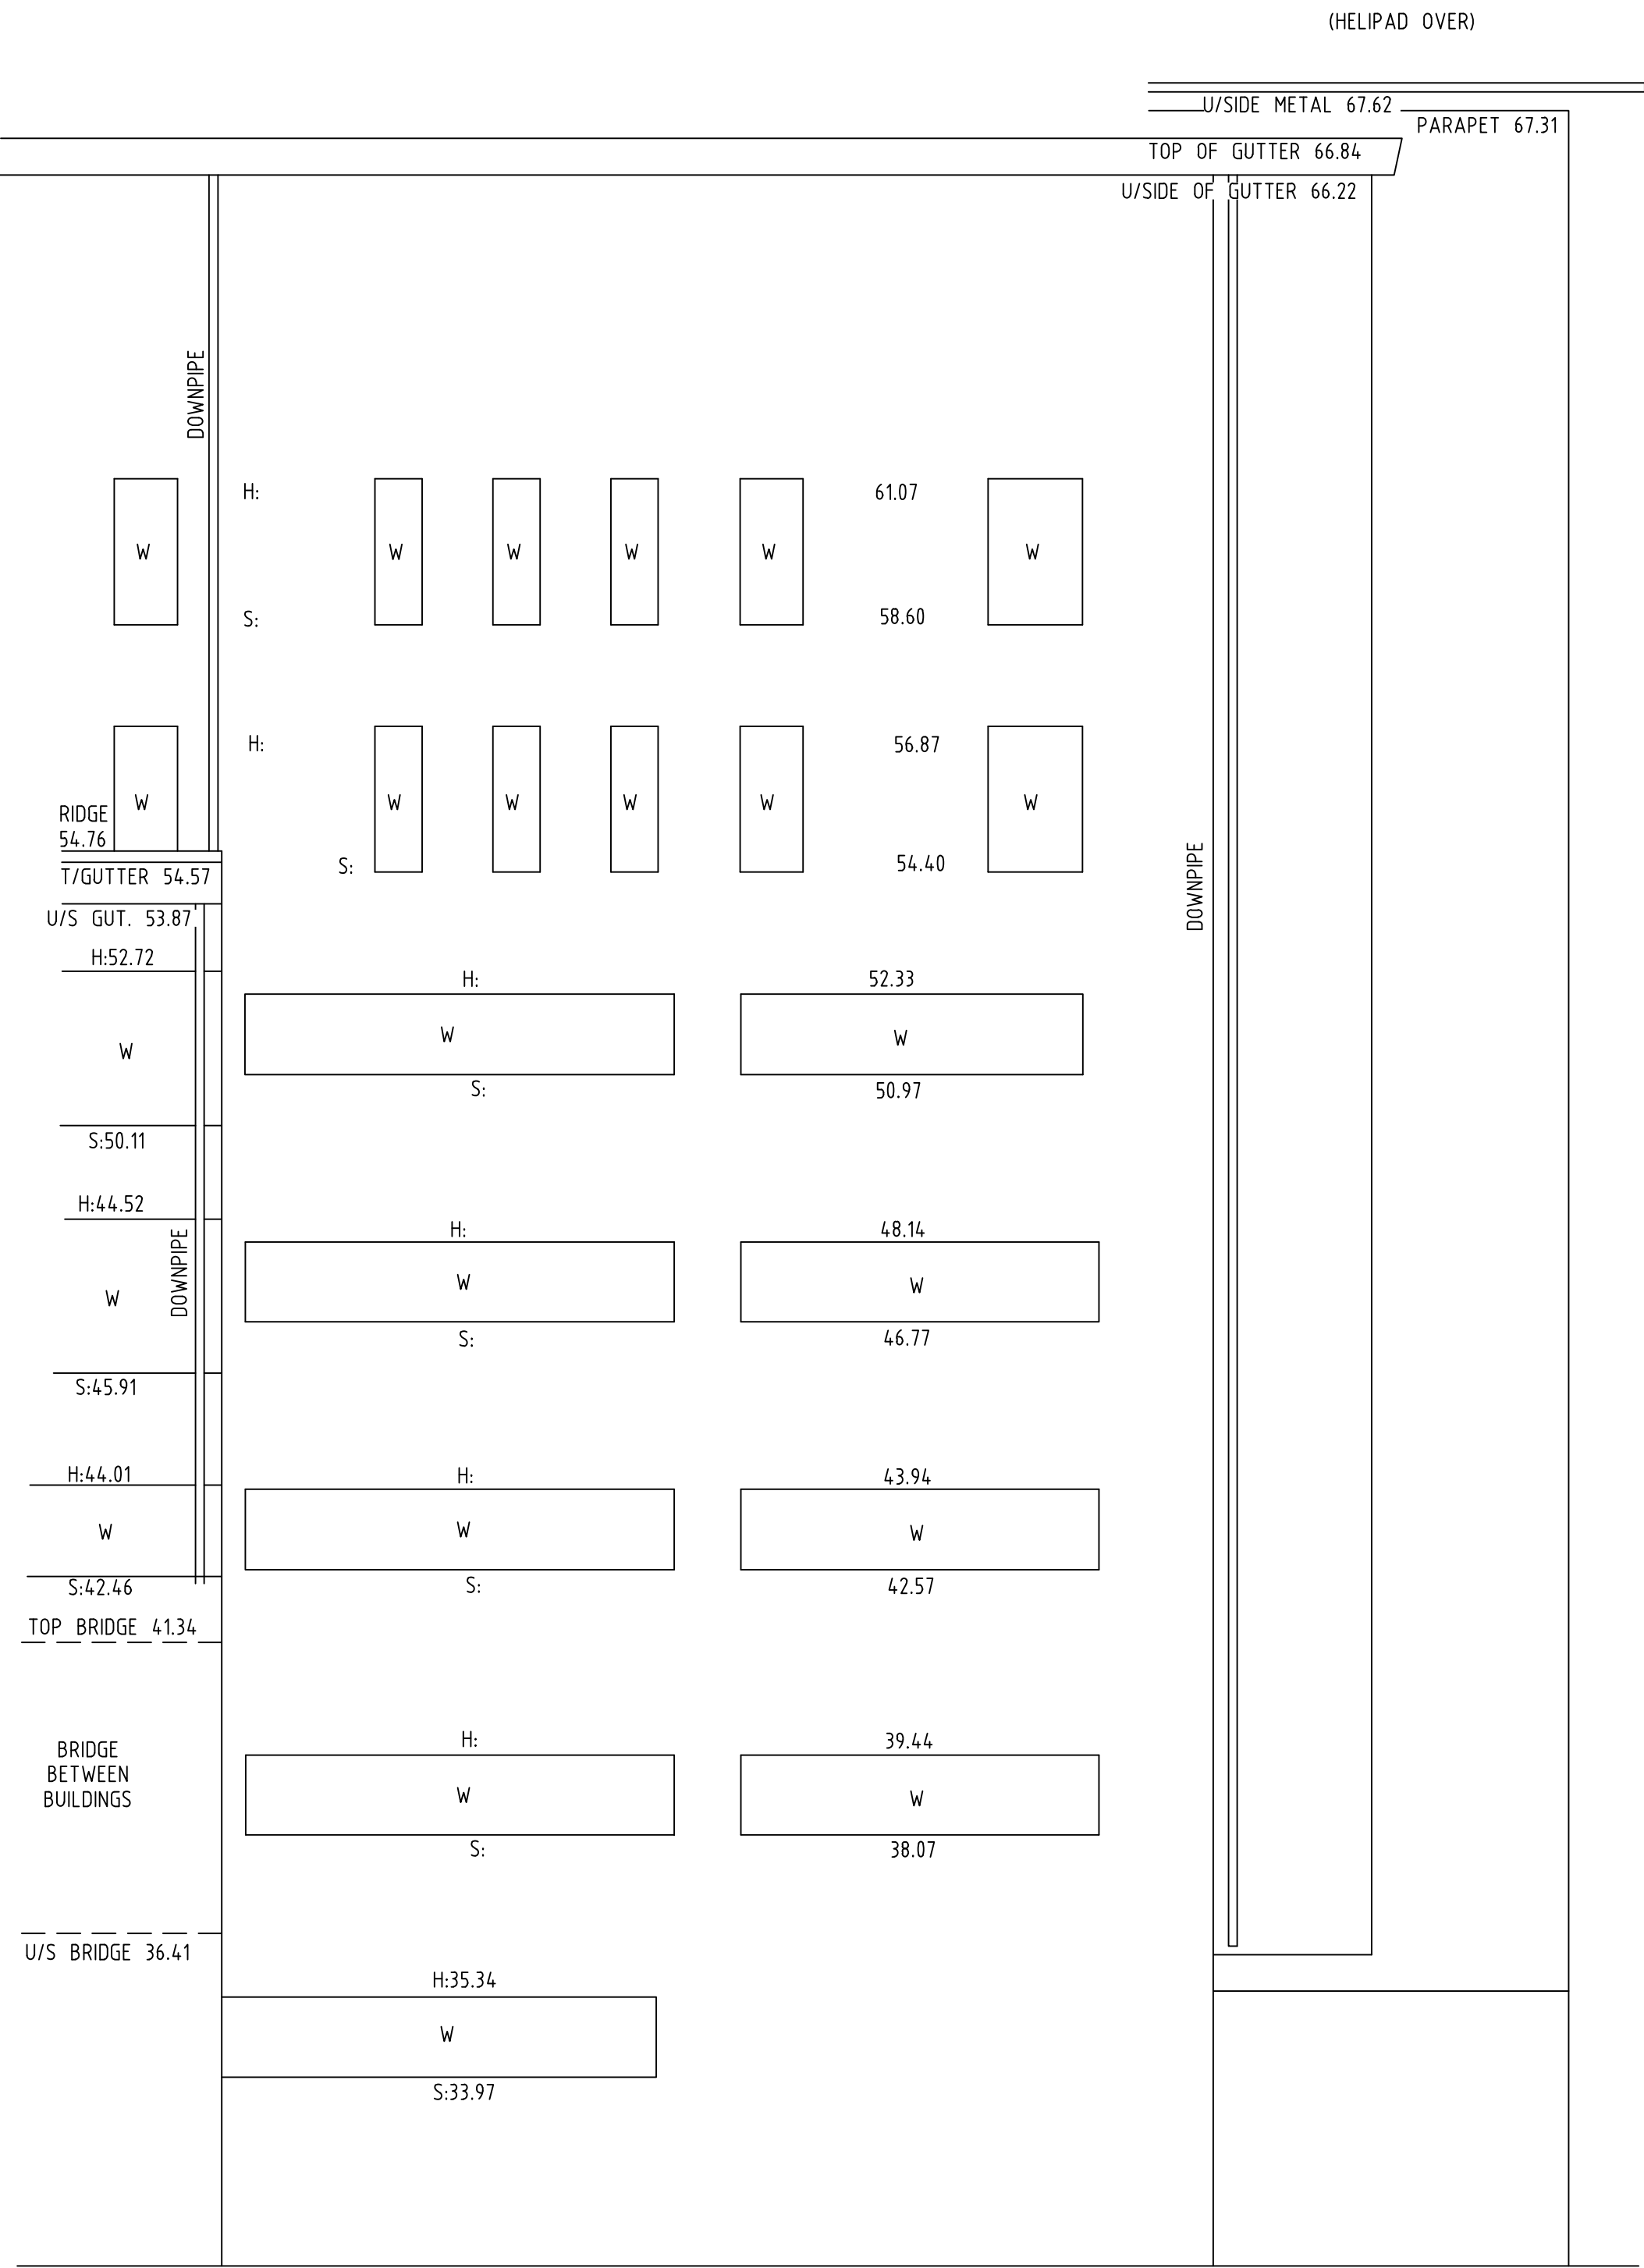

ELEVATION 1G-1G
MULTI-LEVEL HOSPITAL
BUILDING

THIS IS THE PLAN REFERRED TO
IN MY LETTER DATED:

Registered Surveyor NSW



Suite 1, Level 1
810 Pacific Highway
Gordon NSW 2072
Locked Bag 5
Gordon NSW 2072
P 1300 587 000
F 02 9499 7760

Client HEALTH INFRASTRUCTURE

Drawing title
PLAN OF DETAIL AND LEVELS OVER LOT 1-6 DP1130879 &
LOT 12 DP800476 KNOWN AS "ST GEORGE HOSPITAL" AT
KOGARAH

datum
AHD
site Area
5.179ha
LGA
KOGARAH

project number
33459
scale
1:100 @A1
OF SHEETS

reference number
33459DT
date of survey
24/06/15
52 SHEETS