



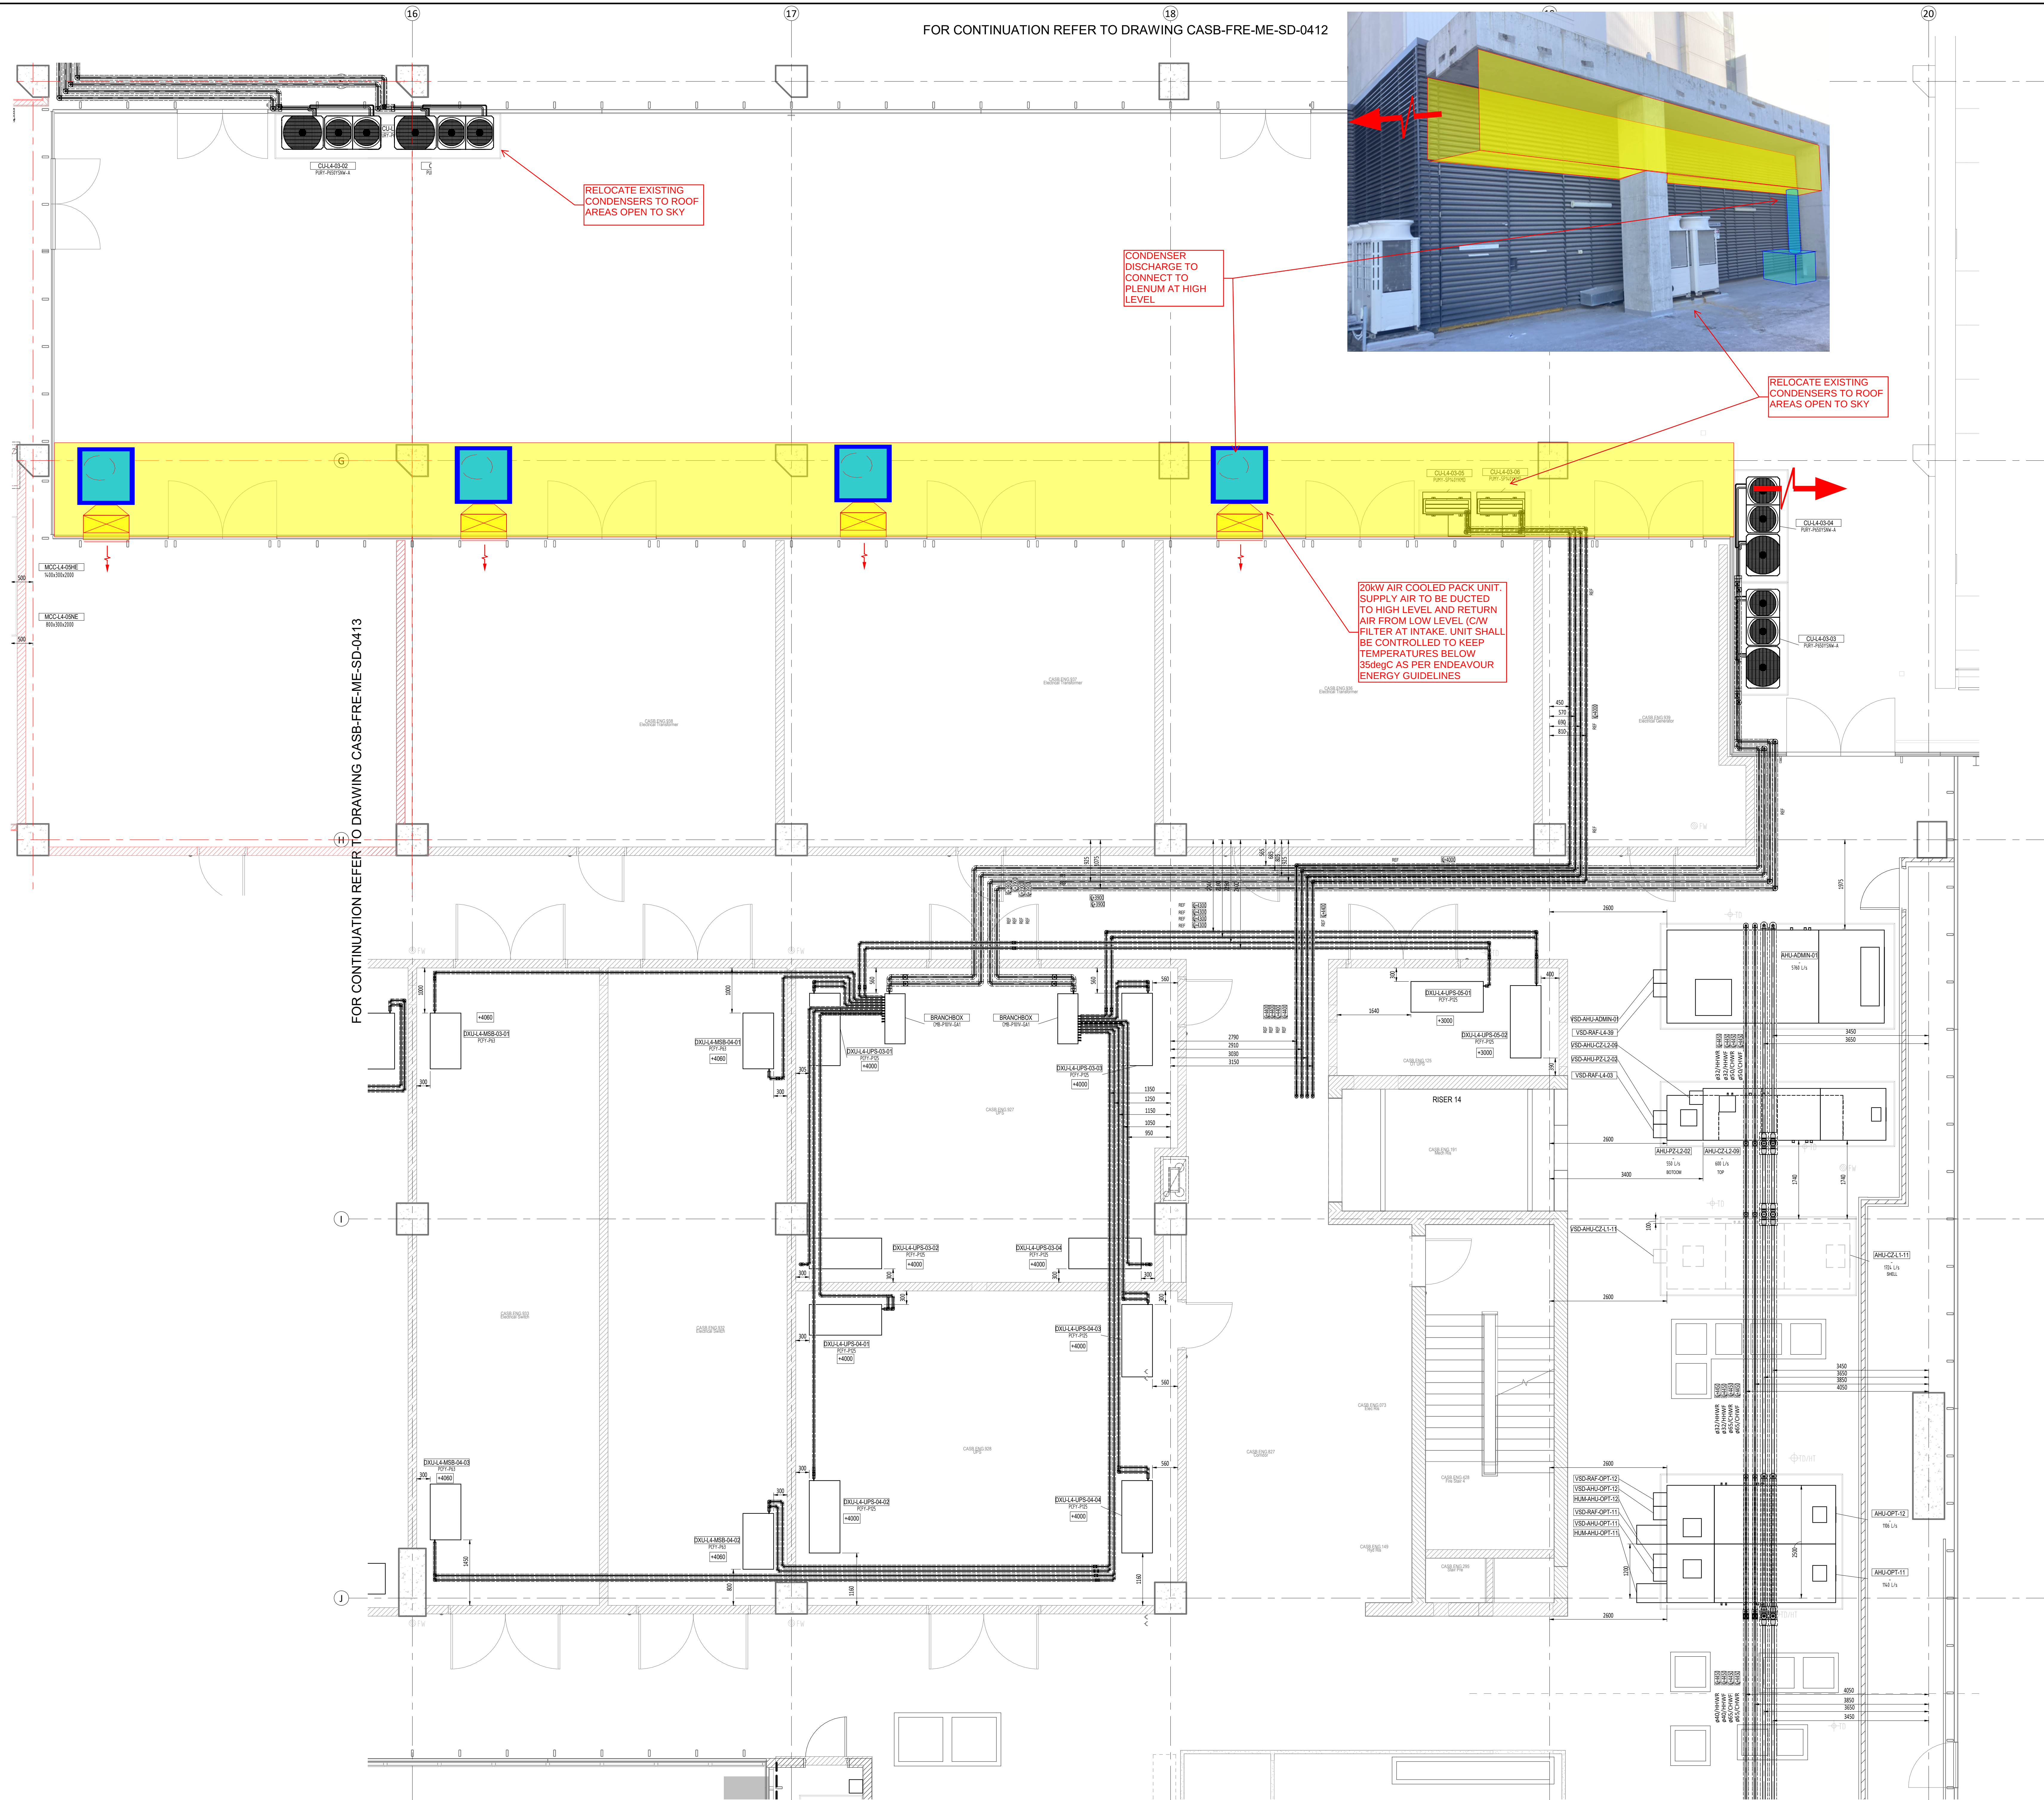

FOR CONTINUATION REFER TO DRAWING CASB-FRE-ME-SD-0412

FOR CONTINUATION REFER TO DRAWING CASB-FRE-ME-SD-0415

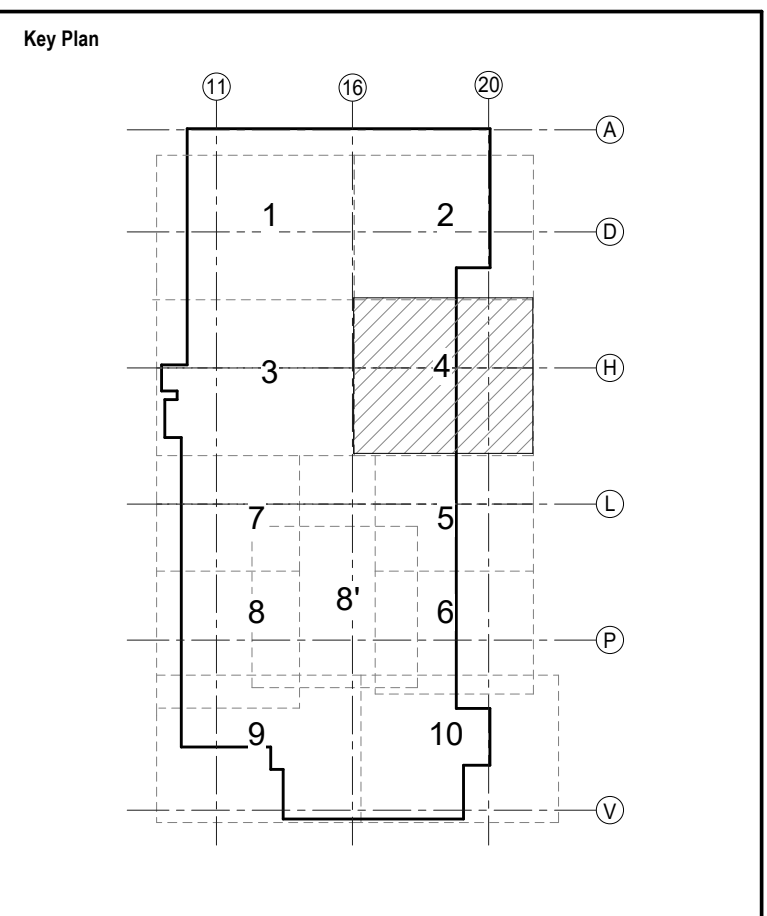

CLIENT:
Level 6, 77 Pacific Highway,
North Sydney NSW 2060
F: (02) 9571 5427
www.health.nsw.gov.au

PROJECT MANAGER:
Darling Park Tower 2
201 Sussex St,
Sydney NSW 2000
F: (02) 9226 0000
www.multiplex.com.au

CONTRACTOR:
Level 22, 115 King Street
Sydney NSW 2000
F: (02) 9322 2400
www.multiplex.com.au

MULTIPLEX

FREDON AIR NSW
Air Conditioning & Mechanical Services
ABN: 75 165 145 764
123 Westmead Drive, Westmead NSW 2128
Phone No. 02 9475 9400 Fax No. 02 9748 0040 www.fredon.com.au

APP FM	DATE	DSGN CHECK	DATE
DS	12/05/20	TB	12/05/20
DRAWN	DATE	DRG CHECK	DATE
WJ	11/03/18	RB	12/05/20
DISCIPLINE	TITLE	REVISION	
ARCHITECTURAL	ASB-HOR-AR-EM001	46	
ARCHITECTURAL	ASB-HOR-AR-EM002	67	
ARCHITECTURAL	ASB-HOR-AR-EM003	67	
STRUCTURAL	ASB-APP-ST-EM001	31	
ELECTRICAL	CASB-HV-EL-EM001	31	
HYDRAULIC	CASB-HV-HF-EM004	13	
FIRE	CASB-FS-FS-EM001	20	
OTHER	CASB-HOS-MG-EM001	34	
REV	DATE	Description	DWN
1	15/01/2019	FOR CONSTRUCTION	AT
2	18/03/2019	FOR CONSTRUCTION	NZ
3	18/04/2019	FOR CONSTRUCTION	JC
4	04/05/2020	AS BUILT	NZ

Project Name
WESTMEAD HOSPITAL REDEVELOPMENT
Hawkesbury Road, Westmead

Sheet Name
**Mechanical Services
LEVEL 04 PLANTROOM ZONE 4 AHU /
PIPEWORK LAYOUT**

Scale
1 : 50 @ A0

Sheet Number
CASB-FRE-ME-SD-0414

Status
AS BUILT

Project Number
31C044

Revision
4



sydney • melbourne • manila

Project name WCEnLP	Job Number SYD24106	Date 1/07/2024
Sketch Number SK-M02	Signed MA	
Discipline MECH	Revision P1	

