	22.01.09	21.05.13	20.07.20	25.03.21	29.07.21	28.04.22	24.03.23	03.04.25	
DATE OF ISSUE	2	2	2	2	2	7	2	0	
DRAWING PACKAGE VERSION	1	2	3	4	5	6	7	8	
GENERAL									
S0200-G1 SITE SPECIFICATIONS	AB	Α	В	C	AB	Α	Α	В	
S0200-G2 OVERALL SITE PLAN	AB	Α	В	C	AB	Α	Α	В	
S0200-G3 SITE LAYOUT AND SETOUT PLAN	AB	Α	В	C	AB	Α	Α	В	
S0200-G4 SITE ELEVATION	AB	Α	В	L	AB	Α	Α	В	
ANTENNAS & TRANSMISSION									
S0200-A1 OPTUS PANEL ANTENNA SYSTEM CONFIGURATION - SECTOR 1	AB	_ A	_∟ В		_ AB _□		В	_ C	
S0200-A2 OPTUS PANEL ANTENNA SYSTEM CONFIGURATION - SECTOR 2		_	_ A	B	AB	Α	_ A	B	
S0200-A3 OPTUS PANEL ANTENNA SYSTEM CONFIGURATION - SECTOR 3	-	_		_ A	AB	Α	_ A	В	
S0200-A4 PHYSICAL ASSET SUMMARY TABLE	-	_	_	-		Α	Α	В	
S0200-P1 OPTUS RF PLUMBING DIAGRAM	_	_	_	_		-	_	_ A _	
S0200-T1 SITE TRANSMISSION DETAILS		_	_ A	B	AB	Α	_ A	-	
STRUCTURAL		ı	1	1			ı	1 1	
ELECTRICAL									
S0200-E1 SITE POWER DETAILS	-		_	-		Α	_ A		
S0200-E2 SINGLE LINE DIAGRAM		_	_	_		Α	_ A		
SHELTER / FITOUT									
S0200-F1 EQUIPMENT ROOM LAYOUT - SHEET 1 0F 3	AB	Α	В	LC	AB	Α	Α	В	
EME EXCLUSION ZONES									
LEASE / LICENCE									

OPTUS

OPTUS SITE - S0200

THREDBO

INDARA SITE ID: 3000599

TOP OF KOSCIUSZKO CHAIRLIFT EAGLE'S NEST

LOT 863 DP1128686 FRIDAY DRIVE

THREDBO NSW 2625

UPGRADE 5G (OO MOCN)

OPTUS WORK AUTHORITY Nº 515062



DISTRIBUTION

 FOR CONSTRUCTION

S0200-00

DATE OF ISSUE	22.01.09	21.05.13	20.07.20	25.03.21	29.07.21	28.04.22	24.03.23	03.04.25	
DRAWING PACKAGE VERSION	1	2	3	4	5	6	7	8	

REFERENCE DOCUMENTS

OSD-100	STANDARD CONSTRUCTION NOTES	_	-	В	В	В	C	_ C	C	
OSD-171-1	SITE SIGNAGE TYPICAL GROUND SITE	· -	-	· -		-	-	-	В	
OSD-171-3	SIGNAGE LEGEND AND NOTES	_	-	-	_	-	-	-	В	
OSD-340	PARABOLIC ANTENNA STRAP MOUNTS ON MONOPOLES	_	-	Α	Α	Α	Α	-	-	
-	DALY INTERNATIONAL STRUCTURAL ASSESSMENT	_	1	· -	-	-	-	-	-	
STD-21622 SHT. 1	ANTENNA MOUNT @ R.L. 8.90m - GENERAL ARRANGEMENT & DETAILS	_	-	3	3	3	-	-	-	
STD-21622 SHT. 2	ANTENNA MOUNT @ R.L. 8.90m - SUB-ASSEMBLY 2A & DETAIL 2.1	_	_	3	3	3	-	-	-	
87840/11581333/2	STRUCTEL MOUNT CERTIFICATION	_	-	1	1	1	-	-	-	
S0200-NSW/S-Rev 1.1	LENDLEASE STRUCTURAL STATEMENT	_ -	-	· -	1	1	-	-	-	
STD-40010	7.44m STEEL POLE STEEL WORK @ R.L. 8.90m GENERAL ARRANGEMENT	_	-	-	_ -	-	1	1	1	
87840/P-021049/1	STRUCTEL - THREDBO (NSW) - MOUNT CERTIFICATION DATED 04.02.2022	_	-	-	-	-	1	1	-	
87840/P-021049/2	STRUCTEL - THREDBO (NSW) - MOUNT CERTIFICATION DATED 02.04.2025	_	-	-	-	_	_	_	1	
-	STRUCTURAL ADEQUACY STATEMENT BY SSMC	_	_	-	_	-	-	-	1	

OPTUS

OPTUS SITE - S0200

THREDBO

INDARA SITE ID: 3000599

TOP OF KOSCIUSZKO CHAIRLIFT EAGLE'S NEST

LOT 863 DP1128686 FRIDAY DRIVE

THREDBO NSW 2625

UPGRADE 5G (OO MOCN)

OPTUS WORK AUTHORITY Nº 515062



FOR CONSTRUCTION

S0200-01


50200-01

SITE ADDRESS

THREDBO NSW 2625

TOP OF KOSCIUSZKO CHAIRLIFT EAGLE'S NEST LOT 863 DP1128686 FRIDAY DRIVE

OPTUS SITE S0200 RFNSA SITE ID: 2625001

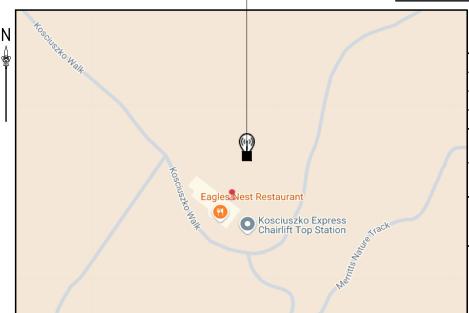

SITE LOCATION DATA SOURCE: RFNSA DATUM: MGA (GDA94) | ZONE: 55 REF LOCATION: & OF MONOPOLE **EASTING** 615 337 NORTHING 5 960 542 LATITUDE -36.4935° LONGITUDE 148.28775° WGS84 DATUM (USED BY GOOGLE EARTH®

AND GPS DEVICES) CAN BE CONSIDERED SAME AS GDA94 (SOURCE: "GEOCENTRIC DATUM OF AUSTRALIA TECHNICAL MANUAL" VERSION 2.3)

TOPOGRAPHIC MAP ... COPYRIGHT © GOOGLE MAPS

EXISTING INDARA STEEL MONOPOLE

- EXISTING INDARA 7.44m STEEL MONOPOLE ON 3.0m SQUARE x 0.8m HIGH CONCRETE BASE SLAB (BY INDARA). OVERALL HEIGHT OF MONOPOLE AND FOUNDATION IS 7.44m ABOVE GROUND LEVEL. MONOPOLE AND EQUIPMENT FINISHED IN NON REFLECTIVE PALE EUCALYPT GREEN. STRUCTURAL ADEQUACY OF EXISTING STEEL MONOPOLE AND ITS FOUNDATION HAS BEEN CONFIRMED BY INDARA AS PART OF AA PROCESS.
- NEW OPTUS PASSIVE ANTENNAS AND ANCILLARY EQUIPMENT TO BE INSTALLED ON EXISTING OPTUS SPOKE HEADFRAME WITH NEW ANTENNA MOUNTING PIPES. REFER TO DRAWING STD-40010, SHT 1 REV 1 FOR DETAILS.
- STRUCTURAL ADEQUACY OF EXISTING OPTUS SPOKE HEADFRAME HAS BEEN CONFIRMED BY SSMC. REFER TO STRUCTURAL CERTIFICATE VER.01 DATED 03.04.2025 FOR DETAILS.
- ANTENNA MAINTENANCE ACCESS BY QUALIFIED PERSONNEL ONLY (VIA STEP PEGS WITH FALL ARREST SYSTEM ON MONOPOLE).

OPTUS EQUIPMENT ROOM

- EXISTING OPTUS TIMBER AND PLYWOOD EQUIPMENT ROOM IN ROOFSPACE ABOVE STOREROOM, LOCATED NEAR THE 'EAGLES NEST' RESTAURANT
- REFER TO SHEET S0200-F1 FOR EQUIPMENT ROOM LAYOUT DETAILS.

TRANSMISSION

THIS SITE IS LINKED TO THE NETWORK VIA RADIO.

SITE ACCESS

- ALL SITE ACCESS VIA LOT 863 DP1128686 FRIDAY DRIVE.
- CONSTRUCTION CONTRACTOR TO FOLLOW ALL SITE PROTOCOLS. APPLICATION APPROVAL AND SITE ACCESS TO BE PERMIT OBTAINED PRIOR TO CARRYING OUT ANY UPGRADES ON SITE.
- REFER TO INDARA DIGITAL SITE PERMITS GUIDELINE FOR MORE DETAILS. CONTACT INDARA SITE MANAGEMENT CENTRE (SMC) ON 1800 006 667 OR EMAIL ACCESSTOSITE@ACCESSTOSITE.COM.AU FOR FURTHER ASSISTANCE.

SITE HAZARDS

- **EXISTING EME TRANSMITTING ANTENNAS**
- MANUAL HANDLING
- **WORKING AT HEIGHTS**
- SLIP. TRIP AND FALLS
- **ELECTRICAL HAZARDS**
- WEATHER / LIGHTNING /SNOW
- SUN EXPOSURE
- WILDLIFE / INSECTS
- GENERAL PUBLIC (INCLUDING BICYCLE RIDERS AND BUSHWALKERS)

SITE SIGNAGE

- SITE SIGNAGE SHALL BE IN ACCORDANCE WITH OSD-171-1 (GROUND SITE) AND OSD-171-3 (EME SIGNAGE).
- EXISTING MERCS-2 SIGN INSTALLED ON BASE OF THE OPTUS POLE NEEDS TO BE HARD-STAMPED WITH RFNSA ID.



EME EXCLUSION ZONES

REFER TO EME GUIDE FOR LATEST EME EXCLUSION ZONES FOR EXISTING AND NEW ANTENNAS AT THIS SITE.

ELECTRICAL INSTALLATION AND SITE EARTHING

GENERAL

- 1.1 ALL WORKS ARE TO BE IN ACCORDANCE WITH THE OPTUS CONSTRUCTION SPECIFICATION (OSD 010), OPTUS EARTHING SPECIFICATION (OSD - 020) AND THE OPTUS SHELTER SPECIFICATION (OSD - 040). LATEST EDITION WITH AMENDMENTS AT TIME OF CONSTRUCTION IS TO APPLY.
- **AC SUPPLY TO SHELTER**
- EXISTING 3 PHASE 20A IS SUFFICIENT FOR THE PROPOSED SCOPE OF WORK.

EARTHING 3.

- 3.1 ALL NEW EQUIPMENT AND FEEDER CABLING SHOULD BE BONDED TO THE EXISTING EARTH SYSTEM.
- 3.2 ALL WALKWAYS, HANDRAILS AND EXTRANEOUS METALWORK ASSOCIATED WITH THE OPTUS INSTALLATION IS TO BE BONDED TO THE EXISTING EARTH SYSTEM.
- 3.3 FOR DETAILS OF METHODOLOGY REFER TO OPTUS EARTHING SPECIFICATION, OSD 020. (LATEST EDITION AT TIME OF CONSTRUCTION IS TO APPLY).

GENERAL

- CONTRACTOR SHALL COMPLY WITH ALL RELEVANT OPTUS CONSTRUCTION STANDARDS AND SPECIFICATIONS.
- 2. ALL INFORMATION TO BE CHECKED ON SITE PRIOR TO FABRICATION AND CONSTRUCTION.

В	03.04.25	ISSUED FOR CONSTRUCTION (UPGRADE 5G (00 MOCN))	RMSI	MV	KK :	AQ	HR
Α	28.04.22	FOR CONSTRUCTION	RMSI	RT	KK	VR	RS
AB	29.07.21	AS BUILT (REGIONAL UG)	LENDLEASE	SRS	_	_	SA
С	25.03.21	NOTES AMENDED & ISSUED FOR CONSTRUCTION	LENDLEASE	AB	AQ :	SK :	SK
В	20.07.20	ISSUED FOR CONSTRUCTION	AXICOM	ADC	GJF	GL	GS
Α	30.01.19	FOR CONSTRUCTION	DALY	BRS	SC	DI	СТ
AB	22.01.09	AS BUILT	DALY	DI	JM :	DI :	ст
Rev	Date	Revision Details	Consultant	CAD	Designer	Verifier	Approver






MOBILE NETWORK **AUSTRALIA SITE No:- S0200 THREDBO**

LOT 863 DP1128686 FRIDAY DRIVE

SITE SPECIFICATIONS

Drawing Status FOR CONSTRUCTION S0200-G1



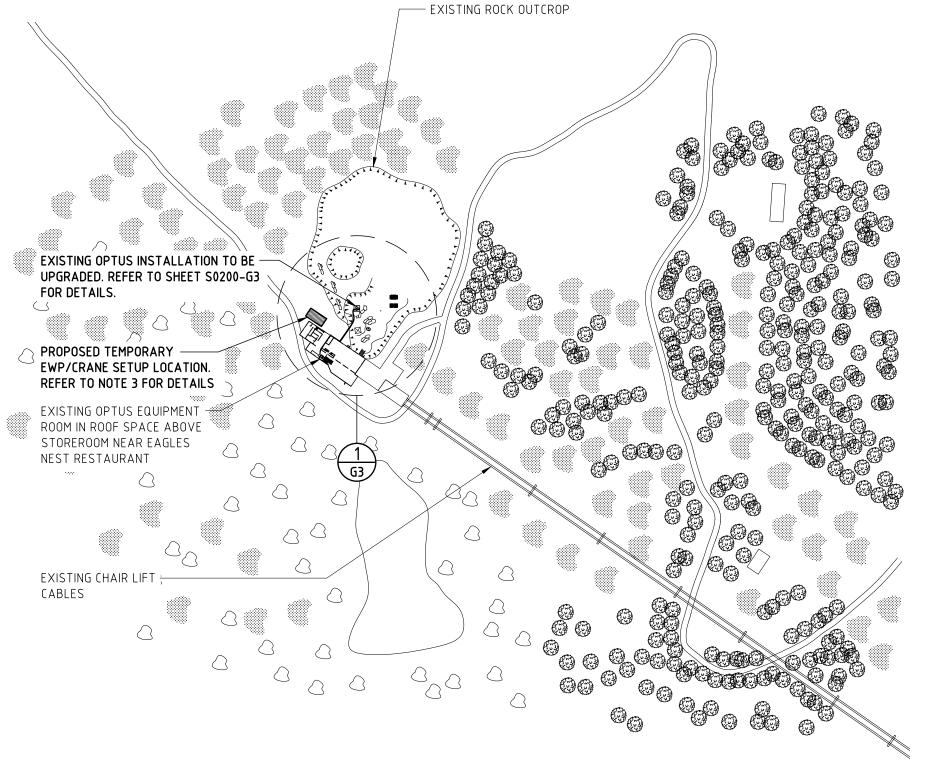

NOTES:

- 1. ALL INFORMATION TO BE CHECKED ON SITE PRIOR TO FABRICATION AND CONSTRUCTION.
- 2. DRAWINGS BASED ON INFORMATION PROVIDED BY OTHERS.
- 3. CONSTRUCTION CONTRACTOR TO CONFIRM SUITABILITY OF PROPOSED EWP SET-UP/PARKING LOCATION ON SITE PRIOR TO WORK COMMENCING.
- 4. SERVICES INFORMATION CONTAINED ON THIS DRAWING IS INDICATIVE ONLY AND REFERENCE SHOULD BE MADE TO THE AUTHORITIES DRAWINGS TO CONFIRM ACCURACY AND COMPLETENESS. WHERE INFORMATION IS AVAILABLE, THE SUB-SURFACE SERVICES INSTALLED BY AGENTS OTHER THAN AUTHORITIES HAVE BEEN SHOWN, BUT ADDITIONAL UNDOCUMENTED SERVICES MAY BE PRESENT. IF THE CONTRACTOR BELIEVE THAT SUB-SURFACE SERVICES ARE AT RISK OF DAMAGE DURING CONSTRUCTION, THE CONTRACTOR SHOULD NOTIFY THE RELEVANT AUTHORITIES AND ESTABLISH THE EXACT LOCATION OF THE SERVICES.

LEGEND

EXISTING PROPERTY BOUNDARY

OVERALL SITE PLAN

SCALE 1:2000

В	03.04.25	ISSUED FOR CONSTRUCTION (UPGRADE 5G (00 MOCN))	RMSI	MV	KK	AQ	HR
Α	28.04.22	FOR CONSTRUCTION	RMSI	RT	KK	VR	RS
AB	29.07.21	AS BUILT (REGIONAL UG)	LENDLEASE	SRS	_	-	SA
C	25.03.21	ISSUED FOR CONSTRUCTION	LENDLEASE	AB	AQ :	SK :	SK
В	20.07.20	ISSUED FOR CONSTRUCTION	AXICOM	ADC	GJF	GL	GS :
Α	30.01.19	FOR CONSTRUCTION	DALY	BRS	SC	DI	СТ
AB	22.01.09	AS BUILT	DALY	DI	JM :	DI :	СТ
Rev	Date	Revision Details	Consultant	CAD	Designer	Verifier	Approver



OPTUS

MOBILE NETWORK
AUSTRALIA
SITE No:- S0200
THREDBO


LOT 863 DP1128686 FRIDAY DRIVE


Drawing Title

OVERALL SITE PLAN

FOR CONSTRUCTION

S0200-G2 B

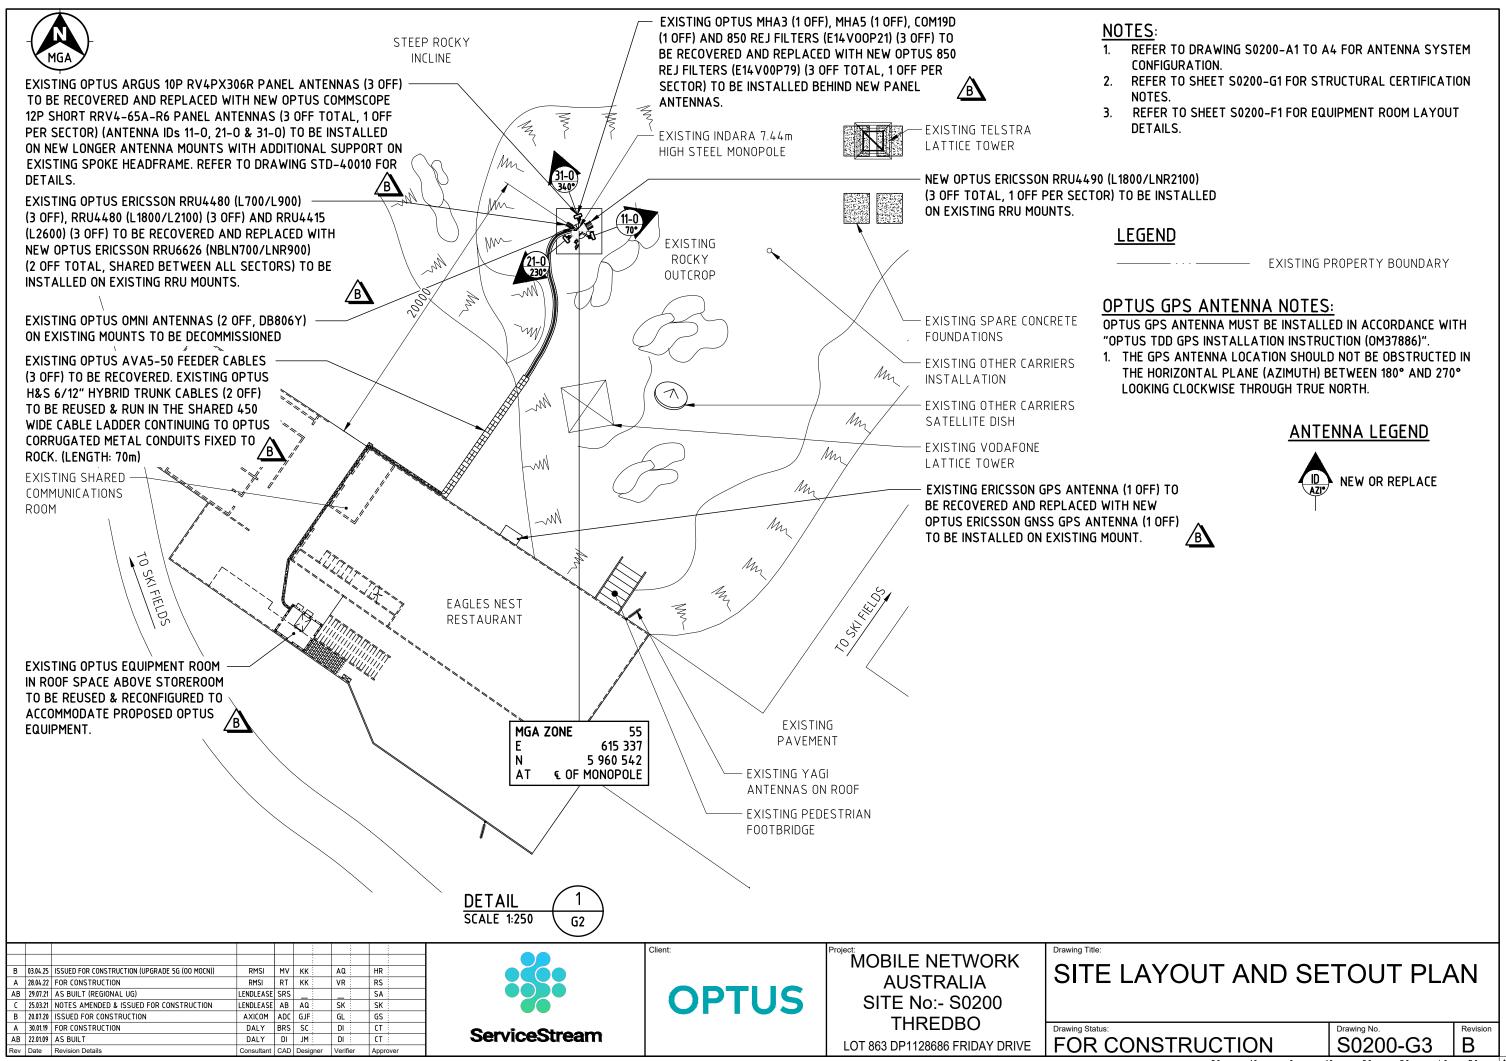

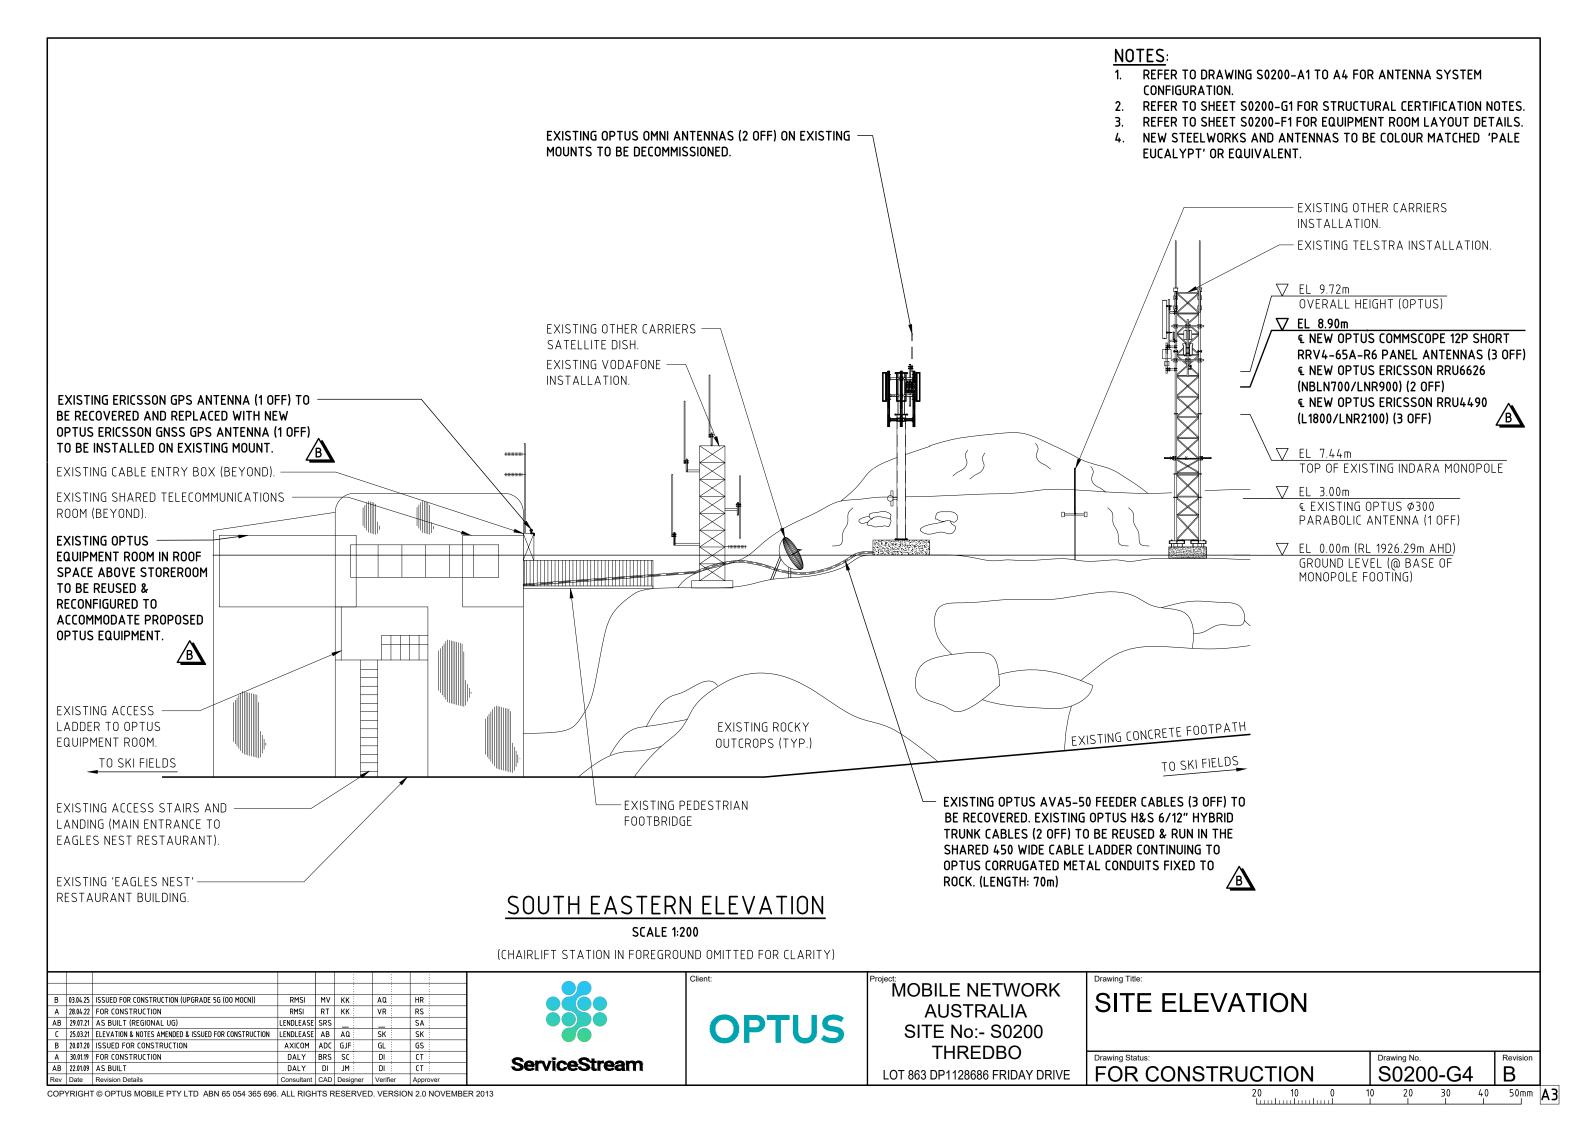

A1 - PHYSICAL ANTENNA GROUP 1 DETAILS

ANTENNA DETAILS												
PHYSICAL ANTENNA G	ROUP (N2)				1							
CO-ORDINATES (N5)	LATITUDE			-36.4	4935							
CO-ONDINATES (NS)	LONGITUDE			148.2	28775							
ANTENNA OPERATOR			OPTUS									
PHYSICAL ANTENNA N	UMBER (N3)		1									
PHYSICAL ANTENNA ID) (N4)			11	-0							
ANTENNA ALIAS				12-POR	SHORT							
ANTENNA STATUS				NE	EW .							
PHYSICAL AZIMUTH (°)	(N6)			70)°							
PHYSICAL ANT CL EL (m) (N7)			8.9	0m							
MECH DOWN-TILT (°)				C	0							
MODEL NO.				RRV4-	65A-R6							
MANUFACTURER				COM	имs							
TYPE				PAS	SIVE							
NO. OF RF PORTS / TxF	₹x	12										
PORT TYPE		4.3-10										
BAND CAPABILITY		07 / 09 / 18 / 21 / 23 / 26										
DIMENSIONS (HxWxD)	(mm)	1499 × 498 × 197										
WEIGHT (kg)		33										
RF SECTOR & BAND A	LLOCATION											
RF SECTOR ID / SUB-S	ECTOR ID				1							
PHYSICAL ARRAY ID		L11	L21	H12	H22	H13	H23					
LOGICAL ANTENNA PO	RT	LP1 & LP2	LP3 & LP4	LP5 & LP6	LP7 & LP8	LP9 & LP10	LP11 & LP12					
PHYSICAL ANTENNA P	ORT (OEM LABEL)	3 & 4	1 & 2	11 & 12	9 & 10	7 & 8	5 & 6					
ETILT (N8)		7	7			5	5					
ARRAY BEAM OFFSET	(°)			()							
ARRAY BEAM AZIMUTI	H (°)			70)°							
ARRAY BAND CAPABIL	ΙΤΥ	7,8,9	7,8,9	18,21,23,26	18,21,23,26	18,21,23,26	18,21,23,26					
ASSIGNED ARRAY OPE	ASSIGNED ARRAY OPERATOR			0	0	0	0					
ASSIGNED RF PORT FI	ASSIGNED RF PORT FREQUENCY 1					18/21	18/21					
ASSIGNED RF PORT FI	ASSIGNED RF PORT FREQUENCY 2											
ASSIGNED RF PORT FI	ASSIGNED RF PORT FREQUENCY 3											
ASSIGNED RF PORT FI	REQUENCY 4											



OPTUS PANEL ANTENNA SYSTEM CONFIGURATION FOR SECTOR 1

					:	- :	
C	03.04.25	ISSUED FOR CONSTRUCTION (UPGRADE 5G (00 MOCN))	RMSI	MV	KK :	AQ	HR
В	24.03.23	TABLE UPDATED	SSMC	JW	AM	FA	HR
Α	28.04.22	FOR CONSTRUCTION	RMSI	RT	KK	VR	RS
AB	29.07.21	AS BUILT (REGIONAL UG)	LENDLEASE	SRS	_	_	SA
С	25.03.21	TABLE, NOTES AMENDED & ISSUED FOR CONSTRUCTION	LENDLEASE	AB	AQ :	SK :	SK :
В	20.07.20	ISSUED FOR CONSTRUCTION	AXICOM	ADC	GJF	GL	GS
Α	30.01.19	FOR CONSTRUCTION	DALY	BRS	SC	DI	СТ
AB	22.01.09	AS BUILT	DALY	DI	JM :	DI :	СТ
Rev	Date	Revision Details	Consultant	CAD	Designer	Verifier	Approver





MOBILE NETWORK **AUSTRALIA SITE No:- S0200 THREDBO**


LOT 863 DP1128686 FRIDAY DRIVE

NOTES:

- 1. THE ANTENNA TABLE SHALL BE READ IN CONJUCTION WITH THE DETAIL RF PLUMBING FOR THIS SITE.
- 2. A PHYSICAL SECTOR GROUP IS DEFINED AS A GROUP OF ANTENNAS GENERALLY ORIENTATED WITH SIMILAR AZIMUTHS AND EACH GROUP IS ASSIGNED A NUMBER 1, 2, 3,4, ETC. THE PHYSICAL SECTOR GROUP MAY INCLUDE SINGLE BEAM OR MULTI-BEAM ANTENNAS. IN THE CASE OF MULTI-BEAM ANTENNAS, THE RF SECTOR MAY DIFFER TO THE PHYSICAL SECTOR.
- 3. THE PHYSICAL ANTENNA NUMBER DEFINED BY ASSIGNING SEQUENCED NUMBERS TO EACH JV OPERATOR'S ANTENNAS WITHIN A PHYSICAL SECTOR GROUP, STARTING FROM LEFT TO RIGHT, TOP TO
- 4. THE PHYSICAL ANTENNA ID IS DEFINED BY THE NUMBER MADE UP BY CONCATENATING THE PHYSICAL SECTOR GROUP NUMBER WITH THE PHYSICAL ANTENNA NUMBER & THE FIRST LETTER FROM THE OPERATOR'S NAME OR JOINT (O, V, J), SAME AS THE SAO NUMBER, AS SPECIFIED IN OSD-070 SECTION 5,6
- 5. ANTENNA CO-ORDINATES ARE TO BE IN GDA94/GDA2020 REFERENCE SYSTEM, SPECIFIED FOR CENTRE OF EACH SECTOR TO NEAREST METRE.
- 6. THE PHYSICAL AZIMUTH () DEFINED AS THE DIRECTION OF THE PHYSICAL ANTENNA BORE SIGHT WITH RESPECT TO TRUE NORTH, AZIMUTHS OF EACH BEAM OF MULTI-BEAM ANTENNAS ARE NOT DOCUMENTED
- 7. THE PHYSICAL ANT CL EL (m) IS DEFINED AS THE MID-HEIGHT OF THE PHYSICAL ANTENNA. THE HEIGHT OF INDIVIDUAL BEAMS OR DIFFERENT SEGMENTS OF MULTI-BEAM OR HYBRID ANTENNAS (IPAA) ARE NOT DOCUMENTED IN THIS TABLE.
- 8. ELECTRICAL DOWN-TILTS ARE ONLY ACCURATE AT THE TIME OF BUILD AS THEY ARE FREQUENTLY OPTIMISED. ALWAYS REFER TO CURRENT VALUES IN MNIS.





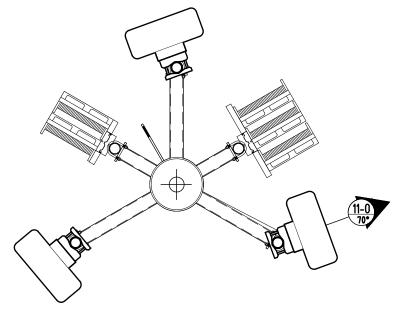

OPTUS ANTENNA PLAN

SCALE 1:25

OPTUS PANEL ANTENNA SYSTEM CONFIGURATION - SECTOR 1

FOR CONSTRUCTION

S0200-A1 C

A2 - PHYSICAL ANTENNA GROUP 2 DETAILS

ANTENNA DETAILS											
PHYSICAL ANTENNA G	ROUP (N2)			:	2						
CO OPDINATES (NE)	LATITUDE			-36.4	4935						
CO-ORDINATES (N5)	LONGITUDE			148.2	28775						
ANTENNA OPERATOR				OP.	TUS						
PHYSICAL ANTENNA N	UMBER (N3)	1									
PHYSICAL ANTENNA ID) (N4)			21	-0						
ANTENNA ALIAS				12-POR1	Γ SHORT						
ANTENNA STATUS				NE	ΞW						
PHYSICAL AZIMUTH (°)	(N6)			23	0°						
PHYSICAL ANT CL EL (m) (N7)			8.9	0m						
MECH DOWN-TILT (°)				0	°						
MODEL NO.				RRV4-	65A-R6						
MANUFACTURER				CON	MMS						
TYPE				PAS	SIVE						
NO. OF RF PORTS / TxF	₹x	12									
PORT TYPE		4.3-10									
BAND CAPABILITY		07 / 09 / 18 / 21 / 23 / 26									
DIMENSIONS (HxWxD)	(mm)	1499 × 498 × 197									
WEIGHT (kg)		33									
RF SECTOR & BAND A	LLOCATION										
RF SECTOR ID / SUB-S	ECTOR ID				2						
PHYSICAL ARRAY ID		L11	L21	H12	H22	H13	H23				
LOGICAL ANTENNA PC	RT	LP1 & LP2	LP3 & LP4	LP5 & LP6	LP7 & LP8	LP9 & LP10	LP11 & LP12				
PHYSICAL ANTENNA P	ORT (OEM LABEL)	3 & 4	1 & 2	11 & 12	9 & 10	7 & 8	5 & 6				
ETILT (N8)		6	6			5	5				
ARRAY BEAM OFFSET	(°)			(0						
ARRAY BEAM AZIMUTI	H (°)			23	l0°						
ARRAY BAND CAPABIL	.ΠΥ	7,8,9	7,8,9	18,21,23,26	18,21,23,26	18,21,23,26	18,21,23,26				
ASSIGNED ARRAY OPE	ASSIGNED ARRAY OPERATOR			0	0	0	0				
ASSIGNED RF PORT FI	REQUENCY 1	07/09	07/09			18/21	18/21				
ASSIGNED RF PORT FI	REQUENCY 2										
ASSIGNED RF PORT FI	ASSIGNED RF PORT FREQUENCY 3										
ASSIGNED RF PORT FI	ASSIGNED RF PORT FREQUENCY 4										



OPTUS PANEL ANTENNA SYSTEM CONFIGURATION FOR SECTOR 2

B 03.04.25 ISSUED FOR CONSTRUCTION (UPGRADE 5G (00 MOCN)) RMSI MV KK AQ	HR
A 28.04.22 FOR CONSTRUCTION RMSI RT KK : VR :	RS
AB 29.07.21 AS BUILT (REGIONAL UG) LENDLEASE SRS	SA
B 25.03.21 DIAGRAM AMENDED & ISSUED FOR CONSTRUCTION LENDLEASE AB AQ SK	SK
A 20.07.20 ISSUED FOR CONSTRUCTION AXICOM ADC GJF: GL:	GS
Rev Date Revision Details Consultant CAD Designer Verifier	Approver





MOBILE NETWORK **AUSTRALIA SITE No:- S0200 THREDBO**

LOT 863 DP1128686 FRIDAY DRIVE


NOTES:

- 1. THE ANTENNA TABLE SHALL BE READ IN CONJUCTION WITH THE DETAIL RF PLUMBING FOR THIS SITE.
- 2. A PHYSICAL SECTOR GROUP IS DEFINED AS A GROUP OF ANTENNAS GENERALLY ORIENTATED WITH SIMILAR AZIMUTHS AND EACH GROUP IS ASSIGNED A NUMBER 1, 2, 3,4, ETC. THE PHYSICAL SECTOR GROUP MAY INCLUDE SINGLE BEAM OR MULTI-BEAM ANTENNAS. IN THE CASE OF MULTI-BEAM ANTENNAS, THE RF SECTOR MAY DIFFER TO THE PHYSICAL SECTOR.
- 3. THE PHYSICAL ANTENNA NUMBER DEFINED BY ASSIGNING SEQUENCED NUMBERS TO EACH JV OPERATOR'S ANTENNAS WITHIN A PHYSICAL SECTOR GROUP, STARTING FROM LEFT TO RIGHT, TOP TO
- 4. THE PHYSICAL ANTENNA ID IS DEFINED BY THE NUMBER MADE UP BY CONCATENATING THE PHYSICAL SECTOR GROUP NUMBER WITH THE PHYSICAL ANTENNA NUMBER & THE FIRST LETTER FROM THE OPERATOR'S NAME OR JOINT (O, V, J), SAME AS THE SAO NUMBER, AS SPECIFIED IN OSD-070 SECTION 5,6
- 5. ANTENNA CO-ORDINATES ARE TO BE IN GDA94/GDA2020 REFERENCE SYSTEM, SPECIFIED FOR CENTRE OF EACH SECTOR TO NEAREST METRE.
- 6. THE PHYSICAL AZIMUTH () DEFINED AS THE DIRECTION OF THE PHYSICAL ANTENNA BORE SIGHT WITH RESPECT TO TRUE NORTH, AZIMUTHS OF EACH BEAM OF MULTI-BEAM ANTENNAS ARE NOT DOCUMENTED
- 7. THE PHYSICAL ANT CL EL (m) IS DEFINED AS THE MID-HEIGHT OF THE PHYSICAL ANTENNA. THE HEIGHT OF INDIVIDUAL BEAMS OR DIFFERENT SEGMENTS OF MULTI-BEAM OR HYBRID ANTENNAS (IPAA) ARE NOT DOCUMENTED IN THIS TABLE.
- 8. ELECTRICAL DOWN-TILTS ARE ONLY ACCURATE AT THE TIME OF BUILD AS THEY ARE FREQUENTLY OPTIMISED. ALWAYS REFER TO CURRENT VALUES IN MNIS.

ANTENNA LEGEND





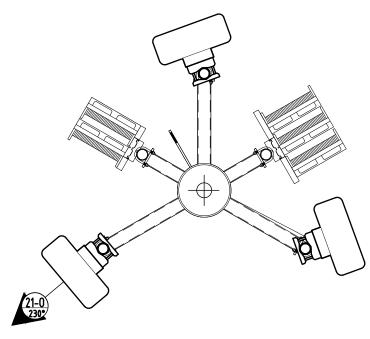

OPTUS ANTENNA PLAN

SCALE 1:25

OPTUS PANEL ANTENNA SYSTEM CONFIGURATION - SECTOR 2

FOR CONSTRUCTION

S0200-A2

В

A3 - PHYSICAL ANTENNA GROUP 3 DETAILS

ANTENNA DETAILS											
PHYSICAL ANTENNA G	ROUP (N2)			;	3						
CO-ORDINATES (N5)	LATITUDE			-36.4	1935						
CO-ORDINATES (NS)	LONGITUDE			148.2	28775						
ANTENNA OPERATOR		OPTUS									
PHYSICAL ANTENNA N	UMBER (N3)	1									
PHYSICAL ANTENNA ID) (N4)			31	-0						
ANTENNA ALIAS				12-POR1	SHORT						
ANTENNA STATUS				NE	EW						
PHYSICAL AZIMUTH (°)	(N6)			34	0°						
PHYSICAL ANT CL EL (r	m) (N7)			8.9	0m						
MECH DOWN-TILT (°)				0	0						
MODEL NO.				RRV4-	65A-R6						
MANUFACTURER				CON	MMS						
TYPE				PAS	SIVE						
NO. OF RF PORTS / TxF	₹x	12									
PORT TYPE		4.3-10									
BAND CAPABILITY		07 / 09 / 18 / 21 / 23 / 26									
DIMENSIONS (HxWxD) ((mm)	1499 × 498 × 197									
WEIGHT (kg)		33									
RF SECTOR & BAND A	LLOCATION										
RF SECTOR ID / SUB-S	ECTOR ID			;	3						
PHYSICAL ARRAY ID		L11	L21	H12	H22	H13	H23				
LOGICAL ANTENNA PO	RT	LP1 & LP2	LP3 & LP4	LP5 & LP6	LP7 & LP8	LP9 & LP10	LP11 & LP12				
PHYSICAL ANTENNA P	ORT (OEM LABEL)	3 & 4	1 & 2	11 & 12	9 & 10	7 & 8	5 & 6				
ETILT (N8)		4	4			4	4				
ARRAY BEAM OFFSET	(°)			()						
ARRAY BEAM AZIMUTH	H (°)			34	0°						
ARRAY BAND CAPABIL	ΙΤΥ	7,8,9	7,8,9	18,21,23,26	18,21,23,26	18,21,23,26	18,21,23,26				
ASSIGNED ARRAY OPE	ASSIGNED ARRAY OPERATOR			0	0	0	0				
ASSIGNED RF PORT FF	ASSIGNED RF PORT FREQUENCY 1					18/21	18/21				
ASSIGNED RF PORT FF	ASSIGNED RF PORT FREQUENCY 2										
ASSIGNED RF PORT FF	ASSIGNED RF PORT FREQUENCY 3										
ASSIGNED RF PORT FF	REQUENCY 4										



OPTUS PANEL ANTENNA SYSTEM CONFIGURATION FOR SECTOR 3






MOBILE NETWORK
AUSTRALIA
SITE No:- S0200
THREDBO

LOT 863 DP1128686 FRIDAY DRIVE

NOTES:

- 1. THE ANTENNA TABLE SHALL BE READ IN CONJUCTION WITH THE DETAIL RF PLUMBING FOR THIS SITE.
- 2. A PHYSICAL SECTOR GROUP IS DEFINED AS A GROUP OF ANTENNAS GENERALLY ORIENTATED WITH SIMILAR AZIMUTHS AND EACH GROUP IS ASSIGNED A NUMBER 1, 2, 3,4. ETC. THE PHYSICAL SECTOR GROUP MAY INCLUDE SINGLE BEAM OR MULTI-BEAM ANTENNAS. IN THE CASE OF MULTI-BEAM ANTENNAS, THE RF SECTOR MAY DIFFER TO THE PHYSICAL SECTOR.
- 3. THE PHYSICAL ANTENNA NUMBER DEFINED BY ASSIGNING SEQUENCED NUMBERS TO EACH JV OPERATOR'S ANTENNAS WITHIN A PHYSICAL SECTOR GROUP, STARTING FROM LEFT TO RIGHT, TOP TO BOTTOM.
- 4. THE PHYSICAL ANTENNA ID IS DEFINED BY THE NUMBER MADE UP BY CONCATENATING THE PHYSICAL SECTOR GROUP NUMBER WITH THE PHYSICAL ANTENNA NUMBER & THE FIRST LETTER FROM THE OPERATOR'S NAME OR JOINT (O, V, J), SAME AS THE SAO NUMBER, AS SPECIFIED IN OSD-070 SECTION 5,6
- 5. ANTENNA CO-ORDINATES ARE TO BE IN GDA94/GDA2020 REFERENCE SYSTEM, SPECIFIED FOR CENTRE OF EACH SECTOR TO NEAREST METRE.
- 6. THE PHYSICAL AZIMUTH () DEFINED AS THE DIRECTION OF THE PHYSICAL ANTENNA BORE SIGHT WITH RESPECT TO TRUE NORTH, AZIMUTHS OF EACH BEAM OF MULTI-BEAM ANTENNAS ARE NOT DOCUMENTED IN THIS TARI F
- 7. THE PHYSICAL ANT CL EL (m) IS DEFINED AS THE MID-HEIGHT OF THE PHYSICAL ANTENNA. THE HEIGHT OF INDIVIDUAL BEAMS OR DIFFERENT SEGMENTS OF MULTI-BEAM OR HYBRID ANTENNAS (IPAA) ARE NOT DOCUMENTED IN THIS TABLE.
- 8. ELECTRICAL DOWN-TILTS ARE ONLY ACCURATE AT THE TIME OF BUILD AS THEY ARE FREQUENTLY OPTIMISED. ALWAYS REFER TO CURRENT VALUES IN MNIS.

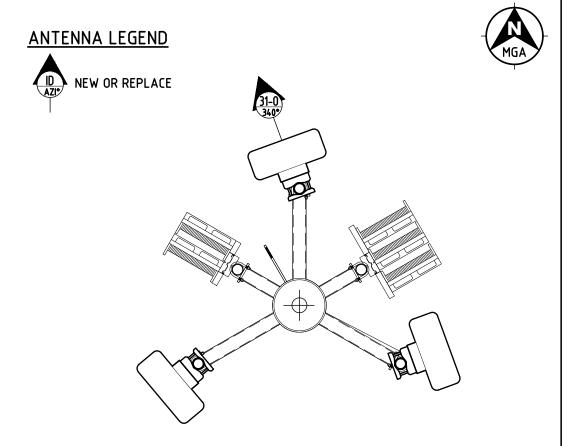

OPTUS ANTENNA PLAN
SCALE 1:25

Drawing Title:

OPTUS PANEL ANTENNA SYSTEM CONFIGURATION - SECTOR 3

FOR CONSTRUCTION

S0200-A3

Revision B

PHYSICAL ASSET SUMMARY TABLE

EQUIPMENT ALIAS	PART NO.	STATUS	LOCATION	OPERATOR	PHY ANT GRP	QTY	FREQUENCY	MFR	RF PORT TYPE	DIM (H x W x D)	WT (Kg)
850 REJ	E14V00P79	NEW	ANTENNA	0	1	1	85	COMMS	4.3-10	292 × 219 × 124	9.2
850 REJ	E14V00P79	NEW	ANTENNA	0	2	1	85	COMMS	4.3-10	292 × 219 × 124	9.2
850 REJ	E14V00P79	NEW	ANTENNA	0	3	1	85	COMMS	4.3-10	292 × 219 × 124	9.2

RADIO UNITS												
EQUIPMENT ALIAS	PART NO.	STATUS	LOCATION	OPERATOR	PHY ANT GRP	QTY	RF PORT CONNECTED	MFR	NO. RF PORTS / TxRx	RF PORT TYPE	DIM (H x W x D)	WT (Kg)
RRU 700/900	RRU6626	NEW	ANTENNA	0	1, 2, 3	2	6	ERICSSON	6T6R	4.3-10	786 × 397 × 192	48.75
RRU 1800/2100	RRU4490	NEW	ANTENNA	0	1	1	4	ERICSSON	4T4R	4.3-10	552 × 397 × 146	24.5
RRU 1800/2100	RRU4490	NEW	ANTENNA	0	2	1	4	ERICSSON	4T4R	4.3-10	552 × 397 × 146	24.5
RRU 1800/2100	RRU4490	NEW	ANTENNA	0	3	1	4	ERICSSON	4T4R	4.3-10	552 × 397 × 146	24.5

COAXIAL FEEDER / HFDC TRUNK CABLES							
CABLE ALIAS	STATUS	LENGTH (m)	OPERATOR	PHY ANT GRP	QTY	COAX BAND ASSIGNMENT	MFR
HFDC 6/12	EXISTING	70m	0	1	1	FOR SECTOR 1 (2 X RRU6626 IS TO BE CONNECTED ON SECTOR 1 CABLE TRUNK)	H+S
HFDC 6/12	EXISTING	70m	0	2 & 3	1	SHARED BETWEEN SECTOR 2 & 3	H+S



NOTES:

- 1. THIS DRAWING SHALL BE READ IN CONJUNCTION WITH RF PLUMBING DIAGRAM DRAWING S0200-P1.
- 2. ANTENNA CO-ORDINATES ARE SPECIFIED FOR CENTRE OF STRUCTURE, TO THE NEAREST METRE.
- 3. INFORMATION IN THE TABLES SUPPLIED AND VERIFIED BY OPTUS.
- 4. ANCILLARIES REFER TO ITEMS AT OR NEAR THE ANTENNA.
- 5. THE TAIL LENGTH BETWEEN RRU AND ANTENNA NOT TO EXCEED 10m.
- 6. EXISTING OPTUS H&S 6/12" MLEH TRUNK CABLES (1 OFF) FOR SECTOR 1 (700/900/1800/2100) RRUs. LENGTH 70m.
- 7. EXISTING OPTUS H&S 6/12" MLEH TRUNK CABLE (1 OFF) SHARED BETWEEN SECTOR 2 & 3 (1800/2100) RRUs. LENGTH 70m.


					:			
						-		
В	03.04.25	ISSUED FOR CONSTRUCTION (UPGRADE 5G (00 MOCN))	RMSI	ΜV	KK	AQ	HR	
Α	28.04.22	FOR CONSTRUCTION	RMSI	RT	KK :	VR :	RS :	
Rev	Date	Revision Details	Consultant	CAD	Designer	Verifier	Approver	






MOBILE NETWORK AUSTRALIA SITE No:- S0200 **THREDBO**

Drawing Title:	
PHYSICAL ASSET SUI	MMARY
TABLE	
Drawing Status:	Drawing No.

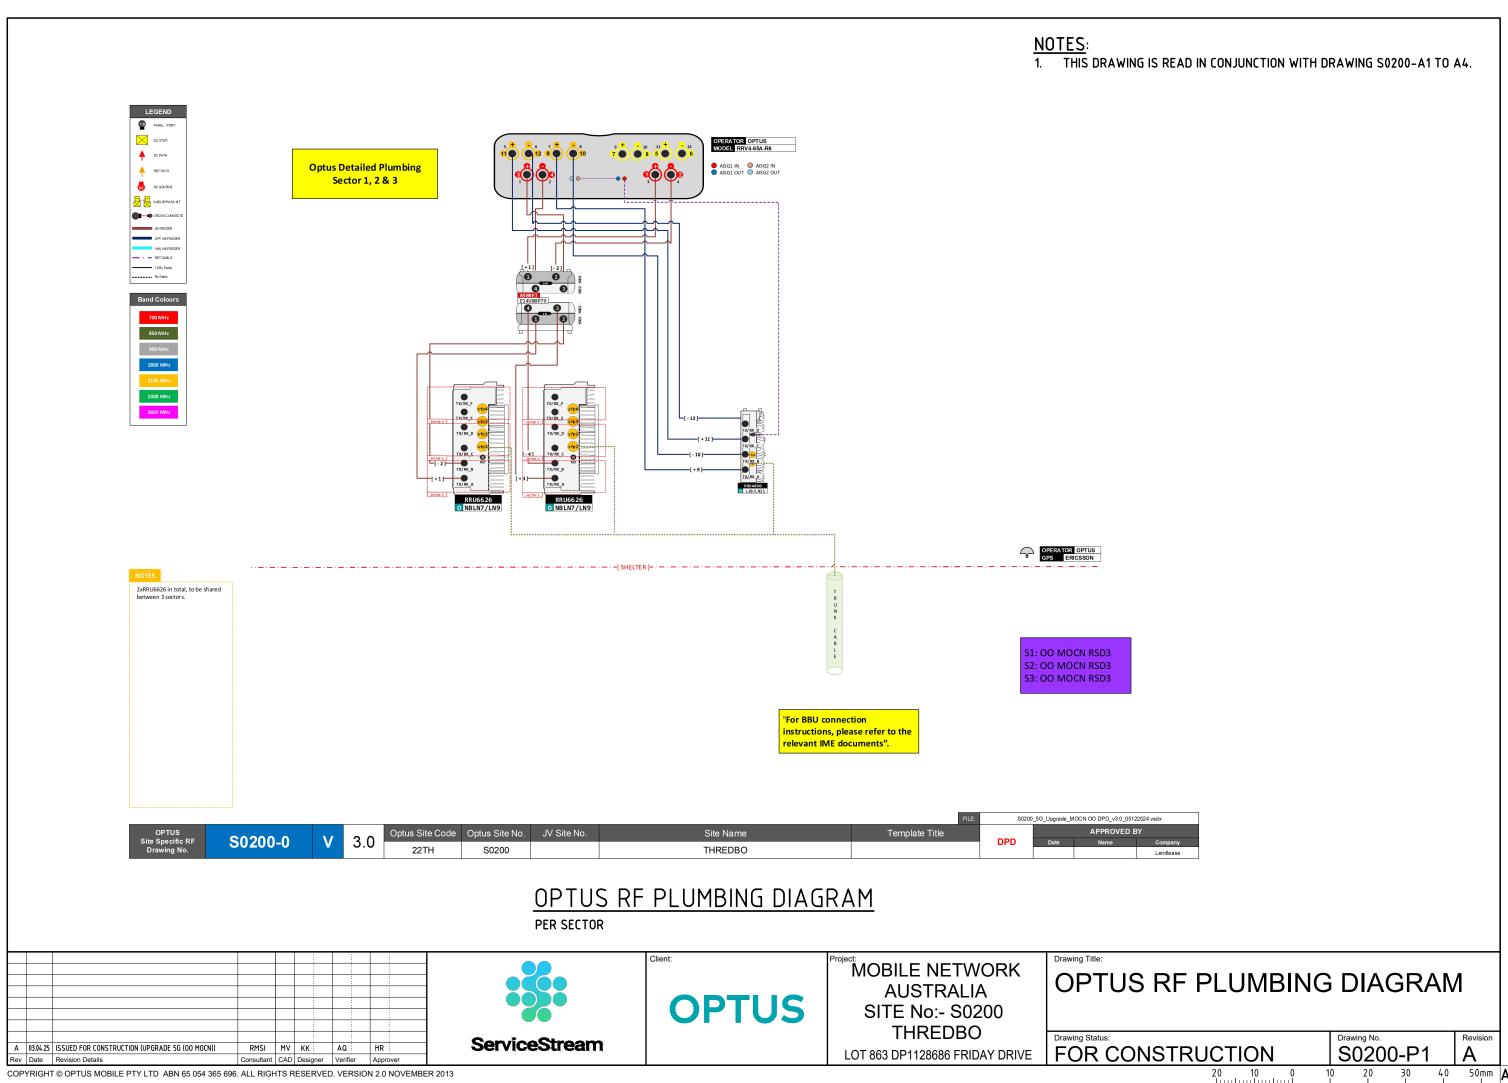

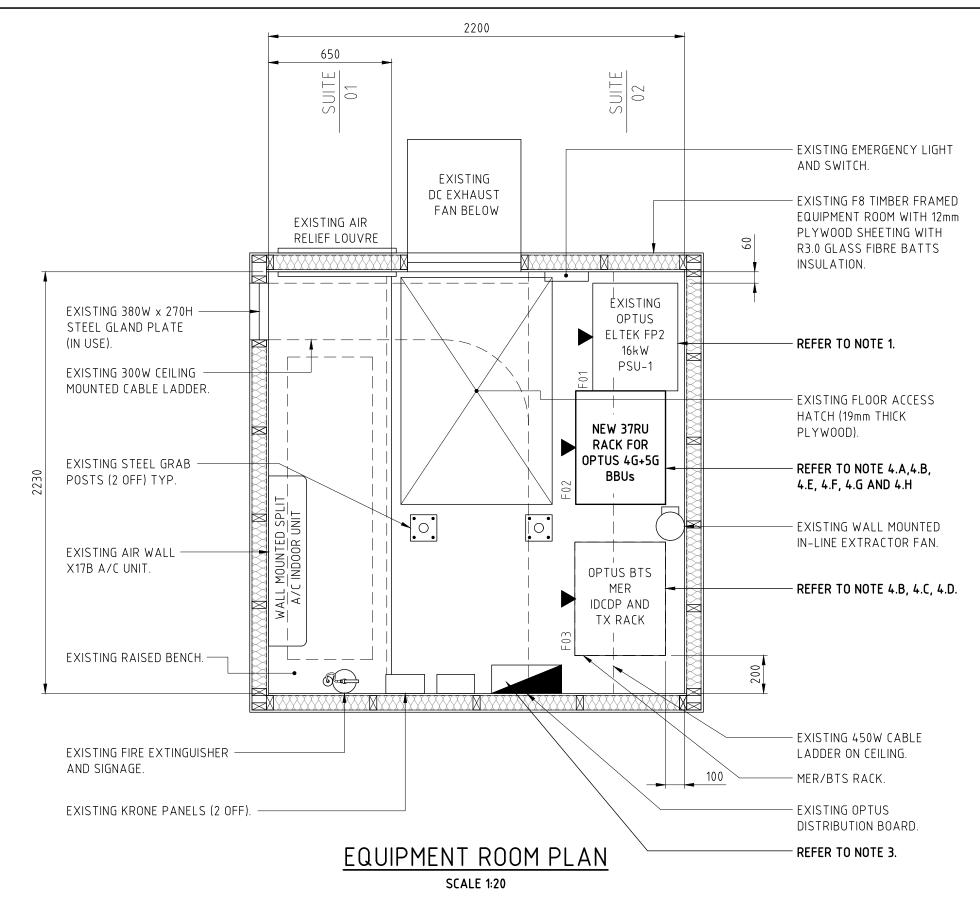

NOTE:

FOR ALL INSTALLATION OF THE EQUIPMENT REFER TO OPTUS ENGINEERING ORDER FOR DETAILS AND OPTUS CURRENT INSTALLATION GUIDELINES.

1. REUSED EXISTING ELTEK 18kW PSU:

- RECOVER EXISITING 2 x SILVER RECTIFIERS AND 1 x FAULTY RECTIFIER AT SLOT 5
- PROPOSED 3 x FP2 HE 2kW RECTIFIERS, TOTAL 6 X FP2 HE 2kW RECTIFIERS.
- RELOCATE ALL RECTIFIERS, TO ENSURE IT BALANCE ACROSS 3 PHASE.
 REFER TO "PSU RECTIFIER RESTRICTION CONFIGURATION TABLE" FOR RECTIFIERS ALLOCATION
- NO CHANGES TO THE EXISTING BATTERIES STRINGS, TOTAL 5 STRINGS OF BATTERIES.

2. IDCDP CONFIGURATION:

- EXISTING 15 WAY IDCDP IS TO BE REUSED AND RECONFIGURED FOR OPTUS PROPOSED RRUS CONTRACTOR TO ENSURE ALL DC FEED IS CONFORM WITH OPTUS 112% RULE, POLE FILLER TO BE INSTALLED.
- PROPOSED 3 x POLE FILLER, 4 x 32A FOR THE IDCDP, REUSED EXISTING 6 x 40A CB.

3. A/C COOLING SYSTEM:


CONTRACTOR IS TO REWIRE AND ENSURE THAT THE A/C UNIT IS CONNECTED TO PHASE 3 ONLY.

4. BBU:

- A. EXISTING 1 x OPTUS HUAWEI U9/U21 BTS RACK /BBUs IS TO BE RECOVERED, (RFU AND BBU INCLUDED).
- B. EXISTING TX EQUIPMENT IS TO BE RELOCATED FROM SUITE 02 F02 TO SUITE 02 F03
- C. ENSURE ALL EXISTING TX EQUIPMENT IS POWER VIA THE APDP OR DCDU UNIT DIVERSIFIED BOTH FEED
- D. RECOVER EXISITNG 2 x LEGACY ERICSSON BBUs
- E. PROPOSED 1 x 37RU MER RACK AT SUTIE 02 F02
- F. PROPOSED 1 x ERICSSON BBUs FOR OPTUS 4G AND 5G
- TECHNOLOGY AS PER LATEST OPTUS ERICSSON LATEST BTS DESIGN
- G. PROPOSED 1 x C6610 CONTROLLER AND 1 x SAU
- H. PROPOSED 1 x VERTIV 12 WAY DCDU FOR POWERING ERICSSON RP6651.

5. ALARM SYSTEM:

- ALL EXTERNAL ALARMS (ENVIRONMENTAL ETC) TO BE MIGRATED FROM 3G TO 4G AND 5G BBU.
- ALL KRONE PANELS TO BE REPLACED WITH RJ45 PATCH PANELS.

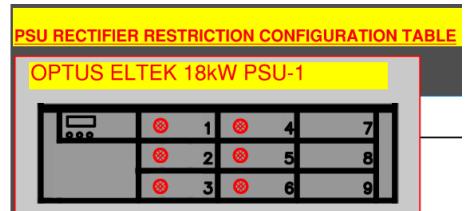

					- :		i
В	03.04.25	ISSUED FOR CONSTRUCTION (UPGRADE 5G (00 MOCN))	RMSI	MV	EY	RI :	HR :
Α	28.04.22	FOR CONSTRUCTION	RMSI	RT	KK	VR	RS
AB	29.07.21	AS BUILT (REGIONAL UG)	LENDLEASE	SRS	_	_	SA
С	25.03.21	NOTES AMENDED & ISSUED FOR CONSTRUCTION	LENDLEASE	AB	AQ :	SK :	SK
В	20.07.20	ISSUED FOR CONSTRUCTION	AXICOM	ADC	GJF	GL	GS :
Α	30.01.19	FOR CONSTRUCTION	DALY	BRS	SC	DI	СТ
AB	22.01.09	AS BUILT	DALY	DI	JM :	DI :	СТ
Rev	Date	Revision Details	Consultant	CAD	Designer	Verifier	Approver






MOBILE NETWORK
AUSTRALIA
SITE No:- S0200
THREDBO

LOT 863 DP1128686 FRIDAY DRIVE

Drawing Title:
EQUIPMENT ROOM LAYOUT
SHEET 1 OF 3

Drawing Status:
FOR CONSTRUCTION

Drawing No. Revisi

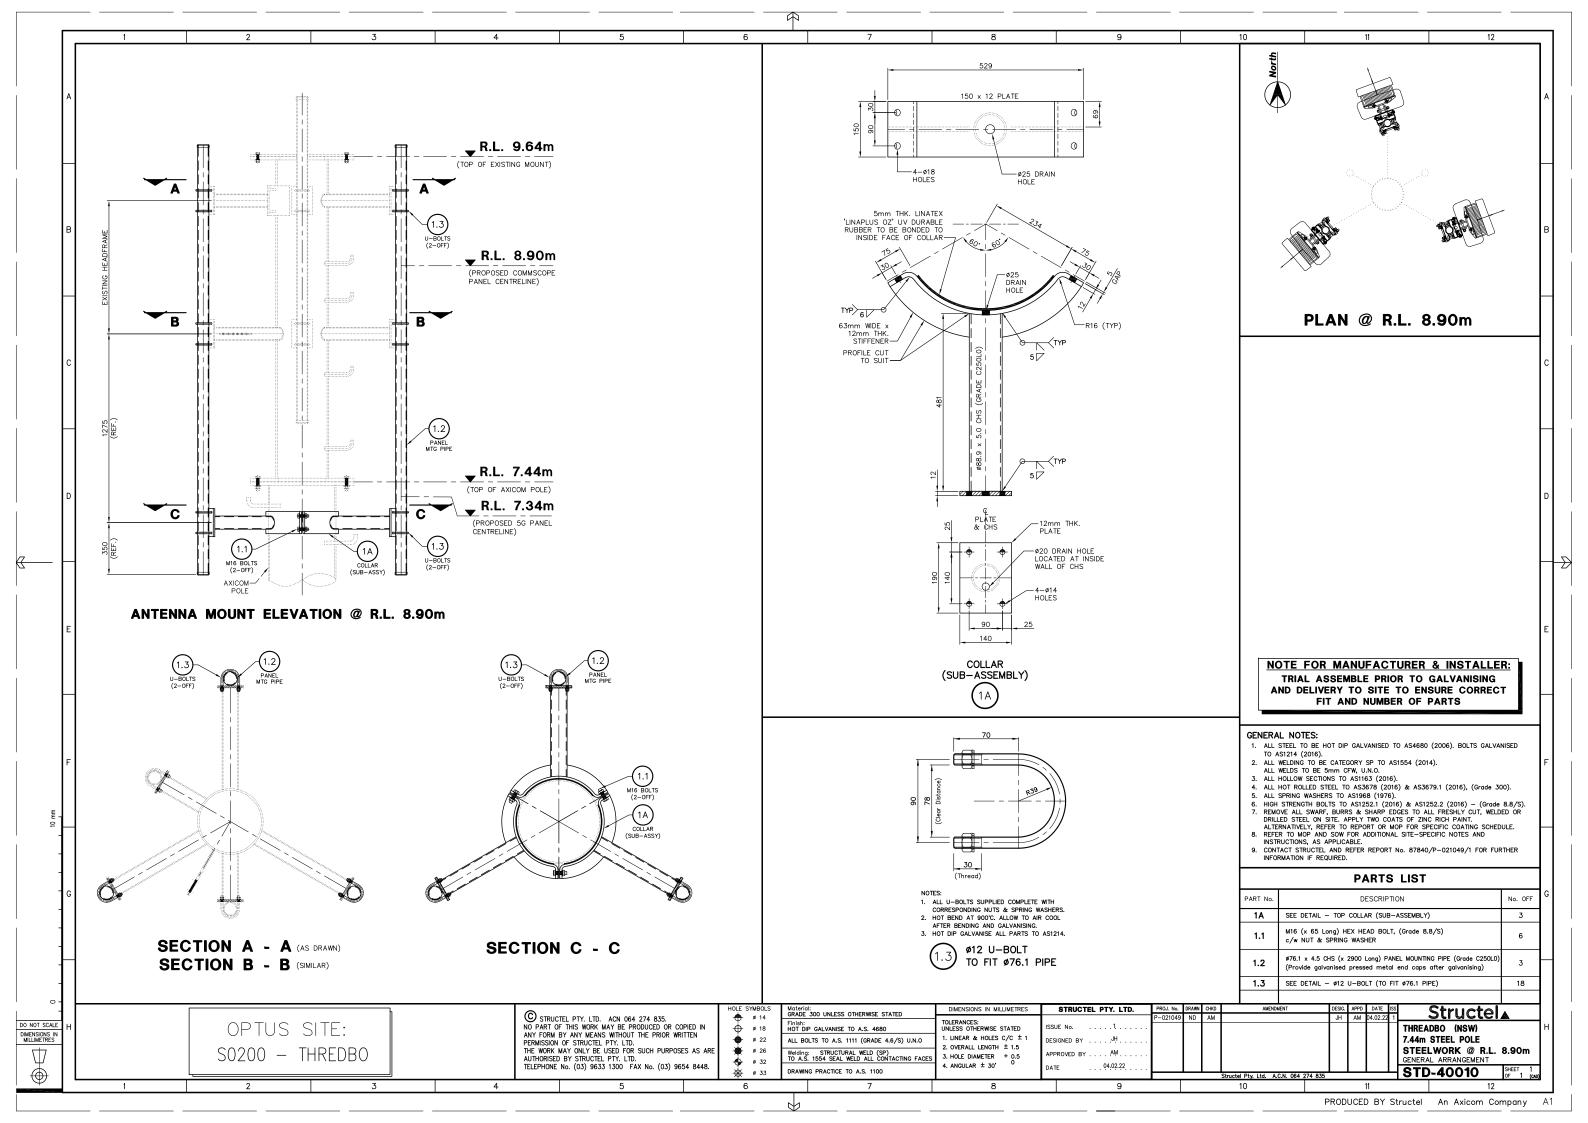

- 1. THE CONTRACTOR SHALL COMPLY WITH THE REQUIREMENTS OF THE SPECIFICATIONS FOR ALL WORKS AND REQUIREMENTS UNLESS NOTED OTHERWISE.
- 2. THE CONTRACTOR OR REPRESENTATIVE SHALL BE RESPONSIBLE FOR LIAISONS WITH THE PROPERTY OWNER REGARDING CONSTRUCTION OF THE INSTALLATION. THE PROPERTY MUST REMAIN SERVICEABLE AND OPERATIONAL AT ALL TIMES UNLESS AGREED WITH THE PROPERTY OWNER.
- 3. THE CONTRACTOR SHALL CONFIRM ALL DIMENSIONS ON SITE PRIOR TO FABRICATION AND CONSTRUCTION
- 4. REFER TO GIVEN DIMENSIONS ONLY, DRAWINGS SHOULD NOT TO BE SCALED. DIMENSIONS ARE IN MILLIMETRES UNO.
- 5. SPECIFIED PRODUCTS (OR THEIR APPROVED EQUIVALENTS) SHALL BE INSTALLED IN ACCORDANCE WITH THE MANUFACTURER'S SPECIFICATIONS.
- 6. THE CONTRACTOR SHALL USE DROP SHEETS OR ANY OTHER METHOD DEEMED NECESSARY TO PROTECT THE EXISTING **BUILDING FROM DAMAGE DURING CONSTRUCTION.**
- 7. NORTH POINT AS SHOWN ON DRAWINGS INDICATES MGA NORTH (GDA 94 DATUM) UNLESS NOTED OTHERWISE.
- 8. ANTENNA AZIMUTHS ARE SPECIFIED IN DEGREES REFERENCED TO TRUE NORTH (TN).
- ALL LEVELS ARE EXPRESSED IN METRES TO AUSTRALIAN HEIGHT DATUM (AHD).

- 1. THE CONTRACTOR SHALL BE RESPONSIBLE FOR SET OUT OF THE SHELTER OR OUTDOOR UNITS IN ACCORDANCE WITH THE DESIGN INTENT AS SHOWN ON THE DRAWINGS
- 2. THE CONTRACTOR SHALL BE RESPONSIBLE FOR SET OUT OF THE CABLE LADDER IN ACCORDANCE WITH THE DESIGN INTENT AS SHOWN ON THE DRAWINGS.
- 3. CONCRETE WORKS TOLERANCES SHALL COMPLY WITH CLAUSE 17.5 OF AS 3600.
- 4. STRUCTURAL STEELWORK TOLERANCES SHALL COMPLY WITH CLAUSE 15.3 OF AS 4100.

USE OF OPTUS STANDARD DRAWINGS

CONSTRUCTION DETAILS ON OPTUS STANDARD DRAWINGS SHALL BE ONLY BE USED WITHIN THE SPECIFIED DESIGN CRITERIA. THE OPTUS DESIGN CONSULTANT SHALL CONFIRM APPLICABILITY TO THE SITE. THE OPTUS CONTRACTOR SHALL CONFIRM ACTUAL SITE CONDITIONS ARE SAME AS STATED ON THE STANDARD DRAWINGS REFERENCED.

STRUCTURAL STEELWORK

- 1. ALL MATERIALS AND WORKMANSHIP TO BE IN ACCORDANCE WITH AS 4100, AS 1657 AND AS/NZS 1554.1.
- 2. ALL STEELWORK SHALL BE IN ACCORDANCE WITH AS/NZS 3679.1 (GRADE 300) FOR HOT-ROLLED SECTIONS AND BARS), AS/NZS 3678 (GRADE 250) FOR HOT-ROLLED PLATES AND AS 1163 (GRADE 250 (MIN)) FOR HOLLOW SECTIONS.
- 3. THE CONTRACTOR SHALL CONFIRM ALL DIMENSIONS ON SITE PRIOR TO FABRICATION.
- 4. ALL PREFABRICATED STEELWORK SHALL BE HOT-DIP GALVANISED AFTER FABRICATION, IN ACCORDANCE WITH AS/NZS 4680. PLUG AND SEAL WATERTIGHT ANY HOLES MADE FOR GALVANISING.
- 5. THE CONTRACTOR SHALL PROVIDE ALL CLEATS AND HOLES NECESSARY FOR FIXING STEEL TO STEEL AND TIMBER TO STEEL, WHETHER OR NOT DETAILED ON THE STEELWORK DRAWINGS.
- 6. UNLESS SPECIFIED OTHERWISE, WELDS SHALL BE GENERAL PURPOSE (GP) CONTINUOUS FILLET WELDS. DEFAULT SIZE IS LESSOR OF 6mm AND THICKNESS OF THE THINNEST PART, BEING JOINED. STRUCTURAL PURPOSE (SP) WELDS SHALL BE SELECTED FOR STRUCTURES SUBJECT TO FATIGUE.
- 7. ANY CUTS, HOLES AND WELDS TO EXISTING STEELWORK SHALL BE TREATED WITH 'COLD-GAL' ZINC RICH PAINT.
- 8. BOLTS NOT DESIGNATED SHALL BE GRADE 8.8 TO AS/NZS 1252 AND 'SNUG' TIGHTENED.
- 9. ALL BOLTS AND U-BOLTS, SHALL BE SNUG TIGHTENED AND SECURED WITH FLAT WASHER AND SPRING WASHER (UNLESS SPECIFIED OTHERWISE).
- 10. PROVIDE APPROVED NEOPRENE (OR EQUIVALENT) WASHERS AND COLLARS AT ALL DISSIMILAR METAL INTERFACES.
- 11. ALL CHEMICAL AND MECHANICAL MASONRY ANCHORS SHALL BE STAINLESS STEEL (UNLESS SPECIFIED OTHERWISE) AND INSTALLED IN ACCORDANCE WITH THE MANUFACTURER'S SPECIFICATION.
- 12. TWO-HOLE EARTH LUGS SHALL BE PROVIDED ON ALL MOUNTS, EXCEPT ON STEEL MONOPOLES, LATTICE TOWERS AND **GUYED MASTS.**

CONCRETE WORK

- 1. ALL CONCRETE WORK SHALL COMPLY WITH THE CURRENT ISSUE OF AS 3600 AND OTHER RELEVANT STANDARDS REFERENCED THEREIN.
- 2. UNLESS SPECIFIED OTHERWISE, CONCRETE MIX SHALL CONTAIN PORTLAND CEMENT TYPE GP OR GB, 20mm GRADED COARSE AGGREGATE AND ACHIEVE 80mm SLUMP AT POINT OF DELIVERY.
- 3. UNLESS SPECIFIED OTHERWISE, CONCRETE COMPRESSIVE STRENGTH AT 28 DAYS (f'c) SHALL BE 32 MPa.

HUAWEI TECHNOLOGIES (AU) PTY LTD
ABN 49 103 793 800 **OPTUS**

EVEL 6 TOWER B 799 PACIFIC HIGHWAY

HUAWEI

MOBILE NETWORK **AUSTRALIA**

OPTUS STANDARD DRAWING

STANDARD **CONSTRUCTION NOTES**

FOR CONSTRUCTION

OSD-100

THICKNESS (IF ANY).

ALL MASONRY WORK SHALL CONFORM WITH THE CURRENT ISSUE OF AS 3700 AND OTHER STANDARDS REFERENCED.

4. SIZES OF CONCRETE ELEMENTS DO NOT INCLUDE THICKNESS OF APPLIED COATINGS. BEAM DEPTHS INCLUDES SLAB

5. CONCRETE SURFACES SHALL BE CURED FOR A MINIMUM OF 7 DAYS, COMMENCING IMMEDIATELY AFTER PLACING.

- 2. BUILD IN AS NECESSARY, LINTELS, FRAMES, BOLTS, LUGS, WALL TIES AND METALWORK.
- 3. CAREFULLY POSITION OPENINGS FOR OTHER TRADES TO ELIMINATE CUTTING.
- 4. BED JOINTS ARE TO BE 10mm THICK.
- 5. BEFORE LAYING MASONRY UNITS, ENSURE THAT THE BASE IS CLEAN AND FREE OF LAITANCE.
- 6. INSTALL WIRING FOR POWER AND OTHER CONDUITS WITHIN BLOCK CORES (WHERE APPLICABLE). DO NOT CUT CHASES IN HOLLOW BLOCKWORK.
- 7. ALL WALL INTERSECTIONS SHALL BE OF BONDED CONSTRUCTION OR TIED TO EXISTING WITH MEDIUM DUTY (MIN) TIES AT 400mm CENTRES VERTICALLY.

- 1. ALL TIMBER WORK SHALL CONFORM WITH THE CURRENT ISSUE OF AS/NZS 1684 AND AS/NZS 1720 AND OTHER STANDARDS REFERENCED THEREIN.
- 2. MINIMUM STRENGTH GRADE SHALL BE F7, UNLESS SPECIFIED OTHERWISE.


ELECTRICAL WORK (POWER)

- 1. THE ELECTRICAL INSTALLATION SHALL COMPLY WITH THE RELEVANT CODES, STANDARDS, RULES, AND REGULATIONS OF STATUTORY AUTHORITIES. IN PARTICULAR: STATE SERVICE AND INSTALLATION RULES, AS/NZS 3000 WIRING RULES, AS3015, AS/NZS 3017 AND THE SUPPLY AUTHORITY REGULATIONS.
- 2. THE LOCATIONS AND MOUNTING HEIGHTS OF THE NEW INSTALLATION SHOWN ON THE SITE DRAWINGS IS INDICATIVE ONLY. THE FINAL LOCATIONS AND HEIGHTS SHALL BE DETERMINED ON SITE TO SUIT THE CLIENT AND THE INSTALLATION. THE CONTRACTOR SHOULD VISIT THE SITE DURING THE TENDER PERIOD TO BECOME FAMILIAR WITH THE SCOPE OF WORK.
- 3. ALL REQUIREMENTS FOR INSTALLATIONS REGARDING SUPPLY ARRANGEMENTS, PROVISION OF SERVICE CABLES AND CONSUMER MAINS AND METERING SHALL BE IN ACCORDANCE WITH AS/NZS 3000 AND RELEVANT STATE SERVICE AND INSTALLATION RULES.
- 4. A SEPARATE MEN EARTH ELECTRODE SHALL BE PROVIDED BY THE CONTRACTOR BELOW THE METER BOX AS REQUIRED.
- 5. ALL WIRING SYSTEMS SHALL BE INSTALLED AND ENCLOSED BY APPROVED METHODS WHICH WILL READILY PERMIT CABLES TO BE DRAWN IN OR REPLACED AFTER COMPLETION OF CONSTRUCTION.
- 6. CABLE MARKERS SHALL BE PROVIDED FOR UNDERGROUND WIRING FROM WITHIN THE PROPERTY BOUNDARY AND TO THE OPTUS INSTALLATION, AT THE COMMENCEMENT AND FINISH OF EACH ROUTE AND AT EACH CHANGE OF DIRECTION.
- 7. ALL EXISTING SURFACES, KERBS, GUTTERS, INVERTS, VEHICLE CROSSINGS AND PAVEMENTS DISTURBED AFTER INSTALLATION OF UNDERGROUND WIRING SHALL BE REINSTATED AND MADE GOOD BY THE CONTRACTOR.
- 8. LOCATE AND INDENTIFY ALL UNDERGROUND SERVICES BEFORE COMMENCING WORK.

- 1. EQUIPMENT AND ANTENNA MOUNTS SHALL BE EARTHED IN ACCORDANCE WITH THE EARTHING SPECIFICATION (OSD-030).
- 2. ALL EXTERIOR EARTH TAPE ELECTRODES SHALL BE COPPER BONDED HARDENED STEEL UNLESS OTHERWISE NOMINATED ON THE SITE DRAWINGS.
- 3. THE EARTHING SYSTEM SHALL BE CHECKED FOR CONTINUITY AND IMPEDANCE SHALL BE MEASURED AND A WRITTEN TEST
- 4. EARTHING ELECTRODES SHALL BE INSTALLED AT A DEPTH OF NOT LESS THAN 3 METRES UNLESS NOTED OTHERWISE.

UNDERGROUND SERVICES

- 1. EXISTING SERVICES SHOWN ON SITE DRAWINGS IS REPRESENTATIVE OF AVAILABLE INFORMATION (OBTAINED FROM LOCAL AUTHORITIES) AND THE SITE SURVEY.
- 2. SERVICES INFORMATION SHALL BE READ IN CONJUNCTION WITH THE RELEVANT LOCAL AUTHORITIES DRAWINGS TO CONFIRM ACCURACY AND COMPLETENESS.
- 3. ADDITIONAL UNDOCUMENTED SERVICES MAY BE PRESENT ON SITE. FOR INFORMATION OF UTILITY UNDERGROUND SERVICES CALL 1100 'DIAL BEFORE YOU DIG'.
- 4. THE CONTRACTOR SHALL IDENTIFY AND CONFIRM THE LOCATION OF ALL RELEVANT UNDERGROUND SERVICES PRIOR TO COMMENCEMENT OF THE WORKS USING MANUAL POTHOLING OR OTHER APPROVED MEANS.

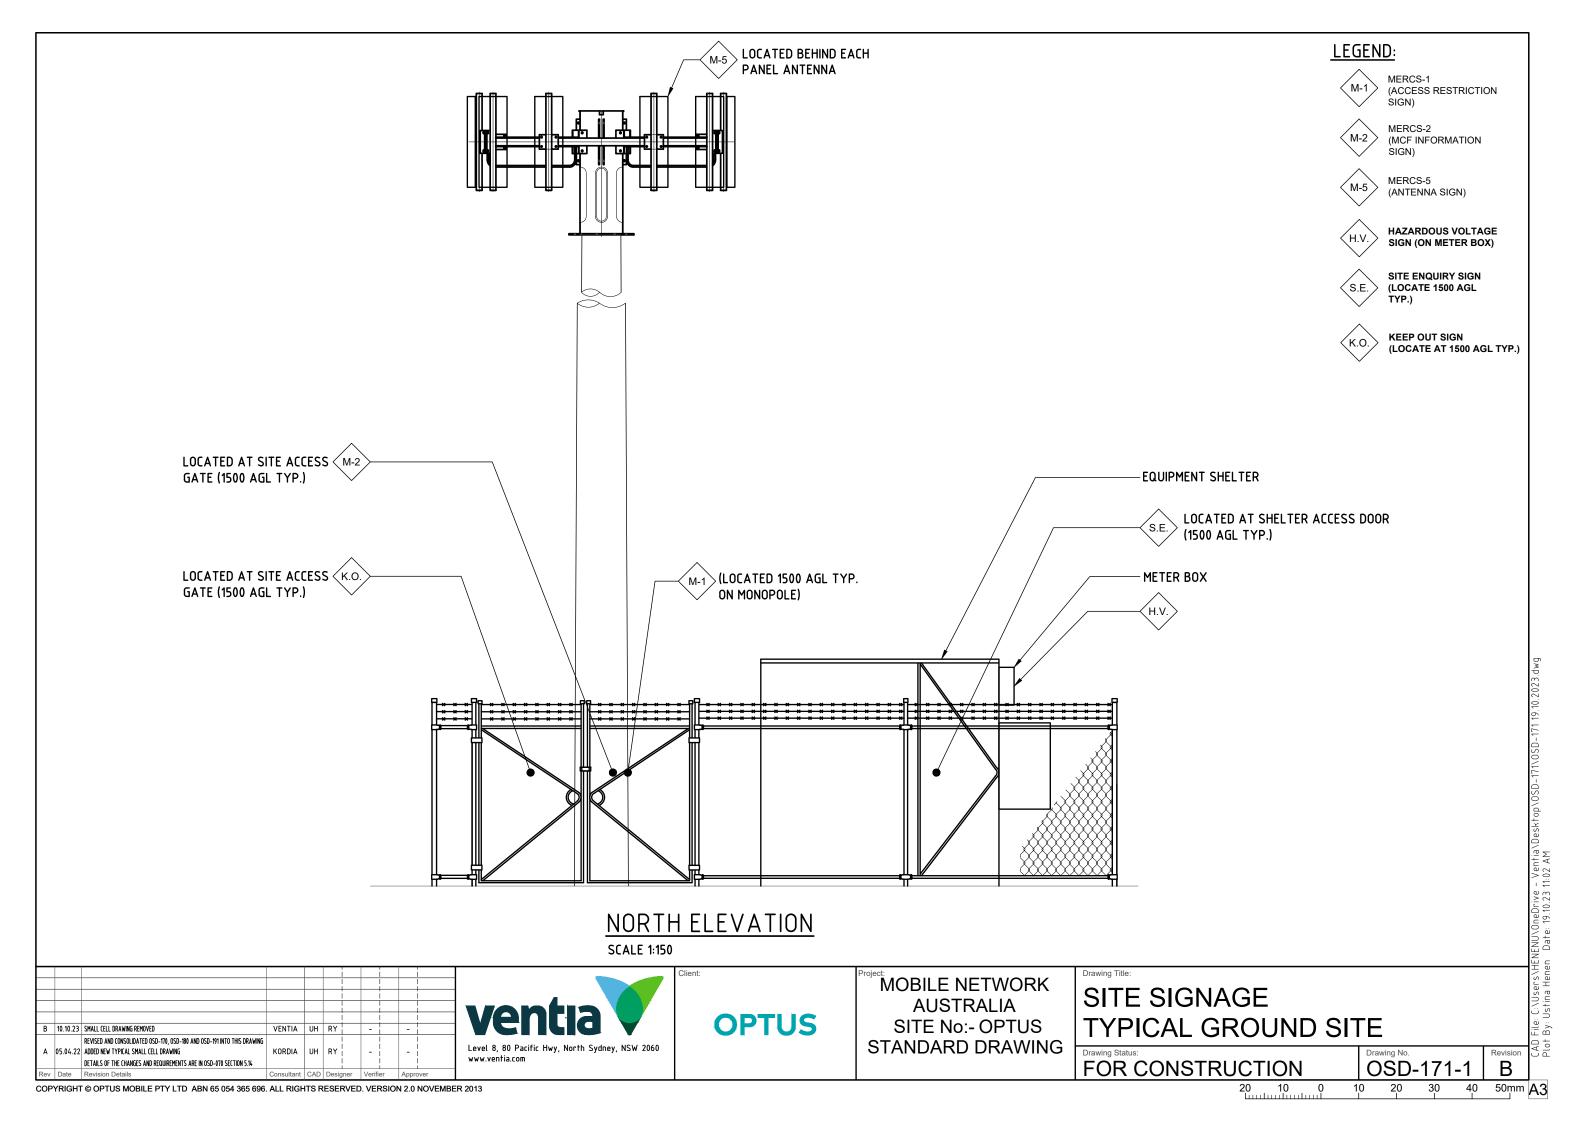

SIGNAGE LEGEND

SIGN NAME	SYMBOL	SIGN IMAGE
MERCS-1 (ACCESS RESTRICTION SIGN)	M-1	RF Hazard Area Beyond this Point Gunt of the Point Gunt of the Point Gunt of the Point Contact Failily Humgar (In Seed Swinner or In Manage Area or In
MERCS-2 (MCF INFORMATION SIGN)	M-2	This is a belecommunications facility. For Information about this site visit wave trians com as use and or contact the facility manager. NSA Site Number:
MERCS-3 (NO PEDESTRIAN ACCESS GENERAL PUBLIC SIGN)	M-3	Ceneral Public RF Hazard Boundary Beyond the poter
MERCS-4 (NO PEDESTRIAN ACCESS OCCUPATIONAL SIGN)	M-4	Comprehent RY Humand Boundary Beyond this point Boundary Beyond attack Veryong RF Preser Sed Clause
MERCS-5 (ANTENNA SIGN)	M-5	
MERCS-6 (MICROWAVE ANTENNA SIGN)	M-6	Transmitting Antenna RF hazard zone inside dish
MERCS-7 (CONCEALED ANTENNA SIGN)	M-7	Concealed Transmitting Antenna Art hand care development this paths. Conclusion in the particular p
MERCS-8A (MICROCELL SIGN 2m)	M-8A	
MERCS-8B (MICROCELL SIGN 1m)	M-8B	RF Hazard Area
MERCS-8C (MICROCELL SIGN 0.5m)	M-8C	Do not approach which I motive of others which you fill the hammatic. Consect

SIGN NAME	SYMBOL	SIGN IMAGE
MERCS-9 (IN-BUILDING ANTENNA SIGN)	M-9	
MERCS-10 (REPEATER ANTENNA SIGN)	M-10	
MERCS-14 (ISOLATION SWITCH SIGN)	M-14	Transmitting Antenna RF Hezard above this point holistic method devices the point before stream is switched off. Committees Name Tritte the hander. Contact [Carrington]
MERCS-15 (MACRO SIGN AT 3.5m ABOVE AGL TYP.)	M-15	Transmitting Antonna RF Hazard above this point for Hazard above this point situd for tendeding Cartier Chance SPEAN Vallable Word-Windows and FEMA On Sealing Cartier Chance SPEAN Vallable Word-Windows and
MERCS-16 (MACRO SIGN)	M-16	Transmitting Antonna RF Hazard within 3m redius of powerfine De set Process down the parts construction of Parts construction of Parts construction of Parts process down the parts pro
MERCS-17 (STREET LIGHT SIGN)	M-17	Transmitting Antomine RF Hazard above this point Do not proceed above this point and do not access error light before missions to enchance of mentions and access and access and access resultance and access Contact Transmi
MERCS-18 (SMALL CELL SIGN)	M-18	Transmitting Anhanna On Neerby Pole RF Hazard above this polyf. Do not Proceed above this polyf. Covert SYMAN Microlla 1979M She Shealter Contest [Carrier] Contest [Carrier] Contest [Carrier] Contest [Carrier]

SIGN NAME	SYMBOL	SIGN IMAGE
MERCS-19 (SMALL CELL ISOLATION SWITCH SIGN AFFIXED NO HIGHER THAN 4m AGL TYP.)	M-19	Transmitting Antenna Antenna delication to plant by plant for sells access Antenna delication del
MERCS-20 (GENERIC ADJACENT RF HAZARD SIGN)	M-20	RF Hazard from nearby Transmitter Consult Educate for Details
HAZARDOUS VOLTAGE SIGN ON METER BOX	H.V.	DANGER HAZARDOUS VOLTAGE
SITE ENQUIRY SIGN (LOCATE 1500 AGL TYP.)	S.E.	FOR ALL ENQUIRIES CALL 1800 505 777
KEEP OUT SIGN (LOCATE 1500 AGL TYP.)	K.O.	KEEP OUT AUTHORISED PERSONNEL ONLY
KEEP OFF ROOF SIGN (LOCATE AT EDGE OF ROOF AT POINT OF ACCESS	K.O.R	MANGER KEEP OFF BRITTLE AND FRAGILE ROOF
LOAD EXCLUSION SIGN (LOCATE 1500 AGL TYP.)	L.E.	NO EQUIPMENT OR MATERIALS SHALL BE STORED WITHIN THE MARKED AREA AROUND THE EQUIPMENT SHELTER
EQUIPMENT LOADING SIGN (LOCATE 1500 AGL TYP.)	E.L.	TOTAL EQUIPMENT LOAD IN THIS SHELTER MUST NOT EXCEED 2800 kg
LADDER USE SIGN (LOCATE 1500 AGL TYP. TYP.)	L.U.	THIS LADDER IS TO BE USED ONLY BY PERSONNEL USING THE ANTI-FALL DEVICE AND WHO HAVE GAINED PERMISSION FOR ACCESS.
WALKWAY SIGN (ON WALKWAY OR HANDRAIL)	⟨w.⟩	WARNING REMAIN WITHIN WALKWAYS

SIGN NAME	SYMBOL	SIGN IMAGE
OPTUS ISOLATION SWITCH (MICROCELL RF SHUTDOWN SIGN)	(O.I.S.)	The Park of the Control of the Contr

- 1. REFER TO CURRENT RFSP, MANUAL 2 "PREFERRED SITE SIGNAGE" FOR EME SIGNAGE REQUIREMENTS AND INSTALLATION REQUIREMENTS.
- 2. REFER TO SECTION 5 OF THE OPTUS MOBILE NETWROK DRAWING SPECIFICATION (OSD-070) FOR DRAWING REQUIREMENTS.
- 3. REFER TO SECTION 6 OF THE OPTUS DESIGN & CONSTRUCTION SPECIFICATION (OSD-010) FOR SIGNAGE DETAILS INCLUDING SIZE, MATERIALS AND FIXING.
- 4. THIS IS A TEMPLATE DRAWING ONLY. ACTUAL SITE DRAWING MUST BE PRODUCED TO REFLECT SITE SPECIFIC CONDITION.

						i		i		i
								1		
						İ		i		İ
								İ		İ
В	10.10.23	SMALL CELL DRAWING REMOVED	VENTIA	UH	RY	l	-		-	
		REVISED AND CONSOLIDATED OSD-170, OSD-180 AND OSD-191 INTO THIS DRAWING				!		!		!
Α	05.04.22	ADDED NEW TYPICAL SMALL CELL DRAWING	KORDIA	UH	RY	i	-	ĺ	-	¦
		DETAILS OF THE CHANGES AND REQUIREMENTS ARE IN OSD-070 SECTION 5.14								!
Rev	/ Date	Revision Details	Consultant	CAD	Desig	ner	Verifi	er	Appro	over





MOBILE NETWORK AUSTRALIA SITE No:- OPTUS STANDARD DRAWING

ı	Drawing Status:	Drawing No.
	FOR CONSTRUCTION	08D

OSD-171-3 В FOR CONSTRUCTION 40 50mm **A3** 20 10 10