


1 AS BUILT SOUTH ELEVATION  
Scale 1:100

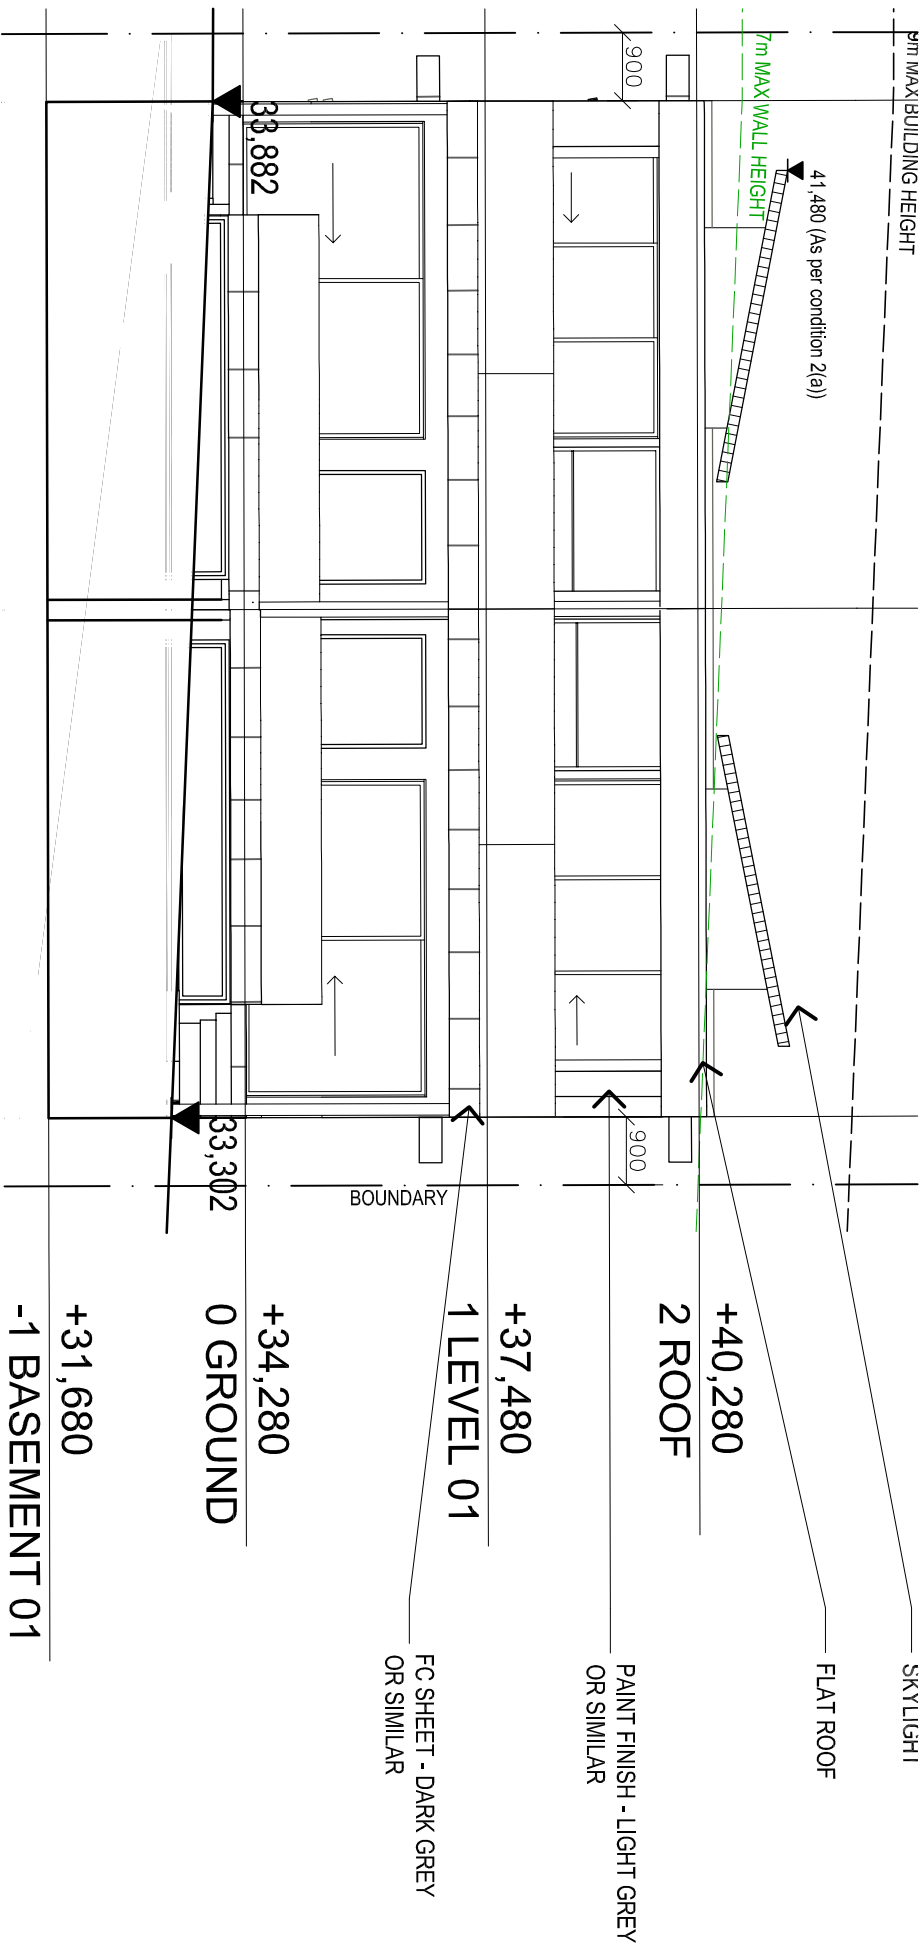

2 APPROVED SOUTH ELEVATION  
Scale 1:100