

DO NOT SCALE THESE DRAWINGS,  
READ ALL DEMENSIONS SHOWN.

ALL RIGHTS RESERVED.  
THESE DRAWINGS, PLANS AND SPECIFICATION  
AND COPYRIGHT ARE THE PROPERTY OF  
WARATAH GROUP AND MUST NOT BE USED,  
REPRODUCED OR COPIED WHOLLY OR IN PART  
WITHOUT THE WRITTEN PREMISSION OF  
WARATAH GROUP.



Waratah Group

Level 1  
Building 3  
20 Worth Street  
Chullora NSW  
2190 Australia

(02) 9758 7567  
www.waratahcertifiers.com.au

Drw	Chk	Description	Rev	Date
MA	AA	BIC Documentation	A	15/03/2022

Client Details  
Abdul Sayed


Project Details  
Unit 2, 22 Warwick Street, Punchbowl, NSW, 2196

Drawing Name  
Neighbour Notification

Date 15/03/2022 Scale Sheet scale A1


Drawn By MA Checked By AA

Job No. 2022-0075 Drawing No. A109 Revision A

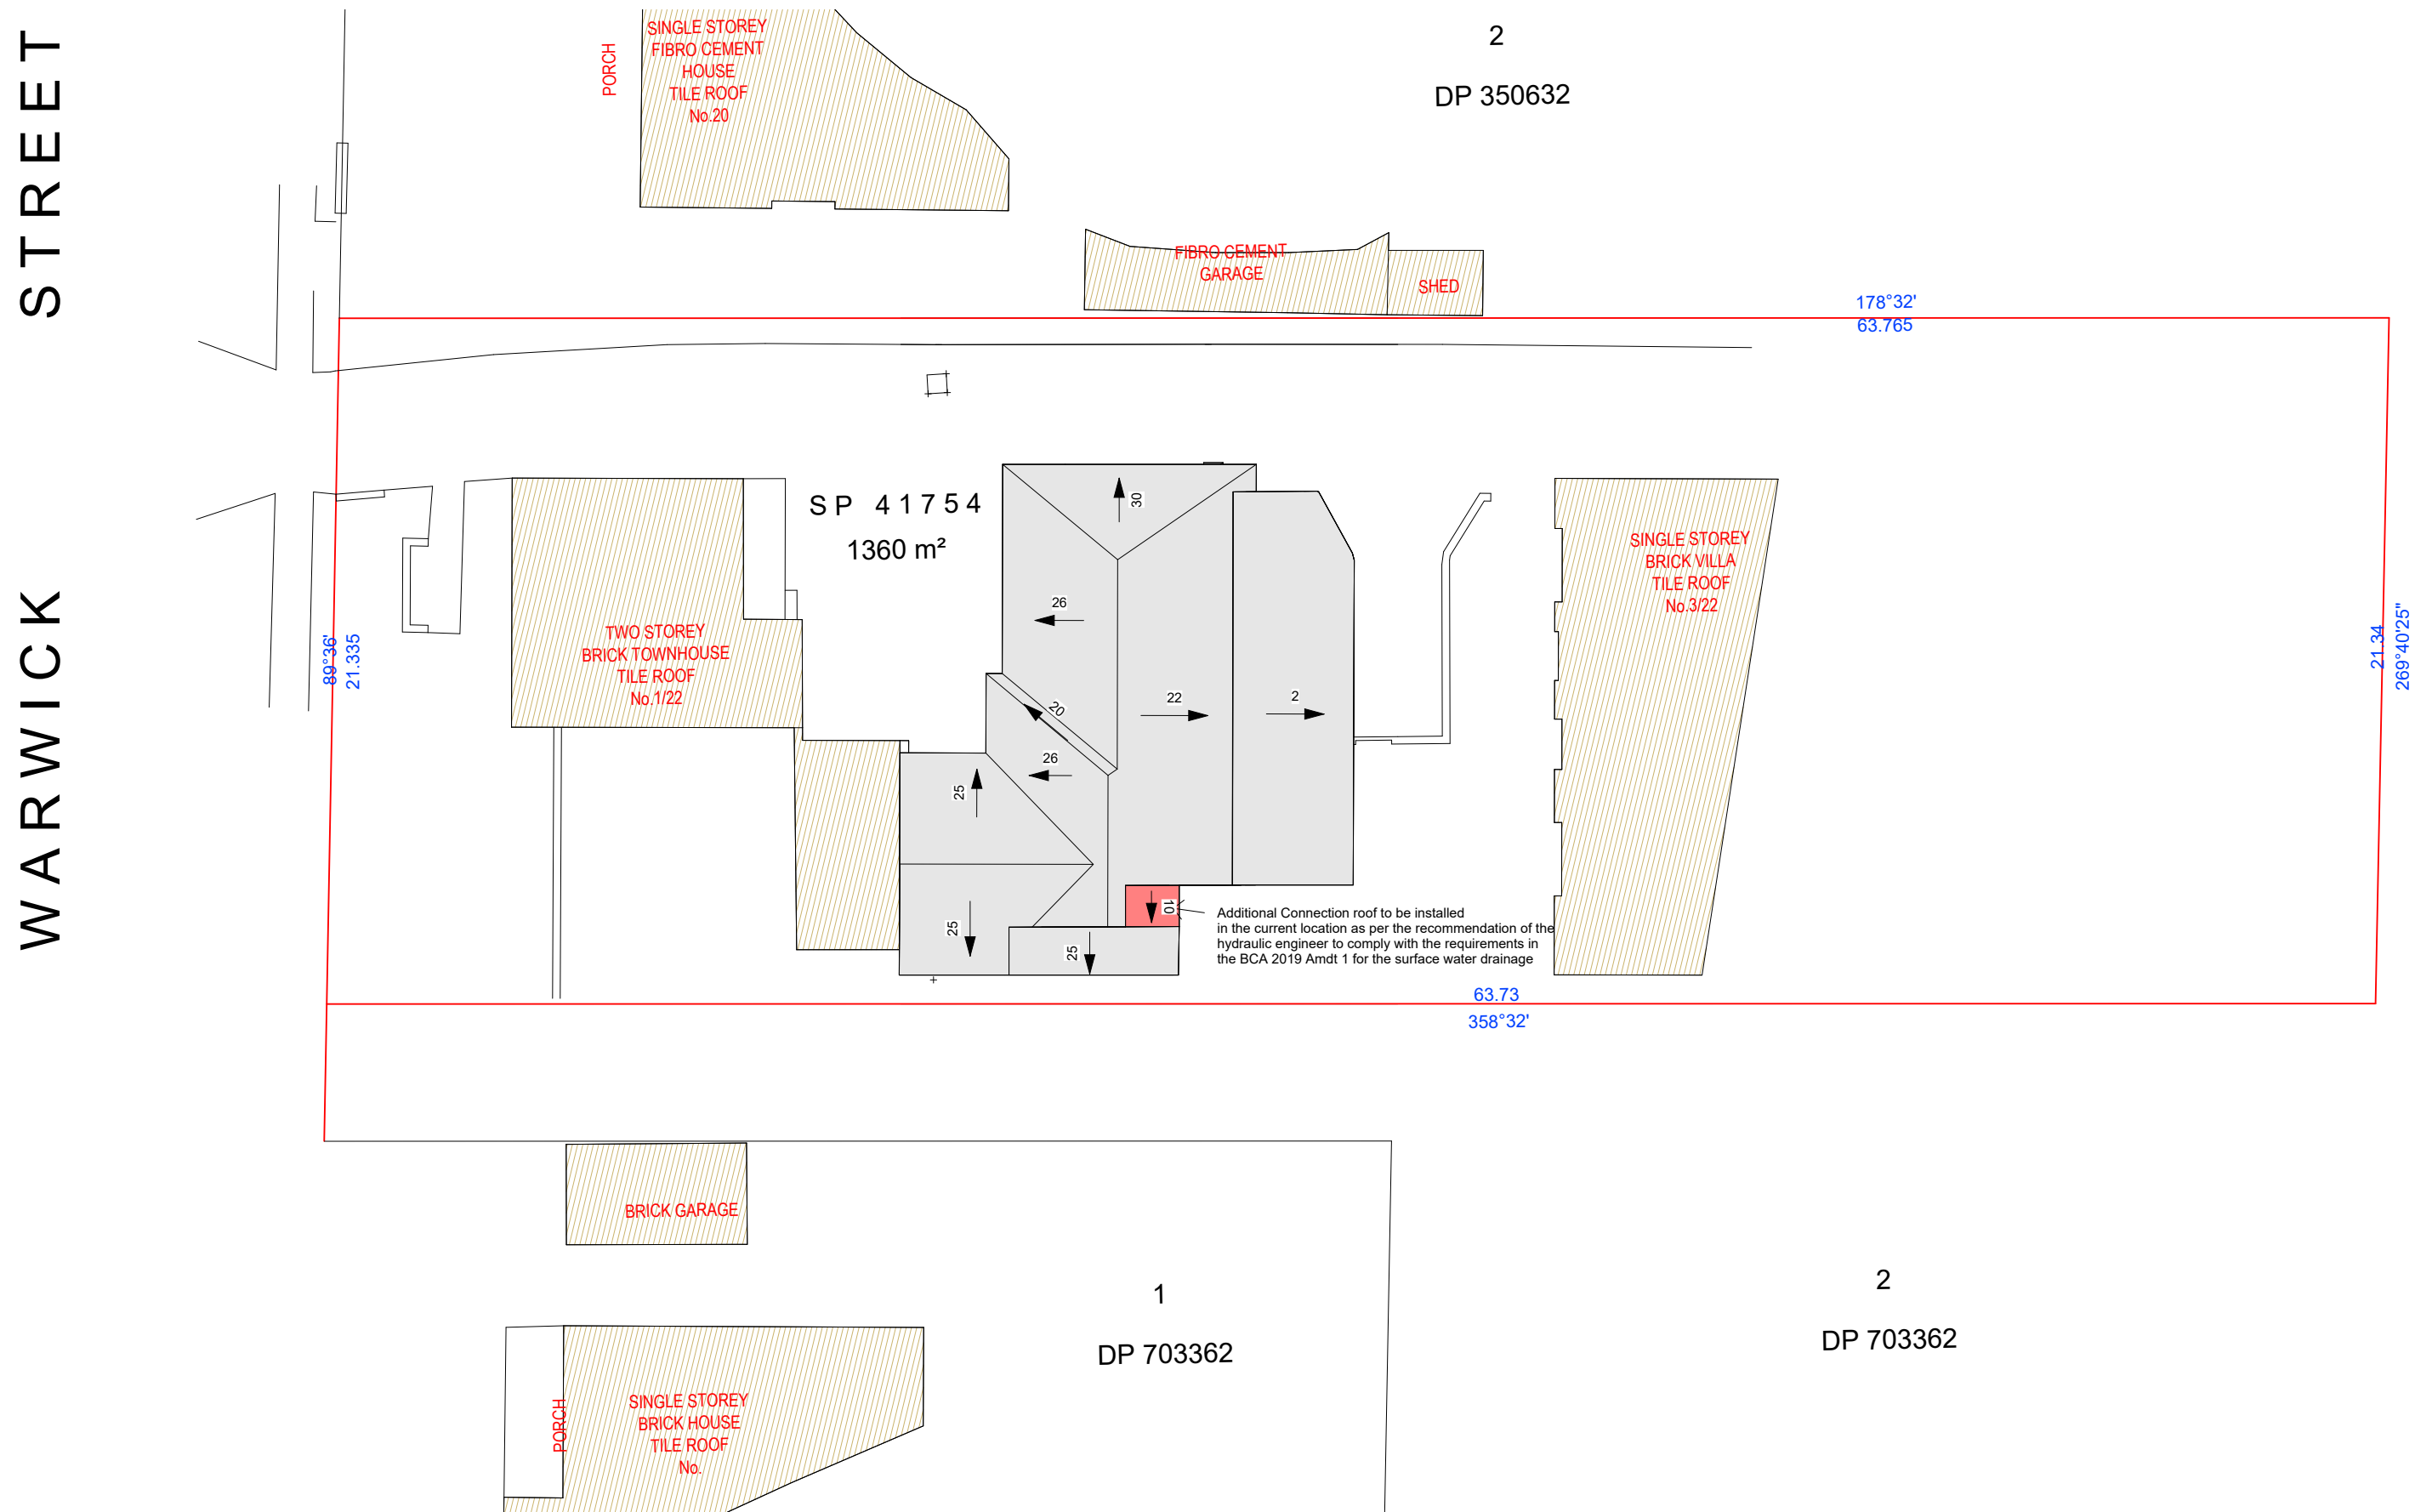


## 1 Neighbour Notification Site Plan

1 : 200

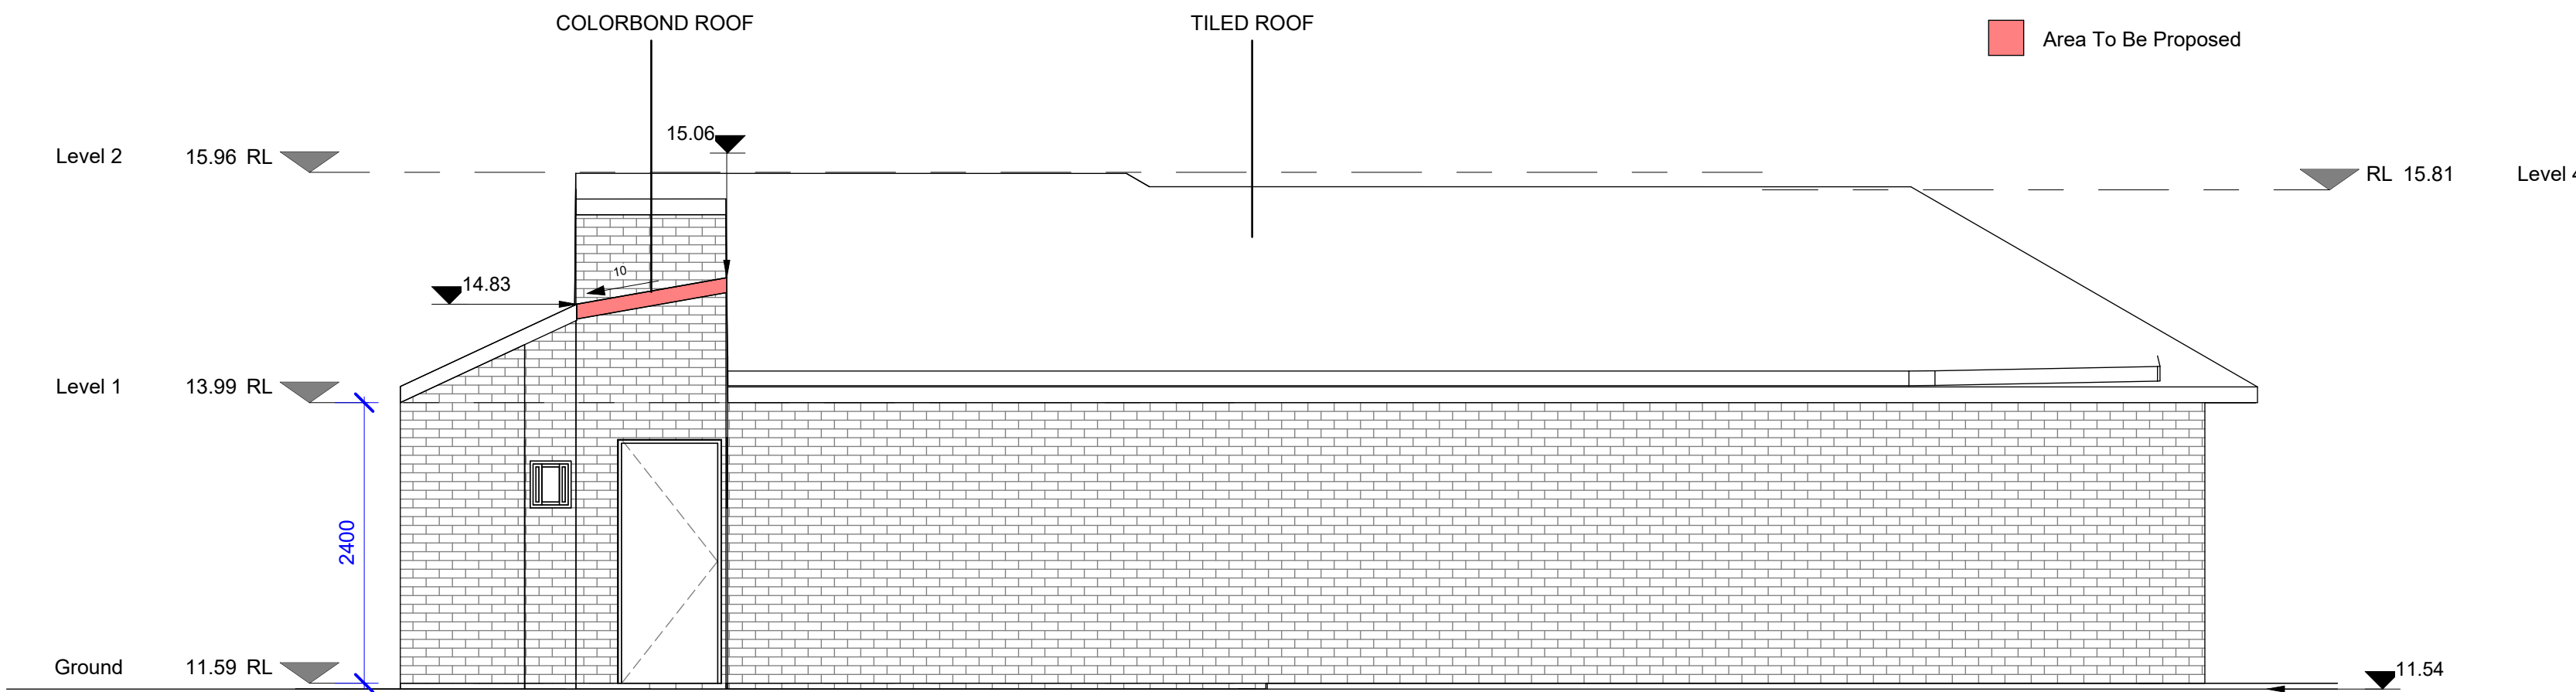

## 2 Neighbour Notification Elevations

1 : 50

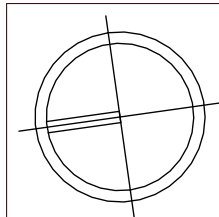

DO NOT SCALE THESE DRAWINGS,  
READ ALL DEMENSIONS SHOWN.

ALL RIGHTS RESERVED.  
THESE DRAWINGS, PLANS AND SPECIFICATION  
AND COPYRIGHT ARE THE PROPERTY OF  
WARATAH GROUP AND MUST NOT BE USED,  
REPRODUCED OR COPIED WHOLLY OR IN PART  
WITHOUT THE WRITTEN PREMISSION OF  
WARATAH GROUP.



Waratah Group

Level 1  
Building 3  
20 Worth Street  
Chullora NSW  
2190 Australia

(02) 9758 7567  
www.waratahcertifiers.com.au

Drw	Chk	Description	Rev	Date
MA	AA	DA Documentation	A	15/03/2022

Client Details

Abdul Sayed

Project Details

Unit 2, 22 Warwick Street, Punchbowl, NSW, 2196


Drawing Name

As Built Elevation

Date	Scale	Sheet scale
15/03/2022	1:50	A1


Drawn By	Checked By
MA	AA

Job No.	Drawing No.	Revision
2022-0075	A104	A

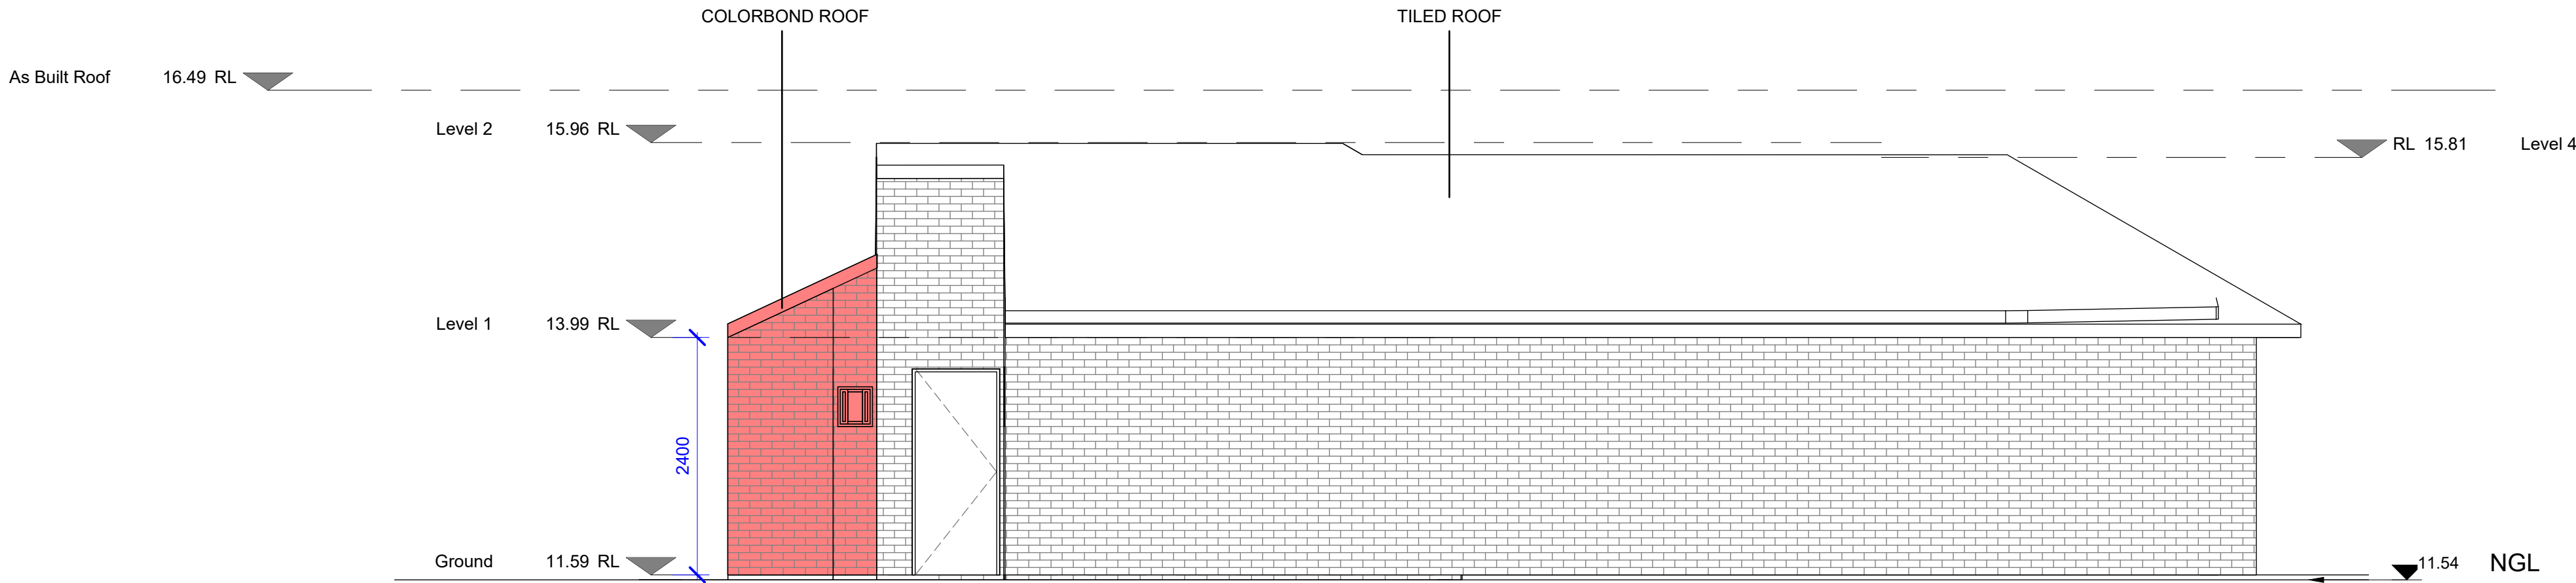

## 1 As Built East

1 : 50

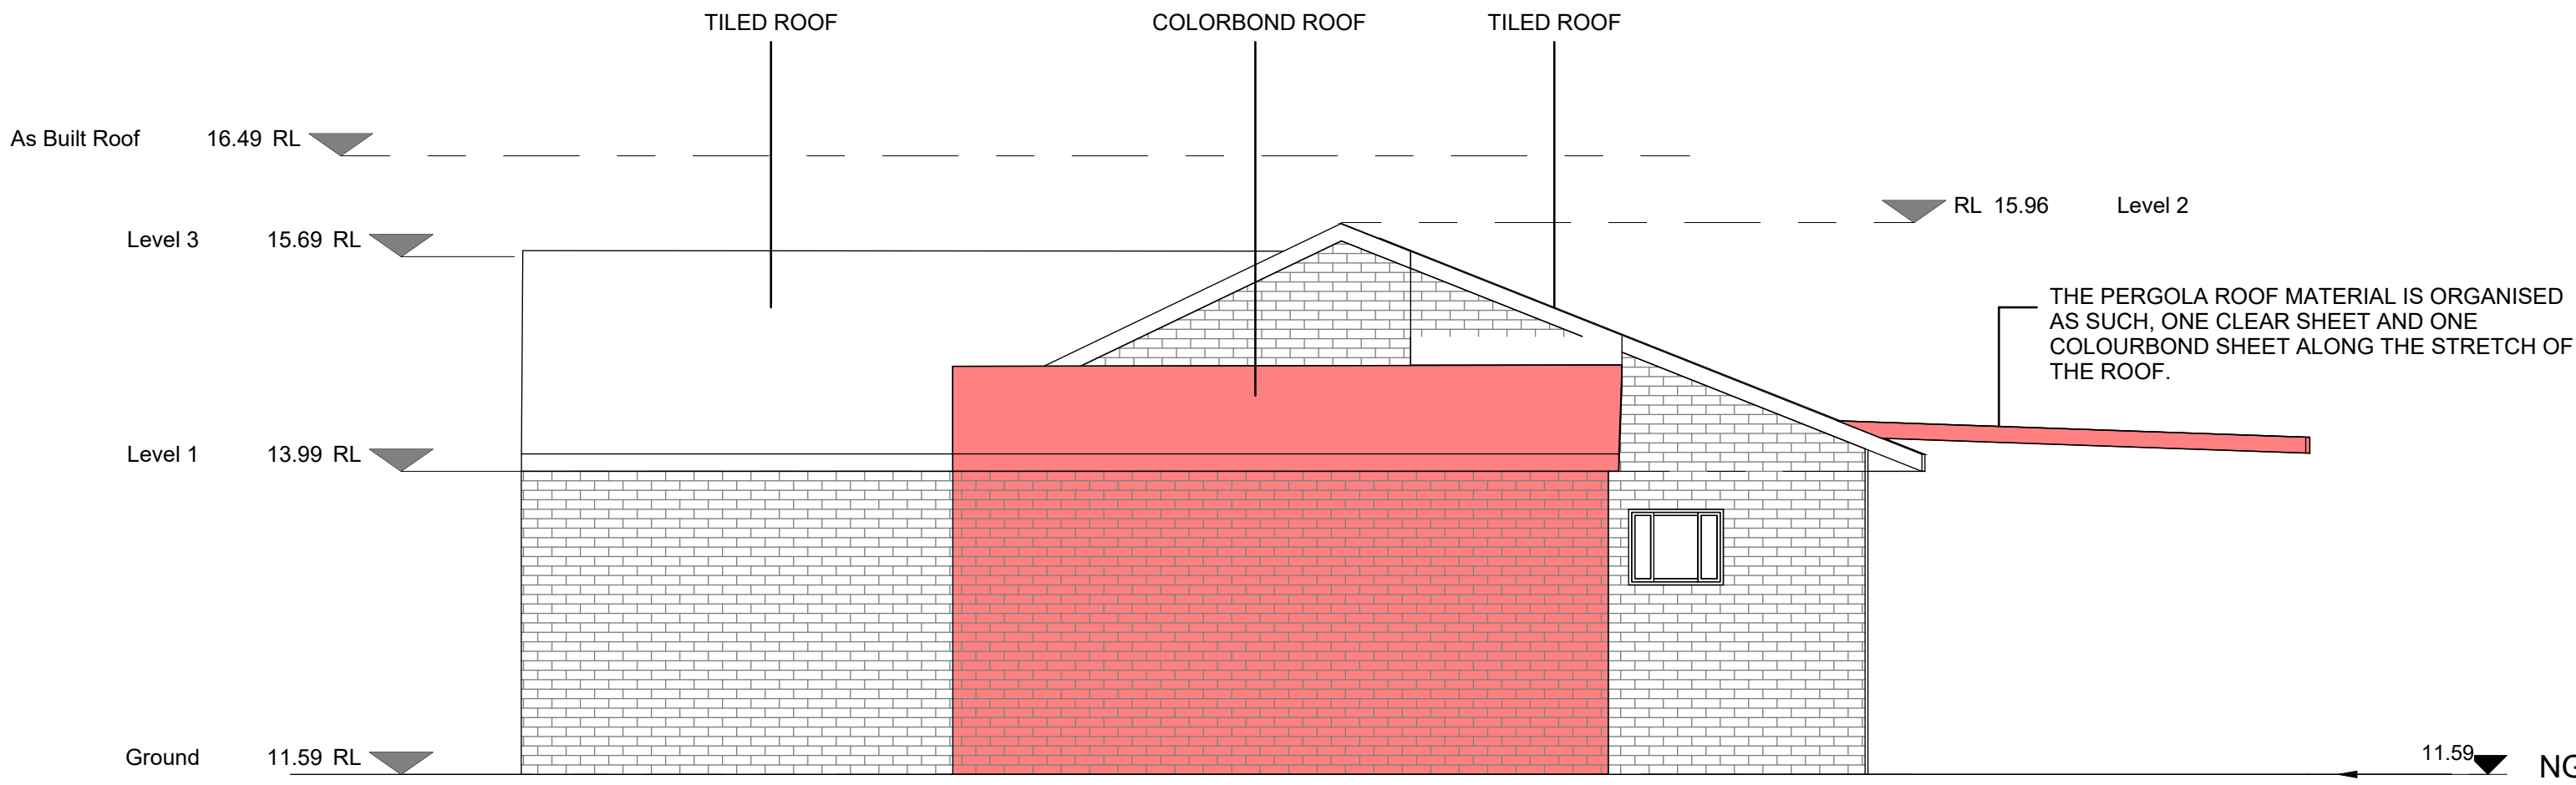

## 2 As Built South

1 : 50

DO NOT SCALE THESE DRAWINGS,  
READ ALL DEMENSIONS SHOWN.

ALL RIGHTS RESERVED.  
THESE DRAWINGS, PLANS AND SPECIFICATION  
AND COPYRIGHT ARE THE PROPERTY OF  
WARATAH GROUP AND MUST NOT BE USED,  
REPRODUCED OR COPIED WHOLLY OR IN PART  
WITHOUT THE WRITTEN PREMISSION OF  
WARATAH GROUP.



Waratah Group

Level 1  
Building 3  
20 Worth Street  
Chullora NSW  
2190 Australia  
  
(02) 9758 7567  
www.waratahcertifiers.com.au

Drw	Chk	Description	Rev	Date
MA	AA	DA Documentation	A	15/03/2022

Client Details  
Abdul Sayed


Project Details  
Unit 2, 22 Warwick Street, Punchbowl, NSW, 2196

Drawing Name  
Section


Date 15/03/2022 Scale 1:50 Sheet scale A1

Drawn By MA Checked By AA

Job No. 2022-0075 Drawing No. A106 Revision A

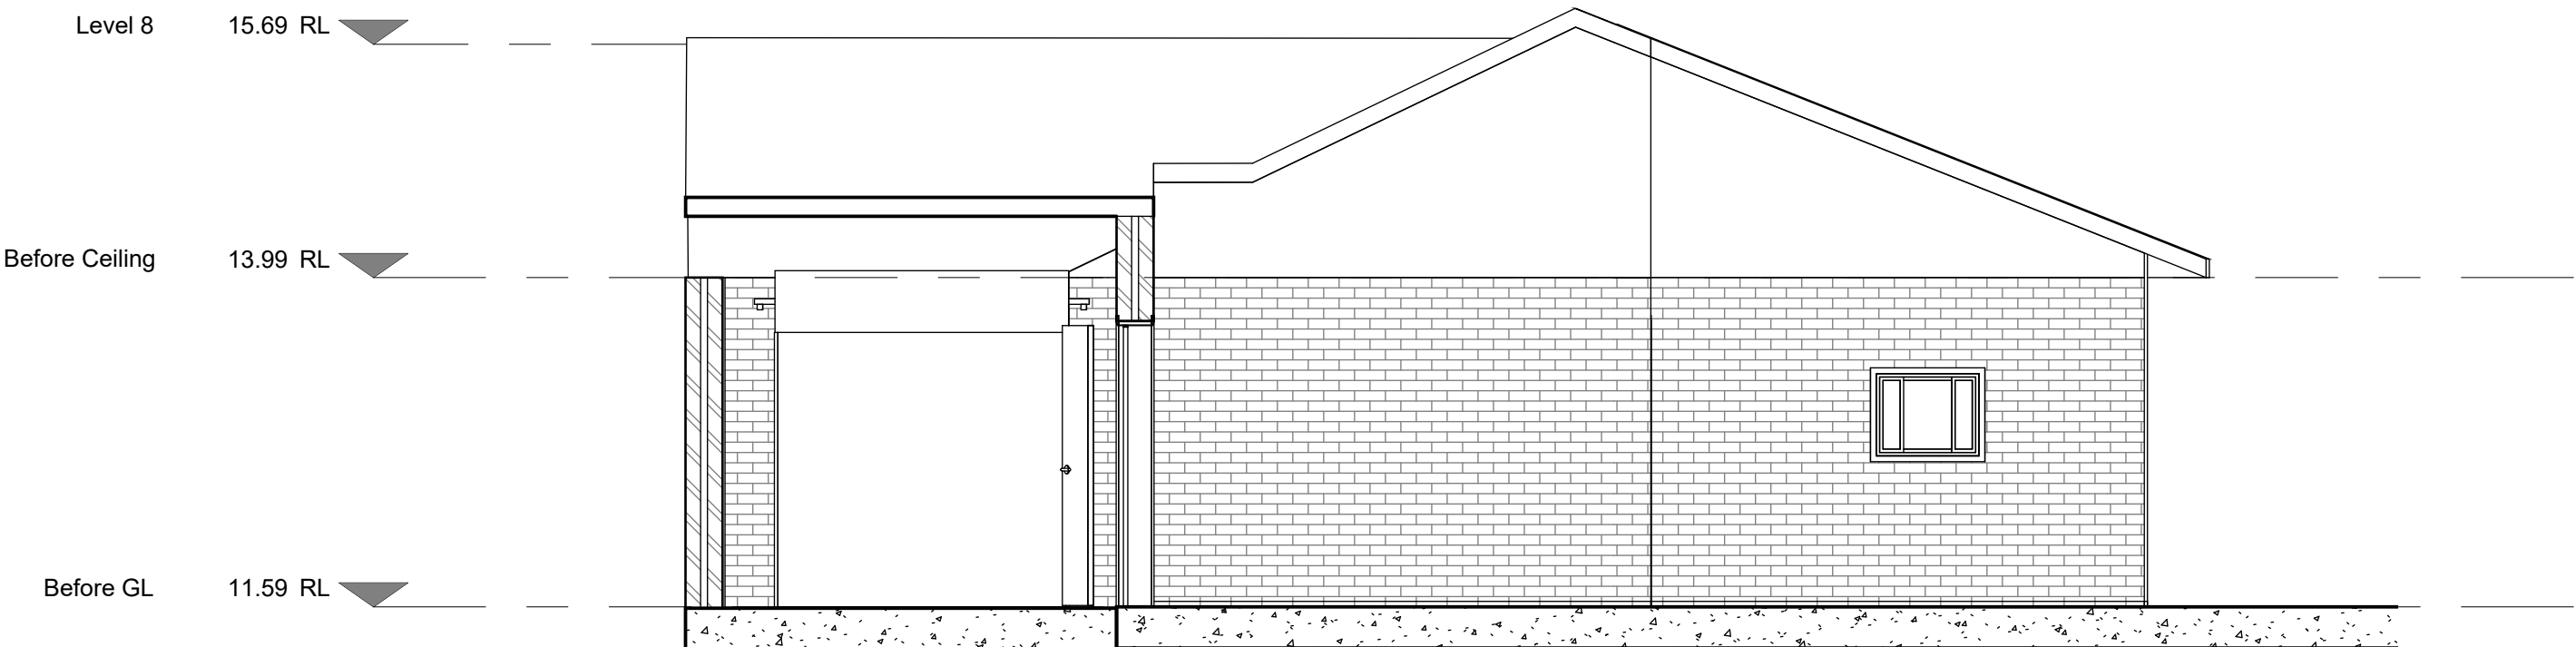


2 Before Section  
1 : 50

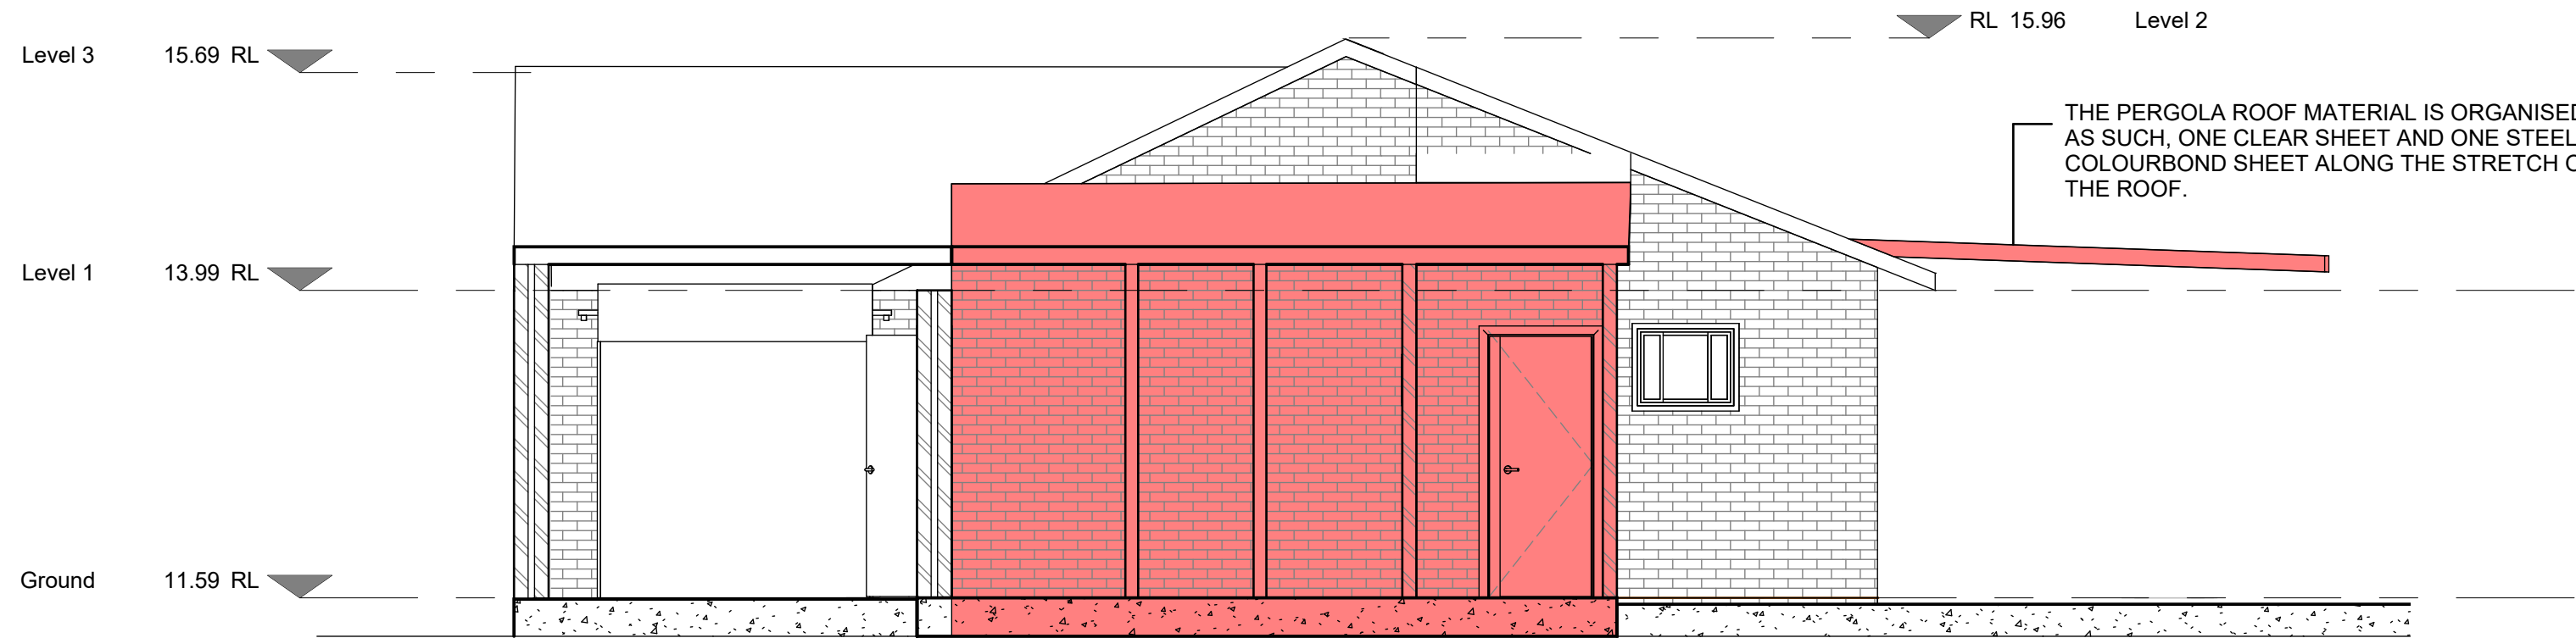


1 As Built Section  
1 : 50

Area To Be Proposed

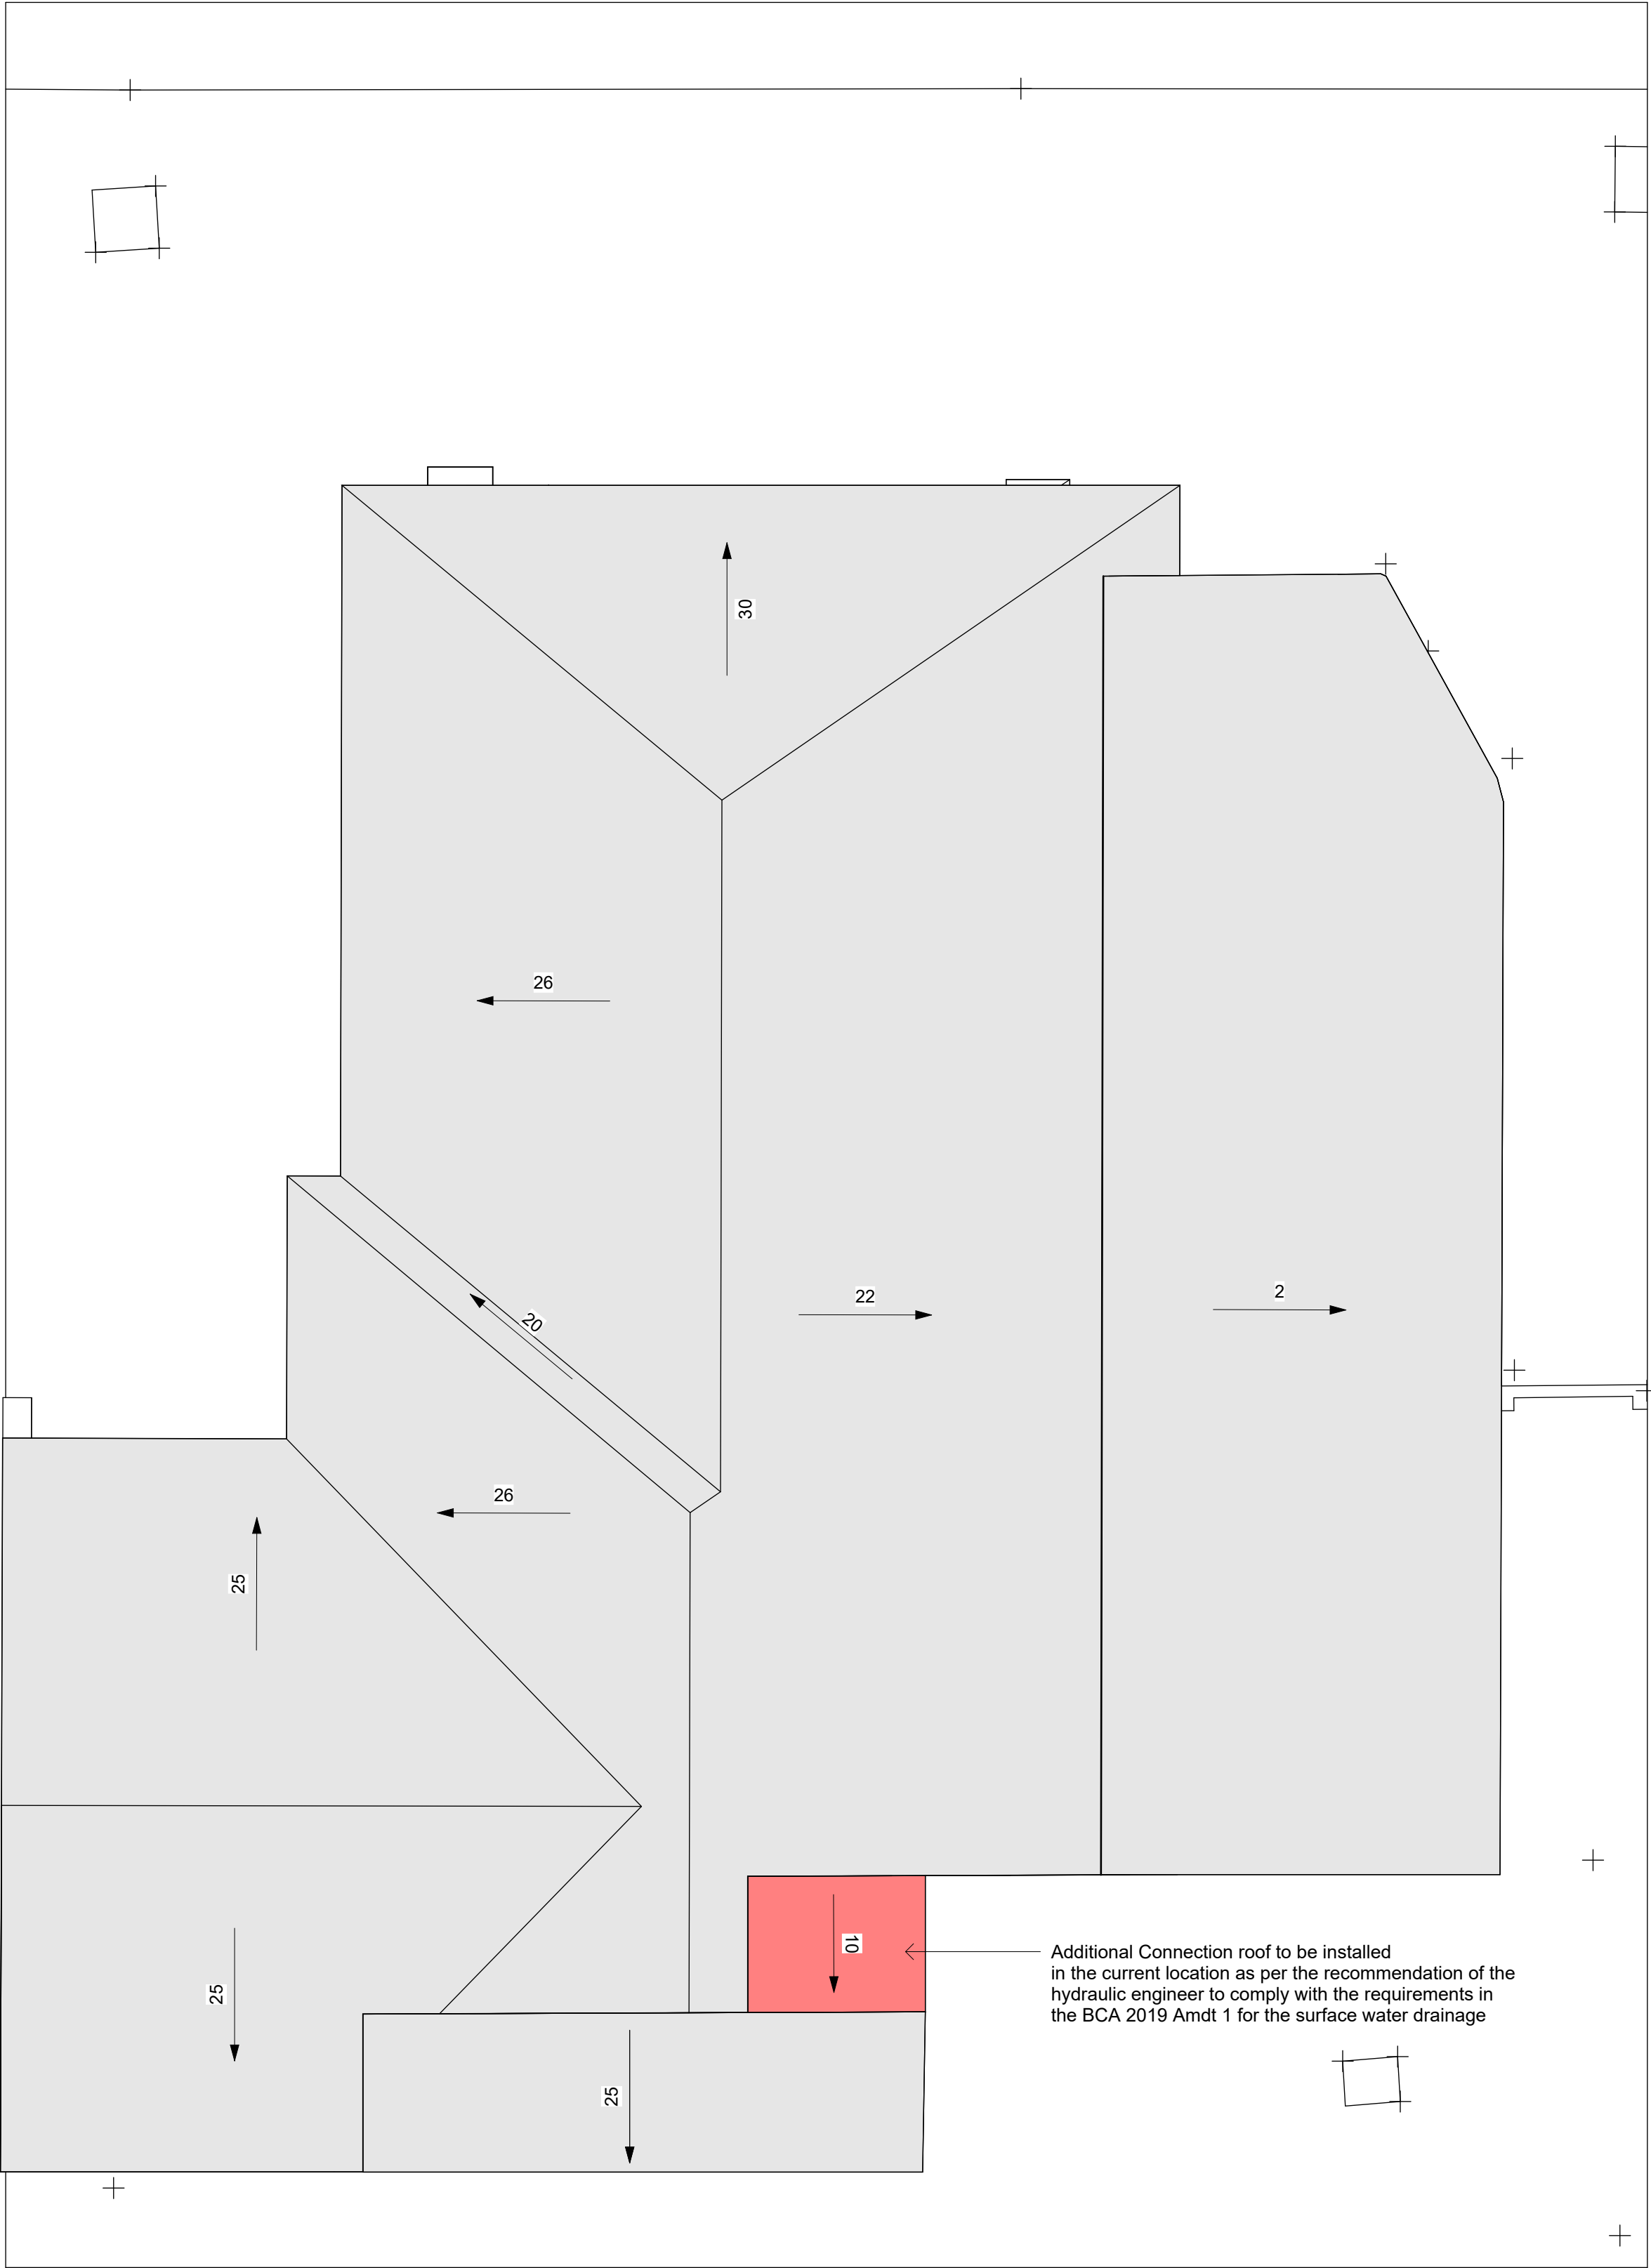

**1** Proposed Roof Plan  
1 : 50

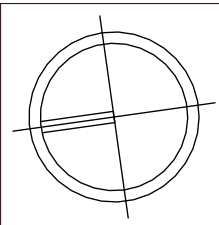

DO NOT SCALE THESE DRAWINGS,  
READ ALL DEMENSIONS SHOWN.

ALL RIGHTS RESERVED.  
THESE DRAWINGS, PLANS AND SPECIFICATION  
AND COPYRIGHT ARE THE PROPERTY OF  
WARATAH GROUP AND MUST NOT BE USED,  
REPRODUCED OR COPIED WHOLLY OR IN PART  
WITHOUT THE WRITTEN PREMISSION OF  
WARATAH GROUP.



Waratah Group

Level 1  
Building 3  
20 Worth Street  
Chullora NSW  
2190 Australia  
  
(02) 9758 7567  
www.waratahcertifiers.com.au

Drw	Chk	Description	Rev	Date
MA	AA	DA Documentation	A	15/03/2022

Client Details  
Abdul Sayed

Project Details  
Unit 2, 22 Warwick Street, Punchbowl, NSW, 2196

Drawing Name  
Site Plan

Date 15/03/2022 Scale 1:50 Sheet scale A1

Drawn By MA Checked By AA

Job No. 2022-0075 Drawing No. A108 Revision A