


WAE DRAINAGE

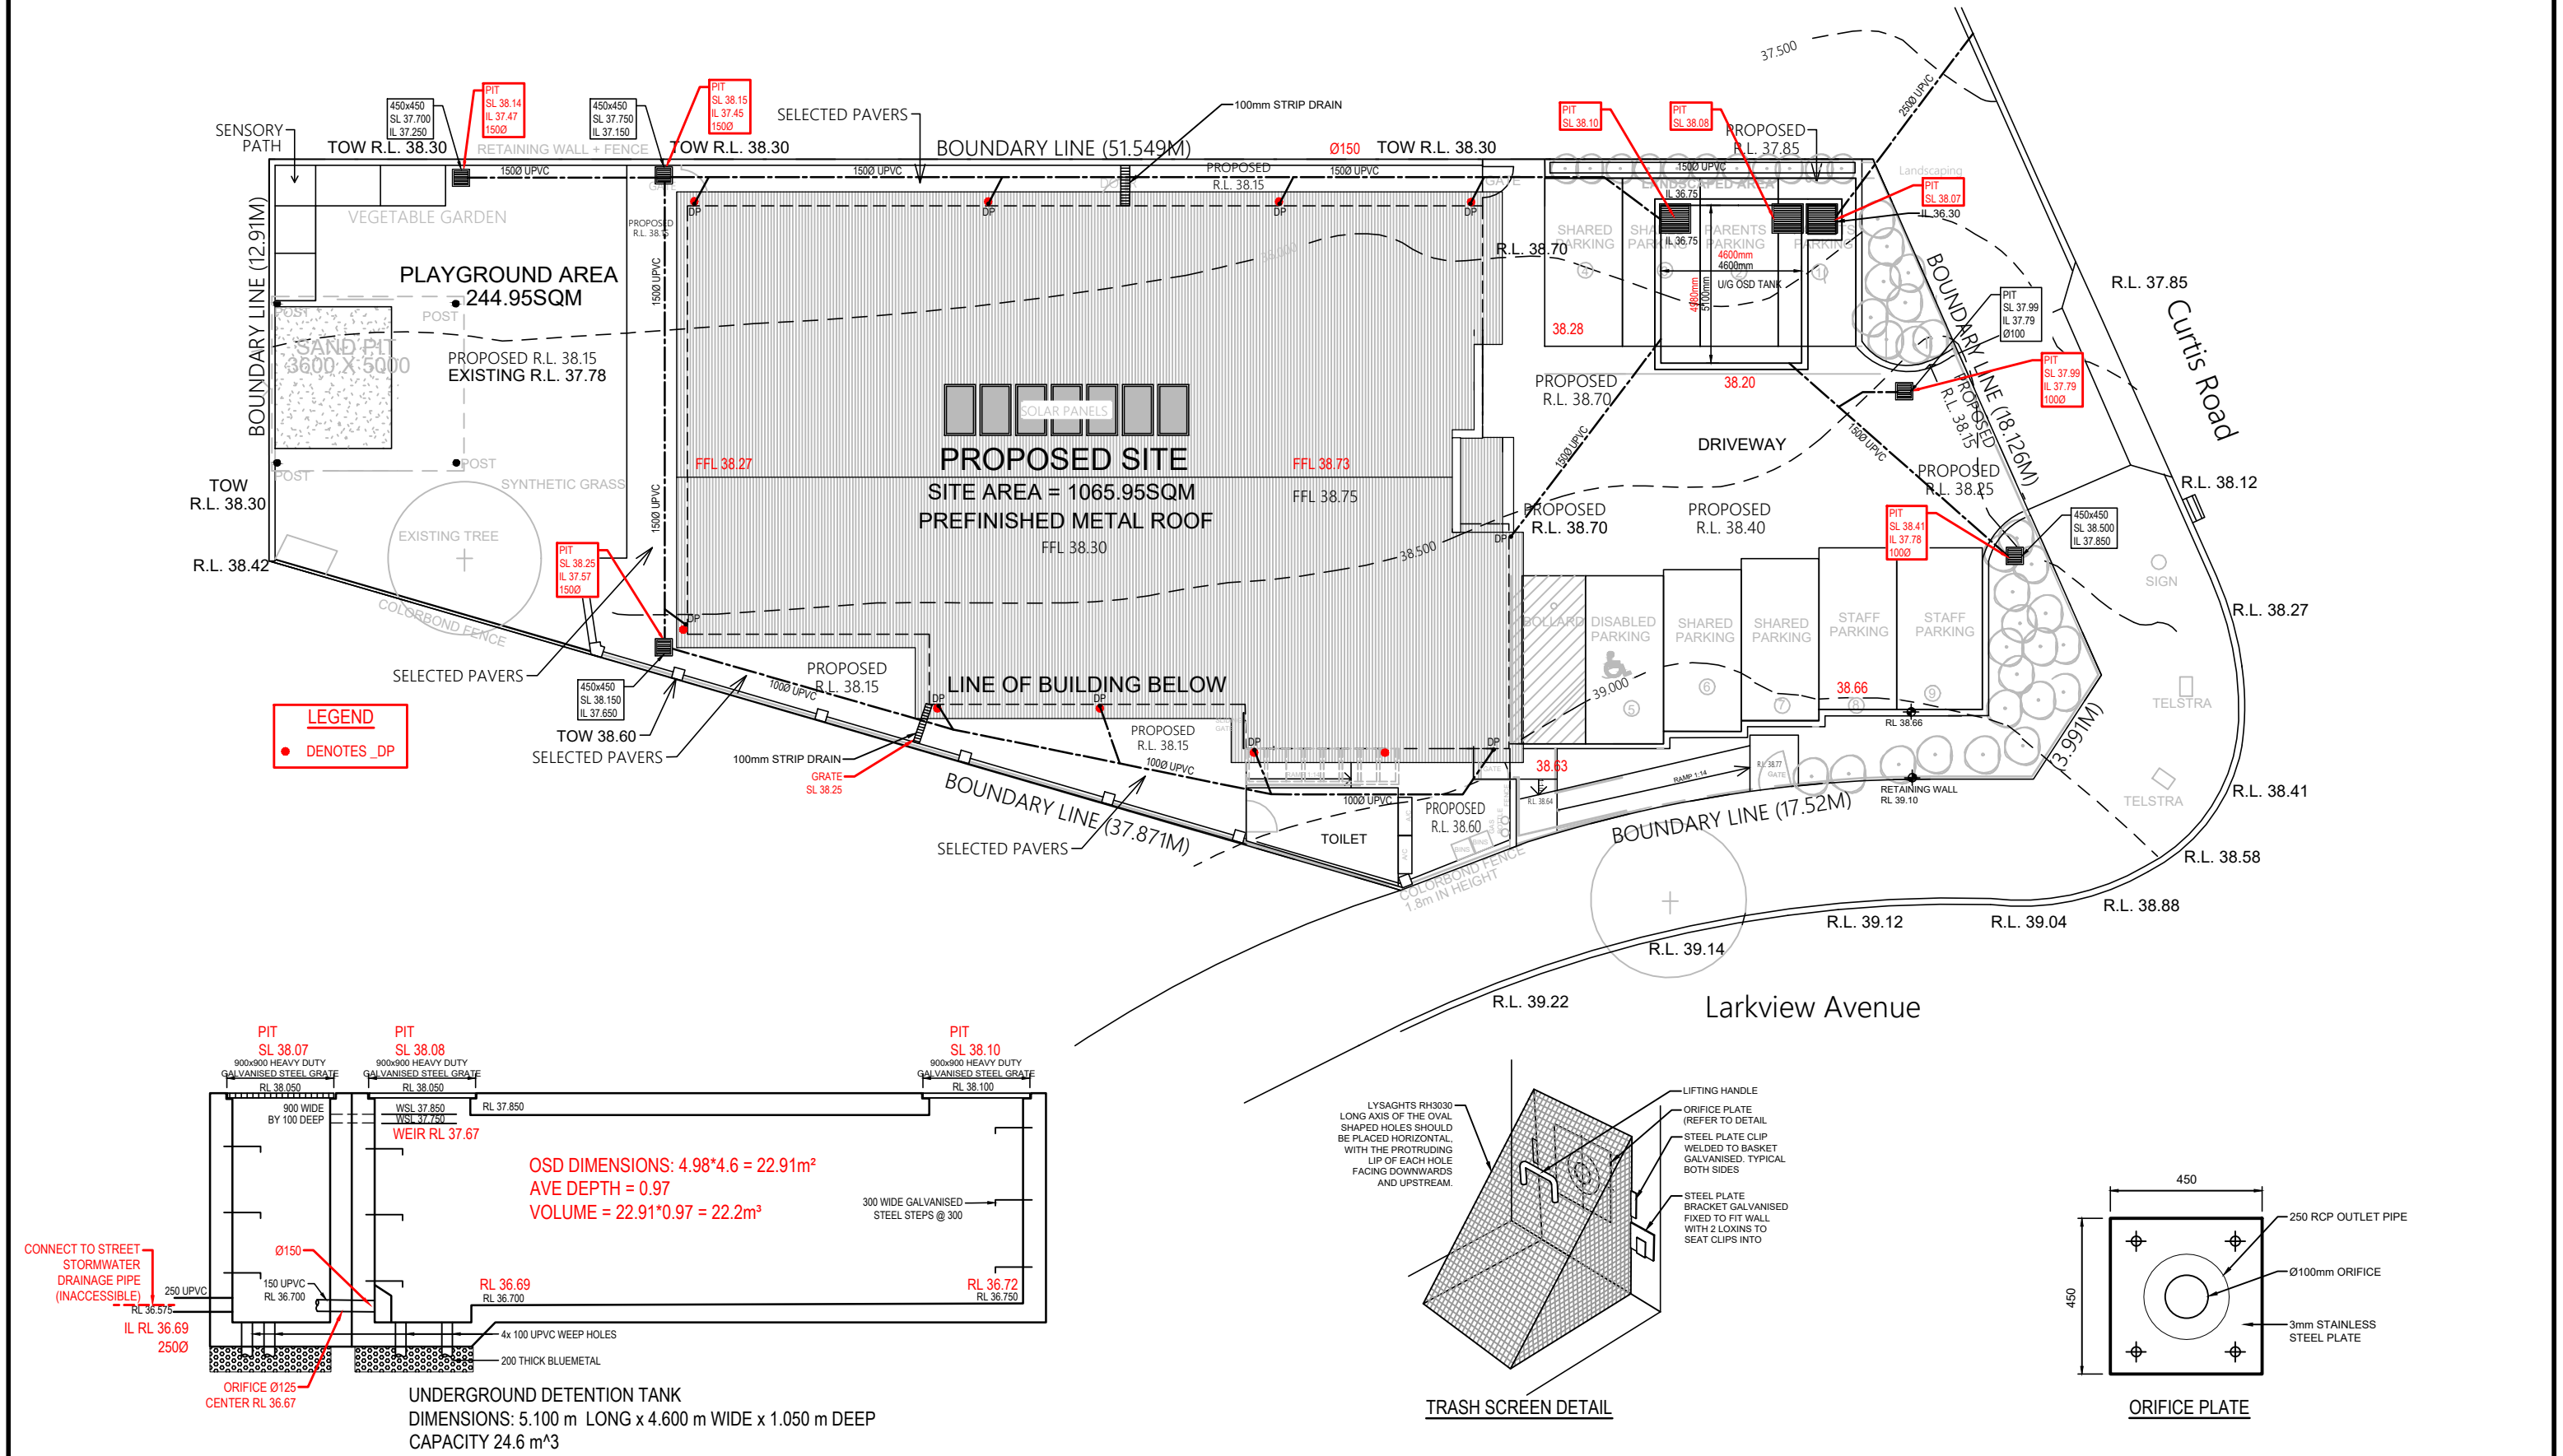

Mailing Address:
P.O. BOX 36
BANKSTOWN N.S.W. 2200
Ph: (02) 9793 9017 Mob:0413 413 770
E-Mail: grconstruction@bigpond.com

COPYRIGHT:
This design and any other content on this drawing remains the property of MLE Designs P/L. it cannot be copied or reproduced in part of whole or used in any way without the written permission of MLE DESIGNS Pty. Ltd.

ISSUE:	DATE:	DESCRIPTION:	BY:
A	21/01/2017	ISSUED FOR CC	DC
B	01/08/2023	SEC 4.55 MODIFICATION	DC
C	08/08/2023	AS CONSTRUCTED T.B.A.	DC

CLIENT
MR JOE WAKIM

PROJECT
PROPOSED NEW CHILD CARE DEVELOPEMTN AT
No.23 CURTIS ROAD, CHESTER HILL. NSW

DRAWING TITLE			
STORMWATER DESIGN			
SCALE: N/A	DATE: 08/08/2023	DRAWN: D.C.	CHECKED: M.P.
JOB NUMBER: 23CURTIS/17	DRAWING 1 OF 1	REVISION C	