

LEGEND & SCHEDULE


NOTES:
1. ALL FINAL PLANT QUANTITIES INDICATED ON PLANS SHALL BE CHECKED AND VERIFIED BY SUCCESSFUL LANDSCAPE CONTRACTOR.
2. ANY PLANT SUBSTITUTES REQUIRED DUE TO UNAVAILABILITY SHALL BE RECOMMENDED BY THE LANDSCAPE CONTRACTOR TO BEST MATCH SUBSTITUTED PLANTS AND APPROVED PRIOR TO PURCHASING BY THE LANDSCAPE ARCHITECT.
3. WORKS CERTIFIED FOR FINAL OCCUPANCY CERTIFICATE ARE TO MATCH APPROVED LANDSCAPE PLANS.
4. LANDSCAPE CONTRACTOR SHALL LOCATE AND AVOID SITE STORM WATER & DRAINAGE SERVICES. LOCATE TREES A MINIMUM 1.25M FROM PITS
5. ALL PLANTING AROUND EXISTING TREES SHALL BE ADJUSTED TO AVOID DAMAGE AND CLASHING WITH SURFACE ROOTS

- TREES**
- Botanical Name:** *Elaeocarpus reticulatus*
Common Name: Blueberry Ash (Native)
Pot size: 75Lt
Mature H x S: 8-10m x 6-7m
Qty Required: AS PLANTED
- Botanical Name:** *Tristanopsis laurina* 'Luscious'
Common Name: Watergum (Native)
Pot size: 75Lt
Mature H x S: 5-8m x 3-5m
Qty Required: AS PLANTED

- SHRUBS AND HEDGES**
- Botanical Name:** *Westringia 'Mundi'*
Common Name: Dwarf Coastal Rosemary (Native)
Pot size: 300mm
Mature H x S: 500mm x 1.5m
Qty Required: AS PLANTED
- Botanical Name:** *Banksia ericifolia*
Common Name: Heath Banksia (Native)
Pot size: 300mm
Mature H x S: 3m x 2m
Qty Required: AS PLANTED
- Botanical Name:** *Westringia fruticosa*
Common Name: Native Rosemary (Native)
Pot size: 300mm
Mature H x S: 1.5m x 1m
Qty Required: AS PLANTED
- Botanical Name:** *Banksia spinulosa*
Common Name: Hairpin Banksia (Native)
Pot size: 300mm
Mature H x S: 2m x 1.2m
Qty Required: AS PLANTED

- ACCENT PLANTS**
- Botanical Name:** *Doryanthes excelsa*
Common Name: Gynea Lily (Native)
Pot size: 45Lt
Mature H x S: 1m x 1m
Qty Required: AS PLANTED

- GRASSES / GROUNDCOVERS**
- Botanical Name:** *Anigozanthos 'Ruby Velvet'*
Common Name: Kangaroo Paw cvs (Native)
Pot size: 150mm
Mature H x S: .6m x .5m
Qty Required: AS PLANTED
- Botanical Name:** *Dianella 'Little Jess'*
Common Name: Little Jess Flax Lily (Native)
Pot size: 140mm
Mature H x S: .4m x .4m
Qty Required: AS PLANTED

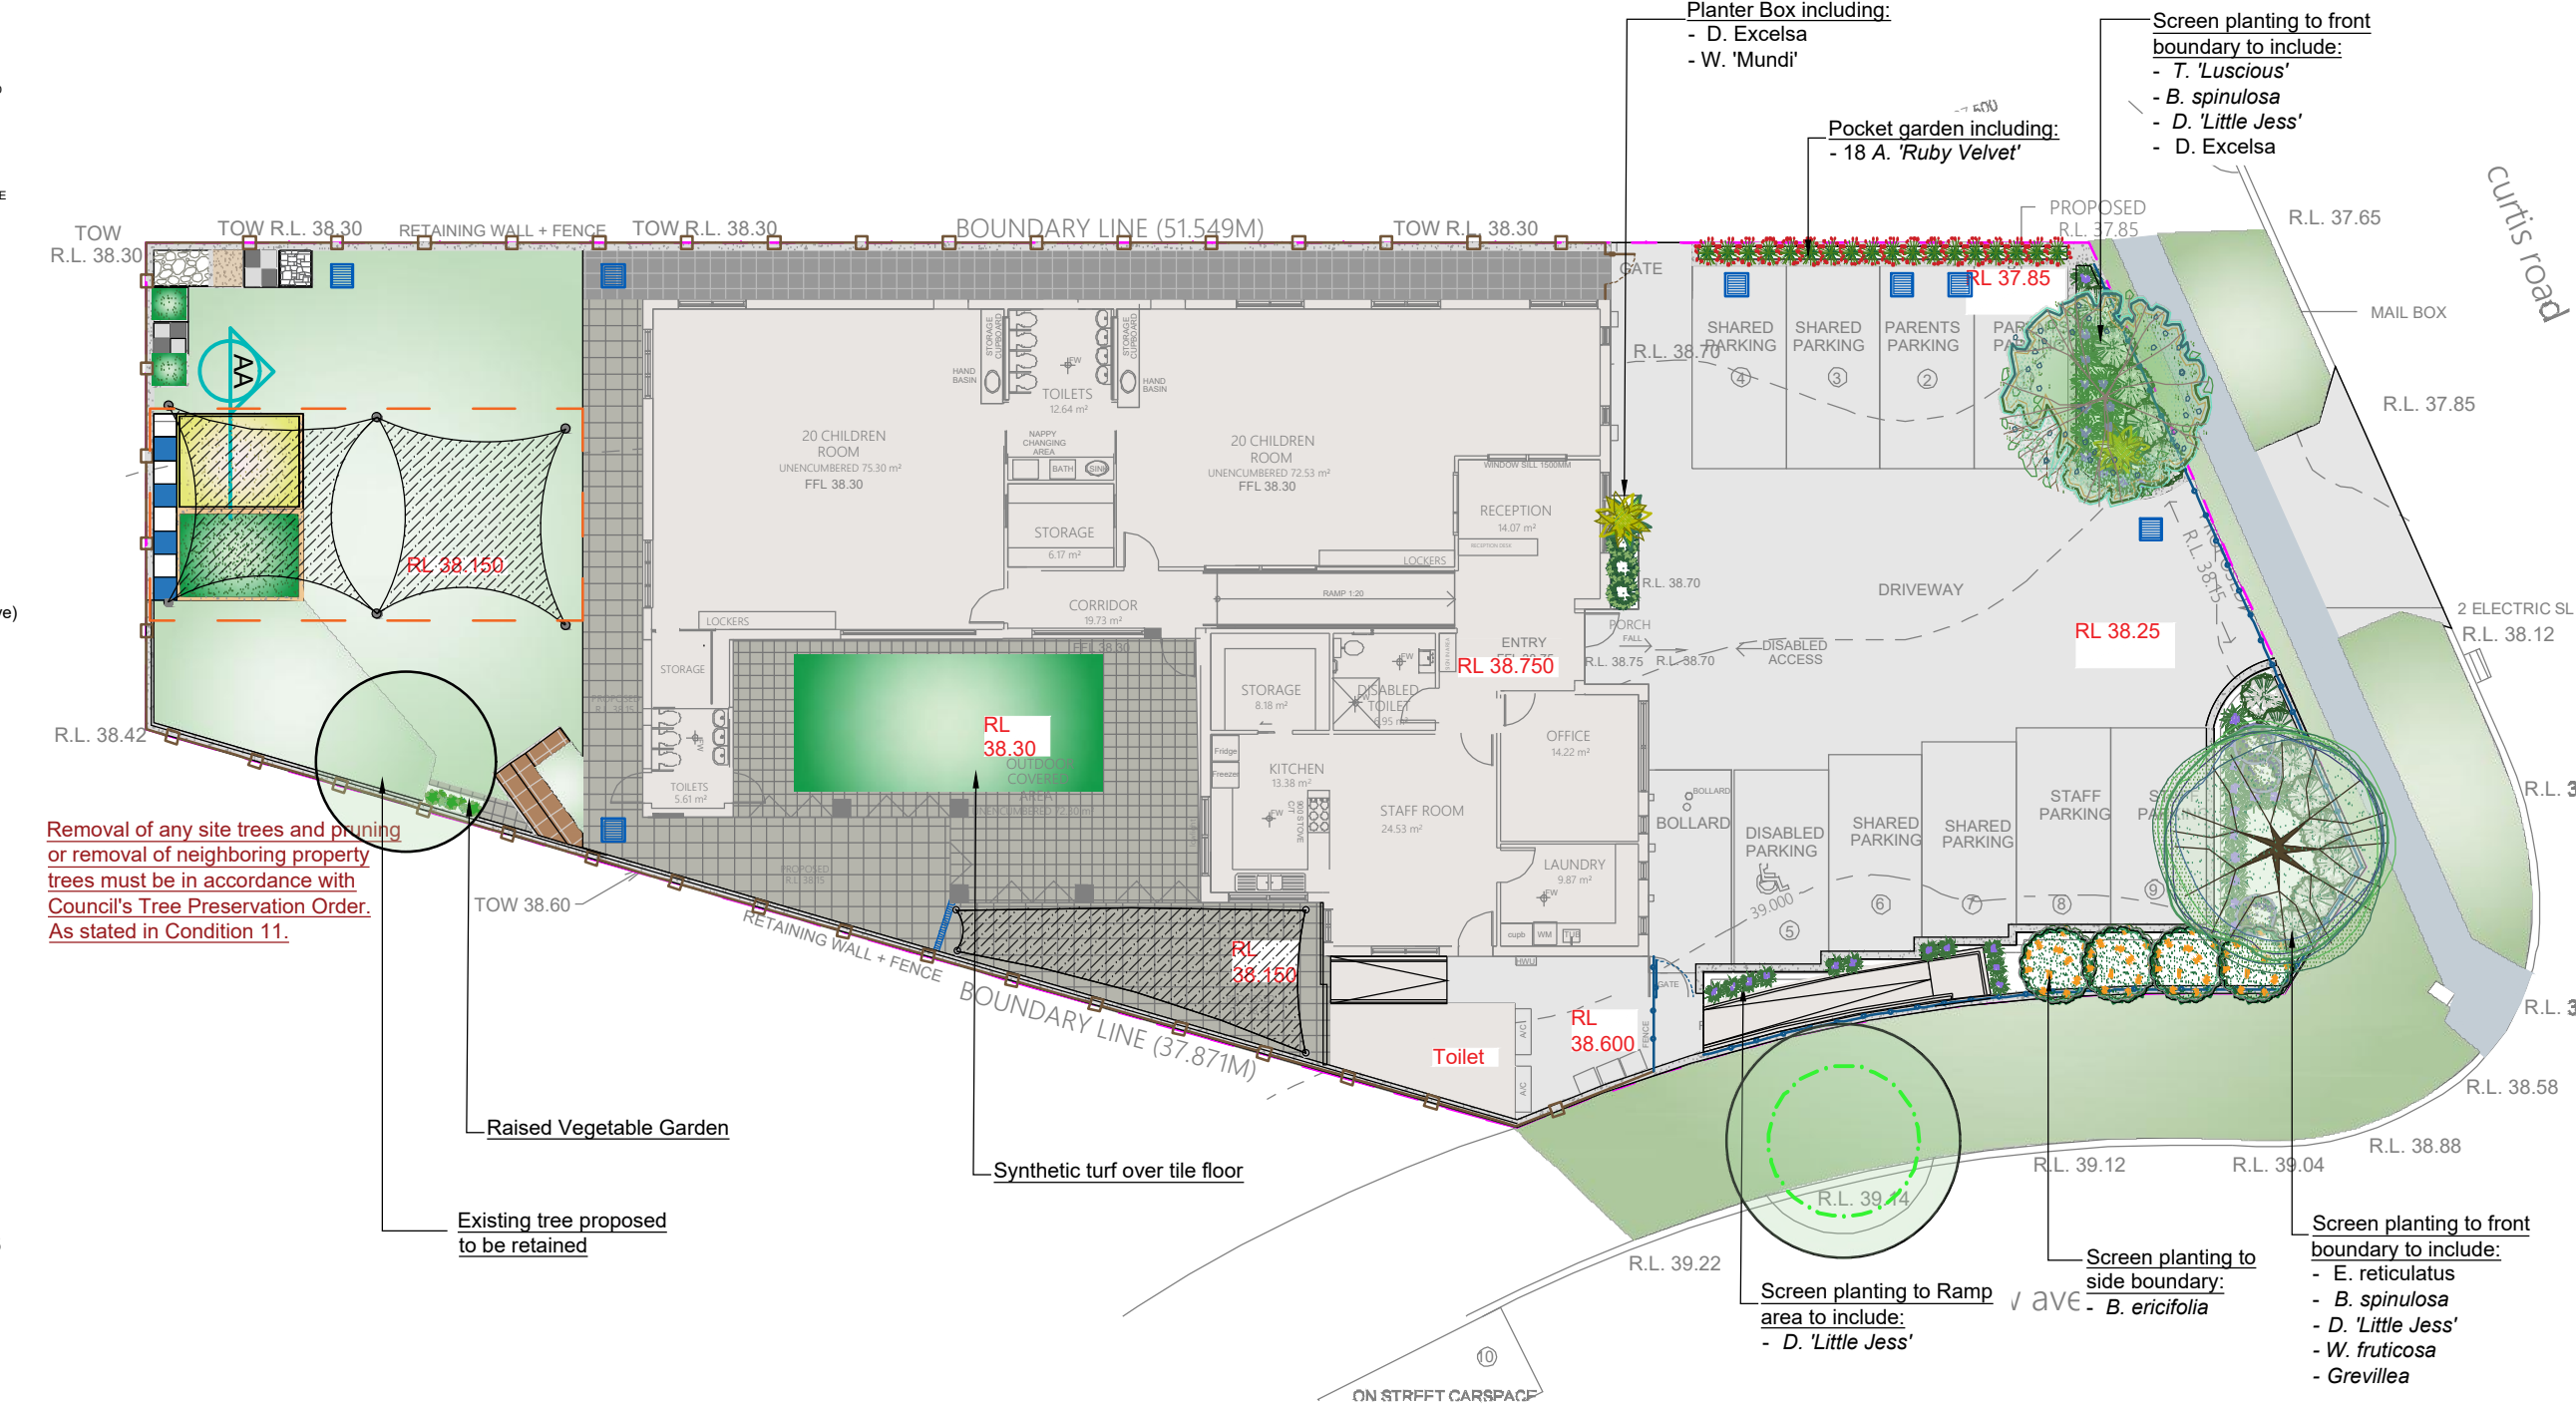

Tristanopsis laurina 'Luscious'



Syzygium 'Resilience'



Westringia 'Mundi'



Dianella 'Little Jess'



Doryanthes excelsa

LANDSCAPE PLAN NOTES
THIS PLAN HAS BEEN PREPARED TO CAPTURE THE 'AS CONSTRUCTED' CONDITION

General Notes:

Figured dimensions take preference to scale readings. Verify all dimensions on site. PDF'd plans may vary slightly in Scale for that indicated on plans. Report any discrepancies to the Landscape Architect before proceeding with the work.

Copyright R. L. Frew Landscape Architectural Services T/A CONZEPT
This drawing is protected by copyright. All rights are reserved. Unless permitted under the Copyright Act 1968, no part of this drawing may in any form or by any means be reproduced, published, broadcast or transmitted without the prior written permission of the copyright owner.
If the Status of this drawing is not signed off For Construction it may be subject to change, alteration or amendment at the discretion of our office. If so, Concept is not liable for any loss, damage, harm or injury whether special, consequential, direct or indirect, suffered by you or any other person as a result of your use of this drawing for construction purposes.
These plans and associated IP remain the property of R. L. Frew Landscape Architectural Services Pty Ltd (T/A Concept) until such time as all agreed payments are made in full. We retain the right to withdraw this information from the assessment process if such payments are not made following the notification period.

AILA Associate



Bar Scale




REV	DATE	NOTATION/AMENDMENT
A	12.02.16	Preliminary DA prepared for review
B	15.02.16	Revised plan to comply with preliminary letter
		CONSTRUCTION CERTIFICATE
C	09.06.17	Co-ordinated with council conditions
D	16.06.17	Co-ordinated with council conditions
E	10.06.20	Co-ordinated with amended architectural plan
F	16.06.20	Co-ordinated with client's comments
G	05.06.23	Co-ordinated with constructed

COUNCIL	CANTERBURY BANKSTOWN
CLIENT	Joe Wakim
ARCHITECT	A2 CONCEPTS
STATUS / ISSUE	AS BUILT


Conzept
Landscape Architects

Conzept Landscape Architects Suite 101, 506 Miller St CAMMERAY NSW 2062
Phone: 9922 5312 Fax: 8209 4982
www.conzept.net.au enquiries@conzept.net.au Mob: 0413 861 351


TITLE:	LANDSCAPE PLAN	DWG.No:	LP-Built_17-358 / 2
	PROPOSED CHILDCARE CENTRE	SCALE:	1:200 @ A3
	23 CURTIS ROAD CHESTER HILL	DATE:	MAY 2023
DRAWN:	K.Z/J.G	CHECKED:	R.F

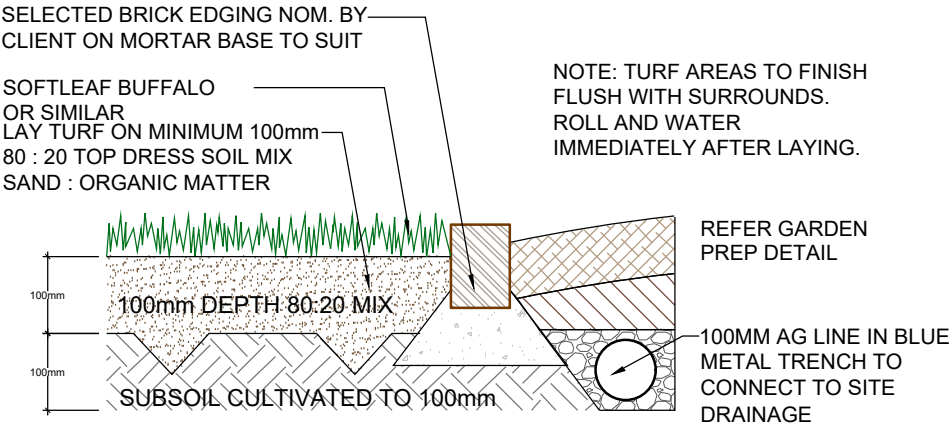


DETAIL 1: TYPICAL TURF AND BRICK EDGE SCALE: 1:10

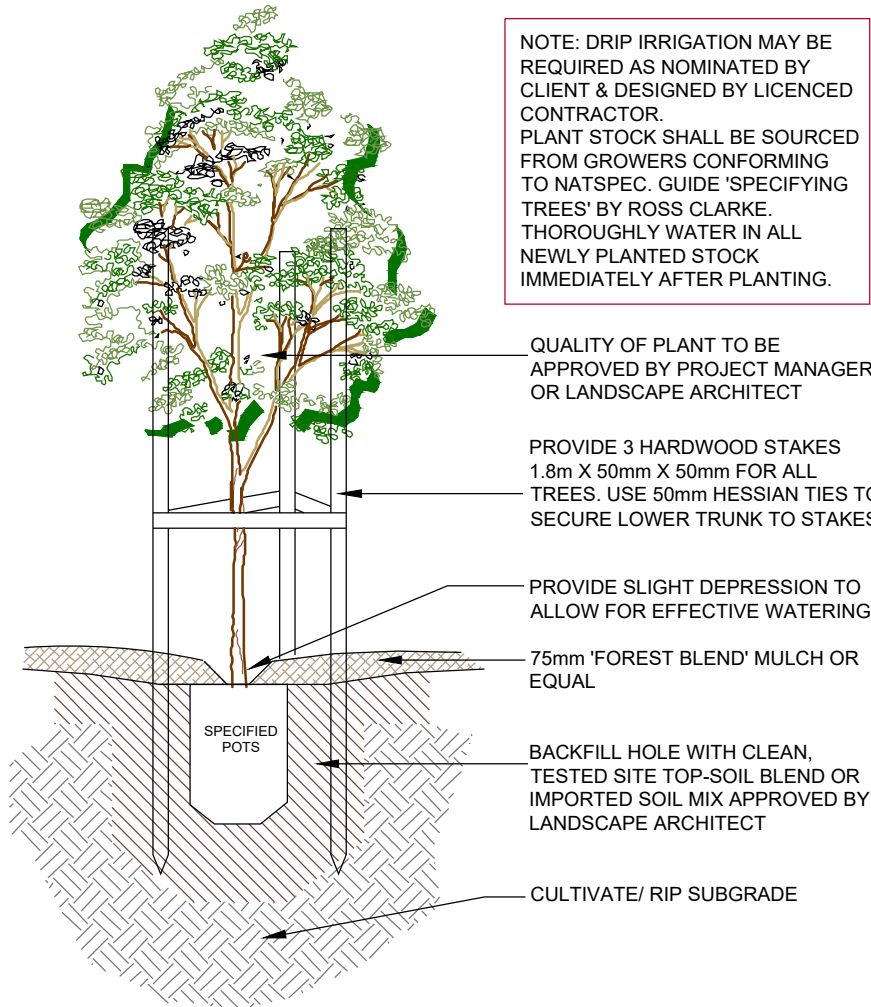


DETAIL 3: INDIVIDUAL TREE PLANTING SCALE 1:20

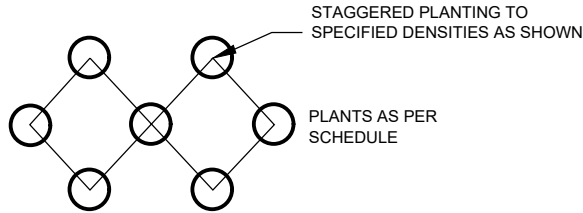


DETAIL 2: MASS PLANTING SETOUT N.T.S

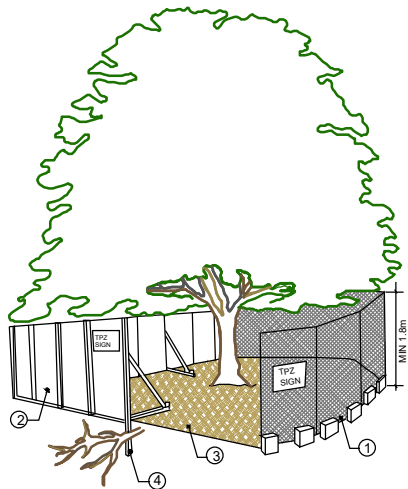


DETAIL 4: TREE PROTECTION ZONE N.T.S

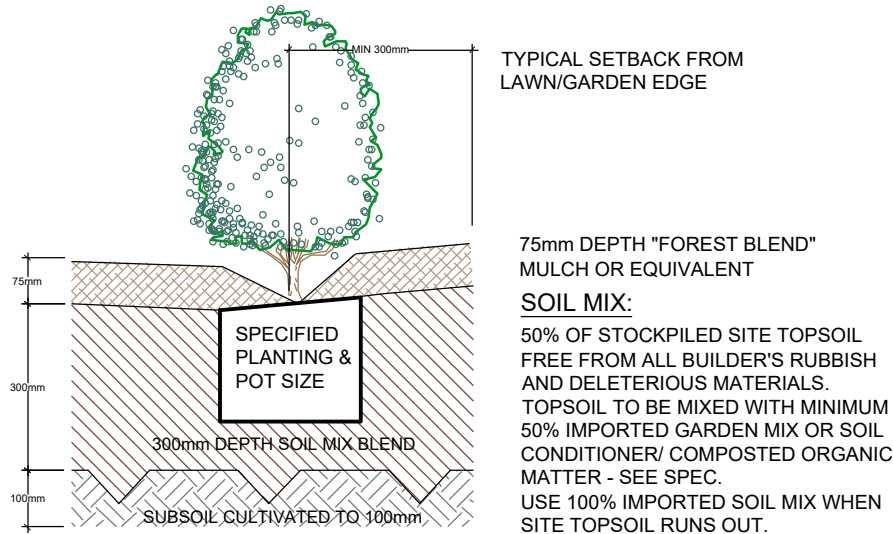

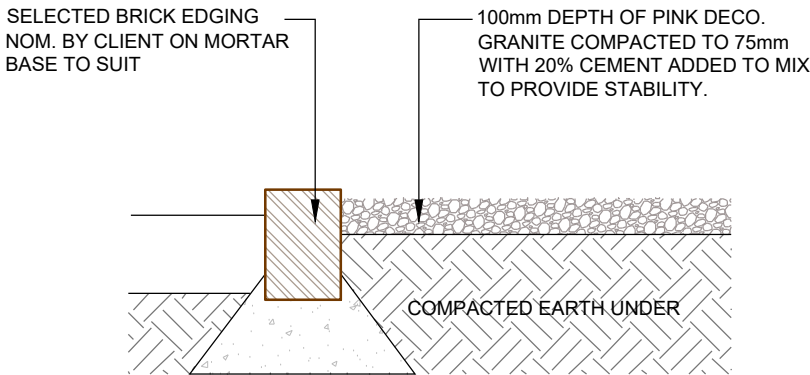


DETAIL 5: GARDEN AREA PREPARATION SCALE 1:15

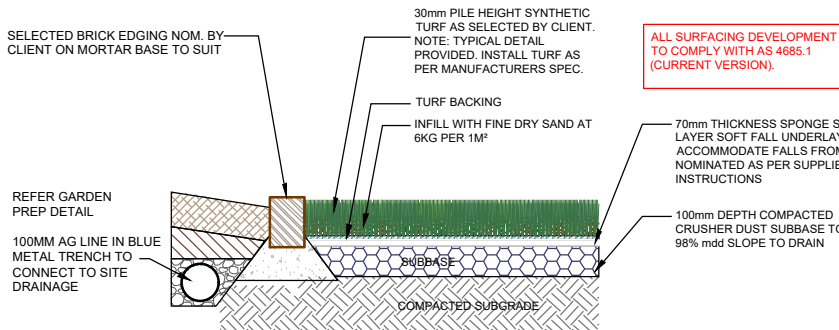


DETAIL 6: TYPICAL COMPACTED DECO GRANITE DETAIL SCALE 1:10




DETAIL 7: TYPICAL ARTIFICIAL TURF & BRICK EDGING SCALE: 1:10


<div>General Notes:</div> <div>Figured dimensions take preference to scale readings. Verify all dimensions on site. PDF'd plans may vary slightly in Scale for that indicated on plans. Report any discrepancies to the Landscape Architect before proceeding with the work.</div> <div>© Copyright R. L. Few Landscape Architectural Services T/A CONZEPT</div> <div>This drawing is protected by copyright. All rights are reserved. Unless permitted under the Copyright Act 1968, no part of this drawing may in any form or by any means be reproduced, published, broadcast or transmitted without the prior written permission of the copyright owner.</div> <div>If the Status of this drawing is not signed off For Construction it may be subject to change, alteration or amendment at the discretion of our office. If so, Concept is not liable for any loss, damage, harm or injury whether special, consequential, direct or indirect, suffered by you or any other person as a result of your use of this drawing for construction purposes.</div> <div>These plans and associated IP remain the property of R. L. Few Landscape Architectural Services Pty Ltd (T/A Concept) until such time as all agreed payments are made in full. We retain the right to withdraw this information from the assessment process if such payments are not made following the notification period.</div>	<div><div>AILA Associate</div><div></div><div>Australian Institute of Landscape Architects</div></div> <div></div>	<div>REV</div> <div>DATE</div> <div>NOTATION/AMENDMENT</div>	<div>COUNCIL</div> <div>CANTERBURY BANKSTOWN</div>	<div></div> <div><div>Conzept Landscape Architects</div><div>Suite 101, 506 Miller St CAMMERAY NSW 2062</div><div>Phone: 9922 5312 Fax: 8209 4982 enquiries@conzept.net.au Mob: 0413 861 351</div></div>	<div>TITLE:</div> <div>DETAILS</div> <div>PROPOSED CHILDCARE CENTRE</div> <div>23 CURTIS ROAD</div> <div>CHESTER HILL</div>	<div>DWG No:</div> <div>LP-Built_17-358 / 3</div>	
		<div>A</div> <div>12.02.16</div> <div>Preliminary DA prepared for review</div>			<div>SCALE:</div> <div>AS NOTED @ A3</div>		
		<div>B</div> <div>15.02.16</div> <div>Revised landscape plan to comply with preliminary letter</div>			<div>DATE:</div> <div>MAY 2023</div>		
					<div>CONSTRUCTION CERTIFICATE</div>	<div>CLIENT</div> <div>Joe Wakim</div>	<div>DRAWN:</div> <div>K.Z/J.G</div>
		<div>C</div> <div>09.06.17</div> <div>Co-ordinated with council conditions</div>			<div>ARCHITECT</div> <div>A2 CONCEPTS</div>	<div>CHECKED:</div> <div>R.F</div>	
		<div>D</div> <div>16.06.17</div> <div>Co-ordinated with council conditions</div>					
		<div>E</div> <div>16.06.20</div> <div>Co-ordinated with client's comments</div>					
		<div>G</div> <div>05.06.23</div> <div>Co-ordinated with constructed</div>					
						<div>STATUS / ISSUE</div> <div>AS BUILT</div>	

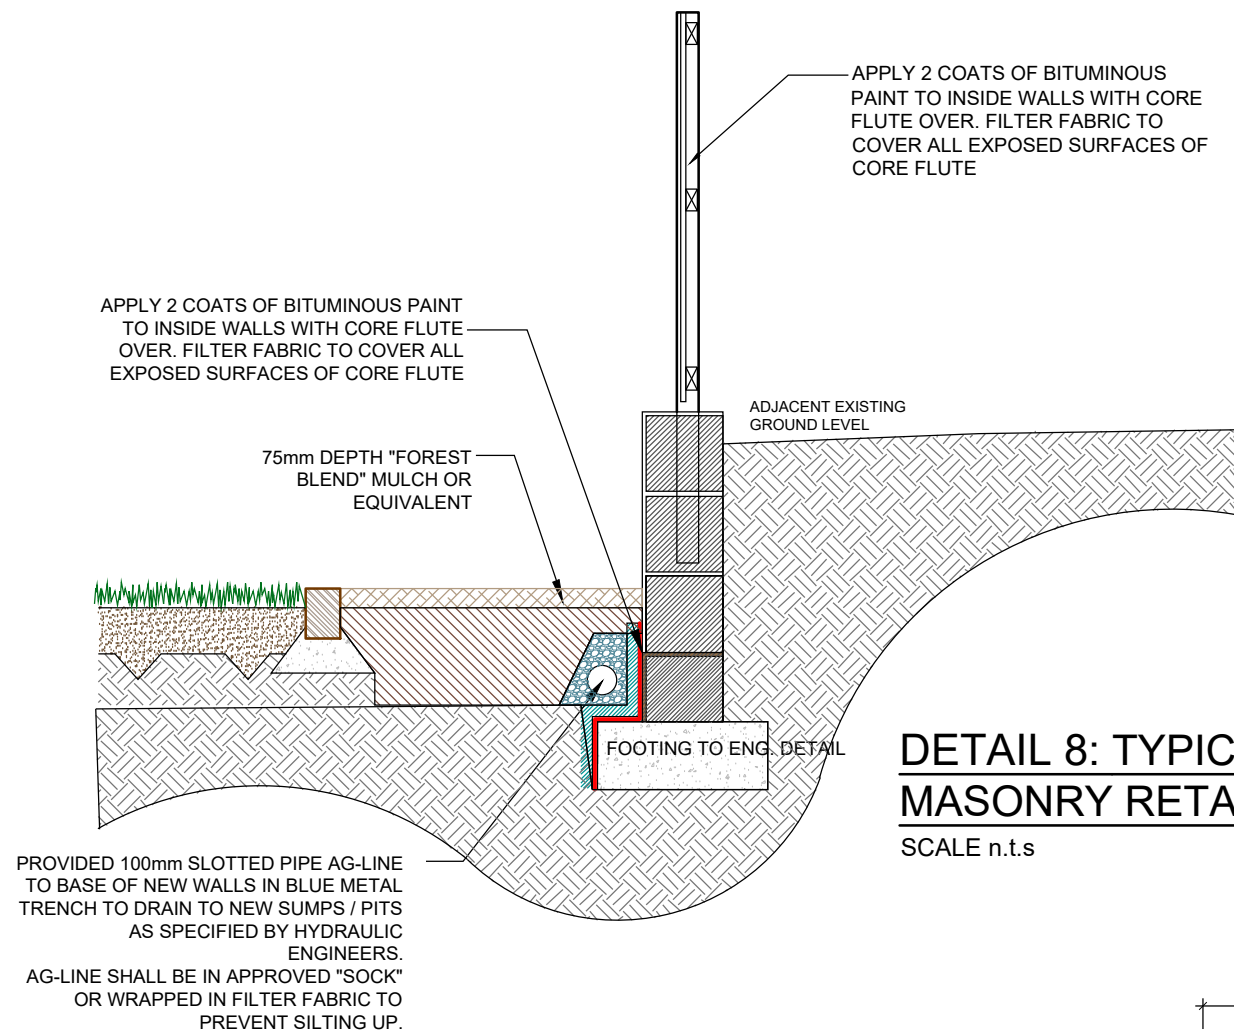

**DETAIL 8: TYPICAL IN SITU
MASONRY RETAINING WALL**
SCALE n.t.s

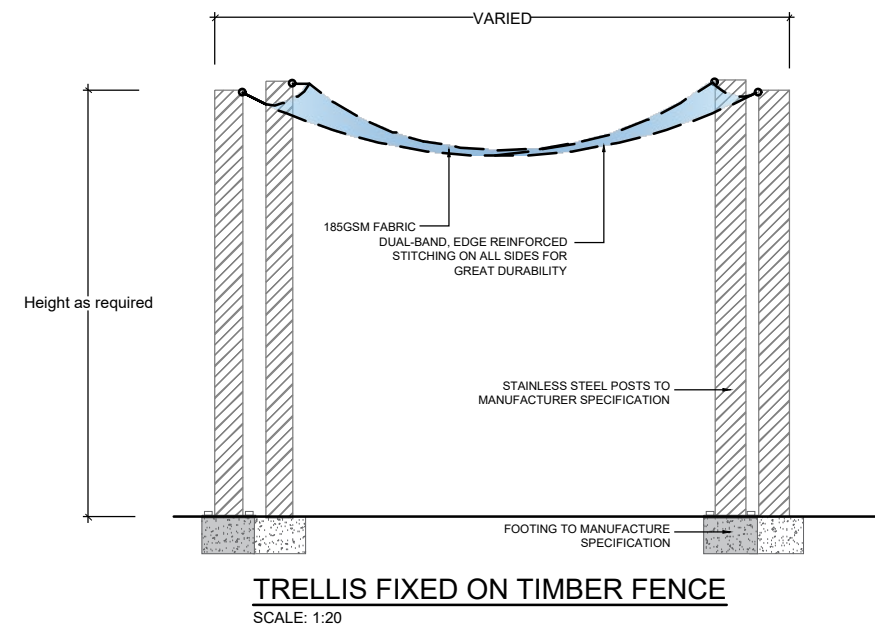

DETAIL 9: TYPICAL SHADE CLOTH
SCALE: nts

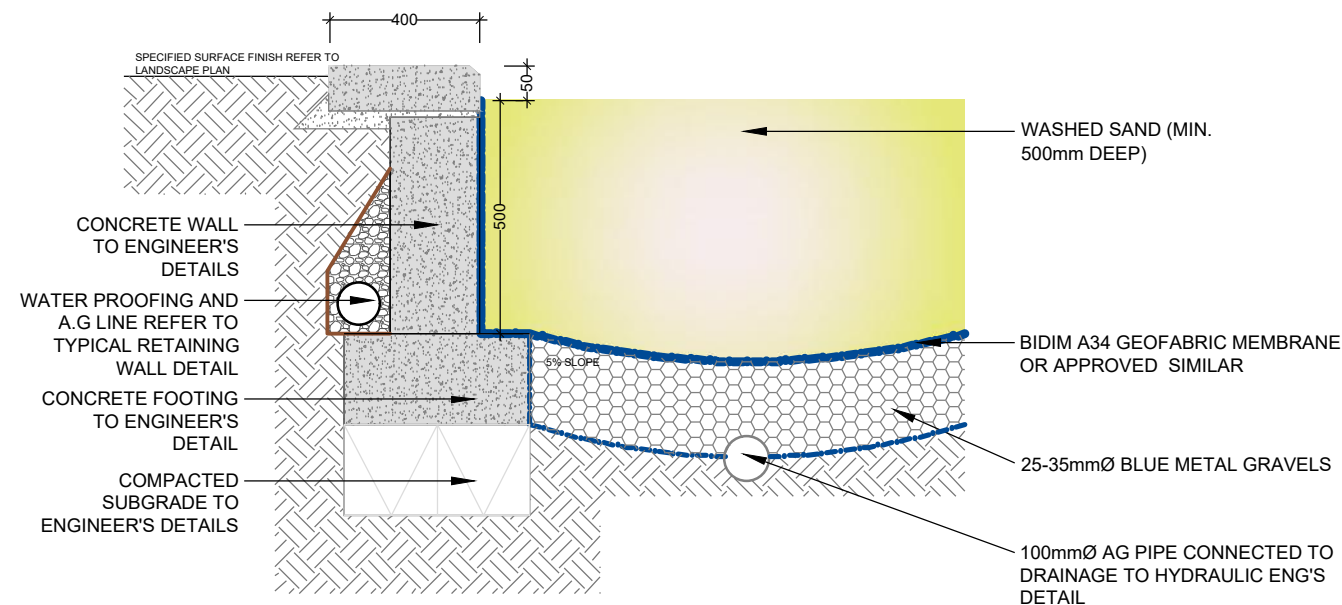

SECTION A-A: TYPICAL SANDPIT DETAIL
NTS

<div>General Notes:</div> <div>Figured dimensions take preference to scale readings. Verify all dimensions on site. PDF'd plans may vary slightly in Scale for that indicated on plans. Report any discrepancies to the Landscape Architect before proceeding with the work.</div> <div><div><div><div><div><div></div></div></div><div><div><div></div></div></div><div><div><div></div></div></div></div><div><div><div></div></div></div><div><div><div></div></div></div></div><div>Australian Institute of landscape Architects</div></div> <div><div><div><div><div></div></div><div><div></div></div></div><div><div><div></div></div><div><div></div></div></div></div><div><div><div></div></div><div><div></div></div></div></div> <div><div><div></div></div><div><div></div></div></div> <div><div><div></div></div><div><div></div></div></div> <
