
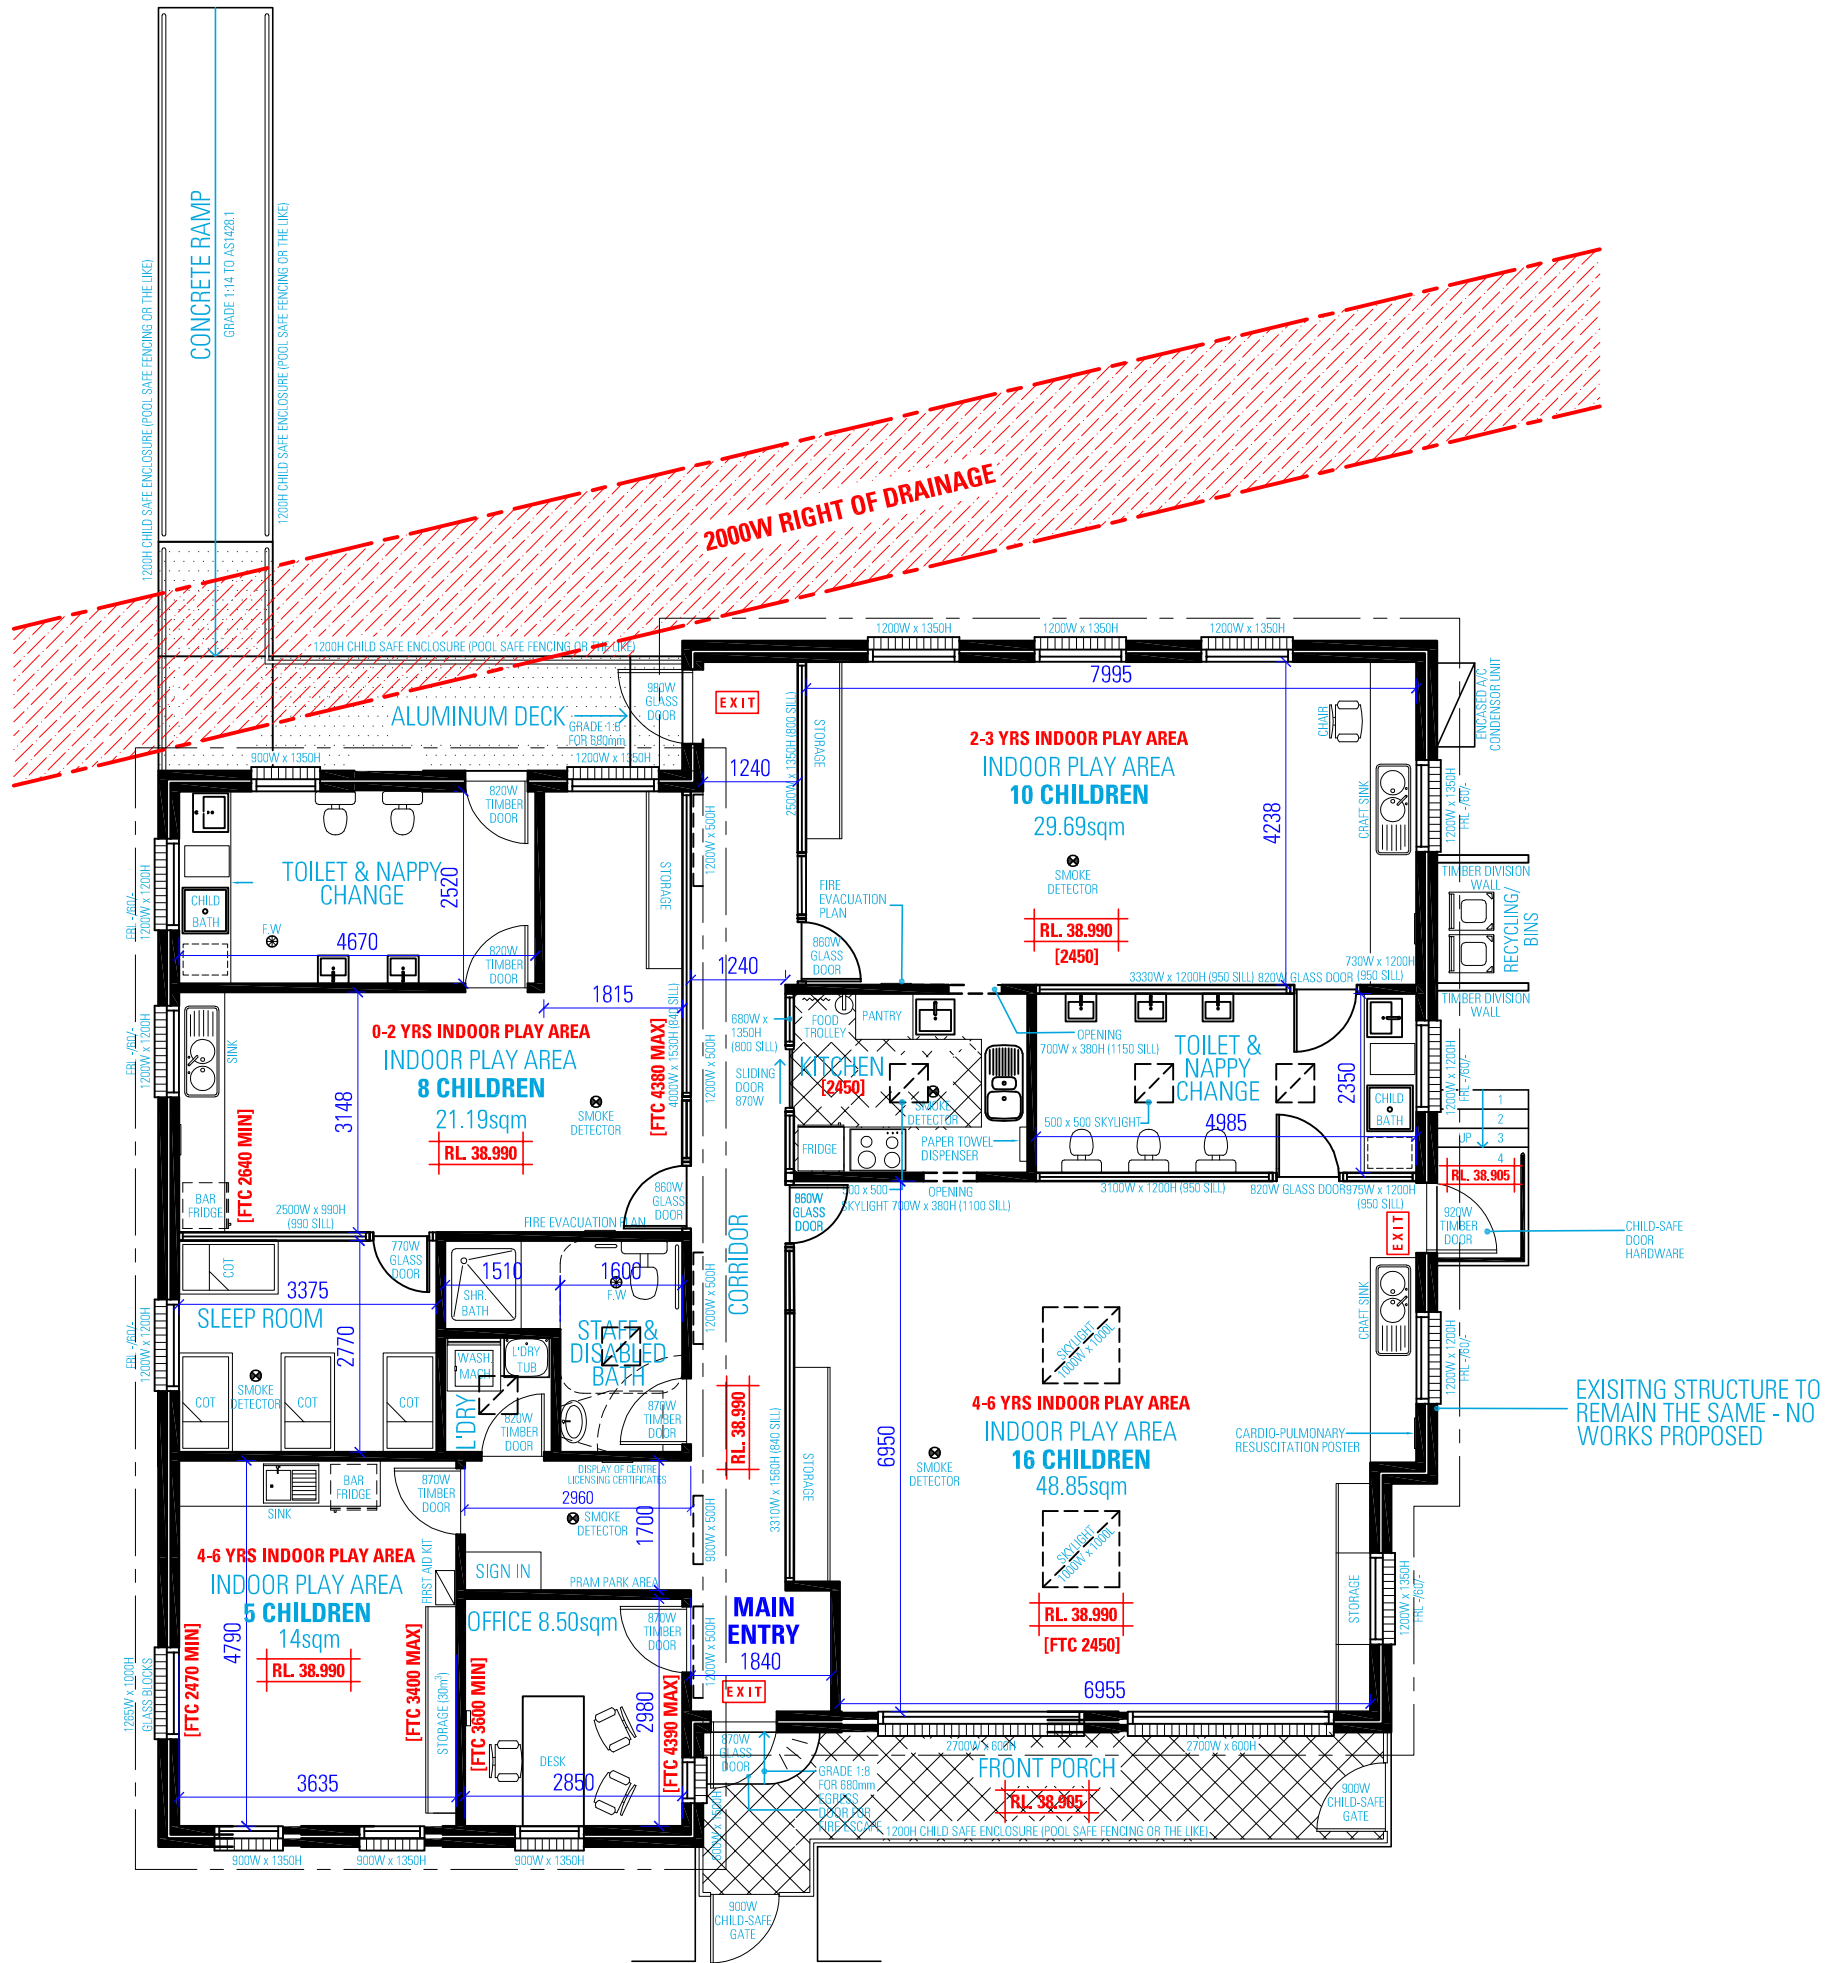


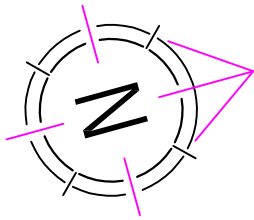

AS BUILT FLOOR PLAN

NOT FOR CONSTRUCTION

NOTES

1. ALL DIMENSIONS ARE IN MILLIMETRES
2. VERIFY ALL DIMENSIONS ON SITE
3. DO NOT SCALE, USE FIGURED DIMENSIONS ONLY
4. VERIFY ALL DISCREPANCIES WITH THE DESIGNER
5. ALL WORKS TO COMPLY WITH THE NATIONAL CONSTRUCTION CODE (BCA) & AUSTRALIAN STANDARDS

COPYRIGHT

THESE DRAWINGS HAVE BEEN PREPARED BY ES DESIGN, AND SHALL REMAIN THE PROPERTY OF THE SAME. NO PORTION OF THESE DRAWINGS, WHETHER IN PART OR WHOLE, SHALL BE USED IN ANY FORM, DUPLICATED OR OTHERWISE, WITHOUT PRIOR WRITTEN PERMISSION OF THE ARCHITECT/DESIGNER. THESE DRAWINGS ARE SUBJECT TO COPYRIGHT LAWS.



www.es.au



PROPOSED ALTERATIONS AND ADDITIONS
50 HIGHLAND AVENUE
BANKSTOWN, NSW 2200

DESIGN ELIE SLEIMAN
DRAFTED ANDREA SAOUMA

MR FRED NOUJAIN

DRAWING

AS BUILT FLOOR PLAN

SCALE 1 : 100 / A3 PORTRAIT
ISSUE A 19.09.2024

DWG No. 24389-02