



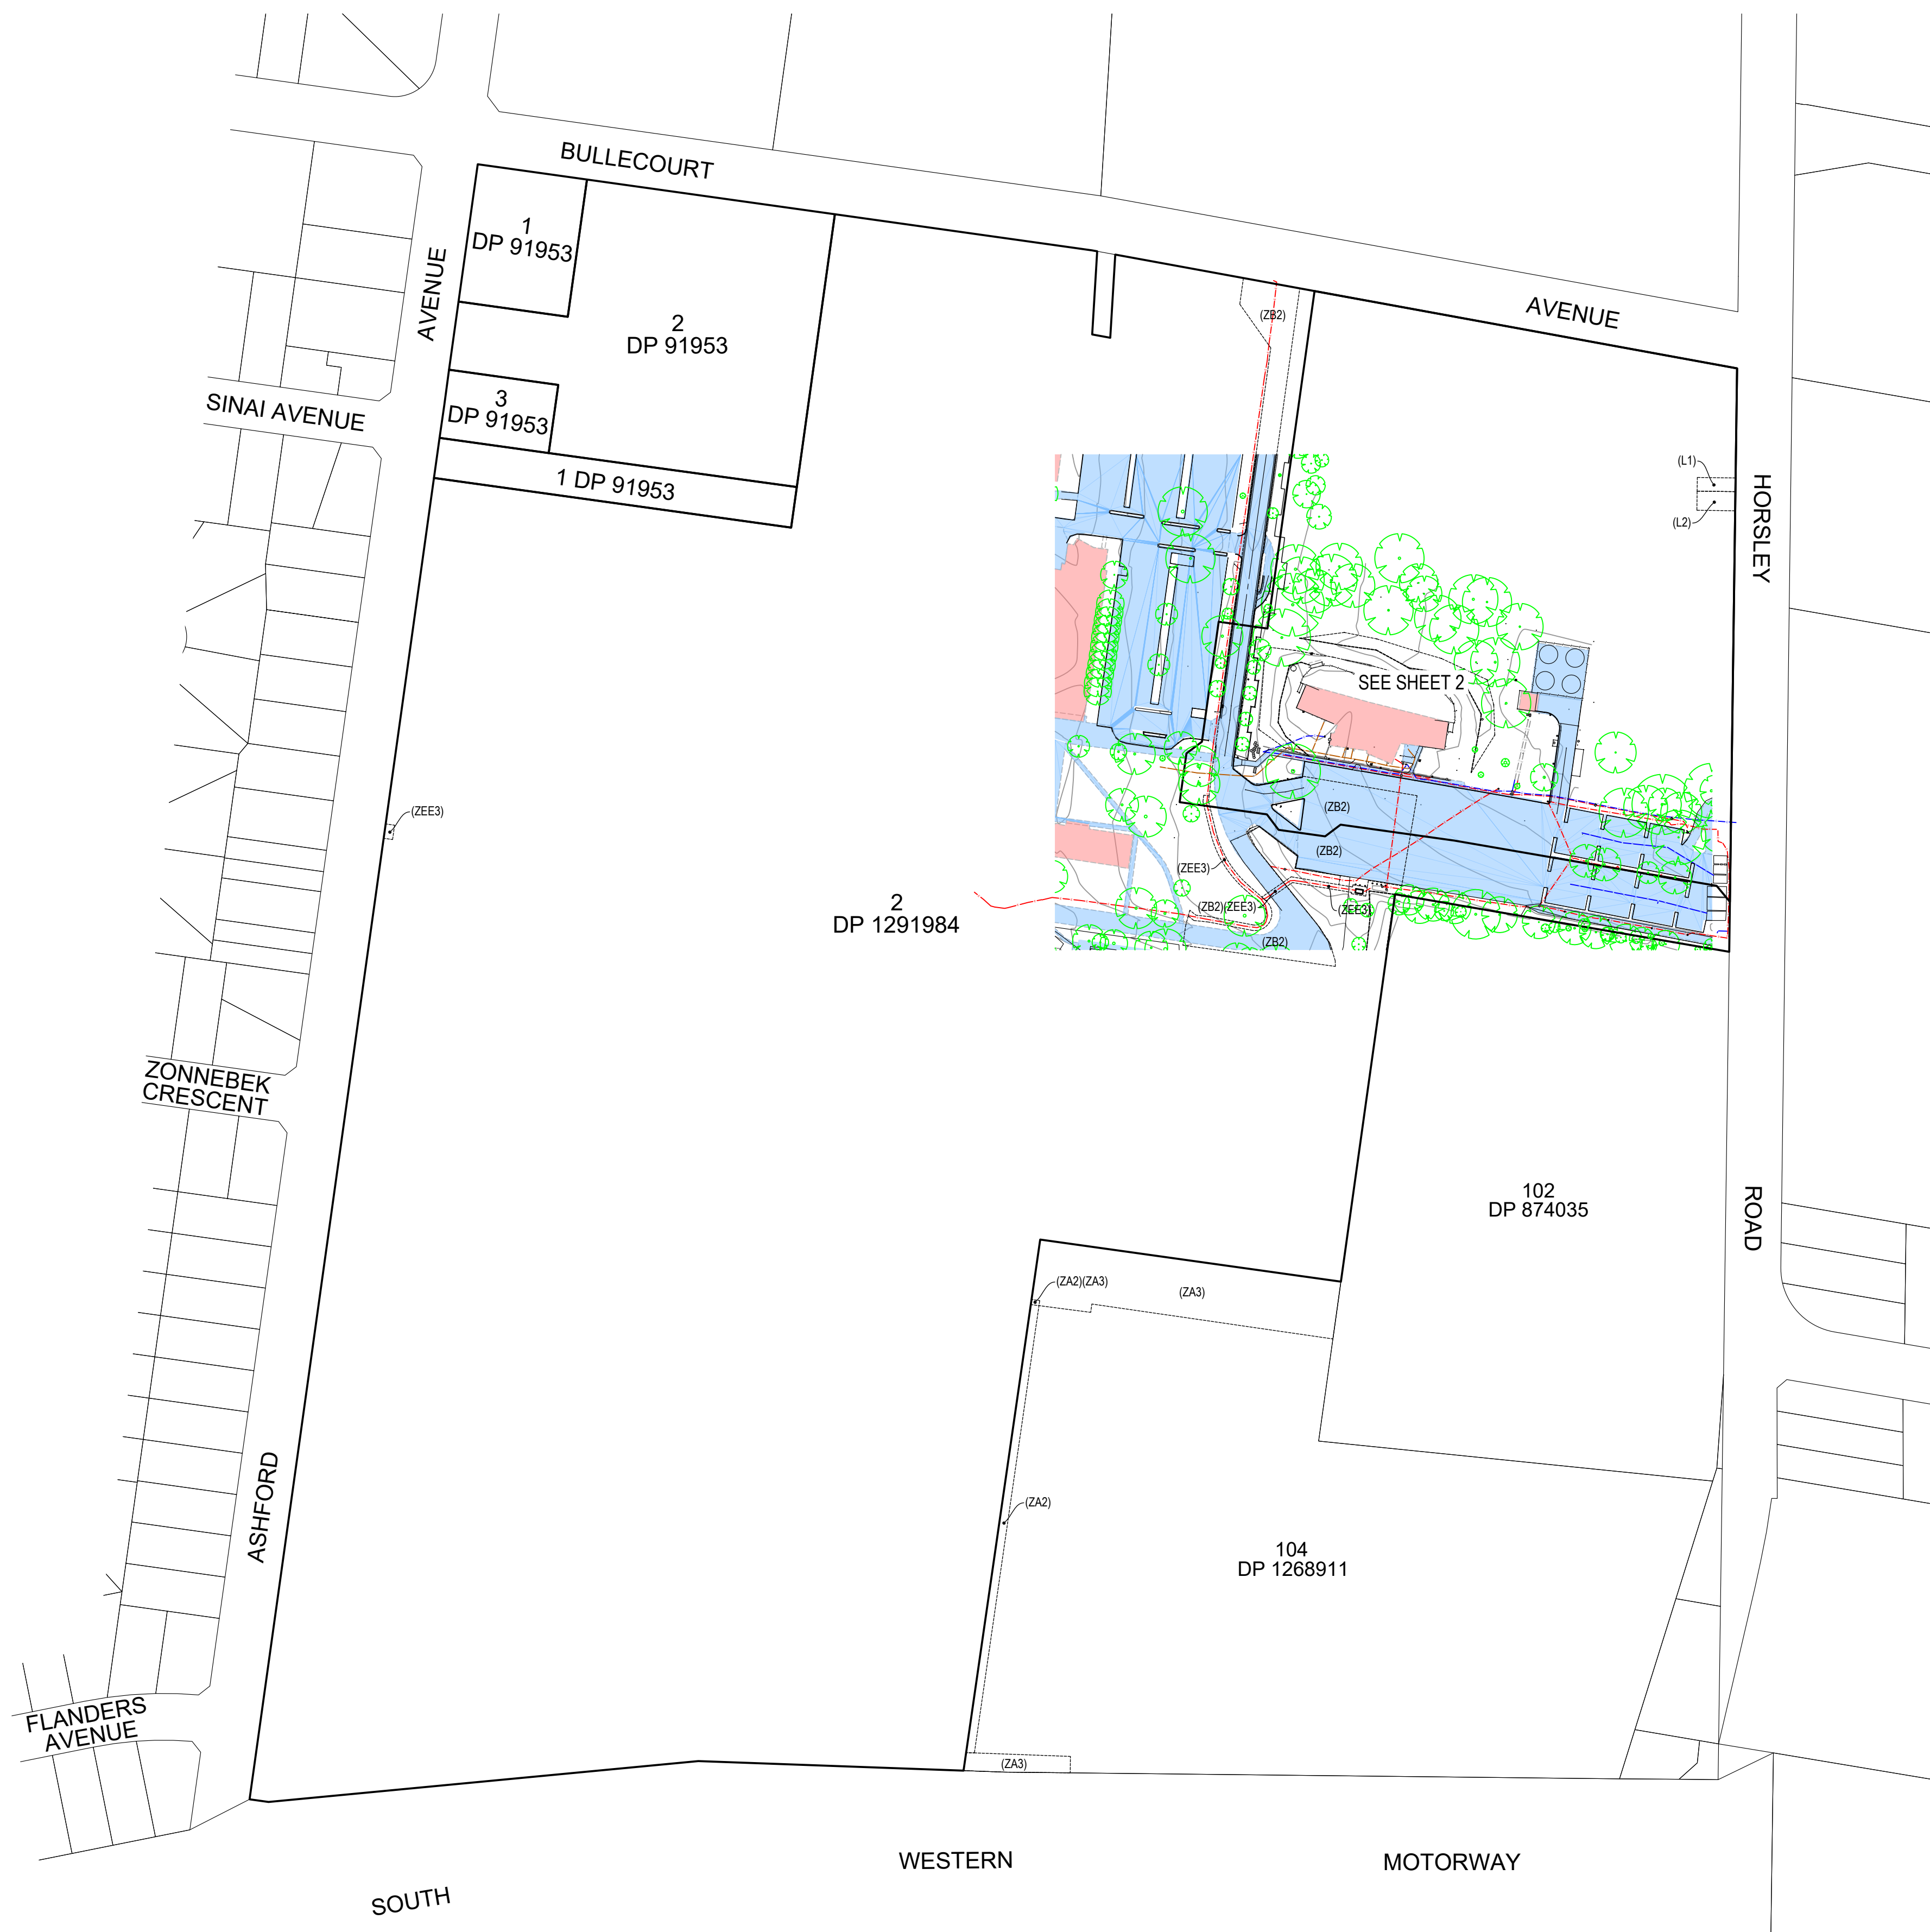

(L1)	LEASES TO CROWN CASTLE (AH574654, AH574655, AH574656, AH574657)
(L2)	LEASES TO AMPLIET (AH208745 AND AH208746) AND LEASES TO CROWN CASTLE (AH574654, AH574655, AH574656, AH574657)
(ZA2)	EASEMENT TO DRAIN WATER 3.0 WIDE
(ZA3)	EASEMENT TO DRAIN WATER VARIABLE WIDTH
(ZB2)	RIGHT OF CARRIAGE WAY VARIABLE WIDTH (DP1263474)
(ZEE2)	EASEMENT FOR ELECTRICITY AND OTHER PURPOSES (DP1144378)
(ZEE3)	EASEMENT FOR ELECTRICITY AND OTHER PURPOSES 2 & 3.3 WIDE (DP1263474)

PROJECT No. 2301879
DRAWING REF. 2301879(C)-DET
VERSION A
SHEET 1 OF 2

(ZB2) RIGHT OF CARRIAGE WAY VARIABLE WIDTH (DP1236474)
(ZEE2) EASEMENT FOR ELECTRICITY AND OTHER PURPOSES (DP144378)
(ZEE3) EASEMENT FOR ELECTRICITY AND OTHER PURPOSES 2 & 3.3 WIDE (DP1236474)

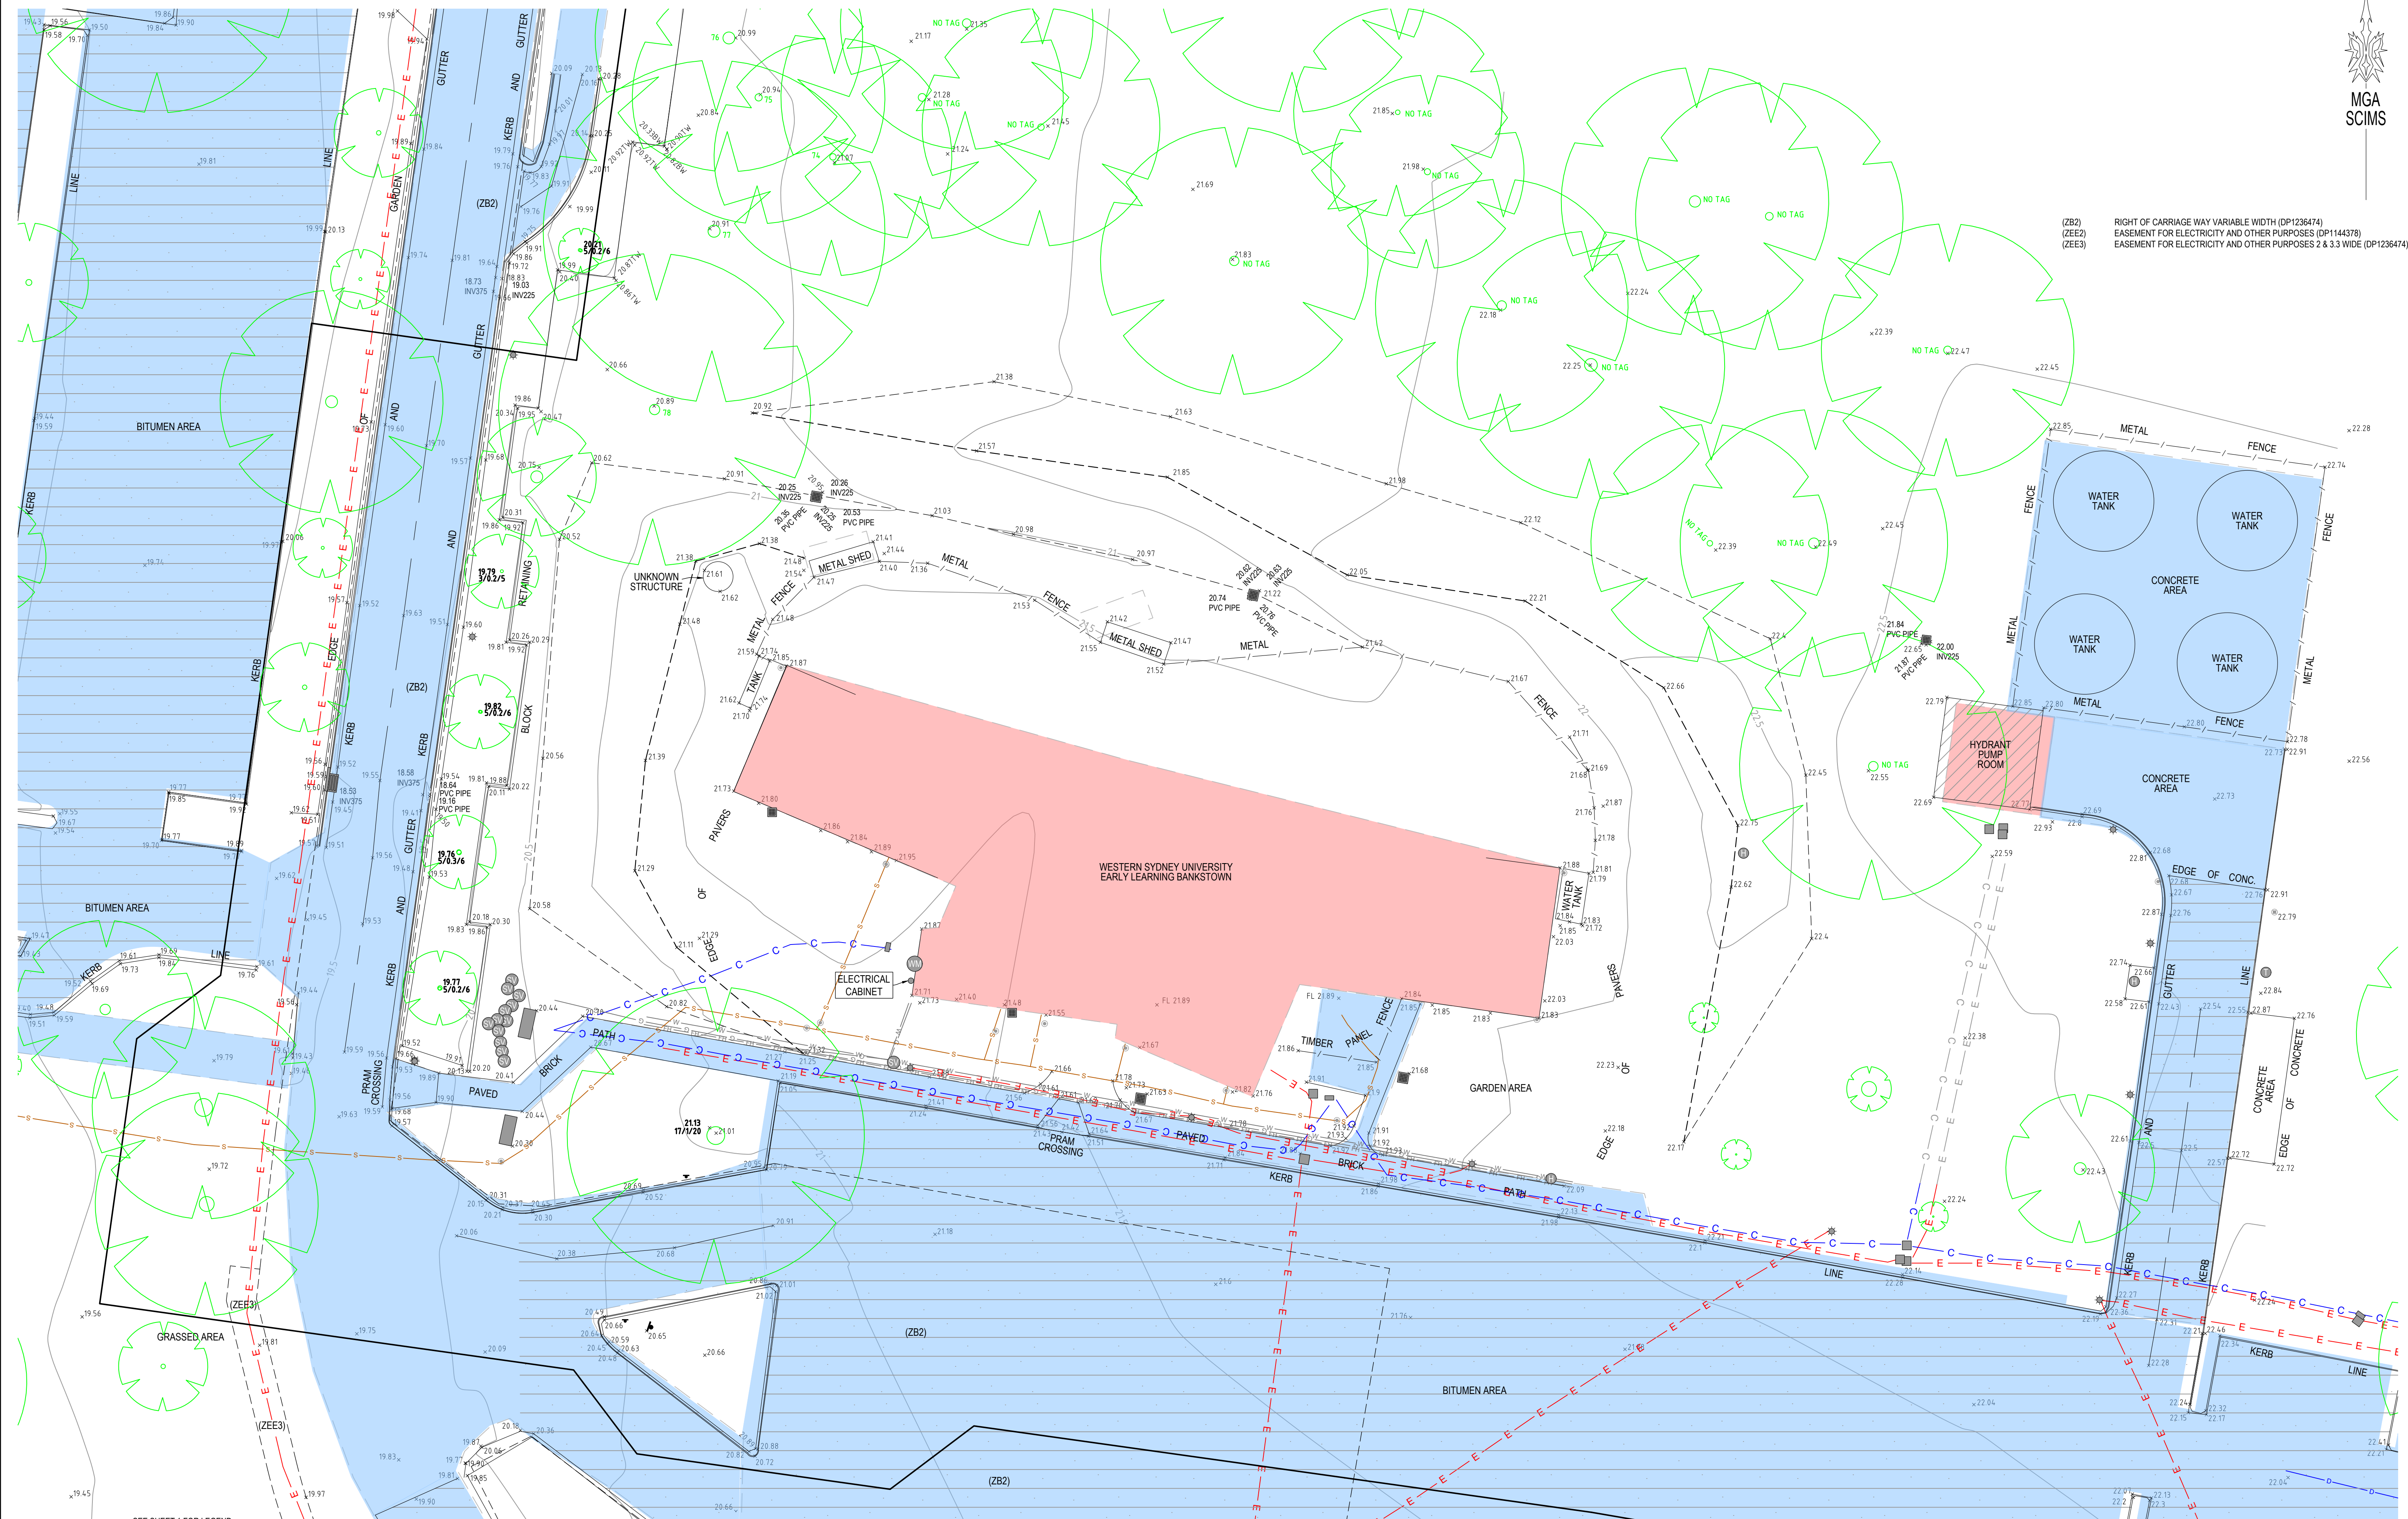

VER	BY	AMENDMENTS	DATE
A	BC	ORIGINAL ISSUE	17-12-2024

- THE POSITION OF SERVICES SHOWN ON THIS DRAWING ARE INDICATIVE ONLY AND HAVE BEEN PLOTTED FROM PLANS AND DRAWINGS SUPPLIED BY RELEVANT AUTHORITIES.
- SERVICE AUTHORITY PITS, MANHOLES, POLES, MARKER POSTS, ETC., WHERE SIGHTED AT TIME OF SURVEY, HAVE BEEN LOCATED. THE SURVEY DOES NOT INCLUDE INVESTIGATION OR LOCATION OF UNDERGROUND INFRASTRUCTURE.
- SERVICES INFORMATION SHOWN ON THIS DRAWING HAS BEEN OBTAINED THROUGH A DIAL BEFORE YOU DIG SEARCH AND IS VALID FOR THE PERIOD OF TIME FROM THE DATE OF ISSUE NOTATED BY THE AUTHORITY.
- PRIOR TO ANY DEMOLITION, EXCAVATION OR CONSTRUCTION ON OR ADJACENT TO THE SITE IT IS THE RESPONSIBILITY OF THE DEVELOPER AND CONTRACTORS TO APPLY FOR AND OBTAIN UP TO DATE PLANS THROUGH A NEW DIAL BEFORE YOU DIG SEARCH AND TO CONTACT ALL THE RELEVANT AUTHORITIES TO ESTABLISH AND CONFIRM THE DETAIL LOCATION AND DEPTH OF ALL UNDERGROUND SERVICES.



CLIENT:



BW Beveridge Williams
Development and Infrastructure Consultants
Western Sydney (02) 4625 5055 www.beveridgewilliams.com.au

DETAILS:

PLAN OF DETAIL AND CONTOUR
OVER PART OF
LOT 2 IN DP1291984
2 BULLECOURT AVENUE, MILPERRA

ORIGINAL SHEET SIZE
SCALE 1:200 A1
CAD REFERENCE: 2301879(C)-DET
0 4 8 12
SCALE ON ORIGINAL DRAWING AT 1:200

SURVEYOR: BC
DRAWN: TR
CHECKED: BC
SURVEY DATE: 05-12-2024
VERTICAL DATUM: MGA 2020
HORIZONTAL DATUM: AHD

PROJECT No.
2301879
DRAWING REF.
2301879(C)-DET
VERSION A
SHEET 2 OF 2