


PROPOSED USE OF EXISTING
FITNESS CENTRE TO OPERATE
AS BUILT AND INCLUSION OF
BALCONY AREA ON LEVEL 1 AS
PART OF GYMNASIUM

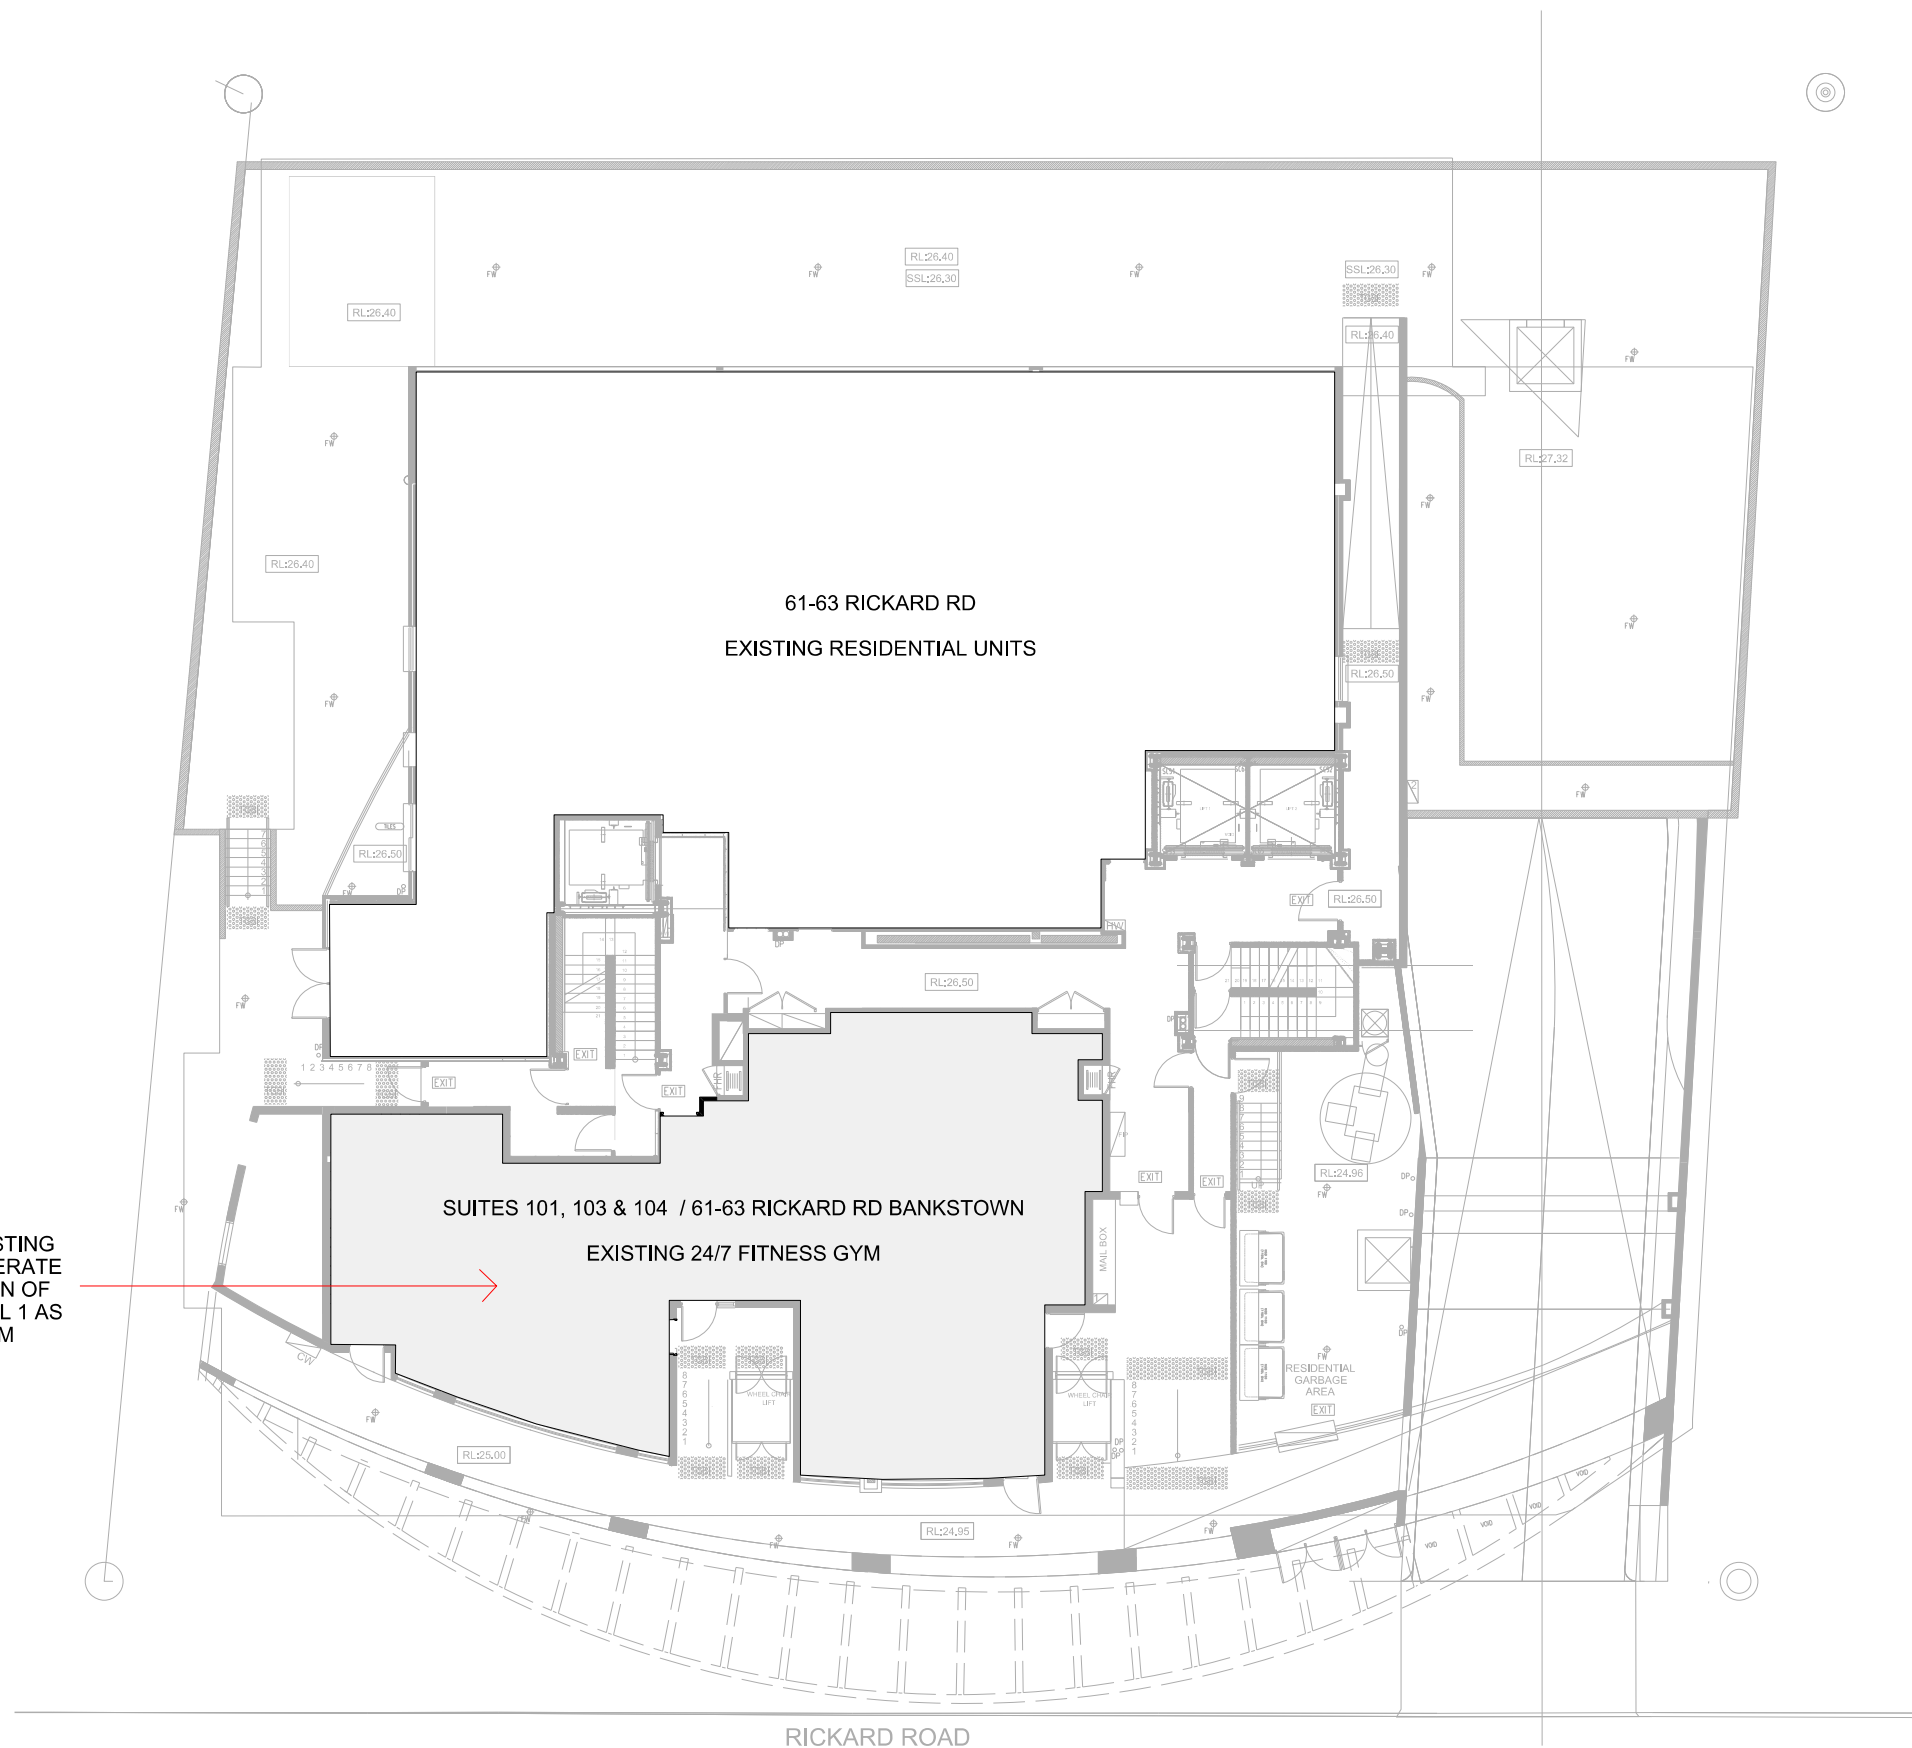

GROUND FLOOR PLAN

NOTE:
IT IS BELIEVED THAT A MAJOIRTY OF THE EXTERNAL AND
INTERNAL WALL MODIFICATIONS WHERE MADE DURING
THE BASE BUILD AND NOT DURING THE FITUT OF THE
EXISTING APPROVED DA FOR FITNESS CENTRE. IT IS
BELIVED THE DA RELFECTED THE APPROVED BUILDING
PLANS AND NOT THE BUILT STRUCTURE.


- EXISTING BUILT STRUCTURE AND
APPROVED PLAN SHOWN GREY
- ALTERATIONS AND AS BUILT STRUCTURES
SHOWN BLACK
- PROPOSED WORKS SHOWN HIGHLIGHTED
RED
- USE OF EXISTING BALCONY FOR GYMANSIUM
PURPOSES

Revisions	No	Date	Description	App'd
A	22.08.2026	SUED FOR DA APPROVAL		RE



Do not scale drawings. Use figured dimensions only.
Check & verify levels and dimensions on site prior to
the commencement of any work, the preparation of
shop drawings or the fabrication of components.
This drawing is the copyright of ELKAD GROUP PTY
LTD and is protected under the Copyright Act 1968. Do
not alter, reproduce or transmit in any form, or by any
means without the express permission of ELKAD
GROUP PTY LTD.

DEVELOPMENT
APPLICATION

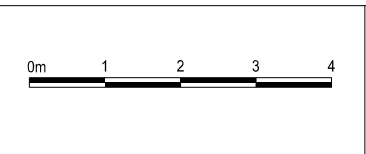

Project
EXISTING 24/7 FITNESS GYM

Drawing Title
DA00.00
NOTIFICATION PLAN
GROUND FLOOR
Scale
NTS
Issue
A