

Site Plan
SCALE: 1:400

- NOTE:
- ONLY SELECTED DETAIL RELATED TO THE AS-BUILT SANDSTONE WALLS HAVE BEEN LOCATED IN THIS SURVEY
 - ORIGIN OF LEVELS: SSM63789 (RL 49.68) AHD

(A) DENOTES EASEMENT FOR ELECTRICITY TRANSMISSION LINES 5 WIDE (VIDE DP645080)

LEGEND

BRW - BOTTOM RETAINING WALL
RFP - ROUND FENCE POST
TRW - TOP RETAINING WALL



Zenith
Surveying
Services
LAND SURVEYORS
ABN: 97 085 028 379
45 Tuncurry Lane
Tuncurry NSW 2428
Ph: (02)6555 7024 Mob: 0410 596 896

DESCRIPTION
SKETCH SHOWING LOCATION & LEVELS OF AS-BUILT RETAINING WALLS AT No.52 PARADISE DRIVE, SMITHS LAKE BEING LOT 18 IN DP 806842

L.G.A. MID-COAST COUNCIL


RaP Drawing
Phone 0421808574 rapdrawing@gmail.com
abn 30 632 283 157

client
AS-Built Retaining Walls
Norm Lyons
52 Paradise Drive
Smiths Lake

Print Date: Thursday, 31 October 2024
NSW 2428 Lot 18 D.P. 806842
page: 1 / 5

Dimensions are in millimetres * Figured dimensions to be taken in preference to scale * Levels and dimensions to be verified prior to construction *All work to comply to Council regulations.

Driveway Long Section

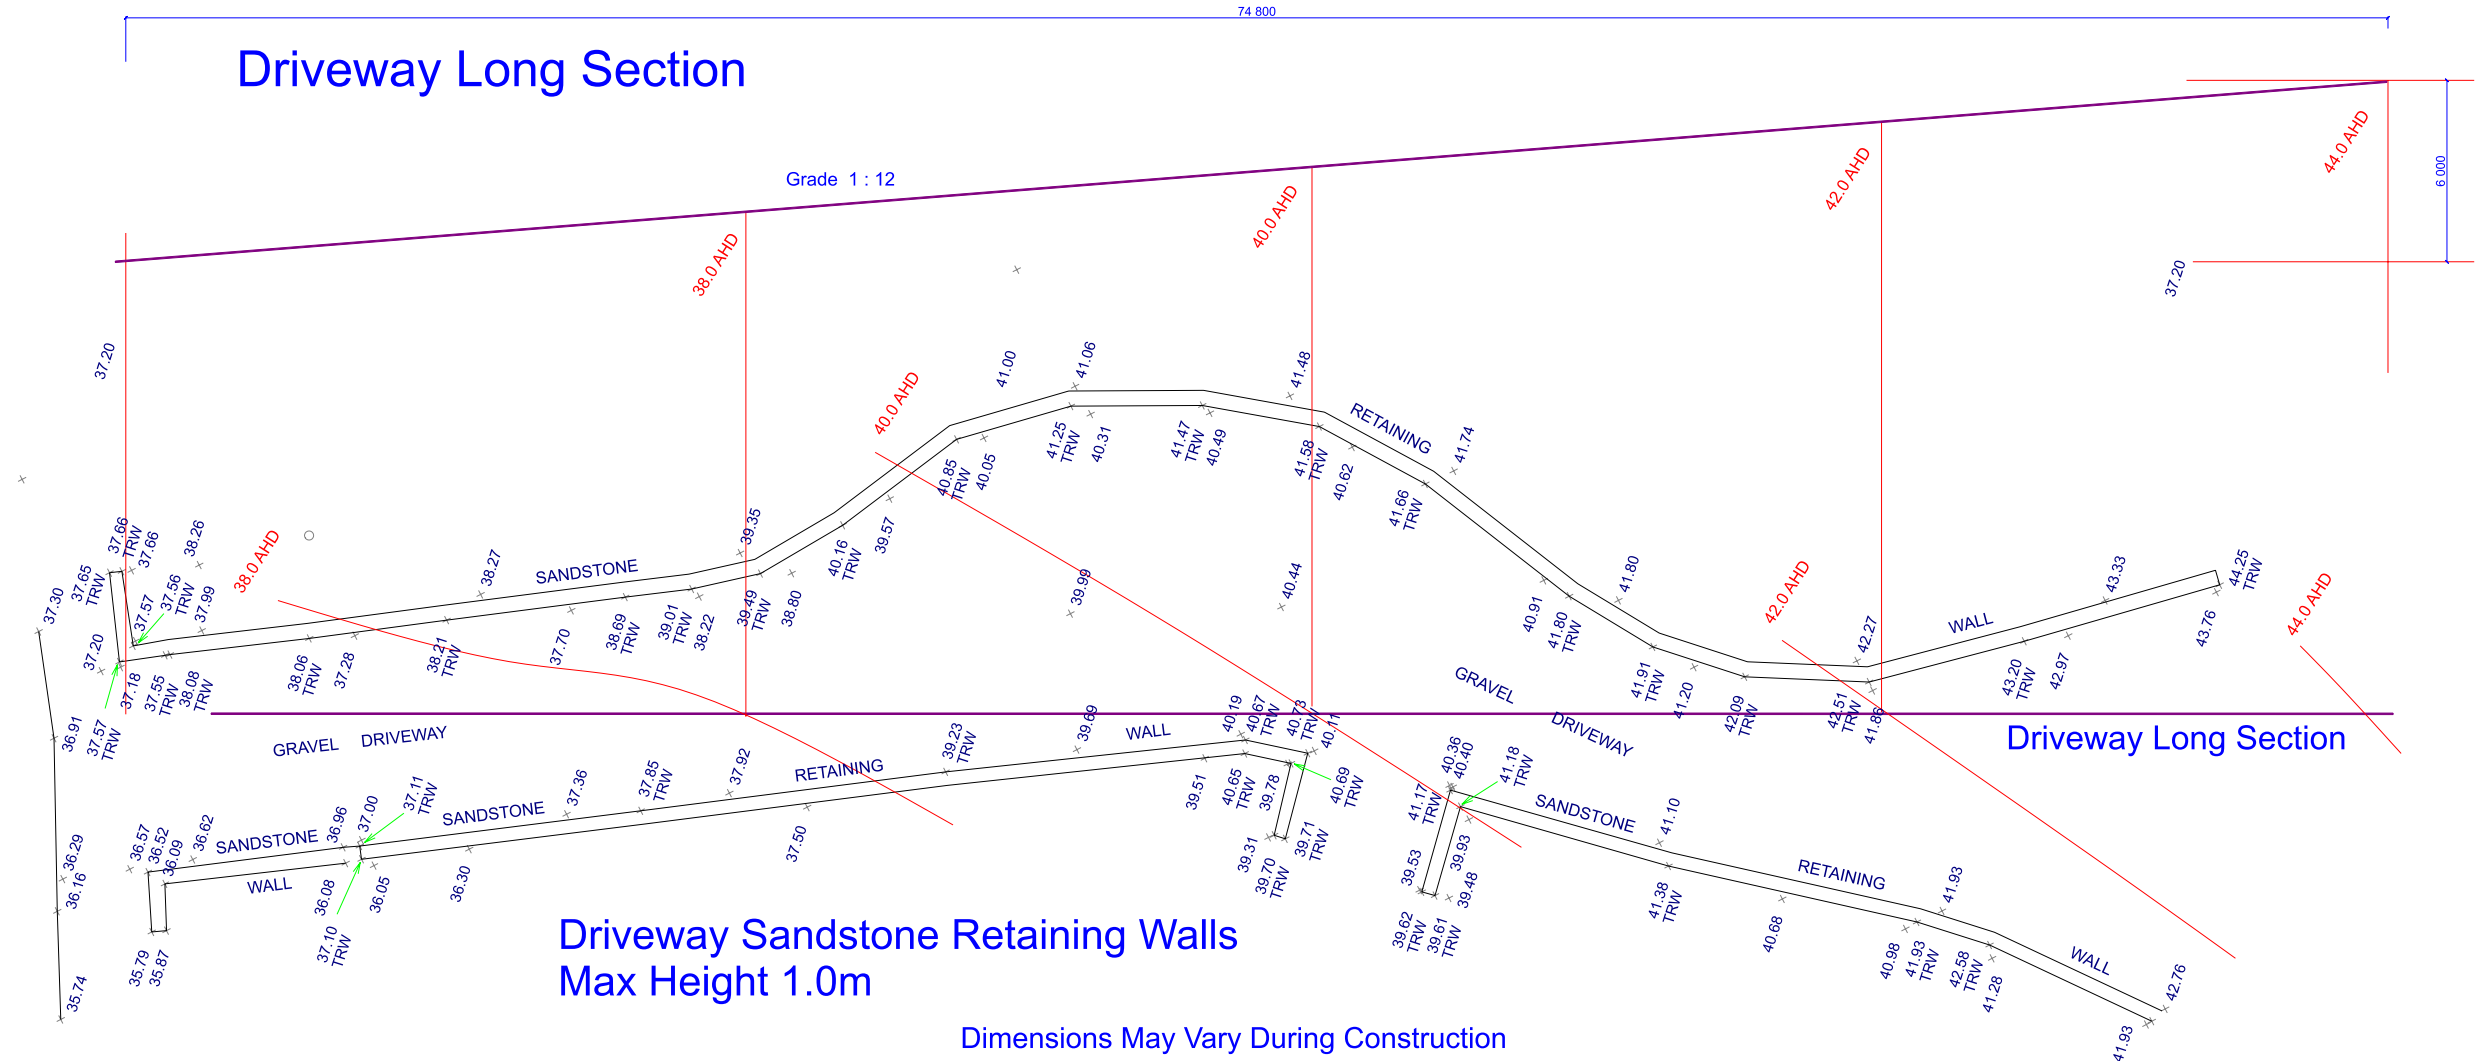

Driveway Sandstone Retaining Walls Max Height 1.0m

Dimensions May Vary During Construction



Driveway
SCALE: 1:250

RaP Drawing
Phone 0421808574 rapdrawing@gmail.com
abn 30 632 283 157

client

AS-Built Retaining Walls

Norm Lyons
52 Paradise Drive
Smiths Lake NSW 24

Print Date: Thursday, 31 October 2024

NSW 2428 Lot 18 D.P. 806842

page: 2 / 5 A3

Dimensions are in millimetres * Figured dimensions to be taken in preference to scale * Levels and dimensions to be varified prior to construction *All work to comply to Council regulations.

NOTE:

1. ONLY SELECTED DETAIL RELATED TO THE AS-BUILT SANDSTONE WALLS HAVE BEEN LOCATED IN THIS SURVEY
2. ORIGIN OF LEVELS: SSM63789 (RL 49.68) AHD

2. ORIGIN OF LEVELS: SSM63789 (RL 49.68) AHD

LEGEND

A DENOTES EASEMENT FOR ELECTRICITY TRANSMISSION LINES 5 WIDE (VIDE DP645080)


BRW - BOTTOM RETAINING WALL
RFP - ROUND FENCE POST
TRW - TOP RETAINING WALL



Zenith
Surveying
Services
LAND SURVEYORS
ABN: 97 085 028 379
45 Tuncurry Lane
Tuncurry NSW 2428
(02)6555 7024 Mob: 0410 596 896


DESCRIPTION	SKETCH SHOWING LOCATION & LEVELS OF AS-BUILT RETAINING WALLS AT No.52 PARADISE DRIVE, SMITHS LAKE BEING LOT 18 IN DP 806842
-------------	--

L.G.A.	MID-COAST COUNCIL
--------	-------------------

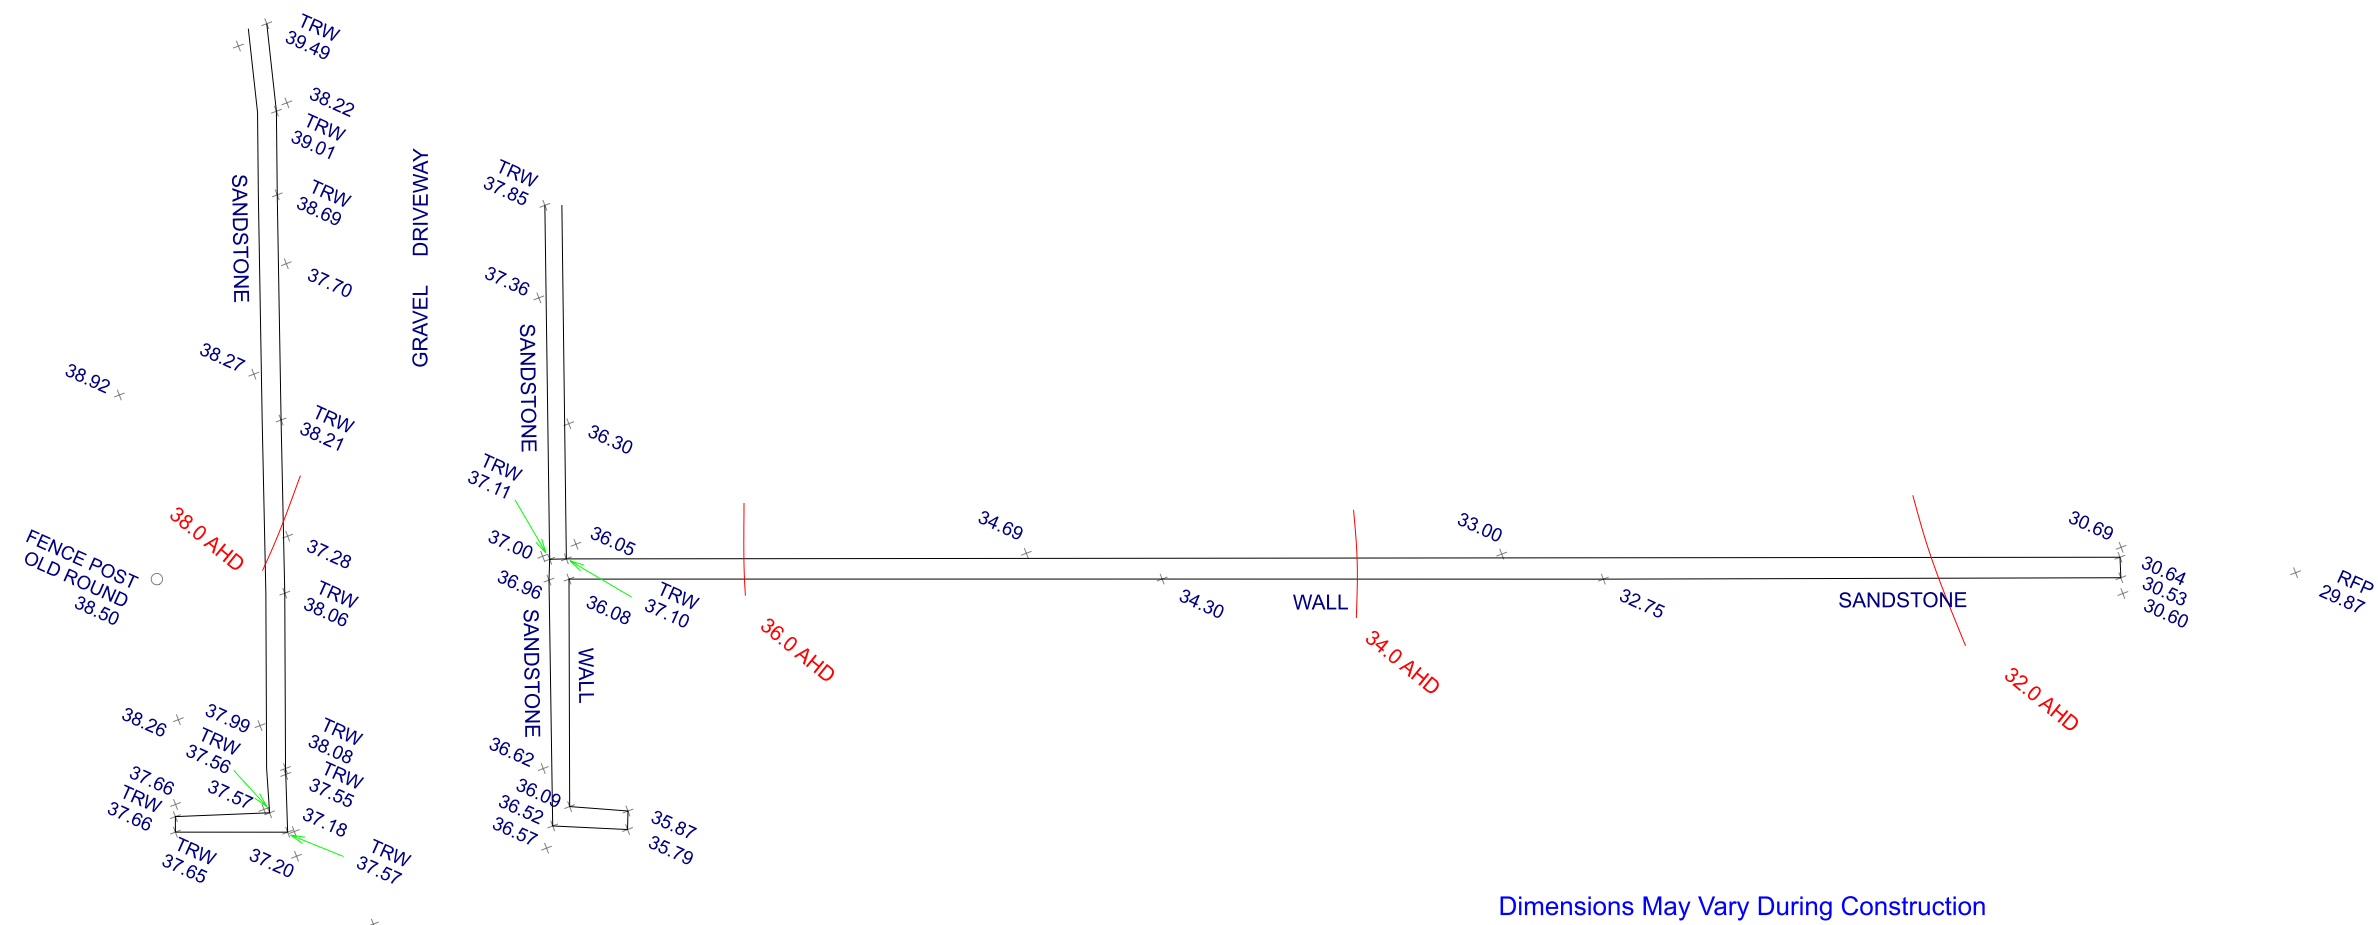


Dimensions May Vary During Construction

Feature Sandstone Boundary Fence

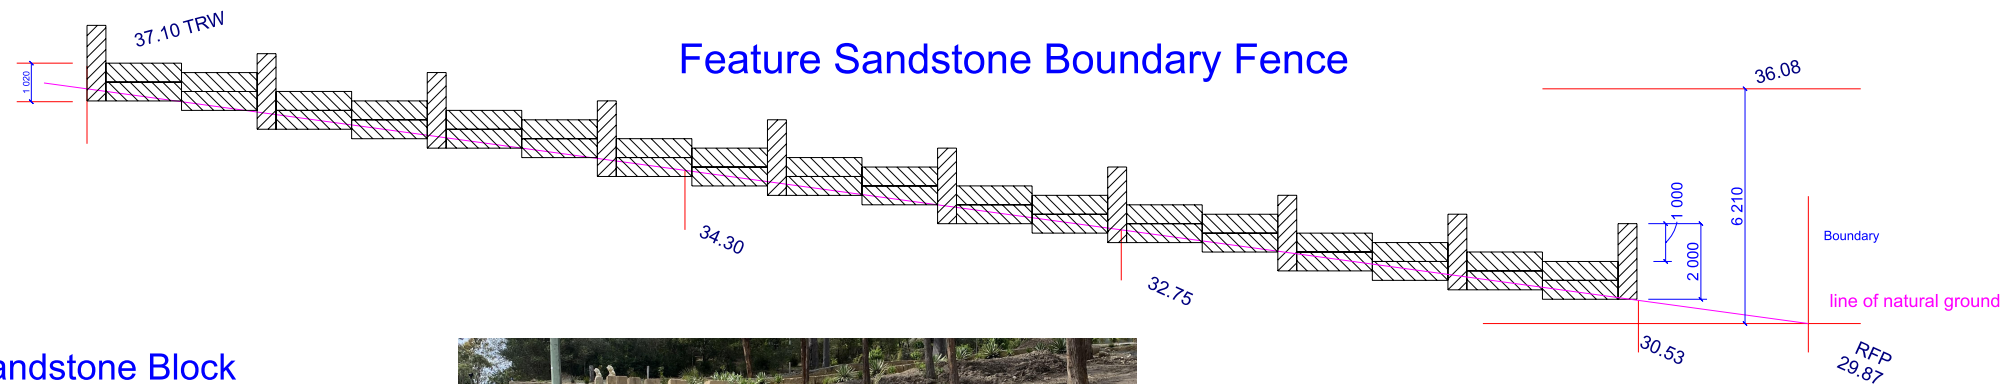

Sandstone Block

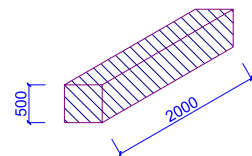

WALL A

Wall A
SCALE: 1:200

AS-Built Retaining Walls

ent

Norm Lyons
52 Paradise Drive
Smiths Lake

Print Date: Thursday, 31 October 2024

NSW 2428 Lot 18 D.P. 806842

page: A3
3 / 5

RaP Drawing
Phone 0421808574 rapdrawing@gmail.com
ahn 30 632 283 157

NOTE:

1. ONLY SELECTED DETAIL RELATED TO THE AS-BUILT SANDSTONE WALLS HAVE BEEN LOCATED IN THIS SURVEY
2. ORIGIN OF LEVELS: SSM63789 (RL 49.68) AHD

LEGEND

(A) DENOTES EASEMENT FOR ELECTRICITY TRANSMISSION LINES 5' WIDE (VIDE DP645080)

BRW - BOTTOM RETAINING WALL
RFP - ROUND FENCE POST
TRW - TOP RETAINING WALL





Zenith
Surveying
Services
LAND SURVEYORS
ABN: 97 085 028 379
45 Tuncurry Lane
Tuncurry NSW 2428
(02)6555 7024 Mob: 0410 596 896



DESCRIPTION	SKETCH SHOWING LOCATION & LEVELS OF AS-BUILT RETAINING WALLS AT No.52 PARADISE DRIVE, SMITHS LAKE BEING LOT 18 IN DP 806842
-------------	--

L.G.A.	MID-COAST COUNCIL
--------	-------------------

Dimensions are in millimetres * Figured dimensions to be taken in preference to scale * Levels and dimensions to be verified prior to construction *All work to comply to Council regulations.

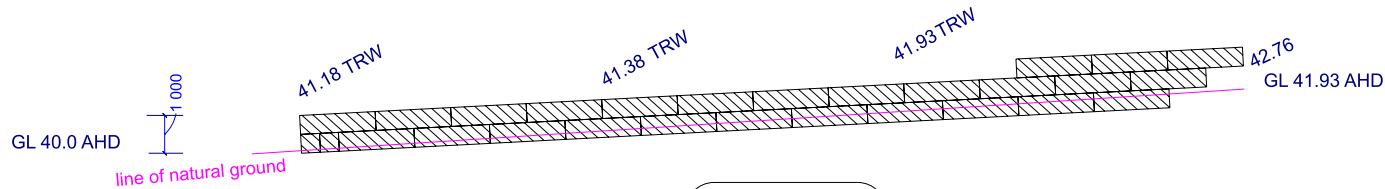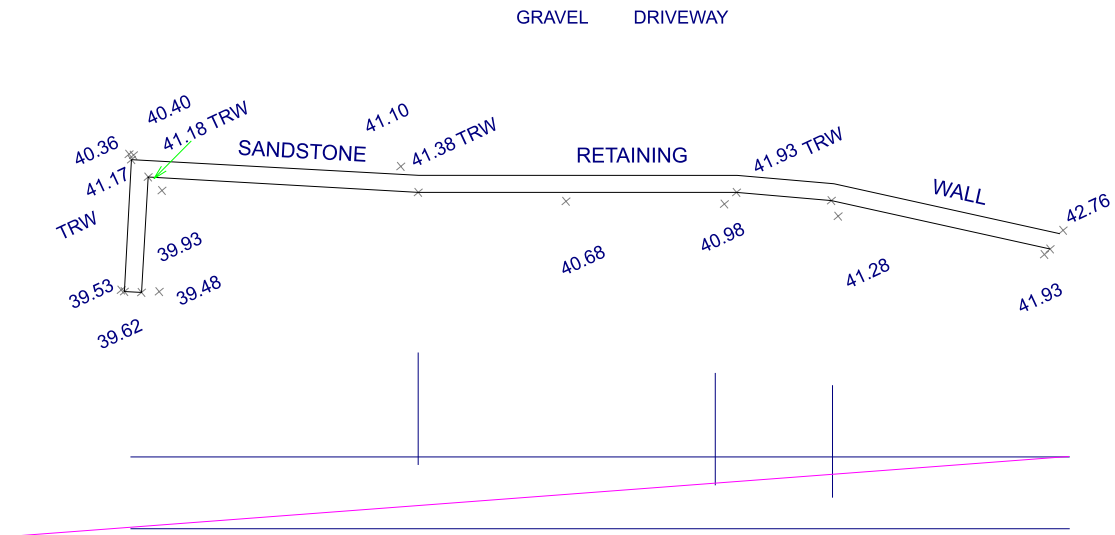

WALL B

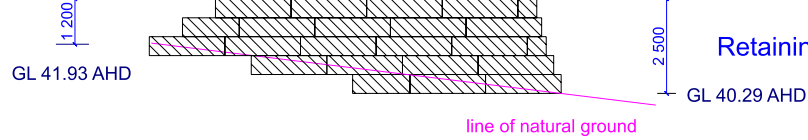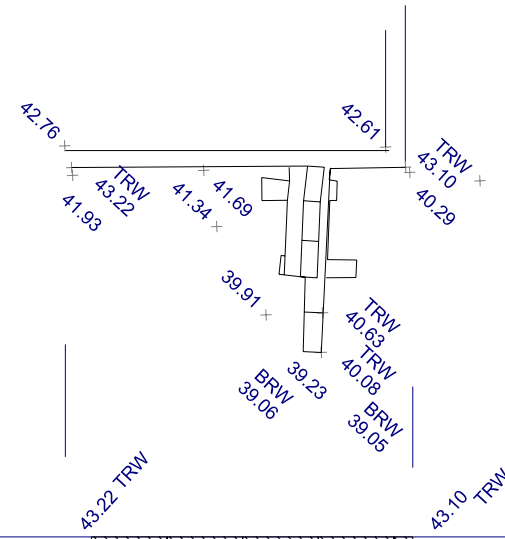

WALL C




Retaining Wall Max Height 2.5m

Retaining Walls
SCALE: 1:200



Sandstone Block

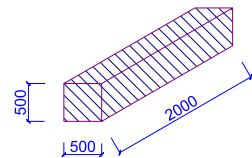

NOTE:

- ONLY SELECTED DETAIL RELATED TO THE AS-BUILT SANDSTONE WALLS HAVE BEEN LOCATED IN THIS SURVEY
- ORIGIN OF LEVELS: SSM63789 (RL 49.68) AHD

LEGEND

(A) DENOTES EASEMENT FOR ELECTRICITY TRANSMISSION LINES 5 WIDE (VIDE DP645080)

BRW - BOTTOM RETAINING WALL
RFP - ROUND FENCE POST
TRW - TOP RETAINING WALL



Zenith
Surveying
Services
LAND SURVEYORS
ABN: 97 085 028 379
45 Tuncurry Lane
Tuncurry NSW 2428
Ph: (02)6555 7024 Mob: 0410 596 896

DESCRIPTION
SKETCH SHOWING LOCATION & LEVELS OF AS-BUILT RETAINING WALLS AT No.52 PARADISE DRIVE, SMITHS LAKE BEING LOT 18 IN DP 806842

L.G.A. MID-COAST COUNCIL

RaP Drawing
Phone 0421808574 rapdrawing@gmail.com
abn 30 632 283 157


client
AS-Built Retaining Walls
Norm Lyons
52 Paradise Drive
Smiths Lake

Print Date: Thursday, 31 October 2024

NSW 2428 Lot 18 D.P. 806842

page: 4 / 5
A3

Dimensions are in millimetres * Figured dimensions to be taken in preference to scale * Levels and dimensions to be verified prior to construction *All work to comply to Council regulations.


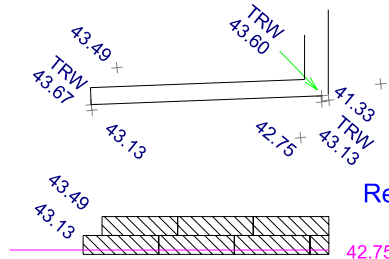


Retaining Wall Max Height 0.9m



line of natural ground

WALL D

Sandstone Block

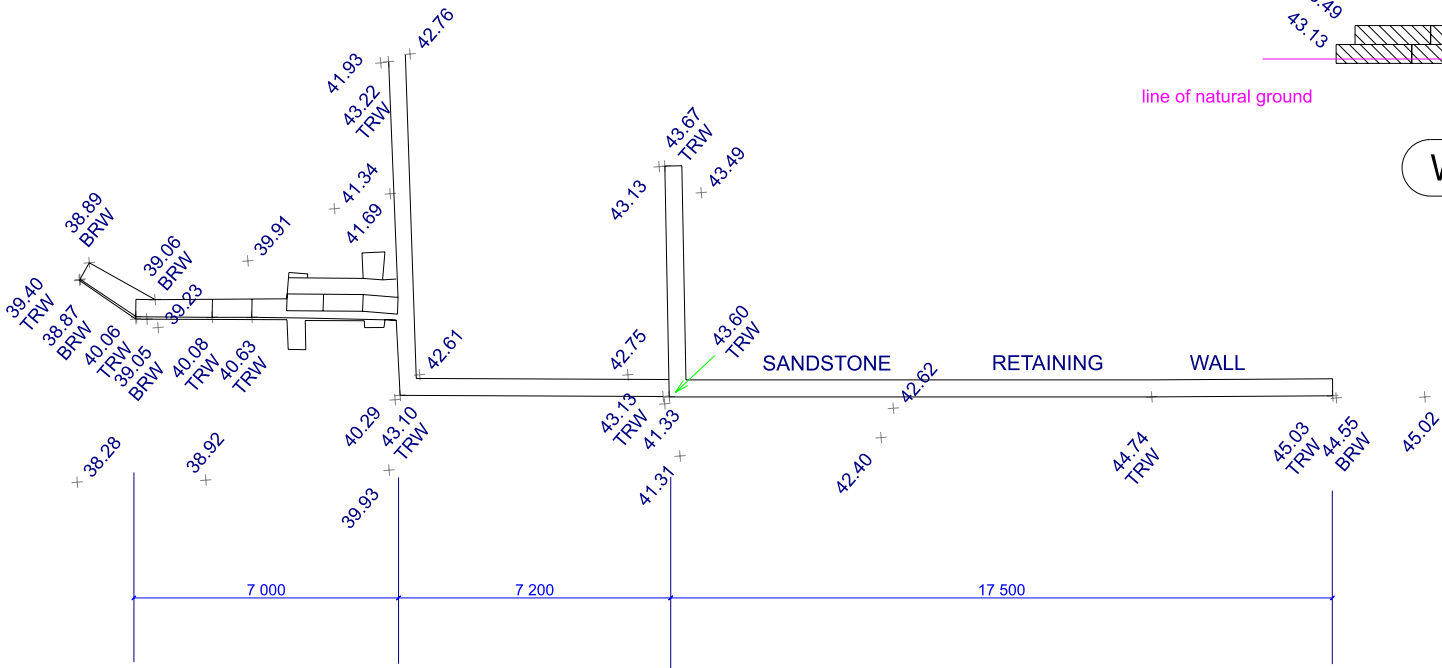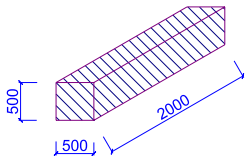

Retaining Wall Max Height 2.5m

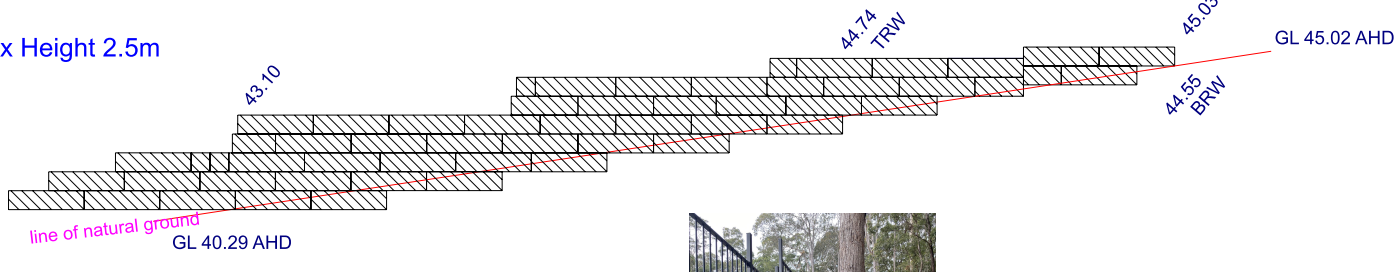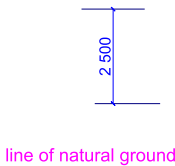

WALL E



Retaining Walls
SCALE: 1:200

- NOTE:
- ONLY SELECTED DETAIL RELATED TO THE AS-BUILT SANDSTONE WALLS HAVE BEEN LOCATED IN THIS SURVEY
 - ORIGIN OF LEVELS: SSM63789 (RL 49.68) AHD

(A) DENOTES EASEMENT FOR ELECTRICITY TRANSMISSION LINES 5 WIDE (VIDE DP645080)

LEGEND

BRW - BOTTOM RETAINING WALL
RFP - ROUND FENCE POST
TRW - TOP RETAINING WALL



Zenith
Surveying
Services
LAND SURVEYORS
ABN: 97 085 028 379
45 Tuncurry Lane
Tuncurry NSW 2428
Ph: (02)6555 7024 Mob: 0410 596 896

DESCRIPTION SKETCH SHOWING LOCATION & LEVELS OF AS-BUILT RETAINING WALLS AT No.52 PARADISE DRIVE, SMITHS LAKE BEING LOT 18 IN DP 806842

L.G.A. MID-COAST COUNCIL

RaP Drawing
Phone 0421808574 rapdrawing@gmail.com
abn 30 632 283 157

client
AS-Built Retaining Walls
Norm Lyons
52 Paradise Drive
Smiths Lake

Print Date: Thursday, 31 October 2024
NSW 2428 Lot 18 D.P. 806842
page: 5 / 5 A3

Dimensions are in millimetres * Figured dimensions to be taken in preference to scale * Levels and dimensions to be verified prior to construction *All work to comply to Council regulations.