

Car Parking

•	U		
	NO. OF UNITS	RATE	PROVIDED
Residential (Basement)	120	0.2	26
Visitor (Ground Level)	132	0.1	13

TYPOLOGY	NO. OF UNITS	MAX RATE	MIN	PROVI
1 Bedroom Apartment	13	1.0	13	13
2 Bedroom Apartment	18	1.2	22	22
3 Bedroom Apartment	37	1.5	56	63
3 Bedroom Terrace	62	2.0	124	124
4 Bedroom Apartment	1	1.5	2	2
3 Bedroom House	1	1.0	1	1
Subtotal	132	-	219	225
Accessible Spaces			13	13
Visitor	132	0.2	26	26
Accessible Spaces			1	1

Bicycle Parking


- 10 10 10 10 10 10 10 1	9			
	NO. OF UNITS	RATE	PROVIDED	
Residential (Basement)	132	0.2	26	
Visitor (Ground Level)	132	0.1	13	
TOTAL			39	

In accepting and utilising this document the recipient agrees that SJB Architecture (NSW) Pty. Ltd. ACN 081 094 724 T/A SJB Architects, retain all common law, statutory law and other rights including copyright and intellectual property rights. The recipient agrees not to use this document for any purpose other than its intended use; to waive all claims against SJB Architects resulting from unauthorised changes; or to reuse the document on other projects without the prior written consent of SJB Architects. Under no circumstances shall transfer of this document be deemed a sale. SJB Architects makes no warranties of fitness for any purpose. The Builder/Contractor shall verify job dimensions prior to any work commencing. Use figured dimensions only. Do not scale drawings.

Nominated Architects: Adam Haddow-7188 | John Pradel-7004

FOR APPROVAL

ev	Date	Revision	Ву	Chk
	21.07.2020	For Coordination	JS	WG
	28.07.2020	For Coordination	JS	WG
	11.08.2020	For Coordination	JS	WG
	27.08.2020	For DA	JS	WG
	17.03.2021	For DA - Additional Information	JS	WG
	28.07.2021	Post SOFAC	WG	WG
	22.08.2021	For review	WG	WG
	24.08.2021	Co-ordination	WG	WG
	26.08.2021	Co-ordination	WG	WG
	30.08.2021	L&EC Submission	BM	WG
	18.09.2021	L&EC Submission	BM	AH
	27.10.2021	L&EC Submission	WG	WG
	01.11.2023	Draft S4.55 Modification	DC	DC
	03.11.2023	S4.55 Modification	DC	JT
	13.12.2023	S4.55 Modification	DC	JT
	25.01.2024	S4.55 Modification	DC	JT
	07.02.2024	S4.55 Modification	DC	JT
	12.03.2024	S4.55 Modification	DC	JT
	02.07.2025	S4.55 Modification	DC	JT
	08.07.2025	S4.55 Modification	DC	JT
	02.08.2024	For Information	DC	JT
	30.10.2024	For Information	MF	DC
	06.11.2024	For Information	MF	DC
	11.11.2024	For Approval	MF	DC
	22.05.2025	For Approval	DC	JT

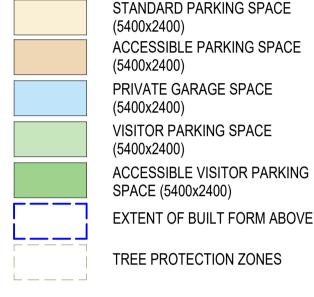

STANDARD PARKING SPACE (5400x2400) ACCESSIBLE PARKING SPACE (5400x2400) PRIVATE GARAGE SPACE (5400x2400) VISITOR PARKING SPACE (5400x2400)

251

EXTENT OF BUILT FORM ABOVE

TREE PROTECTION ZONES

NOTE: MINOR CHANGES TO FORM AND CONFIGURATION MAY BE REQUIRED WHEN DRAWINGS ARE SUBSEQUENTLY PREPARED FOR CONSTRUCTION PURPOSES AFTER THE GRANT OF DEVELOPMENT CONSENT

Client

Coronation Property

ASHBURY STAGE 2

149-163 MILTON STREET ASHBURY NSW 2193

Drawing Name

Overall Plan - Basement



Job No.	Drawing No.	Revision
	JT	
DC		
Drawn	Chk.	
22.05.2025	As indicated	@ A1
Date	Scale	Sheet Size

6839

SJB Architects Level 2 490 Crown Street Surry Hills NSW 2010 Australia T 61 2 9380 9911 F 61 2 9380 9922 www.sjb.com.au DA-0101 / 29





- 1. COMMUNAL GYM ADDED
- RESIDENTIAL BICYCLE PARKING RELOCATED 3. MAIL/PARCEL ROOM & ASSOCIATED OPENING
- REDUCTION / RELOCATION OF PERGOLA
- REDESIGN OF ROOF
- SECURITY FENCING AND GATES ADDED
- REMOVAL OF SKYLIGHT
- UPDATE TO LANDSCAPE DESIGN REMOVAL OF ARCHITECTURAL METALWORK

In accepting and utilising this document the recipient agrees that SJB Architecture (NSW) Pty. Ltd. ACN 081 094 724 T/A SJB Architects, retain all common law, statutory law and other rights including copyright and intellectual property rights. The recipient agrees not to use this document for any purpose other than its intended use; to waive all claims against SJB Architects resulting from unauthorised changes; or to reuse the document on other projects without the prior written consent of SJB Architects. Under no circumstances shall transfer of this document be deemed a sale. SJB Architects makes no warranties of fitness for any purpose. The Builder/Contractor shall verify job dimensions prior to any work commencing. Use figured dimensions only. Do not scale drawings.

Nominated Architects: Adam Haddow-7188 | John Pradel-7004

FOR APPROVAL

Rev	Date	Revision	Ву	Chk.
	27.08.2020	For DA	JS	WG
	22.08.2021	For review	WG	WG
0	23.08.2021	Co-ordination	WG	WG
1	24.08.2021	Co-ordination	WG	WG
2	26.08.2021	Co-ordination	WG	WG
3	30.08.2021	L&EC Submission	BM	WG
4	18.09.2021	L&EC Submission	BM	AH
5	27.10.2021	L&EC Submission	WG	WG
6	01.11.2023	Draft S4.55 Modification	DC	DC
7	03.11.2023	S4.55 Modification	DC	JT
8	04.12.2023	Draft S4.55 Modification	DC	JT
9	13.12.2023	S4.55 Modification	DC	JT
0	25.01.2024	S4.55 Modification	DC	JT
1	07.02.2024	S4.55 Modification	DC	JT
2	12.03.2024	S4.55 Modification	DC	JT
3	31.05.2024	For Information	DC	JT
4	26.06.2024	For Information	DC	JT
5	15.10.2024	For Information	MF	DC
6	30.10.2024	For Information	MF	DC
7	11.11.2024	For Approval	MF	DC
8	29.11.2024	For Approval	DC	JT
9	12.12.2024	For Coordination	DC	JT
0	18.12.2024	S4.55 Modification	MF	JT
1	07.01.2024	S4.55 Modification	DC	JT
2	22.05.2025	For Approval	DC	JT

NOTE: MINOR CHANGES TO FORM AND CONFIGURATION MAY BE REQUIRED WHEN DRAWINGS ARE SUBSEQUENTLY PREPARED FOR CONSTRUCTION PURPOSES AFTER THE GRANT OF DEVELOPMENT CONSENT

Coronation Property

ASHBURY STAGE 2

149-163 MILTON STREET **ASHBURY NSW 2193**

Drawing Name

Overall Plan - Ground Floor



Date	Scale	Sheet Size
22.05.2025	1:300	@ A1
Drawn	Chk.	
DC	JT	
Job No.	Drawing No.	Revision
6839	DA-0110	/ 32

SJB Architects Level 2 490 Crown Street Surry Hills NSW 2010 Australia T 61 2 9380 9911 F 61 2 9380 9922

www.sjb.com.au





1. COMMUNAL GYM ADDED

RESIDENTIAL BICYCLE PARKING RELOCATED 3. MAIL/PARCEL ROOM & ASSOCIATED OPENING

REDUCTION / RELOCATION OF PERGOLA

REDESIGN OF ROOF SECURITY FENCING AND GATES ADDED

REMOVAL OF SKYLIGHT

UPDATE TO LANDSCAPE DESIGN REMOVAL OF ARCHITECTURAL METALWORK In accepting and utilising this document the recipient agrees that SJB Architecture (NSW) Pty. Ltd. ACN 081 094 724 T/A SJB Architects, retain all common law, statutory law and other rights including copyright and intellectual property rights. The recipient agrees not to use this document for any purpose other than its intended use; to waive all claims against SJB Architects resulting from unauthorised changes; or to reuse the document on other projects without the prior written consent of SJB Architects. Under no circumstances shall transfer of this document be deemed a sale. SJB Architects makes no warranties of fitness for any purpose. The Builder/Contractor shall verify job dimensions prior to any work commencing. Use figured dimensions only. Do not scale drawings.

Nominated Architects: Adam Haddow-7188 | John Pradel-7004

FOR APPROVAL

Date	Revision	Ву	Chk.
05.05.2020	Preliminary - DA Set 20%	JS	WG
18.05.2020	Preliminary - DA Set 40%	JS	WG
29.06.2020	For Review	WG	WG
21.07.2020	For Coordination	JS	WG
28.07.2020	For Coordination	JS	WG
11.08.2020	For Coordination	JS	WG
27.08.2020	For DA	JS	WG
22.08.2021	For review	WG	WG
30.08.2021	L&EC Submission	BM	WG
18.09.2021	L&EC Submission	BM	AH
27.10.2021	L&EC Submission	WG	WG
01.11.2023	Draft S4.55 Modification	DC	DC
03.11.2023	S4.55 Modification	DC	JT
04.12.2023	Draft S4.55 Modification	DC	JT
13.12.2023	S4.55 Modification	DC	JT
25.01.2024	S4.55 Modification	DC	JT
07.02.2024	S4.55 Modification	DC	JT
12.03.2024	S4.55 Modification	DC	JT
30.10.2024	For Information	MF	DC
11.11.2024	For Approval	MF	DC
29.11.2024	For Approval	DC	JT
22.05.2025	For Approval	DC	JT

NOTE: MINOR CHANGES TO FORM AND CONFIGURATION MAY BE REQUIRED WHEN DRAWINGS ARE SUBSEQUENTLY PREPARED FOR CONSTRUCTION PURPOSES AFTER THE GRANT OF DEVELOPMENT CONSENT

Client

Coronation Property

ASHBURY STAGE 2

149-163 MILTON STREET ASHBURY NSW 2193

Drawing Name

Overall Plan - Level 1



Date	Scale	Sheet Size
22.05.2025	1:300	@ A1
Drawn	Chk.	
DC	JT	
Job No.	Drawing No.	Revision
6839	DA-0111	/ 22





- 1. COMMUNAL GYM ADDED
- RESIDENTIAL BICYCLE PARKING RELOCATED MAIL/PARCEL ROOM & ASSOCIATED OPENING
- REDUCTION / RELOCATION OF PERGOLA
- REDESIGN OF ROOF
- SECURITY FENCING AND GATES ADDED
- REMOVAL OF SKYLIGHT
- UPDATE TO LANDSCAPE DESIGN REMOVAL OF ARCHITECTURAL METALWORK

In accepting and utilising this document the recipient agrees that SJB Architecture (NSW) Pty. Ltd. ACN 081 094 724 T/A SJB Architects, retain all common law, statutory law and other rights including copyright and intellectual property rights. The recipient agrees not to use this document for any purpose other than its intended use; to waive all claims against SJB Architects resulting from unauthorised changes; or to reuse the document on other projects without the prior written consent of SJB Architects. Under no circumstances shall transfer of this document be deemed a sale. SJB Architects makes no warranties of fitness for any purpose. The Builder/Contractor shall verify job dimensions prior to any work commencing. Use figured dimensions only. Do not scale drawings.

Nominated Architects: Adam Haddow-7188 | John Pradel-7004

FOR APPROVAL

Date	Revision	Ву	Chk.
05.05.2020	Preliminary - DA Set 20%	JS	WG
18.05.2020	Preliminary - DA Set 40%	JS	WG
29.06.2020	For Review	WG	WG
21.07.2020	For Coordination	JS	WG
28.07.2020	For Coordination	JS	WG
11.08.2020	For Coordination	JS	WG
27.08.2020	For DA	JS	WG
22.08.2021	For review	WG	WG
30.08.2021	L&EC Submission	BM	WG
18.09.2021	L&EC Submission	BM	AH
27.10.2021	L&EC Submission	WG	WG
01.11.2023	Draft S4.55 Modification	DC	DC
03.11.2023	S4.55 Modification	DC	JT
04.12.2023	Draft S4.55 Modification	DC	JT
07.02.2024	S4.55 Modification	DC	JT
12.03.2024	S4.55 Modification	DC	JT
30.10.2024	For Information	MF	DC
11.11.2024	For Approval	MF	DC
29.11.2024	For Approval	DC	JT
22.05.2025	For Approval	DC	JT

NOTE: MINOR CHANGES TO FORM AND CONFIGURATION MAY BE REQUIRED WHEN DRAWINGS ARE SUBSEQUENTLY PREPARED FOR CONSTRUCTION PURPOSES AFTER THE GRANT OF DEVELOPMENT CONSENT

Client

Coronation Property

ASHBURY STAGE 2

149-163 MILTON STREET **ASHBURY NSW 2193**

Drawing Name

Overall Plan - Level 2



Date	Scale	Sheet Size
22.05.2025	1:300	@ A1
Drawn	Chk.	
DC	JT	
Job No.	Drawing No.	Revision
6839	DA-0112	/ 20

SJB Architects Level 2 490 Crown Street Surry Hills NSW 2010 Australia T 61 2 9380 9911 F 61 2 9380 9922

www.sjb.com.au





- 1. COMMUNAL GYM ADDED
- RESIDENTIAL BICYCLE PARKING RELOCATED 3. MAIL/PARCEL ROOM & ASSOCIATED OPENING
- REDUCTION / RELOCATION OF PERGOLA
- REDESIGN OF ROOF
- SECURITY FENCING AND GATES ADDED
- REMOVAL OF SKYLIGHT
- UPDATE TO LANDSCAPE DESIGN
- REMOVAL OF ARCHITECTURAL METALWORK 10. BOUNDARY FENCE UPDATE

In accepting and utilising this document the recipient agrees that SJB Architecture (NSW) Pty. Ltd. ACN 081 094 724 T/A SJB Architects, retain all common law, statutory law and other rights including copyright and intellectual property rights. The recipient agrees not to use this document for any purpose other than its intended use; to waive all claims against SJB Architects resulting from unauthorised changes; or to reuse the document on other projects without the prior written consent of SJB Architects. Under no circumstances shall transfer of this document be deemed a sale. SJB Architects makes no warranties of fitness for any purpose. The Builder/Contractor shall verify job dimensions prior to any work commencing. Use figured dimensions only. Do not scale drawings.

Nominated Architects: Adam Haddow-7188 | John Pradel-7004

FOR APPROVAL

Date	Revision	Ву	Chk
.05.2020	Preliminary - DA Set 20%	JS	WG
.05.2020	Preliminary - DA Set 40%	JS	WG
.06.2020	For Review	WG	WG
.07.2020	For Coordination	JS	WG
.07.2020	For Coordination	JS	WG
.08.2020	For Coordination	JS	WG
.08.2020	For DA	JS	WG
.08.2021	L&EC Submission	BM	WG
.09.2021	L&EC Submission	BM	AH
.11.2023	Draft S4.55 Modification	DC	DC
.11.2023	S4.55 Modification	DC	JT
12.2023	Draft S4.55 Modification	DC	JT
12.2023	S4.55 Modification	DC	JT
.02.2024	S4.55 Modification	DC	JT
.03.2024	S4.55 Modification	DC	JT
10.2024	For Information	MF	DC
11.2024	For Approval	MF	DC
11.2024	For Approval	DC	JT
.05.2025	For Approval	DC	JT

NOTE: MINOR CHANGES TO FORM AND CONFIGURATION MAY BE REQUIRED WHEN DRAWINGS ARE SUBSEQUENTLY PREPARED FOR CONSTRUCTION PURPOSES AFTER THE GRANT OF DEVELOPMENT CONSENT

Client

Coronation Property

ASHBURY STAGE 2

149-163 MILTON STREET **ASHBURY NSW 2193**

Drawing Name

Overall Plan - Level 3



Date	Scale	Sheet Size
22.05.2025	1 : 300	@ A1
Drawn	Chk.	
DC	JT	
Job No.	Drawing No.	Revision
6839	DA-0113	/ 19





- 1. COMMUNAL GYM ADDED
- RESIDENTIAL BICYCLE PARKING RELOCATED 3. MAIL/PARCEL ROOM & ASSOCIATED OPENING
- REDUCTION / RELOCATION OF PERGOLA
- REDESIGN OF ROOF
- SECURITY FENCING AND GATES ADDED
- REMOVAL OF SKYLIGHT
- UPDATE TO LANDSCAPE DESIGN REMOVAL OF ARCHITECTURAL METALWORK

In accepting and utilising this document the recipient agrees that SJB Architecture (NSW) Pty. Ltd. ACN 081 094 724 T/A SJB Architects, retain all common law, statutory law and other rights including copyright and intellectual property rights. The recipient agrees not to use this document for any purpose other than its intended use; to waive all claims against SJB Architects resulting from unauthorised changes; or to reuse the document on other projects without the prior written consent of SJB Architects. Under no circumstances shall transfer of this document be deemed a sale. SJB Architects makes no warranties of fitness for any purpose. The Builder/Contractor shall verify job dimensions prior to any work commencing. Use figured dimensions only. Do not scale drawings.

Nominated Architects: Adam Haddow-7188 | John Pradel-7004

FOR APPROVAL

Date	Revision	Ву	Chk.
05.05.2020	Preliminary - DA Set 20%	JS	WG
18.05.2020	Preliminary - DA Set 40%	JS	WG
29.06.2020	For Review	WG	WG
21.07.2020	For Coordination	JS	WG
28.07.2020	For Coordination	JS	WG
11.08.2020	For Coordination	JS	WG
27.08.2020	For DA	JS	WG
22.08.2021	For review	WG	WG
30.08.2021	L&EC Submission	BM	WG
18.09.2021	L&EC Submission	BM	AH
01.11.2023	Draft S4.55 Modification	DC	DC
03.11.2023	S4.55 Modification	DC	JT
04.12.2023	Draft S4.55 Modification	DC	JT
13.12.2023	S4.55 Modification	DC	JT
07.02.2024	S4.55 Modification	DC	JT
12.03.2024	S4.55 Modification	DC	JT
30.10.2024	For Information	MF	DC
11.11.2024	For Approval	MF	DC
18.11.2024	For Approval	MF	DC
29.11.2024	For Approval	DC	JT
22.05.2025	For Approval	DC	JT

MAY BE REQUIRED WHEN DRAWINGS ARE SUBSEQUENTLY PREPARED FOR CONSTRUCTION PURPOSES AFTER THE GRANT OF DEVELOPMENT CONSENT

NOTE: MINOR CHANGES TO FORM AND CONFIGURATION

Client

Coronation Property

ASHBURY STAGE 2

149-163 MILTON STREET **ASHBURY NSW 2193**

Drawing Name

Overall Plan - Level 4



Drawn Chk DC JT		Revision
Drawn Chk		
22.05.2025 1 :		
	300	@ A1
Date Sca	e	Sheet Size





- 1. COMMUNAL GYM ADDED
- RESIDENTIAL BICYCLE PARKING RELOCATED MAIL/PARCEL ROOM & ASSOCIATED OPENING
- REDUCTION / RELOCATION OF PERGOLA
- REDESIGN OF ROOF
- SECURITY FENCING AND GATES ADDED
- REMOVAL OF SKYLIGHT
- UPDATE TO LANDSCAPE DESIGN
- REMOVAL OF ARCHITECTURAL METALWORK 10. BOUNDARY FENCE UPDATE

In accepting and utilising this document the recipient agrees that SJB Architecture (NSW) Pty. Ltd. ACN 081 094 724 T/A SJB Architects, retain all common law, statutory law and other rights including copyright and intellectual property rights. The recipient agrees not to use this document for any purpose other than its intended use; to waive all claims against SJB Architects resulting from unauthorised changes; or to reuse the document on other projects without the prior written consent of SJB Architects. Under no circumstances shall transfer of this document be deemed a sale. SJB Architects makes no warranties of fitness for any purpose. The Builder/Contractor shall verify job dimensions prior to any work commencing. Use figured dimensions only. Do not scale drawings.

Nominated Architects: Adam Haddow-7188 | John Pradel-7004

FOR APPROVAL

Date	Revision	Ву	Chk.
5.05.2020	Preliminary - DA Set 20%	JS	WG
3.05.2020	Preliminary - DA Set 40%	JS	WG
9.06.2020	For Review	WG	WG
1.07.2020	For Coordination	JS	WG
3.07.2020	For Coordination	JS	WG
1.08.2020	For Coordination	JS	WG
7.08.2020	For DA	JS	WG
2.08.2021	For review	WG	WG
0.08.2021	L&EC Submission	BM	WG
3.09.2021	L&EC Submission	BM	AH
1.11.2023	Draft S4.55 Modification	DC	DC
3.11.2023	S4.55 Modification	DC	JT
4.12.2023	Draft S4.55 Modification	DC	JT
3.12.2023	S4.55 Modification	DC	JT
7.02.2024	S4.55 Modification	DC	JT
2.03.2024	S4.55 Modification	DC	JT
1.05.2024	For Information	DC	JT
6.06.2024	For Information	DC	JT
0.10.2024	For Information	MF	DC
6.11.2024	For Information	MF	DC
1.11.2024	For Approval	MF	DC
3.11.2024	For Approval	MF	DC
9.11.2024	For Approval	DC	JT
2.05.2025	For Approval	DC	JT

MAY BE REQUIRED WHEN DRAWINGS ARE SUBSEQUENTLY PREPARED FOR CONSTRUCTION PURPOSES AFTER THE GRANT OF DEVELOPMENT CONSENT

NOTE: MINOR CHANGES TO FORM AND CONFIGURATION

Client


Coronation Property

ASHBURY STAGE 2

149-163 MILTON STREET **ASHBURY NSW 2193**

Drawing Name

Overall Plan - Level 5

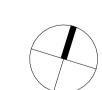

Date Scale 22.05.2025 1:300 Drawn Chk. DC JT Job No. Drawing No.	15	DA-0115 / 24
22.05.2025 1:300 Drawn Chk.		Drawing No. Revision
22.05.2025 1:300		JT
		Chk.
Date Scale		25 1 : 300 @ A1
		Scale Sheet Siz





- 1. COMMUNAL GYM ADDED
- RESIDENTIAL BICYCLE PARKING RELOCATED MAIL/PARCEL ROOM & ASSOCIATED OPENING
- REDUCTION / RELOCATION OF PERGOLA
- REDESIGN OF ROOF
- SECURITY FENCING AND GATES ADDED
- REMOVAL OF SKYLIGHT
- UPDATE TO LANDSCAPE DESIGN
- REMOVAL OF ARCHITECTURAL METALWORK 10. BOUNDARY FENCE UPDATE

In accepting and utilising this document the recipient agrees that SJB Architecture (NSW) Pty. Ltd. ACN 081 094 724 T/A SJB Architects, retain all common law, statutory law and other rights including copyright and intellectual property rights. The recipient agrees not to use this document for any purpose other than its intended use; to waive all claims against SJB Architects resulting from unauthorised changes; or to reuse the document on other projects without the prior written consent of SJB Architects. Under no circumstances shall transfer of this document be deemed a sale. SJB Architects makes no warranties of fitness for any purpose. The Builder/Contractor shall verify job dimensions prior to any work commencing. Use figured dimensions only. Do not scale drawings.

Nominated Architects: Adam Haddow-7188 | John Pradel-7004

FOR APPROVAL

Date	Revision	Ву	Chk
Date	Revision	Бу	Clik
.05.2020	Preliminary - DA Set 20%	JS	WG
.05.2020	Preliminary - DA Set 40%	JS	WG
.07.2020	For Coordination	JS	WG
.07.2020	For Coordination	JS	WG
.08.2020	For Coordination	JS	WG
.08.2020	For DA	JS	WG
.08.2021	For review	WG	WG
.08.2021	L&EC Submission	BM	WG
.09.2021	L&EC Submission	BM	AH
.11.2023	Draft S4.55 Modification	DC	DC
.11.2023	S4.55 Modification	DC	JT
.12.2023	Draft S4.55 Modification	DC	JT
.12.2023	S4.55 Modification	DC	JT
.02.2024	S4.55 Modification	DC	JT
.03.2024	S4.55 Modification	DC	JT
.10.2024	For Information	MF	DC
.11.2024	For Information	MF	DC
.11.2024	For Approval	MF	DC
.11.2024	For Approval	MF	DC
.11.2024	For Approval	DC	JT
.05.2025	For Approval	DC	JT

NOTE: MINOR CHANGES TO FORM AND CONFIGURATION MAY BE REQUIRED WHEN DRAWINGS ARE SUBSEQUENTLY PREPARED FOR CONSTRUCTION PURPOSES AFTER THE GRANT OF DEVELOPMENT CONSENT

Client


Coronation Property

ASHBURY STAGE 2

149-163 MILTON STREET **ASHBURY NSW 2193**

Drawing Name

Overall Plan - Roof

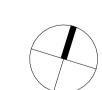

Date	Scale	Sheet Size
22.05.2025	1:300	@ A1
Drawn	Chk.	
DC	JT	
Job No.	Drawing No.	Revision
6839	DA-0116	/ 21






A1-Ground



A1-Level 2



A1-Level 1

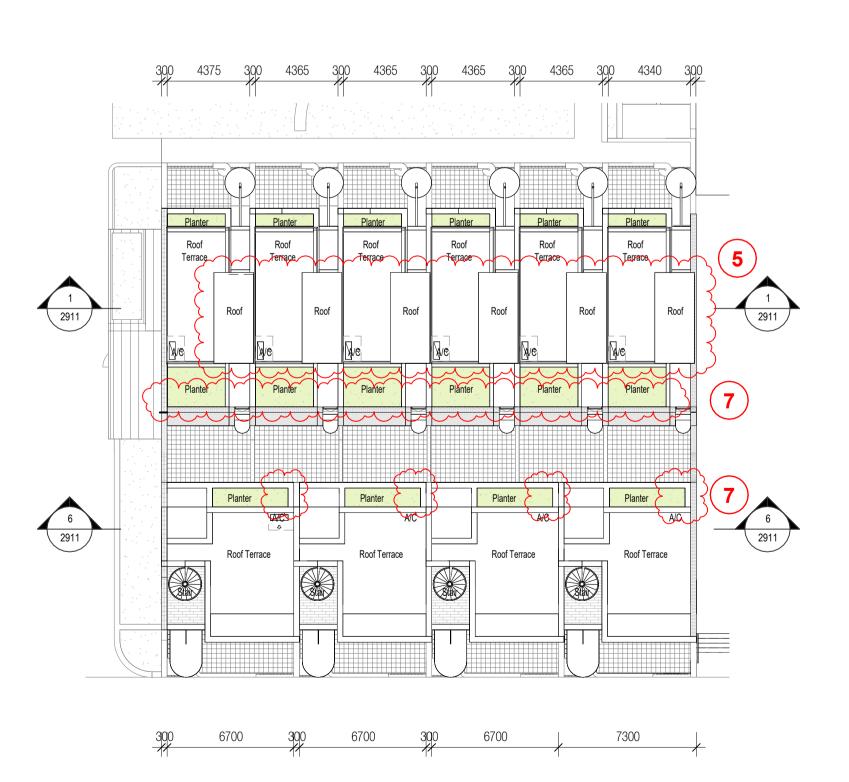

A1-Roof

- 1. COMMUNAL GYM ADDED
- RESIDENTIAL BICYCLE PARKING RELOCATED 3. MAIL/PARCEL ROOM & ASSOCIATED OPENING
- REDUCTION / RELOCATION OF PERGOLA
- REDESIGN OF ROOF
- SECURITY FENCING AND GATES ADDED
- REMOVAL OF SKYLIGHT
- REMOVAL OF ARCHITECTURAL METALWORK 10. BOUNDARY FENCE UPDATE
- UPDATE TO LANDSCAPE DESIGN

waive all claims against SJB Architects resulting from unauthorised changes; or to reuse the document on other projects without the prior written consent of SJB Architects. Under no circumstances shall transfer of this document be deemed a sale. SJB Architects makes no warranties of fitness for any purpose. The Builder/Contractor shall verify job dimensions prior to any work commencing. Use figured dimensions only. Do not scale drawings. Nominated Architects: Adam Haddow-7188 | John Pradel-7004

FOR INFORMATION

In accepting and utilising this document the recipient agrees that SJB Architecture (NSW) Pty. Ltd. ACN 081 094 724 T/A SJB Architects, retain all common law, statutory law and other rights including copyright and intellectual property rights. The recipient agrees not to use this document for any purpose other than its intended use; to

ev	Date	Revision	Ву	Chk.
	05.05.2020	Preliminary - DA Set 20%	JS	WG
	18.05.2020	Preliminary - DA Set 40%	JS	WG
	21.07.2020	For Coordination	JS	WG
	28.07.2020	For Coordination	JS	WG
	11.08.2020	For Coordination	JS	WG
	27.08.2020	For DA	JS	WG
	15.07.2021	Issued for Section34	WG	WG
	30.08.2021	L&EC Submission	BM	WG
	27.10.2021	L&EC Submission	WG	WG
)	04.12.2023	Draft S4.55 Modification	DC	JT
	22.05.2025	For Approval	DC	JT

NOTE: MINOR CHANGES TO FORM AND CONFIGURATION MAY BE REQUIRED WHEN DRAWINGS ARE SUBSEQUENTLY PREPARED FOR CONSTRUCTION PURPOSES AFTER THE GRANT OF DEVELOPMENT CONSENT

Planning & Heritage Urbis

Landscape Architect

Arcadia Landscape Architecture

Building Certificates Australia

Services, Hydraulic & BASIX Integrated Group Services

Civil & Geotech

El Australia

Ason Group

Waste Management

Elephant's Foot Waste Compactors

Naturally Trees

Access Consultant

Jensen Hughes

Client

Coronation Property

ASHBURY STAGE 2

149-163 MILTON STREET **ASHBURY NSW 2193**

Drawing Name

Building A



@ A1

Materials Legend

BWK

Aluminium Framed Window Aluminium Fin

Face Brickwork (1) Stretcher Course (2) Soldier Course

(3) Stack Course Metal Balustrade MB MSR Metal Sheet Roof

RC Concrete Structure SIL Concrete Sill + Handrail TFW Timber Framed Window/Door Timber Palisade Fence/Gate

DC JT Drawing No. DA-0201 / 11

22.05.2025 As indicated

Chk.

SJB Architects Level 2 490 Crown Street Surry Hills NSW 2010 Australia T 61 2 9380 9911



RESIDENTIAL BICYCLE PARKING RELOCATED MAIL/PARCEL ROOM & ASSOCIATED OPENING

REDUCTION / RELOCATION OF PERGOLA REDESIGN OF ROOF

SECURITY FENCING AND GATES ADDED

REMOVAL OF SKYLIGHT

10. BOUNDARY FENCE UPDATE

UPDATE TO LANDSCAPE DESIGN REMOVAL OF ARCHITECTURAL METALWORK In accepting and utilising this document the recipient agrees that SJB Architecture (NSW) Pty. Ltd. ACN 081 094 724 T/A SJB Architects, retain all common law, statutory law and other rights including copyright and intellectual property rights. The recipient agrees not to use this document for any purpose other than its intended use; to waive all claims against SJB Architects resulting from unauthorised changes; or to reuse the document on other projects without the prior written consent of SJB Architects. Under no circumstances shall transfer of this document be deemed a sale. SJB Architects makes no warranties of fitness for any purpose. The Builder/Contractor shall verify job dimensions prior to any work commencing. Use figured dimensions only. Do not scale drawings.

Nominated Architects: Adam Haddow-7188 | John Pradel-7004

FOR INFORMATION

Rev	Date	Revision	Ву	Chk
1	05.05.2020	Preliminary - DA Set 20%	JS	WG
2	18.05.2020	Preliminary - DA Set 40%	JS	WG
3	21.07.2020	For Coordination	JS	WG
4	28.07.2020	For Coordination	JS	WG
5	11.08.2020	For Coordination	JS	WG
6	27.08.2020	For DA	JS	WG
7	17.03.2021	For DA - Additional Information	JS	WG
8	24.08.2021	Co-ordination	WG	WG
9	30.08.2021	L&EC Submission	BM	WG
10	27.10.2021	L&EC Submission	WG	WG
11	04.12.2023	Draft S4.55 Modification	DC	JT
12	13.12.2023	S4.55 Modification	DC	JT
13	07.02.2024	S4.55 Modification	DC	JT
14	22.05.2025	For Approval	DC	JT





B-Level 1

B-Ground

Coronation Property

Client

ASHBURY STAGE 2

Naturally Trees

Access Consultant Jensen Hughes

149-163 MILTON STREET ASHBURY NSW 2193

Drawing Name

Building B - Sheet 1



@ A1

Materials l	_egend	Date	Scale
AFW	Aluminium Framed Window	22.05.2025	As indicated
AFN BWK	Aluminium Fin Face Brickwork	Drawn	Chk.
DVVIX	(1) Stretcher Course	DC	JT
	(2) Soldier Course (3) Stack Course	Job No.	Drawing No.
MB	Metal Balustrade	6839	DA-0211

Metal Sheet Roof

Concrete Structure

Timber Framed Window/Door

Timber Palisade Fence/Gate

MSR

RC

SIL

TFW

Concrete Sill + Handrail



Mechanical Services Area for solar panels as per BASIX requirements **(4)** \$\begin{align*}
\phi & \quad \ \$ N \$ \$ N \$ RC ф RL 57.850 Communal open space below ф. RL 54.600 RL 59.350 AFN Landscape RC Area for solar panels as per BASIX requirements RL 54.600 RC RC -**★**- RL 57.850

22300

Terrace below

RL 52.210

B-Roof

Retain and protect

existing trees in

accordance with

Tree Management

Plan. TPZ dashed blue

S4.55 AMENDMENT SCHEDULE

- 1. COMMUNAL GYM ADDED
- RESIDENTIAL BICYCLE PARKING RELOCATED MAIL/PARCEL ROOM & ASSOCIATED OPENING
- REDUCTION / RELOCATION OF PERGOLA
- REDESIGN OF ROOF
- SECURITY FENCING AND GATES ADDED
- REMOVAL OF SKYLIGHT
- UPDATE TO LANDSCAPE DESIGN
- REMOVAL OF ARCHITECTURAL METALWORK 10. BOUNDARY FENCE UPDATE

In accepting and utilising this document the recipient agrees that SJB Architecture (NSW) Pty. Ltd. ACN 081 094 724 T/A SJB Architects, retain all common law, statutory law and other rights including copyright and intellectual property rights. The recipient agrees not to use this document for any purpose other than its intended use; to waive all claims against SJB Architects resulting from unauthorised changes; or to reuse the document on other projects without the prior written consent of SJB Architects. Under no circumstances shall transfer of this document be deemed a sale. SJB Architects makes no warranties of fitness for any purpose. The Builder/Contractor shall verify job dimensions prior to any work commencing. Use figured dimensions only. Do not scale drawings.

Nominated Architects: Adam Haddow-7188 | John Pradel-7004

FOR INFORMATION

Rev	Date	Revision	Ву	Chk.
1	05.05.2020	Preliminary - DA Set 20%	JS	WG
2	18.05.2020	Preliminary - DA Set 40%	JS	WG
3	21.07.2020	For Coordination	JS	WG
4	28.07.2020	For Coordination	JS	WG
5	11.08.2020	For Coordination	JS	WG
6	27.08.2020	For DA	JS	WG
7	17.03.2021	For DA - Additional Information	JS	WG
8	30.08.2021	L&EC Submission	BM	WG
9	04.12.2023	Draft S4.55 Modification	DC	JT
10	13.12.2023	S4.55 Modification	DC	JT
11	07.02.2024	S4.55 Modification	DC	JT
12	12.03.2024	S4.55 Modification	DC	JT
13	26.06.2024	For Information	DC	JT
14	18.11.2024	For Approval	MF	DC
15	29.11.2024	For Approval	DC	JT
16	22.05.2025	For Approval	DC	JT

NOTE: MINOR CHANGES TO FORM AND CONFIGURATION MAY BE REQUIRED WHEN DRAWINGS ARE SUBSEQUENTLY PREPARED FOR CONSTRUCTION PURPOSES AFTER THE GRANT OF DEVELOPMENT CONSENT

Planning & Heritage Urbis

Landscape Architect

Arcadia Landscape Architecture

Building Certificates Australia

Services, Hydraulic & BASIX

Integrated Group Services

Civil & Geotech El Australia

Ason Group

Waste Management

Elephant's Foot Waste Compactors

Naturally Trees

Access Consultant Jensen Hughes

Client

Coronation Property

ASHBURY STAGE 2

149-163 MILTON STREET **ASHBURY NSW 2193**

Drawing Name

Building B - Sheet 2



Materials Legend

BWK

SIL

TPF

Aluminium Framed Window AFN Aluminium Fin

Face Brickwork (1) Stretcher Course (2) Soldier Course

(3) Stack Course Metal Balustrade MB MSR Metal Sheet Roof RC Concrete Structure

Concrete Sill + Handrail TFW Timber Framed Window/Door Timber Palisade Fence/Gate


22.05.2025 As indicated @ A1 Chk. DC JT Drawing No. 6839 DA-0212 / 16


SJB Architects Level 2 490 Crown Street Surry Hills NSW 2010 Australia T 61 2 9380 9911 F 61 2 9380 9922

www.sjb.com.au





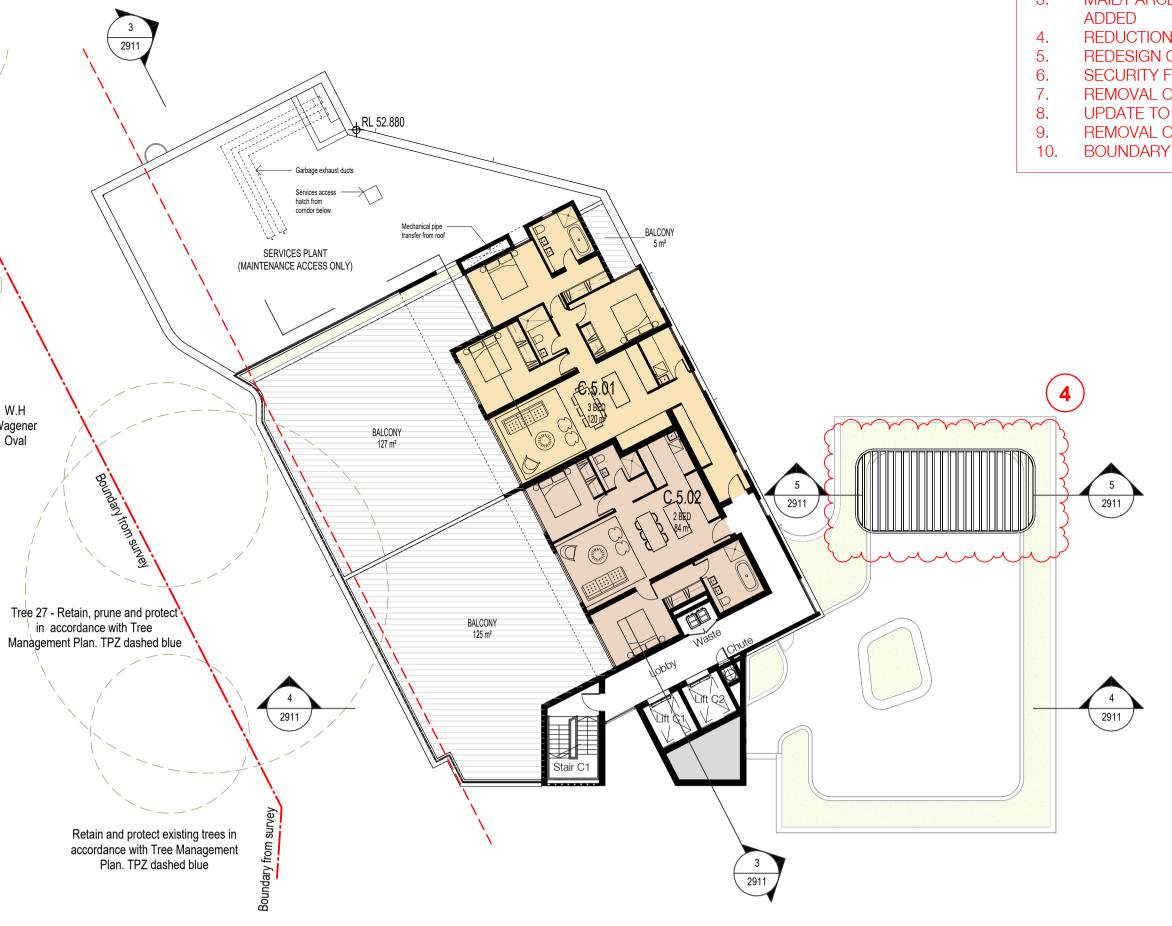

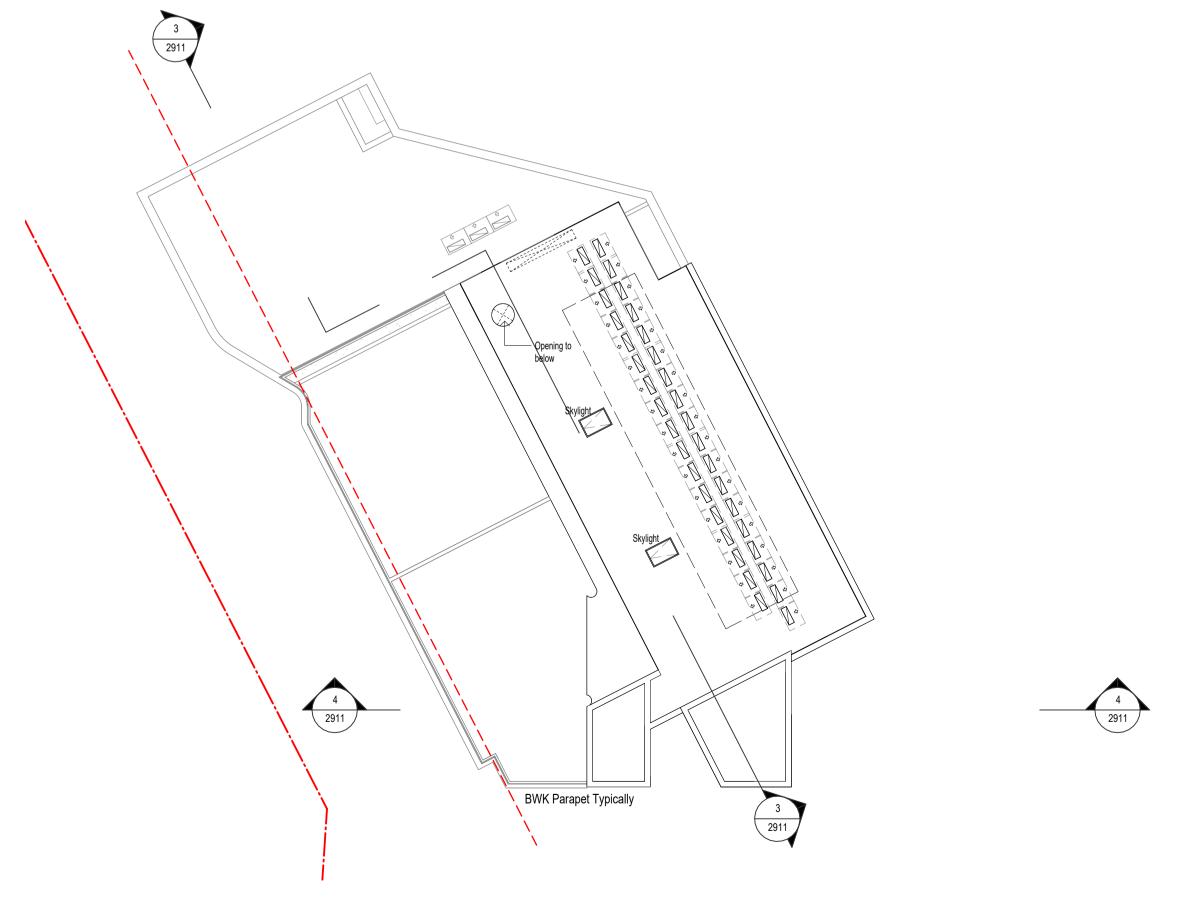

C-Roof

S4.55 AMENDMENT SCHEDULE

- 1. COMMUNAL GYM ADDED
- RESIDENTIAL BICYCLE PARKING RELOCATED MAIL/PARCEL ROOM & ASSOCIATED OPENING
- REDUCTION / RELOCATION OF PERGOLA
- REDESIGN OF ROOF
- SECURITY FENCING AND GATES ADDED
- REMOVAL OF SKYLIGHT
- UPDATE TO LANDSCAPE DESIGN
- REMOVAL OF ARCHITECTURAL METALWORK 10. BOUNDARY FENCE UPDATE

Nominated Architects: Adam Haddow-7188 | John Pradel-7004

In accepting and utilising this document the recipient agrees that SJB Architecture (NSW) Pty. Ltd. ACN 081 094 724 T/A SJB Architects, retain all common law, statutory law and other rights including copyright and intellectual property rights. The recipient agrees not to use this document for any purpose other than its intended use; to waive all claims against SJB Architects resulting from unauthorised changes; or to reuse the document on other projects without the prior written consent of SJB Architects. Under no circumstances shall transfer of this document be deemed a sale. SJB Architects makes no warranties of fitness for any purpose. The Builder/Contractor shall verify job dimensions prior to any work commencing. Use figured dimensions only. Do not scale drawings.

FOR INFORMATION

Date	Revision	Ву	Chk.
05.05.2020	Preliminary - DA Set 20%	JS	WG
18.05.2020	Preliminary - DA Set 40%	JS	WG
21.07.2020	For Coordination	JS	WG
28.07.2020	For Coordination	JS	WG
11.08.2020	For Coordination	JS	WG
27.08.2020	For DA	JS	WG
17.03.2021	For DA - Additional Information	JS	WG
15.07.2021	Issued for Section34	WG	WG
23.08.2021	Co-ordination	WG	WG
30.08.2021	L&EC Submission	BM	WG
04.12.2023	Draft S4.55 Modification	DC	JT
13.12.2023	S4.55 Modification	DC	JT
07.02.2024	S4.55 Modification	DC	JT
12.03.2024	S4.55 Modification	DC	JT
31.05.2024	For Information	DC	JT
26.06.2024	For Information	DC	JT
31.07.2024	For Information	DC	JT
26.09.2024	For Information	DC	JT
30.10.2024	For Information	MF	DC
06.11.2024	For Information	MF	DC
11.11.2024	For Approval	MF	DC
18.11.2024	For Approval	MF	DC
29.11.2024	For Approval	DC	JT
22.05.2025	For Approval	DC	JT

NOTE: MINOR CHANGES TO FORM AND CONFIGURATION MAY BE REQUIRED WHEN DRAWINGS ARE SUBSEQUENTLY PREPARED FOR CONSTRUCTION PURPOSES AFTER THE GRANT OF DEVELOPMENT CONSENT

Planning & Heritage Urbis

Landscape Architect

Building Certificates Australia

Arcadia Landscape Architecture

Services, Hydraulic & BASIX

Integrated Group Services

Civil & Geotech El Australia

Ason Group

Waste Management

Elephant's Foot Waste Compactors

Naturally Trees

Access Consultant

Jensen Hughes

Client

Coronation Property

ASHBURY STAGE 2

149-163 MILTON STREET ASHBURY NSW 2193

Drawing Name

Building C - Sheet 2



Materials Legend

AFW Aluminium Framed Window AFN Aluminium Fin BWK

Face Brickwork (1) Stretcher Course (2) Soldier Course

(3) Stack Course

Metal Balustrade MB MSR Metal Sheet Roof Concrete Structure RC SIL

Concrete Sill + Handrail TFW Timber Framed Window/Door Timber Palisade Fence/Gate

22.05.2025 As indicated @ A1 DC JT Drawing No. DA-0222 / 24

SJB Architects Level 2 490 Crown Street Surry Hills NSW

2010 Australia T 61 2 9380 9911 F 61 2 9380 9922 www.sjb.com.au





NOTE: Refer to Drawing 1404-Apartment Plans for additional apartment information including rooms sizes

D-Roof

S4.55 AMENDMENT SCHEDULE

1. COMMUNAL GYM ADDED 2. RESIDENTIAL BICYCLE PARKING RELOCATED 3. MAIL/PARCEL ROOM & ASSOCIATED OPENING

ADDED 4. REDUCTION / RELOCATION OF PERGOLA

REDESIGN OF ROOF

SECURITY FENCING AND GATES ADDED

REMOVAL OF SKYLIGHT

8. UPDATE TO LANDSCAPE DESIGN 9. REMOVAL OF ARCHITECTURAL METALWORK

10. BOUNDARY FENCE UPDATE

TFW

Materials Legend

Aluminium Framed Window AFN Aluminium Fin BWK Face Brickwork

(1) Stretcher Course (2) Soldier Course

(3) Stack Course Metal Balustrade MB MSR Metal Sheet Roof RC Concrete Structure SIL

Concrete Sill + Handrail Timber Framed Window/Door Timber Palisade Fence/Gate

SJB Architects 490 Crown Street Surry Hills NSW 2010 Australia T 61 2 9380 9911

In accepting and utilising this document the recipient agrees that SJB Architecture (NSW) Pty. Ltd. ACN 081 094 724 T/A SJB Architects, retain all common law, statutory law and other rights including copyright and intellectual property rights. The recipient agrees not to use this document for any purpose other than its intended use; to waive all claims against SJB Architects resulting from unauthorised changes; or to reuse the document on other projects without the prior written consent of SJB Architects. Under no circumstances shall transfer of this document be deemed a sale. SJB Architects makes no warranties of fitness for any purpose. The Builder/Contractor shall verify job dimensions prior to any work commencing. Use figured dimensions only. Do not scale drawings.

Nominated Architects: Adam Haddow-7188 | John Pradel-7004

FOR INFORMATION

By Chk. 1 05.05.2020 Preliminary - DA Set 20% JS WG JS WG JS WG 18.05.2020 Preliminary - DA Set 40% 3 21.07.2020 For Coordination 4 28.07.2020 For Coordination JS WG
JS WG
BM WG
BM AH
DC JT
DC JT 5 11.08.2020 For Coordination 6 27.08.2020 For DA 30.08.2021 L&EC Submission 8 18.09.2021 L&EC Submission 9 04.12.2023 Draft S4.55 Modification 10 22.05.2025 For Approval

NOTE: MINOR CHANGES TO FORM AND CONFIGURATION MAY BE REQUIRED WHEN DRAWINGS ARE SUBSEQUENTLY PREPARED FOR CONSTRUCTION PURPOSES AFTER THE GRANT OF DEVELOPMENT CONSENT

Coronation Property

Project

Client

ASHBURY STAGE 2


149-163 MILTON STREET **ASHBURY NSW 2193**

Drawing Name


Level 2

F 61 2 9380 9922 www.sjb.com.au

Building D - Sheet 3

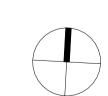

Date	Scale	Sheet Size
22.05.2025	As indicated	@ A1
Drawn	Chk.	
DC	JT	
Job No.	Drawing No.	Revision
6839	DA-0233	/ 10

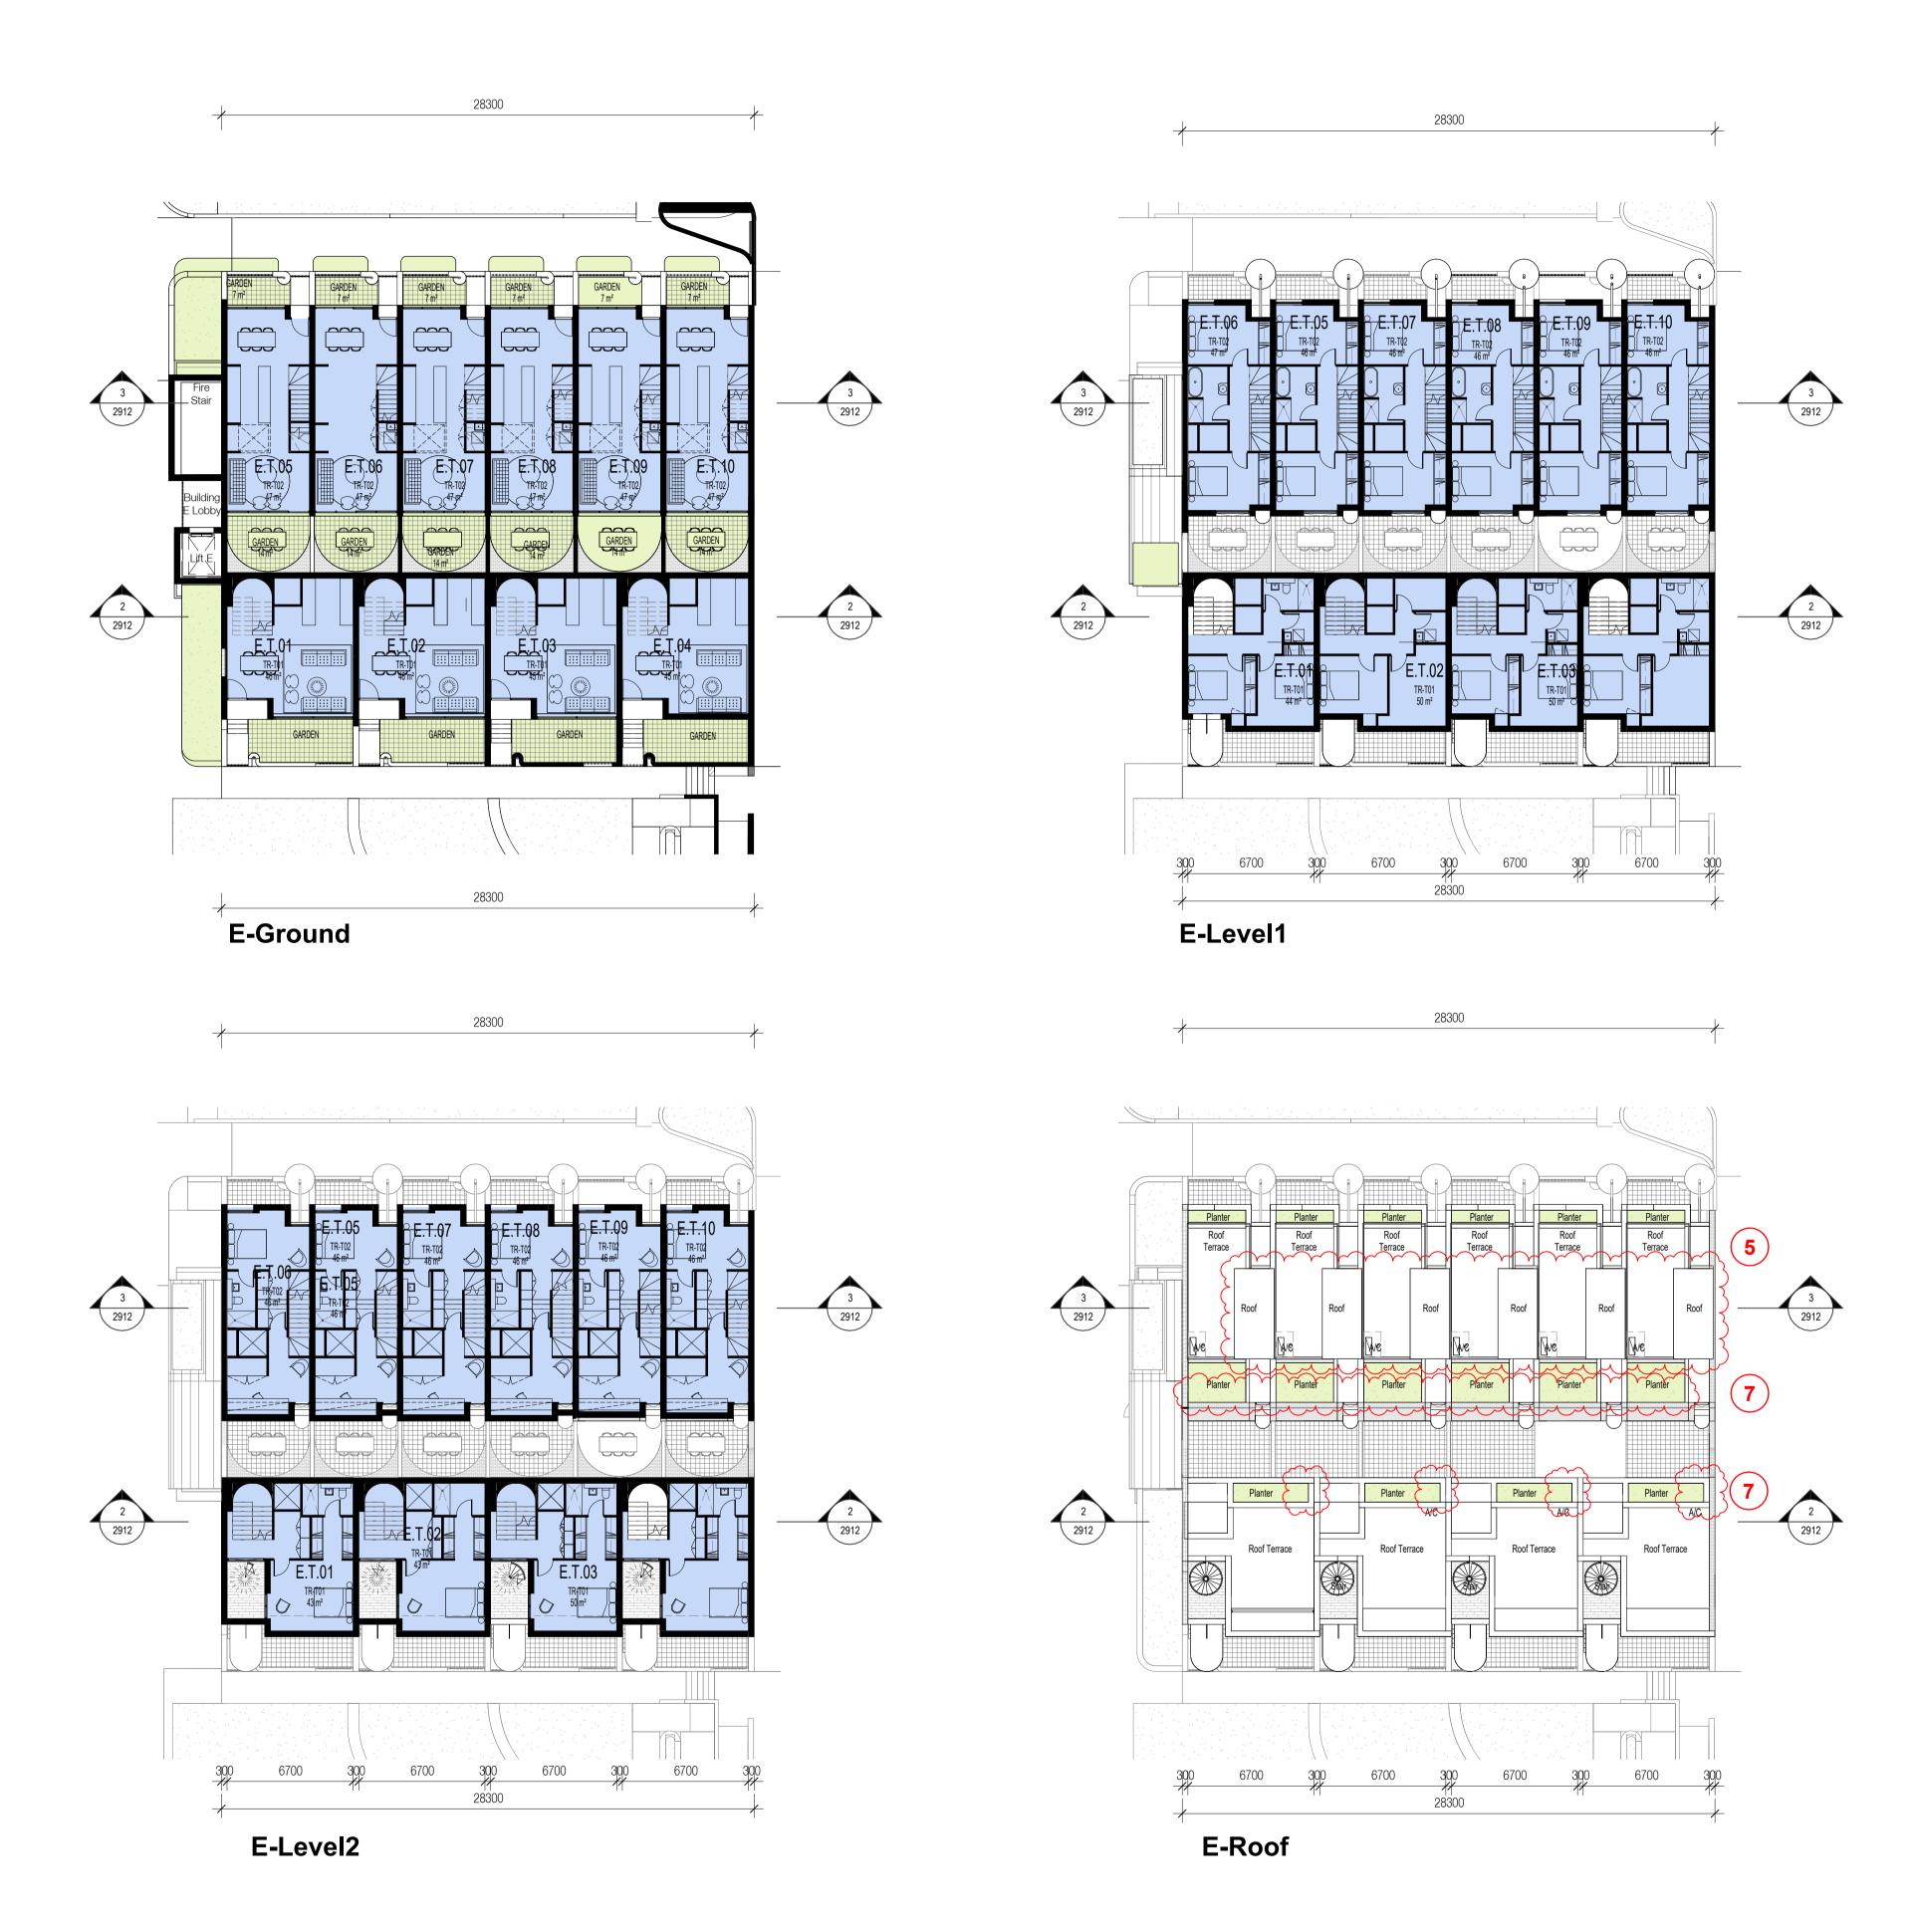

1. COMMUNAL GYM ADDED

RESIDENTIAL BICYCLE PARKING RELOCATED MAIL/PARCEL ROOM & ASSOCIATED OPENING

REDUCTION / RELOCATION OF PERGOLA

REDESIGN OF ROOF

SECURITY FENCING AND GATES ADDED

REMOVAL OF SKYLIGHT

UPDATE TO LANDSCAPE DESIGN REMOVAL OF ARCHITECTURAL METALWORK

10. BOUNDARY FENCE UPDATE

In accepting and utilising this document the recipient agrees that SJB Architecture (NSW) Pty. Ltd. ACN 081 094 724 T/A SJB Architects, retain all common law, statutory law and other rights including copyright and intellectual property rights. The recipient agrees not to use this document for any purpose other than its intended use; to waive all claims against SJB Architects resulting from unauthorised changes; or to reuse the document on other projects without the prior written consent of SJB Architects. Under no circumstances shall transfer of this document be deemed a sale. SJB Architects makes no warranties of fitness for any purpose. The Builder/Contractor shall verify job dimensions prior to any work commencing. Use figured dimensions only. Do not scale drawings.

Nominated Architects: Adam Haddow-7188 | John Pradel-7004

FOR INFORMATION

Date	Revision	Ву	Chk.
05.05.2020	Preliminary - DA Set 20%	JS	WG
18.05.2020	Preliminary - DA Set 40%	JS	WG
21.07.2020	For Coordination	JS	WG
28.07.2020	For Coordination	JS	WG
11.08.2020	For Coordination	JS	WG
27.08.2020	For DA	JS	WG
15.07.2021	Issued for Section34	WG	WG
30.08.2021	L&EC Submission	BM	WG
27.10.2021	L&EC Submission	WG	WG
29.11.2024	For Approval	DC	JT
22.05.2025	For Approval	DC	JT

NOTE: MINOR CHANGES TO FORM AND CONFIGURATION MAY BE REQUIRED WHEN DRAWINGS ARE SUBSEQUENTLY PREPARED FOR CONSTRUCTION PURPOSES AFTER THE GRANT OF DEVELOPMENT CONSENT

Planning & Heritage Urbis

Landscape Architect

Arcadia Landscape Architecture

Building Certificates Australia

Services, Hydraulic & BASIX Integrated Group Services

Civil & Geotech

El Australia

Ason Group

Waste Management Elephant's Foot Waste Compactors

Naturally Trees

Access Consultant Jensen Hughes

Client


Coronation Property

ASHBURY STAGE 2

149-163 MILTON STREET **ASHBURY NSW 2193**

Drawing Name

Building E

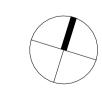

Materials Legend

TFW

TPF

Aluminium Framed Window

Aluminium Fin BWK

Face Brickwork (1) Stretcher Cours (2) Soldier Course

Timber Framed Window/Door

Timber Palisade Fence/Gate

(3) Stack Course

Metal Balustrade MB MSR Metal Sheet Roof RC Concrete Structure SIL Concrete Sill + Har

se	DC
	Job N
	68
е	
ındrail	

22.05.2025 As indicated @ A1 JT Drawing No. DA-0241 / 11





- 1. COMMUNAL GYM ADDED
- RESIDENTIAL BICYCLE PARKING RELOCATED MAIL/PARCEL ROOM & ASSOCIATED OPENING
- REDUCTION / RELOCATION OF PERGOLA
- REDESIGN OF ROOF
- SECURITY FENCING AND GATES ADDED
- REMOVAL OF SKYLIGHT
- UPDATE TO LANDSCAPE DESIGN
- REMOVAL OF ARCHITECTURAL METALWORK 10. BOUNDARY FENCE UPDATE

In accepting and utilising this document the recipient agrees that SJB Architecture (NSW) Pty. Ltd. ACN 081 094 724 T/A SJB Architects, retain all common law, statutory law and other rights including copyright and intellectual property rights. The recipient agrees not to use this document for any purpose other than its intended use; to waive all claims against SJB Architects resulting from unauthorised changes; or to reuse the document on other projects without the prior written consent of SJB Architects. Under no circumstances shall transfer of this document be deemed a sale. SJB Architects makes no warranties of fitness for any purpose. The Builder/Contractor shall verify job dimensions prior to any work commencing. Use figured dimensions only. Do not scale drawings.

Nominated Architects: Adam Haddow-7188 | John Pradel-7004

FOR INFORMATION

Date	Revision	Ву	
7.08.2020	For DA	JS	٧
0.08.2021	L&EC Submission	BM	٧
4.12.2023	Draft S4.55 Modification	DC	J
3.12.2023	S4.55 Modification	DC	J
2.03.2024	S4.55 Modification	DC	J
8.11.2024	For Approval	MF	
2.05.2025	For Approval	DC	J

NOTE: MINOR CHANGES TO FORM AND CONFIGURATION MAY BE REQUIRED WHEN DRAWINGS ARE SUBSEQUENTLY PREPARED FOR CONSTRUCTION PURPOSES AFTER THE GRANT OF DEVELOPMENT CONSENT

Planning & Heritage Urbis

Landscape Architect

Arcadia Landscape Architecture

Building Certificates Australia

Services, Hydraulic & BASIX

Integrated Group Services

Civil & Geotech

El Australia

Ason Group

Waste Management

Elephant's Foot Waste Compactors

Naturally Trees

Access Consultant

Jensen Hughes

Client

Coronation Property

ASHBURY STAGE 2

149-163 MILTON STREET **ASHBURY NSW 2193**

Drawing Name

Building F - Sheet 2



@ A1

Materials Legend

SIL

Aluminium Framed Window Aluminium Fin BWK Face Brickwork

(1) Stretcher Course (2) Soldier Course

(3) Stack Course Metal Balustrade MB MSR Metal Sheet Roof RC


Concrete Structure Concrete Sill + Handrail TFW Timber Framed Window/Door Timber Palisade Fence/Gate TPF

Chk. DC JT Drawing No. DA-0252 / 7

22.05.2025 As indicated



- 1. COMMUNAL GYM ADDED
- RESIDENTIAL BICYCLE PARKING RELOCATED 3. MAIL/PARCEL ROOM & ASSOCIATED OPENING
- REDUCTION / RELOCATION OF PERGOLA
- REDESIGN OF ROOF
- SECURITY FENCING AND GATES ADDED
- REMOVAL OF SKYLIGHT UPDATE TO LANDSCAPE DESIGN

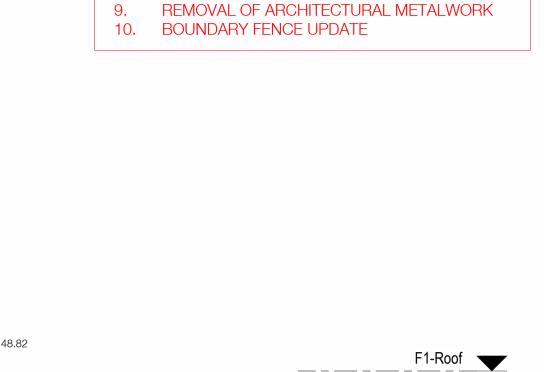

47350

F1-Level 1

44150

F1-Ground

40900

In accepting and utilising this document the recipient agrees that SJB Architecture (NSW) Pty. Ltd. ACN 081 094 724 T/A SJB Architects, retain all common law, statutory law and other rights including copyright and intellectual property rights. The recipient agrees not to use this document for any purpose other than its intended use; to waive all claims against SJB Architects resulting from unauthorised changes; or to reuse the document on other projects without the prior written consent of SJB Architects. Under no circumstances shall transfer of this document be deemed a sale. SJB Architects makes no warranties of fitness for any purpose. The Builder/Contractor shall verify job dimensions prior to any work commencing. Use figured dimensions only. Do not scale drawings.

Nominated Architects: Adam Haddow-7188 | John Pradel-7004

FOR APPROVAL

Rev	Date	Revision	Ву	Chk
1	05.05.2020	Preliminary - DA Set 20%	JS	WG
2	18.05.2020	Preliminary - DA Set 40%	JS	WG
3	21.07.2020	For Coordination	JS	WG
4	28.07.2020	For Coordination	JS	WG
5	27.08.2020	For DA	JS	WG
6	17.03.2021	For DA - Additional Information	JS	WG
7	15.07.2021	Issued for Section34	WG	WG
3	30.08.2021	L&EC Submission	BM	WG
9	18.09.2021	L&EC Submission	BM	AH
10	27.10.2021	L&EC Submission	WG	WG
11	01.11.2023	Draft S4.55 Modification	DC	DC
12	03.11.2023	S4.55 Modification	DC	JT
13	13.12.2023	S4.55 Modification	DC	JT
14	07.02.2024	S4.55 Modification	DC	JT
15	12.03.2024	S4.55 Modification	DC	JT
16	18.11.2024	For Approval	MF	DC
17	22.05.2025	For Approval	DC	JT

NOTE: MINOR CHANGES TO FORM AND CONFIGURATION

MAY BE REQUIRED WHEN DRAWINGS ARE SUBSEQUENTLY PREPARED FOR CONSTRUCTION PURPOSES AFTER THE GRANT OF DEVELOPMENT CONSENT

East (Milton Street)

165-171 MILTON ST

- METAL FENCE WITHIN EXISTING TREE TPZ

TO BE IN ACCORDANCE WITH ARBORIST

BUILDING F2

REQUIREMENTS AND CONDITIONS

FOOT PATH

- 1.1m FENCE & GATE TO BE IN ACCORDANCE


WITH COUNCIL HERITAGE ARCHITECTS
REQUIREMENTS AND CONDITIONS

F2-Level 1

F2-Ground

44350

41100

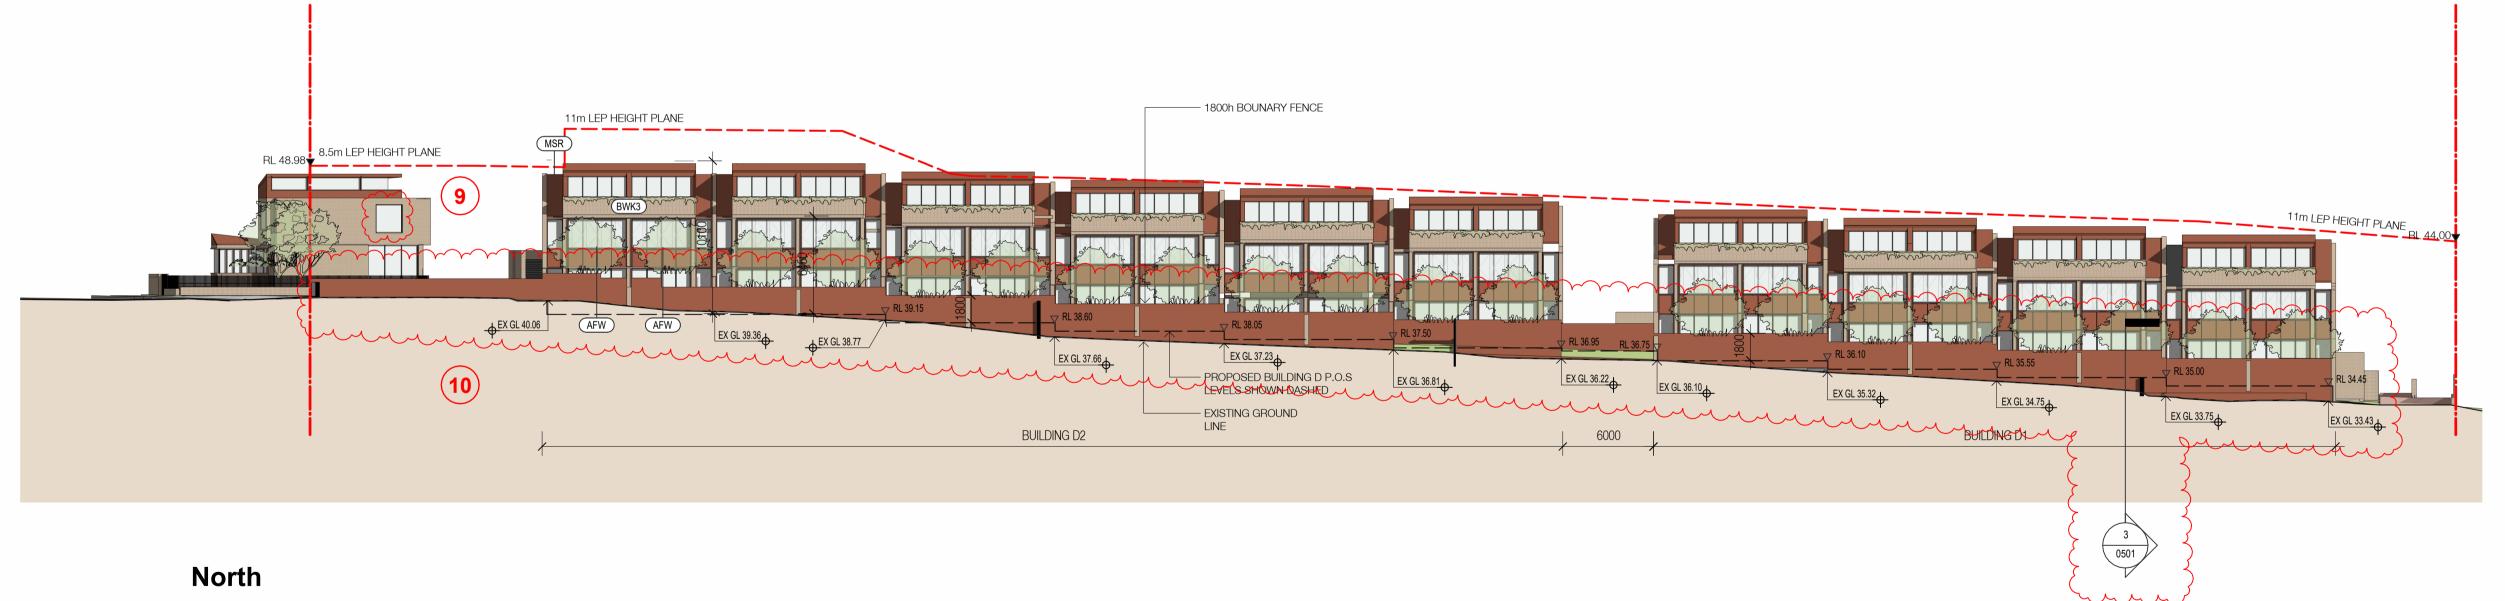

- EXISTING STREET TREES SHOWN IN GREY

BUILDING F1


— EXISTING GROUND

LINE SHOWN DASHED

1.1m FENCE & GATE TO BE IN ACCORDANCE

WITH COUNCIL HERITAGE ARCHITECTS

REQUIREMENTS AND CONDITIONS

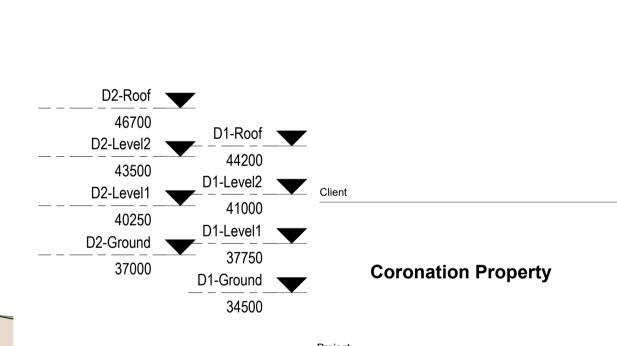


ASHBURY STAGE 2

149-163 MILTON STREET **ASHBURY NSW 2193**

Drawing Name

Elevations - North & East

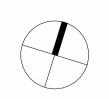


Date	Scale	Sheet Size
22.05.2025	As indicated	@ A1
Drawn	Chk.	
DC	JT	
Job No.	Drawing No.	Revision
6839	DA-0501	/ 17

SJB Architects Level 2 490 Crown Street Surry Hills NSW 2010 Australia T 61 2 9380 9911 F 61 2 9380 9922

www.sjb.com.au




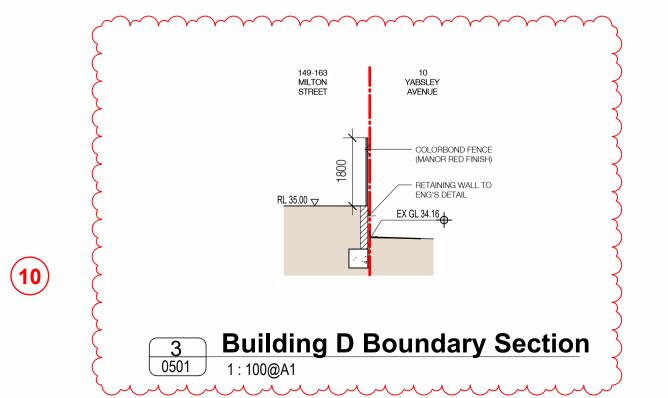


8.5m LEP HEIGHT PLANE

147 MILTON ST


TO BE IN ACCORDANCE WITH ARBORIST REQUIREMENTS AND CONDITIONS

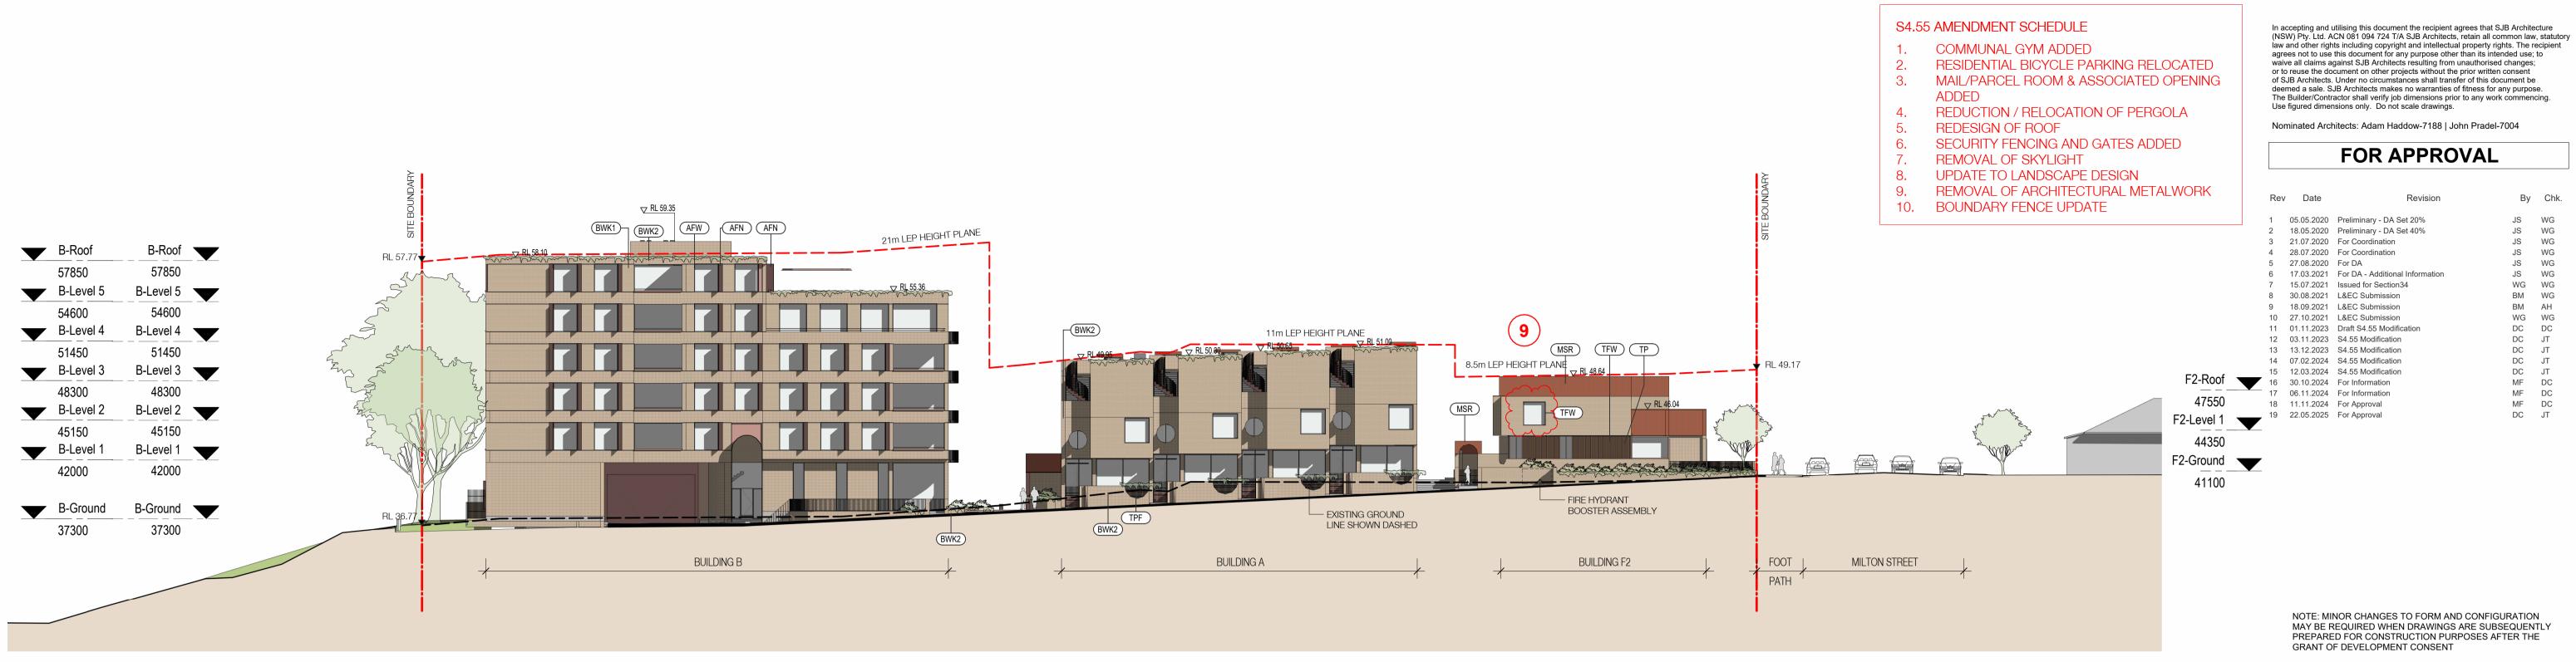

South (New Street)

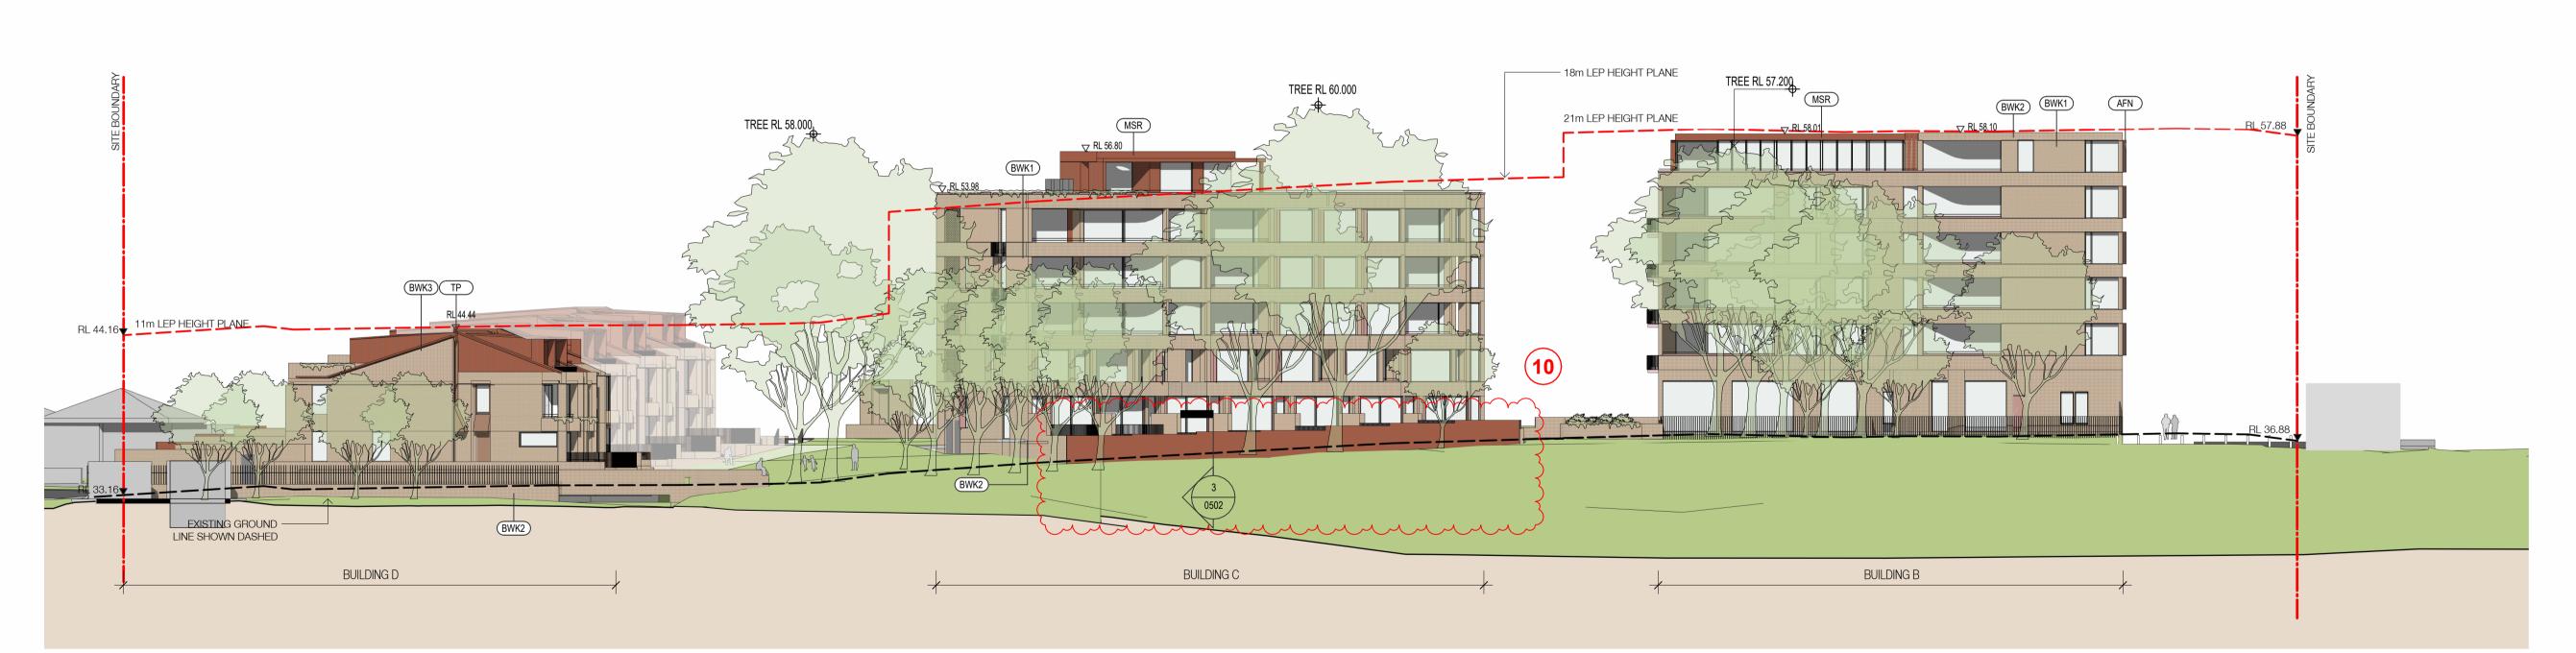

West

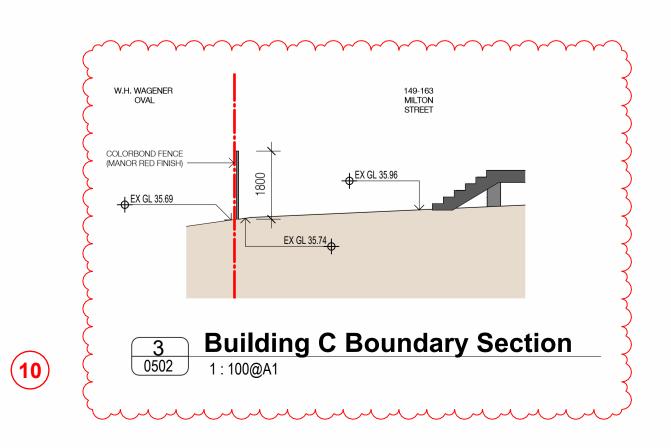

MB

MSR

RC

SIL

TFW

TPF

Materials Legend Aluminium Framed Window Aluminium Fin

Face Brickwork (1) Stretcher Course (2) Soldier Course

(3) Stack Course Metal Balustrade Metal Sheet Roof

Concrete Structure Concrete Sill + Handrail Timber Framed Window/Door Timber Palisade Fence/Gate

Timber Infill Panel (to match TFW)

DA-0502 / 19 SJB Architects Level 2 490 Crown Street Surry Hills NSW 2010 Australia T 61 2 9380 9911

F 61 2 9380 9922

www.sjb.com.au

DC



@ A1

Client

Coronation Property

FOR APPROVAL

By Chk.

JS WG JS WG JS WG

JS WG
JS WG
JS WG
WG WG
BM WG
BM AH
WG WG
DC DC
JT
DC JT
DC JT
ASHBURY STAGE 2

149-163 MILTON STREET **ASHBURY NSW 2193**


22.05.2025 As indicated

JT

Drawing No.

Drawing Name

Elevations - South & West

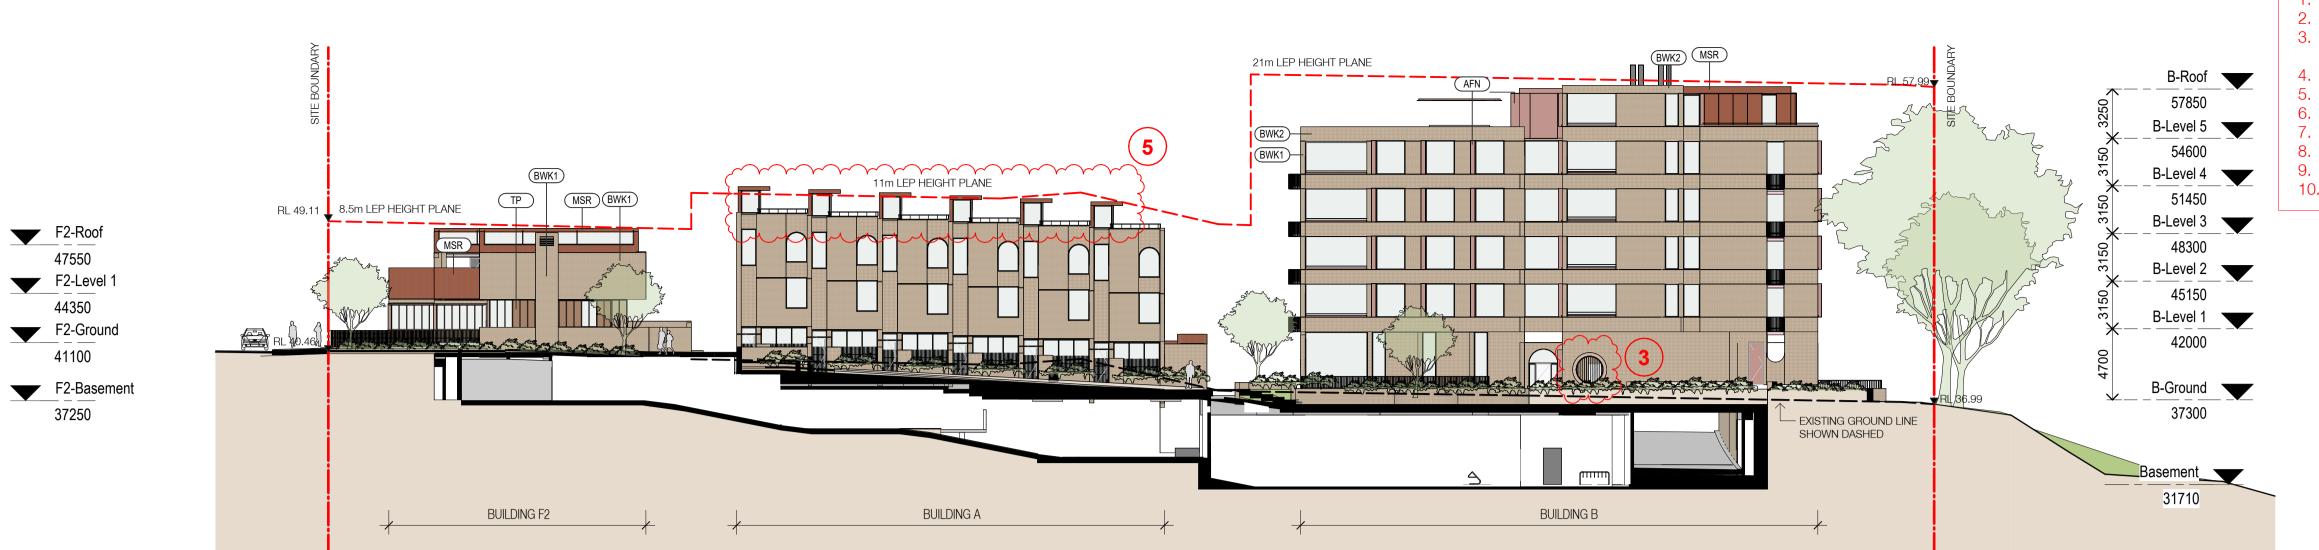

- 1. COMMUNAL GYM ADDED
- RESIDENTIAL BICYCLE PARKING RELOCATED MAIL/PARCEL ROOM & ASSOCIATED OPENING
- REDUCTION / RELOCATION OF PERGOLA
- REDESIGN OF ROOF SECURITY FENCING AND GATES ADDED
- REMOVAL OF SKYLIGHT UPDATE TO LANDSCAPE DESIGN REMOVAL OF ARCHITECTURAL METALWORK BOUNDARY FENCE UPDATE
- Nominated Architects: Adam Haddow-7188 | John Pradel-7004

Use figured dimensions only. Do not scale drawings.

FOR APPROVAL

In accepting and utilising this document the recipient agrees that SJB Architecture (NSW) Pty. Ltd. ACN 081 094 724 T/A SJB Architects, retain all common law, statutory law and other rights including copyright and intellectual property rights. The recipient

agrees not to use this document for any purpose other than its intended use; to waive all claims against SJB Architects resulting from unauthorised changes;


waive all claims against SJB Architects resulting from unauthorised changes; or to reuse the document on other projects without the prior written consent of SJB Architects. Under no circumstances shall transfer of this document be deemed a sale. SJB Architects makes no warranties of fitness for any purpose. The Builder/Contractor shall verify job dimensions prior to any work commencing.

V	Date	Revision	Ву	Chk
	05.05.2020	Preliminary - DA Set 20%	JS	WG
	18.05.2020	Preliminary - DA Set 40%	JS	WG
	21.07.2020	For Coordination	JS	WG
	28.07.2020	For Coordination	JS	WG
	27.08.2020	For DA	JS	WG
	17.03.2021	For DA - Additional Information	JS	WG
	15.07.2021	Issued for Section34	WG	WG
	30.08.2021	L&EC Submission	BM	WG
	18.09.2021	L&EC Submission	BM	AH
	27.10.2021	L&EC Submission	WG	WG
	01.11.2023	Draft S4.55 Modification	DC	DC
	03.11.2023	S4.55 Modification	DC	JT
	13.12.2023	S4.55 Modification	DC	JT
	25.01.2024	S4.55 Modification	DC	JT
	07.02.2024	S4.55 Modification	DC	JT
	12.03.2024	S4.55 Modification	DC	JT
	30.10.2024	For Information	MF	DC
	06.11.2024	For Information	MF	DC
	11.11.2024	For Approval	MF	DC
	18.11.2024	For Approval	MF	DC
	22.05.2025	For Approval	DC	JT

NOTE: MINOR CHANGES TO FORM AND CONFIGURATION MAY BE REQUIRED WHEN DRAWINGS ARE SUBSEQUENTLY PREPARED FOR CONSTRUCTION PURPOSES AFTER THE

GRANT OF DEVELOPMENT CONSENT

Building A, B & F3 North Height **Plane Cut**

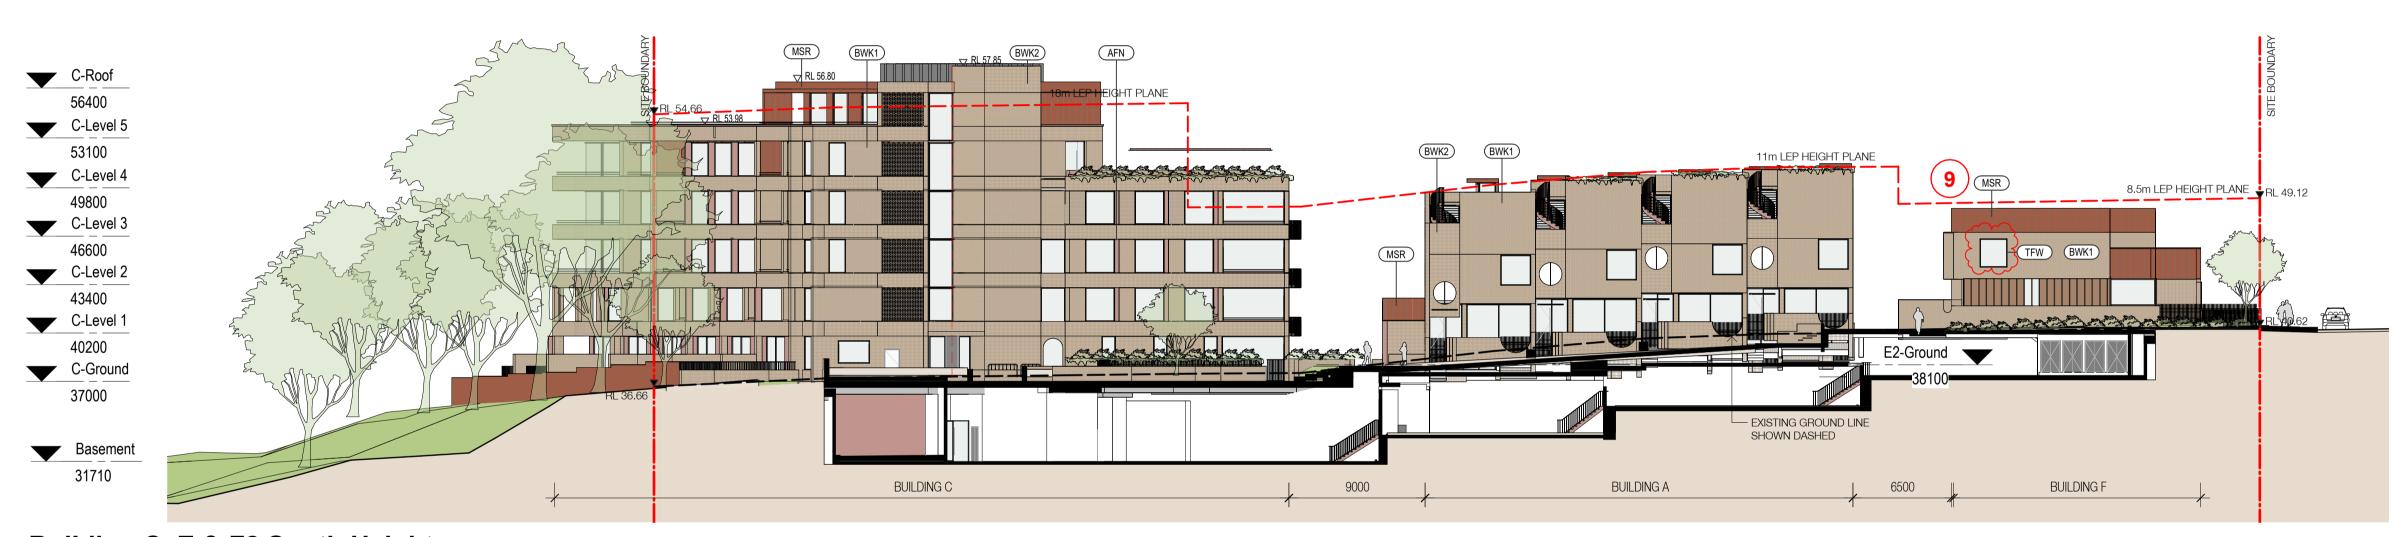

F1-Roof F1-Level 1

47350

44150

40900

F1-Basement

37400

F1-Ground

Coronation Property

ASHBURY STAGE 2

ASHBURY NSW 2193

Elevations - Internal Sheet 1


Drawing Name

www.sjb.com.au

149-163 MILTON STREET

Client

Building C, E & F2 South Height Plane Cut

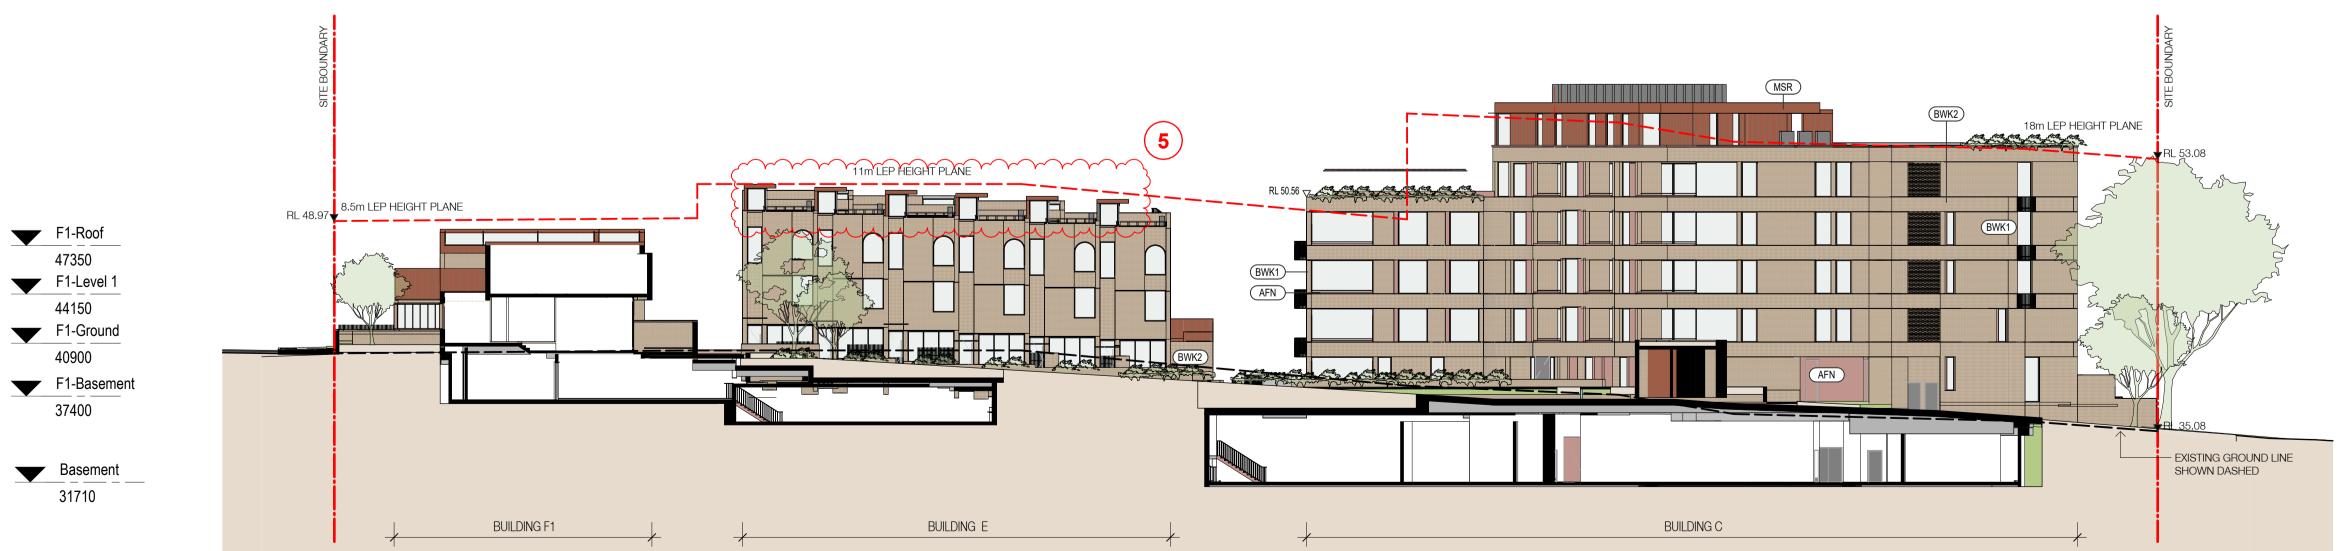

Building C, E & F2 North Height **Plane Cut**

C-Level 5 53100 C-Level 4 49800 C-Level 3 46600 C-Level 2 43400 C-Level 1 40200 C-Ground 37000 Materials Legend BWK

MB

MSR

RC

SIL

TPF

TFW

C-Roof

56400

Aluminium Framed Window


Aluminium Fin Face Brickwork (1) Stretcher Course (2) Soldier Course

(3) Stack Course Metal Balustrade Metal Sheet Roof


Timber Infill Panel (to match TFW)

Concrete Structure Concrete Sill + Handrail Timber Framed Window/Door Timber Palisade Fence/Gate


22.05.2025 As indicated @ A1 Chk. DC JT Drawing No. DA-0503 / 21

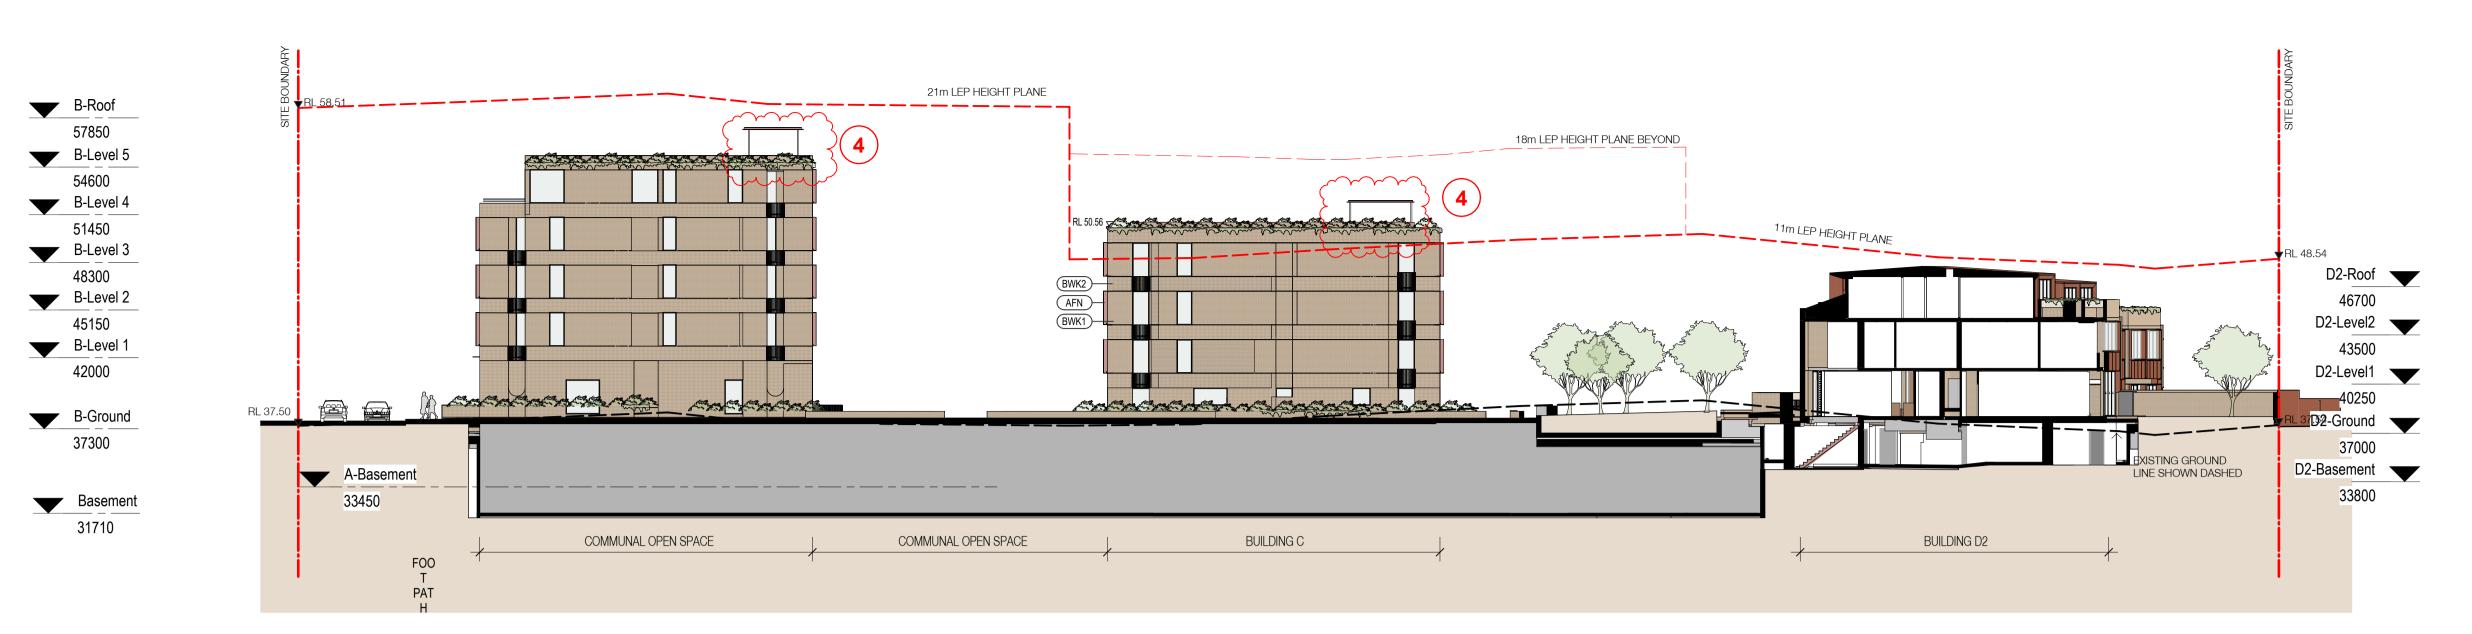

Building B & C East Height Plane Cut

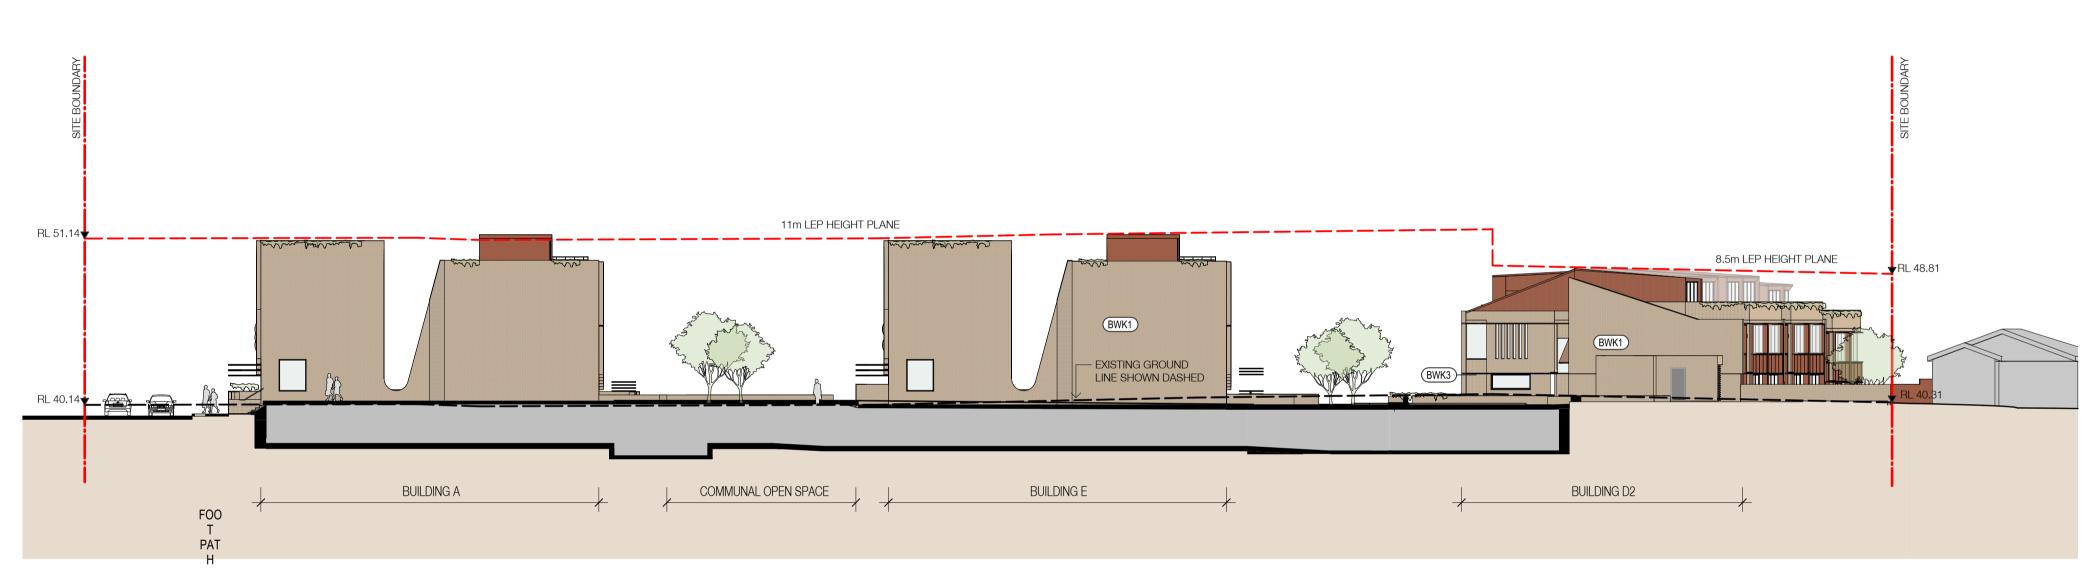

Building A & E East Height Plane Cut

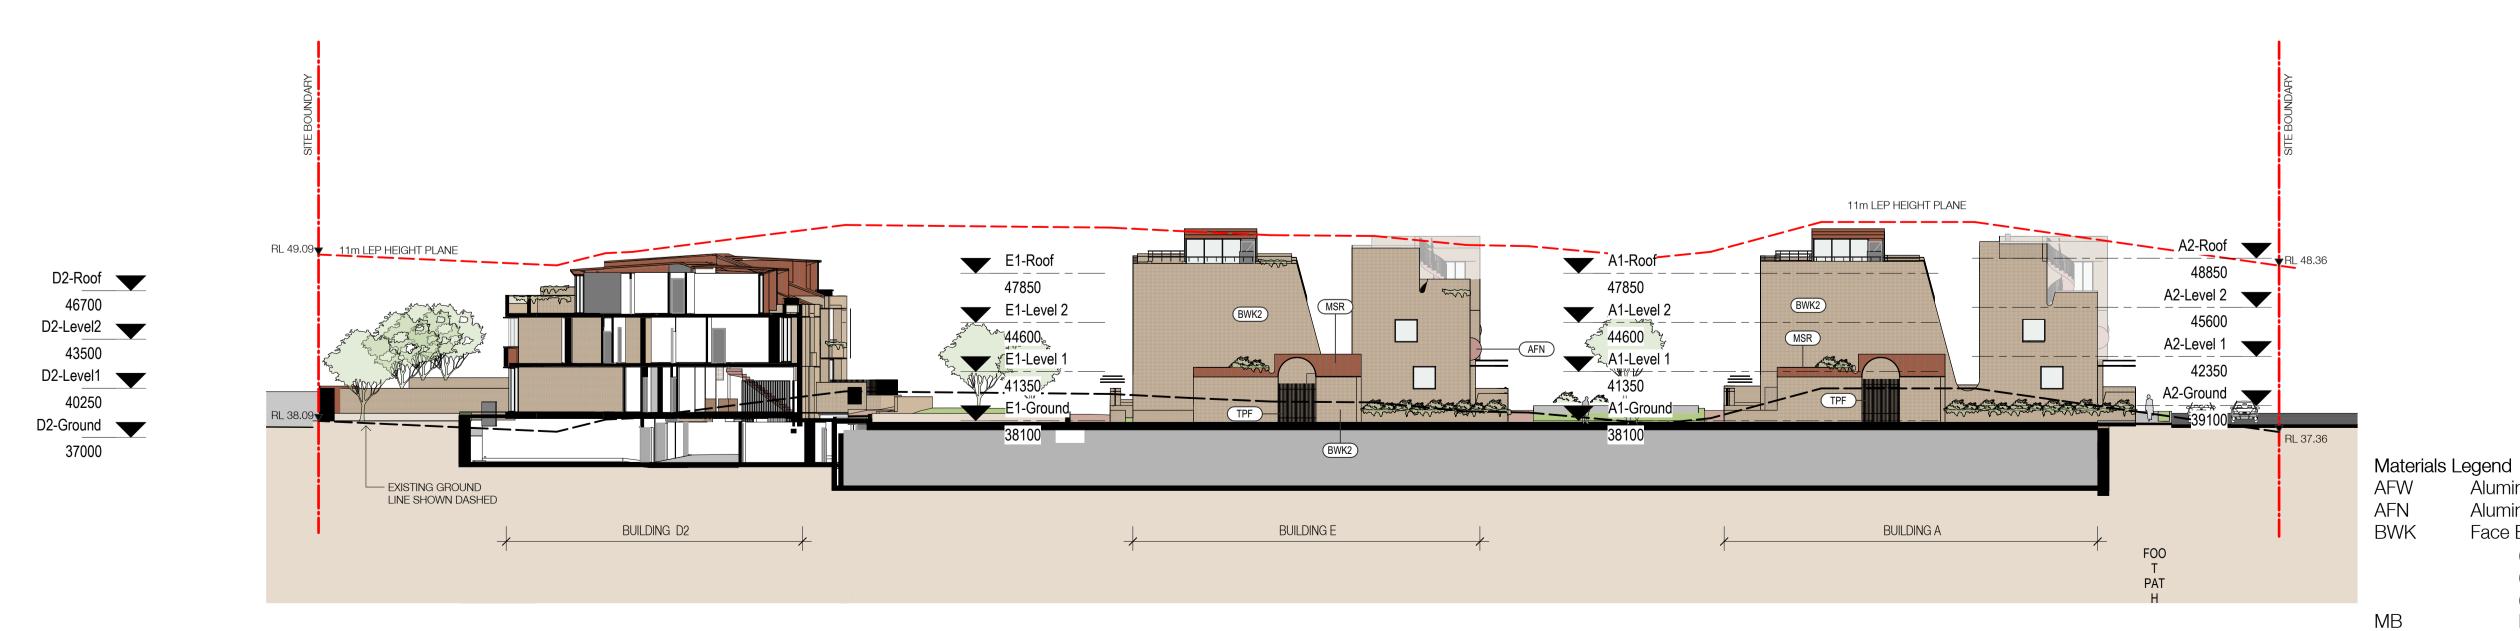

Building A & E West Height Plane Cut

In accepting and utilising this document the recipient agrees that SJB Architecture (NSW) Pty. Ltd. ACN 081 094 724 T/A SJB Architects, retain all common law, statutory law and other rights including copyright and intellectual property rights. The recipient agrees not to use this document for any purpose other than its intended use; to waive all claims against SJB Architects resulting from unauthorised changes; or to reuse the document on other projects without the prior written consent of SJB Architects. Under no circumstances shall transfer of this document be deemed a sale. SJB Architects makes no warranties of fitness for any purpose. The Builder/Contractor shall verify job dimensions prior to any work commencing. Use figured dimensions only. Do not scale drawings.

Nominated Architects: Adam Haddow-7188 | John Pradel-7004

FOR APPROVAL

Date	Revision	Ву	C
05.05.2020	Preliminary - DA Set 20%	JS	W
18.05.2020	Preliminary - DA Set 40%	JS	W
21.07.2020	For Coordination	JS	W
28.07.2020	For Coordination	JS	W
27.08.2020	For DA	JS	W
17.03.2021	For DA - Additional Information	JS	W
15.07.2021	Issued for Section34	WG	W
30.08.2021	L&EC Submission	BM	W
18.09.2021	L&EC Submission	BM	Αŀ
27.10.2021	L&EC Submission	WG	W
01.11.2023	Draft S4.55 Modification	DC	DO
03.11.2023	S4.55 Modification	DC	JT
13.12.2023	S4.55 Modification	DC	JT
25.01.2024	S4.55 Modification	DC	JT
07.02.2024	S4.55 Modification	DC	JT
12.03.2024	S4.55 Modification	DC	JT
30.10.2024	For Information	MF	DO
06.11.2024	For Information	MF	DO
11.11.2024	For Approval	MF	DO
18.11.2024	For Approval	MF	DO
22.05.2025	For Approval	DC	JT

NOTE: MINOR CHANGES TO FORM AND CONFIGURATION MAY BE REQUIRED WHEN DRAWINGS ARE SUBSEQUENTLY PREPARED FOR CONSTRUCTION PURPOSES AFTER THE GRANT OF DEVELOPMENT CONSENT

Client

S4.55 AMENDMENT SCHEDULE

REDESIGN OF ROOF

10. BOUNDARY FENCE UPDATE

D2-Level1 40250 D2-Ground

37000

Aluminium Framed Window

(1) Stretcher Course(2) Soldier Course

(3) Stack Course

Metal Balustrade

Concrete Structure

Timber Framed Window/Door

Timber Palisade Fence/Gate

Concrete Sill + Handrail

Timber Infill Panel (to match TFW)

Aluminium Fin Face Brickwork

Metal Sheet Roof

MSR

RC

SIL

TFW

TPF

REMOVAL OF SKYLIGHT

ADDED

COMMUNAL GYM ADDED

RESIDENTIAL BICYCLE PARKING RELOCATED

MAIL/PARCEL ROOM & ASSOCIATED OPENING

REMOVAL OF ARCHITECTURAL METALWORK

REDUCTION / RELOCATION OF PERGOLA

SECURITY FENCING AND GATES ADDED

UPDATE TO LANDSCAPE DESIGN

Coronation Property


Project

ASHBURY STAGE 2

149-163 MILTON STREET ASHBURY NSW 2193

Drawing Name

Elevations - Internal Sheet 2

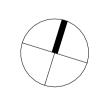


Date	Scale	Sheet Size
22.05.2025	As indicated	@ A1
Drawn	Chk.	
DC	JT	
Job No.	Drawing No.	Revision
6839	DA-0504	/ 21

SJB Architects Level 2 490 Crown Street Surry Hills NSW 2010 Australia T 61 2 9380 9911 F 61 2 9380 9922

www.sjb.com.au



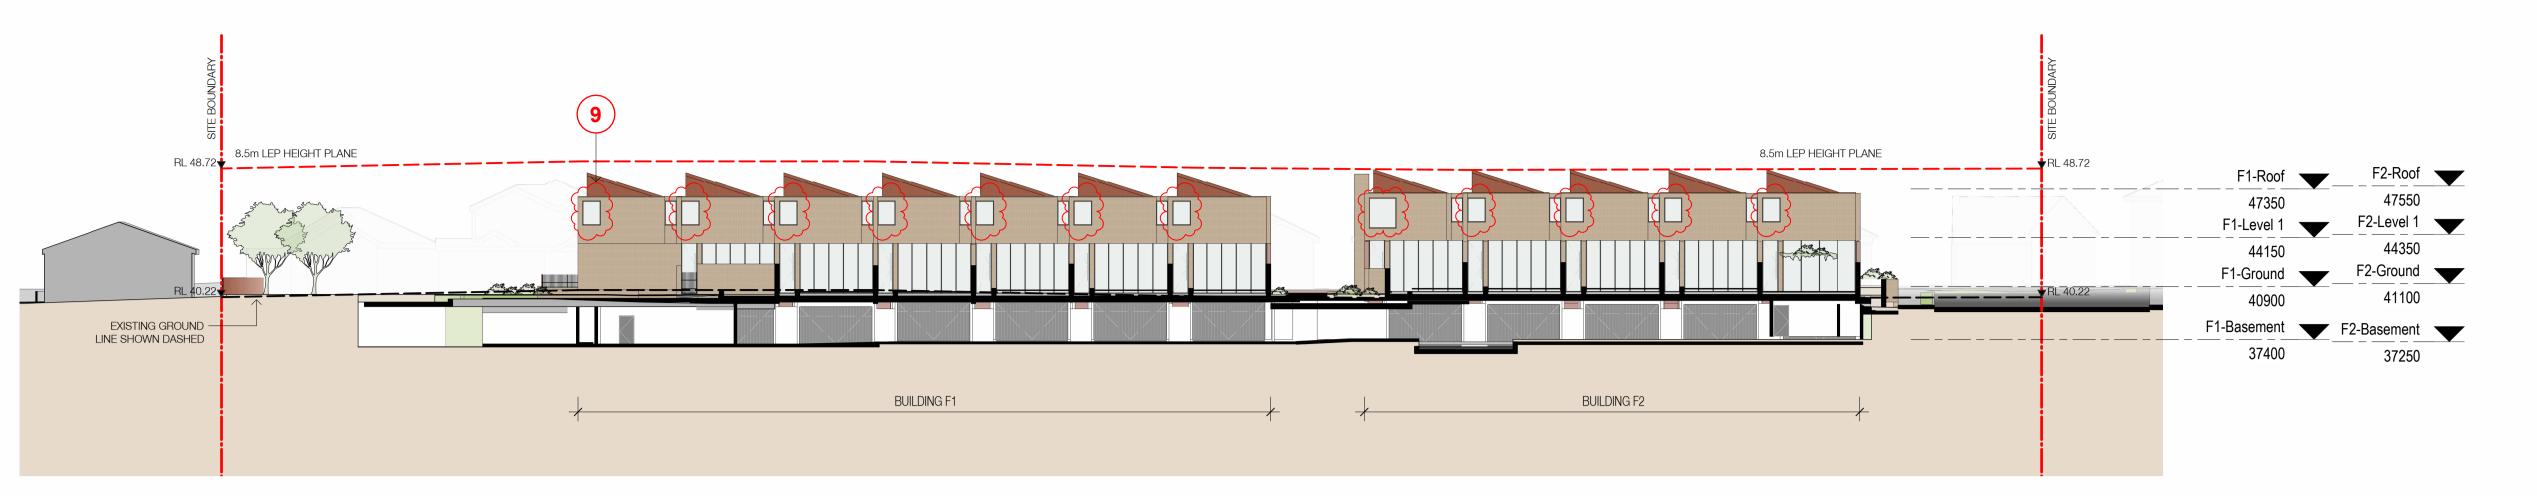

Building F West Height Plane Cut



Building D & F1 South Height Plane Cut

S4.55 AMENDMENT SCHEDULE

1. COMMUNAL GYM ADDED 2. RESIDENTIAL BICYCLE PARKING RELOCATED

4. REDUCTION / RELOCATION OF PERGOLA

6. SECURITY FENCING AND GATES ADDED

10. BOUNDARY FENCE UPDATE


Client

Drawing Name Elevations - Internal Sheet 3

ASHBURY STAGE 2

ASHBURY NSW 2193

149-163 MILTON STREET

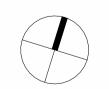

Date	Scale	Sheet Size
22.05.2025	As indicated	@ A1
Drawn	Chk.	
DC	JT	
Job No.	Drawing No.	Revision
6839	DA-0505	/ 16

Coronation Property

In accepting and utilising this document the recipient agrees that SJB Architecture (NSW) Pty. Ltd. ACN 081 094 724 T/A SJB Architects, retain all common law, statutory law and other rights including copyright and intellectual property rights. The recipient agrees not to use this document for any purpose other than its intended use; to

waive all claims against SJB Architects resulting from unauthorised changes; or to reuse the document on other projects without the prior written consent of SJB Architects. Under no circumstances shall transfer of this document be deemed a sale. SJB Architects makes no warranties of fitness for any purpose. The Builder/Contractor shall verify job dimensions prior to any work commencing. Use figured dimensions only. Do not scale drawings.

FOR APPROVAL

NOTE: MINOR CHANGES TO FORM AND CONFIGURATION MAY BE REQUIRED WHEN DRAWINGS ARE SUBSEQUENTLY PREPARED FOR CONSTRUCTION PURPOSES AFTER THE

GRANT OF DEVELOPMENT CONSENT

By Chk.

JS WG JS WG

WG WG BM WG

WG WG
DC DC
DC JT

Nominated Architects: Adam Haddow-7188 | John Pradel-7004

18.05.2020 Preliminary - DA Set 40%

17.03.2021 For DA - Additional Information

21.07.2020 For Coordination 28.07.2020 For Coordination

15.07.2021 Issued for Section34 30.08.2021 L&EC Submission

9 27.10.2021 L&EC Submission 10 01.11.2023 Draft S4.55 Modification

11 03.11.2023 S4.55 Modification 12 13.12.2023 S4.55 Modification

13 07.02.2024 S4.55 Modification

14 12.03.2024 S4.55 Modification

15 18.11.2024 For Approval 16 22.05.2025 For Approval

27.08.2020 For DA

SJB Architects Level 2 490 Crown Street Surry Hills NSW 2010 Australia T 61 2 9380 9911 F 61 2 9380 9922

www.sjb.com.au



3. MAIL/PARCEL ROOM & ASSOCIATED OPENING ADDED

5. REDESIGN OF ROOF

7. REMOVAL OF SKYLIGHT

8. UPDATE TO LANDSCAPE DESIGN

Materials Legend

AFN

BWK

MB

MSR

RC

SIL

TFW

TPF

9. REMOVAL OF ARCHITECTURAL METALWORK

Aluminium Framed Window

(1) Stretcher Course (2) Soldier Course (3) Stack Course

Metal Balustrade

Concrete Structure

Timber Framed Window/Door

Timber Palisade Fence/Gate


Concrete Sill + Handrail

Timber Infill Panel (to match TFW)


Aluminium Fin

Face Brickwork

Metal Sheet Roof

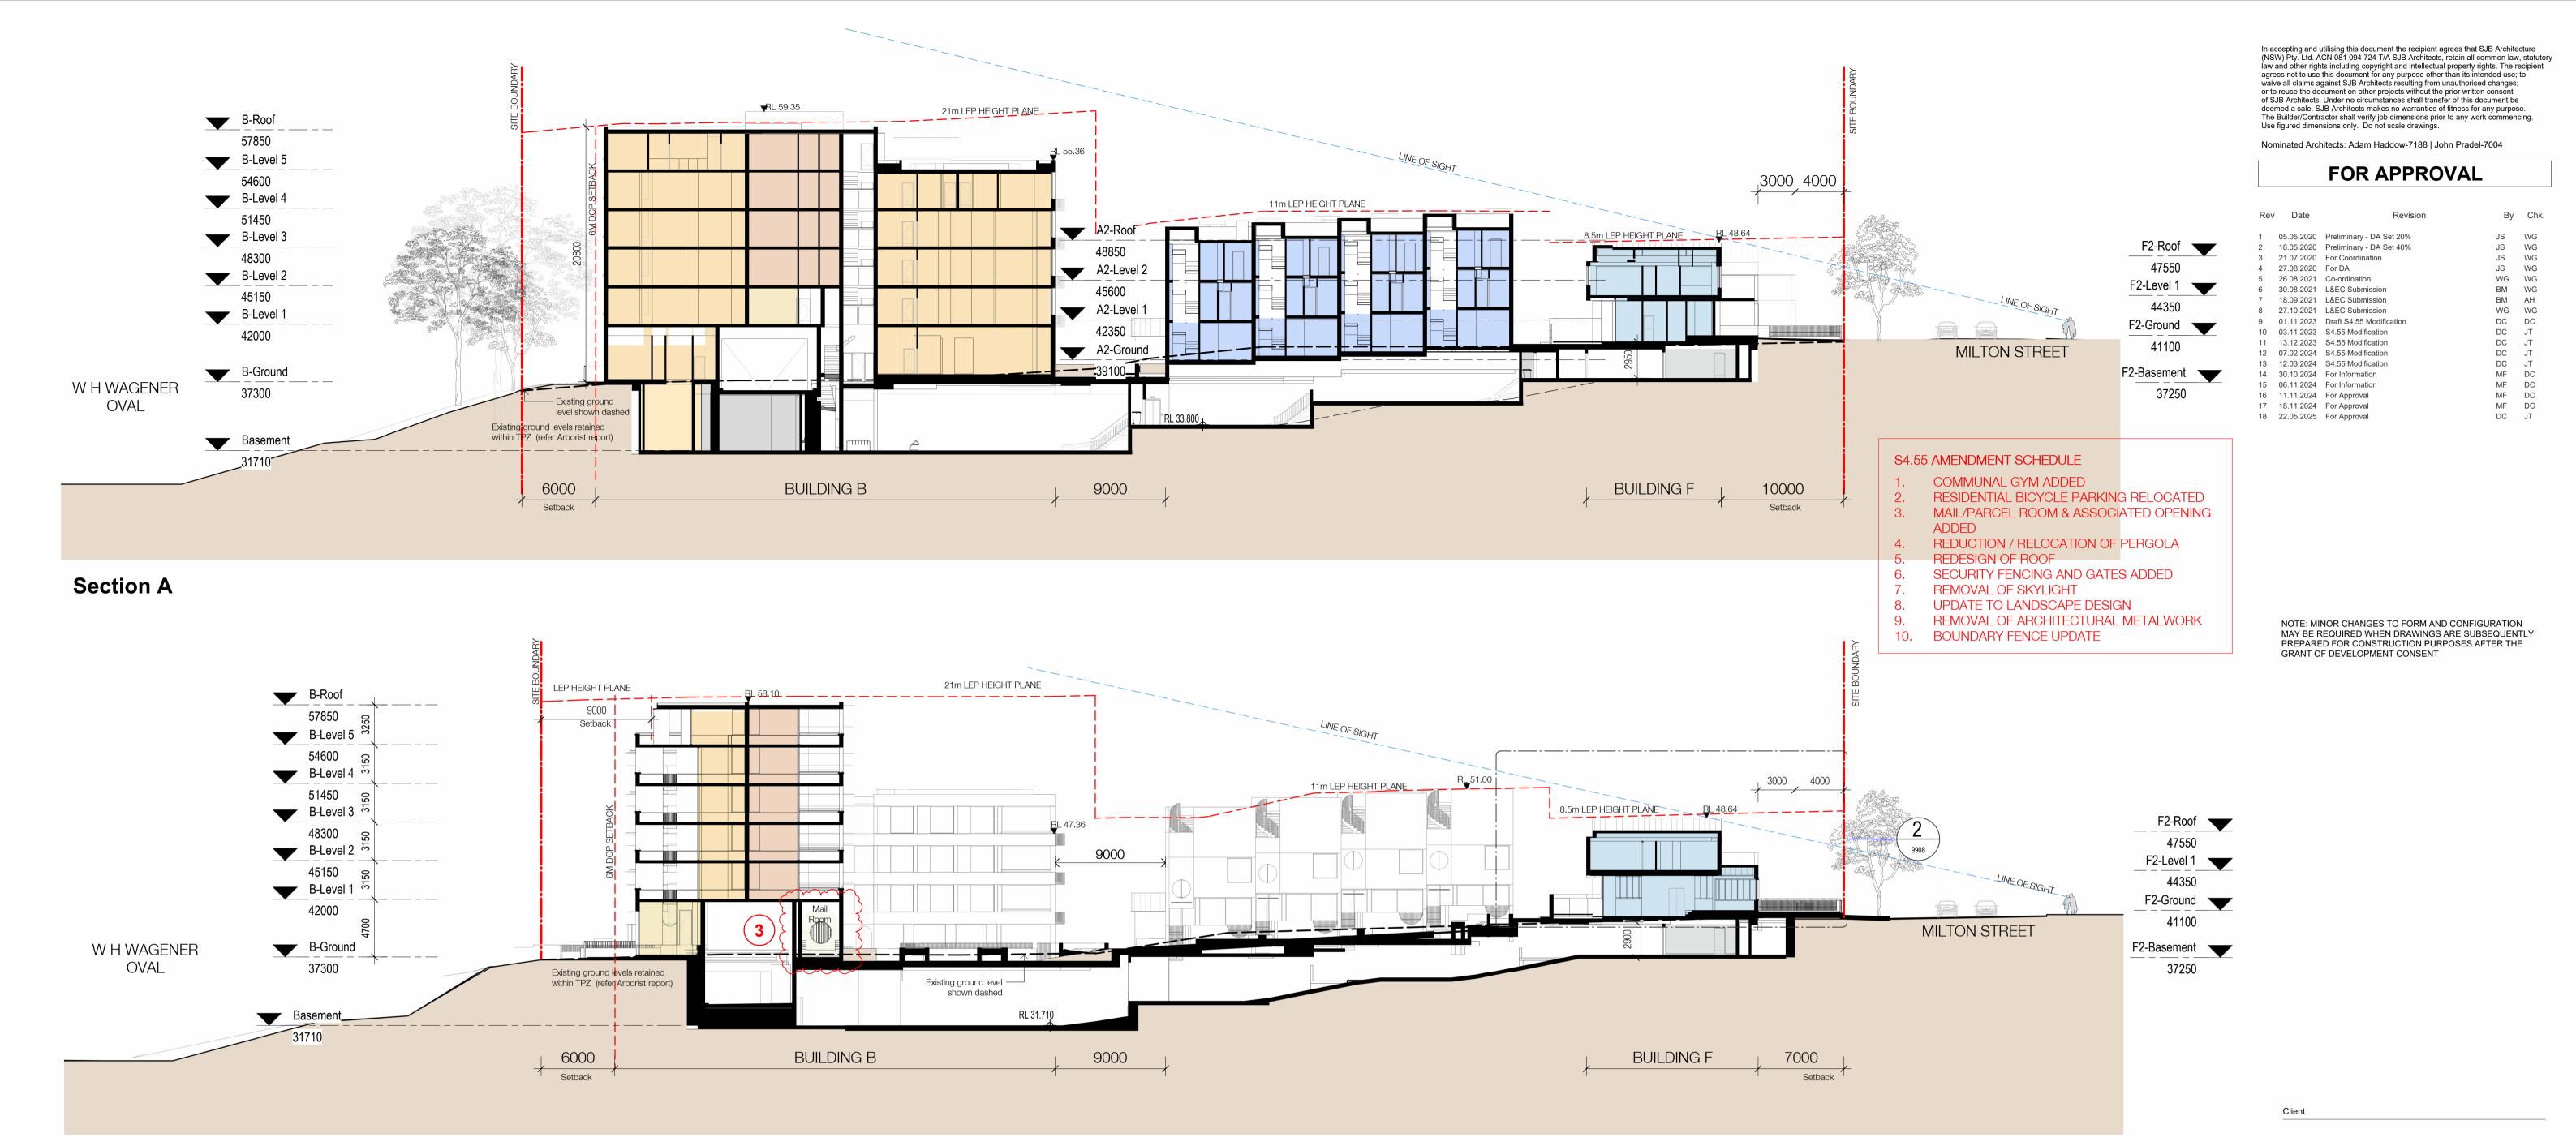

Section B

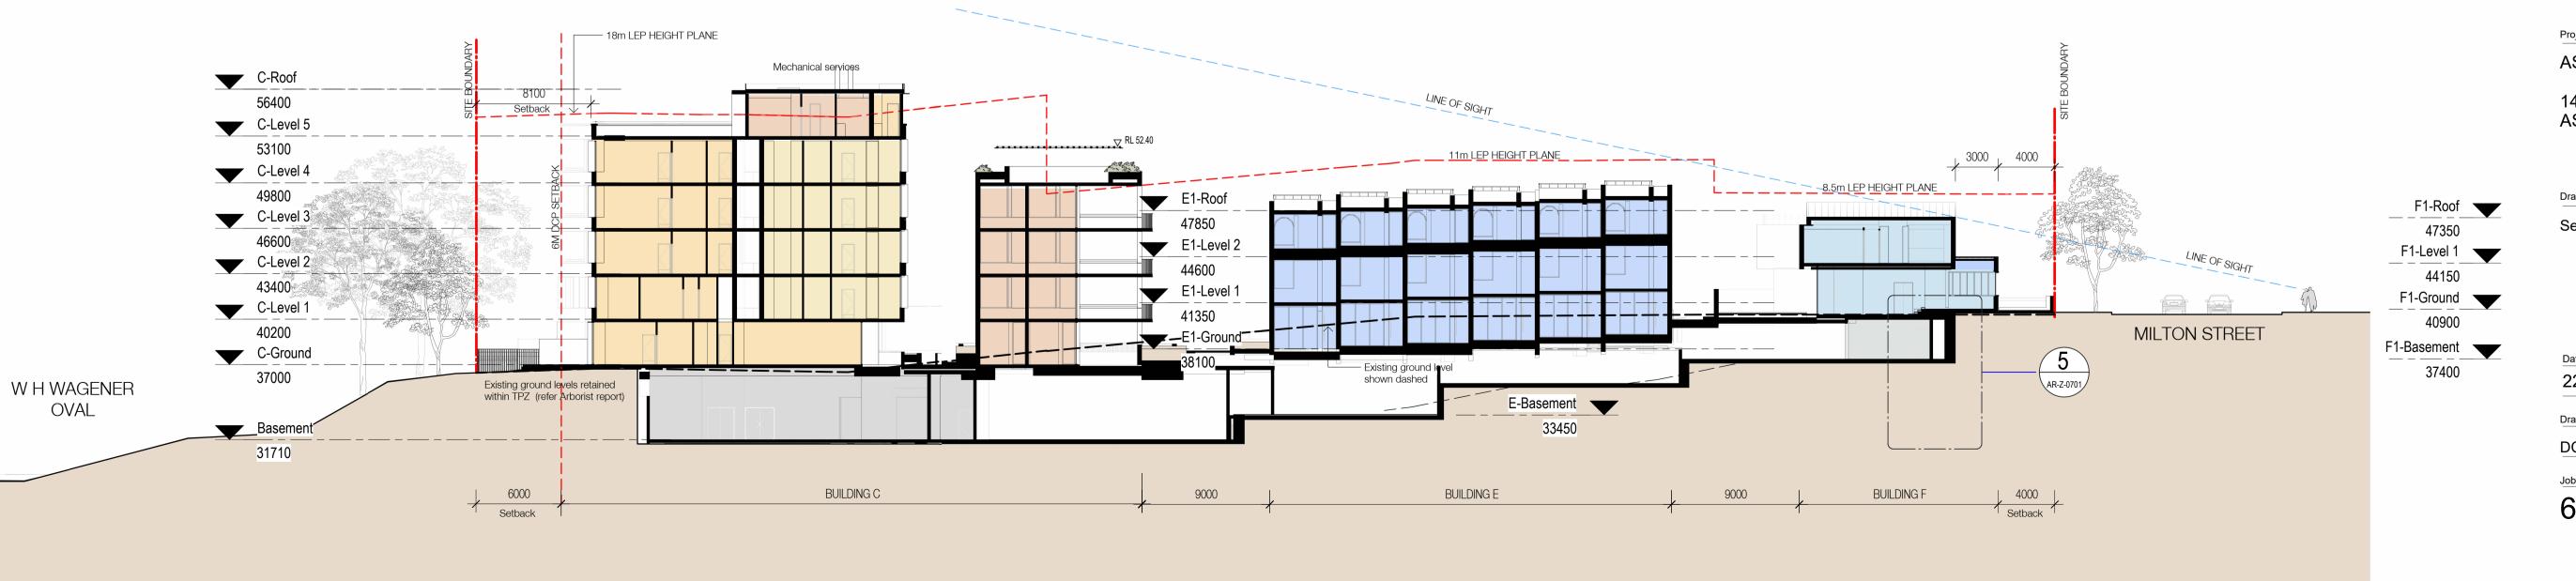

Section C

Coronation Property

Project

ASHBURY STAGE 2


149-163 MILTON STREET ASHBURY NSW 2193

Drawing Name


Sections - Sheet 1

6839	DA-0601	/ 18
Job No.	Drawing No.	Revision
DC	JT	
Drawn	Chk.	
22.05.2025	As indicated	@ A1
Date	Scale	Sheet Size



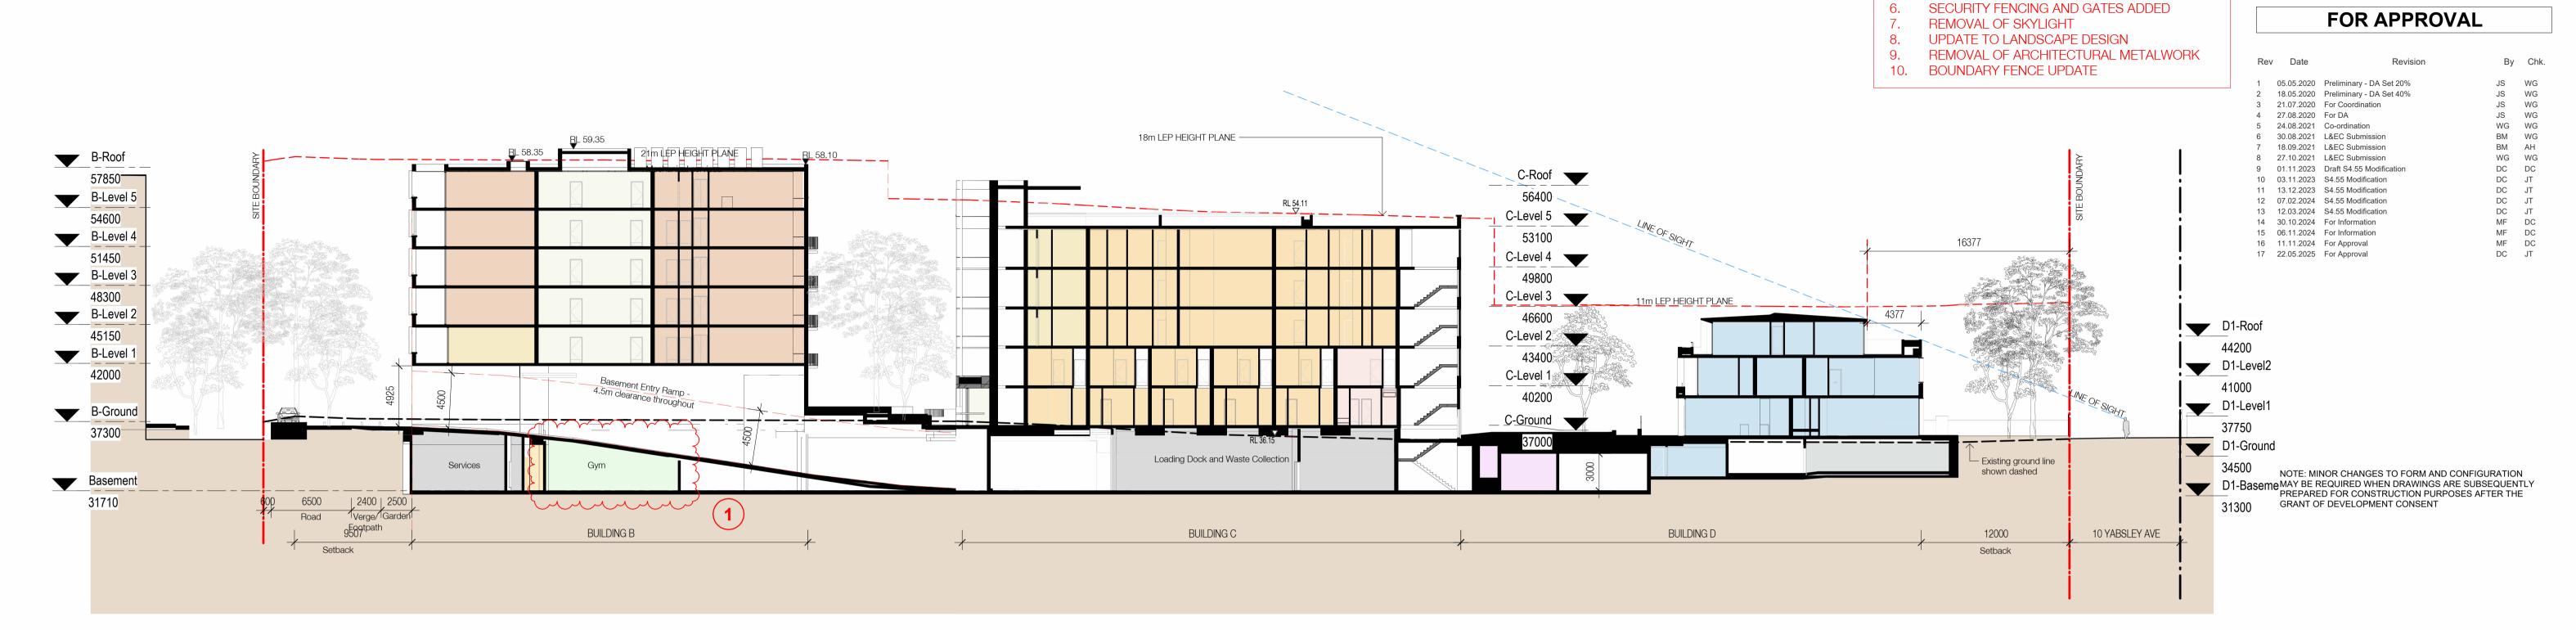

Section D

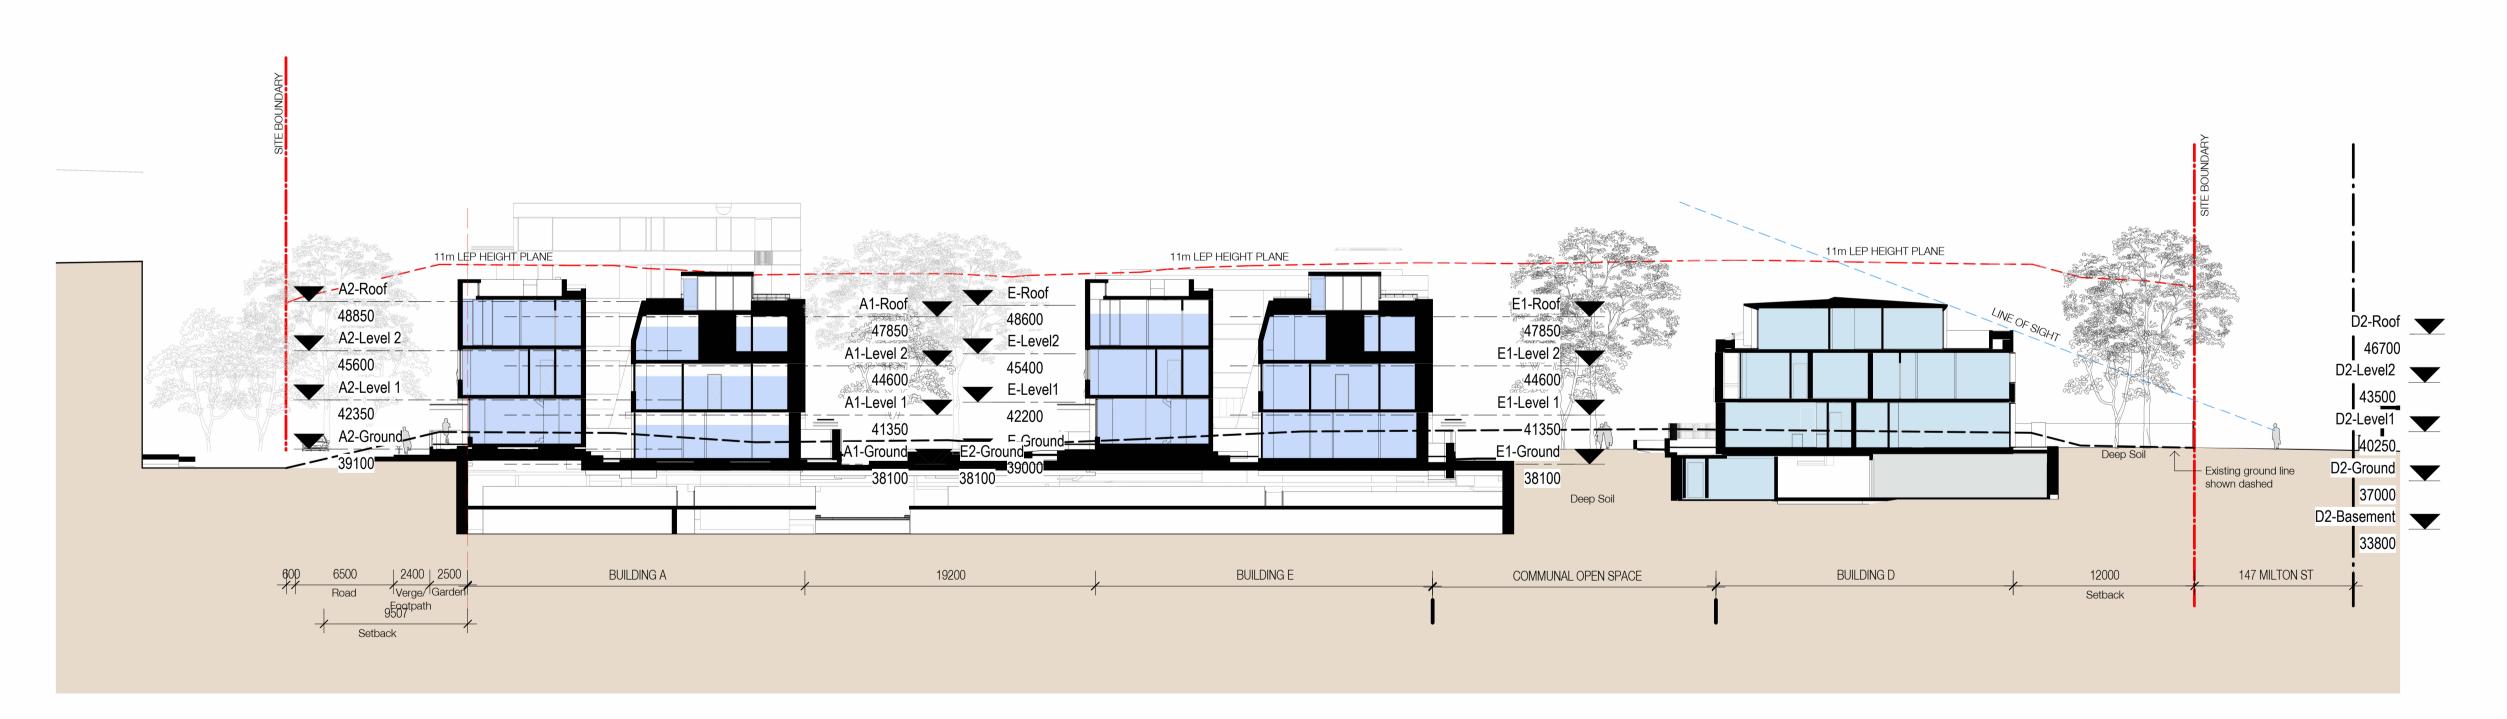

Section E

Coronation Property

Project

ASHBURY STAGE 2

149-163 MILTON STREET
ASHBURY NSW 2193

Drawing Name

Sections - Sheet 2

Client

In accepting and utilising this document the recipient agrees that SJB Architecture (NSW) Pty. Ltd. ACN 081 094 724 T/A SJB Architects, retain all common law, statutory law and other rights including copyright and intellectual property rights. The recipient agrees not to use this document for any purpose other than its intended use; to

waive all claims against SJB Architects resulting from unauthorised changes; or to reuse the document on other projects without the prior written consent of SJB Architects. Under no circumstances shall transfer of this document be deemed a sale. SJB Architects makes no warranties of fitness for any purpose. The Builder/Contractor shall verify job dimensions prior to any work commencing.

Nominated Architects: Adam Haddow-7188 | John Pradel-7004

Use figured dimensions only. Do not scale drawings.

S4.55 AMENDMENT SCHEDULE

1. COMMUNAL GYM ADDED


REDESIGN OF ROOF

RESIDENTIAL BICYCLE PARKING RELOCATED
 MAIL/PARCEL ROOM & ASSOCIATED OPENING

REDUCTION / RELOCATION OF PERGOLA

Scale	Sheet Size
As indicated	@ A1
Chk.	
JT	
Drawing No.	Revision
DA-0602	/ 17
	As indicated Chk. JT



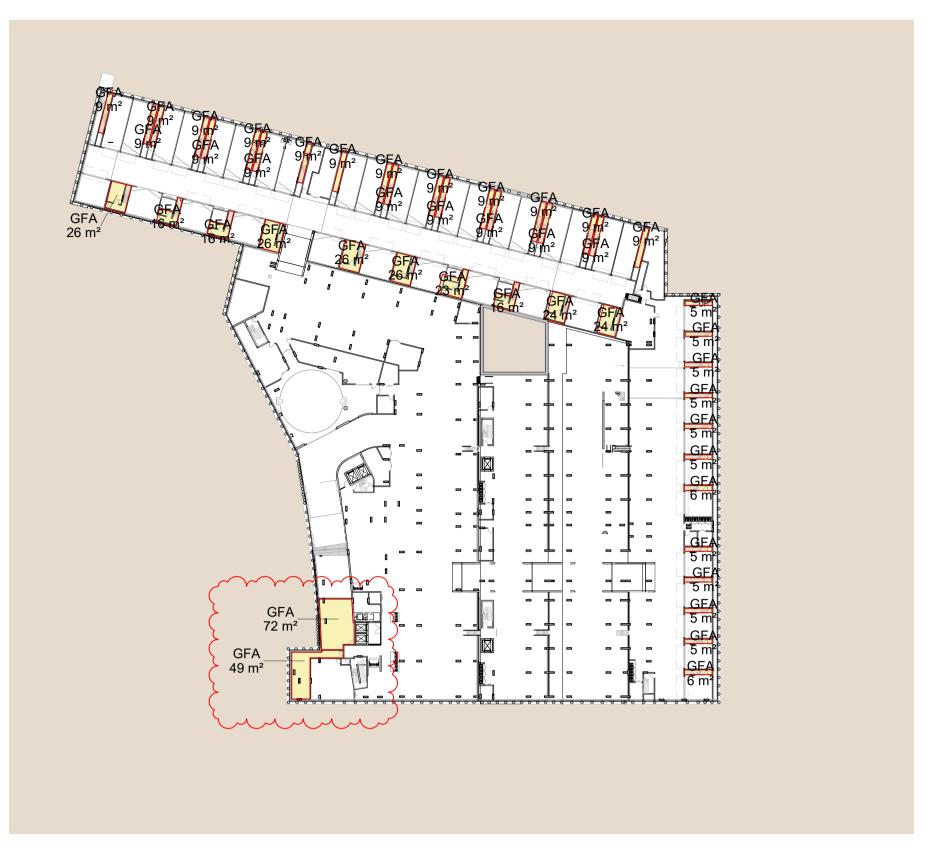

BASEMENT GFA = 591m² **Basement**



GFA - Level 1

APPROVED

ALLOWABLE FSR 1.1:1 SITE AREA 16,220m² ALLOWABLE GFA 17,842m² 17,383m² GFA FSR: 1.07:1

S4.55. MODIFICATION ALLOWABLE FSR 1.1:1 16,220m² SITE AREA 17,842m² ALLOWABLE GFA 17,539m² GFA 1.08:1

LEVEL 1 GFA = 4,912m²





S4.55 AMENDMENT SCHEDULE

1. COMMUNAL GYM ADDED

RESIDENTIAL BICYCLE PARKING RELOCATED MAIL/PARCEL ROOM & ASSOCIATED OPENING

REDUCTION / RELOCATION OF PERGOLA

REDESIGN OF ROOF SECURITY FENCING AND GATES ADDED REMOVAL OF SKYLIGHT

UPDATE TO LANDSCAPE DESIGN REMOVAL OF ARCHITECTURAL METALWORK 10. BOUNDARY FENCE UPDATE

In accepting and utilising this document the recipient agrees that SJB Architecture (NSW) Pty. Ltd. ACN 081 094 724 T/A SJB Architects, retain all common law, statutory law and other rights including copyright and intellectual property rights. The recipient agrees not to use this document for any purpose other than its intended use; to waive all claims against SJB Architects resulting from unauthorised changes; or to reuse the document on other projects without the prior written consent of SJB Architects. Under no circumstances shall transfer of this document be deemed a sale. SJB Architects makes no warranties of fitness for any purpose. The Builder/Contractor shall verify job dimensions prior to any work commencing. Use figured dimensions only. Do not scale drawings.

Nominated Architects: Adam Haddow-7188 | John Pradel-7004

FOR APPROVAL

Date	Revision	Ву	Chk.
05.05.2020	Preliminary - DA Set 20%	JS	WG
18.05.2020	Preliminary - DA Set 40%	JS	WG
29.06.2020	For Review	WG	WG
18.08.2020	For Information	JS	WG
27.08.2020	For DA	JS	WG
26.08.2021	Co-ordination	WG	WG
30.08.2021	L&EC Submission	BM	WG
18.09.2021	L&EC Submission	BM	AH
27.10.2021	L&EC Submission	WG	WG
01.11.2023	Draft S4.55 Modification	DC	DC
03.11.2023	S4.55 Modification	DC	JT
13.12.2023	S4.55 Modification	DC	JT
12.03.2024	S4.55 Modification	DC	JT
31.07.2024	For Information	DC	JT
06.11.2024	For Information	MF	DC
11.11.2024	For Approval	MF	DC
22.05.2025	For Approval	DC	JT

NOTE: MINOR CHANGES TO FORM AND CONFIGURATION MAY BE REQUIRED WHEN DRAWINGS ARE SUBSEQUENTLY PREPARED FOR CONSTRUCTION PURPOSES AFTER THE GRANT OF DEVELOPMENT CONSENT

Coronation Property

ASHBURY STAGE 2

149-163 MILTON STREET ASHBURY NSW 2193

Drawing Name


GFA Plan



Date	Scale	Sheet Size
22.05.2025	As indicated	@ A1
Drawn	Chk.	
DC	JT	
Job No.	Drawing No.	Revision
6839	DA-2901	/ 17






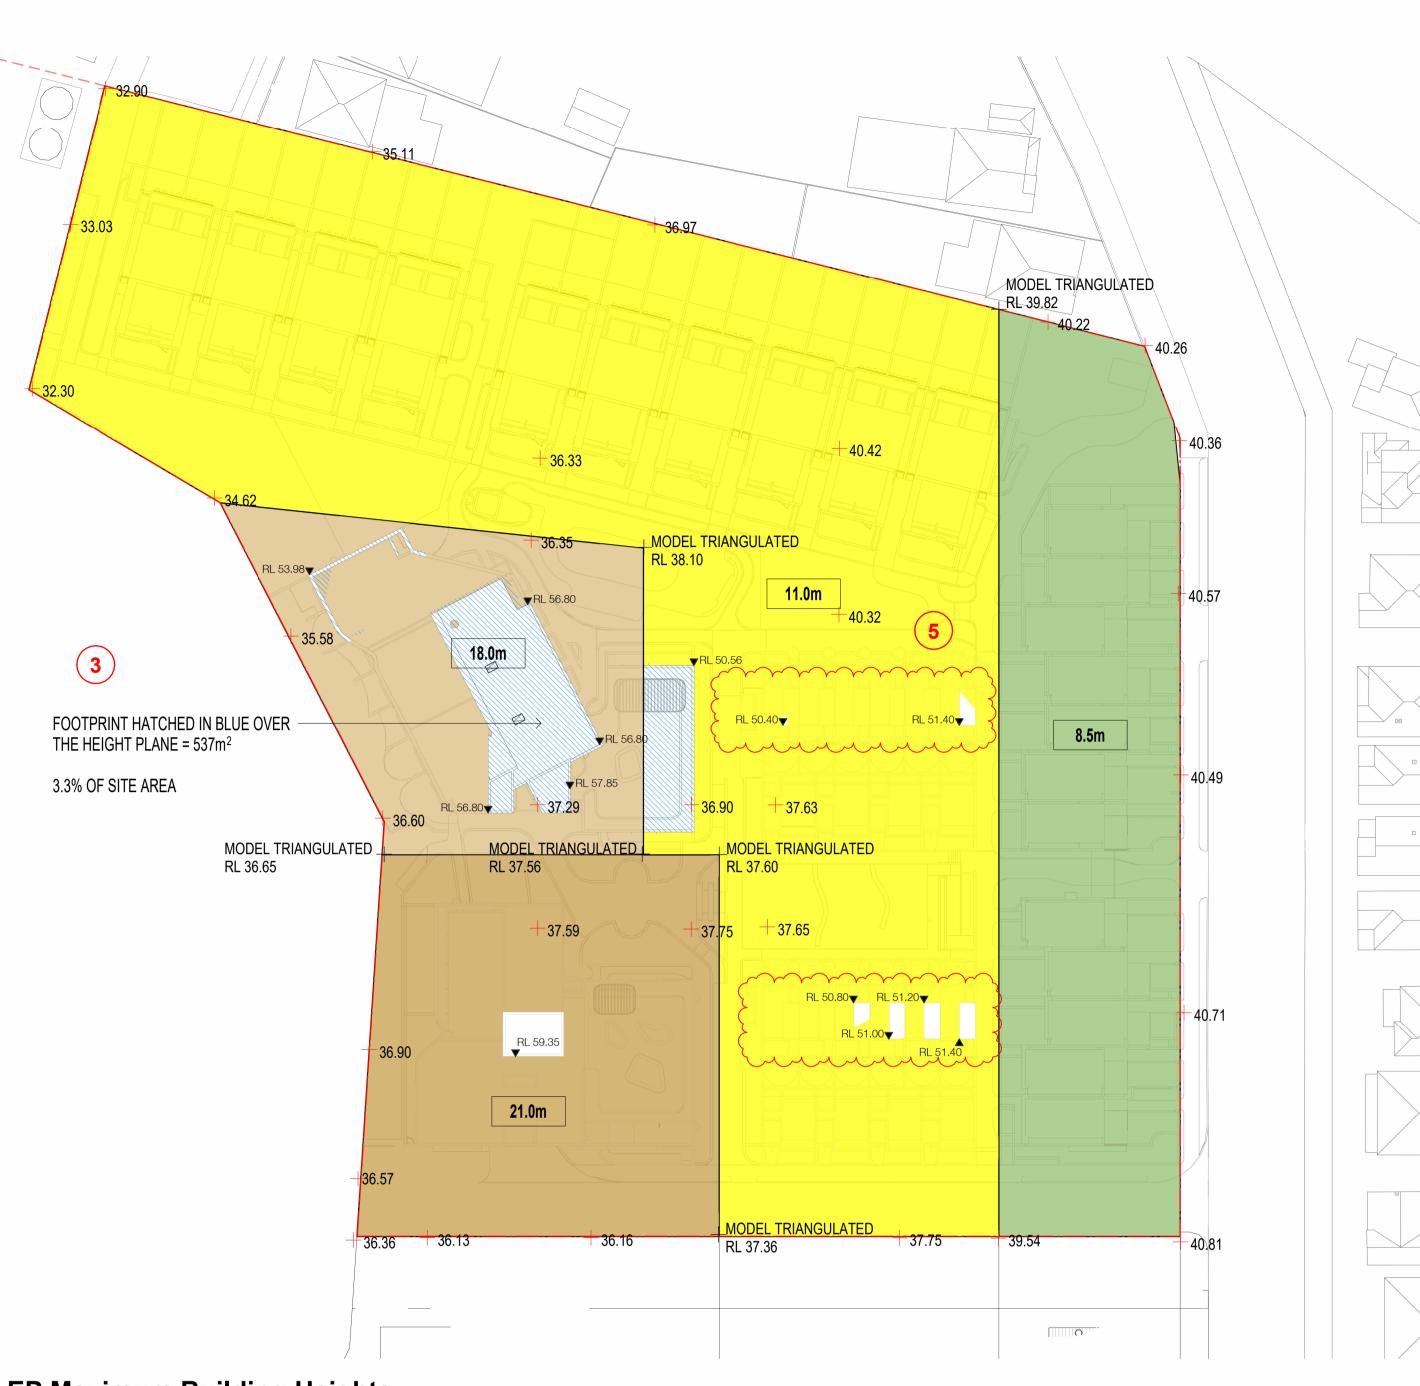

LEP Maximum Building Heights

S4.55 AMENDMENT SCHEDULE COMMUNAL GYM ADDED RESIDENTIAL BICYCLE PARKING RELOCATED MAIL/PARCEL ROOM & ASSOCIATED OPENING REDUCTION / RELOCATION OF PERGOLA REDESIGN OF ROOF SECURITY FENCING AND GATES ADDED REMOVAL OF SKYLIGHT UPDATE TO LANDSCAPE DESIGN REMOVAL OF ARCHITECTURAL METALWORK 10. BOUNDARY FENCE UPDATE

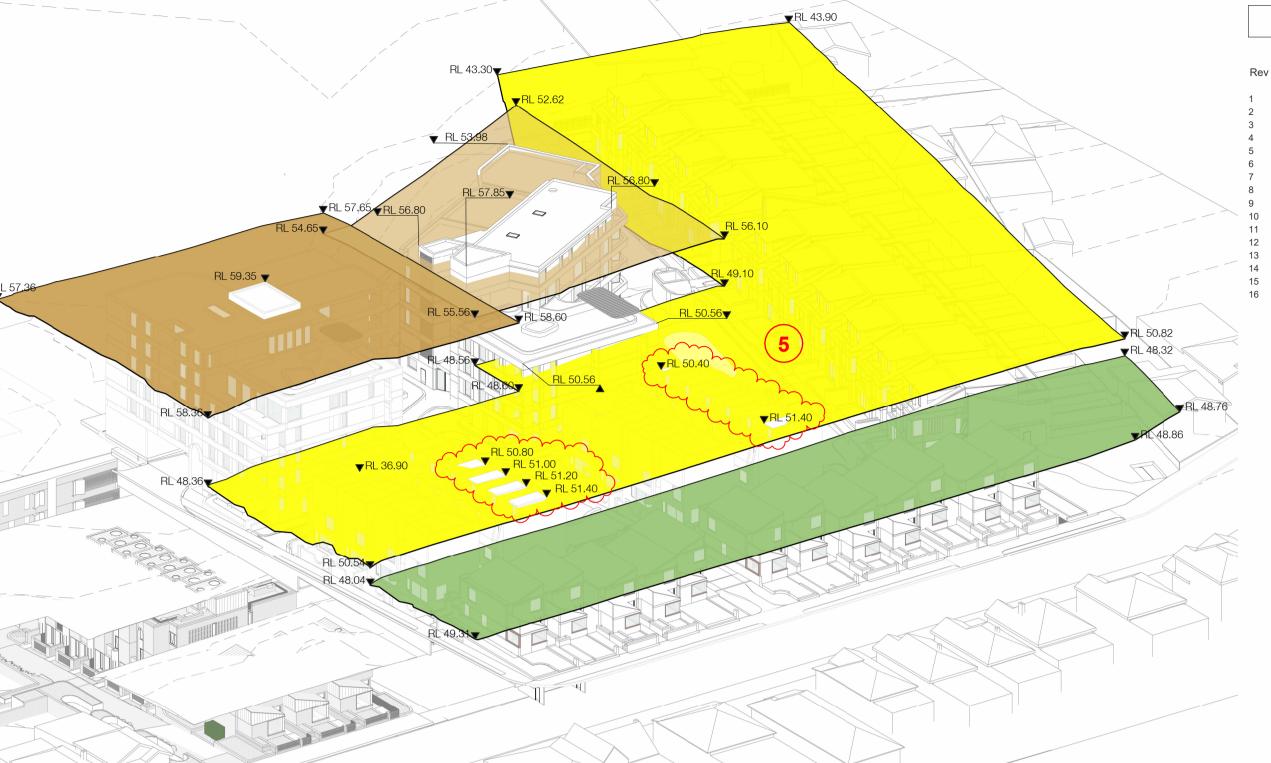

In accepting and utilising this document the recipient agrees that SJB Architecture (NSW) Pty. Ltd. ACN 081 094 724 T/A SJB Architects, retain all common law, statutory law and other rights including copyright and intellectual property rights. The recipient agrees not to use this document for any purpose other than its intended use; to waive all claims against SJB Architects resulting from unauthorised changes; or to reuse the document on other projects without the prior written consent of SJB Architects. Under no circumstances shall transfer of this document be deemed a sale. SJB Architects makes no warranties of fitness for any purpose. The Builder/Contractor shall verify job dimensions prior to any work commencing. Use figured dimensions only. Do not scale drawings.

Nominated Architects: Adam Haddow-7188 | John Pradel-7004

FOR APPROVAL

Date	Revision	Ву	C
05.05.2020	Preliminary - DA Set 20%	JS	W
18.05.2020	Preliminary - DA Set 40%	JS	W
27.08.2020	For DA	JS	W
17.03.2021	For DA - Additional Information	JS	W
15.07.2021	Issued for Section34	WG	W
16.07.2021	Issued for Planning Panel	WG	W
30.08.2021	L&EC Submission	BM	W
18.09.2021	L&EC Submission	BM	Αŀ
01.11.2023	Draft S4.55 Modification	DC	D
03.11.2023	S4.55 Modification	DC	JT
04.12.2023	Draft S4.55 Modification	DC	JT
13.12.2023	S4.55 Modification	DC	JT
06.11.2024	For Information	MF	D
11.11.2024	For Approval	MF	D
18.11.2024	For Approval	MF	D
22.05.2025	For Approval	DC	JT
		DC	

NOTE: MINOR CHANGES TO FORM AND CONFIGURATION MAY BE REQUIRED WHEN DRAWINGS ARE SUBSEQUENTLY PREPARED FOR CONSTRUCTION PURPOSES AFTER THE GRANT OF DEVELOPMENT CONSENT

LEP AXO 01



LEP AXO 02


Coronation Property

ASHBURY STAGE 2


149-163 MILTON STREET ASHBURY NSW 2193

Drawing Name

LEP Height Plane Compliance

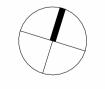


6839	DA-2910	/ 16
Job No.	Drawing No.	Revision
DC	JT	
Drawn	Chk.	
22.05.2025	As indicated	@ A1

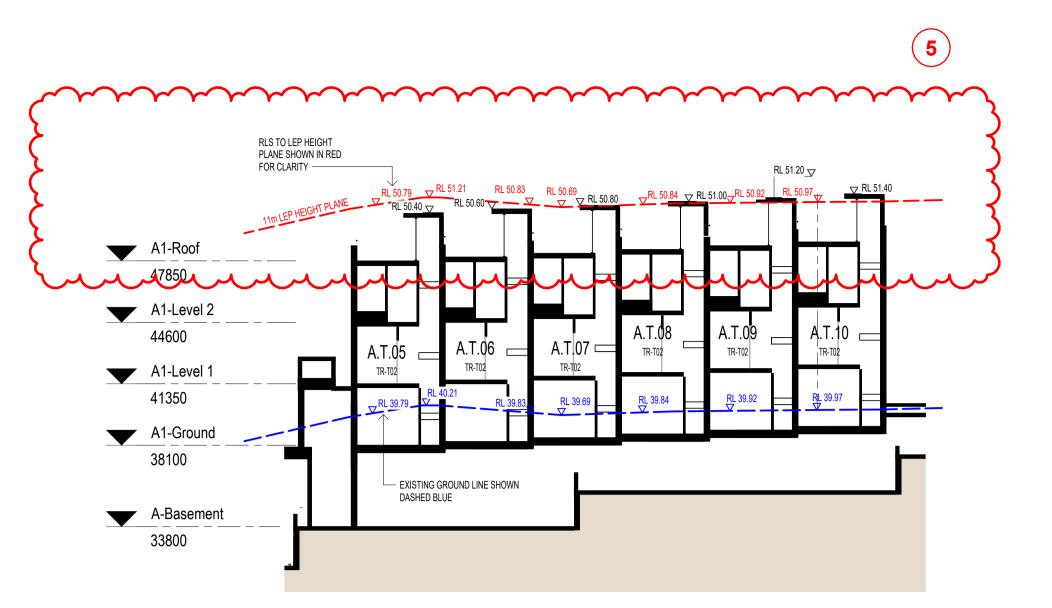


Building Height Compliance -

Building A1 1:200@A1

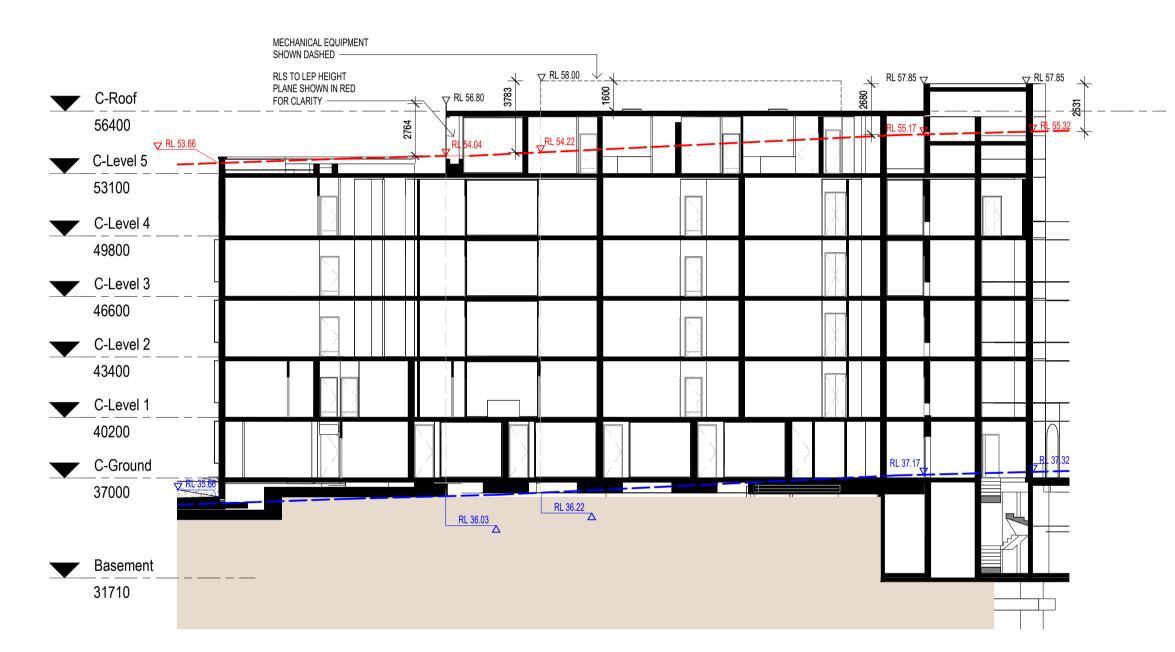


Building Height Compliance -Building C Section 1

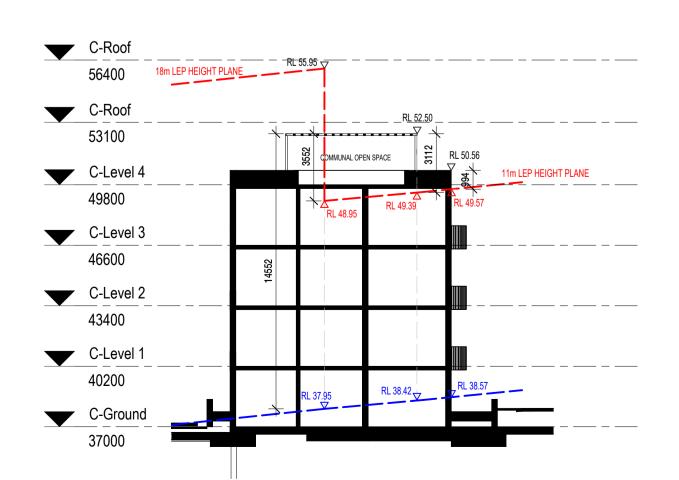

Building Height Compliance -Building C Section 3


<u>5</u> 2911 1:200@A1



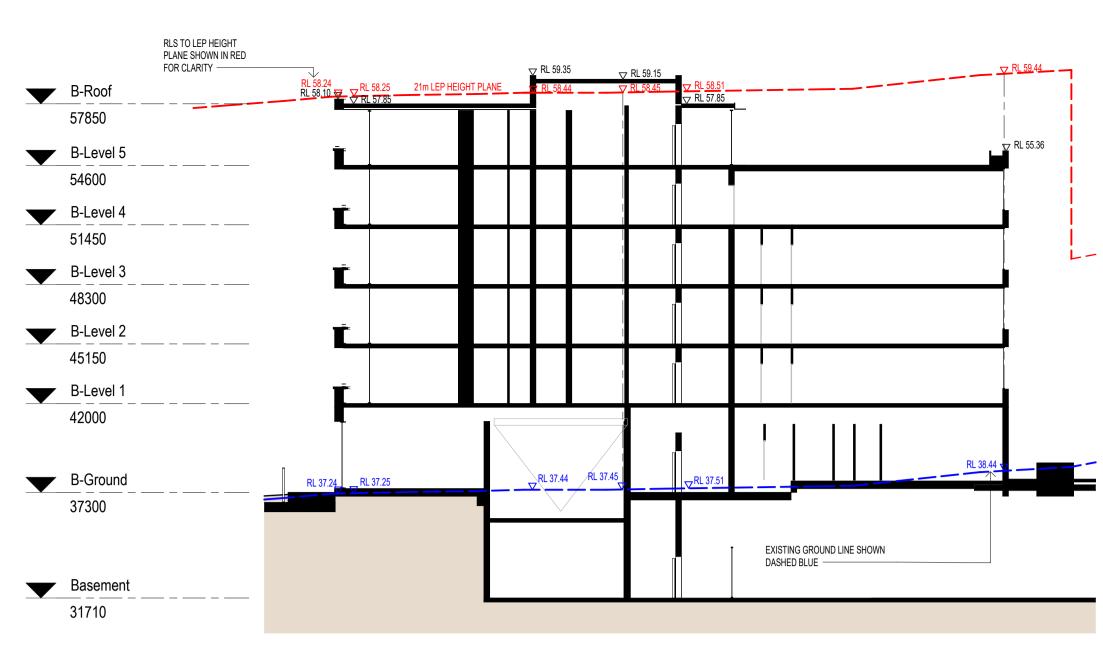

Building Height Compliance -

Building B 2 **Buildin** 1:200@A1

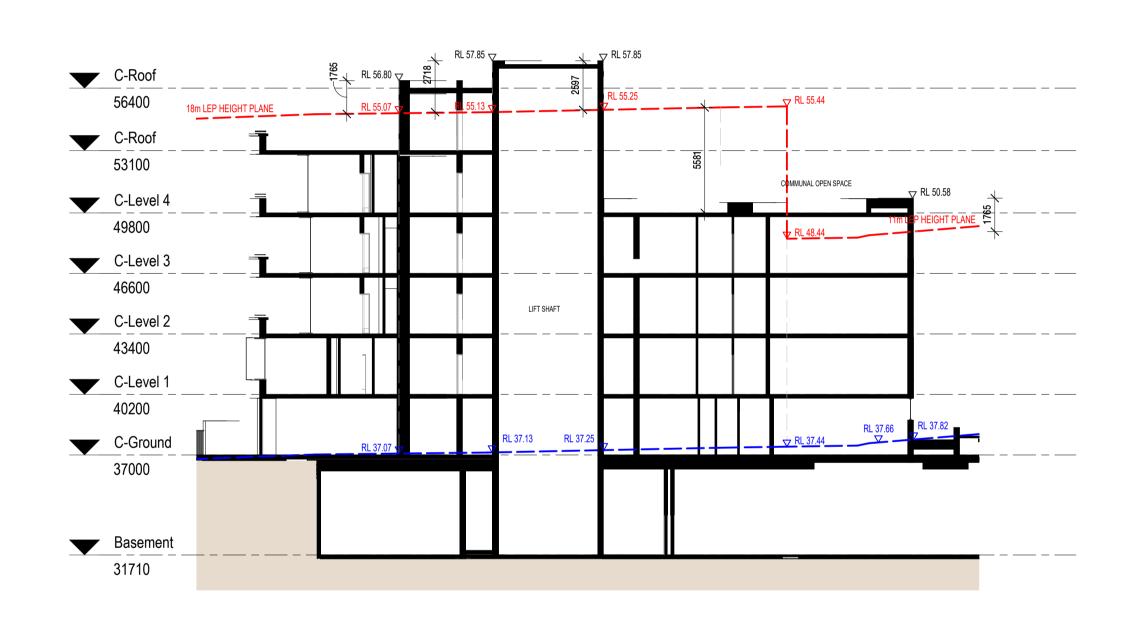

Building Height Compliance -Building C Section 2

1:200@A1

RLS TO LEP HEIGHT PLANE SHOWN IN RED FOR CLARITY -_RL 51.26_____ A2-Roof A2-Level 2 45600 A.T.02 A.T.01 TR-T01 A2-Level 1 42350 A2-Ground 39100 EXISTING GROUND LINE SHOWN DASHED BLUE A-Basement 33800

Building Height Compliance -

Building A2 <u>6</u> 2911 1:200@A1

S4.55 AMENDMENT SCHEDULE

- COMMUNAL GYM ADDED
- RESIDENTIAL BICYCLE PARKING RELOCATED MAIL/PARCEL ROOM & ASSOCIATED OPENING
- REDUCTION / RELOCATION OF PERGOLA REDESIGN OF ROOF
- SECURITY FENCING AND GATES ADDED
- REMOVAL OF SKYLIGHT
- UPDATE TO LANDSCAPE DESIGN
- REMOVAL OF ARCHITECTURAL METALWORK
- 10. BOUNDARY FENCE UPDATE

FOR APPROVAL

Nominated Architects: Adam Haddow-7188 | John Pradel-7004

By Chk. 19.02.2024 S4.55 Modification 12.03.2024 S4.55 Modification 31.05.2024 For Information 30.10.2024 For Information

In accepting and utilising this document the recipient agrees that SJB Architecture (NSW) Pty. Ltd. ACN 081 094 724 T/A SJB Architects, retain all common law, statutory law and other rights including copyright and intellectual property rights. The recipient

agrees not to use this document for any purpose other than its intended use; to waive all claims against SJB Architects resulting from unauthorised changes; or to reuse the document on other projects without the prior written consent

of SJB Architects. Under no circumstances shall transfer of this document be deemed a sale. SJB Architects makes no warranties of fitness for any purpose. The Builder/Contractor shall verify job dimensions prior to any work commencing.

Use figured dimensions only. Do not scale drawings.

06.11.2024 For Information

18.11.2024 For Information

29.11.2024 For Approval 8 22.05.2025 For Approval

Planning & Heritage Landscape Architect Arcadia Landscape Architecture **Building Certificates Australia** Services, Hydraulic & BASIX Integrated Group Services Civil & Geotech El Australia Traffic Ason Group Waste Management Elephant's Foot Waste Compactors Naturally Trees Access Consultant Vista Access Architects Client

Coronation Property

ASHBURY STAGE 2

149-163 MILTON STREET **ASHBURY NSW 2193**


Drawing Name


Building Height Compliance Sections





Date	Scale	Sheet Size
22.05.2025	As indicated	@ A1
Drawn	Chk.	
DC	JT	
Job No.	Drawing No.	Revision
6839	DA-2911	/ 8



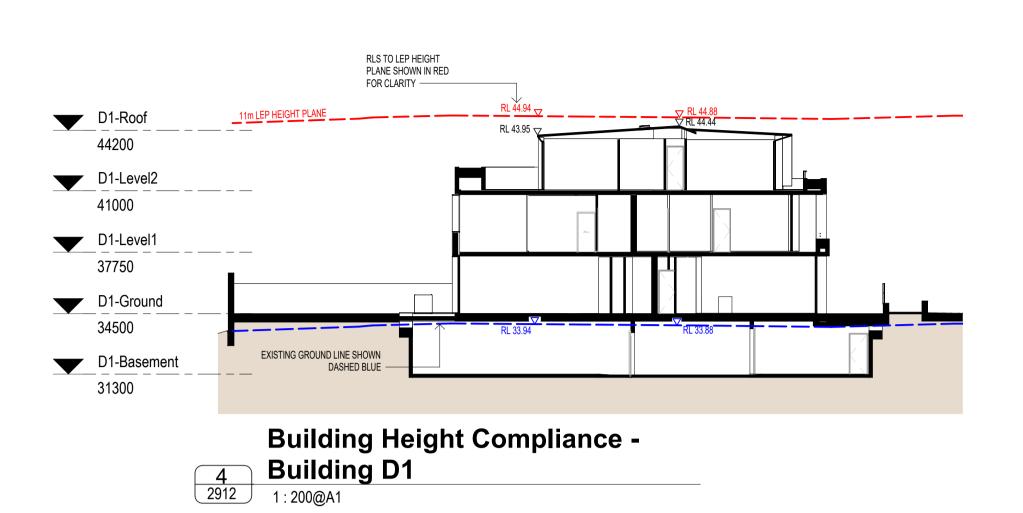

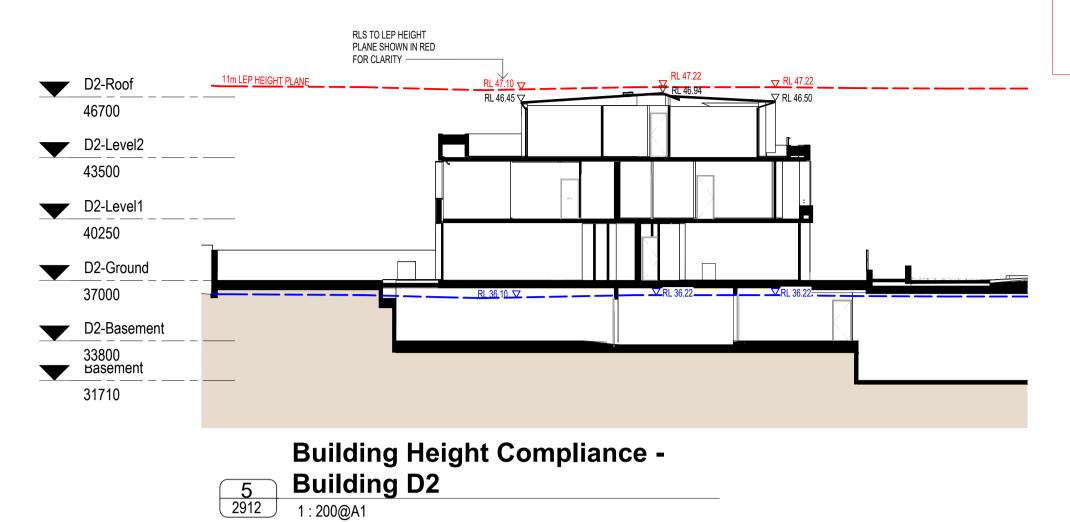

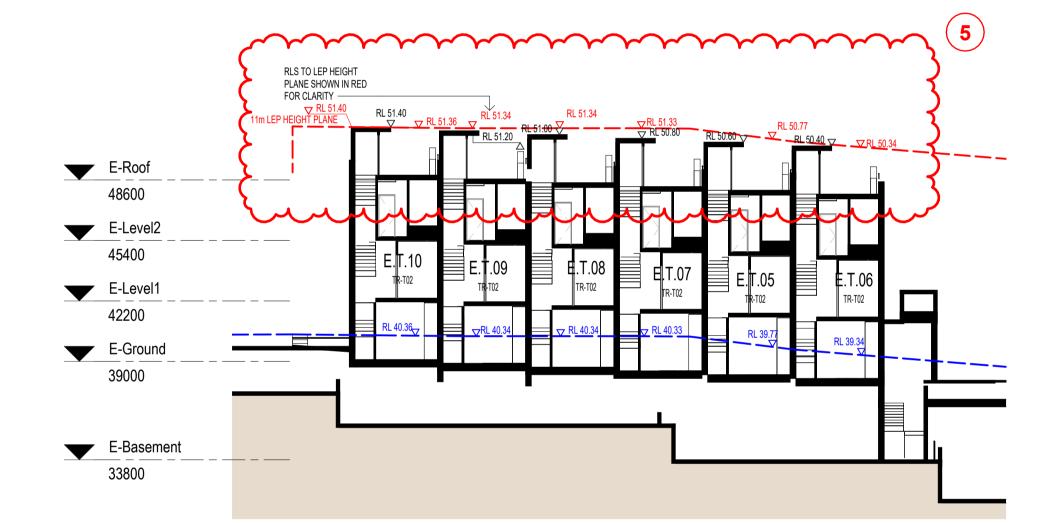


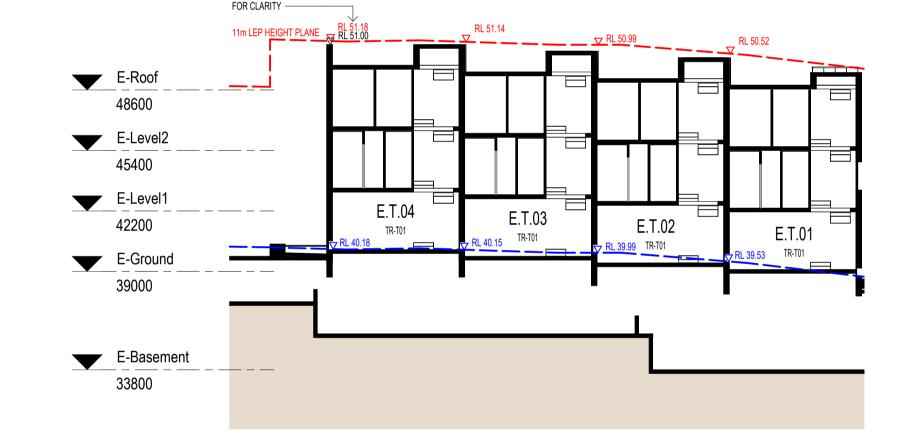

RLS TO LEP HEIGHT PLANE SHOWN IN RED

Building Height Compliance -Building E1 1:200@A1



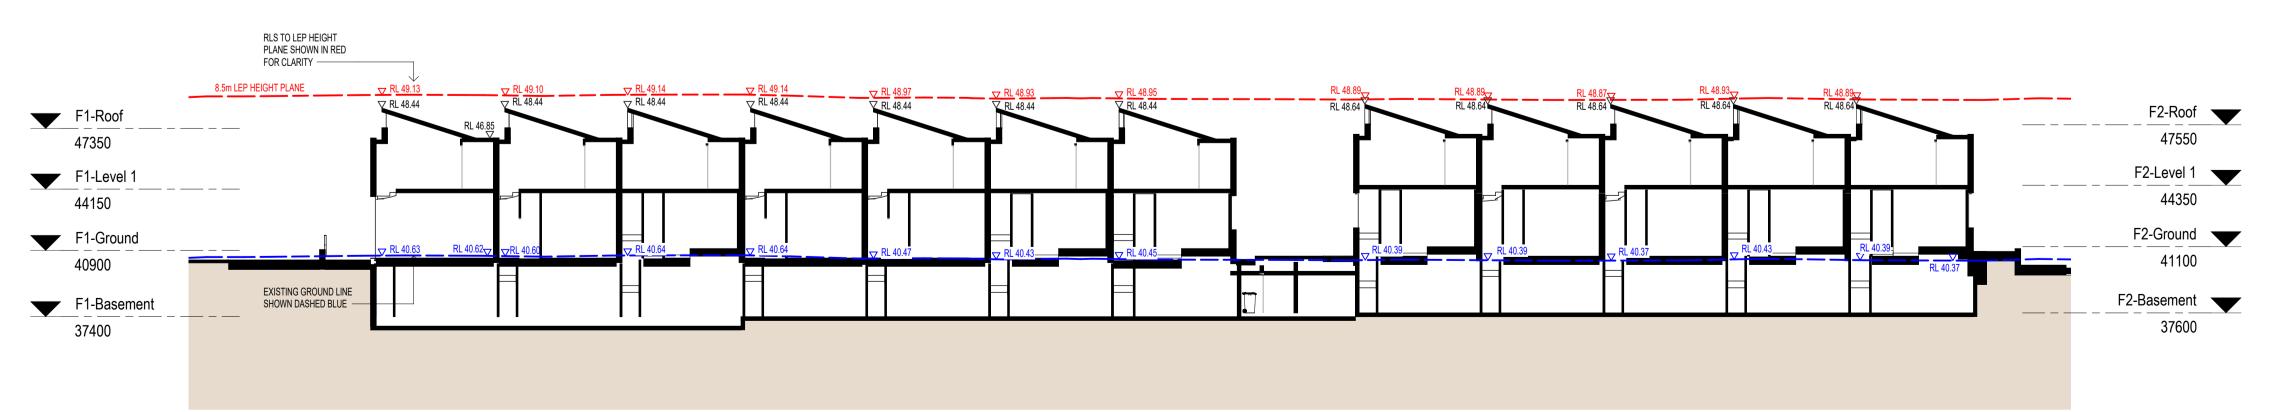

Building Height Compliance -Building F 2912 1 : 200@A1

S4.55 AMENDMENT SCHEDULE 1. COMMUNAL GYM ADDED

RESIDENTIAL BICYCLE PARKING RELOCATED MAIL/PARCEL ROOM & ASSOCIATED OPENING

REDUCTION / RELOCATION OF PERGOLA

REDESIGN OF ROOF

SECURITY FENCING AND GATES ADDED REMOVAL OF SKYLIGHT UPDATE TO LANDSCAPE DESIGN


REMOVAL OF ARCHITECTURAL METALWORK 10. BOUNDARY FENCE UPDATE

In accepting and utilising this document the recipient agrees that SJB Architecture (NSW) Pty. Ltd. ACN 081 094 724 T/A SJB Architects, retain all common law, statutory law and other rights including copyright and intellectual property rights. The recipient agrees not to use this document for any purpose other than its intended use; to waive all claims against SJB Architects resulting from unauthorised changes; or to reuse the document on other projects without the prior written consent of SJB Architects. Under no circumstances shall transfer of this document be deemed a sale. SJB Architects makes no warranties of fitness for any purpose. The Builder/Contractor shall verify job dimensions prior to any work commencing. Use figured dimensions only. Do not scale drawings.

Nominated Architects: Adam Haddow-7188 | John Pradel-7004

OR APPROVA	۱L
------------	----

٧	Date	Revision	Ву	Chk
	29.11.2024	S4.55 Modification For Approval For Approval	DC DC DC	JT JT

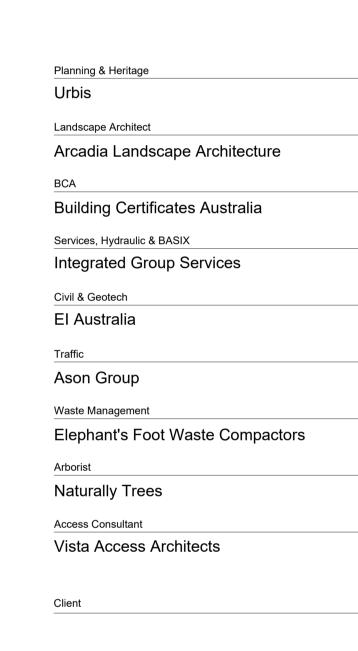


Coronation Property

ASHBURY STAGE 2

149-163 MILTON STREET ASHBURY NSW 2193

Drawing Name

Building Height Compliance Sections

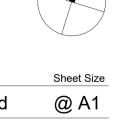

Date	Scale	Sheet Siz
22.05.2025	As indicated	@ A1
Drawn	Chk.	
DC	JT	
Job No.	Drawing No.	Revision
6839	DA-2912	/ 3

SJB Architects Level 2 490 Crown Street Surry Hills NSW 2010 Australia T 61 2 9380 9911 F 61 2 9380 9922

www.sjb.com.au



- 1. COMMUNAL GYM ADDED
- 2. RESIDENTIAL BICYCLE PARKING RELOCATED 3. MAIL/PARCEL ROOM & ASSOCIATED OPENING
- REDUCTION / RELOCATION OF PERGOLA
- REDESIGN OF ROOF
- SECURITY FENCING AND GATES ADDED
- REMOVAL OF SKYLIGHT
- 8. UPDATE TO LANDSCAPE DESIGN 9. REMOVAL OF ARCHITECTURAL METALWORK
- 10. BOUNDARY FENCE UPDATE

In accepting and utilising this document the recipient agrees that SJB Architecture (NSW) Pty. Ltd. ACN 081 094 724 T/A SJB Architects, retain all common law, statutory law and other rights including copyright and intellectual property rights. The recipient agrees not to use this document for any purpose other than its intended use; to waive all claims against SJB Architects resulting from unauthorised changes; or to reuse the document on other projects without the prior written consent of SJB Architects. Under no circumstances shall transfer of this document be deemed a sale. SJB Architects makes no warranties of fitness for any purpose. The Builder/Contractor shall verify job dimensions prior to any work commencing. Use figured dimensions only. Do not scale drawings.

Nominated Architects: Adam Haddow-7188 | John Pradel-7004

FOR APPROVAL

Date		Revision	Ву	Chk.
06.11.2024 11.11.2024 18.11.2024	For Information For Information For Approval For Approval For Approval		DC MF MF MF DC	JT DC DC DC JT



Client

Coronation Property

ASHBURY STAGE 2

149-163 MILTON STREET ASHBURY NSW 2193

Drawing Name

View From Sun (Winter Solstice)

Date	Scale	Sheet Size
22.05.2025	1 : 300	@ A1
Drawn	Chk.	
DC	JT	
Job No.	Drawing No.	Revision
6839	DA-3041	/ 5




- 1. COMMUNAL GYM ADDED
- 2. RESIDENTIAL BICYCLE PARKING RELOCATED 3. MAIL/PARCEL ROOM & ASSOCIATED OPENING ADDED
- 4. REDUCTION / RELOCATION OF PERGOLA
 - REDESIGN OF ROOF
- 6. SECURITY FENCING AND GATES ADDED 7. REMOVAL OF SKYLIGHT
- 8. UPDATE TO LANDSCAPE DESIGN
- 9. REMOVAL OF ARCHITECTURAL METALWORK 10. BOUNDARY FENCE UPDATE

In accepting and utilising this document the recipient agrees that SJB Architecture (NSW) Pty. Ltd. ACN 081 094 724 T/A SJB Architects, retain all common law, statutory law and other rights including copyright and intellectual property rights. The recipient agrees not to use this document for any purpose other than its intended use; to waive all claims against SJB Architects resulting from unauthorised changes; or to reuse the document on other projects without the prior written consent of SJB Architects. Under no circumstances shall transfer of this document be deemed a sale. SJB Architects makes no warranties of fitness for any purpose. The Builder/Contractor shall verify job dimensions prior to any work commencing. Use figured dimensions only. Do not scale drawings.

Nominated Architects: Adam Haddow-7188 | John Pradel-7004

FOR APPROVAL

	Chk
06.11.2024 For Information MF 11.11.2024 For Approval MF 18.11.2024 For Approval MF	JT DC DC DC JT

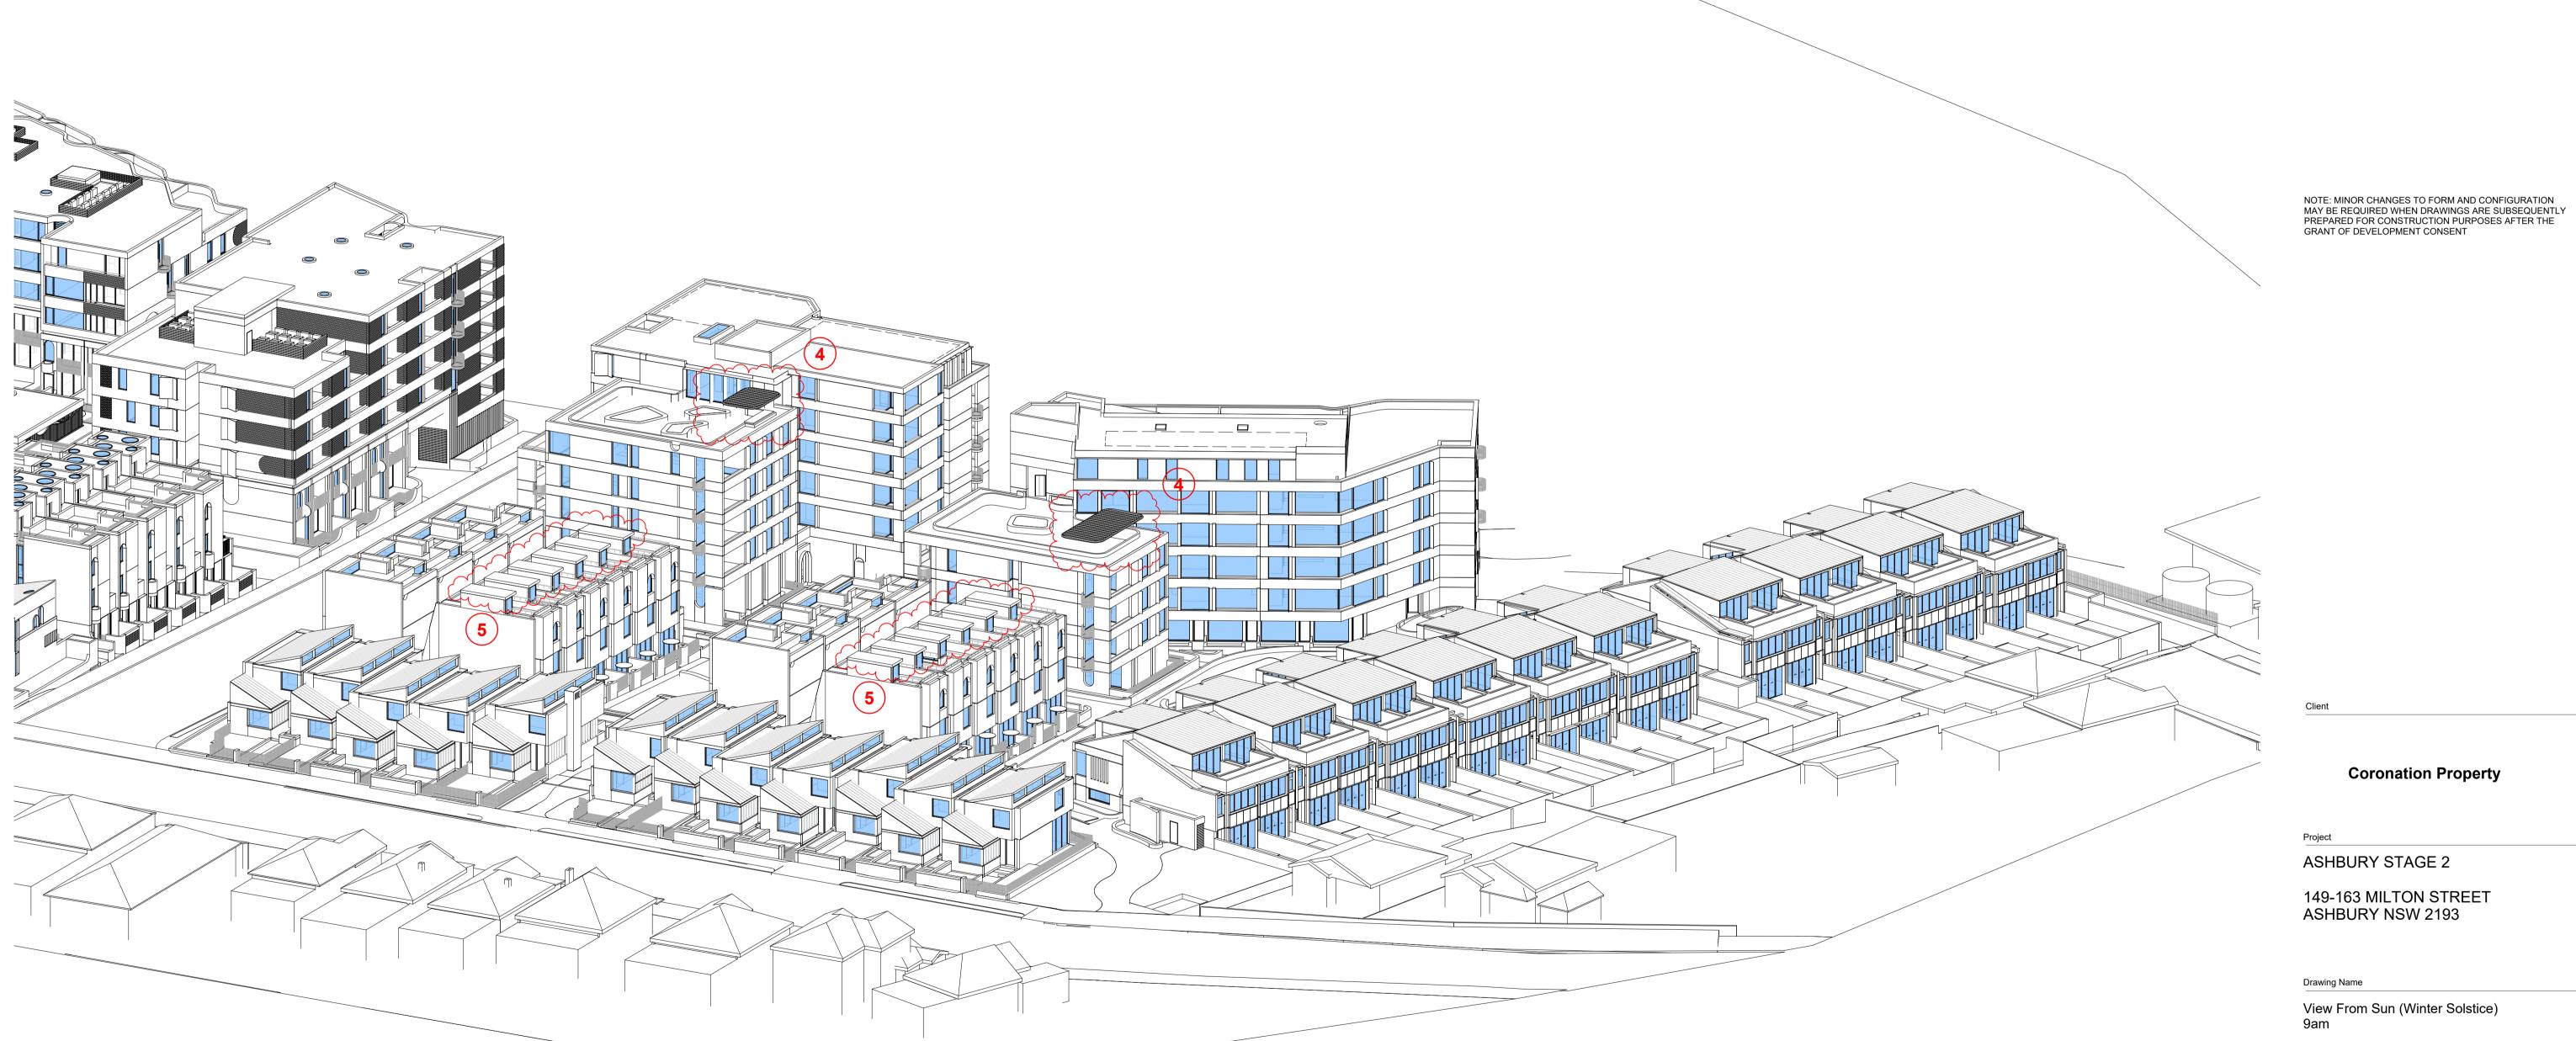

Coronation Property

ASHBURY STAGE 2

149-163 MILTON STREET ASHBURY NSW 2193

Drawing Name

View From Sun (Winter Solstice)

Scale	Sheet Size
1:300	@ A1
Chk.	
JT	
Drawing No.	Revision
DA-3042	/ 5
	1:300 Chk.




- 1. COMMUNAL GYM ADDED
- 2. RESIDENTIAL BICYCLE PARKING RELOCATED 3. MAIL/PARCEL ROOM & ASSOCIATED OPENING
- ADDED 4. REDUCTION / RELOCATION OF PERGOLA
- REDESIGN OF ROOF
- SECURITY FENCING AND GATES ADDED
- 7. REMOVAL OF SKYLIGHT
- 8. UPDATE TO LANDSCAPE DESIGN 9. REMOVAL OF ARCHITECTURAL METALWORK 10. BOUNDARY FENCE UPDATE
- Nominated Architects: Adam Haddow-7188 | John Pradel-7004

5 22.05.2025 For Approval

FOR APPROVAL

In accepting and utilising this document the recipient agrees that SJB Architecture (NSW) Pty. Ltd. ACN 081 094 724 T/A SJB Architects, retain all common law, statutory law and other rights including copyright and intellectual property rights. The recipient agrees not to use this document for any purpose other than its intended use; to waive all claims against SJB Architects resulting from unauthorised changes; or to reuse the document on other projects without the prior written consent of SJB Architects. Under no circumstances shall transfer of this document be deemed a sale. SJB Architects makes no warranties of fitness for any purpose. The Builder/Contractor shall verify job dimensions prior to any work commencing. Use figured dimensions only. Do not scale drawings.

Rev	Date		Revision	Ву	Chk
2 3	06.11.2024 11.11.2024	For Information For Information For Approval For Approval		DC MF MF MF	JT DC DC DC

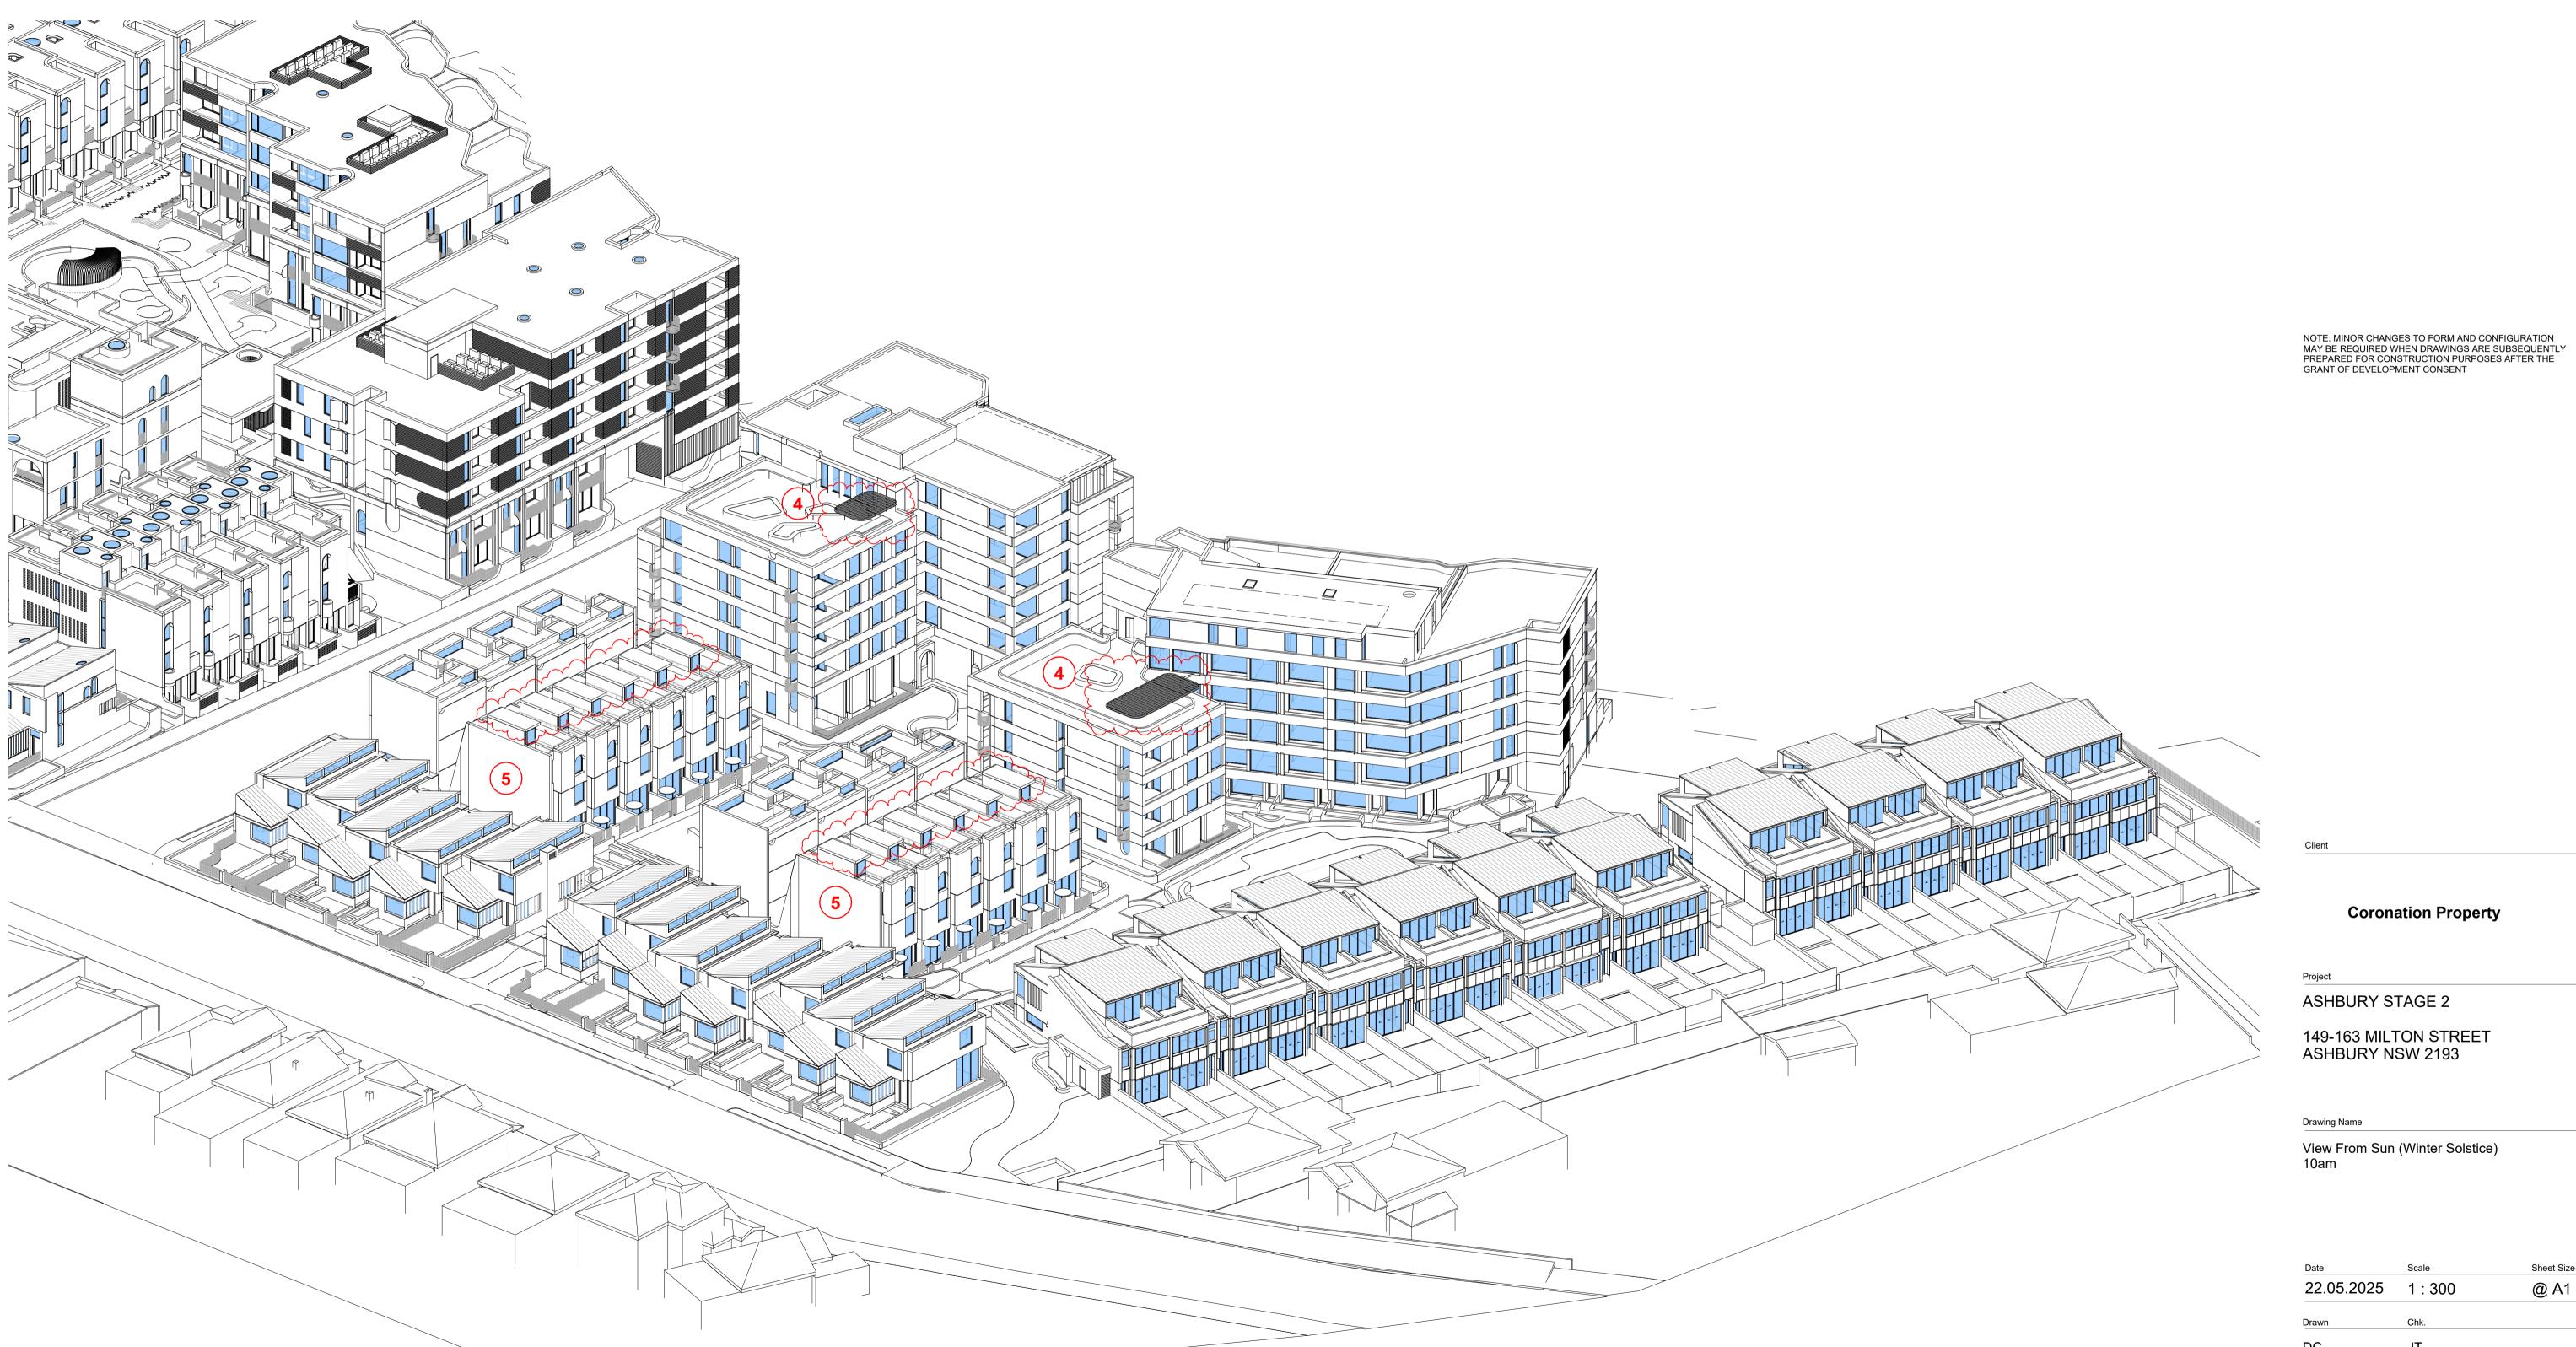

Coronation Property

ASHBURY STAGE 2

149-163 MILTON STREET ASHBURY NSW 2193

Drawing Name

View From Sun (Winter Solstice)

6839	DA-3043	/ 5
Job No.	Drawing No.	Revision
DC	JT	
Drawn	Chk.	
22.05.2025	1 : 300	@ A1
Date	Scale	Sheet Size




- 1. COMMUNAL GYM ADDED
- RESIDENTIAL BICYCLE PARKING RELOCATED 3. MAIL/PARCEL ROOM & ASSOCIATED OPENING
- ADDED REDUCTION / RELOCATION OF PERGOLA
- REDESIGN OF ROOF
- SECURITY FENCING AND GATES ADDED
- REMOVAL OF SKYLIGHT
- 8. UPDATE TO LANDSCAPE DESIGN
- REMOVAL OF ARCHITECTURAL METALWORK 10. BOUNDARY FENCE UPDATE

In accepting and utilising this document the recipient agrees that SJB Architecture (NSW) Pty. Ltd. ACN 081 094 724 T/A SJB Architects, retain all common law, statutory law and other rights including copyright and intellectual property rights. The recipient agrees not to use this document for any purpose other than its intended use; to waive all claims against SJB Architects resulting from unauthorised changes; or to reuse the document on other projects without the prior written consent of SJB Architects. Under no circumstances shall transfer of this document be deemed a sale. SJB Architects makes no warranties of fitness for any purpose. The Builder/Contractor shall verify job dimensions prior to any work commencing. Use figured dimensions only. Do not scale drawings.

Nominated Architects: Adam Haddow-7188 | John Pradel-7004

FOR APPROVAL

Date		Revision	Ву	С
06.11.2024 11.11.2024 18.11.2024	For Information For Information For Approval For Approval For Approval		DC MF MF MF DC	JT DC DC DC

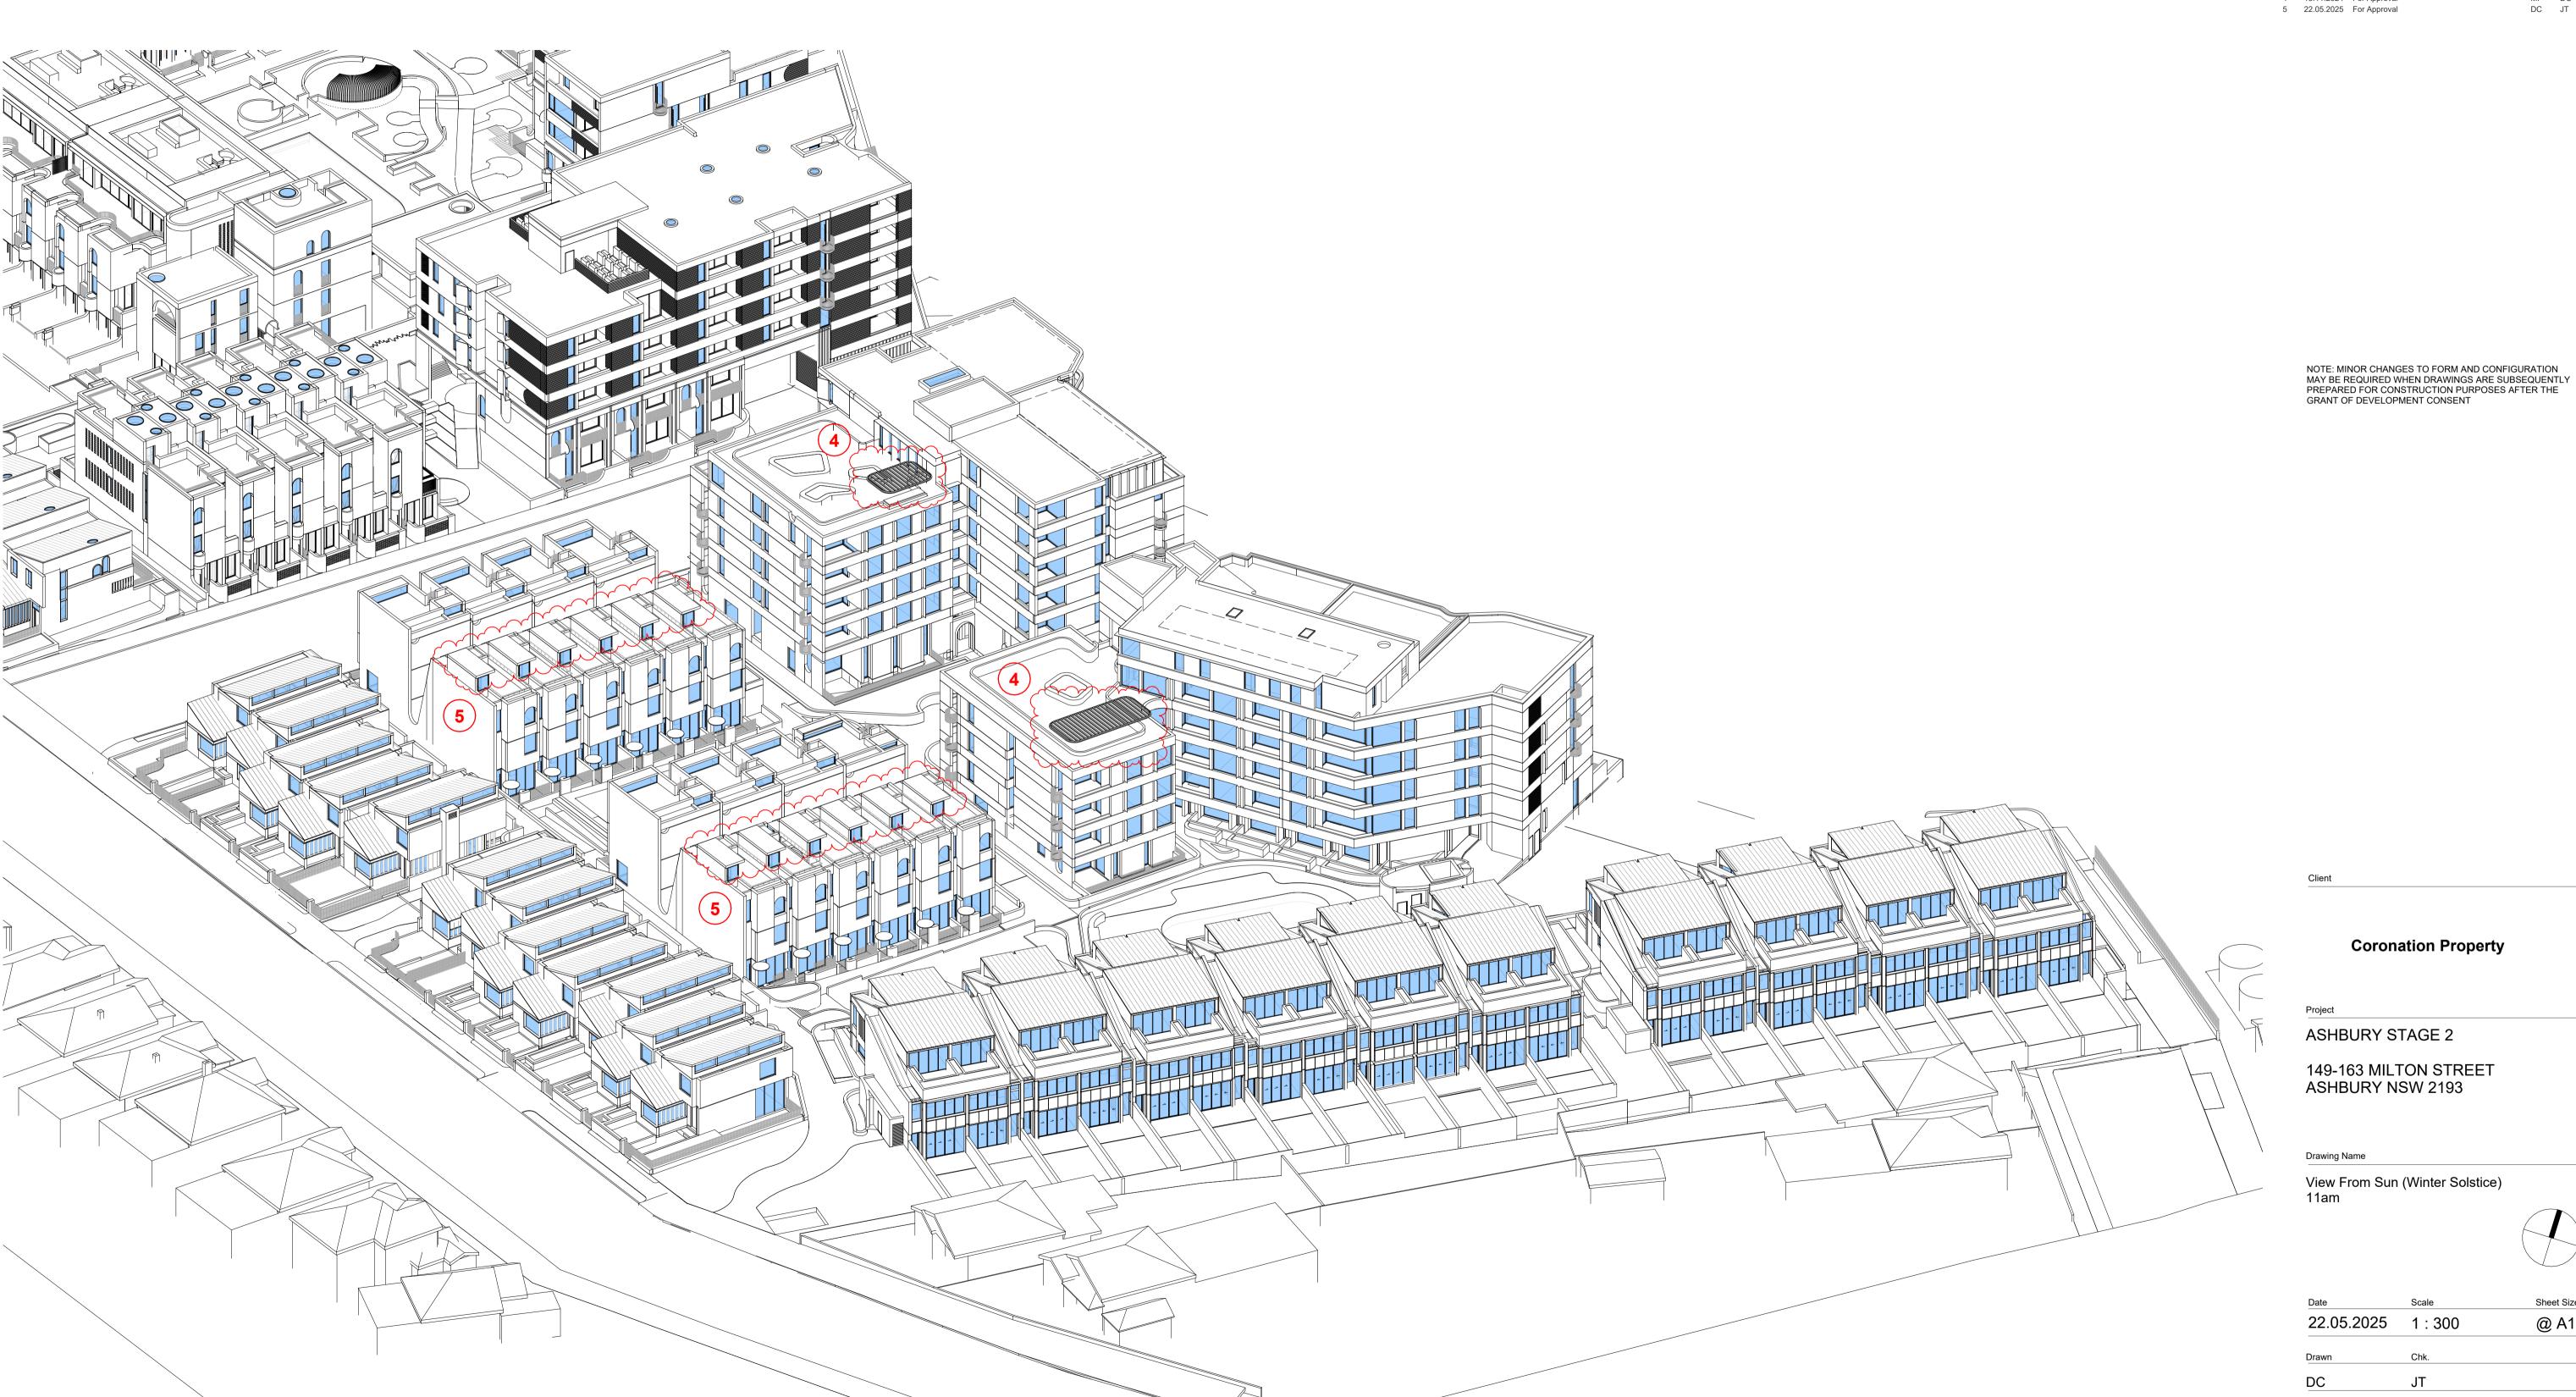

Coronation Property

ASHBURY STAGE 2

149-163 MILTON STREET ASHBURY NSW 2193

Drawing Name

View From Sun (Winter Solstice) 11am

Date	Scale	Sheet Size
22.05.2025	1 : 300	@ A1
Drawn	Chk.	
DC	JT	

6839 DA-3044 / 5

490 Crown Street Surry Hills NSW 2010 Australia T 61 2 9380 9911 F 61 2 9380 9922 www.sjb.com.au

- 1. COMMUNAL GYM ADDED
- RESIDENTIAL BICYCLE PARKING RELOCATED 3. MAIL/PARCEL ROOM & ASSOCIATED OPENING
- REDUCTION / RELOCATION OF PERGOLA
- REDESIGN OF ROOF
- SECURITY FENCING AND GATES ADDED
- REMOVAL OF SKYLIGHT
- UPDATE TO LANDSCAPE DESIGN
- REMOVAL OF ARCHITECTURAL METALWORK 10. BOUNDARY FENCE UPDATE

In accepting and utilising this document the recipient agrees that SJB Architecture (NSW) Pty. Ltd. ACN 081 094 724 T/A SJB Architects, retain all common law, statutory law and other rights including copyright and intellectual property rights. The recipient agrees not to use this document for any purpose other than its intended use; to waive all claims against SJB Architects resulting from unauthorised changes; or to reuse the document on other projects without the prior written consent of SJB Architects. Under no circumstances shall transfer of this document be deemed a sale. SJB Architects makes no warranties of fitness for any purpose. The Builder/Contractor shall verify job dimensions prior to any work commencing. Use figured dimensions only. Do not scale drawings.

Nominated Architects: Adam Haddow-7188 | John Pradel-7004

FOR APPROVAL

Date		Revision	Ву	Chk
.11.2024 .11.2024 .11.2024	For Information For Information For Approval For Approval For Approval		DC MF MF MF DC	JT DC DC DC JT

NOTE: MINOR CHANGES TO FORM AND CONFIGURATION MAY BE REQUIRED WHEN DRAWINGS ARE SUBSEQUENTLY PREPARED FOR CONSTRUCTION PURPOSES AFTER THE

GRANT OF DEVELOPMENT CONSENT



Coronation Property

ASHBURY STAGE 2

149-163 MILTON STREET ASHBURY NSW 2193

Drawing Name

View From Sun (Winter Solstice)

6839	DA-3045	/ 5
Job No.	Drawing No.	Revision
DC	JT	
Drawn	Chk.	
22.05.2025	1:300	@ A1
Date	Scale	Sheet Siz

SJB Architects

490 Crown Street Surry Hills NSW 2010 Australia T 61 2 9380 9911 F 61 2 9380 9922 www.sjb.com.au

- 1. COMMUNAL GYM ADDED
- RESIDENTIAL BICYCLE PARKING RELOCATED 3. MAIL/PARCEL ROOM & ASSOCIATED OPENING
- ADDED REDUCTION / RELOCATION OF PERGOLA
- REDESIGN OF ROOF
- SECURITY FENCING AND GATES ADDED
- REMOVAL OF SKYLIGHT
- UPDATE TO LANDSCAPE DESIGN
- REMOVAL OF ARCHITECTURAL METALWORK 10. BOUNDARY FENCE UPDATE

In accepting and utilising this document the recipient agrees that SJB Architecture (NSW) Pty. Ltd. ACN 081 094 724 T/A SJB Architects, retain all common law, statutory law and other rights including copyright and intellectual property rights. The recipient agrees not to use this document for any purpose other than its intended use; to waive all claims against SJB Architects resulting from unauthorised changes; or to reuse the document on other projects without the prior written consent of SJB Architects. Under no circumstances shall transfer of this document be deemed a sale. SJB Architects makes no warranties of fitness for any purpose. The Builder/Contractor shall verify job dimensions prior to any work commencing. Use figured dimensions only. Do not scale drawings.

Nominated Architects: Adam Haddow-7188 | John Pradel-7004

FOR	APP	ROVAL

Date	1	Revision	Ву	Chk.
6.11.2024 1.11.2024 3.11.2024	For Information For Information For Approval For Approval For Approval		DC MF MF MF DC	JT DC DC DC JT



Coronation Property

ASHBURY STAGE 2

149-163 MILTON STREET ASHBURY NSW 2193

Drawing Name

View From Sun (Winter Solstice)

Date	Scale	Sheet Size
22.05.2025	1:300	@ A1
Drawn	Chk.	
DC	JT	
Job No.	Drawing No.	Revision

SJB Architects 490 Crown Street Surry Hills NSW 2010 Australia

T 61 2 9380 9911 F 61 2 9380 9922 www.sjb.com.au



DA-3046 / 5

- 1. COMMUNAL GYM ADDED
- 2. RESIDENTIAL BICYCLE PARKING RELOCATED 3. MAIL/PARCEL ROOM & ASSOCIATED OPENING
- REDUCTION / RELOCATION OF PERGOLA
- REDESIGN OF ROOF
- SECURITY FENCING AND GATES ADDED REMOVAL OF SKYLIGHT
- 8. UPDATE TO LANDSCAPE DESIGN
- 9. REMOVAL OF ARCHITECTURAL METALWORK 10. BOUNDARY FENCE UPDATE


In accepting and utilising this document the recipient agrees that SJB Architecture (NSW) Pty. Ltd. ACN 081 094 724 T/A SJB Architects, retain all common law, statutory law and other rights including copyright and intellectual property rights. The recipient agrees not to use this document for any purpose other than its intended use; to waive all claims against SJB Architects resulting from unauthorised changes; or to reuse the document on other projects without the prior written consent of SJB Architects. Under no circumstances shall transfer of this document be deemed a sale. SJB Architects makes no warranties of fitness for any purpose. The Builder/Contractor shall verify job dimensions prior to any work commencing. Use figured dimensions only. Do not scale drawings.

Nominated Architects: Adam Haddow-7188 | John Pradel-7004

FOR APPROVAL

٧	Date		Revision	Ву	Chk
	06.11.2024 11.11.2024 18.11.2024	For Information For Information For Approval For Approval For Approval		DC MF MF MF DC	JT DC DC DC JT

NOTE: MINOR CHANGES TO FORM AND CONFIGURATION MAY BE REQUIRED WHEN DRAWINGS ARE SUBSEQUENTLY PREPARED FOR CONSTRUCTION PURPOSES AFTER THE GRANT OF DEVELOPMENT CONSENT

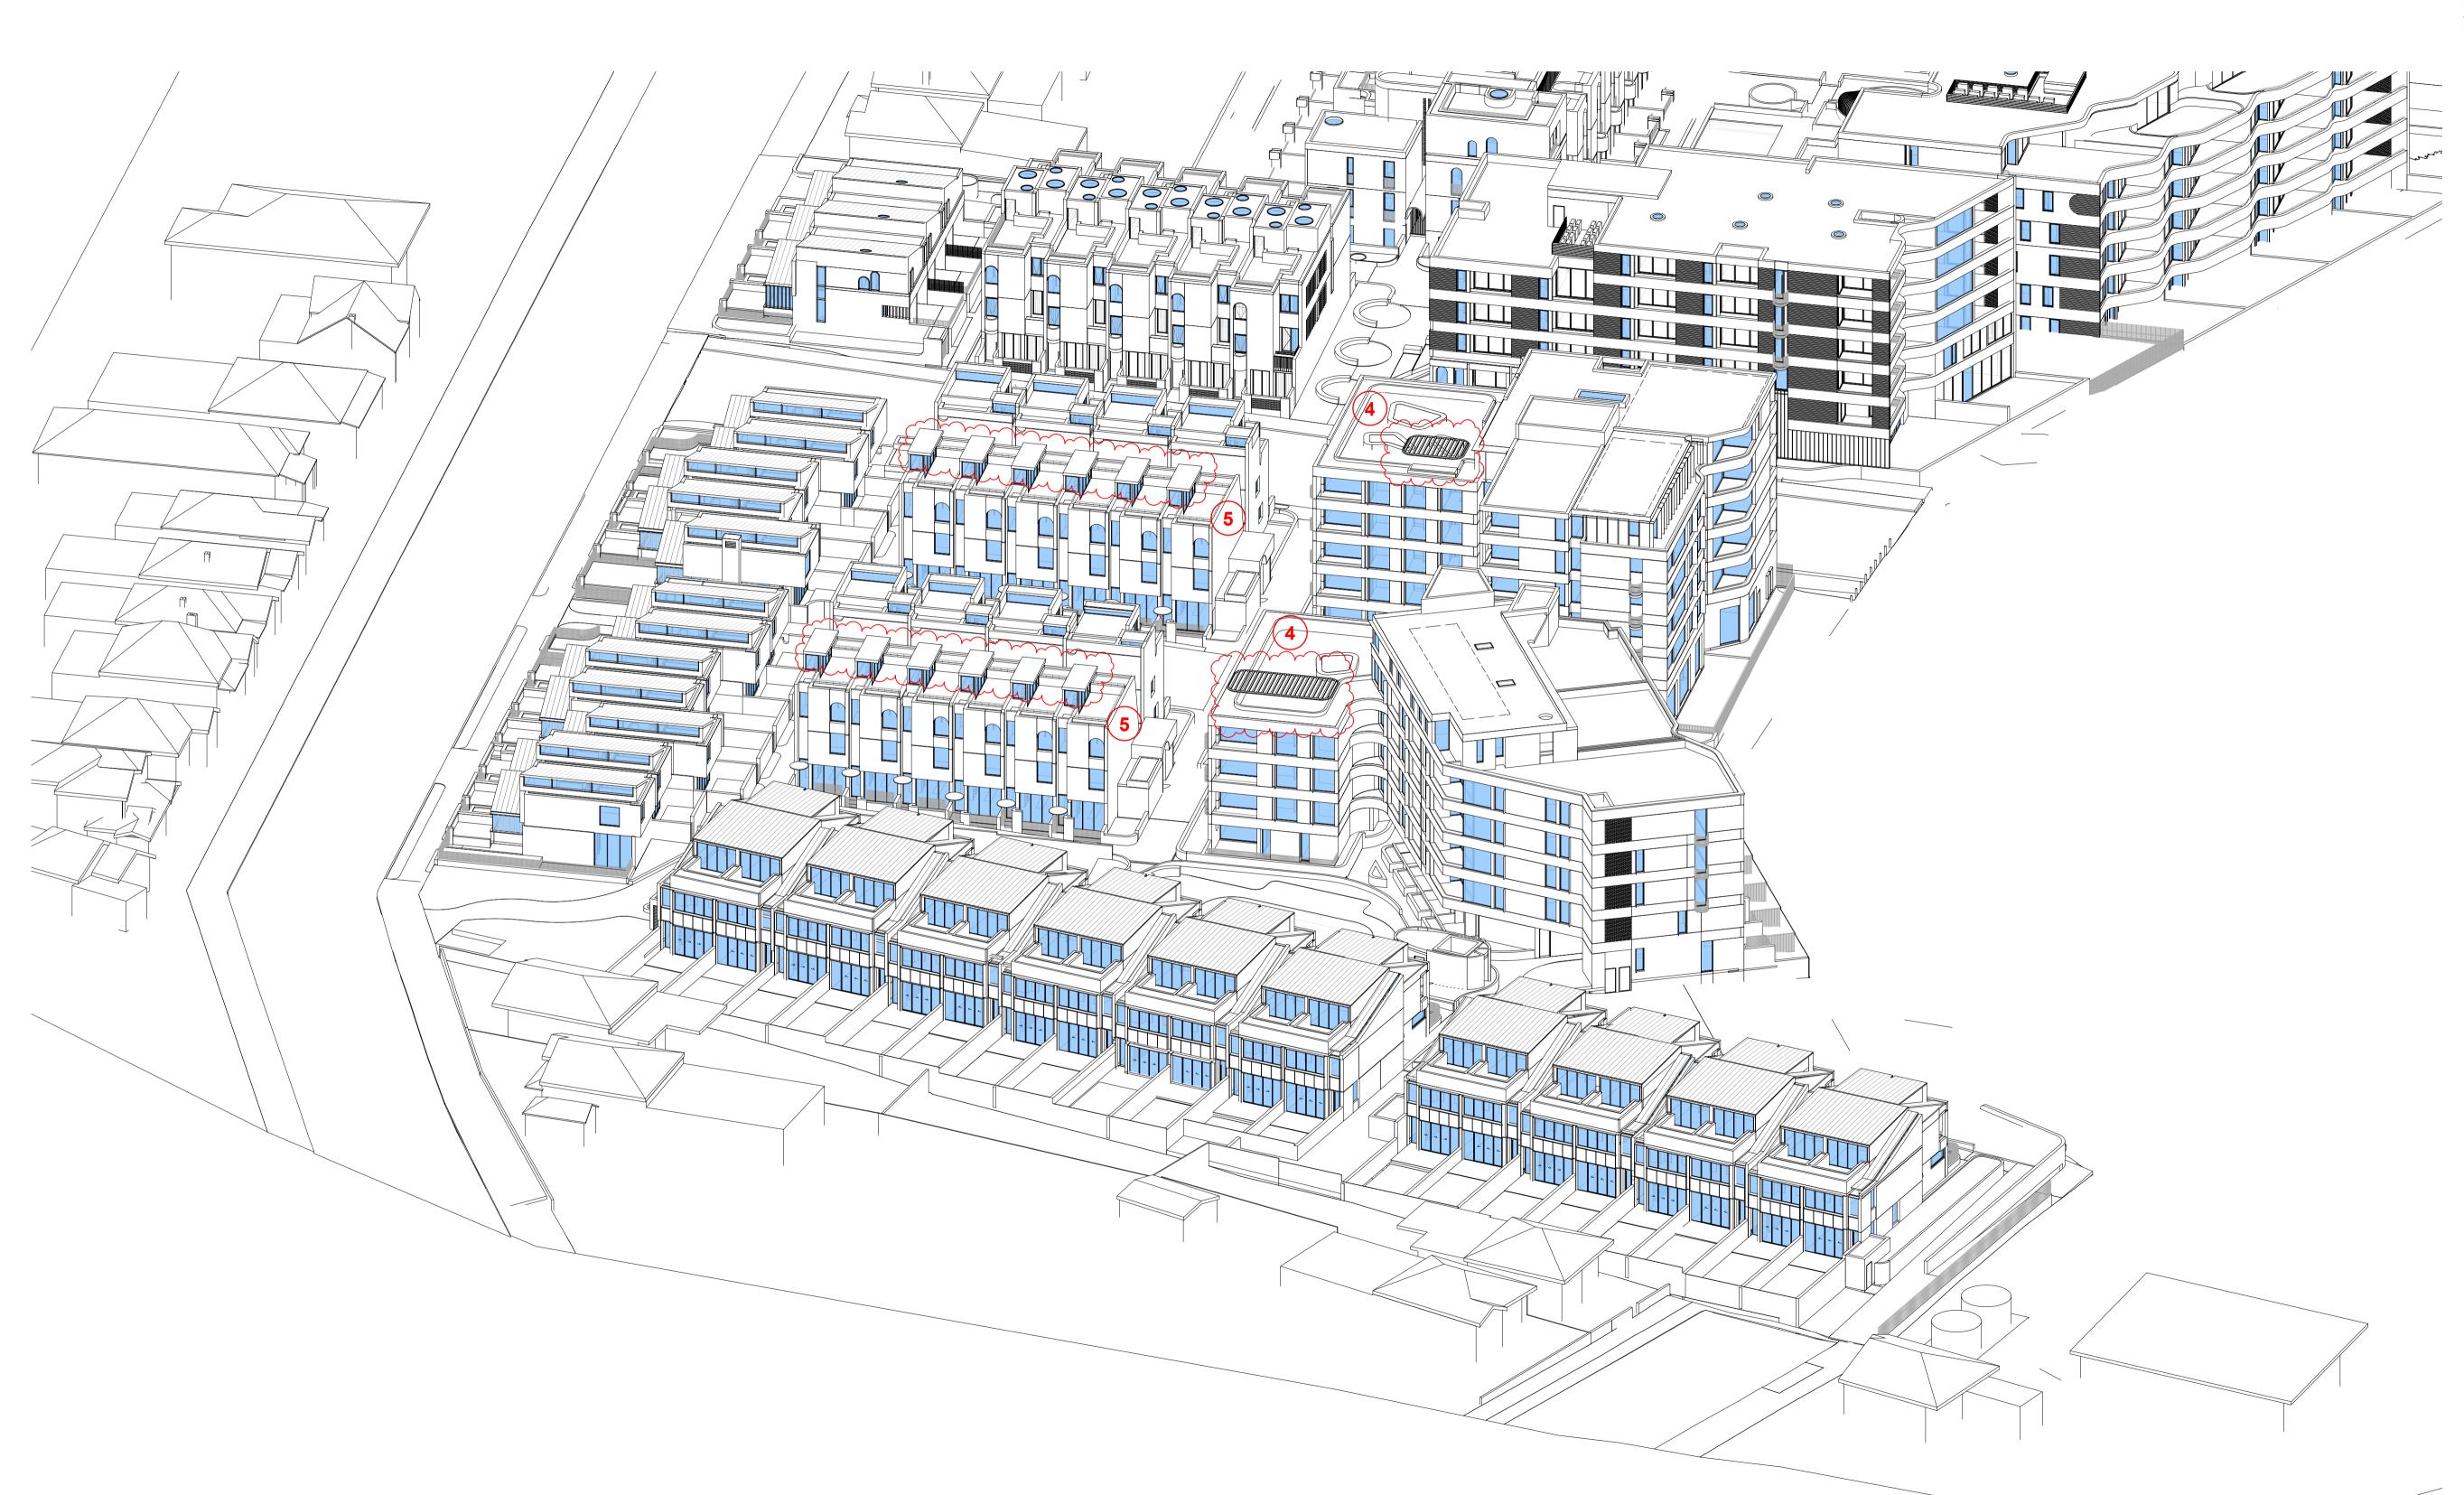

Coronation Property

ASHBURY STAGE 2

149-163 MILTON STREET ASHBURY NSW 2193

Drawing Name

View From Sun (Winter Solstice)

6839	DA-3047	/ 5
Job No.	Drawing No.	Revision
DC	JT	
Drawn	Chk.	
22.05.2025	1 : 300	@ A
Date	Scale	Sheet Si



- 1. COMMUNAL GYM ADDED
- RESIDENTIAL BICYCLE PARKING RELOCATED
 MAIL/PARCEL ROOM & ASSOCIATED OPENING
- ADDED


 4. REDUCTION / RELOCATION OF PERGOLA
- REDESIGN OF ROOF
- 6. SECURITY FENCING AND GATES ADDED
- 7. REMOVAL OF SKYLIGHT
 - UPDATE TO LANDSCAPE DESIGN
- 9. REMOVAL OF ARCHITECTURAL METALWORK10. BOUNDARY FENCE UPDATE

In accepting and utilising this document the recipient agrees that SJB Architecture (NSW) Pty. Ltd. ACN 081 094 724 T/A SJB Architects, retain all common law, statutory law and other rights including copyright and intellectual property rights. The recipient agrees not to use this document for any purpose other than its intended use; to waive all claims against SJB Architects resulting from unauthorised changes; or to reuse the document on other projects without the prior written consent of SJB Architects. Under no circumstances shall transfer of this document be deemed a sale. SJB Architects makes no warranties of fitness for any purpose. The Builder/Contractor shall verify job dimensions prior to any work commencing. Use figured dimensions only. Do not scale drawings.

Nominated Architects: Adam Haddow-7188 | John Pradel-7004

FOR APPROVAL

Date	Revision	n By	Chk
.11.2024 .11.2024 .11.2024		DC MF MF MF DC	JT DC DC DC JT

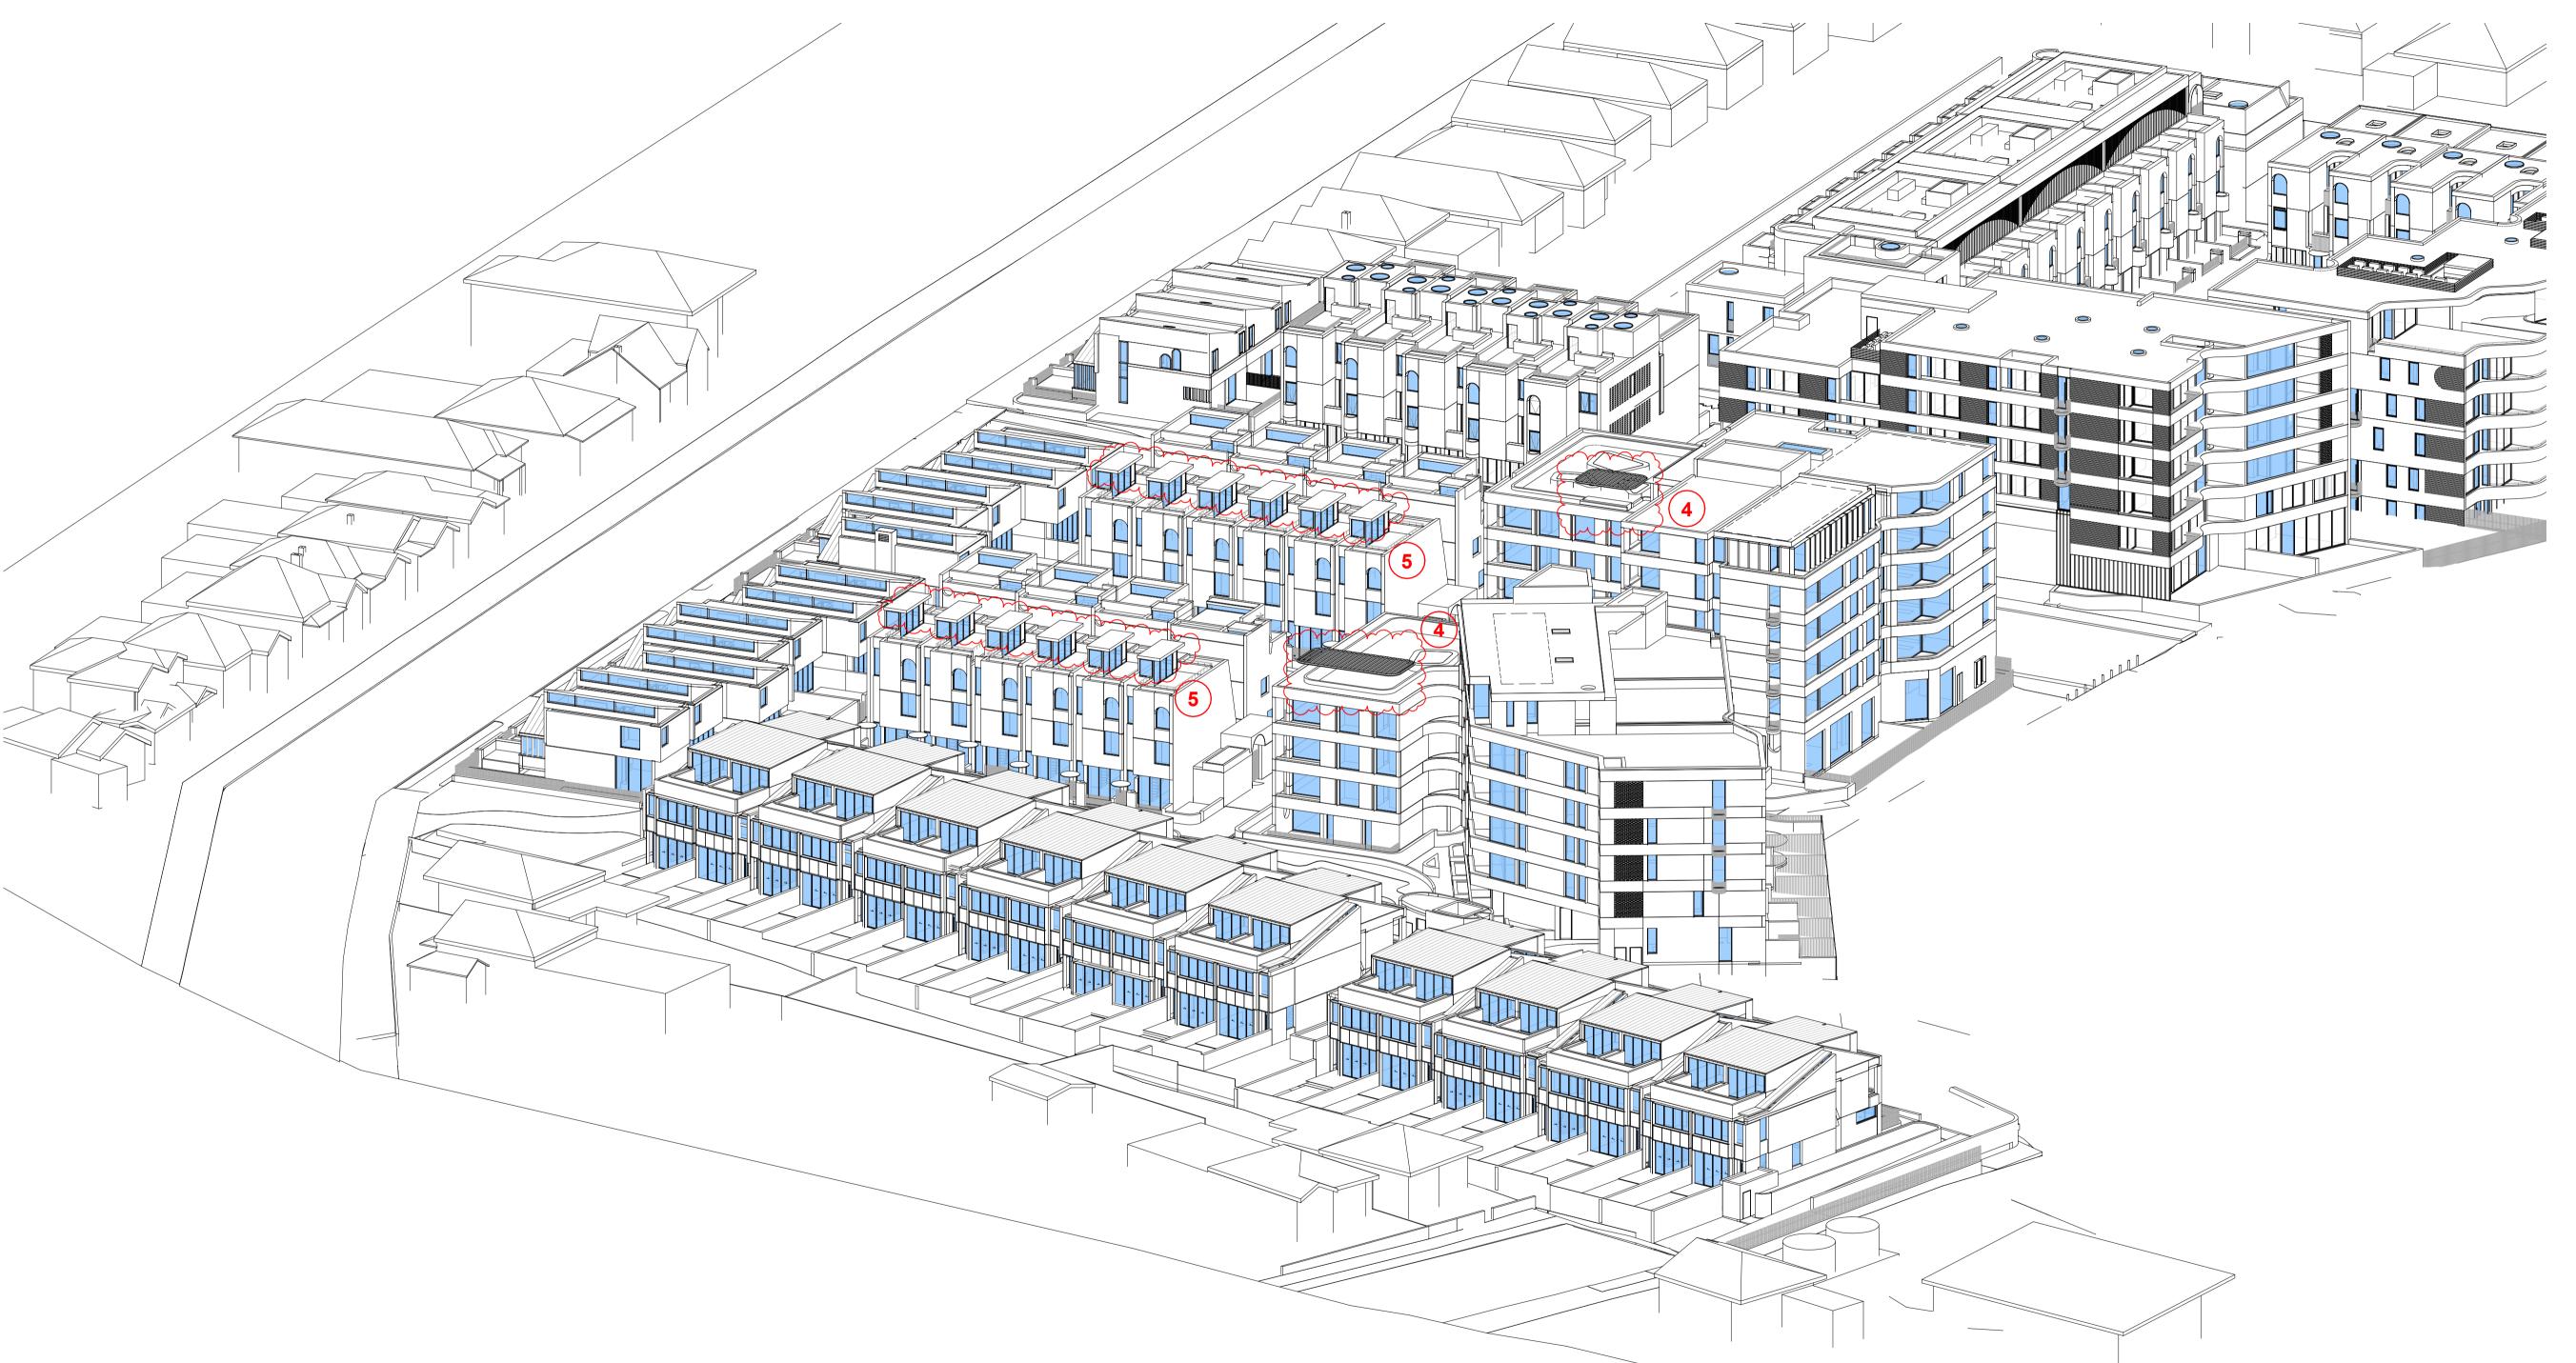

NOTE: MINOR CHANGES TO FORM AND CONFIGURATION MAY BE REQUIRED WHEN DRAWINGS ARE SUBSEQUENTLY PREPARED FOR CONSTRUCTION PURPOSES AFTER THE GRANT OF DEVELOPMENT CONSENT

Cli

Coronation Property


Project

ASHBURY STAGE 2

149-163 MILTON STREET ASHBURY NSW 2193

Drawing Name

View From Sun (Winter Solstice) 3pm

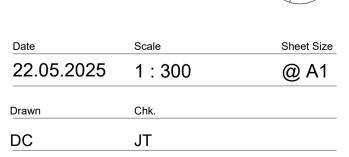

Drawing No. Revision DA-3048 / 5


- 1. COMMUNAL GYM ADDED
- 2. RESIDENTIAL BICYCLE PARKING RELOCATED 3. MAIL/PARCEL ROOM & ASSOCIATED OPENING ADDED
- REDUCTION / RELOCATION OF PERGOLA
- REDESIGN OF ROOF
- SECURITY FENCING AND GATES ADDED REMOVAL OF SKYLIGHT
- 8. UPDATE TO LANDSCAPE DESIGN
- 9. REMOVAL OF ARCHITECTURAL METALWORK 10. BOUNDARY FENCE UPDATE

In accepting and utilising this document the recipient agrees that SJB Architecture (NSW) Pty. Ltd. ACN 081 094 724 T/A SJB Architects, retain all common law, statutory law and other rights including copyright and intellectual property rights. The recipient agrees not to use this document for any purpose other than its intended use; to waive all claims against SJB Architects resulting from unauthorised changes; or to reuse the document on other projects without the prior written consent of SJB Architects. Under no circumstances shall transfer of this document be deemed a sale. SJB Architects makes no warranties of fitness for any purpose. The Builder/Contractor shall verify job dimensions prior to any work commencing. Use figured dimensions only. Do not scale drawings.

Nominated Architects: Adam Haddow-7188 | John Pradel-7004

FOR APPROVAL

Date	I	Revision	Ву	Chk
.11.2024 .11.2024 .11.2024	For Information For Information For Approval For Approval For Approval		DC MF MF MF DC	JT DC DC DC DC JT

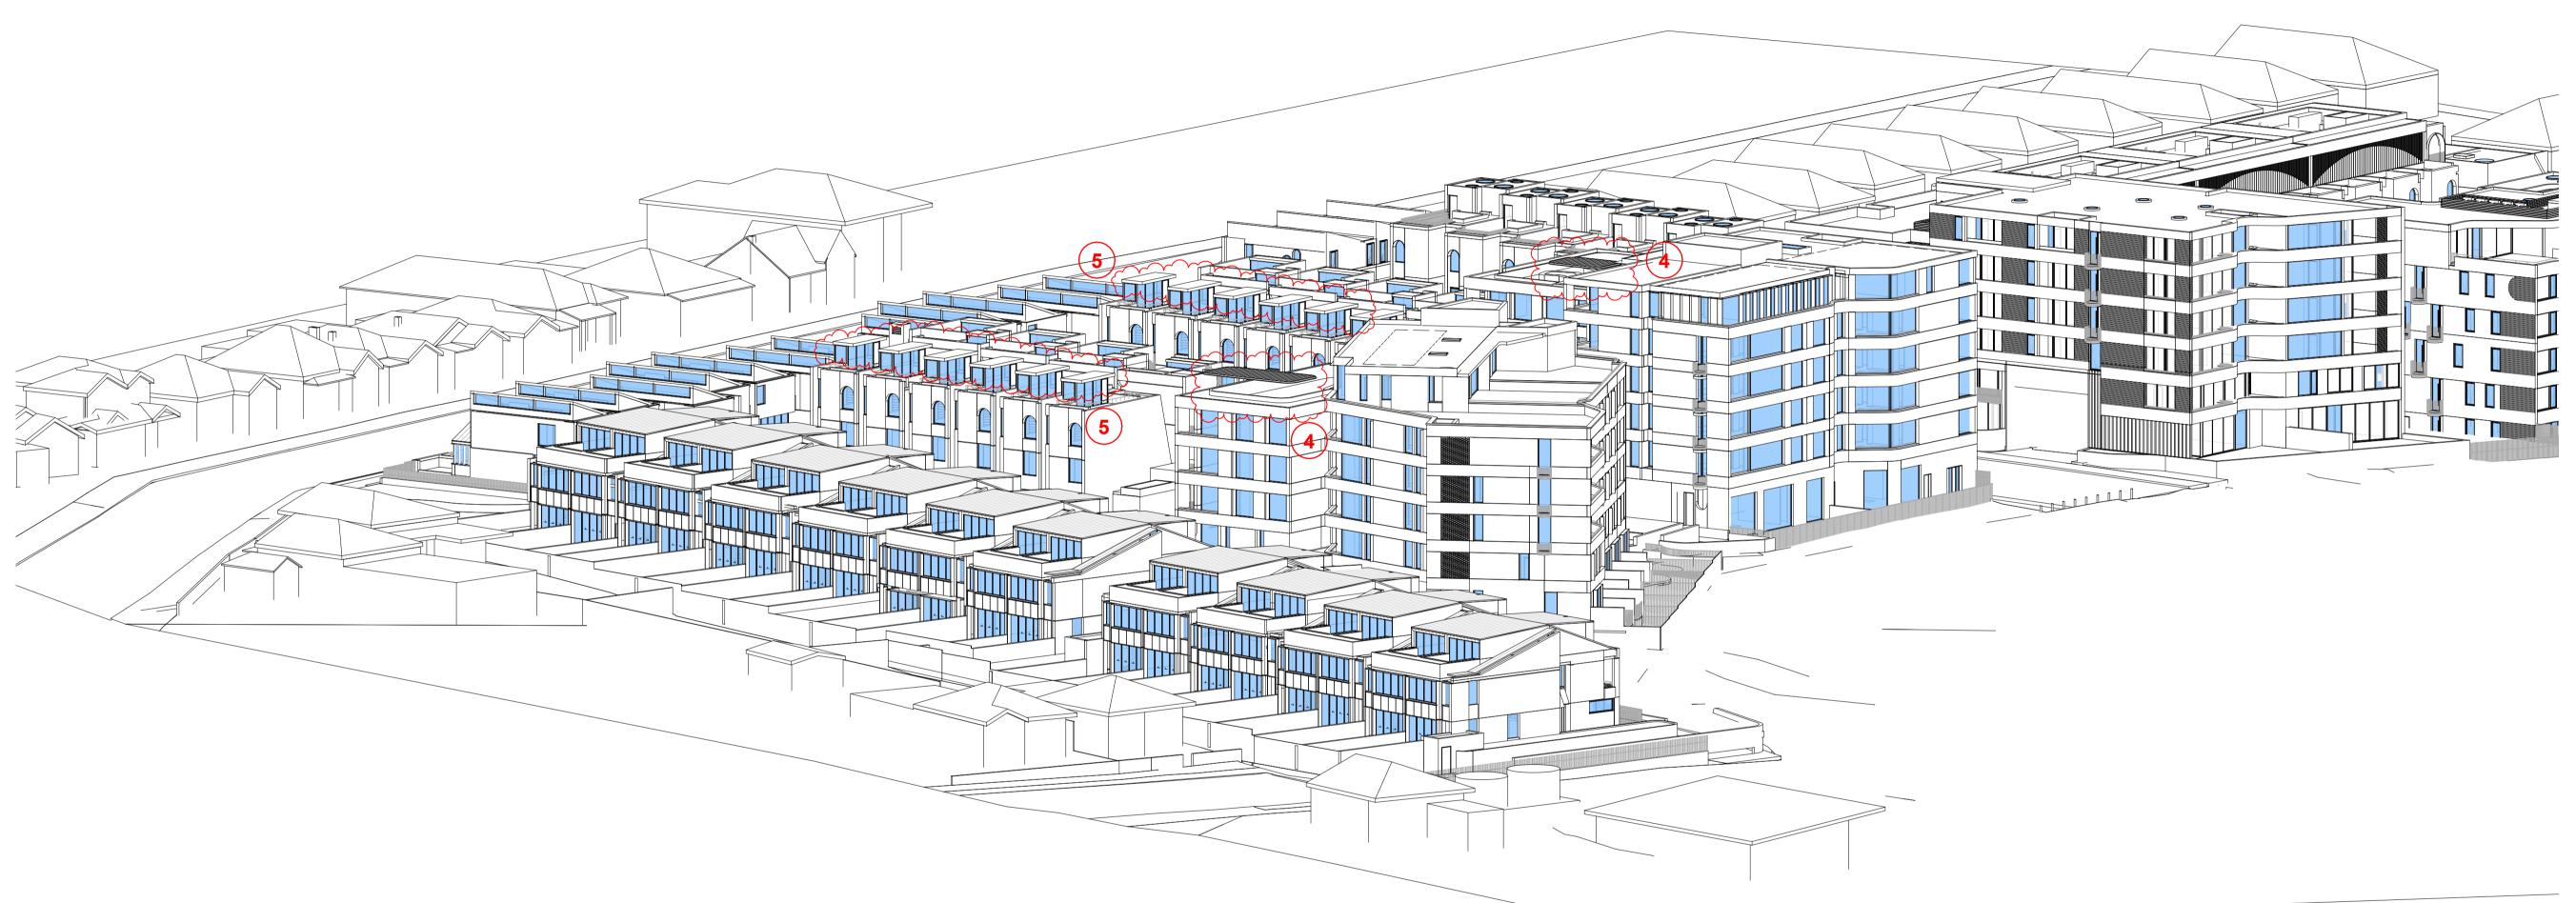

NOTE: MINOR CHANGES TO FORM AND CONFIGURATION MAY BE REQUIRED WHEN DRAWINGS ARE SUBSEQUENTLY PREPARED FOR CONSTRUCTION PURPOSES AFTER THE GRANT OF DEVELOPMENT CONSENT

Client


Coronation Property

ASHBURY STAGE 2

149-163 MILTON STREET ASHBURY NSW 2193


Drawing Name

View From Sun (Winter Solstice) 4pm

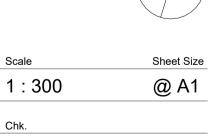

6839	DA-3049	/ 5
Job No.	Drawing No.	Revision
DC	JT	
Drawn	Chk.	
22.05.2025	1:300	@ A1
Date	Scale	Sheet Siz



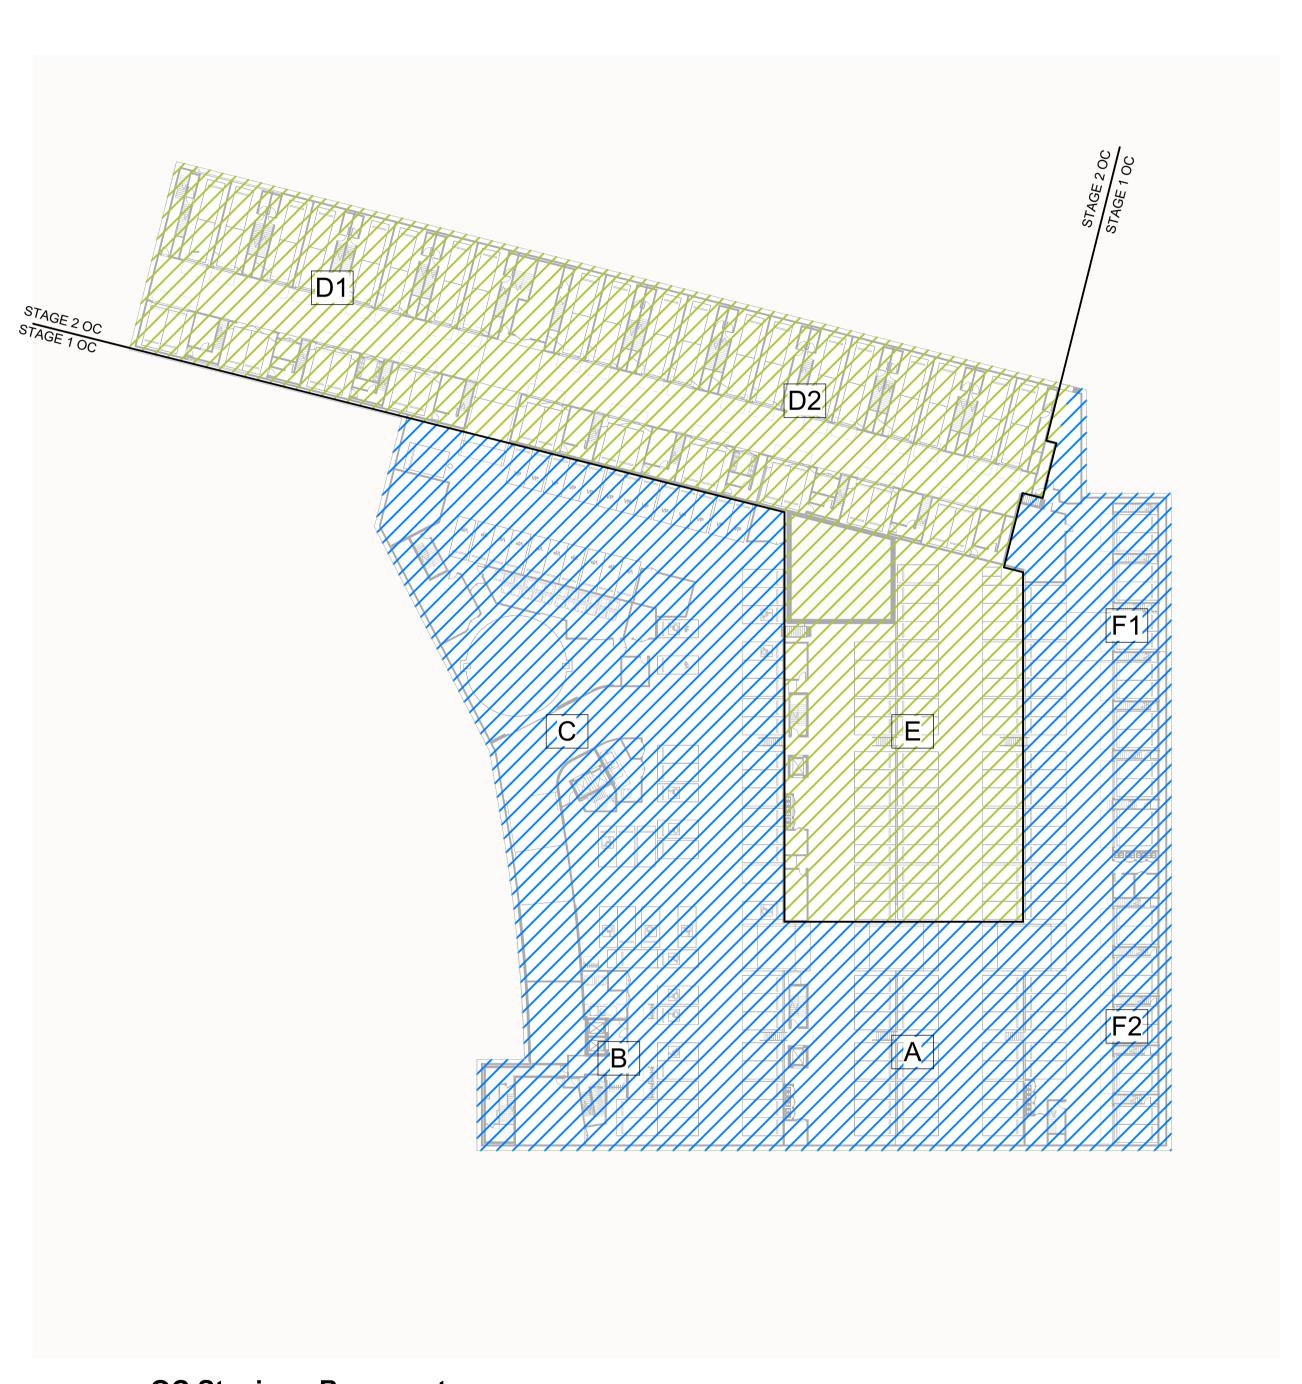



OC Staging - Basement

OC Staging - Level 0 Ground

In accepting and utilising this document the recipient agrees that SJB Architecture (NSW) Pty. Ltd. ACN 081 094 724 T/A SJB Architects, retain all common law, statutory law and other rights including copyright and intellectual property rights. The recipient agrees not to use this document for any purpose other than its intended use; to waive all claims against SJB Architects resulting from unauthorised changes; or to reuse the document on other projects without the prior written consent of SJB Architects. Under no circumstances shall transfer of this document be deemed a sale. SJB Architects makes no warranties of fitness for any purpose. The Builder/Contractor shall verify job dimensions prior to any work commencing. Use figured dimensions only. Do not scale drawings.

Nominated Architects: Adam Haddow-7188 | John Pradel-7004

FOR INFORMATION

RevDateRevisionByChk.122.05.2025For ApprovalDCJT

NOTE: MINOR CHANGES TO FORM AND CONFIGURATION MAY BE REQUIRED WHEN DRAWINGS ARE SUBSEQUENTLY PREPARED FOR CONSTRUCTION PURPOSES AFTER THE GRANT OF DEVELOPMENT CONSENT

Planning & Heritage

Urbis

Landscape Architect

Arcadia Landscape Architecture

BCA

Building Certificates Australia

Integrated Group Services

megratea ereap ee.

Services, Hydraulic & BASIX

El Australia

Civil & Geotech

Traffic

Ason Group

Waste Management

Elephant's Foot Waste Compactors

Naturally Trees

Access Consultant

Jensen Hughes

Cli

Coronation Property

Project

ASHBURY STAGE 2

149-163 MILTON STREET ASHBURY NSW 2193

Drawing Name

OC Staging Diagram



6839	DA-9950	/ 1
Job No.	Drawing No.	Revision
DC	JT	
Drawn	Chk.	
22.05.2025	1 : 500	@ A
Date	Scale	Sheet Siz

