971 Richmond Road, Marsden Park



		ISSUE C - AMENDMENTS - 02.06.21	ISSUE E - AMENDMENTS - 15.07.21	ISSUE F - AMENDMENTS - 05.10.21	DRAWING LIST	
STARK AND AREAN		1. Unit Breakdown amended	1. Gross Site Area revised	1. Silver Level Unit Calculations amended	NO. DRAWING NAME	ISSUE DATE
THE AND		2. Landscape and Deep soil areas amended	2. Unit Breakdown amended	2. Electric Vehicle Charging Bays added	00 Cover Sheet	F 05.10.21
		 Car parking provision amended Child Care calculations amended 	3. Landscape and Deep soil areas amended4. Parking provision amended	3. Parking provision amended	00a Unit Breakdown + Solar & Cross Vent. Calc - 00b Basix Commitments	F 05.10.21 A 06.04.2020
	A STATE A	5. Retail areas amended	5. Retail & Gym gross floor areas amended	AL AN ALL	00c Site Analysis 01 Subdivision Plan	A 06.04.2020 I 15.07.21
		ISSUE D - AMENDMENTS - 29.06.21	6. Basement gross floor areas amended7. Sheet 53a and 53b added to Drawing List.		01a Future Roads - Site Plan	G 05.10.21 C 15.07.21
		1. Unit Breakdown amended 2. Calculations amended			02 Overall Site Plan	Н 05.10.21
		3. Sheet 50a added to Drawing List.			03Basement Level 304Basement Level 2	F 05.10.21 F 05.10.21
					05 Basement Level 1 06 Level 1 / Ground Floor	G 05.10.21 H 05.10.21
					07 Level 2	Н 05.10.21
					08 Level 3 09 Level 4	G 15.07.21 G 15.07.21
		N			10 Level 5 11 Level 6	H 05.10.21 H 05.10.21
					12 Level 7	Н 05.10.21
					13Level 814Roof Plan	H 05.10.21 H 05.10.21
					15 Level 02 - Block A 16 Level 03-04 - Block A	C 15.07.21 C 15.07.21
					17 Level 05 - Block A	C 15.07.21
					18Level 06-08 - Block A19Roof Level - Block A	C 15.07.21 C 15.07.21
					20 Level 02 & 03-04 - Block B 21 Level 05-07 & Roof Level - Block B	C 15.07.21 C 15.07.21
					22 Level 02 - Block C	C 15.07.21
					23 Level 03-04 - Block C 24 Level 05 - Block C	C 15.07.21 C 15.07.21
					25Level 06-08 - Block C26Roof Level - Block C	C 15.07.21 C 15.07.21
					27 Level 02 - Block D	D 05.10.21
					28 Level 03-04 - Block D 29 Level 05 - Block D	C 15.07.21 D 05.10.21
					30Level 06-08 - Block D31Roof Level - Block D	D 05.10.21 D 05.10.21
					32 Level 02 - Block E	D 05.10.21
					33 Level 03-04 - Block E 34 Level 05 - Block E	C 15.07.21 C 15.07.21
			Constant Chronitation in Annual Constant Constant of C		35Level 06-08 - Block E36Roof Level - Block E	C 15.07.21 C 15.07.21
	A MUN COLOR				37 Level 02 - Block F	C 15.07.21
HAR MARKEN CHARTER MANY		~~~~~~~~~~~~~~~~~~~~~~~~~~~~~~~~~~~~~~	Y- Y- Y- Y- Y- Y- Y- Y-	Y Y Y Y Y YY YY YY YY	38 Level 03-04 - Block F 39 Level 05 - Block F	C 15.07.21 C 15.07.21
CALCULATIONS	WN PARKING PROVISIONS			CHILDCARE CALCULATIONS	40 Level 06-08 - Block F J 41 Roof Level - Block F	C 15.07.21 C 15.07.21
	Resident Res	dent Resident Total Retail Retail Gym	Gym Customer Child-care Child-care Total Total Co	ourier/ Car Bicycle Motorbke Vabiate Internal Play Areas	42 Elevations (43 Elevations 2	F 05.10.21 G 05.10.21
Gross Site Area24,700.6 sq.mBlocks A, B, CNet Site Area(Lot 1)9,698.9 sq.mLevel 2	1 Bed 2 Bed 3 Bed 4 Bed Total Blocks A, B, C Parking Ada 5 14 19 19 Parking Parking Parking Parking	otable Visitor Resident Customer Customer Access. ing Parking +Visitors Parking Par	access. Parking Parking Parking Parking Parking Parking Spaces sp	bading Wash Parking Parking Charging Playroom Age Area Children baces Bays Bays 25	44 Elevations 3	G 05.10.21
Building Area 5,611.7 sq.m Level 3-4	8 22 2 2 34 Ground Floor/Level 1			8 2 3 - 5 69.0 sq.m 20	\$\chi_45\$3D Building Height Plane\$\chi_46\$Section AA	F 05.10.21 F 05.10.21
Site Cover57.85 %Level 5-8Gross Floor Area26,474.58 sq.mProposed Total	7 36 8 51 Basement 1 44 20 72 2 10 104 Basement 2 85	7 ^v 21 72 4 89	72	1 22 4 6 3 0 - 2 62.9 sq.m 20 14 4 4 4 2 - 3 58.0 sq.m 15	47 Section BB 48 Section CC	F 05.10.21 F 05.10.21
Gloss Floor Area 26,474.38 sq.111 Proposed Total FSR 2.73:1 Adaptable Units	-7 -4 - 11 - Basement 3			14 4 2 - 3 58.0 sq.m 15 5 3 - 5 74.0 sq.m 20	49 Section DD (D)	F 05.10.21
-Silver Level Units	6 7 1357 Total 129			1 44 8 6 Total 356.4 sq.m 100	$\begin{array}{c c} & & \\ \hline \\ \hline$	F 05.10.21
Gross Floor AreasBlocks A, B, CBlocks D, E, FTotalGround Floor/Level 12,268.58 sq.m2,340.00 sq.m4,608.58 sq.m	Resident Res	ident Resident Total Retail Retail Gym	Gym Child-care Child-care Child-care Total Total Co	ourier/ Car Bicycle Motorbike Vabiate Total Area Children	51 Driveway Sections	C 05.10.21
Level 2 1,566.30 sq.m 1,831.60 sq.m 3,397.90 sq.m Blocks D, E, F Level 3 1,478.50 sq.m 1,836.50 sq.m 3,315.00 sq.m Level 2			Customer Parent Staff Accessible Commercial Car Lo access. Parking Parking Parking Parking Spaces sp	bading Wash Parking Parking Charging E 700 sq.m 100 baces Bays	53 Site Details 2	C 05.10.21 B 05.10.21
Level 4 1,478.50 sq.m 1,836.50 sq.m 3,315.00 sq.m (Level 3-4	5 11 4 20 Pair 10 22 8 40 Ground Floor/Level 1 -	Parking +VISITORS ³ Parking Parking arking		Bay 8 RETAIL SCHEDULE	53a Site Details 3 53b Site Details 4 54 Post-Adaptable Layouts	A 15.07.21
Level 5 1,291.90 sq.m 1,755.90 sq.m 3,047.80 sq.m Level 5-8	8 40 24 72 Basement 1	48 3 16 7 27 116	1 16 17 1 102 102	2 2 2 1 2 R101 Retail 142 sq.m	55 Study Diock A	A 06.04.2020 B 15.07.21
Level 6 1,291.90 sq.m 1,765.60 sq.m 3,057.50 sq.m Proposed Total Level 7 1,291.90 sq.m 1,765.60 sq.m 3,057.50 sq.m Adaptable Units	23 73 36 132 Basement 2 82 33 - -10 -4 -4 -4 -62 82 -7	27 116 3 70 53	53 (123)	1 29 2 5 R102 Retail 207 sq.m 29 2 6 0 R103 Retail 98 sq.m	56 3D Study - Block B 57 3D Study - Block C	B 15.07.21 B 15.07.21
Level 8 909.70 sq.m 1,765.60 sq.m 2,675.30 sq.m Silver Level Units	3 11 14 14 1 144 1	5 27 186 48 3 53 16	1 16 17 1 155 341	2 1 66 6 6 R104 Retail 134 sq.m	58 3D Study - Block D	C 05.10.21
Total 11,577.28 sq.m 14,897.30 sq.m 26,474.58 sq.m	Resident Res	ident Resident Total Retail Retail Gym	Gym Child-care Child-care Child-care Total Total Co	ourier/ Car Bicycle Motorbicountry R105 Retail 208 sq.m 132 sq.m		B 15.07.21 B 15.07.21
Basement Areas Blocks A, B, C Blocks D, E, F Total TOTAL DEVELOPME	ENT 1 Bed 2 Bed 3 Bed 4 Bed Tota TOTAL Parking Ada	ptable Visitor Resident Customer Customer Staff Customer	Customer Parent Staff Accessible Commercial Car Lo	bading Wash Parking Parking Charging R107 Gym 404 sq.m	61 3D - Overalls	B 15.07.21 B 15.07.21
Basement 12,993.90 sq.m3,721.50 sq.m6,715.40 sq.mLevel 2Basement 23,236.90 sq.m3,941.80 sq.m7,178.70 sq.mLevel 3-4	10 25 4 39 DEVELOPMENT Park 18 44 10 2 74 Ground Floor/Level 1 1	Parking +Visitors Parking Parking Parking	Parking Parking Parking Parking Parking Spaces sp	baces Bays (Bay R108 Retail 197 sq.m. 16 R109 Retail 159 sq.m.	63 L2 - Solar Access & Cross-Ventilation Diagrams	B 15.07.21
Basement 3 3,972.50 sq.m 3,972.50 sq.m Level 5-8	15 76 24 8 123 Basement 1 44	7 ^v 21 72 48 3 16	1 16 17 1 102 174	2 1 22 6 7 R110 Retail 229 sq.m	65 L4 - Solar Access & Cross-Ventilation Diagrams	B 15.07.21 B 15.07.21
Total 6,230.80 sq.m 11,635.80 sq.m 17,866.60 sq.m Proposed Total	43 145 38 10 Basement 2 167 (18.2%) (61.4%) (16.2%) (4.2%) Basement 3 62	11 27 205 8 70 53		1 43 6 5 R111 Retail 189 sq.m 29 2		B 15.07.21 B 15.07.21
Landscape Calculations	-7 -14 -4 -25 Total 273	26 48 347 48 3 53 16	1 16 17 1 155 502	2 2 110 14 12 R113 Retail 194 sq.m		
Landscape + Deep Soil 1,953.00 sq.m (20.1%) Silver Level Units Deep Soil 661.00 sq.m (6.82%) 4				R114 Retail 185 sq.m	人 70 FSR Calculations 2	B 15.07.21
Common Open Space 3,580.00 sq.m (36.9%)	Total Unite - 224	F	(F)	Total Parking – 502 Total Retail Area (GLA)		B 15.07.21 B 15.07.21
24-~~~~~~~~~~~~~~~~~~~~~~~~~~~~~~~~~~~~	Total Units = 236	<u></u>	ᠰᢩᡔᠰᢩᡔᠰᢩᡔᠰᢩᡔᠰᢩᡔᠰᢩᡔᠰᢩᠵᠰᢩᠵᠰ	Total Parking = 502		B 15.07.21 B 15.07.21
1_11_1_1_1_1_1_1_1_1_1_1_1_1_1_1_1_1_1_1			-^^			
DEVELOPMENT APPLICA	(IION) (b) (c) (c)					

Proposed Mixed Use Development

tel: 02 9633 5888 mob: 0418 402 919



Level 3, 7k parkes St.
parramatta, 2150email@architex.com.au
www.architex.com.auryleton pty ltd t/as architex
abn 32 003 315 142

Proposed Mixed Use Development

DEVELOPMENT APPLICATION

Description	Total
Number of Units with living areas receiving 2 hours minimum solar access on 21st June	168 (71.2%)
Number of Units with 0 solar access	17 (7.2%)
Number of Units with cross ventilation	167 (70.7%)

ISSUE C - AMENDMENTS - 02.06.21
1. Unit Breakdown amended
ISSUE D - AMENDMENTS - 29.06.21
1. Unit Breakdown amended
ISSUE E - AMENDMENTS - 15.07.21
1. Unit Breakdown amended
2. Solar Access and Cross-ventilation Calculation amended
ISSUE F - AMENDMENTS - 05.10.21
1. Silver Level Unit allocations amended

20 0 VENT SOLAR & CROSS CALCULATION

A803

A804

A805

Grand total: 39

	2 Bedroom	80 m ²	12.96 m ²		
	4 Bedroom	122 m ²	22.6 m ²		
	2 Bedroom	79 m²	13.27 m ²		12
	2 Bedroom	78 m²	17.91 m ²		
	1 Bedroom	58 m²	11.00 m ²	Adaptable	
	2 Bedroom	80 m ²	12.96 m ²		12
39))

Apartment Schedule - Block A

1			
	B504	2 Bedroom	79 m²
	B505	2 Bedroom	77 m²
	B601	2 Bedroom	76 m²
	B602	1 Bedroom	51 m²
	B603	2 Bedroom	76 m²
	B604	2 Bedroom	79 m²
	B605	2 Bedroom	77 m²
	B701	2 Bedroom	76 m²
	B702	1 Bedroom	51 m²
	B703	2 Bedroom	76 m²
	B704	2 Bedroom	79 m²
	B705	2 Bedroom	77 m²
		۰۸_ ۰۸_ ۲ С	~_/

Apartment Schedule - Block B

	лраг	tment Schedu			_ <u>\</u>		лра	tment Schedu		
Unit Number	Bedrooms	Area	Courtyard/Balcony Area	Unit Type	`×	Unit Number	Bedrooms	Area	Courtyard/Balcony Area	Unit Typ
A201	2 Bedroom	79 m ²	45.0 m ²			B201	2 Bedroom	76 m ²	23.65 m ²	
A202	1 Bedroom	62 m ²	48.0 m ²			B202	1 Bedroom	51 m ²	11.80 m ²	Silver Level
A203	2 Bedroom	78 m ²	52.20 m ²			B203	2 Bedroom	76 m ²	23.69 m ²	
A204	2 Bedroom	79 m ²	20.0 m ²		- V.	B204	2 Bedroom	79 m ²	40.30 m ²	
A205	2 Bedroom	78 m ²	45.5 m ²			B205	2 Bedroom	77 m ²	44.20 m ²	
A206	1 Bedroom	58 m ²	20.95 m ²	Adaptable	1	B301	2 Bedroom	76 m ²	13.45 m ²	
A207	2 Bedroom	82 m ²	18.46 m ²			B302	1 Bedroom	51 m ²	8.50 m ²	Silver Level
A301	3 Bedroom	103 m ²	65.5 m ²			B 303	2 Bedroom	76 m ²	13.45 m ²	
A302	2 Bedroom	78 m ²	11.30 m ²		₩	A B304	2 Bedroom	79 m ²	15.21 m ²	
A303	2 Bedroom	79 m ²	13.27 m ²		- ¥	B305	2 Bedroom	77 m ²	15.21 m ²	
A304	2 Bedroom	78 m ²	17.91 m ²		╶╻┥⋖	4 8401	2 Bedroom	76 m ²	13.45 m ²	
A305	1 Bedroom	58 m ²	11.00 m ²	Adaptable	<u>الْا</u>	4 8402	1 Bedroom	51 m ²	8.50 m ²	Silver Level
A306	2 Bedroom	82 m ²	12.96 m ²		- ĭ>	B403	2 Bedroom	76 m ²	13.45 m ²	
A401	3 Bedroom	103 m ²	65.5 m ²		╶┰┥⋖	B 404	2 Bedroom	79 m ²	15.21 m ²	
A402	2 Bedroom	78 m ²	11.30 m ²			K B405	2 Bedroom	77 m ²	15.21 m ²	
A403	2 Bedroom	79 m ²	13.27 m ²		≪ز ∣	B501	2 Bedroom	76 m ²	13.45 m ²	
A404	2 Bedroom	78 m ²	17.91 m ²		॑	B 502	1 Bedroom	51 m ²	8.50 m ²	Silver Level
A405	1 Bedroom	58 m ²	11.00 m ²	Adaptable		L B503	2 Bedroom	76 m ²	13.45 m ²	
A406	2 Bedroom	82 m ²	12.96 m ²		7	B504	2 Bedroom	79 m ²	15.21 m ²	
A501	4 Bedroom	122 m ²	22.6 m ²		॑ {	B 505	2 Bedroom	77 m ²	15.21 m ²	
A502	2 Bedroom	79 m ²	13.27 m ²			L B601	2 Bedroom	76 m ²	13.45 m ²	
A503	2 Bedroom	78 m ²	17.91 m ²		ار (B602	1 Bedroom	51 m ²	8.50 m ²	Silver Level
A504	1 Bedroom	58 m ²	11.00 m ²	Adaptable	─ ∕(-	6 603	2 Bedroom	76 m ²	13.45 m ²	
A505	2 Bedroom	80 m ²	12.96 m ²			L B604	2 Bedroom	79 m ²	15.21 m ²	
A601	4 Bedroom	122 m ²	22.6 m ²		ר ך <i>ך</i>	B605	2 Bedroom	77 m ²	15.21 m ²	
A602	2 Bedroom	79 m ²	13.27 m ²			6 B701	2 Bedroom	76 m ²	13.45 m ²	
A603	2 Bedroom	78 m ²	17.91 m ²			L B702	1 Bedroom	51 m ²	8.50 m ²	Silver Level
A604	1 Bedroom	58 m ²	11.00 m ²	Adaptable		B703	2 Bedroom	76 m ²	13.45 m ²	
A605	2 Bedroom	80 m ²	12.96 m ²			6 B704	2 Bedroom	79 m ²	15.21 m ²	
A701	4 Bedroom	122 m ²	22.6 m ²			L B705	2 Bedroom	77 m ²	15.21 m ²	
A702	2 Bedroom	79 m ²	13.27 m ²			Grand total: 30	0	-		
A703	2 Bedroom	78 m ²	17.91 m ²			<*				
A704	1 Bedroom	58 m ²	11.00 m ²	Adaptable		4				
A705	2 Bedroom	80 m ²	12.96 m ²			い~~~	<u> </u>	~~~~	い_~^_~	してく
A801	4 Bedroom	122 m ²	22.6 m ²		<u> </u>	<				
A802	2 Bedroom	79 m ²	13.27 m ²			L				

971 Richmond Road, Marsden Park

	Apart	ment Schedu	lle - Block C	· · · ·			Apart	ment Schedu	le - Block D				Apar	rtment S
>			Courtyard/Balcony	у	<u>_</u>				Courtyard/Balcon					
Unit Number	Bedrooms	Area	Area	Unit Type	<u> </u>	Unit Number	Bedrooms	Area	Area	Unit Type		Unit Number	Bedrooms	
C201	2 Bedroom	83 m ²	10.0 m ²		\neg	D201	2 Bedroom	83 m ²	13.40 m ²]	E201	2 Bedroom	89 m²
C202	1 Bedroom	67 m ²	16.75 m ²			D202	1 Bedroom	62 m ²	12.50 m ²		-	E202	3 Bedroom	113 m
C203	1 Bedroom	55 m ²	34.50 m ²			D203	1 Bedroom	55 m ²	26.40 m ²	Silver Level		E203	1 Bedroom	66 m ²
C204	2 Bedroom	78 m ²	38.0 m ²	Adaptable	71	J D204	2 Bedroom	74 m ²	22.80 m ²			E204	2 Bedroom	78 m ²
► C205	2 Bedroom	76 m ²	69.9 m ²		₹ ∕	D205	2 Bedroom	78 m ²	56.50 m ²		-	E205	2 Bedroom	79 m ²
C206	2 Bedroom	82 m ²	59.6 m ²			D206	2 Bedroom	81 m ²	36.10 m ²	Silver Level	-	E206	3 Bedroom	106 m
C207	2 Bedroom	76 m ²	45.40 m ²		71) D207	2 Bedroom	82 m ²	29.70 m ²			E301	2 Bedroom	89 m ²
C 301	2 Bedroom	83 m ²	11.75 m ²		~ ^	D208	1 Bedroom	56 m ²	13.16 m ²		-	E302	3 Bedroom	118 m
C302	1 Bedroom	67 m ²	10.15 m ²			D301	1 Bedroom	64 m ²	15.08 m ²		-	E303	1 Bedroom	66 m ²
C303	1 Bedroom	55 m ²	8.15 m ²		ゴバ	J D302	2 Bedroom	83 m ²	15.17 m ²			E304	2 Bedroom	78 m ²
C304	2 Bedroom	78 m ²	10.20 m ²	Adaptable	* /	D303	1 Bedroom	62 m ²	13.0 m ²			E305	2 Bedroom	79 m ²
C305	2 Bedroom	76 m ²	12.80 m ²		<u>-{</u> (,	D304	1 Bedroom	55 m ²	17.29m ²	Silver Level	-	E306	3 Bedroom	106 m
C306	4 Bedroom	124 m ²	67.50 m ²		コバ	J D305	2 Bedroom	74 m ²	12.85m ²			E401	2 Bedroom	89 m ²
C401	2 Bedroom	83 m ²	11.75 m ²		77	D306	2 Bedroom	78 m ²	16.60m ²		-	E402	3 Bedroom	118 m
C402	1 Bedroom	67 m ²	10.15 m ²			D307	2 Bedroom	81 m ²	10.77m ²	Silver Level	-	E403	1 Bedroom	66 m ²
C403	1 Bedroom	55 m ²	8.15 m ²		コバ	D308	2 Bedroom	87 m ²	10.77m ²			E404	2 Bedroom	78 m ²
C404	2 Bedroom	78 m ²	10.20 m ²	Adaptable	*	D401	1 Bedroom	64 m ²	15.08 m ²			E405	2 Bedroom	79 m ²
C405	2 Bedroom	76 m ²	12.80 m ²			D402	2 Bedroom	83 m ²	15.17 m ²		-	E406	3 Bedroom	106 n
C406	4 Bedroom	124 m ²	26.56 m ²		$\neg \mathcal{N}$	D403	1 Bedroom	62 m ²	13.0 m ²		-	E501	2 Bedroom	89 m ²
C501	2 Bedroom	82 m ²	28.70 m ²	Silver Level	1 2	D404	1 Bedroom	55 m ²	17.29m ²	Silver Level	-	E502	3 Bedroom	113 n
C502	2 Bedroom	79 m ²	26.56 m ²		T LI	D405	2 Bedroom	74 m ²	12.85m ²		-	E503	1 Bedroom	66 m ²
C503	2 Bedroom	78 m ²	10.20 m ²	Adaptable		D406	2 Bedroom	78 m ²	16.60m ²		-	E504	2 Bedroom	78 m ²
C504	4 Bedroom	127 m ²	23.80 m ²		7.2	D407	2 Bedroom	81 m ²	10.77m ²	Silver Level	-	E505	2 Bedroom	79 m ²
C601	2 Bedroom	82 m ²	10.90 m ²	Silver Level		D408	2 Bedroom	87 m ²	10.77m ²		-	E506	3 Bedroom	106 n
C602	2 Bedroom	79 m ²	13.70 m ²			D501	3 Bedroom	109 m ²	13.76m ²	Adaptable	-	E601	2 Bedroom	89 m ²
C603	2 Bedroom	78 m ²	10.20 m ²	Silver Level		D502	2 Bedroom	79 m ²	10.95m ²		-	E602	3 Bedroom	118 n
C604	4 Bedroom	127 m ²	23.80 m ²			D503	2 Bedroom	74 m ²	12.85m ²		-	E603	1 Bedroom	66 m ²
C701	2 Bedroom	82 m ²	10.90 m ²	Silver Level		D504	2 Bedroom	78 m ²	16.60m ²		-	E604	2 Bedroom	78 m ²
C702	2 Bedroom	79 m ²	13.70 m ²			D505	2 Bedroom	80 m ²	10.77m²	Silver Level		E605	2 Bedroom	79 m ²
C703	2 Bedroom	78 m ²	10.20 m ²	Silver Level	12	D506	3 Bedroom	96 m ²	10.77m ²		1	E606	3 Bedroom	106 n
C704	4 Bedroom	127 m ²	23.80 m ²		<u>-</u> / (D601	3 Bedroom	109 m ²	13.76m ²	Adaptable	1	E701	2 Bedroom	89 m ²
C801	2 Bedroom	82 m ²	10.90 m ²	Silver Level		D602	2 Bedroom	79 m ²	10.95m ²		-	E702	3 Bedroom	118 n
C802	2 Bedroom	79 m ²	13.70 m ²		15	D603	2 Bedroom	74 m ²	12.85m ²		-	E703	1 Bedroom	66 m ²
C803	2 Bedroom	78 m ²	10.20 m ²	Silver Level	₹`\$	D604	2 Bedroom	78 m ²	16.60m ²		-	E704	2 Bedroom	78 m ²
C804	4 Bedroom	127 m ²	23.80 m ²			D605	2 Bedroom	80 m ²	19.77m²	Silver Level		E705	2 Bedroom	79 m ²
Grand total: 35					- K	D606	3 Bedroom	96 m ²	10.77m ²		1	E706	3 Bedroom	106 m
7 .					<u>م</u> ' سر	D701	3 Bedroom	109 m ²	13.76m ²	Adaptable		E801	2 Bedroom	89 m ²
		してい			(D702	2 Bedroom	79 m ²	10.95m ²			E802	3 Bedroom	118 n
~~ ~	٨ ٨	~ ~ ~	1 ~ 1 ~	۸ ۸	~く	D703	2 Bedroom	74 m ²	12.85m ²		-	E803	1 Bedroom	66 m ²
					5	D704	2 Bedroom	78 m ²	16.60m ²		-	E804	2 Bedroom	78 m ²
			<i>(</i>	5	Í	D705	2 Bedroom	80 m ²	10.77m²	Silver Level		E805	2 Bedroom	79 m ²
	(\mathbf{D})		(シ	Š	D706	3 Bedroom	96 m ²	10.77m ²	<u> </u>	13	E806	3 Bedroom	106 m
	\sim				< ا	D801	3 Bedroom	109 m ²	13.76m ²	Adaptable	1	Grand total: 42		
					1	D802	2 Bedroom	79 m ²	10.95m ²		1			
											-			

D803

D804

DS05

D806

Grand total: 48

2 Bedroom

2 Bedroom

2 Bedroom

3 Bedroom

74 m²

78 m²

80 m²___

96 m²

12.85m²


16.60m²

10.77m²

10.77m²


Silver Level

tel: 02 9633 5888 mob: 0418 402 919

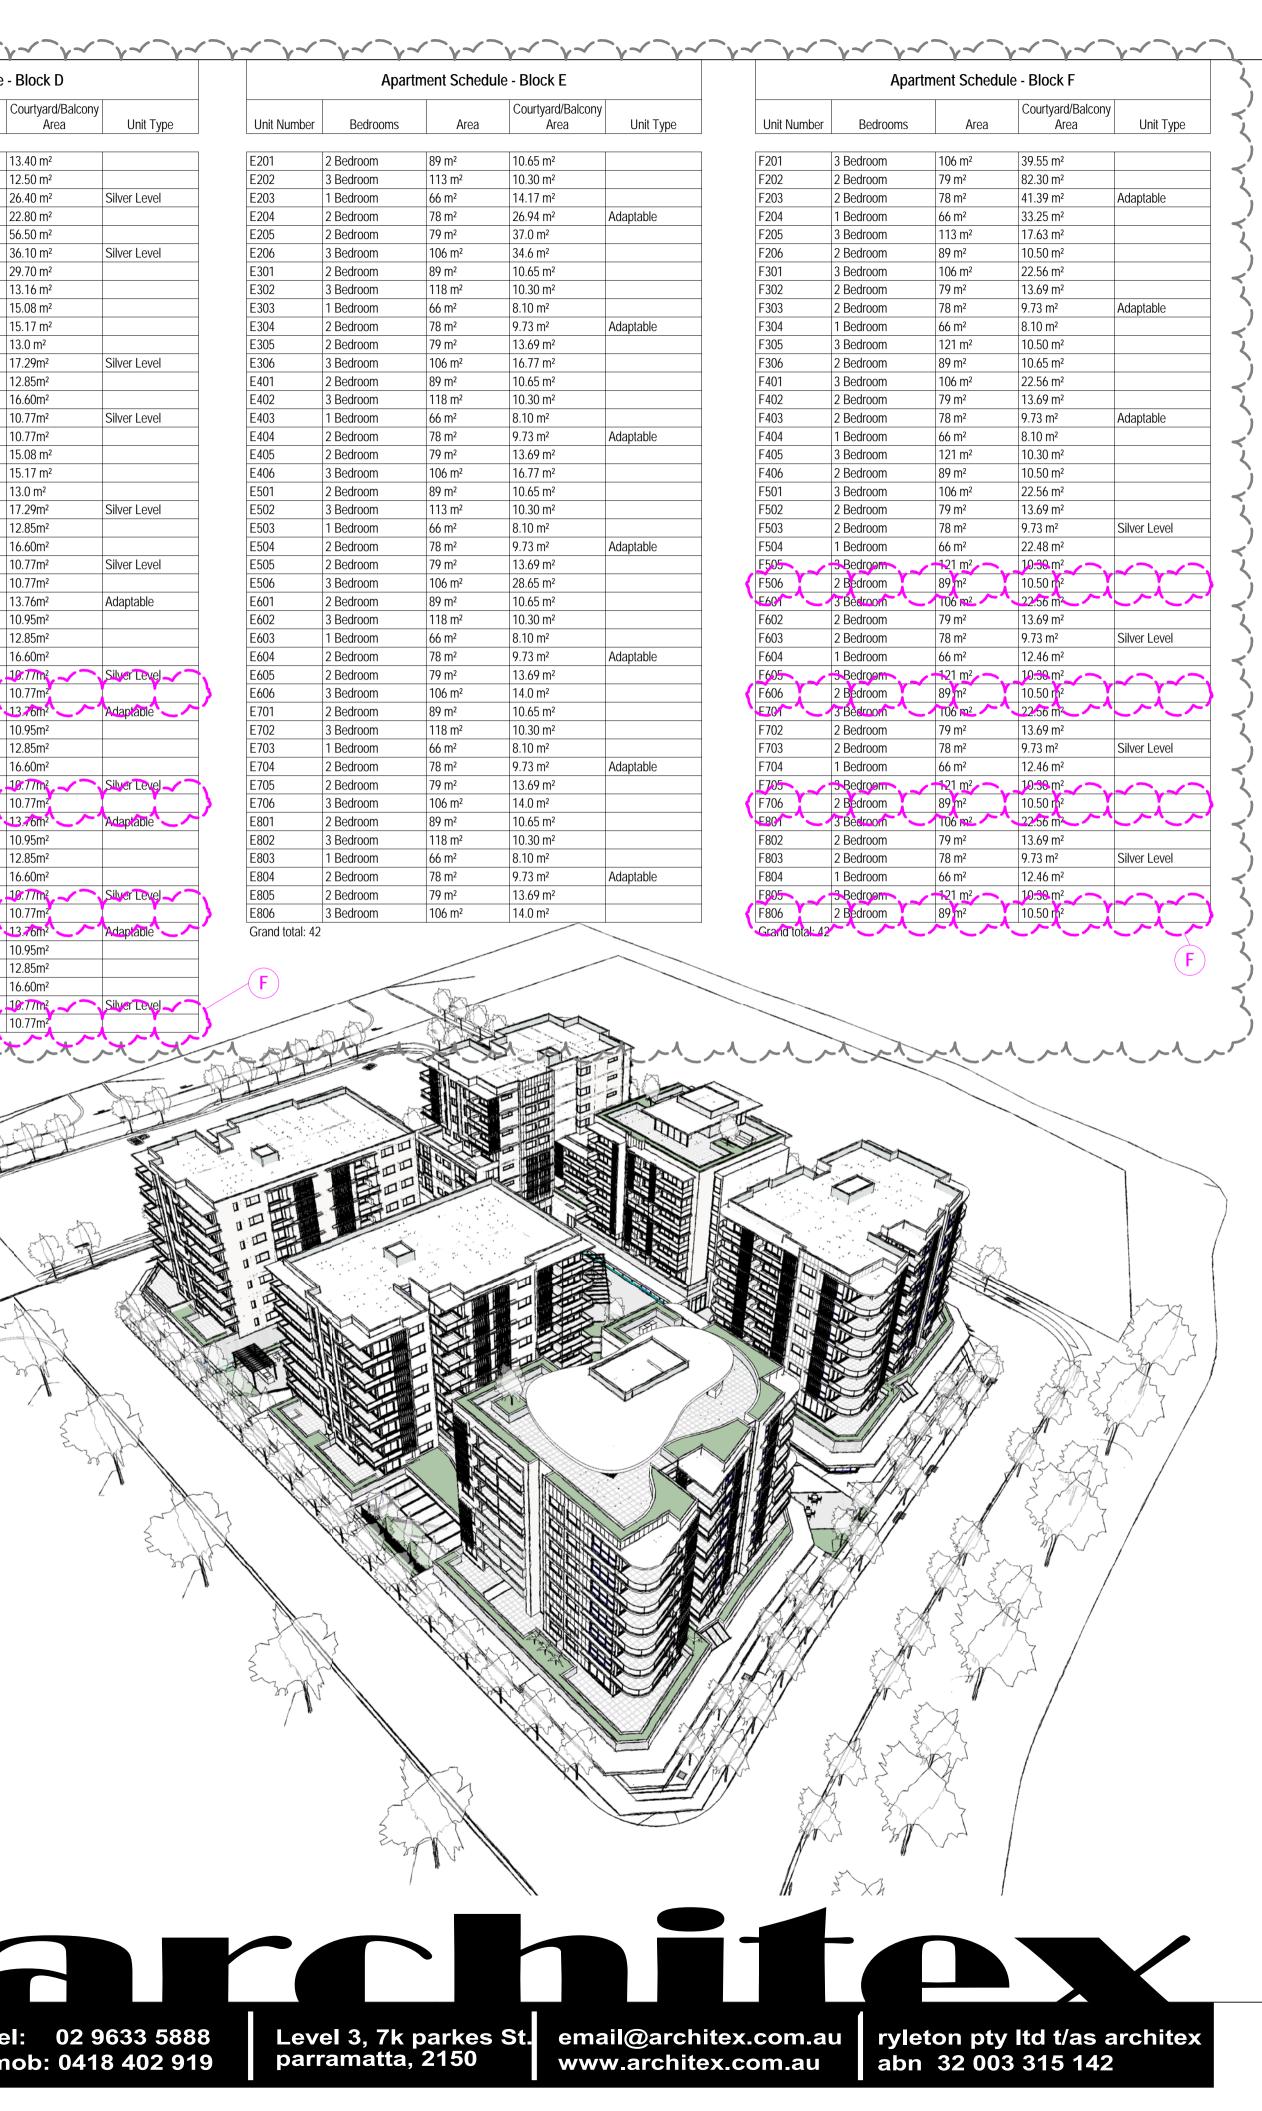

Area



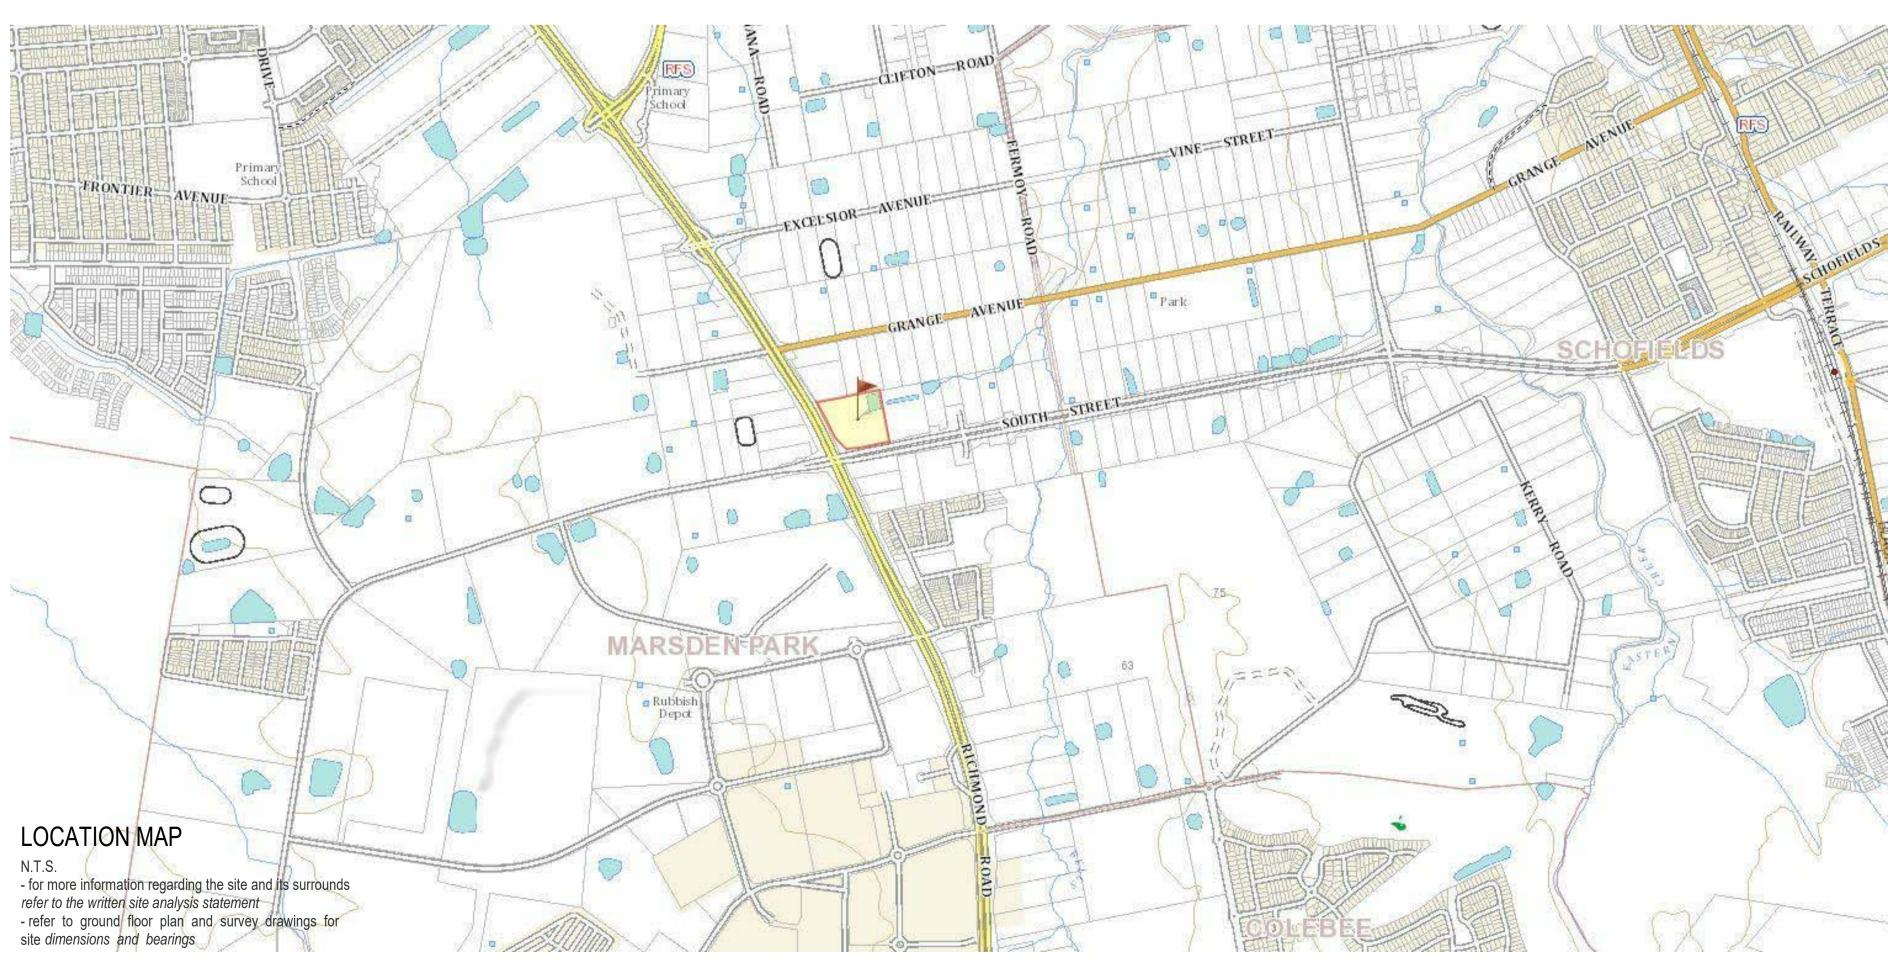



View 1




View 2




View 3



EW 4	
LOC	CATION AMENITIES
	1.8 km to ALDI Marsden Park 1.8 km to COSTCO Marsden Park 1.8 km to IKEA Marsden Park
	4.3 km to Schofields TRAIN STATION
	10m to NEAREST BUS STOP (RICHMOND RD)
	8.1km to Mount Druitt Hospital
Æ	1.0 km to the Grange Park
0	5.6km to Australia Post - Riverstone
	1.4 km to Marsden Park Public School
±	2.9 km to Life Anglican Church Marsden Park

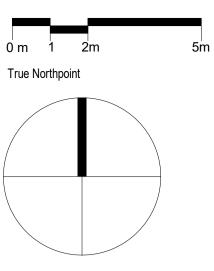

Do not scale, check and verify all dimensions before commencing new work, ground levels may vary due to site conditions.

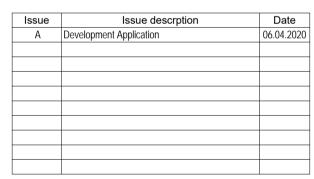



RD)

DEVELOPMENT APPLICATION

Project Pronose

Proposed Mixed Use Development

Project Address

971 Richmond Road, Marsden Park


Client

iDream Property Pty Ltd and C & S Partners Pty Ltd


Title

Site Analysis

Drawn	Scale	Checked
A.S	NTS	Checker
Job No	Drawing No.	Issue
2435	00c	A

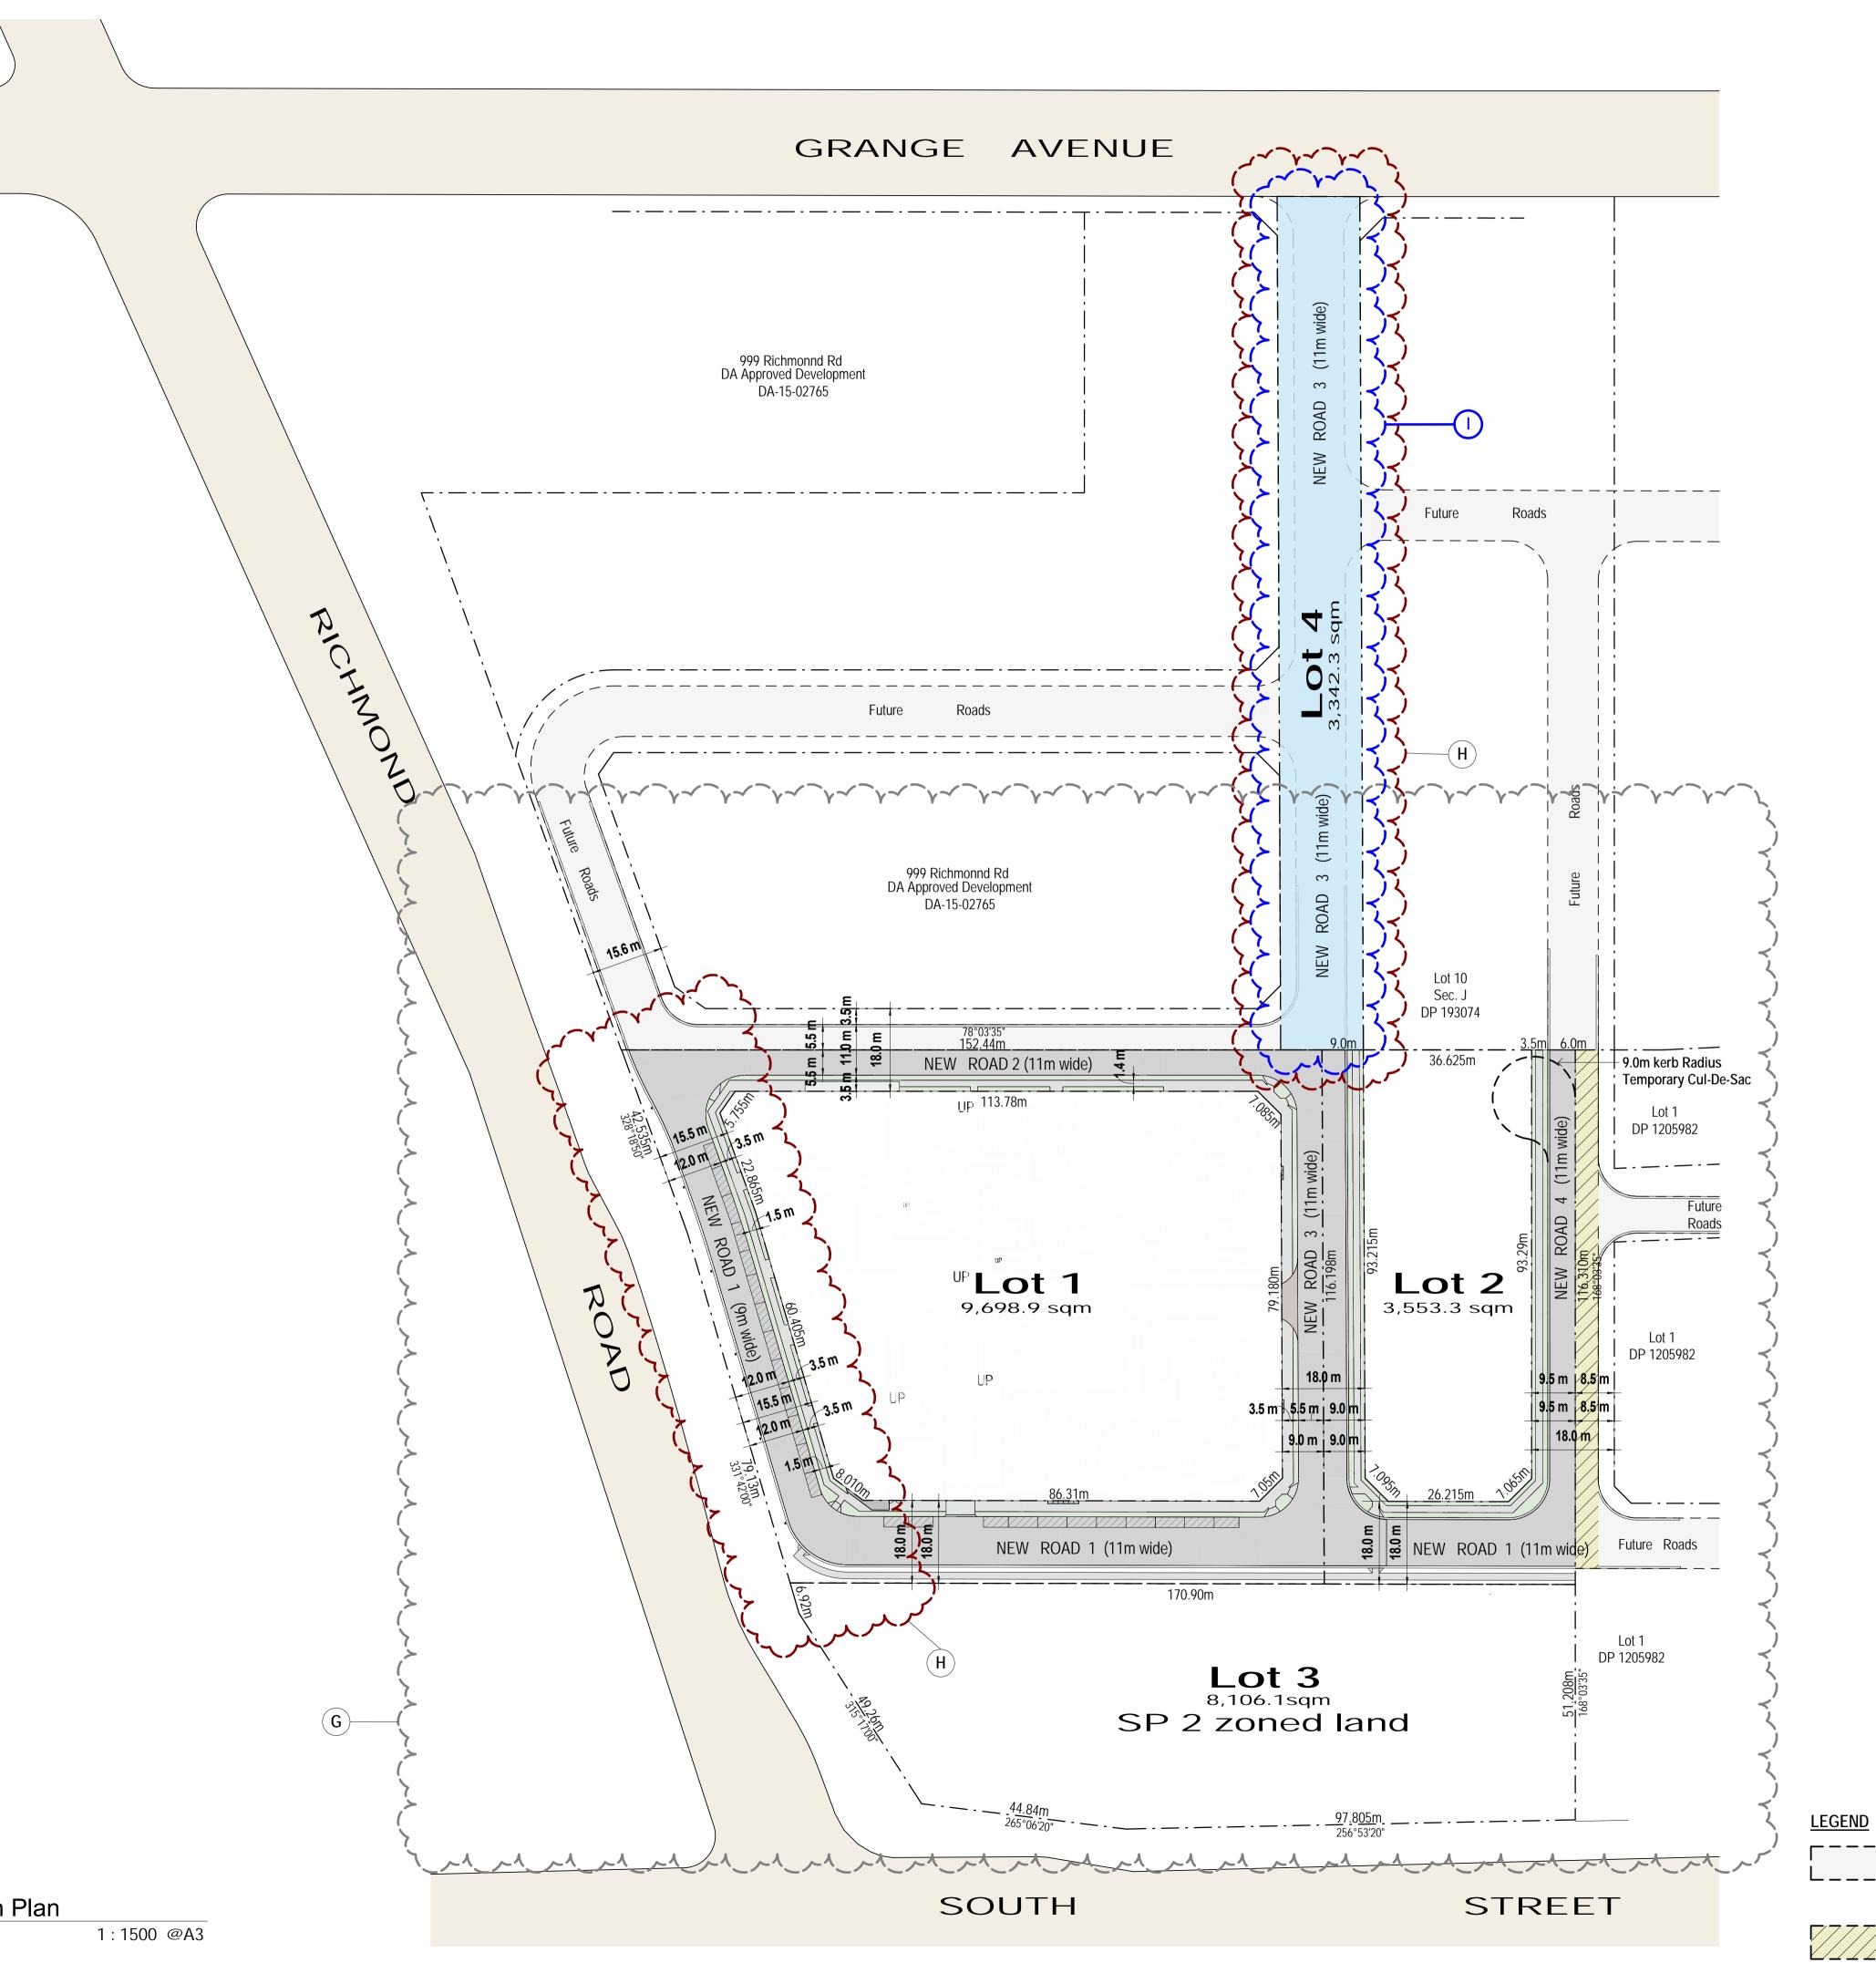



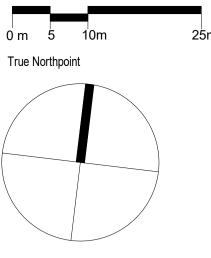

Do not scale, check and verify all dimensions before commencing new work, ground levels may vary due to site conditions.

ISSUE G - AMENDMENTS - 02.06.21
 R3 land (Lot 2) proposed as one super-lot New road 1 & new road 3 amended to allign with adjoining da approved development. SP2 boundary revised. Southern boundary alignments adjusted to suit Lot 1 & Lot 2 boundaries amended New Road 4 increased in width 9.0m radius Temporary cul-de-sac provided
ISSUE H - AMENDMENTS - 29.06.21
 New Road 1, along western boundary has been amended to incorporate a 3 metre wide landscaped area, resulting in New Road 1 in this area to be reduced to 9 metres wide. New Road 3 / Lot 4 location & details added
ISSUE I - AMENDMENTS - 15.07.21
1. Lot 4 enlarged to include road reserves either side of New Road 3

H Amendments To Address SOFAC 29.06.21 G Amendments To Address SOFAC 02.06.21 F Lot Boundaries Amended + General Amendments 18.11.20 E New Road Location & Sizes Adopted, Waste Collection Areas Added, Units Added + General Amendments 08.07.20 D Roads Amended 06.04.20	H Amendments To Address SOFAC 29.06.21 G Amendments To Address SOFAC 02.06.21 F Lot Boundaries Amended + General Amendments 18.11.20 E New Road Location & Sizes Adopted, Waste Collection Areas Added, Units Added + General Amendments 08.07.20 D Roads Amended 06.04.20 C Waste Collection bays added, Units added + 02.04.20	H Amendments To Address SOFAC 29.06.21 G Amendments To Address SOFAC 02.06.21 F Lot Boundaries Amended + General Amendments 18.11.20 E New Road Location & Sizes Adopted, Waste Collection Areas Added, Units Added + General Amendments 08.07.20 D Roads Amended 06.04.20 C Waste Collection bays added, Units added + 02.04.20	Issue	Issue des	scrption	Date
G Amendments To Address SOFAC 02.06.21 F Lot Boundaries Amended + General Amendments 18.11.20 E New Road Location & Sizes Adopted, Waste Collection Areas Added, Units Added + General Amendments 08.07.20 D Roads Amended 06.04.20 C Waste Collection bays added, Units added + 02.04.20	G Amendments To Address SOFAC 02.06.21 F Lot Boundaries Amended + General Amendments 18.11.20 E New Road Location & Sizes Adopted, Waste Collection Areas Added, Units Added + General Amendments 08.07.20 D Roads Amended 06.04.20 C Waste Collection bays added, Units added + 02.04.20	G Amendments To Address SOFAC 02.06.21 F Lot Boundaries Amended + General Amendments 18.11.20 E New Road Location & Sizes Adopted, Waste Collection Areas Added, Units Added + General Amendments 08.07.20 D Roads Amended 06.04.20 C Waste Collection bays added, Units added + 02.04.20	I	Amendments To Address	SOFAC	15.07.21
F Lot Boundaries Amended + General Amendments 18.11.20 E New Road Location & Sizes Adopted, Waste Collection Areas Added, Units Added + General Amendments 08.07.20 D Roads Amended 06.04.20 C Waste Collection bays added, Units added + 02.04.20	F Lot Boundaries Amended + General Amendments 18.11.20 E New Road Location & Sizes Adopted, Waste Collection Areas Added, Units Added + General Amendments 08.07.20 D Roads Amended 06.04.20 C Waste Collection bays added, Units added + 02.04.20	F Lot Boundaries Amended + General Amendments 18.11.20 E New Road Location & Sizes Adopted, Waste Collection Areas Added, Units Added + General Amendments 08.07.20 D Roads Amended 06.04.20 C Waste Collection bays added, Units added + 02.04.20	Н	Amendments To Address	SOFAC	29.06.21
E New Road Location & Sizes Adopted, Waste Collection Areas Added, Units Added + General Amendments 08.07.20 D Roads Amended 06.04.20 C Waste Collection bays added, Units added + 02.04.20	E New Road Location & Sizes Adopted, Waste Collection Areas Added, Units Added + General Amendments 08.07.20 D Roads Amended 06.04.20 C Waste Collection bays added, Units added + 02.04.20	E New Road Location & Sizes Adopted, Waste Collection Areas Added, Units Added + General Amendments 08.07.20 D Roads Amended 06.04.20 C Waste Collection bays added, Units added + 02.04.20	G	Amendments To Address	SOFAC	02.06.21
Collection Areas Added, Units Added + General Amendments 06.04.20 D Roads Amended 06.04.20 C Waste Collection bays added, Units added + 02.04.20	Collection Areas Added, Units Added + General Amendments 06.04.20 D Roads Amended 06.04.20 C Waste Collection bays added, Units added + 02.04.20	Collection Areas Added, Units Added + General Amendments 06.04.20 D Roads Amended 06.04.20 C Waste Collection bays added, Units added + 02.04.20	F	Lot Boundaries Amended	+ General Amendments	18.11.20
C Waste Collection bays added, Units added + 02.04.20	C Waste Collection bays added, Units added + 02.04.20	C Waste Collection bays added, Units added + 02.04.20	E	Collection Areas Added, U		08.07.20
			D	Roads Amended		06.04.20
			С		led, Units added +	02.04.20
architev	architey	architev		rch		
architex	architex	architex	6	nrch	itex	X
Ryleton pty ltd t/as Architex T : 02 9633	Ryleton pty ltd t/as Architex T : 02 9633	Ryleton pty ltd t/as Architex T : 02 9633	,			

abn 32 003 315 142 Level 3, 7K Parkes Street Parramatta NSW 2150 Nominated Architect:

M : 0418 402 919 email@architex.com.au www.architex.com.au Robert Del Pizzo NSW Reg. No. 3972

Project

Proposed Mixed Use Development

Project Address

971 Richmond Road, Marsden Park

Client

Title

APPLICATION

DEVELOPMENT


iDream Property Pty Ltd and C & S Partners Pty Ltd

Subdivision Plan

Drawn Checked Scale A.S 1:1500 @A3 Checker Job No Drawing No. Issue 2435 01

Future Roads


Part of Future Road to be provided by Lot 1 Neighbouring Development

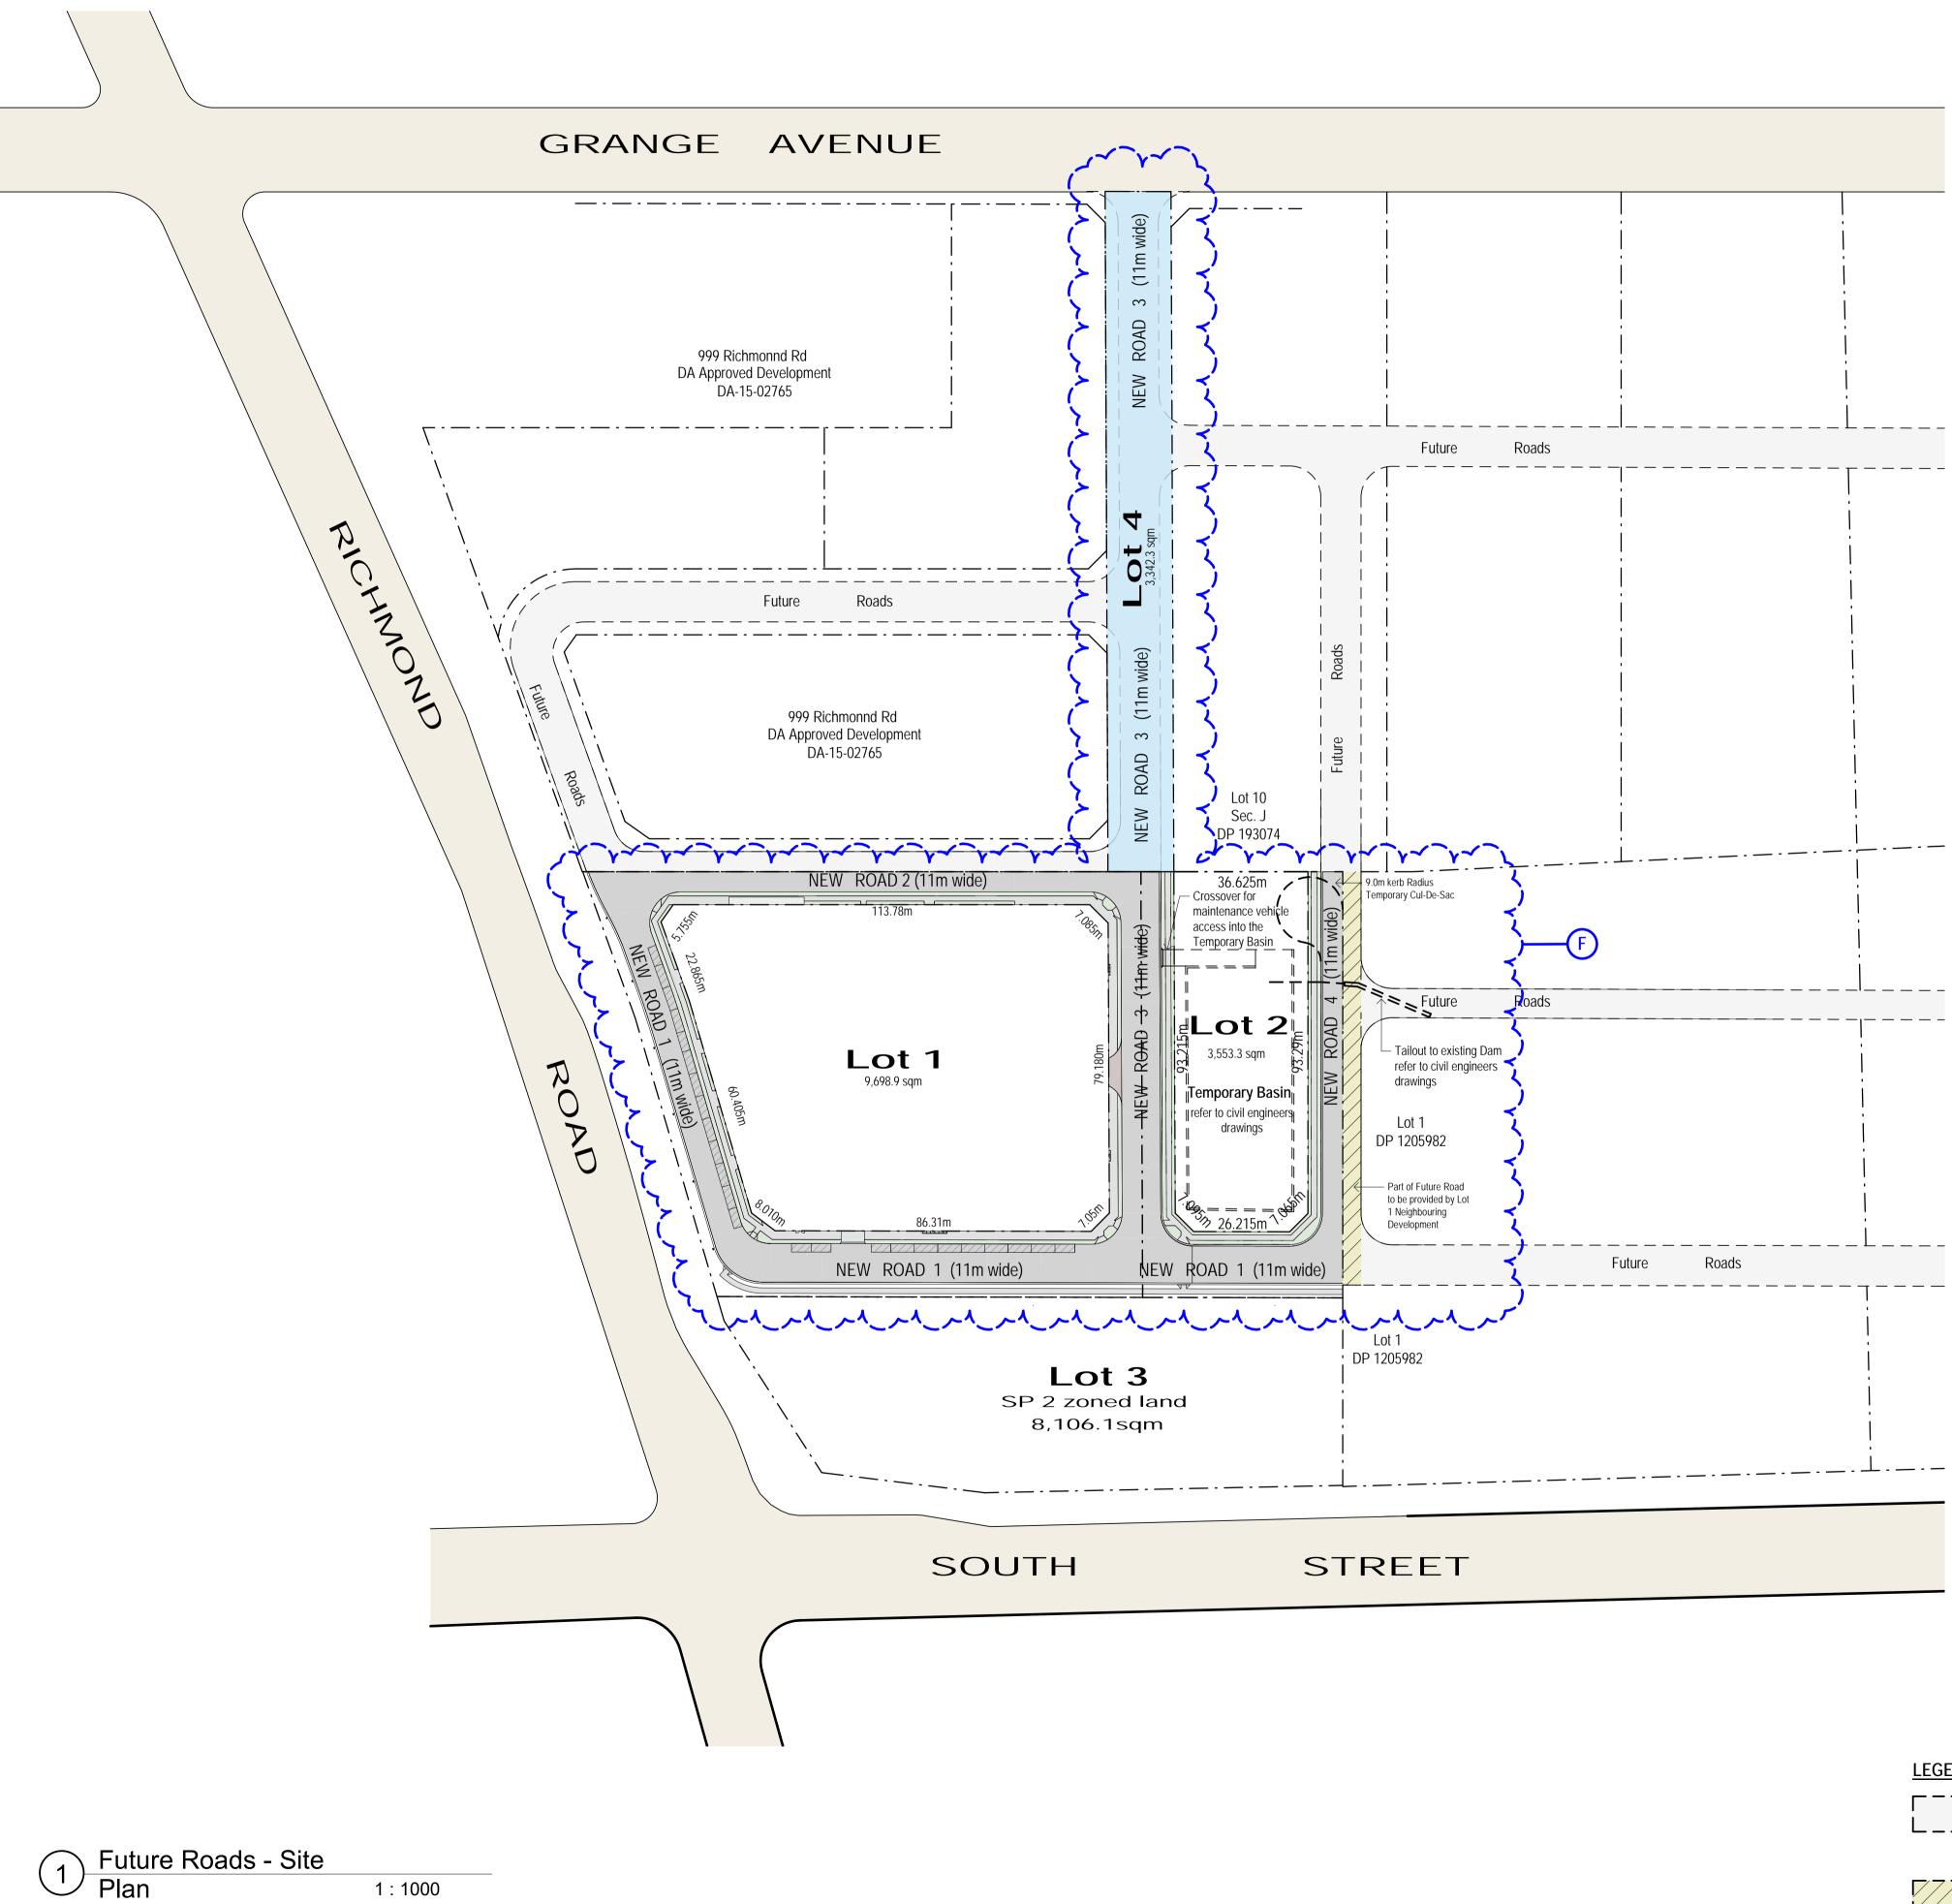

1

1 : 1000

LEGEND _____

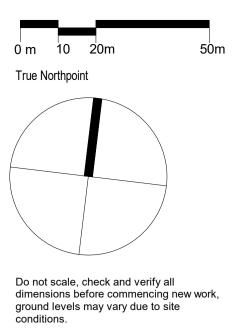

ISSUE F - AMENDMENTS - 15.07.21

 New Road 3 extended to Grange Road to form Lot 4. New Road 1 reduced to 9m to allow for a 3m wide landscape strip adjacent to the Western Boundary. R3 land (Lot 2) proposed as one super-lot
 4. New road 1 & new road 3 amended to allign with adjoining da approved development. 5. SP2 boundary revised. Southern boundary alignments adjusted to suit 6. Lot 1 & Lot 2 boundaries amended 7. New Road 4 increased in width 8. Temporary Basin added to Lot 2.

F A	Amendments To Address SOFAC	15 07 01
		15.07.21
Εl	Lot Boundaries Amended + General Amendments	18.11.20
(New Road Location & Sizes Adopted, Waste Collection Areas Added, Units Added + General Amendments	08.07.20
	Waste Collection bays added, Units added + General Amendments	02.04.20
B N	Neighbouring Roads incorporated	16.06.20
A [Development Application	06.04.2020



Project

Proposed Mixed Use Development

Project Address

971 Richmond Road, Marsden Park

Client

Title

APPLICATION

DEVELOPMENT


iDream Property Pty Ltd and C & S Partners Pty Ltd


Future Roads - Site Plan

Drawn	Scale	Checked
A.S	1:2000 @A3	Checker
Job No	Drawing No.	Issue
2435	01a	F


Future Roads

Part of Future Road to be provided by Lot 1 Neighbouring Development

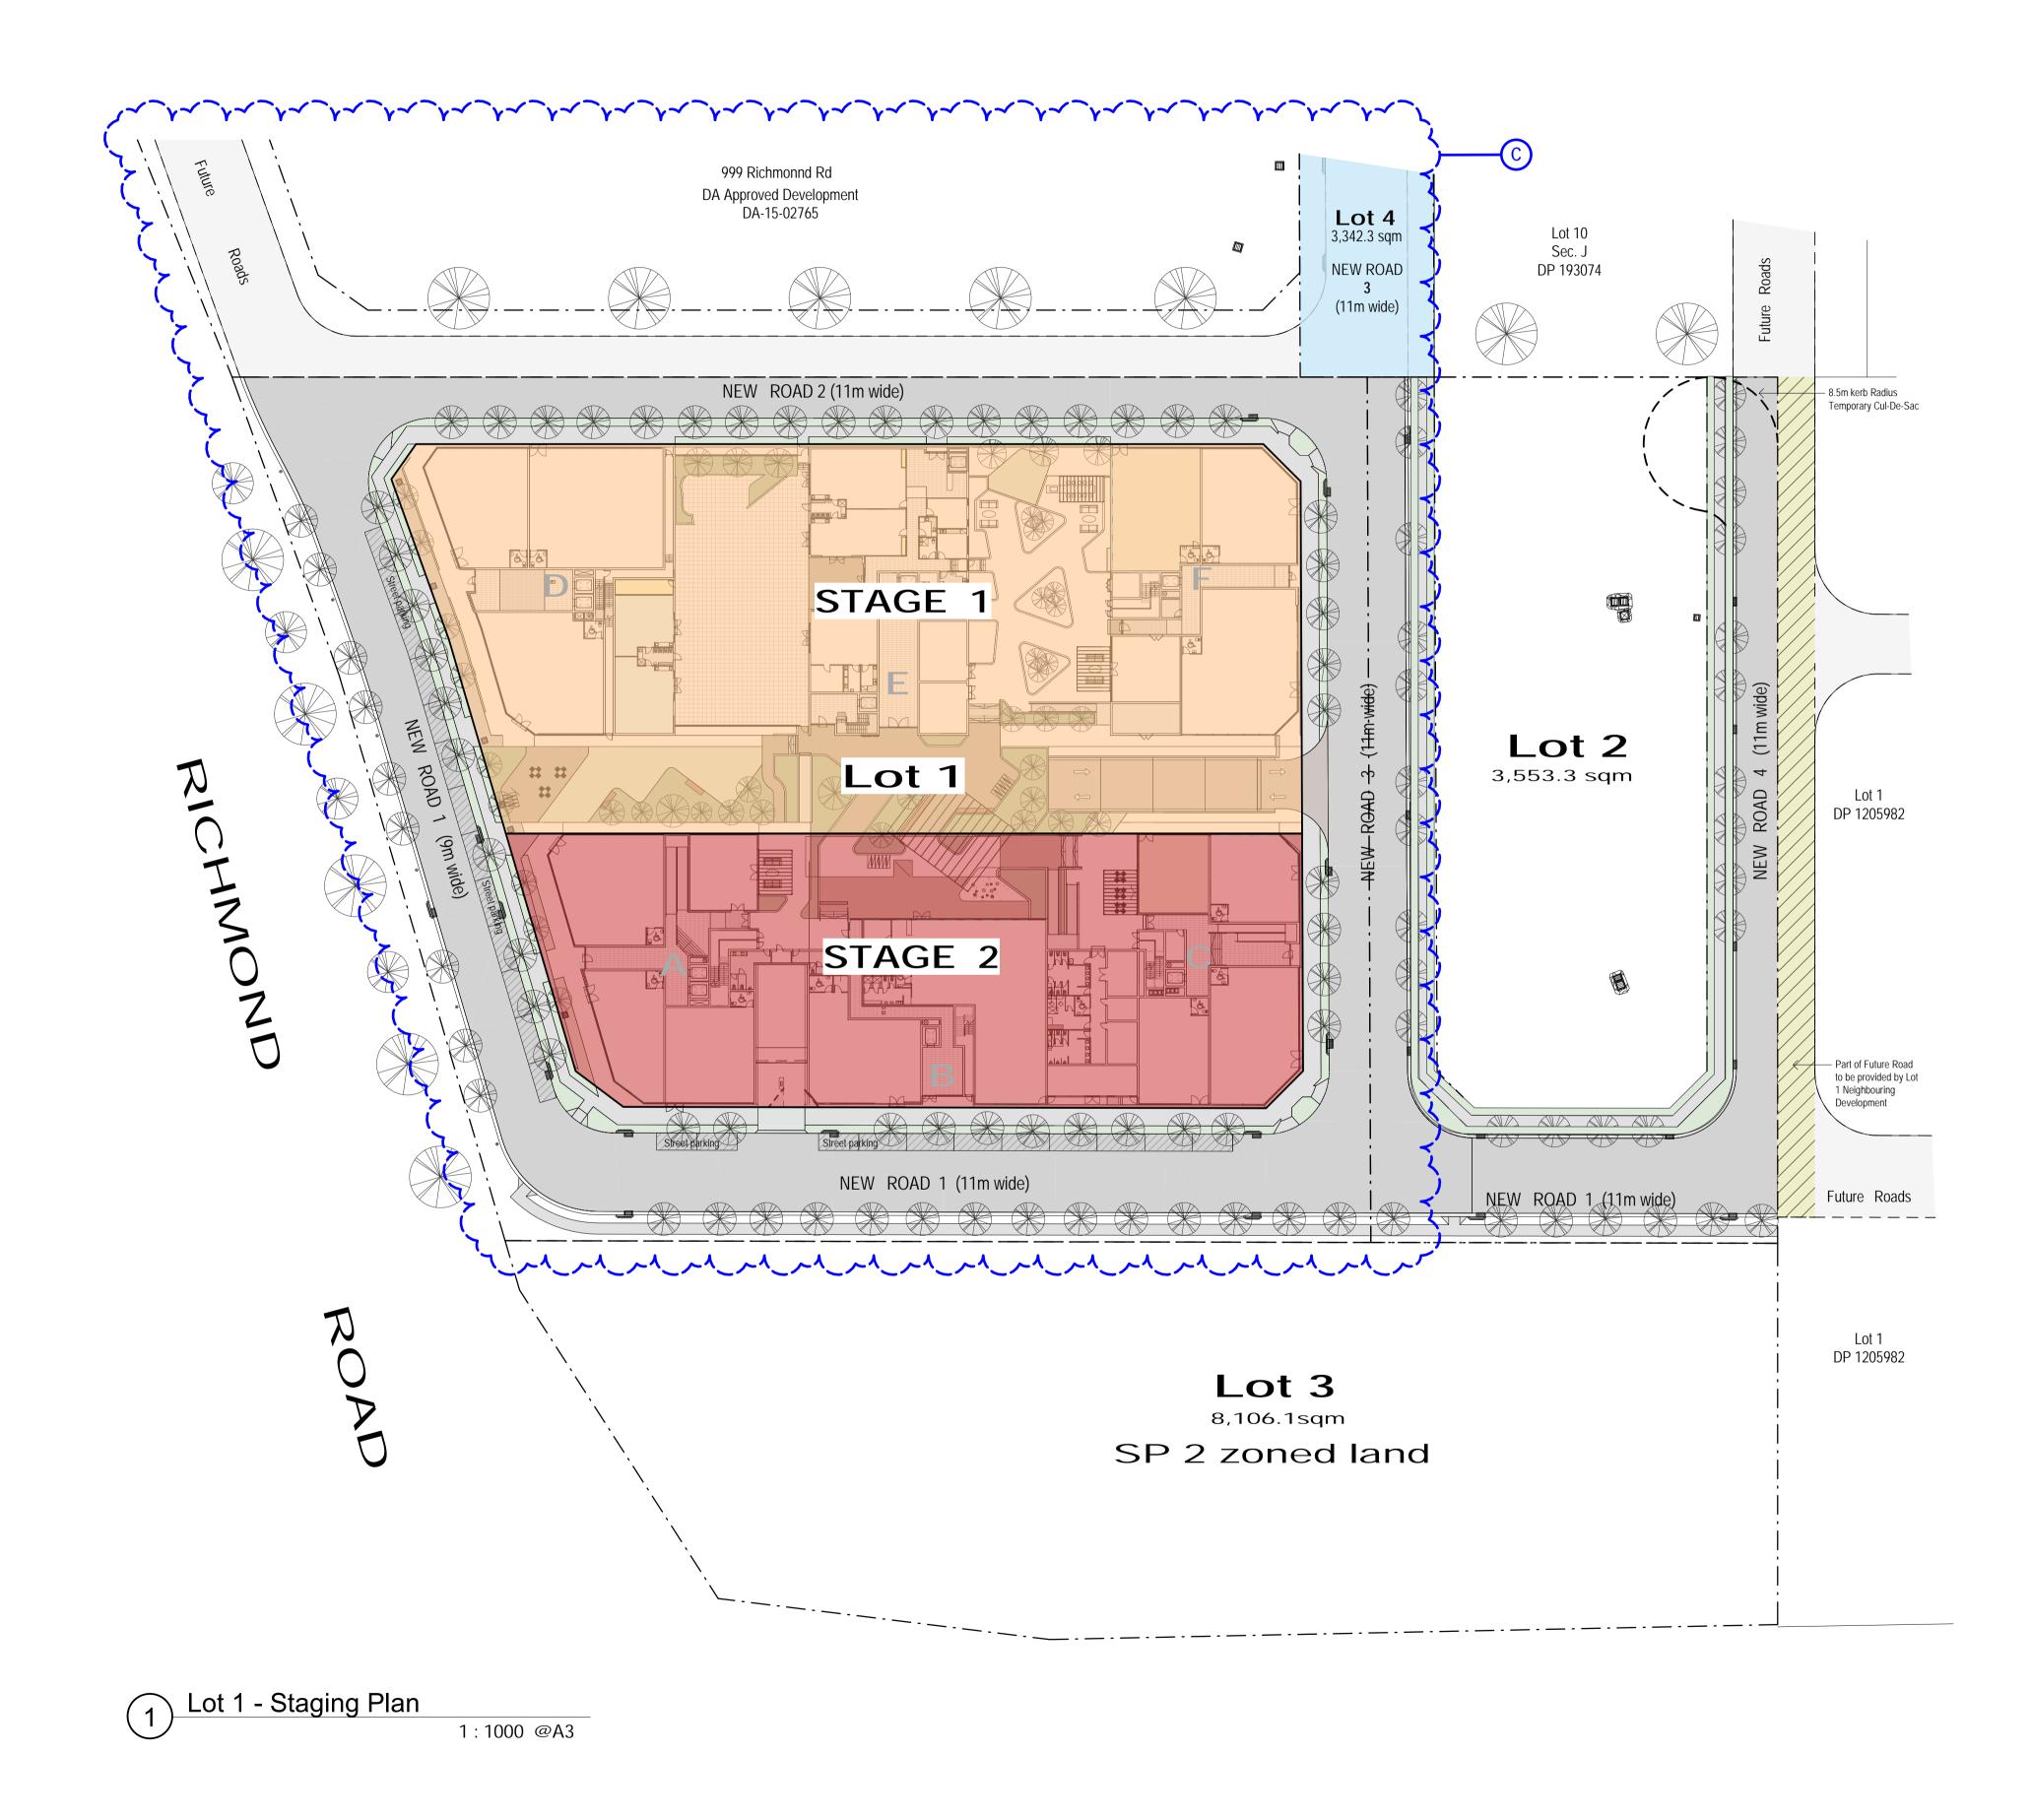


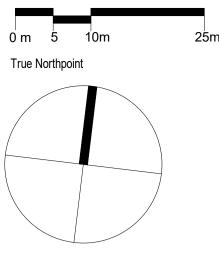

ISSUE C - AMENDMENTS - 15.07.21					
1. Staging Plan updated to match Subdivision Plan and Site Plans.					
	LEG	<u>END</u>			
			STAG	E 1	
			STAG	E 2	
			Issue descrptio		Date 15.07.21
		t Boundaries agin Plan Ad	Amended + Gener ded	ral Amendments	18.11.20 31.08.20
	a	r	hi	tex	\mathbf{k}
	Ryleton pt 5888	y Itd t/as /	Architex	T : 02 96	533
	abn 32 00 Level 3, 7		emai	418 402 919 @architex.co .architex.com.	
	Parramatta		50 t: Robe	ert Del Pizzo / Reg. No. 397	
				r Reg. No. 597	
	Project				
NC	Propos	sed Mix	ked Use De	evelopmer	nt
	Project A	Address			
APPLICATIO	_		d Road, M	arsden Pa	ırk
Ы	Client	n Dron	orty Dty Ltr	land	
AF		•	erty Pty Lto ers Pty Ltd	I di lu	
ENT,	Title				
	lot	1-9	Staging	n Plan	
M	Lot			j i iari	
ЮЧ					
	Drawn		Scale	Checked	
DEVEL	A.S		1:1000 @A3	Checke	
DE	^{Јов No}		Drawing No.	Issue	С
	2400				$\mathbf{\circ}$

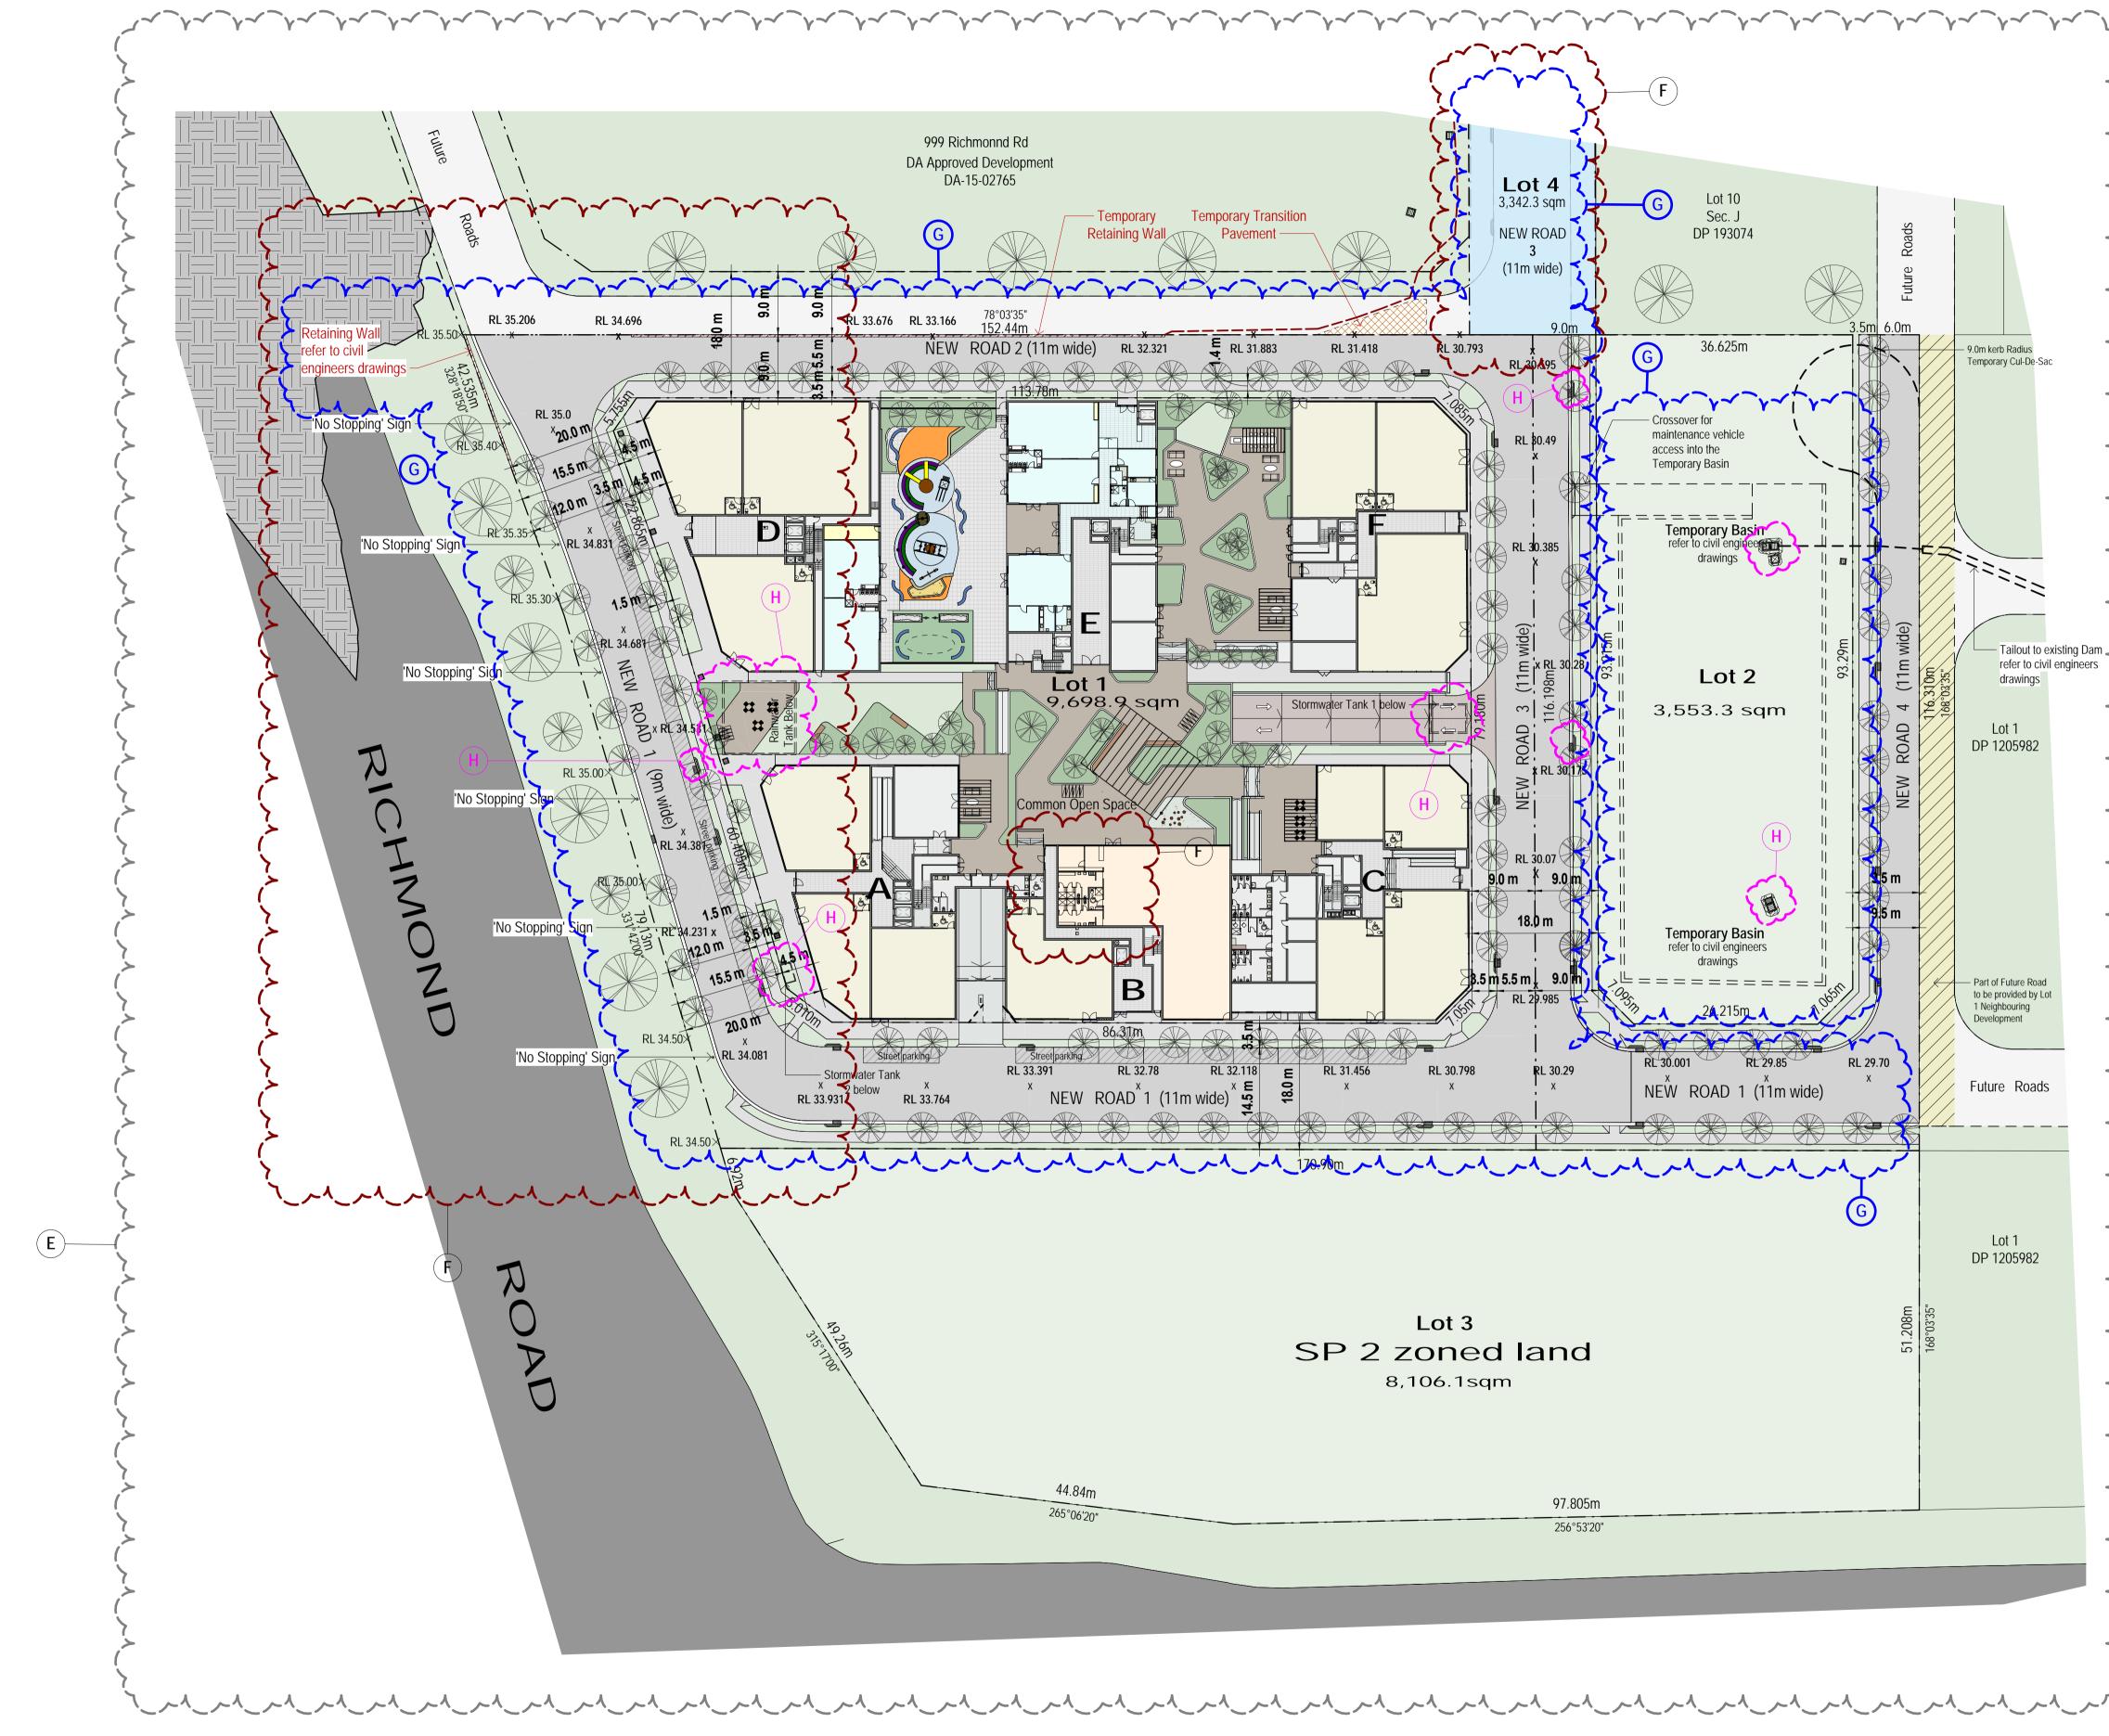




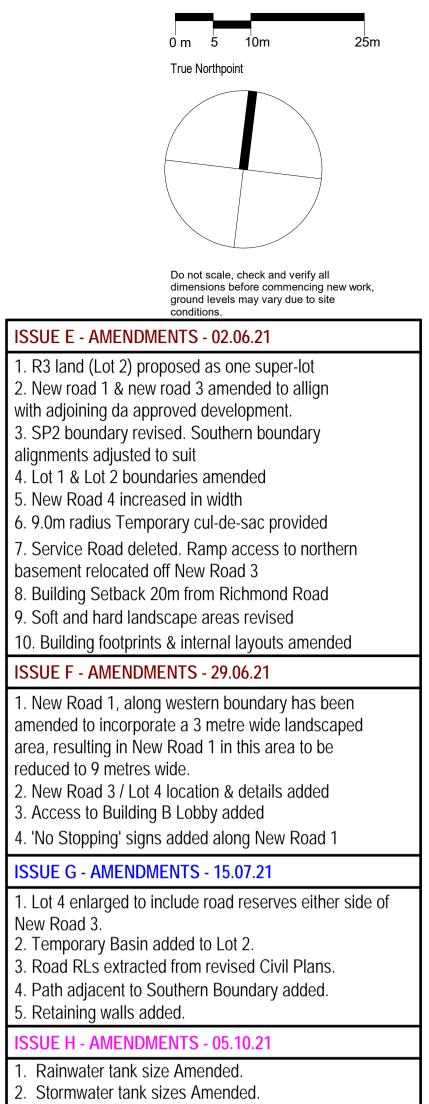

3. Drainage Pits amended to reflect updated civil drawings.

Issue	Issue descrption	Date
Н	Amendments To Address SOFAC	05.10.21
G	Amendments To Address SOFAC	15.07.21
F	Amendments To Address SOFAC	29.06.21
E	Amendments To Address SOFAC	02.06.21
D	Lot Boundaries Amended + General Amendments	18.11.20
С	New Road Location & Sizes Adopted, Waste Collection Areas Added, Units Added + General Amendments	08.07.20
В	Waste Collection bays added, Units added + General Amendments	02.04.20

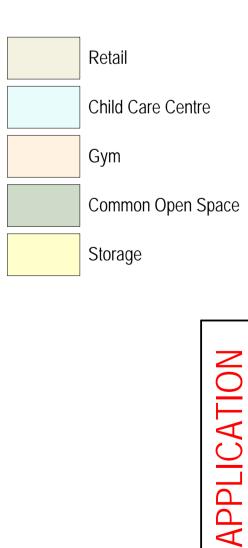





iDream Property Pty Ltd and C & S Partners Pty Ltd Title


Overall Site Plan


DEVELOPMENT

Drawn	Scale	Checked
A.S	1:1000 @A3	Checker
Job No	Drawing No.	Issue
2435	02	H

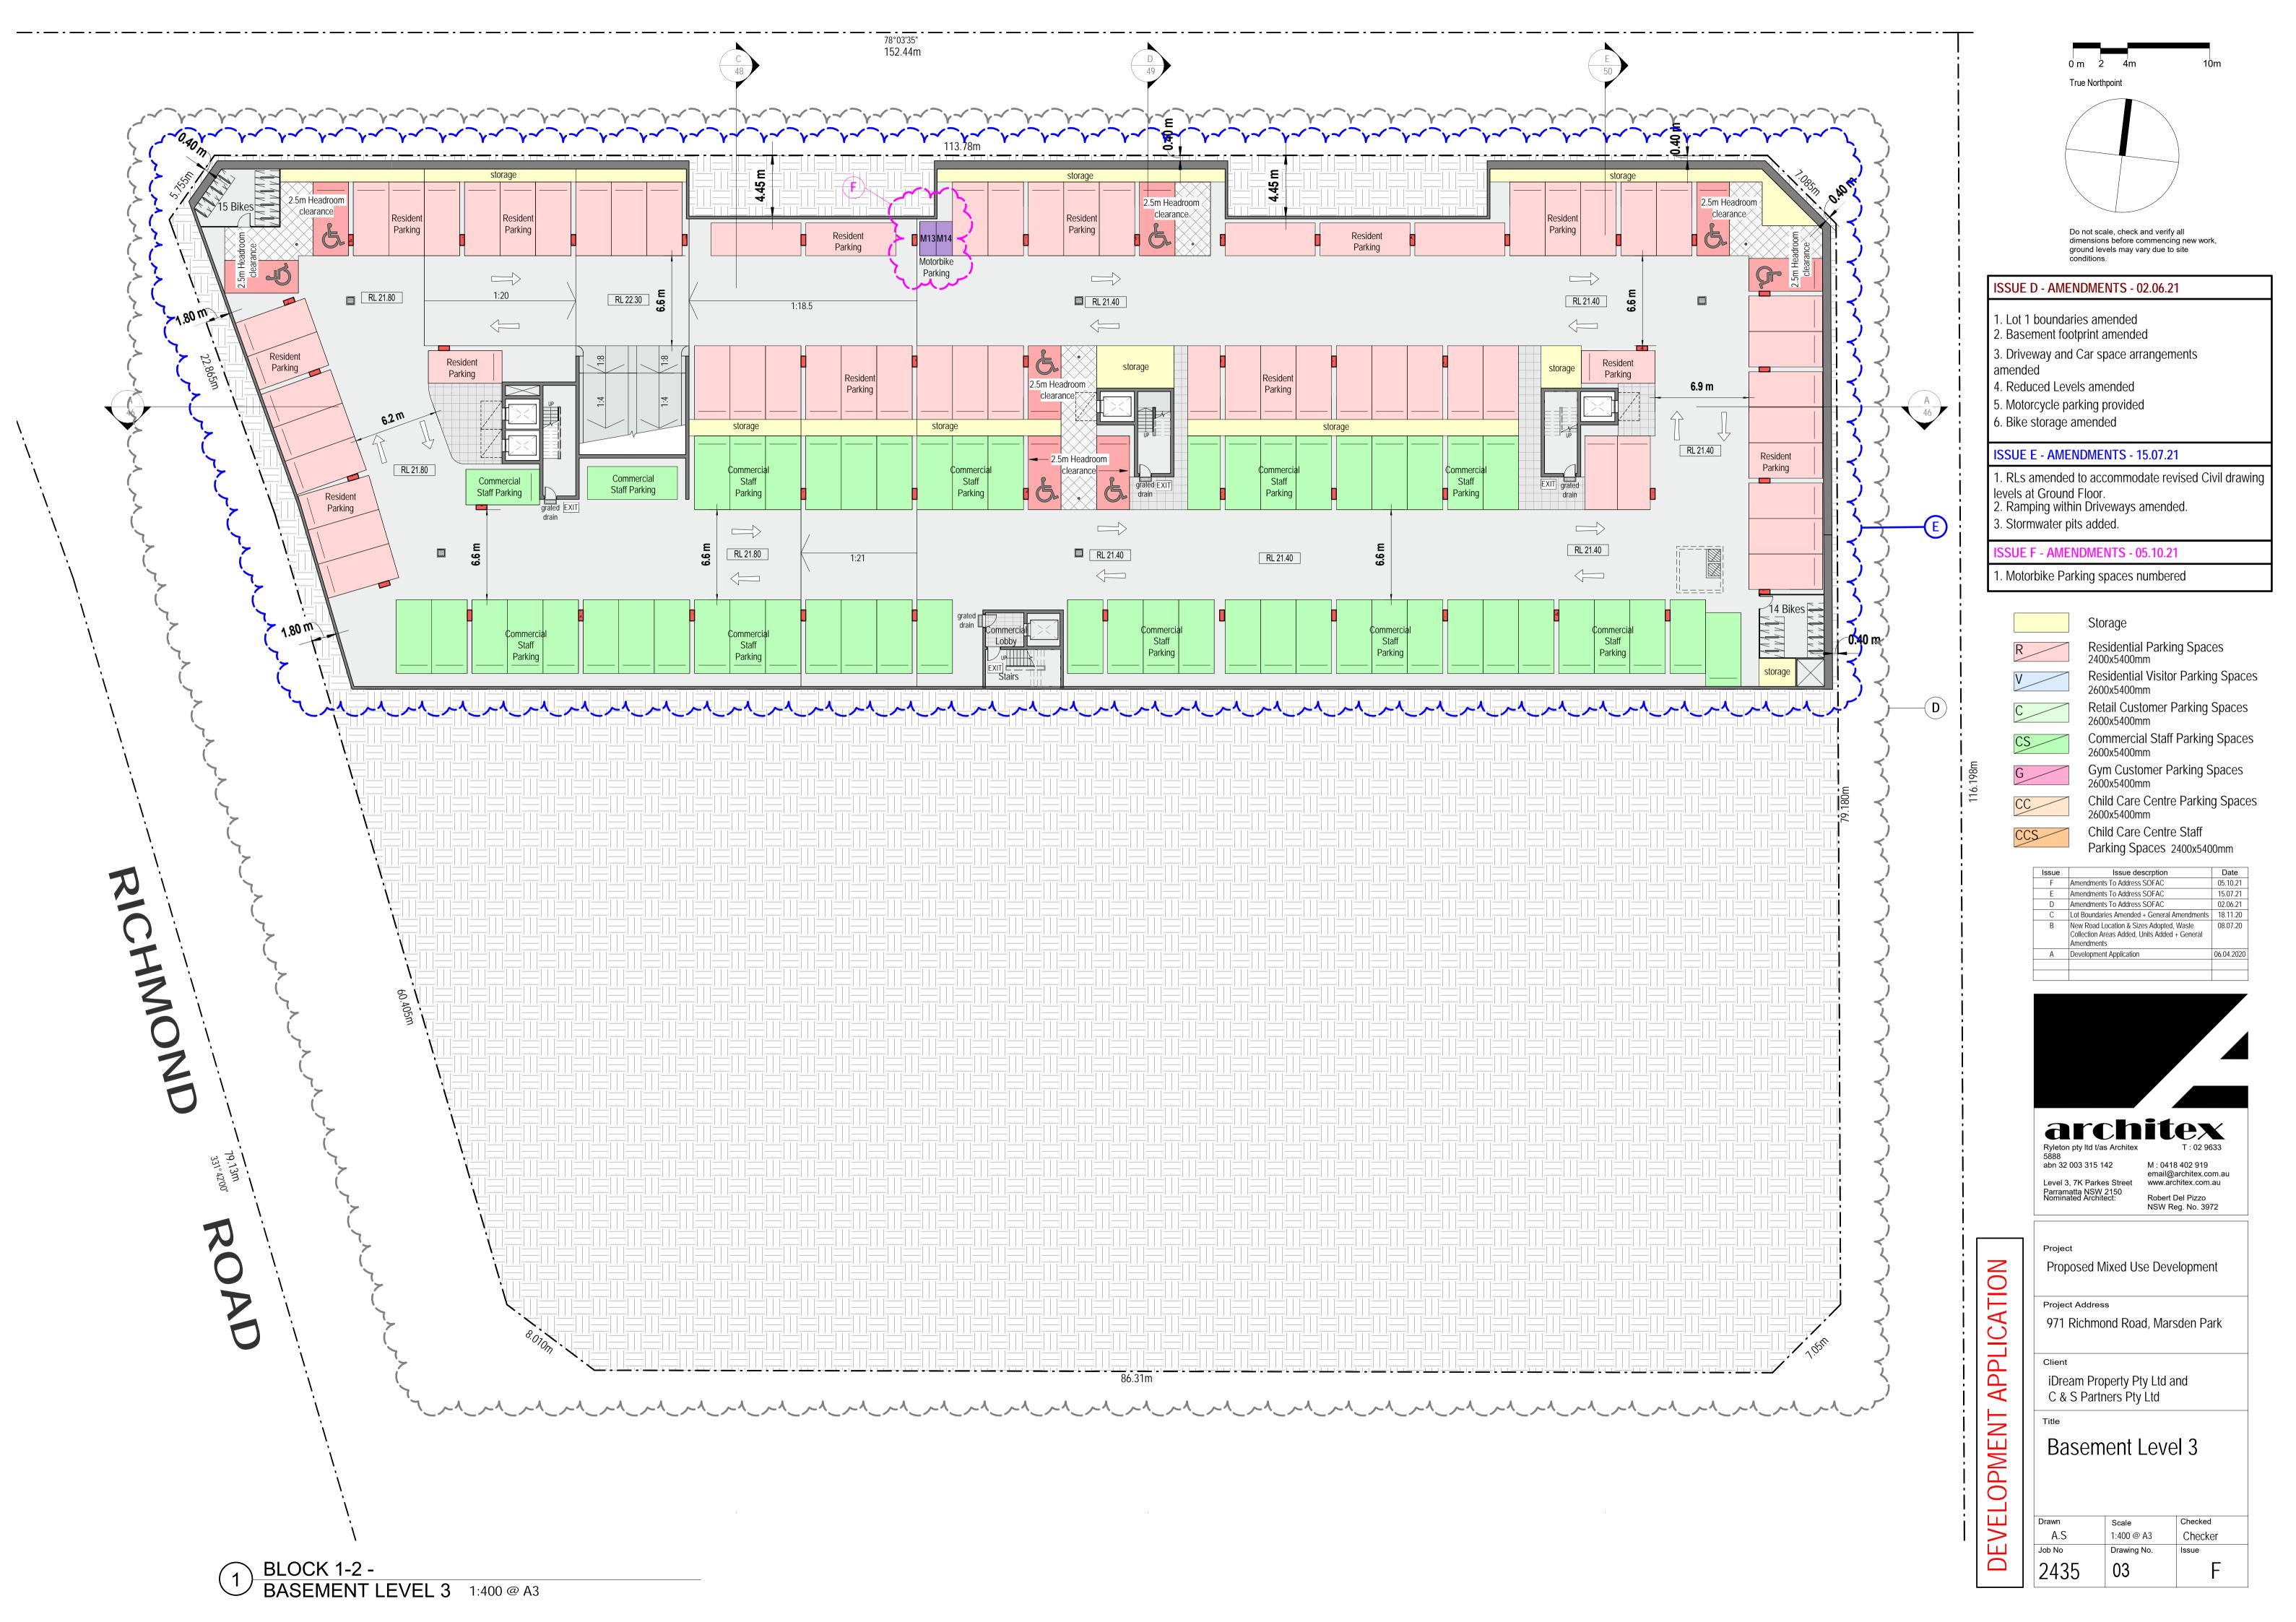

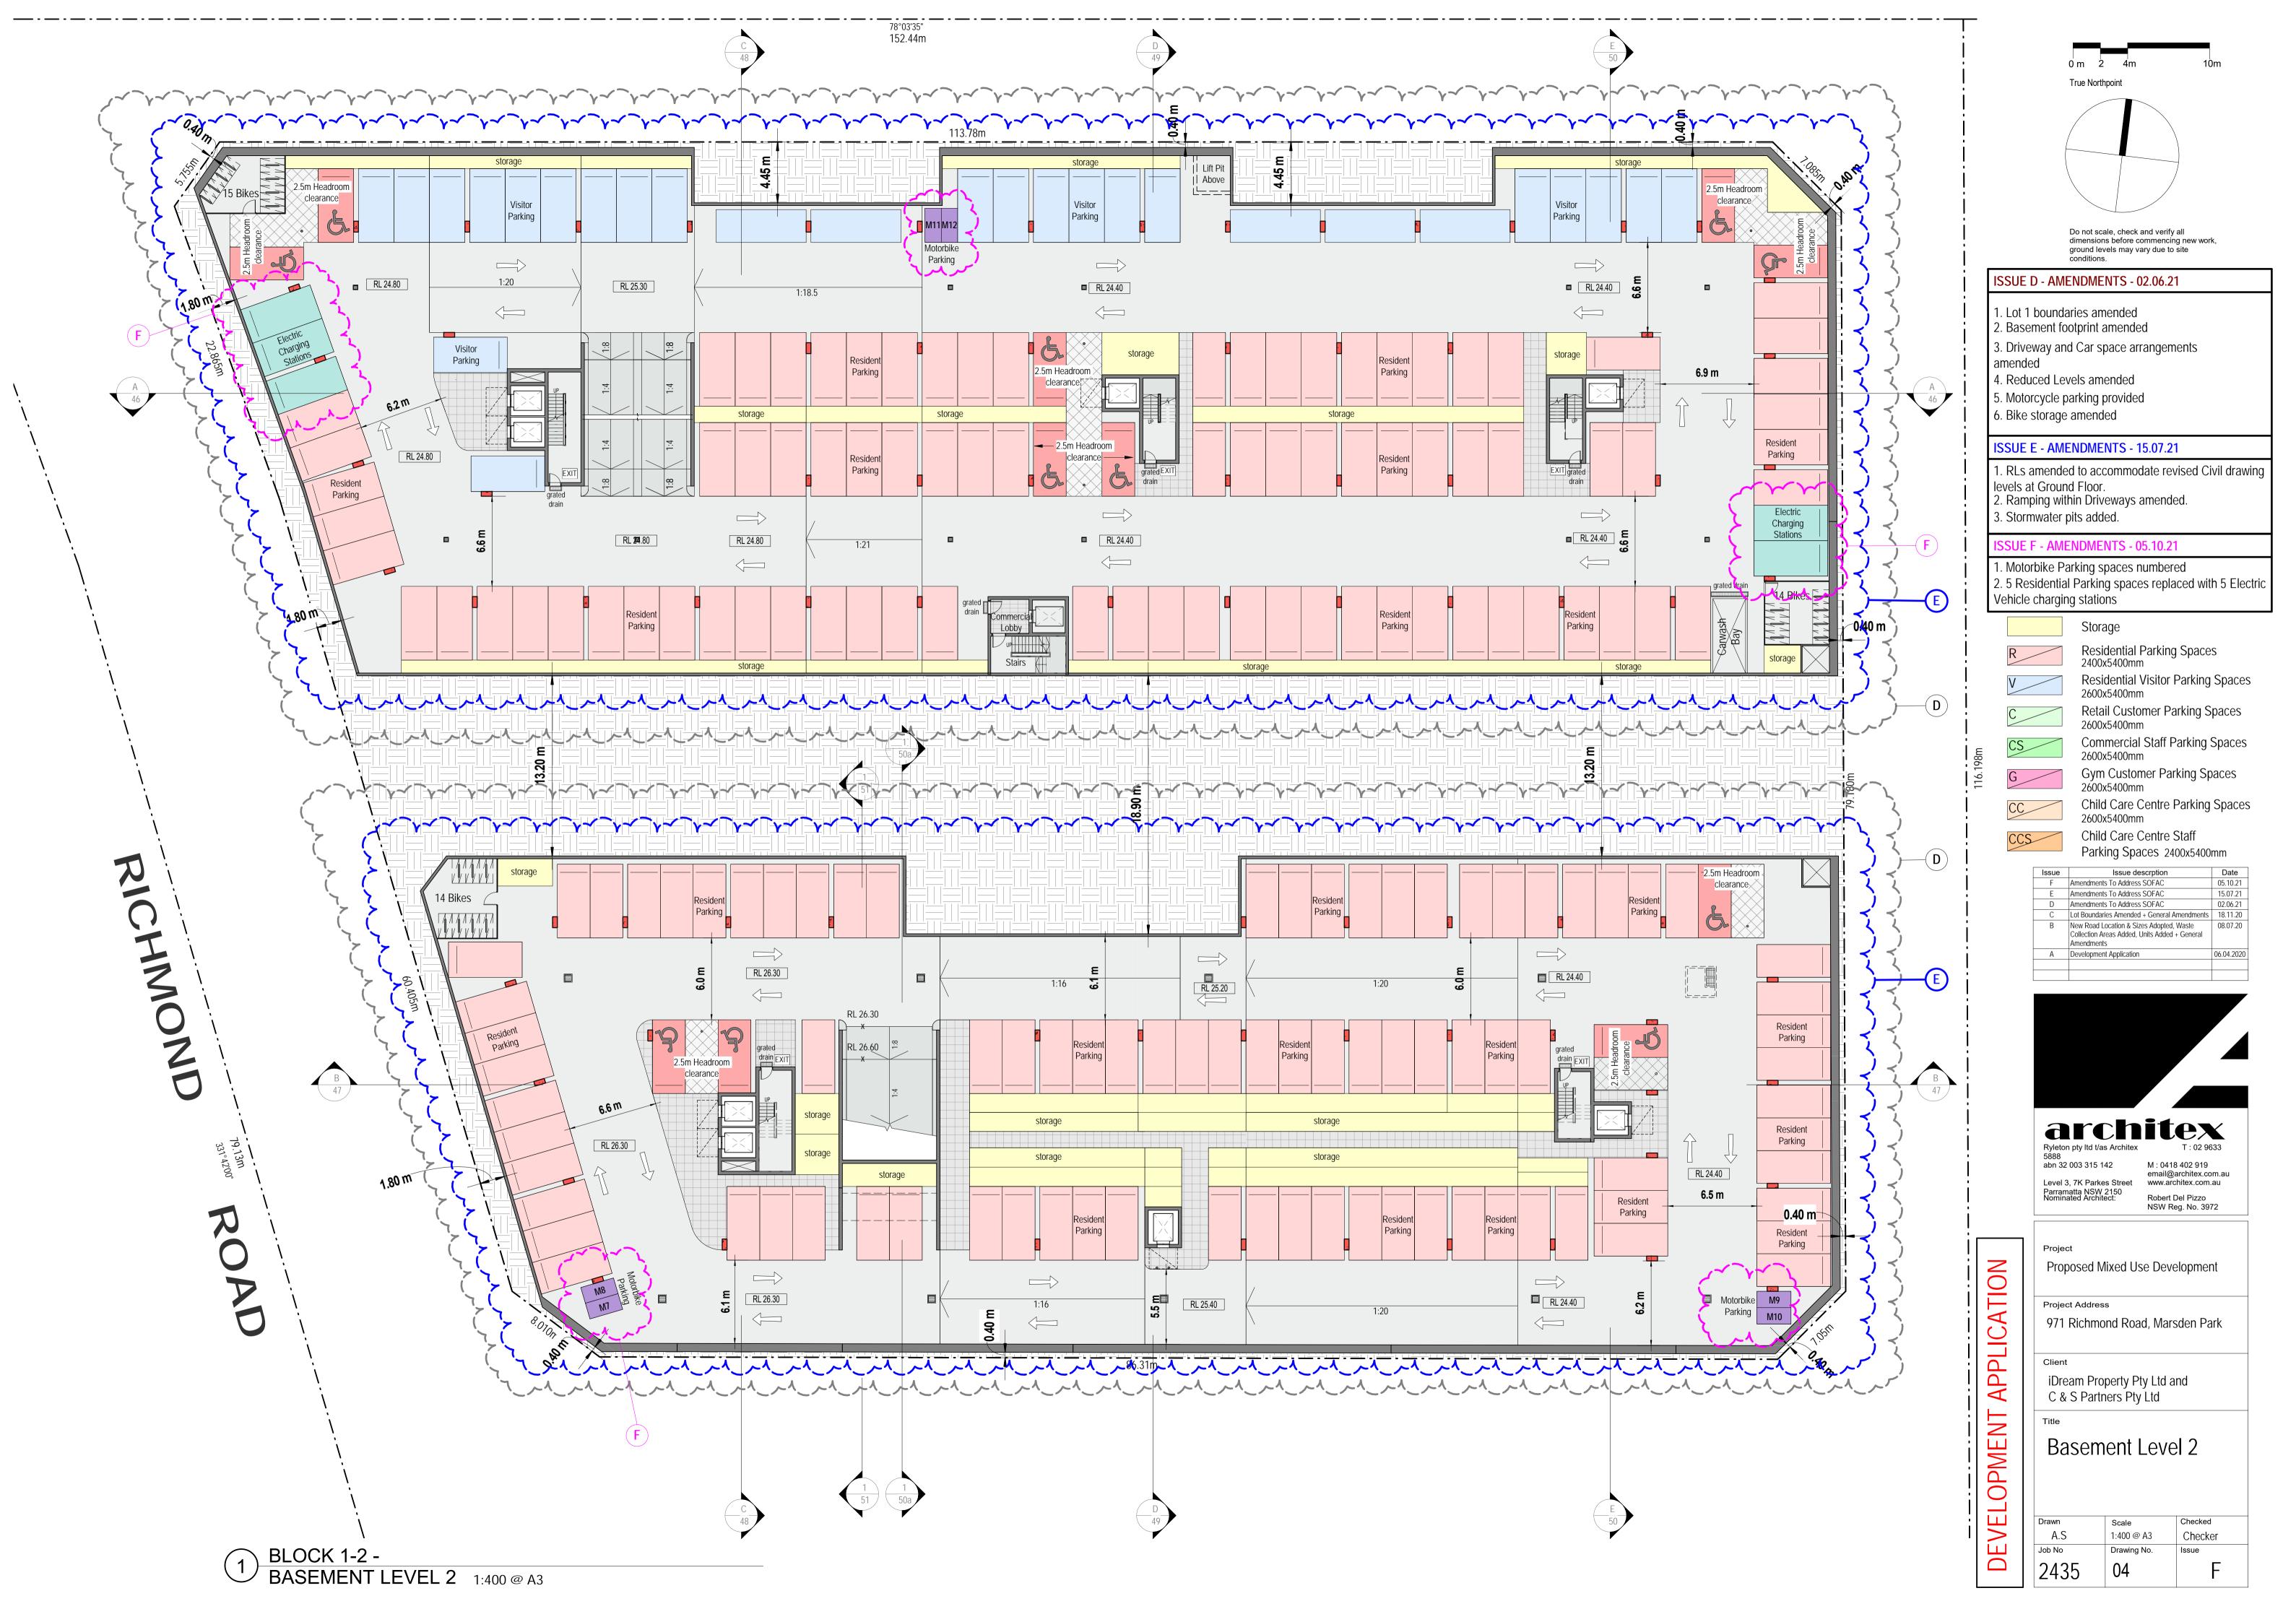

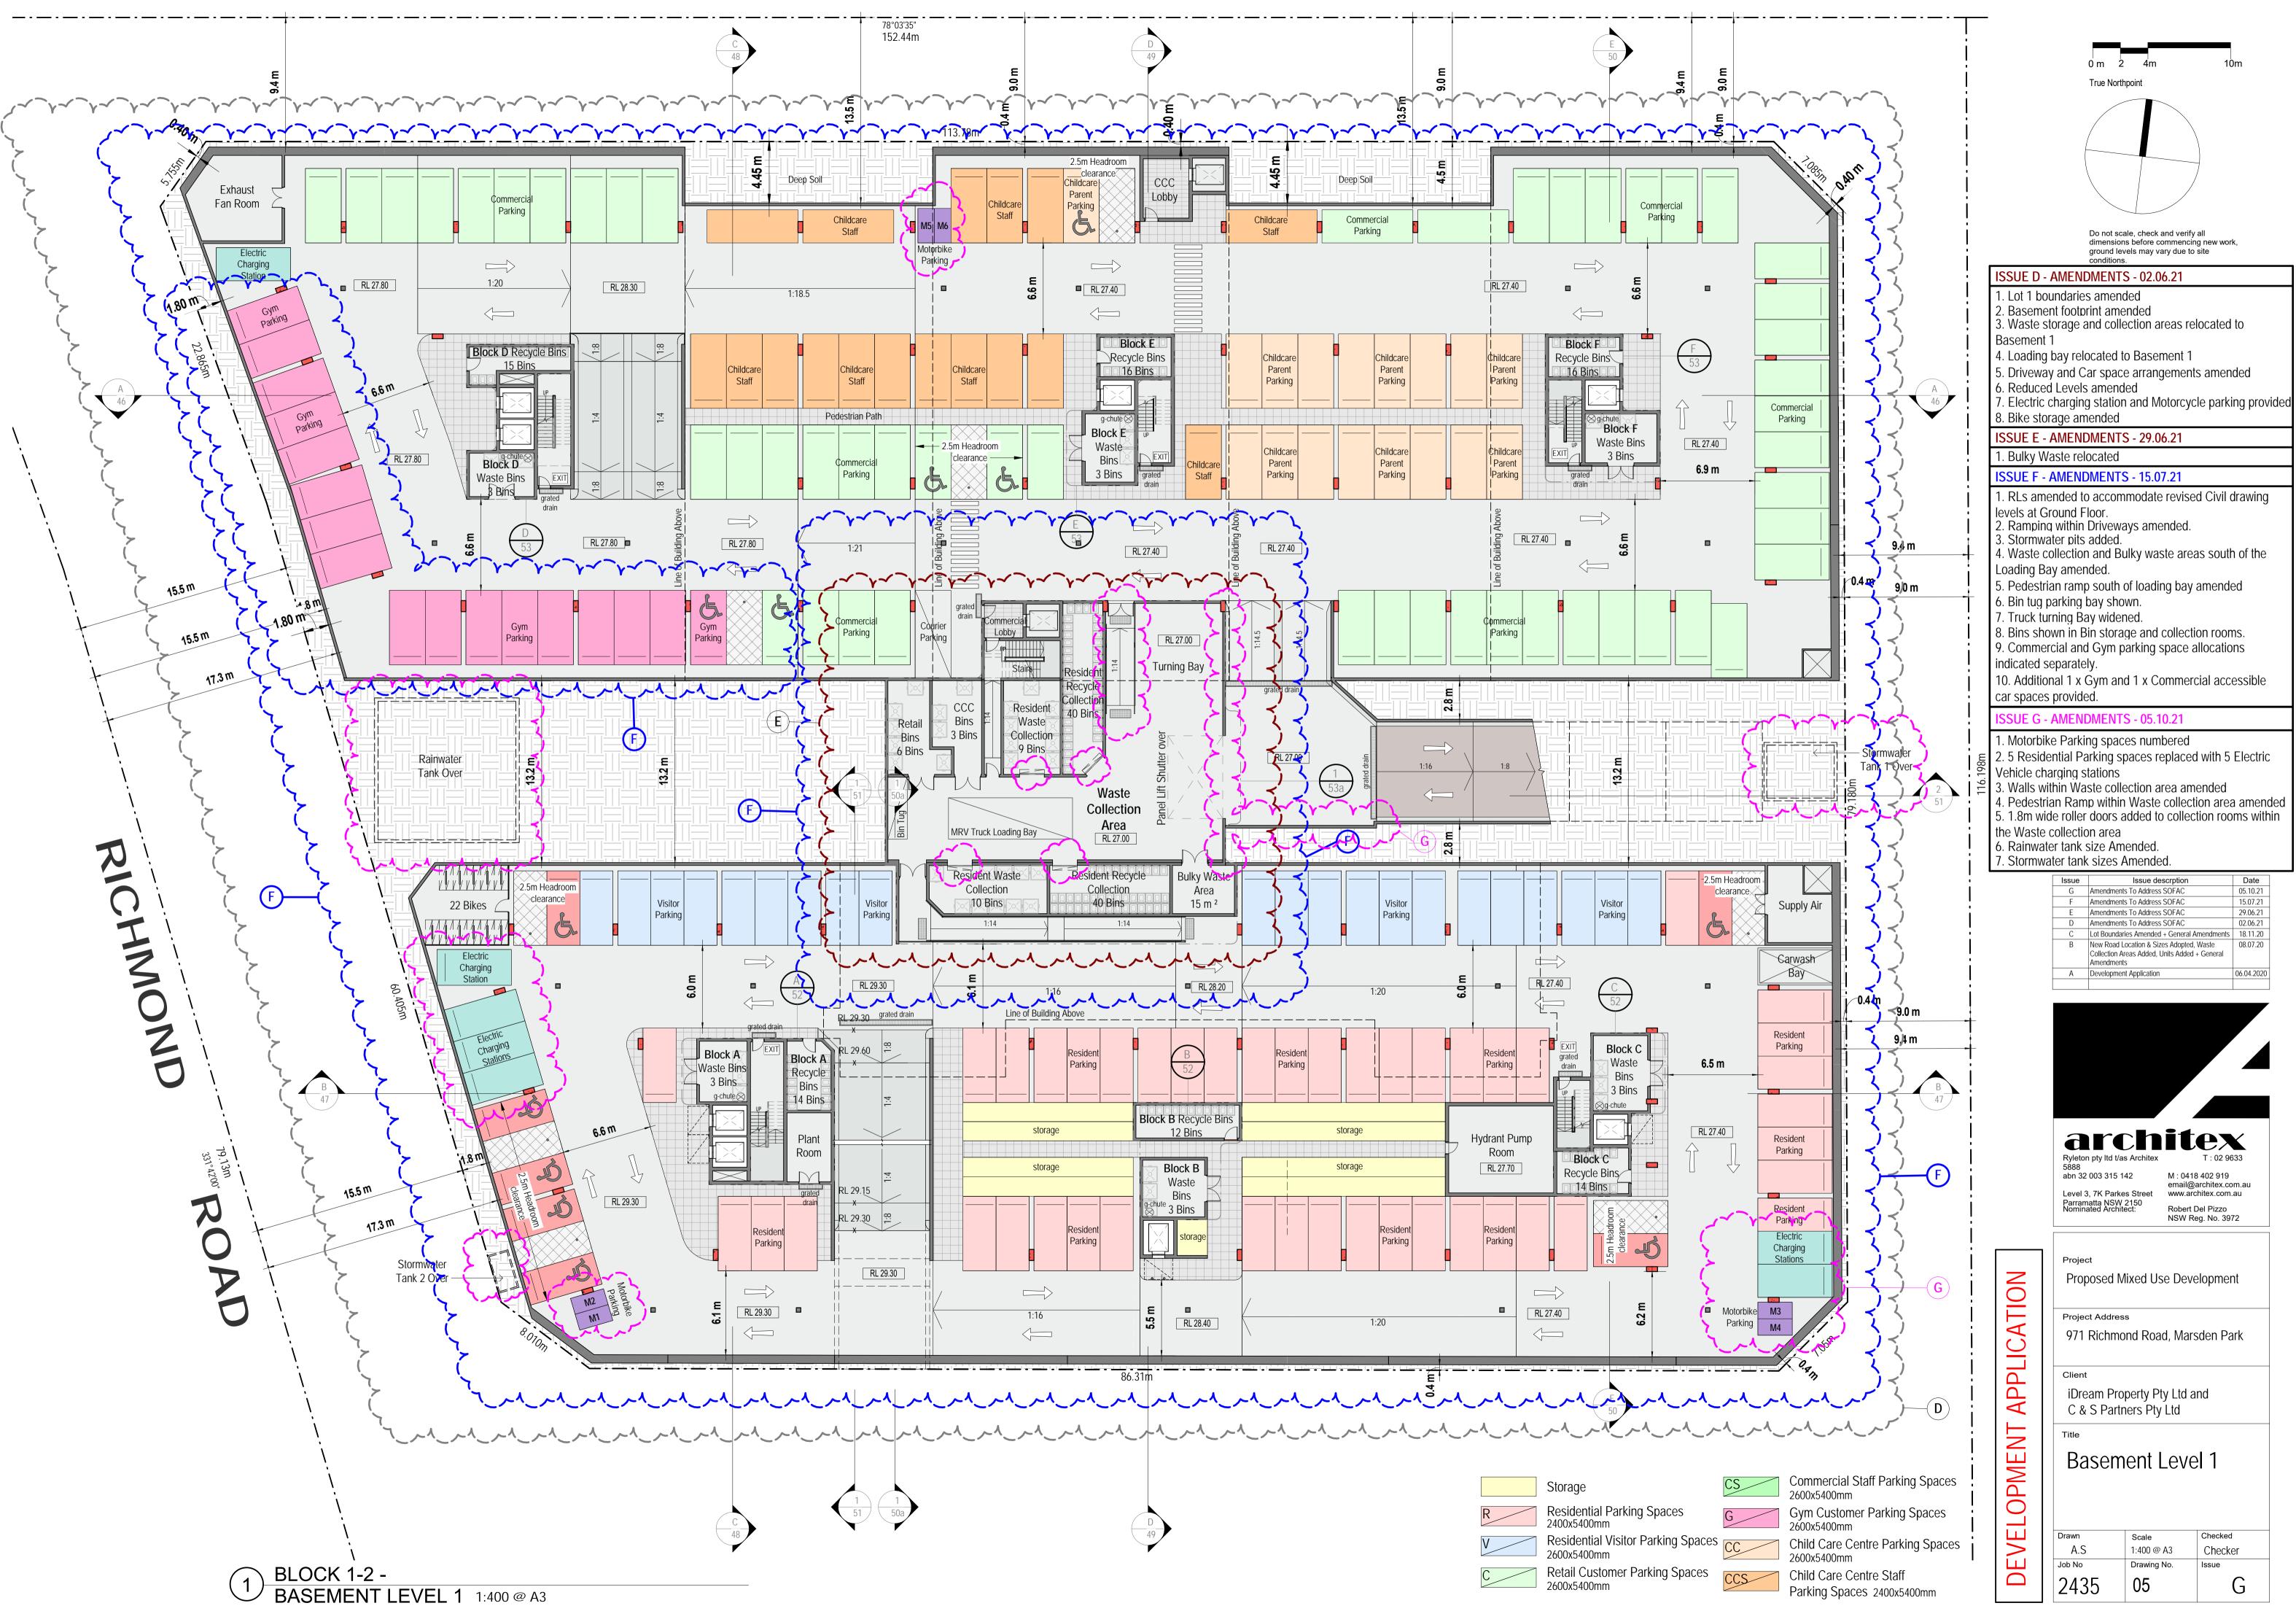

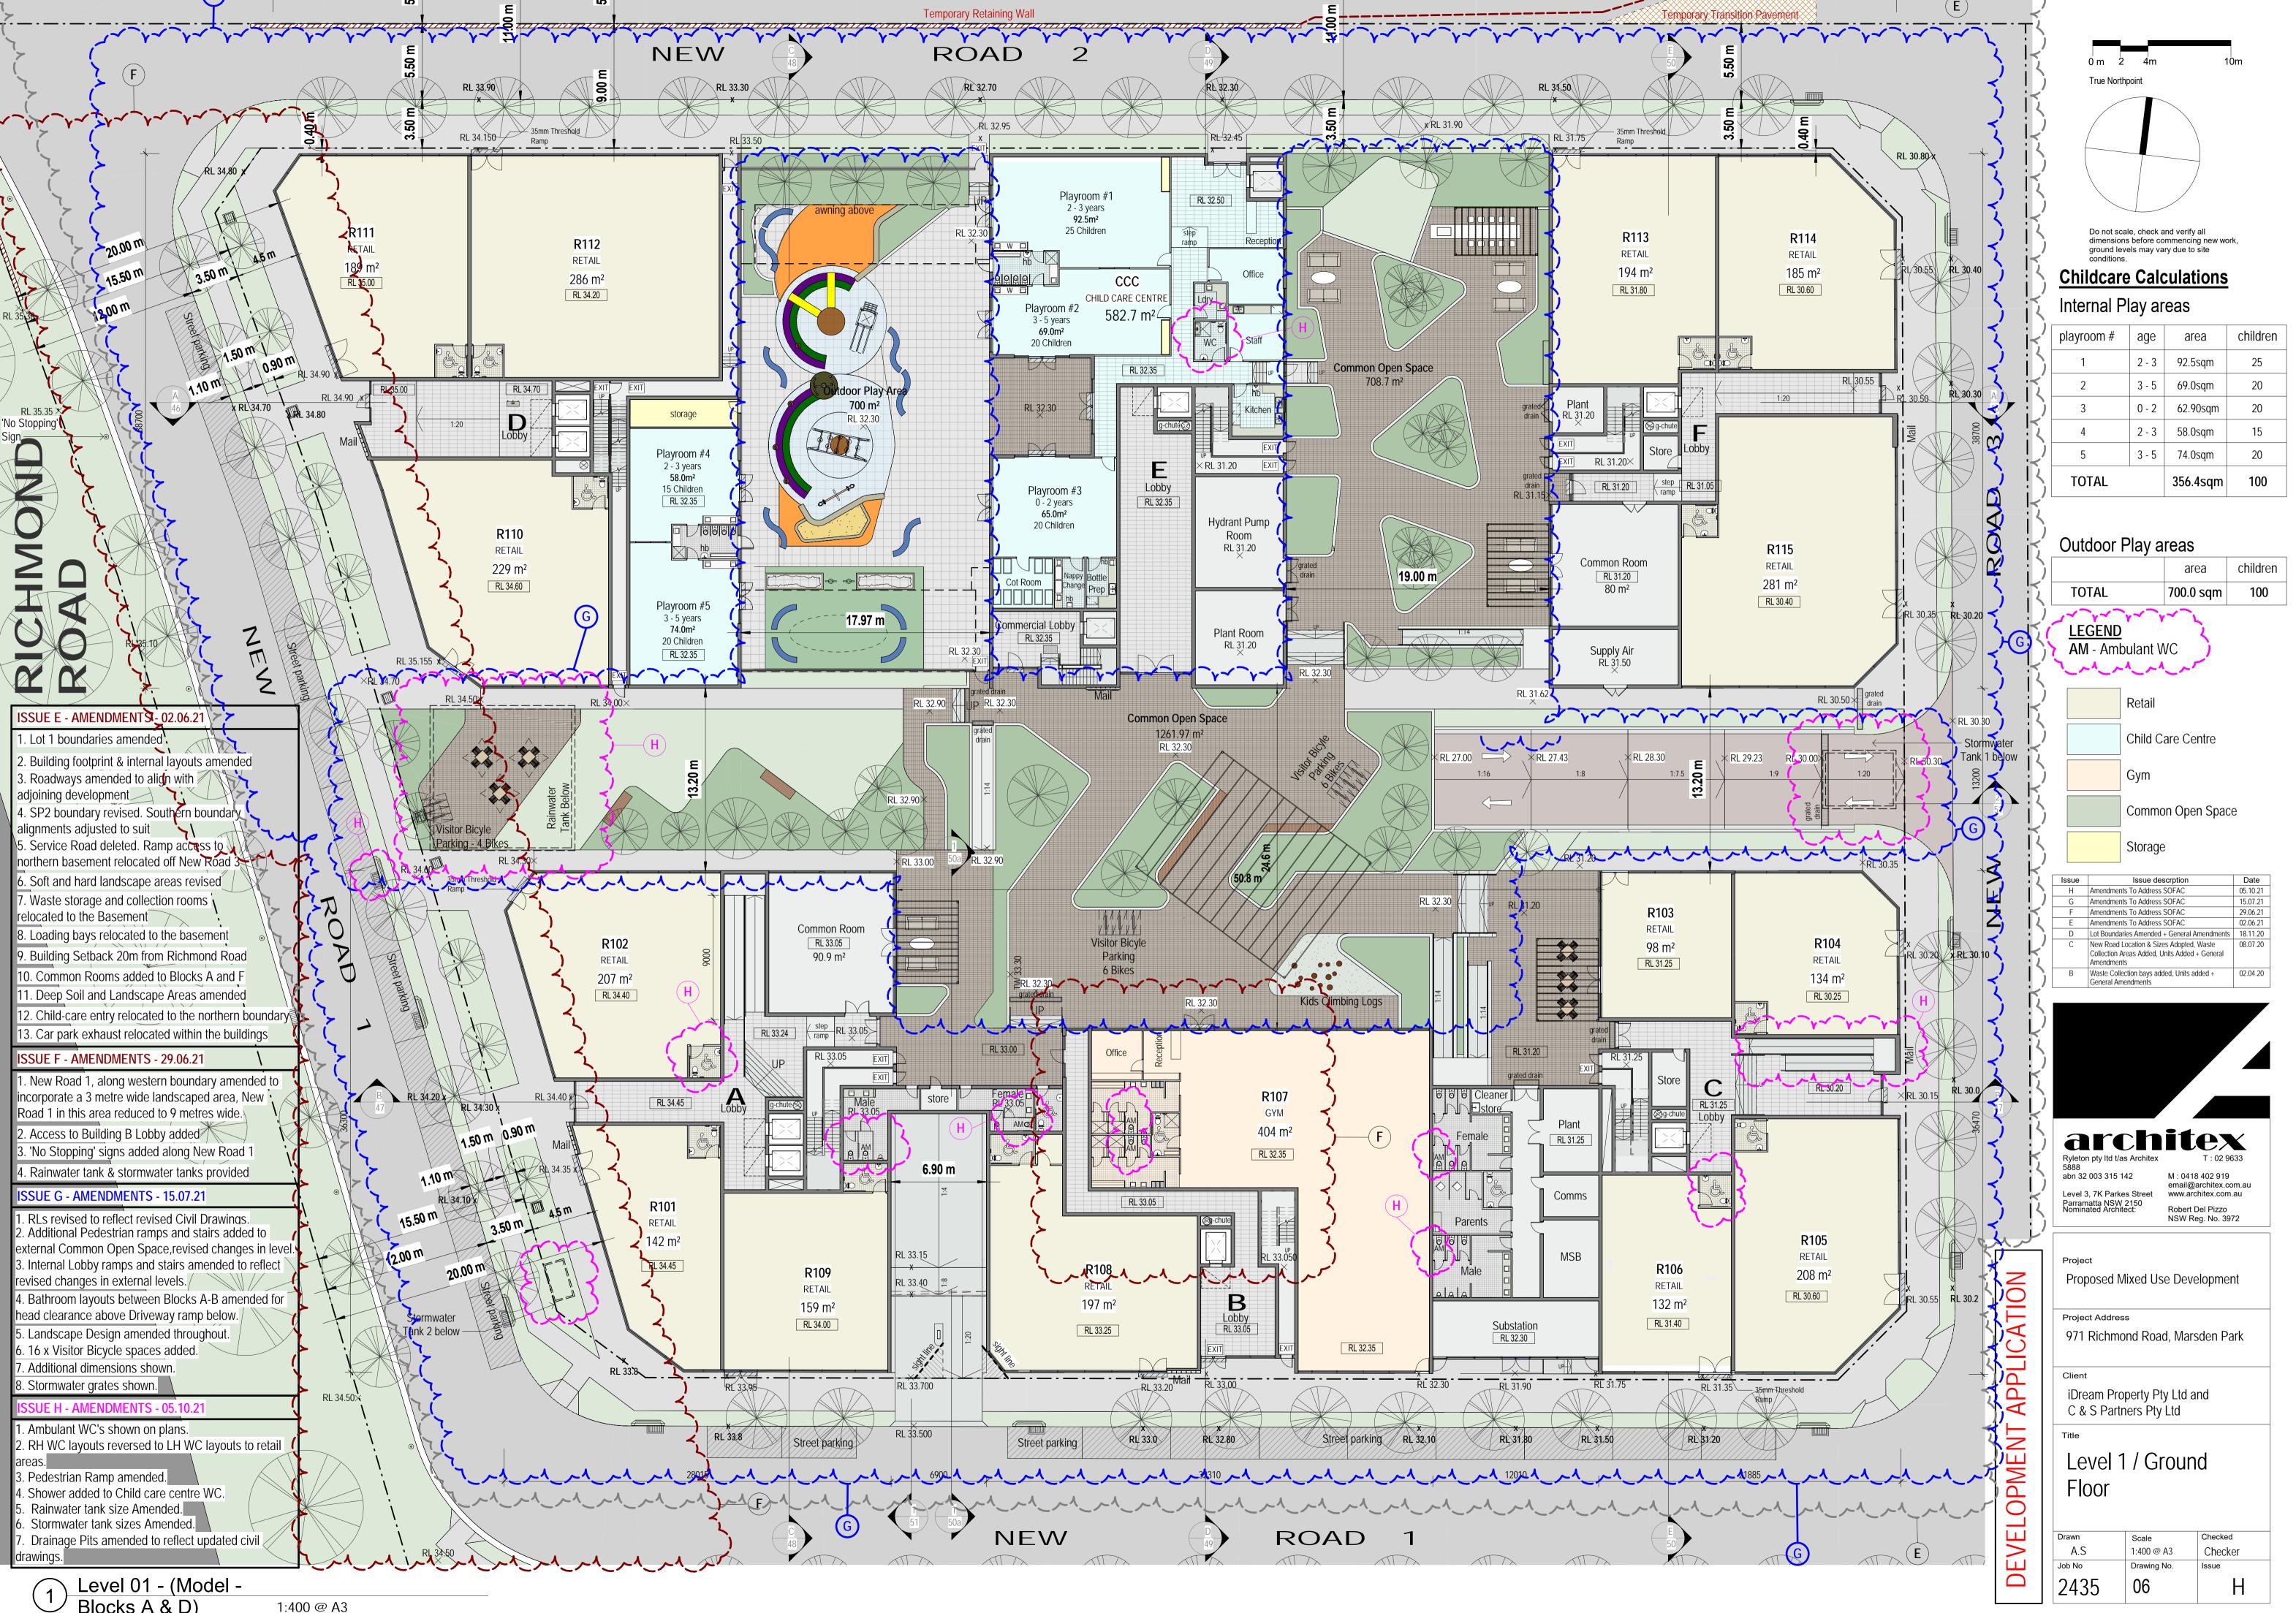


Blocks A & D)








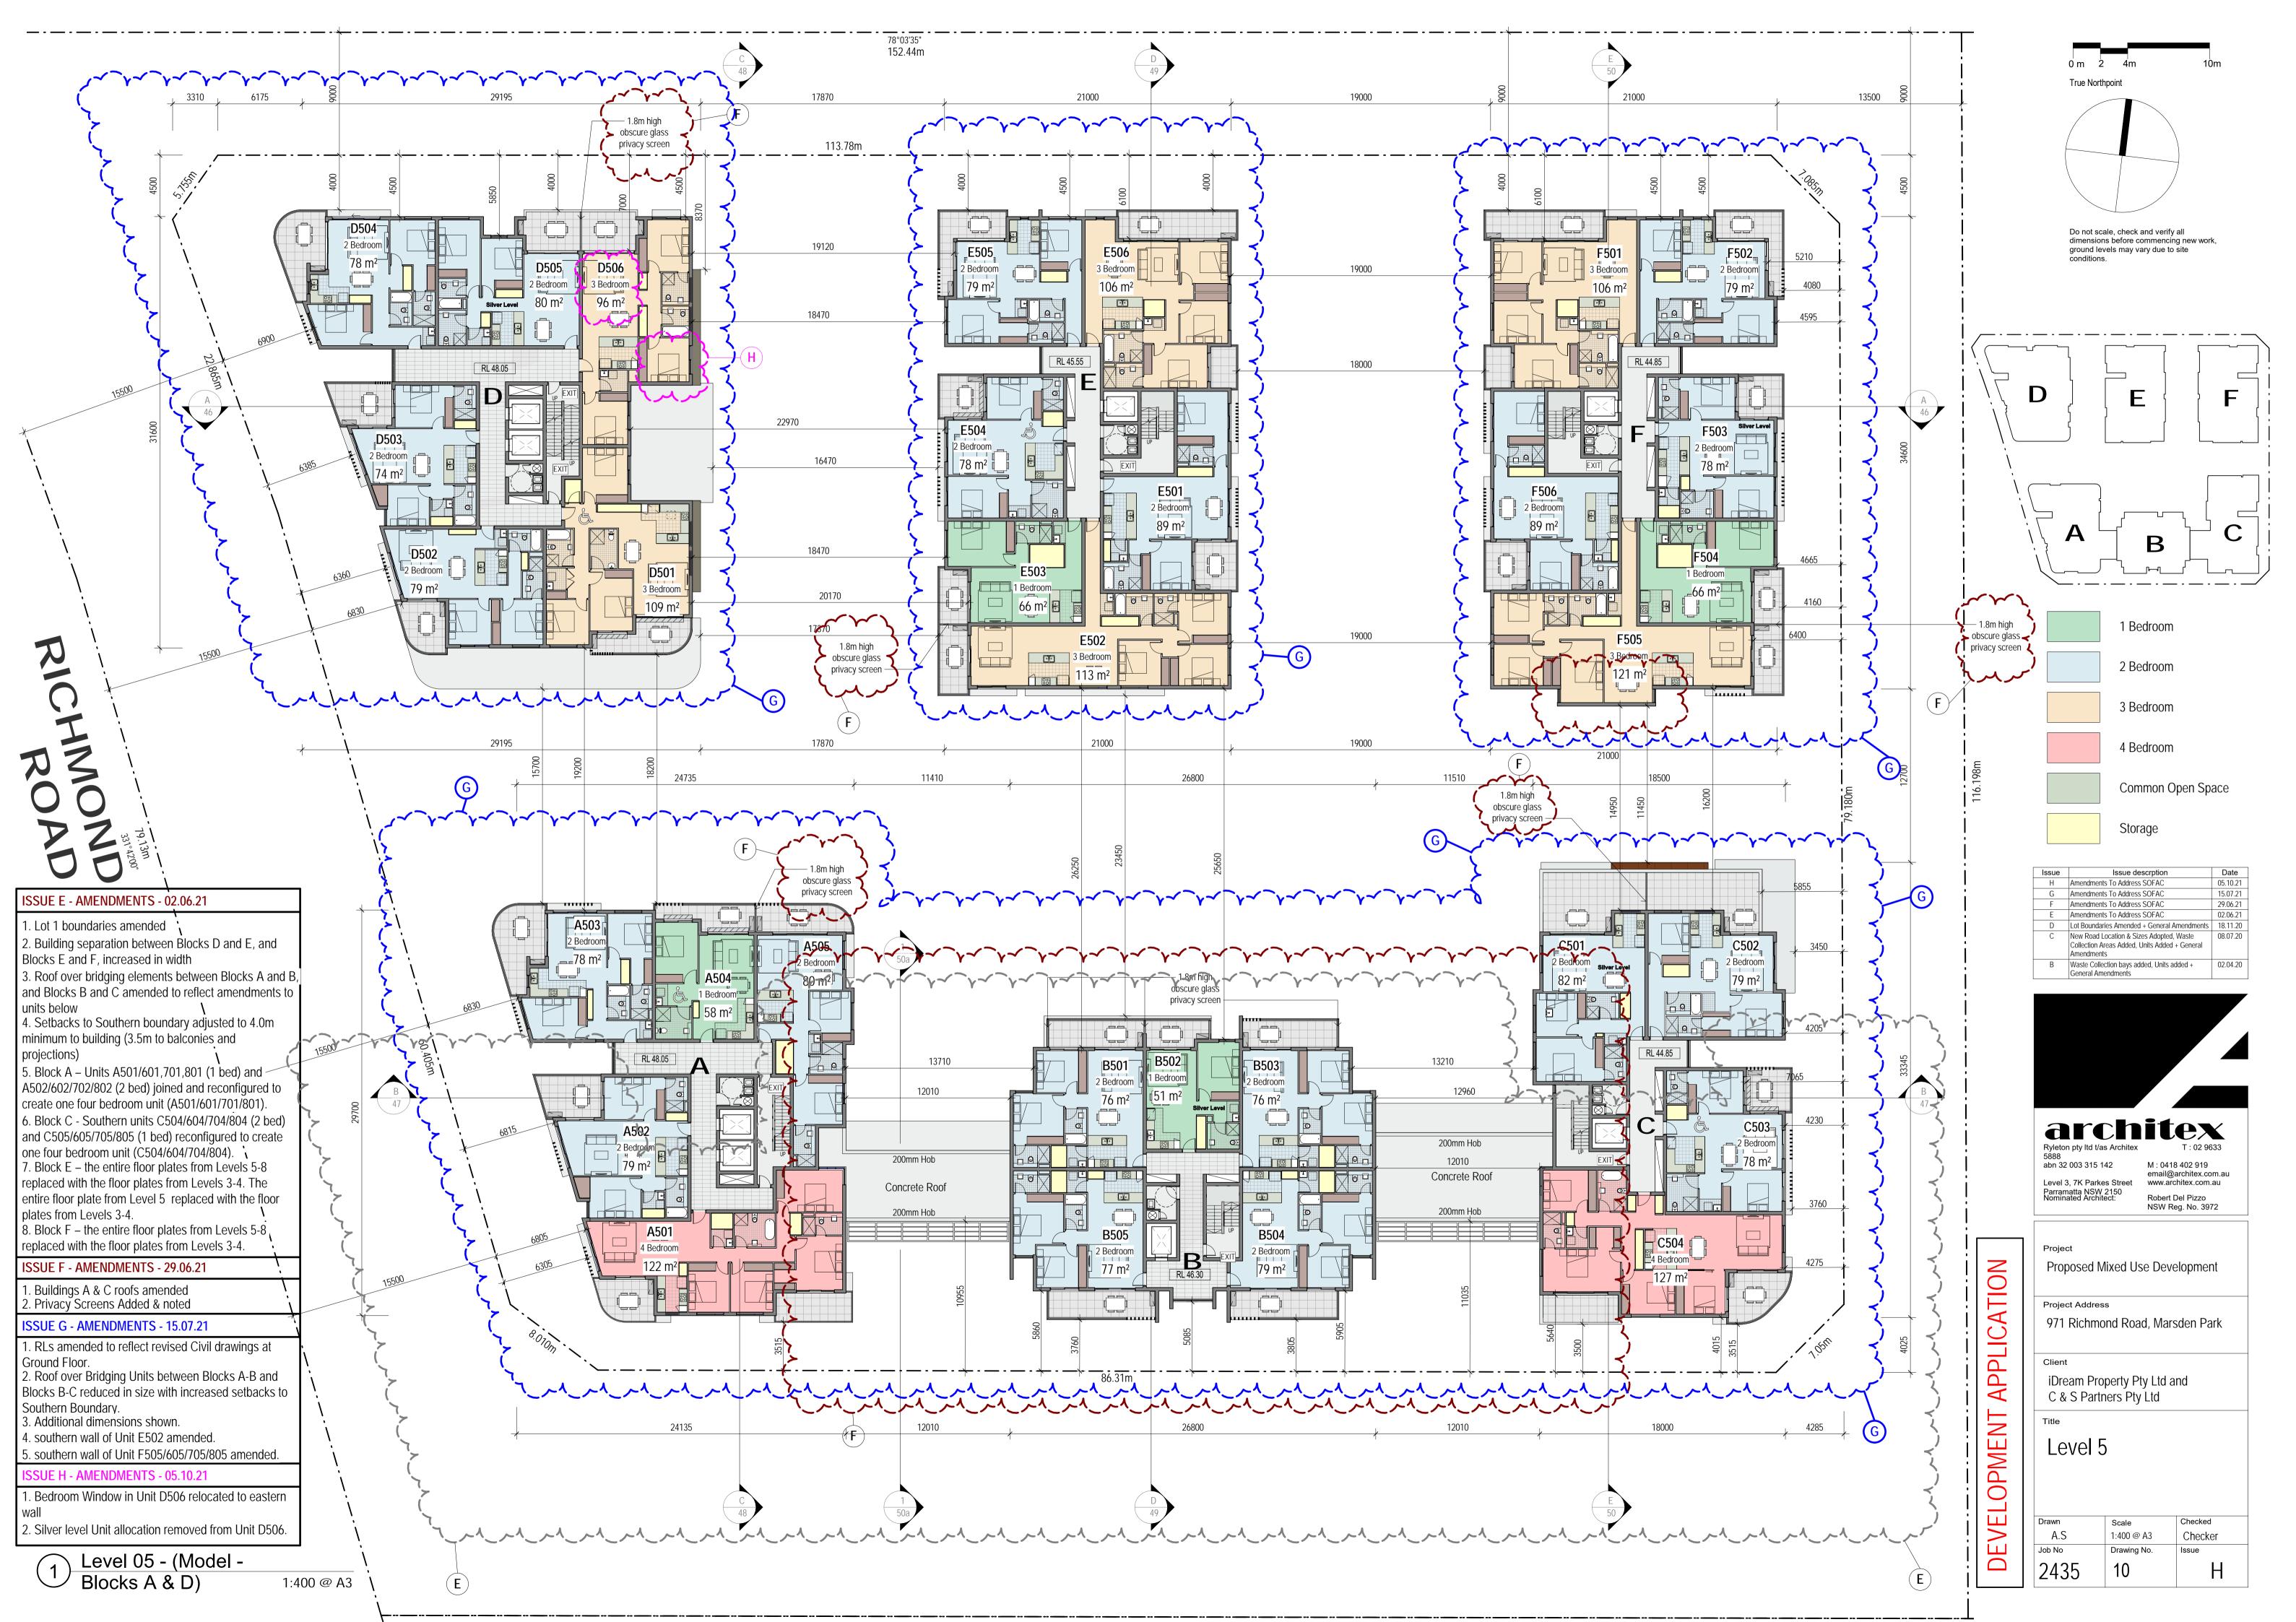










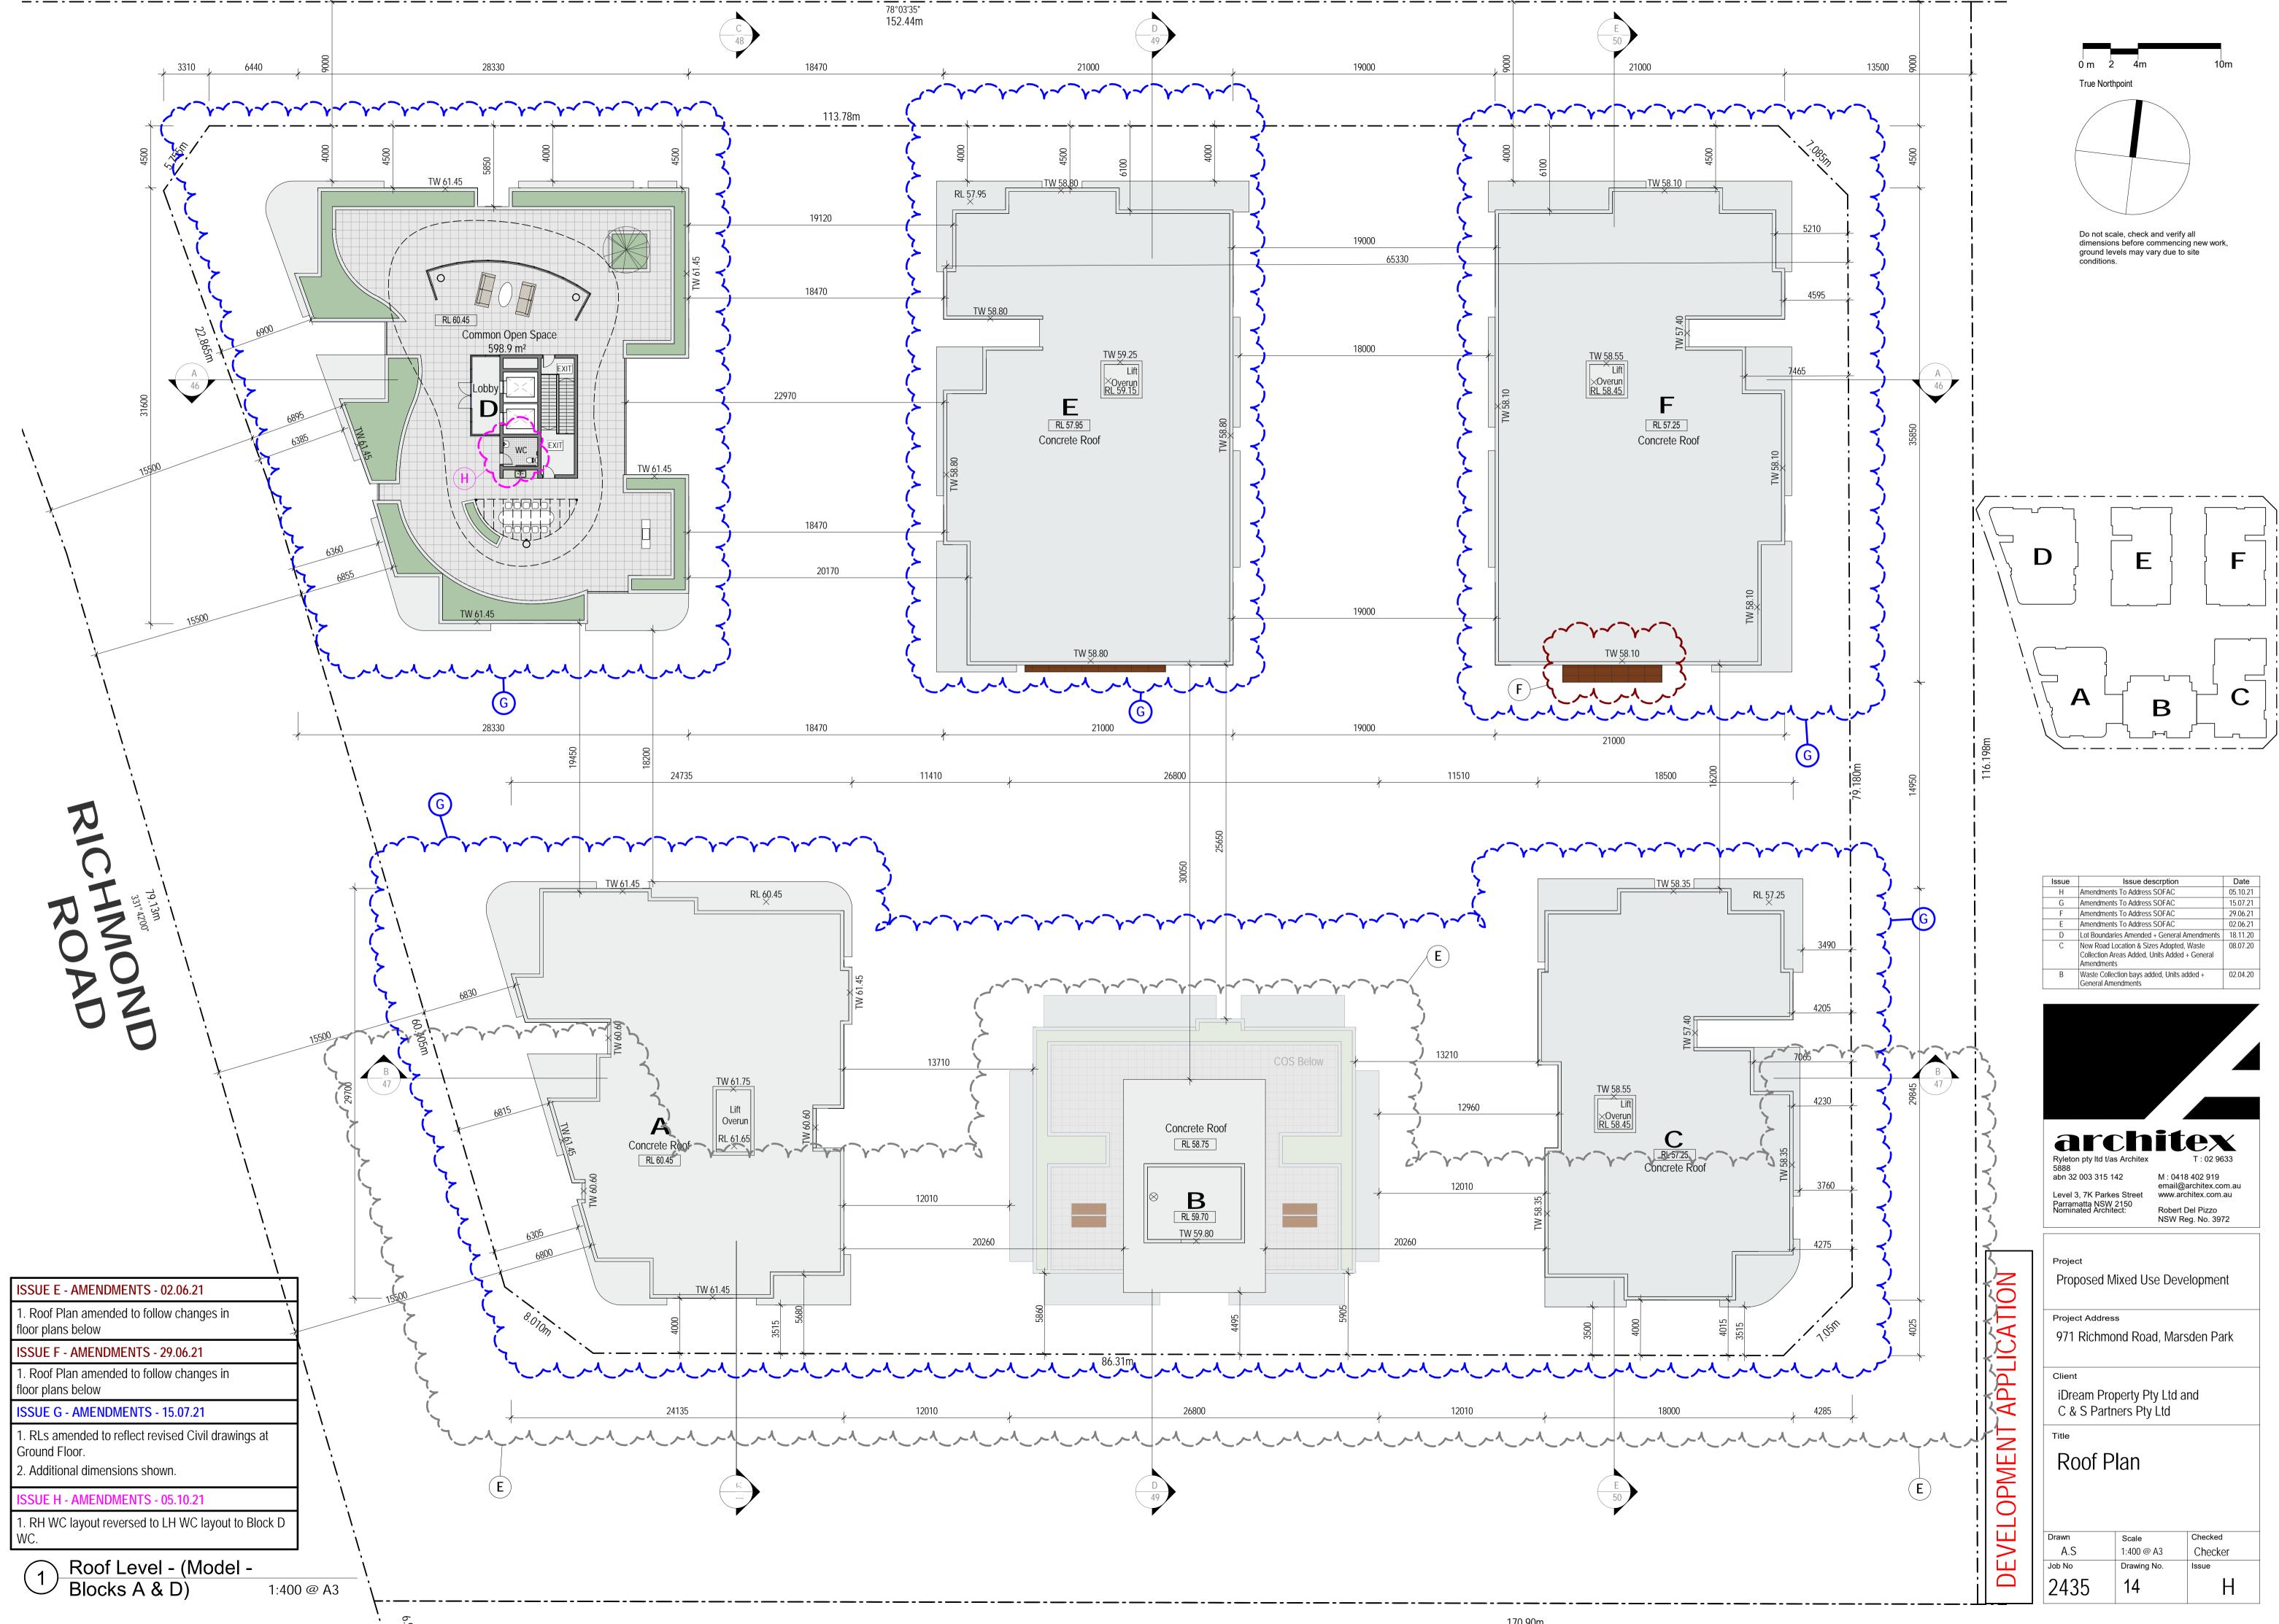

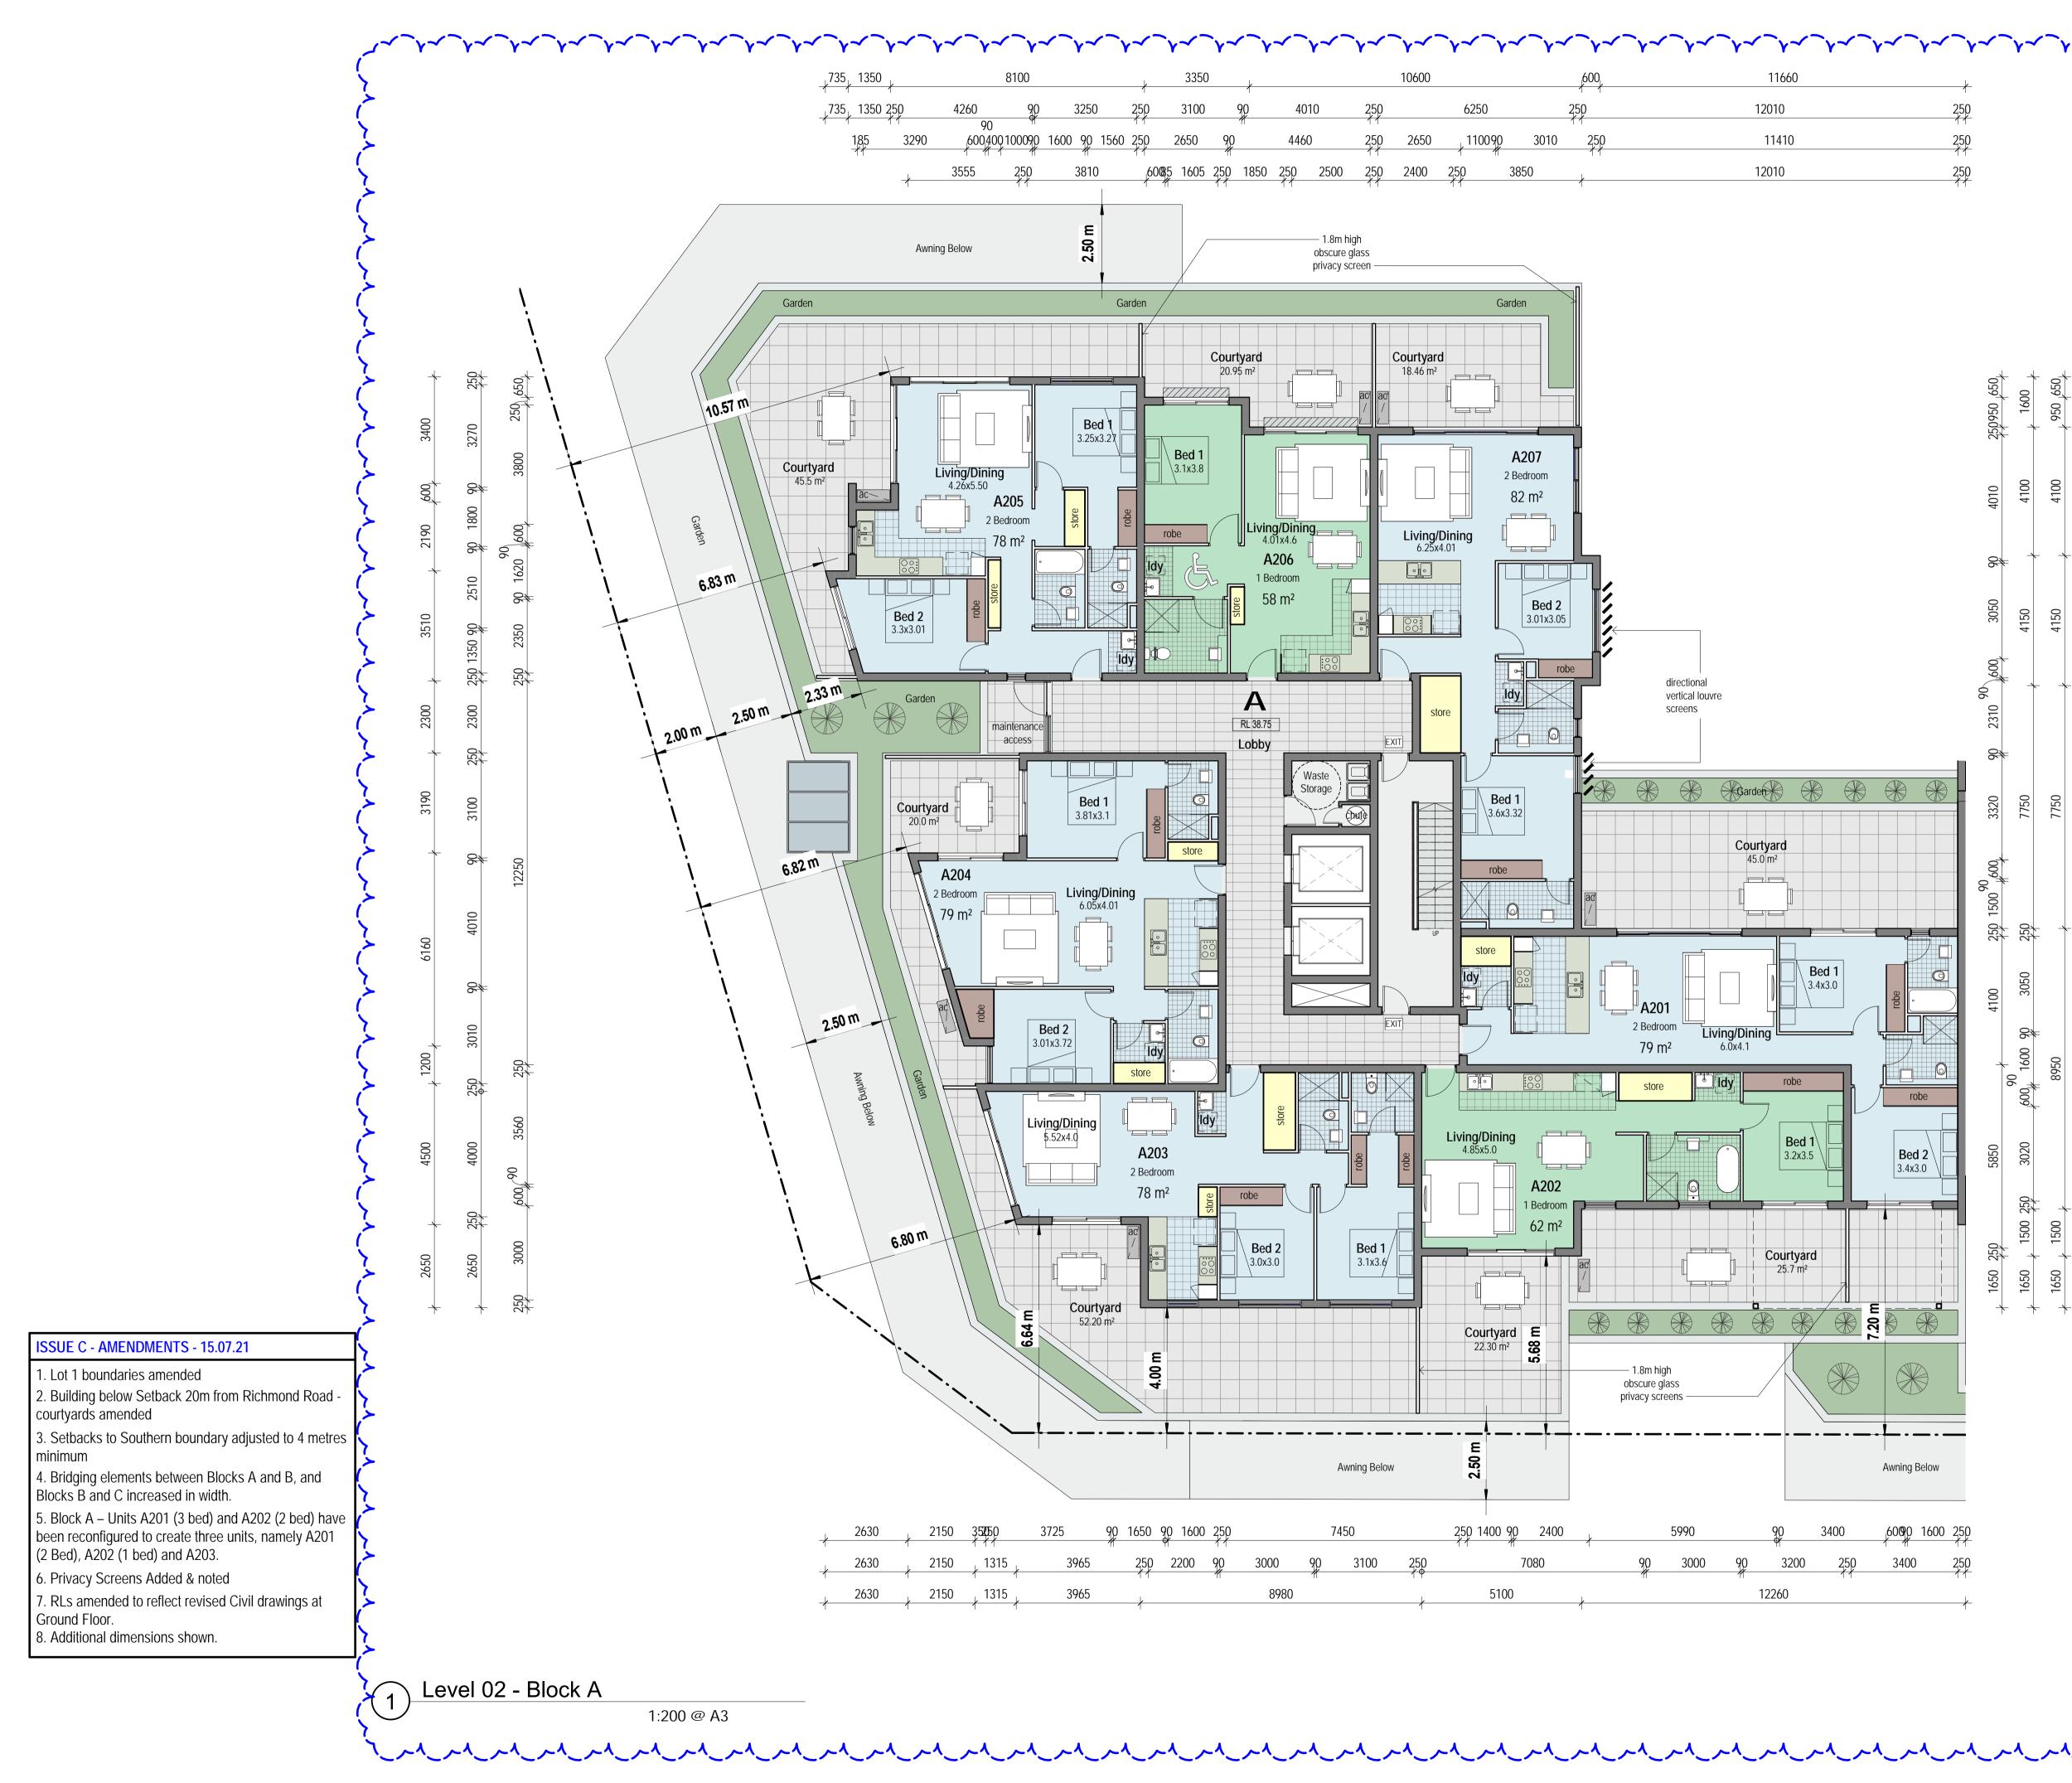

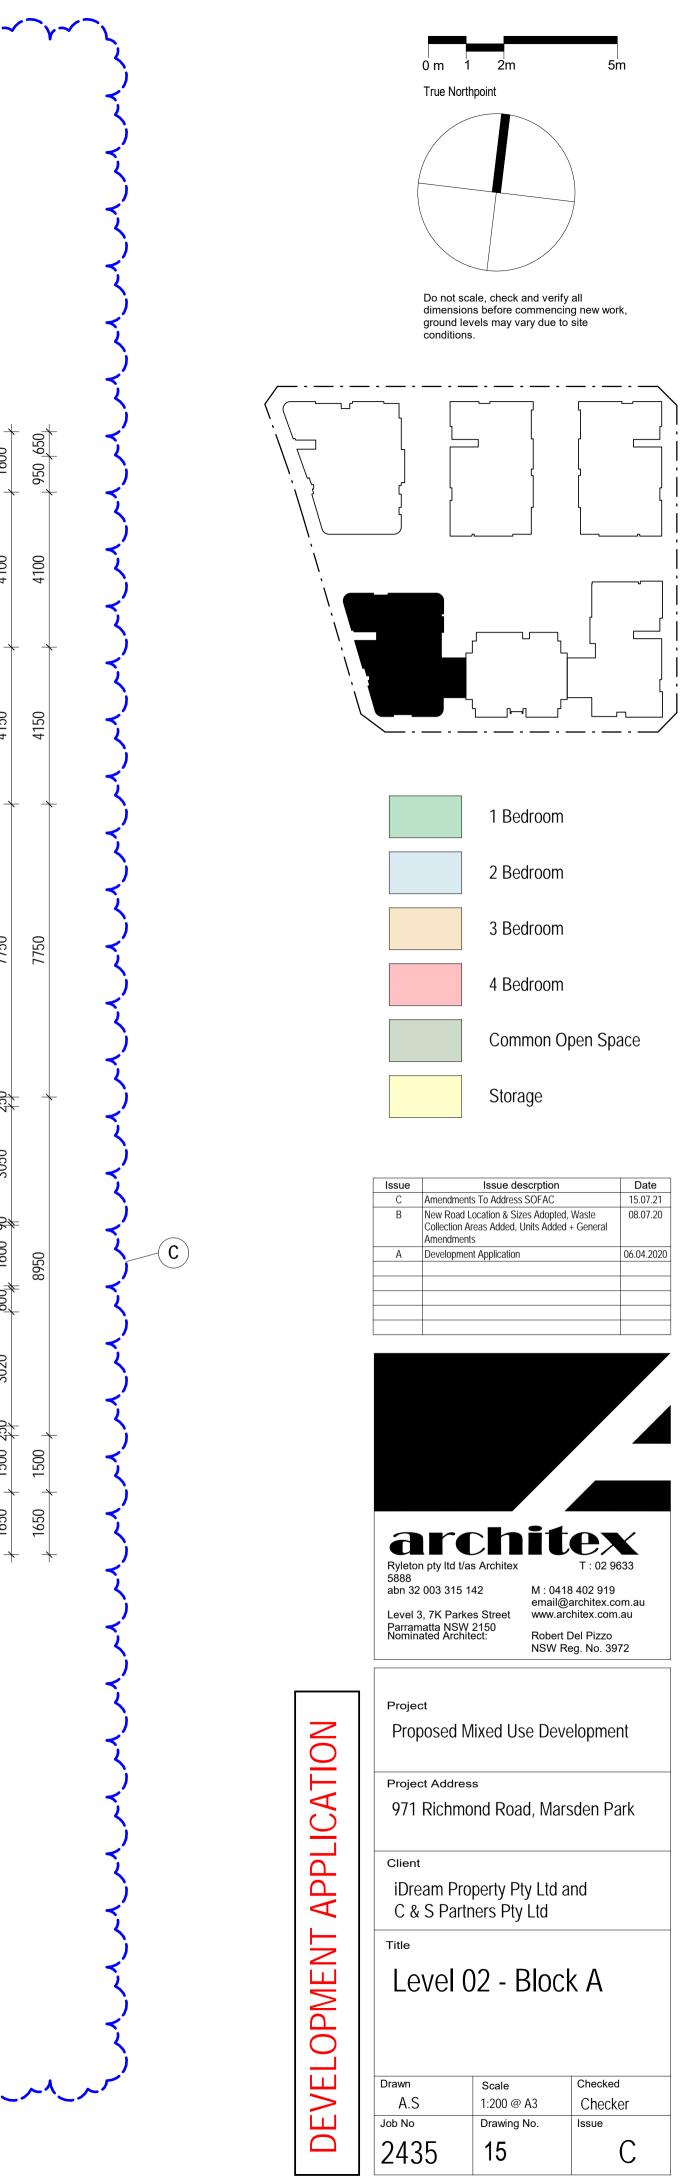


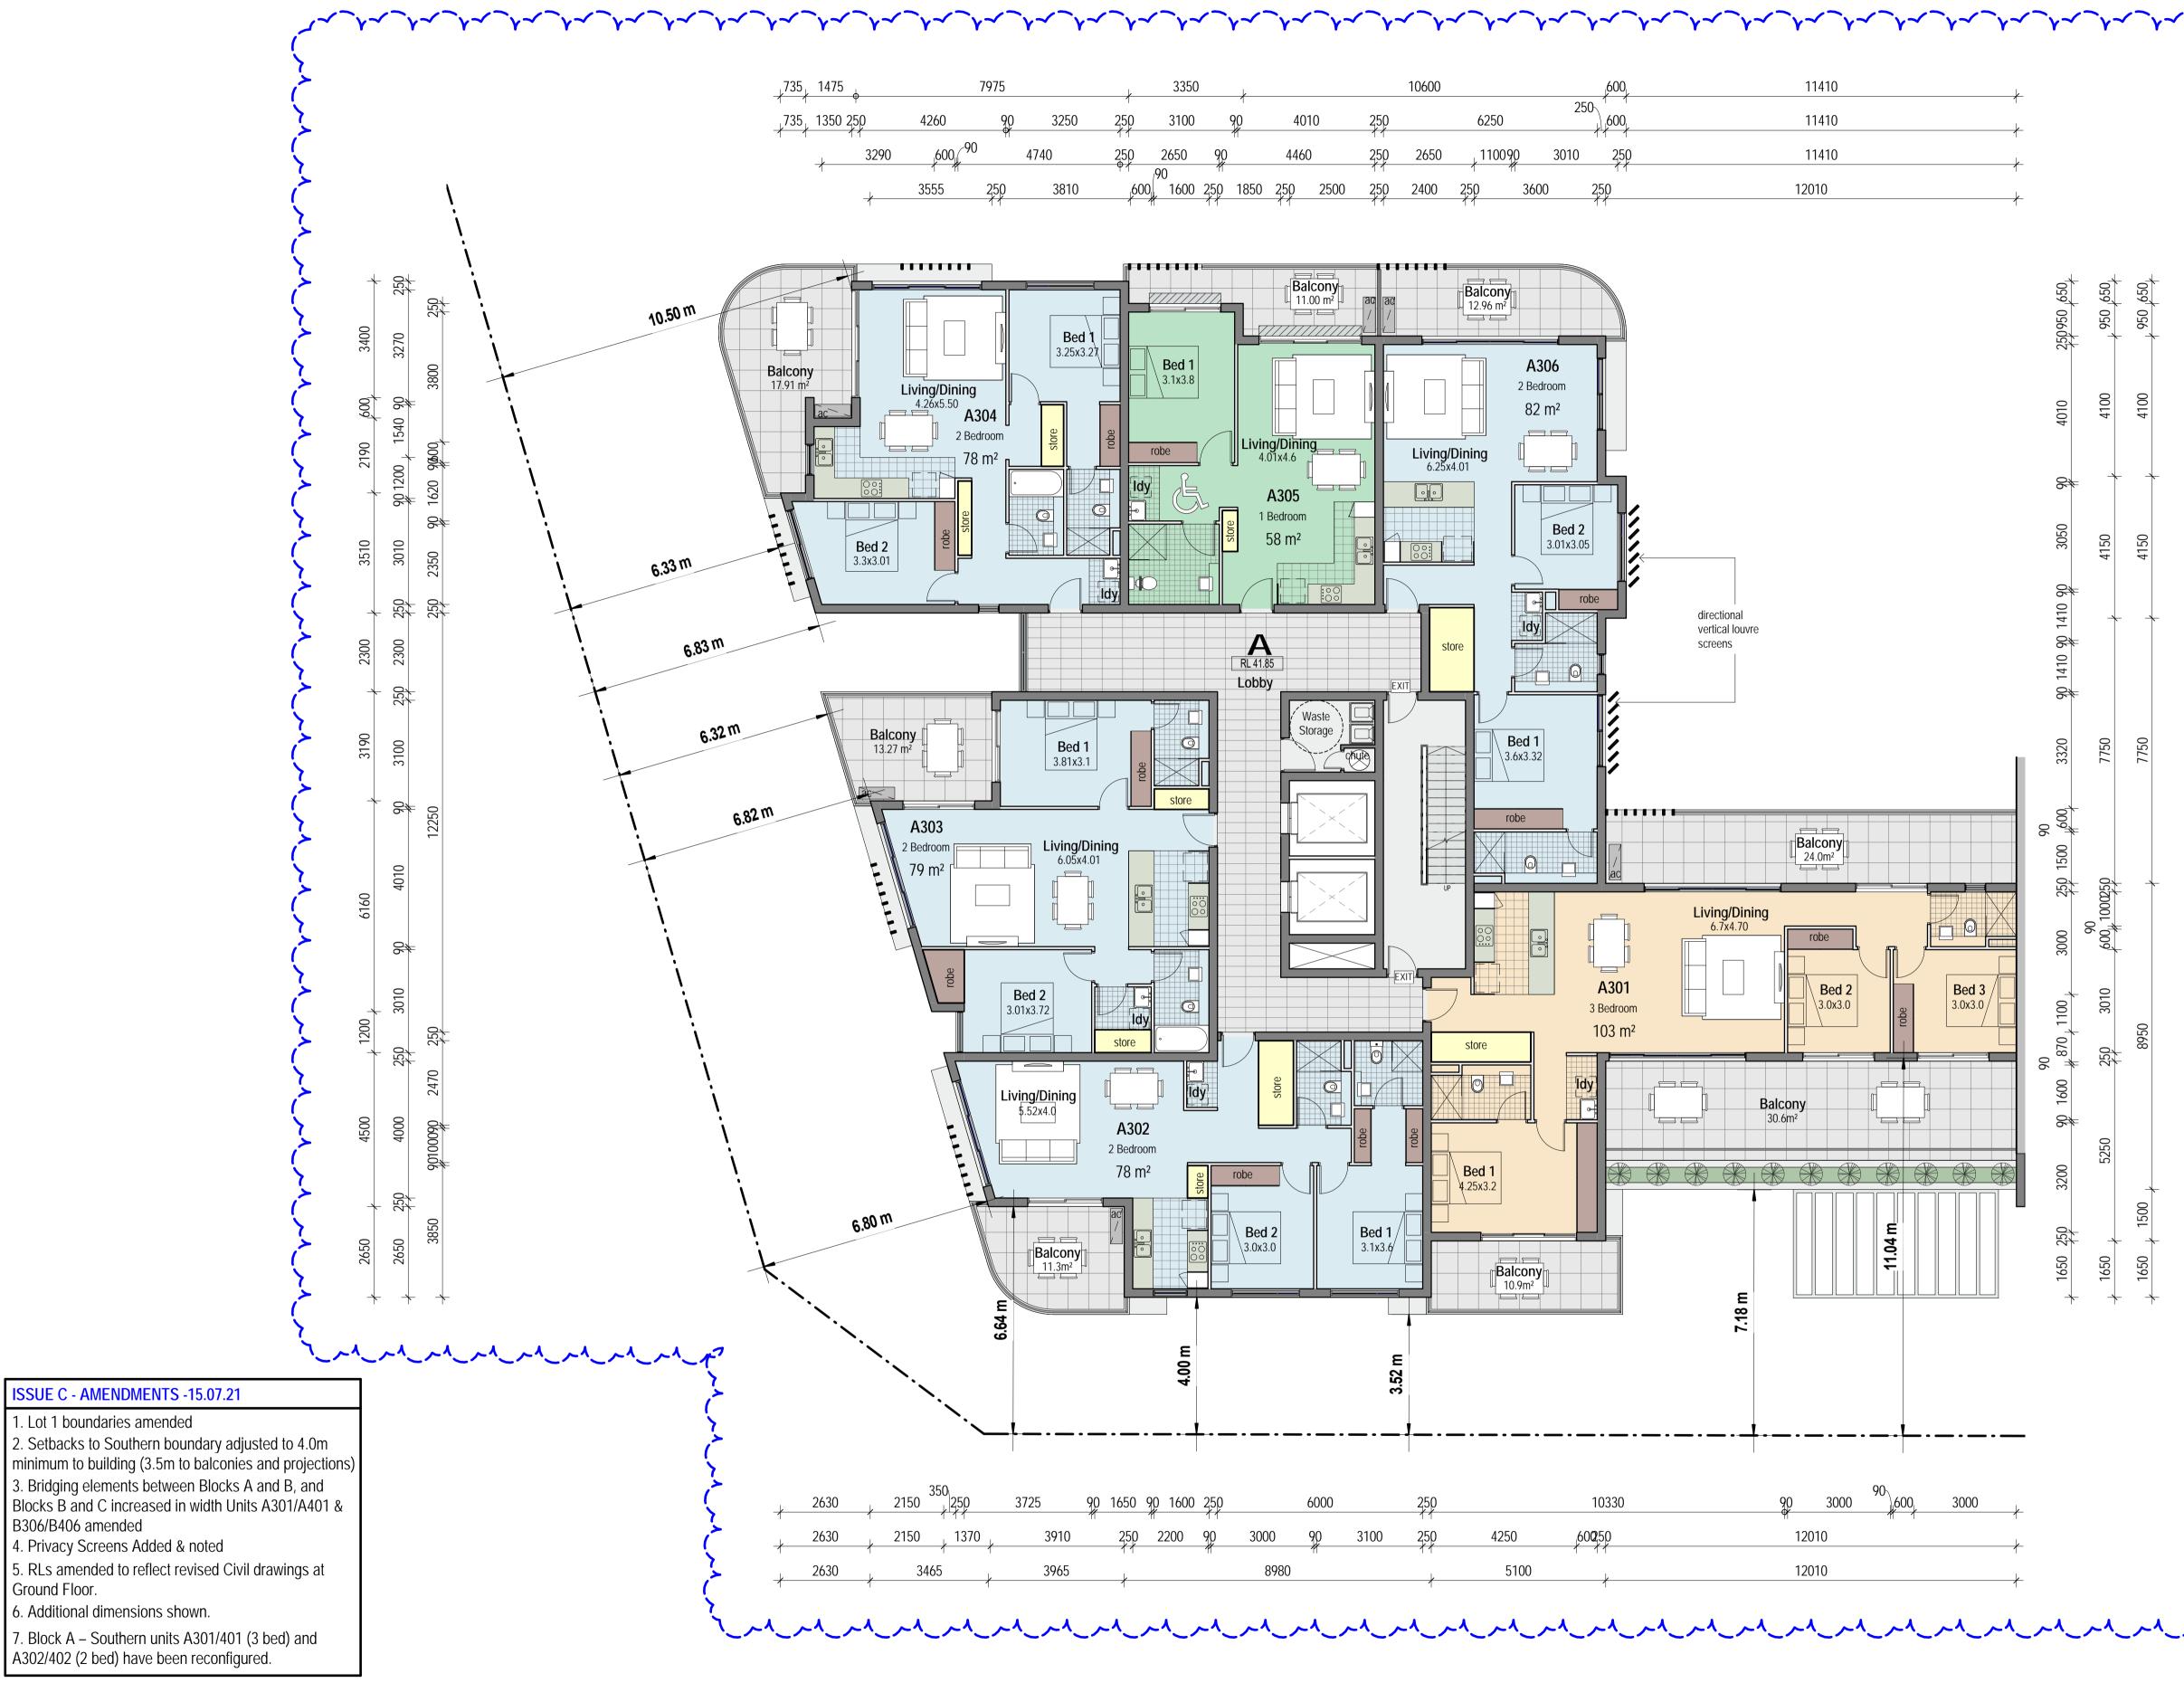

Level 03-04 - Block A (1)

1:200 @ A3

		3350				10600			600	11410	
	1		1					250 _\	1 1		1
3250	250	3100	90	4010	250		6250	L	600 ¹	11410	L
	11		11		11			17			1
740	250	2650	90	4460	250	2650	110090	3010	250	11410	Ŀ
		(90	Ħ		11		1 11		11		t
3810	600	1600	250 1850	250 2500	250	2400	250 360)0 2 ₅	Q	12010	I.
		11	11		- 11-				r		1

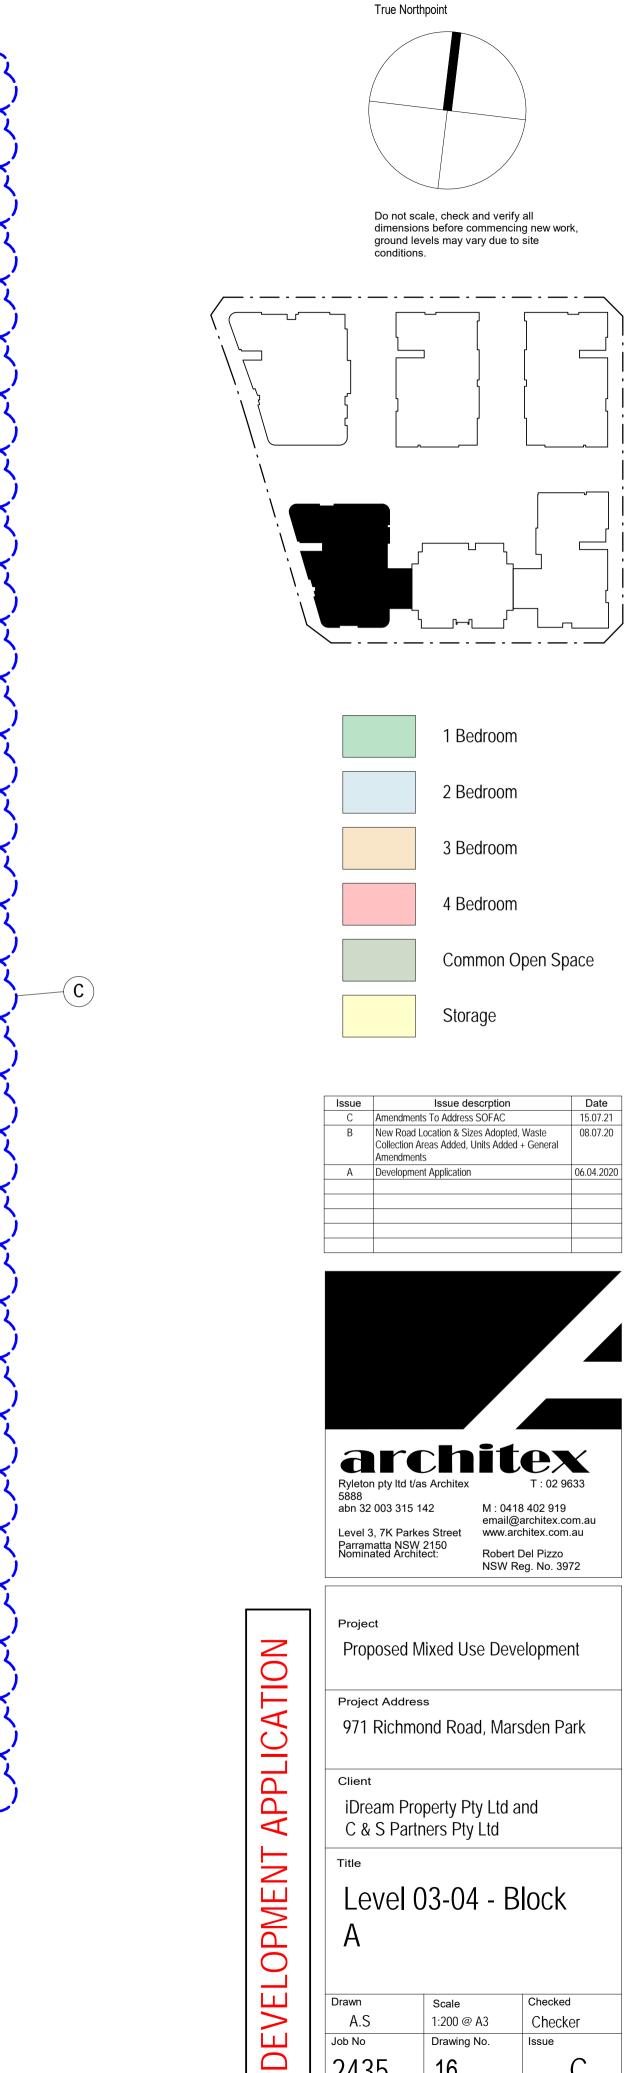

2435

16

С

0 m 1 2 m

8 20

1500


650

950




Level 05 - Block A (1)

1:200 @ A3

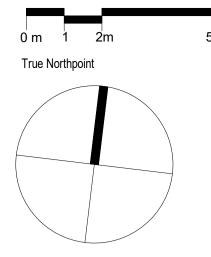

Do not scale, check and verify all dimensions before commencing new work, ground levels may vary due to site conditions.

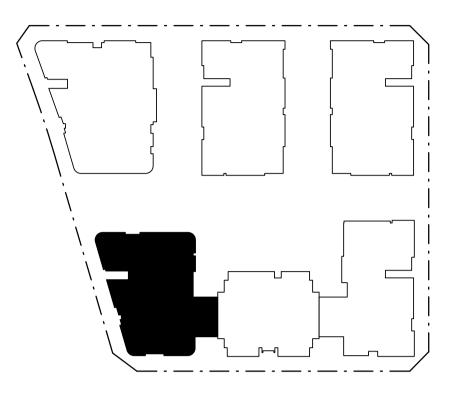



Issue	Issue descrption	Date
С	Amendments To Address SOFAC	15.07.21
В	New Road Location & Sizes Adopted, Waste Collection Areas Added, Units Added + General Amendments	08.07.20
A	Development Application	06.04.2020



	Nomina
ON	Projec Prop
ICALI	Projec 971
	Client iDre C & Title
DEVELOPN	Drawn A.S Job No 243

roject Proposed Mixed Use Development

roject Address

971 Richmond Road, Marsden Park

lient

iDream Property Pty Ltd and C & S Partners Pty Ltd

Level 05 - Block A

Drawn	Scale	Checked	
A.S	1:200 @ A3	Checker	
Job No	Drawing No.	Issue	
2435	17	С	

-(C)



ISSUE C - AMENDMENTS - 15.07.21

1. Lot 1 boundaries amended

2. Setbacks to Southern boundary adjusted to 4.0m minimum to building (3.5m to balconies and projections)

3. Block A – Units A501/601,701,801 (1 bed) and A502/602/702/802 (2 bed) joined and reconfigured to create one four bedroom unit (A501/601/701/801).


4. Privacy Screens Added & noted


5. RLs amended to reflect revised Civil drawings at Ground Floor.

6. Additional dimensions shown.



1:12:001:000 A3

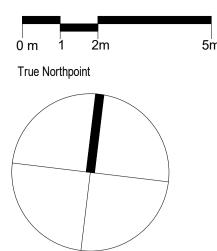

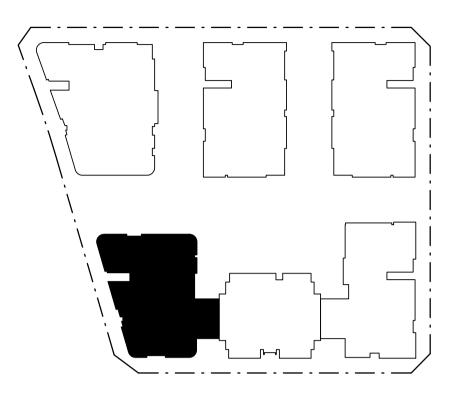




Issue	Issue descrption	Date
С	Amendments To Address SOFAC	15.07.21
В	New Road Location & Sizes Adopted, Waste Collection Areas Added, Units Added + General Amendments	08.07.20
A	Development Application	06.04.2020



	Parramatta NSW Nominated Archite		Del Pizzo eg. No. 3972		
NO	Project Proposed M	lixed Use Deve	elopment		
-ICATI	Project Addres 971 Richmo	^s nd Road, Mars	den Park		
APPL	Client iDream Property Pty Ltd and C & S Partners Pty Ltd				
EVELOPMENT APPLICATION	Level C A)6-08 - B	lock		
VE	Drawn A.S	Scale 1:200 @ A3	Checked Checker		
DE	^{Јов No} 2435	Drawing No.	Issue		

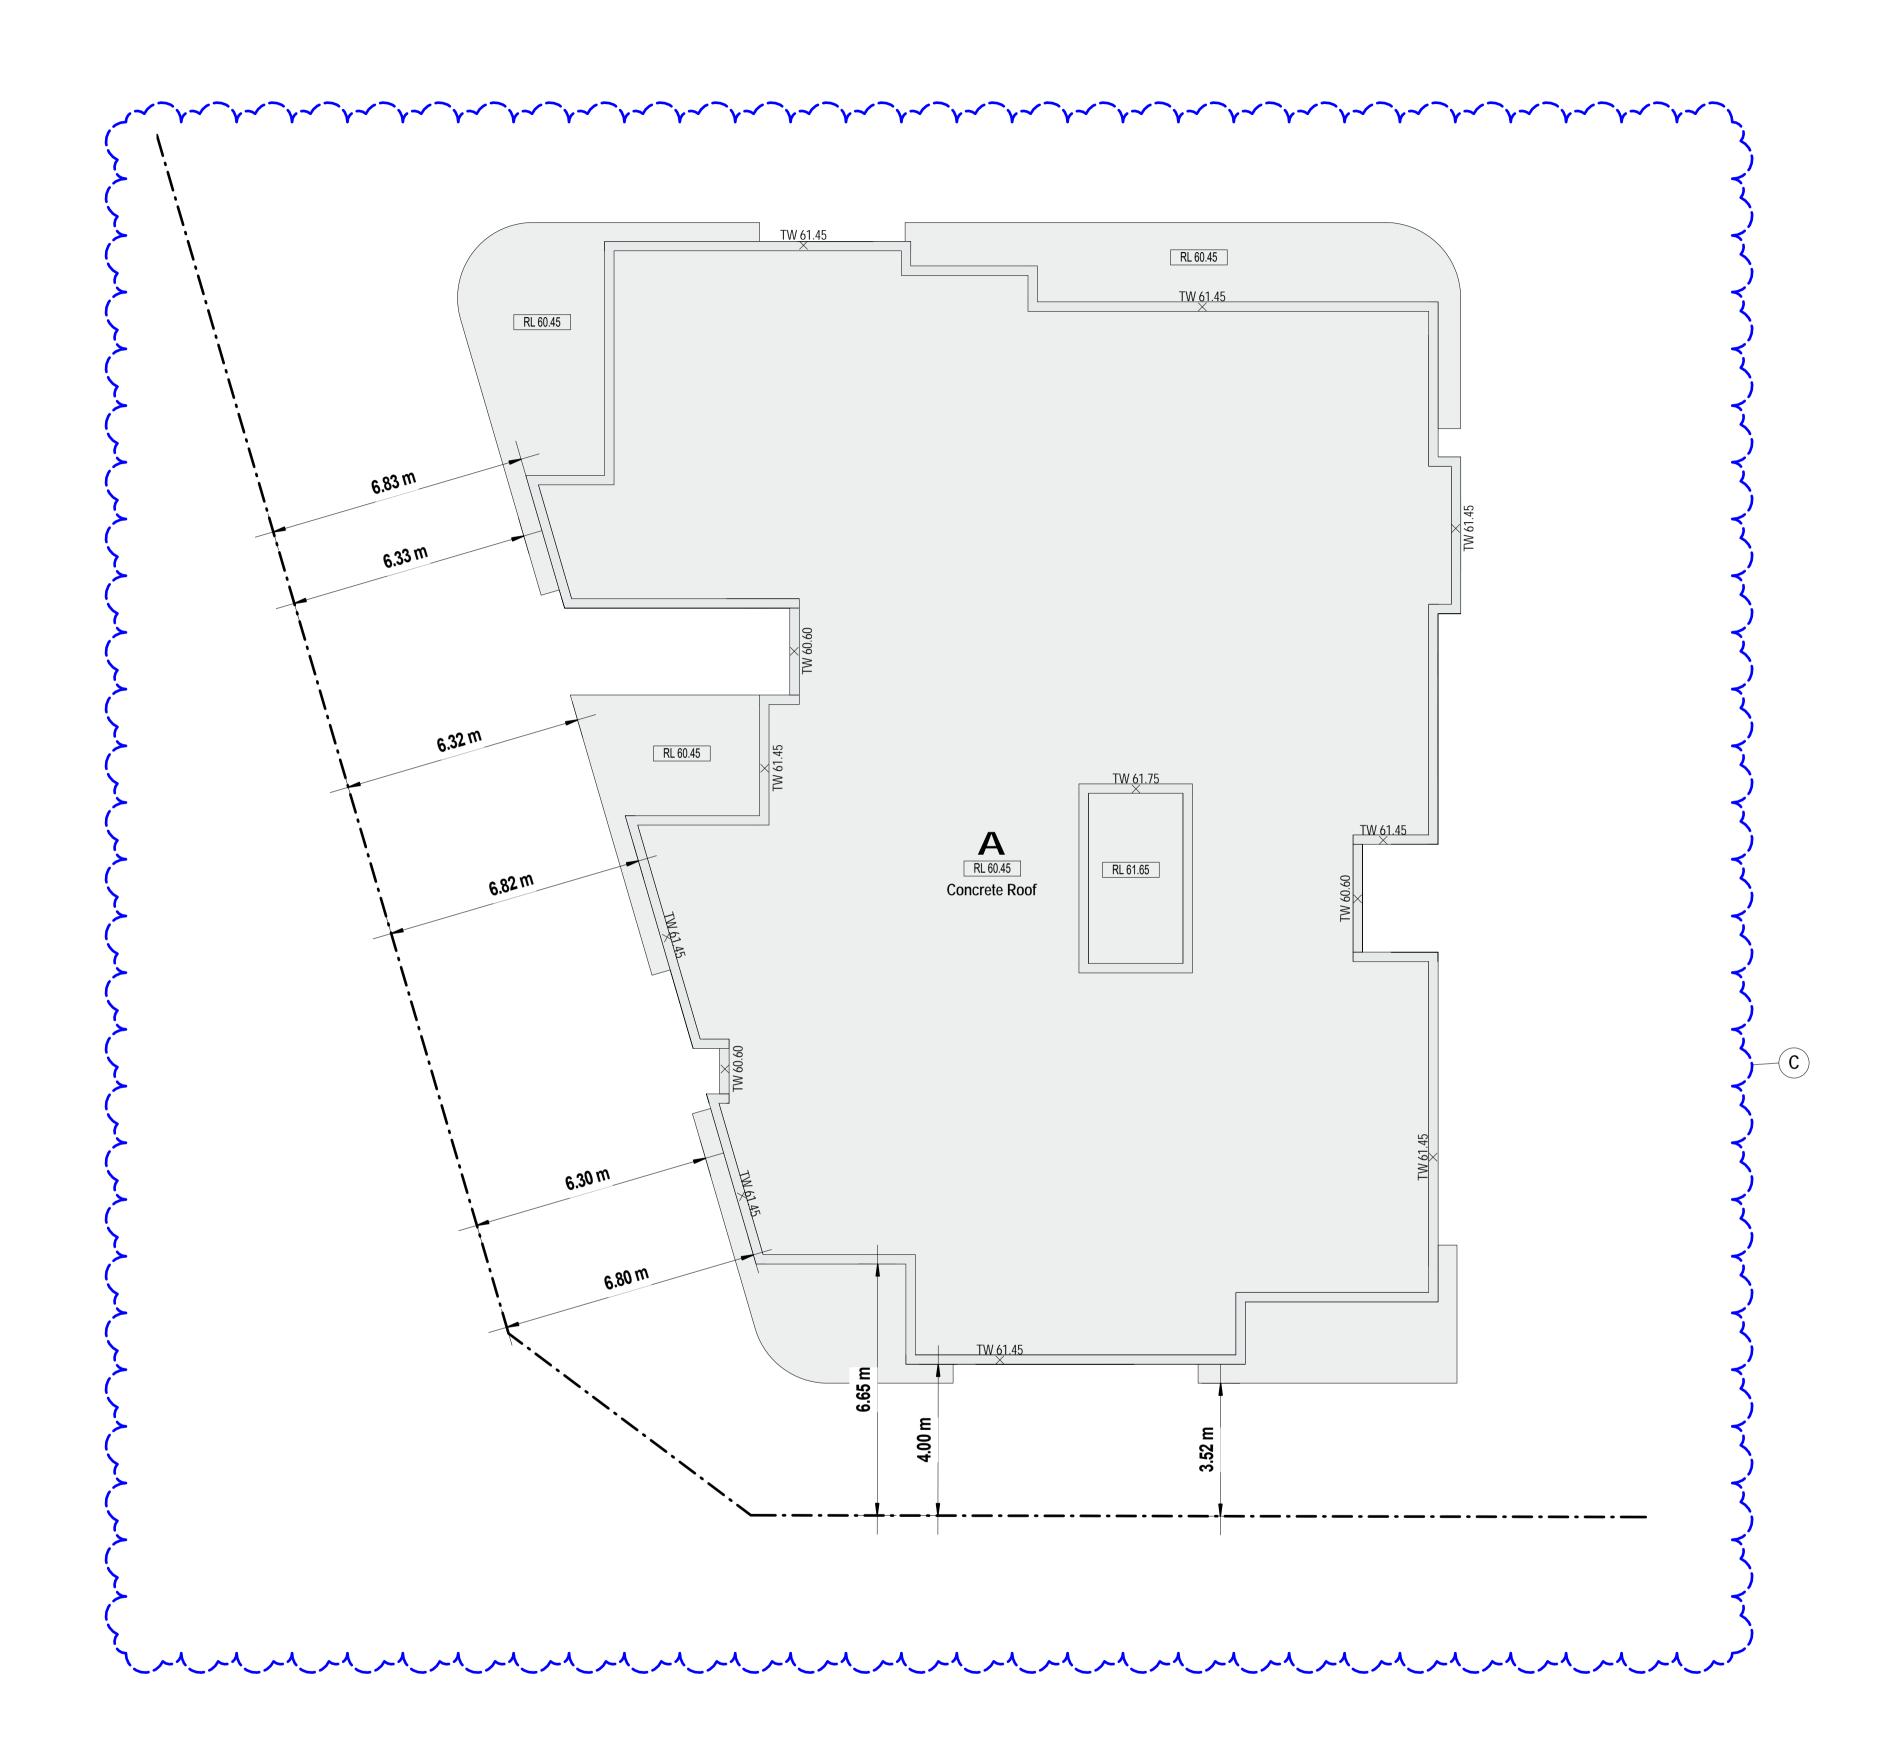


ISSUE C - AMENDMENTS - 15.07.21


- 1. Roof Plan amended to follow changes in
- floor plans below
- 1. RLs amended to reflect revised Civil drawings at
- Ground Floor.
- 2. Additional dimensions shown.




1:200 @ A3

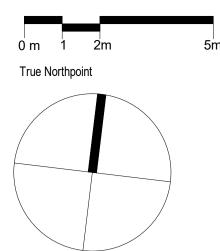

Do not scale, check and verify all dimensions before commencing new work, ground levels may vary due to site conditions.

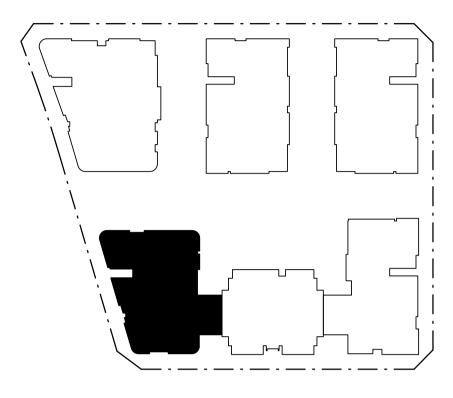

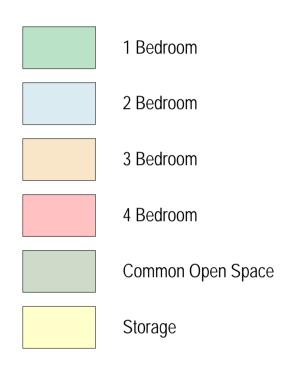

Issue	Issue descrption	Date
С	Amendments To Address SOFAC	15.07.21
В	New Road Location & Sizes Adopted, Waste Collection Areas Added, Units Added + General Amendments	08.07.20
A	Development Application	06.04.2020



Robert Del Pizzo NSW Reg. No. 3972

Project Proposed Mixed Use Development

Project Address

971 Richmond Road, Marsden Park

Client

Title


DEVELOPMENT APPLICATION

iDream Property Pty Ltd and C & S Partners Pty Ltd

Roof Level - Block A

Drawn	Scale	Checked
A.S	1:200 @ A3	Checker
Job No	Drawing No.	Issue
2435	19	С



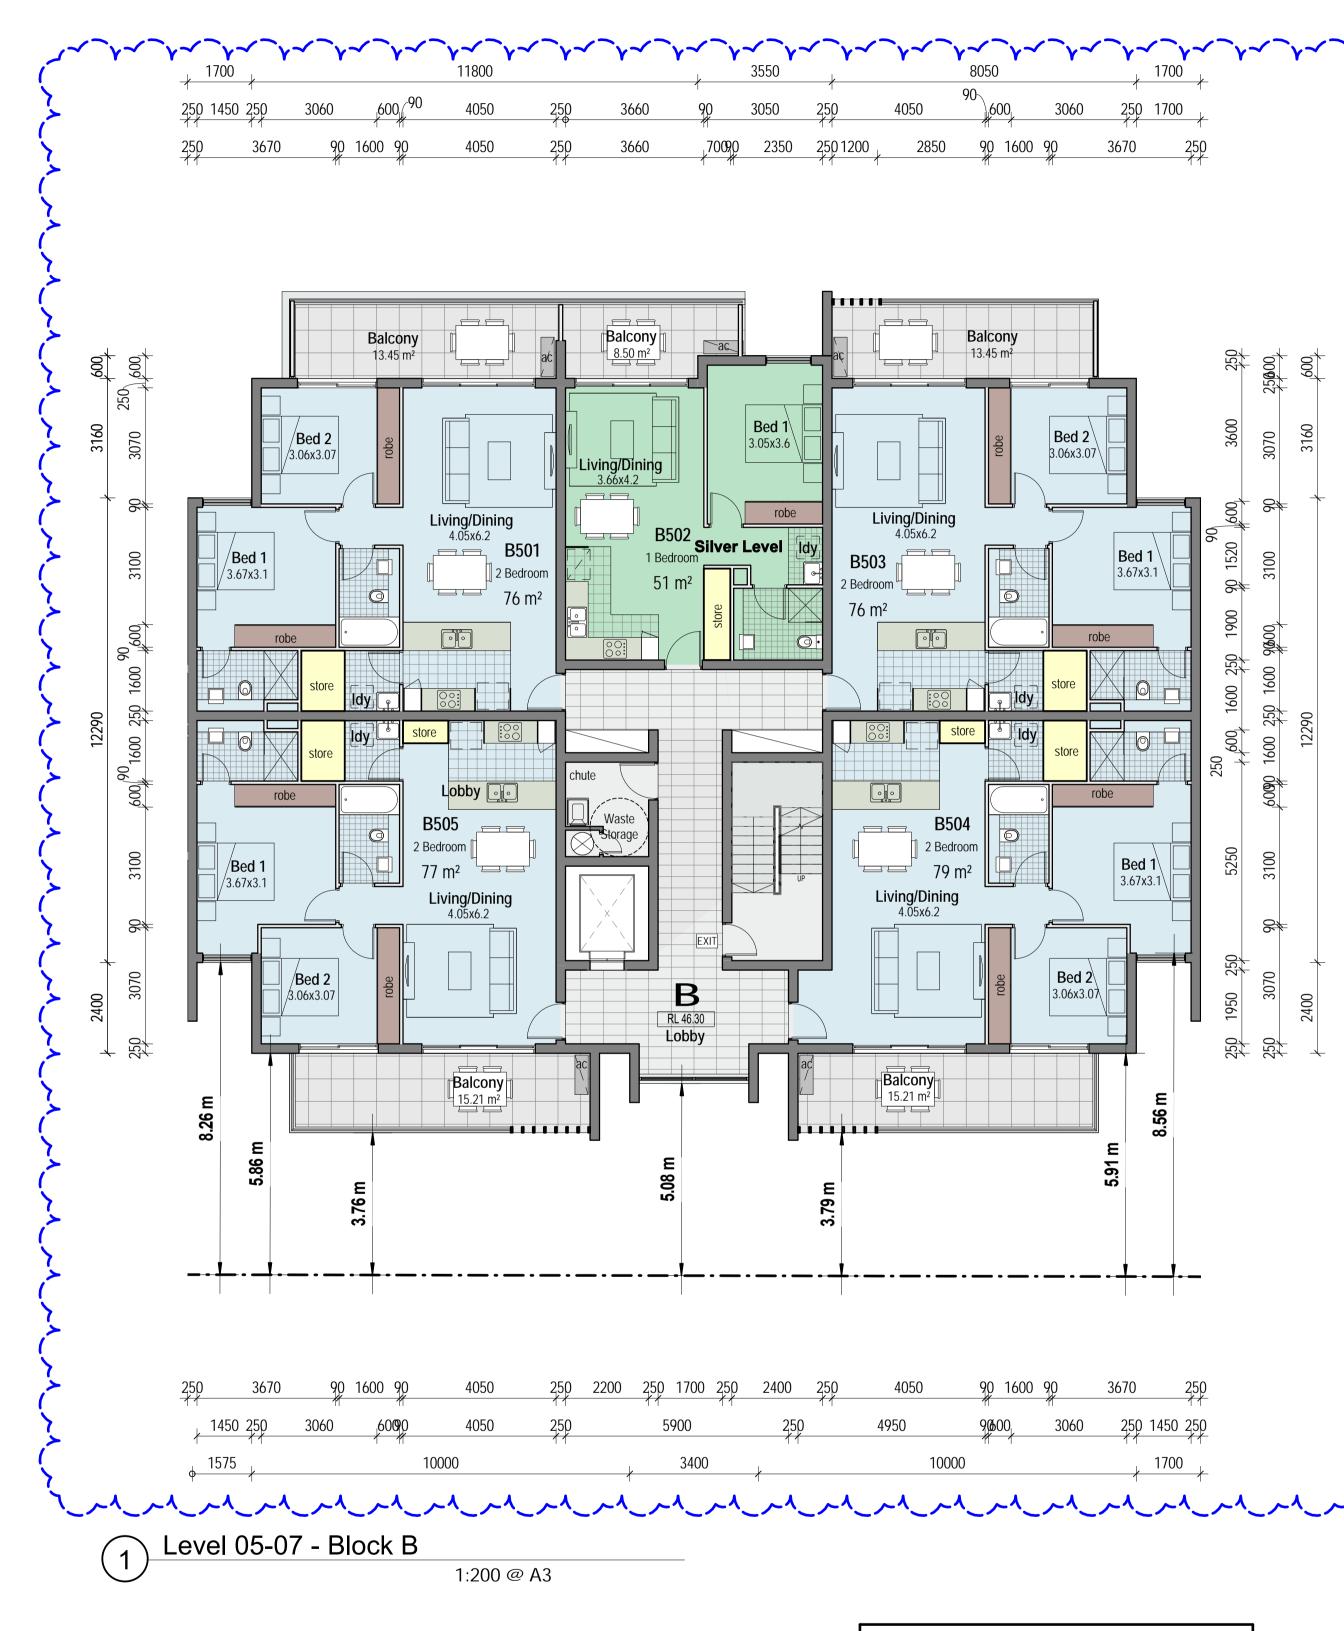


ISSUE C - AMENDMENTS - 15.07.21 1. Lot 1 boundaries amended 2. Roof over bridging elements between Blocks A and B, and Blocks B and C amended to reflect amendments to units below 3. Setbacks to Southern boundary adjusted to 4.0m minimum to building (3.5m to balconies and projections) 4. Privacy Screens Added & noted 5. RLs amended to reflect revised Civil drawings at

Ground Floor.


6. Additional dimensions shown.


7. Block B Landscape Design amended.

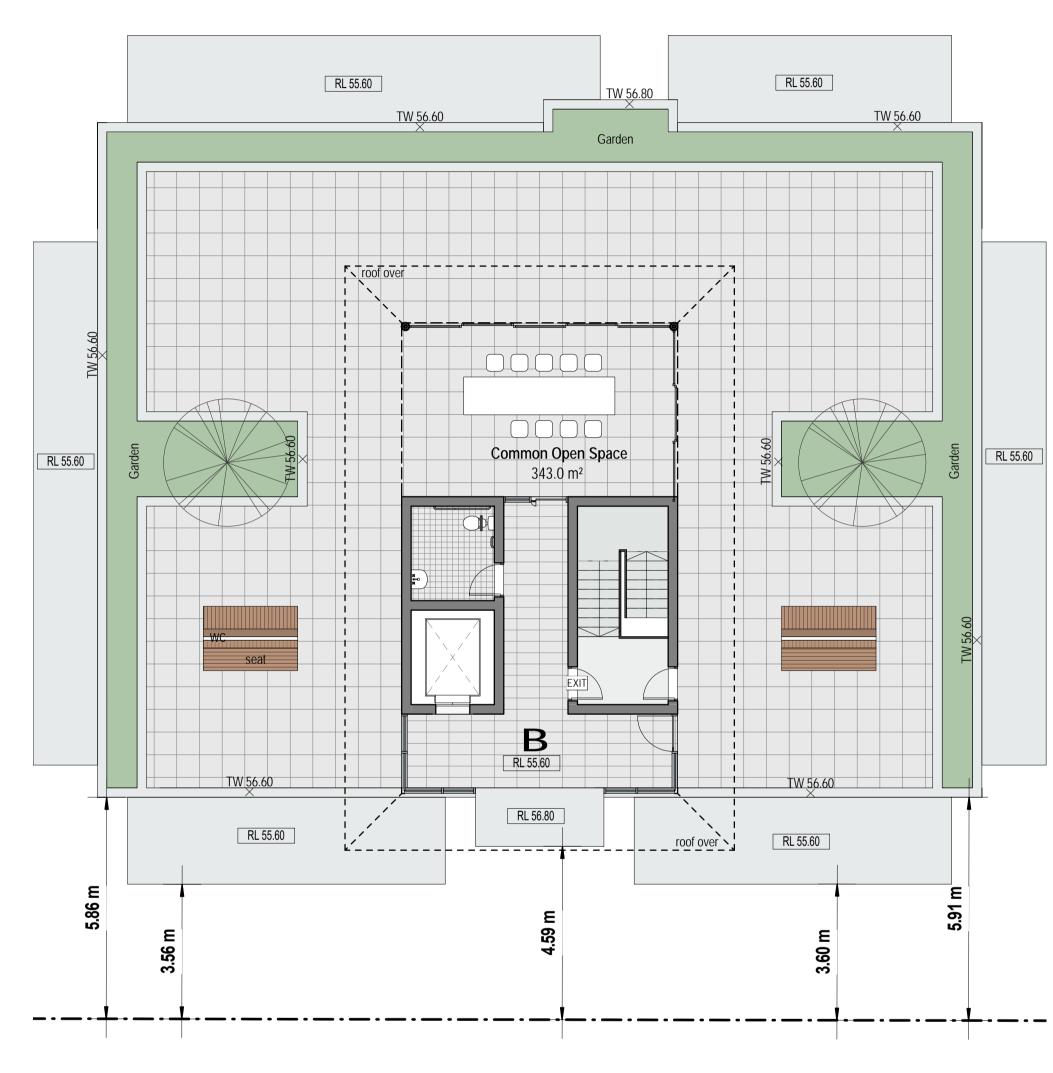

1:200 @ A3

(2) Roof Level - Block B

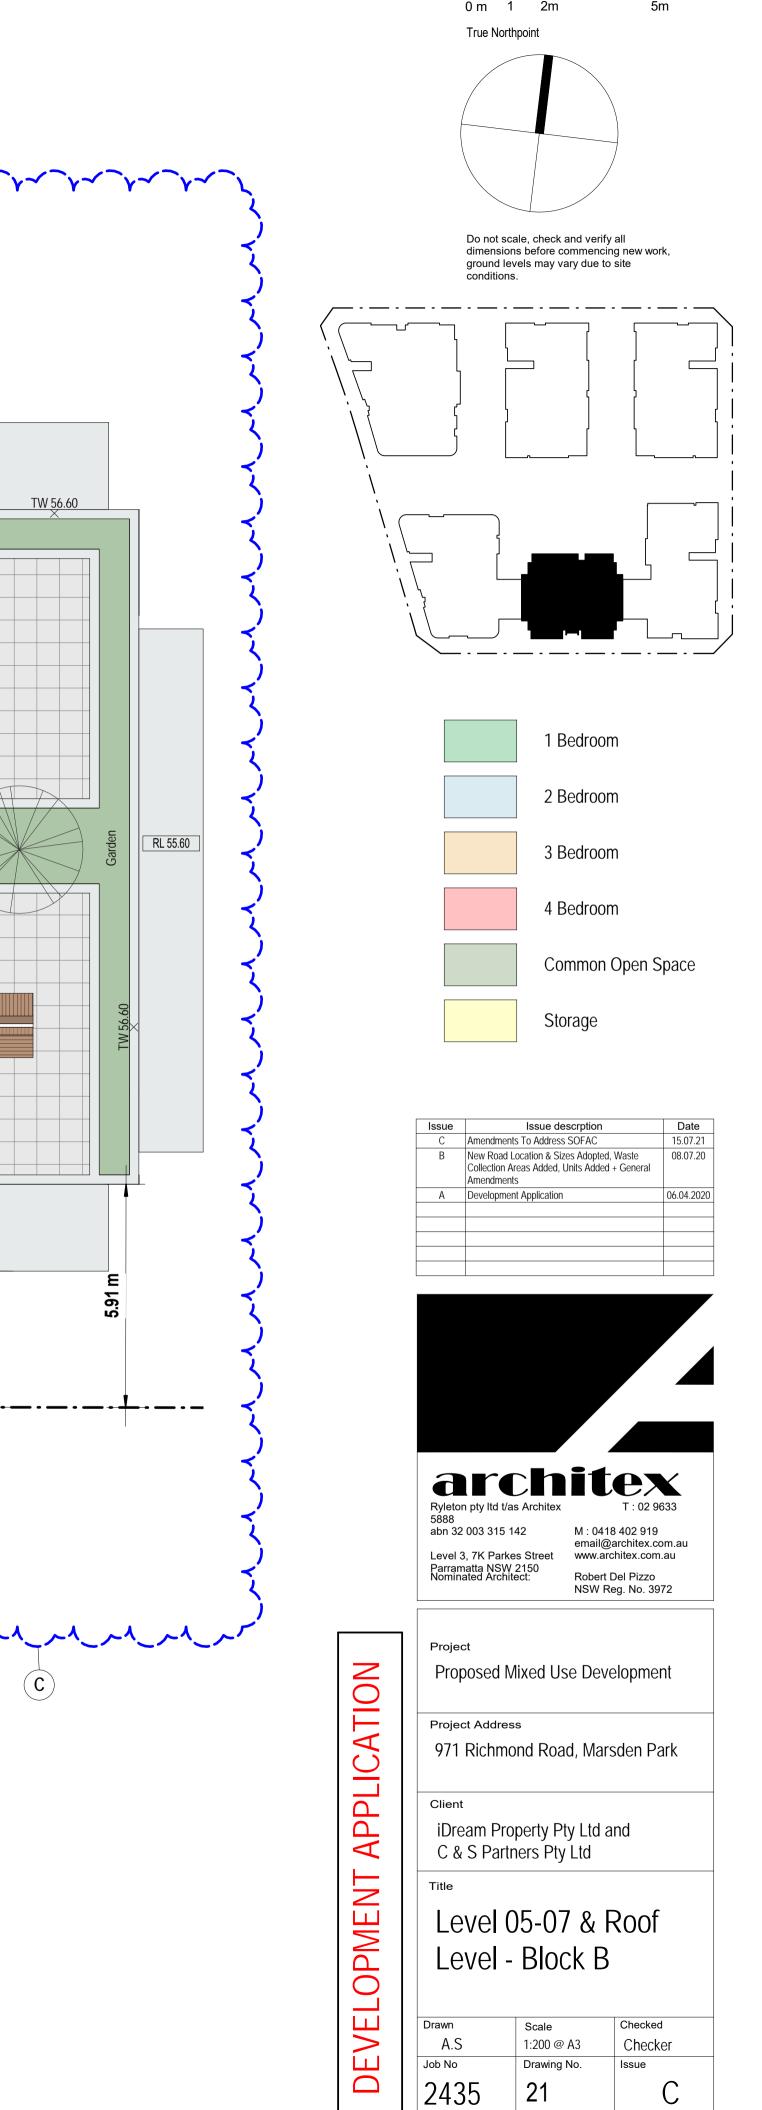

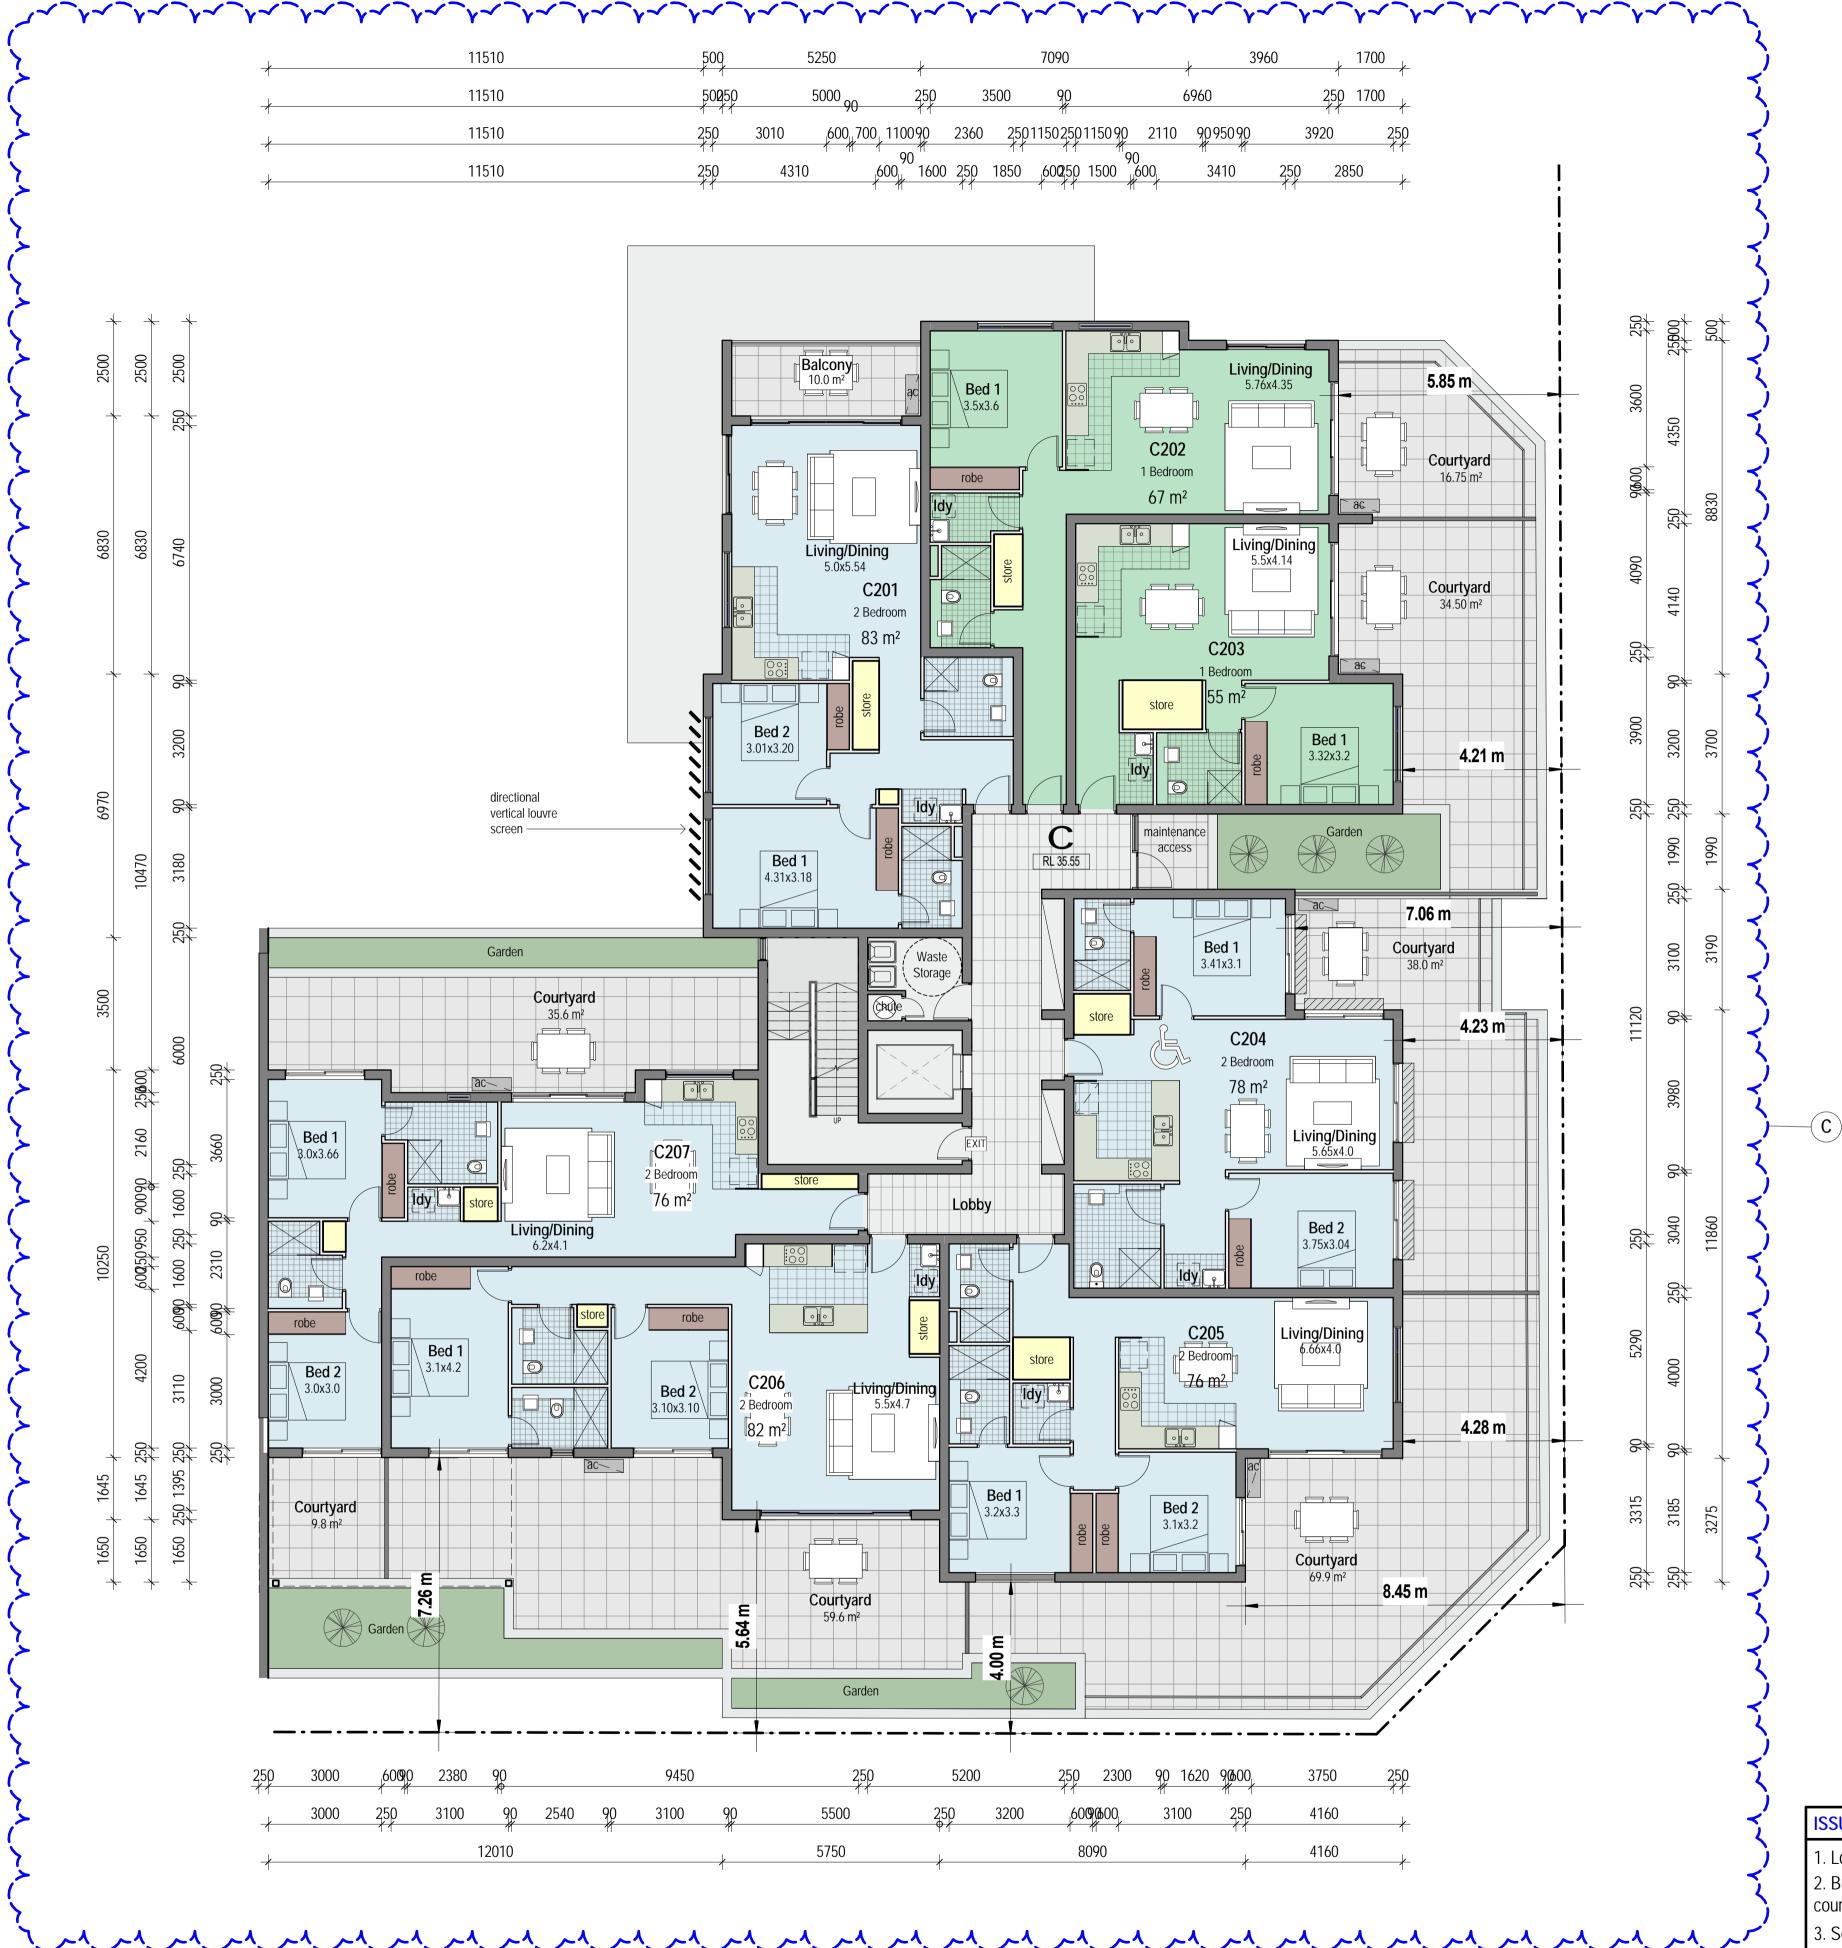


(1) Level 02 - Block C


1:200 @ A3


minimum respectively)

Ground Floor.

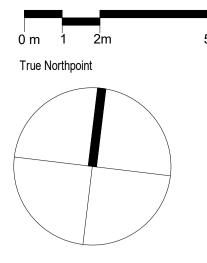

Do not scale, check and verify all dimensions before commencing new work, ground levels may vary due to site conditions.

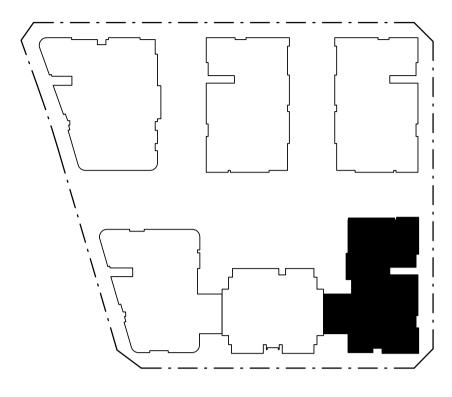

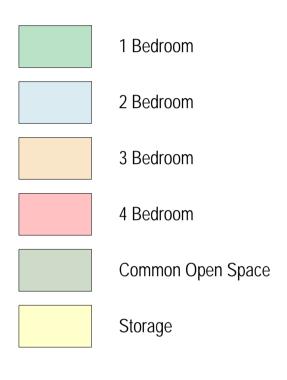

Issue	Issue descrption	Date
С	Amendments To Address SOFAC	15.07.21
В	New Road Location & Sizes Adopted, Waste Collection Areas Added, Units Added + General Amendments	08.07.20
A	Development Application	06.04.2020



Level 3, 7K Parkes Street Parramatta NSW 2150 Nominated Architect:

M : 0418 402 919 email@architex.com.au www.architex.com.au Robert Del Pizzo NSW Reg. No. 3972

Project

Proposed Mixed Use Development

Project Address

971 Richmond Road, Marsden Park

Client

Title

iDream Property Pty Ltd and C & S Partners Pty Ltd

Level 02 - Block C

Drawn	Scale	Checked
A.S	1:200 @ A3	Checker
Job No	Drawing No.	Issue
2435	22	С

ISSUE C - AMENDMENTS - 15.07.21 1. Lot 1 boundaries amended

2. Building below Setback 20m from Richmond Road courtyards amended

3. Setbacks to Southern boundary adjusted to 4 metres

4. Bridging elements between Blocks A and B, and Blocks B and C increased in width.

5. Block C - Units C305/405 (2 bed) and C306/406 (3 bed) reconfigured (to a 2 bed and 4 bed unit

6. Privacy Screens Added & noted

7. RLs amended to reflect revised Civil drawings at

8. Additional dimensions shown.





ISSUE C - AMENDMENTS -15.07.21

1. Lot 1 boundaries amended

2. Setbacks to Southern boundary adjusted to 4.0m minimum to building (3.5m to balconies and projections) 3. Bridging elements between Blocks A and B, and Blocks B and C increased in width Units A301/A401 & B306/B406 amended


- 4. Privacy Screens Added & noted
- 5. RLs amended to reflect revised Civil drawings at Ground Floor.
- 6. Additional dimensions shown.

7. Block C - Units C305/405 (2 bed) and C306/406 (3 bed) reconfigured (to a 2 bed and 4 bed unit


respectively)

Level 03-04 - Block C $\begin{bmatrix} 1 \end{bmatrix}$

1:200 @ A3

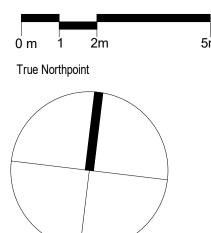

Do not scale, check and verify all dimensions before commencing new work, ground levels may vary due to site conditions.

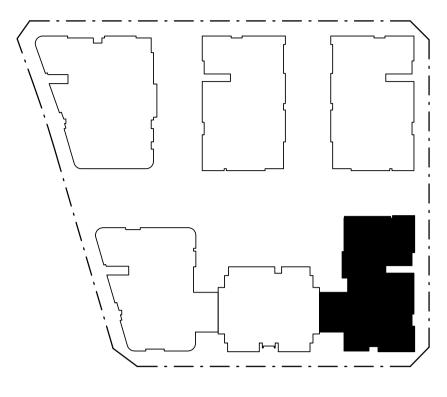




Issue	Issue descrption	Date
С	Amendments To Address SOFAC	15.07.21
В	New Road Location & Sizes Adopted, Waste Collection Areas Added, Units Added + General Amendments	08.07.20
A	Development Application	06.04.2020



	Project				
NO	Proposed N	Proposed Mixed Use Development			
	Project Addres	s			
EVELOPMENT APPLICATIO	971 Richmo	971 Richmond Road, Marsden Park			
Ц	Client				
API		iDream Property Pty Ltd and C & S Partners Pty Ltd			
	Title	Title			
		Loval 02 04 Plack			
M		Level 03-04 - Block			
Ы	C				
ЦЦ	Drawn	Scale	Checked		
\geq	A.S	1:200 @ A3	Checker		
Ш	Job No	Drawing No.	Issue		
	2435	23	С		

-(**C**)

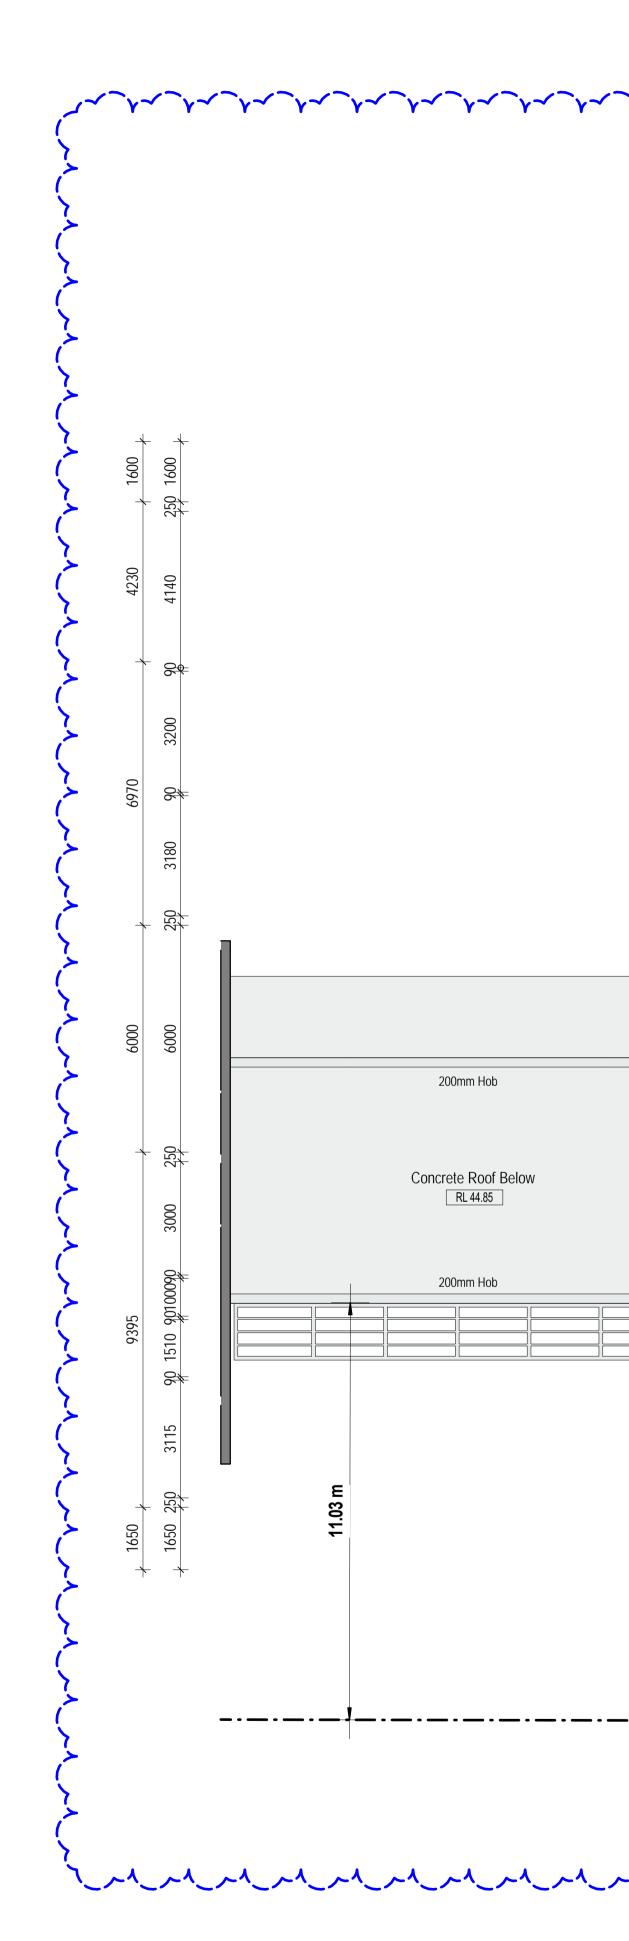


ISSUE C - AMENDMENTS - 15.07.21
1. Lot 1 boundaries amended
 Roof over bridging elements between Blocks A and B, and Blocks B and C amended to reflect amendments to units below
3. Setbacks to Southern boundary adjusted to 4.0m minimum to building (3.5m to balconies and projections)
4. Privacy Screens Added & noted
5. RLs amended to reflect revised Civil drawings at Ground Floor.
 Additional dimensions shown. Block C - Southern units C504/604/704/804 (2 bed)

7. Block C - Southern units C504/604/704/804 (2 bed) and C505/605/705/805 (1 bed) reconfigured to create one four bedroom unit (C504/604/704/804).


(1) Level 05 - Block C


1:200 @ A3



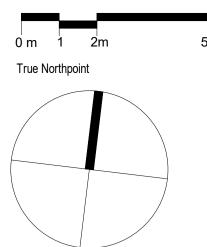

Do not scale, check and verify all dimensions before commencing new work, ground levels may vary due to site conditions.

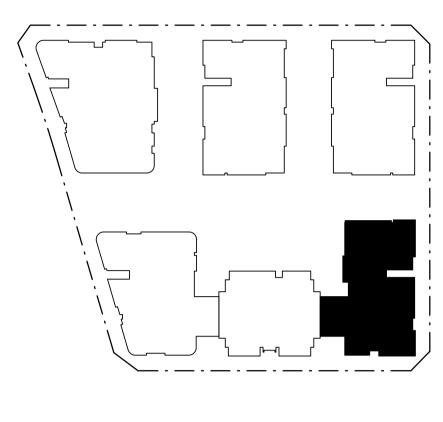

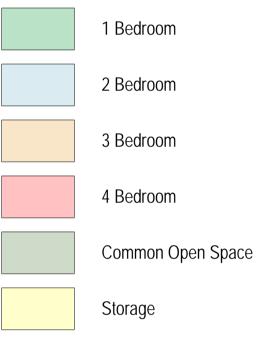

Issue	Issue descrption	Date
С	Amendments To Address SOFAC	15.07.21
В	New Road Location & Sizes Adopted, Waste Collection Areas Added, Units Added + General Amendments	08.07.20
А	Development Application	06.04.2020



١	Project	lixed Use Deve	loomont	
0	FTOPOSEd M	ined USE Deve	aopment	
F	Project Addres	S		
-ICA	971 Richmo	nd Road, Mars	den Park	
Ы	Client			
API		iDream Property Pty Ltd and C & S Partners Pty Ltd		
EVELOPMENT APPLICATION)5 - Block		
/E	Drawn	Scale	Checked	
	A.S Job No	1:200 @ A3	Checker	
E	• • • • • • •	Drawing No.	Issue	
	2435	24	С	

-**C**)

~~~~~	+ 1600 +	250 1600	
	4230	4140	
	+	0 <del>0</del>	
		3200	
~	6970	<i>64</i>	
2		3180	
	+	250	
~~~~~	0009	0009	
	*	250	
~~~~~~~	9395	90 1510 90100090 3000	
		3115 90	
~~~~~~~~~~~~~~~~~~~~~~~~~~~~~~~~~~~~~~~	+ 1650 +	+ 1650 250	
~~~~~			5.64 m
			250 77 250 77 77
5			

500

250

250

ISSUE C - AMENDMENTS - 15.07.21

1. Lot 1 boundaries amended

2. Setbacks to Southern boundary adjusted to 4.0m minimum to building (3.5m to balconies and projections)

3. Block C - Southern units C504/604/704/804 (2 bed) and C505/605/705/805 (1 bed) reconfigured to create one four bedroom unit (C504/604/704/804).


4. Privacy Screens Added & noted


5. RLs amended to reflect revised Civil drawings at Ground Floor.

6. Additional dimensions shown.

1:200 @ A3



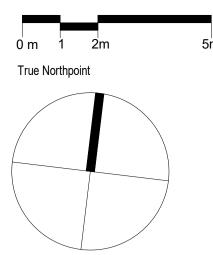

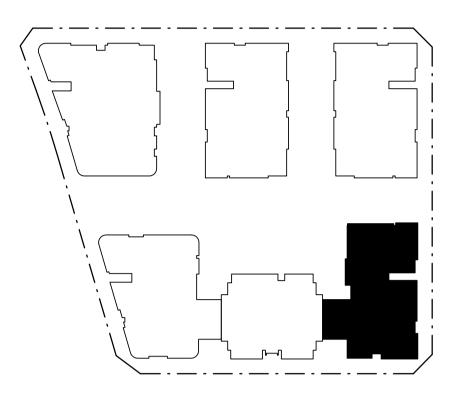




Issue	Issue descrption	Date
С	Amendments To Address SOFAC	15.07.21
В	New Road Location & Sizes Adopted, Waste Collection Areas Added, Units Added + General Amendments	08.07.20
A	Development Application	06.04.2020





NOI	Project Proposed N	lixed Use Deve	elopment	
	Project Addres	s		
ICA	971 Richmo	971 Richmond Road, Marsden Park		
	Client			
API		iDream Property Pty Ltd and C & S Partners Pty Ltd		
	Title	Title		
<b>DEVELOPMENT APPLICATION</b>	Level C C	)6-08 - B	lock	
	Drawn	Scale	Checked	
	A.S	1:200 @ A3	Checker	
	Job No	Drawing No.	Issue	
	2435	25	C	

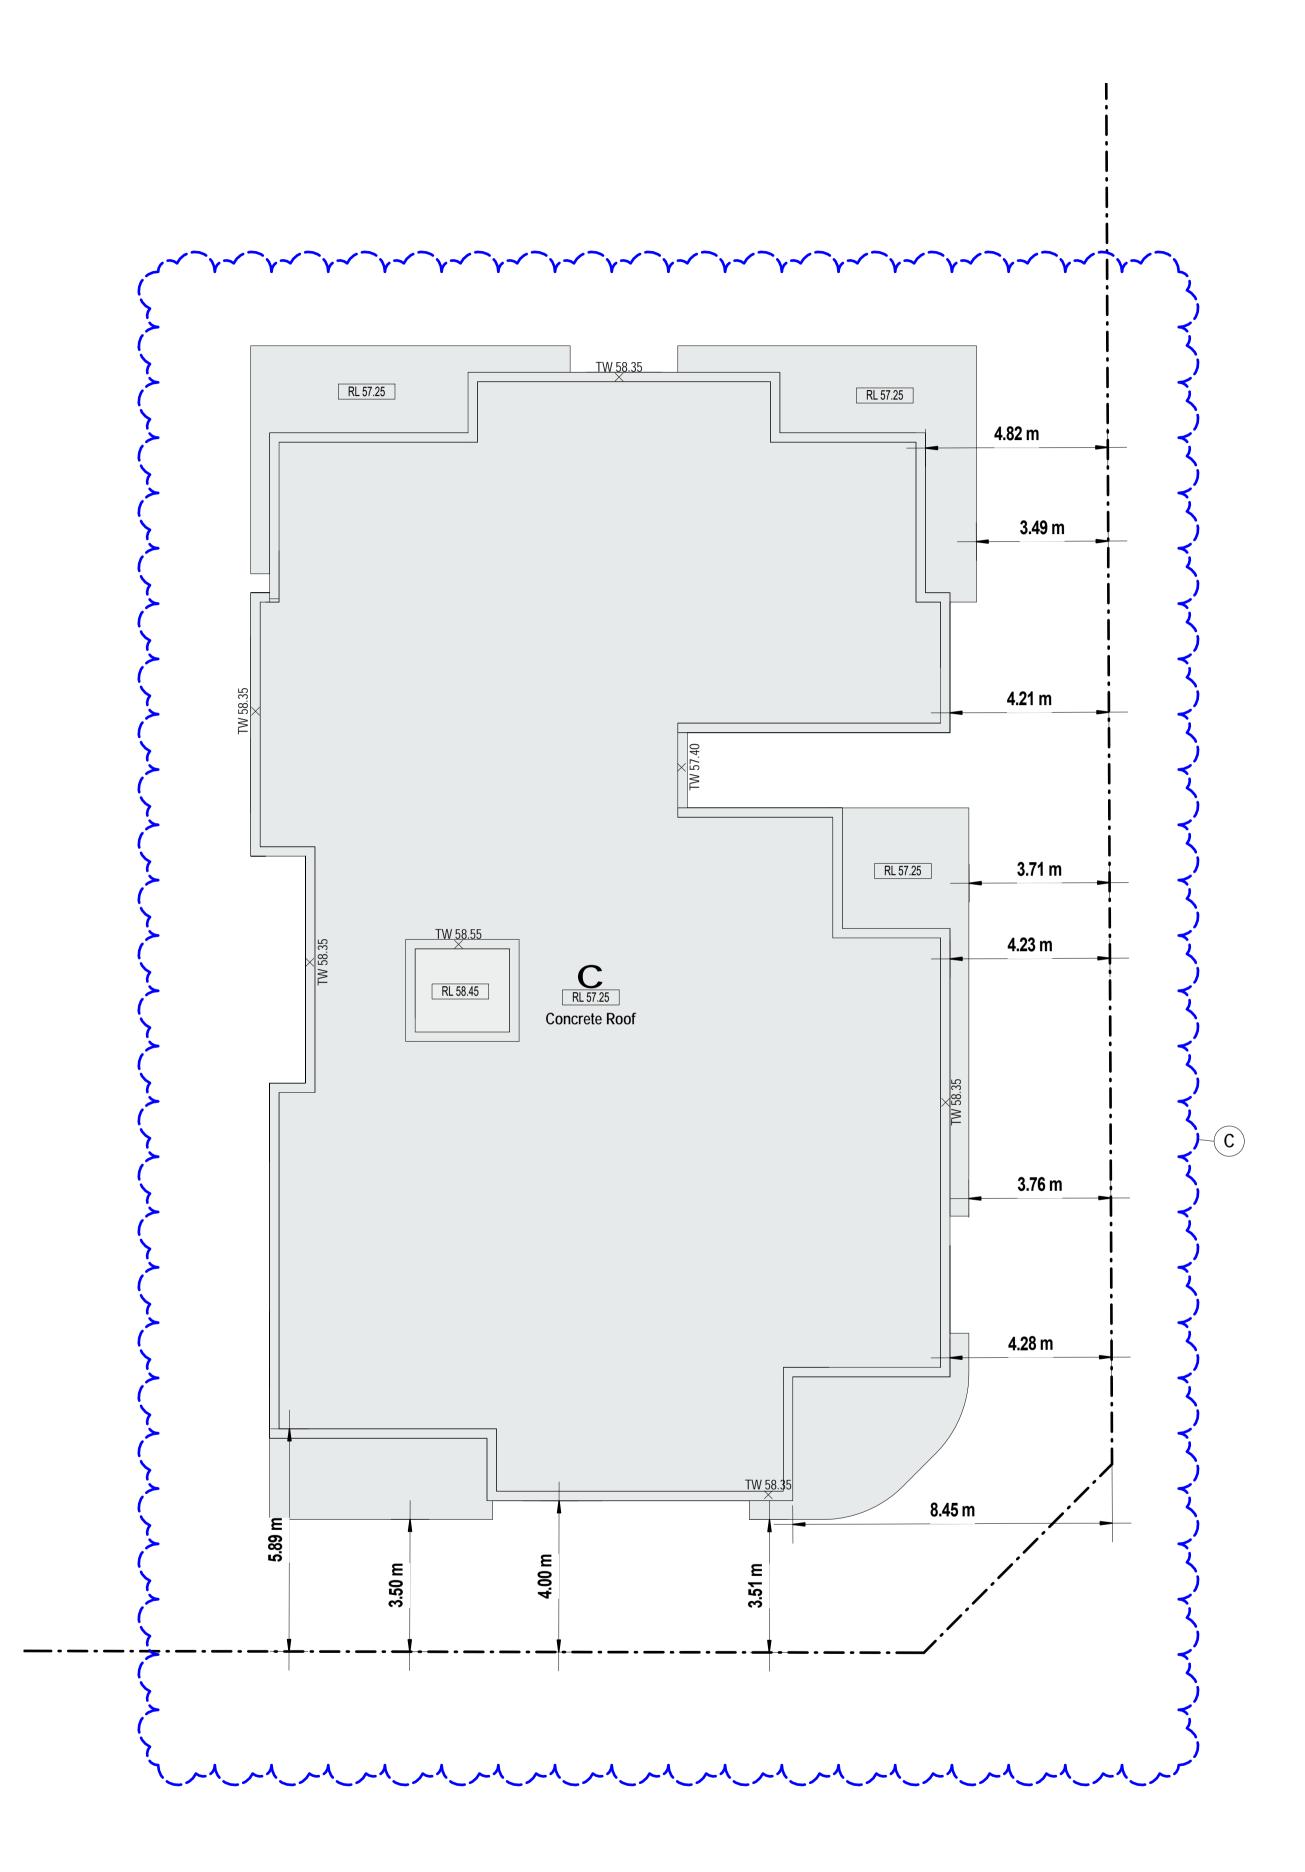

#### ISSUE C - AMENDMENTS - 15.07.21

- 1. Roof Plan amended to follow changes in
- floor plans below
- 1. RLs amended to reflect revised Civil drawings at
- Ground Floor.
- 2. Additional dimensions shown.

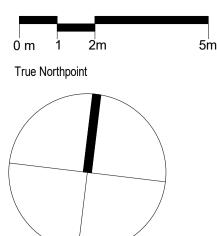

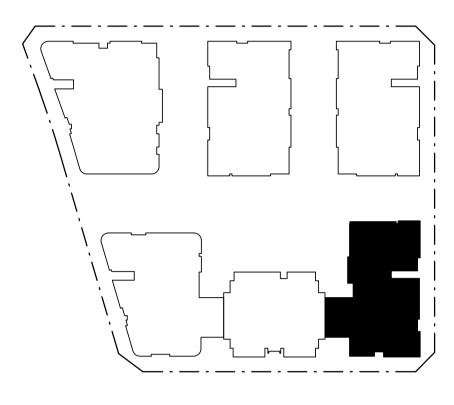





Issue	Issue descrption	Date
С	Amendments To Address SOFAC	15.07.21
В	New Road Location & Sizes Adopted, Waste Collection Areas Added, Units Added + General Amendments	08.07.20
A	Development Application	06.04.2020





	Noninated Archi		eg. No. 3972	
NO	Project Proposed N	lixed Use Deve	elopment	
E	Project Addres	SS		
<b>DEVELOPMENT APPLICATION</b>	971 Richmond Road, Marsden Park			
Ы	Client			
Р	iDream Property Pty Ltd and			
A	C & S Parti	C & S Partners Pty Ltd		
Ν	Title			
	Roof L	Roof Level - Block C		
M				
Р				
L(				
/E	Drawn	Scale	Checked	
	A.S Job No	1:200 @ A3 Drawing No.		
G				
	2435	26		

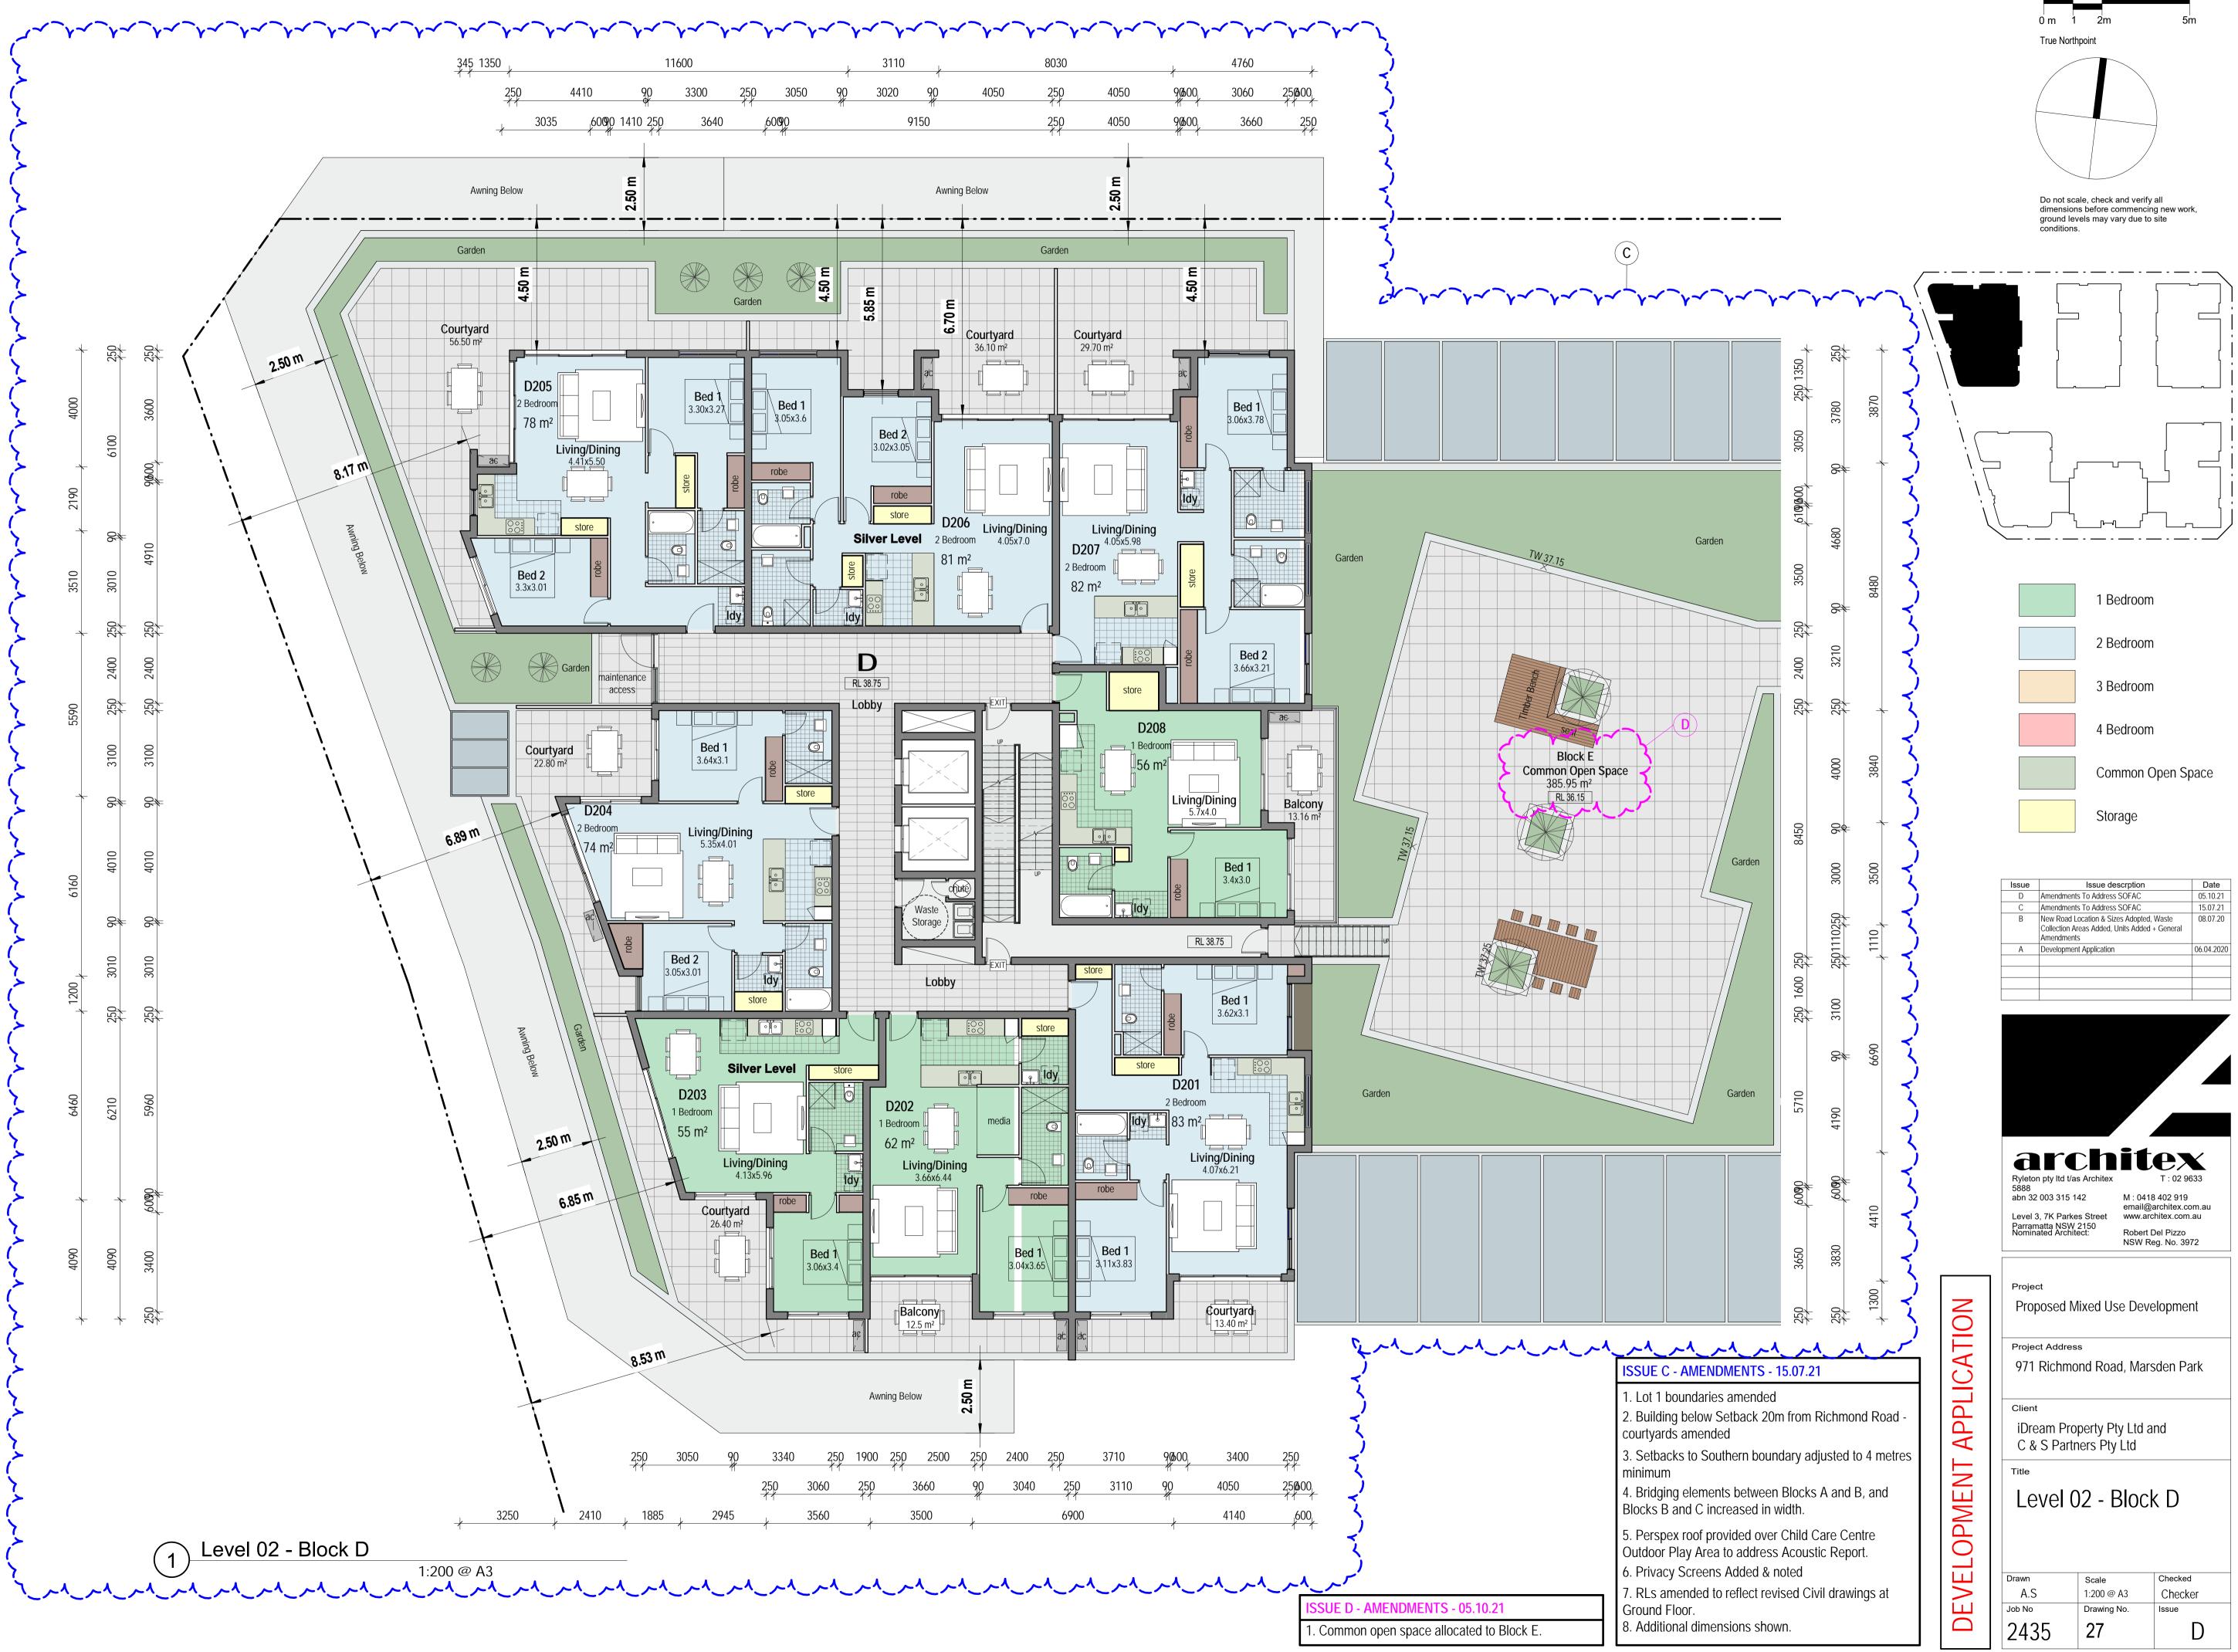

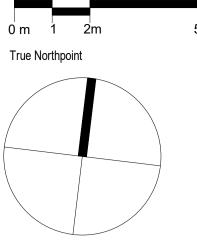



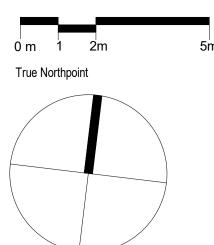

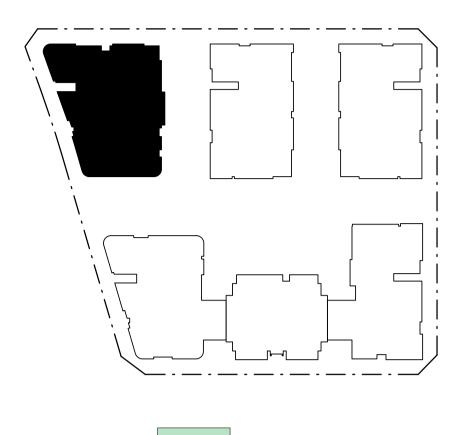

1 Bedroom
2 Bedroom
3 Bedroom
4 Bedroom
Common Open Space
Storage

Issue	Issue descrption	Date
С	Amendments To Address SOFAC	15.07.21
В	New Road Location & Sizes Adopted, Waste Collection Areas Added, Units Added + General Amendments	08.07.20
A	Development Application	06.04.2020



Level 3, 7K Parkes Street Parramatta NSW 2150 Nominated Architect: Robert Del Pizzo NSW Reg. No. 3972

Project

Proposed Mixed Use Development

Project Address

971 Richmond Road, Marsden Park

Client

Title

**APPLICATION** 

DEVELOPMENT

iDream Property Pty Ltd and C & S Partners Pty Ltd


## Level 03-04 - Block D


Drawn	Scale	Checked
A.S	1:200 @ A3	Checker
Job No	Drawing No.	Issue
2435	28	С


ISSUE C - AMENDMENTS -15.07.21 1. Lot 1 boundaries amended 2. Setbacks to Southern boundary adjusted to 4.0m minimum to building (3.5m to balconies and projections) 3. Privacy Screens Added & noted 4. RLs amended to reflect revised Civil drawings at

5. Additional dimensions shown.

-(**C**)

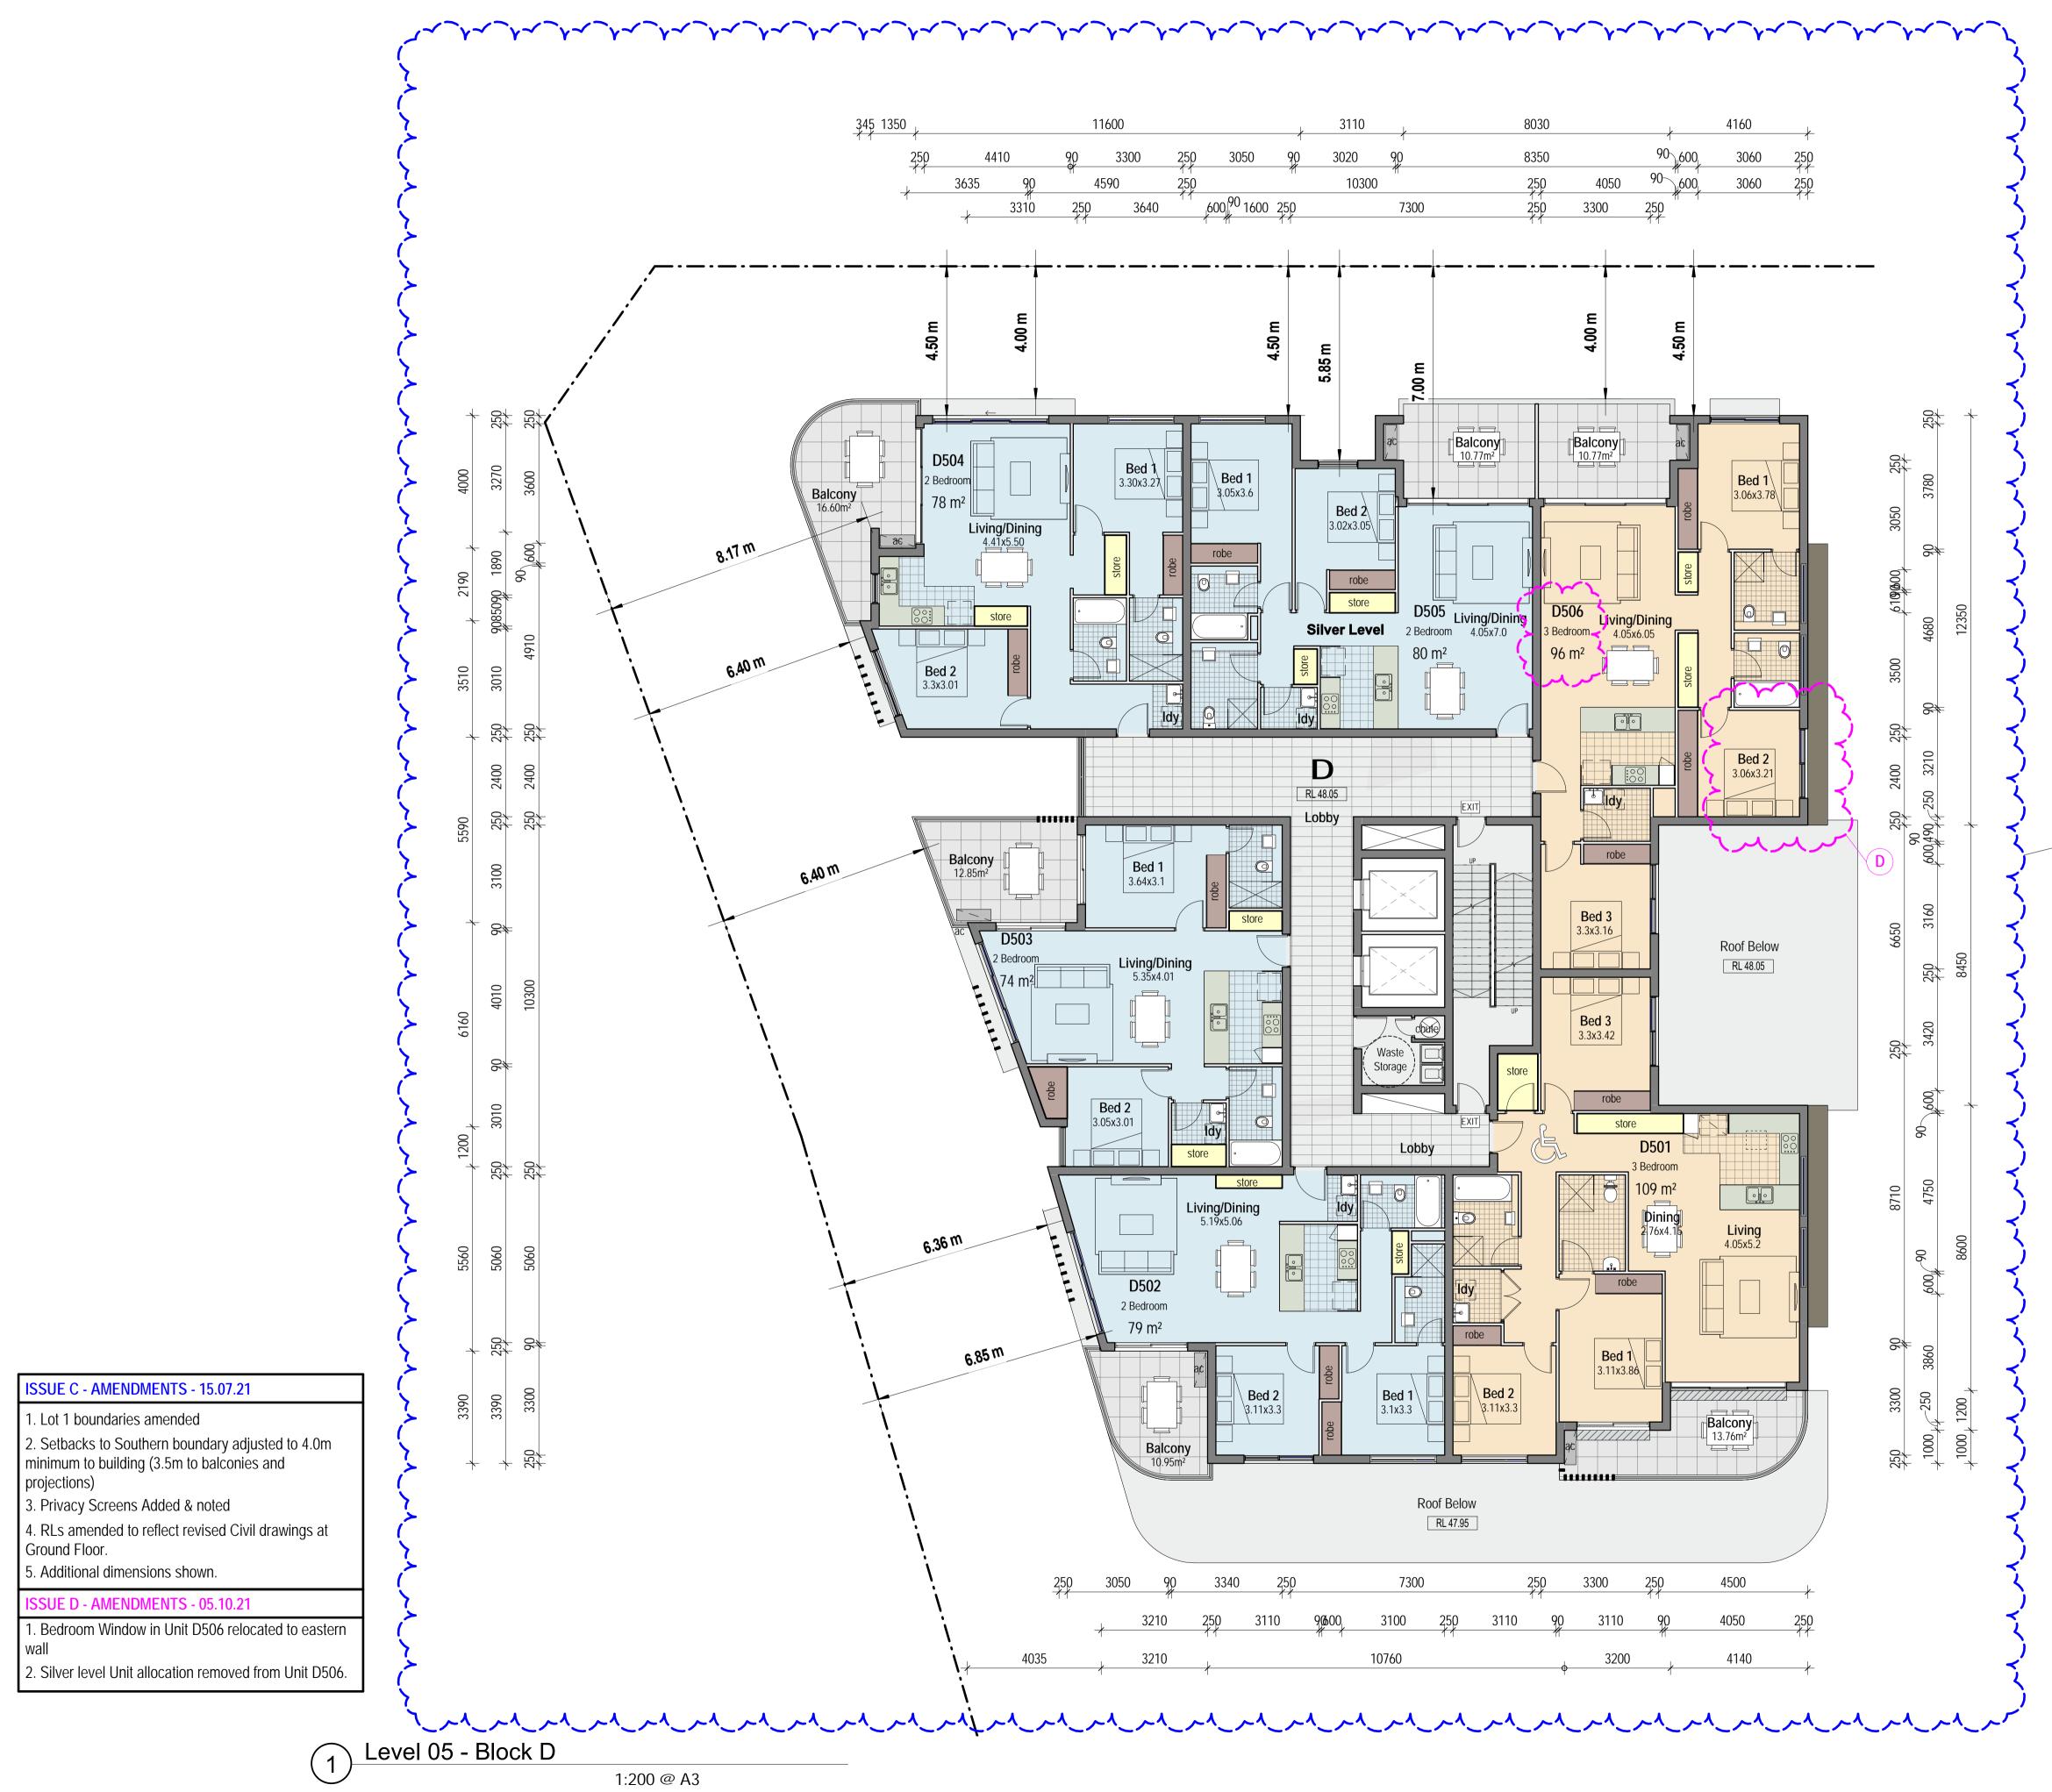

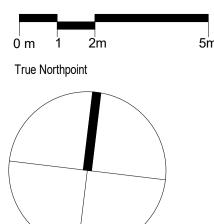

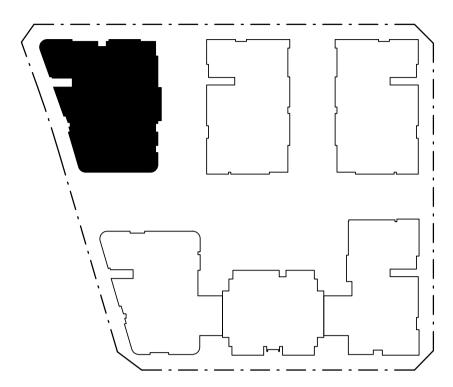



Issue	Issue descrption	Date
D	Amendments To Address SOFAC	05.10.21
С	Amendments To Address SOFAC	15.07.21
В	New Road Location & Sizes Adopted, Waste Collection Areas Added, Units Added + General Amendments	08.07.20
A	Development Application	06.04.2020



email@architex.com.a Level 3, 7K Parkes Street Parramatta NSW 2150 Nominated Architect: Robert Del Pizzo NSW Reg. No. 3972

Project

Proposed Mixed Use Development

Project Address

971 Richmond Road, Marsden Park

Client

Title

**APPLICATION** 


DEVELOPMENT


iDream Property Pty Ltd and C & S Partners Pty Ltd


Level 05 - Block D

Drawn	Scale	Checked
A.S	1:200 @ A3	Checker
Job No	Drawing No.	Issue
2435	29	D

- **C** 

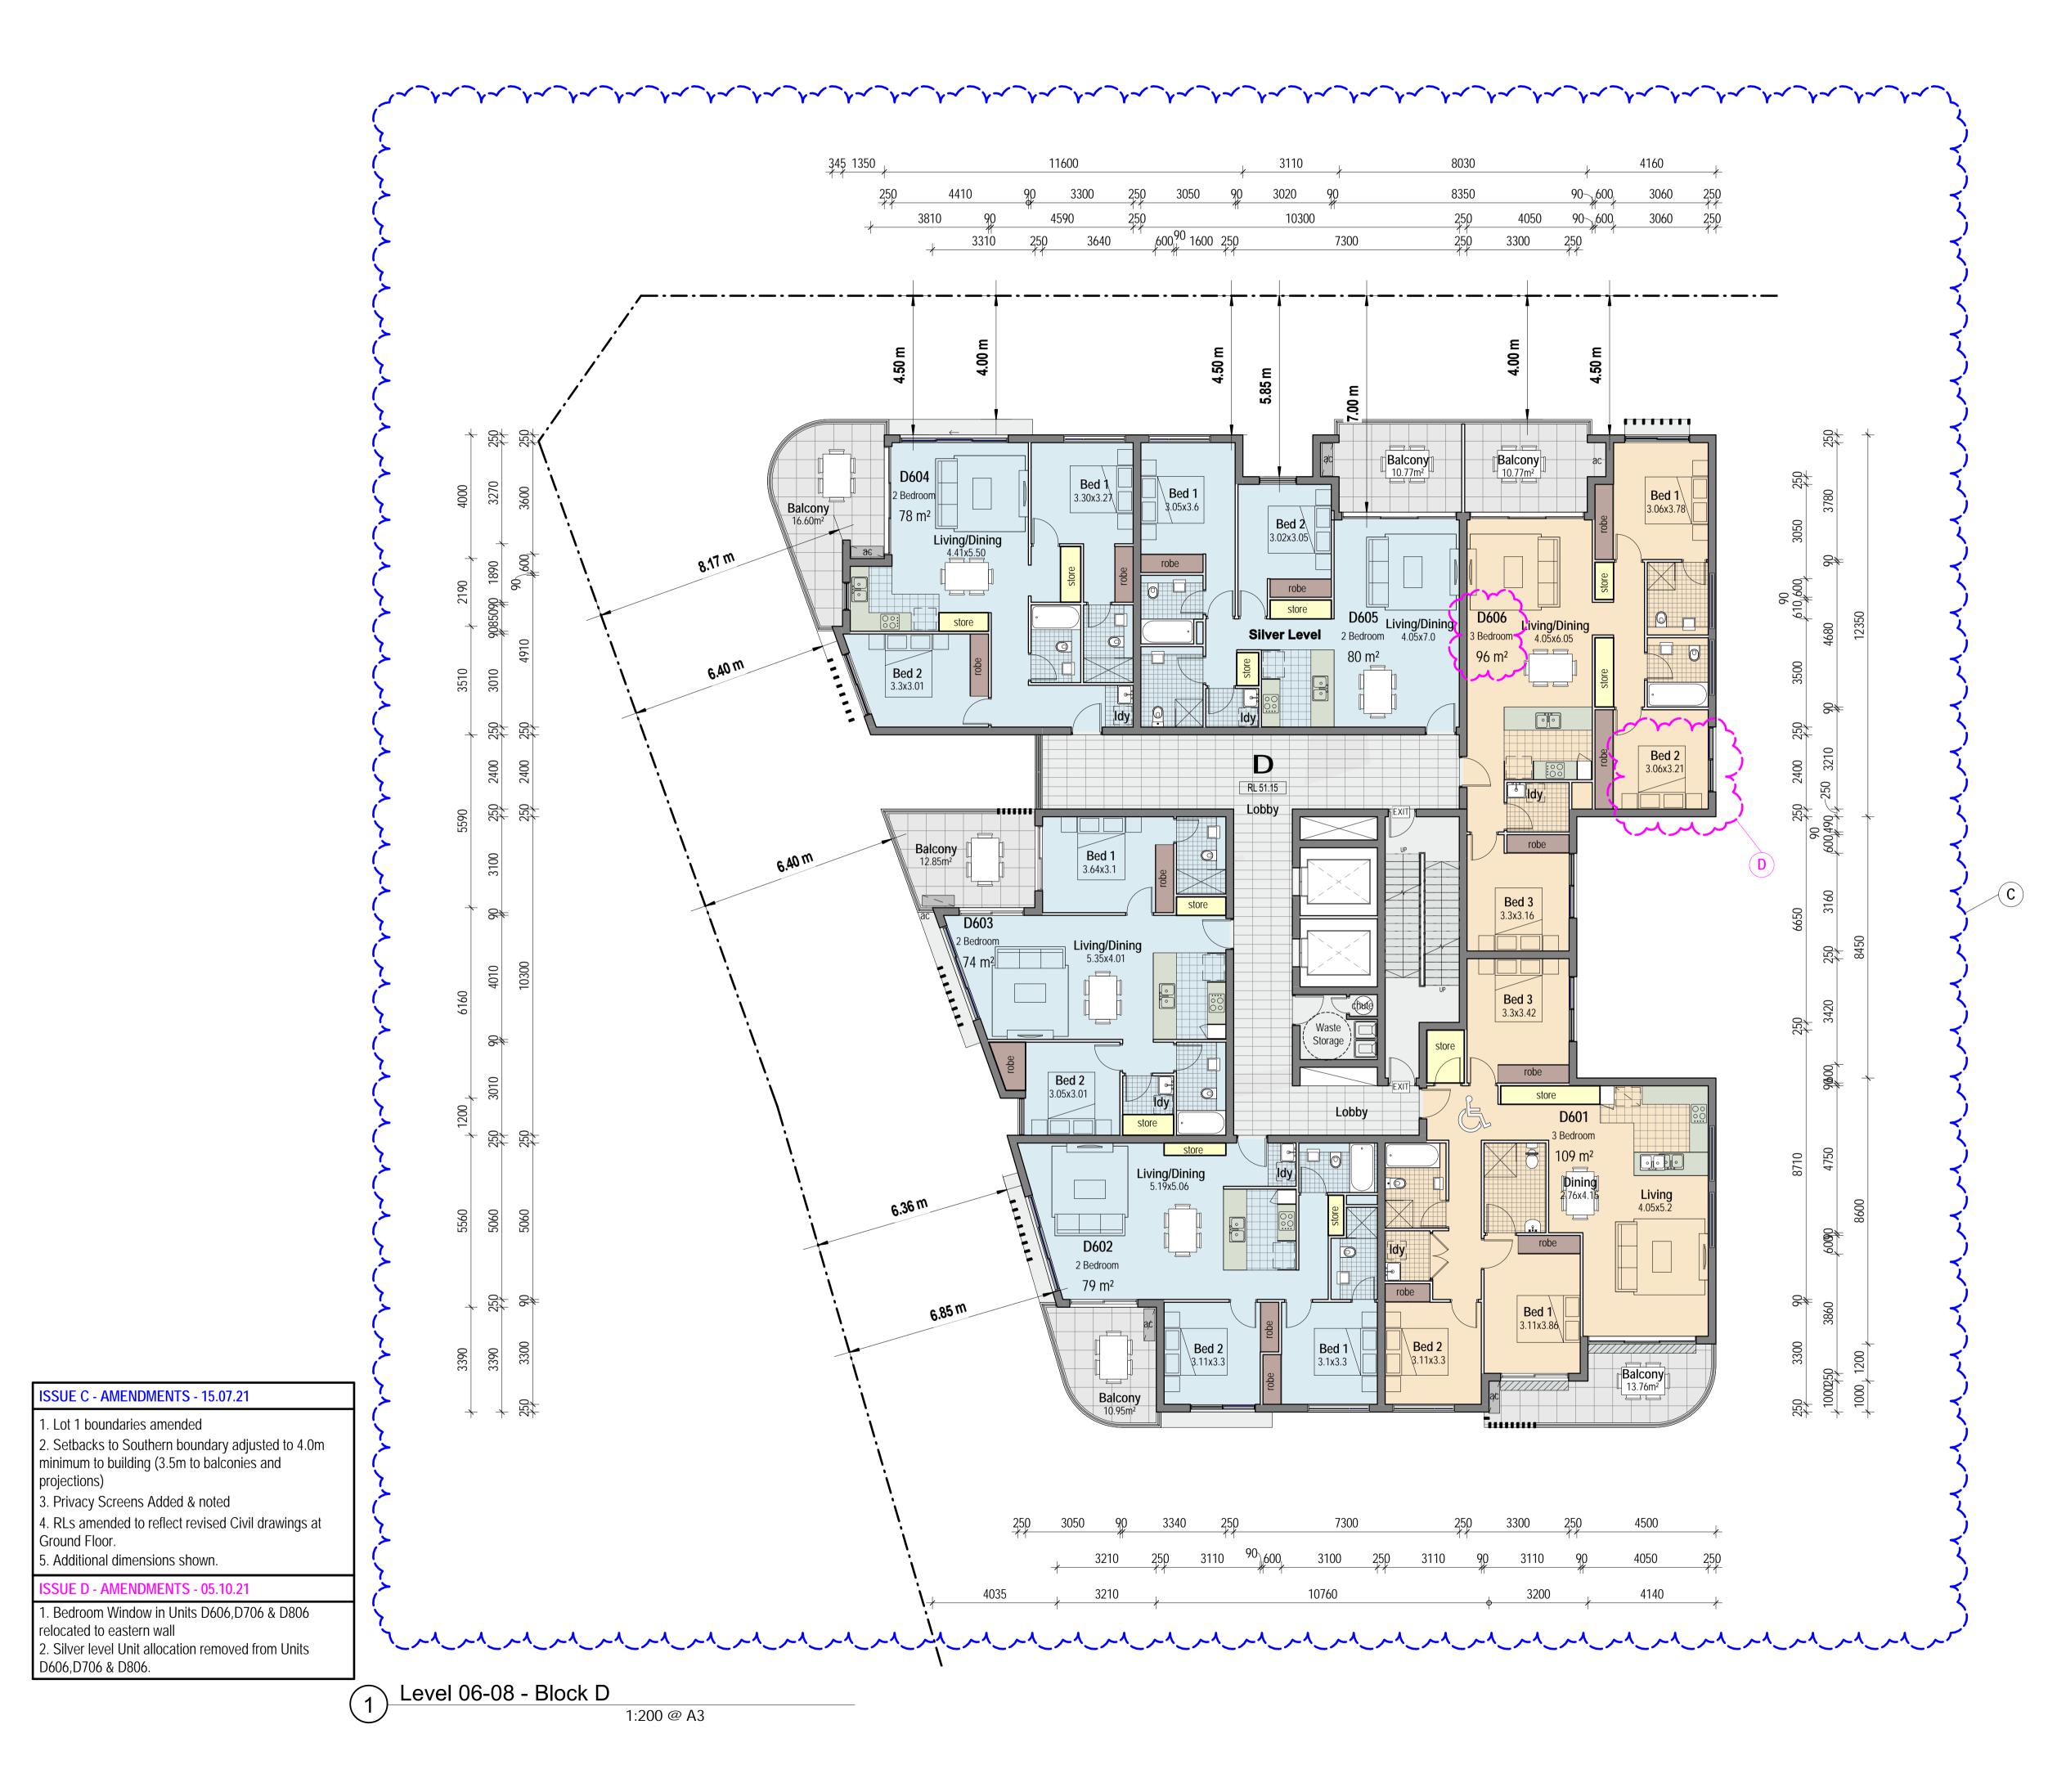

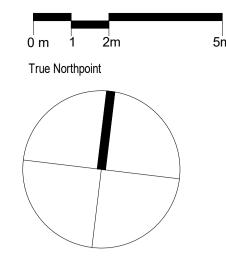

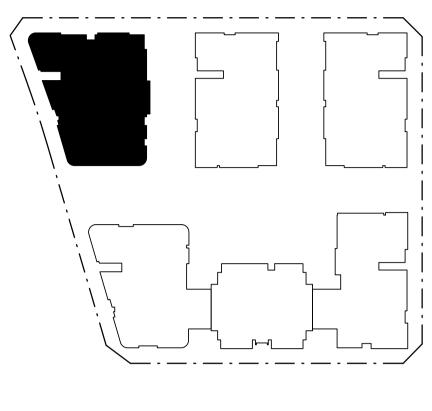



Issue	Issue descrption	Date
D	Amendments To Address SOFAC	05.10.21
С	Amendments To Address SOFAC	15.07.21
В	New Road Location & Sizes Adopted, Waste Collection Areas Added, Units Added + General Amendments	08.07.20
A	Development Application	06.04.2020



abn 32 003 315 142 M e Level 3, 7K Parkes Street w Parramatta NSW 2150 Nominated Architect: R

M : 0418 402 919 email@architex.com.au www.architex.com.au Robert Del Pizzo NSW Reg. No. 3972

#### Project

Proposed Mixed Use Development

Project Address

971 Richmond Road, Marsden Park

## Client


Title

iDream Property Pty Ltd and C & S Partners Pty Ltd


## Level 06-08 - Block D


Drawn	Scale	Checked
A.S	1:200 @ A3	Checker
Job No	Drawing No.	Issue
2435	30	D

/
0
T
CA
$\square$
ldd
ЧР
1
Z
ΛE
NdC
0
<b>H</b>

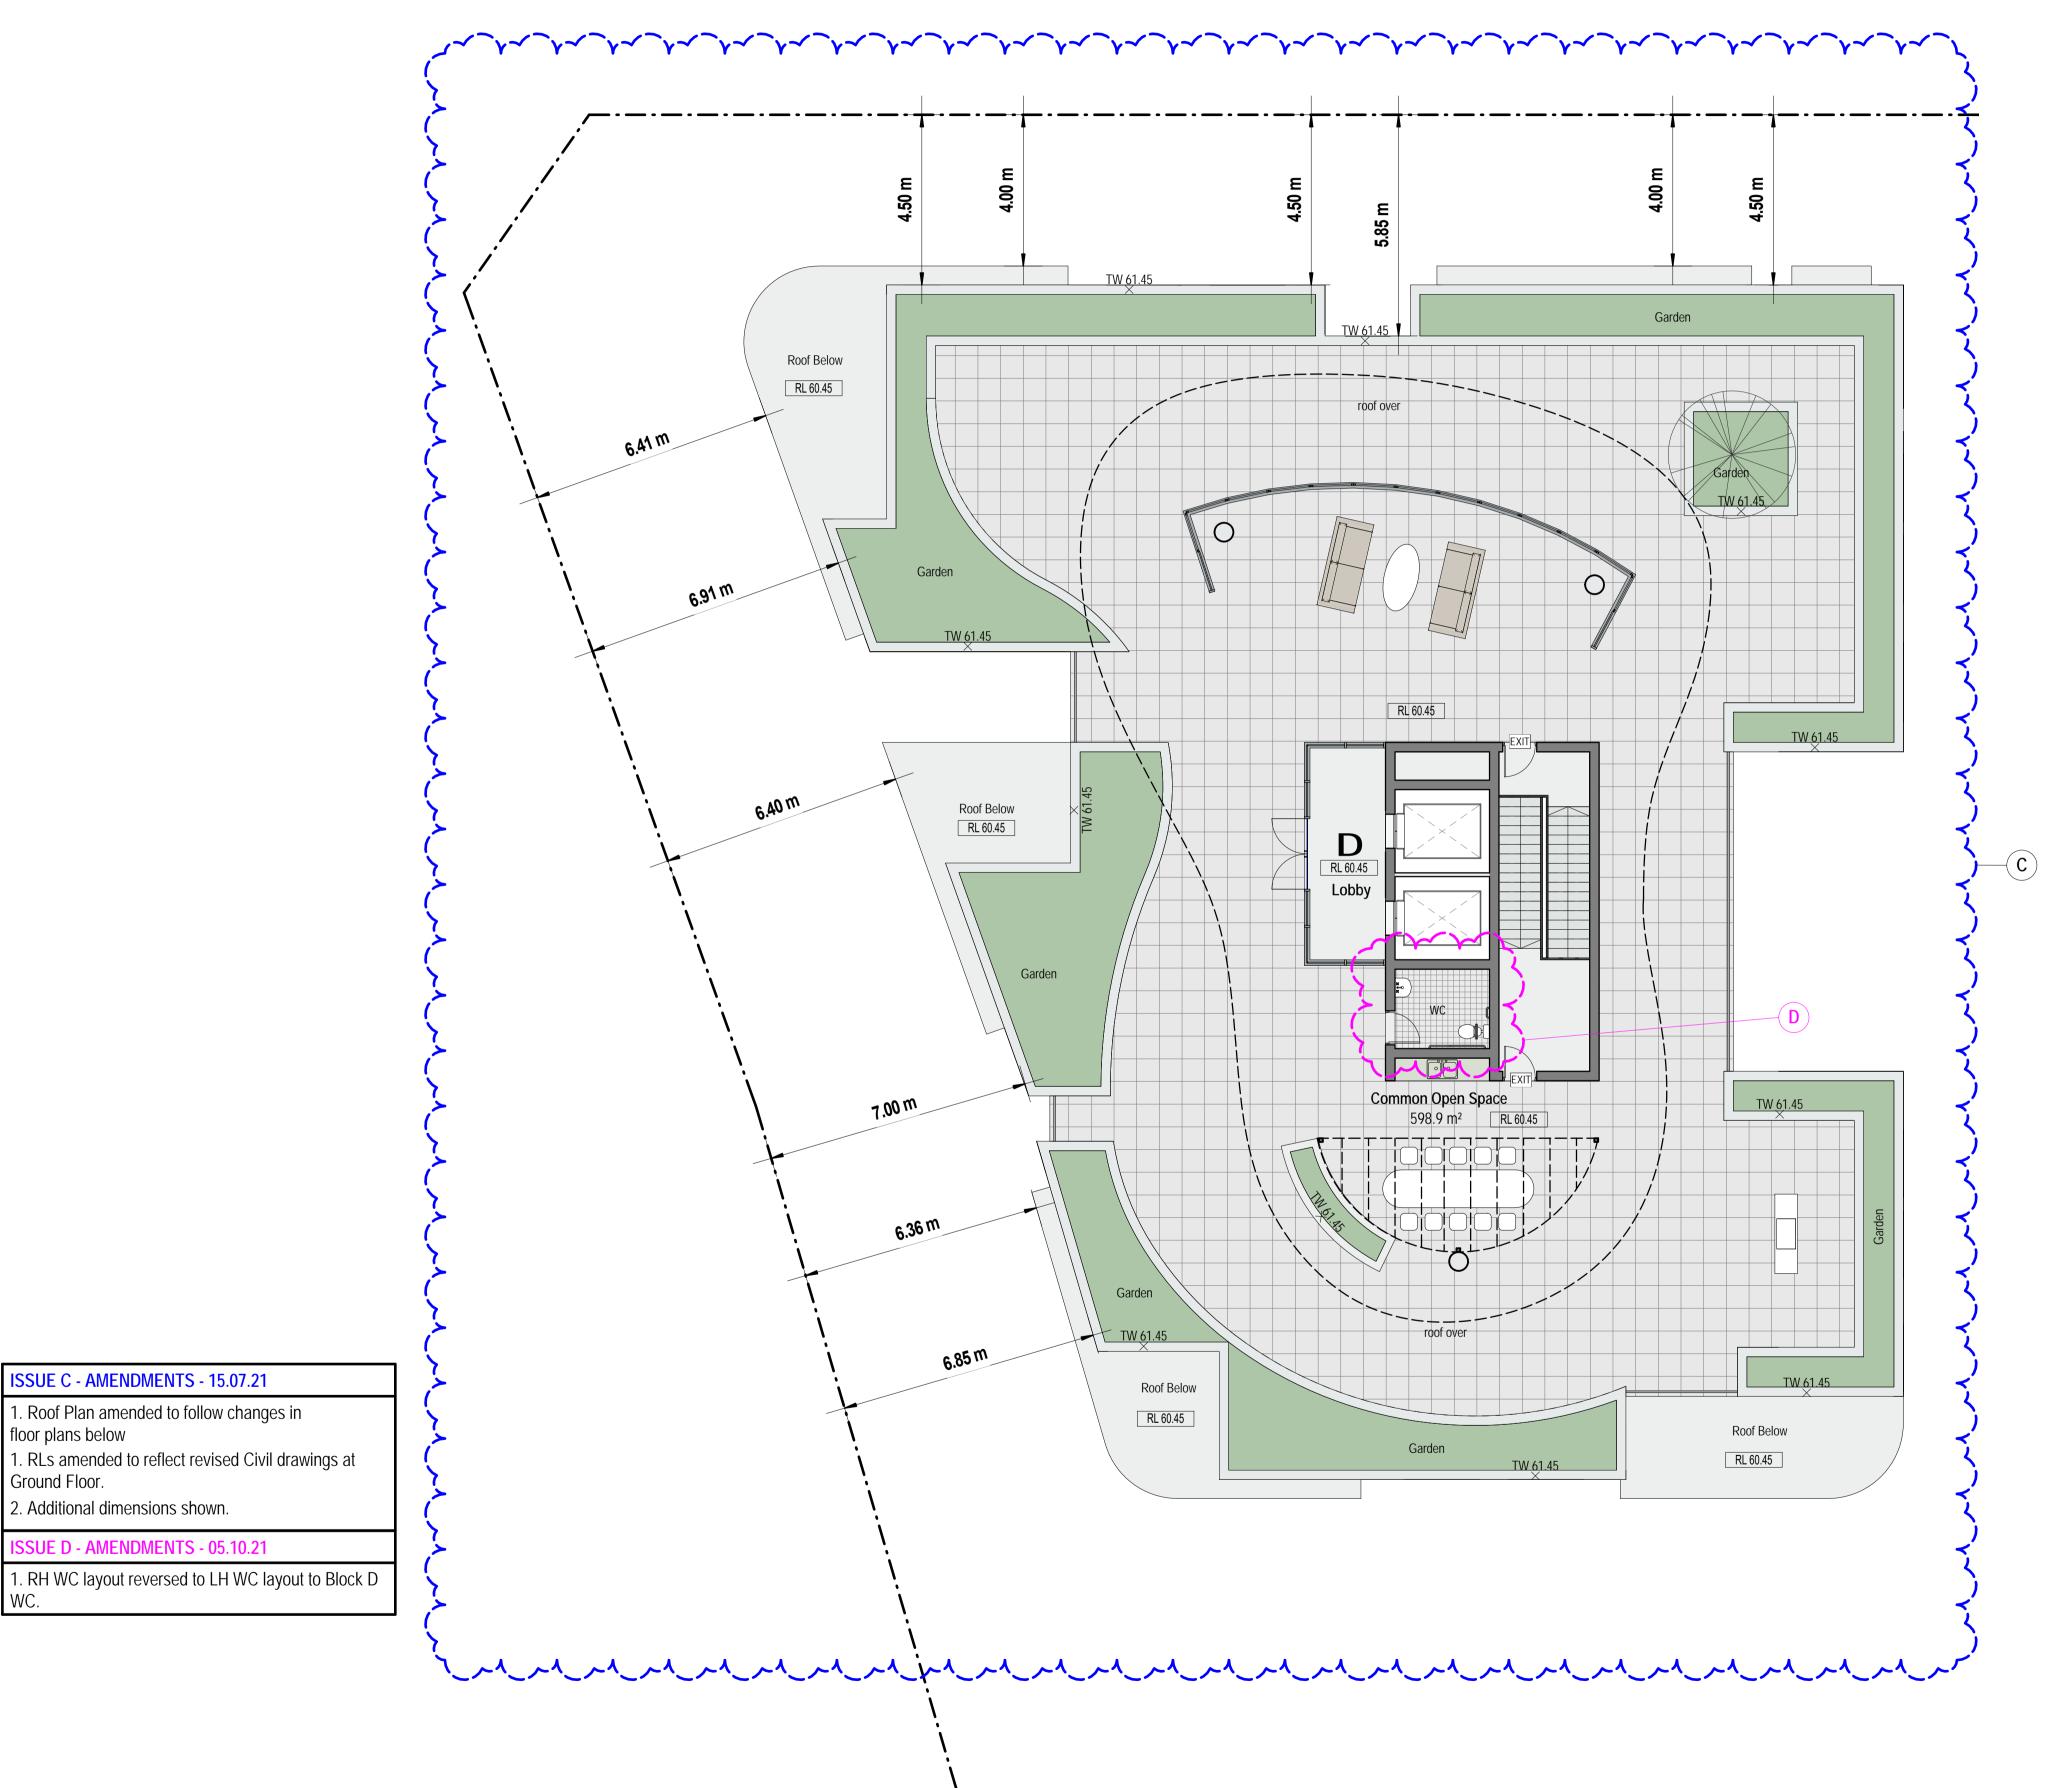

WC.

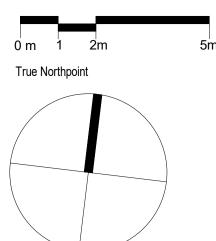

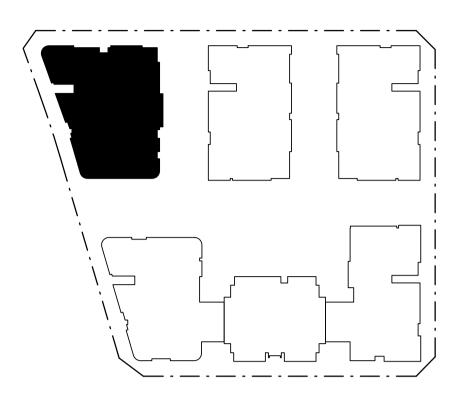




Issue	Issue descrption	Date
D	Amendments To Address SOFAC	05.10.21
С	Amendments To Address SOFAC	15.07.21
В	New Road Location & Sizes Adopted, Waste Collection Areas Added, Units Added + General Amendments	08.07.20
A	Development Application	06.04.2020



	Parramatta NSW Nominated Archite		Del Pizzo eg. No. 3972
NO	Project Proposed N	lixed Use Deve	elopment
ICATI	Project Addres 971 Richmo	^s nd Road, Mars	sden Park
APPL	Client iDream Property Pty Ltd and C & S Partners Pty Ltd		
DEVELOPMENT APPLICATION	Title Roof Lo	evel - Blo	DCK D
$\geq$	A.S	1:200 @ A3	Checker
Ш	Job No	Drawing No.	Issue
	2435	31	D

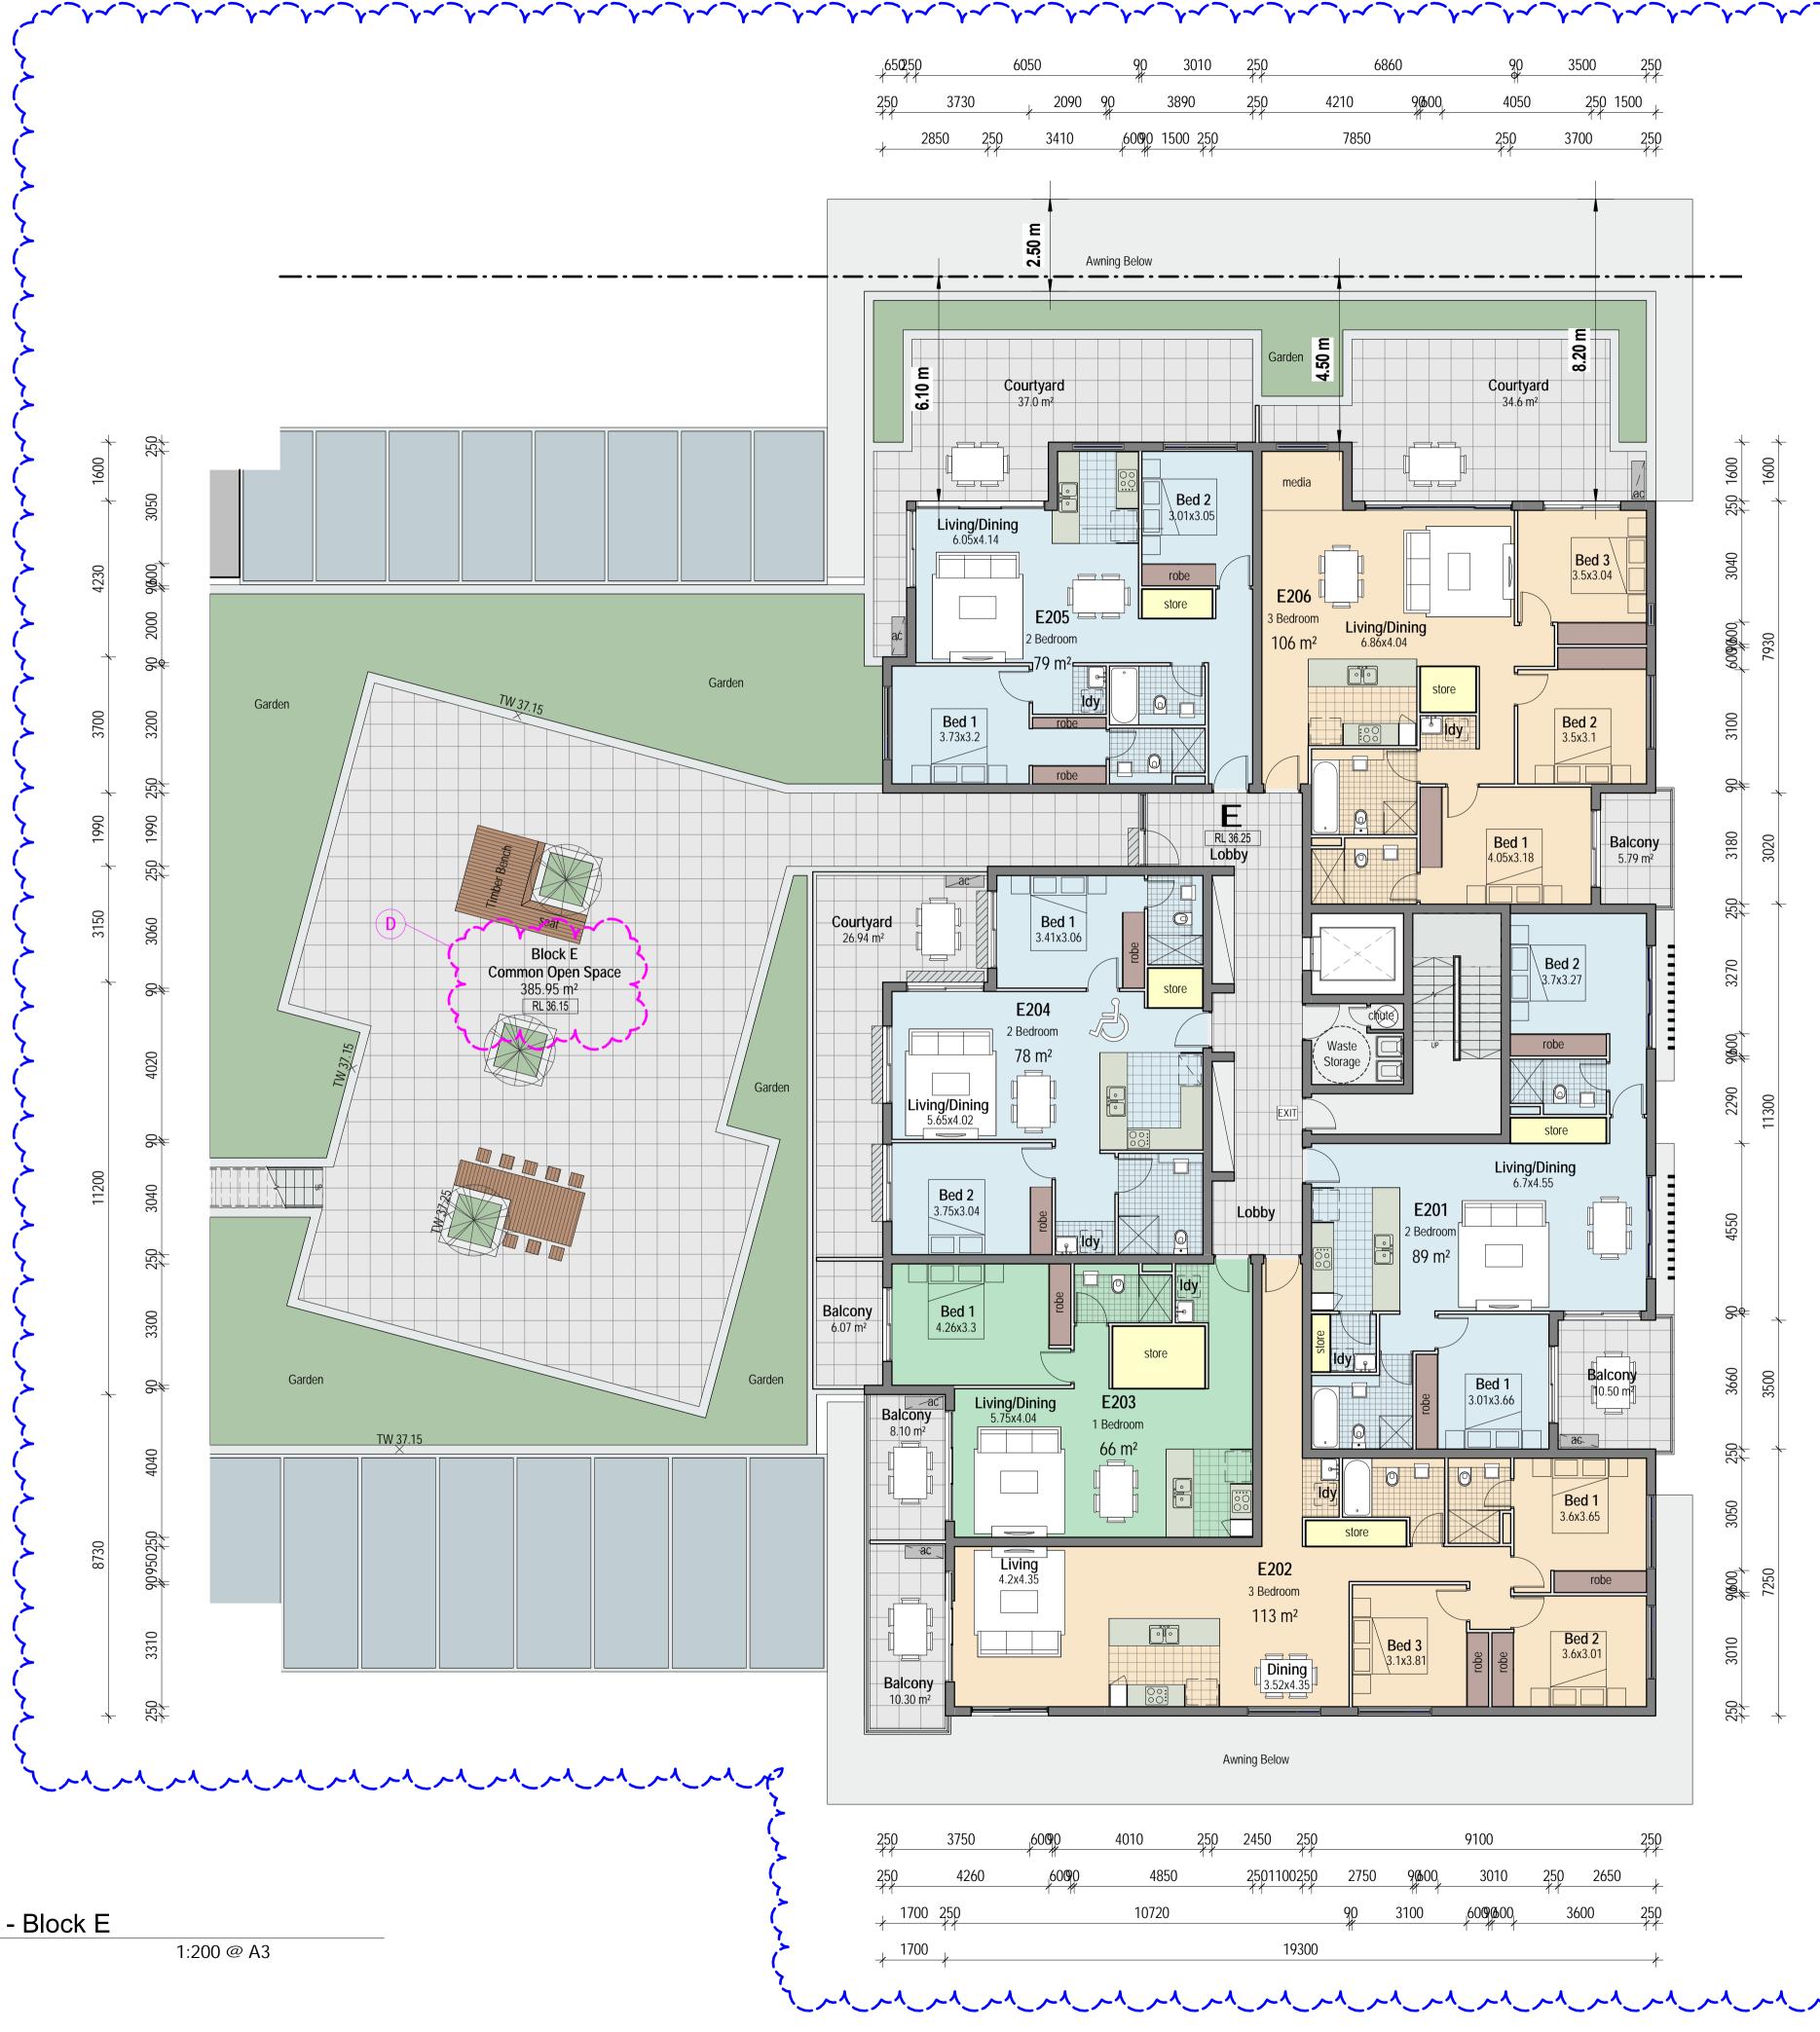

1. Lot 1 boundaries amended

2. Building below Setback 20m from Richmond Road courtyards amended

3. Setbacks to Southern boundary adjusted to 4 metres minimum

4. Block E - Common Open Space increased in size. Landscape design amended accordingly.

5. Unit E202 external wall amended on southern façade

7. Perspex roof provided over Child Care Centre Outdoor Play Area to address Acoustic Report.


8. Privacy Screens Added & noted

9. RLs amended to reflect revised Civil drawings at Ground Floor.


10. Additional dimensions shown.

SSUE D - AMENDMENTS - 05.10.21 1. Common open space allocated to Block E.

(1) Level 02 - Block E

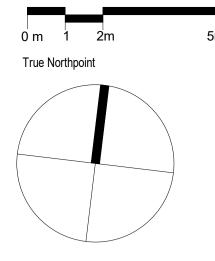

Do not scale, check and verify all dimensions before commencing new work, ground levels may vary due to site conditions.

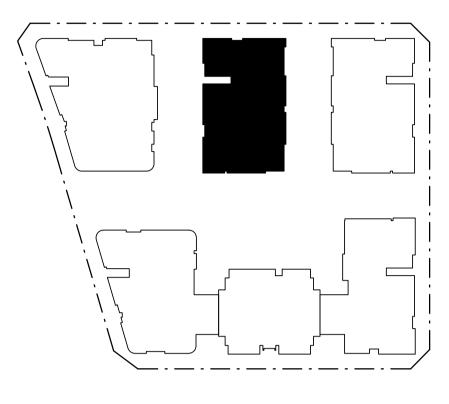



Issue	Issue descrption	Date
D	Amendments To Address SOFAC	05.10.21
С	Amendments To Address SOFAC	15.07.21
В	New Road Location & Sizes Adopted, Waste Collection Areas Added, Units Added + General Amendments	08.07.20
A	Development Application	06.04.2020



Level 3, 7K Parkes Street Parramatta NSW 2150 Nominated Architect:

Robert Del Pizzo NSW Reg. No. 3972

# Project

**APPLICATION** 

DEVELOPMENT

—(C)

Proposed Mixed Use Development

Project Address

971 Richmond Road, Marsden Park

Client

Title

iDream Property Pty Ltd and C & S Partners Pty Ltd


Level 02 - Block E


Drawn	Scale	Checked
A.S	1:200 @ A3	Checker
Job No	Drawing No.	Issue
2435	32	D



- 1. Lot 1 boundaries amended
- 2. Setbacks to Southern boundary adjusted to 4.0m
- minimum to building (3.5m to balconies and projections) 3. Building separation between Blocks D and E, and
- Blocks E and F, increased in width
- 4. Privacy Screens Added & noted
- 5. RLs amended to reflect revised Civil drawings at Ground Floor.
- 6. Additional dimensions shown.

(1) Level 03-04 - Block E

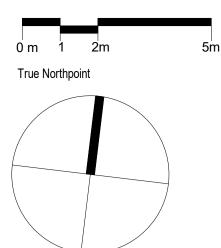

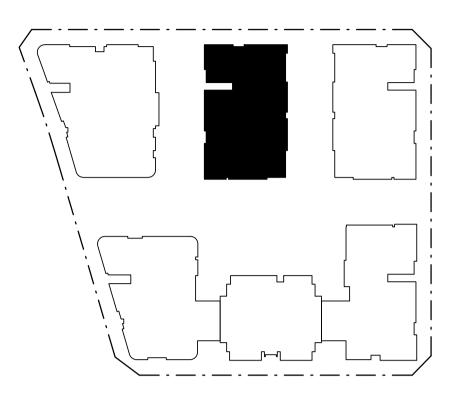

1 Bedroom
2 Bedroom
3 Bedroom
4 Bedroom
Common Open Space
Storage

Issue	Issue descrption	Date
С	Amendments To Address SOFAC	15.07.21
В	New Road Location & Sizes Adopted, Waste Collection Areas Added, Units Added + General Amendments	08.07.20
A	Development Application	06.04.2020



	Project				
NO	Proposed Mixed Use Developmen				
	Project Addres	SS			
ICA	971 Richmond Road, Marsden Park				
	Client				
EVELOPMENT APPLICATION		iDream Property Pty Ltd and C & S Partners Pty Ltd			
	Title	Title			
		Level 03-04 - Block			
$\geq$					
L C	E				
ш	Drawn	Scale	Checked		
	A.S	1:200 @ A3	Checker		
Ш	Job No	Drawing No.	Issue		
	2435	33	C		


			250 11
			+
1725 +	0 250	5	<b>Balc</b> 13.6
+ 4105 <del>+</del>	90 2000 9000 3050		
1990 + 3700	1990 250 3200		
+ 3150 + ¹	90 3060 250 1	2	9.73 m ² Balconv
10950	90 3300 250 3040 90 4020		
8980	250 3310 90950250 4040 9		Bal 8.1
			250 11 250 11


1. Lot 1 boundaries amended
2. Setbacks to Southern boundary adjusted to 4.0m minimum to building (3.5m to balconies and projections)
3. Privacy Screens Added & noted
<ul><li>4. RLs amended to reflect revised Civil drawings at Ground Floor.</li><li>5. Additional dimensions shown.</li></ul>
6. Building separation between Blocks D and E, and Blocks E and F, increased in width
7. Block E – the entire floor plates from Levels 5-8 replaced with the floor plates from Levels 3-4. The entire floor plate from Level 5 replaced with the floor plates from Levels 3-4.


8. southern wall of Unit E502 amended.

ISSUE C - AMENDMENTS - 15.07.21

(1) Level 05 - Block E

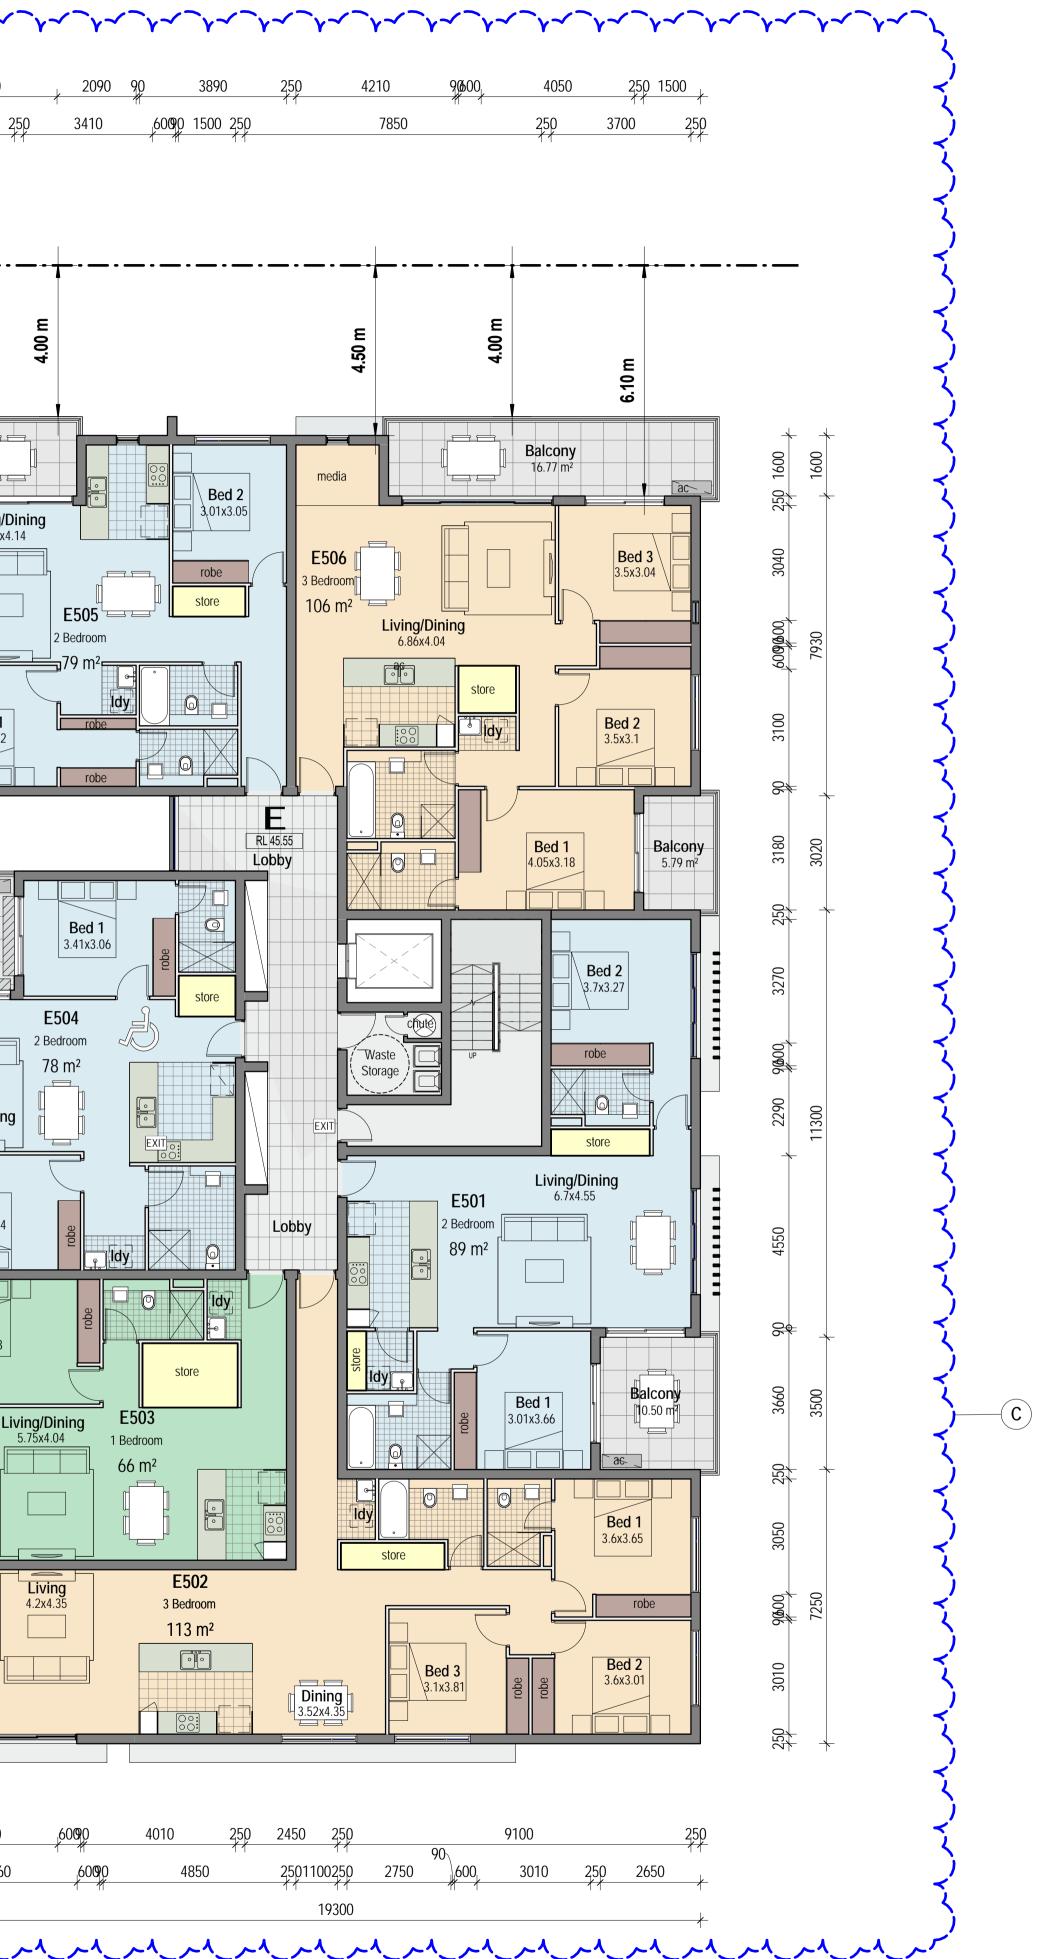

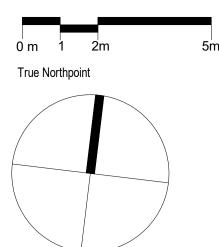

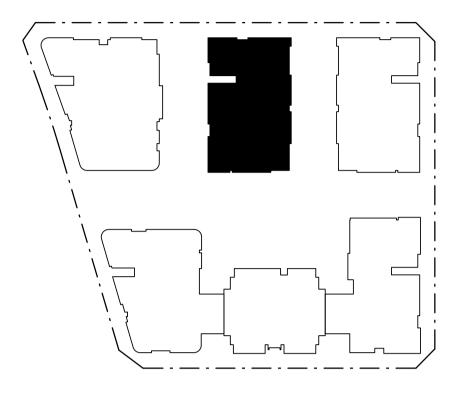



Issue	Issue descrption	Date
С	Amendments To Address SOFAC	15.07.21
В	New Road Location & Sizes Adopted, Waste Collection Areas Added, Units Added + General Amendments	08.07.20
A	Development Application	06.04.2020



	Parramatta NSW Nominated Archite		Del Pizzo eg. No. 3972
ATION	Project Addres	lixed Use Deve s nd Road, Mars	
APPLIC	Client	perty Pty Ltd a	
EVELOPMENT APPLICATION	Title Level C	)5 - Blocl	< Ε
N N	Drawn A.S	Scale 1:200 @ A3	Checked Checker
DE	Job No 2435	Drawing No.	Issue


		_
	6.10 m 6.10 m 6.10 m 6.10 m 6.10 m	
+ 1725 + 13050 250	Balcony 13.69 m ² biring /Dining	250 1600 + + 1600 +
4105 9600	ELVING/DINING 6.05x4.14 robe store store E606 3 Bedroom 106 m ²	3040
30 5000	ac 2 Bedroom 79 m ² Idy 0	600000
+ 3700 250 3200	Bed 1 3.73x3.2 robe robe	90 3100
4 250 1990	E RL 48.65 Lobby Bed 1 4.05x3.18 5.79 m ²	3180 3020
3150	Bed 1 3.41x3.06 Bed 2 3.7x3.27	3270 250
4020	E604 2 Bedroom 78 m ² Vaste Storage	0000
84	Living/Dining	+ 2290 11300
11200 250 3040	Bed 2 3.75x3.04 Bed 2 3.75x3.04 Bed 2 3.75x3.04 Bed 2 Control 100 Bed 2 Control 100 Control 1000 Contr	4550
3300	Bed 1 4.26x3.3	8 <del>4</del> ×
× 84	Balcony     E603       8.10 m²     1 Bedroom	3660
0 4040	66 m ² 66 m ² 66 m ² 66 m ² 66 m ² 66 m ² 60 m ² 70	3050 250
8730 90950250	Image: Second	9600 7250
4 250 3310	Balcony 10.30 m ² Bed 2 10.30 m ² Bed 3 3.1x3.81 Bed 3 3.1x3.81 Bed 3 3.1x3.81 Bed 3 3.1x3.81 Bed 3 0 Bed 2 3.6x3.01	250 3010 +

ISSUE C - AMENDMENTS - 15.07.21	
1 Lat 1 houndaries amonded	


- 1. Lot 1 boundaries amended
- 2. Setbacks to Southern boundary adjusted to 4.0m minimum to building (3.5m to balconies and
- projections)
- 3. Building separation between Blocks D and E, and Blocks E and F, increased in width
- 4. Block E the entire floor plates from Levels 5-8
- replaced with the floor plates from Levels 3-4.
- 5. Privacy Screens Added & noted
- 6. RLs amended to reflect revised Civil drawings at Ground Floor.
- 7. Additional dimensions shown.

(1) Level 06-08 - Block E



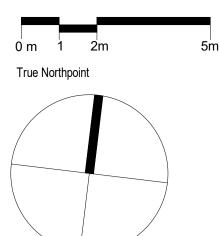

Do not scale, check and verify all dimensions before commencing new work, ground levels may vary due to site conditions.

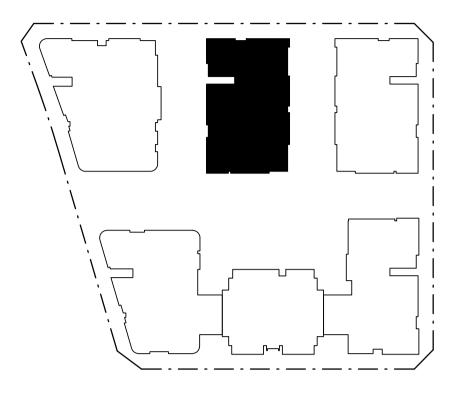




Issue	Issue descrption	Date
С	Amendments To Address SOFAC	15.07.21
В	New Road Location & Sizes Adopted, Waste Collection Areas Added, Units Added + General Amendments	08.07.20
A	Development Application	06.04.2020



Robert Del Pizzo


NSW Reg. No. 3972


			-		
NOI	Project Proposed N	lixed Use Deve	elopment		
<b>ICAT</b>	Project Addres 971 Richmo	s and Road, Mars	sden Park		
APPL		Client iDream Property Pty Ltd and C & S Partners Pty Ltd			
EVELOPMENT APPLICATION	Level C E	)6-08 - B	lock		
VE	Drawn A.S	Scale 1:200 @ A3	Checked Checker		
DE	Job No 2435	Drawing No. <b>35</b>	Issue		

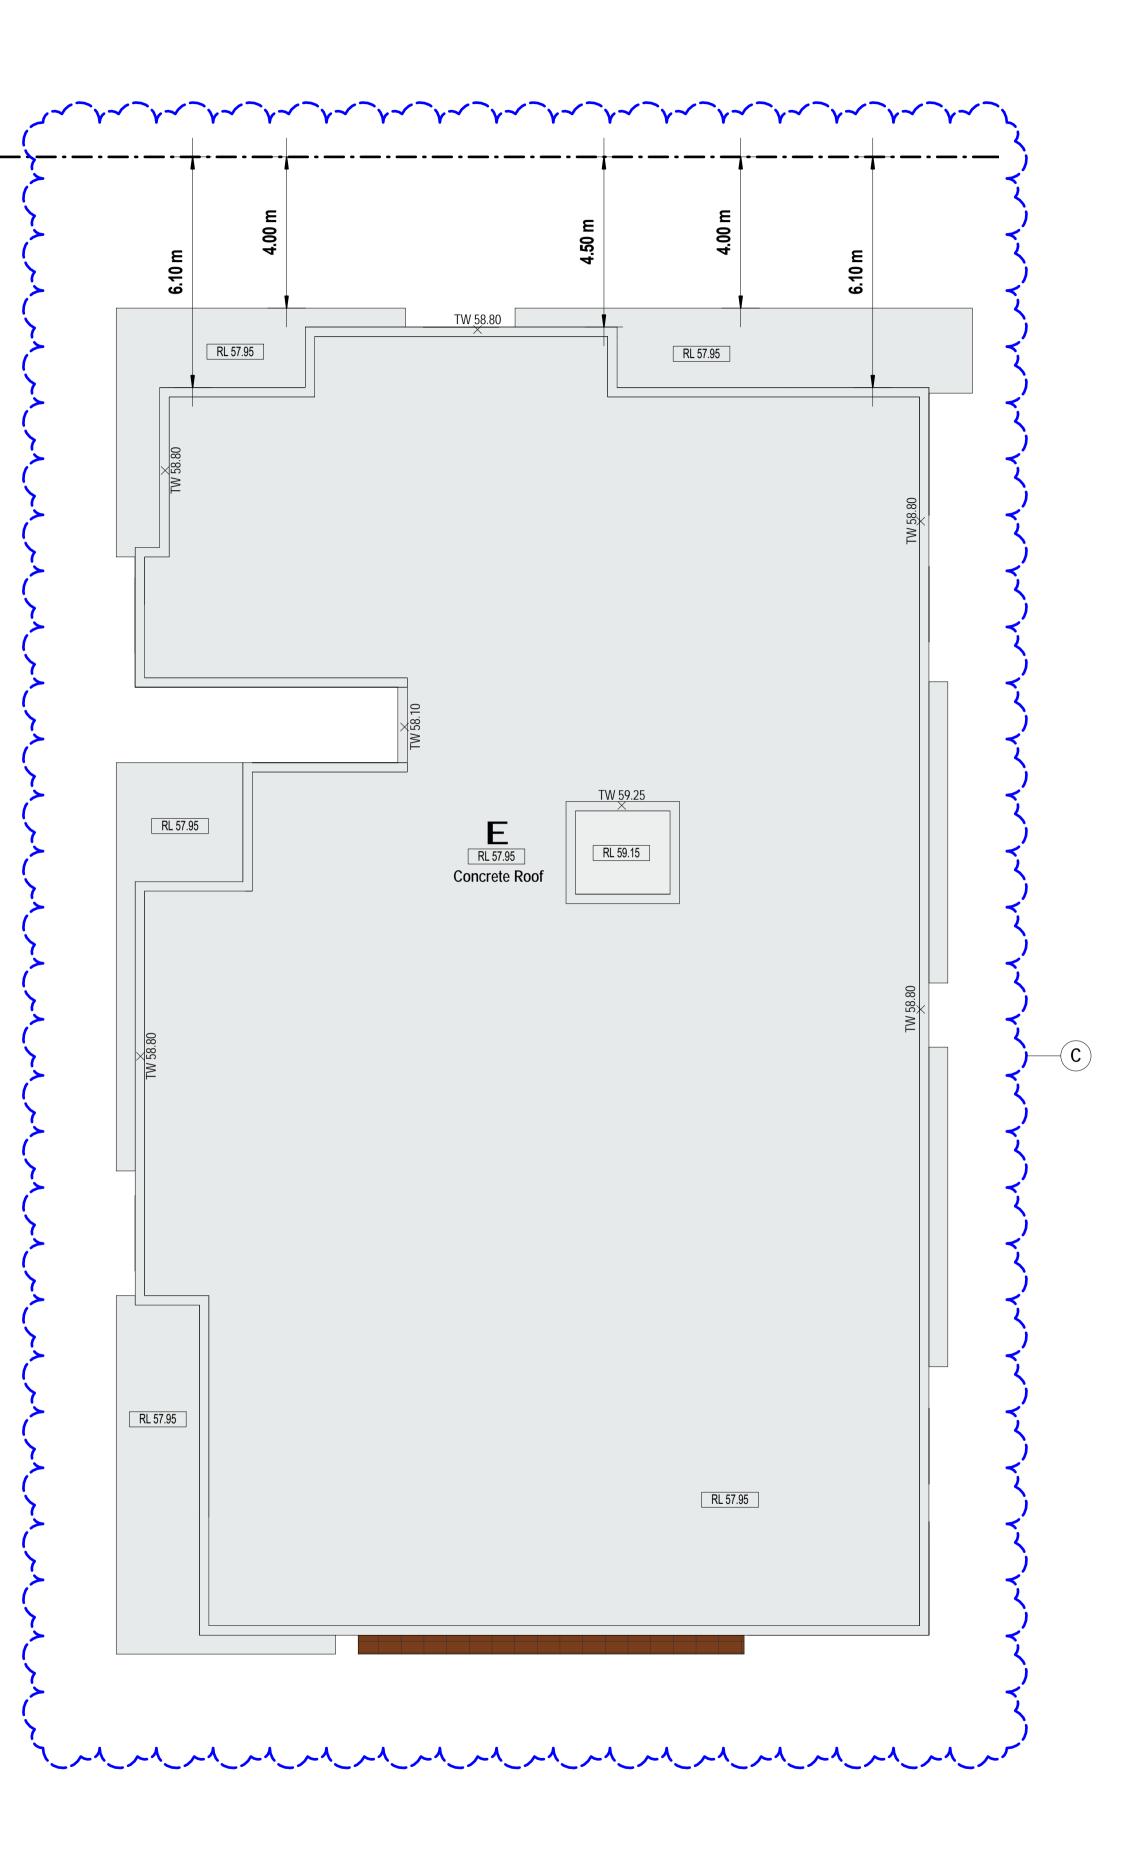

- 1. Roof Plan amended to follow changes in
- floor plans below
- 1. RLs amended to reflect revised Civil drawings at
- Ground Floor.
- 2. Additional dimensions shown.



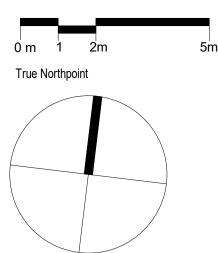

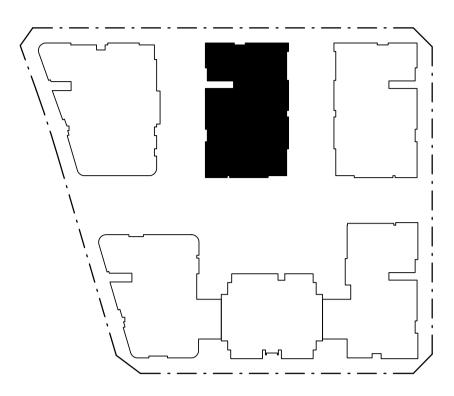




Issue	Issue descrption	Date
С	Amendments To Address SOFAC	15.07.21
В	New Road Location & Sizes Adopted, Waste Collection Areas Added, Units Added + General Amendments	08.07.20
А	Development Application	06.04.2020



		NSW Reg. No. 3972		
	Project			
ION	Proposed M	lixed Use Deve	elopment	
$\vdash$	Project Addres	s		
ICA.	971 Richmo	nd Road, Mars	den Park	
	Client			
Ы	iDream Pro	perty Pty Ltd a	nd	
A		C & S Partners Pty Ltd		
Ν	Title	Title		
DEVELOPMENT APPLICATION		evel - Blo		
/E	Drawn	Scale	Checked	
	A.S Job No	1:200 @ A3 Drawing No.	Checker Issue	
E				
	2435	36	С	

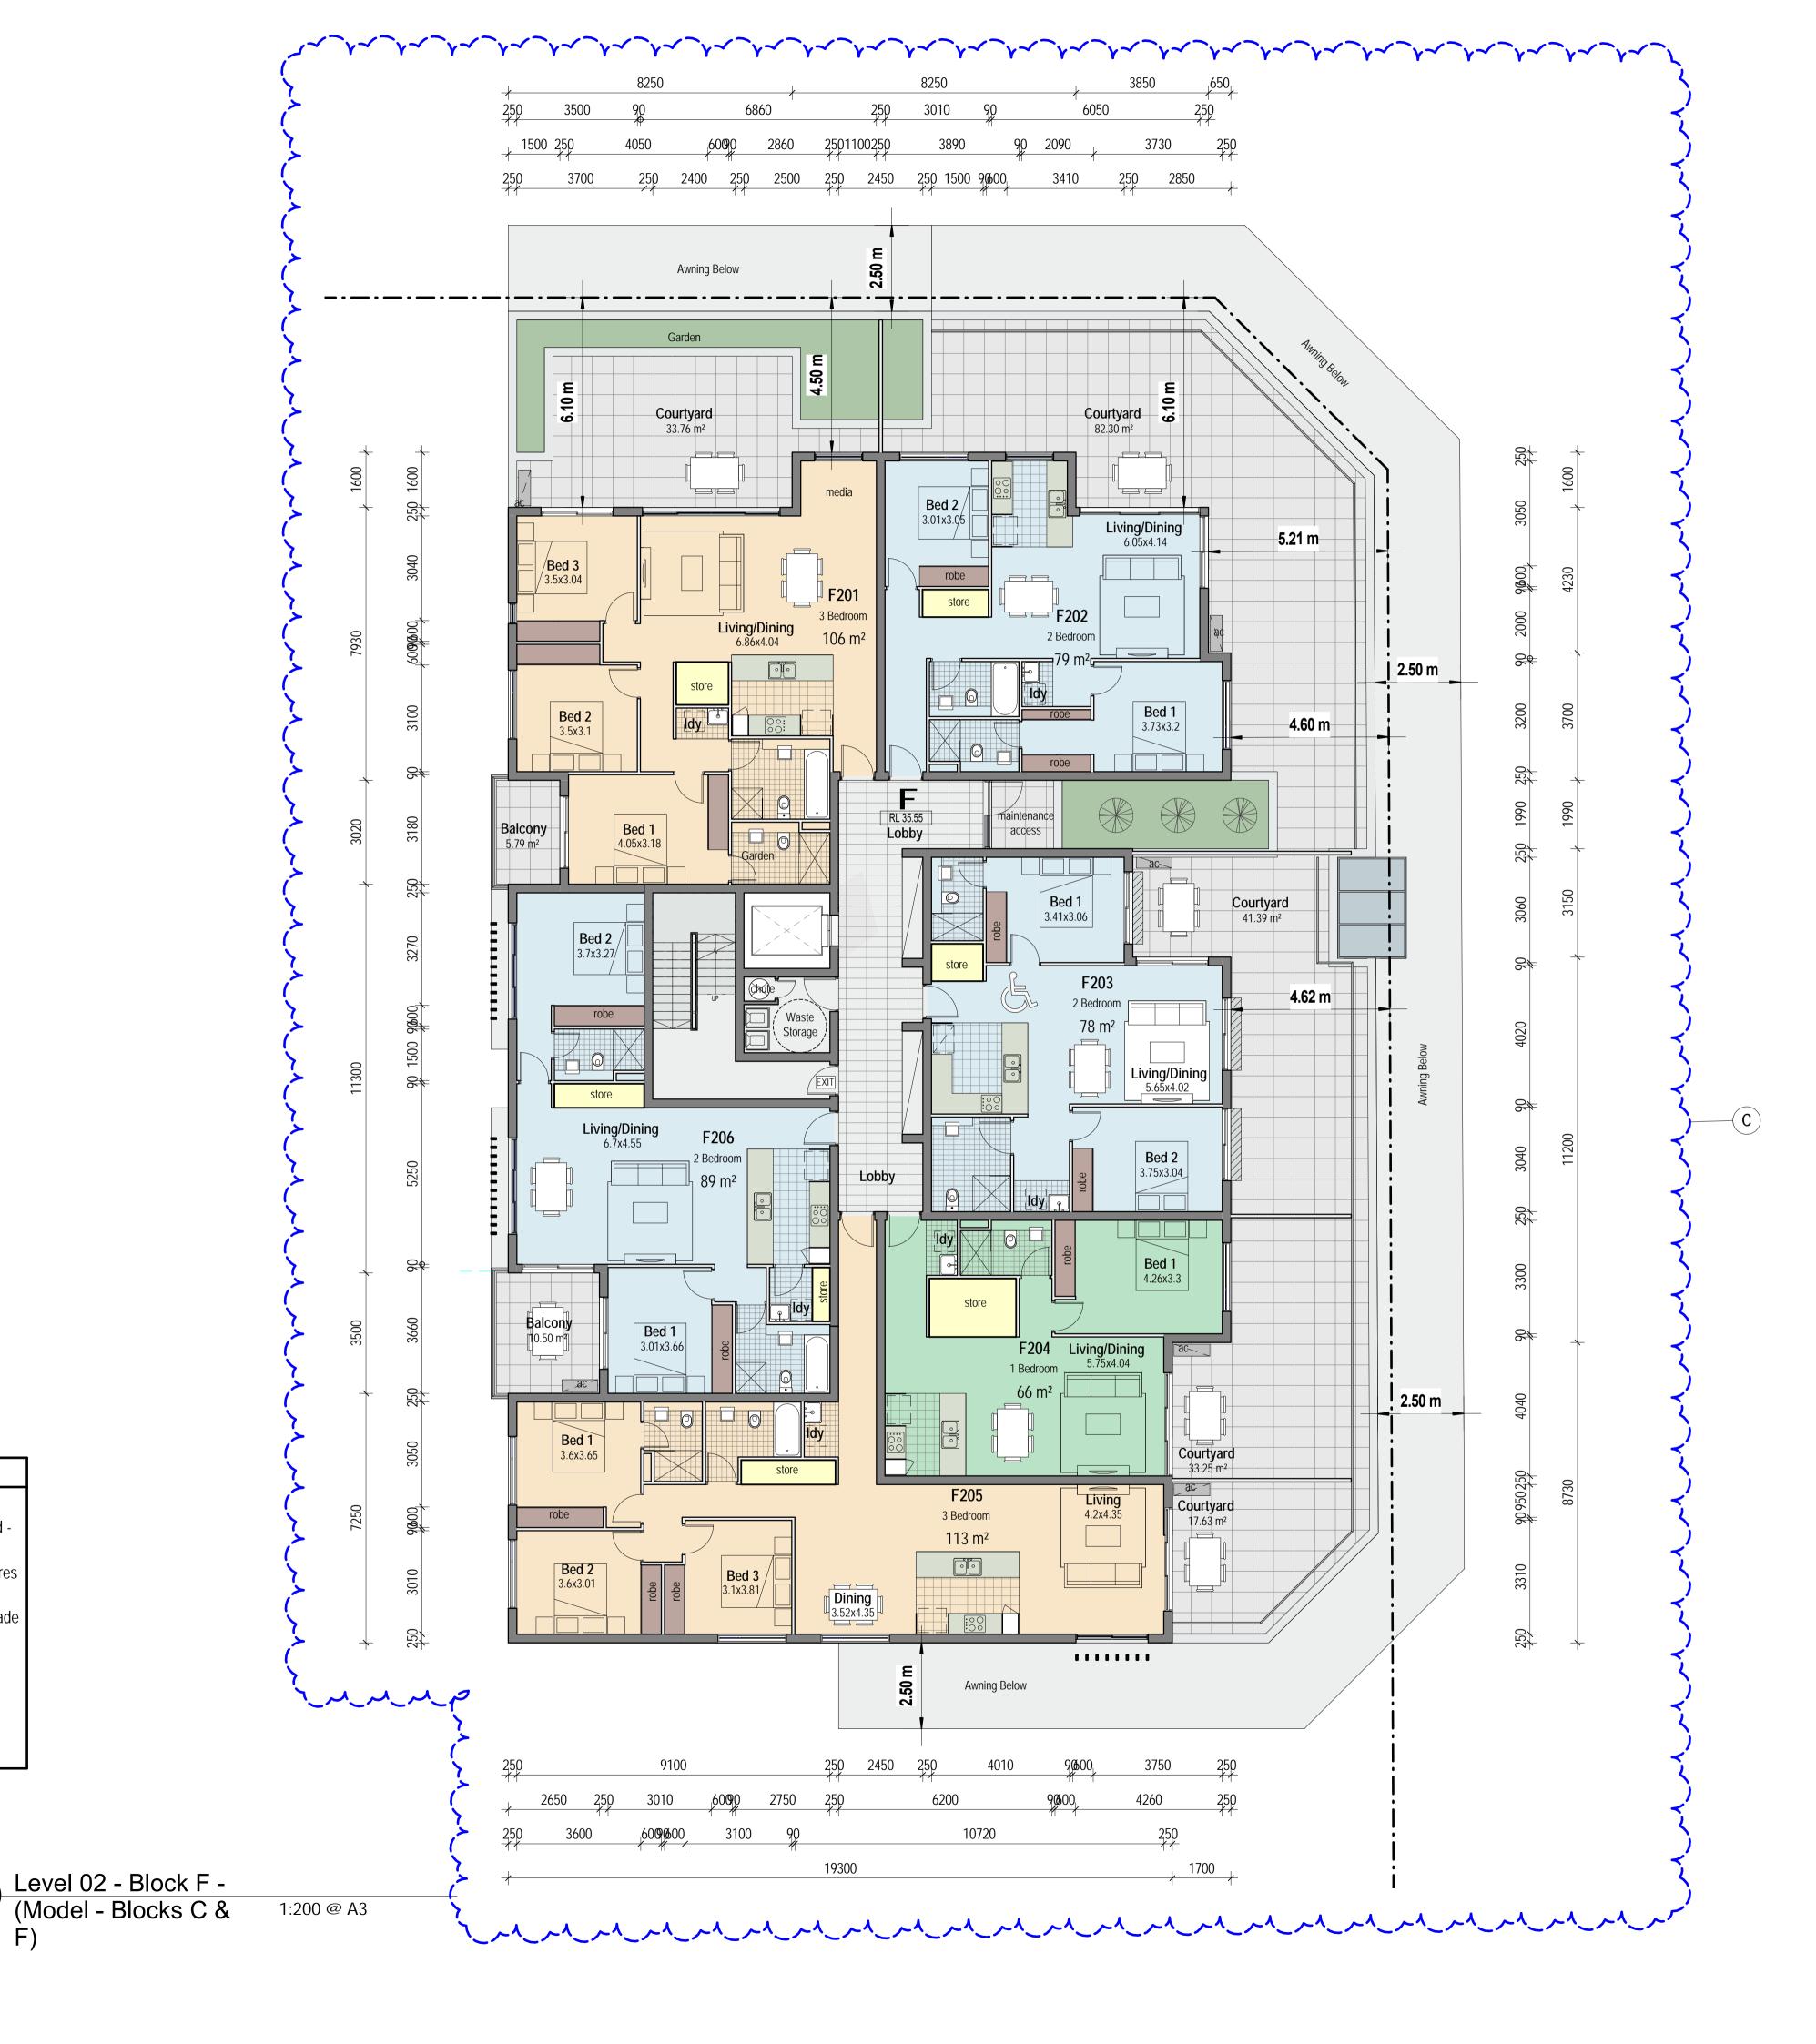


1. Lot 1 boundaries amended


- 2. Building below Setback 20m from Richmond Road courtyards amended
- 3. Setbacks to Southern boundary adjusted to 4 metres minimum
- 4. Unit F205 external wall amended on southern façade
- 5. Perspex roof provided over Child Care Centre
- Outdoor Play Area to address Acoustic Report.
- 6. Privacy Screens Added & noted
- 9. RLs amended to reflect revised Civil drawings at

1)

F)

- Ground Floor.
- 8. Additional dimensions shown.

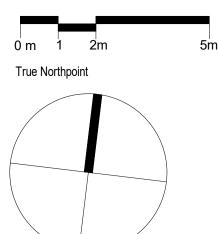

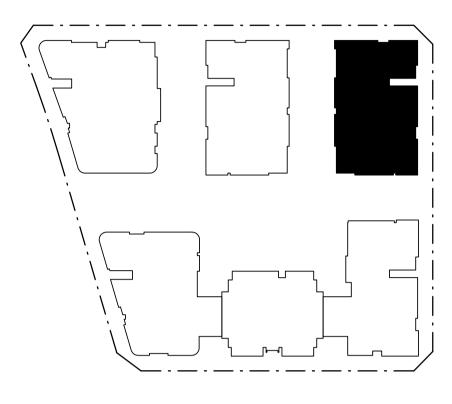



Issue	Issue descrption	Date
С	Amendments To Address SOFAC	15.07.21
В	New Road Location & Sizes Adopted, Waste Collection Areas Added, Units Added + General Amendments	08.07.20
A	Development Application	06.04.2020




NO	Project Proposed I	Vlixed Use De	velopment
<b>ICAT</b>	Project Addre 971 Richm	^{ss} ond Road, Ma	nrsden Park
EVELOPMENT APPLICATION	C & S Part	operty Pty Ltd ners Pty Ltd 02 - Bloc	
DEVELOP	Drawn A.S Job No 2435	Scale 1:200 @ A3 Drawing No. <b>37</b>	Checked Checker Issue




1. Lot 1 boundaries amended

- 2. Setbacks to Southern boundary adjusted to 4.0m
- minimum to building (3.5m to balconies and projections) 3. Building separation between Blocks D and E, and
- Blocks E and F, increased in width
- 4. Privacy Screens Added & noted
- 5. RLs amended to reflect revised Civil drawings at Ground Floor.
- 6. Additional dimensions shown.
- 7. Block F Unit F305/405 External wall amended on southern side

Level 03-04 - Block F (1) - (Model - Blocks C & F)

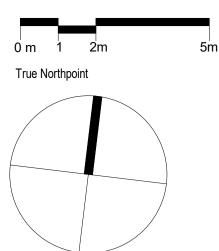

Do not scale, check and verify all dimensions before commencing new work, ground levels may vary due to site conditions.

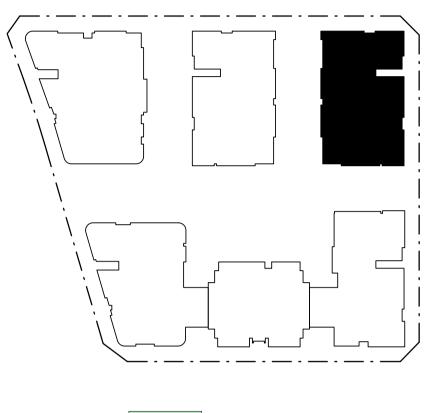



Issue	Issue descrption	Date
С	Amendments To Address SOFAC	15.07.21
В	New Road Location & Sizes Adopted, Waste Collection Areas Added, Units Added + General Amendments	08.07.20
A	Development Application	06.04.2020



	Project	Project			
NOI	Proposed Mixed Use Development				
	Project Addre	SS			
-ICA	971 Richm	ond Road, Mar	sden Park		
Ы	Client				
EVELOPMENT APPLICATION		iDream Property Pty Ltd and C & S Partners Pty Ltd			
ΙN	Title	Title			
		Level 03-04 - Block			
$\geq$					
D D	F				
Ш	Drawn	Scale	Checked		
	A.S	1:200 @ A3	Checker		
	Job No	Drawing No.	Issue		
	2435	38	C		

-**C** 

بر مر	·~ _Y ~~	~~~ _Y	·~~~~~~~~~~~~~~~~~~~~~~~~~~~~~~~~~~~~~
~			<del> </del> 250 350
Z			1500 250
			250 37 11
Ę			1
Ś			
5			6.10 m
~	+	+	
2	+ 1600	250 1600	
2		3040	Bed 3 3.5x3.0
2			
2	7930	000000	
5		3100	Bec 3.5x
Ś	*	64	
	3020	3180	Balcony 5.79 m ²
~	+	250	
		3270	
		000	
-	11300	90 1500 9600	
	$\leftarrow$		
		5250	
	+	84	
	3500	3660	Balcony
	+	250	
		3050	Bec 3.6x3
	7250	0000	robe
		3135	<b>Bec</b> 3.6x3
	+	<del>0</del>	
			250
			250 77 2650
•		_	250 360
-	ر ۲۰	۹ مر ۲۰	المر المر
Sector 1			

1. Lot 1 boundaries amended

2. Setbacks to Southern boundary adjusted to 4.0m minimum to building (3.5m to balconies and projections)

3. Privacy Screens Added & noted

4. RLs amended to reflect revised Civil drawings at Ground Floor.

5. Additional dimensions shown.

6. Building separation between Blocks D and E, and Blocks E and F, increased in width


7. Block F – the entire floor plates from Levels 5-8

replaced with the floor plates from Levels 3-4.


8. southern wall of Unit F505/605/705/805 amended.


) Level 05 - Block F -(Model - Blocks C & 1 F)



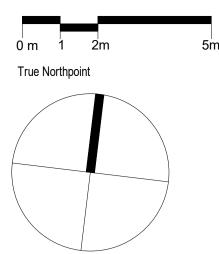

Do not scale, check and verify all dimensions before commencing new work, ground levels may vary due to site conditions.

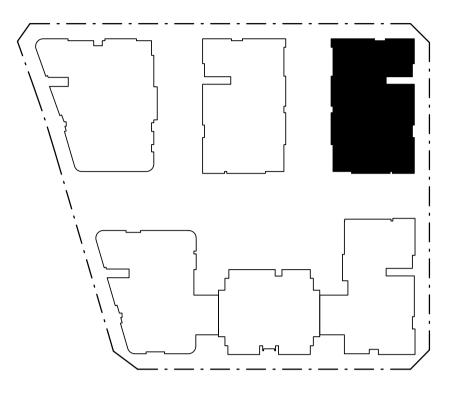

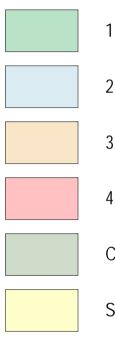

-(C)

1 Bedroom

2 Bedroom

3 Bedroom

4 Bedroom

Common Open Space

Storage

Issue	Issue descrption	Date
С	Amendments To Address SOFAC	15.07.21
В	New Road Location & Sizes Adopted, Waste Collection Areas Added, Units Added + General Amendments	08.07.20
А	Development Application	06.04.2020



Ryleton pty ltd t/as Architex 5888 abn 32 003 315 142 T : 02 9633 M : 0418 402 919 email@architex.com.au www.architex.com.au Level 3, 7K Parkes Street Parramatta NSW 2150 Nominated Architect: Robert Del Pizzo NSW Reg. No. 3972

Project

APPLICATION

DEVELOPMENT

Proposed Mixed Use Development

Project Address

971 Richmond Road, Marsden Park

Client

Title

iDream Property Pty Ltd and C & S Partners Pty Ltd

Level 05 - Block F

Drawn	Scale	Checked
A.S	1:200 @ A3	Checker
Job No	Drawing No.	Issue
2435	39	С





1. Lot 1 boundaries amended	
2. Setbacks to Southern boundary adjusted to 4.0m	
minimum to building (3.5m to balconies and	
projections)	
3. Building separation between Blocks D and E, and Blocks E and F, increased in width	
4. Block F – the entire floor plates from Levels 5-8	
replaced with the floor plates from Levels 3-4. 5. Privacy Screens Added & noted	
6. RLs amended to reflect revised Civil drawings at	
Ground Floor.	
7. Additional dimensions shown.	
8. southern wall of Unit F505/605/705/805 amended.	

1

F)

ISSUE C - AMENDMENTS - 15.07.21

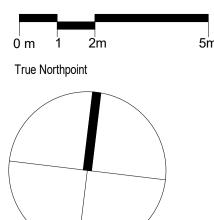

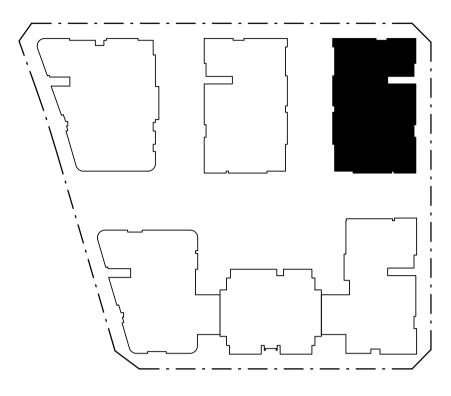




Issue	Issue descrption	Date
С	Amendments To Address SOFAC	15.07.21
В	New Road Location & Sizes Adopted, Waste Collection Areas Added, Units Added + General Amendments	08.07.20
А	Development Application	06.04.2020



	NSW R	eg. No. 3972					
		elopment					
		sden Park					
	Client iDream Property Pty Ltd and C & S Partners Pty Ltd						
Level ( F	)6-08 - B	lock					
Drawn A.S	Scale 1:200 @ A3	Checked Checker					
_{Јоб No} 2435	Drawing No.	Issue					
	Proposed M Project Addres 971 Richmo Client iDream Pro C & S Partr Title Level C F	Project         Project Address         971 Richmond Road, Mars         Client         iDream Property Pty Ltd a         C & S Partners Pty Ltd         Title         Level 06-08 - B         F         Drawn       Scale         A.S       1:200 @ A3         Job No       Drawing No.					


- 1. Roof Plan amended to follow changes in
- floor plans below
- 1. RLs amended to reflect revised Civil drawings at
- Ground Floor.
- 2. Additional dimensions shown.


1 Roof Level - Block F -(Model - Blocks C & 1:200 @ A3 F)

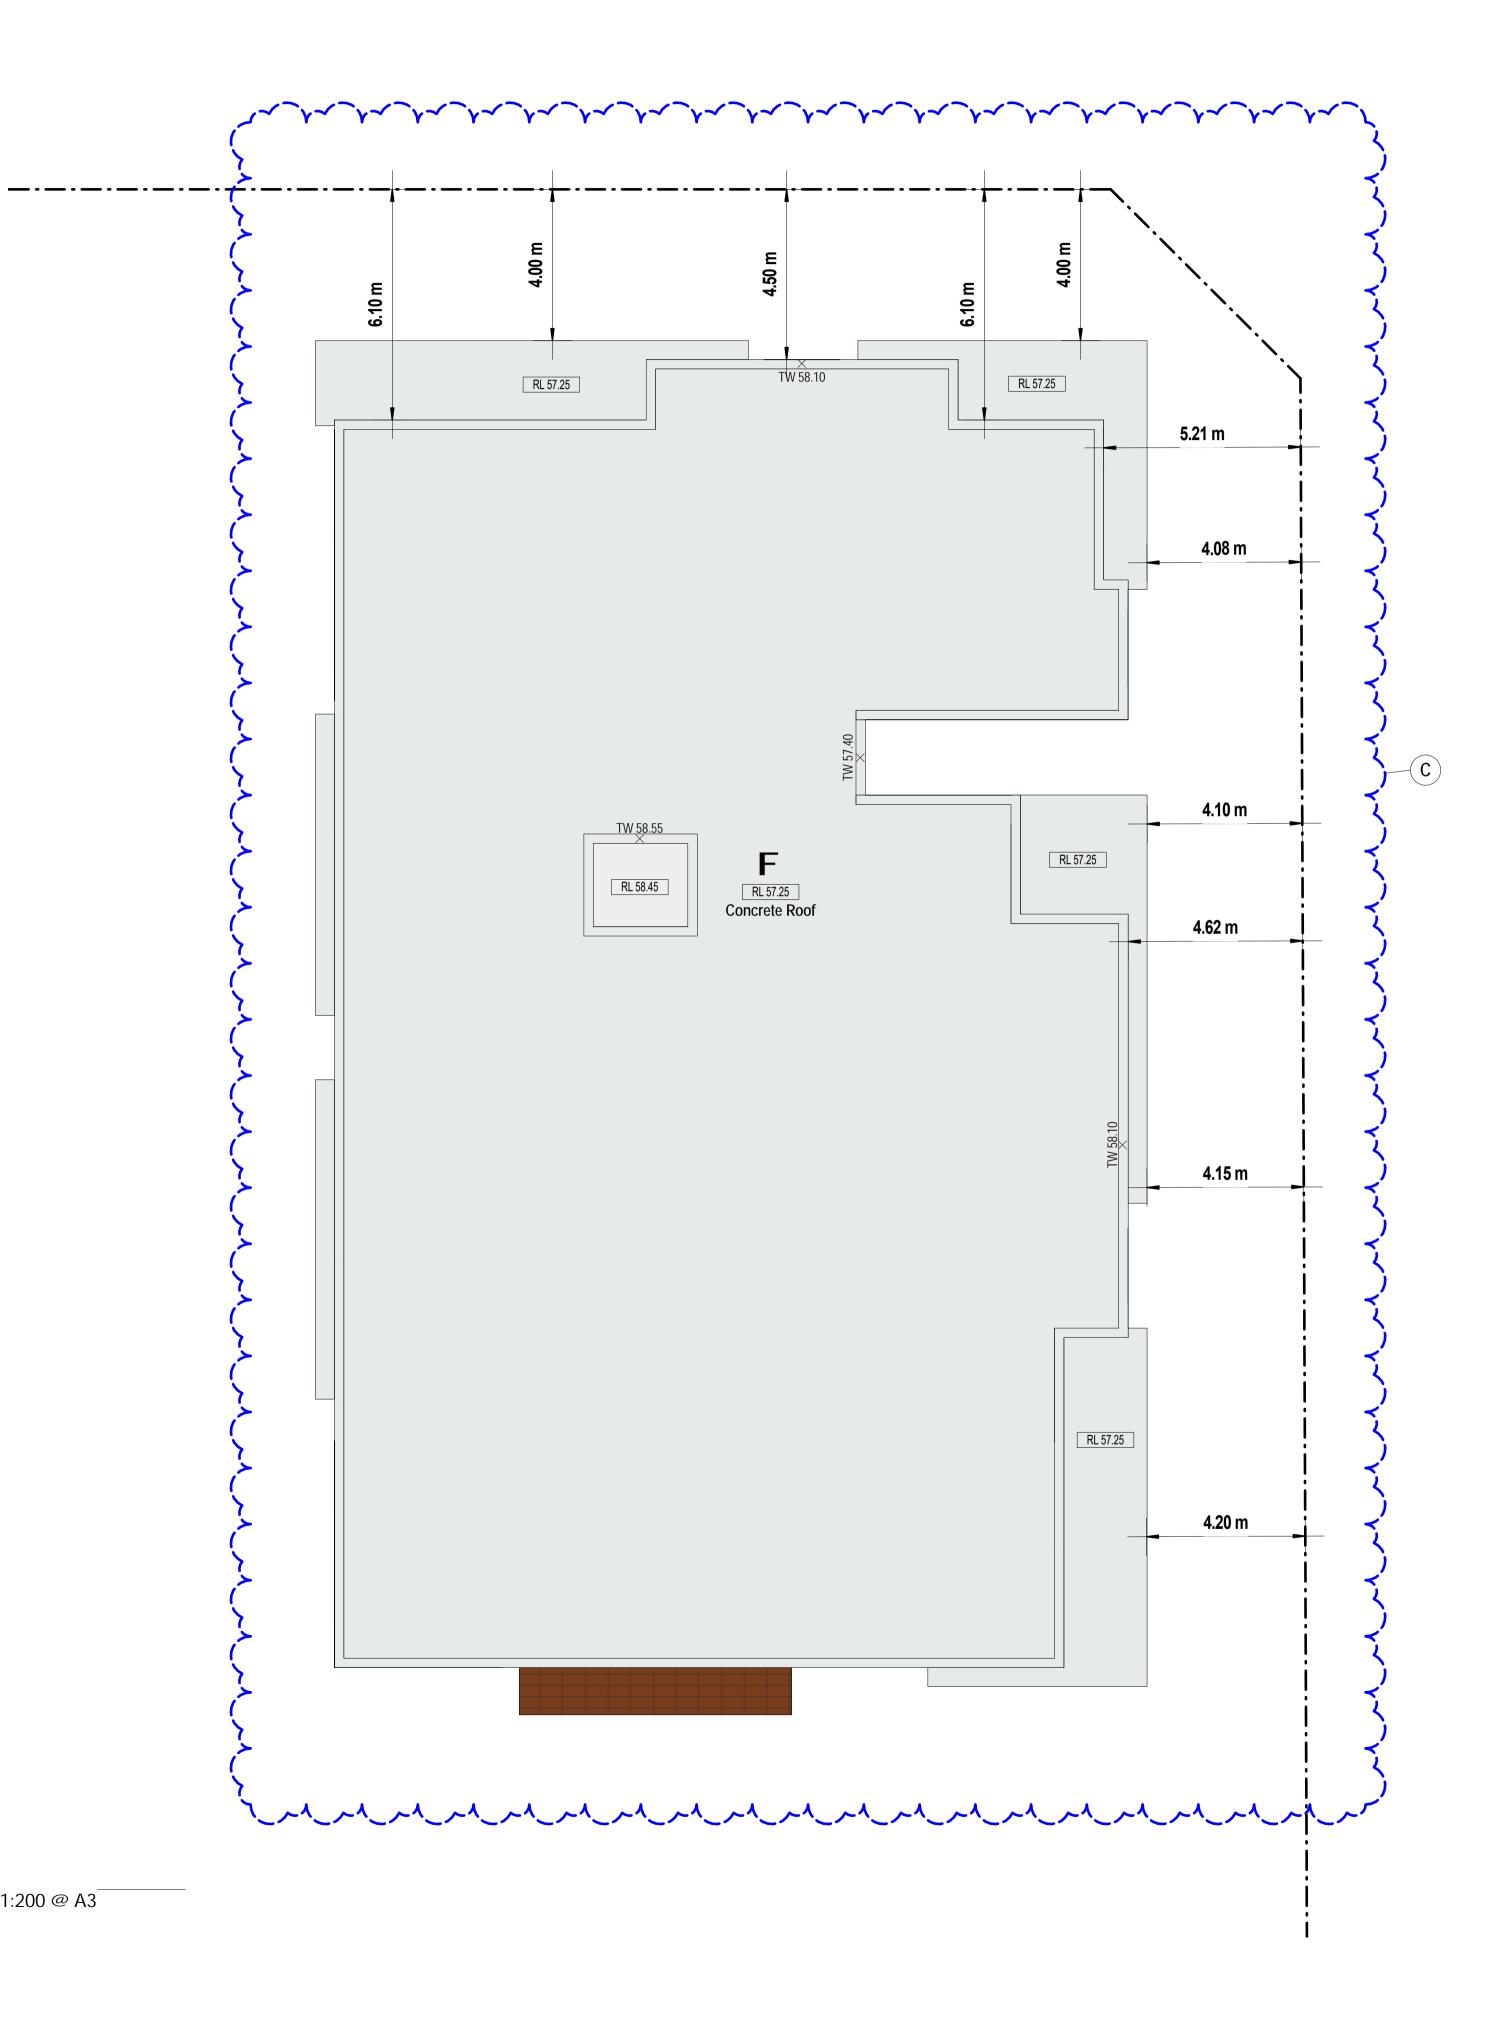

Ε

6.10

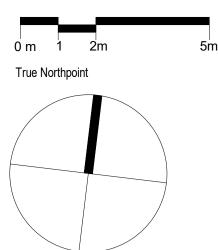

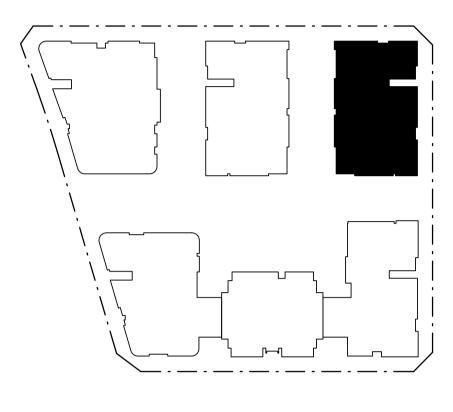


1 Bedroom
2 Bedroom
3 Bedroom
4 Bedroom
Common Open Space
Storage

Issue	Issue descrption	Date
С	Amendments To Address SOFAC	15.07.21
В	New Road Location & Sizes Adopted, Waste Collection Areas Added, Units Added + General Amendments	08.07.20
A	Development Application	06.04.2020




		NSW R	eg. No. 3972						
NOI	Project Proposed N	lixed Use Deve	elopment						
H	Project Addres	s							
ICA	971 Richmo	ond Road, Mars	sden Park						
	Client								
API		iDream Property Pty Ltd and C & S Partners Pty Ltd							
	Title								
DEVELOPMENT APPLICATION	Roof Level - Block F								
ш	Drawn	Scale	Checked						
$\geq$	A.S	1:200 @ A3	Checker						
Ш	Job No	Drawing No.	Issue						
	2435	41	C						

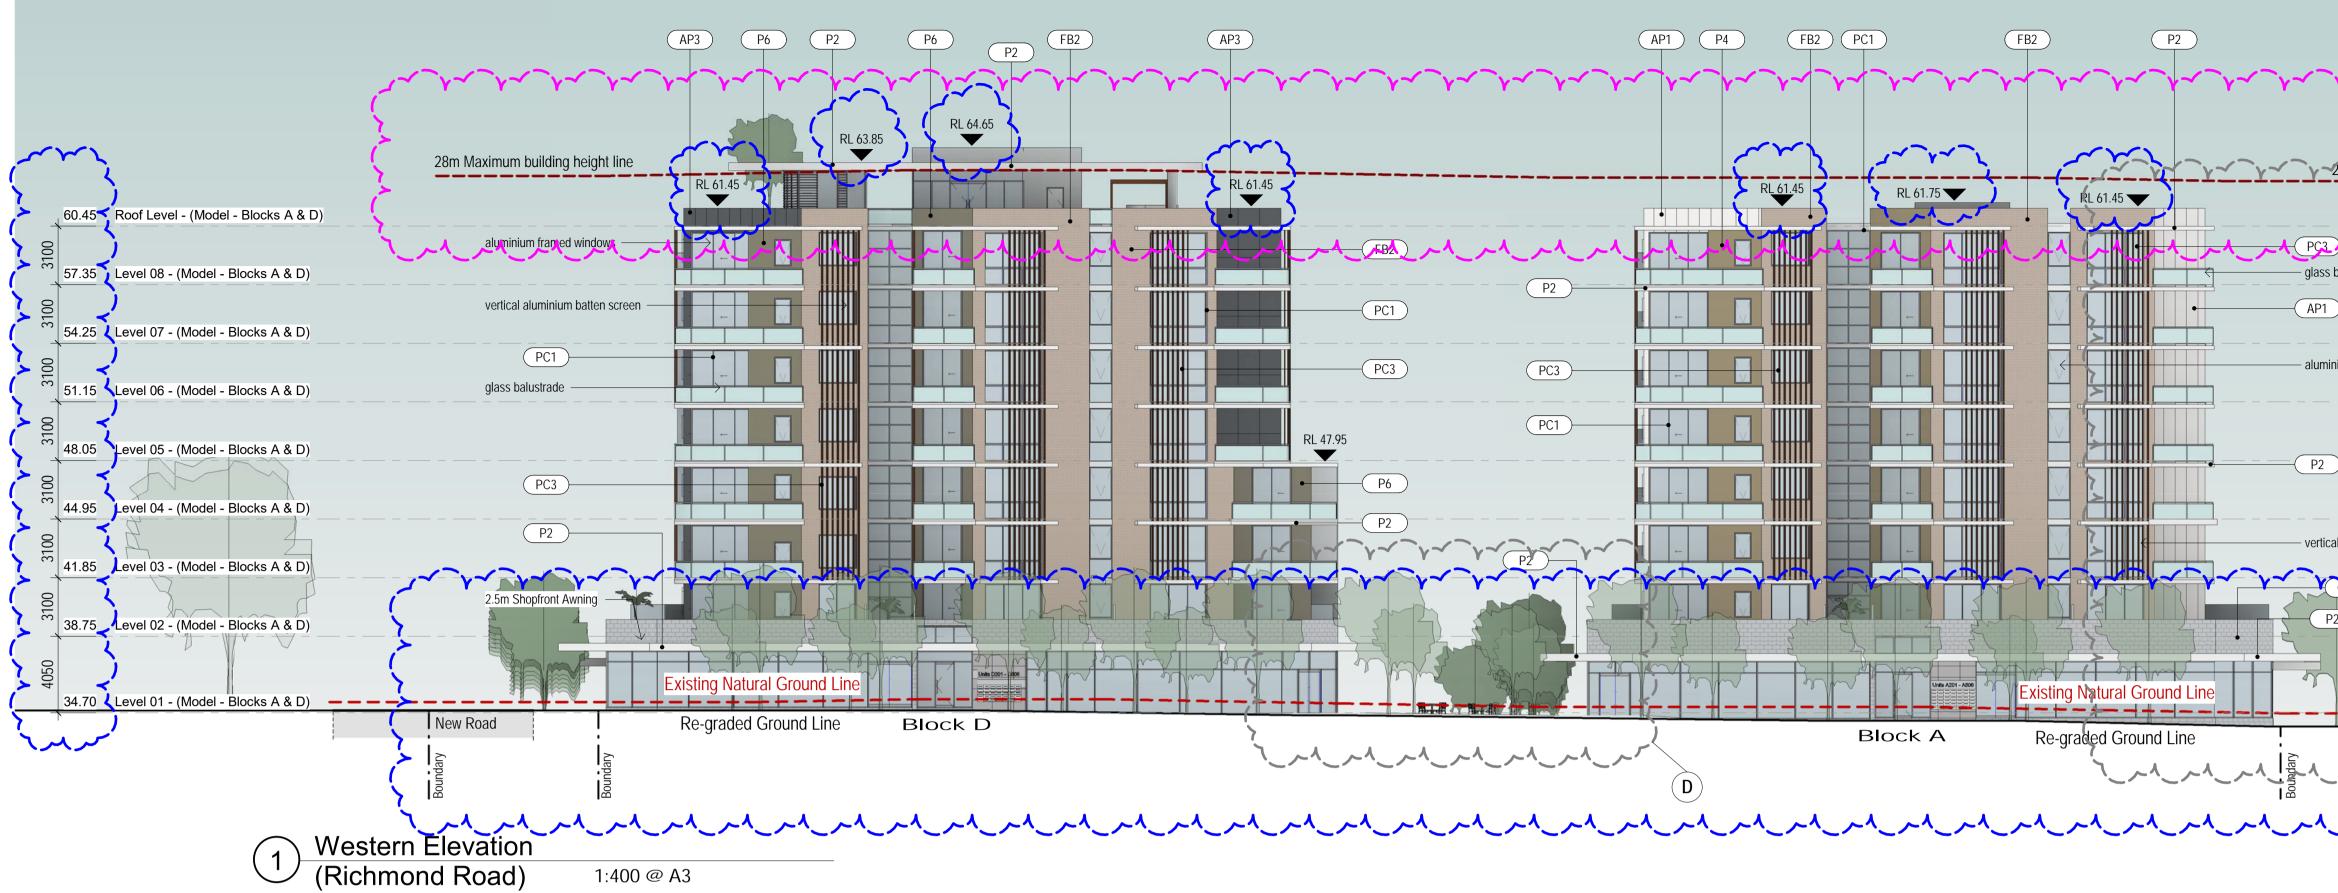



# MATERIAL SCHEDULE LEGEND


EXTERNAL	FINISHE	S SCHEDULE									 
	P1	PAINT FINISH 1 Dulux Endless Dusk	P4	PAINT FINISH 4 Dulux Knapsack	AP1	SOLID ALUMINIUM PANEL 1 Mondoclad Pure White	CB1	CONCRETE BLOCK Boral Designer Block - Midway Honed Finish	PC1	WINDOW FRAMES, BALUSTRADES, BATTENS Dulux Powdercoat Apo Grey	PC4
	P2	PAINT FINISH 2 Dulux Lexicon Half	P5	PAINT FINISH 5 Dulux Sea Squash	AP2	SOLID ALUMINIUM PANEL 2 Mondoclad Halo	FB1	FACEBRICK Austral - LA Paloma - Azul	PC2	FEATURE WALL Dulux Powdercoat Steel Pearl Satin	PC5
	P3	PAINT FINISH 3 Dulux Grid	P6	PAINT FINISH 6 Dulux Bare	AP3	SOLID ALUMINIUM PANEL 3 Mondoclad Dark Grey Metallic	FB2	FACEBRICK Austral - Ultra Smooth - Chill	PC3	BATTEN SCREENS, FEATURE WALLS Deco Batten/Deco Panel - Chestnut	PC6

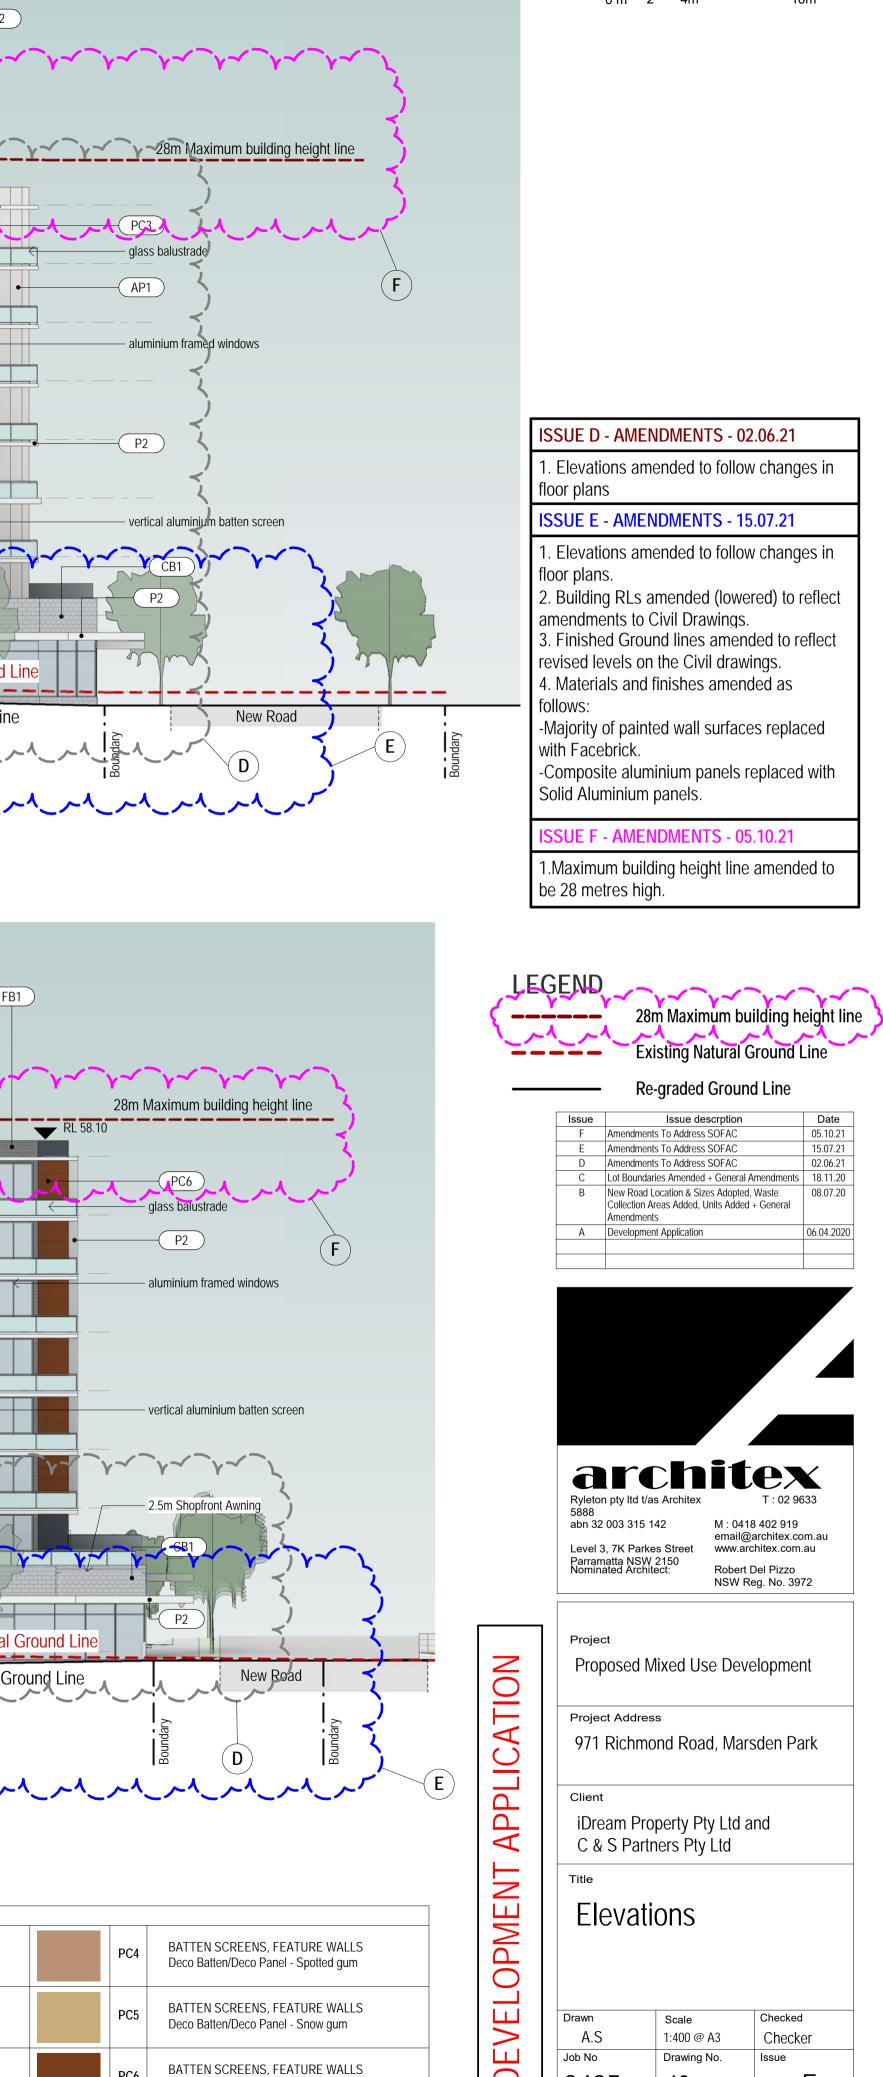


Deco Batten/Deco Panel - Ironbark

2435


42

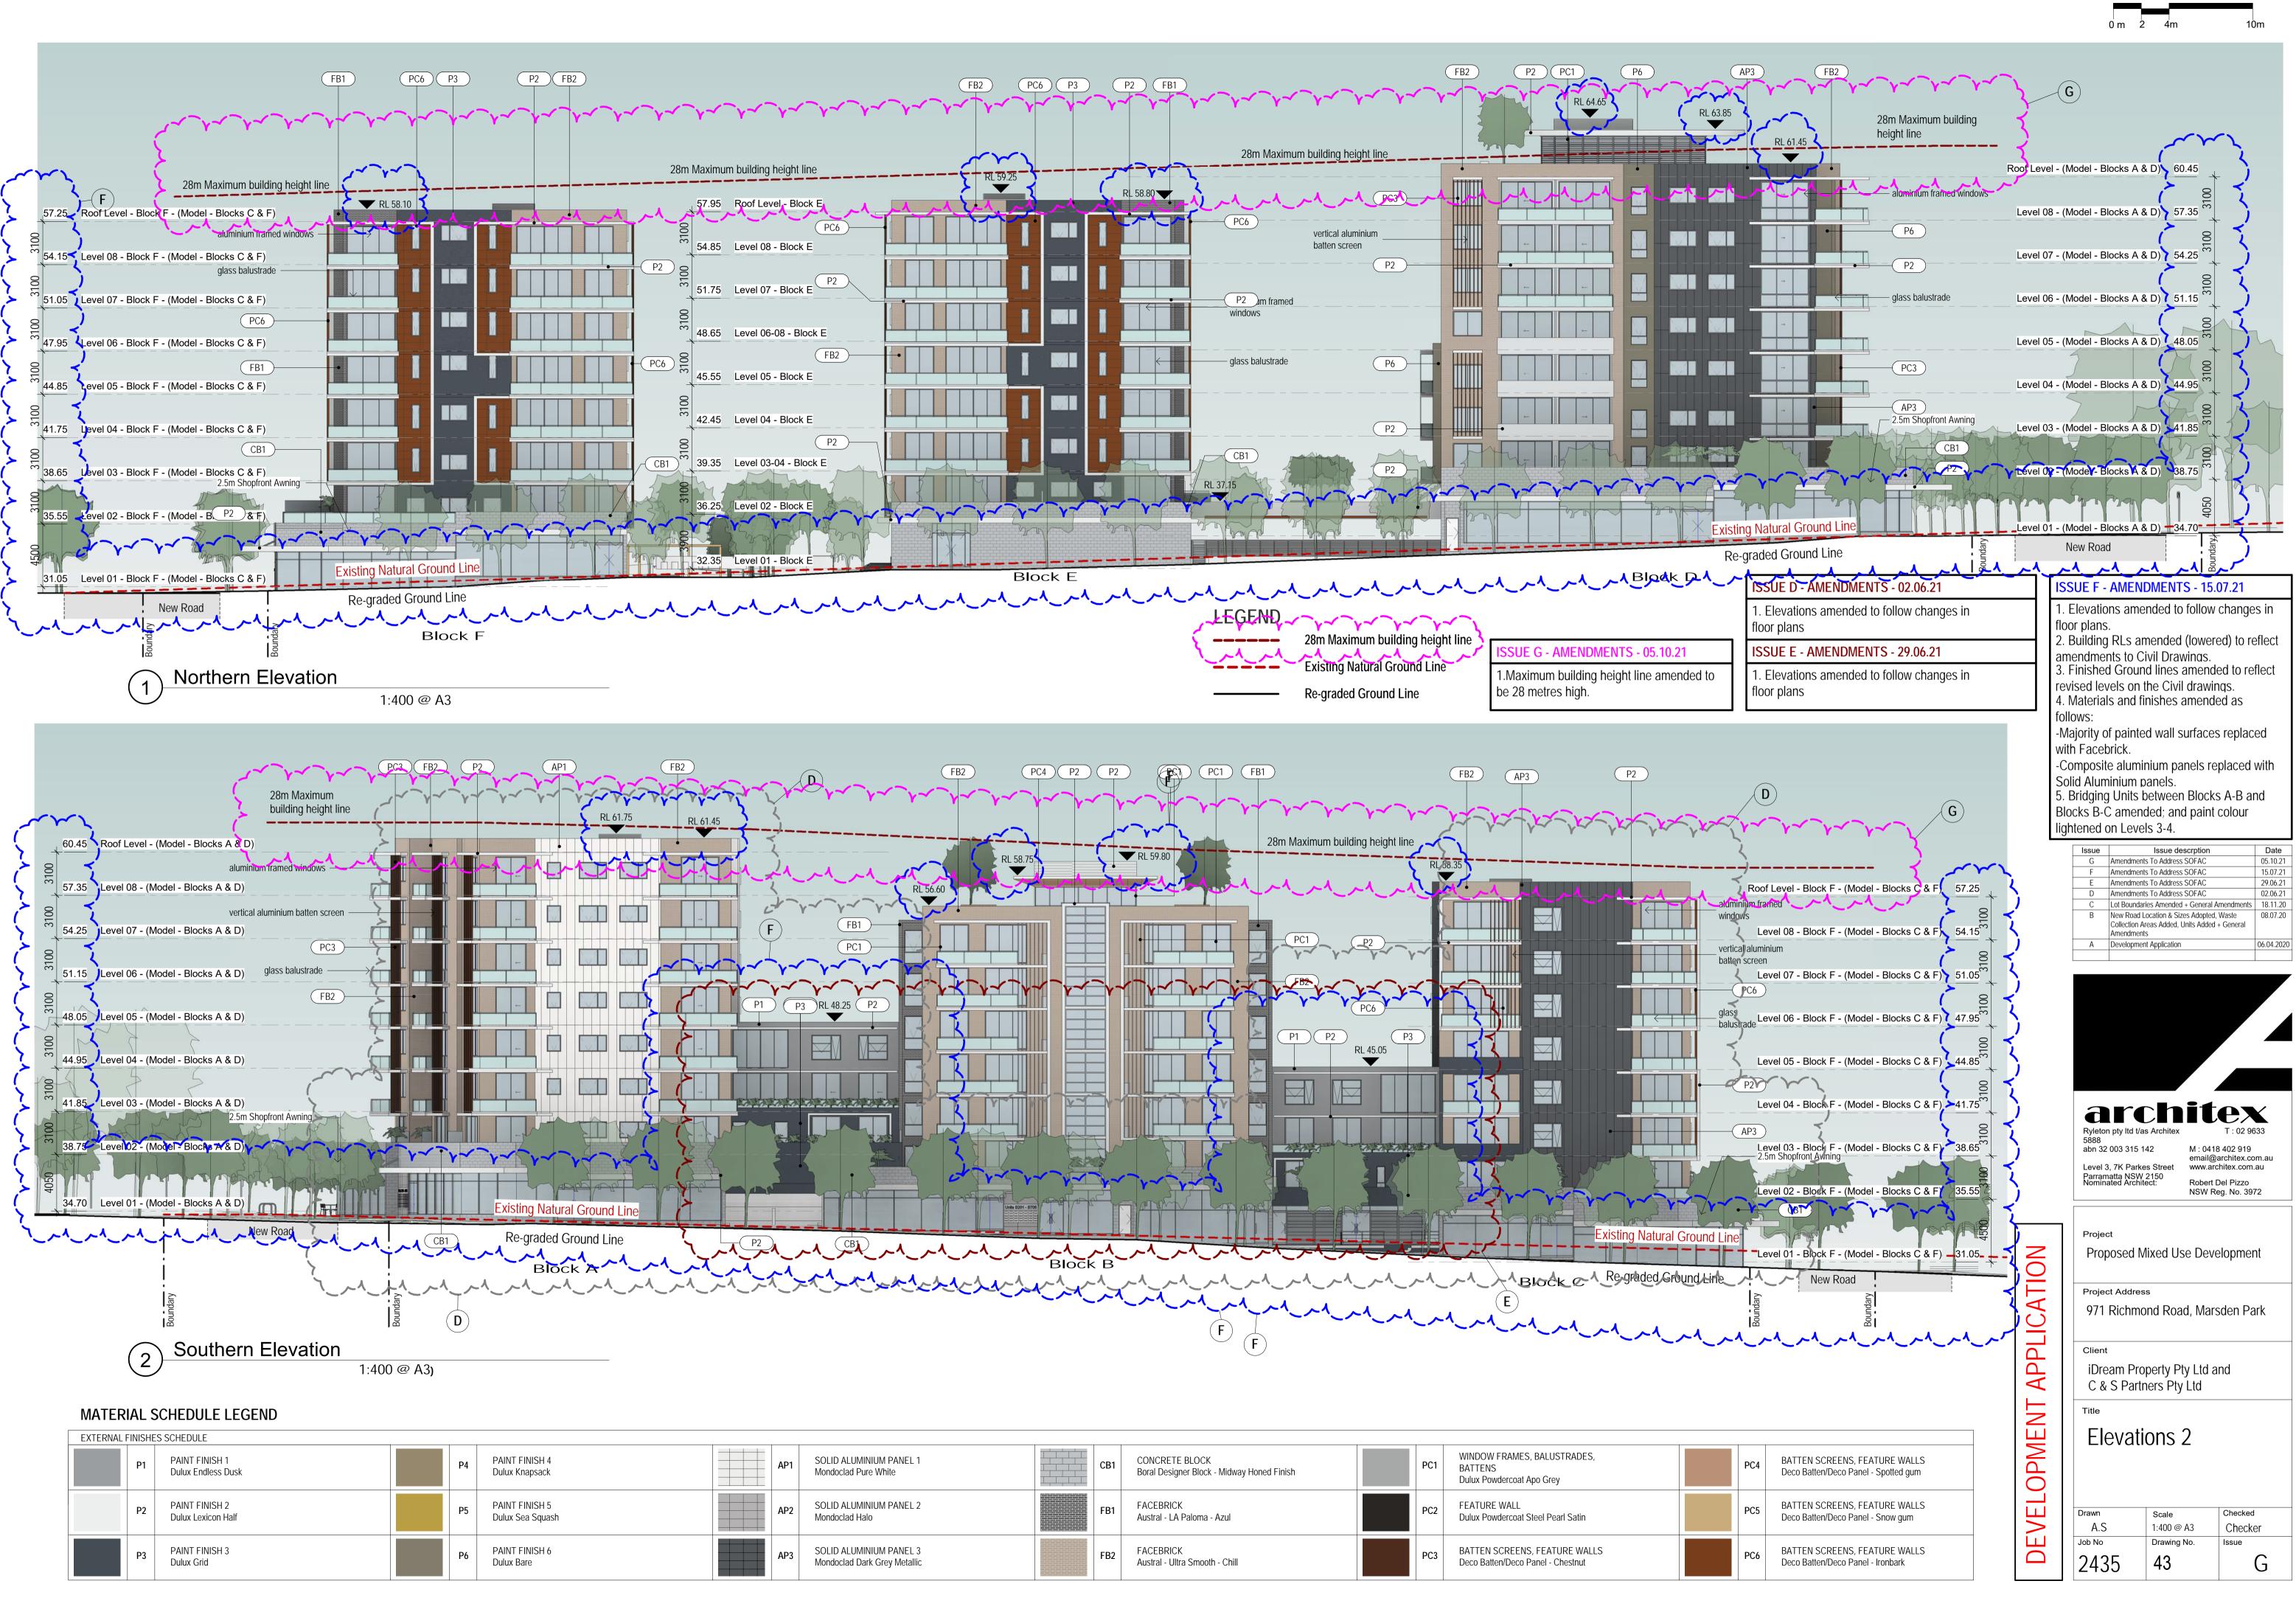


EXTERNAL FIN	ISHES	SCHEDULE				-						 			
	P1	PAINT FINISH 1 Dulux Endless Dusk	Р	24	PAINT FINISH 4 Dulux Knapsack		AP1	SOLID ALUMINIUM PANEL 1 Mondoclad Pure White	с 	CB1	CONCRETE BLOCK Boral Designer Block - Midway Honed Finish	PC1	WINDOW FRAMES, BALUSTRADES, BATTENS Dulux Powdercoat Apo Grey	PC4	
	P2	PAINT FINISH 2 Dulux Lexicon Half	Ρ	'5	PAINT FINISH 5 Dulux Sea Squash		AP2	SOLID ALUMINIUM PANEL 2 Mondoclad Halo	F	FB1	FACEBRICK Austral - LA Paloma - Azul	PC2	FEATURE WALL Dulux Powdercoat Steel Pearl Satin	PC5	
	P3	PAINT FINISH 3 Dulux Grid	Р	6	PAINT FINISH 6 Dulux Bare		AP3	SOLID ALUMINIUM PANEL 3 Mondoclad Dark Grey Metallic	F	FB2	FACEBRICK Austral - Ultra Smooth - Chill	PC3	BATTEN SCREENS, FEATURE WALLS Deco Batten/Deco Panel - Chestnut	PC6	,

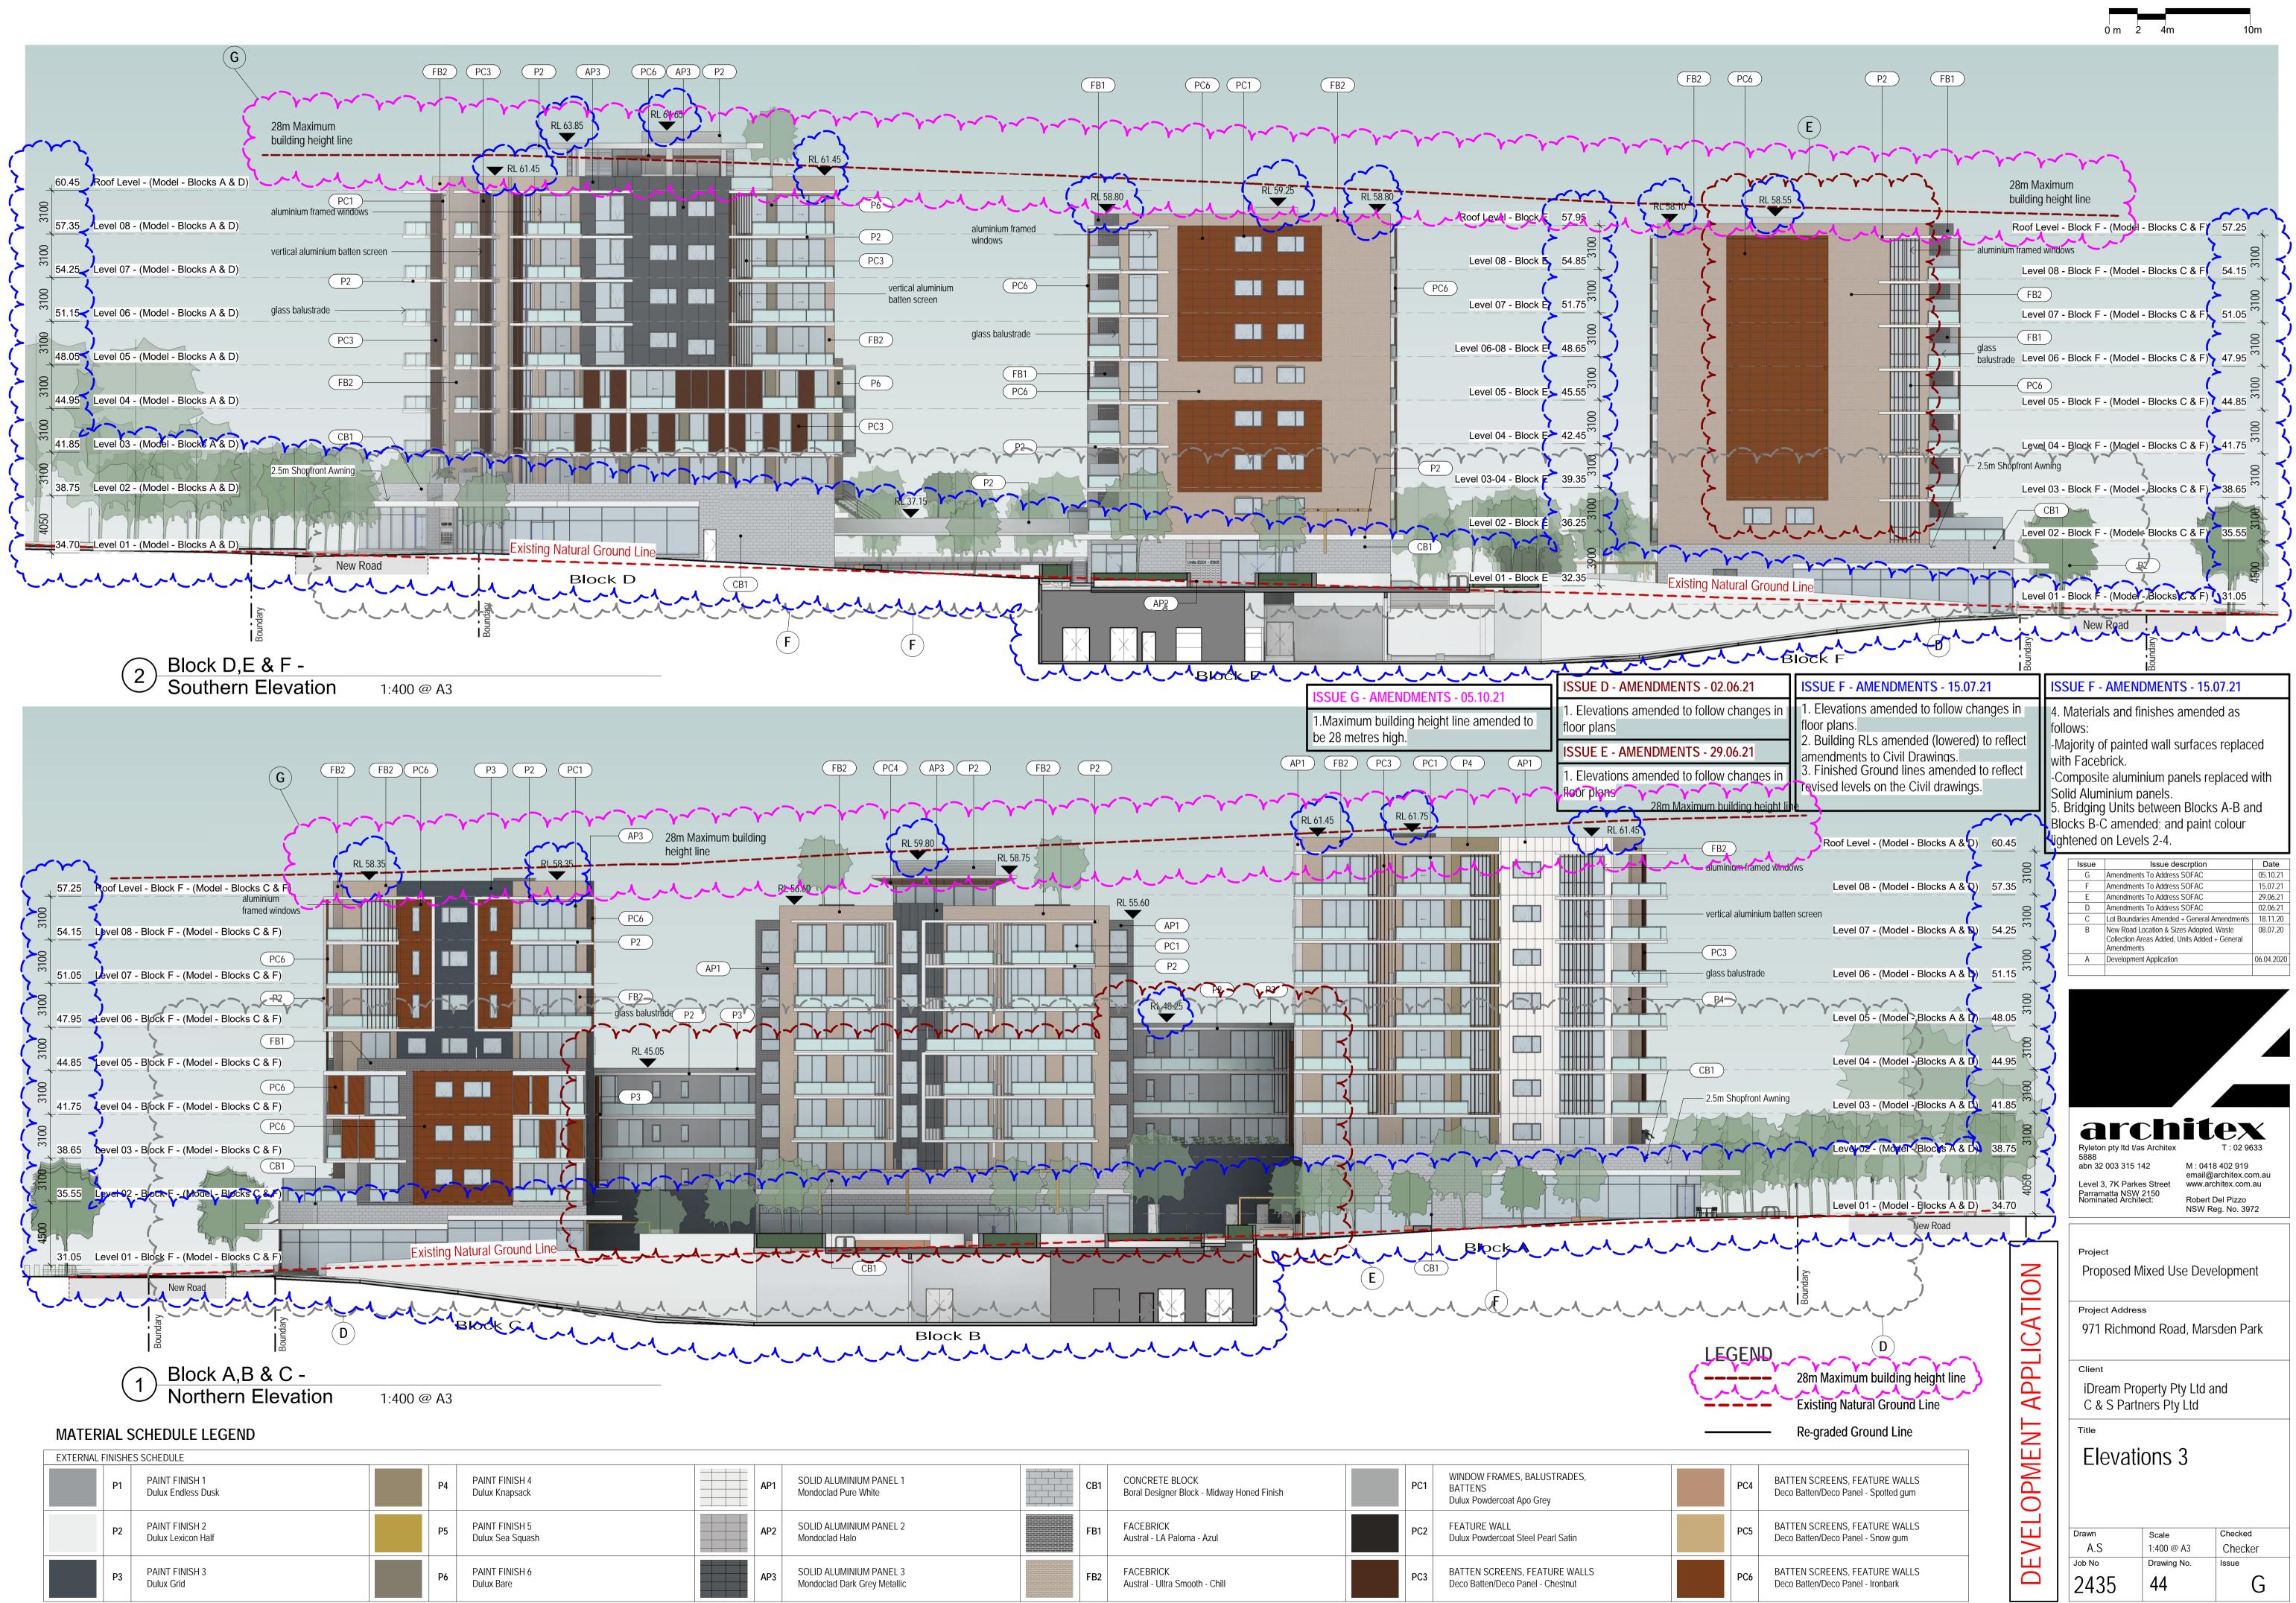





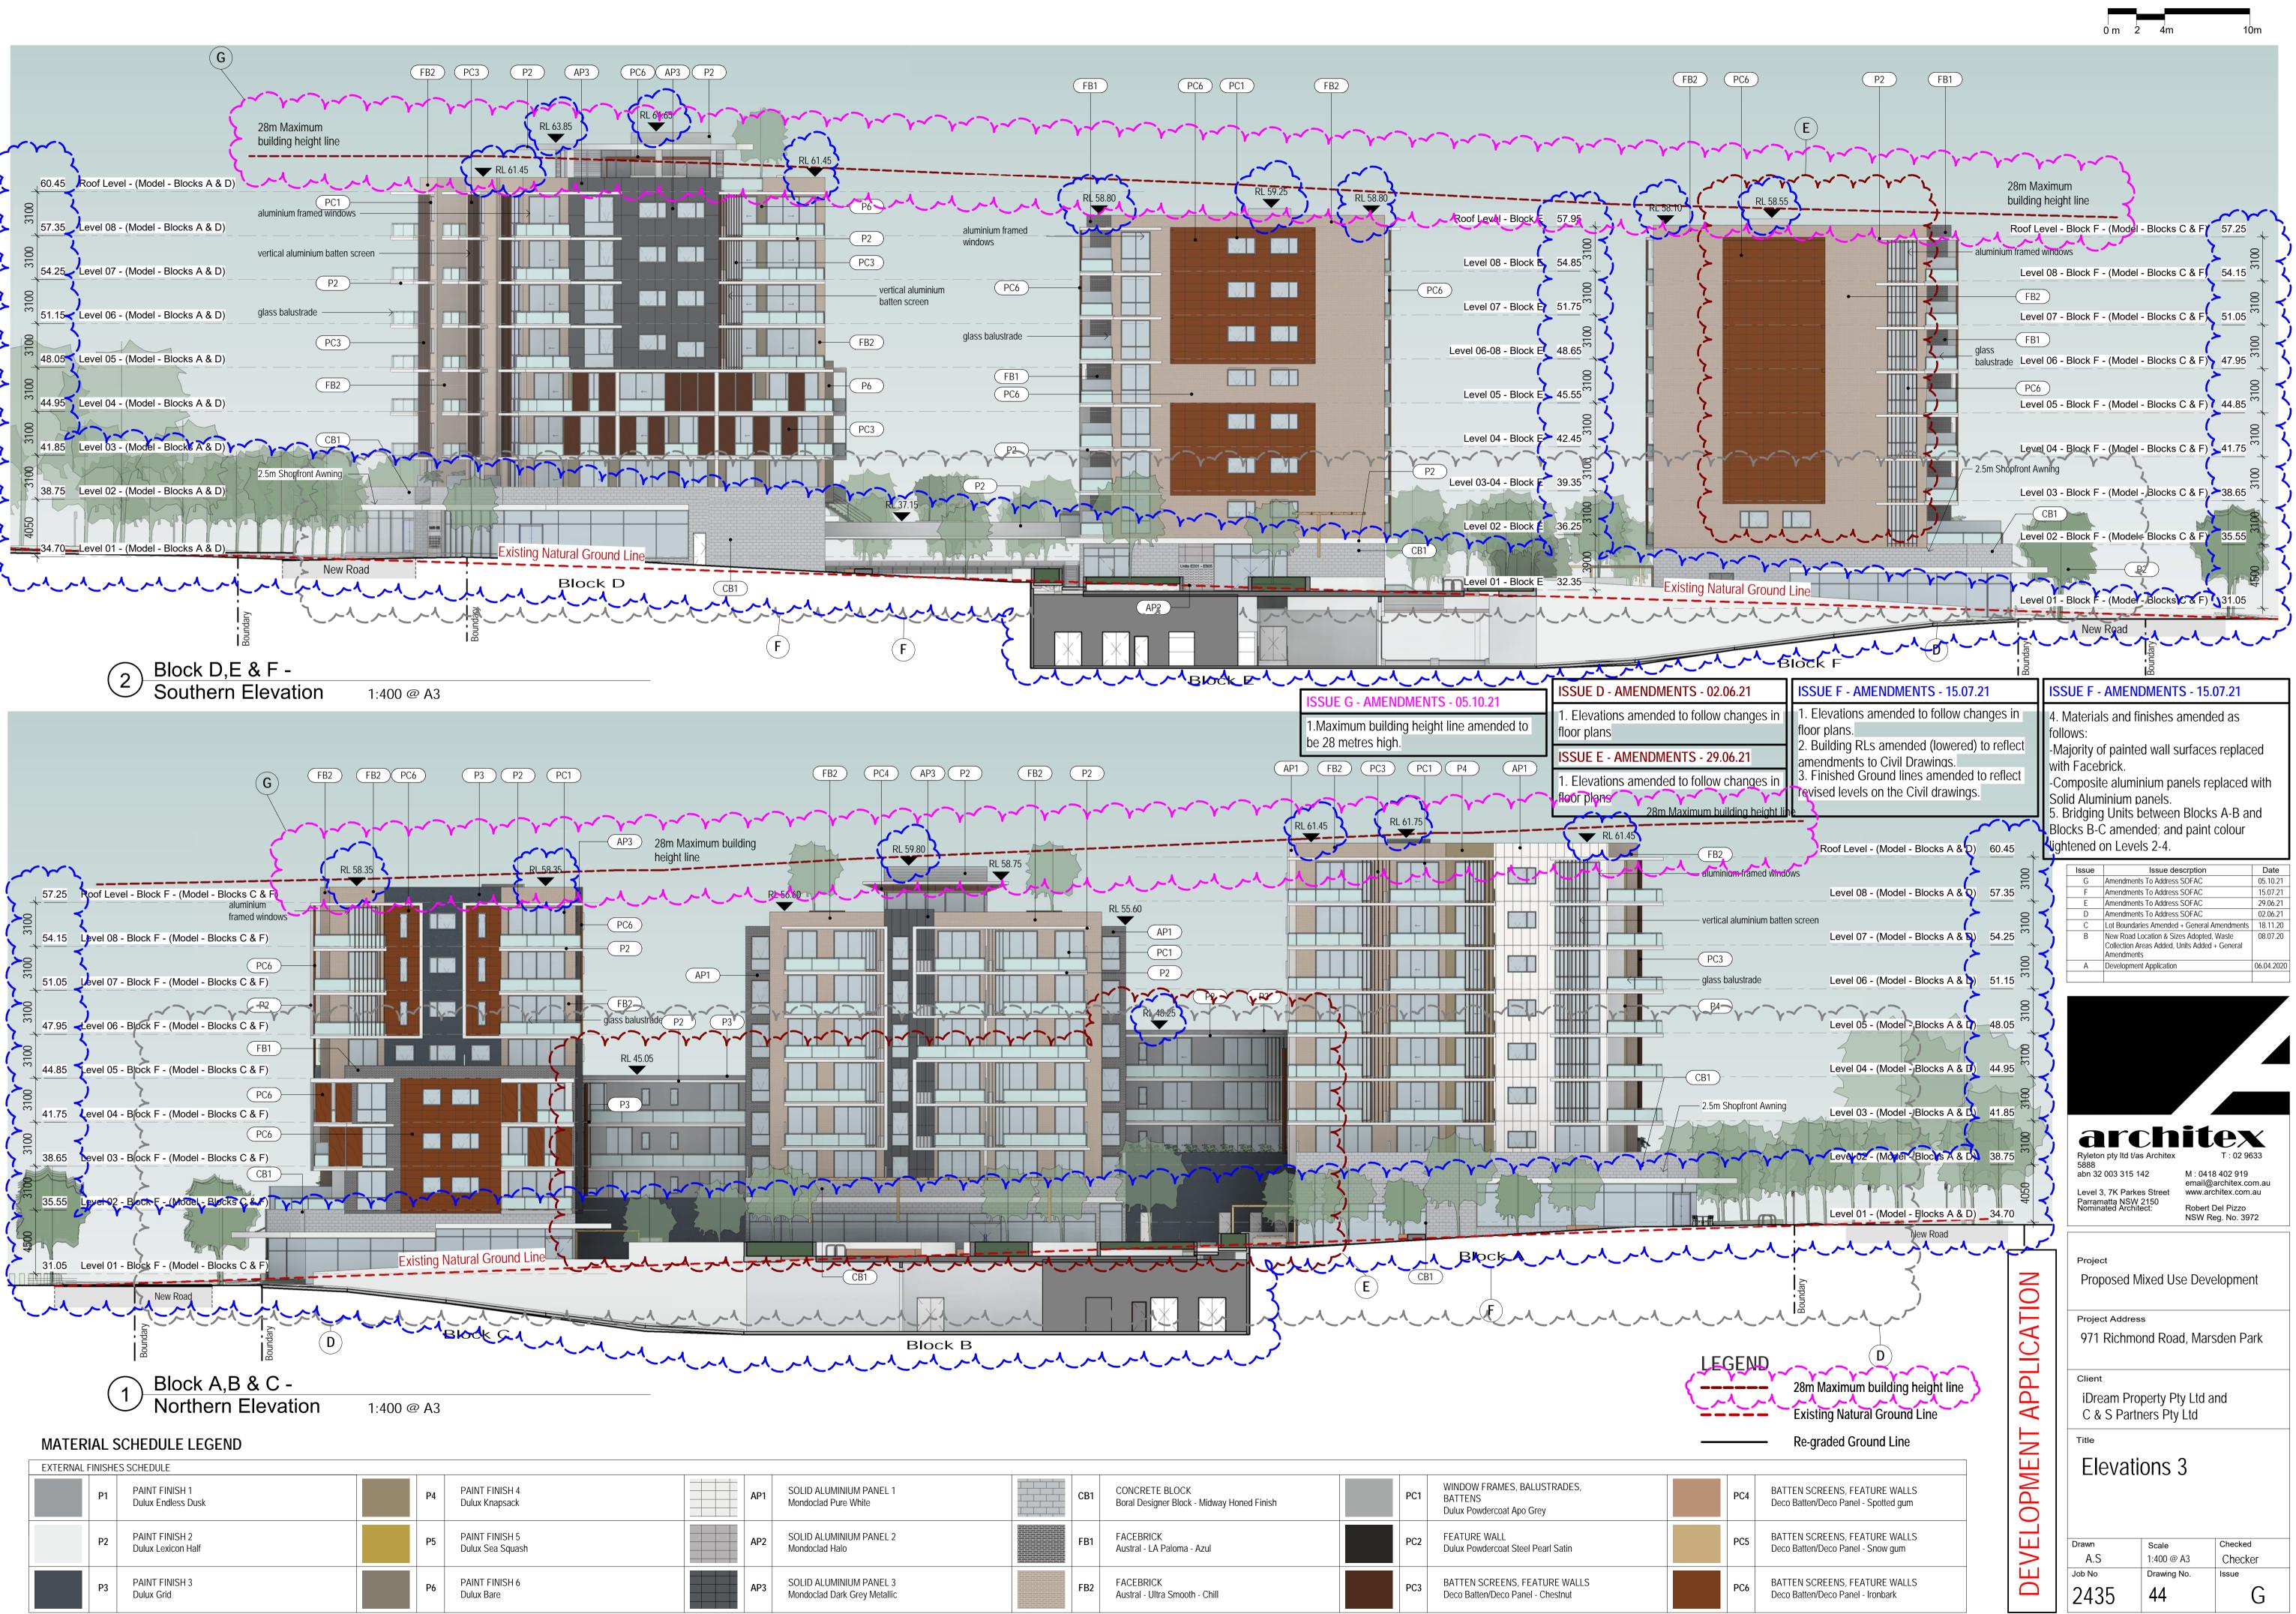

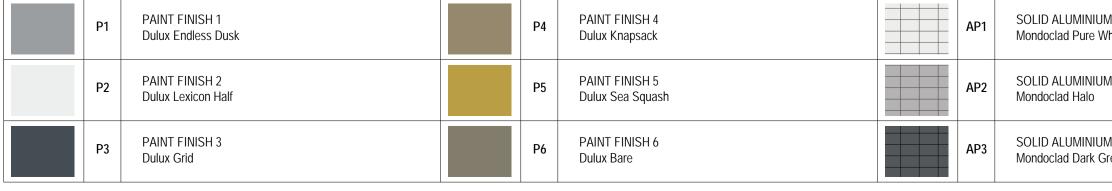

JM PANEL 1 White	CB1	CONCRETE BLOCK Boral Designer Block - Midway Honed Finish	PC1	WINDOW FRAMES, BALUSTRADES, BATTENS Dulux Powdercoat Apo Grey	PC4
JM PANEL 2	FB1	FACEBRICK Austral - LA Paloma - Azul	PC2	FEATURE WALL Dulux Powdercoat Steel Pearl Satin	PC5
JM PANEL 3 Grey Metallic	FB2	FACEBRICK Austral - Ultra Smooth - Chill	PC3	BATTEN SCREENS, FEATURE WALLS Deco Batten/Deco Panel - Chestnut	PC6

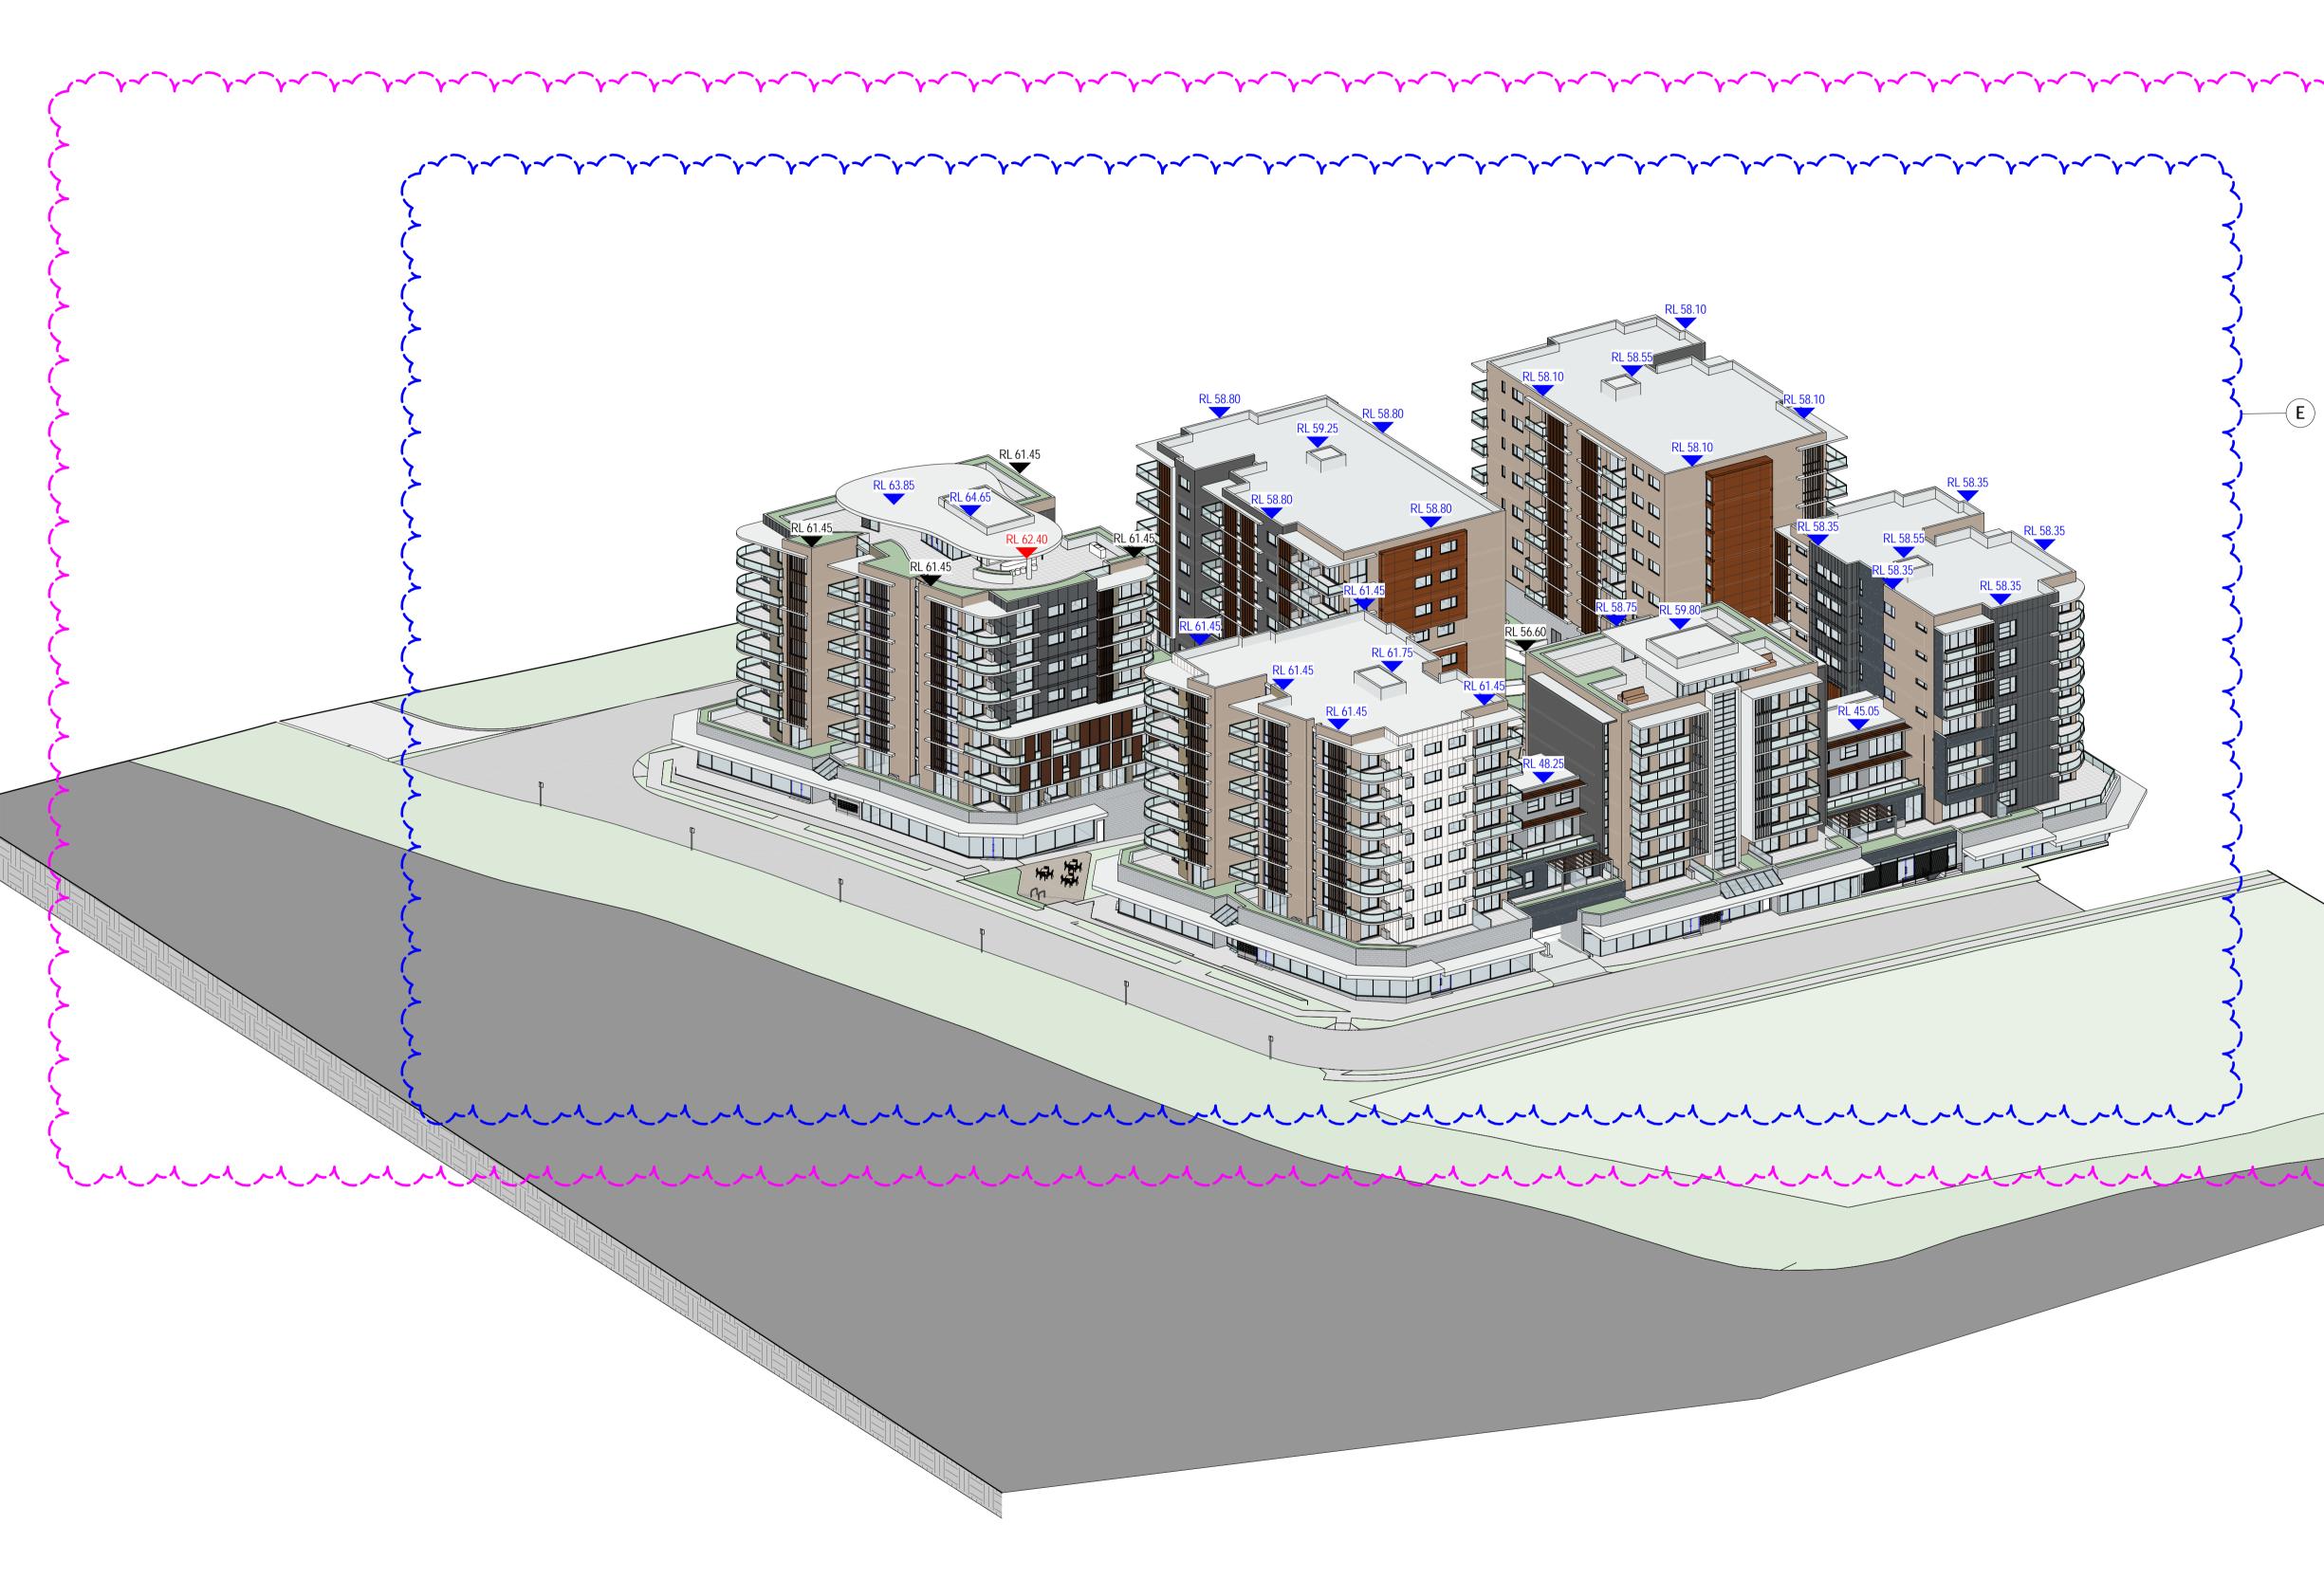

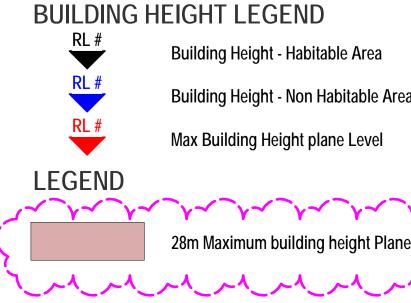

ISSUE D - AMENDMENTS - 02.06.21
1. 3D Height Plane amended to follow changes in floor plans below
ISSUE E - AMENDMENTS - 15.07.21
<ol> <li>Building Levels adjusted to reflect revised RLs on the Civil and Architectural Drawings.</li> <li>Top of Building RLs added above height plane to show extent of breaches.</li> </ol>

SSUE F - AMENDMENTS - 05.10.21

 $(\mathbf{F})$ 

1.Maximum building height line amended to be 28 metres high.

Issue	Issue descrption	Date
F	Amendments To Address SOFAC	05.10.21
E	Amendments To Address SOFAC	15.07.21
D	Amendments To Address SOFAC	02.06.21
С	New Road Location & Sizes Adopted, Waste Collection Areas Added, Units Added + General Amendments	08.07.20
В	Waste Collection bays added, Units added + General Amendments	02.04.20
A	Development Application	06.04.2020



Job No

2435


Drawing No.


45


Issue


Г


28m Maximum building height Plane

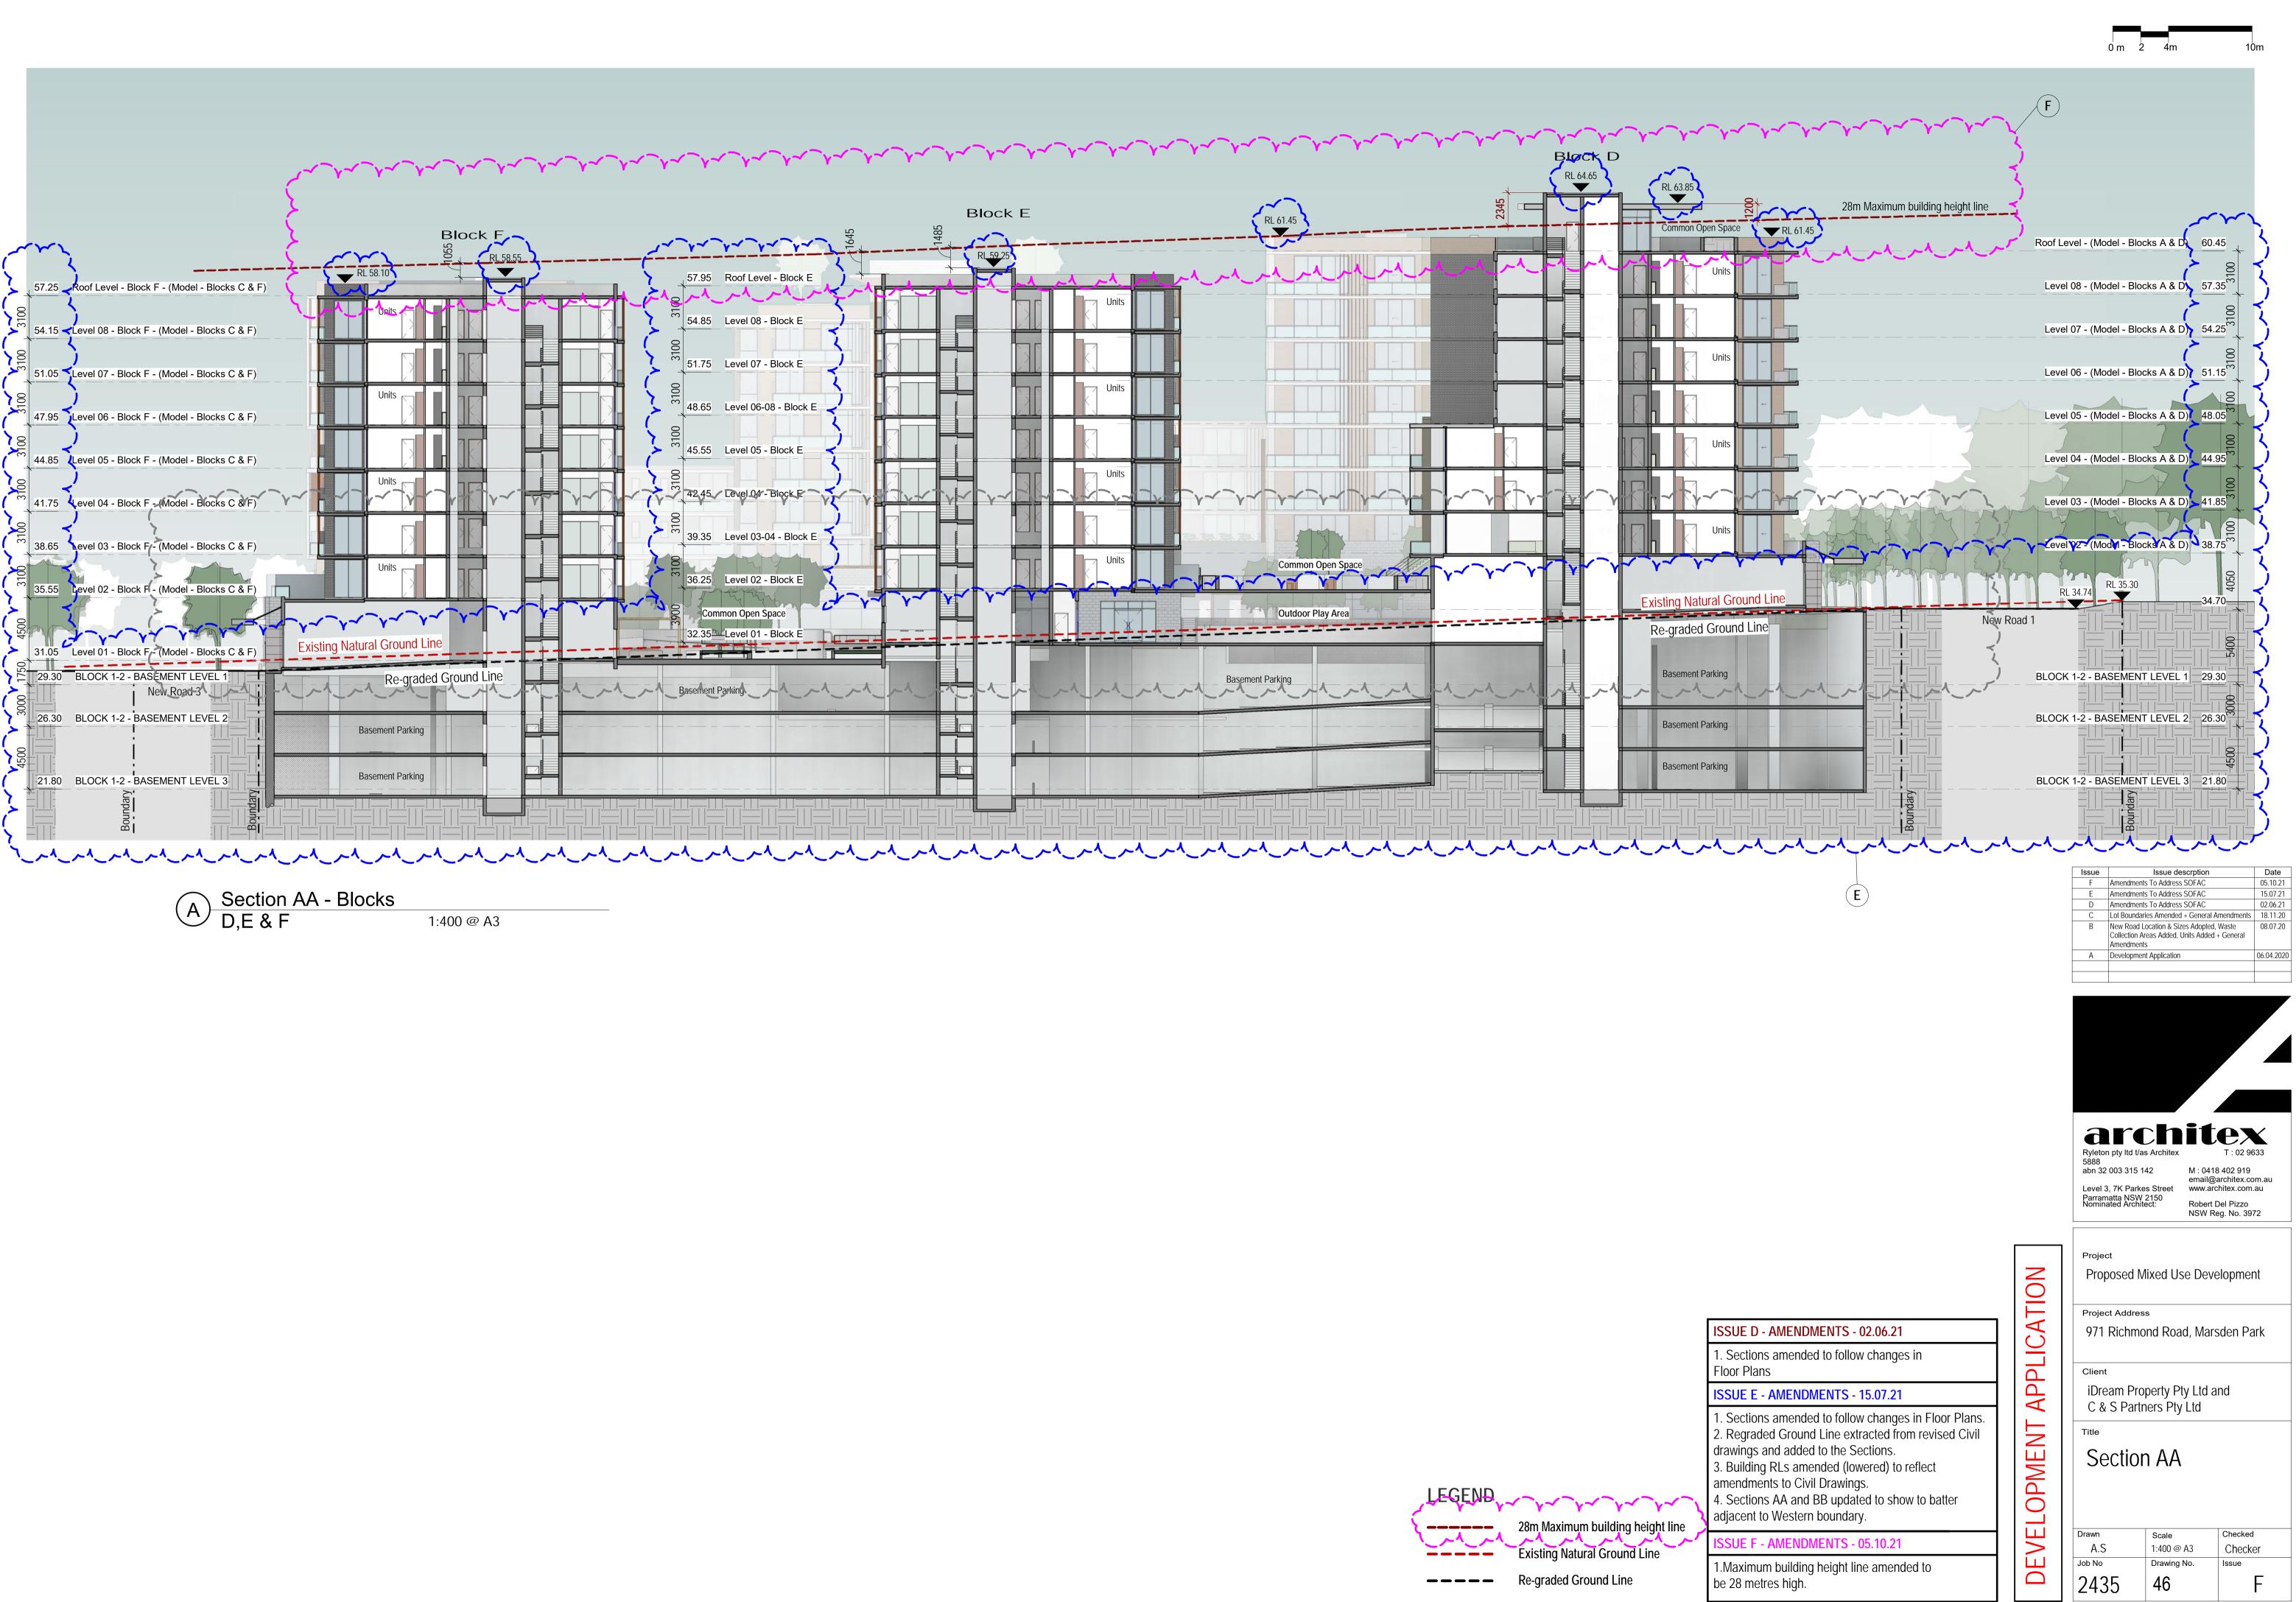

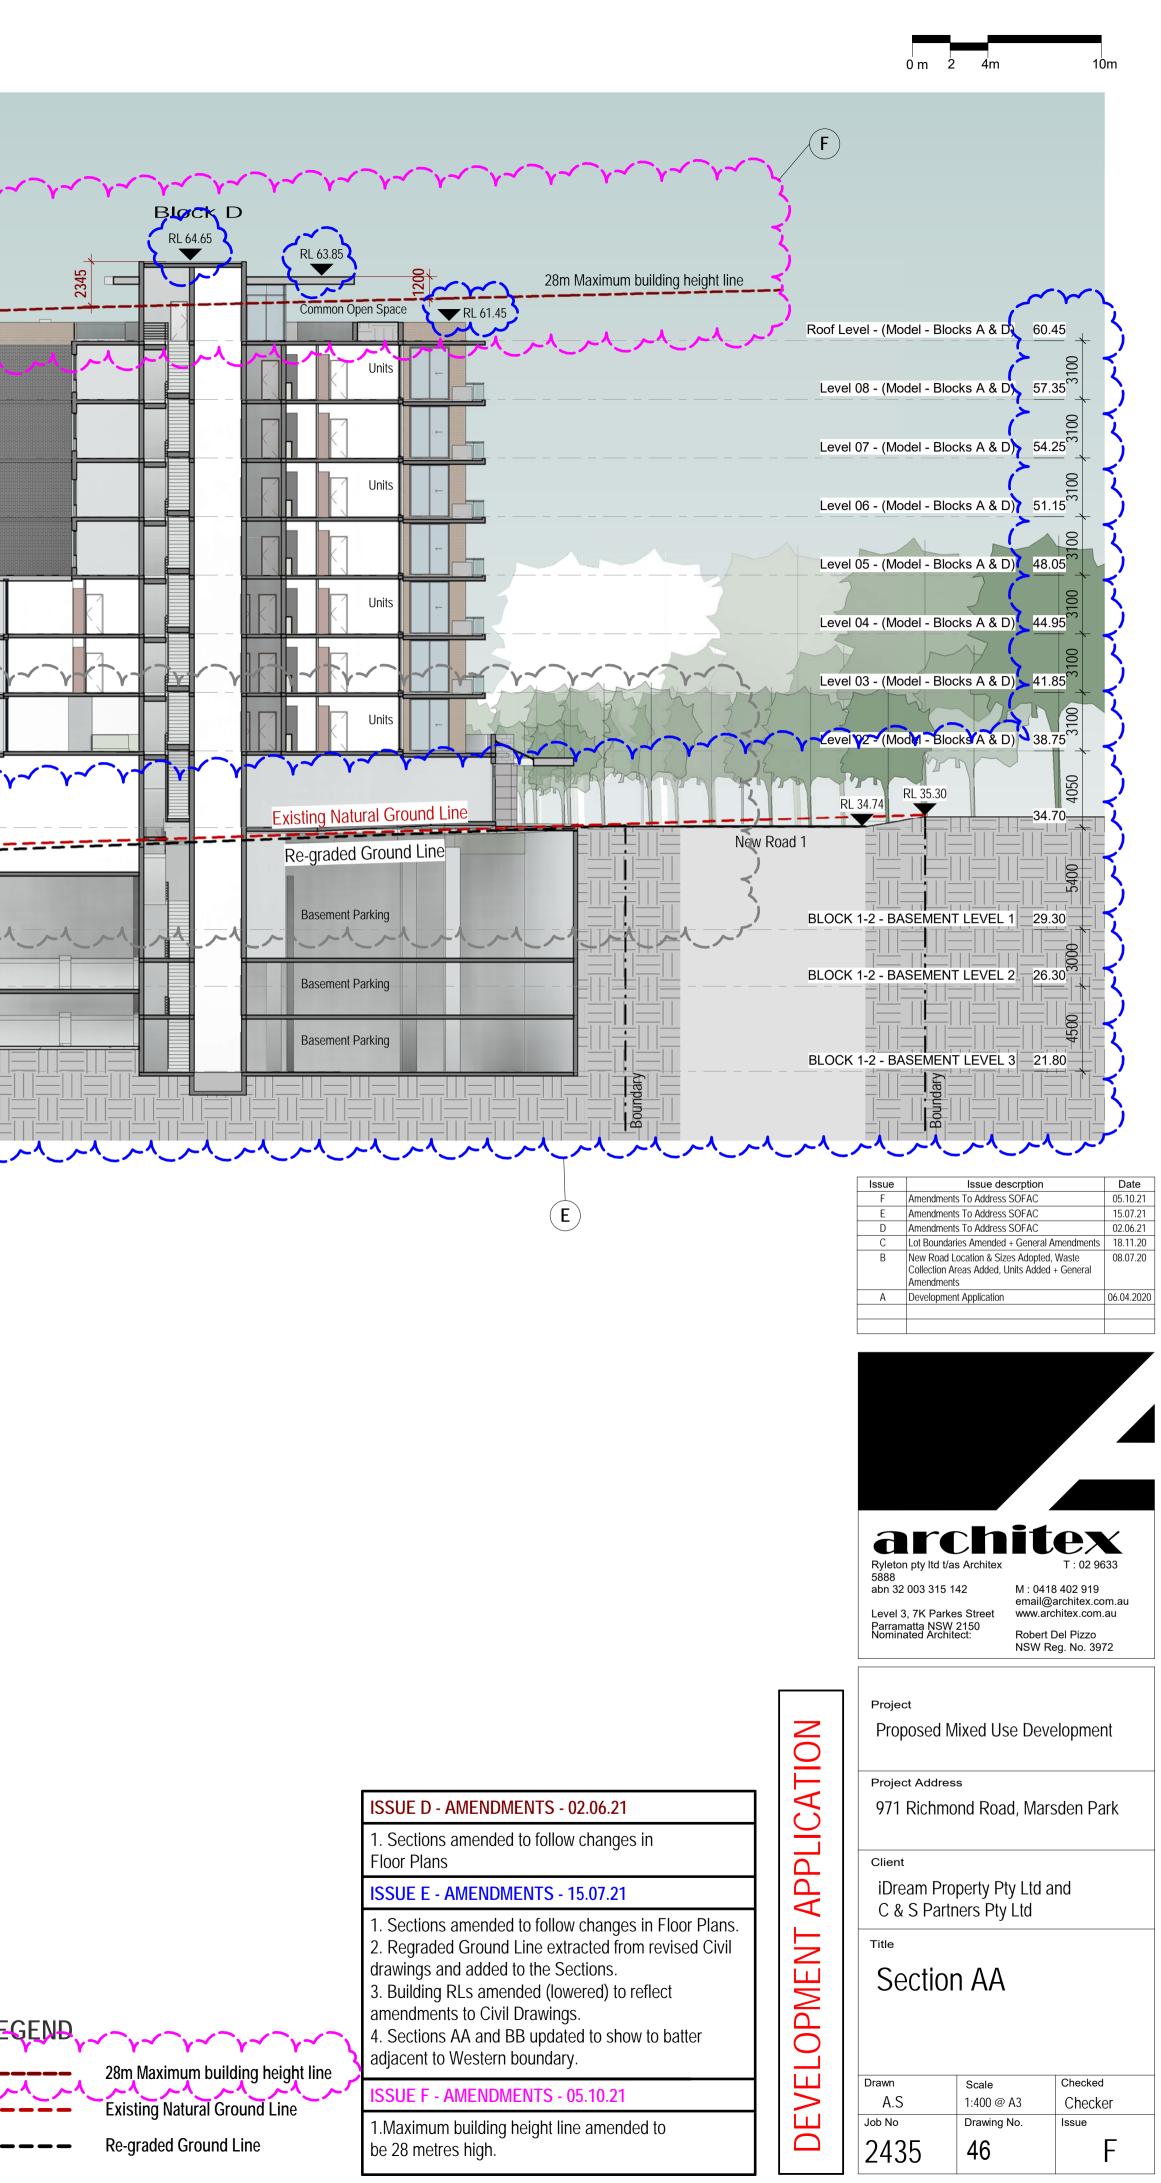

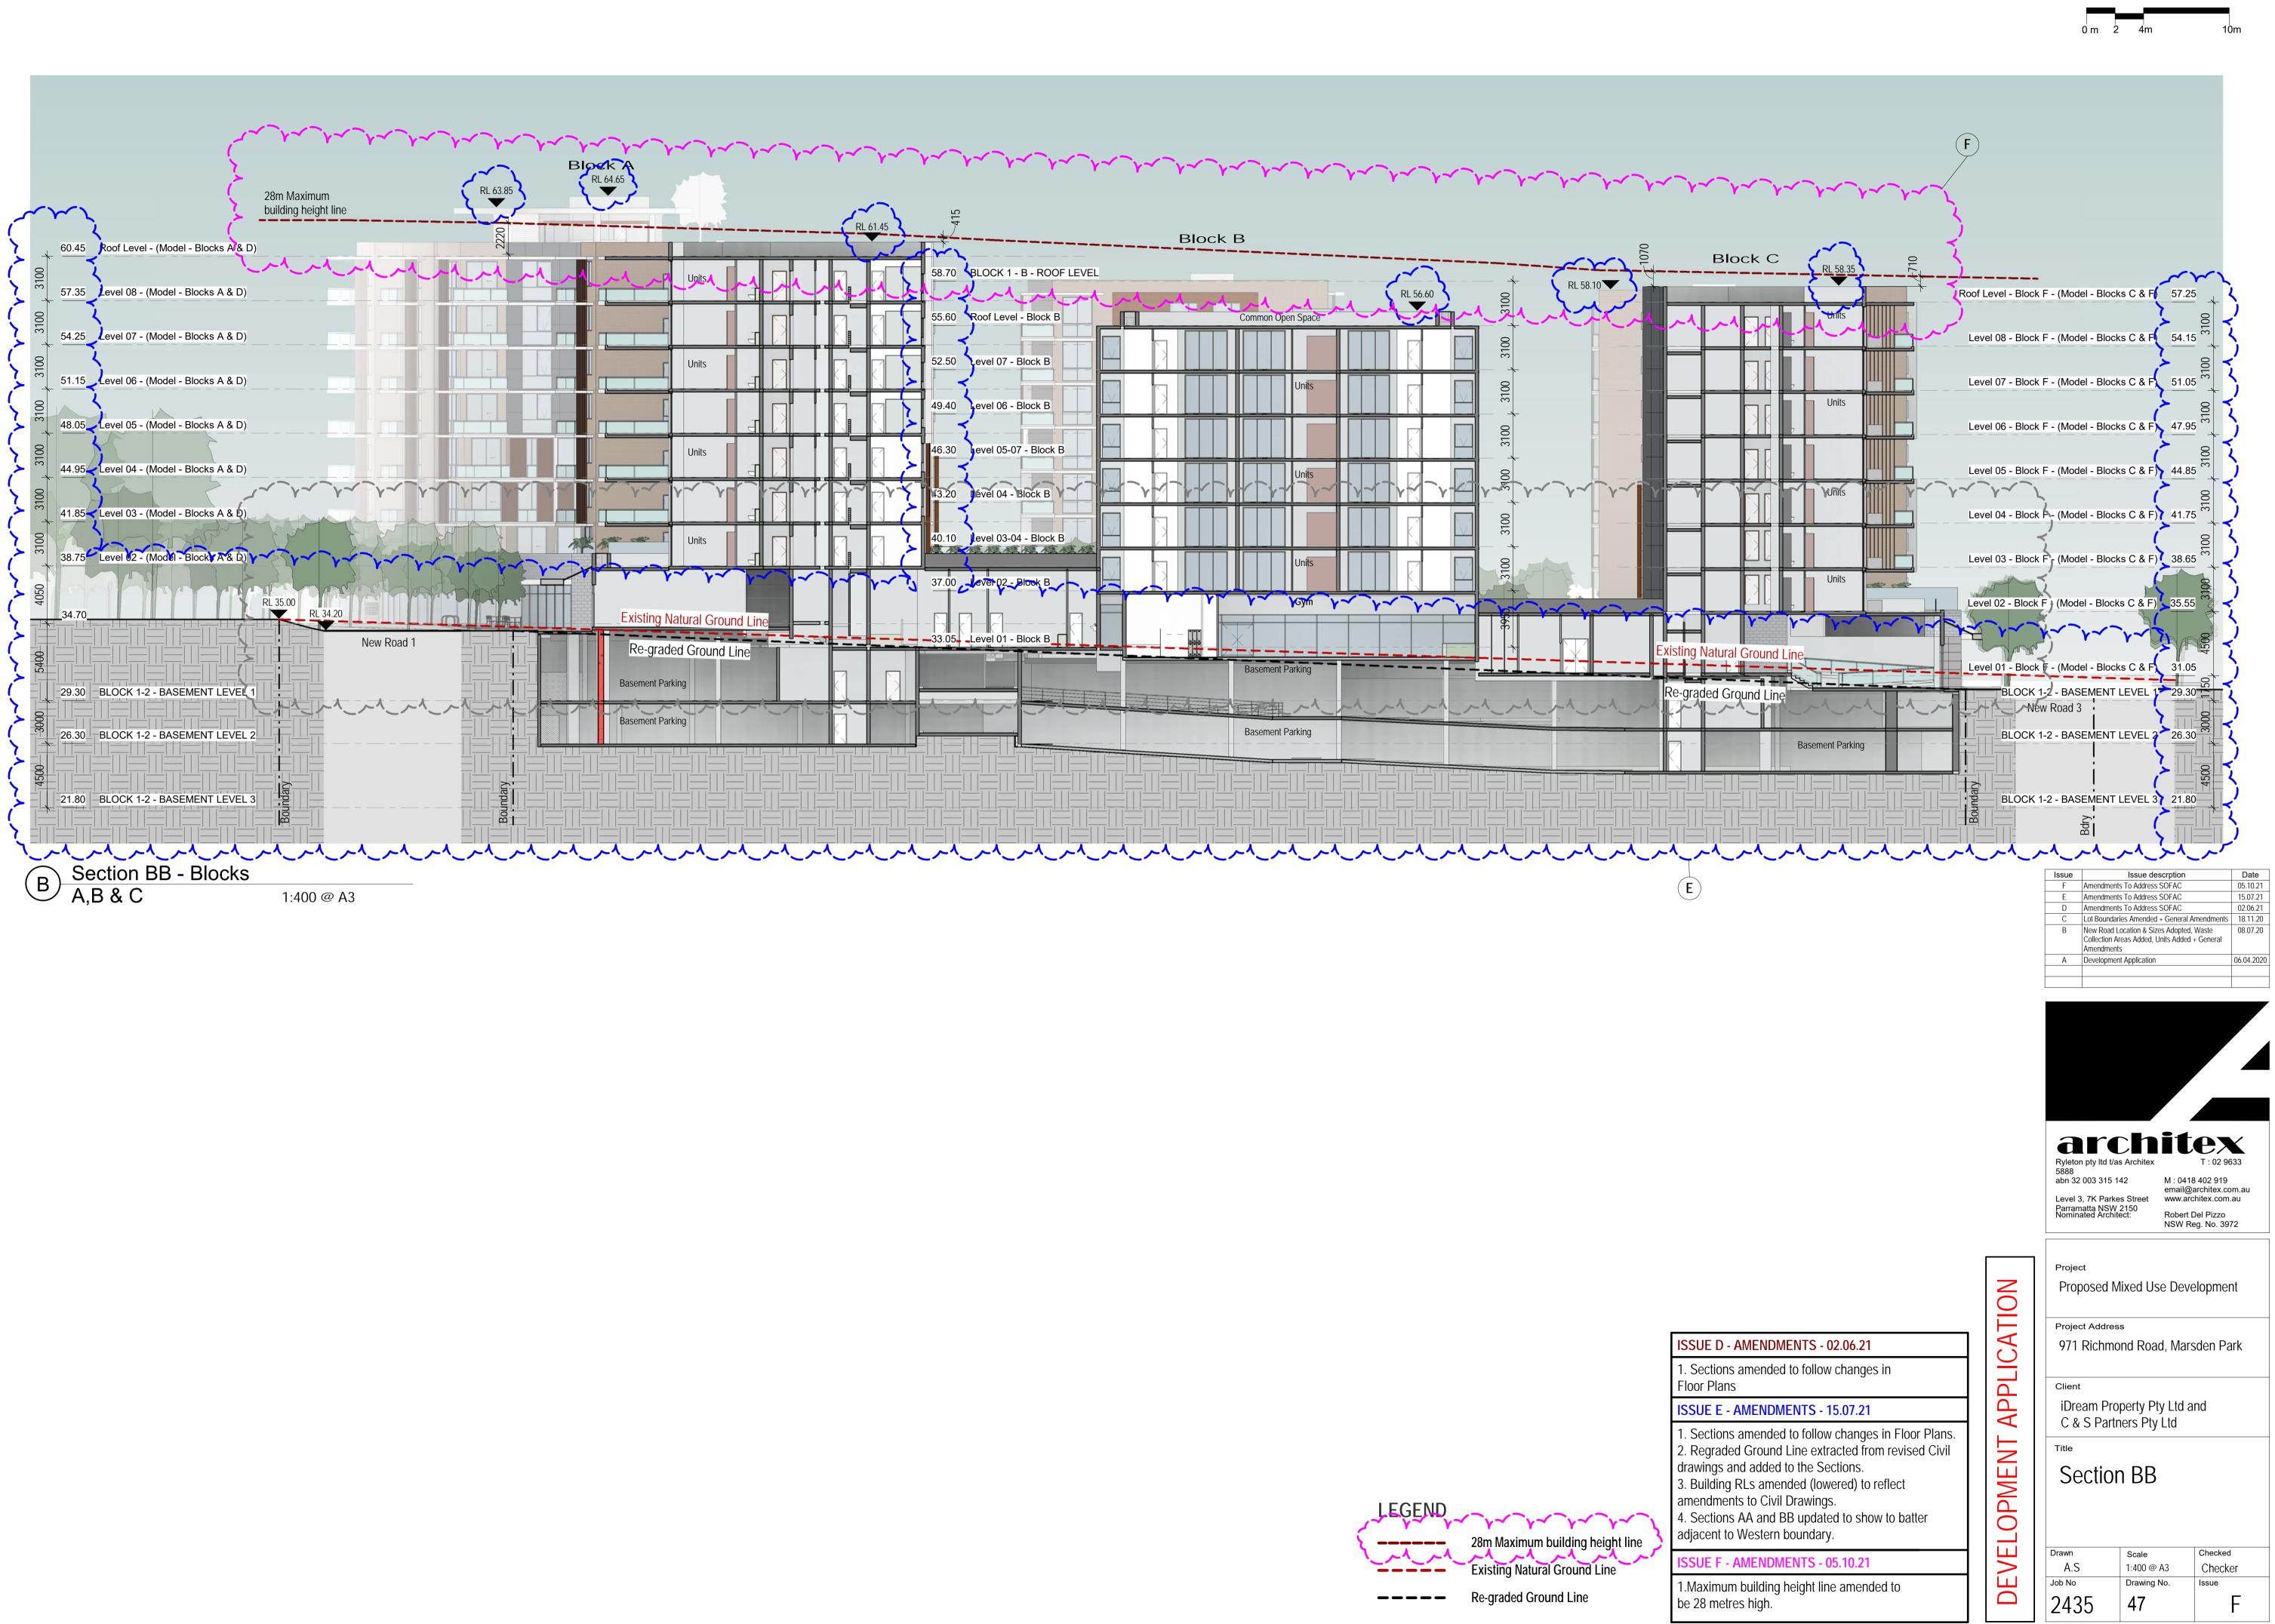

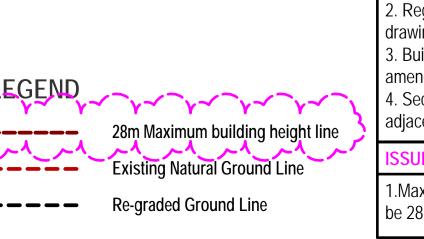

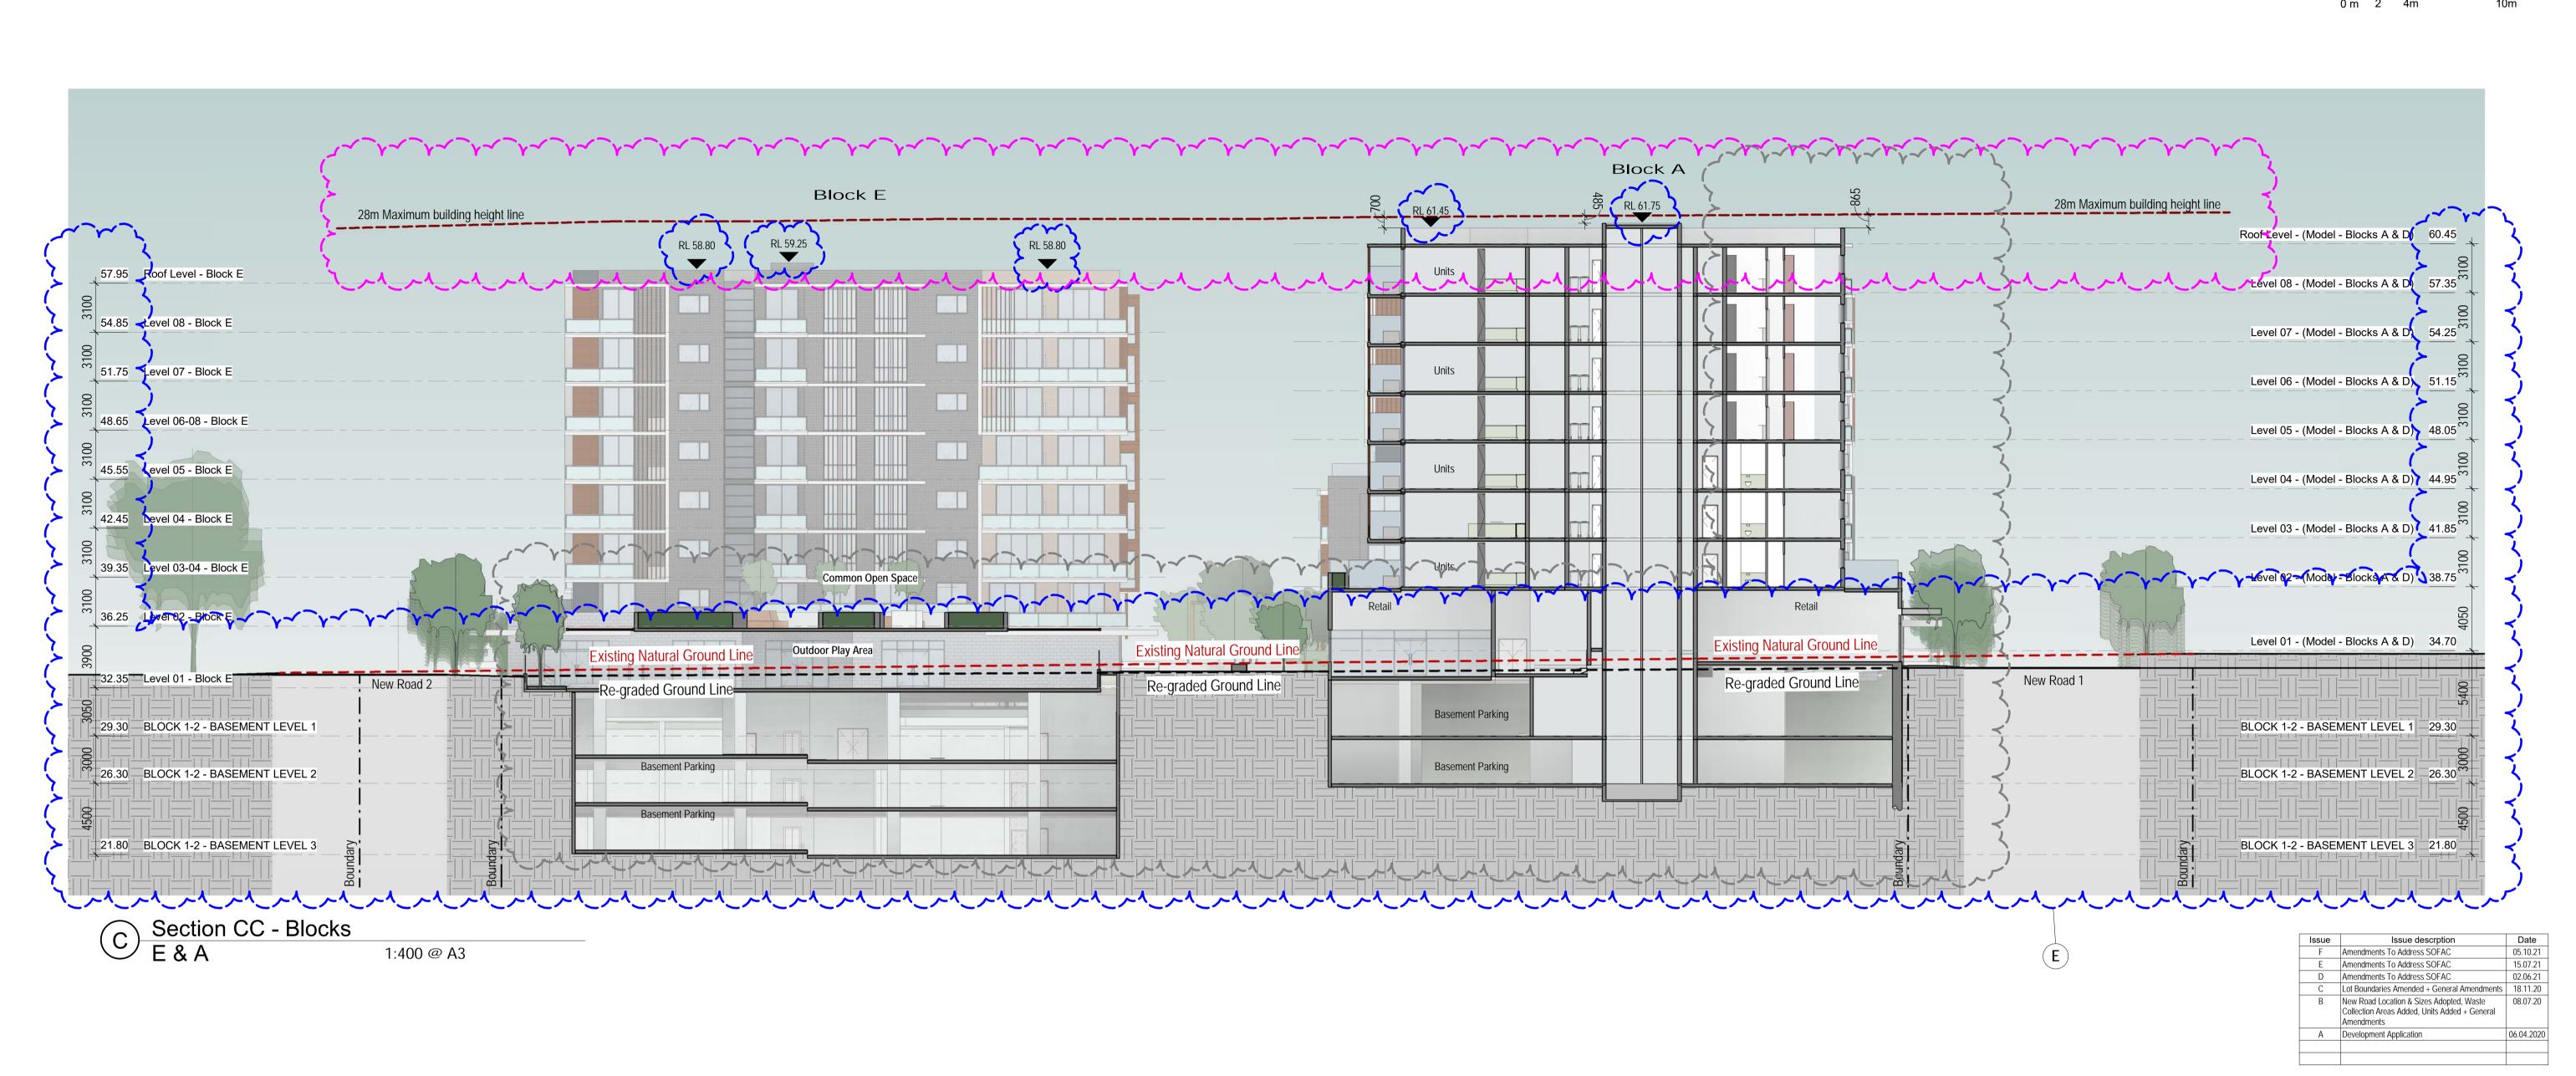

ISSUE D -1. Sections Floor Plans

**ISSUE E** -

1. Sections 2. Regrade

drawings an 3. Building F

amendmen

4. Sections

adjacent to

5. Perspex Area on Sec

SSUE F -

---- Re-graded Ground Line

28m Maximum building height line

Existing Natural Ground Line

LEGEND

γ~

_____

____



architex Ryleton pty ltd t/as Architex 5888 T : 02 9633 Level 3, 7K Parkes Street Parramatta NSW 2150 Nominated Architect: Robert Dol D

Robert Del Pizzo NSW Reg. No. 3972

### Project

Proposed Mixed Use Development

Project Address

971 Richmond Road, Marsden Park

Client

**APPLICATION** 

DEVELOPMENT


iDream Property Pty Ltd and C & S Partners Pty Ltd


Title Section CC

Drawn Checked Scale A.S 1:400 @ A3 Checker Job No Drawing No. Issue 2435 Г 48

AMENDMENTS - 02.06.21
s amended to follow changes in s
AMENDMENTS - 15.07.21
s amended to follow changes in Floor Plans. ed Ground Line extracted from revised Civil and added to the Sections. g RLs amended (lowered) to reflect nts to Civil Drawings. s AA and BB updated to show to batter o Western boundary. c Awning shown over Child Care Outdoor Play ection CC.
AMENDMENTS - 05.10.21

1.Maximum building height line amended to be 28 metres high.

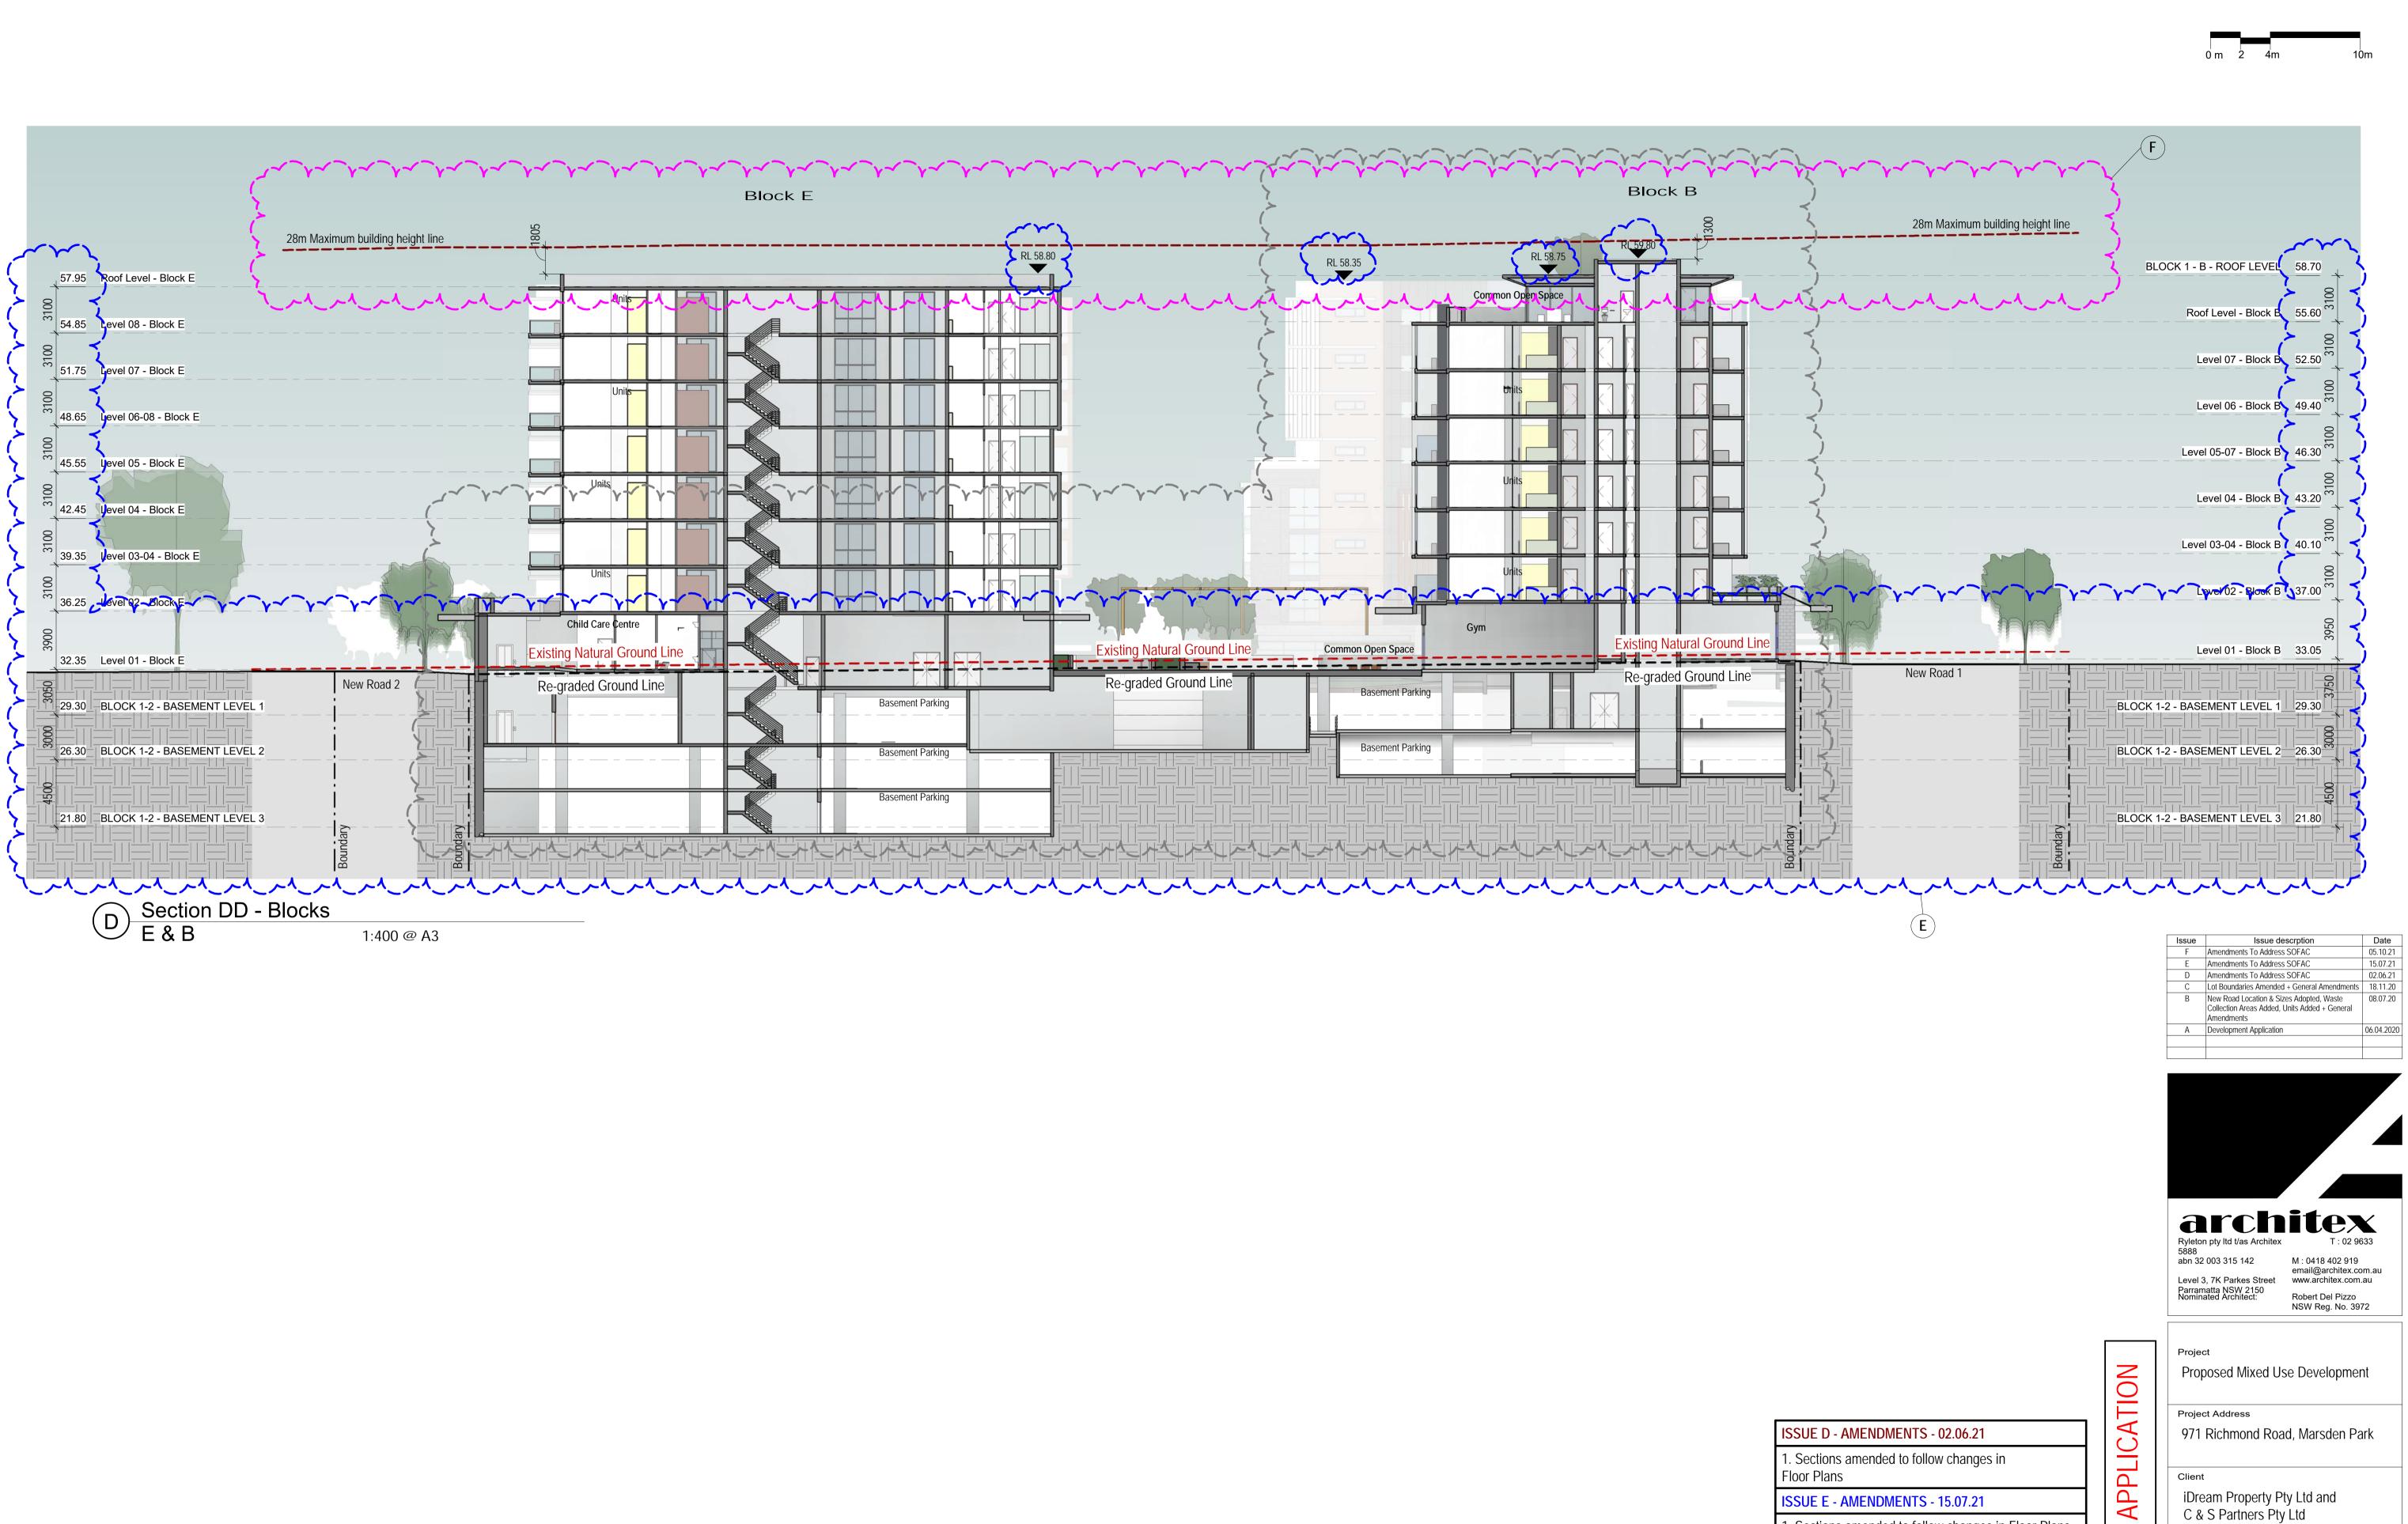

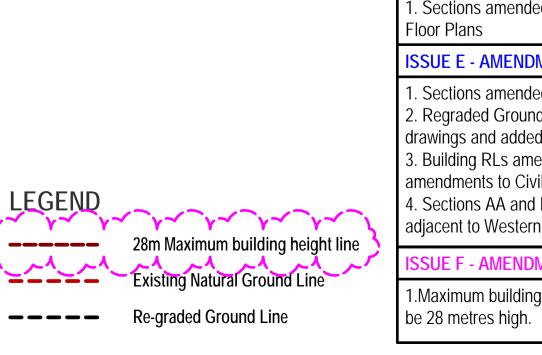

~~

1. Sections amended to follow changes in Floor Plans. 2. Regraded Ground Line extracted from revised Civil drawings and added to the Sections. 3. Building RLs amended (lowered) to reflect amendments to Civil Drawings.

4. Sections AA and BB updated to show to batter adjacent to Western boundary.

SSUE F - AMENDMENTS - 05.10.21


1.Maximum building height line amended to


Section DD

Title


DEVELOPMENT


Drawn	Scale	Checked
A.S	1:400 @ A3	Checker
Job No	Drawing No.	Issue
2435	49	F

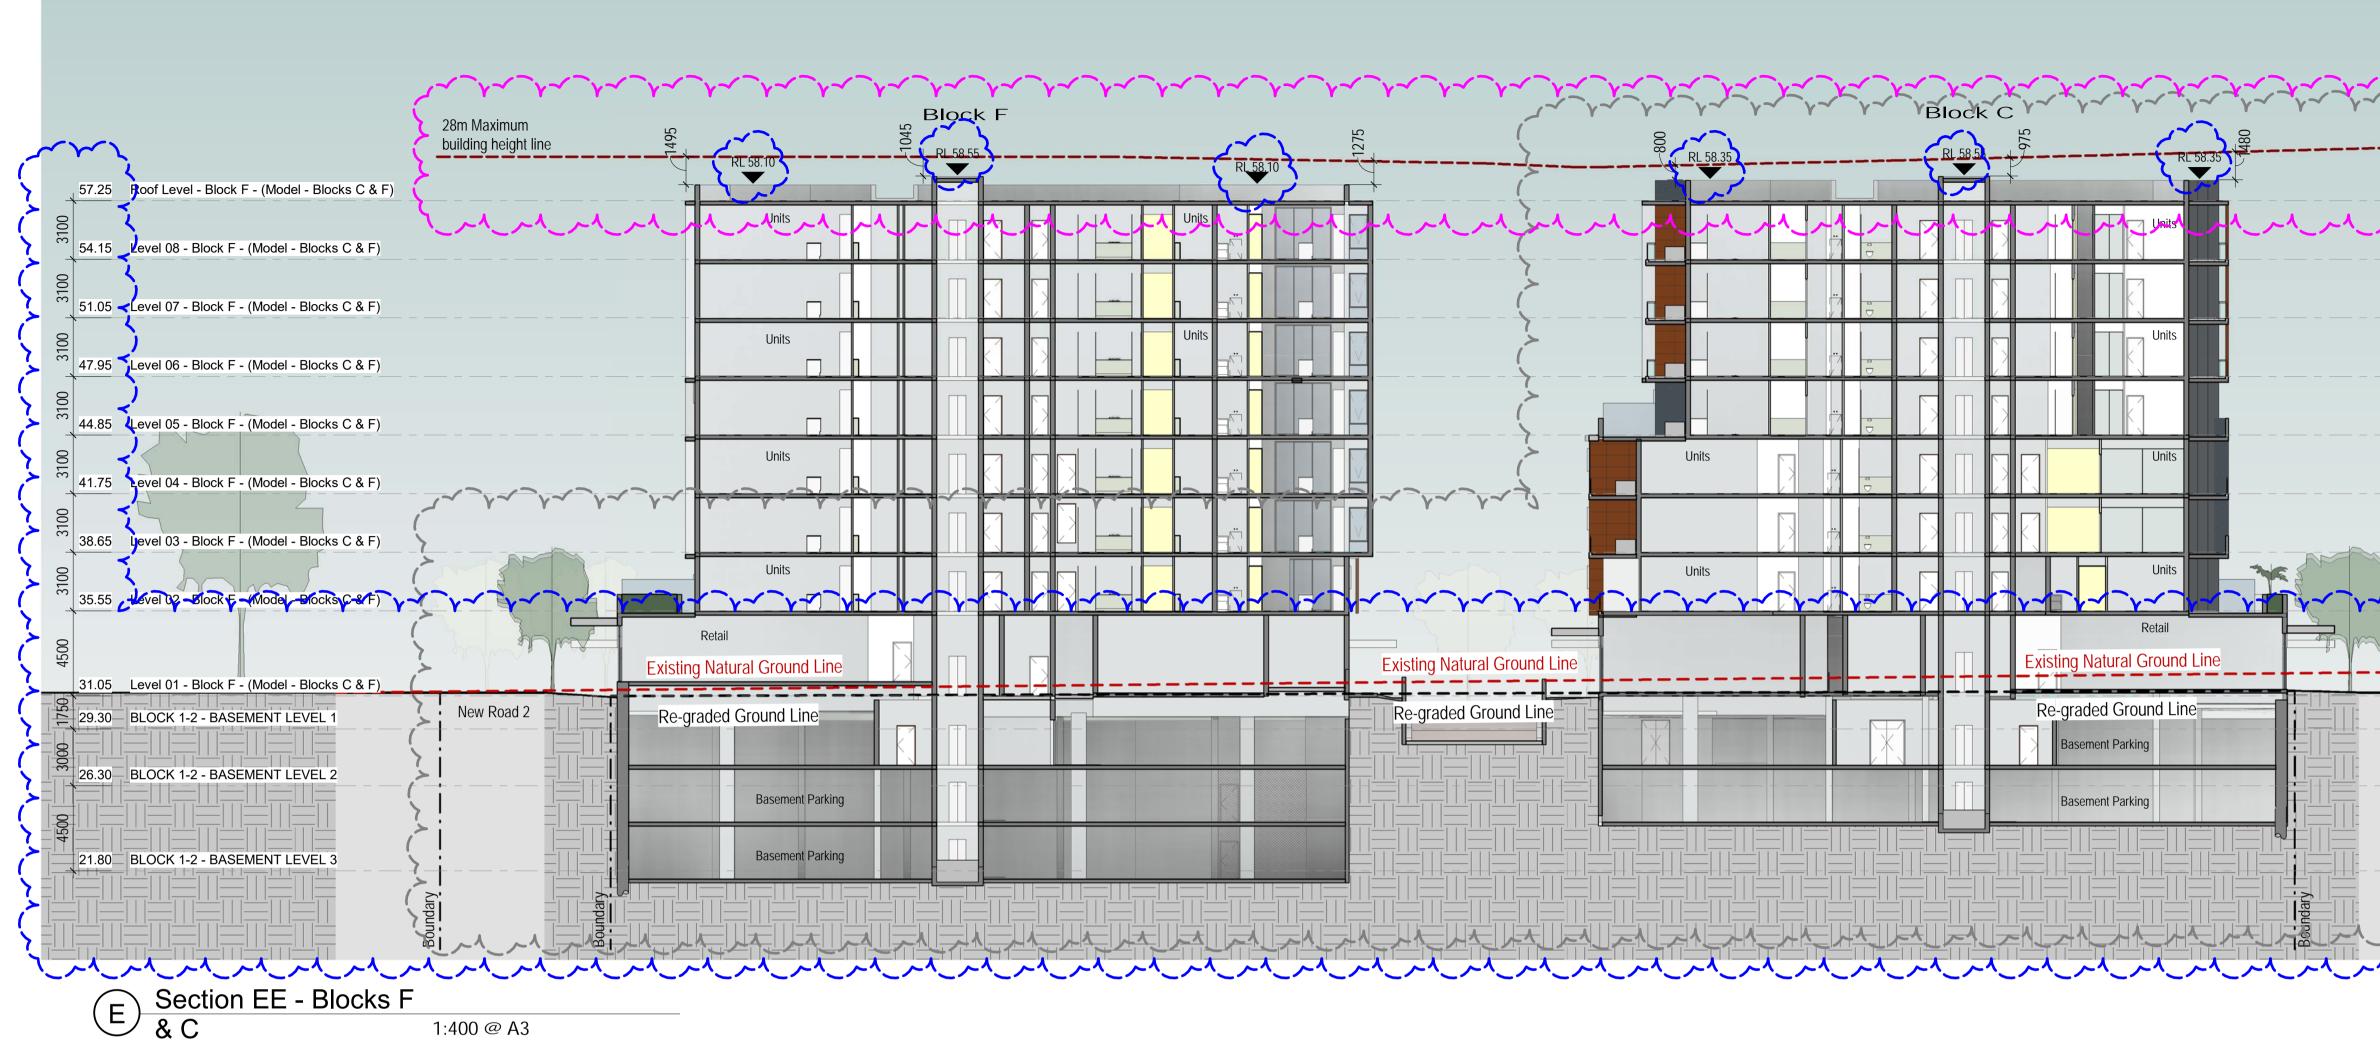

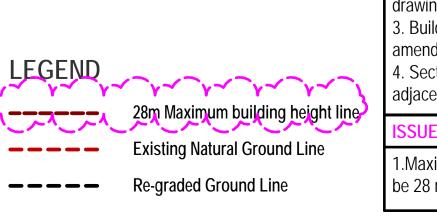




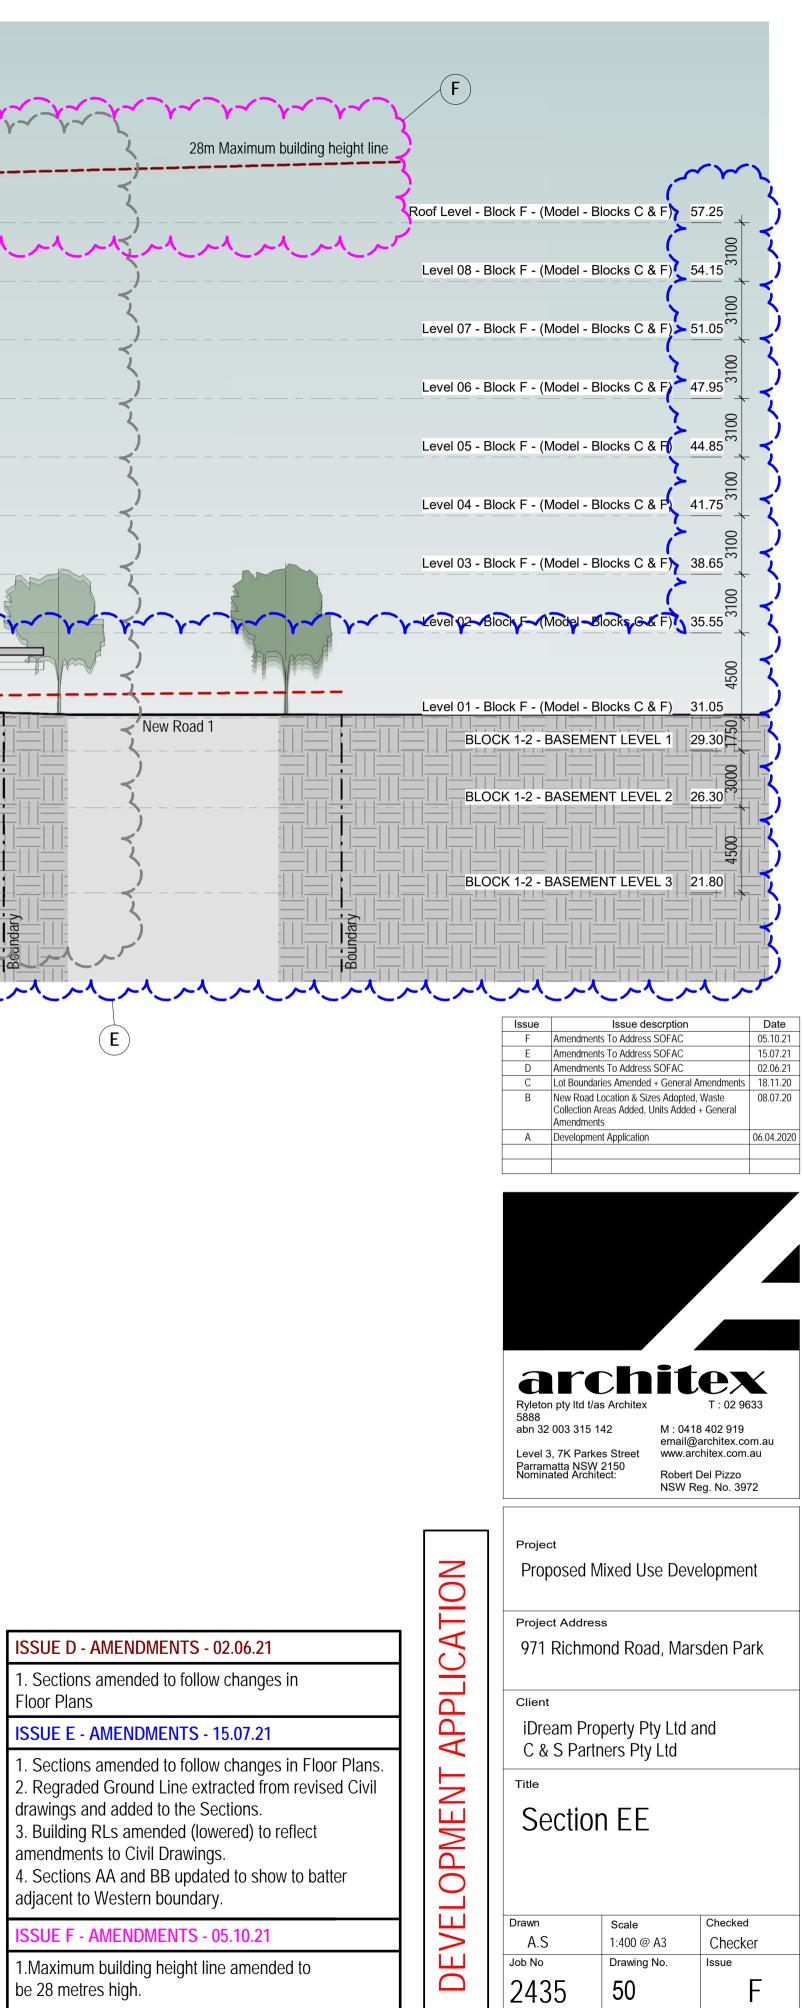

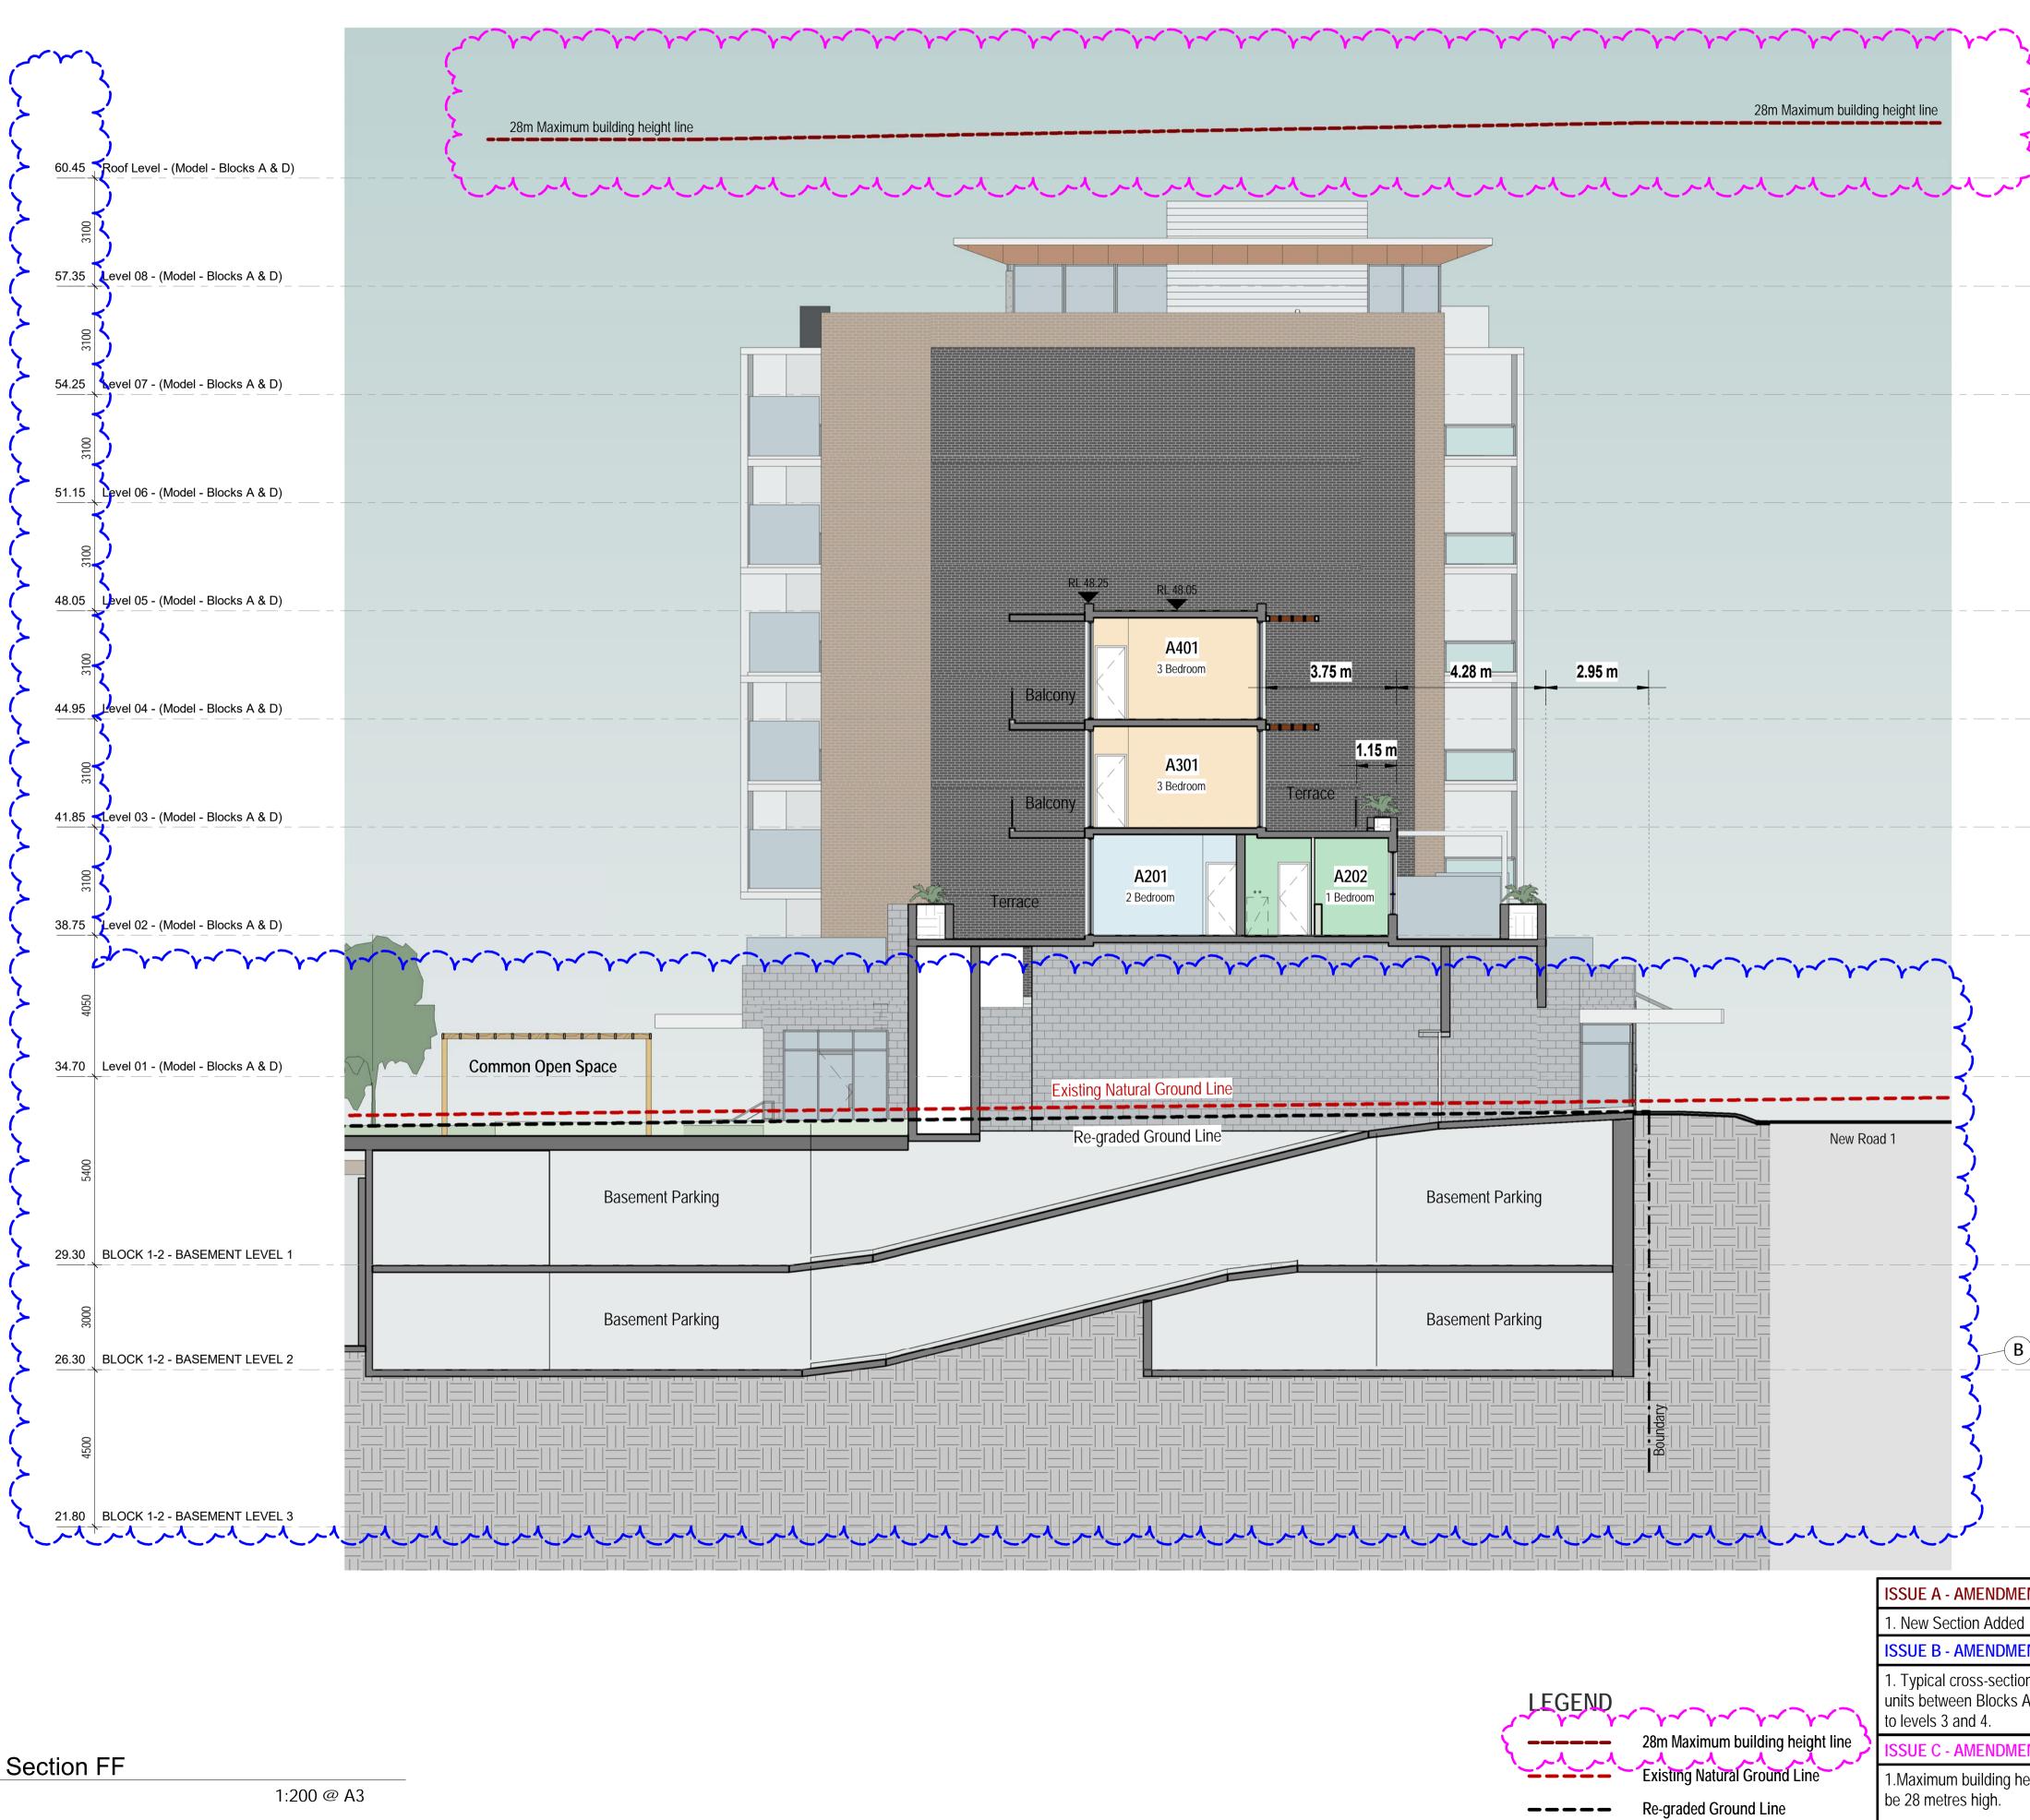



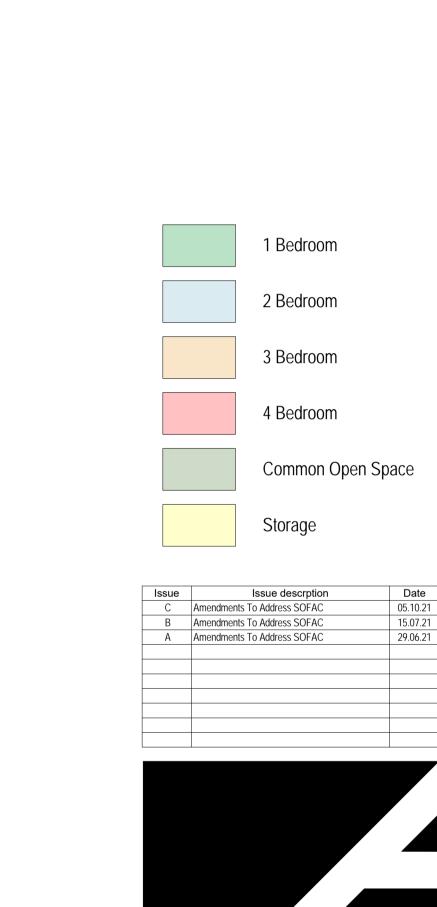

arch	itex
Ryleton pty Itd t/as Architex 5888	T : 02 9633
abn 32 003 315 142	M : 0418 402 919 email@architex.com.au
Level 3, 7K Parkes Street	www.architex.com.au
Parramatta NSW 2150 Nominated Architect:	Robert Del Pizzo NSW Reg. No. 3972

Proje	•
	1

Proposed Mixed Use Development

Project Address

971 Richmond Road, Marsden Park

Client

Title

**APPLICATION** 

DEVELOPMENT

iDream Property Pty Ltd and C & S Partners Pty Ltd

Section FF

Drawn	Scale	Checked
A.S	1:200 @ A3	Checker
Job No	Drawing No.	Issue
2435	50a	С

|--|


B


ISSUE B - AMENDMENTS - 15.07.21


1. Typical cross-section added through the Bridging units between Blocks A-B; to show additional setbacks


C - AMENDMENTS - 05.10.21


1.Maximum building height line amended to be 28 metres high.

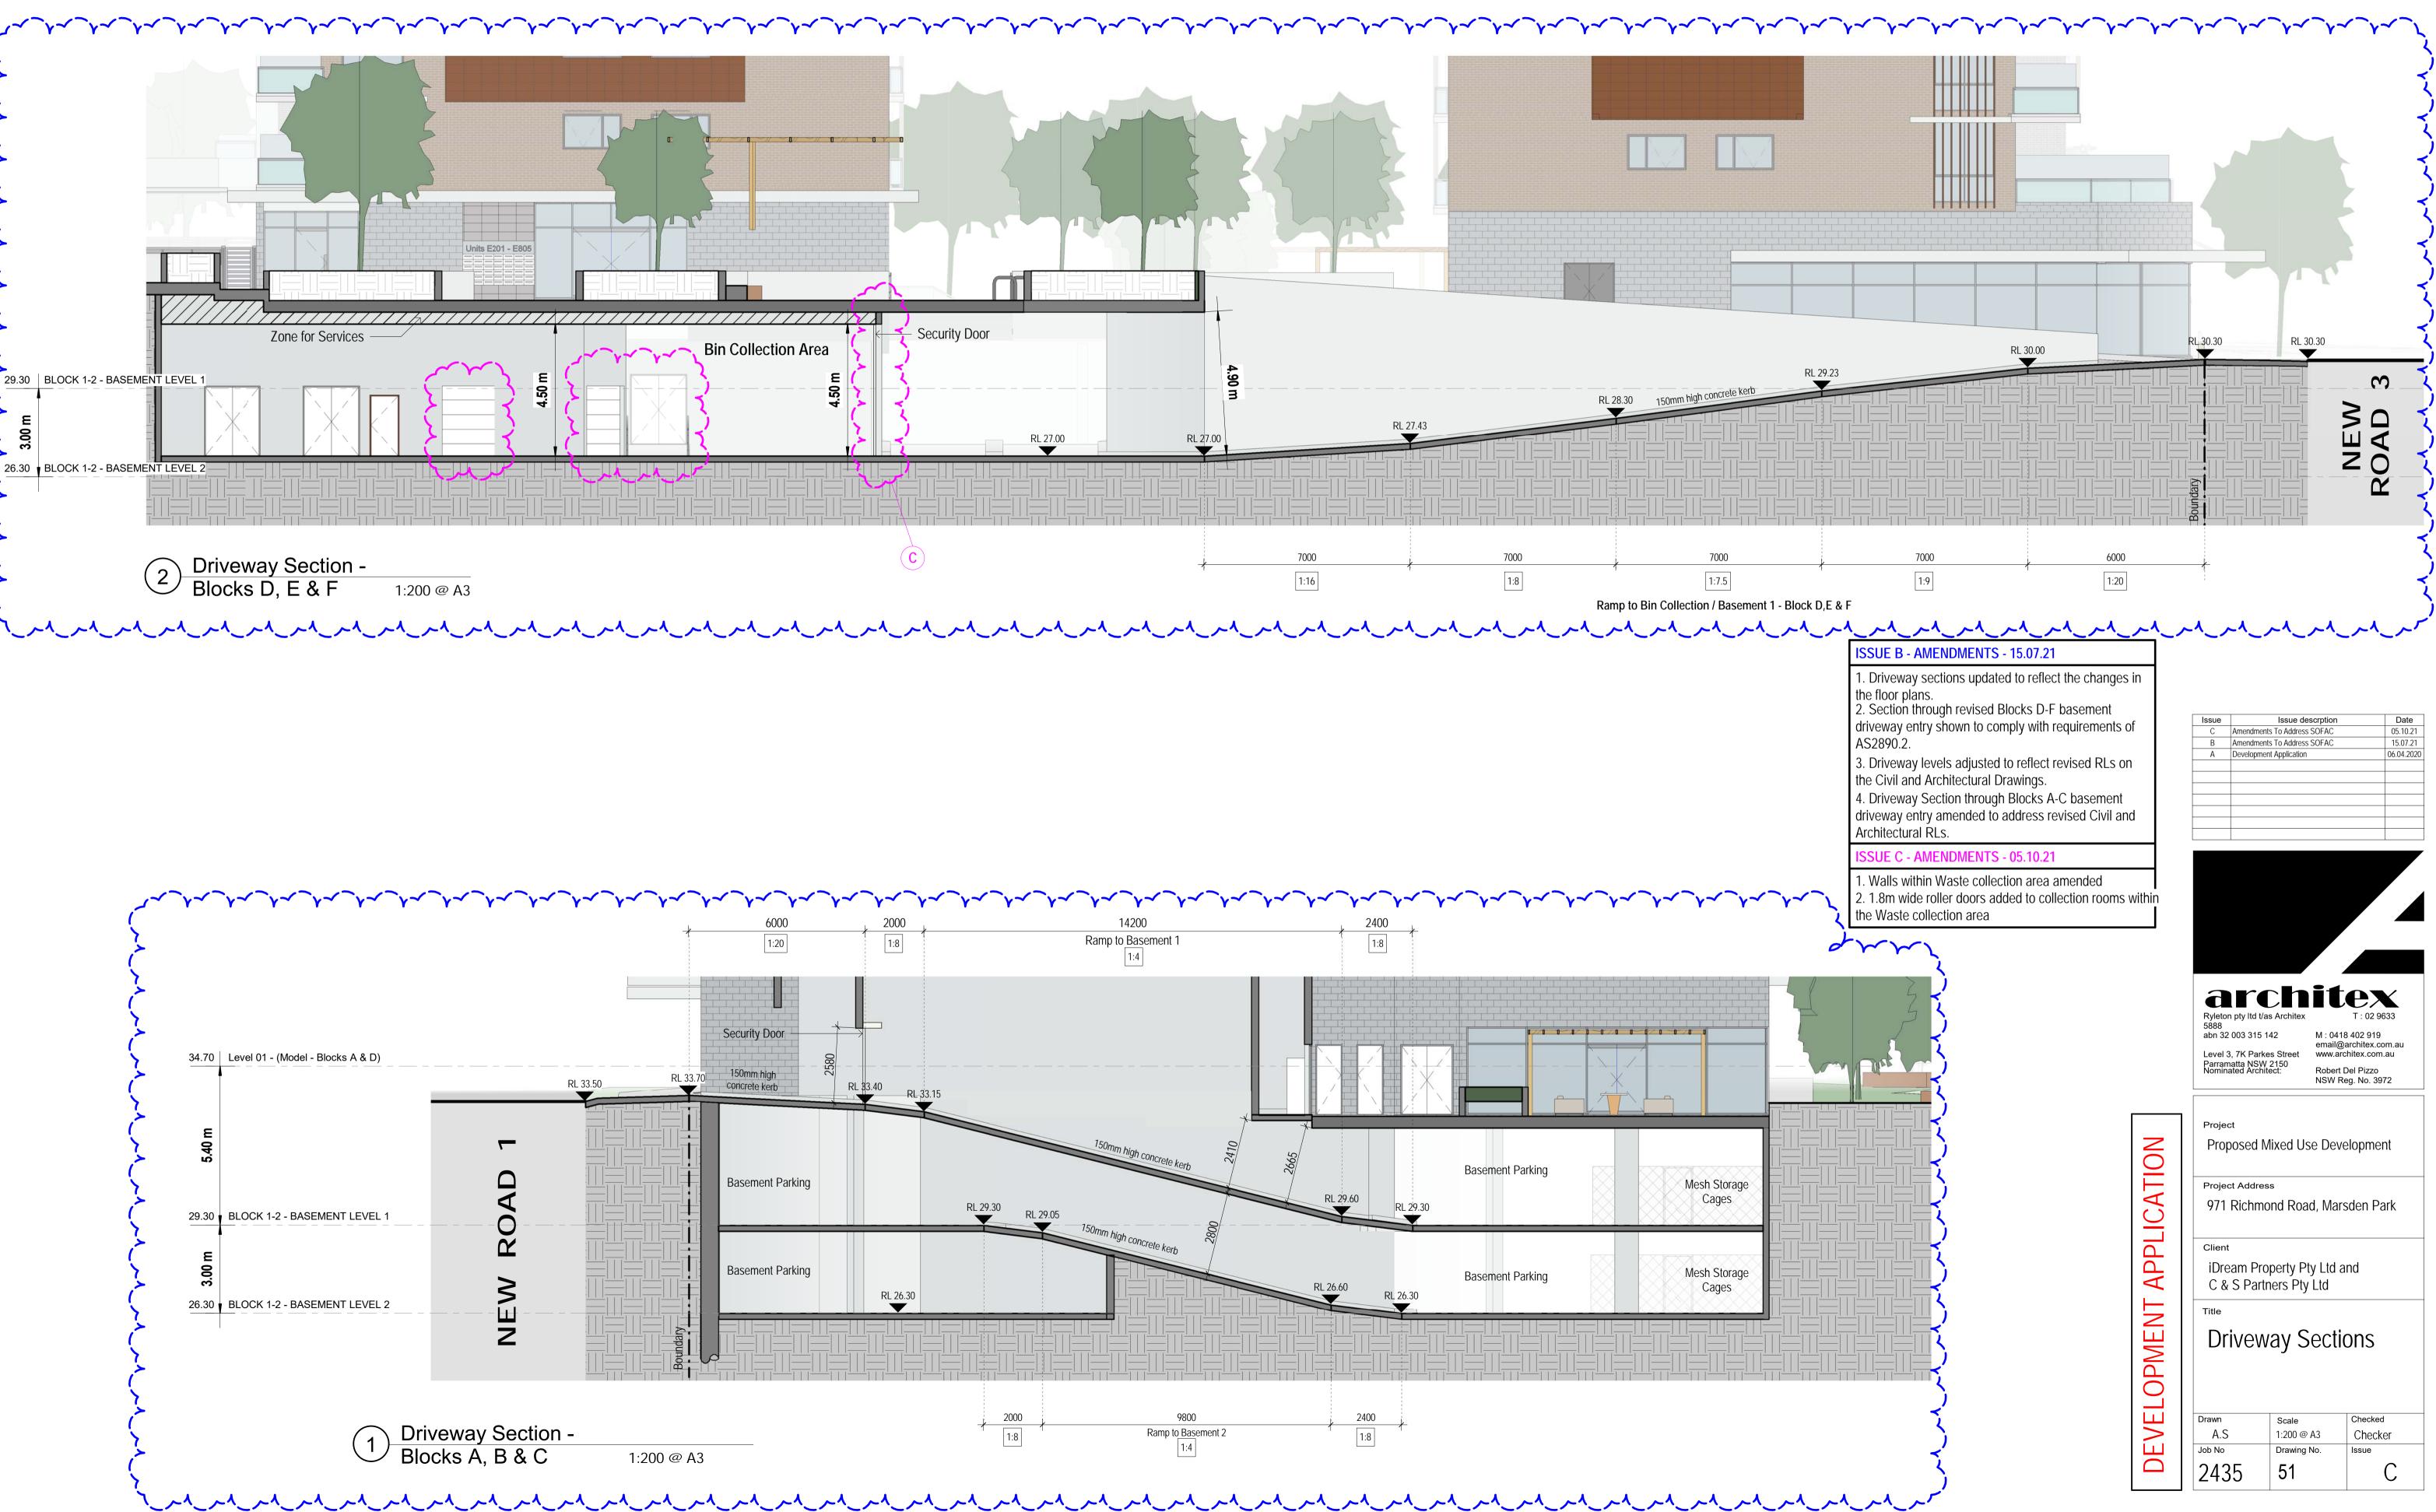

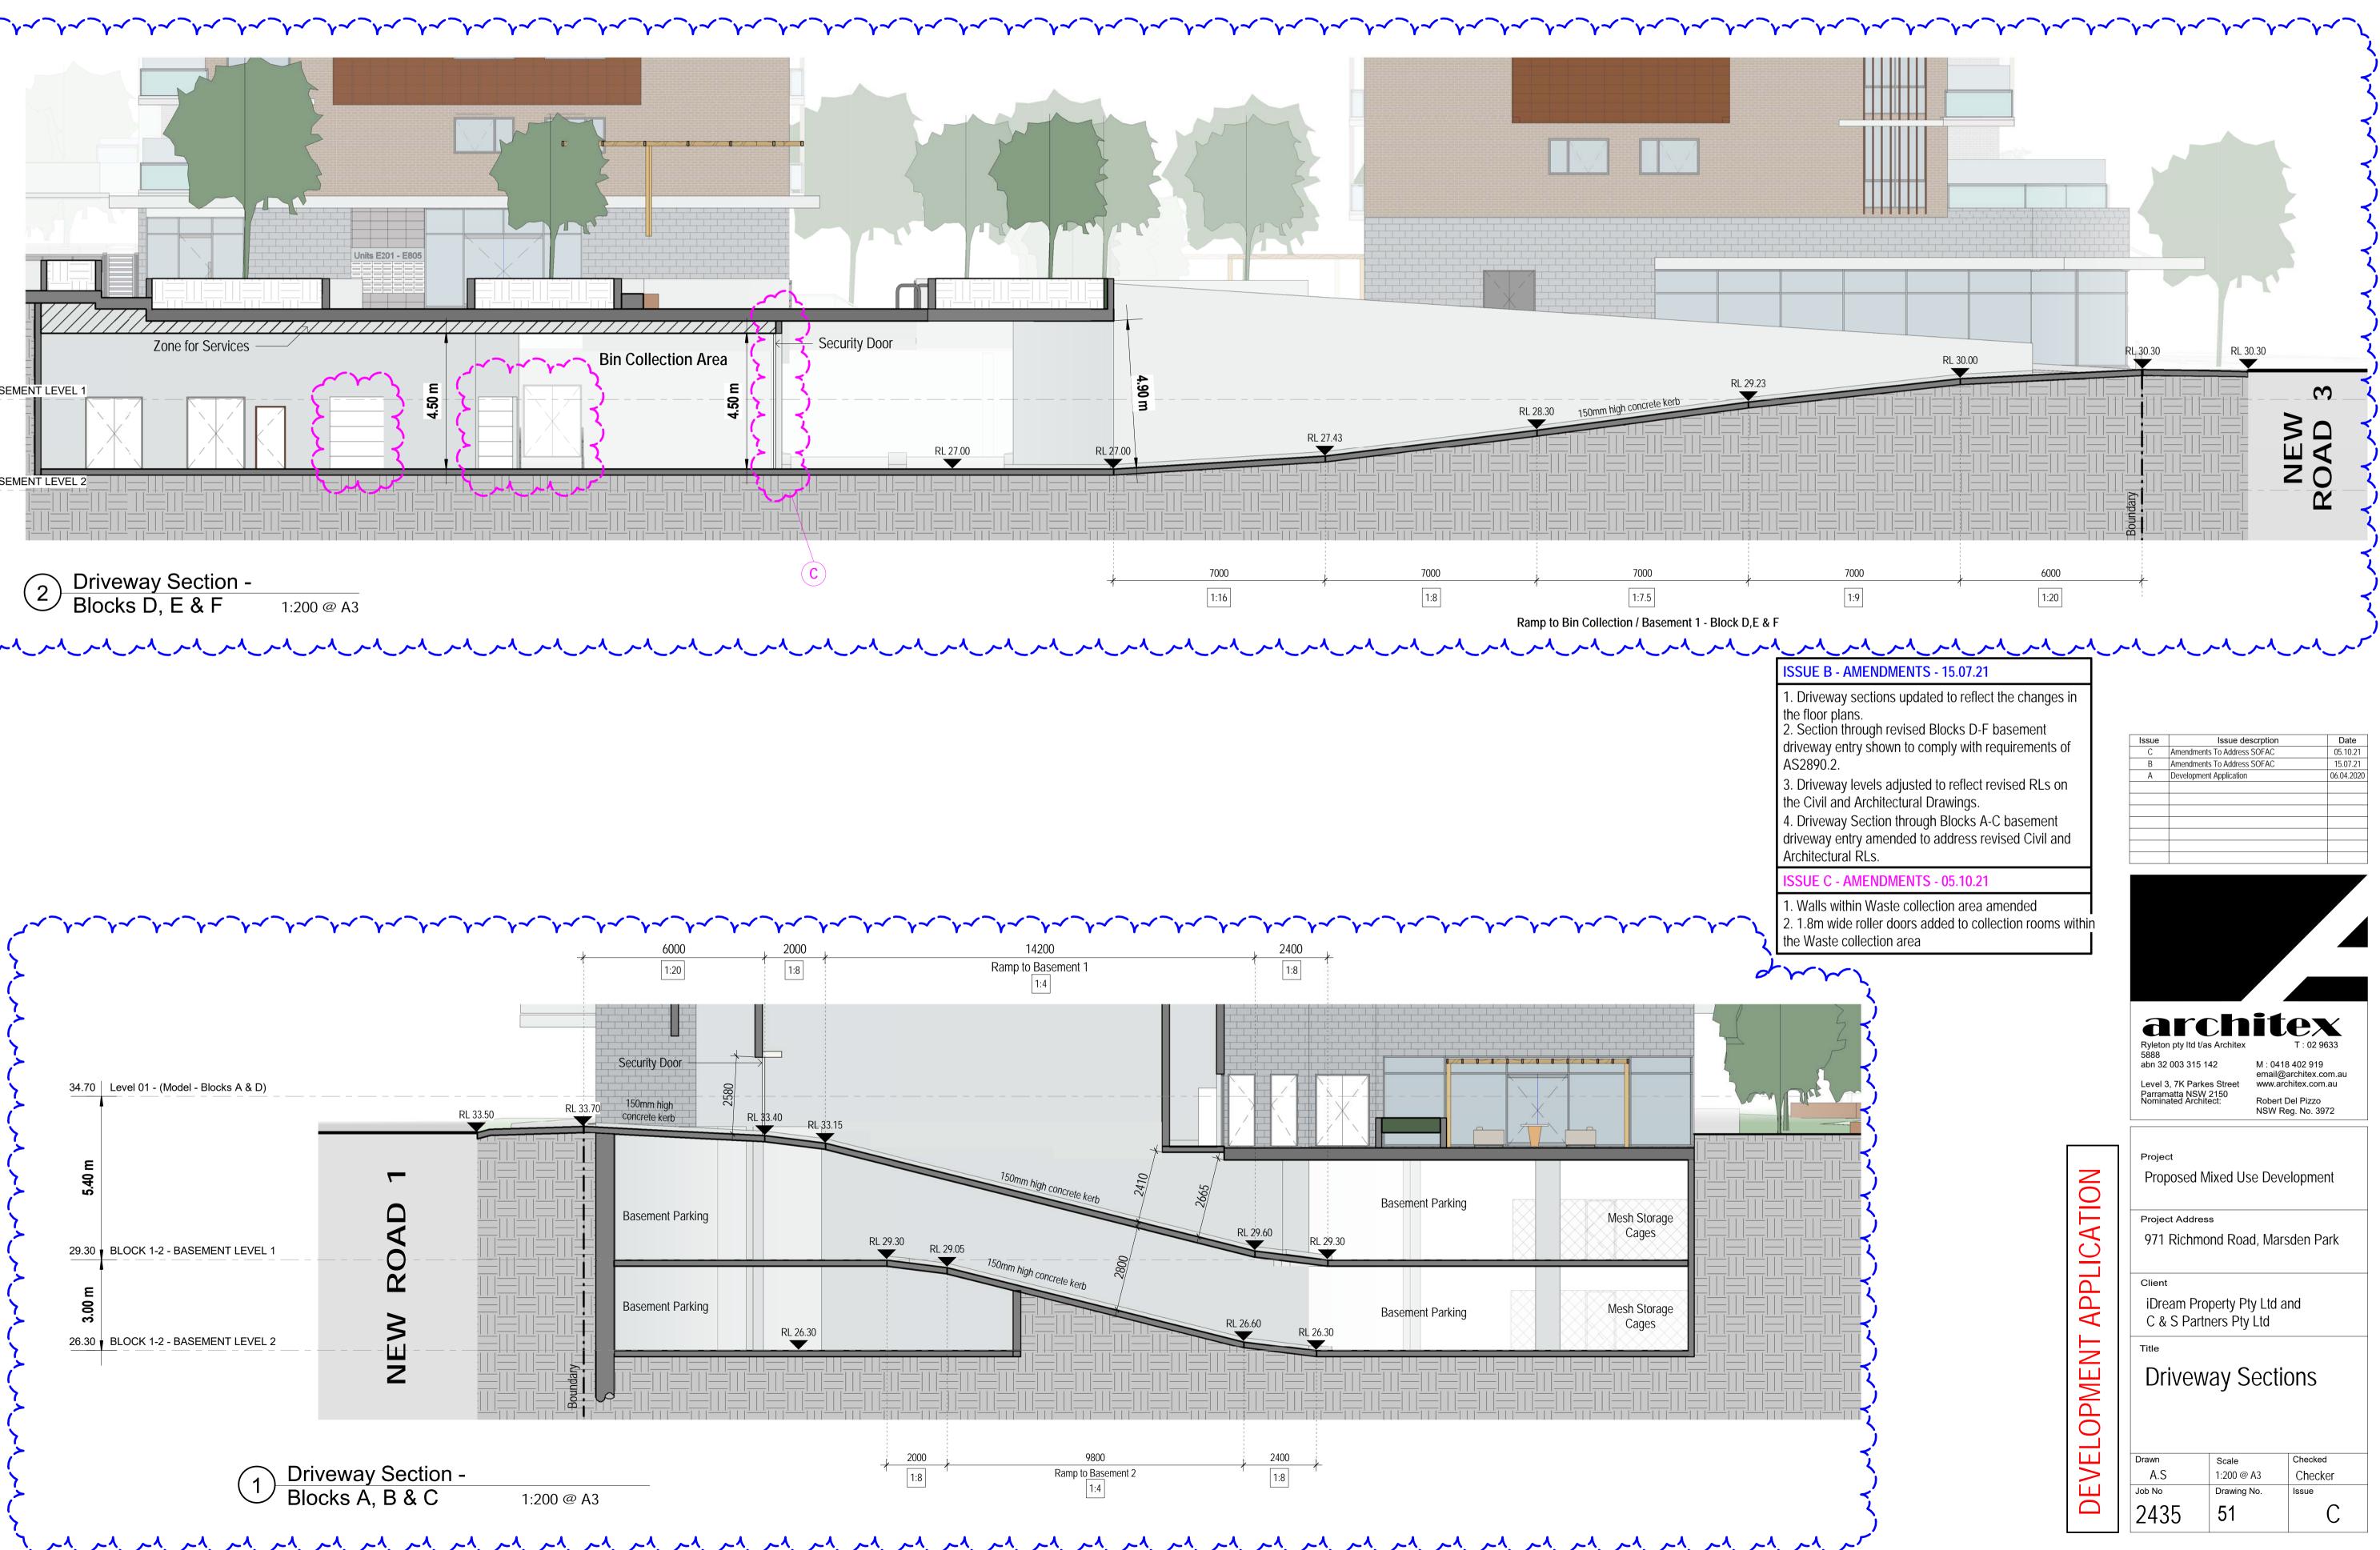

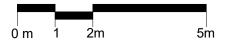

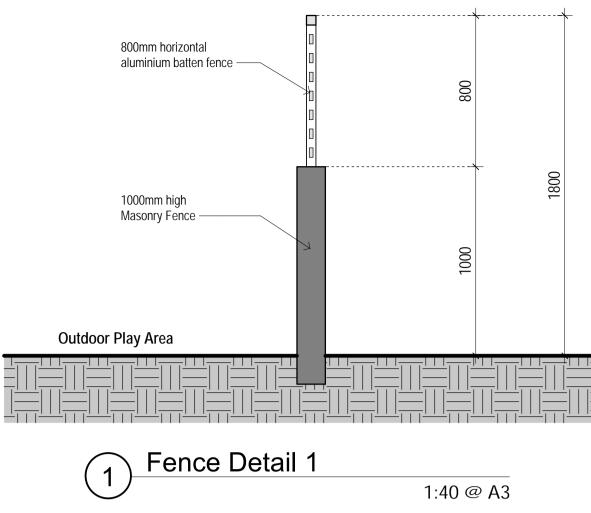

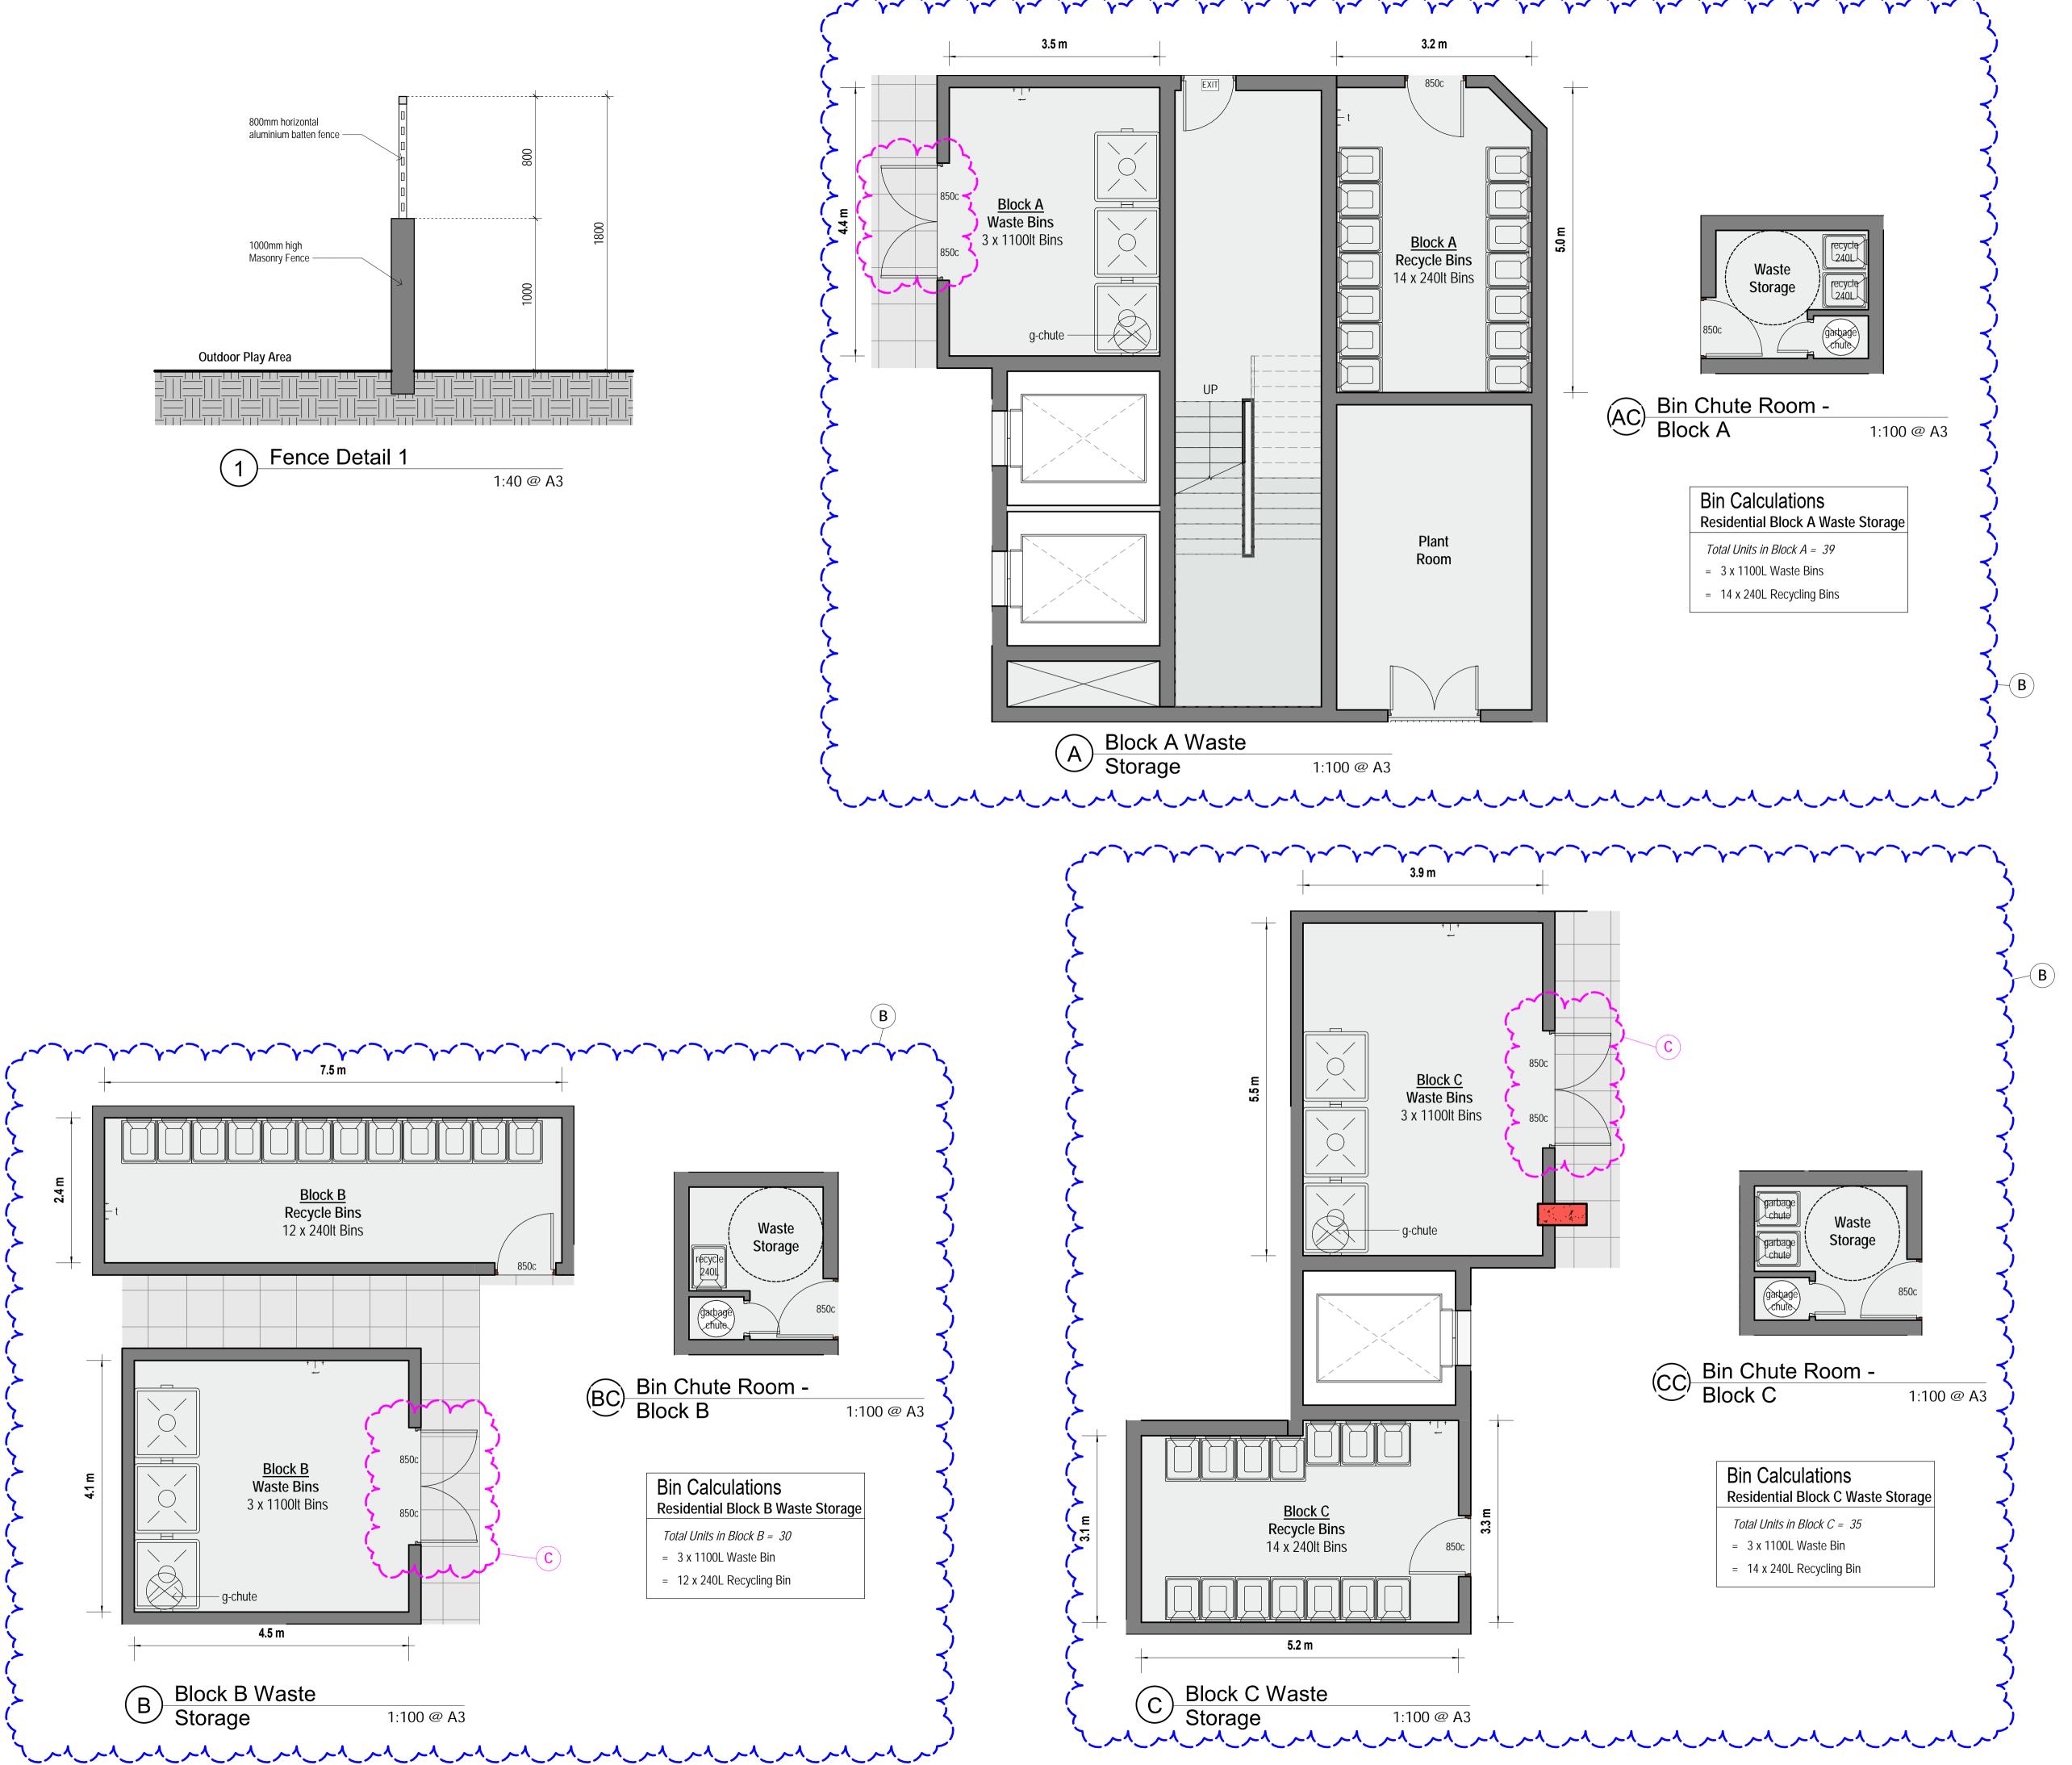

0 m	0.5	1m	2.5m

ISSUE B - AMENDMENTS - 15.07.21
1. Site details updated to show the new Waste storage and collection layouts
ISSUE C - AMENDMENTS - 05.10.21
1. 2x 920 Doors added to Waste rooms.

Issue	Issue descrption	Date
С	Amendments To Address SOFAC	05.10.21
В	Amendments To Address SOFAC	15.07.21
А	Development Application	06.04.2020



Ryleton pty ltd t/as Architex 5888 abn 32 003 315 142 T : 02 9633 M : 0418 402 919 email@architex.com.au www.architex.com.au Level 3, 7K Parkes Street Parramatta NSW 2150 Nominated Architect: Robert Del Pizzo NSW Reg. No. 3972

Project

**APPLICATION** 

DEVELOPMENT

Proposed Mixed Use Development

Project Address

971 Richmond Road, Marsden Park


Client

Title

iDream Property Pty Ltd and C & S Partners Pty Ltd

Site Details 1

Drawn	Scale	Checked
A.S	1:100 @ A3	Checker
Job No	Drawing No.	Issue
2435	52	С

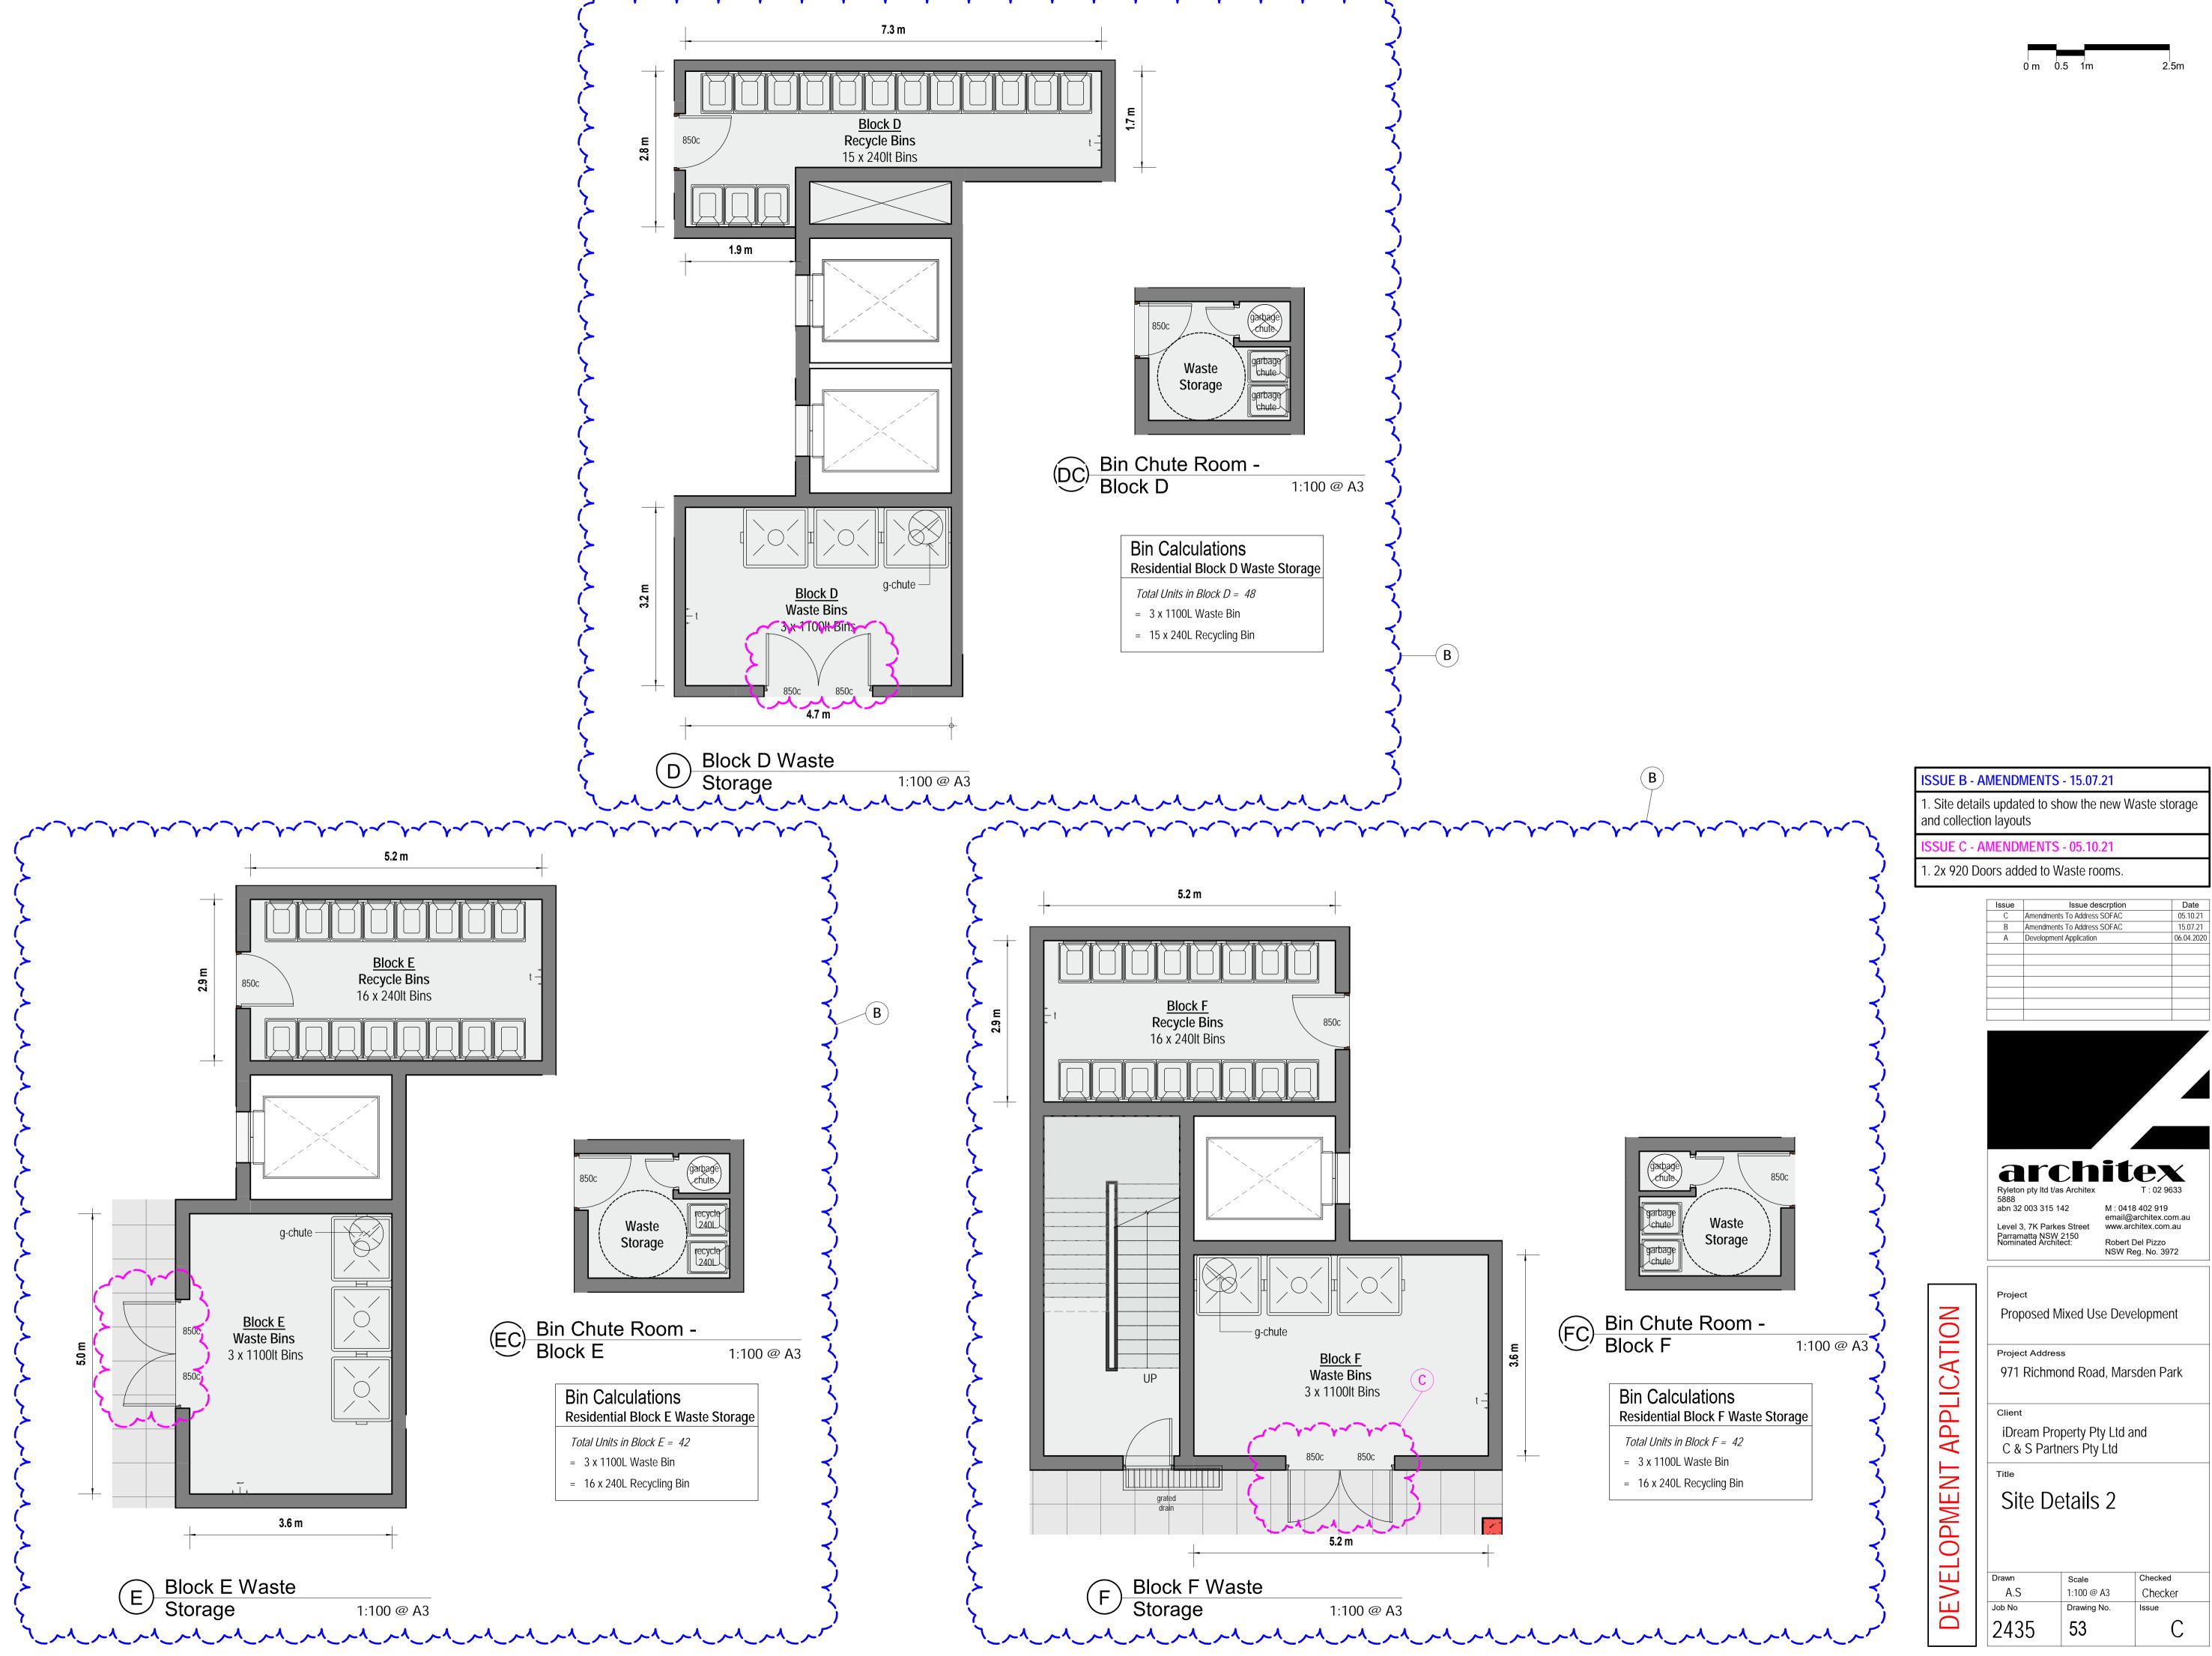



0 m 0.5 1 m

## ISSUE B - AMENDMENTS - 15.07.21 1. New drawing added to set 2. Site details updated to show the new Waste storage and collection layouts SSUE C - AMENDMENTS - 05.10.21 1. Walls within Waste collection area amended 2. Pedestrian Ramp within Waste collection area amended

3. 1.8m wide roller doors added to collection rooms within the Waste collection area

Issue	Issue descrption	Date
В	Amendments To Address SOFAC	05.10.21
А	Amendments To Address SOFAC	15.07.21



Ryleton pty ltd t/as Architex abn 32 003 315 142 Ryleton pty ltd t/as Architex B888 Bab 32 003 315 142 Ryleton pty ltd t/as Architex B888 Bab 32 003 315 142 Ryleton pty ltd t/as Architex B888 Bab 32 003 315 142 Ryleton pty ltd t/as Architex B888 Bab 32 003 315 142 Ryleton pty ltd t/as Architex B888 Bab 32 003 315 142 Ryleton pty ltd t/as Architex B888 Bab 32 003 315 142 Ryleton pty ltd t/as Architex Bab 32 003 315 142 Ryleton pty ltd t/as Architex B100 Ryleton pty lt M : 0418 402 919 email@architex.com.au www.architex.com.au Level 3, 7K Parkes Street Parramatta NSW 2150 Nominated Architect: Robert Del Pizzo NSW Reg. No. 3972

### Project

APPLICATION

DEVELOPMENT

Proposed Mixed Use Development

Project Address

971 Richmond Road, Marsden Park

## Client


Title

iDream Property Pty Ltd and C & S Partners Pty Ltd

Site Details 3

	Issue
ker	Checker
ed	Checked
	Checke

18.6

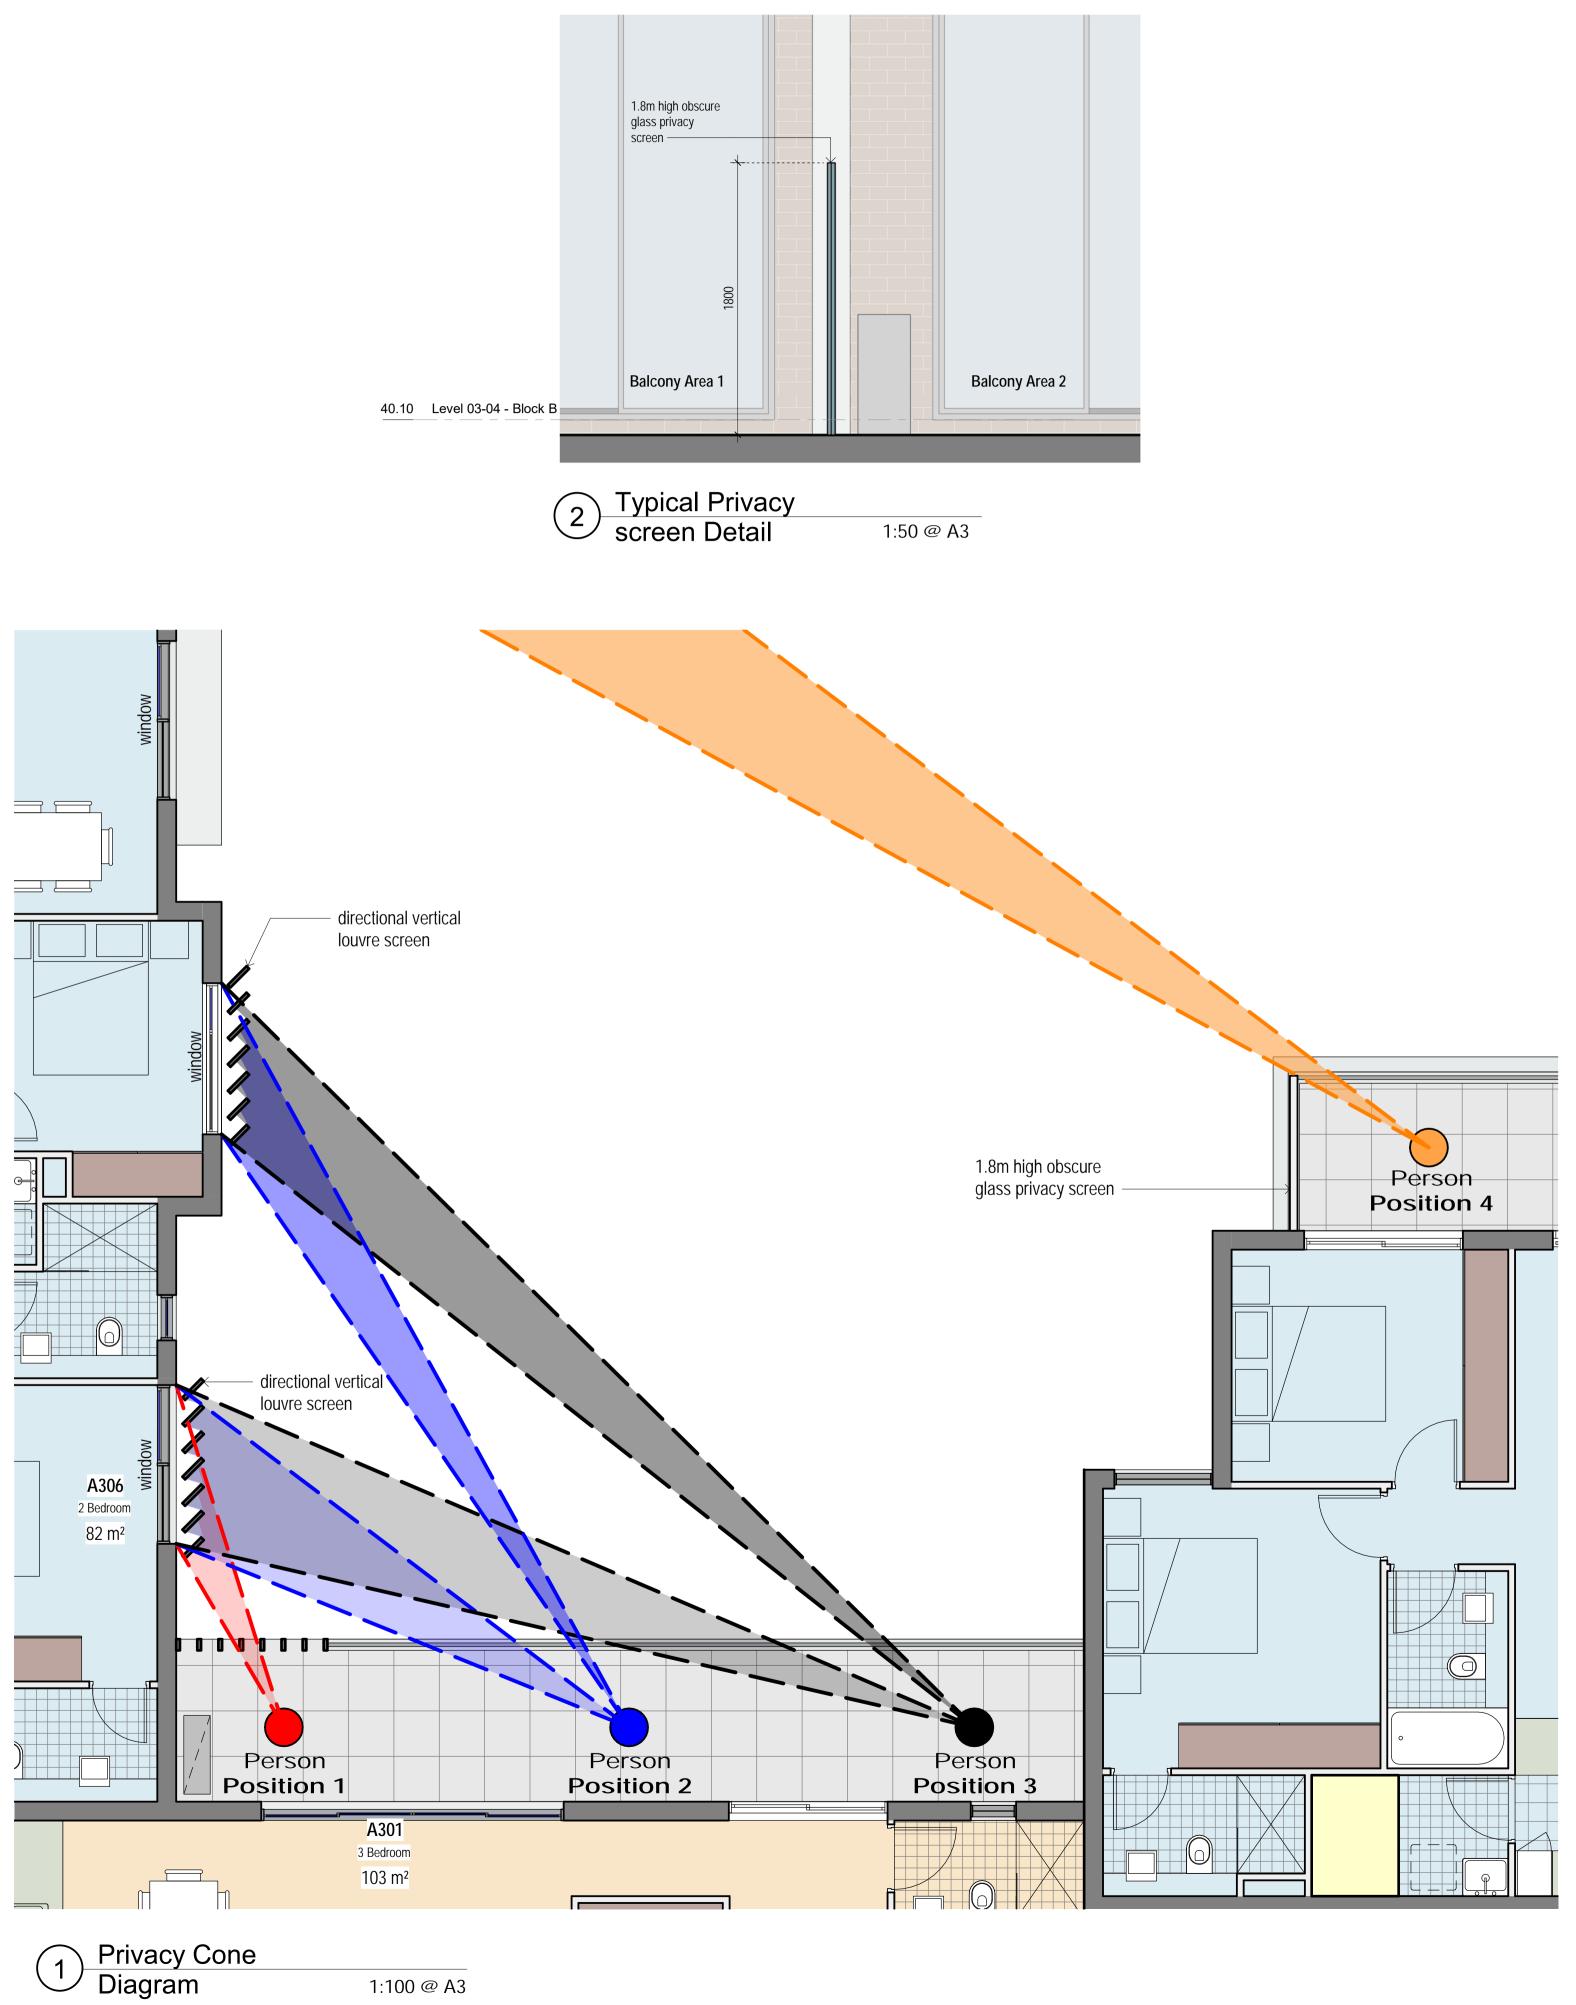

0 m	0.5	1m	2.5m

1. New drawing added to set

2. Privacy cone diagrams show measures taken to ensure privacy between bridging unit balconies and adjacent unit windows

Issue	Issue descrption	Date
А	Amendments To Address SOFAC	15.07.21





Level 3, 7K Parkes Street Parramatta NSW 2150 Nominated Architect:

M : 0418 402 919 email@architex.com.au www.architex.com.au Robert Del Pizzo NSW Reg. No. 3972

#### Project

Proposed Mixed Use Development

Project Address

971 Richmond Road, Marsden Park

### Client


Title

DEVELOPMENT APPLICATION

iDream Property Pty Ltd and C & S Partners Pty Ltd


# Site Details 4 Privacy Cone Diagram


Drawn	Scale	Checked
A.S	1:100 @ A3	Checker
Job No	Drawing No.	Issue
2435	53b	А

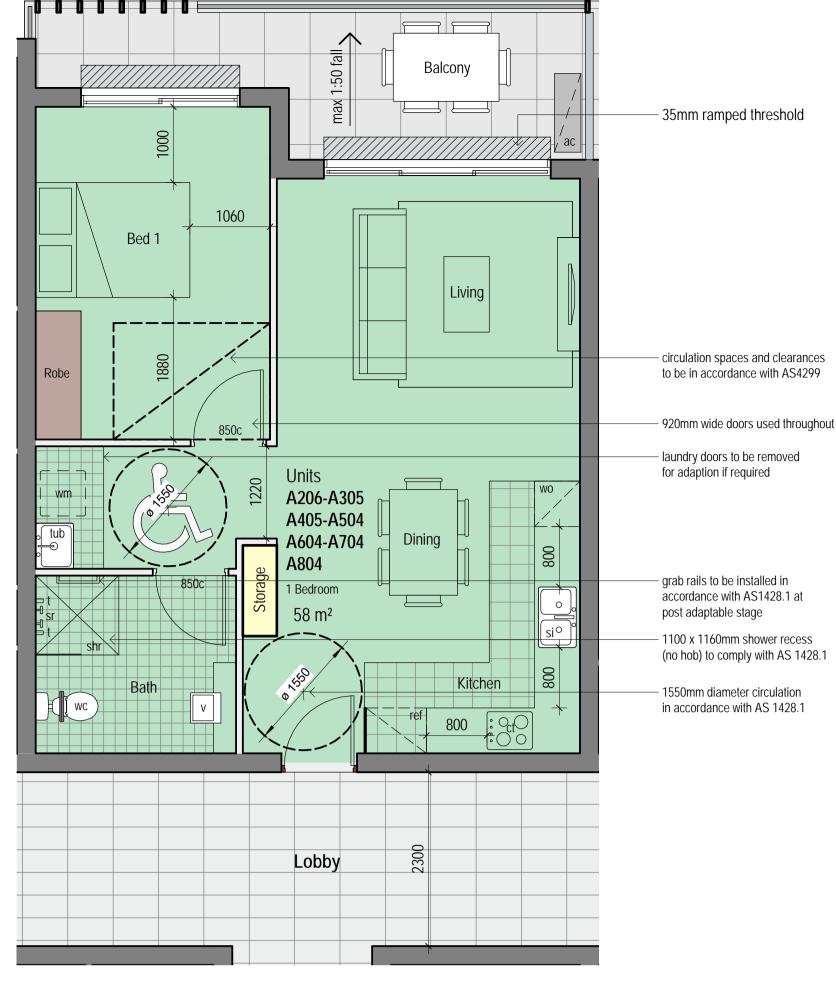

Post Adaptable Typical Unit Layout - Block A

1:100 @ A3

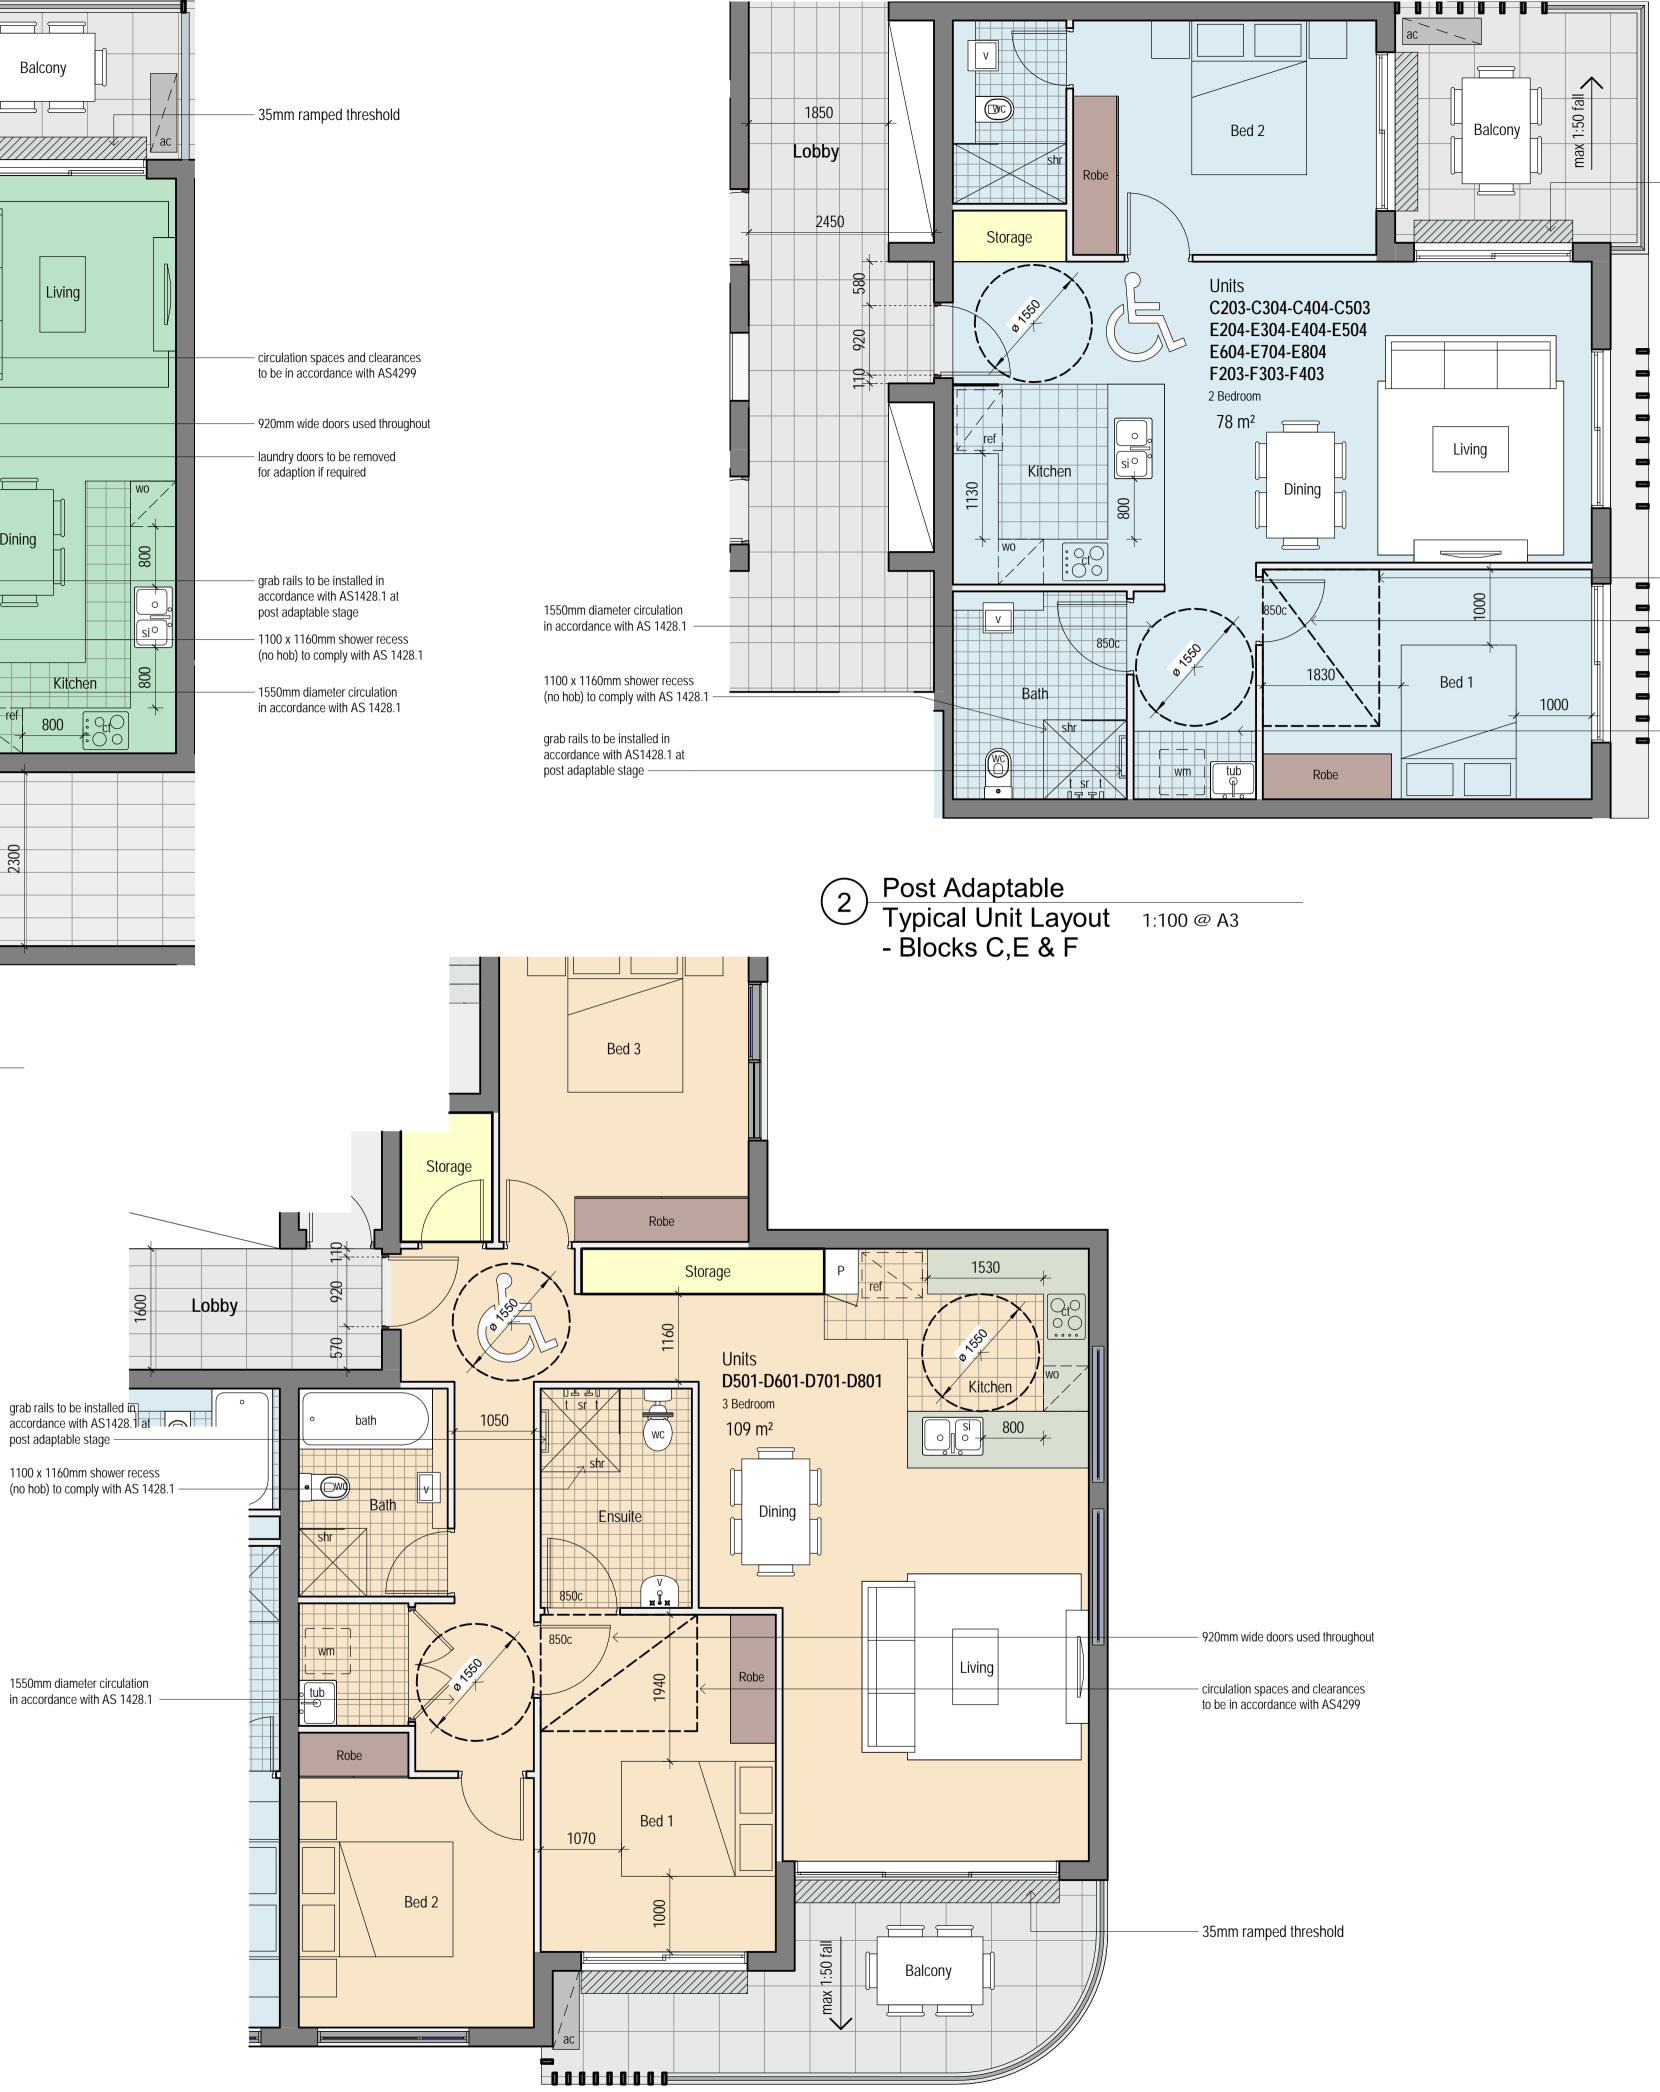


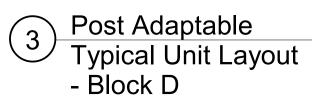

35mm ramped threshold

circulation spaces and clearances to be in accordance with AS4299 920mm wide doors used throughout

laundry doors to be removed for adaption if required

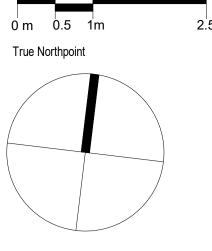

Do not scale, check and verify all dimensions before commencing new work, ground levels may vary due to site conditions.

POST ADAPTABLE NOTES:

General Notes

- 35mm ramped threshold to external sliding doors
- all floor surfaces to be slip resistant in accordance with AS/NZS 3661.1

 door openings to be positioned in wall to allow circulation adjacent to the doorway in accordance with AS1428.1- 2009 Electrical Notes

- Hot Water System to deliver hot water at a
- maximum of 50° in accordance with AS4299
- electrical distribution board to be located within the
- unit and be accessible - allow for illumination levels in accordance with AS4299
- switch and power points to be located in accordance AS4299 - a telephone outlet to be provided in the lounge/dining

area adjacent to a G.P.O Laundry Notes

laundry tub dimension and height to comply with AS 4299.
taps to be provided at side of laundry tub

- provide double G.P.O Bathroom Notes

- selected slip resistant ceramic floor tiles

laid to fall on screed, provide waterproof membrane

in accordance with AS 3740 1994 - tap sets to be capstan or lever handles with single outlet locate toilet paper holder in accordance with AS 1428.1- 2009

- accessible toilet in accordance with AS 1428.1- 2009

- provide for adjustable, detachable hand held shower

rose mounted on a slider grab rail. clearance and heights to be in accordance with AS1428.1-2009

- vanity clearance to comply with AS 1428.1- 2009

Kitchen Notes

- kitchen sink bowl 150mm deep max
   sink & adjacent work space to be adjustable
   in height (750-850mm) or replaceable
- install floor/wall tiling under & behind

removable/adjustable kitchen benches - tap set shall be capstan or lever handles or lever mix

- cook tops to include either front or
- side controls with raised cross bars
- cook tops to include isolating switch

- tap set located within 300mm of front of sink

- provision to be made for a microwave shelf to be installed or replaced at nay height between 750mm

and 1200mm.

Issue	Issue descrption	Date
А	Development Application	06.04.2020



architex Ryleton pty ltd t/as Architex 5888 T : 02 9633 abn 32 003 315 142 M : 0418 402 919

Level 3, 7K Parkes Street Parramatta NSW 2150 Nominated Architect:

email@architex.com.au www.architex.com.au Robert Del Pizzo NSW Reg. No. 3972

Project

Proposed Mixed Use Development

Project Address

971 Richmond Road, Marsden Park

Client


iDream Property Pty Ltd and C & S Partners Pty Ltd

Title

Post-Adaptable Layouts

Drawn	Scale	Checked
A.S	1:100 @ A3	Checker
Job No	Drawing No.	Issue
2435	54	А

**APPLICATION** DEVELOPMENT

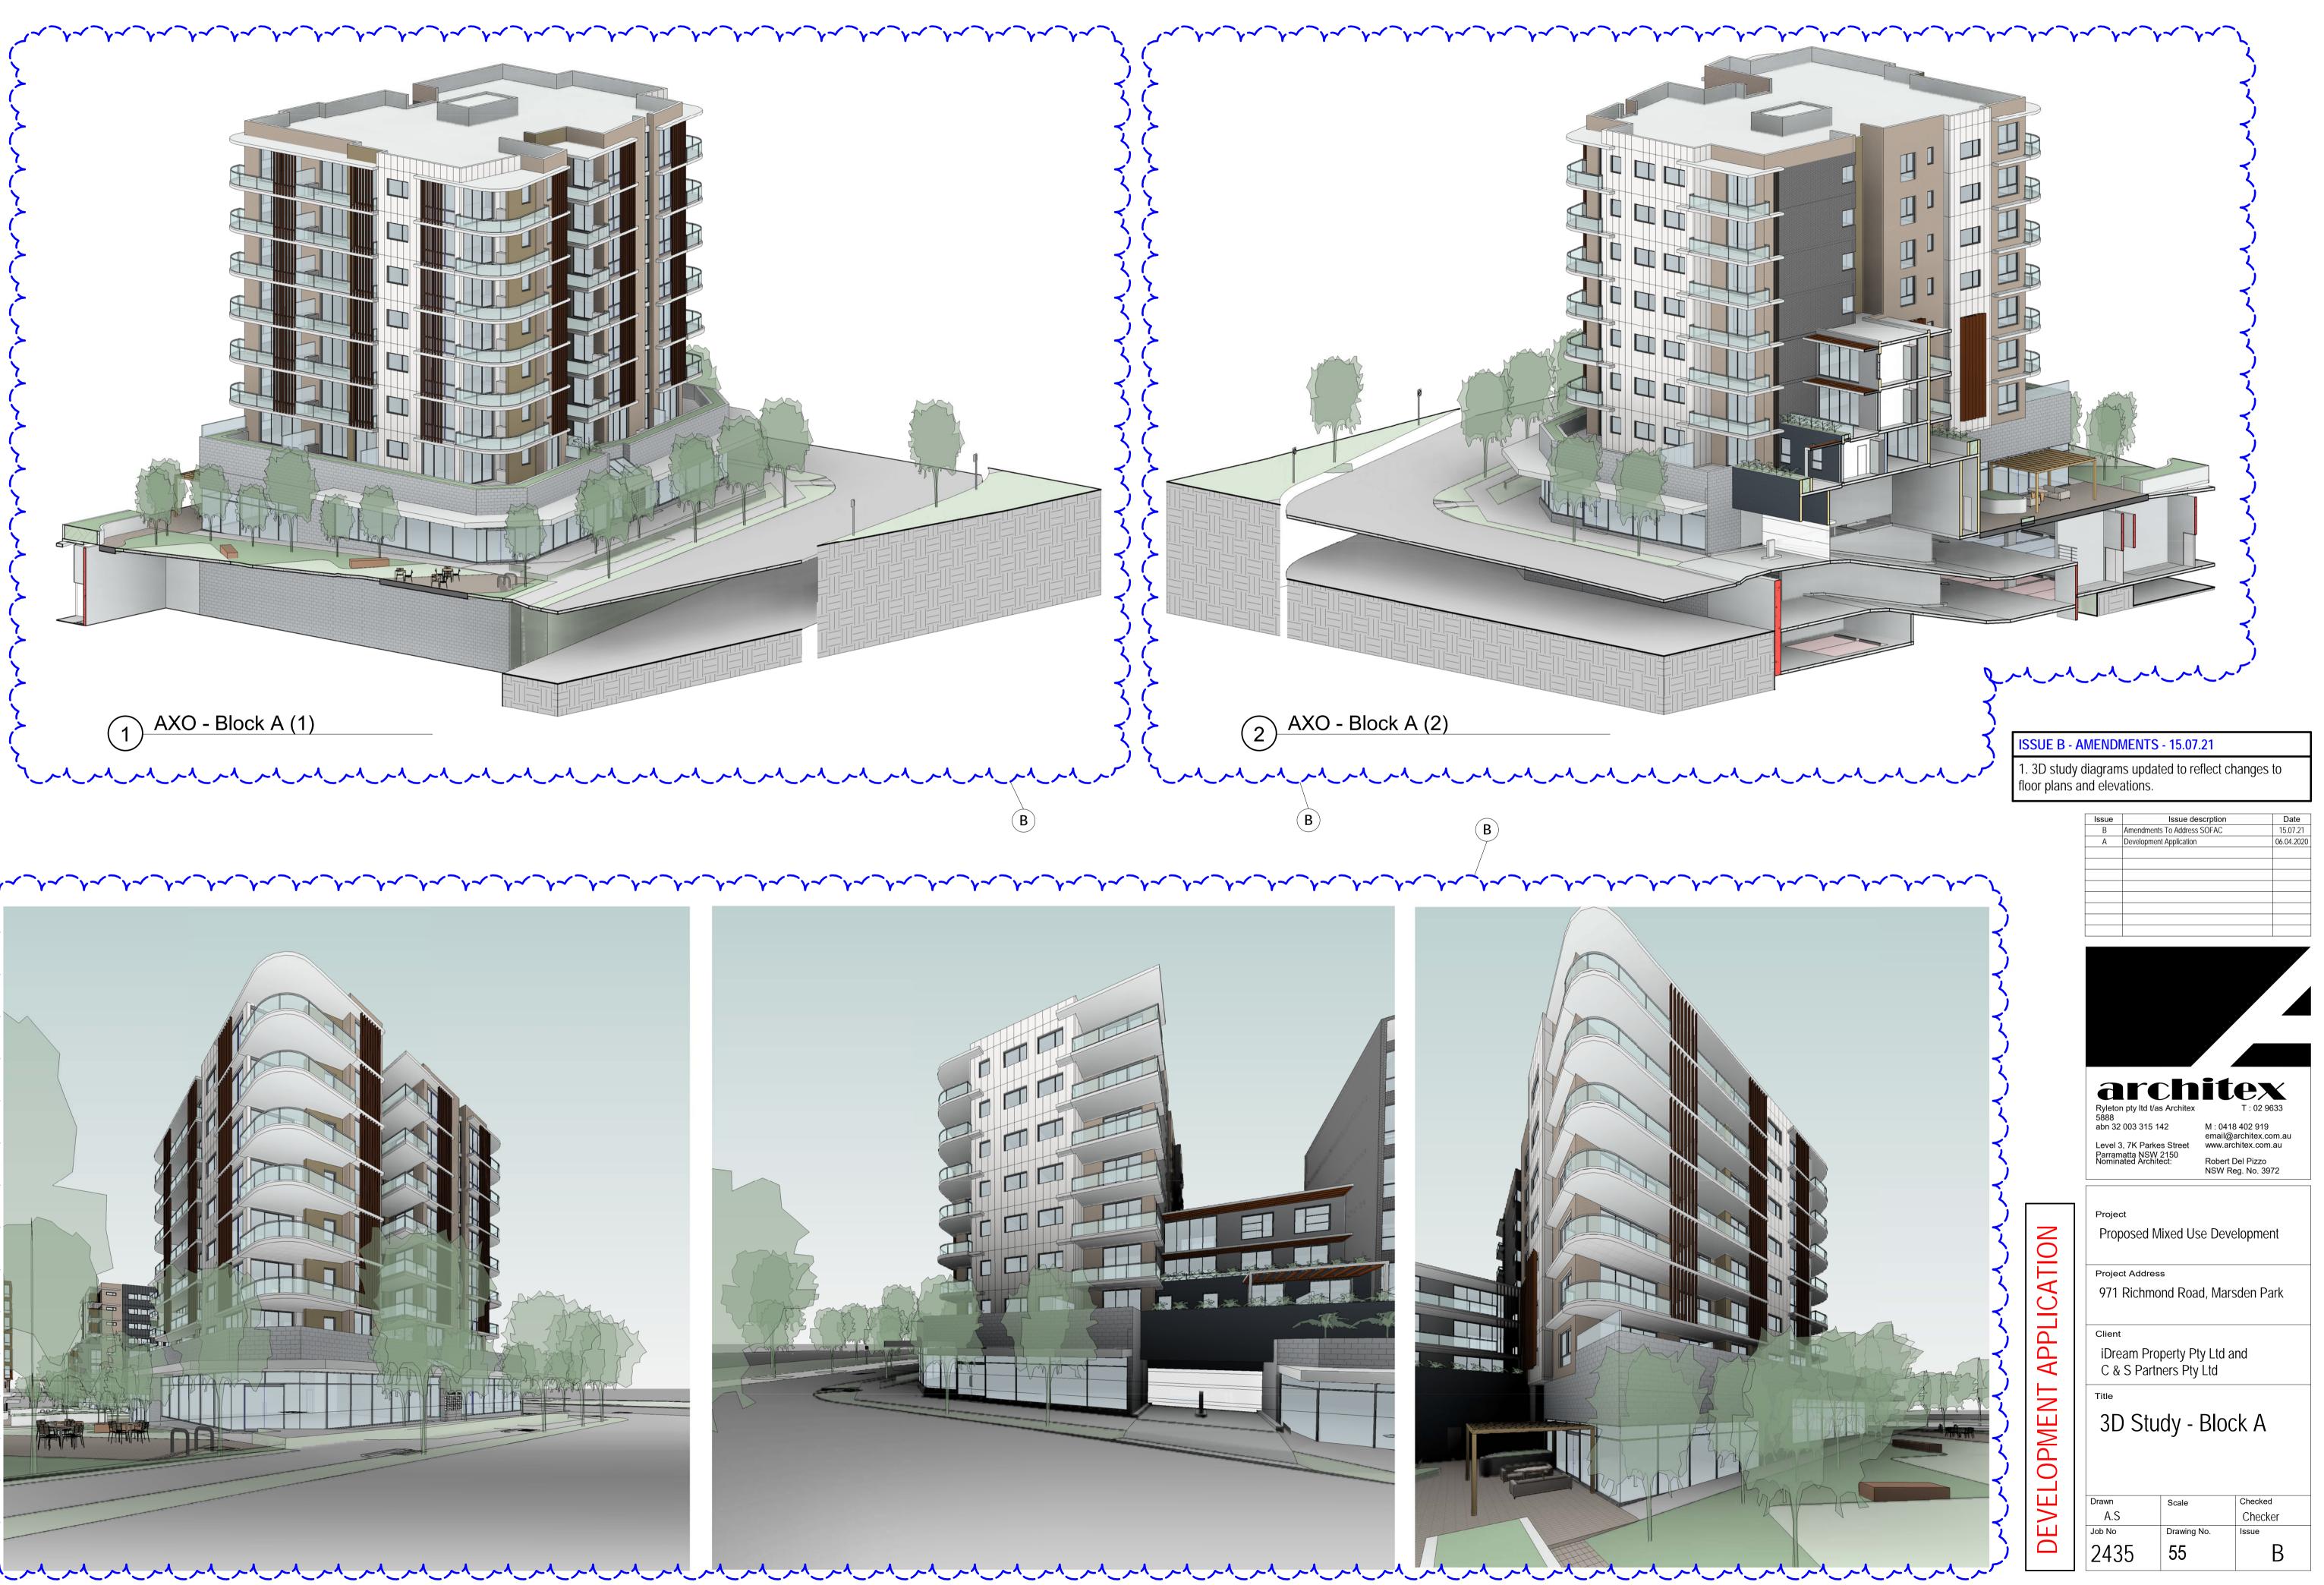














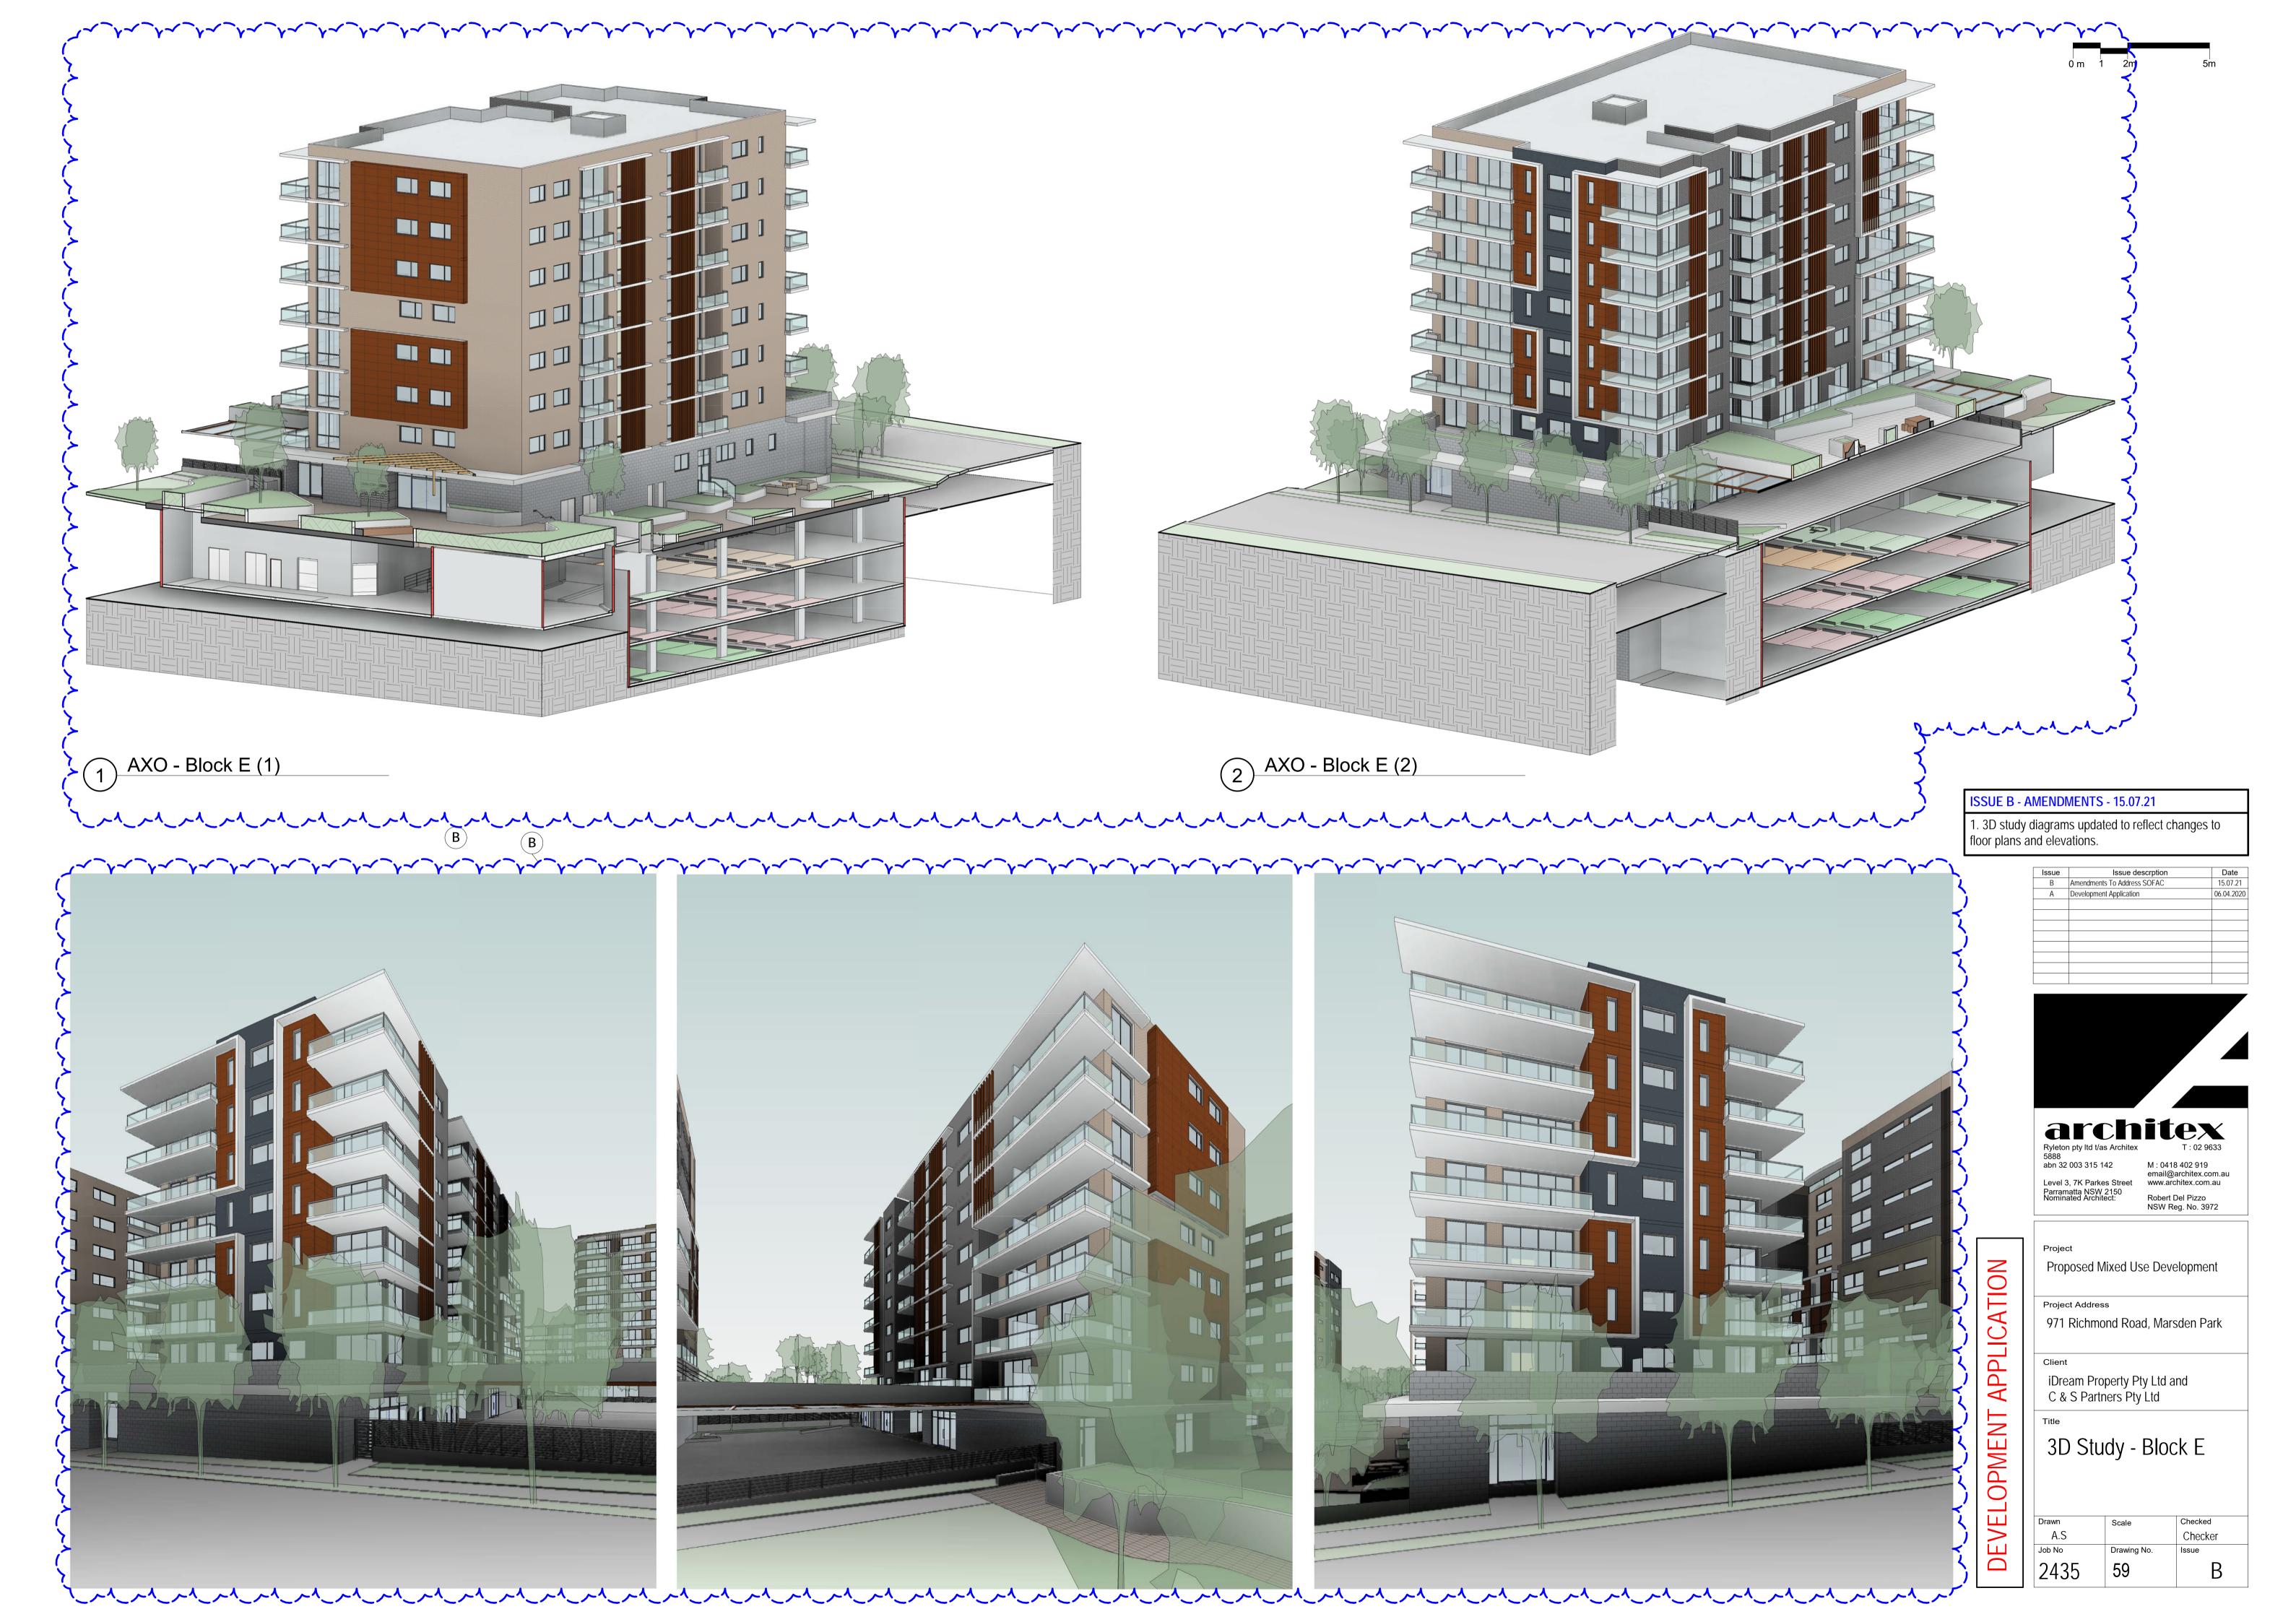







1. 3D study diagrams updated to reflect changes to floor plans and elevations.

Issue	Issue descrption	Date
В	Amendments To Address SOFAC	15.07.21
А	Development Application	06.04.2020



Ryleton pty ltd t/as Architex 5888 abn 32 003 315 142 T : 02 9633 Level 3, 7K Parkes Street Nominated Architect: Nomi

Robert Del Pizzo NSW Reg. No. 3972

## Project

DEVELOPMENT APPLICATION

Proposed Mixed Use Development

Project Address

2435

971 Richmond Road, Marsden Park

Client			
iDream Pro	perty Pty Ltd a	nd	
C & S Partr	ers Pty Ltd		
Title			
3D - Overalls			
Drawn	Scale	Checked	
A.S		Checker	
Job No	Drawing No.	Issue	

61

В







Issue	Issue descrption	Date
В	Amendments To Address SOFAC	15.07.21
А	Development Application	06.04.2020


Drawn	Scale	Checked
A.S		Checker
Job No	Drawing No.	Issue
2435	62	В




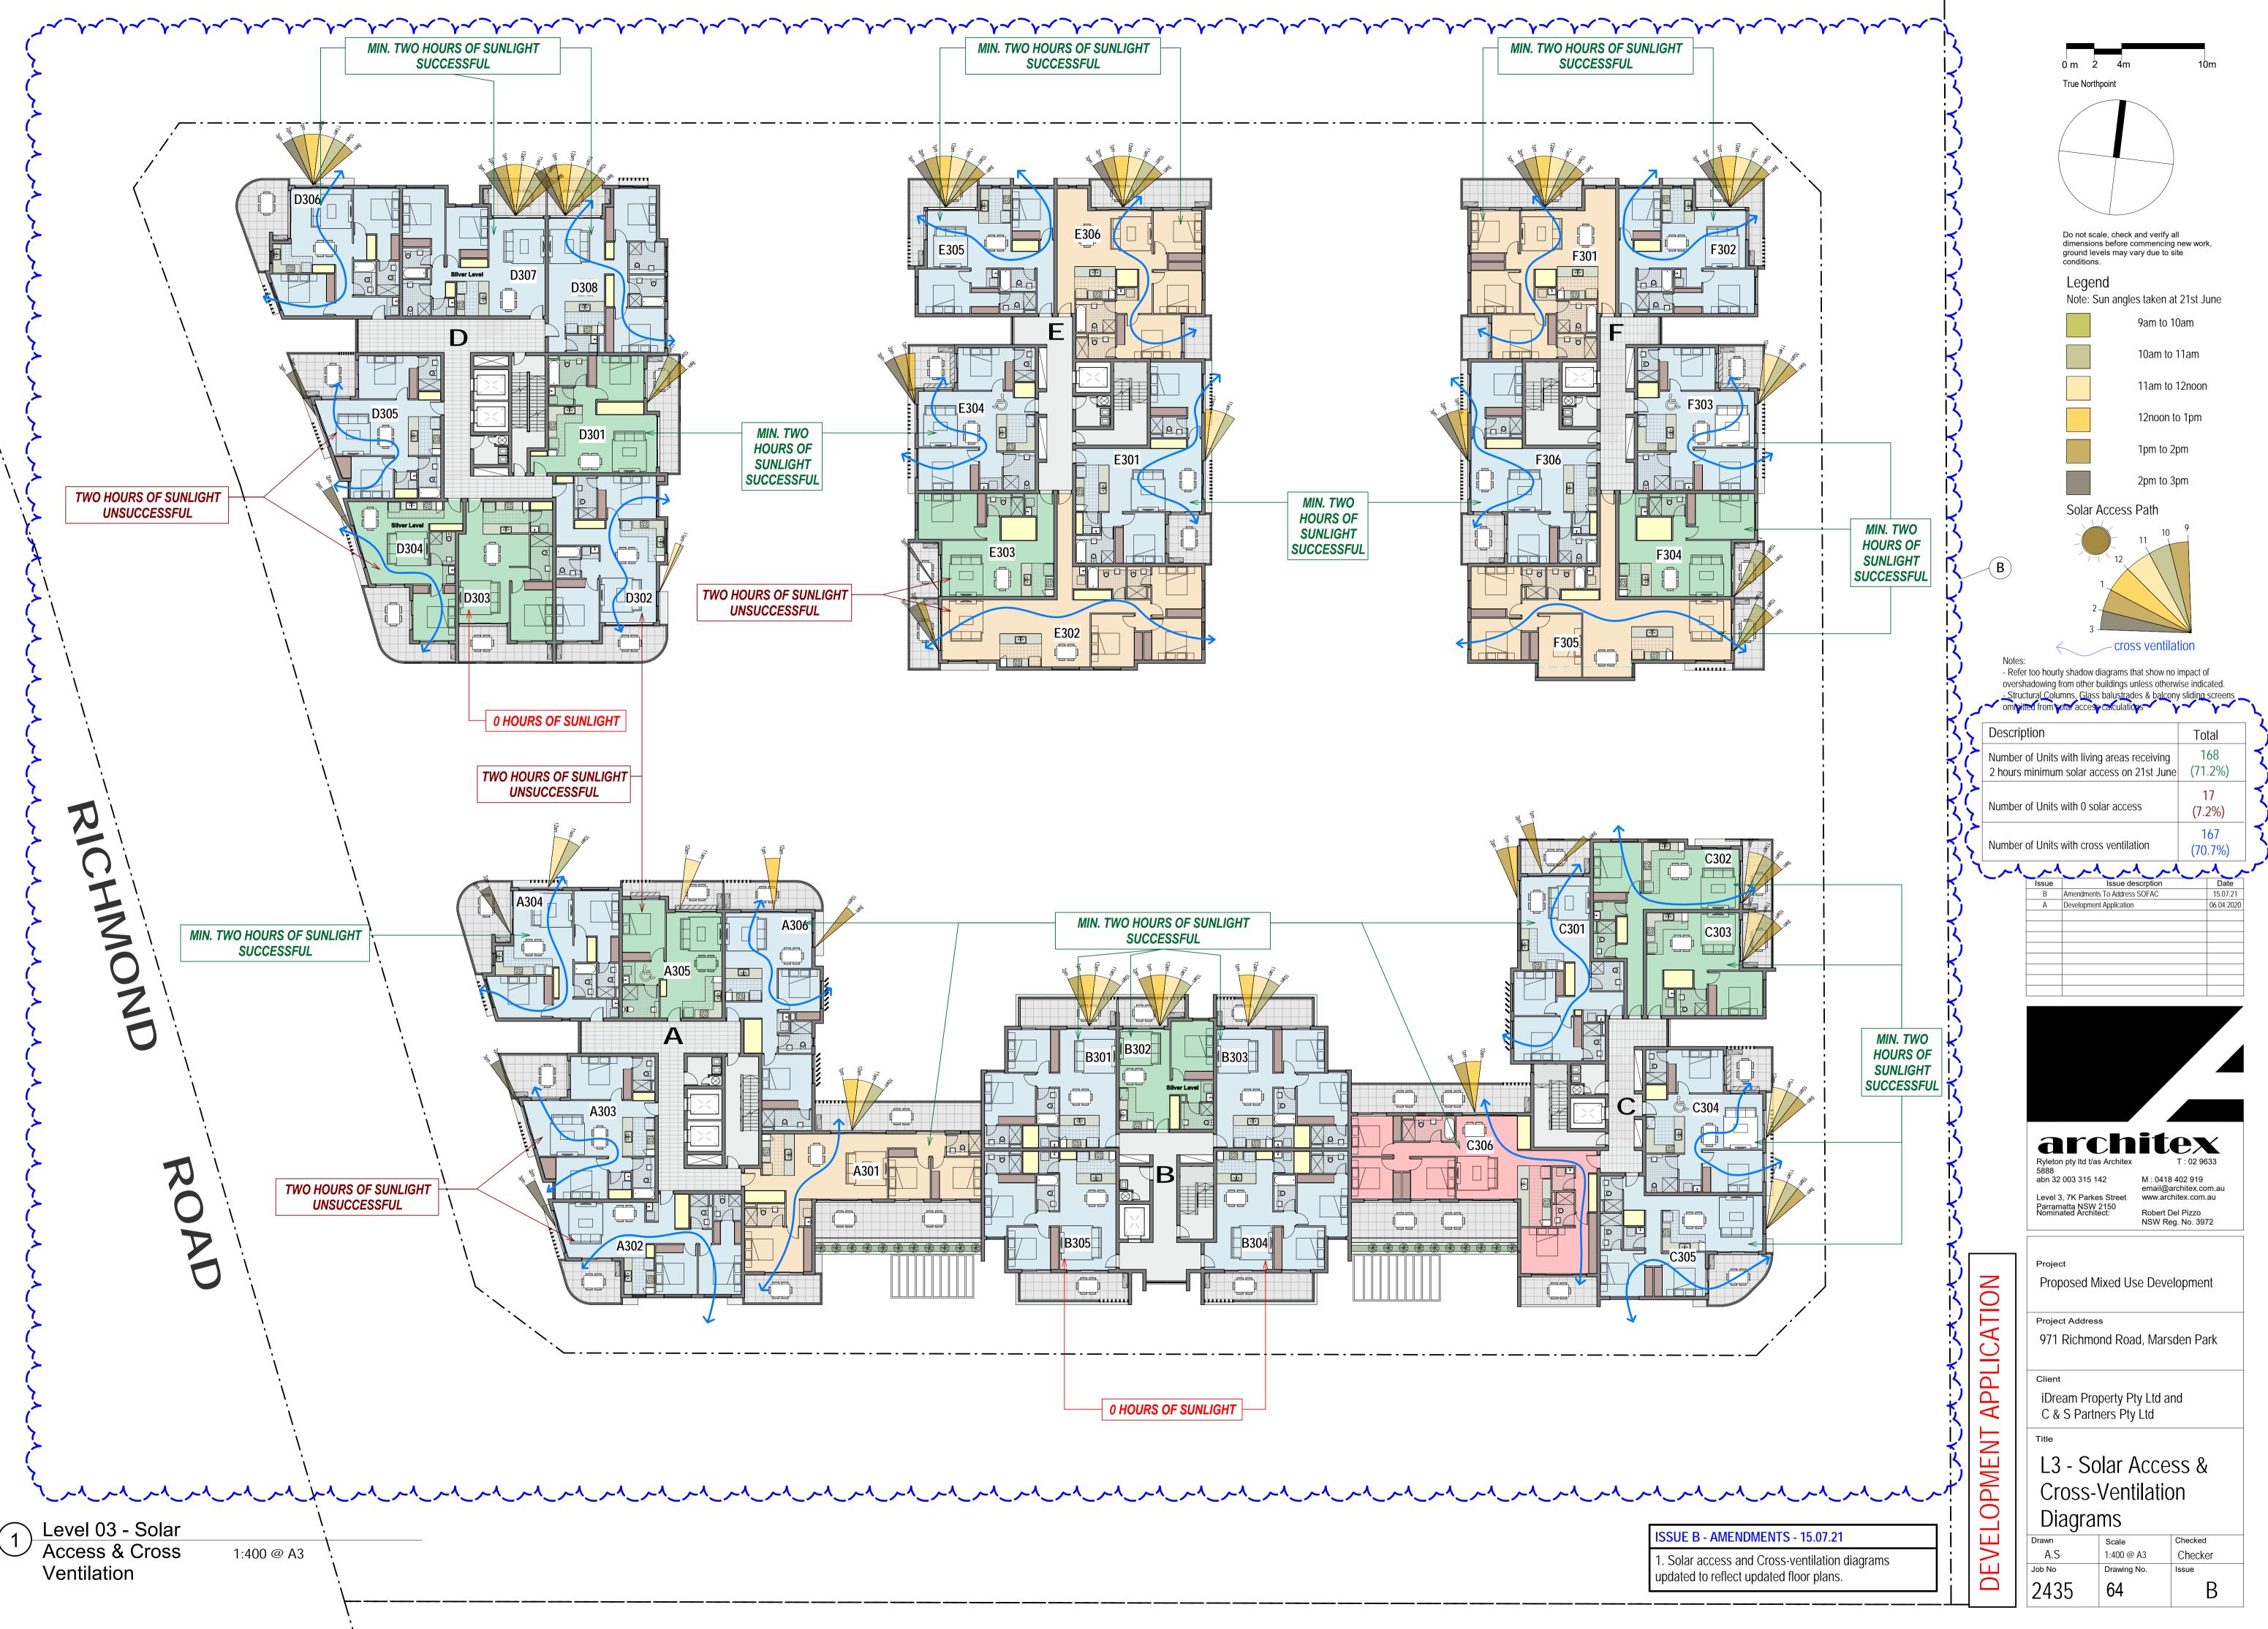




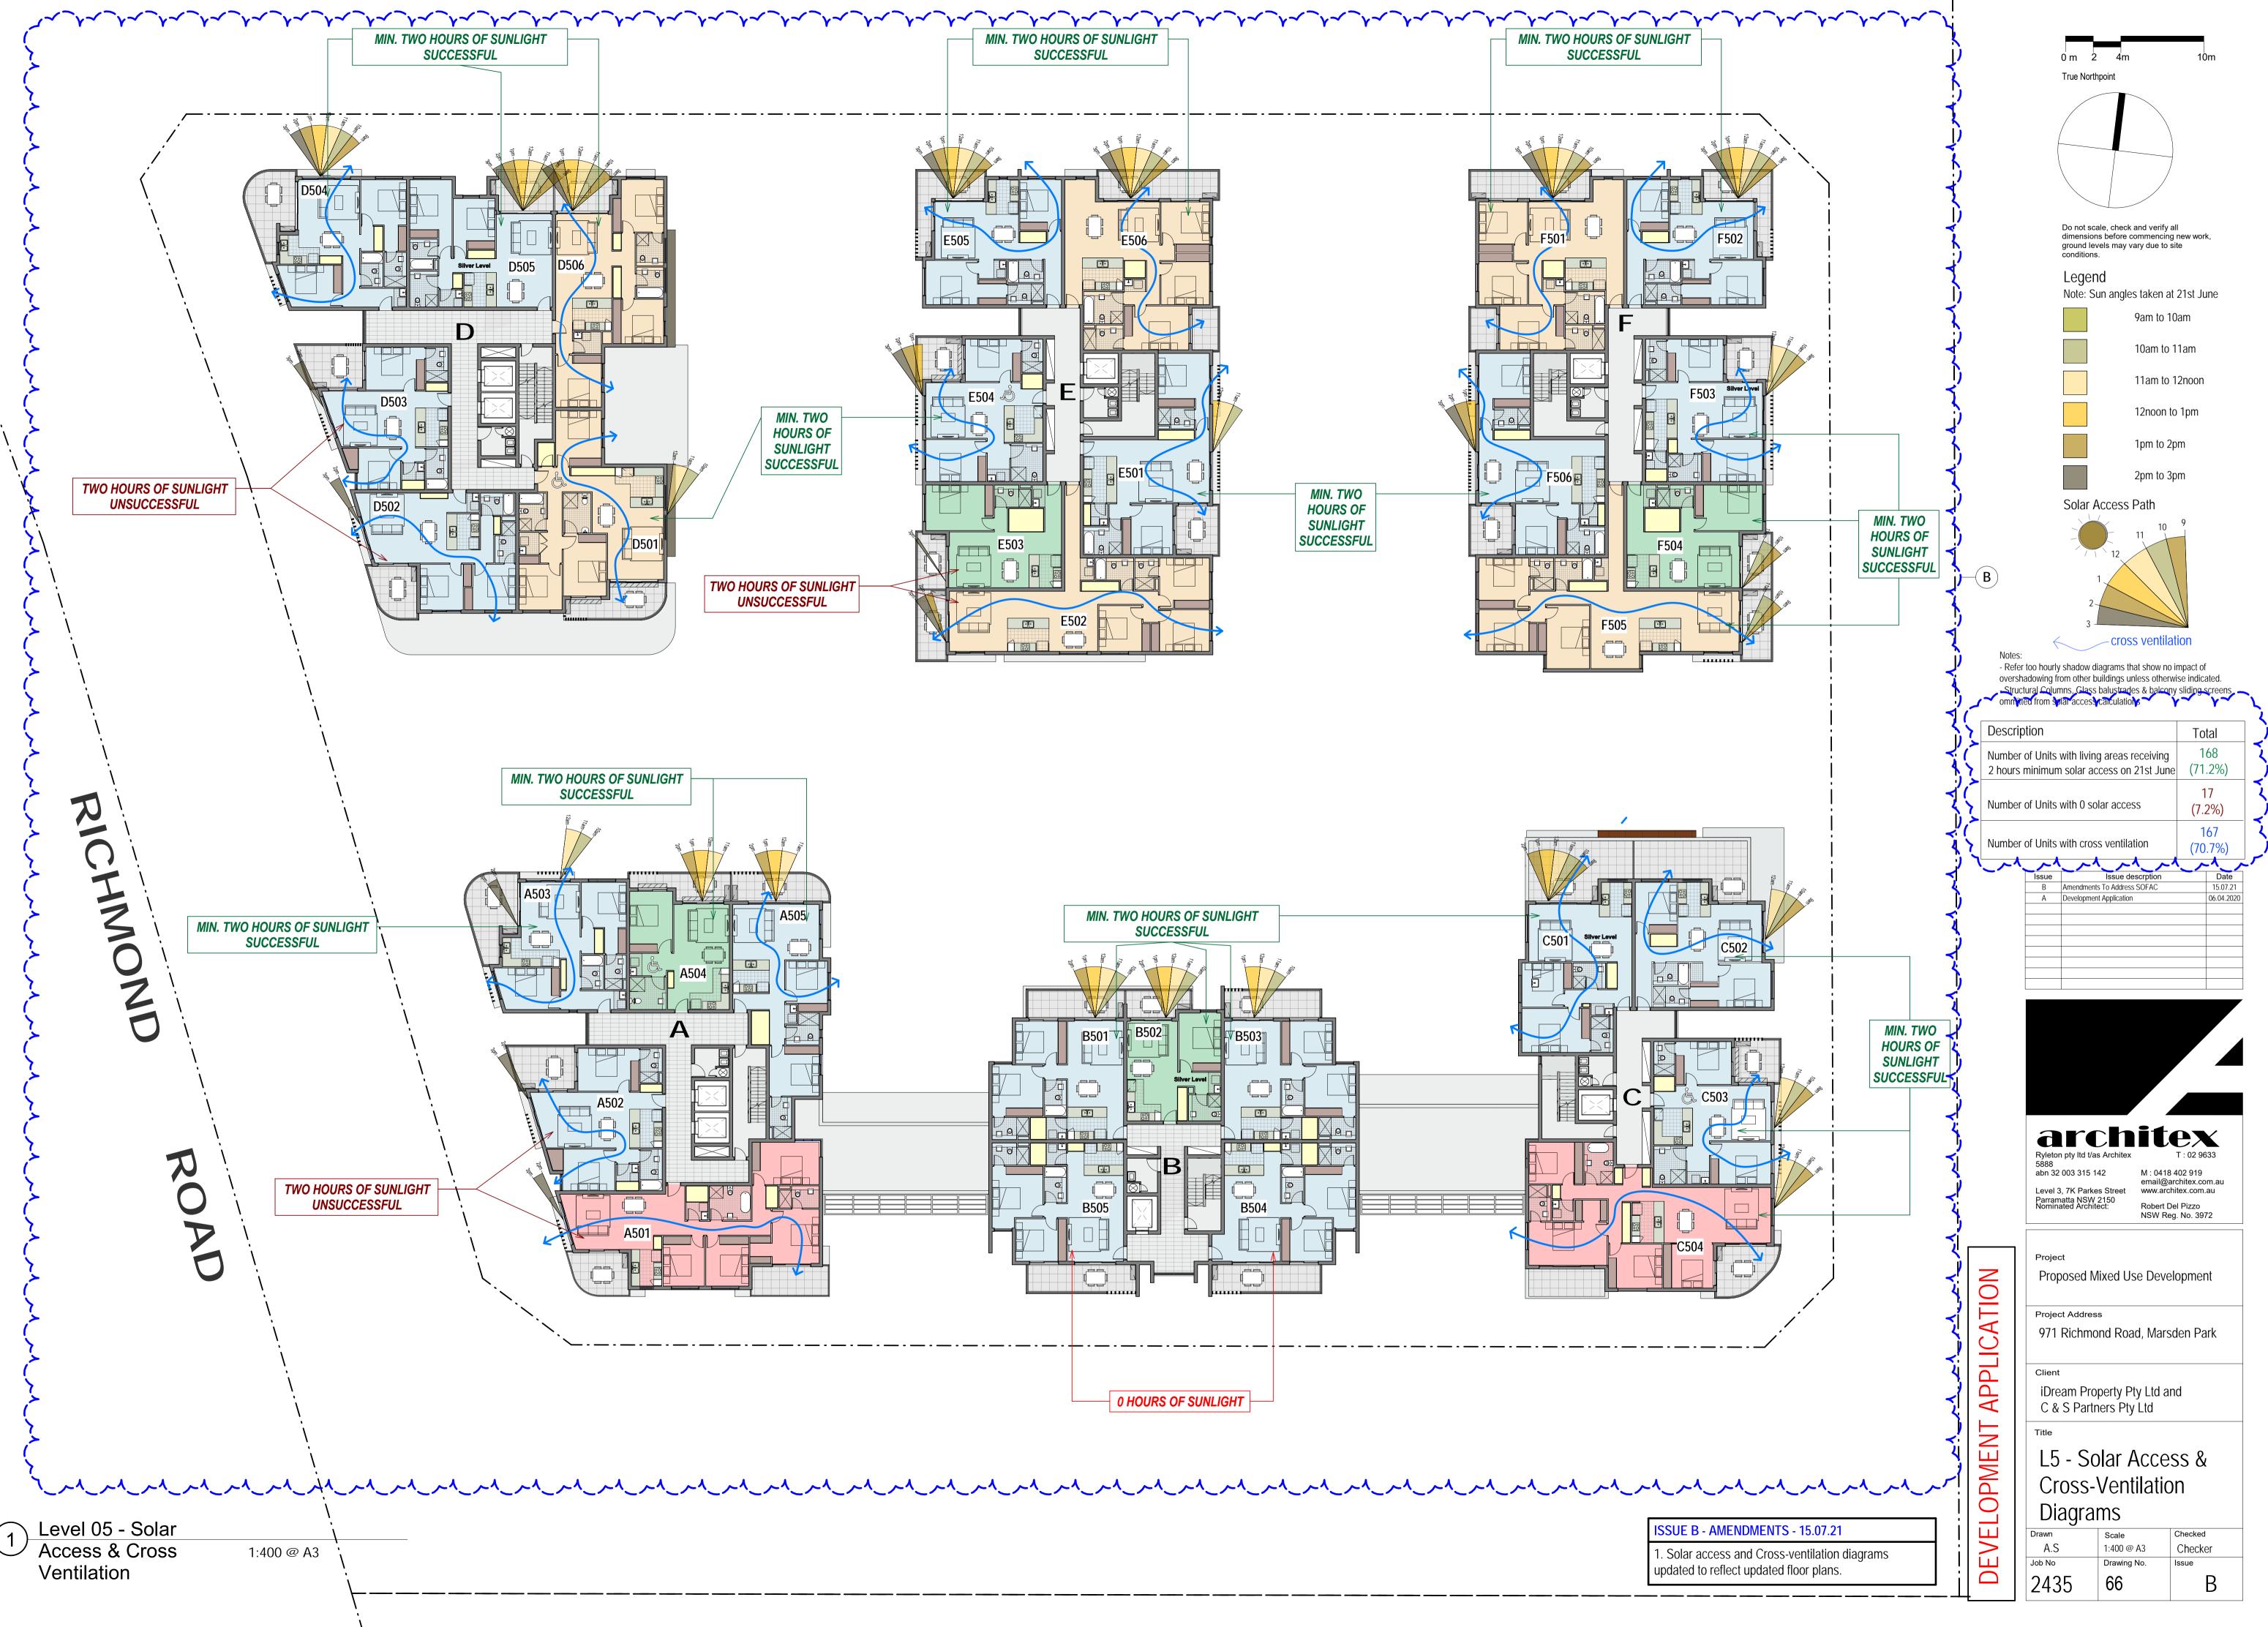

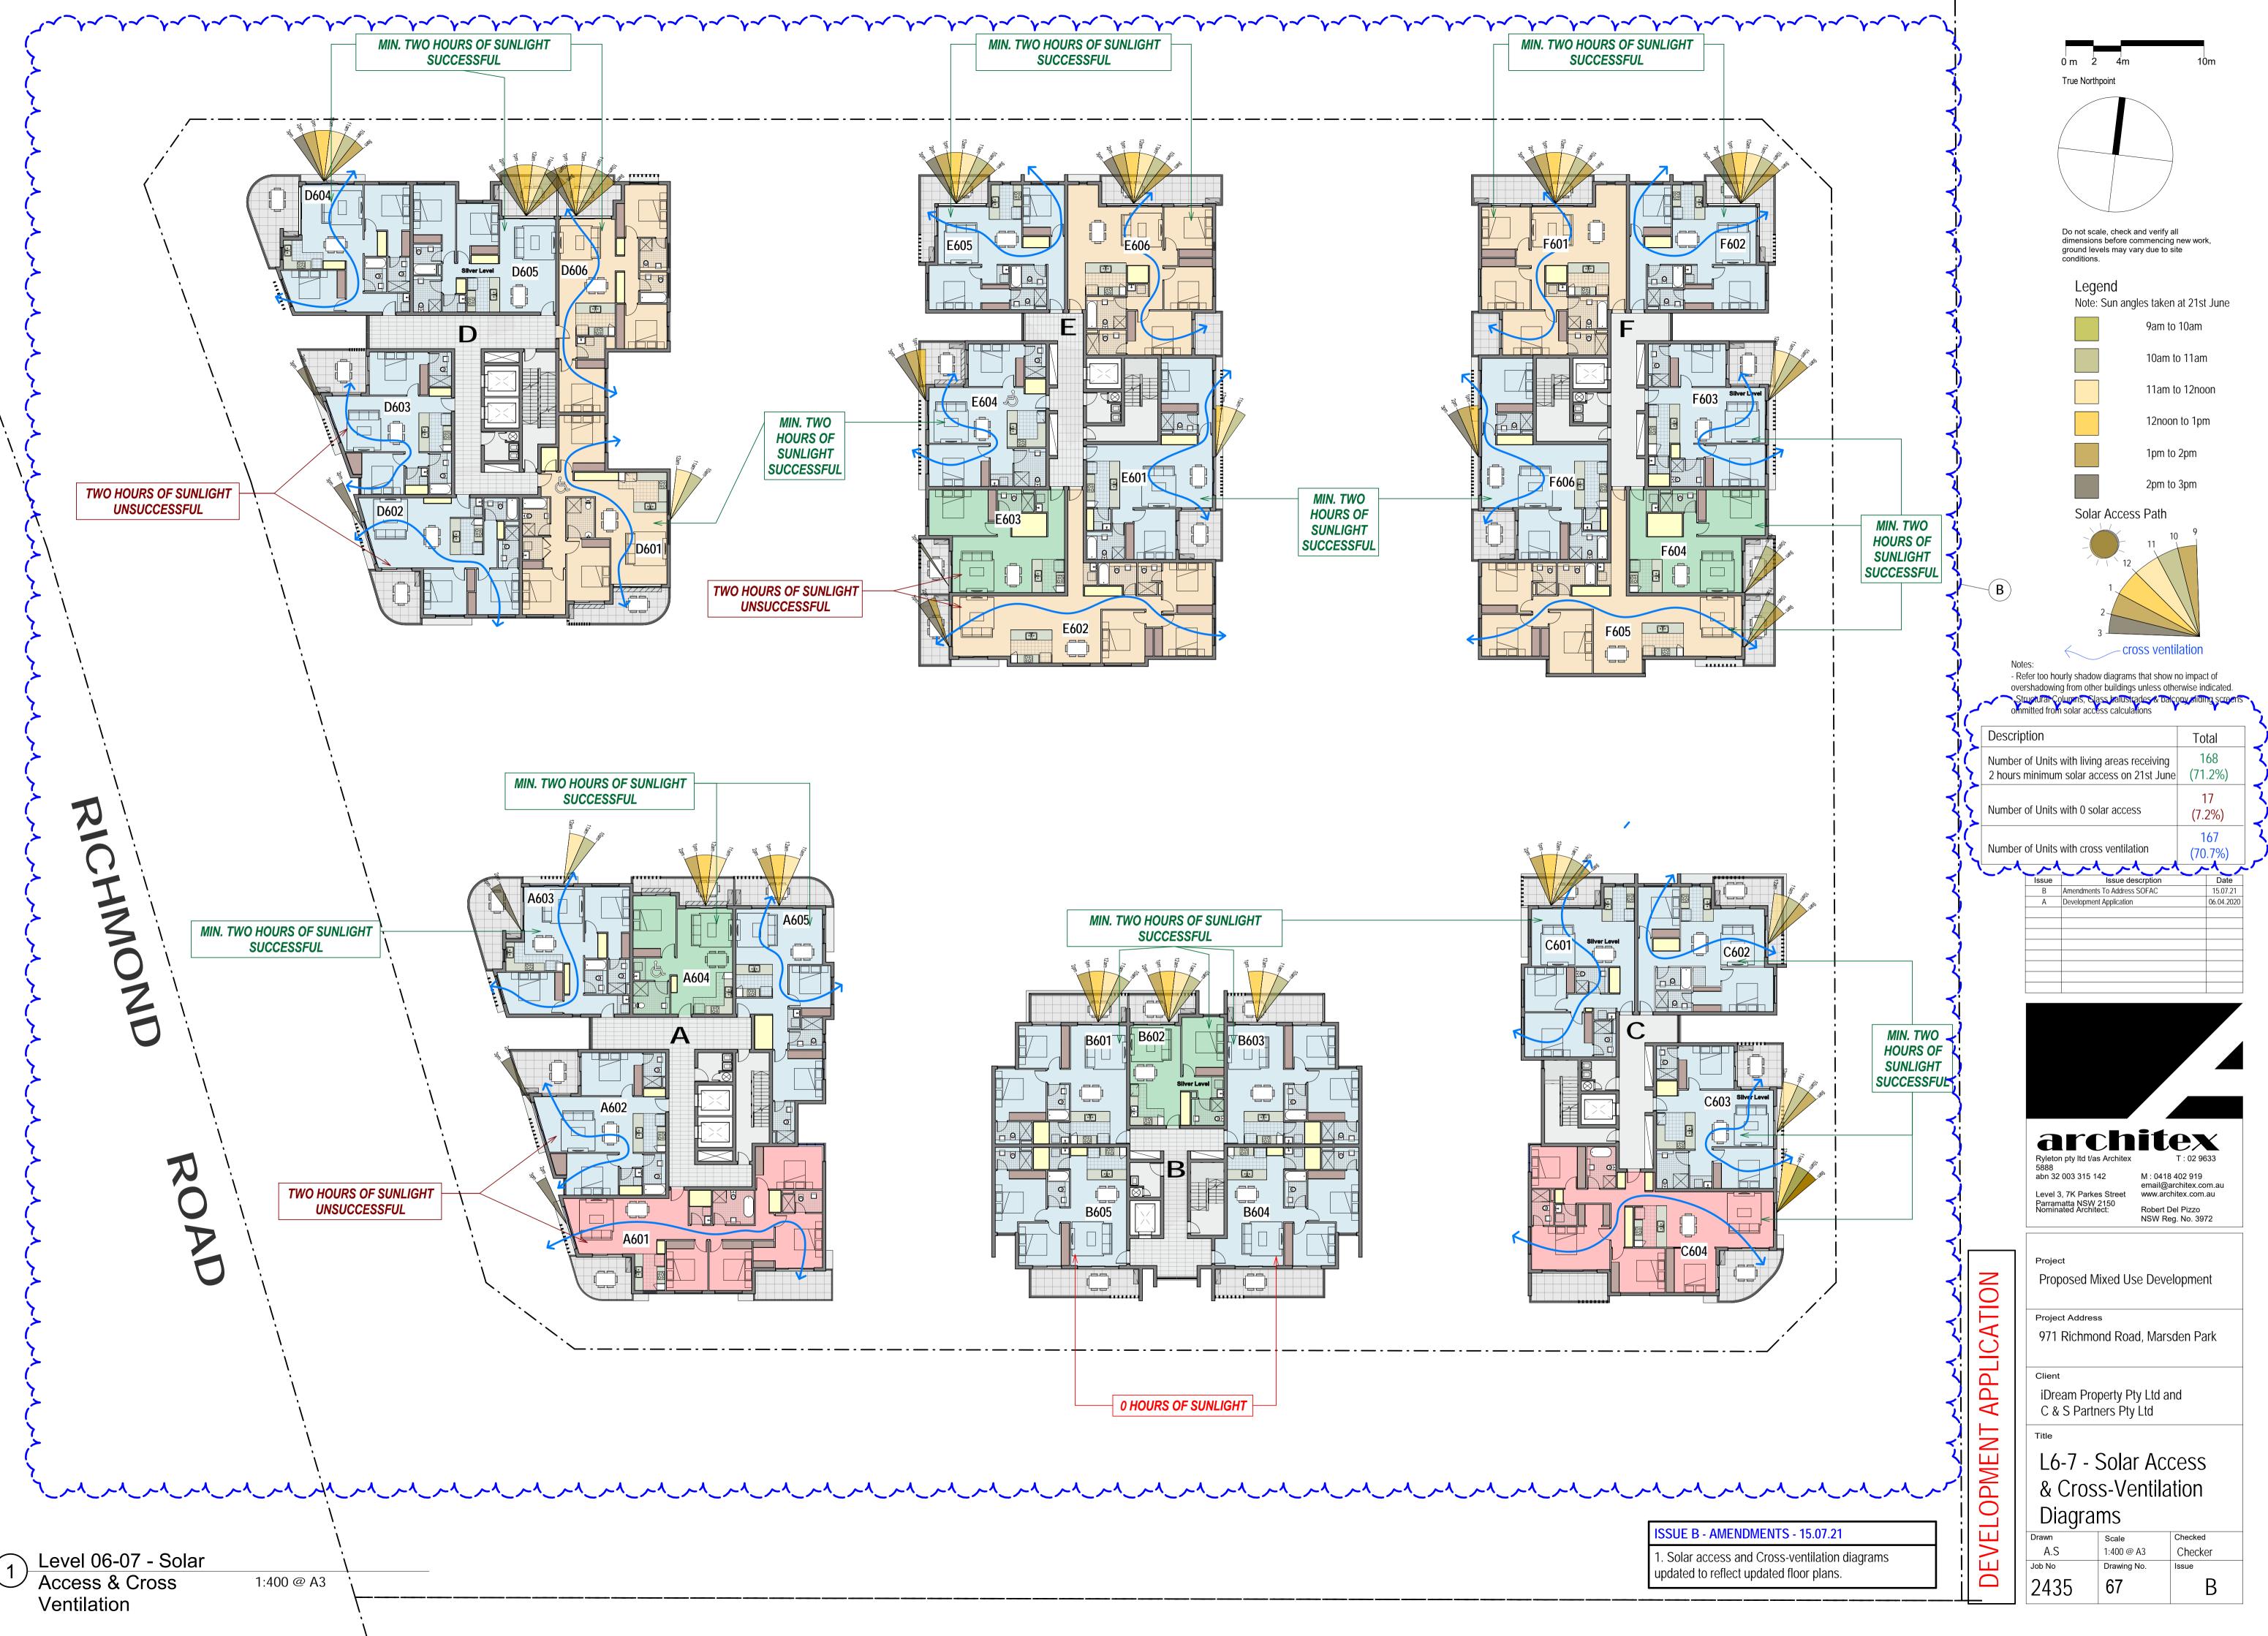

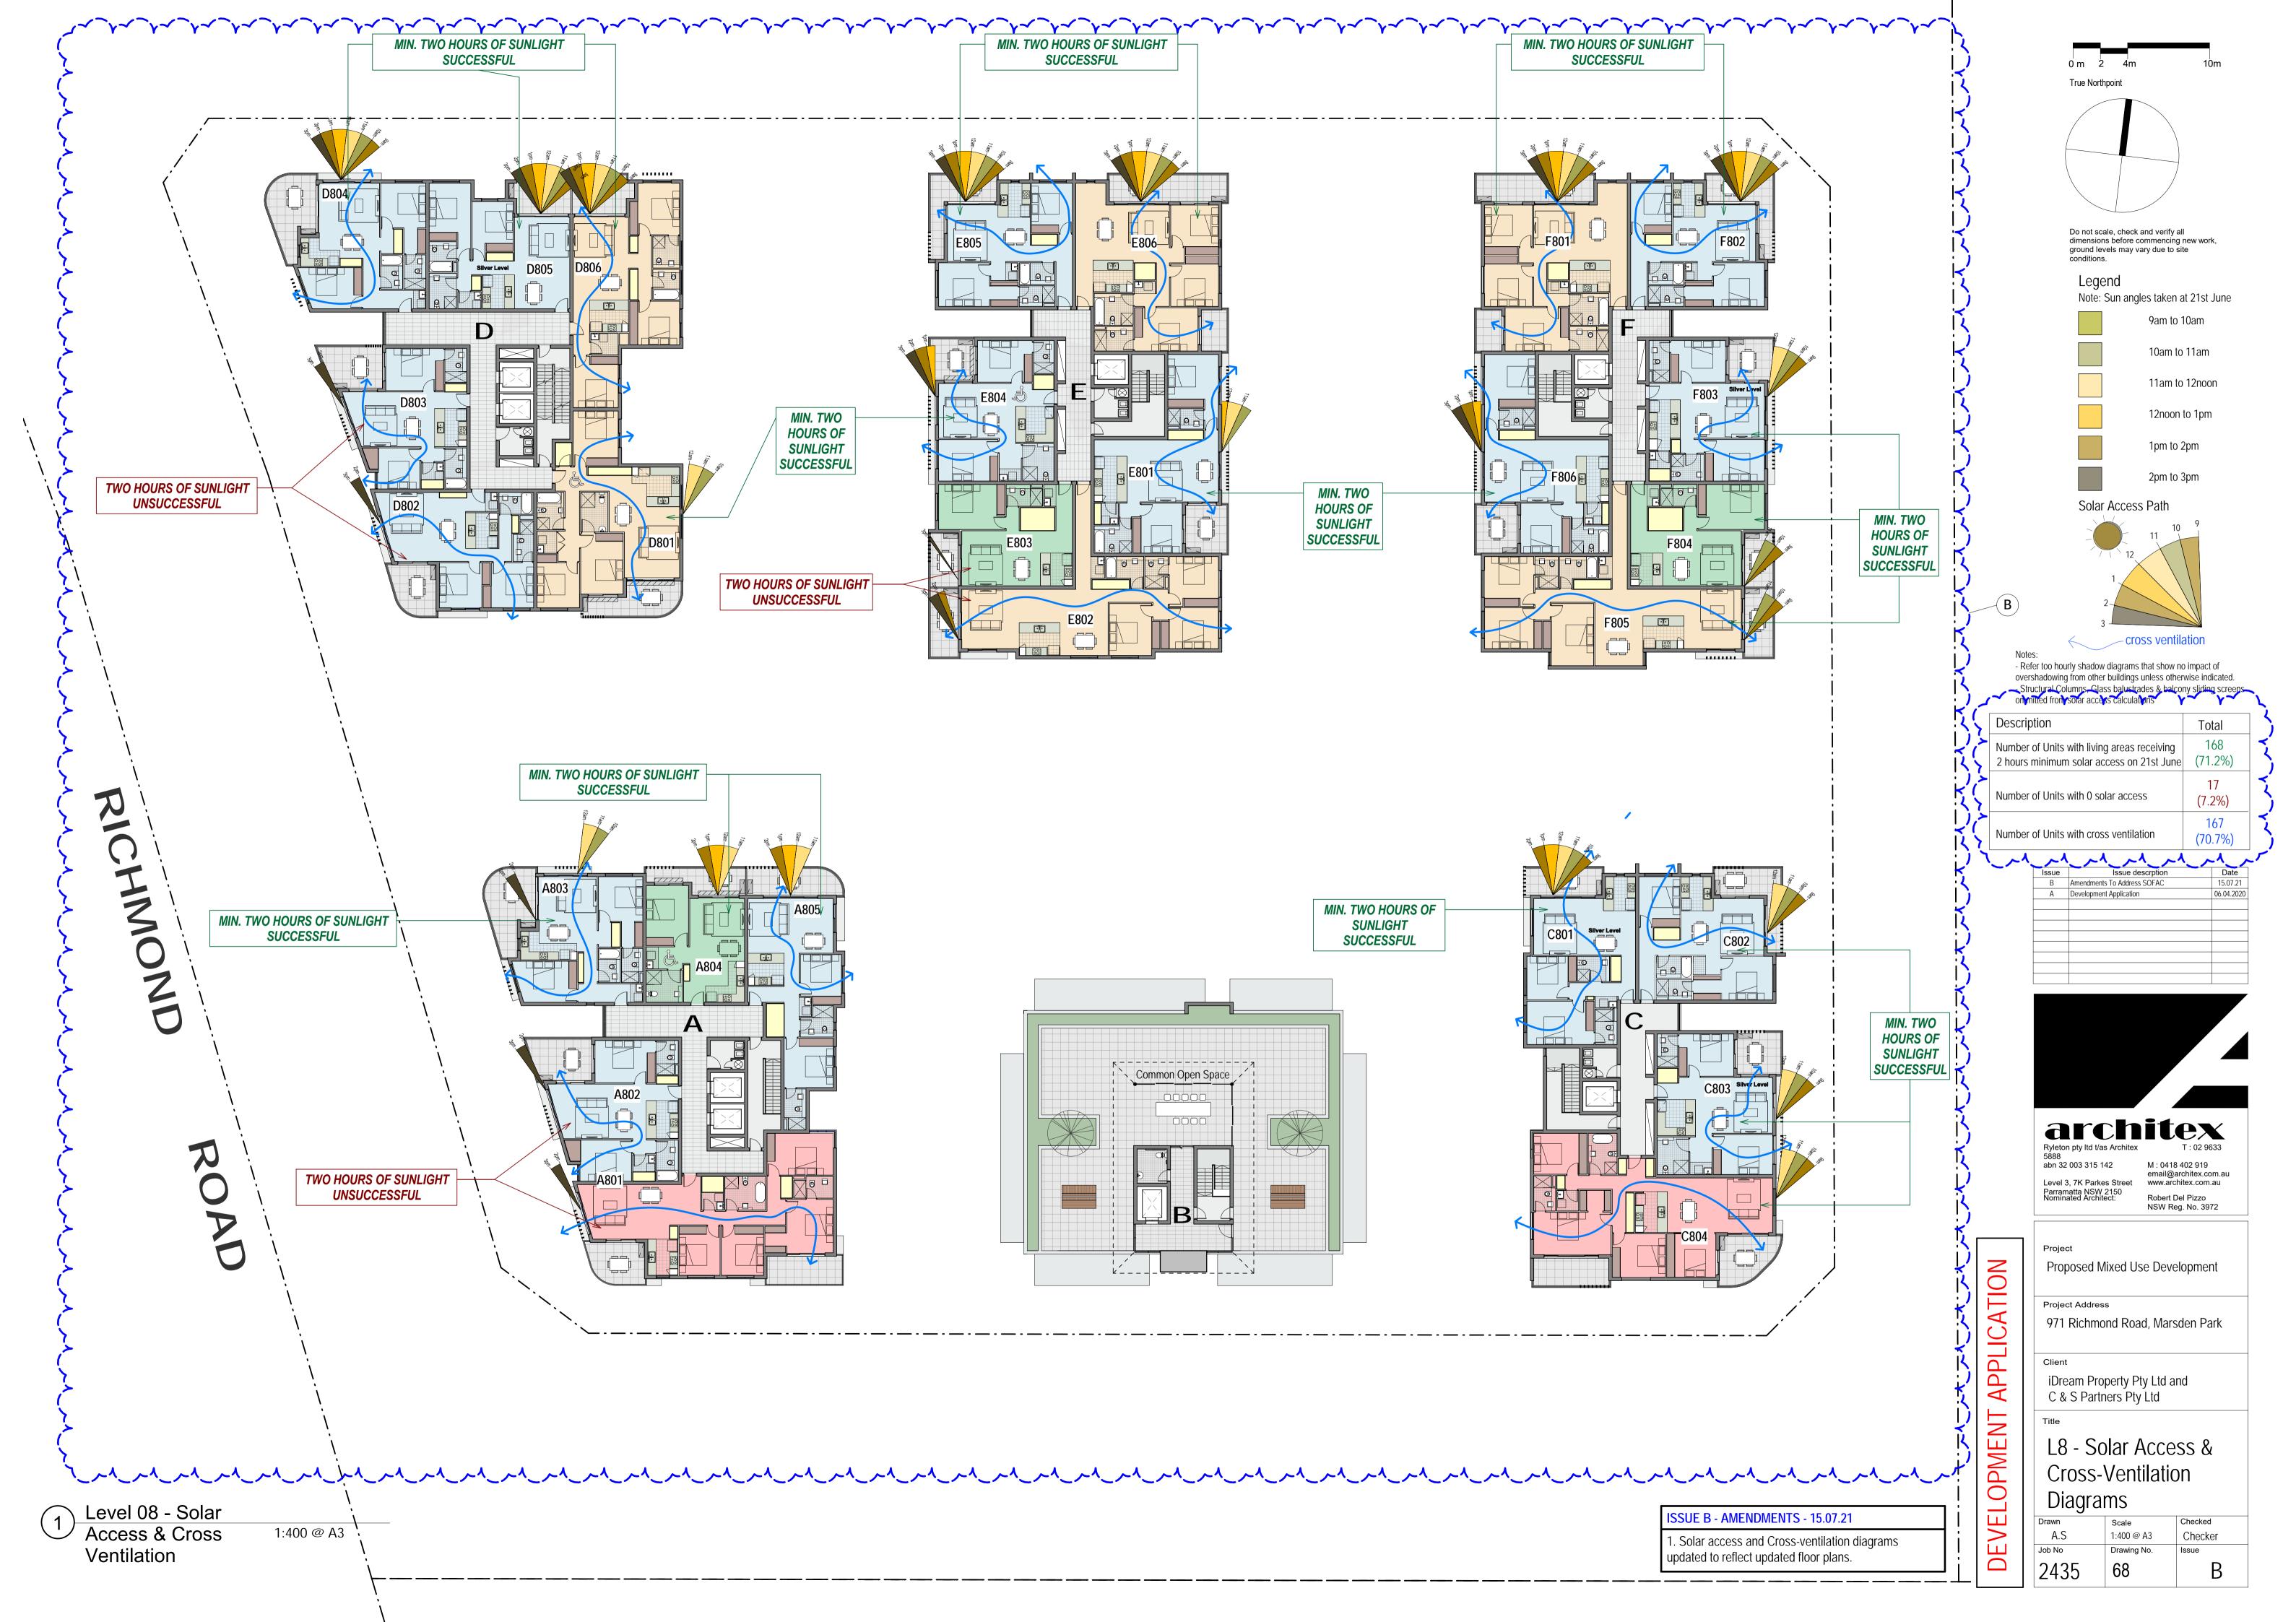


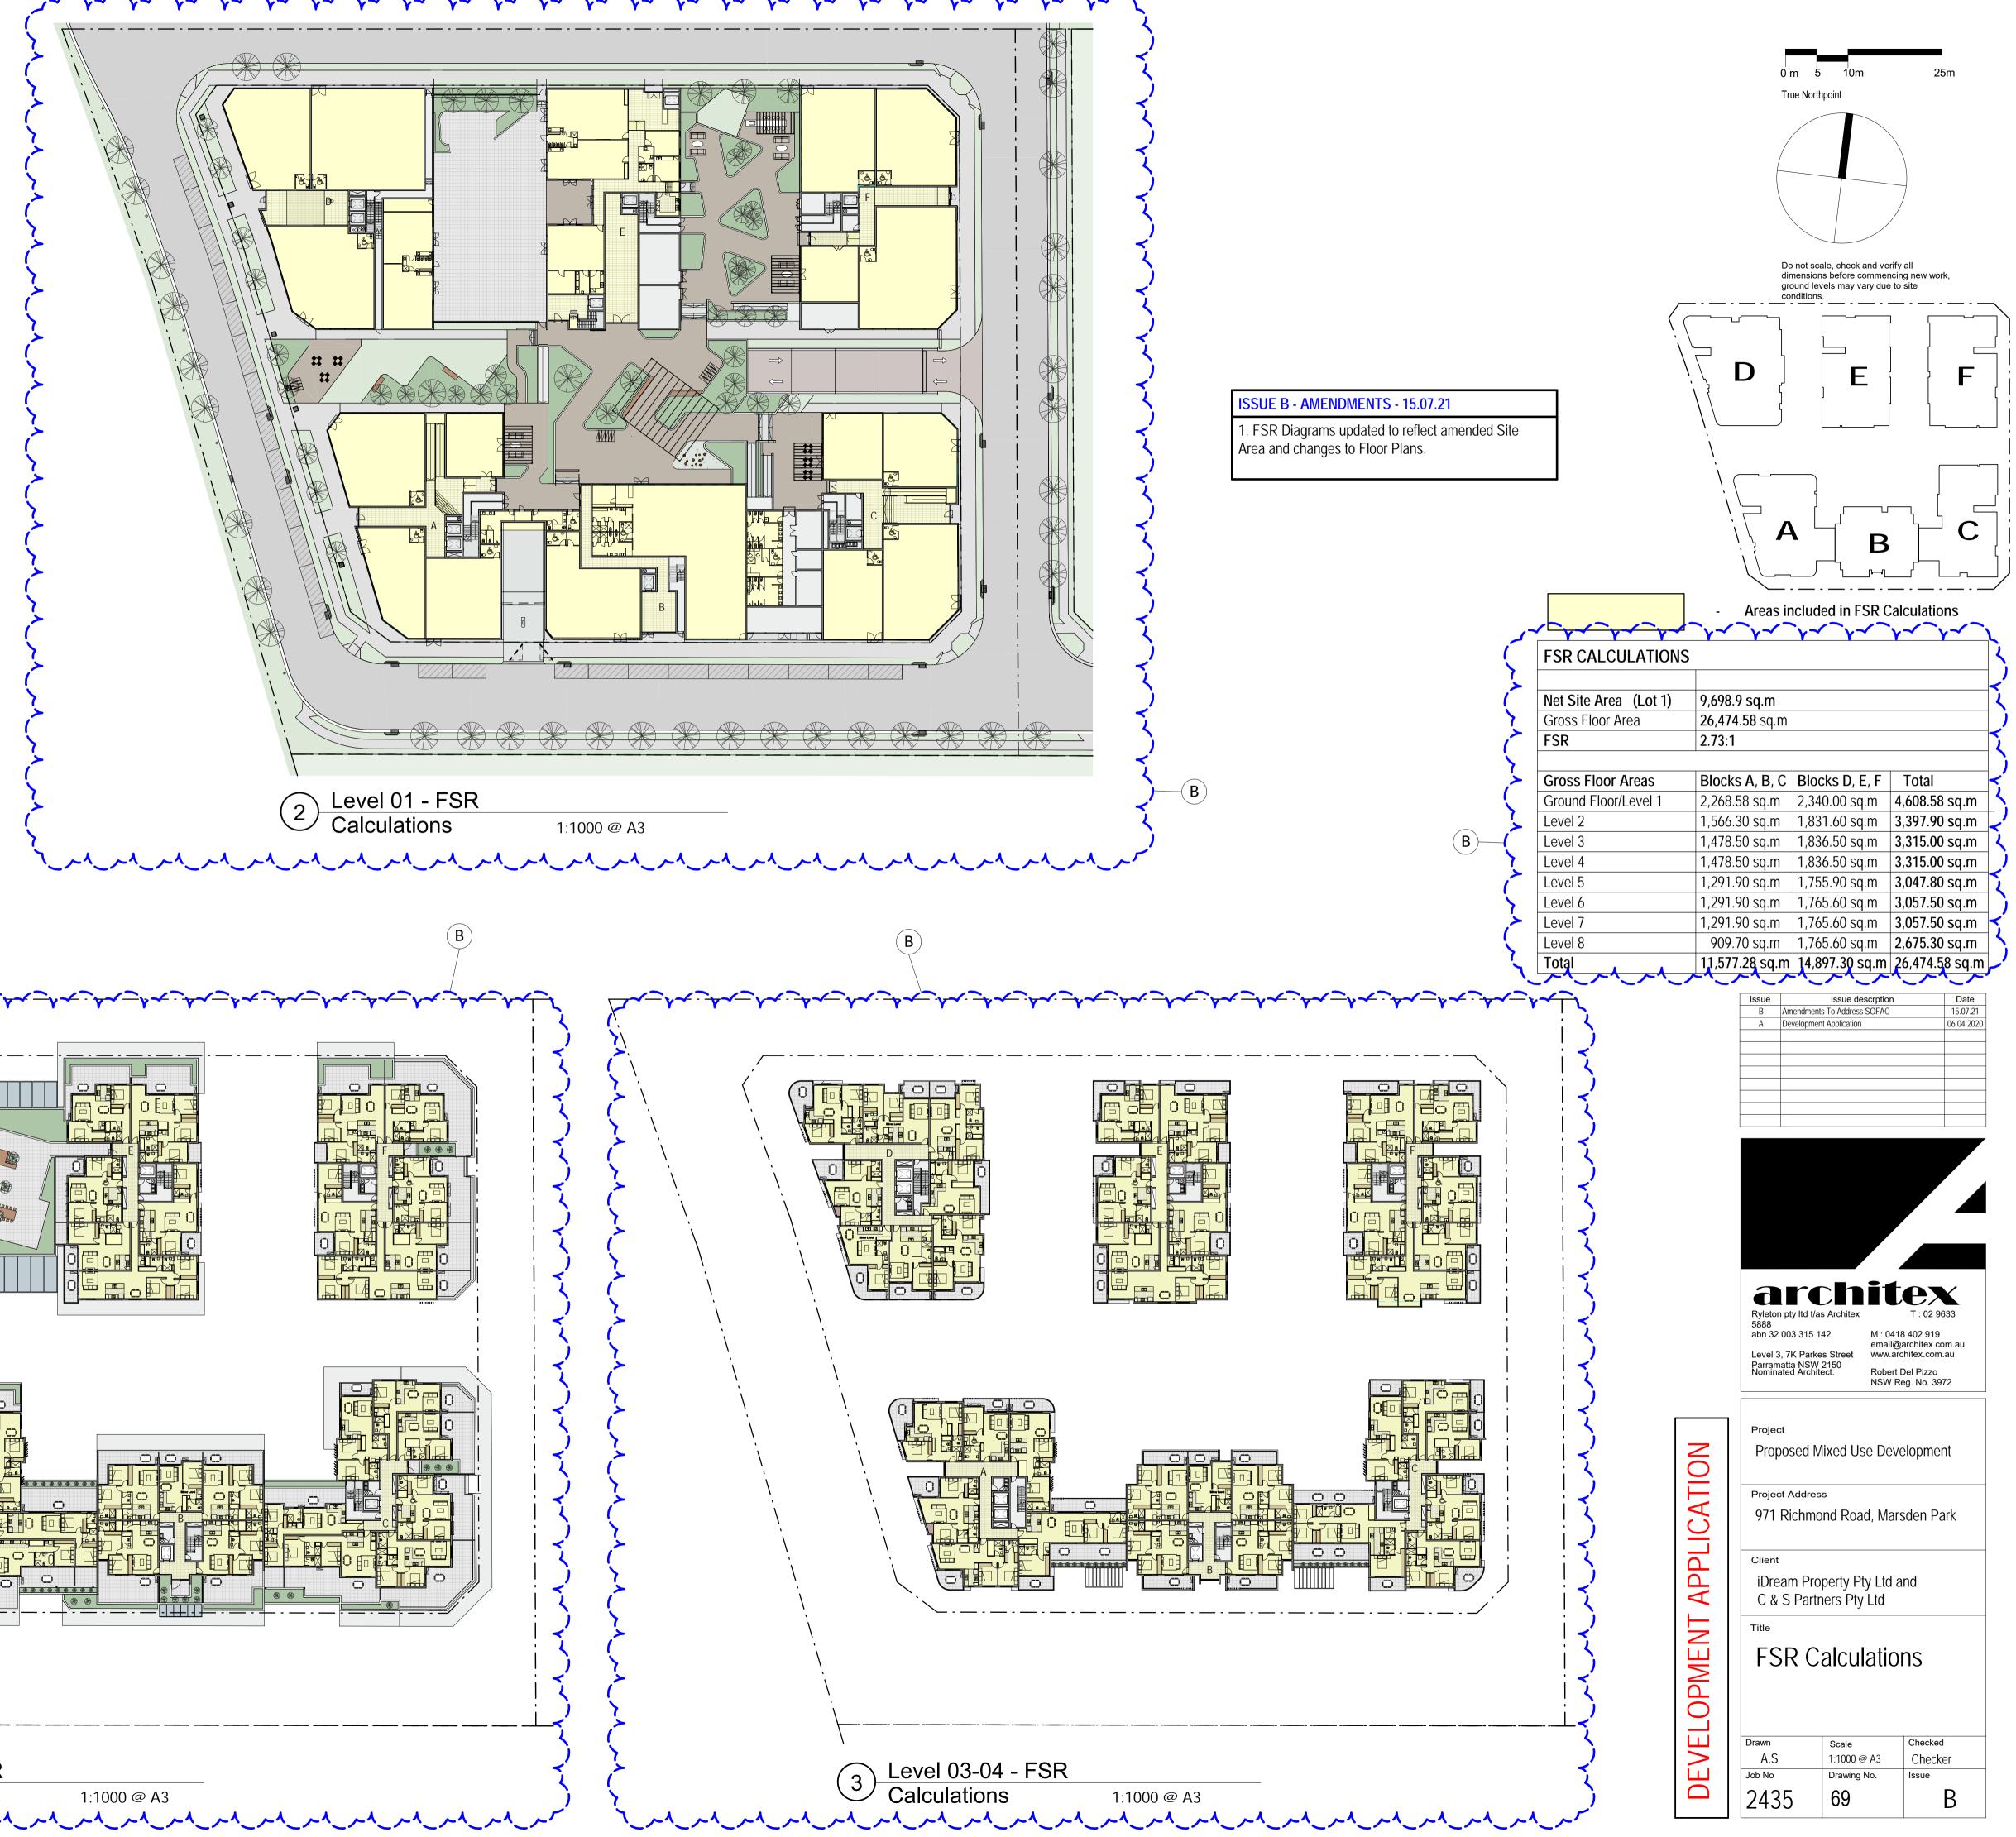










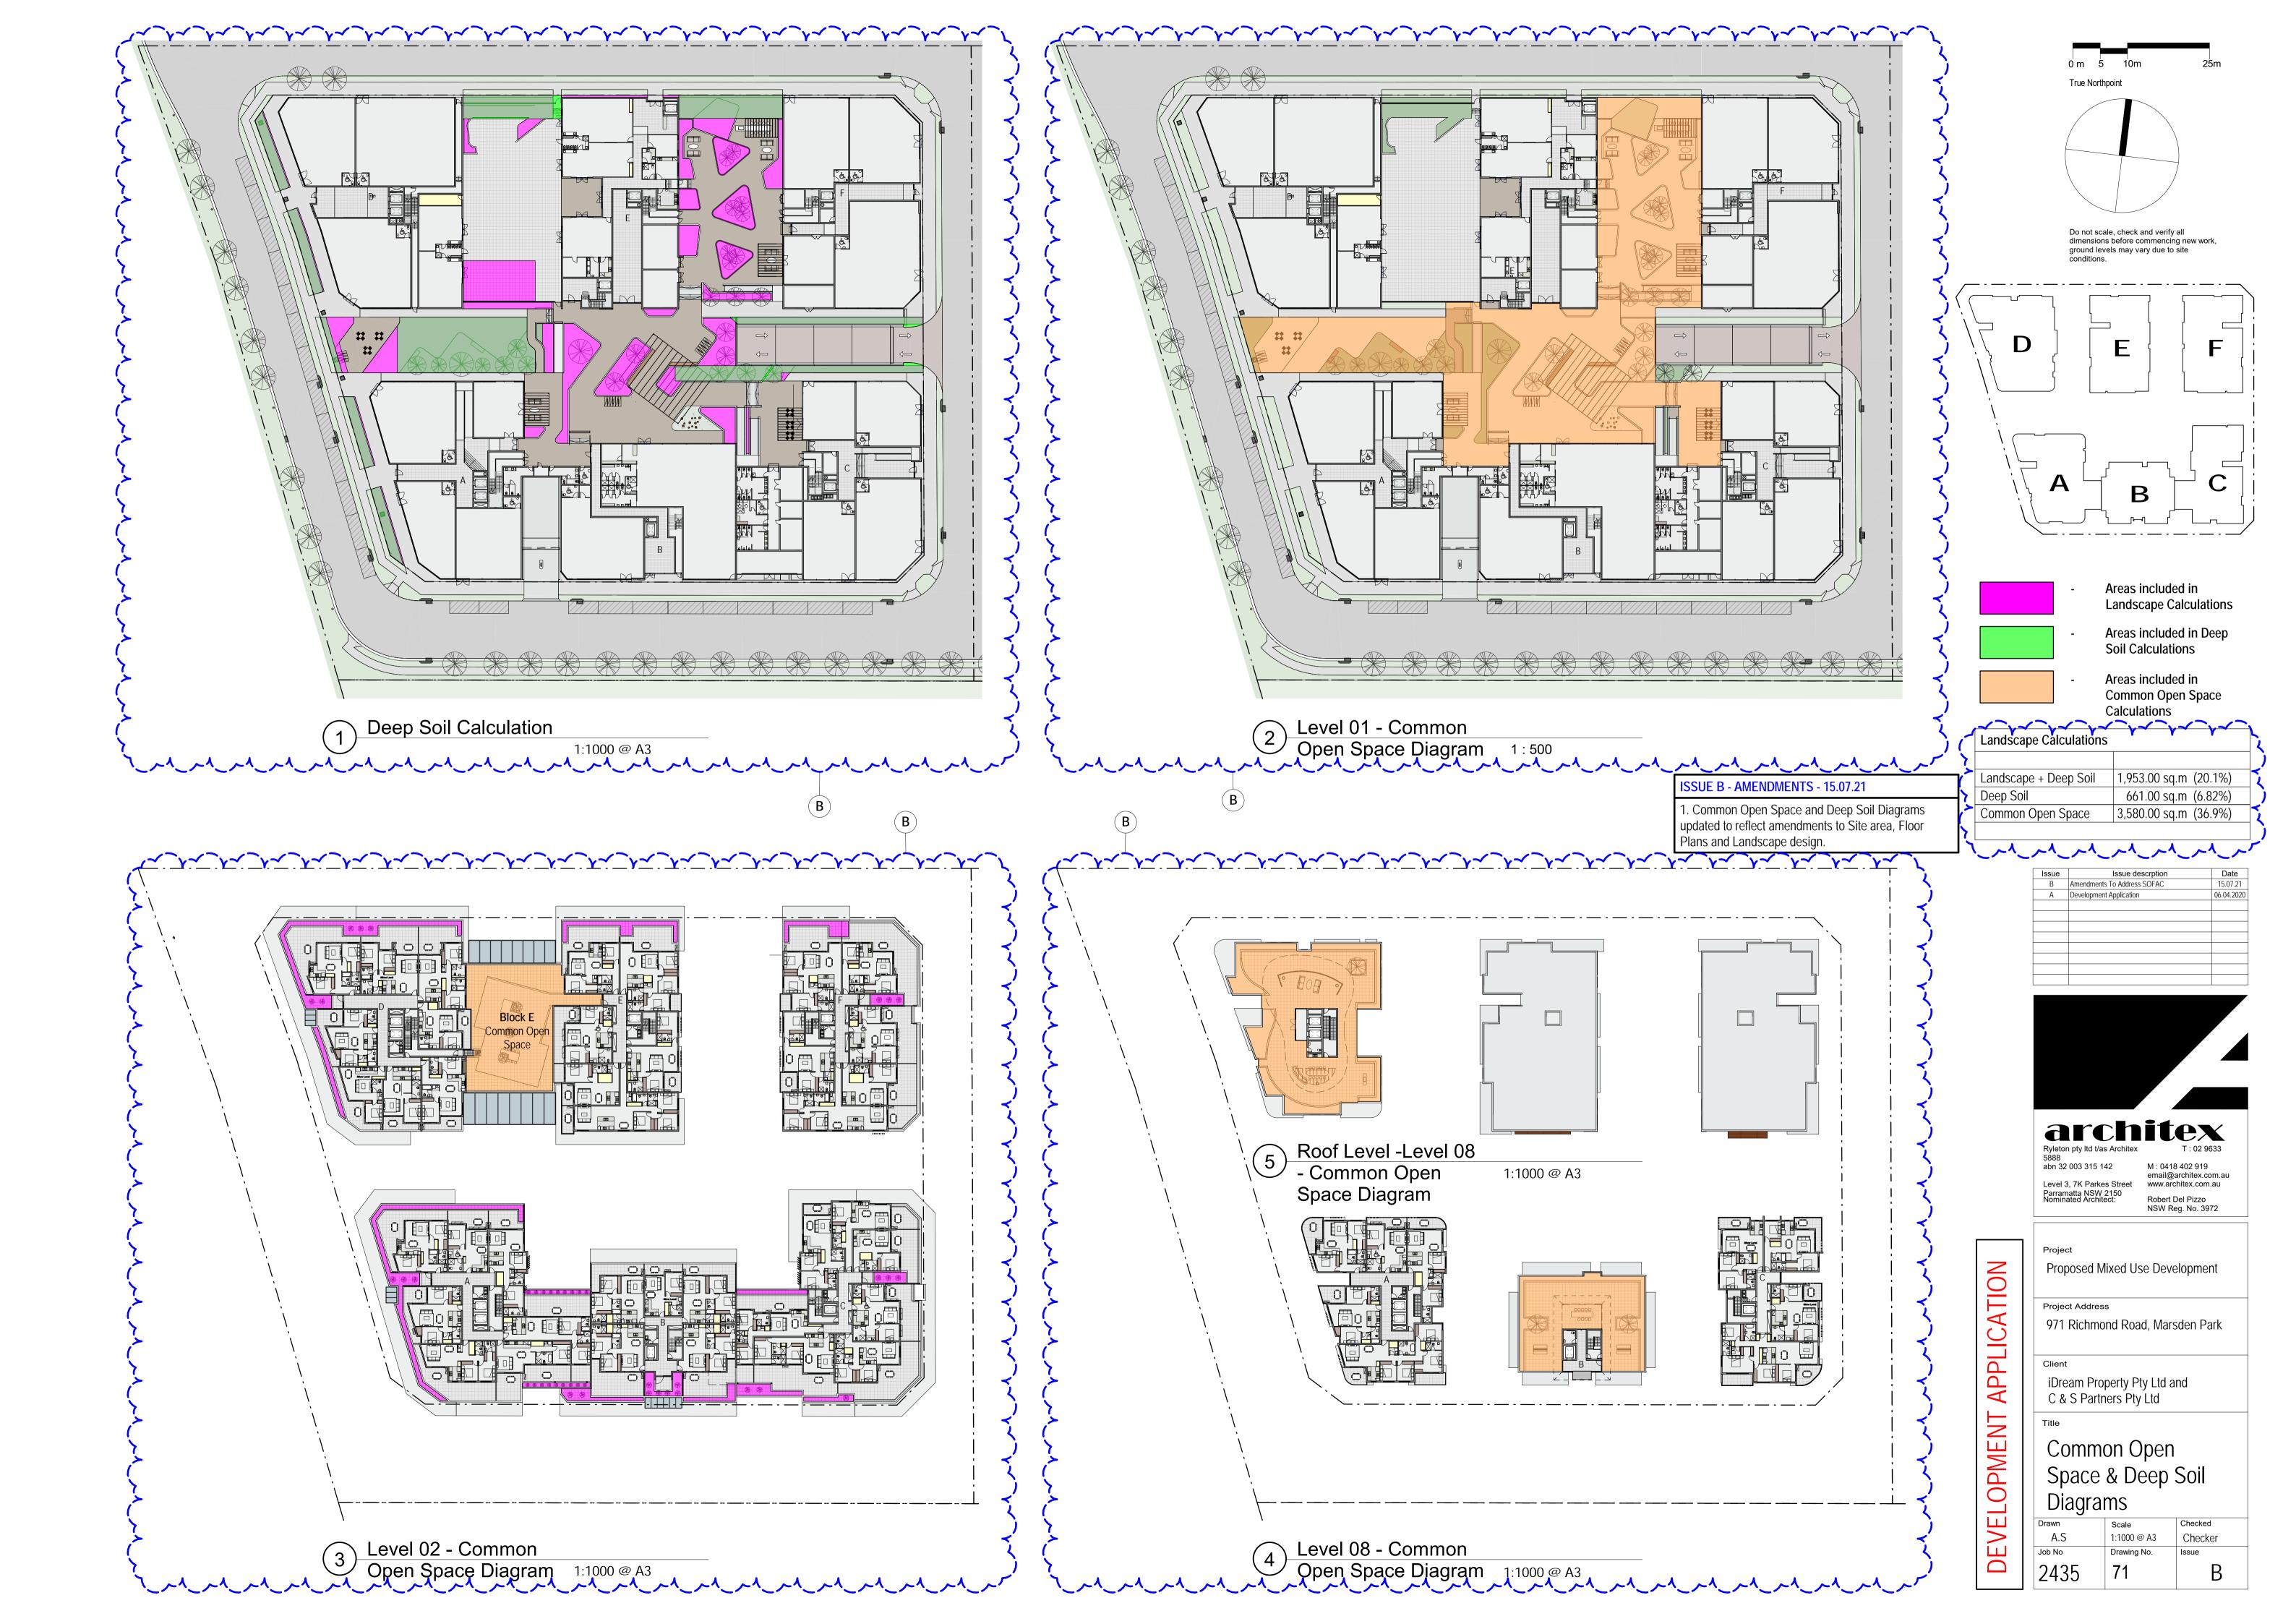

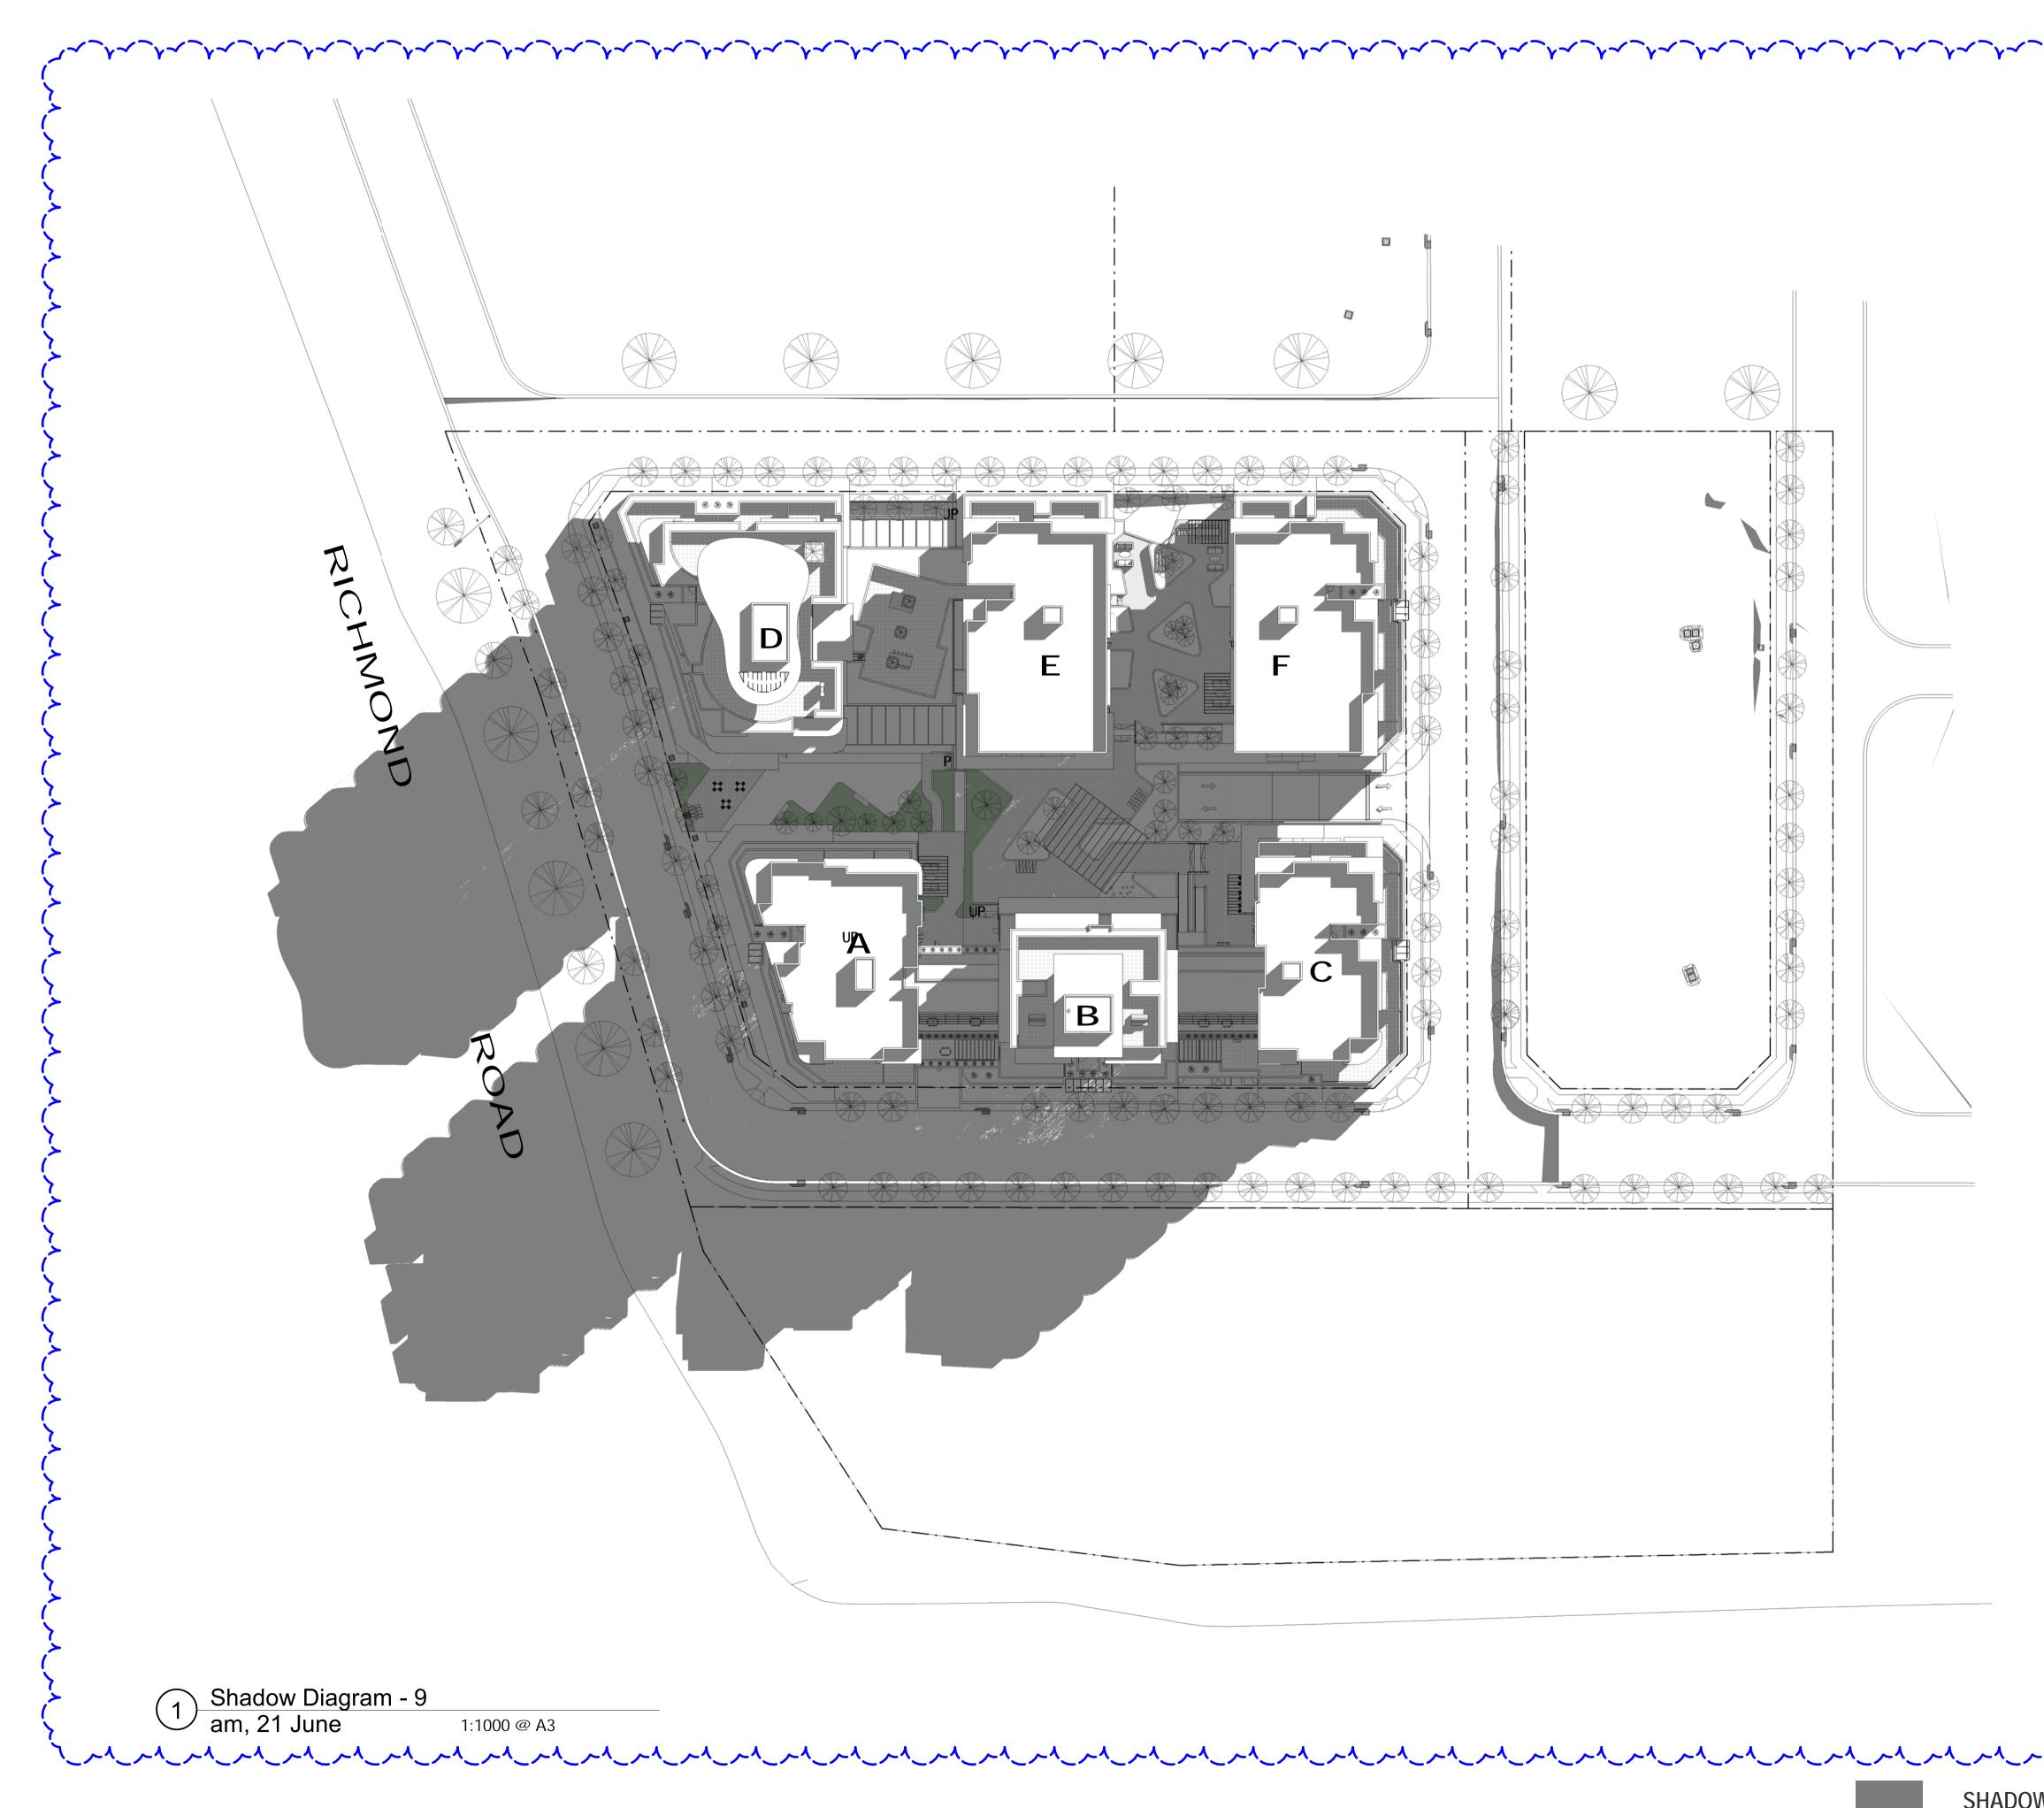

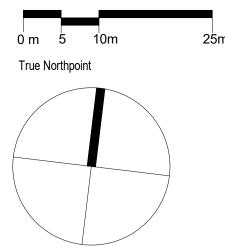

Do not scale, check and verify all dimensions before commencing new work, ground levels may vary due to site conditions.

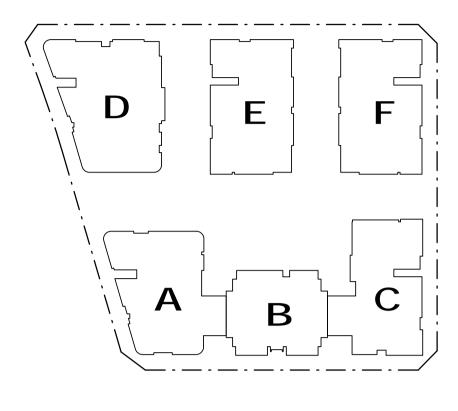

# ISSUE B - AMENDMENTS - 15.07.21

1. Shadow diagrams updated to reflect changes to Floor Plans and levels.

Issue	Issue descrption	Date
В	Amendments To Address SOFAC	15.07.21
А	Development Application	06.04.2020



Client iDream Property Pty Ltd and C & S Partners Pty Ltd

**APPLICATION** 


DEVELOPMENT


# Shadow Diagram - 9 am, 21 June

Drawn	Scale	Checked
A.S	1:1000 @ A3	Checker
Job No	Drawing No.	Issue
2435	72	В


SHADOWS CAST BY PROPOSED BUILDING

B

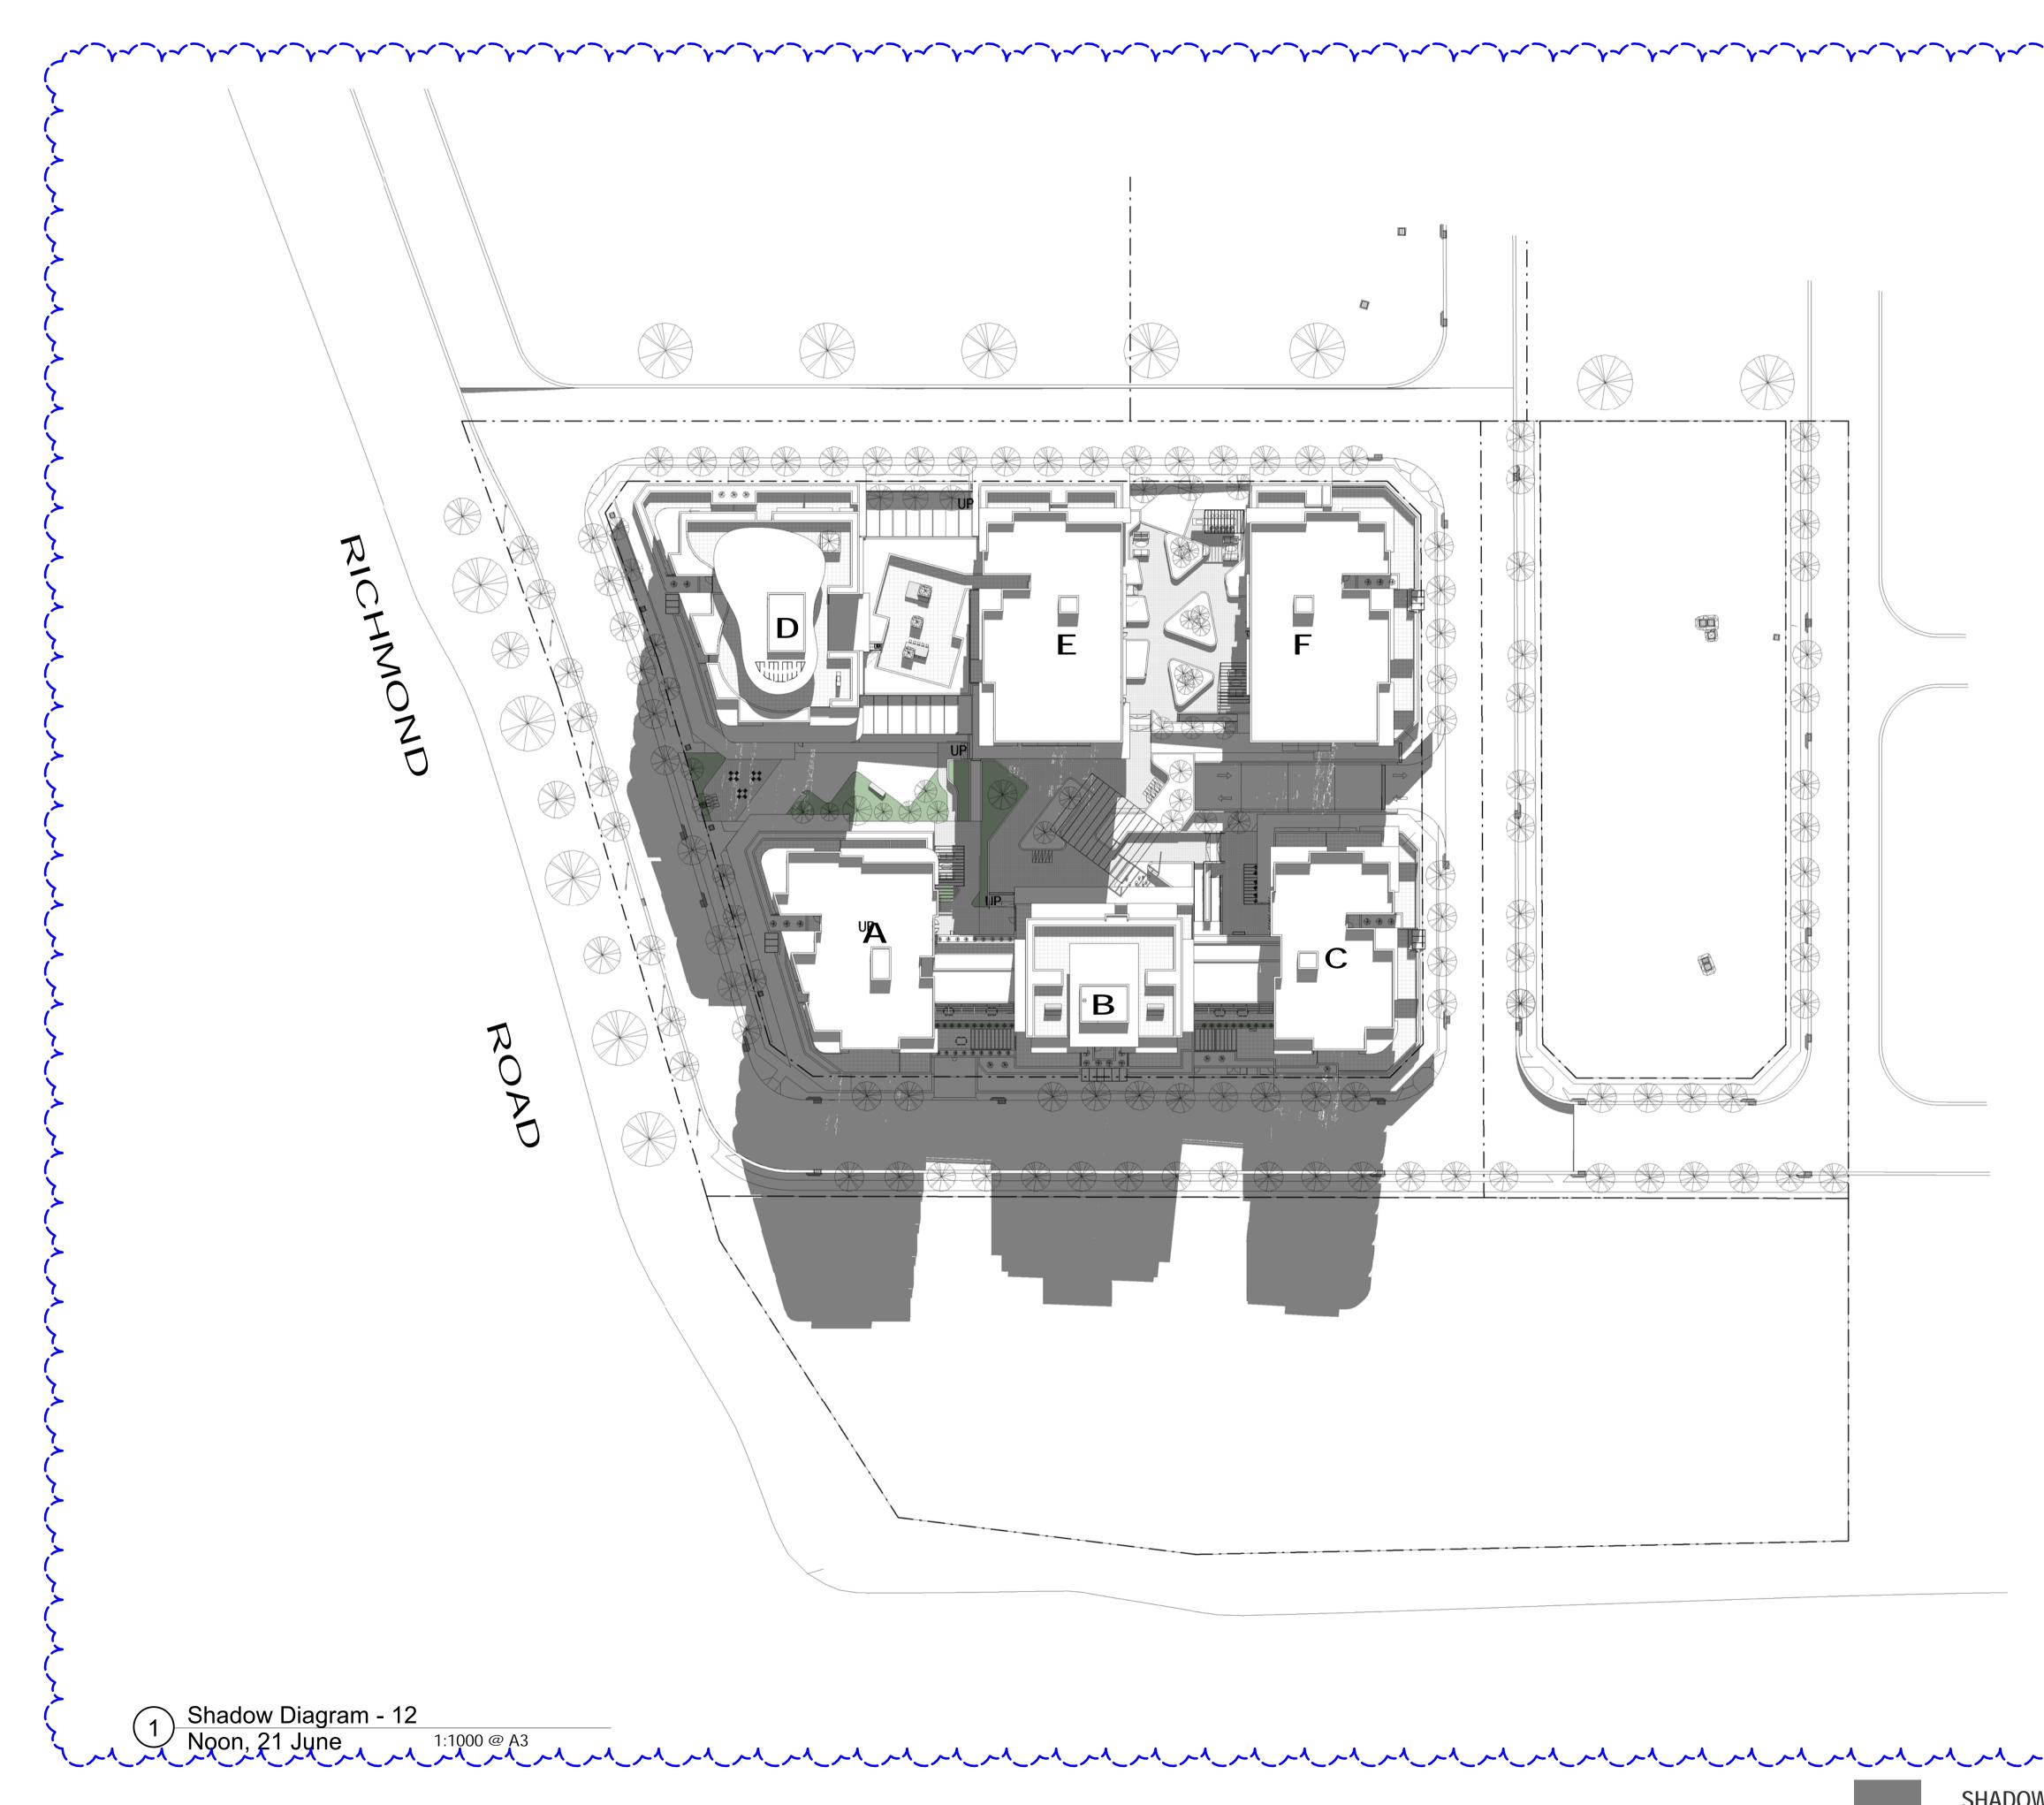

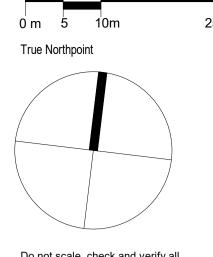

Do not scale, check and verify all dimensions before commencing new work, ground levels may vary due to site conditions.

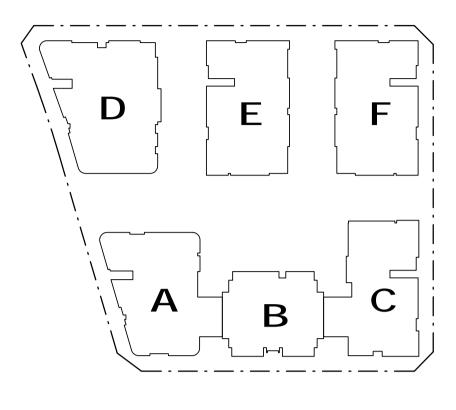

# ISSUE B - AMENDMENTS - 15.07.21

1. Shadow diagrams updated to reflect changes to Floor Plans and levels.

Issue	Issue descrption	Date
В	Amendments To Address SOFAC	15.07.21
А	Development Application	06.04.2020



Proposed Mixed Use Development

Project Address

971 Richmond Road, Marsden Park

Client

Title

APPLICATION

DEVELOPMENT


iDream Property Pty Ltd and C & S Partners Pty Ltd


# Shadow Diagram -12 Noon, 21 June

Drawn	Scale	Checked
A.S	1:1000 @ A3	Checker
Job No	Drawing No.	Issue
2435	73	В

B SHADOWS CAST

BY PROPOSED BUILDING

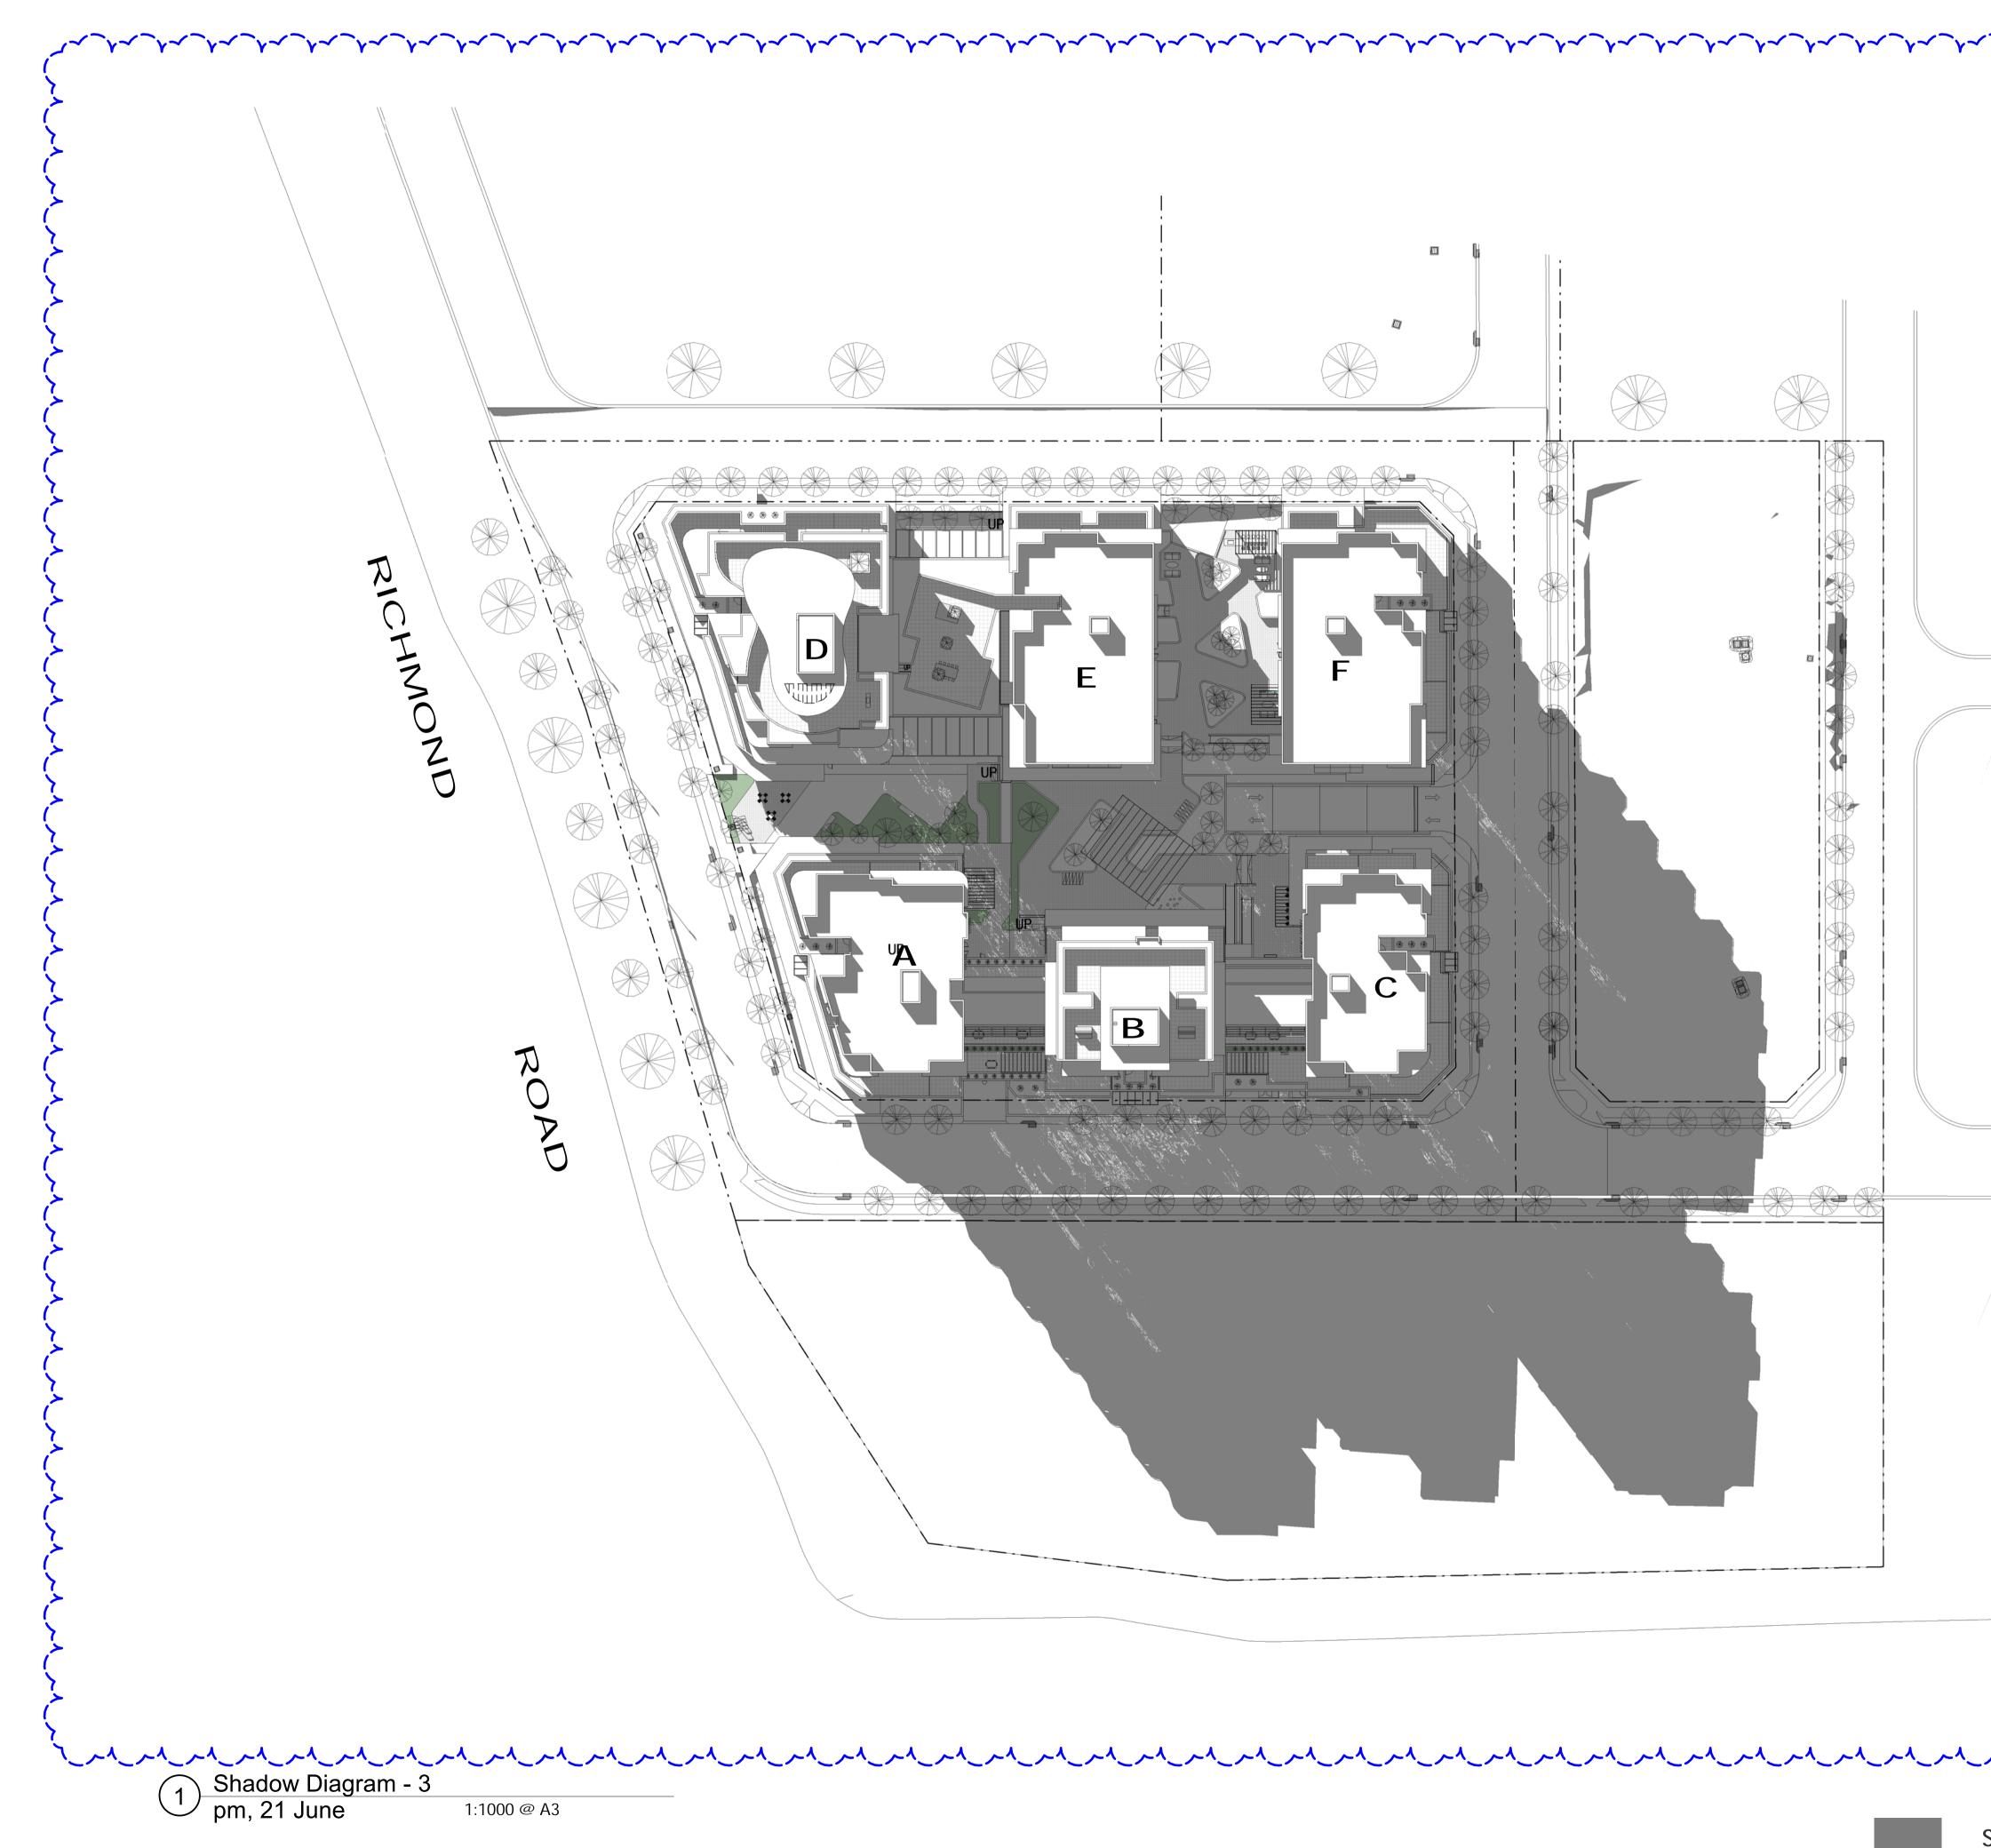

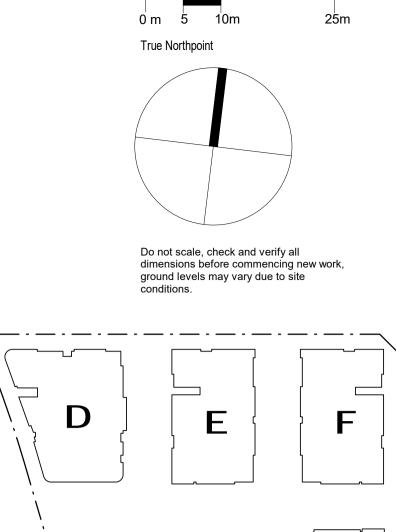

Β

_ · _ · _ · _ · _ · _ ·

 $\mathbf{c}$ 

J

### ISSUE B - AMENDMENTS - 15.07.21 1. Shadow diagrams updated to reflect changes to Floor Plans and levels.

Α

Issue	Issue descrption	Date
В	Amendments To Address SOFAC	15.07.21
A	Development Application	06.04.2020



# Shadow Diagram - 3 pm, 21 June

APPLICATION

DEVELOPMENT

Drawn	Scale	Checked
A.S	1:1000 @ A3	Checker
Job No	Drawing No.	Issue
2435	74	В

SHADOWS CAST BY PROPOSED BUILDING

-**B**