


APPENDIX A

Site Survey

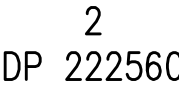

 
 
CAUTION - SERVICES LOCATIONS

- THE POSITION OF SERVICES SHOWN ON THIS DRAWING ARE INDICATIVE ONLY AND HAVE BEEN PLOTTED FROM PLANS AND DRAWINGS SUPPLIED BY RELEVANT AUTHORITIES
- SERVICE AUTHORITY PITS, MANHOLES, POLES, MARKER POSTS, ETC., WHERE SIGHTED AT TIME OF SURVEY, HAVE BEEN LOCATED. THE SURVEY DOES NOT INCLUDE INVESTIGATION OR LOCATION OF UNDERGROUND INFRASTRUCTURE.
- SERVICES INFORMATION SHOWN ON THIS DRAWING HAS BEEN OBTAINED THROUGH A DIAL BEFORE YOU DIG SEARCH AND IS VALID FOR THE PERIOD OF TIME FROM THE DATE OF ISSUE NOMINATED BY THE AUTHORITY.
- PROCEED WITH ANY EXCAVATION OR CONSTRUCTION ON OR ADJACENT TO THE SITE IT IS THE RESPONSIBILITY OF THE DEVELOPER AND CONTRACTORS TO APPLY FOR AND OBTAIN UP TO DATE PLANS THROUGH A NEW DIAL BEFORE YOU DIG SEARCH AND TO CONTACT ALL THE RELEVANT AUTHORITIES TO ESTABLISH AND CONFIRM THE DETAILED LOCATION AND DEPTH OF ALL UNDERGROUND SERVICES.

NOTE:

1. THE BEARINGS SHOWN FOR BOUNDARIES ON THIS DRAWING HAVE BEEN TAKEN FROM DEPOSITED PLANS ON PUBLIC RECORD WITH THE LAND & PROPERTY INFORMATION OFFICE. IF ACCURATE GRID/TRUE NORTH IS REQUIRED FOR CRITICAL SUN SHADOW DIAGRAM PURPOSES FURTHER SURVEY MAY BE REQUIRED.
2. BEARINGS & DISTANCES ARE BY TITLE ONLY. NO BOUNDARY INVESTIGATION HAS BEEN CARRIED OUT.
3. RELATIONSHIP OF IMPROVEMENTS TO BOUNDARIES IS DIAGRAMMATIC ONLY. WHERE OFFSETS ARE CRITICAL THEY SHOULD BE CONFIRMED BY FURTHER SURVEY.
4. CONTOURS SHOWN DEPICT THE TOPOGRAPHY. SPOT LEVELS SHOULD BE TAKEN IN PREFERENCE TO CONTOURS, CONTOURS DO NOT REPRESENT THE EXACT LEVEL AT ANY POINT.
5. SEWER INVERTS SHOWN, UNLESS OTHERWISE INDICATED, HAVE BEEN OBTAINED FROM THE RELEVANT AUTHORITY.

LEGEND

Sewermain	
Sewer manhole	
Watermain	
Water hydrant	
Water stop valve	
Telstra line	
Telstra Pit/Manhole	
Gasmain	
Electricity power pole	
Electricity overhead cables	
Electricity underground cables	
Bench mark	
Top of roof gutter	
Tree (Canopy spread, trunk diameter)	

ORIGIN OF LEVELS: - PM 117643
R.L. 12.890 (AHD)

A	ISSUED TO CLIENT	30.06.1
REV No.	REMARKS	DATE
	AMENDMENTS	

CLIENT:



PALMDALE MEMORIAL PARK
& CREMATORIUM
PO BOX 55 OURIMBAH
NSW 2258



TREHY INGOLD NEATE


Phone: (02) 4351 2233
Fax: (02) 4352 1559
Postal: P.O. BOX 3205
TUGGERAH NSW 2259
Email: admin@tinsurvey.com.au
www.tinsurvey.com.au

SURVEYING CIVIL DESIGN STRATA CERTIFICATION PLANNING

DRAWING TITLE
DETAIL SURVEY PLAN FOR
DEVELOPMENT APPLICATION
PURPOSES OVER LOT 1 IN
D.P. 1012816, PALMDALE ROAD,
PALMDALE

DATE:	18.06.2014	SCALE:	1: 400 @A1
SURVEY:	J.H.	DATUM:	AHD
F.BOOK:	COMP.	INSTRUCTION :	1
DRAWN:	K.I.	CAD FILE:	21657SAA
CHECKED:	R.P.	No. in SET:	1 of 2

REGISTERED SURVEYOR	DATE	PROJECT NUMBER 21657	DRAWING No SA01	REVISION A
---------------------	------	-------------------------	--------------------	---------------

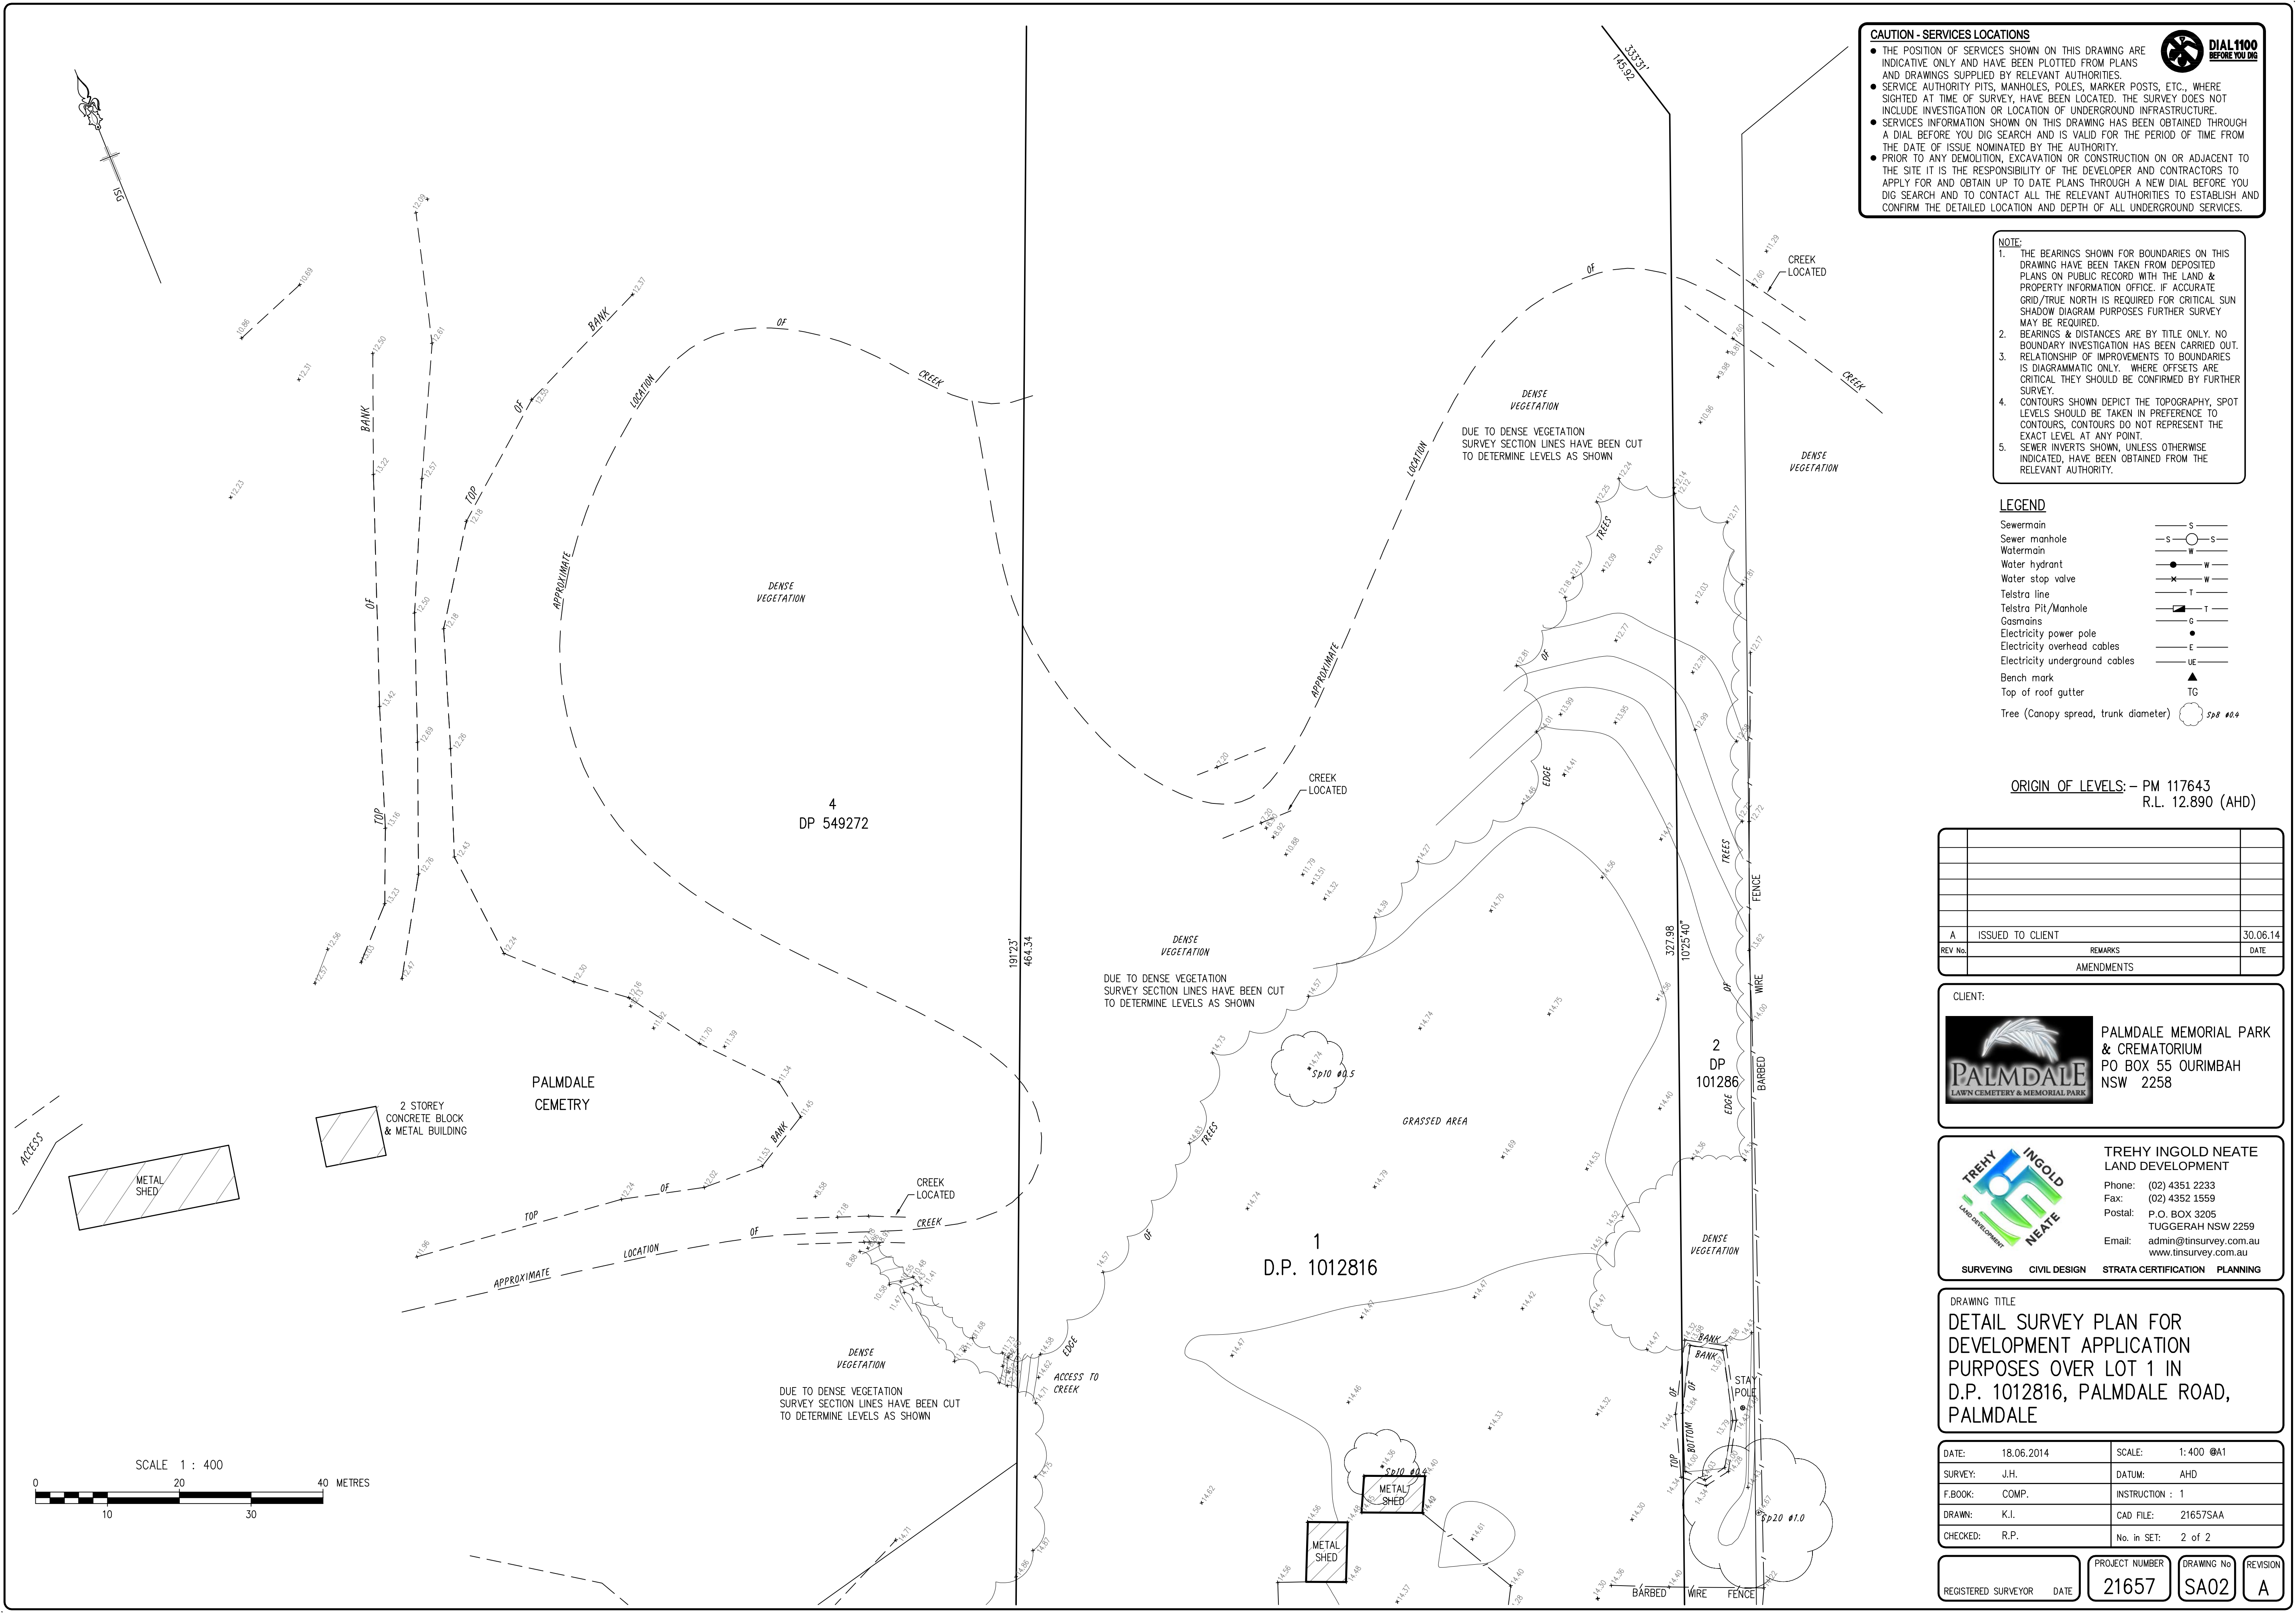

CAUTION - SERVICES LOCATIONS

- THE POSITION OF SERVICES SHOWN ON THIS DRAWING ARE INDICATIVE ONLY AND HAVE BEEN PLOTTED FROM PLANS AND DRAWINGS SUPPLIED BY RELEVANT AUTHORITIES.
- SERVICE AUTHORITY PITS, MANHOLES, POLES, MARKER POSTS, ETC., WHERE SIGHTED AT TIME OF SURVEY, HAVE BEEN LOCATED. THE SURVEY DOES NOT INCLUDE INVESTIGATION OR LOCATION OF UNDERGROUND INFRASTRUCTURE.
- SERVICES INFORMATION SHOWN ON THIS DRAWING HAS BEEN OBTAINED THROUGH A DIAL BEFORE YOU DIG SEARCH AND IS VALID FOR THE PERIOD OF TIME FROM THE DATE OF ISSUE NOMINATED BY THE AUTHORITY.
- PRIOR TO ANY DEMOLITION, EXCAVATION OR CONSTRUCTION ON OR ADJACENT TO THE SITE IT IS THE RESPONSIBILITY OF THE DEVELOPER AND CONTRACTORS TO APPLY FOR AND OBTAIN UP TO DATE PLANS THROUGH A NEW DIAL BEFORE YOU DIG SEARCH AND TO CONTACT ALL THE RELEVANT AUTHORITIES TO ESTABLISH AND CONFIRM THE DETAILED LOCATION AND DEPTH OF ALL UNDERGROUND SERVICES.



NOTE:

1. THE BEARINGS SHOWN FOR BOUNDARIES ON THIS DRAWING HAVE BEEN TAKEN FROM DEPOSITED PLANS ON PUBLIC RECORD WITH THE LAND & PROPERTY INFORMATION OFFICE. IF ACCURATE GRID/TRUE NORTH IS REQUIRED FOR CRITICAL SUN SHADOW DIAGRAM PURPOSES FURTHER SURVEY MAY BE REQUIRED.
2. BEARINGS & DISTANCES ARE BY TITLE ONLY. NO BOUNDARY INVESTIGATION HAS BEEN CARRIED OUT.
3. RELATIONSHIP OF IMPROVEMENTS TO BOUNDARIES IS DIAGRAMMATIC ONLY. WHERE OFFSETS ARE CRITICAL THEY SHOULD BE CONFIRMED BY FURTHER SURVEY.
4. CONTOURS SHOWN DEPICT THE TOPOGRAPHY, SPOT LEVELS SHOULD BE TAKEN IN PREFERENCE TO CONTOURS, CONTOURS DO NOT REPRESENT THE EXACT LEVEL AT ANY POINT.
5. SEWER INVERTS SHOWN, UNLESS OTHERWISE INDICATED, HAVE BEEN OBTAINED FROM THE RELEVANT AUTHORITY.

LEGEND

Sewer main	— S —
Sewer manhole	— S — () — S —
Watermain	— W —
Water hydrant	— W — () — W —
Water stop valve	— W — (X) — W —
Telstra line	— T —
Telstra Pit/Manhole	— T — () — T —
Gas mains	— G —
Electricity power pole	— E — () — E —
Electricity overhead cables	— E —
Electricity underground cables	— UE —
Bench mark	— BM —
Top of roof gutter	— TG —
Tree (Canopy spread, trunk diameter)	— Sp8 @0.4 —

ORIGIN OF LEVELS: – PM 117643
R.L. 12.890 (AHD)

REV No.	ISSUED TO CLIENT	REMARKS	DATE
A	ISSUED TO CLIENT		30.06.14
		AMENDMENTS	

CLIENT:

PALMDALE MEMORIAL PARK & CREMATORIUM
PO BOX 55 OURIMBAH
NSW 2258

TREHY INGOLD NEATE LAND DEVELOPMENT

Phone: (02) 4351 2233
Fax: (02) 4352 1559
Postal: P.O. BOX 3205
TUGGERAH NSW 2259
Email: admin@tinsurvey.com.au
www.tinsurvey.com.au

SURVEYING CIVIL DESIGN STRATA CERTIFICATION PLANNING

DRAWING TITLE

DETAIL SURVEY PLAN FOR DEVELOPMENT APPLICATION PURPOSES OVER LOT 1 IN D.P. 1012816, PALMDALE ROAD, PALMDALE

DATE:	18.06.2014	SCALE:	1:400 @A1
SURVEY:	J.H.	DATUM:	AHD
F.BOOK:	COMP.	INSTRUCTION :	1
DRAWN:	K.I.	CAD FILE:	21657SAA
CHECKED:	R.P.	No. in SET:	2 of 2

REGISTERED SURVEYOR	DATE	PROJECT NUMBER	DRAWING No	REVISION
		21657	SA02	A