	NatHER	RS Thermal Performance Specification			
		External Walls			
Wall Type	Insulation	Colour	Comments		
Brick Veneer	R1.5	Light - SA < 0.475	Throughout except as below		
Brick Veneer	R2.0	Light - SA < 0.475	A1.05, A1.10		
Dincel + Internal Lining	Polystyrene board (Total R value wall and insulation 2.1)	Light - SA < 0.475 SA - Solar Absorptance	Throughout		
Internal Walls					
Wall Type	Insulation		Comments		
Plaster board on Stud	None		Internally in units		
Hebel Panel + Plast Lining	None Party walls				
Hebel Panel + Plast Lining					
	•	Floors			
Floor Type Insulation Comments					
Concrete	te R1.0 All units with suspended slab over carpark				
Concrete None All units with adjoining unit below					
	·	Ceilings			
Ceiling Type Insulation Comments					
Plasterboard None Throughout					
Any insulation loss due to ceiling pe	any insulation loss due to ceiling penetrations for lights, ceiling fans and the like must be offset by increasing the remaining insulation in accordance with the BCA. Insulation loss due to ceiling penetrations has not been included in this assessment.				
		Roof			
Roof Type	Insulation	Colour	Comments		
Concrete	R2.5	Med - SA 0.475 - 0.7	Throughout		
		SA - Solar Absorptance			
		Windows			
Window Type	U-Value	SHGC	Comments		
Single Clear Aluminium	6.57	0.74	Throughout except as below		
Double Clear Aluminium	4.3	0.67	South facing glazing of units B1.01, B1.04, B1.05, B1.06, B1.10, B1.09, B2.01, B2.04, B2.05, B2.06, B2.10, B2.09,		
		Skylights			
Skylight Type	U-Value	SHGC	Comments		
na	na	na	na		
Vindow and skylight U and SHGC va		C. Alternate products or specifications manthe U and SHGC values of the product s	ay be used if their U value is lower, and the SHGC value is less that specified above.		

DEVELOPMENT APPLICATION ISSUE J

PROJECT:

801–807 NEW CANTERBURY ROAD, DULWICH HILL

CLIENT:

HARALAMBIS CONSTRUCTION PTY LTD

PROJECT No:

5729

DATE:

18 AUG 2015

ISSUE:

I

ARCHITECT:

CANDALEPAS ASSOCIATES

L9, 219 CASTLEREAGH ST SYDNEY NSW 2000 T: 9283 7755 F: 9283 7477

LOCATION PLAN:



DRAWING SCHEDULE

DA 1000 DA 1001	COVER SHEET SITE ANALYSIS
DA 1101 DA 1102 DA 1103 DA 1104 DA 1105 DA 1106 DA 1108	BASEMENT FLOOR PLAN B2 BASEMENT FLOOR PLAN B1 GROUND FLOOR PLAN LEVEL 1 FLOOR PLAN LEVEL 2 FLOOR PLAN LEVEL 3 FLOOR PLAN ROOF PLAN
DA 1201 DA 1301 DA 1302 DA 1303	SECTION A & B NORTH ELEVATION (BUILDING A) SOUTH ELEVATION (BUILDING A) NORTH ELEVATION (BUILDING B)

DA 1401 ADAPTABLE UNIT PLANS

DA 1304


DA 1305


DA 1453 DEVELOPMENT AMENITY ANALYSIS


SOUTH ELEVATION (BUILDING B)


EAST AND WEST ELEVATIONS

DA 1801 DEVELOPMENT CALCULATIONS

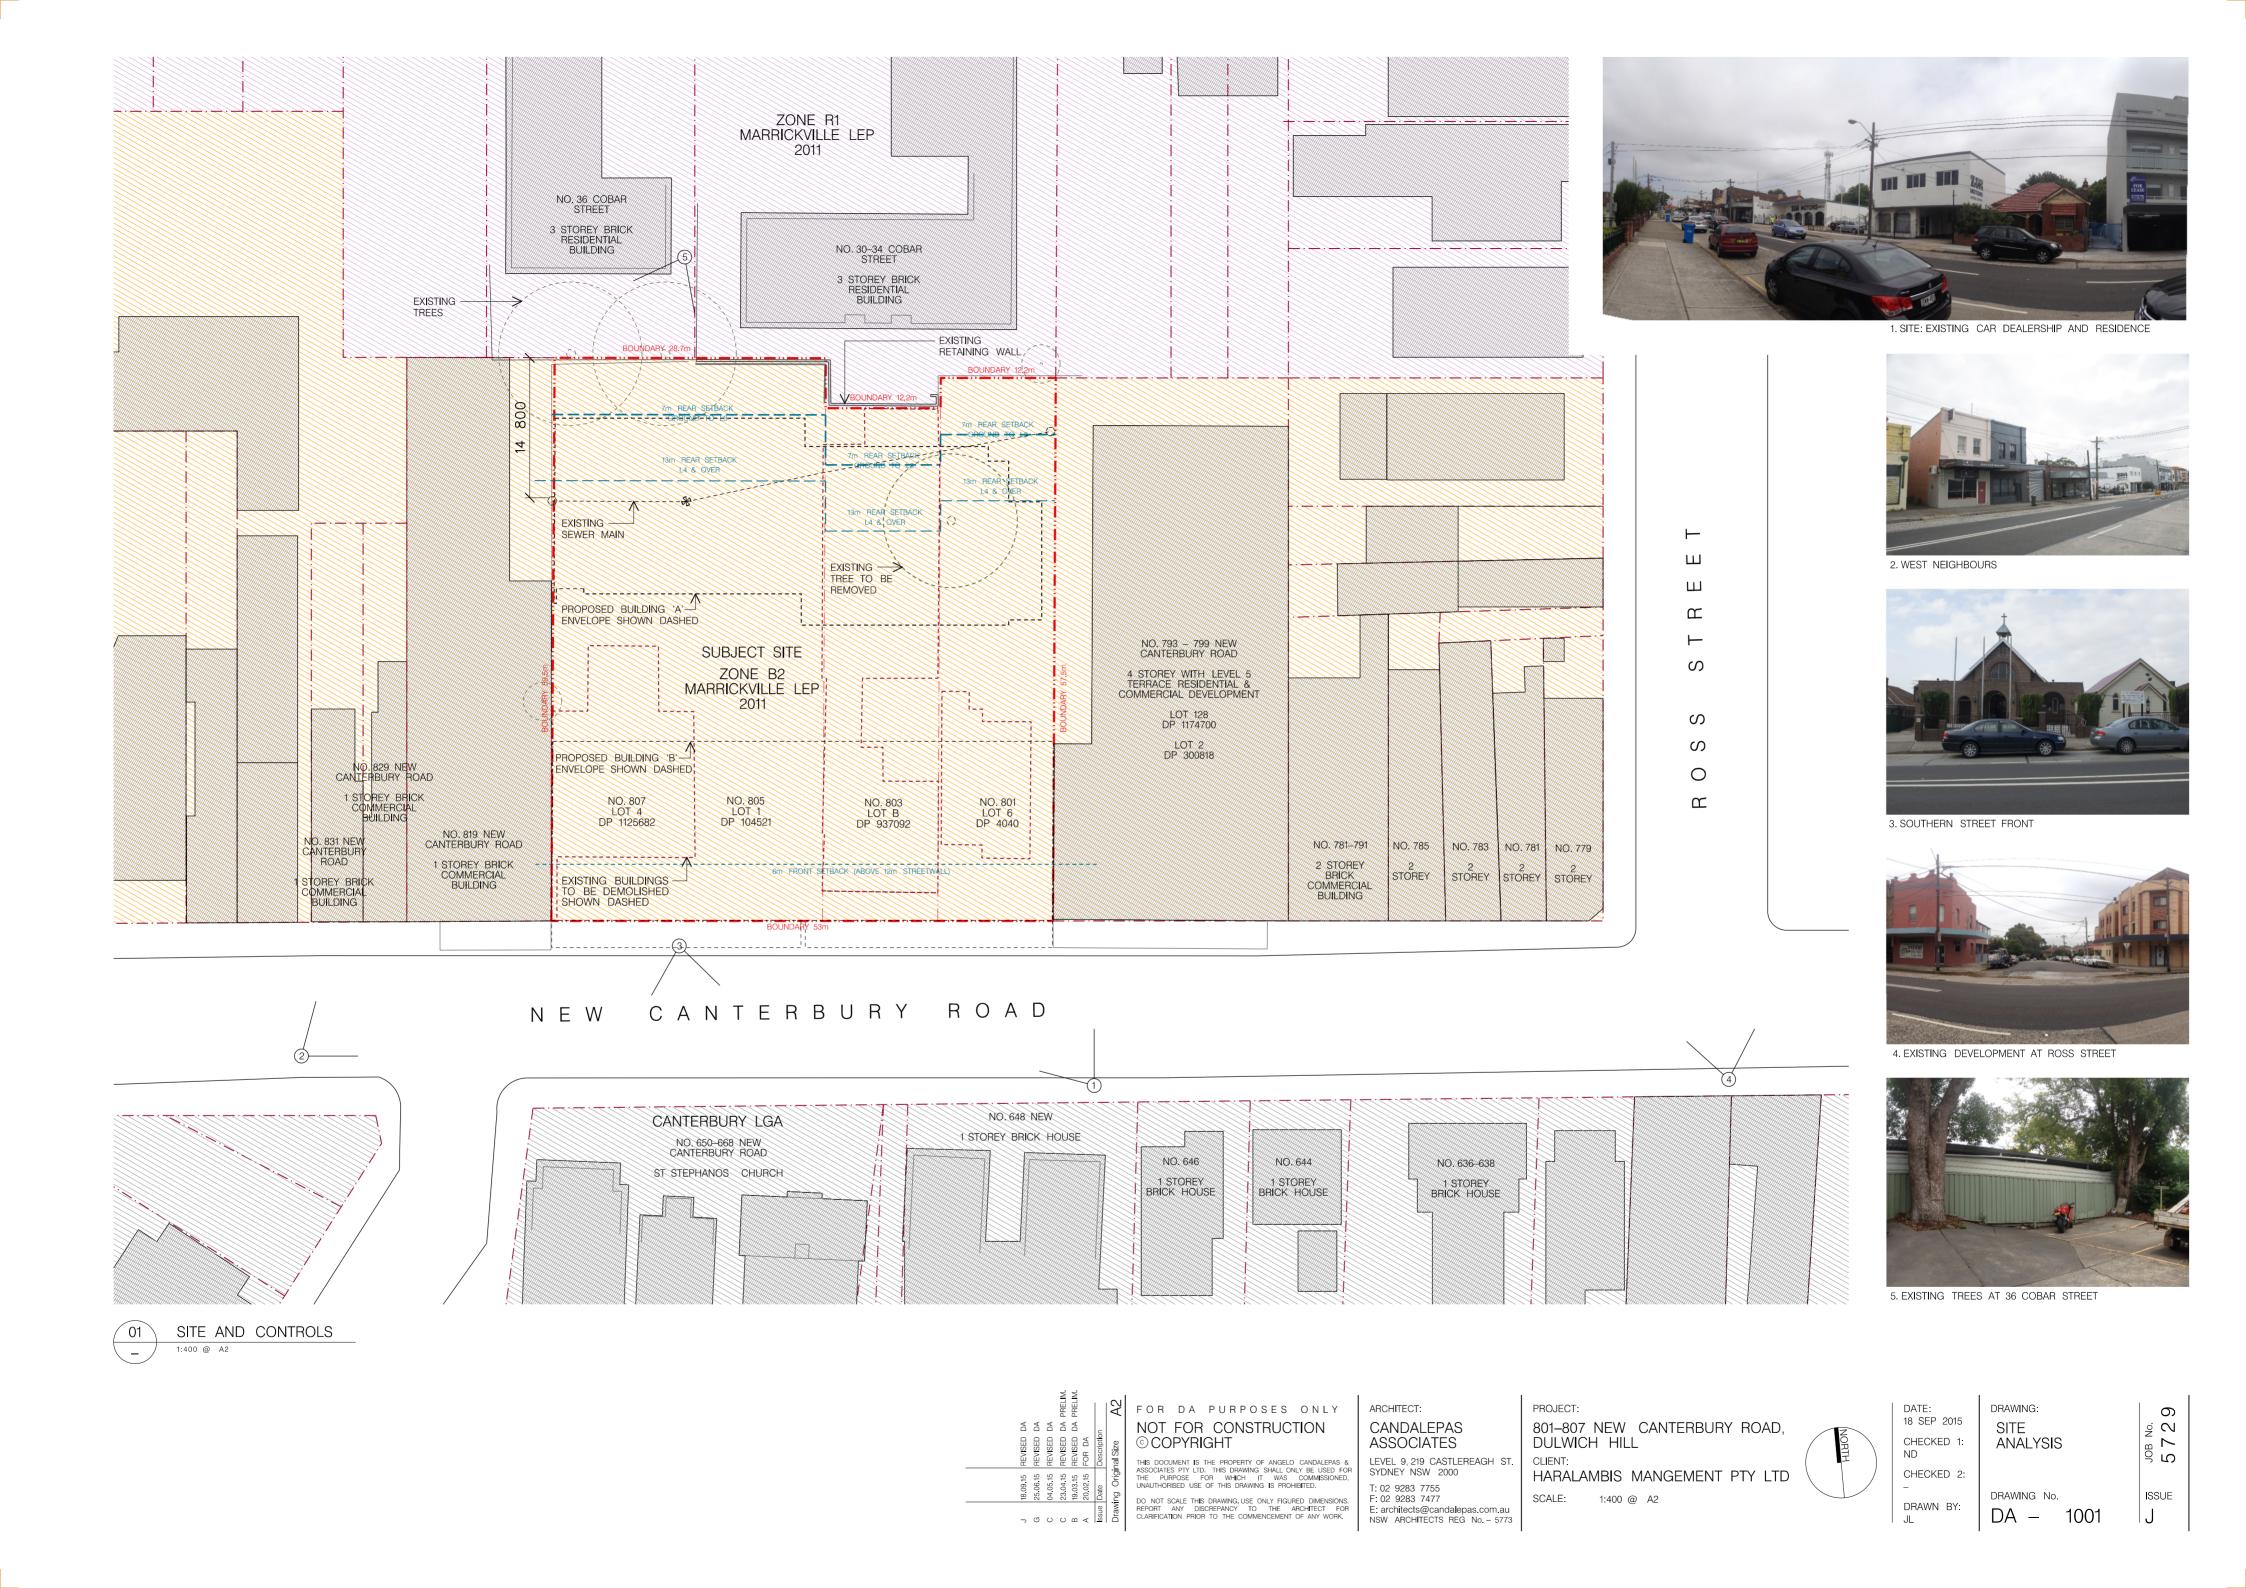

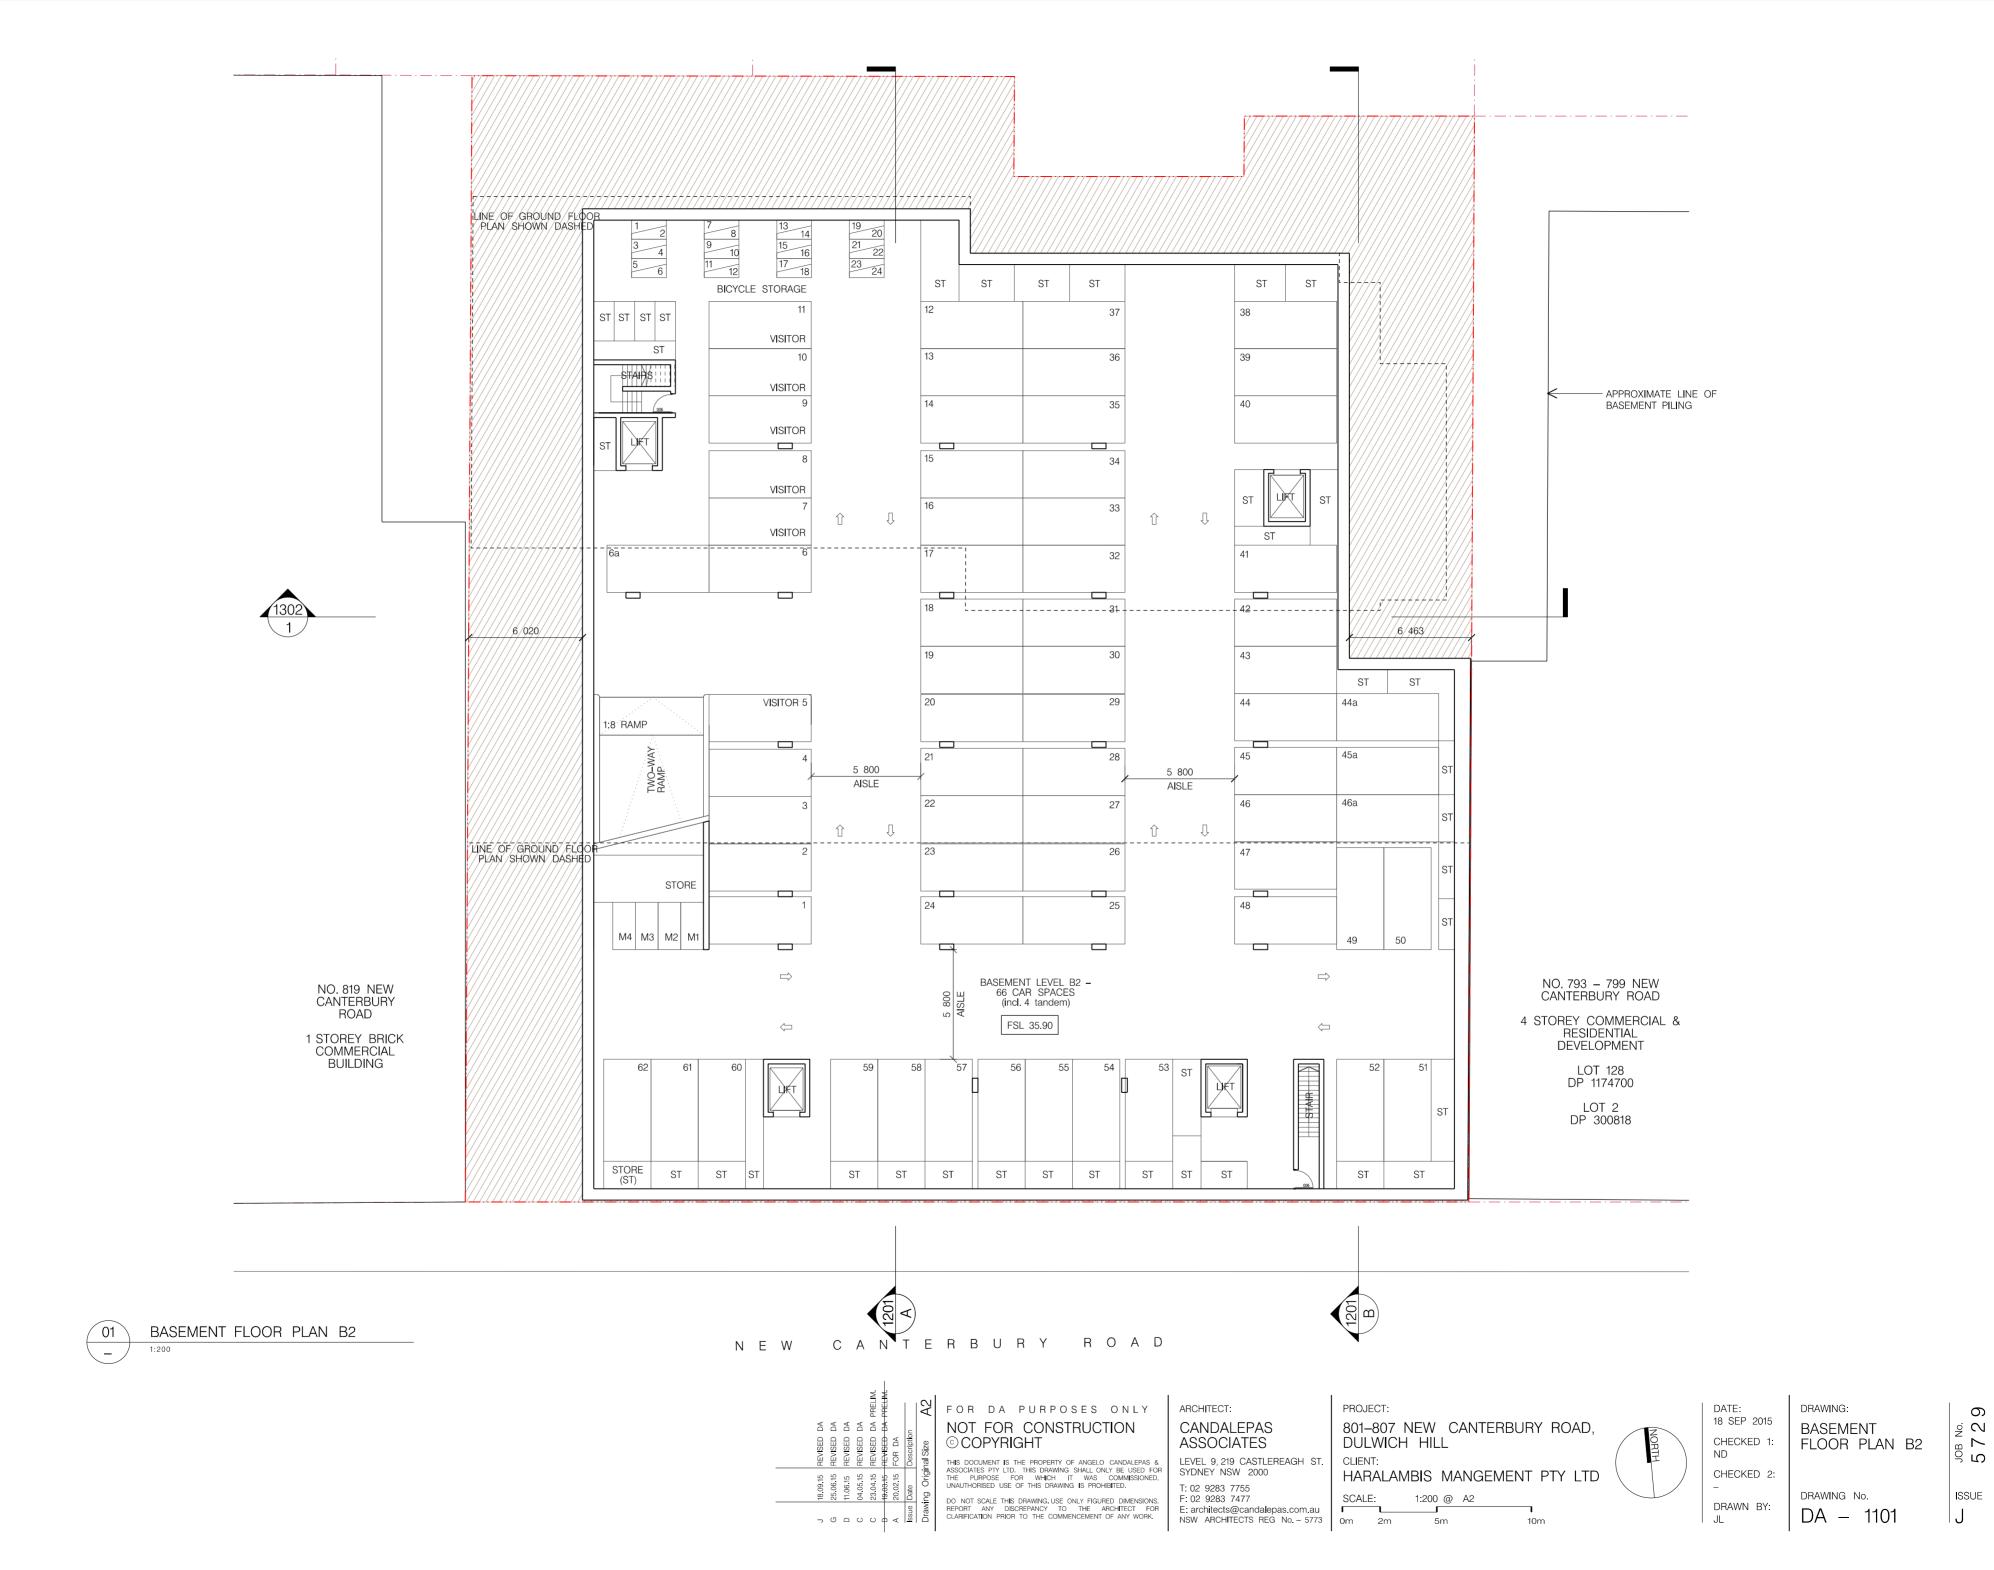

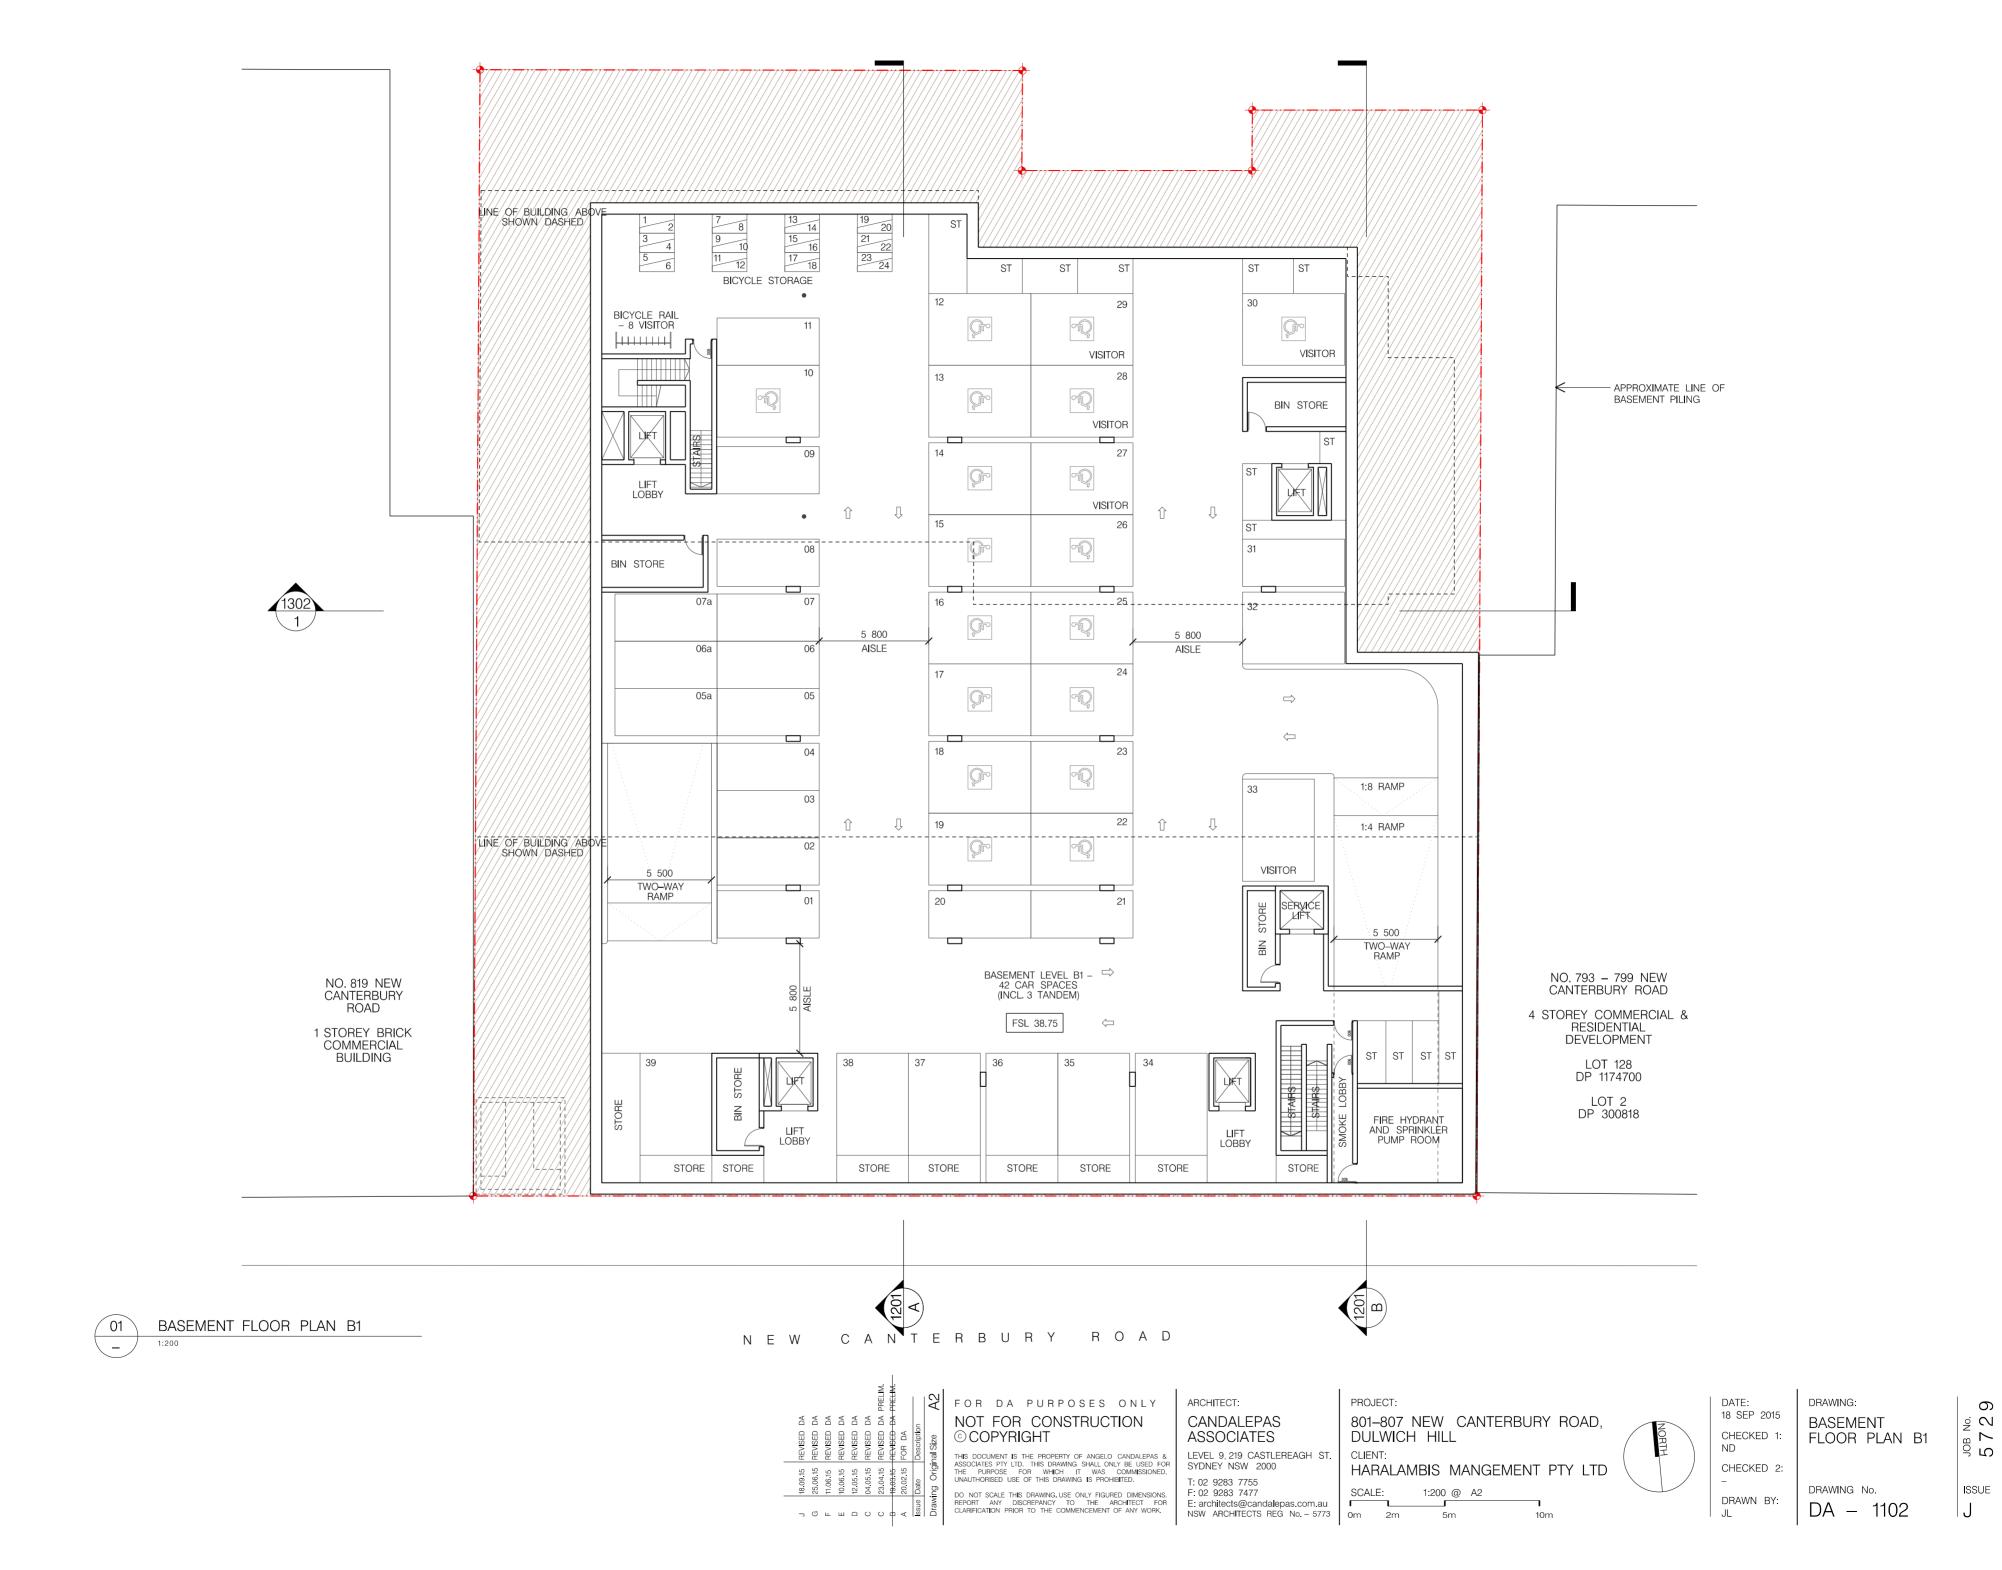

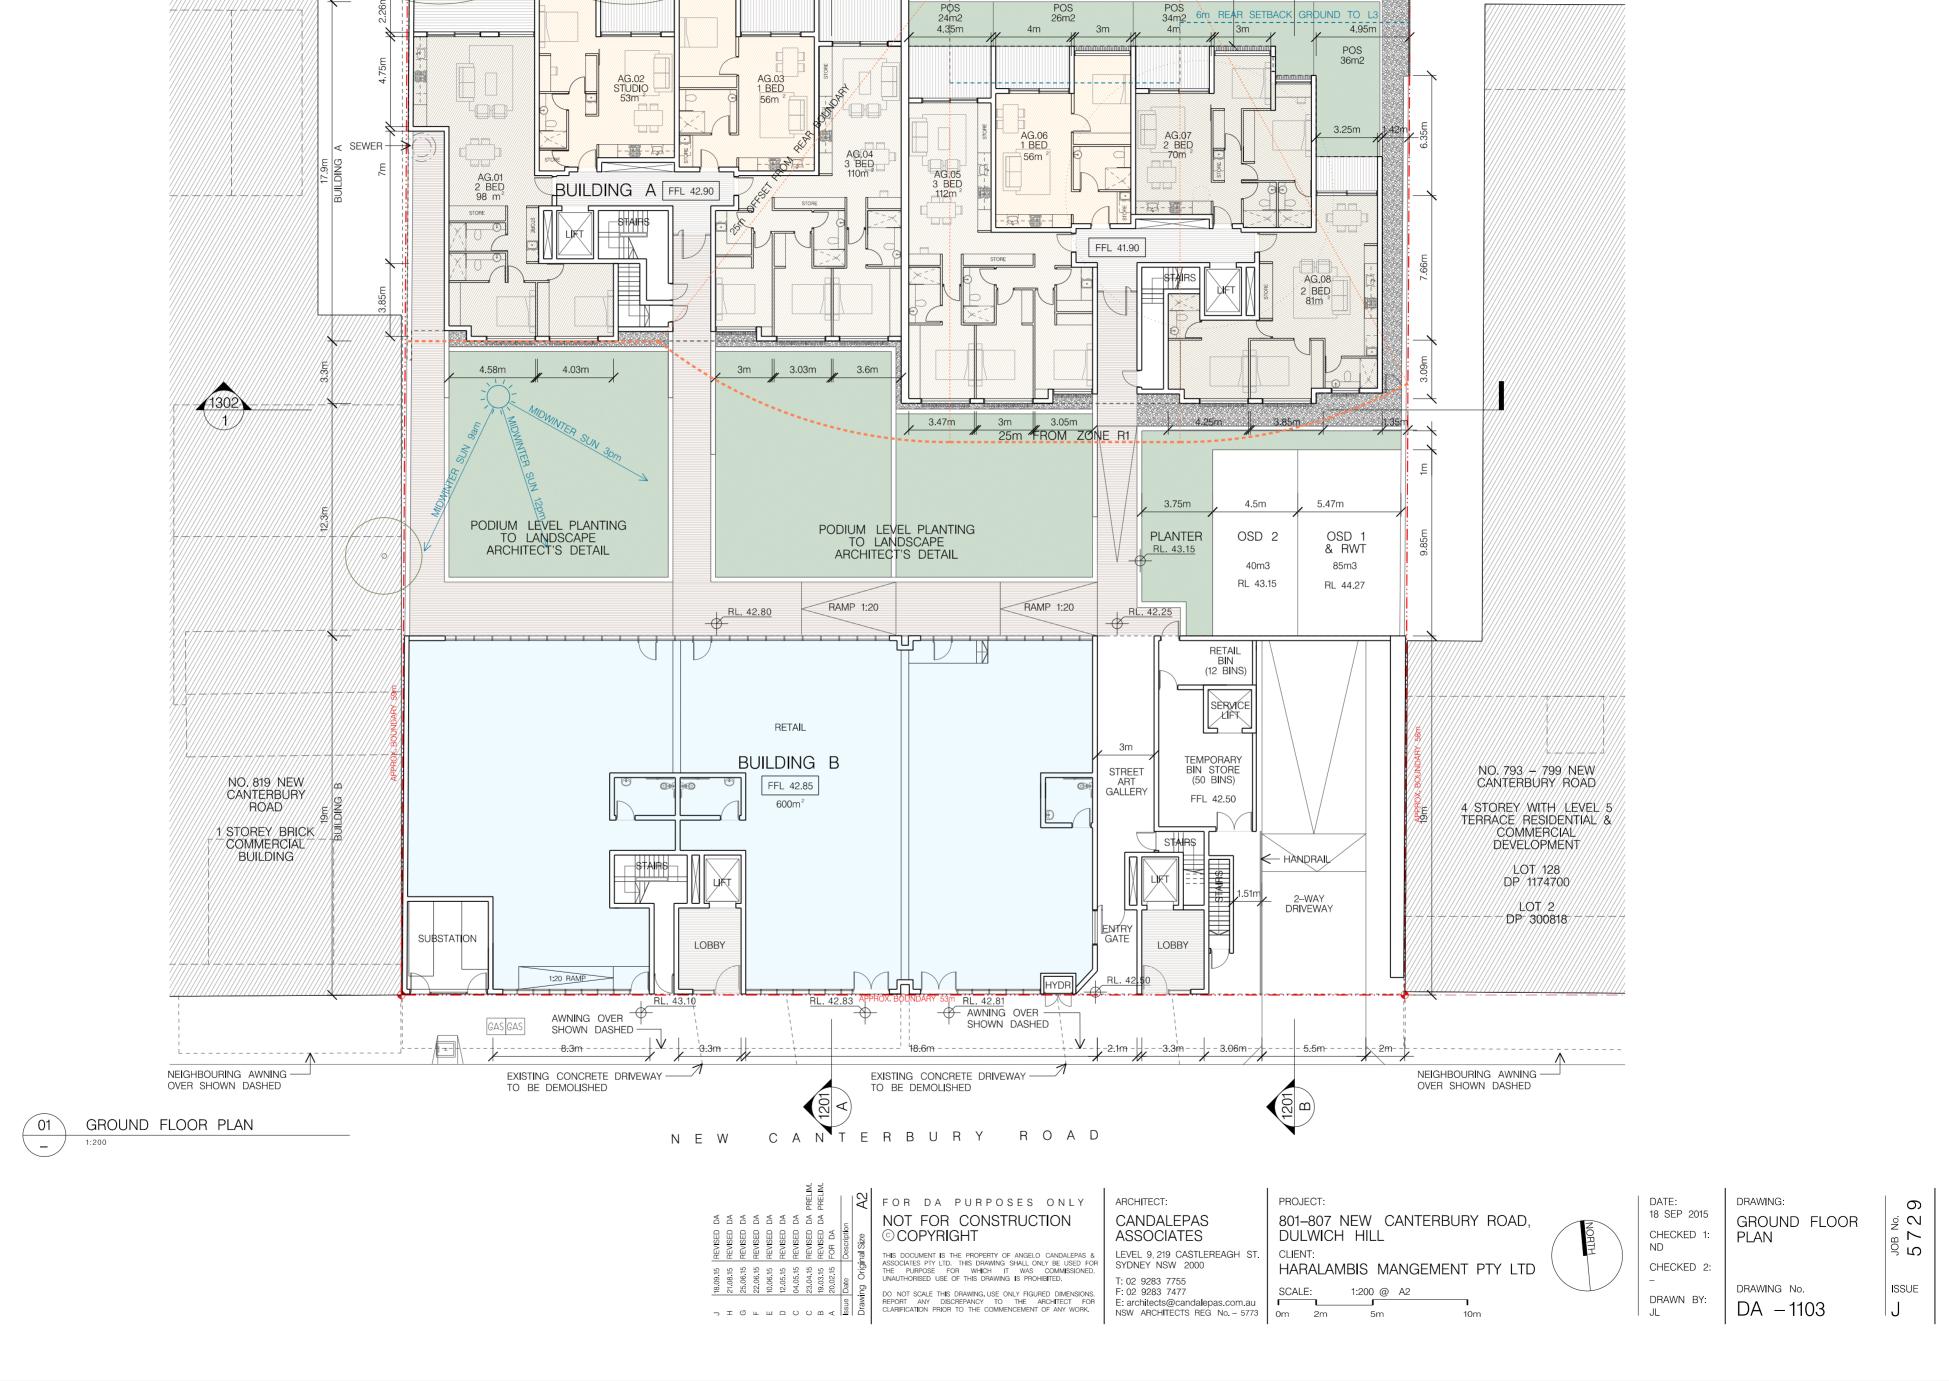

- EXISTING BRICK WALL TO

EXISTING BLOCK WORK RETAINING WALL

DEEP SOIL PLANTING TO

LAND\$CAPE ARCHITECT'S DETAIL

BE DEMOLISHED

8.9m 70 NEIGHB. BUILDING

DEEP SOIL PLANTING TO LANDSCAPE ARCHITECT'S DETAIL

PRIVATE OPEN SPACE

m REAR.38ETBACK

(POS) 27m2 4m 4.35m



LEVEL 1 FLOOR PLAN

| FOR DA PURPOSES ONLY NOT FOR CONSTRUCTION © COPYRIGHT

THIS DOCUMENT IS THE PROPERTY OF ANGELO CANDALEPAS & ASSOCIATES PTY LITD. THIS DRAWING SHALL ONLY BE USED FOR THE PURPOSE FOR WHICH IT WAS COMMISSIONED. UNAUTHORISED USE OF THIS DRAWING IS PROHIBITED. DO NOT SCALE THIS DRAWING, USE ONLY FIGURED DIMENSIONS.
REPORT ANY DISCREPANCY TO THE ARCHITECT FOR
CLARIFICATION PRIOR TO THE COMMENCEMENT OF ANY WORK.

ARCHITECT: CANDALEPAS ASSOCIATES LEVEL 9, 219 CASTLEREAGH ST. SYDNEY NSW 2000 F: 02 9283 7477
E: architects@candalepas.com.au
NSW ARCHITECTS REG No. - 5773

SCALE: 1:200 @ A2

Om 2m 5m

PROJECT: 801-807 NEW CANTERBURY ROAD, DULWICH HILL HARALAMBIS MANGEMENT PTY LTD

SCALE: 1:200 @ A2

DATE: DRAWING: 18 SEP 2015 LEVEL 1 FLOOR CHECKED 1: PLAN CHECKED 2: DRAWING No. DRAWN BY:


DA - 1104

0

≥ 0

JOB 1

ISSUE

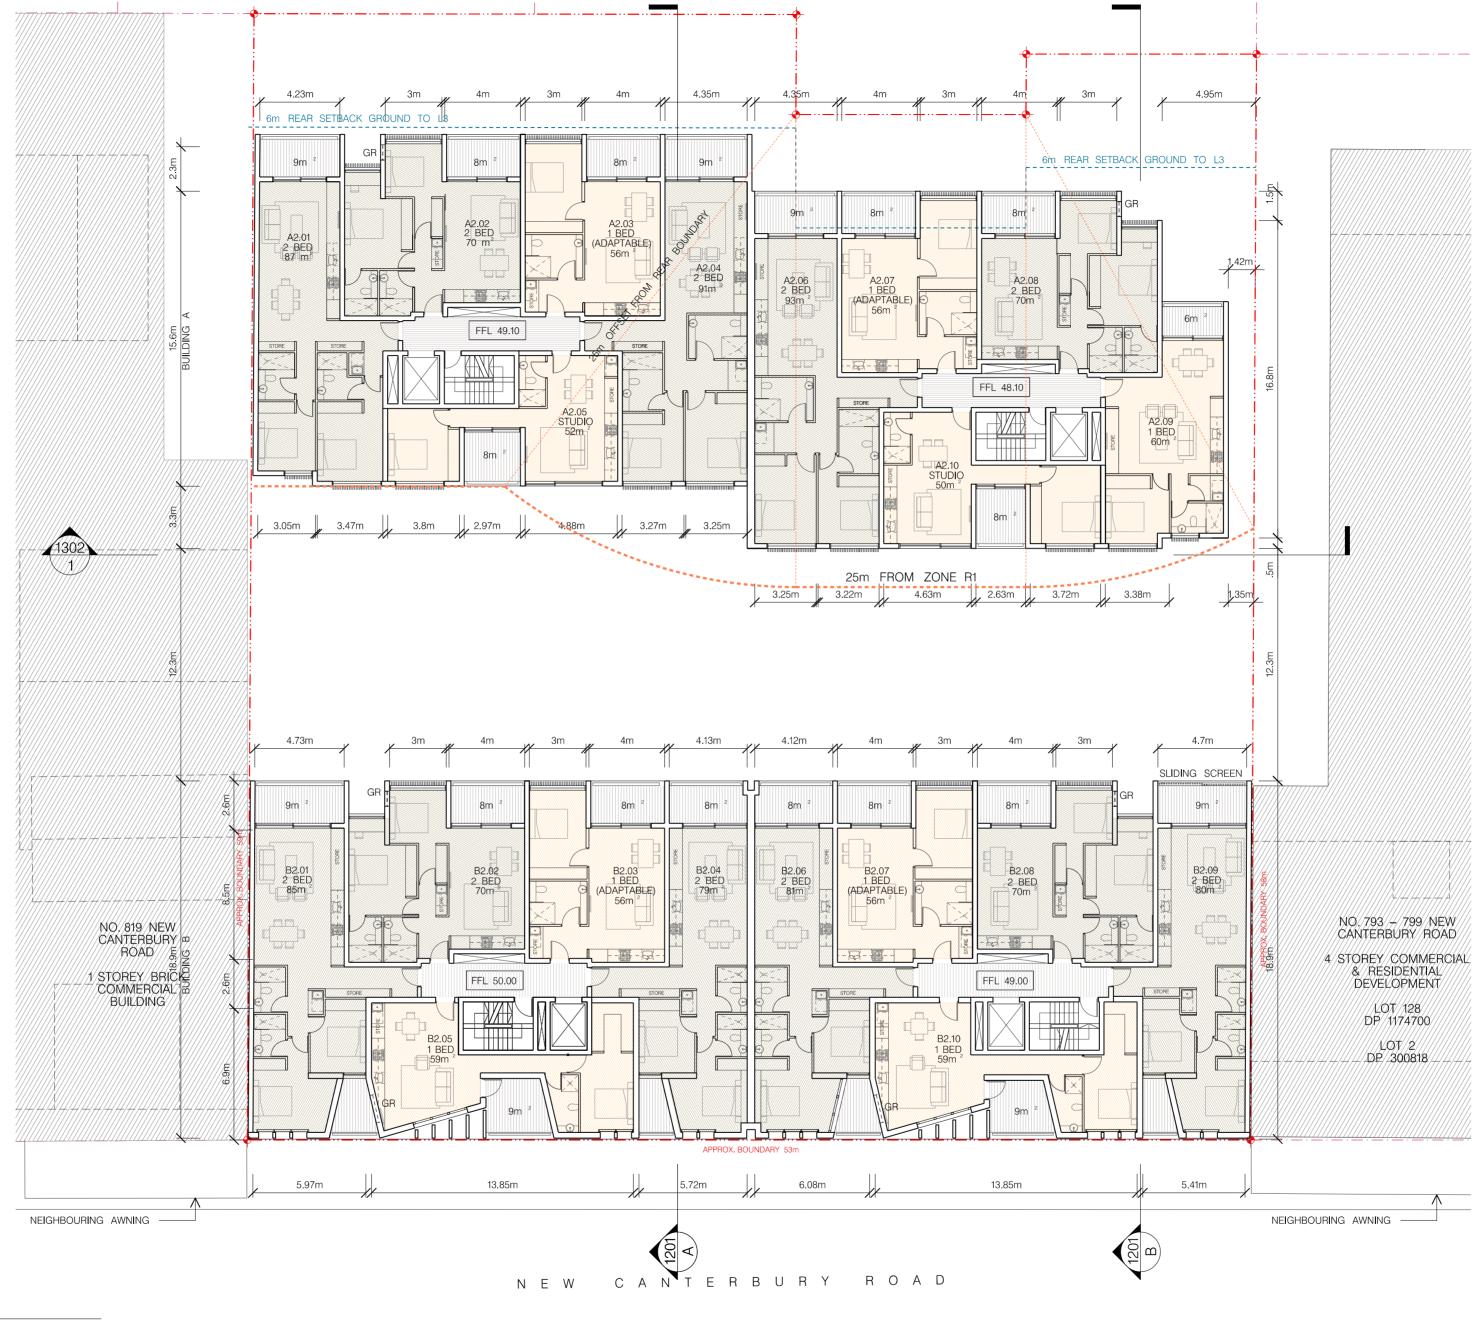

LEVEL 2 FLOOR PLAN

8 8 8 8 8

| | S | FOR DA PURPOSES ONLY NOT FOR CONSTRUCTION © COPYRIGHT

THIS DOCUMENT IS THE PROPERTY OF ANGELO CANDALEPAS & ASSOCIATES PTY LITD. THIS DRAWING SHALL ONLY BE USED FOR THE PURPOSE FOR WHICH IT WAS COMMISSIONED. UNAUTHORISED USE OF THIS DRAWING IS PROHIBITED. DO NOT SCALE THIS DRAWING USE ONLY FIGURED DIMENSIONS.
REPORT ANY DISCREPANCY TO THE ARCHITECT FOR CLARIFICATION PRIOR TO THE COMMENCEMENT OF ANY WORK.

CANDALEPAS ASSOCIATES LEVEL 9, 219 CASTLEREAGH ST. SYDNEY NSW 2000 F: 02 9283 7477
E: architects@candalepas.com.au
NSW ARCHITECTS REG No. - 5773


SCALE: 1:200 @ A2

Om 2m 5m

ARCHITECT:

PROJECT: 801-807 NEW CANTERBURY ROAD, DULWICH HILL HARALAMBIS MANGEMENT PTY LTD


SCALE: 1:200 @ A2

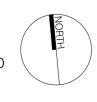



DATE: DRAWING: 18 SEP 2015 CHECKED 1: ND CHECKED 2:


DRAWN BY:

0 LEVEL 2 | ≥ 0 FLOOR PLAN JOB 7 ISSUE DRAWING No. DA - 1105

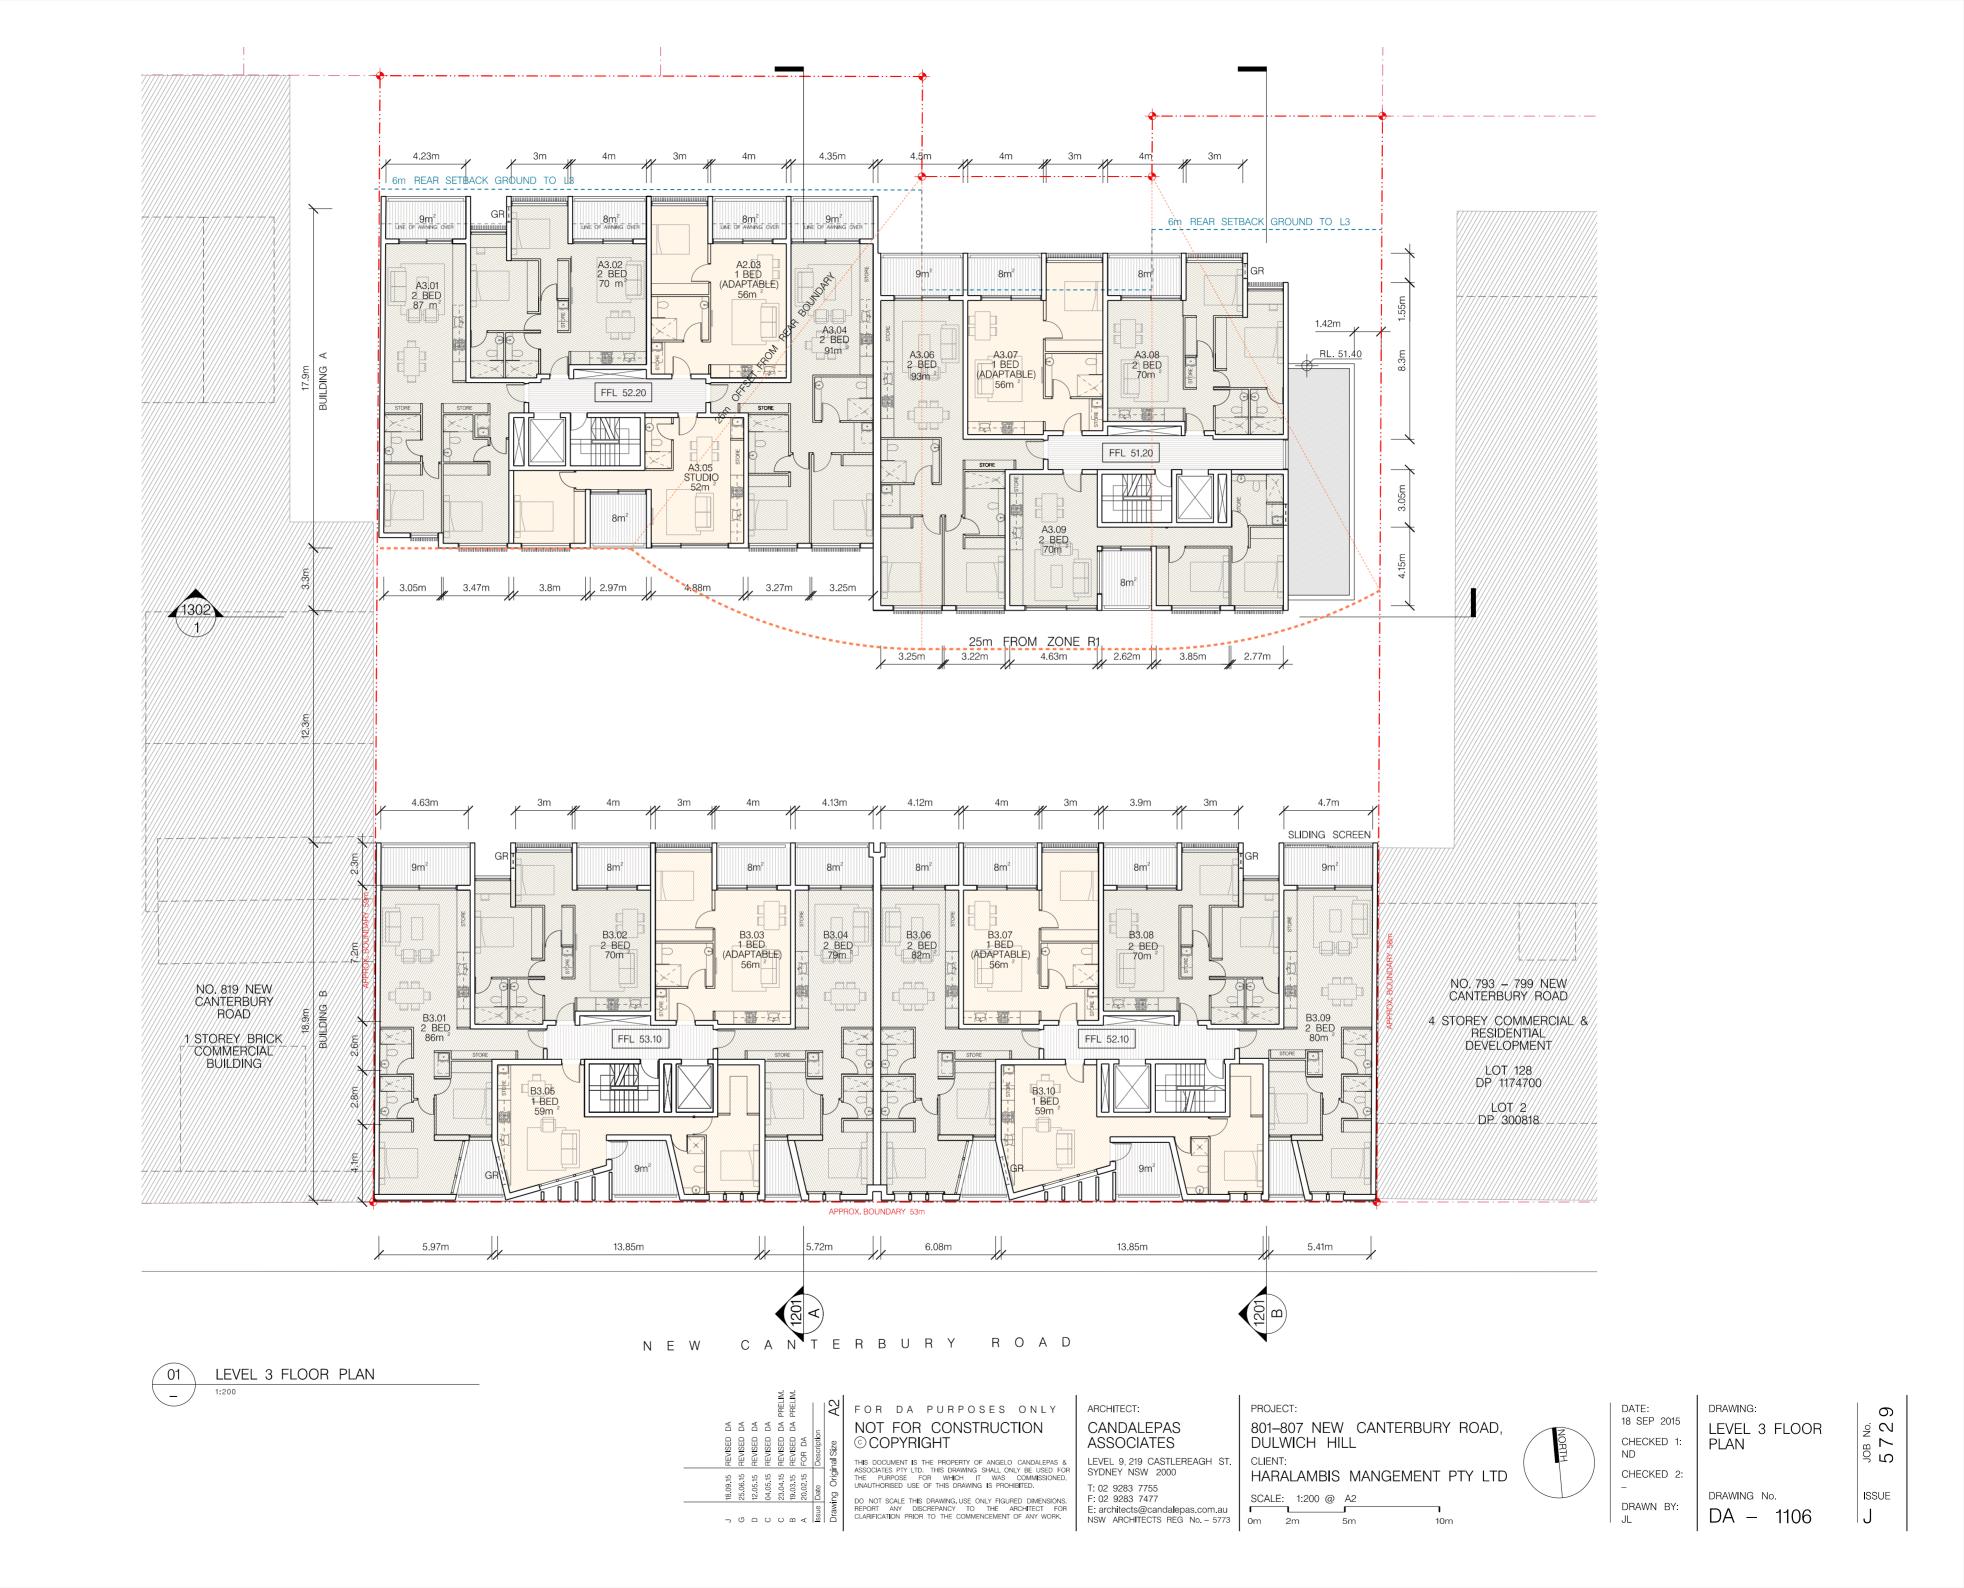

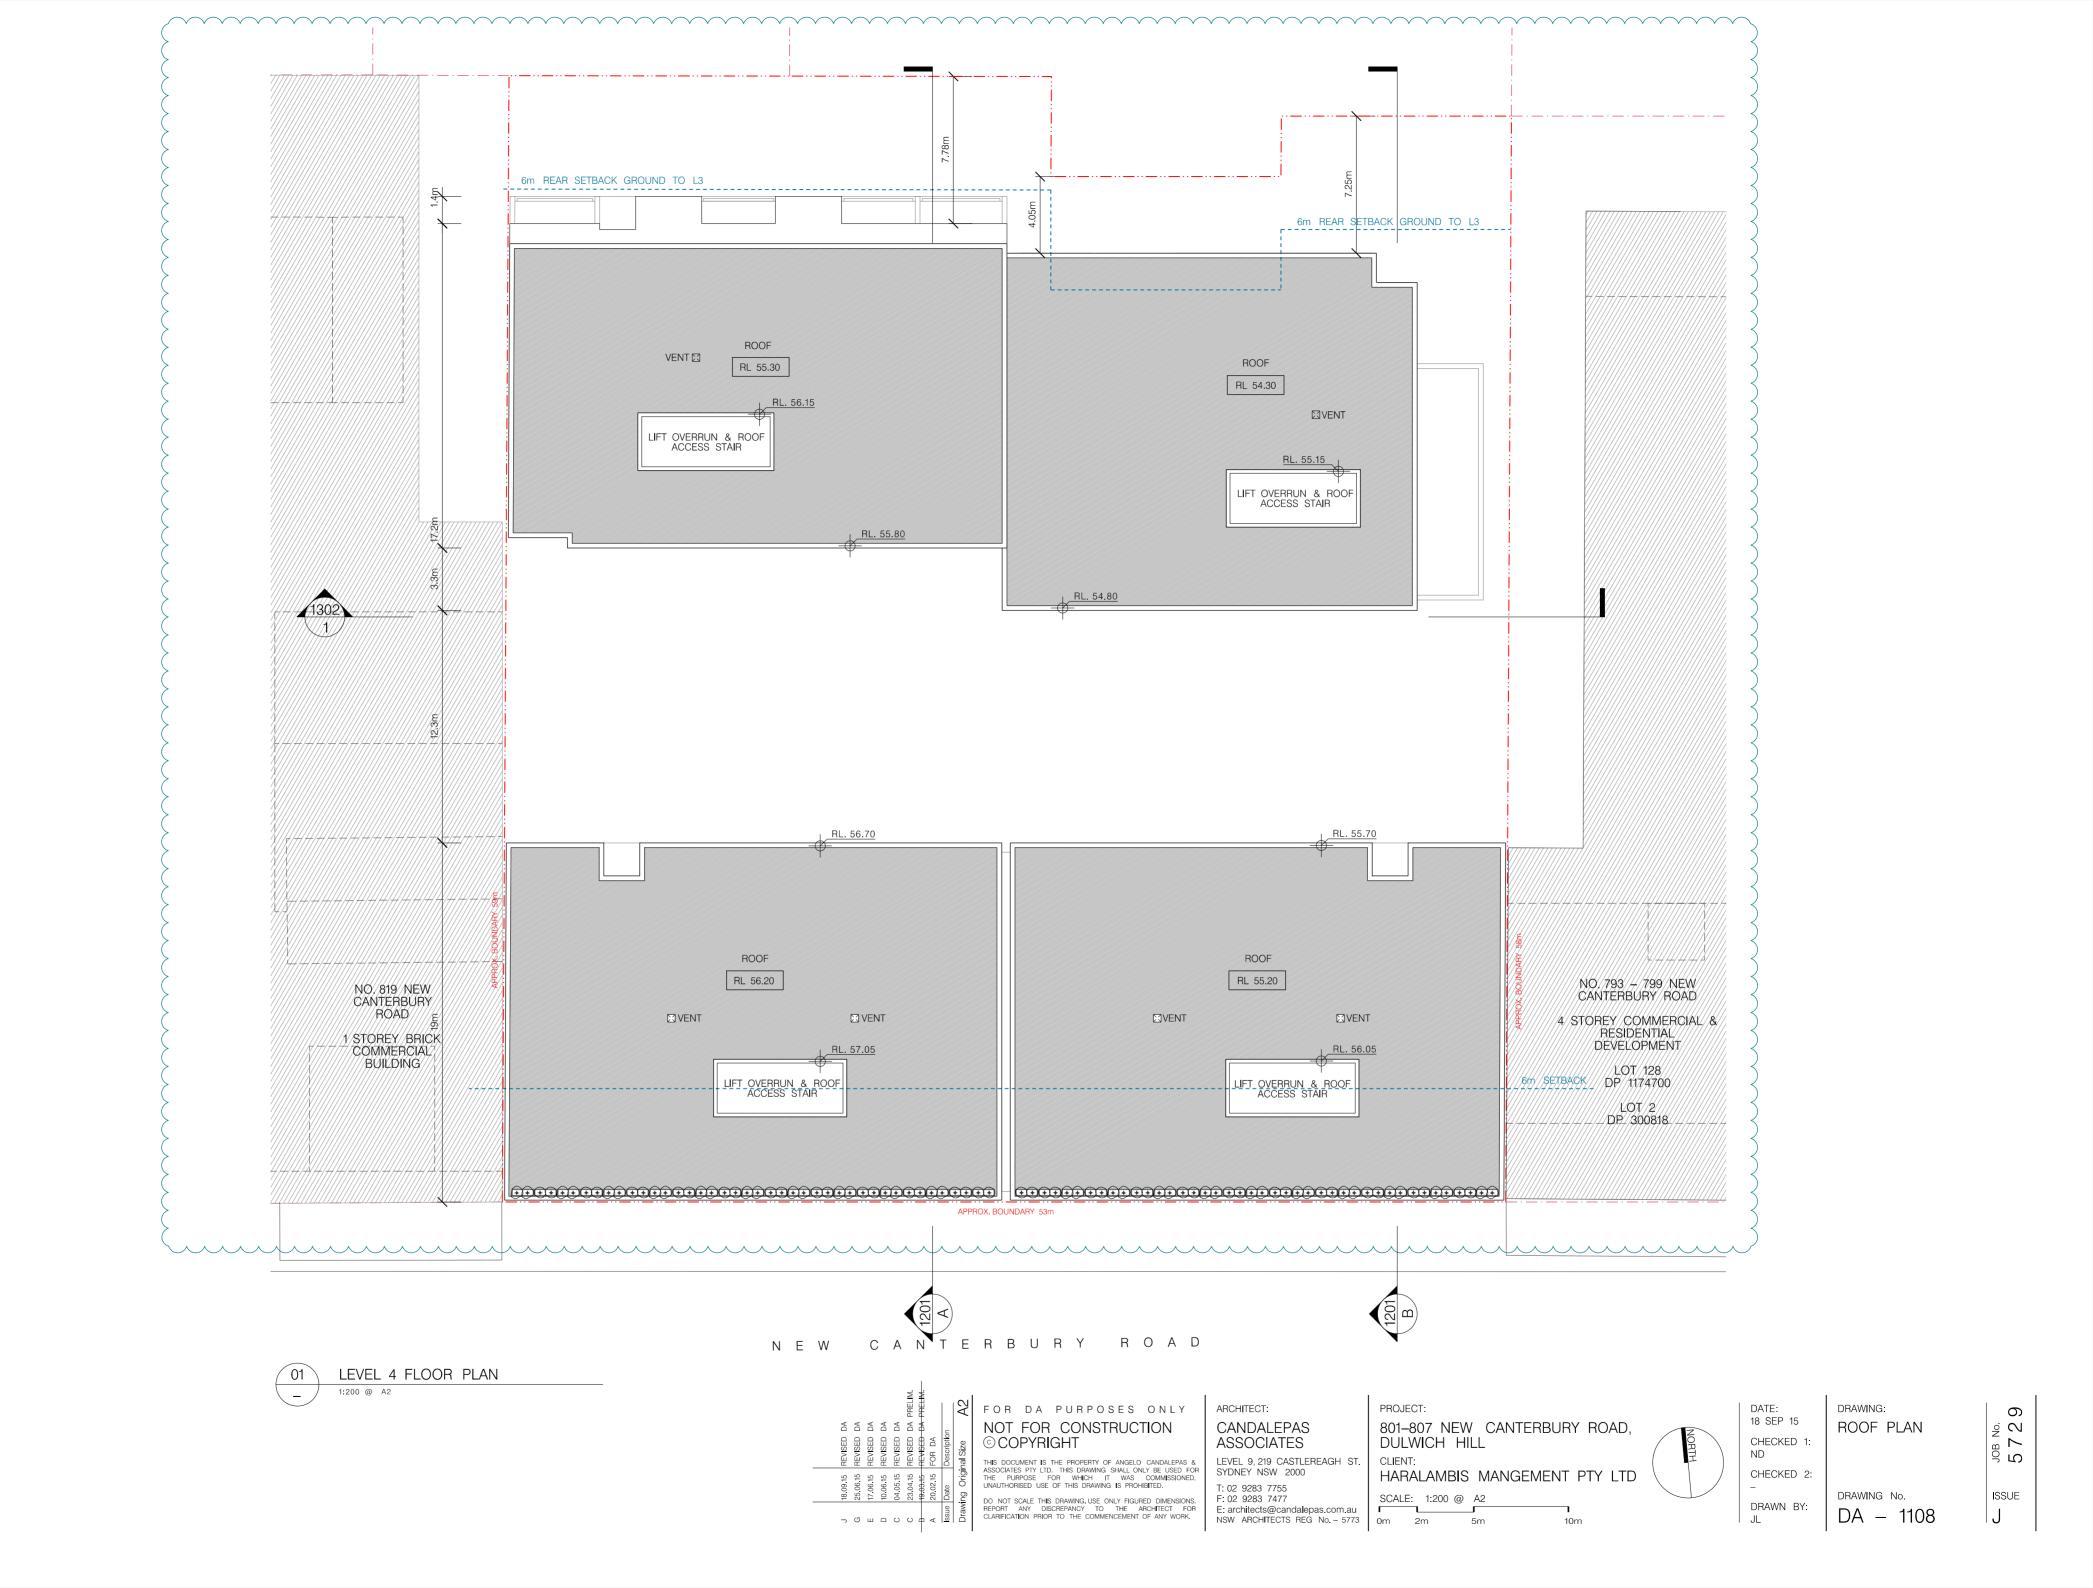

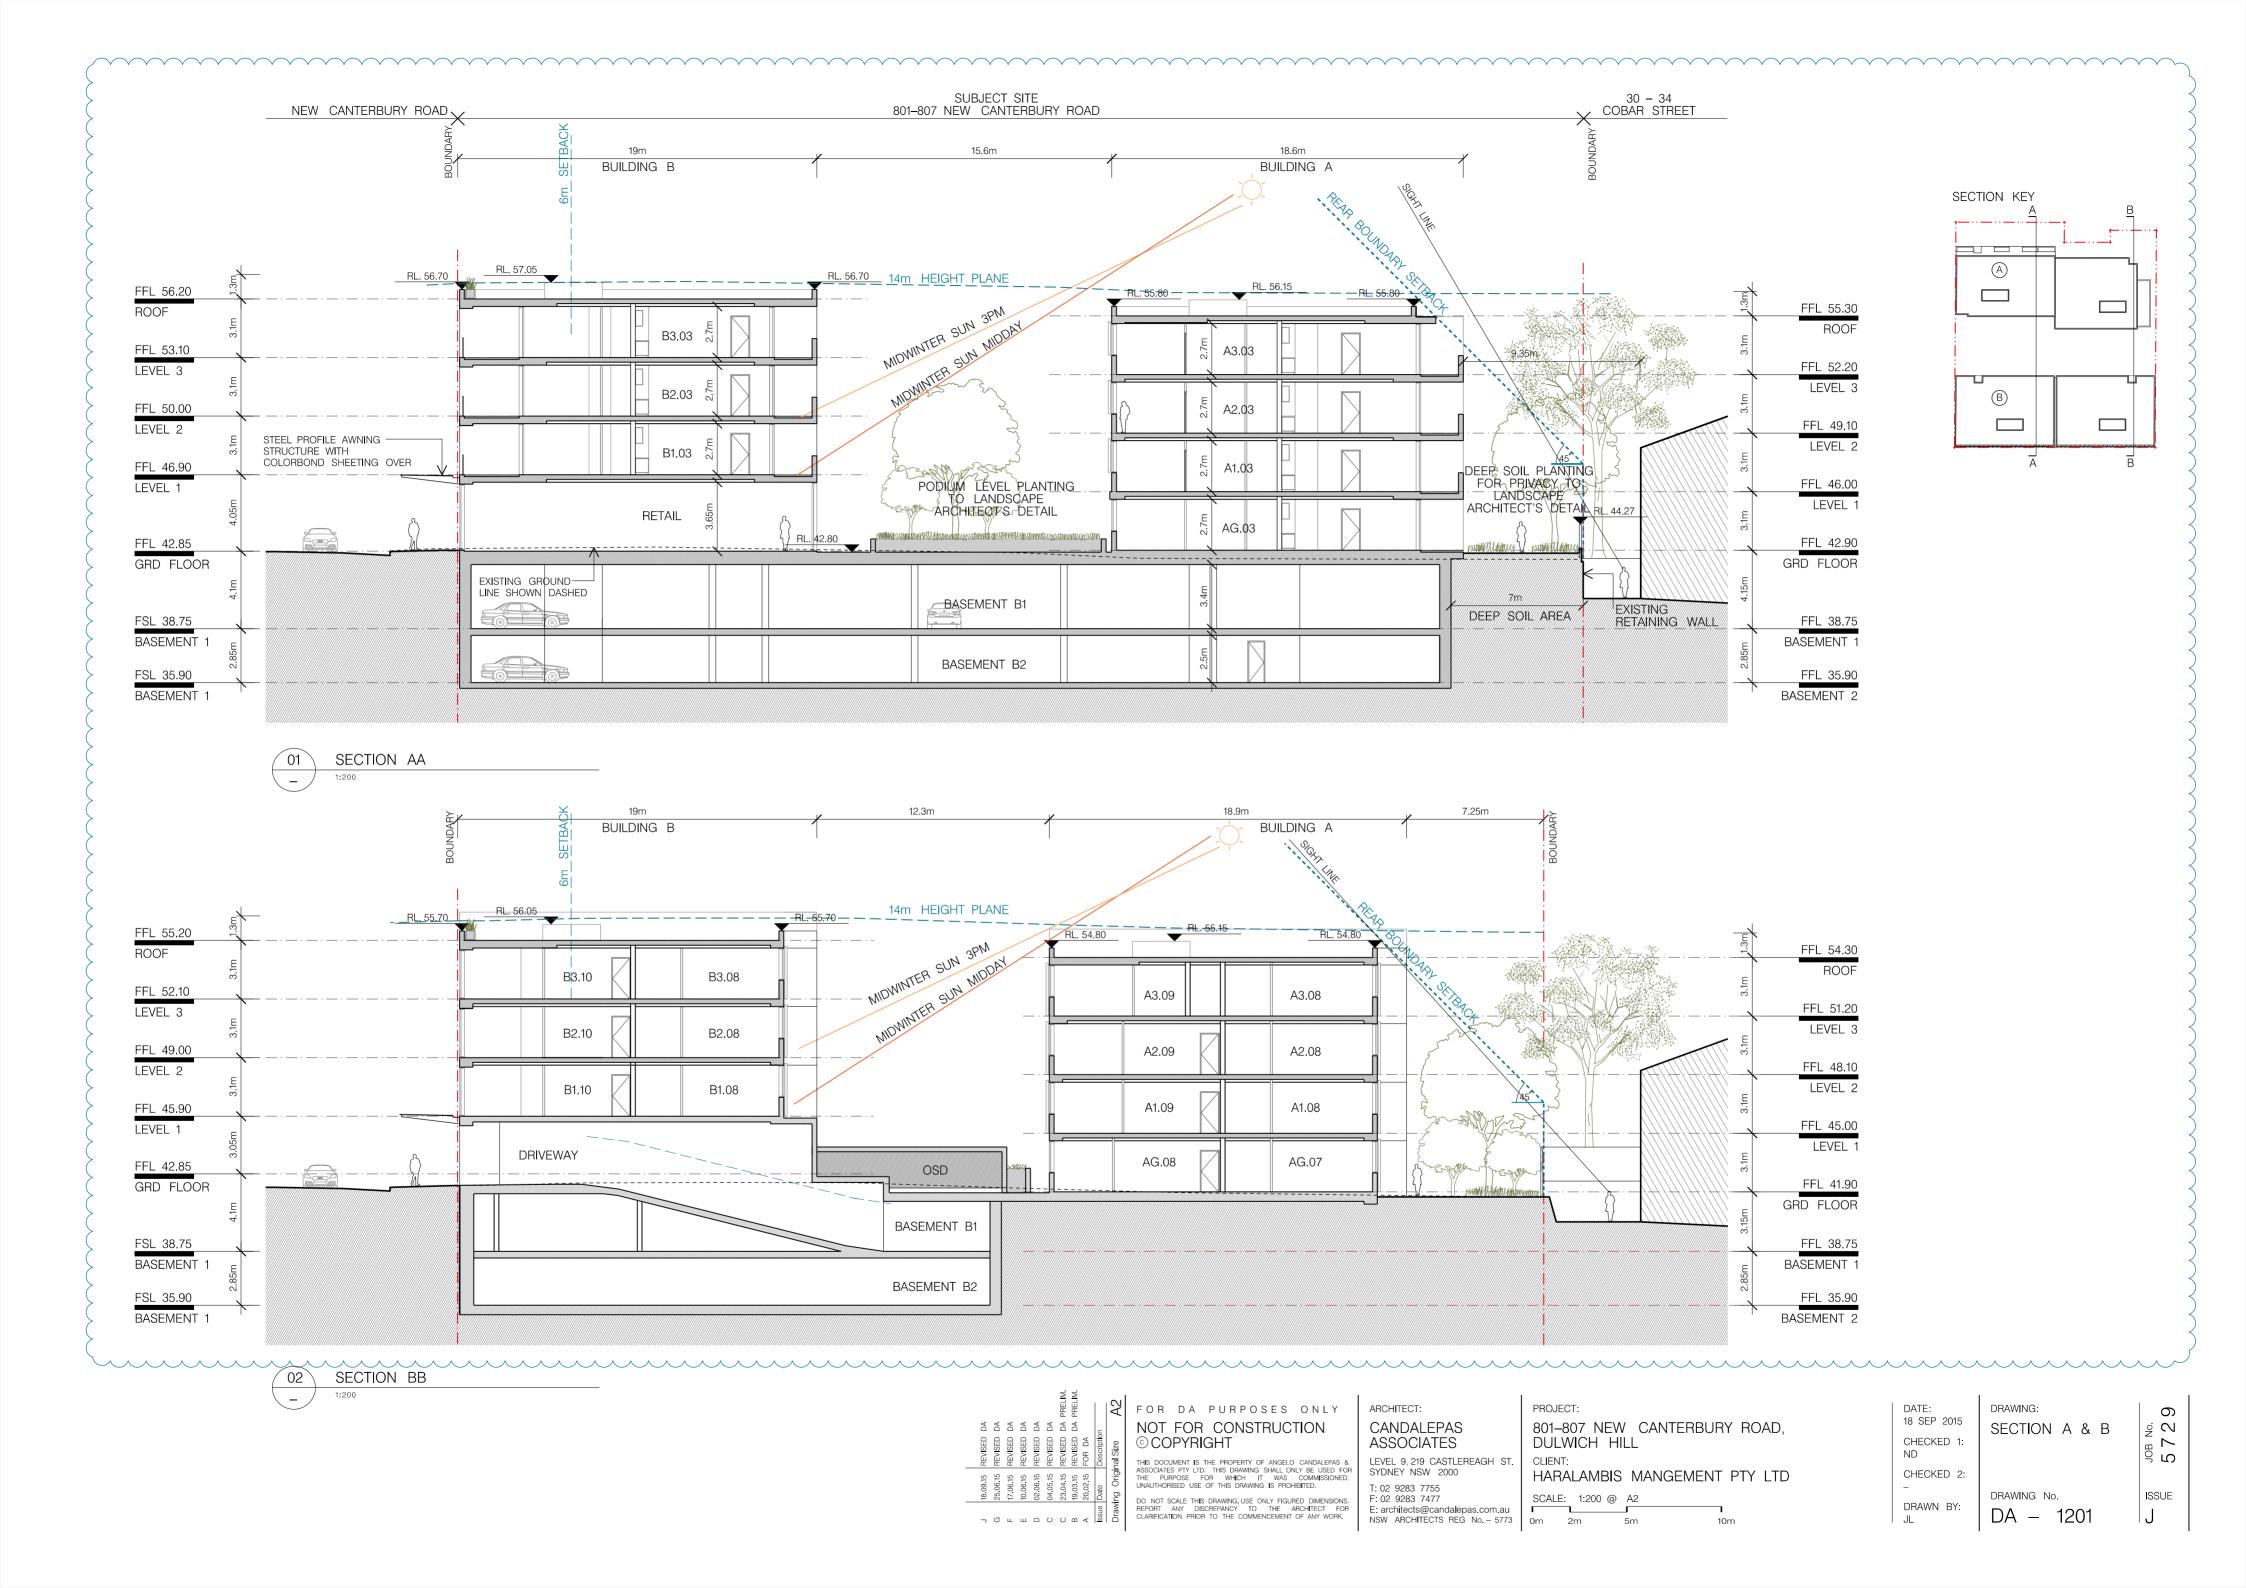

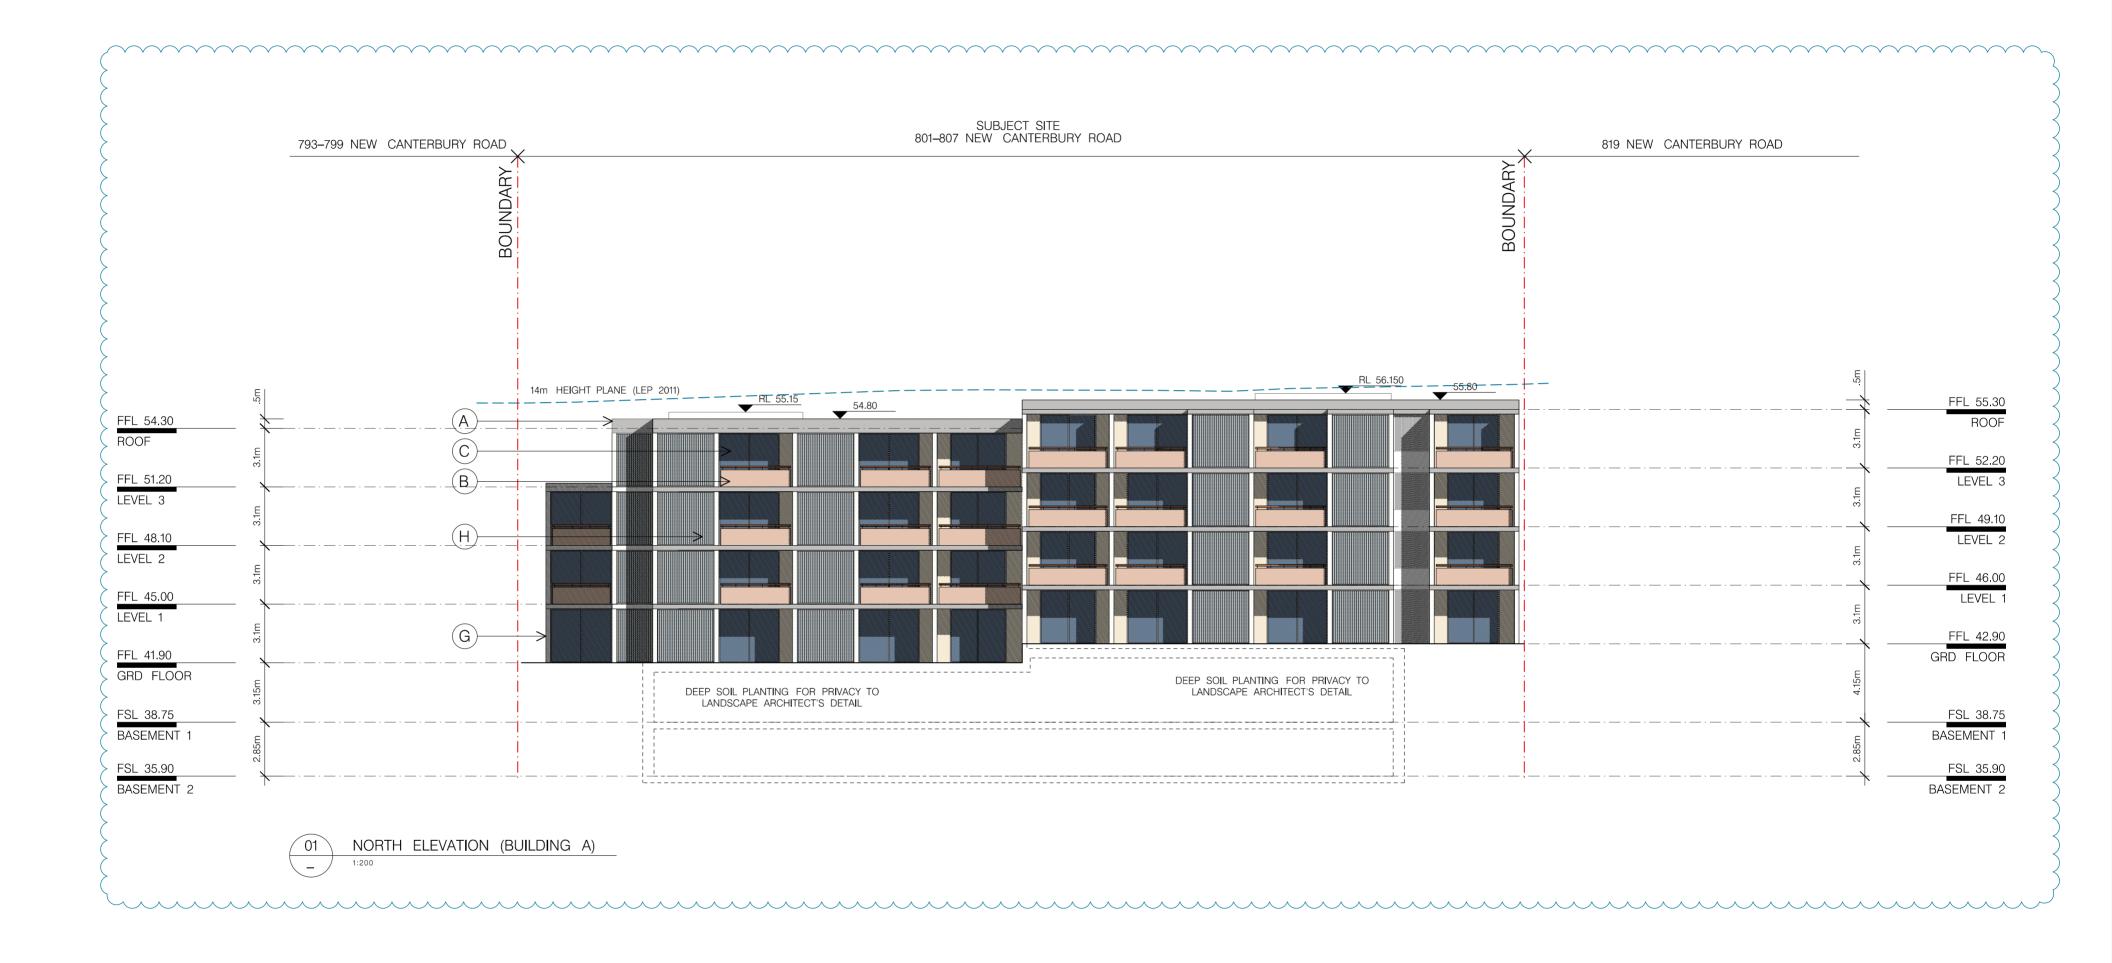



18.09.15 REVISED DA
25.06.15 REVISED DA
23.04.15 REVISED DA
19.09.15 REVISED DA
19.09.15 REVISED DA
19.09.15 REVISED DA PRELIN
20.02.15 FOR DA
ssue Date Description

FOR DA PURPOSES ONLY
NOT FOR CONSTRUCTION
© COPYRIGHT

THIS DOCUMENT IS THE PROPERTY OF ANGELO CANDALEPAS & ASSOCIATES PTY LTD. THIS DRAWING SHALL ONLY BE USED FOR THE PURPOSE FOR WHICH IT WAS COMMISSIONED. UNAUTHORISED USE OF THIS DRAWING IS PROHIBITED.

DO NOT SCALE THIS DRAWING, USE ONLY FIGURED DIMENSIONS. REPORT ANY DISCREPANCY TO THE ARCHITECT FOR CLARIFICATION PRIOR TO THE COMMENCEMENT OF ANY WORK.

ARCHITECT:

CANDALEPAS
ASSOCIATES

LEVEL 9, 219 CASTLEREAGH ST.
SYDNEY NSW 2000

T: 02 9283 7755
F: 02 9283 7477
E: architects@candalepas.com.au
NSW ARCHITECTS REG No. - 5773

PROJECT:

801-807 N
DULWICH
CLIENT:
HARALAMI
SCALE: 1:200
Om 2m

PROJECT:


801–807 NEW CANTERBURY ROAD,
DULWICH HILL

CLIENT:
HARALAMBIS MANGEMENT PTY LTD

SCALE: 1:200 @ A2

DATE:
18 SEP 2015
CHECKED 1:
ND
CHECKED 2:
DRAWING:
NORTH ELEVATION
BUILDING A

DRAWING No.
DATE:
18 SEP 2015
DRAWING:
NO CHECKED 2:
DRAWING No.

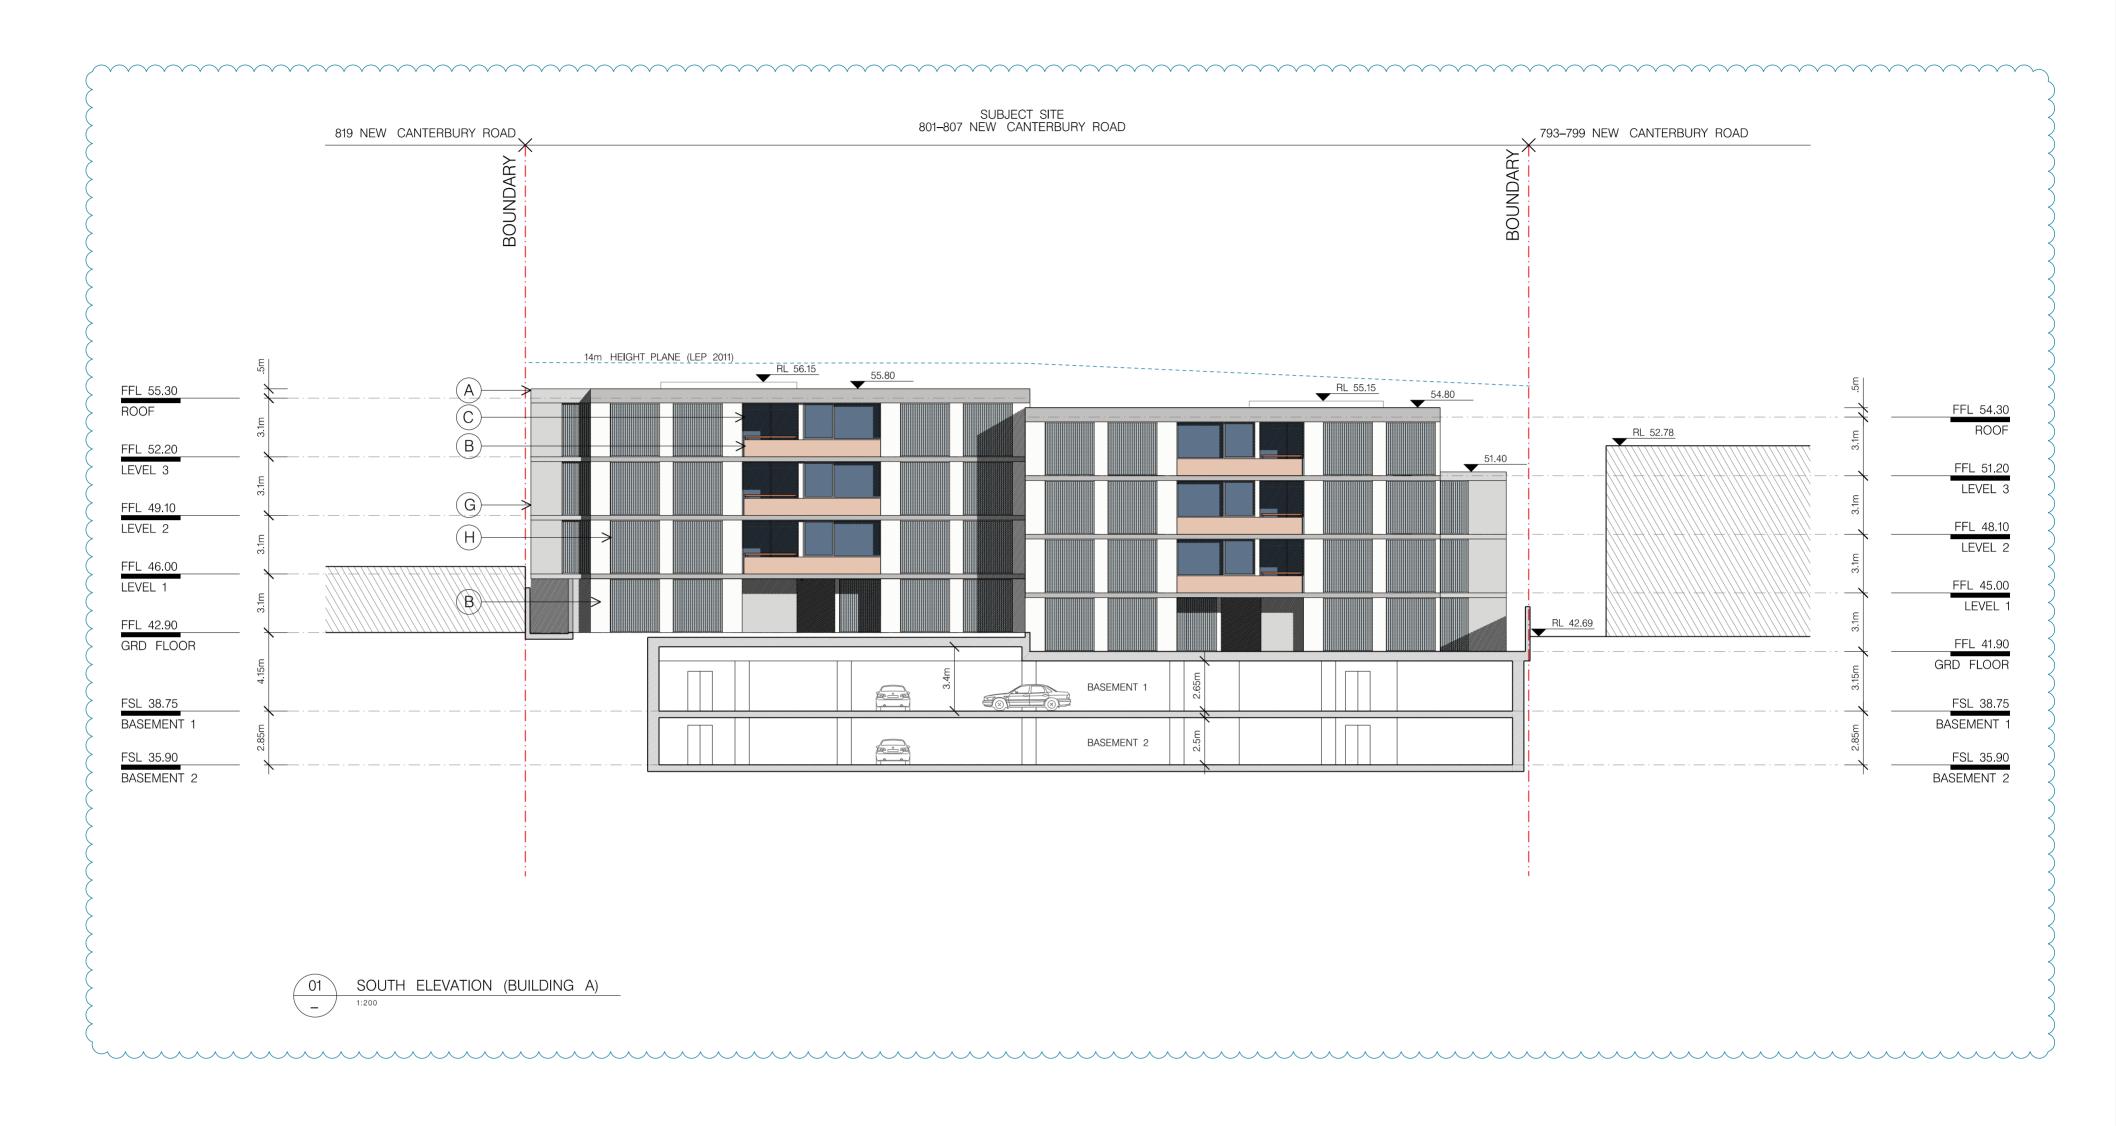



18.09.15 REVISED DA 25.06.15 REVISED DA 04.05.15 REVISED DA 23.04.15 REVISED DA 23.04.15 REVISED DA PREL 19.03.15 REVISED DA PREL 20.02.15 FOR DA sue Date Description

FOR DA PURPOSES ONLY
NOT FOR CONSTRUCTION
© COPYRIGHT

THIS DOCUMENT IS THE PROPERTY OF ANGELO CANDALEPAS & ASSOCIATES PTY LTD. THIS DRAWING SHALL ONLY BE USED FOR THE PURPOSE FOR WHICH IT WAS COMMISSIONED, UNAUTHORISED USE OF THIS DRAWING IS PROHIBITED.

DO NOT SCALE THIS DRAWING. USE ONLY FIGURED UNBENSIONS, REPORT ANY DISCREPANCY TO THE ARCHITECT FOR CLARIFICATION PRIOR TO THE COMMENCEMENT OF ANY WORK.

ARCHITECT:

CANDALEPAS
ASSOCIATES

LEVEL 9, 219 CASTLEREAGH ST.
SYDNEY NSW 2000

T: 02 9283 7755
F: 02 9283 7477
E: architects@candalepas.com.au
NSW ARCHITECTS REG No. - 5773

PROJECT:

801-807 N
DULWICH
CLIENT:
HARALAMI
SCALE: 1:200
Om 2m

PROJECT:


801–807 NEW CANTERBURY ROAD,
DULWICH HILL

CLIENT:
HARALAMBIS MANGEMENT PTY LTD

SCALE: 1:200 @ A2

DATE:
18 SEP 2015
CHECKED 1:
ND
CHECKED 2:
DRAWING:
SOUTH ELEVATION
BUILDING A

PO CHECKED 2:
DRAWING No.
DRAWING No.
JL
DRAWING No.
DA — 1302
J

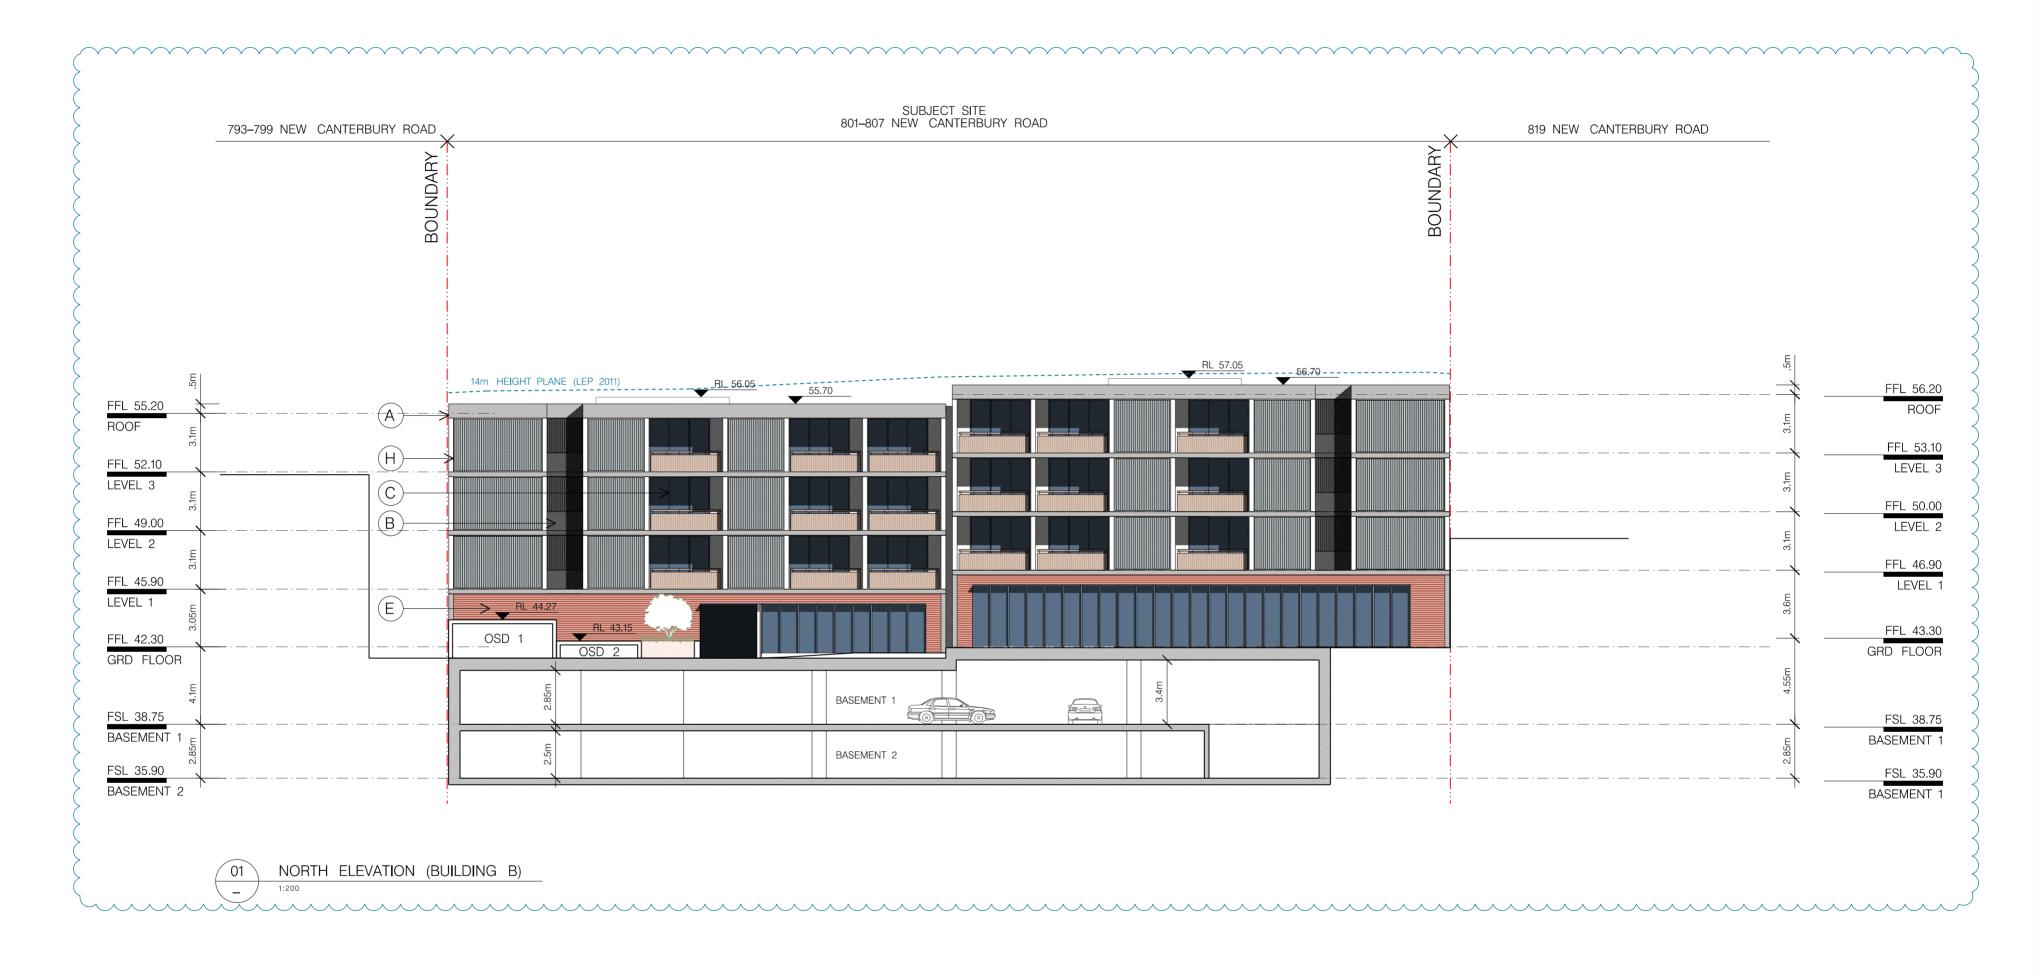



à			DA PRE	DA PRE	DA	DA	DA
Size	Description	FOR DA	REVISED D				
Drawing Original Size	Date	20.02.15	19.03.15	23.04.15	04.05.15	25.06.15	18.09.15
Draw	ssne	⋖	В	O	0	O	_

THIS DOCUMENT IS THE PROPERTY OF ANGELO CANDALEPAS & ASSOCIATES PTY LTD. THIS DRAWING SHALL ONLY BE USED FOR THE PURPOSE FOR WHICH IT WAS COMMISSIONED. UNAUTHORISED USE OF THIS DRAWING IS PROHIBITED DO NOT SCALE THIS DRAWING, USE ONLY FIGURED DIMENSIONS. REPORT ANY DISCREPANCY TO THE ARCHITECT FOR CLARIFICATION PRIOR TO THE COMMENCEMENT OF ANY WORK,

CANDALEPAS
ASSOCIATES

LEVEL 9, 219 CASTLEREAGH ST.
SYDNEY NSW 2000
T: 02 9283 7755
F: 02 9283 7477
E: architects@candalepas.com.au
NSW ARCHITECTS REG No. - 5773

801-807 N
DULWICH
CLIENT:
HARALAM
SCALE:
Om 2m

PROJECT:


801–807 NEW CANTERBURY ROAD,
DULWICH HILL

CLIENT:
HARALAMBIS MANGEMENT PTY LTD

SCALE:

1:200 @ A2


DATE: 18 SEP 2015 CHECKED 1: ND CHECKED 2:	DRAWING: NORTH ELEVATION BUILDING B	JOB No. 5 7 2 9
DRAWN BY:	drawing no. DA – 1303	ISSUE J

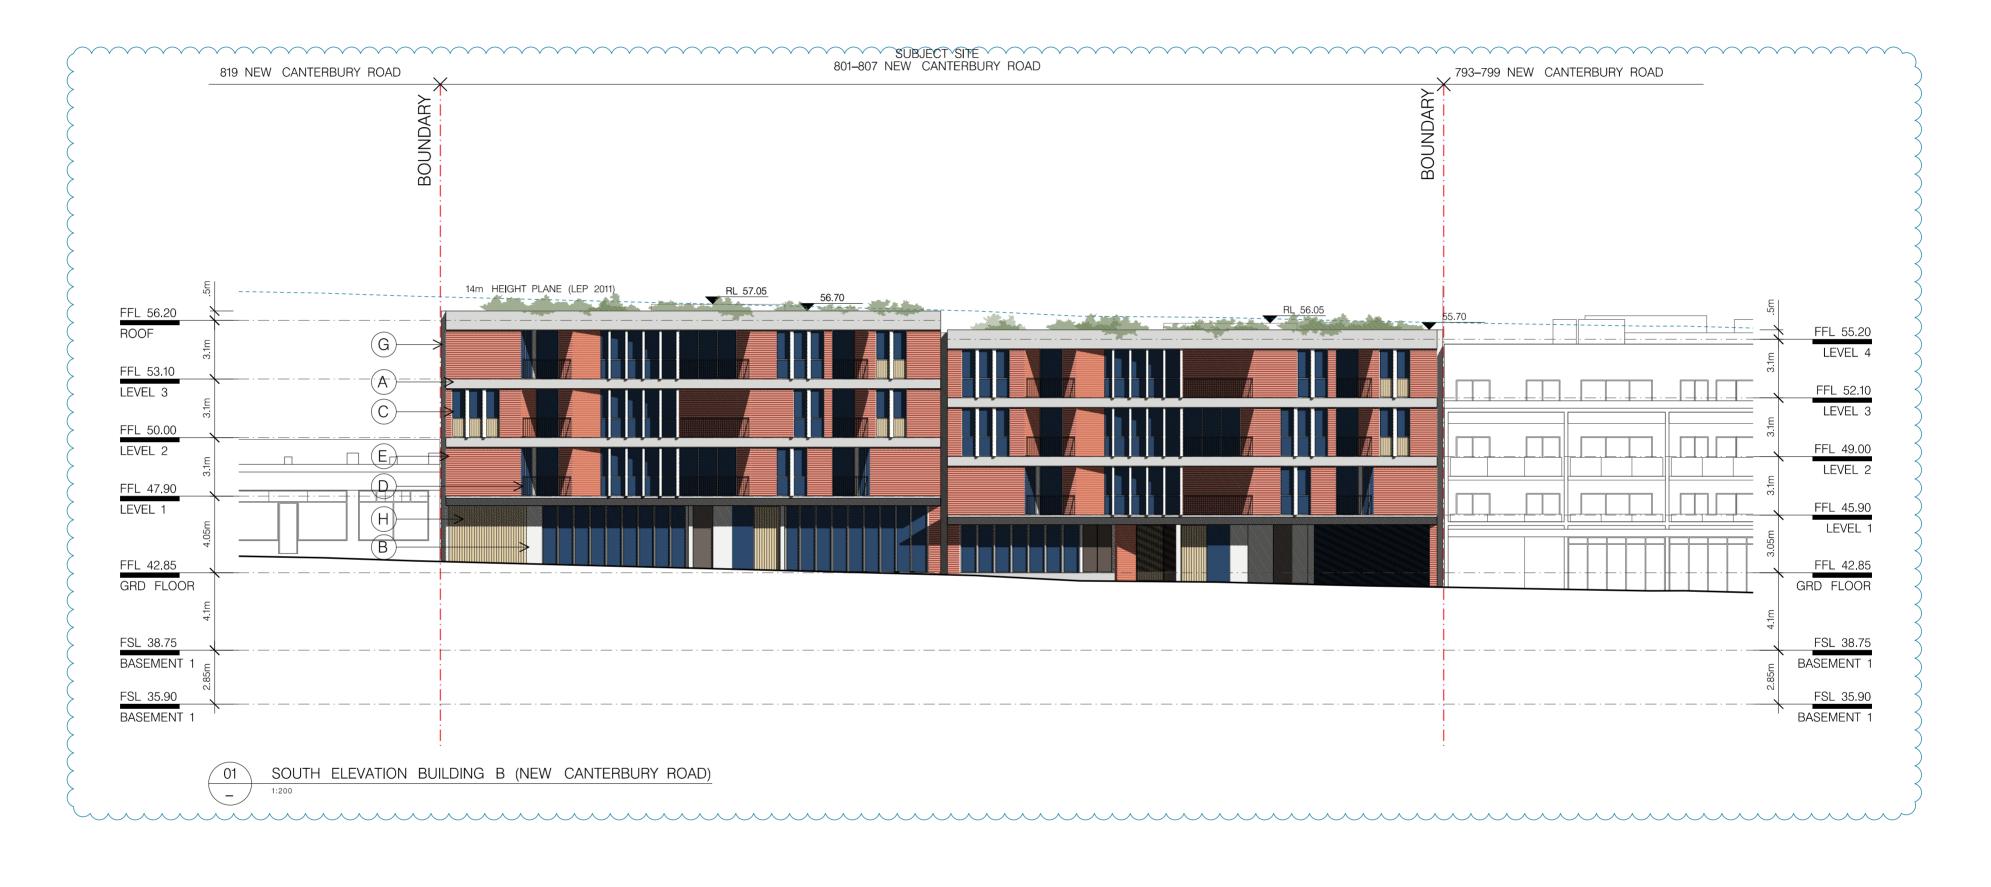






| S | FOR DA PURPOSES ONLY ARCHITECT: PROJECT: DATE: DRAWING: 18 SEP 2015 NOT FOR CONSTRUCTION © COPYRIGHT CANDALEPAS ASSOCIATES SOUTH ELEVATION SOUTH ELEVATIO A A A A A 801-807 NEW CANTERBURY ROAD, DULWICH HILL CHECKED 1: ² Ω LEVEL 9, 219 CASTLEREAGH ST. SYDNEY NSW 2000 THIS DOCUMENT IS THE PROPERTY OF ANGELO CANDALEPAS & ASSOCIATES PTY LITD. THIS DRAWING SHALL ONLY BE USED FOR THE PURPOSE FOR WHICH IT WAS COMMISSIONED. UNAUTHORISED USE OF THIS DRAWING IS PROHIBITED. HARALAMBIS MANGEMENT PTY LTD CHECKED 2: T: 02 9283 7755 SCALE: 1:200 @ A2 ISSUE F: 02 9283 7477
E: architects@candalepas.com.au
NSW ARCHITECTS REG No. – 5773

SCALE: 1:200 (DRAWING No. DO NOT SCALE THIS DRAWING USE ONLY FIGURED DIMENSIONS. REPORT ANY DISCREPANCY TO THE ARCHITECT FOR CLARIFICATION PRIOR TO THE COMMENCEMENT OF ANY WORK, DRAWN BY: DA - 1304

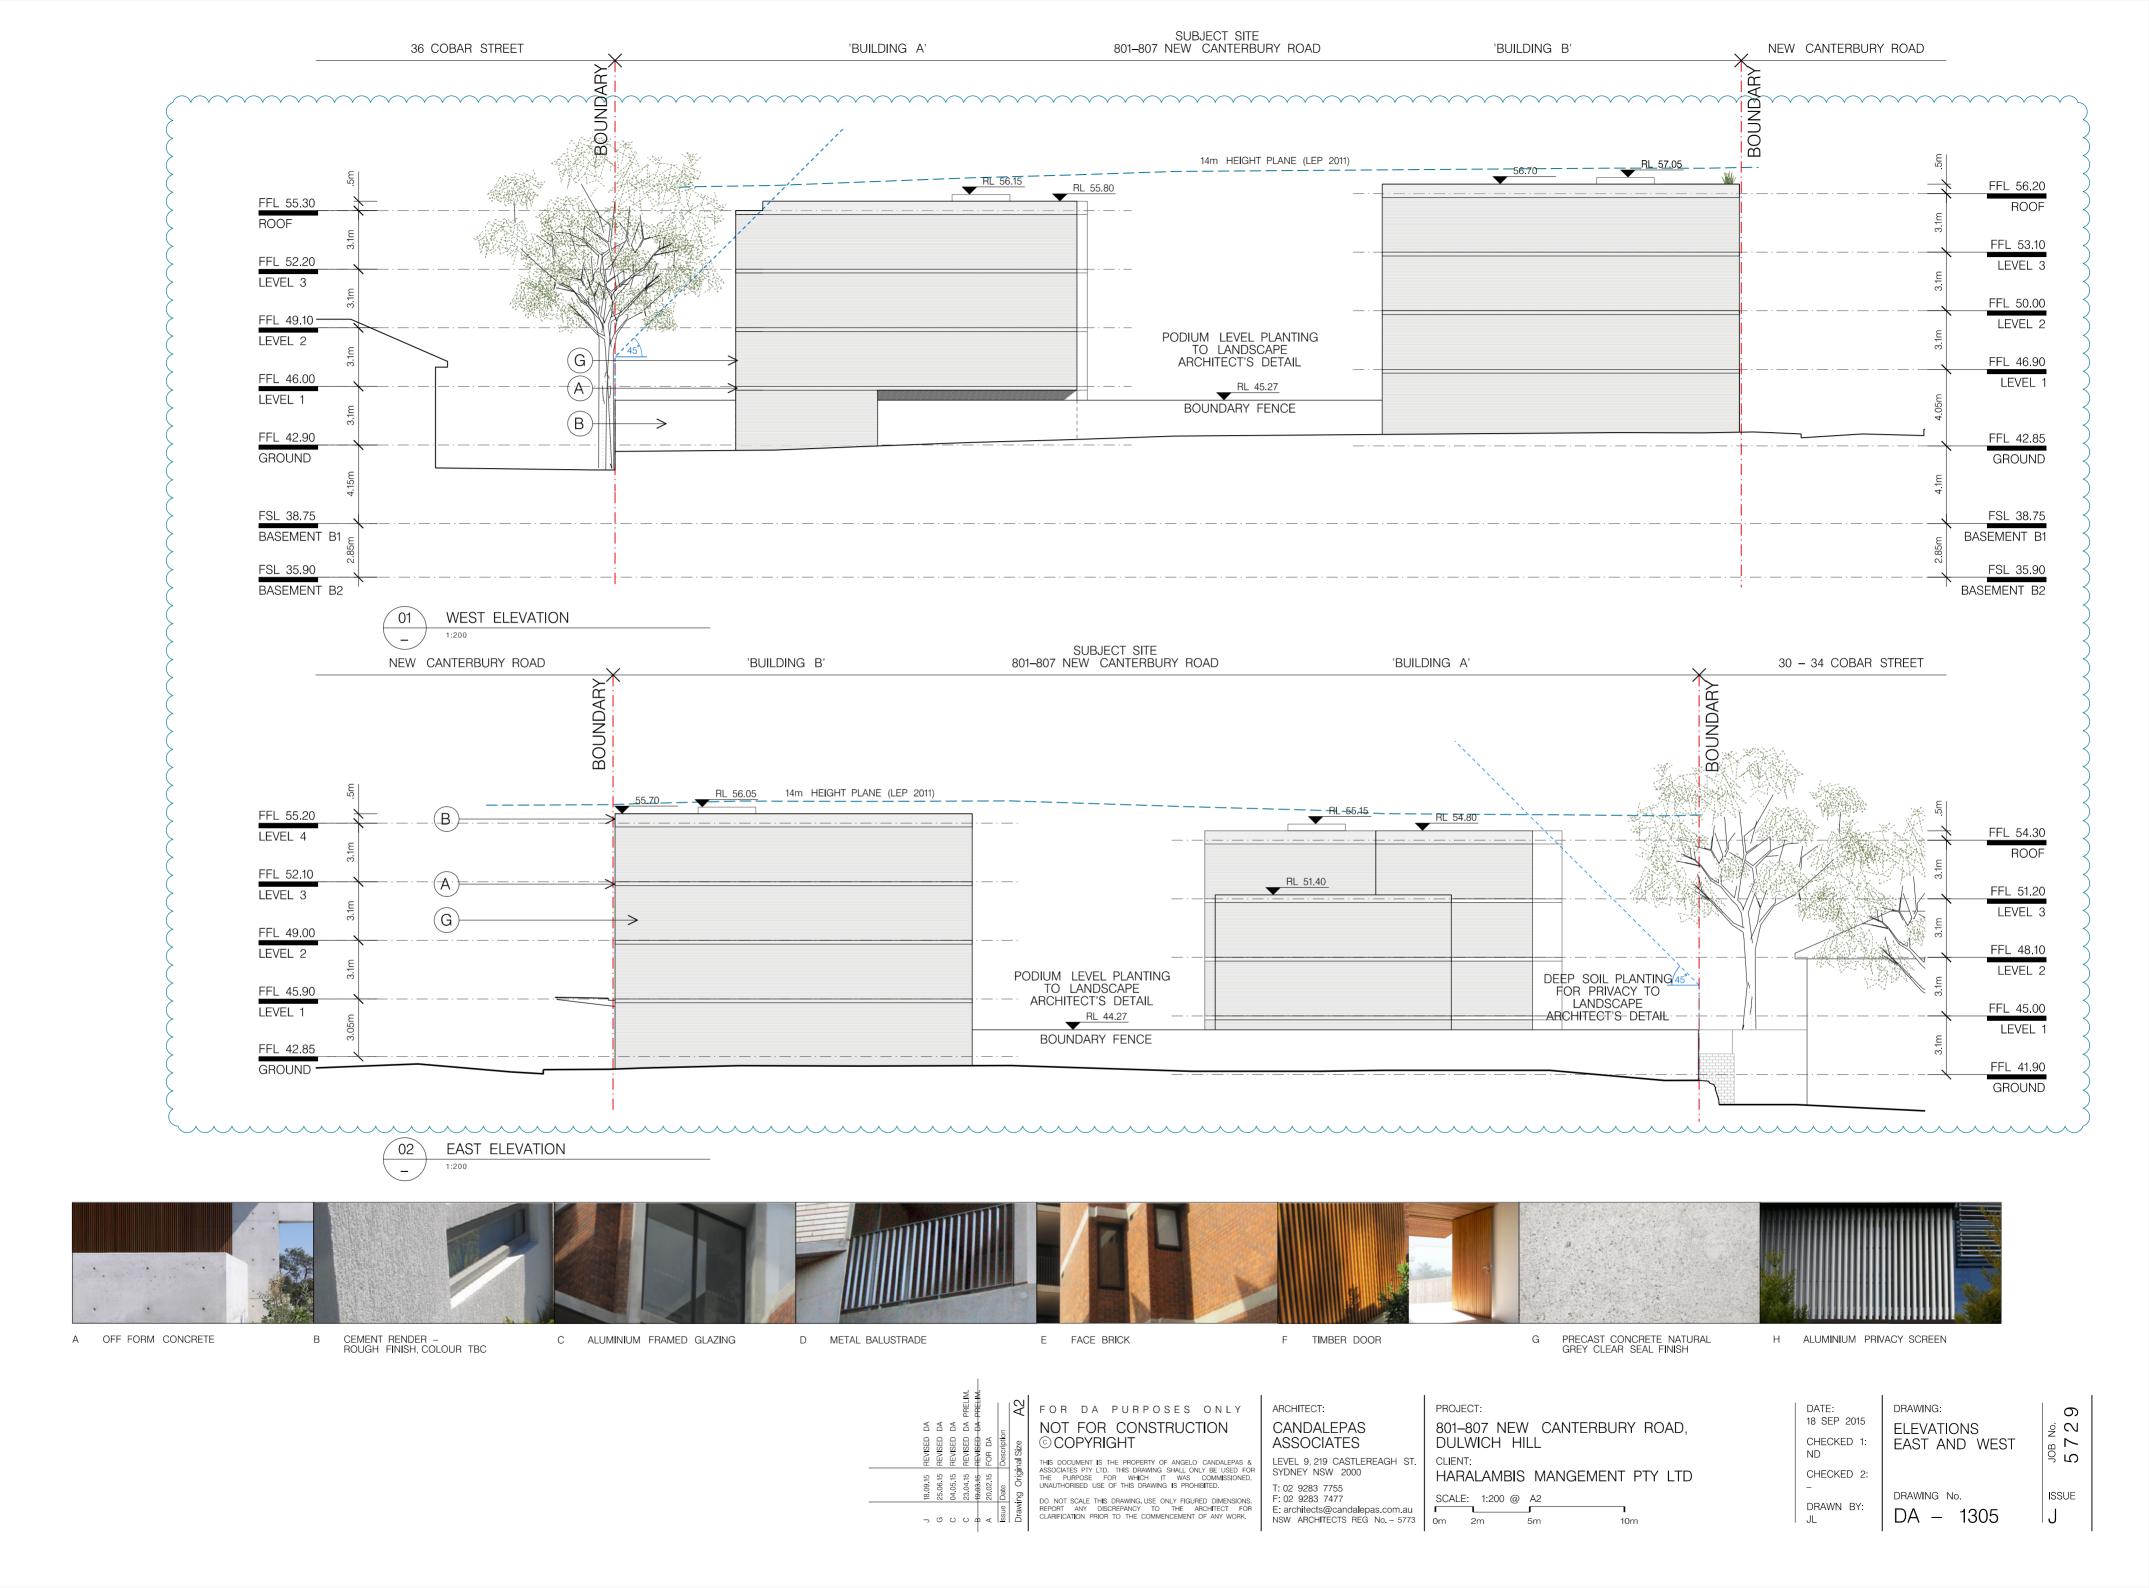

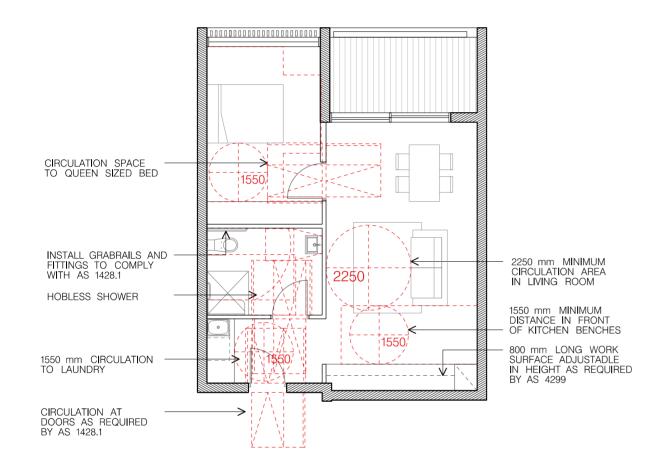

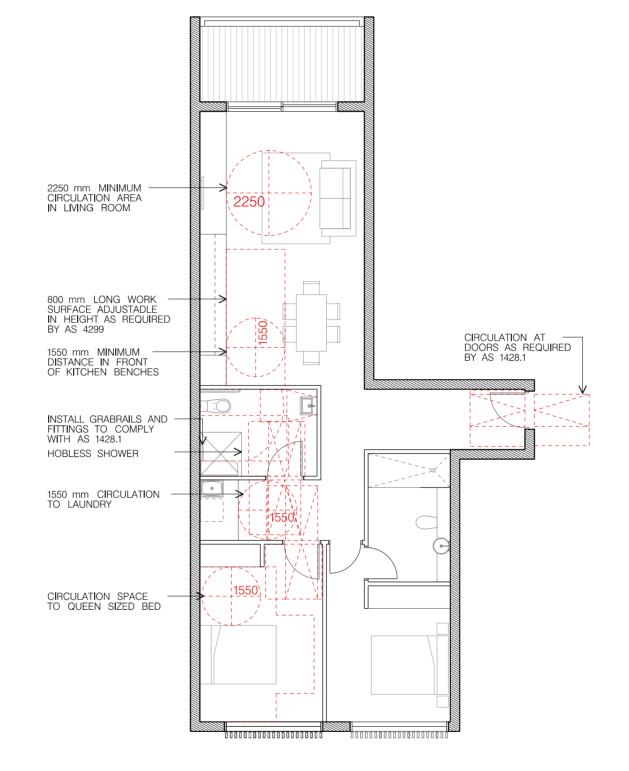

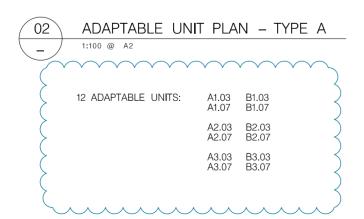



n o o o a v	J 18.09.15 G 25.06.15 C 04.05.15 C 23.04.15 B 19.09.15 A 20.02.15 Issue Date	REVISED DA REVISED DA REVISED DA REVISED DA PRELIM. REVISED DA PRELIM. REVISED DA PRELIM. FOR DA Description	A D D A A	REVISED DA REVISED DA REVISED DA REVISED DA REVISED DA PRELIM. FOR DA POSCRIPITION
×	Drawing Original Size	nal Size		A 2
I			I	

FOR DA PURPOSES ONLY NOT FOR CONSTRUCTION © COPYRIGHT

THIS DOCUMENT IS THE PROPERTY OF ANGELO CANDALEPAS & ASSOCIATES PTY LTD. THIS DRAWING SHALL ONLY BE USED FOR THE PURPOSE FOR WHICH IT WAS COMMISSIONED, UNAUTHORISED USE OF THIS DRAWING IS PROHIBITED. DO NOT SCALE THIS DRAWING USE ONLY FIGURED DIMENSIONS.
REPORT ANY DISCREPANCY TO THE ARCHITECT FOR CLARIFICATION PRIOR TO THE COMMENCEMENT OF ANY WORK.

F: 02 9283 7477

E: architects@candalepas.com.au

NSW ARCHITECTS REG No. – 5773

Om 1m 2m

ARCHITECT:
CANDALEPAS ASSOCIATES
LEVEL 9, 219 CASTLEREAGH ST. SYDNEY NSW 2000
T: 02 9283 7755 F: 02 9283 7477 E: architects@candalepas.com.au


PROJECT:
801–807 NEW CANTERBURY ROAD, DULWICH HILL
CLIENT: HARALAMBIS MANGEMENT PTY LTD
SCALE: 1:100 @ A2

DATE: 18 SEP 2015 CHECKED 1: ND	DRAWING: ADAPTABLE UNIT PLANS	JOB No. 5729
CHECKED 2: - DRAWN BY: JL	drawing no. DA – 1401	ISSUE J




GROUND

CALCULATIONS FOR JUNE/SEPTEMBER 21	TOTAL	8	UNITS
MORE THAN 2 HOURS OF DIRECT SOLAR ACCESS		8	UNI
LESS THAN 2 HOURS OF DIRECT SOLAR ACCESS		0	UNITS
NATURAL CROSS VENTILATION		5	UNITS

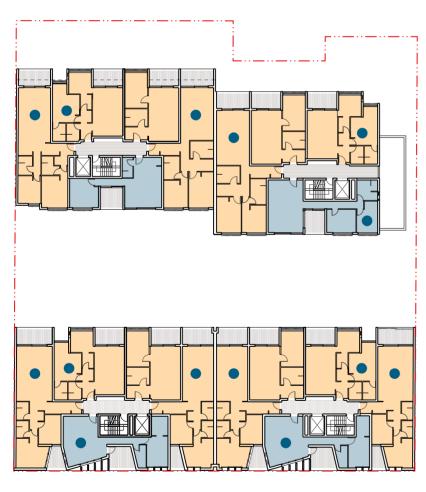


LEVEL 3

CALC	JLATIONS FOR JUNE/SEPTEMBER 21	TOTAL	19 UNITS
	MORE THAN 2 HOURS OF DIRECT SOLAR ACCESS		15 UNIT
	LESS THAN 2 HOURS OF DIRECT SOLAR ACCESS		4 UNITS
	NATURAL CROSS VENTILATION		14 UNITS

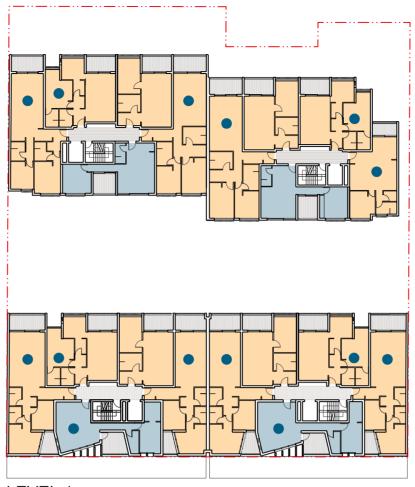

LEVEL 1

CALCULA	ATIONS FOR JUNE/SEPTEMBER 21	TOTAL 20	UNITS
N	MORE THAN 2 HOURS OF DIRECT SOLAR ACCESS	16	UN I T
L	ESS THAN 2 HOURS OF DIRECT SOLAR ACCESS	4	UNITS
• N	NATURAL CROSS VENTILATION	14	UNITS

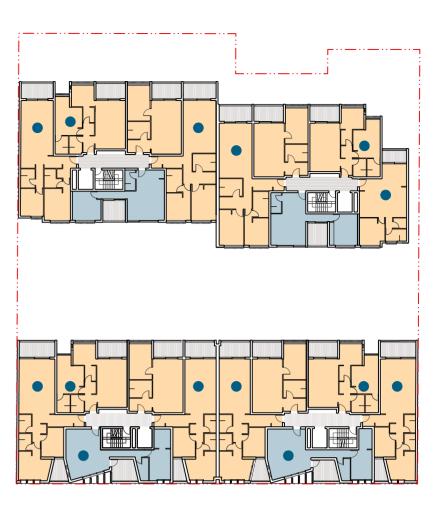

LEVEL 2

CALCUL	ATIONS FOR JUNE/SEPTEMBER 21	TOTAL	20	UNITS
	MORE THAN 2 HOURS OF DIRECT SOLAR ACCESS		16	UNI
	LESS THAN 2 HOURS OF DIRECT SOLAR ACCESS		4	UNITS
	NATURAL CROSS VENTILATION		14	UNITS

SOLAR ACCESS SUMMARY

	MORE THAN 2 HOURS OF DIRECT SOLAR ACCESS	LESS THAN 2 HOURS OF DIREC SOLAR ACCESS
GROUND LEVEL	8	0
LEVEL 01	16	4
LEVEL 02	16	4
LEVEL 03	15	4
TOTAL	55	12
PERCENTAGE (67 LINITS)	82%	18%

CROSS VENTILATION SUMMARY

CROSS VENTILATED	NON-CROSS VENTILATED
5	3
14	6
14	6
14	5
47 70%	20 30%
	VENTILATED 5 14 14 14 14

	_	_	_	DA PRELIN	REVISED DA PRELIN			
	D DA	DA DA	DA DA		Ť	⋖	Lion:	
	REVISED	REVISED	REVISED	REVISED	REVISE	FOR DA	Description	
	18.09.15	25.06.15	04.05.15	23.04.15	19:03:15	20.02.15	Date	(
	_	G	O	O		∢	ssue Date	

FOR DA PURPOSES ONLY NOT FOR CONSTRUCTION © COPYRIGHT

THIS DOCUMENT IS THE PROPERTY OF ANGELO CANDALEPAS & ASSOCIATES PTY LTD. THIS DRAWING SHALL ONLY BE USED FOR THE PURPOSE FOR WHICH IT WAS COMMISSIONED. UNAUTHORISED USE OF THIS DRAWING IS PROHIBITED.

DO NOT SCALE THIS DRAWING, USE ONLY FIGURED DIMENSIONS. REPORT ANY DISCREPANCY TO THE ARCHITECT FOR CLARIFICATION PRIOR TO THE COMMENCEMENT OF ANY WORK.

ARCHITECT:

CANDALEPAS
ASSOCIATES

LEVEL 9, 219 CASTLEREAGH ST.
SYDNEY NSW 2000


T: 02 9283 7755
F: 02 9283 7477
E: architects@candalepas.com.au
NSW ARCHITECTS REG No. - 5773

PROJECT:


801–807 NEW CANTERBURY ROAD,
DULWICH HILL
CLIENT:
HARALAMBIS MANGEMENT PTY LTD

SCALE: 1:500 @ A2 0m 5m 10m

DATE: 18 SEP 2015 CHECKED 1: ND CHECKED 2:	DEVELOPMENT AMENITY ANALYSIS	JOB No. 5729
- DRAWN BY: JL	DRAWING No. DA — 1453	J

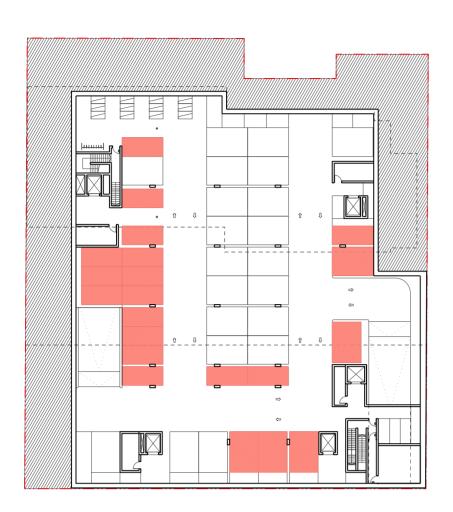


BASEMENT 1 FLOOR PLAN - 1:500

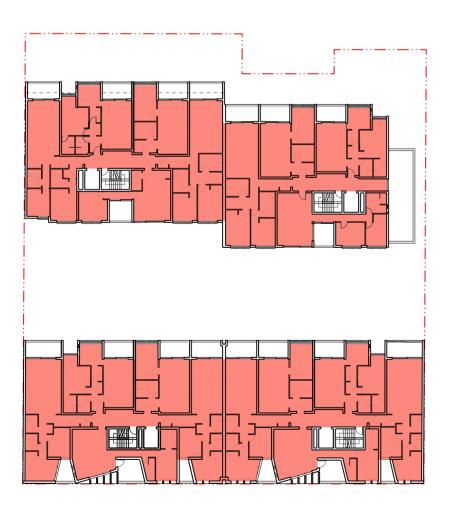


LEVEL 3 FLOOR PLAN - 1:500



GROUND FLOOR PLAN - 1:500

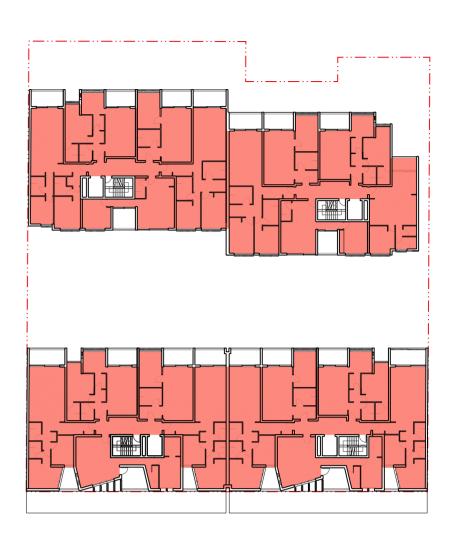

LEVEL 1 & 2 FLOOR PLAN - 1:500

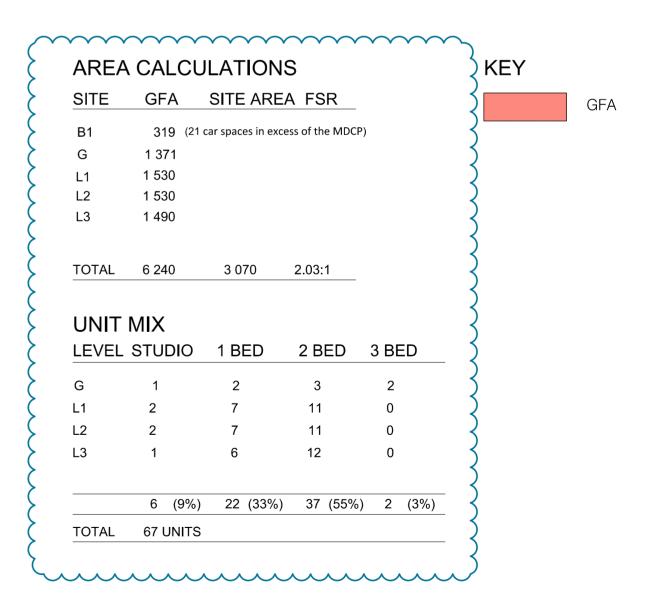

_	18.09.15	REVISED	DA
U	25.06.15	REVISED	DA
ш	11.06.15	REVISED	DA
	12.05.15	REVISED	DA
O	04.05.15	REVISED	DA
O	23.04.15	REVISED	DA PRELIN
	19.03.15	REVISED	HEVISED DA PRELIN
⋖	20.02.15	FOR DA	
ssue	Date	Description	
			:

S FOR DA PURPOSES ONLY NOT FOR CONSTRUCTION © COPYRIGHT

THIS DOCUMENT IS THE PROPERTY OF ANGELO CANDALEPAS & ASSOCIATES PYY LTD. THIS DRAWING SHALL ONLY BE USED FOR THE PURPOSE FOR WHICH IT WAS COMMISSIONED, UNAUTHORISED USE OF THIS DRAWING IS PROHIBITED. DO NOT SCALE THIS DRAWING USE ONLY FIGURED DIMENSIONS. REPORT ANY DISCREPANCY TO THE ARCHITECT FOR CLARIFICATION PRIOR TO THE COMMENCEMENT OF ANY WORK.

ARCHITECT: CANDALEPAS ASSOCIATES LEVEL 9, 219 CASTLEREAGH ST. SYDNEY NSW 2000 T: 02 9283 7755

801-807 NEW CANTERBURY R DULWICH HILL HARALAMBIS MANGEMENT PT F: 02 9283 7/55
F: 02 9283 7477
E: architects@candalepas.com.au
NSW ARCHITECTS REG No. - 5773
Om 5m 10m

PROJECT:

ROAD,		
Y LTC)	

DATE: DRAWING: 18 SEP 2015 DEVELOPMENT ું ∨ CHECKED 1: ND CALCULATIONS JOB N CHECKED 2: DRAWING No. ISSUE DRAWN BY: DA - 1801

0