
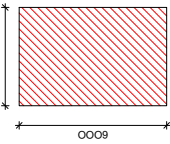


BUILDING A	
BUILDING B	
2 NORTHWEST AXOMETRIC VIEW	
EXTENT OF EXISTING EASEMENT SHOWN IN RED	
BUILDING A	
BUILDING B	
EXTERIOR FINISHES	
CODE	DESCRIPTION
AWN	POWDERCOATED ALUMINIUM AWNING STRUCTURE
BAL 1	SOLID BALUSTRADE WITH SELECTED FINISH
BAL 2	GLASS BALUSTRADE
FIN 1	SELECTED WHITE PAINT FINISH
FIN 2	SELECTED BLACK PAINT FINISH
FIN 3	SELECTED GOLD PAINT FINISH
FIN 4	SELECTED PALE GOLD PAINT FINISH
SCR 2	SELECTED POWDERCOATED ALUMINIUM SCREENING
	
6000 HIGH x 4000 WIDE SEWER EASEMENT CLEARANCE ZONE	

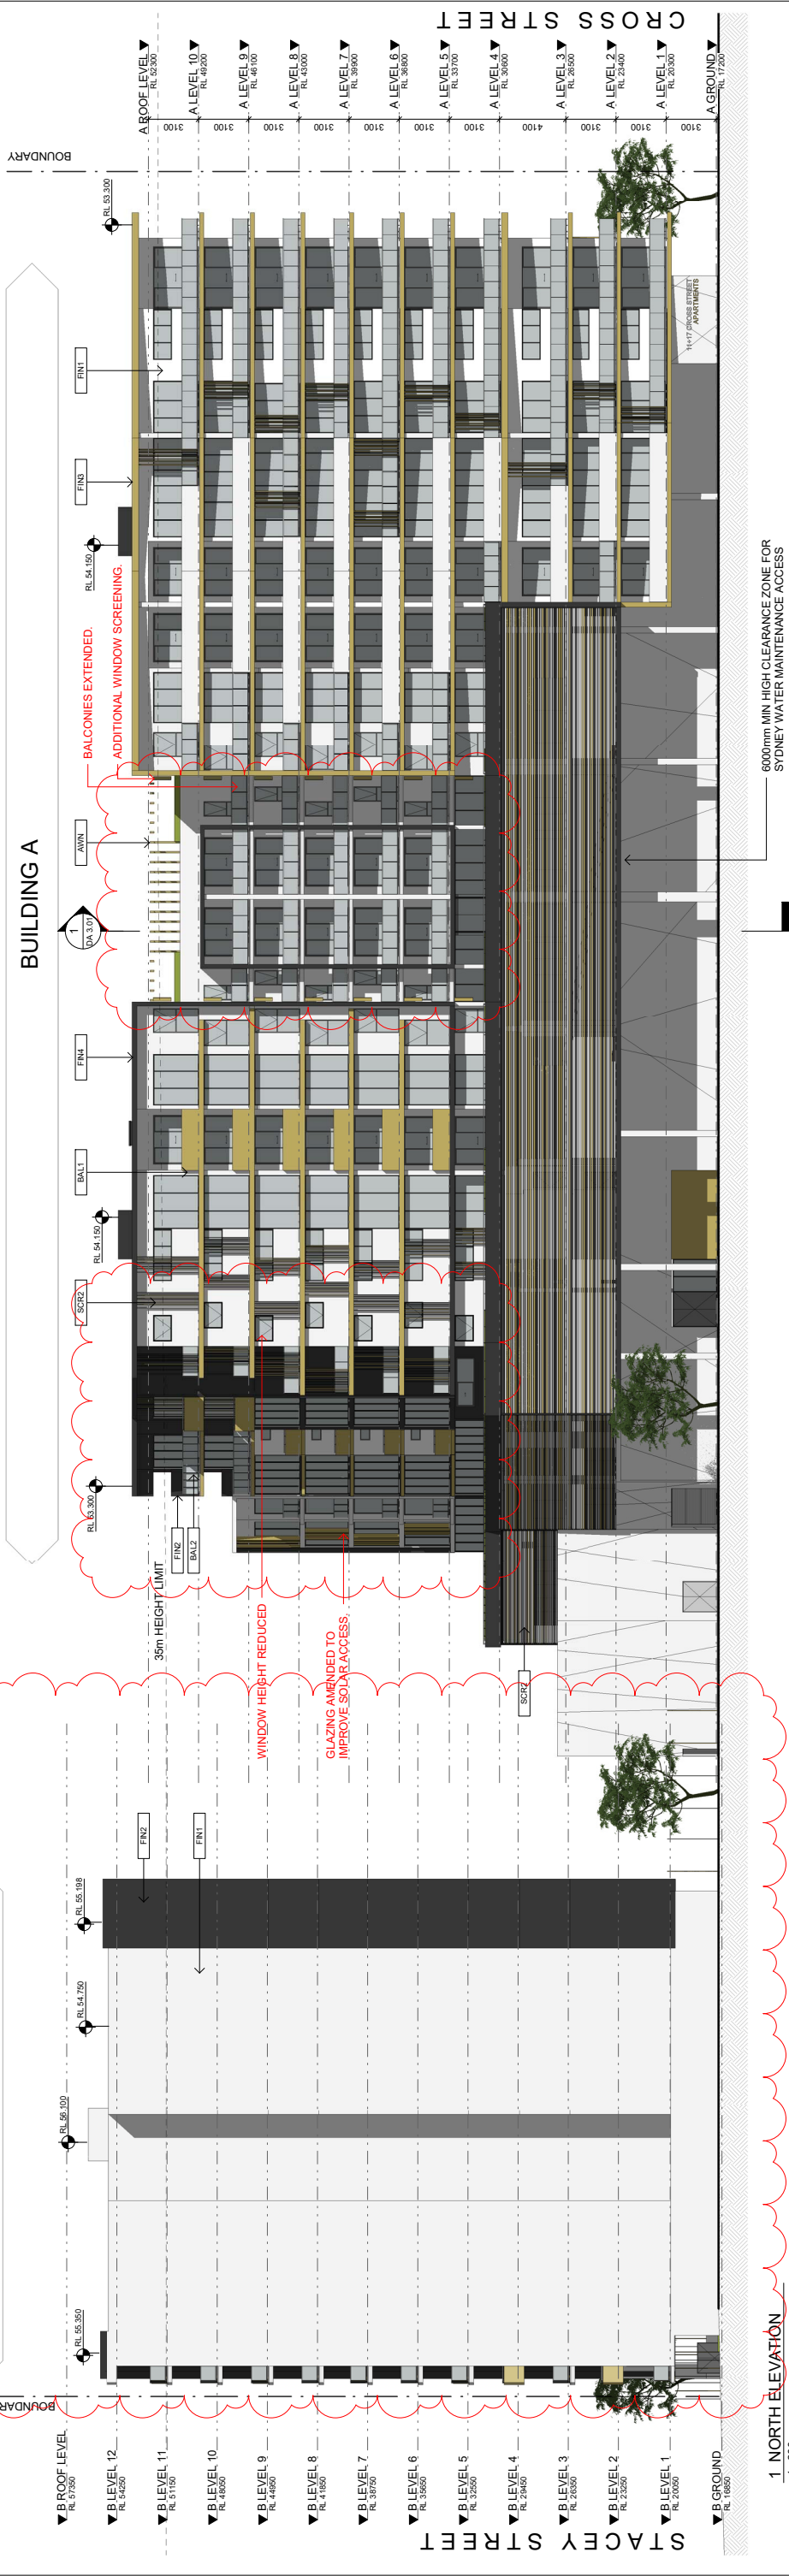

REV	DATE	DESCRIPTION	BY	DA ISSUE NOT FOR CONSTRUCTION	
A	23/02/2015	DA ISSUE	SJ	Do not scale from drawings. All dimensions to be checked to match the DA and approved plans. This drawing is for information only and must not be used for construction without the express authority of MARCHESE PARTNERS INTERNATIONAL PTY. LTD.	
B	04/12/2015	DRAFT RFI DESIGN FOR CLIENT COMMENT	SJ		
C	07/07/2015	FINAL DRAFT RFI DESIGN FOR CLIENT COMMENT	SJ		
D	20/12/2015	FINAL DRAFT RFI DESIGN FOR CLIENT COMMENT	SJ		
E	13/01/2016	FINAL DRAFT RFI DESIGN FOR CLIENT COMMENT	SJ		
F	15/01/2016	COUNCIL DA RFI ISSUE	SJ		
G	08/08/2016	UPDATED GROUND PLANE	SJ		
H	15/08/2016	UPDATED GROUND PLANE	SJ		
J	20/09/2016	COUNCIL RFI RESPONSE	SJ		
K	20/03/17	RFI #2 CLIENT ISSUE	FE		
L	03/04/17	RFI #2 RESPONSE	FE		
M	26/04/17	COUNCIL RFI RESPONSE #2	FE		
CLIENT				DRAWING TITLE	
MAXIMS FAMILY TRUST				NORTH ELEVATION	
PROJECT				SCALE @ A1	CHECKED
CROSS ST SCHEME				As indicated	FE
11+17 CROSS ST, BANKSTOWN				DATE	DRAWN
				26/04/17	AC
				JOB	REVISION
				14082	DA 2.01
					N