24/03/2017



The Administrator City of Canterbury Bankstown PO Box 8 Bankstown NSW 1885

Attention: Ms Samantha Mitchell

Delivered via email: samantha.mitchell@cbcity.nsw.gov.au

Dear Samantha,

Re: DA567/2015/3 - 74-80 Restwell & 1-9 Leonard Streets, Bankstown

Introduction

We refer to the above section 96 application (DA567/2015/3) for the above site and the minutes of the Sydney South Joint Regional Planning Panel (JRPP) meeting, which considered the proposal at its meeting on 15 February, 2017. The JRPP resolved to defer determination of the application for the following:

- 1. The applicant to provide a detailed analysis of the visual impact of the additional floor space when viewed from adjoining properties, based on current and future circumstances, and also from the public domain. The view locations to be determined in consultation with Council officers.
- 2. The applicant is to also provide a concept development form on adjoining properties to the south consistent with the current planning controls, and the likely impact of additional overshadowing on this future development.
- 3. The lodgement of an amended BASIX certificate.
- 4. The Council offices to provide an updated assessment report to the panel after having analysed the above additional information.
- 5. That a further assessment report be submitted for the Panel's consideration as soon as possible.

This submission attends to items 1 to 3 in the JRPP's minutes.

Item 1 – Visual analysis from adjoining properties and the public domain

As agreed with Council on via email on the 6th March, 2017 a total of seven (7) positions were agreed in terms of providing a visual analysis of the proposal from adjoining properties and the public domain. Drawing numbers JRPP.01 1 and JRPP.03 1 illustrate the location of agreed locations noting that position four (4) also has had an analysis from a person of average height standing both at the ground level and from a balcony on level 6 of a future development on adjoining land immediately to the south of the site.

The following provides our assessment of each of the visual analysis prepared and illustrated in drawing numbers JRPP.01 1, JRPP.02 1, JRPP.03 1 and JRPP.04 1 (**see Attachment A)** prepared by Nordon Jago Architects. Where the description in the assessment refers to 'the proposal' this relates to the additional four (4) units sought in the modification application.

SURVEYORS | PLANNERS | DEVELOPMENT ADVISORS

jensenbowers.com.au

Current circumstances

View 1 from the north-east on Leonard Street

As illustrated on drawing JRPP.03 1, the existing building to the north of the site would screen views of the central portion of the development, which is the location of the proposal. The proposal will, therefore, not be readily viewed by a person of average height standing within Leonard street from this location. Hence, there will be no adverse visual impacts as a result of the proposal upon the public domain.

View 2 from south on the corner of Restwell and Ross Streets

As illustrated on drawing JRPP.03 1, the existing development fronting Restwell Street and the site will screen views of the central portion of the development, which is the location of the proposal. The proposal will, therefore, not be readily viewed by a person of average height standing within Restwell Street from this location. Hence, there will be no adverse visual impacts as a result of the proposal upon the public domain.

View 3 approximately 65m from the south at the rear boundary from existing properties

As illustrated on drawing JRPP.03 1, approximately only half of the proposal will be viewed from this location as the western side of the development is screened by existing dwellings fronting Restwell Street. In addition, only the top third of the proposal will be viewed given the built form at this level is set back significantly from the southern elevation and screened by balustrading. Hence, there will be no adverse visual impacts as a result of the proposal upon existing private property when the context of the entire development on this site is taken into consideration.

Moreover, it is important to note that if the existing trees were able to be incorporated into this analysis then it is likely that views of the proposal would be further screened or potentially not seen at all from this location.

View 4 from the south from adjoining properties, immediately adjacent the site

As illustrated on drawing JRPP.04 1, the proposal will not be viewed by a person of average height standing at the ground level at this location. Only the balustrading associated with the additional communal open space proposed and a fire stair shaft can be viewed. These will not contribute to any significant additional adverse visual impacts on existing adjoining properties when the overall approved development is taken into consideration.

View 5 from the north directly in front of the site from Stanley Street

As illustrated on drawing JRPP.04 1, views of the proposal will be unobstructed in the current day situation from this location. The built form as a result of the proposal however will maintain compliance with the maximum 25m height control; a high level of articulation through deep balconies and stepping within the elevation, all of which assist in mitigating any adverse visual impacts on the public domain.

The building will also not be read as one building mass because of the U or C-shaped footprint, which gives the appearance of the development being 3 separate buildings. This is reinforced via the separation of the built form between the western wing and the proposed additional units at the top level. Likewise, the increased setback of the building at the top level where the proposed new units connect with the eastern wing results in a similar outcome.

Given those reasons above, there will be no adverse visual impacts as a result of the proposal upon the public domain.



View 6 from the north within an existing Council car park

As illustrated on drawing JRPP.04, views of the proposal will be unobstructed in the current day situation from this location. If anything, the views closer to the built form highlight the significant level of articulation proposed in the northern elevation of the building. For the same reasons detailed above in the View 5 analysis, the proposal will have no adverse visual impacts on existing private property or on the public domain.

Future development

View 1 from the north-east on Leonard Street

As illustrated on drawing JRPP.01 1, as per the current day circumstances the status quo will remain i.e. the existing building to the north of the site will screen views of the proposal, therefore, it will not be seen from or have adverse visual impacts on the public domain in this location.

View 2 from south on the corner of Restwell and Ross Streets

As illustrated on drawing JRPP.01 1, as per the current day situation, future development fronting Restwell street between the site this location and the site will screen views of the proposal. Hence, there will be no adverse visual impacts as a result of the proposal on the public domain.

View 3 approximately 65m from the south at the rear boundary from existing properties

As illustrated on drawing JRPP.01 1, views of the proposal are narrowed significantly to about less 10% when compared the current situation. This is a result of potential future development on land fronting both Restwell and Leonard Streets. Similar to the current day scenario, only the top third of the proposal will be viewed given they are set back significantly from the southern elevation and screened by balustrading, therefore, limiting any adverse visual impacts from private property.

View 4 from the south from adjoining properties, immediately adjacent the site

As illustrated on drawing JRPP.02 1, the proposal will not be viewed by a person of average height standing at the ground level from this location. Only the balustrading associated with the additional communal open space proposed along the top of the southern elevation and the stairwell will be viewed. These will not contribute to any significant additional adverse visual impacts on the future development of existing adjoining properties.

View 4a from a balcony at the 6th level from a potential future residential flat building immediately adjacent to the south of the site

As illustrated on drawing JRPP.02 1, the proposal will be readily viewed. The proposal is however setback from the southern elevation of the building and future development on adjoining land to the south and thus providing visual relief.

The proposal will also maintain compliance with the maximum height limit and, therefore, is consistent with the built form that would be anticipated on the site. Moreover, when the proposal is viewed in the context of the overall built form that will occur on the site, it will generate any real significant difference from a visual impact perspective.

View 5 from the north directly in front of the site from Stanley Street

As illustrated on drawing JRPP.02 1, future development within Council's current car park to its potential will impede any views of the proposal and around 85% of the whole development itself. Hence, there will be no adverse visual impact upon the public domain as a result of the proposal from this location.

View 6 from the north within an existing Council car park

As illustrated on drawing JRPP.02 1 no views of the proposal would be possible from this location if this adjoining site were developed in the future.



Item 2 – Overshadowing assessment as a result of the proposal

As illustrated on drawing JRPP.05 1 (**see Attachment B**) prepared by Nordon Jago Architects, an elevational shadow analysis has been prepared for the winter solstice at 9am, noon and 3pm. The analysis demonstrates the level of additional overshadowing (identified in red) that would be created by the proposal with respect to potential future development on the adjoining land to the south of the site.

The extent of additional shadow created by this proposal is at best very minor. It is estimated the additional level of shadow generated by the additional four (4) units proposed is less than 5% of the overall impact of the current approval.

Without understanding exactly how the primary internal and external living areas would be orientated on the adjoining land to the south, it is submitted that the very minor level of additional overshadowing created by this proposal would not result in any non-compliance with the minimum requirements of the Apartment Design Guide.

Item 3 – Amended BASIX Certificate

Provided in **Attachment C** are all the necessary requirement to satisfy SEPP Basix, which now take into account the modifications sought by this proposal. The proposal meets the requirements with respect to BASIX.

Conclusion

This submission comprehensively responds to all matters requested by the JRPP in order for Council to finalise its assessment of the proposal. As demonstrated via the analysis undertaken both graphically and as supported by this submission, it is categorically evident that proposal will have no adverse visual impacts from either adjoining properties or from within the public domain. This position stands from both the current day situation and when surrounding land is developed to its full potential.

The level of additional overshadowing created by the proposal is inconsequential. The requirements in respect of BASIX can be achieved.

As presented to the JRPP, this proposal has will have no adverse environmental or visual impacts. The extent of additional built form is knowingly so small in the context of the future development anticipated within the immediate locality and within the Sydenham to Bankstown Urban Renewal Corridor. We therefore submit to Council that it should have no reservations in recommending to the JRPP this this section 96 application be approved in its current form.

Yours Faithfully

Ben Haynes Planning Manager

E benhaynes@jensenbowers.com.au

P 07 3852 1771

M 0419 193 259



Attachment A – Visual analysis studies






View 01_Cnr Leonard St Existing

E-LID**D**-(I) Hill H 1 H (I) (H HIGH (III) H H (III) ET. **C**ati



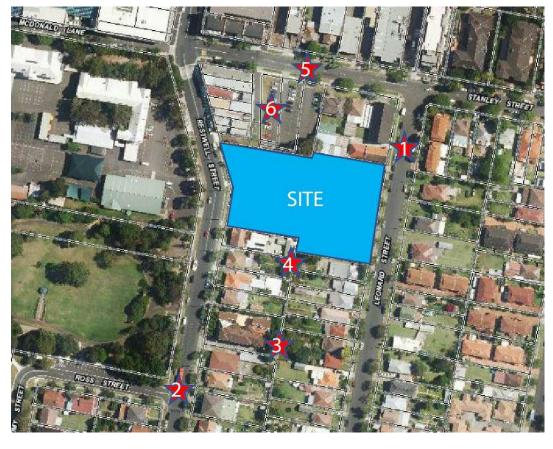

RESIDENTIAL DEVELOPMENT AT 74-80 RESTWELL &1-9 LEONARD STREET


TITLE



3

1



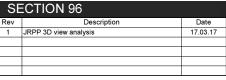

NOT For Construction

3D Views Existing	DWG No.		
	SCALE	A3 @	1 : 25
	DATE		13-05-2016
J:\MRH00216 Bankstown\4 NJA Documentation\5 CADD\3 DA\01 Model\MRH00216_R2016_massing.rvt	JOB No.		MRH00216

JRPP.03 1





View 04 Existing

4





View 06 Existing



SE	ECTION 96	
Rev	Description	Date
1	JRPP 3D view analysis	17.03.17
		(


NOT For Construction

TITLE

View 05 Existing 5

RESIDENTIAL DEVELOPMENT AT 74-80 RESTWELL &1-9 LEONARD STREET

J:\MRH00216 Bankstown\4 NJA Documentation\5 CADD\3 DA\01 Model\MRH00216_R2016_massing.rvt	JOB No.	MRH00216
	DATE	13-05-2016
	SCALE	A3 @
	DWG No.	
	JF	RPP.04 1

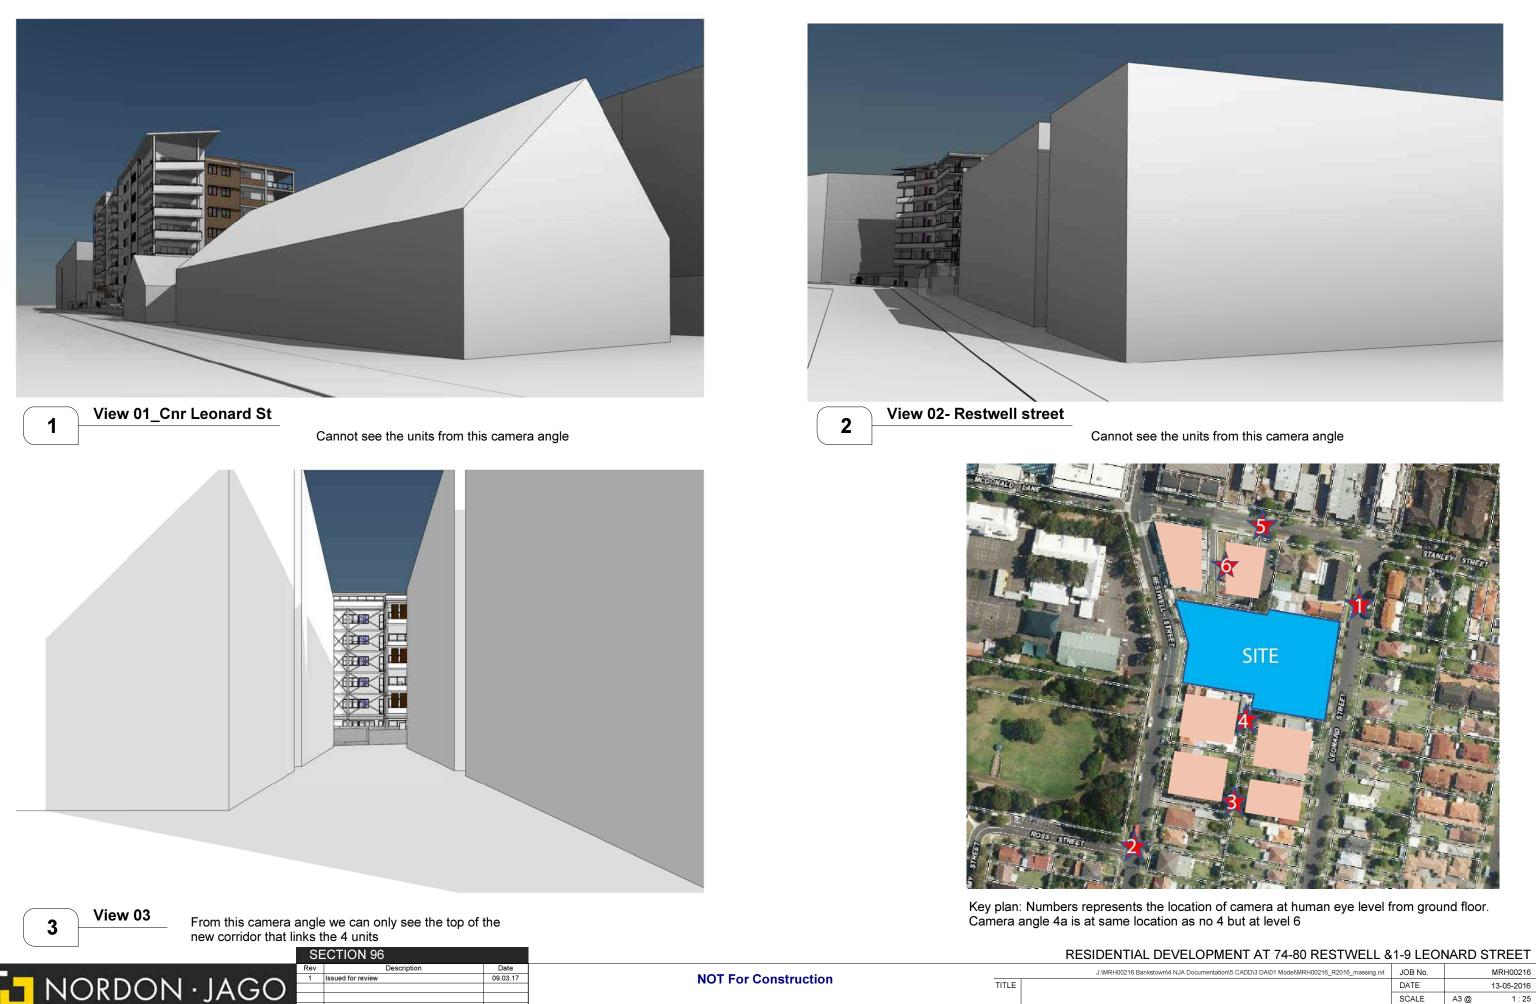

CNR PARRAMATTA RD & JOHNSTON ST - PO BOX 254 - ANNANDALE - NSW 2038 - T.02 9564 8800 F.02 9517 2833 STEPHEN J. NORDON REGISTRATION No. NSW - 4704 - GRAHAM P. JAGO REGISTRATION No. NSW - 4926

n\4 NJA Documentation\5 CADD\3 DA\01 Model\MRH00216_R2016_massing.rvt	JOB No.	MR	H00216
	DATE	13-	05-2016
3D VIEWS	SCALE	A3 @	1 : 25
	DWG No.		
	JF	RPP.01	1






In this camera angle (which is around level 6 of adjoining block to south) we can see the proposed 4 units.

View 04

4

Cannot see the units, except for the staricase block that needs to project to level 6 to service new units.

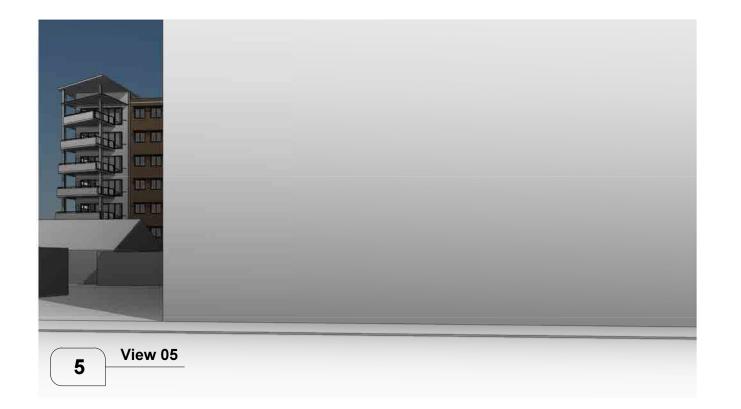



View 06 6

Cannot see the units from this camera angle

RESIDENTIAL DE

ON·JAGO NORE ECTS

Cannot see the units from this camera angle

SE	ECTION 96	
Rev	Description	Date
1	Issued for review	09.03.17


View 4a level6


4a

AT 74 80 DESTINELL	&1-9 LEONARD STREET
AT 74-00 RESTWELL	al-S LEONARD STREET


J:\MRH00216 Bankstown\4 NJA Documentation\5 CADD\3 DA\01 Model\MRH00216_R2016_massing.rvt	JOB No.	MRH00216
	DATE	13-05-2016
		A3 @
3D VIEWS	DWG No.	RPP.02 1

Attachment B – 3D Shadow Analysis

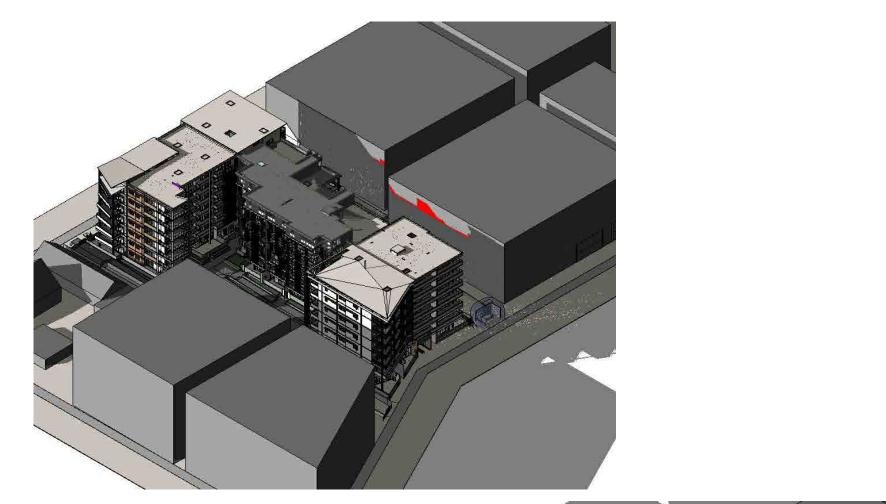

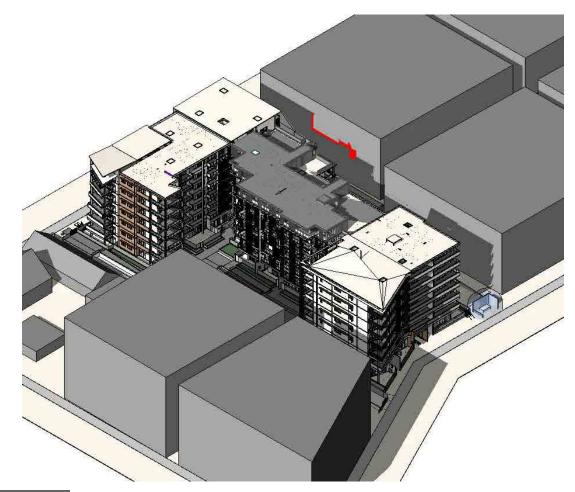

JUNE 21ST 9AM

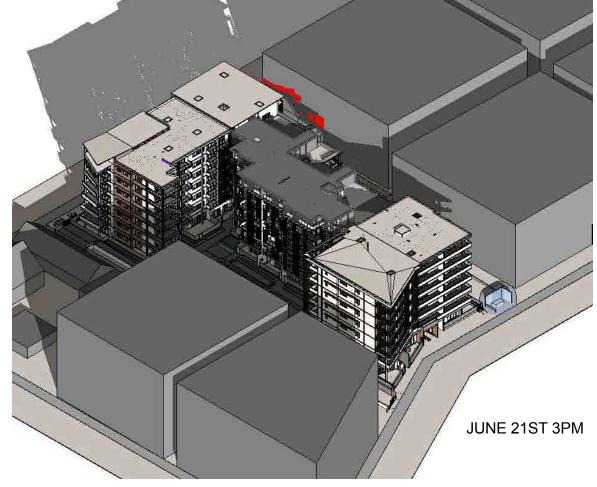



SECTION 96		
Rev	Description	Date
1	JRPP 3D view analysis	17.03.1

NOT For Construction

RESIDENTIAL DE

TITLE

CNR PARRAMATTA RD & JOHNSTON ST - PO BOX 254 - ANNANDALE - NSW 2038 - T.02 9564 8800 F.02 9517 2833 STEPHEN J. NORDON REGISTRATION No. NSW - 4704 - GRAHAM P. JAGO REGISTRATION No. NSW - 4926

JUNE 21ST 12NOON

Ne

New Shadow: Sec 96 on future development

EVELOPMENT AT 74-80 RESTWELL &1-9 LEONARD STREET				
N4 NJA Documentation\5 CADD\3 DA\01 Model\MRH00216_R2016_massing.rvt JOB No. MRH00216				
	DATE		13-05-2016	
	SCALE	A3 @	1 : 50	
Shadows	DWG No.			

JRPP.05 1

Attachment C – BASIX Certificate

RESTWELL & LEONARD ST BANKSTOWN - SEC-96

FOR MERHIS PTY LTD 74-80 RESTWELL ST.& 1-9 LEONARD ST.BANKSTOWN,NSW AUG 2016

Sheets - All Drawings				
Dwg No.	No. Rev Sheet Name		Current Revision Da	
0.00.000	D		11.00.0010	
S-96.000	В	COVER SHEET	11-08-2016	
S-96.091	A	BASEMENT 02 FLOOR PLAN	05-08-2016	
S-96.095	A	BASEMENT 01 FLOOR PLAN	05-08-2016	
S-96.100	A	GROUND FLOOR PLAN	05-08-2016	
S-96.104	A	LEVEL-01 TO 04 (TYPICAL FLOOR PLAN)	05-08-2016	
S-96.120	В	LEVEL-05 FLOOR PLAN	10-08-2016	
S-96.124	В	LEVEL-06 FLOOR PLAN	10-08-2016	
S-96.128	В	ROOF PLAN	10-08-2016	
S-96.140	A	SHADOW DIAGRAM - 21 MARCH	05-08-2016	
S-96.141	A	SHADOW DIAGRAM - 21 JUNE	05-08-2016	
S-96.142	A	SHADOW DIAGRAM - 21 JUNE	05-08-2016	
S-96.143	A	SHADOW DIAGRAM - 21 JUNE	05-08-2016	
S-96.144	A	SHADOW DIAGRAM - 21 SEPTEMBER	05-08-2016	
S-96.145	A	SHADOW DIAGRAM - 21 DECEMBER	05-08-2016	
S-96.150	A	DA-DETAILED SHADOW STUDIES	05-08-2016	
S-96.151	A	S96-DETAILED SHADOW STUDIES	05-08-2016	
S-96.152	A	S96-L6 DETAILED SHADOW STUDIES	05-08-2016	
S-96.200	A	SECTIONS	05-08-2016	
S-96.300	A	ELEVATIONS NORTH AND SOUTH	05-08-2016	
S-96.301	A	ELEVATIONS EAST AND WEST	05-08-2016	

ACCESSIBLE UNITS (COMPARISON TO DA)

	1+1 PER 50 UNITS(160=5 TOWER A		
LEVEL			
	DA	S96	
GROUND	0	0	
LEVEL 1	1	1	
LEVEL 2	1	1	
LEVEL 3	1	1	
LEVEL 4	1	1	
LEVEL 5	1	1	
LEVEL 6	0	0	
REQUIRED UNIT NUMBERS(1+1/50 UNITS)	4.1	4.2	
NUMBER OF ACCESSIBLE UNITS	5	5	
TOTAL NUMBER OF UNITS	156	160	
COMPLIANT PERCENTAGE	3%	3%	

**NOTE: THERE IS NO CHANGES AS PER REQUIRED UNIT NUMBER HAS NOT BEEN CHANGED

FSR CALCULATION (COMPARISON TO DA)

LEVEL	GROSS FLOOR AREA(m ²)				
	DA	\$96			
BASEMENT 2	CAR PARKING	CAR PARKING			
BASEMENT 1	CAR PARKING	CAR PARKING			
GROUND	1,900 m ²	1,900 m ²			
LEVEL 1	2,082 m ²	2,082 m ²			
LEVEL 2	2,082 m²	2,082 m ²			
LEVEL 3	2,082 m ²	2,082 m ²			
LEVEL 4	2,082 m ²	2,082 m ²			
LEVEL 5	2,082 m ²	2,082 m²			
LEVEL 6	1,294 m²	1,724 m ²			
TOTAL GROSS FLOOR AREA	13,604 m²	14,034 m ²			
DIFFERENCES		430 m ²			
SITE AREA	6,363 m²	6,363 m ²			
FSR	2.14	2.21			
OPENSPACE	3,759 m²	3,759 m ²			
COMMUNAL OPEN SPACE	2,845 m ²	3,260 m ²			
A SECOND STOCKS STOCKS AND STOCKS AND STOCKS AND STOCKS	45%	51%			

**NOTE: GFA measured to the inside face of the exsternal wall, not including basement parking or vertical circulations(Incl. lift shafts, fire stairs and services)

ESD ANALYSIS (COMPARISON TO DA)

	req. 60% CROSS-VENT.		req. 70% 2HRS SOLAR ACCESS		SINGLE ASPECT			
LEVEL					FACING SOUTH		EXCEEING 8m DEPTH	
	DA	S96	DA	S96	DA	S96	DA	S9
GROUND	10	10	13	13	4	4	3	(
LEVEL 1	13	13	16	16	3	3	2	1
LEVEL 2	13	13	16	16	3	3	2	
LEVEL 3	13	13	16	16	3	3	2	1
LEVEL 4	13	13	16	16	3	3	2	1
LEVEL 5	16	16	18	16	1	3	2	
LEVEL 6	15	19	15	19	0	0	0	(
TOTAL NUMBER OF COMPLIED UNITS	93	97	110	112	17	19	13	1:
TOTAL NUMBER OF UNITS	156	160	156	160	156	160	156	160
COMPLIANT PERCENTAGE	60%	61%	71%	70%	11%	12%	8%	8%

SOLAR ACCESS STUDY (COMPARISON TO DA)

		SOL	
LEVEL	2HRS SOLAR A	CCESS	
	DA		
GROUND	13		
LEVEL 1	16		
LEVEL 2	16		
LEVEL 3	16		
LEVEL 4	16		
LEVEL 5	18		
LEVEL 6	15		
TOTAL NUMBER OF COMPLIED UNITS	110		
TOTAL NUMBER OF UNITS	156		
COMPLIANT PERCENTAGE	71%	1	

LEVEL	1BED		2BED		3BED		TOTAL	
	DA	S96	DA	S96	DA	S96	DA	S96
UNIT NUMBERS	20	20	115	117	21	23	156	160
1 BED = 1 SPACE PER UNIT	20	20			1			
2 BED = 1.2 SPACE PER UNIT			138	140.4				
3 BED = 1.5 SPACE PER UNIT					31.5	34.5		
REQUIRED RESIDENTIAL SPACE	20	20	138	140.4	31.5	34.5	189.5	198
VISITORS = 1 SPACE PER 5 UNITS					Ľ	1	31.2	32
TOTAL REQUIRED PARKING SPACE + CARWA	SH						221	- 228
INCL. DISABLED SPACES PROVIDED							6	6
PARKING SPACES PROVIDED							221	233
BICYCLE PARKING 1 PER 3 UNITS BICYCLE PARKING SPACE PROVIDED							52	5




**NOTE: Accessible Units are 2BED Units and 5 Accesible units Parking Included in 2 BED Parking Calculation.

Accessible Parking required 1 car space /100 units.



	Section 96 Drawings				
	Rev	Description	Date		
	А	ISSUED FOR S-96 CHANGES	05-08-2016		
D	B	ISSUED FOR S-96 CHANGES	11-08-2016		

CNR PARRAMATTA RD & JOHNSTON ST - PO BOX 254 - ANNANDALE - NSW 2038 - T.02 9564 8800 F.02 9517 2833 STEPHEN J. NORDON REGISTRATION No. NSW - 4704 GRAHAM P. JAGO REGISTRATION No. NSW - 4926

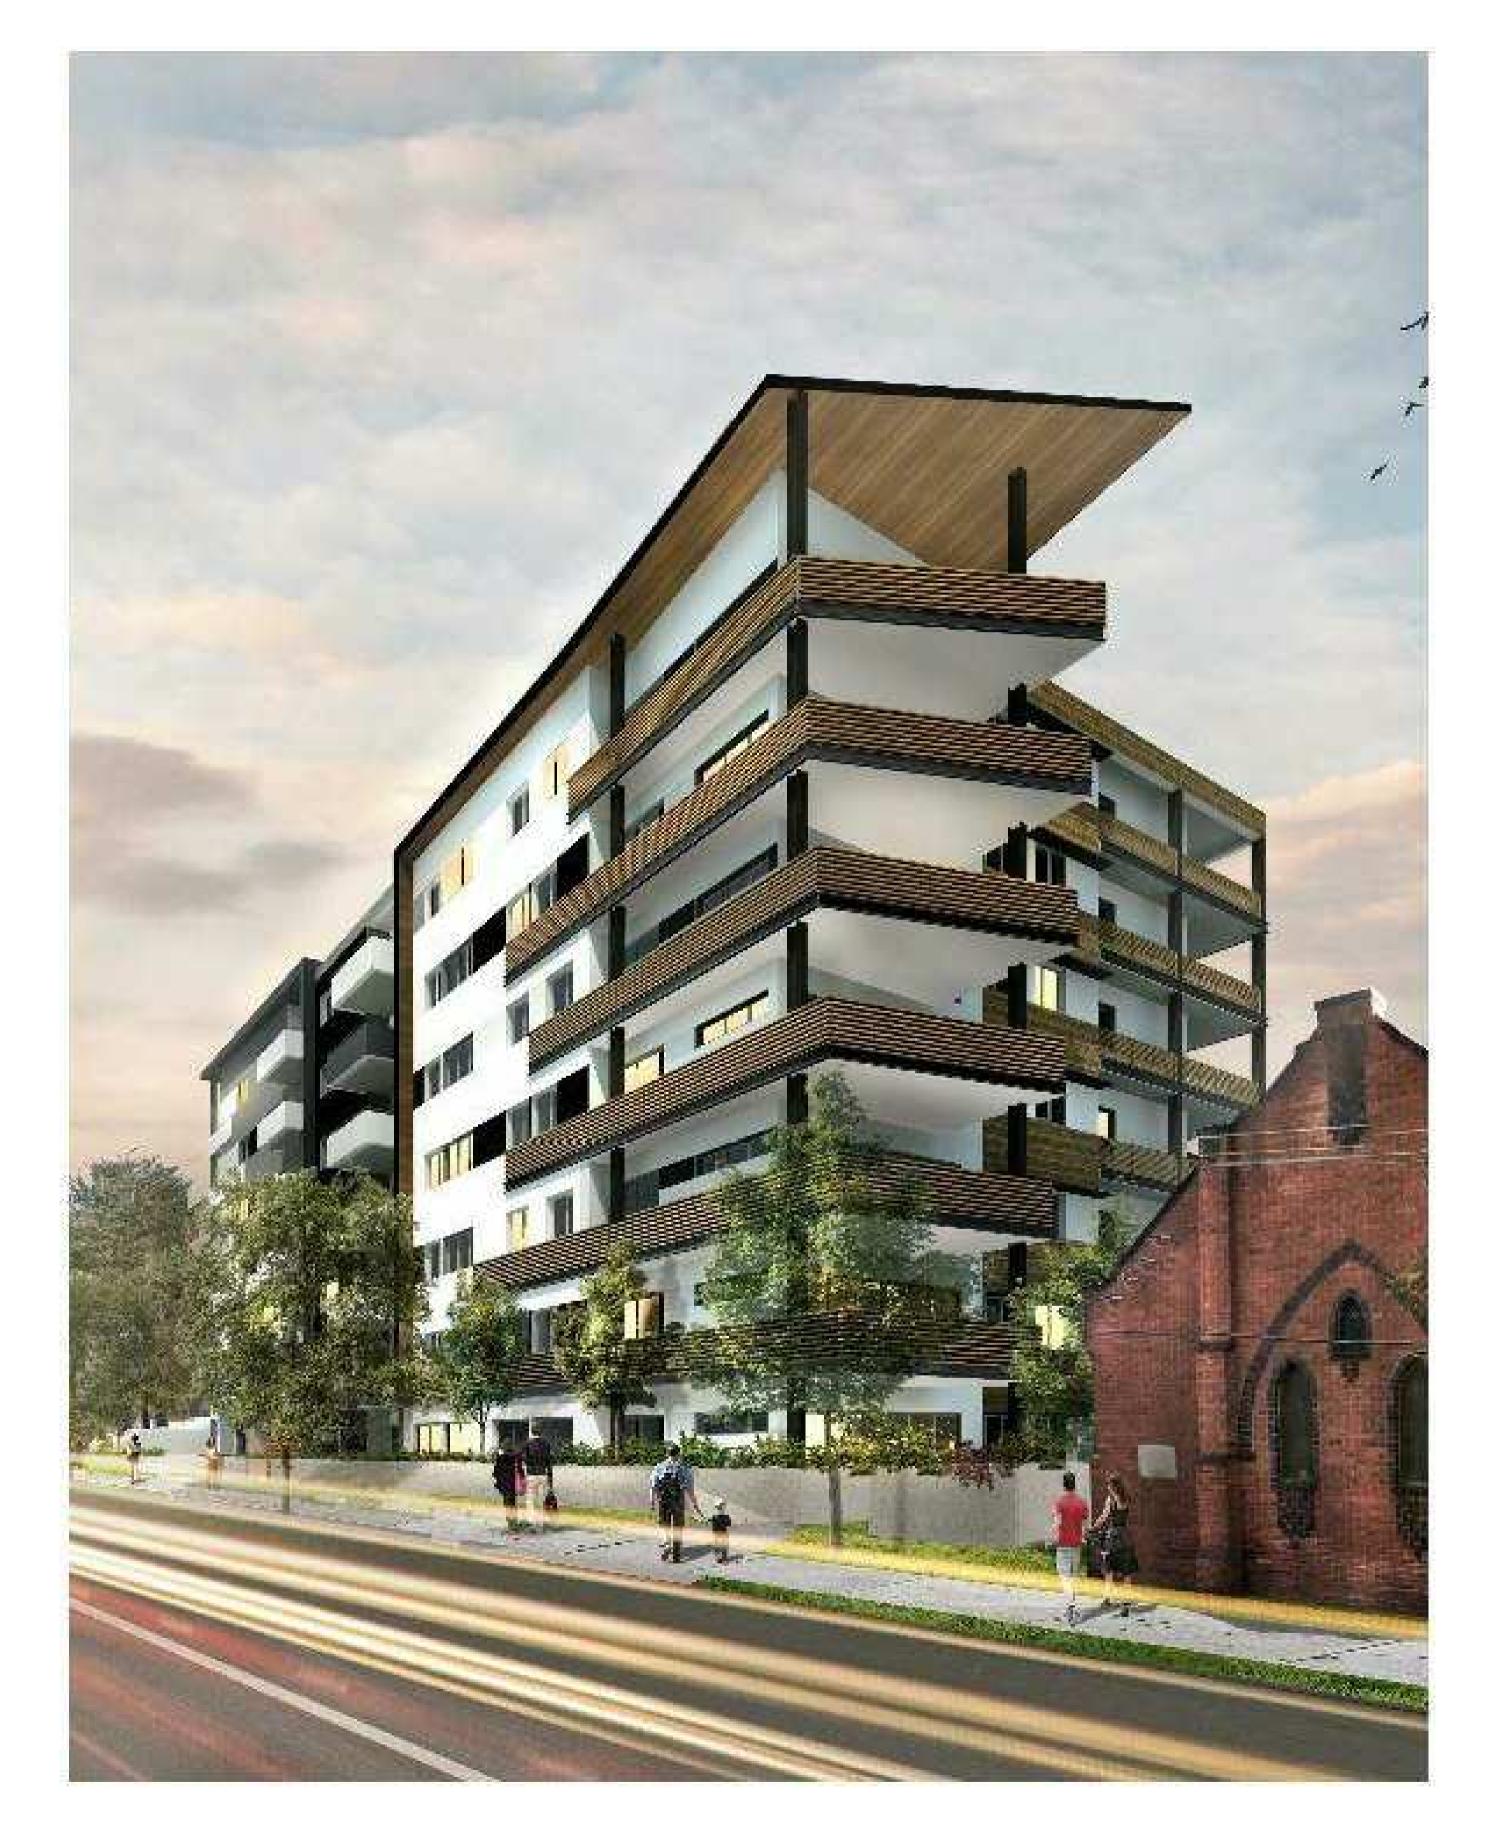


3HRS SOLAR ACCESS



NOT For Construction

RESIDENTIAL DEVELOPMENT AT 74-80 RESTWELL &1-9 LEONARD STREET

C:\00 Local Files\MRH00216 LOCAL\MRH00216_R2016_PB LOCAL.rvt	JOB No.	MRH00216
	DATE	13-05-2016
COVER SHEET	SCALE	A1 @
	DWG No.	
	S	-96.000

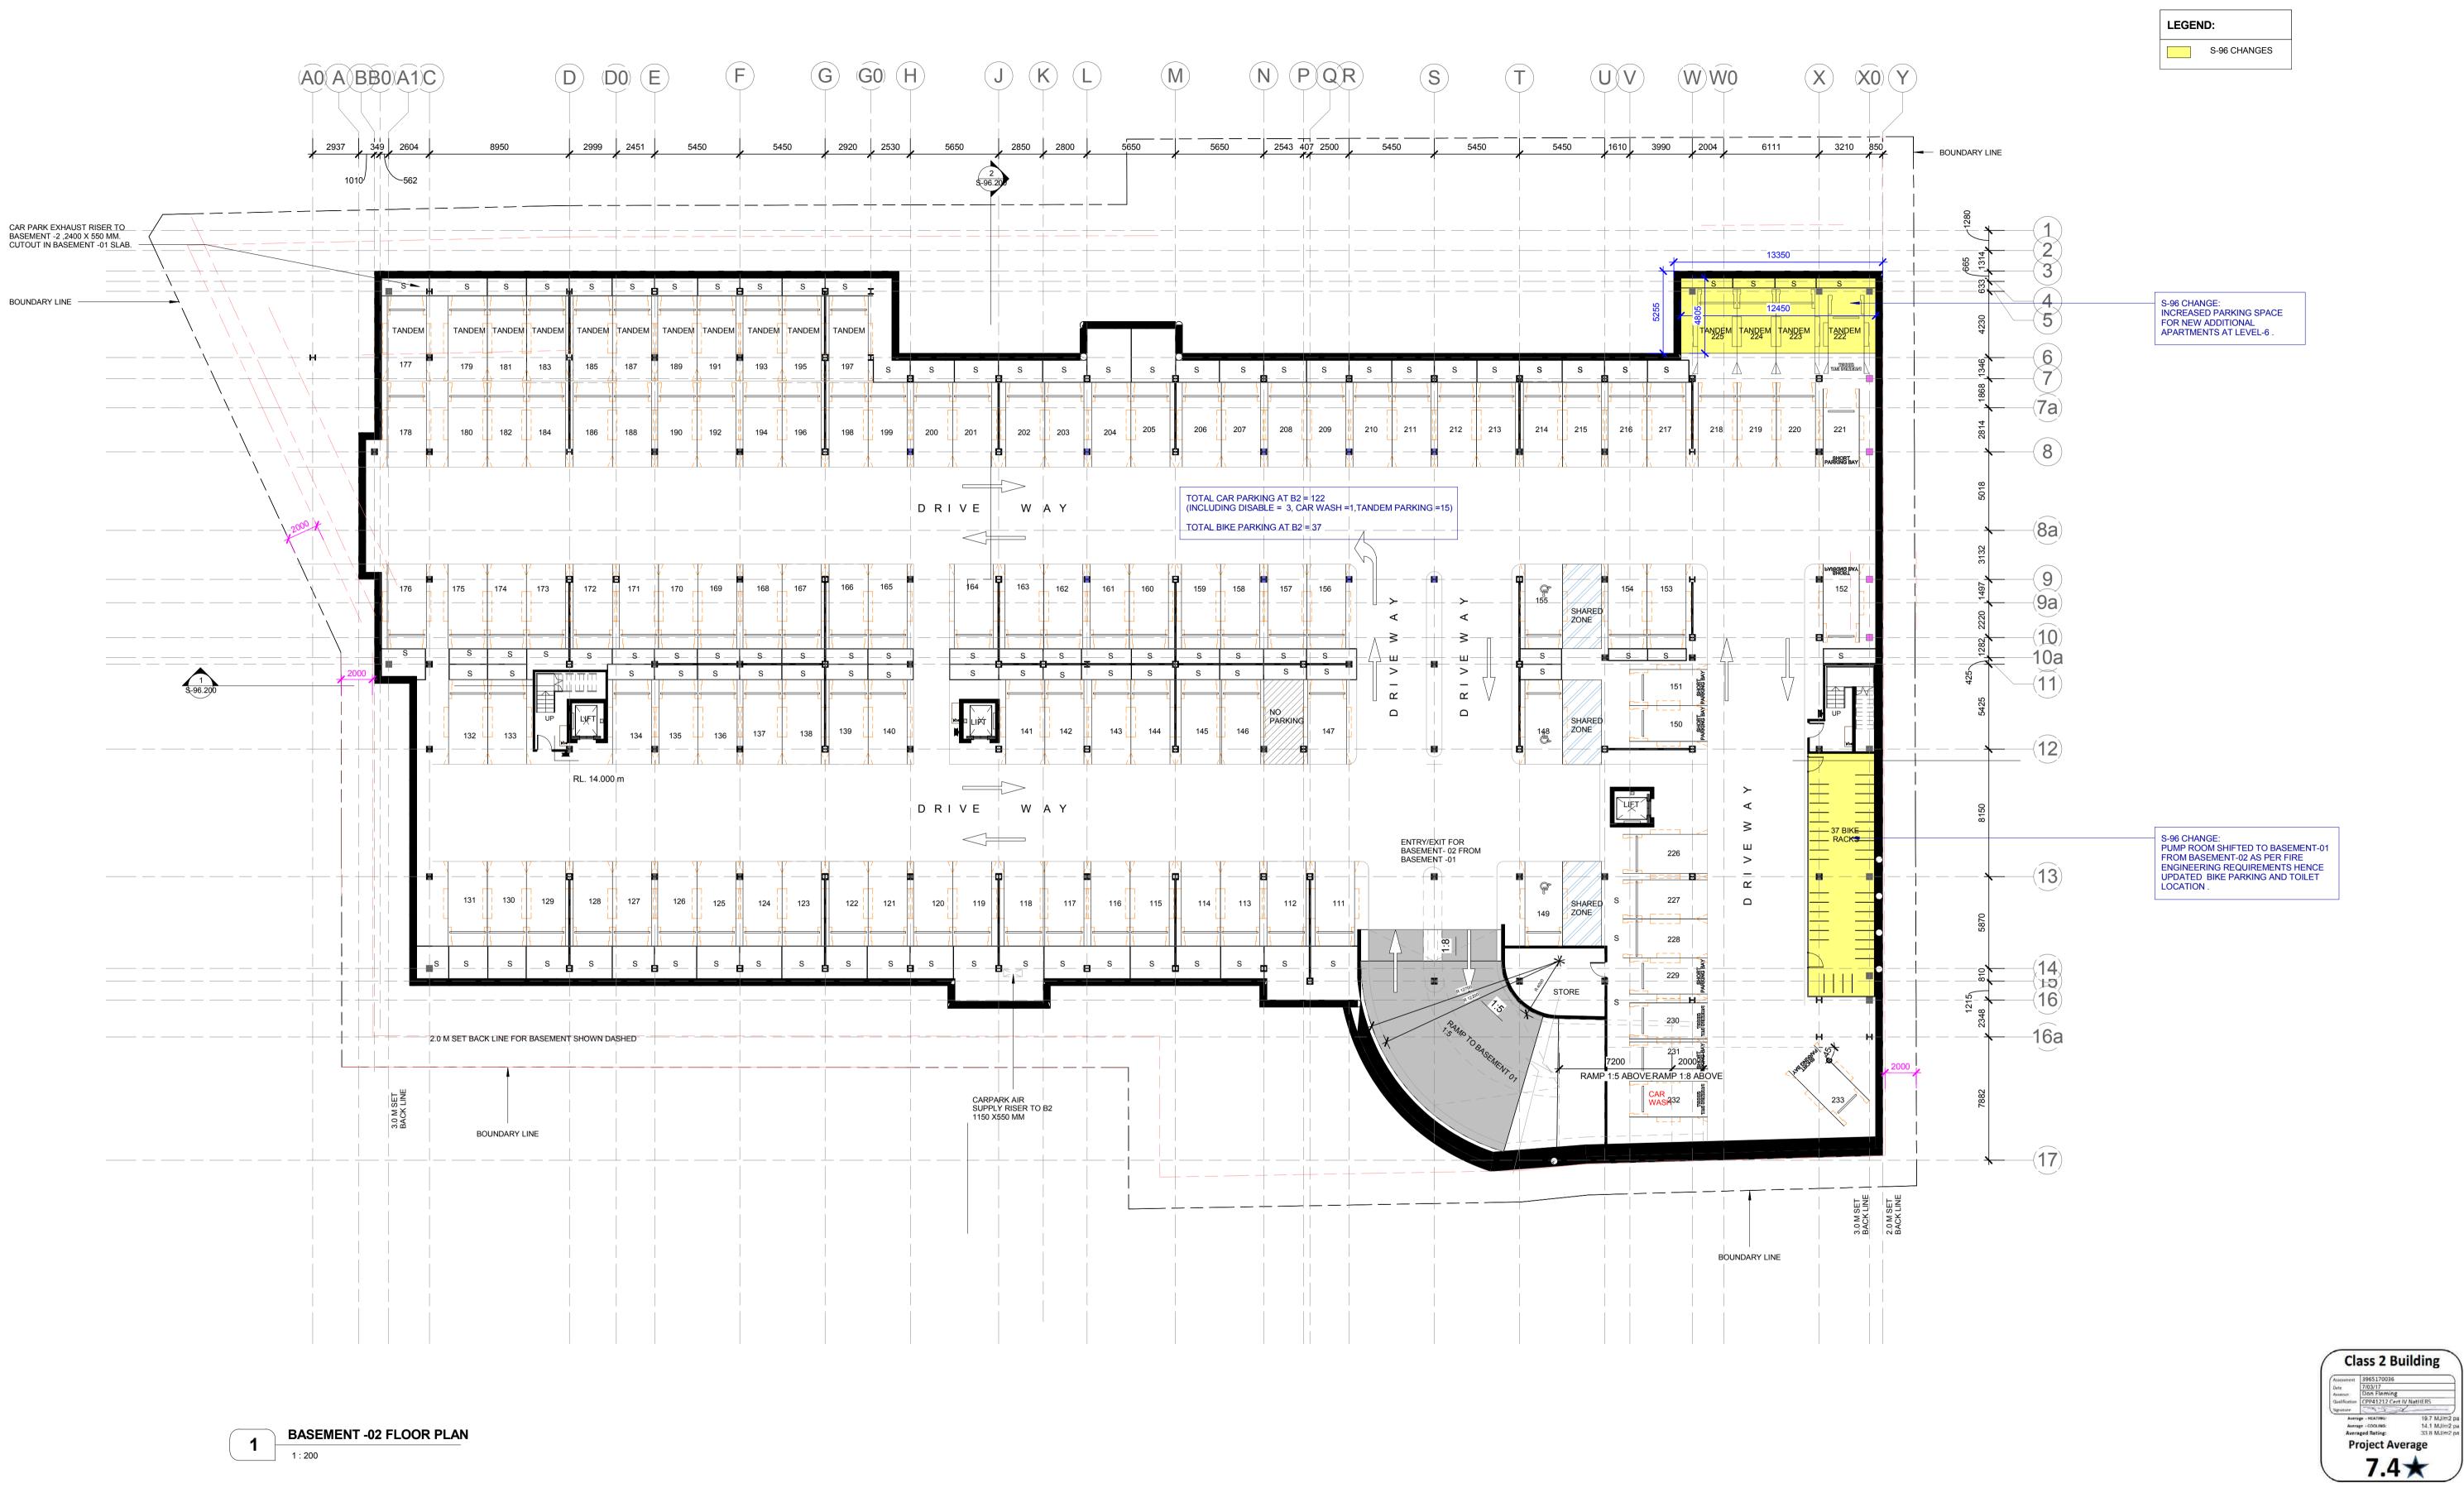



Section 96 Drawings				
Rev	Description	Date		
Α	ISSUED FOR S-96 CHANGES	05-08-2016		

CNR PARRAMATTA RD & JOHNSTON ST - PO BOX 254 - ANNANDALE - NSW 2038 - T.02 9564 8800 F.02 9517 2833 STEPHEN J. NORDON REGISTRATION No. NSW - 4704 GRAHAM P. JAGO REGISTRATION No. NSW - 4926

0m 2m 4m 6m 8m 10m Scale Bar 1:200

RESIDENTIAL DEVE

20m




TITLE

ELOPMENT AT 74-80 RESTWELL &1-9 LEG	ONARI	O STREET
C:\00 Local Files\MRH00216 LOCAL\MRH00216_R2016_PB LOCAL.rvt	JOB No.	MRH00216
	DATE	13-05-2016

7.4★

	DWG No.	-96.091
BASEMENT 02 FLOOR PLAN	SCALE	A1 @ As indicated
	DATE	13-05-2016
C:\00 Local Files\MRH00216 LOCAL\MRH00216_R2016_PB LOCAL.rvt	JOB No.	MRH00216

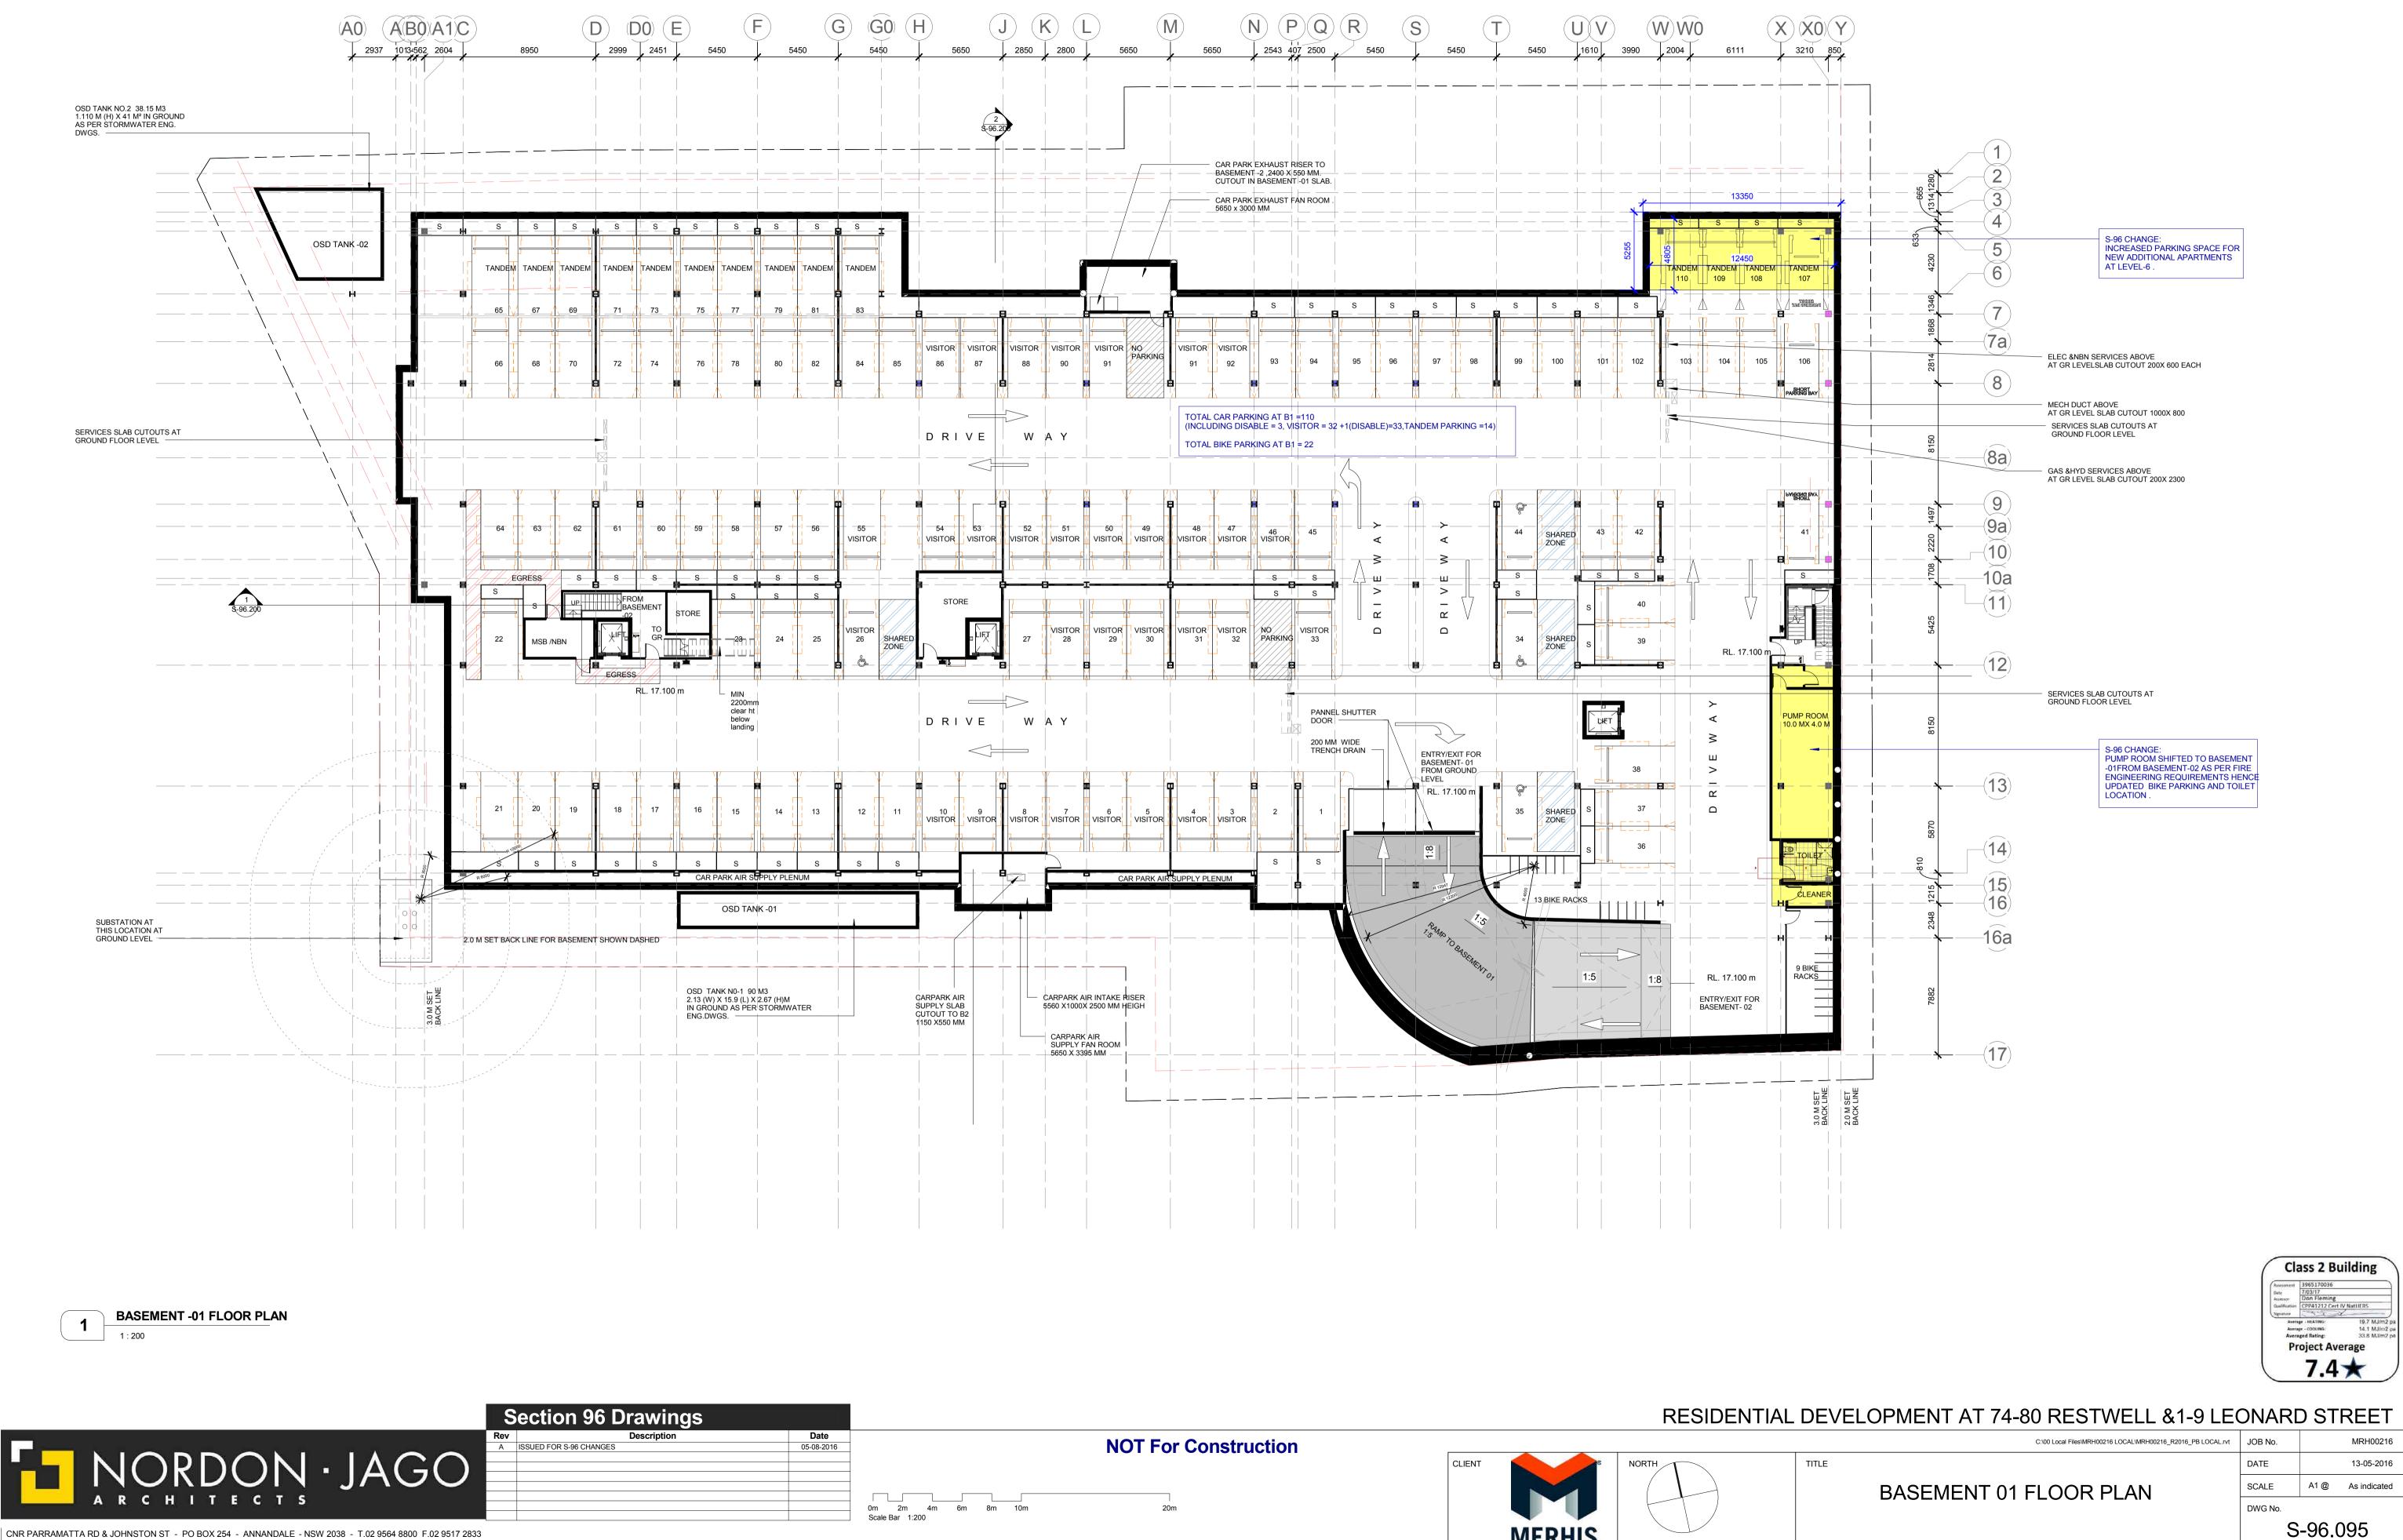





Section 96 Drawings				
,	Description	Date		
	ISSUED FOR S-96 CHANGES	05-08-2016		
			_	
			0n	

STEPHEN J. NORDON REGISTRATION No. NSW - 4704 GRAHAM P. JAGO REGISTRATION No. NSW - 4926






LEGEND:					
	S-96 CHANGES				

S-96.095

MRH00216


13-05-2016

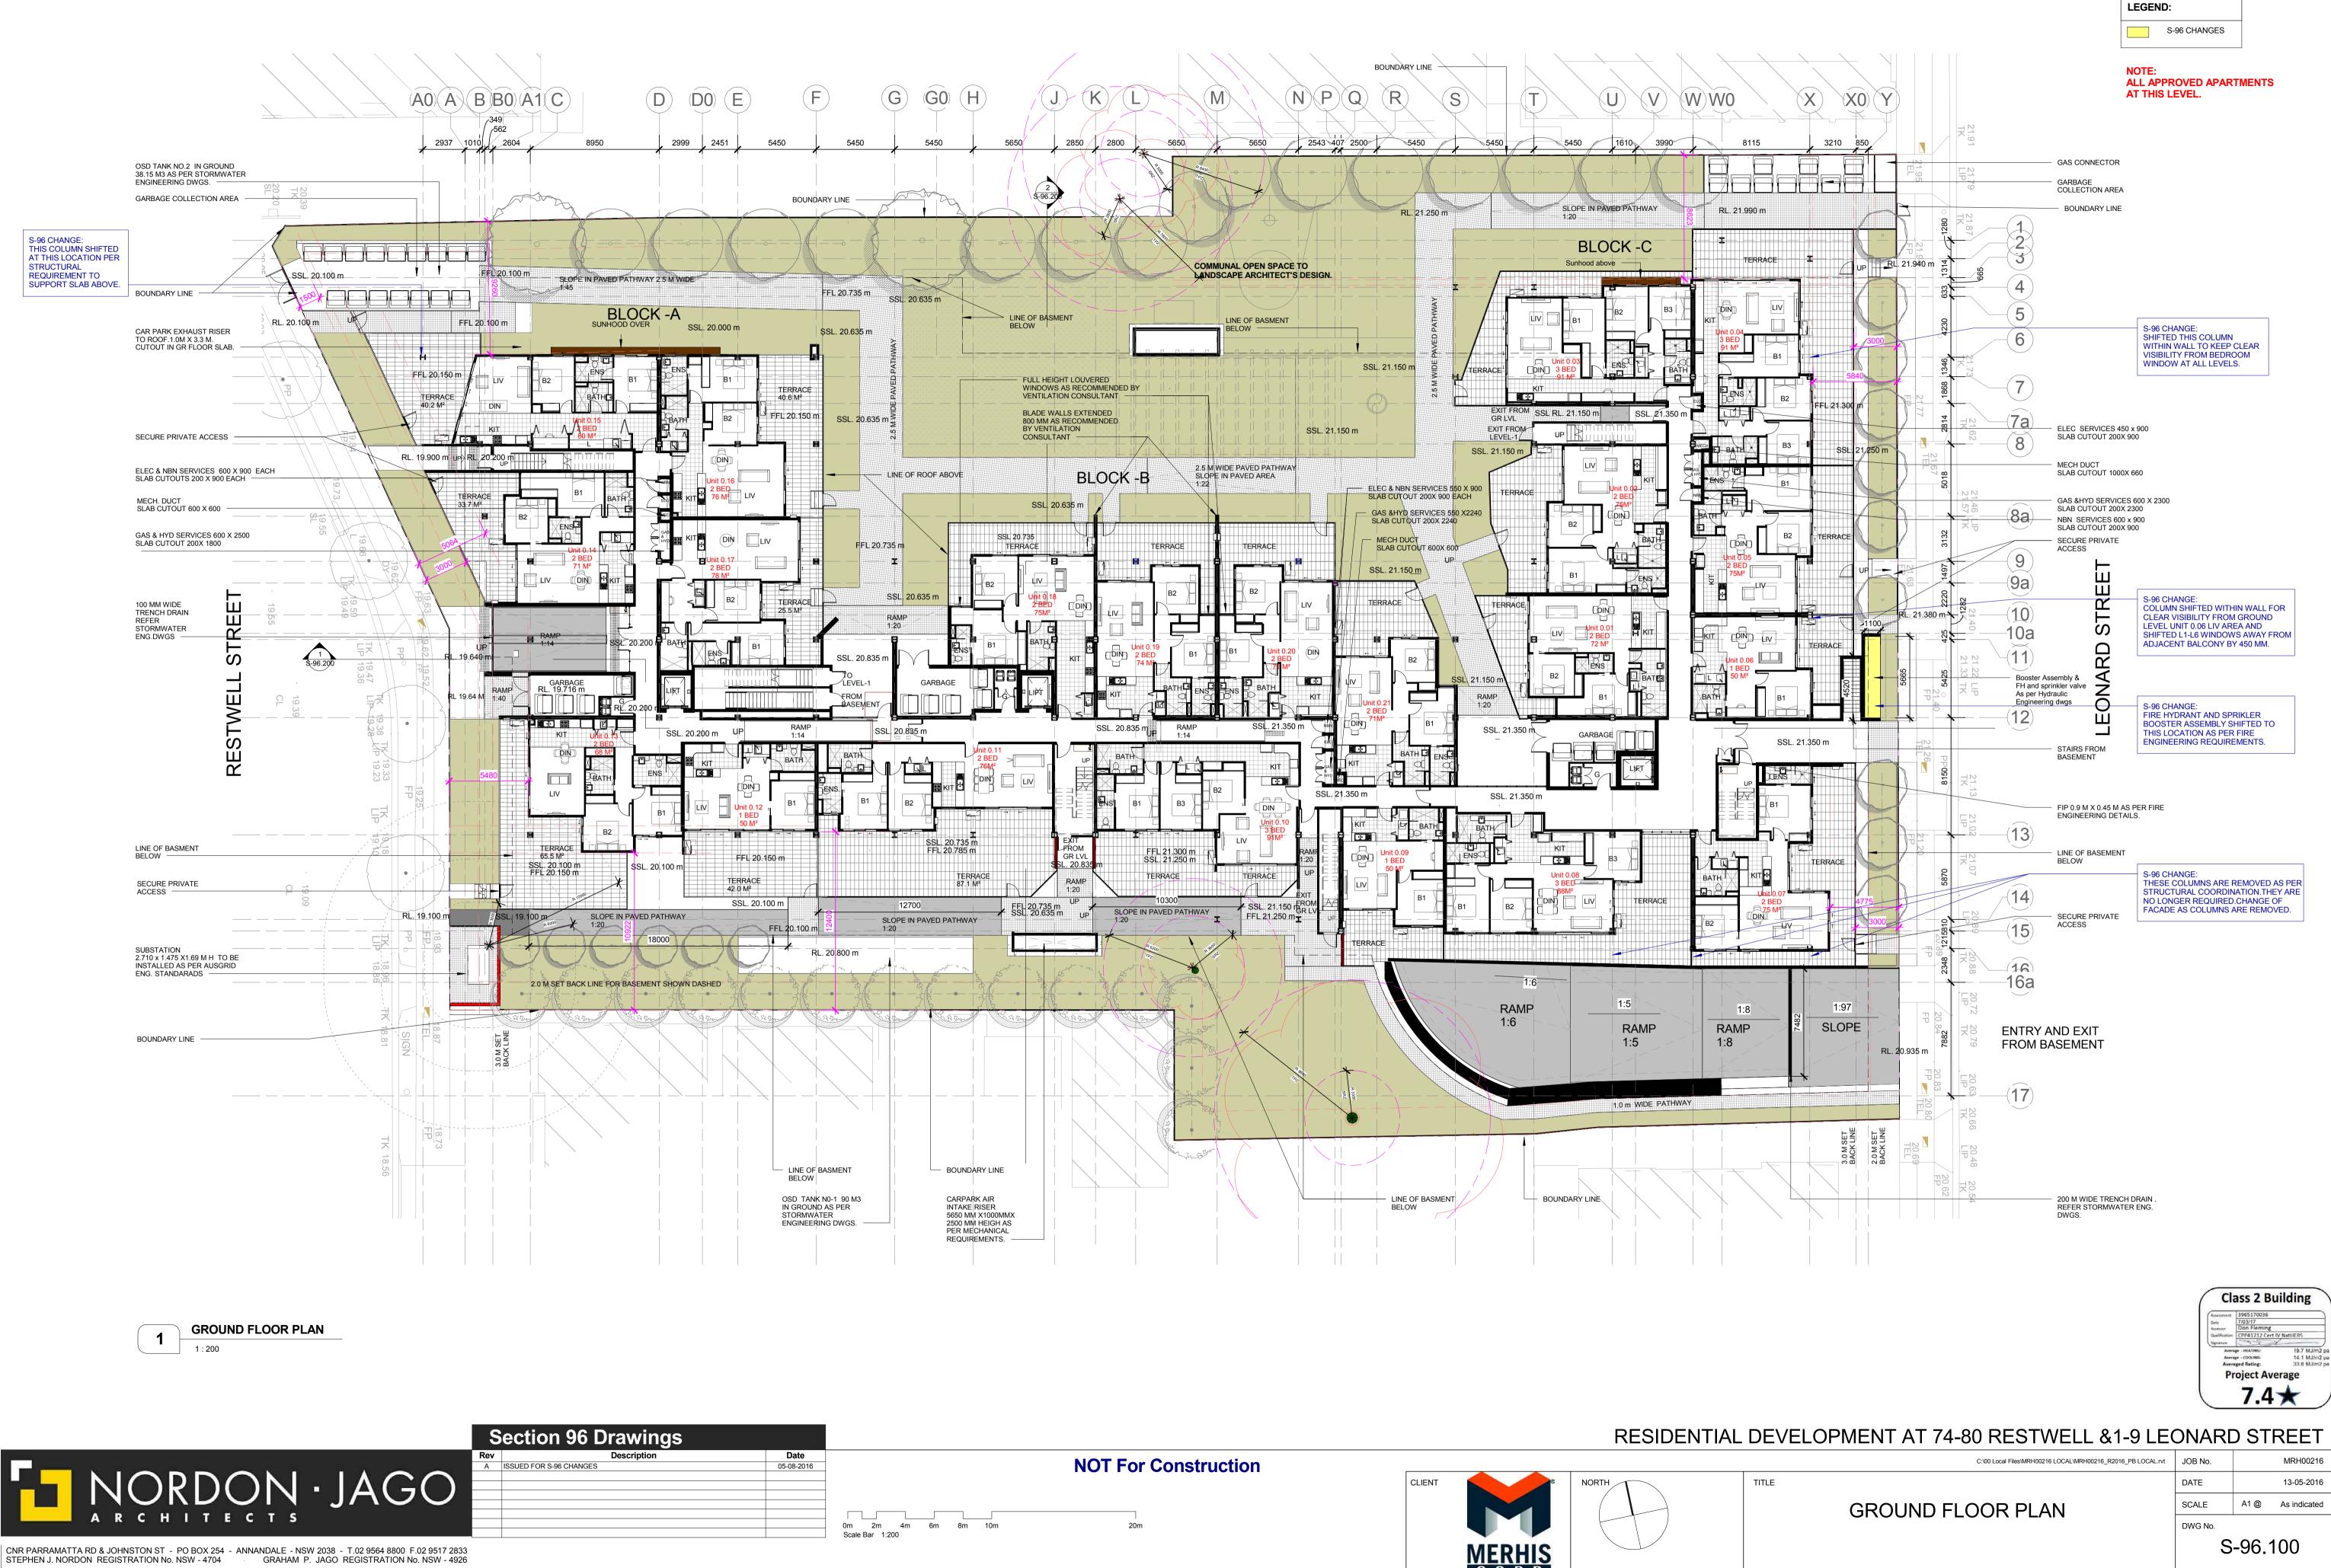






Section 96 Drawings				
Rev	Description	Date		
A	ISSUED FOR S-96 CHANGES	05-08-2016		

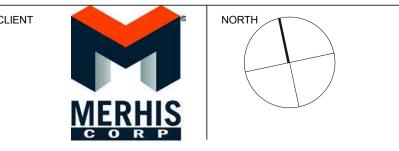

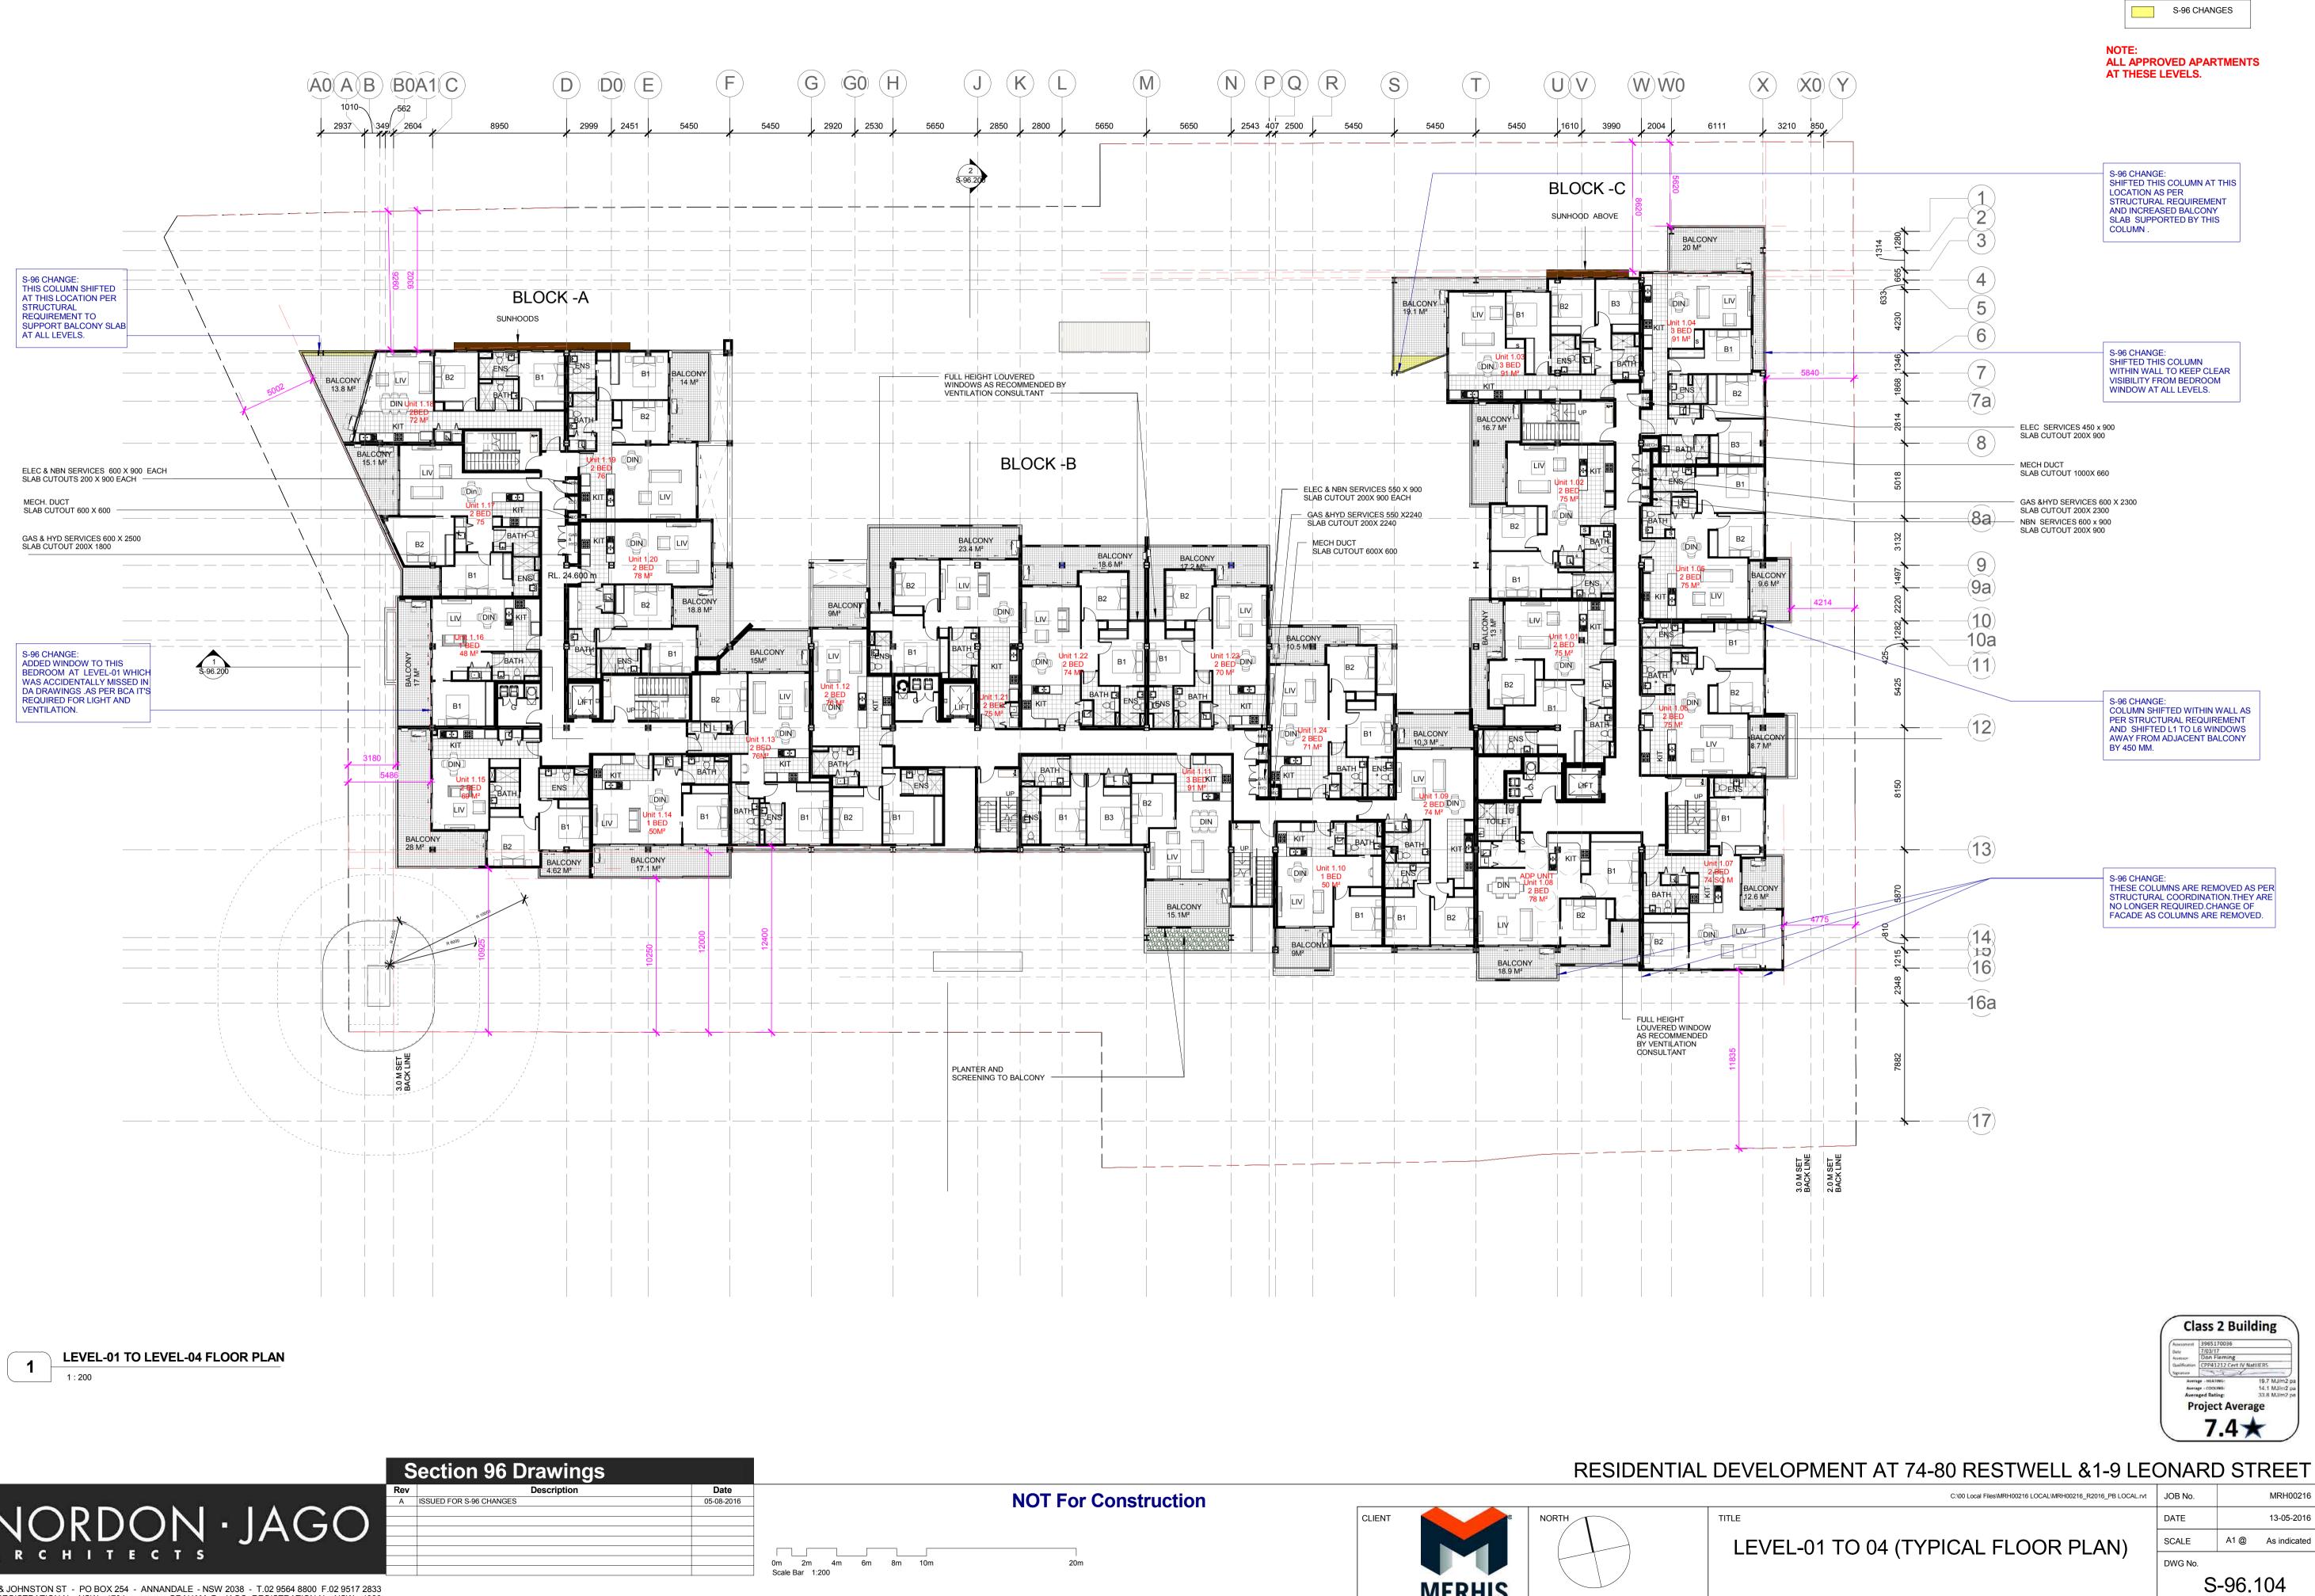




Section 96 Drawings			
Rev	Description	Date	
А	ISSUED FOR S-96 CHANGES	05-08-2016]
			0m
			See

CNR PARRAMATTA RD & JOHNSTON ST - PO BOX 254 - ANNANDALE - NSW 2038 - T.02 9564 8800 F.02 9517 2833 GRAHAM P. JAGO REGISTRATION No. NSW - 4926 STEPHEN J. NORDON REGISTRATION No. NSW - 4704



LEGEND:

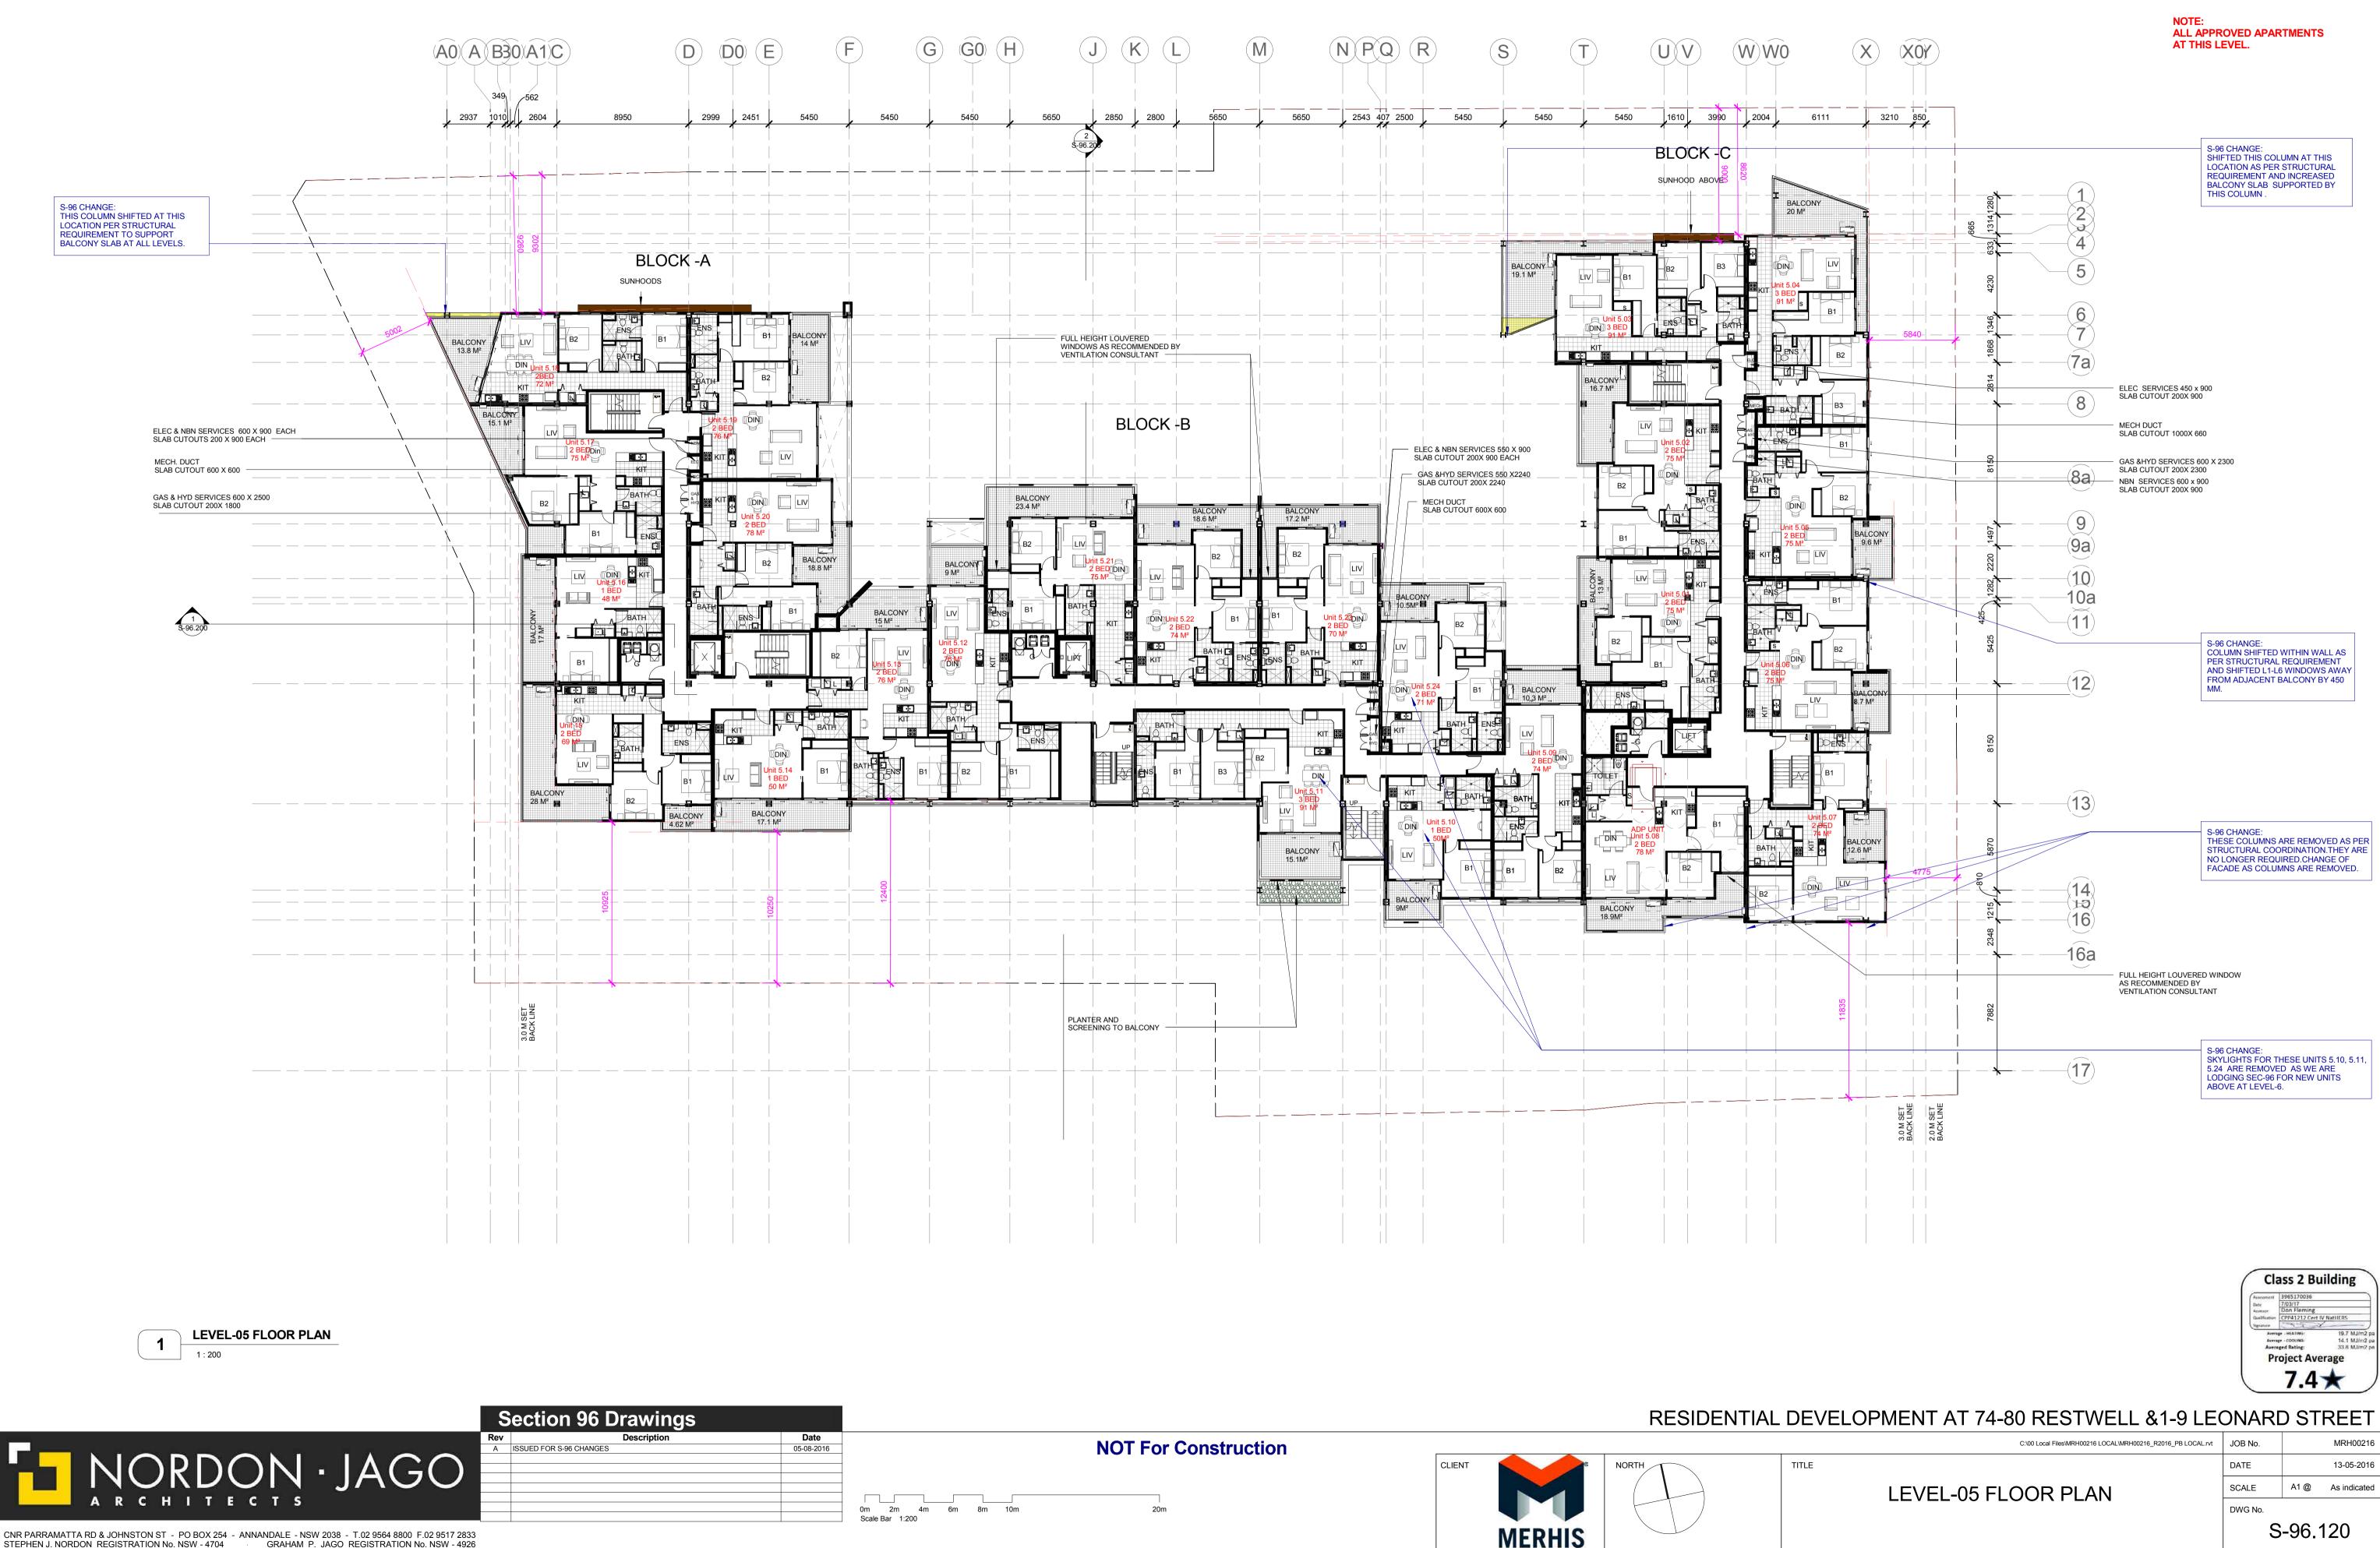






	96 Drawings	Date
Rev	•	Dale
A ISSUED FOR S-96 C	CHANGES	05-08-2016

STEPHEN J. NORDON REGISTRATION No. NSW - 4704 GRAHAM P. JAGO REGISTRATION No. NSW - 4926





LEGEND: S-96 CHANGES

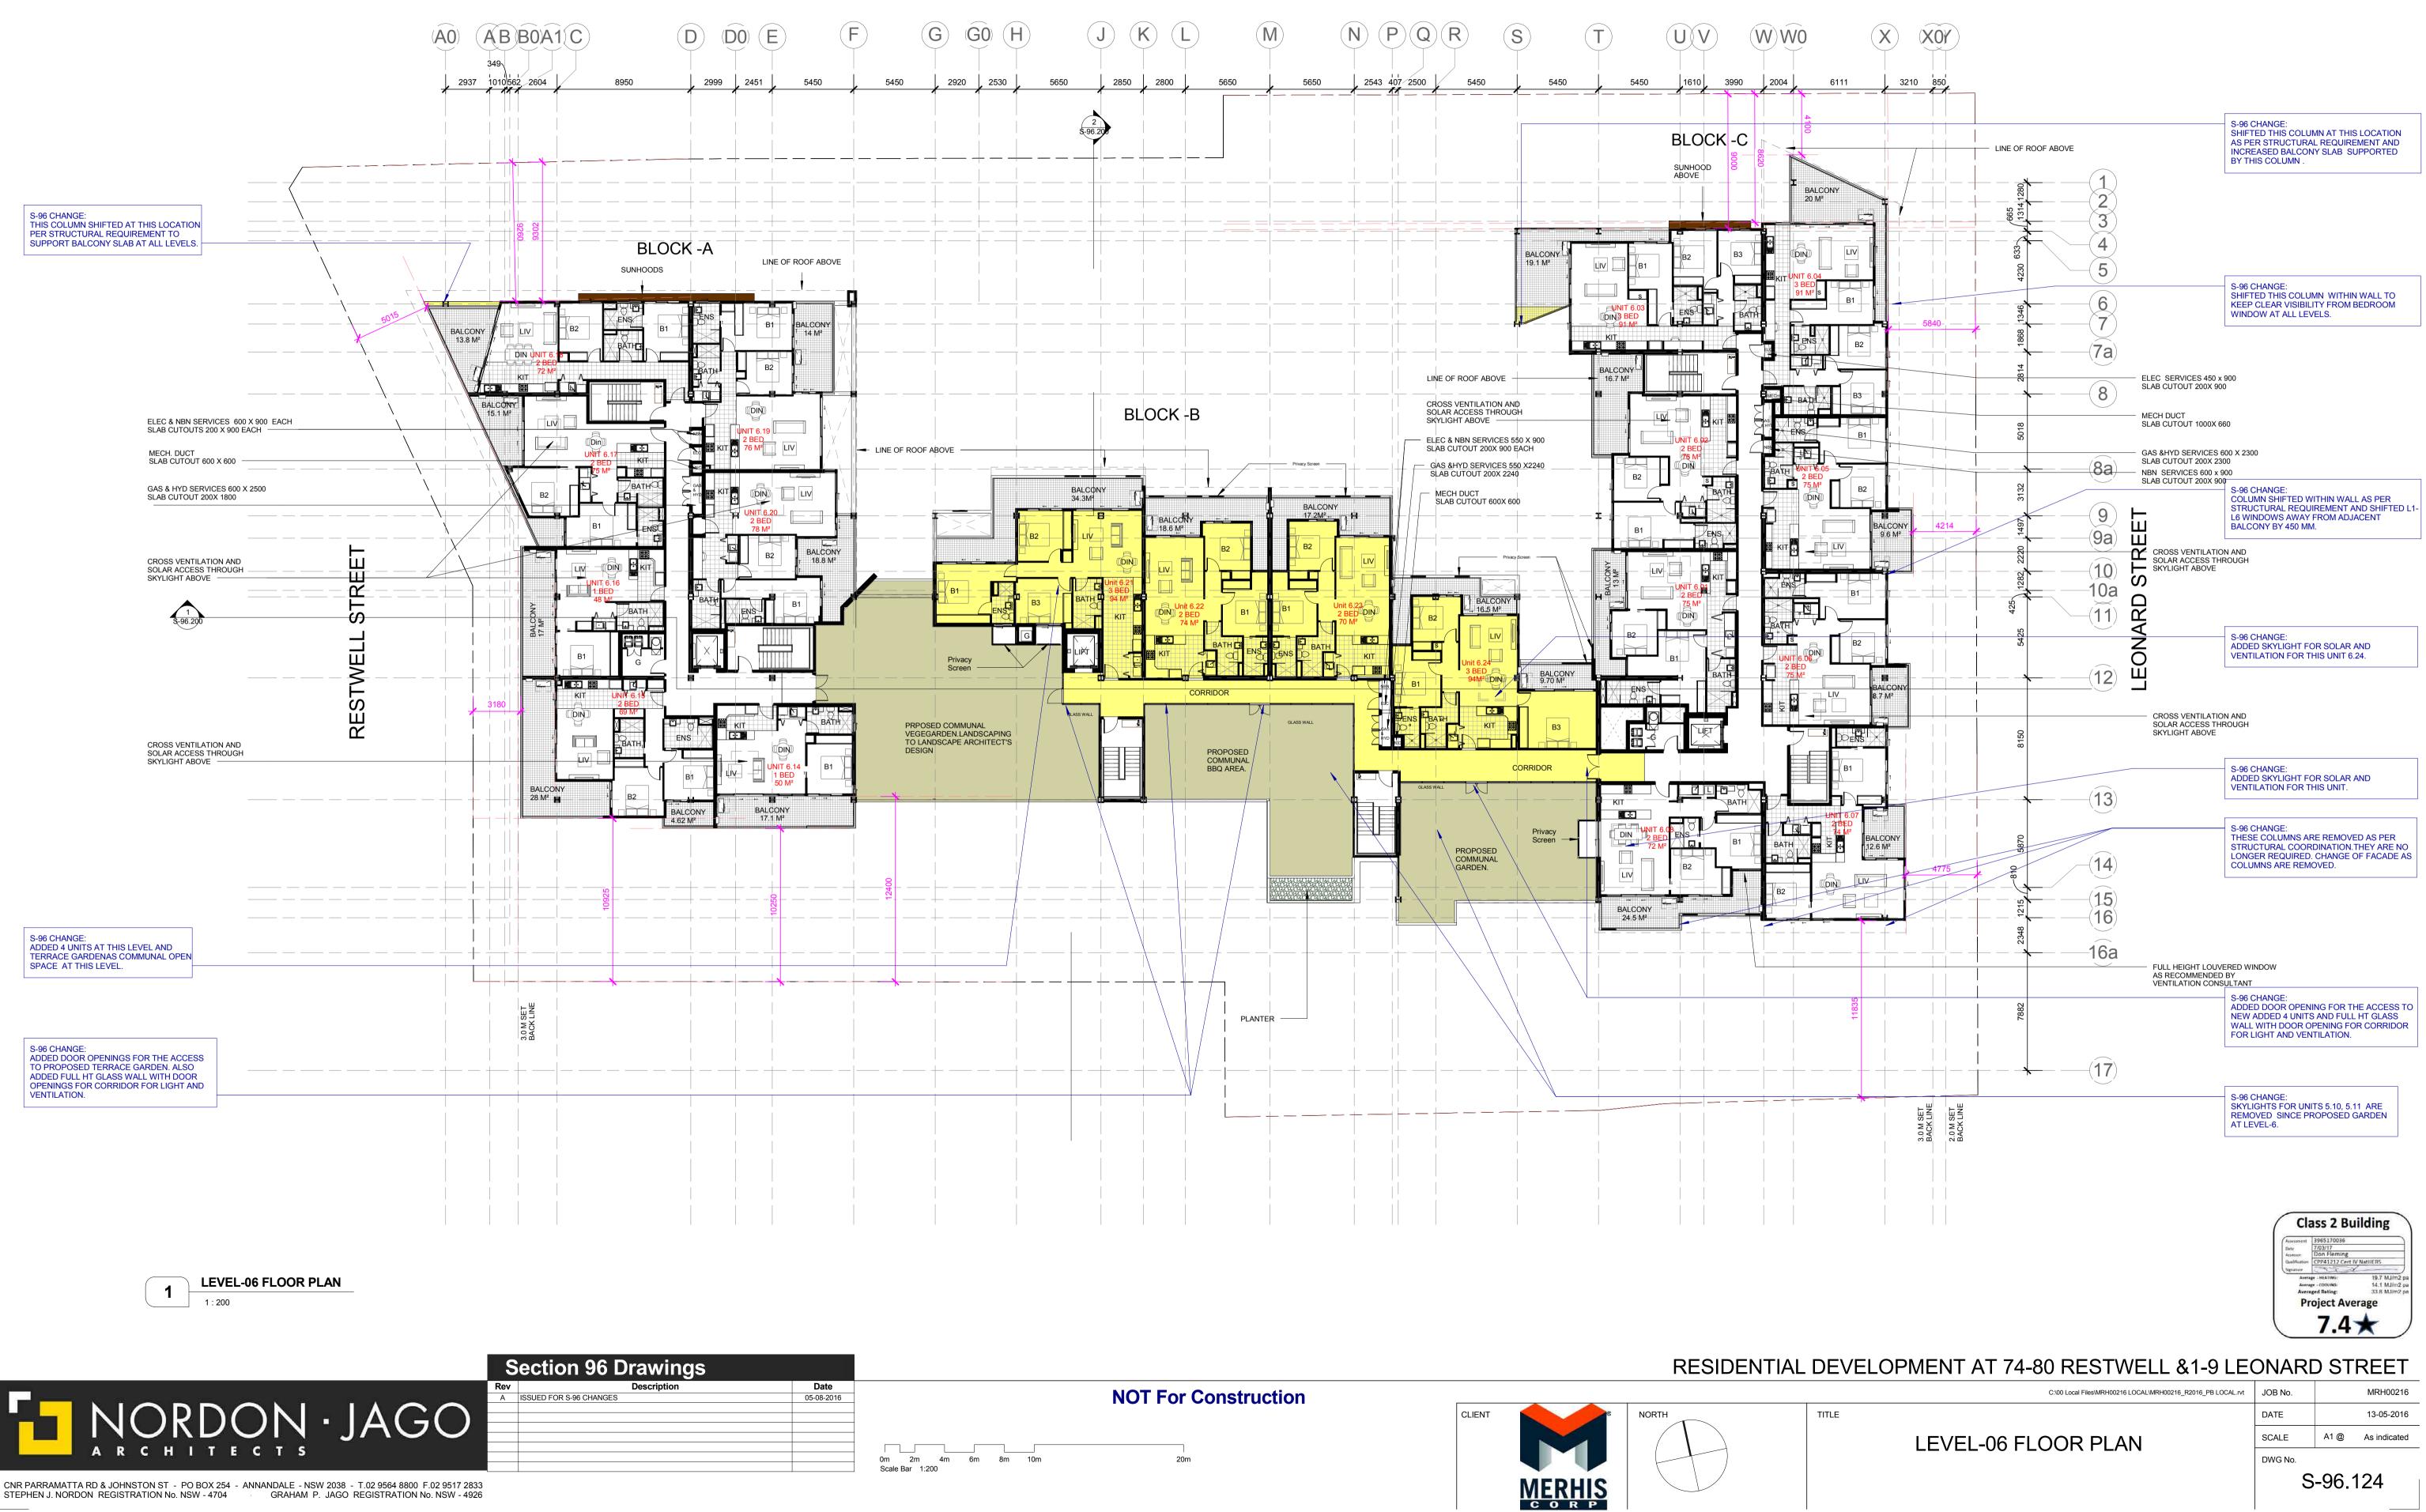




S	Section 96 Drawings		
Rev	Description	Date	
А	ISSUED FOR S-96 CHANGES	05-08-2016	

STEPHEN J. NORDON REGISTRATION No. NSW - 4704




LEGEND: S-96 CHANGES

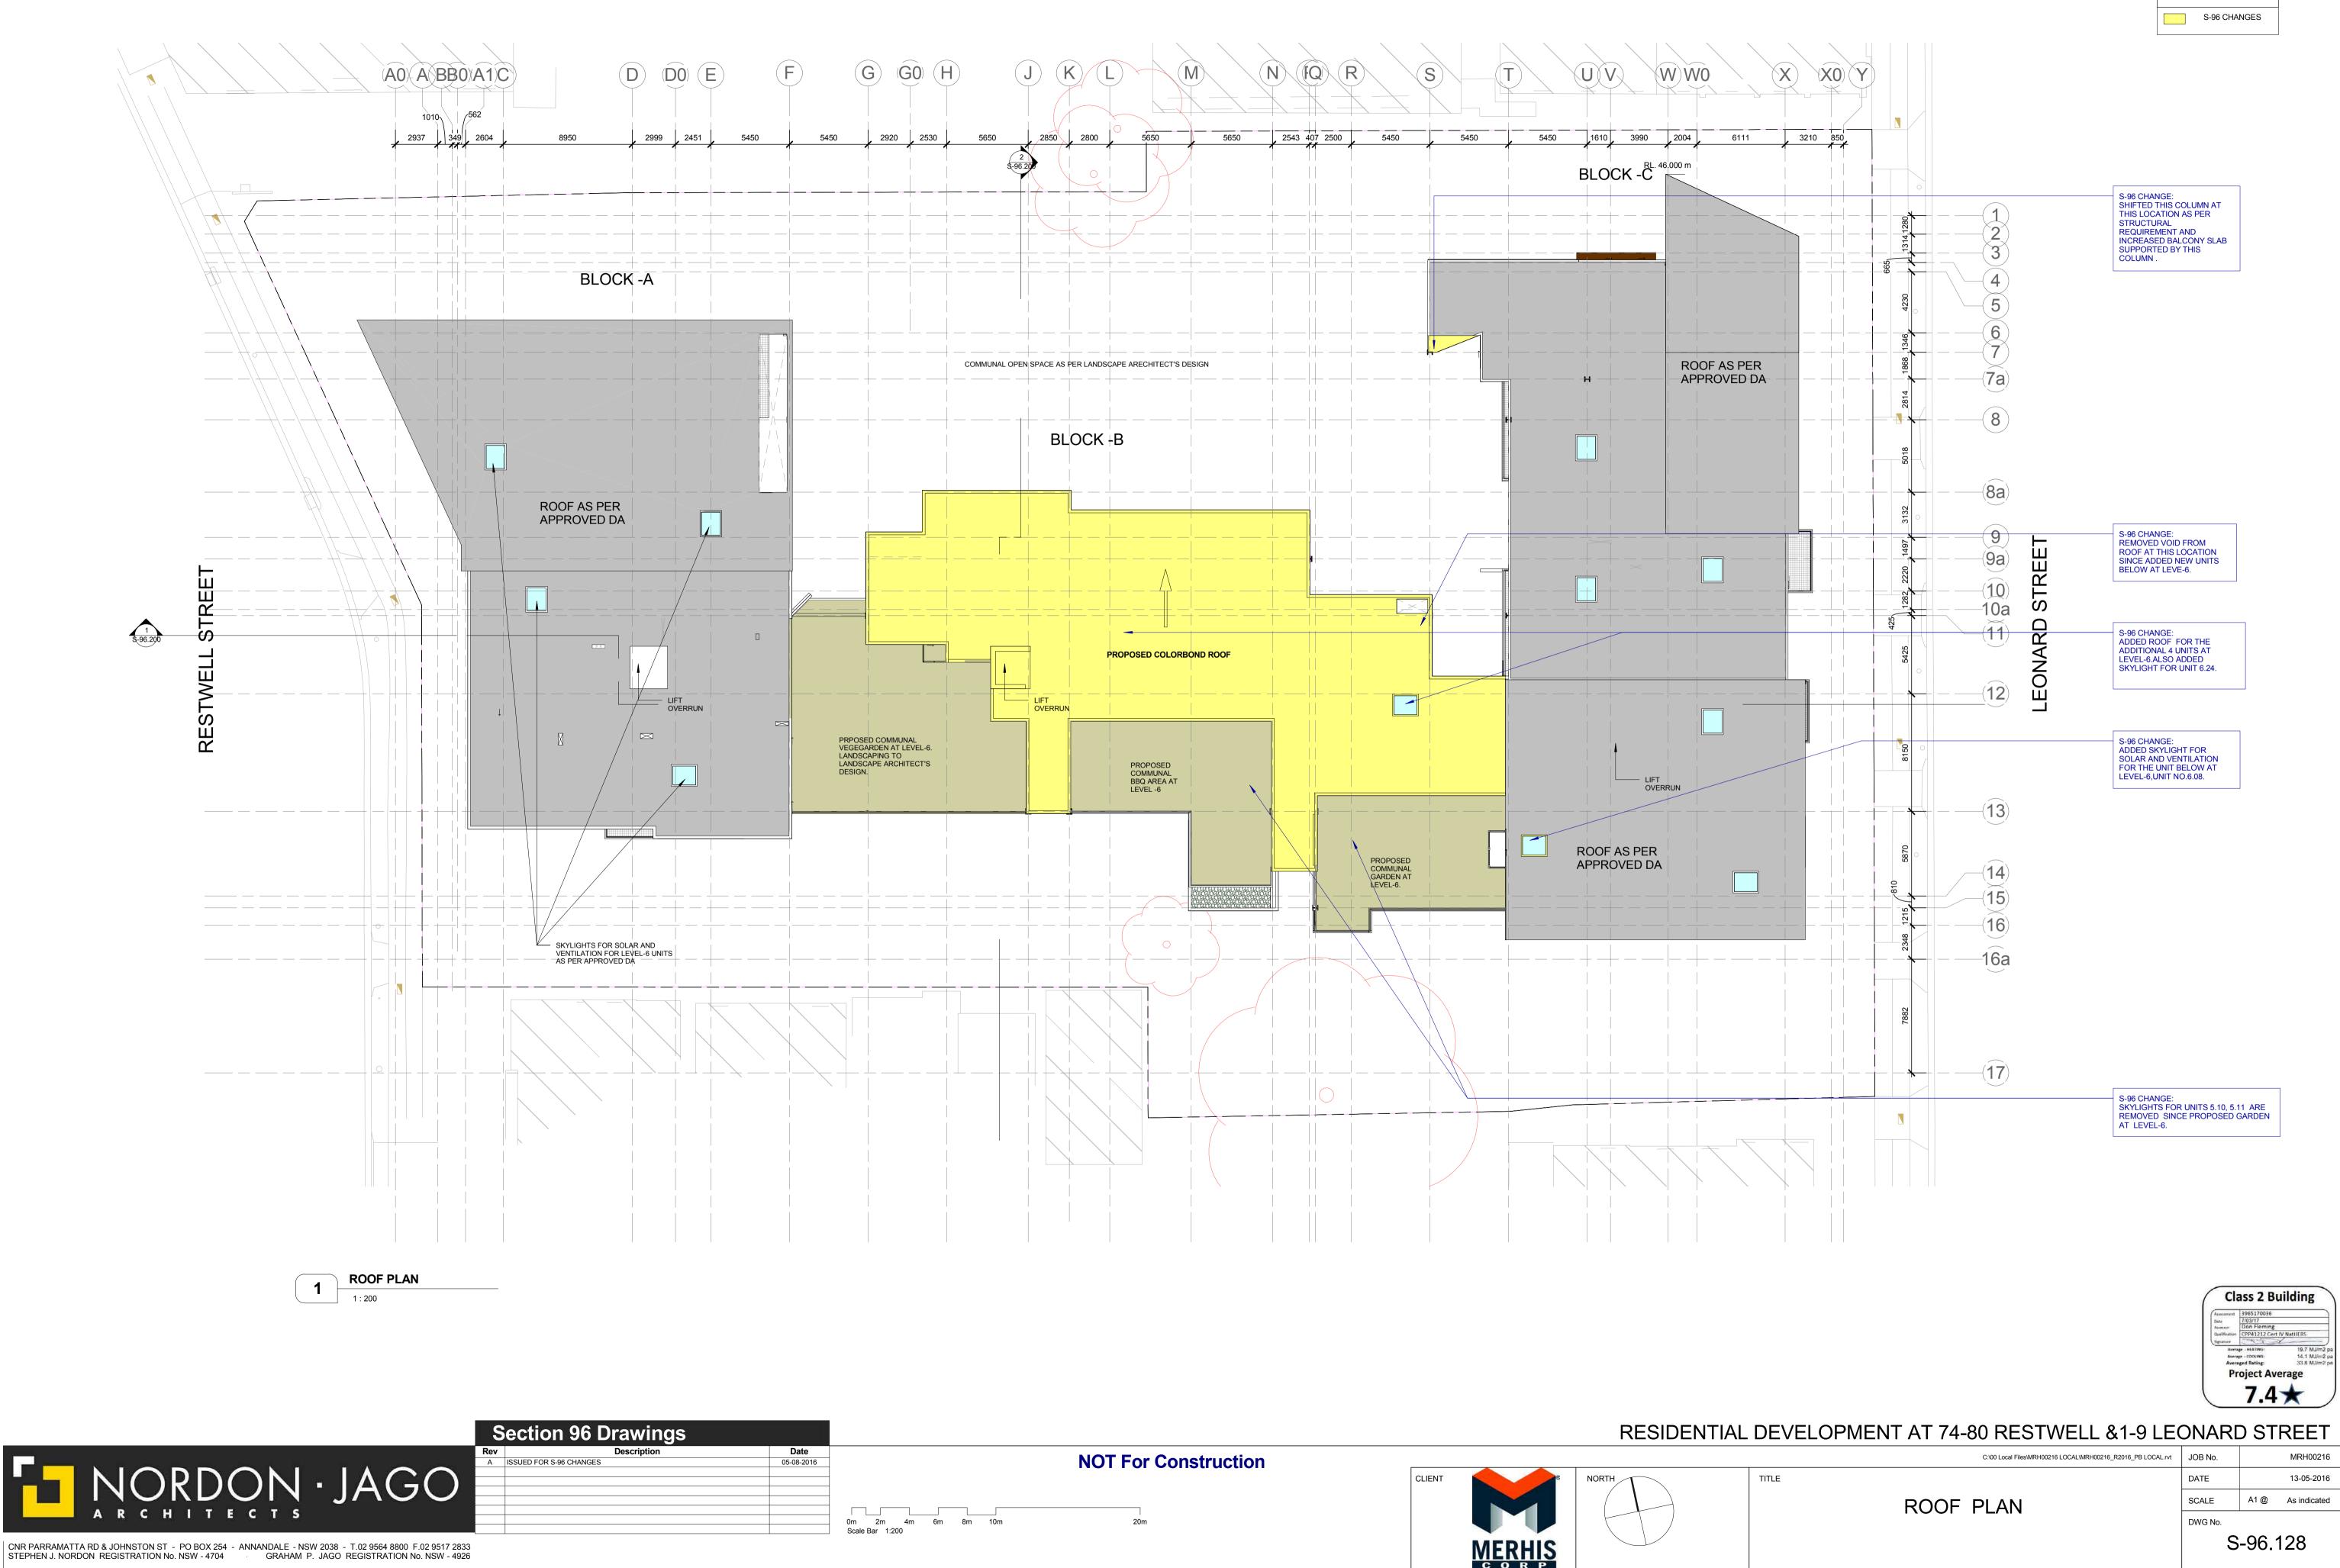



	Section 96 Drawings		
Rev	Description	Date	
А	ISSUED FOR S-96 CHANGES	05-08-2016	
_			
			0r



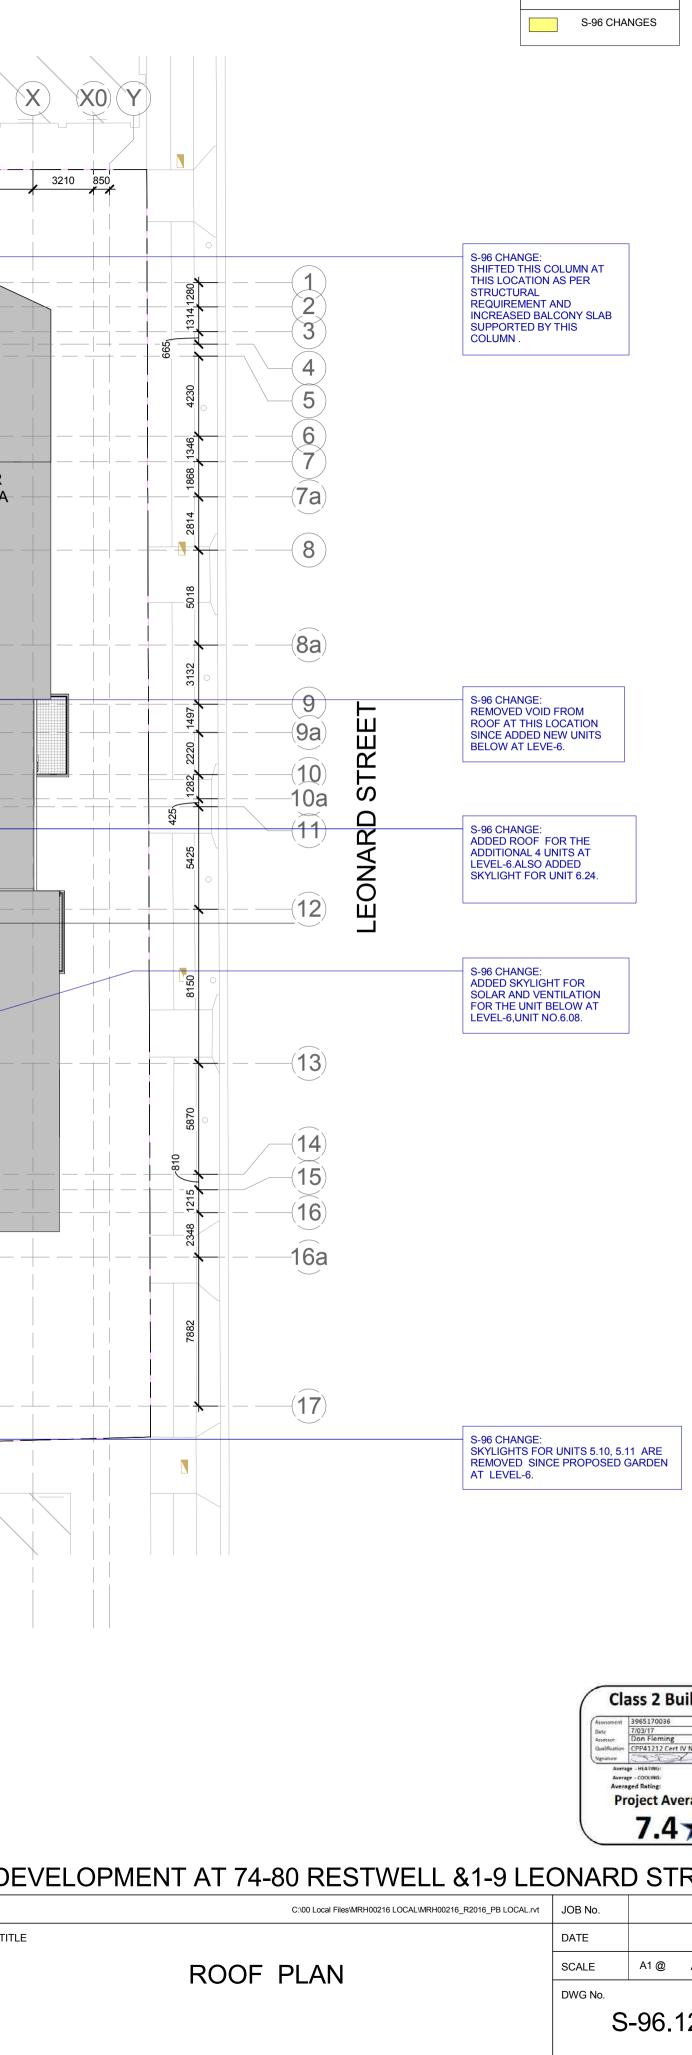

LEGEND:



8 AM on 21 MAR 1 : 1500



4 PM on 21 MAR 1 : 1500



S	Section 96 Drawings			
Rev	Description	Date		
А	ISSUED FOR S-96 CHANGES	05-08-2016		

CNR PARRAMATTA RD & JOHNSTON ST - PO BOX 254 - ANNANDALE - NSW 2038 - T.02 9564 8800 F.02 9517 2833 STEPHEN J. NORDON REGISTRATION No. NSW - 4704 GRAHAM P. JAGO REGISTRATION No. NSW - 4926



2 12 PM on 21 MAR 1 : 1500

NORTH



C:\00 Local Files\MRH00216 LOCAL\MRH00216_R2016_PB LOCAL.rvt	JOB No.		MRH00216
SHADOW DIAGRAM - 21 MARCH	DATE		13-05-2016
	SCALE	A1 @	As indicated
	DWG No.		
S-96.140		140	



8AM ON 21 JUNE 1 : 1500



3 10AM ON 21 JUNE 1 : 1500




S	Section 96 Drawings			
Rev	Description	Date		
А	ISSUED FOR S-96 CHANGES	05-08-2016		

CNR PARRAMATTA RD & JOHNSTON ST - PO BOX 254 - ANNANDALE - NSW 2038 - T.02 9564 8800 F.02 9517 2833 STEPHEN J. NORDON REGISTRATION No. NSW - 4704 GRAHAM P. JAGO REGISTRATION No. NSW - 4926



2 9AM ON 21 JUNE 1 : 1500

NORTH

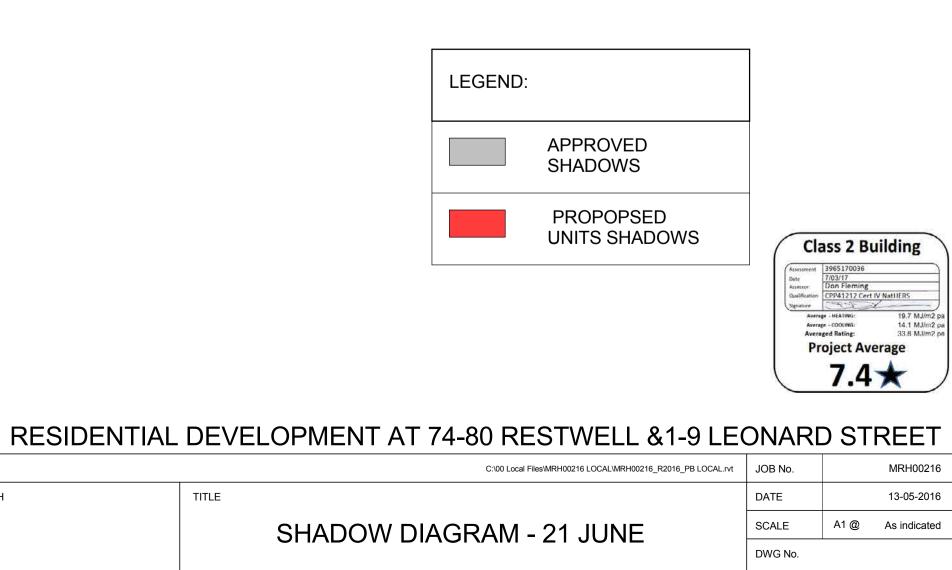



11AM ON 21 JUNE 1 : 1500



3 1PM ON 21 JUNE 1 : 1500



S	Section 96 Drawings				
Rev	Description	Date			
А	ISSUED FOR S-96 CHANGES	05-08-2016			

CNR PARRAMATTA RD & JOHNSTON ST - PO BOX 254 - ANNANDALE - NSW 2038 - T.02 9564 8800 F.02 9517 2833 STEPHEN J. NORDON REGISTRATION No. NSW - 4704 GRAHAM P. JAGO REGISTRATION No. NSW - 4926



2 12PM ON 21 JUNE 1 : 1500

RESIDENTIAL DEVELOF

NORTH



	LEGEND:		
	APPROVED SHADOWS		
	PROPOPSED UNITS SHADOWS	Clay	ss 2 Building
		Assessment 3 Date 7 Assessor 0 Qualification 0 Signature Average Average	965170036 103/17 10/
OPMENT A	74-80 RESTWELL &1-9 LE	ONARI	O STREET
	C:\00 Local Files\MRH00216 LOCAL\MRH00216_R2016_PB LOCAL.rvt	JOB No.	MRH00216
		DATE	13-05-2016
SHADOW F	AGRAM - 21 JUNE	SCALE	A1 @ As indicated
		DWG No.	·
		S	-96.142



1 2PM ON 21 JUNE 1 : 1500



4PM ON 21 JUNE 1 : 1500




Section 96 Drawings		
Rev	Description	Date
А	ISSUED FOR S-96 CHANGES	05-08-2016

CNR PARRAMATTA RD & JOHNSTON ST - PO BOX 254 - ANNANDALE - NSW 2038 - T.02 9564 8800 F.02 9517 2833 STEPHEN J. NORDON REGISTRATION No. NSW - 4704 GRAHAM P. JAGO REGISTRATION No. NSW - 4926



2 3PM ON 21 JUNE 1:1500



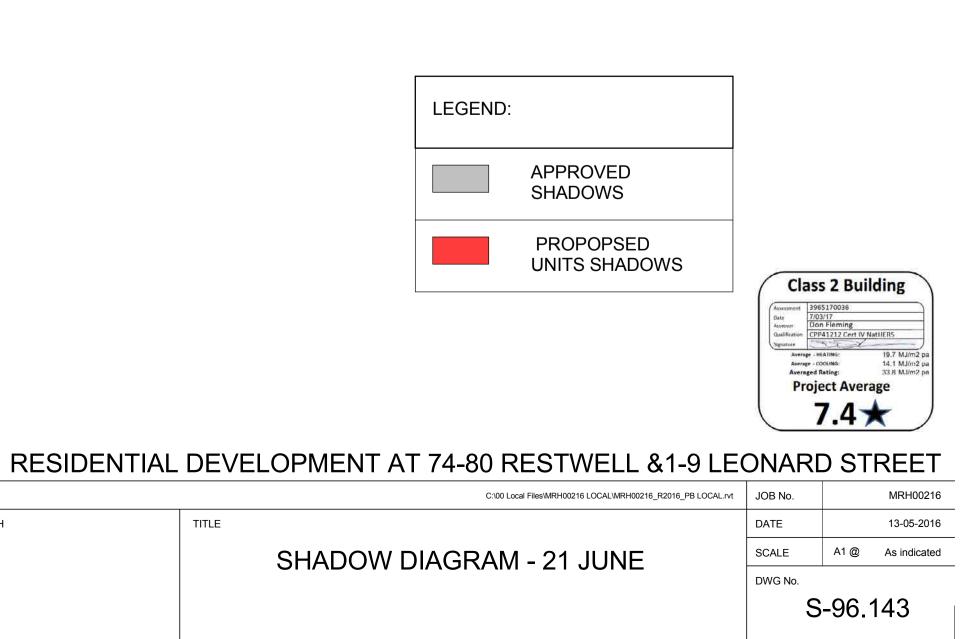



8AM ON 21 SEPTEMBER 1 : 1500



3 4PM ON 21 SEPTEMBER 1 : 1500



Section 96 Drawings				
ev.	Description	Date		
1	ISSUED FOR S-96 CHANGES	05-08-2016		
]	

CNR PARRAMATTA RD & JOHNSTON ST - PO BOX 254 - ANNANDALE - NSW 2038 - T.02 9564 8800 F.02 9517 2833 STEPHEN J. NORDON REGISTRATION No. NSW - 4704 GRAHAM P. JAGO REGISTRATION No. NSW - 4926



2 12PM ON 21 SEPTEMBER 1 : 1500

RESIDENTIAL DEVELOPM



SHADOV

	LEGEND:				
	APPROVED SHADOWS				
	PROPOPSED UNITS SHADOWS				
			Assessment Date Assessor Daslification Signature Average Average	ss 2 Bu a965170036 7/03/17 Don Fleming CPP41212 Cert IV - HEATING - cooling ed Rating: Dject Ave 7.4	19.7 MJ/m2 pa 14.1 MJ/m2 pa 33.8 MJ/m2 pa
IENT A	AT 74-80 RESTWELL &1-9 L	EC	DNAR	D ST	REET
	C:\00 Local Files\MRH00216 LOCAL\MRH00216_R2016_PB LOCAL.	rvt	JOB No.		MRH00216
			DATE		13-05-2016
	GRAM - 21 SEPTEMBER		SCALE	A1 @	As indicated
			DWG No.	-96.1	44



8AM ON 21 DECEMBER 1 : 1500




4PM ON 21 DECEMBER 1 : 1500




S	Section 96 Drawings					
Rev	Description	Date				
А	ISSUED FOR S-96 CHANGES	05-08-2016				

CNR PARRAMATTA RD & JOHNSTON ST - PO BOX 254 - ANNANDALE - NSW 2038 - T.02 9564 8800 F.02 9517 2833 STEPHEN J. NORDON REGISTRATION No. NSW - 4704 GRAHAM P. JAGO REGISTRATION No. NSW - 4926

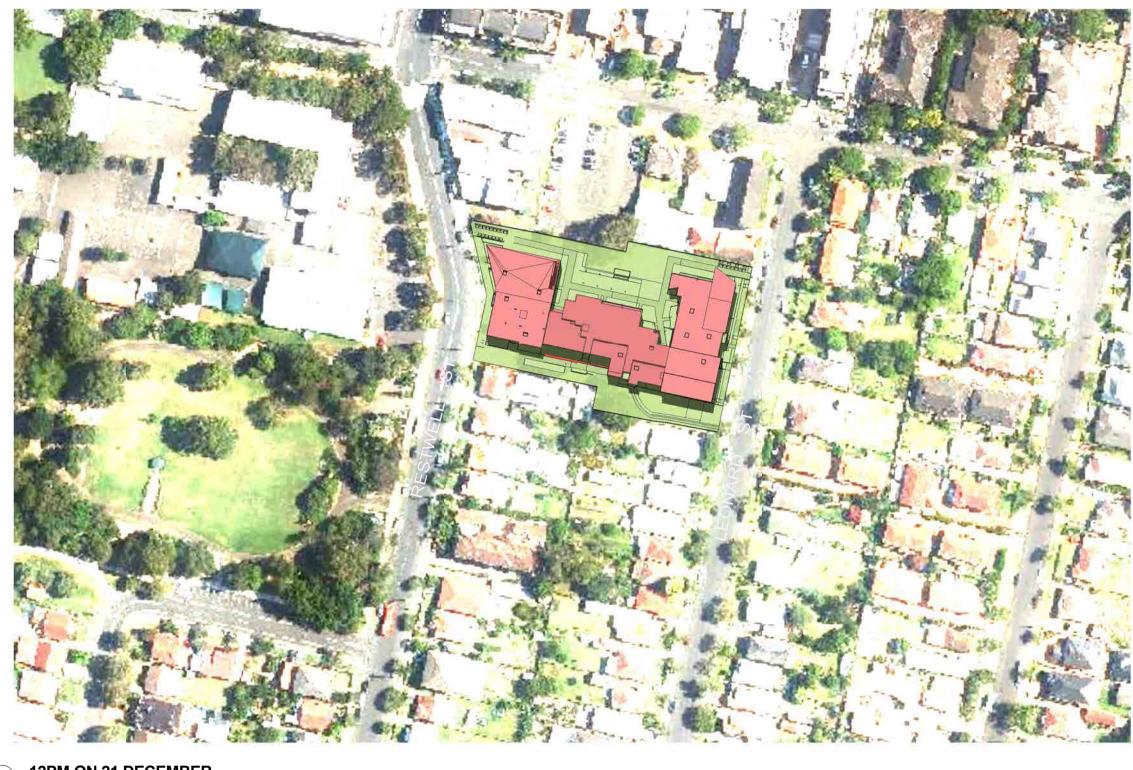

2 12PM ON 21 DECEMBER 1 : 1500




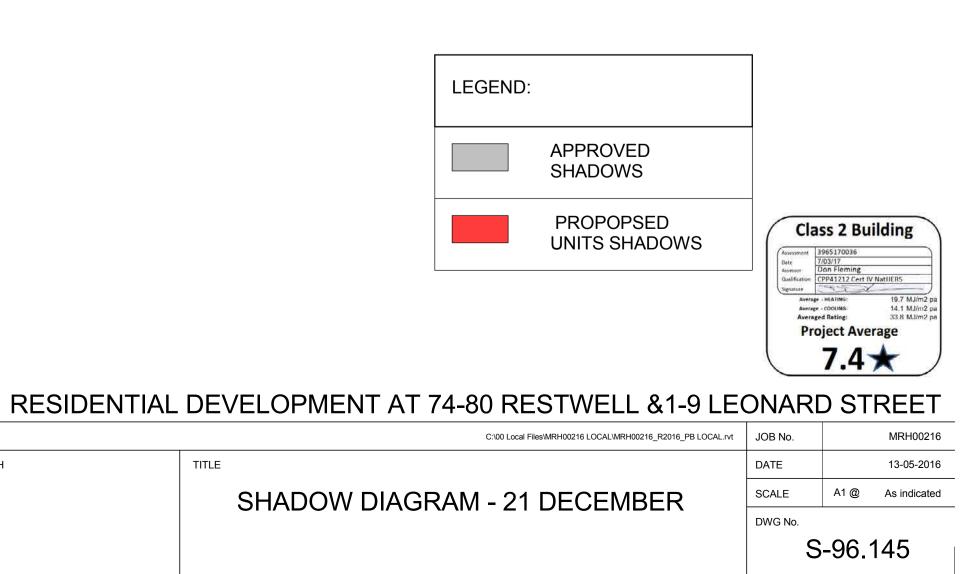


DA-APPROVED DETAILED SHADOW STUDIES (REF. DA 05.08 / REV. C)




21 June 9.45AM TYPICAL APARTMENT L1 - 5.12 + L1 - 5.13

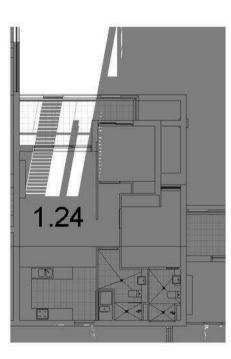


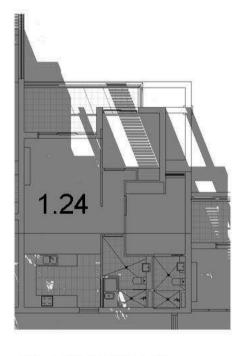


21 June 10.30AM

21 June 12.30AM TYPICAL APARTMENT 0.21, L1 - 5.24 TYPICAL APARTMENT 0.21, L1 - 5.24

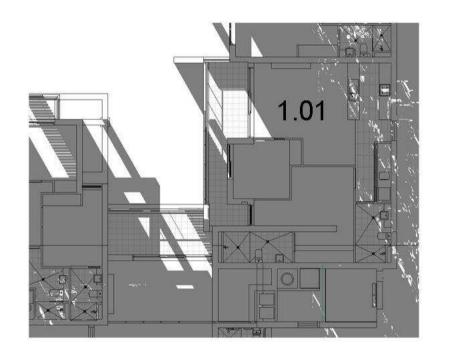

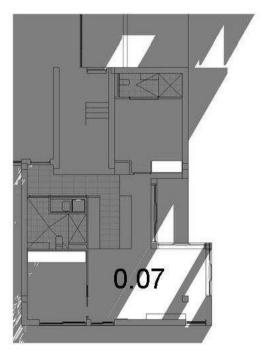

21 June 9AM GROUND APARTMENT L0 - 6.07

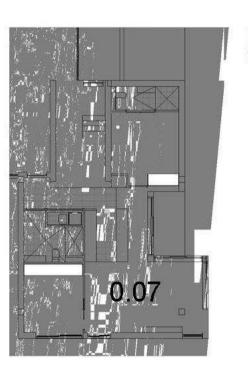

21 June 11AM GROUND APARTMENT L0 - 6.07




Section 96 Drawings									
Rev	Description	Date							
А	ISSUED FOR S-96 CHANGES	05-08-2016							
	Rev	Rev Description							

CNR PARRAMATTA RD & JOHNSTON ST - PO BOX 254 - ANNANDALE - NSW 2038 - T.02 9564 8800 F.02 9517 2833 STEPHEN J. NORDON REGISTRATION No. NSW - 4704 GRAHAM P. JAGO REGISTRATION No. NSW - 4926




21 June 11.45AM TYPICAL APARTMENT L1 - 5.12 + L1 - 5.13

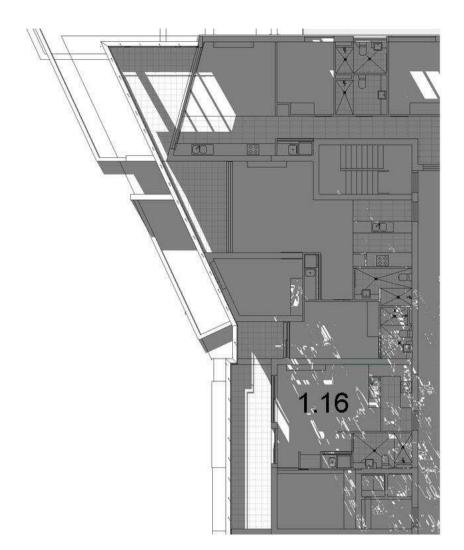


21 June 1PM TYPICAL APARTMENT L1 - 5.16, L6.11


21 June 1PM TYPICAL APARTMENT L1 - 5.01

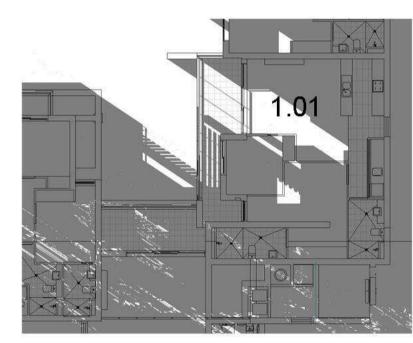


21 June 3PM TYPICAL APARTMENT L1 - 5.01

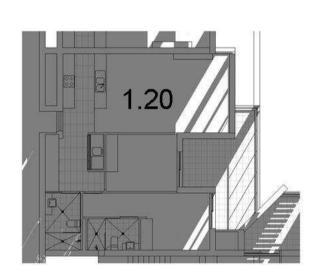


21 June 9AM 21 June 11AM TYPICAL APARTMENT L0 - 5.20, 6.15 TYPICAL APARTMENT L0 - 5.20, 6.15

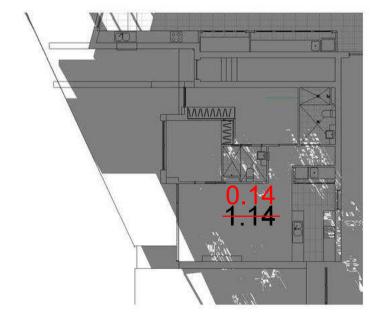

21 June 1PM TYPICAL APARTMENT 0.14 GROUND

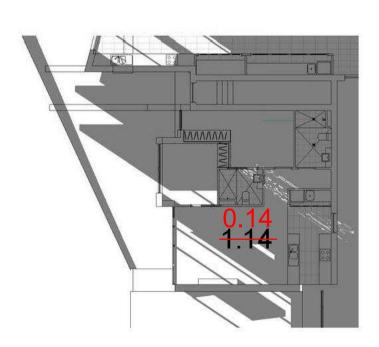


21 June 3PM TYPICAL APARTMENT 0.14 GROUND

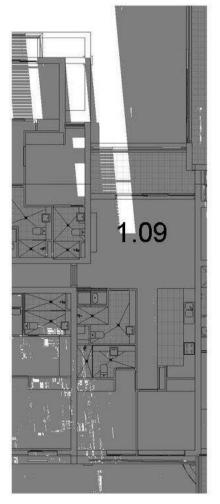


21 June 11.30AM TYPICAL APARTMENT L1 - 5.09




NOT For Construction

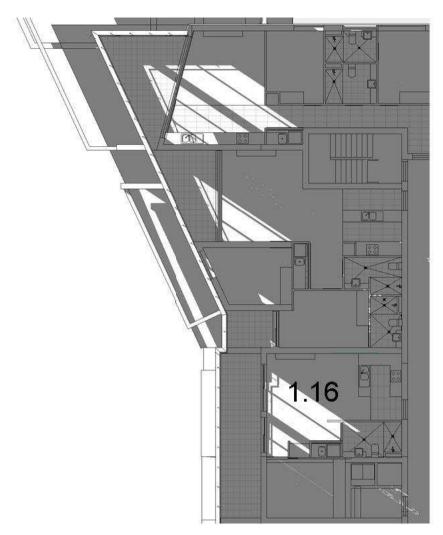

21 June 3PM TYPICAL APARTMENT L1 - 5.16, L6.11

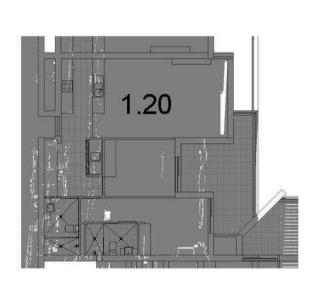

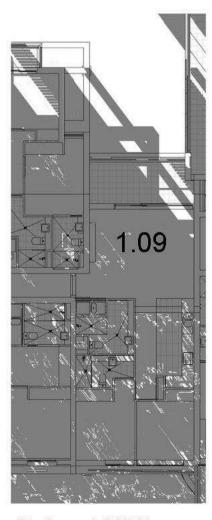


21 June 1.30PM TYPICAL APARTMENT L1 - 5.09




RESIDENTIAL DEVELOPMENT AT 74-80 RESTWELL & 1-9 LEONARD STREET

C:\00 Local Files\MRH00216 LOCAL\MRH00216_R2016_PB LOCAL.rvt	JOB No.	MRH00216
DA-DETAILED SHADOW STUDIES	DATE	13-05-2016
	SCALE	A1 @
	DWG No.	
	່ ດ	06 150


S96 - DETAILED SHADOW STUDIES (TYPICAL LEVELS SIM TO DA)

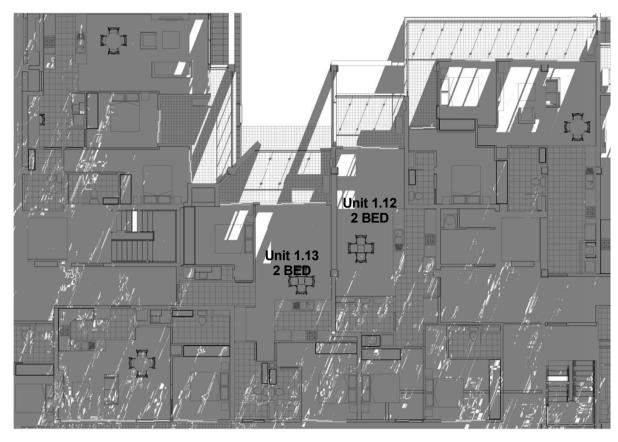


21 June 9.45AM TYPICL APARTMENT L1 - 5.12 + L1 - 5.13

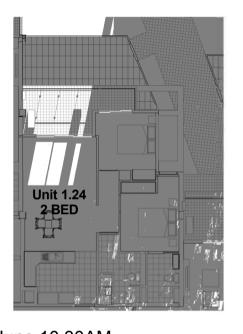

21 June 10.30AM TYPICL APARTMENT 0.21, L1-5.24

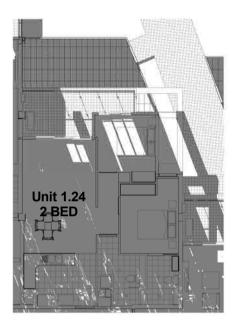

21 June 12.30PM TYPICL APARTMENT 0.21, L1-5.24

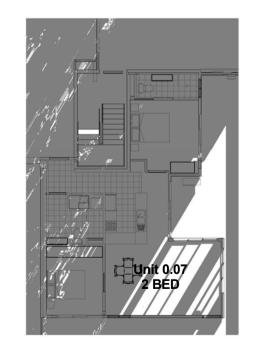

21 June 9AM **GROUND APARTMENT L0 - 6.07**




21 June 11AM **GROUND APARTMENT L0 - 6.07**



S	ection 96 Drawings	
ev	Description	Date
۹.	ISSUED FOR S-96 CHANGES	05-08-2016


CNR PARRAMATTA RD & JOHNSTON ST - PO BOX 254 - ANNANDALE - NSW 2038 - T.02 9564 8800 F.02 9517 2833 STEPHEN J. NORDON REGISTRATION No. NSW - 4704 GRAHAM P. JAGO REGISTRATION No. NSW - 4926

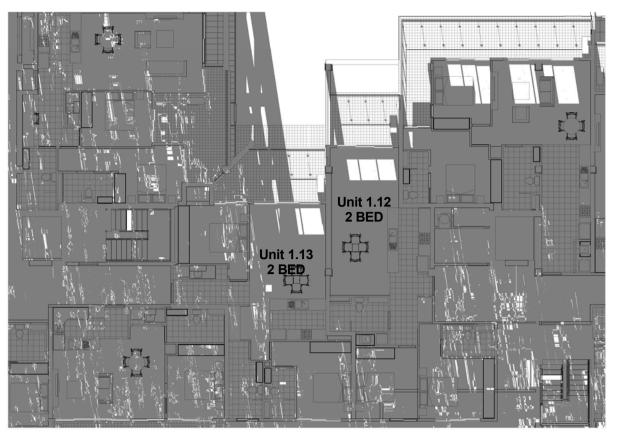


21 June 11.45AM TYPICL APARTMENT L1 - 5.12 + L1 - 5.13



21 June 1PM TYPICL APARTMENT L1 - 6.16

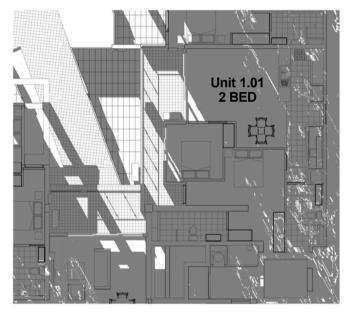


21 June 1PM TYPICL APARTMENT L1 - 5.01

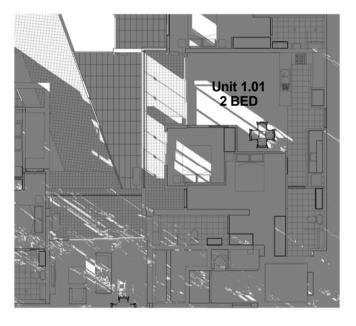

21 June 3PM TYPICL APARTMENT L1 - 5.01

21 June 3PM

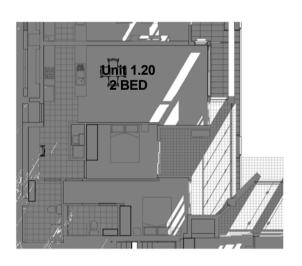

21 June 9AM TYPICL APARTMENT L0 - 6.20



21 June 11.30AM

RESIDENTIAL DEVELOPMENT AT 74-80 RESTWELL & 1-9 LEONARD STREET

Unit 0.14

🔪 2 BED 🗐

21 June 1PM

GROUND APARTMENT 0.14






GROUND APARTMENT 0.14

Jnit 0.14



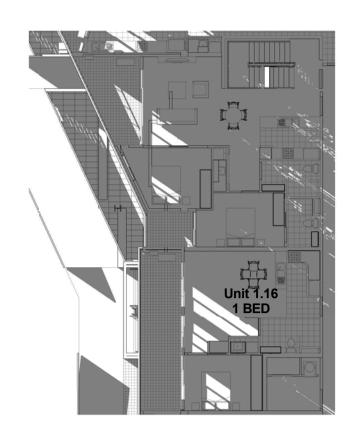


21 June 3PM TYPICL APARTMENT L1 - 6.16

Unit 1.20 2 BED

TYPICL APARTMENT L0 - 6.20


21 June 11AM



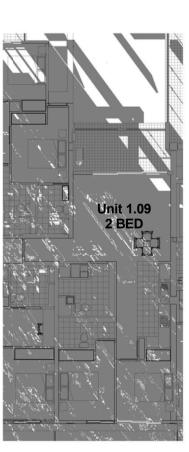


21 June 1.30PM TYPICL APARTMENT L1 - 5.0 TYPICL APARTMENT L1 - 5.09



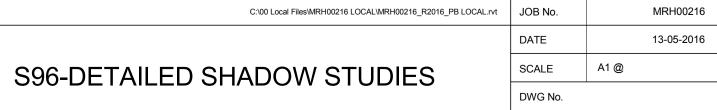

S96 - LEVEL 6 . DETAILED SHADOW STUDIES

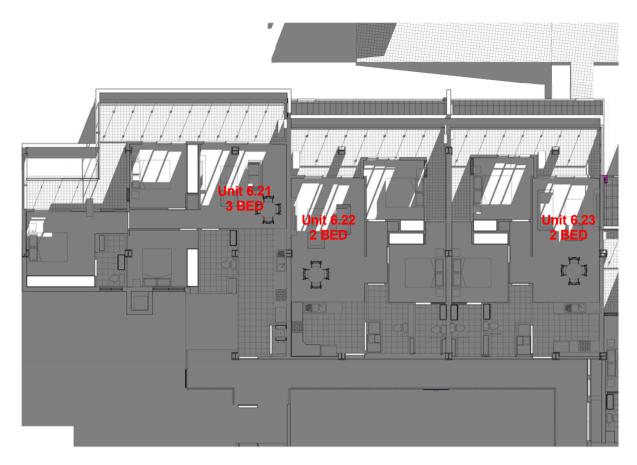


21 June 9.45AM APARTMENT 6.21, 6.22 & 6.23




21 June 10.30AM **APARTMENT 6.24**



21 June 12.30PM **APARTMENT 6.24**

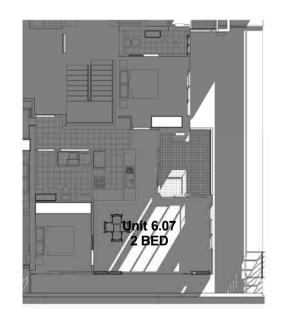

21 June 9AM APARTMENT 6.07

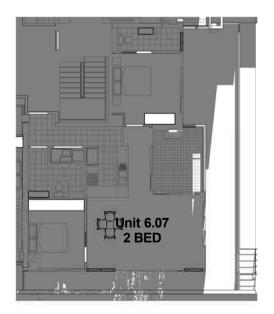



21 June 11AM **APARTMENT 6.07**



ection 96 Drawings	
Description	Date
ISSUED FOR S-96 CHANGES	05-08-2016


CNR PARRAMATTA RD & JOHNSTON ST - PO BOX 254 - ANNANDALE - NSW 2038 - T.02 9564 8800 F.02 9517 2833 STEPHEN J. NORDON REGISTRATION No. NSW - 4704 GRAHAM P. JAGO REGISTRATION No. NSW - 4926

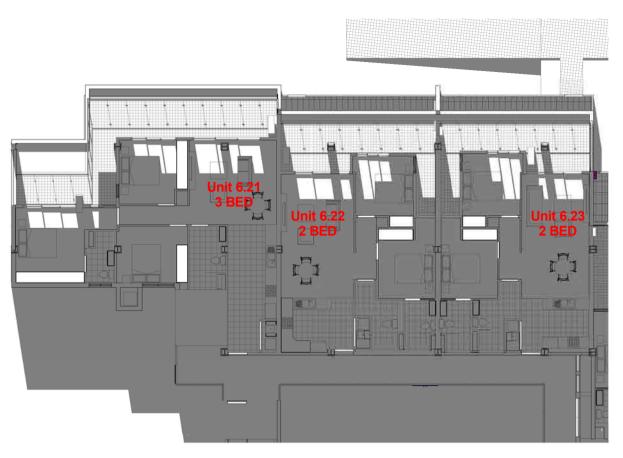

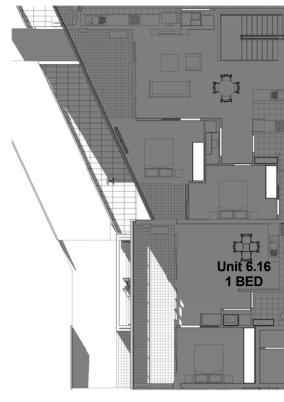


21 June 1PM APARTMENT 6.16


21 June 11.45AM APARTMENT 6.12, 6.22 & 6.23

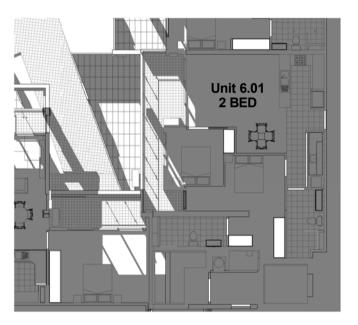


21 June 1PM **APARTMENT 6.01**

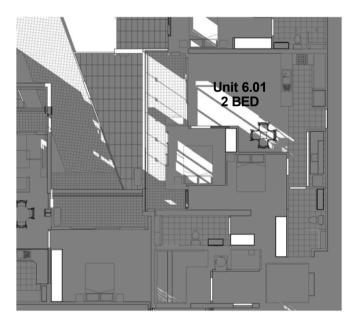


21 June 3PM APARTMENT 6.01

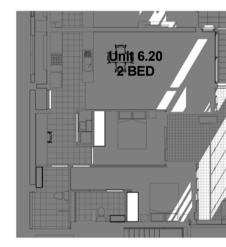

21 June 9AM APARTMENT 6.20

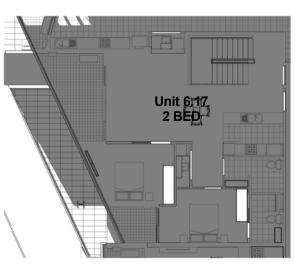

21 June 1PM APARTMENT 6.17

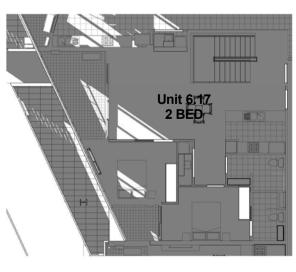

21 June 3PM APARTMENT 6.17






NORTH


TITLE



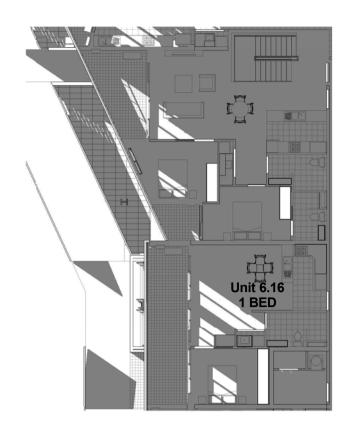

21 June 3PM APARTMENT 6.16



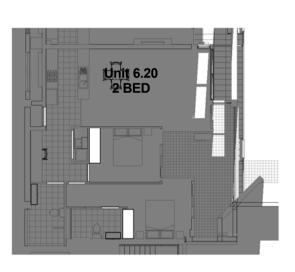

21 June 11AM **APARTMENT 6.20**



RESIDENTIAL DEVELOPMENT AT 74-80 RESTWELL &1-9 LEONARD STREET


	DATE	13-05-2016
S96-L6 DETAILED SHADOW STUDIES	SCALE	A1 @
	DWG No.	
	S	-96.152



1

Section East -West

1:200

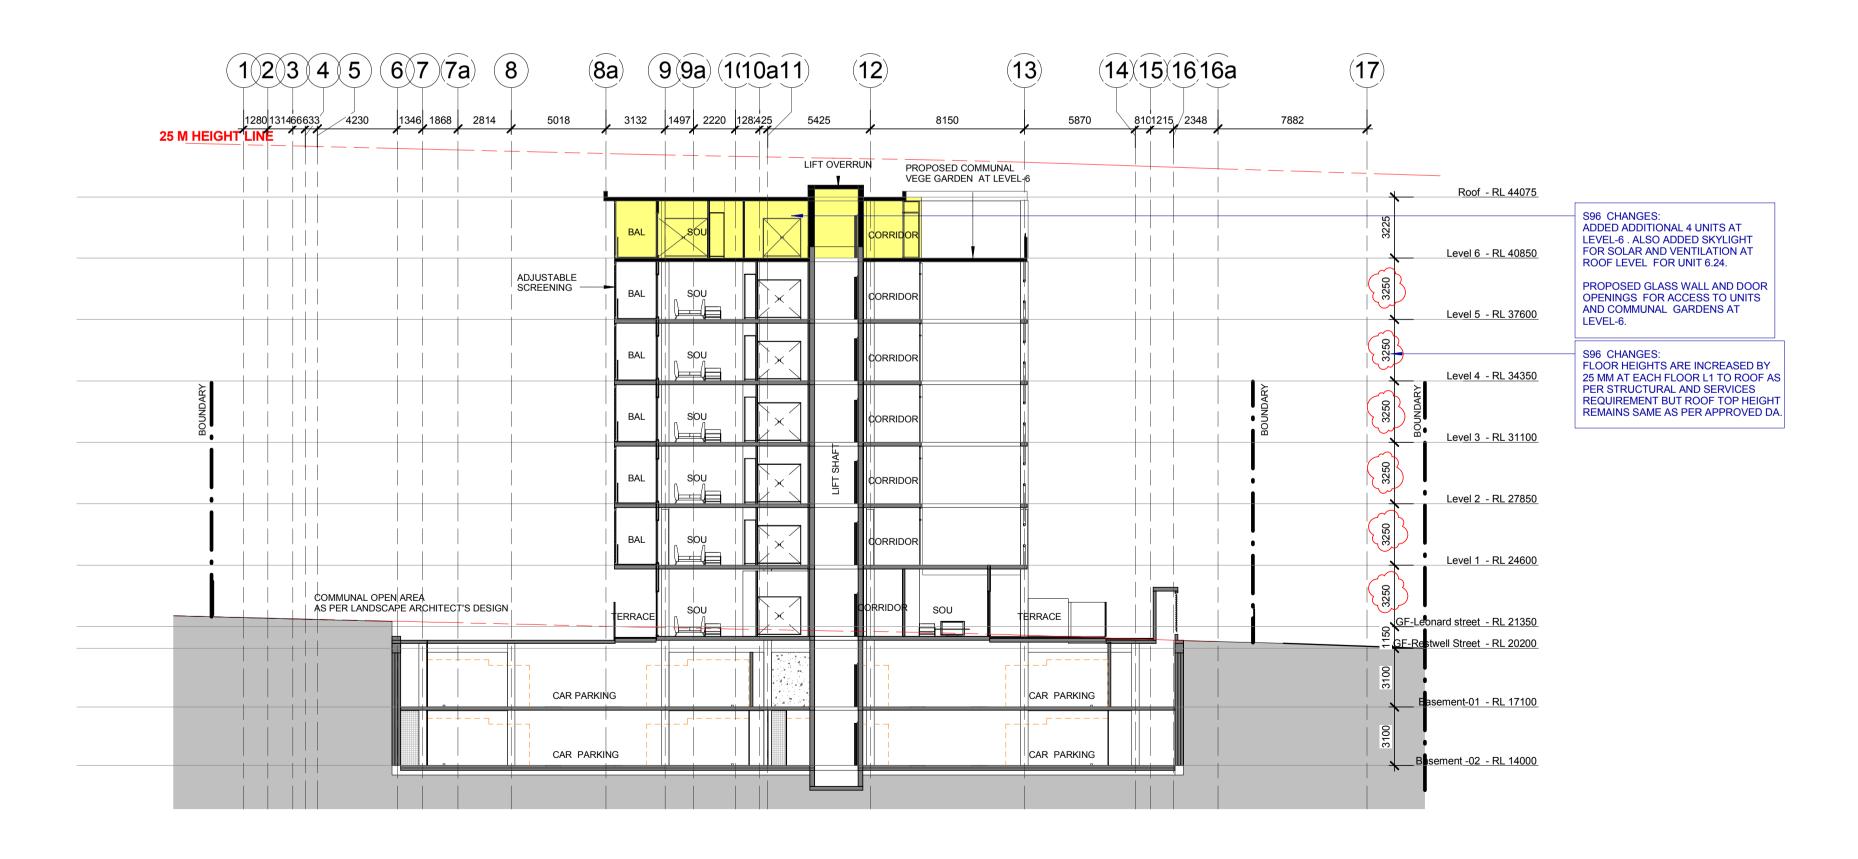

Section North- South 2

1 : 200



S	ection 96 Drawings		
Rev	Description	Date	
А	ISSUED FOR S-96 CHANGES	05-08-2016	
			-
			-
			-
			0m 2m 4m 6m 8m 10m
			0m 2m 4m 6m 8m 10m Scale Bar 1:200

CNR PARRAMATTA RD & JOHNSTON ST - PO BOX 254 - ANNANDALE - NSW 2038 - T.02 9564 8800 F.02 9517 2833 STEPHEN J. NORDON REGISTRATION No. NSW - 4704 GRAHAM P. JAGO REGISTRATION No. NSW - 4926

30	Ò) (I	H			K		M	N		R	3	Γ	UV	') (WŴ	0	X	
	2530	565	/	, 2850	2800	5650	5650	25	543 407 2500	5450	5450	5450	1610	3990	2004	6111	32	10 8
RA	ACE	PRIVACY SCREEN	FT OVERR							SKYLIGHT	+							
					CORRIDOR	3225					BAL	ENS					BAL	
+					CORRIDOR					SOU	BAL	ENS				sou	BAL	
+					CORRIDOR					SOU +	BAL	ENS	SOU			sou	BAL	
					CORRIDOR					SOU F	BAL	ENS	SOU			sou	BAL	
+					CORRIDOR					SOU -	BAL	ENS	SOU □ □			SOU	BAL	
+					CORRIDOR					SOU T	BAL	ENS	SOU] []			SOU	BAL	
					CORRIDOR								BIN ROOM	c		LEONARD		
												CAR PARKING						
												CAR PARKING						


RESIDENTIAL DEVELOPMENT AT 74-80 RESTWELL & 1-9 LEONARD STREET



NOT For Construction

20m

LEGEND:						
	S-96 CHANGES					

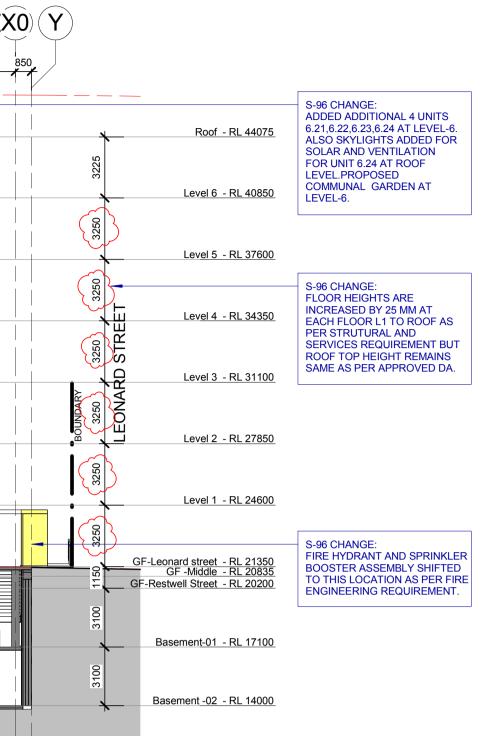




	S	-96.200
OLOHIONO		
SECTIONS	SCALE	A1 @ As indicated
	DATE	13-05-2016
C:\00 Local Files\MRH00216 LOCAL\MRH00216_R2016_PB LOCAL	L.rvt JOB No.	MRH00216



S-96 CHANGES: FIRE HYDRANT AND SPRINKLER BOOSTER ASSEMBLY SHIFTED TO THIS LOCATION AS PER FIRE ENGINEERING REQUIREMENT

1

1:200

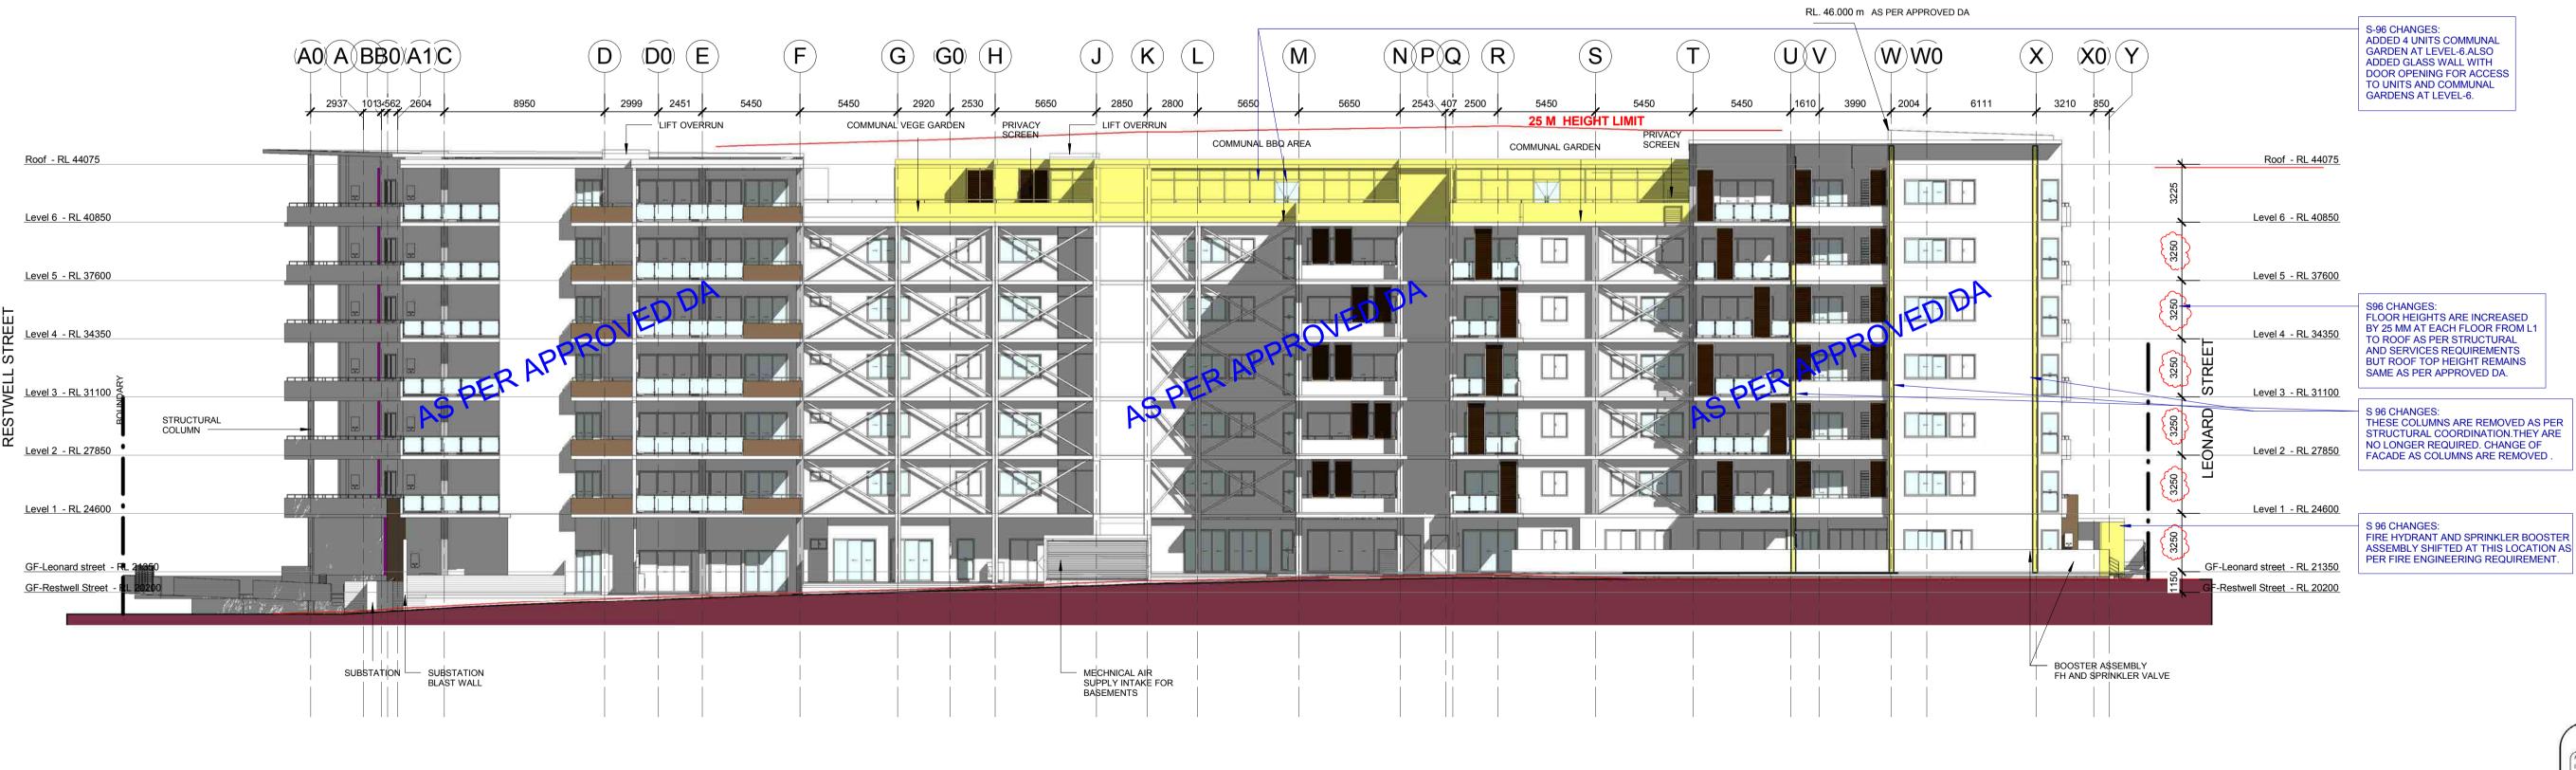

S96 SOUTH Elevation 2



1 : 200



S			
Rev	Description	Date	
А	ISSUED FOR S-96 CHANGES	05-08-2016	
-			
			0m 2m
			0m 2m Scale Bar 1:200

CNR PARRAMATTA RD & JOHNSTON ST - PO BOX 254 - ANNANDALE - NSW 2038 - T.02 9564 8800 F.02 9517 2833 STEPHEN J. NORDON REGISTRATION No. NSW - 4704 GRAHAM P. JAGO REGISTRATION No. NSW - 4926

RESIDENTIAL DEVELOPMENT AT 74-80 RESTWELL & 1-9 LEONARD STREET MRH00216 C:\00 Local Files\MRH00216 LOCAL\MRH00216_R2016_PB LOCAL.rvt JOB No.

NOT For Construction

20m

2m 4m 6m 8m 10m

CLIENT


MERHIS


NORTH TITLE

LEGEND: S-96 CHANGES



	S	-96.300
	DWG No.	·
ELEVATIONS NORTH AND SOUTH	SCALE	A1 @ As indicated
	DATE	13-05-2016
	JOB NO.	WIRI 1002 10

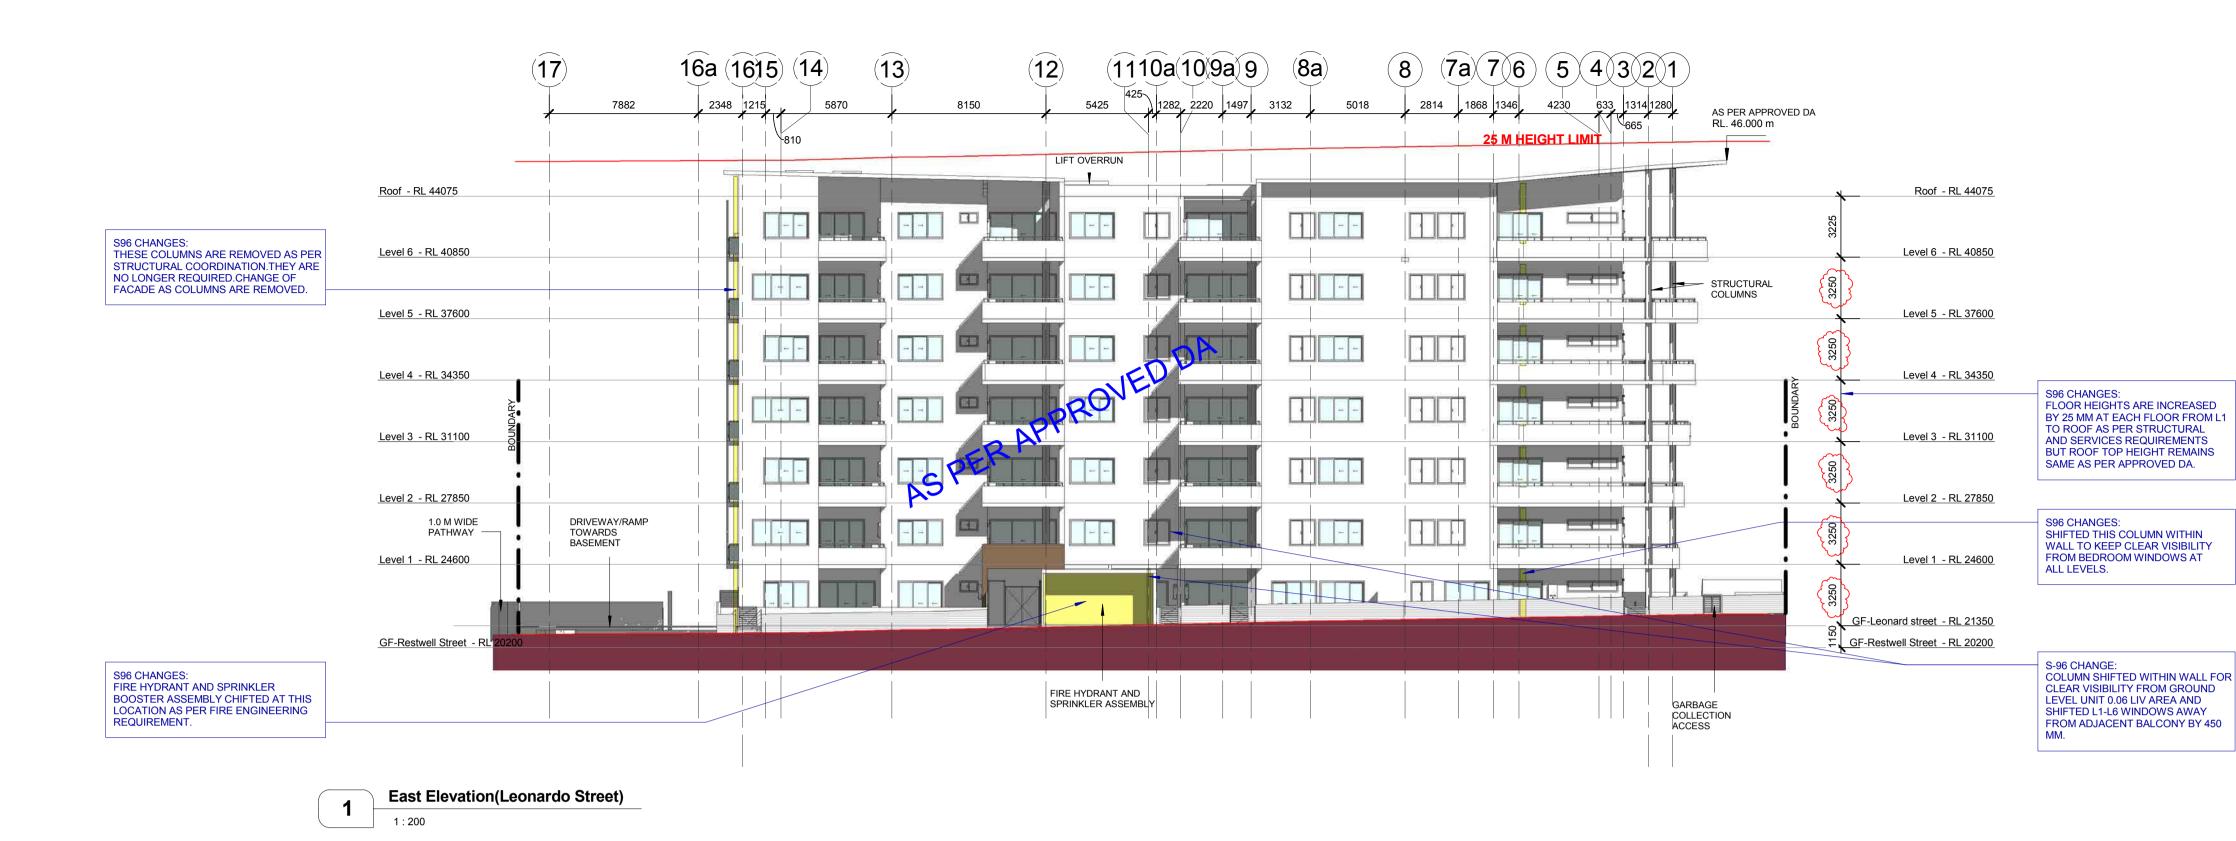

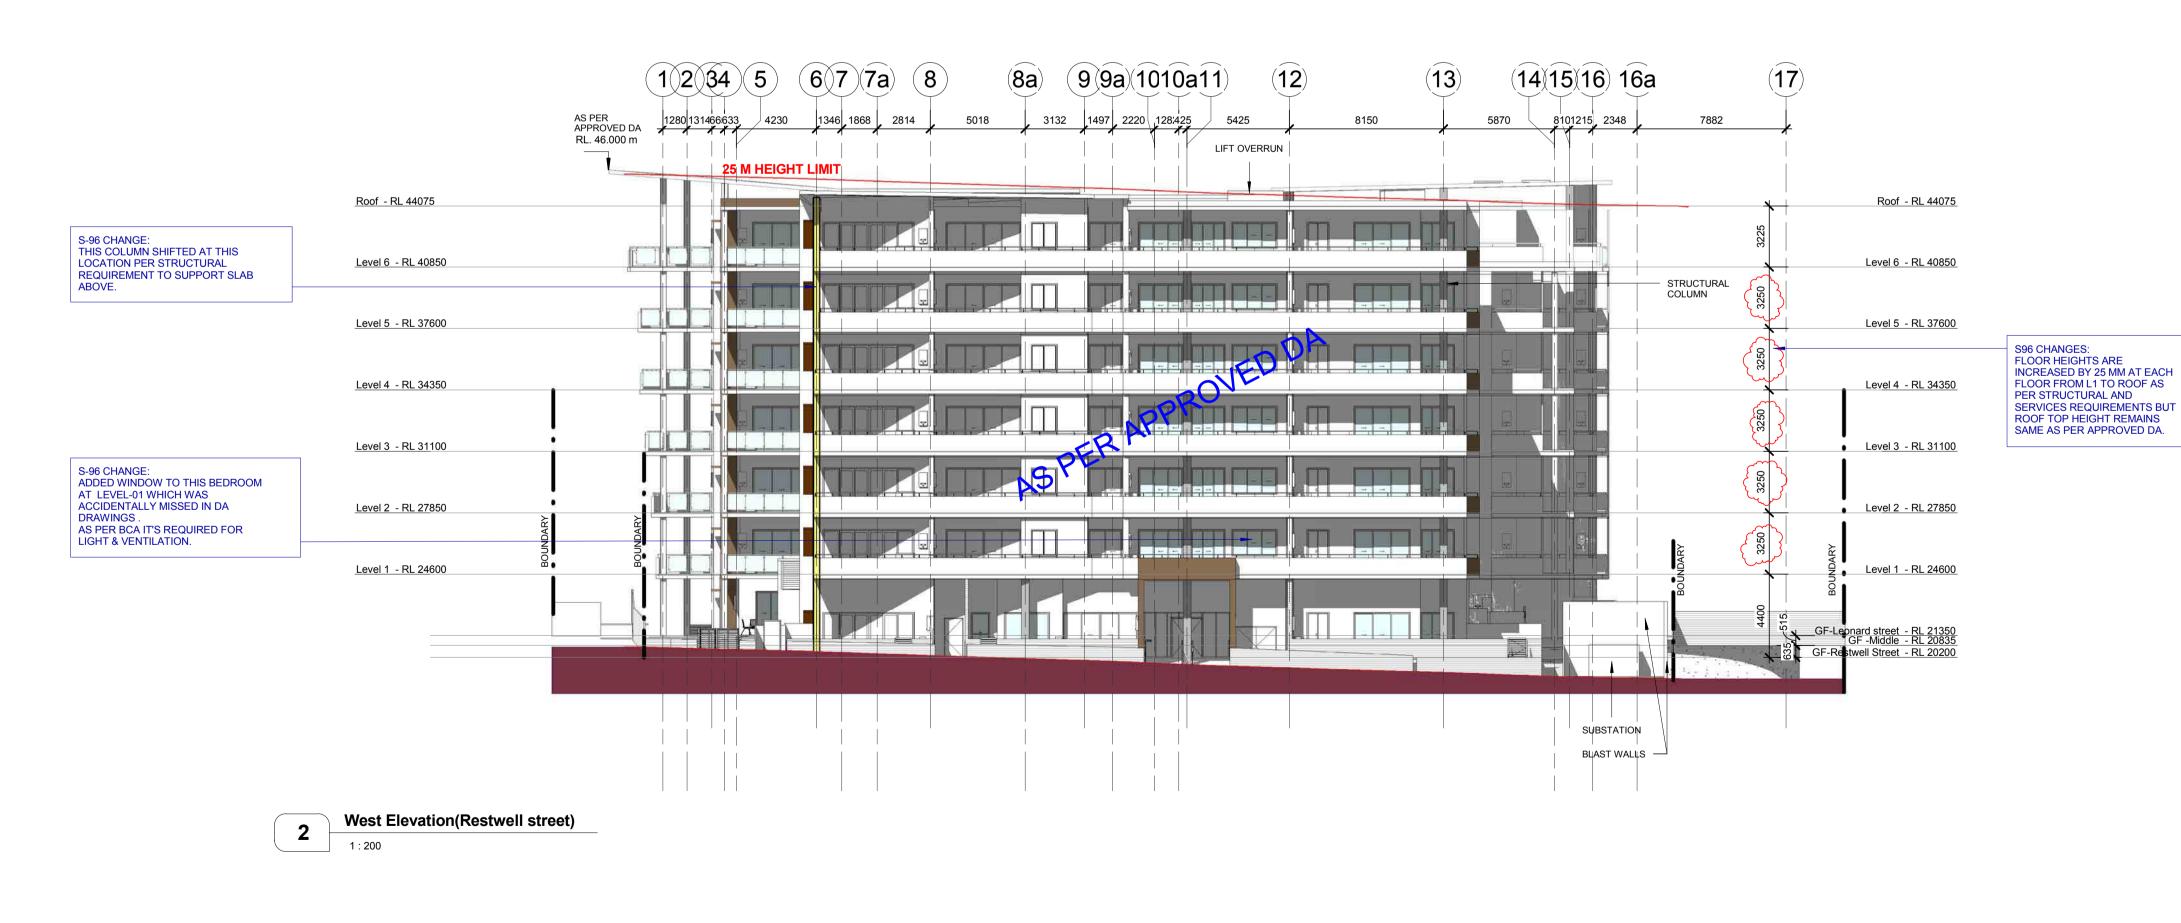



	Rev	Des
	А	ISSUED FOR S-96 CHANGES
NORDON · JAGO		

S	ection 96 Drawings				
Rev	Description	Date			
А	ISSUED FOR S-96 CHANGES	05-08-2016			
				6m	
			Scale Bar 1:200		

CNR PARRAMATTA RD & JOHNSTON ST - PO BOX 254 - ANNANDALE - NSW 2038 - T.02 9564 8800 F.02 9517 2833 STEPHEN J. NORDON REGISTRATION No. NSW - 4704 GRAHAM P. JAGO REGISTRATION No. NSW - 4926

RESIDENTIAL DEVELOPMENT AT 74-80 RESTWELL & 1-9 LEONARD STREET



NOT For Construction

20m

LEGE	ND:	
	S-96 CHANGES	





7/03/2017	File	Ref:	396517003
Important Not	te for Development Appl	icants	
The following specification was used to a assessor declaration form. If they vary fr take precedence. If only one specificatio must apply to all instances of that eleme the location and extent of the alternate s	achieve the thermal performance va om the drawings or other specificat n option is detailed for a building el nt for the whole project. If alternate	lues india ions this ement, th specifica	cated on the Specification shall at specification tions are detailed,
reference documentation.			
Once the development is approved by the of consent and must be included in the b This assessment has assumed that the construction. No loss of insulation arising	ouilt works. NCC provisions for building sealing	will be co	mplied with at
Thermal p	erformance specificatio	ns	
External wall Construction	Insulation		Colour
Fibre clad framed	R2.5		Medium
Internal wall Construction	Insulation		
Plasterboard	Nil		
Ceiling Construction	Insulation		
Plasterboard	Nil		
Roof Construction	Insulation		Colour
Metal clad	R3.0		Medium
Suspended concrete	R3.0		Medium
Floor Construction	Insulation		
Suspended slab/CSOG	Nil		
Windows Glass	s & frame type U		SHGC
Generic Sir	ngle Aluminium 6.7		0.7
External window cover			
As drawn			
Fixed shading- Eaves Width in	ncludes guttering, offset is di	stance	above windows
Width: as drawn Offset: as draw	wn		
Fixed shading- Other	Verandahs, Pergolas (type	& descr	iption)
Shaded areas & devices as drawn			
For construction in NSW the NCC Vol particular the following: - Thermal construction in accordance with - Thermal breaks in accordance with sec - Compensation for loss of ceiling insulat - Floor insulation in accordance with Sec	th Vol 1 section J1.2 or Vol 2 part 3 stion J1.3(d) & 1.5(c) or part 3.12.1. tion in accordance with section J1.3	.12.1.1 2(c) & 3.1 8(C) or Pa	12.1.4(b) art 3.12.1.2(e)

C:\00 Local Files\MRH00216 LOCAL\MRH00216_R2016_PB LOCAL.rvt	JOB No.		MRH00216
	DATE		13-05-2016
ELEVATIONS EAST AND WEST	SCALE	A1 @	As indicated
	DWG No.		

SERVICES REQUIREMENTS BUT ROOF TOP HEIGHT REMAINS SAME AS PER APPROVED DA.

Assessor Certificate

Multiple Dwellings

Assessed and issued in accordance with the BASIX Thermal Comfort Protocol for the Simulation Method

Date:	7/03/2017 File Ref: 3965170036							
Assessor								
Name: Don Fleming						CPP41212 Cert IV NatHERS		
Declaration of inter	est in the	project d	lesign: N	lone				
Project								
Address:	#74-#80	Restwell	Street, Bai	nkstown N	ISW 2200			
Assessment						Climate Zone: 56		
Software:	Fi	rstrate5 V	5.2.5 (3.13	3)				
Documentation								
All details, upon which thi the project documentation assessor issuing this dec	n that has be	en stamped	and signed			Class 2 Building		
Drawings u (title, Ref.#,	Date 7/03/17 Don Fleming Qualification Signature PEATING: 19.7 MJ/m2 pa Average - CODUNG: 14.1 MJ/m2 pa							
Nordon-Jago	: Rev-A: I	MRH0021	6: 05/08/	'16		Averaged Rating: 33.8 MJ/m2 pa Project Average		
Thermal Pe Attached to th		-				7.4★		
Thermal performan	ce specifi	ications	Assess	ment#	3965170036	Page 1 of 4		
Unit No.	Floor	Floor Areas Pr		. Loads //2/y)	Star Rating	Basix Floor Type and Area		
	Cond	Uncond	Heat	Cool	j	m2		
0.01	72.2	0.0	32.0	10.4	6.7			
0.02	74.2	0.0	21.3	19.4	6.9			
0.03	87.4	0.0	22.1	12.5	7.3			
0.04	87.4	0.0	35.0	7.7	6.7			
0.05	74.5	0.0	45.7	15.0	5.3			
0.06	50.2	0.0	48.8	8.0	5.6			
0.07	74.4	0.0	46.7	20.2	4.9			
0.08	88.4	0.0	36.8	17.7	5.7			
0.09	50.2	0.0	26.7	8.3	7.3			
0.10	90.4	0.0	28.2	16.6	6.5			
0.11	77.7	0.0	48.7	13.7	5.2			
0.12	51.2	0.0	47.1	15.0	5.2			
0.13	70.5	0.0	13.2	41.5	5.7			
0.14	70.6	0.0	57.9	4.7	5.2			
0.15	79.8	0.0	12.8	16.2	7.8			
0.16	75.1	0.0	33.0	12.6	6.4			
0.17	77.8	0.0	37.7	9.5	6.3			
0.18	75.4	0.0	24.5	13.2	7.1			
0.19	72.3	0.0	32.8	5.0	7.1			

0.21 1.01 1.02 1.03 1.04 1.05	69.6 72.3 70.7 74.2 87.4 87.4	0.0 0.0 0.0 0.0	26.6 38.8 8.4	8.4 5.7 19.9	7.3 6.5	Class 2 Building
1.01 1.02 1.03 1.04 1.05	70.7 74.2 87.4	0.0				
1.02 1.03 1.04 1.05	74.2 87.4		0.4		70	Assessment 3965170036
1.03 1.04 1.05	87.4	0.0	F 0		7.8	Date 7/03/17 Assessor Don Fleming
1.04 1.05		~ ~ ~	5.8	22.0	7.8	Qualification Signature
1.05	8/4	0.0	9.3	14.5	8.2	Average - HEATING: 19.7 MJ/m2 pa Average - CODUNG: 14.1 MJ/m2 pa Averaged Rating: 33.8 MJ/m2 pa
		0.0	4.8	16.4	8.4	 Project Average
1 1 0 0	72.5	0.0	18.9	25.1	6.6	-∖ 7.4★ /
1.06	72.5	0.0	18.9	25.1	6.6	
1.07	74.4	0.0	49.3	18.0	4.9	
1.08	77.9	0.0	14.6	10.7	8.1	
1.09	73.0	0.0	1.3	9.4	9.3	
1.10	50.2	0.0	14.1	10.9	8.1	
1.11	90.4	0.0	18.5	12.5	7.6	
1.12	78.6	0.0	3.3	8.2	9.3	
1.13	67.3	6.5	5.8	11.8	8.7	
1.14	51.2	0.0	25.7	16.1	6.8	
	70.5	0.0	14.4	40.1	5.8	
	49.2	0.0	6.6	19.9	7.9	
1.17	74.3	0.0	13.6	14.0	7.9	
1.18	74.6	0.0	1.9	27.6	7.7	
1.19	75.1	0.0	12.1	15.3	7.9	
1.20	77.8	0.0	17.0	11.0	7.8	
1.21	75.4	0.0	13.2	16.9	7.7	
1.22	72.3	0.0	8.3	6.4	8.9	
1.23	69.6	0.0	5.1	9.5	8.9	
1.24	72.3	0.0	11.8	7.7	8.5	
2.01	70.7	0.0	9.0	18.4	7.9	
2.02	74.2	0.0	6.4	20.5	7.9	
2.03	87.4	0.0	10.0	13.5	8.2	
2.04	87.4	0.0	5.2	15.7	8.4	
2.05	72.5	0.0	19.9	24.1	6.6	
2.06	72.5	0.0	19.9	24.1	6.6	
2.07	74.4	0.0	50.9	17.9	4.8	
2.08	77.9	0.0	15.4	10.2	8.0	
2.09	73.0	0.0	1.5	9.0	9.4	
2.10	50.2	0.0	15.1	10.7	8.0	
2.11	90.4	0.0	19.4	11.7	7.6	
2.12	78.6	0.0	3.6	7.8	9.3	
2.13	67.3	6.5	6.5	11.4	8.7	
2.14	51.2	0.0	27.0	15.2	6.7	
2.15	70.5	0.0	15.0	37.9	5.9	
2.16	49.2	0.0	7.3	18.3	8.0	
2.17	74.3	0.0	14.5	13.2	7.9	
2.18	74.6	0.0	2.1	26.4	7.8	
2.19	75.1	0.0	12.9	14.8	7.9	
2.20	77.8	0.0	17.8	10.6	7.8	
2.21	75.4	0.0	13.9	16.5	7.6	

0.00	70.0	0.0	0.0	0.5	0.0	
2.22	72.3	0.0	9.0	6.5	8.9	Class 2 Building
2.23	69.6	0.0	5.7	9.1	8.9	Assessment 3965170036
2.24	72.3	0.0	12.6	7.3	8.5	Date 7/03/17 Assessor Don Fleming
3.01	70.7	0.0	9.6	17.8	7.9	Qualification Signature CPP41212 Cert IV NatHERS
3.02	74.2	0.0	6.9	19.9	7.9	Average - HEATING: 19.7 MJ/m2 pa Average - COOLING: 14.1 MJ/m2 pa
3.03	87.4	0.0	10.5	13.3	8.2	Averaged Rating: 33.8 MJ/m2 pa Project Average
3.04	87.4	0.0	5.8	15.2	8.4	
3.05	72.5	0.0	20.7	22.7	6.6	- 7.4
3.06	72.5	0.0	20.7	22.7	6.6	
3.07	74.4	0.0	52.3	17.0	4.8	
3.08	77.9	0.0	16.1	9.8	8.0	
3.09	73.0	0.0	1.6	8.8	9.4	
3.10	50.2	0.0	15.9	9.7	8.0	
3.11	90.4	0.0	20.1	12.1	7.4	
3.12	78.6	0.0	3.9	7.7	9.2	
3.13	67.3	6.5	7.1	11.3	8.6	
3.14	51.2	0.0	28.1	14.2	6.7	
3.15	70.5	0.0	15.7	34.5	6.1	
3.16	49.2	0.0	8.1	17.3	8.1	
3.17	74.3	0.0	15.1	12.8	7.8	
3.18	74.6	0.0	2.5	25.8	7.8	
3.19	75.1	0.0	13.5	14.2	7.9	
3.20	77.8	0.0	18.4	10.4	7.8	
3.21	75.4	0.0	14.4	15.9	7.6	
3.22	72.3	0.0	9.6	6.5	8.8	
3.23	69.6	0.0	6.1	8.7	8.9	
3.23	72.3	0.0	13.3	7.5	8.4	
4.01	72.3	0.0	12.3	13.7	7.9	
4.01	74.2	0.0	9.2	13.0	8.3	
4.02	87.4	0.0	13.5	11.4	8.1	
	87.4		7.9		8.4	
4.04	72.5	0.0	24.0	13.1		
4.05		0.0		17.3	6.8	
4.06	72.5	0.0	24.0	17.3	6.8	
4.07	74.4	0.0	58.4	13.1	4.7	
4.08	77.9	0.0	19.1	7.9	7.9	
4.09	73.0	0.0	2.4	6.9	9.4	
4.10	50.2	0.0	19.5	8.3	7.9	
4.11	90.4	0.0	23.2	9.4	7.4	
4.12	78.6	0.0	5.4	6.3	9.2	
4.13	67.3	6.5	9.7	8.7	8.6	
4.14	51.2	0.0	32.7	12.1	6.5	
4.15	70.5	0.0	18.8	29.8	6.2	
4.16	49.2	0.0	11.2	13.9	8.1	
4.17	74.3	0.0	18.1	9.7	7.9	
4.18	74.6	0.0	4.2	21.6	8.0	
4.19	75.1	0.0	16.4	10.9	7.9	
4.20	77.8	0.0	21.2	7.6	7.8	

4.04	75 4	0.0	17.0	40.0	77	
4.21	75.4	0.0	17.0	12.2	7.7	Class 2 Building
4.22	72.3	0.0	12.3	5.9	8.7	(Assessment 3965170036
4.23	69.6	0.0	8.3	8.1	8.8	Assessor Zerra Contraction Con
4.24	72.3 70.7	0.0	16.1 12.7	6.4	8.3	Average - HEATING: 19.7 MJ/m2 pa
5.01		0.0		13.4	7.9	Average - COOLING: 14.1 MJ/m2 pa Averaged Rating: 33.8 MJ/m2 pa
5.02	74.2	0.0	9.6	12.9	8.3	Project Average
5.03	87.4	0.0	13.9	11.3	8.1	-∖ 7.4★ /
5.04	87.4	0.0	8.3	13.1	8.4	
5.05	72.5	0.0	24.6	16.8	6.8	
5.06 5.07	72.5 74.4	0.0	24.6 59.4	16.8	6.8 4.7	
5.08	74.4	0.0	19.4 19.6	12.8 7.7	7.9	
5.08	73.0	0.0	2.5	6.7	9.4	
	50.2	0.0	2.5			
5.10 5.11	90.2	0.0	29.4 33.3	8.2 9.2	7.1 6.7	
5.11	90.4 78.6	0.0	12.0	9.2 6.2	8.7	
5.12	67.3	0.0 6.5	12.0	0.2 8.8	7.9	
5.13	51.2	0.0	33.5	0.0 12.0	6.4	
5.15	70.5	0.0	19.3	29.2	6.2	
5.15	49.2	0.0	19.3	29.2 13.8	8.0	
5.16	74.3	0.0	18.6	9.4	7.8	
5.18	74.5	0.0	4.5	9.4 21.8	7.8	
5.19	74.0	0.0	16.9	10.7	7.9	
5.20	77.8	0.0	21.7	7.6	7.9	
5.20	75.4	0.0	17.5	12.2	7.7	
5.21	72.3	0.0	17.3	5.9	8.6	
5.23	69.6	0.0	8.7	8.0	8.8	
5.24	72.3	0.0	16.5	6.2	8.3	
6.01	70.7	0.0	28.4	16.0	6.6	
6.02	74.2	0.0	24.0	16.6	6.9	
6.03	87.4	0.0	27.7	14.2	6.8	
6.04	87.4	0.0	19.7	15.2	7.3	
6.05	72.5	0.0	38.3	18.8	5.6	
6.06	72.5	0.0	38.3	18.8	5.6	
6.07	74.4	0.0	64.1	12.5	4.4	
6.08	71.7	0.0	56.1	17.2	4.6	
6.14	51.2	0.0	48.6	13.9	5.2	
6.15	70.5	0.0	34.2	34.2	4.9	
6.16	49.2	0.0	24.5	16.1	6.9	
6.17	74.3	0.0	33.5	12.5	6.4	
6.18	74.6	0.0	15.9	26.9	6.7	
6.19	75.1	0.0	33.0	12.2	6.4	
6.20	77.8	0.0	36.3	9.8	6.4	
6.21	89.2	0.0	29.4	14.2	6.6	
6.22	72.3	0.0	28.7	8.9	7.1	
6.23	69.6	0.0	22.0	9.6	7.5	
6.24	86.3	0.0	17.9	13.4	7.6	

7/03/2017	File Ref:	3965170036
	Important Note for Development Applicante	

Important Note for Development Applicants

The following specification was used to achieve the thermal performance values indicated on the assessor declaration form. If they vary from the drawings or other specifications this Specification shall take precedence. If only one specification option is detailed for a building element, that specification must apply to all instances of that element for the whole project. If alternate specifications are detailed, the location and extent of the alternate specification must be detailed below and/or clearly indicated on reference documentation.


Once the development is approved by the consent authority, these specifications will become a condition of consent and must be included in the built works.

This assessment has assumed that the NCC provisions for building sealing will be complied with at construction. No loss of insulation arising from ceiling penetrations has been simulated.

Thermal performance specifications					
External wall Construction	Insulation	1	Colour		
Fibre clad framed	R2.5		Medium		
Internal wall Construction	Insulation	1			
Plasterboard	Nil				
Ceiling Construction	Insulatior	1			
Plasterboard	Nil				
Roof Construction	Insulatior	1	Colour		
Metal clad	R3.0		Medium		
Suspended concrete	R3.0		Medium		
Floor Construction	Insulatior	1			
Suspended slab/CSOG	Nil				
Windows GI	ass & frame type	U	SHGC		
Generic	Single Aluminium	6.7	0.7		
External window cover					
As drawn					
Fixed shading- Eaves Widt	h includes guttering, offse	et is distanc	e above windows		
Width: as drawn Offset: as of	drawn				
Fixed shading- Other Verandahs, Pergolas (type & description)					
Shaded areas & devices as drawn					
For construction in NSW the NCC y particular the following: - Thermal construction in accordance - Thermal breaks in accordance with - Compensation for loss of ceiling ins	with Vol 1 section J1.2 or Vol 2 section J1.3(d) & 1.5(c) or part	2 part 3.12.1.1 3.12.1.2(c) & 3	3.12.1.4(b)		

- Floor insulation in accordance with Section J1.6(c) &(d) or Part 3.12.1.5(a)(ii) or (c) & (d)

- Building sealing in accordance with Section J3 or Part 3.12.3.1 to 3.12.3.6

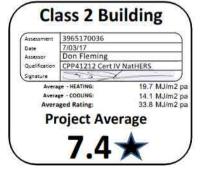



Vipac Engineers and Scientists Limited 2 Sirius Road, Lane Cove, NSW 2066, Australia

t. +61 2 9422 4222 | f. +61 2 9420 5911 | e. sydney@vipac.com.au
w.www.vipac.com.au | A.B.N. 33 005 453 627 | A.C.N. 005 453 627

Vipac Engineers & Scientists

Merhis Management Group Pty Ltd

74-80 Restwell Street Bankstown

BASIX Assessment Report

20E-17-0040-TRP-615497-0

17 Mar 2017



Melbourne • Sydney • Adelaide • Perth • Brisbane • Tasmania



BASIX Assessment Report Job Title:					
DOCUMENT NO: 20E-17-0040	-TRP-615497-	REPORT CODE: TRP			
PREPARED FOR:		PREPARED BY:			
Merhis Management Group Pt	y Ltd	Vipac Engineers and Scientists Limited Office Address			
38-42 Seville Street		2 Sirius Road,			
Fairfield East, New South Wale	es, 2165, Australia	Lane Cove, NSW 2066,			
CONTACT: Dennis Zhang		Tal- 161 2 0422 4222			
Tel: +61 2 8723 2300		Tel: +61 2 9422 4222			
Fax: AURTHOR:		Fax : +61 2 9420 5911			
AURTHUR:	Blizin	Date: 17 Mar 2017			
	Ben Shojaei				
	Senior ESD Engineer				
REVIEWED BY:	-				
	M hermon	Date: 17 Mar 2017			
	Maria Tsinonis				
	Office Administrator				
AUTHORISED BY:	M Journand	Date: 17 Mar 2017			
	Maria Tsinonis				
	Office Administrator				
REVISION HISTORY					
Revision No.	Date Issued	Reason/Comments			
0	17 Mar 2017	Initial Issue			
1					
2					
DISTRIBUTION					
Сору No	Location				
1	Project				
2	Client (PDF Format)	Uncontrolled Copy			
3					
4					
KEYWORDS:					

NOTE: This is a controlled document within the document control system. If revised, it must be marked SUPERSEDED and returned to the Vipac QA Representative. This document contains commercial, conceptual and engineering information that is proprietary to Vipac Engineers & Scientists Ltd. We specifically state that inclusion of this information does not grant the Client any license to use the information without Vipac's written permission. We further require that the information not be divulged to a third party without our written consent.



1 EXECUTIVE SUMMARY

Vipac Engineers & Scientists Ltd. has been commissioned by Merhis Projects Pty Ltd to assess the interaction of the proposed development at 74-80 Restwell Street Bankstow NSW, with the local environment in terms of BASIX compliance.

A BASIX Certificate is a DA requirement and demonstrates compliance with the NSW Government's sustainability targets. BASIX assessment and certification has been completed for this project (Certificate No. 630024M_05).

Dwellings within the development have been assessed in terms of their passive energy design using the BASIX Thermal Comfort protocol. They have also been assessed in terms of their ability to conserve water and energy.

With the recommendations provided in the BASIX certificate the development meets and exceeds the minimum requirements for all following areas.

- Energy Efficiency
- Water Efficiency
- Thermal Comfort

This development achieves the following targets:

- Energy Efficiency: 23% reduction (minimum requirements under BASIX 20%)
 - Water Efficiency: 40% reduction (minimum requirements under BASIX 40%)
- Thermal Comfort: Passing the thermal performance requirements under BASIX



TABLE OF CONTENTS

1	EXECUTIVE SUMMARY	3
1	INTRODUCTION	5
2	BASIX WATER SECTION	5
3	BASIX THERMAL COMFORT SECTION	6
3.1	Modelling Assumptions	6
3.2	Reference Documents	7
3.3	Thermal Comfort Modelling Results (Firsrate5 Software)	8
4	BASIX ENERGY SECTION	12
5	SUMMARY & CONCLUSION	13



1 INTRODUCTION

BASIX is a NSW State Planning Policy Tool which assesses the environmental performance of new residential premises against a range of water, energy and greenhouse gas emissions targets. The assessment has three core components, BASIX Thermal Comfort, BASIX Water and BASIX Energy.

The thermal comfort assessment requires that the thermal performance of dwellings are evaluated and measures put in place to ensure annual heating and cooling loads do not exceed pre-defined limits without compromising the occupants thermal comfort. This assessment uses computer simulation to evaluate the building fabric thermal performance and passive solar design features such as orientation and solar shading.

The energy section evaluates gas and electrical energy used for heating, cooling lighting, ventilation and appliances. The BASIX Energy target requires the development to uses 20% less energy than the NSW average.

The water assessment takes account of landscaping, stormwater management as well as water efficiency performance of fixtures and fitting such as taps and showers. The BASIX target for water requires that potable water consumption is at least 40% lower than the NSW average.

Note:

This report is only a general guide to the BASIX requirements, for complete details of BASIX requirements please refer to the BASIX certificate, thermal modelling documentation and stamped drawings.

While every endeavour has been made to provide a realistic energy rating for the proposed development, we note that the energy calculating process using computer program simulation is not 100% accurate. Computer building simulation provides an estimate of building performance. This estimate is based on a necessarily simplified and idealised version of the building that does not and cannot fully represent all of the intricacies of the building once built. As a result, simulation results only represent an interpretation of the potential performance of the building. No guarantee or warrantee of building performance in practice can be based on simulation results alone.

2 BASIX WATER SECTION

The water efficiency performance of the development has been assessed using the online BASIX Tool. The assessment has considers Common Area and Central System features including the landscape design, plant species, water catchment areas, rain water tank size and efficiency of preferred fixtures and fittings in the dwellings.

The proposed development will meet the mandatory BASIX water target of 40% as long as the water commitments detailed in Table 1 are installed. For details of the requirements necessary to achieve this target, please refer to the BASIX Certificate No. 630024M_05.

Common Areas and Ce	Common Areas and Central Systems				
Showerheads	• 3 star (> 6 but <= 7.5 L/min)				
Toilets and Taps	4 star water rating				
Private Dwellings					
Fixtures and Appliances for apartments	 3-star (Water Rating) showerheads with a flow rate > 4.5 L/min & ≤ 6 L/min 3-star (Water Rating) toilets 3-star (Water Rating) kitchen taps 3-star (Water Rating) bathroom taps 				

Table 1: Water Commitments



4-star (Water Rating) dishwashers ٠

BASIX THERMAL COMFORT SECTION 3

The thermal performance of the development has been evaluated using FirstRate5 software; this computer simulation of residential developments is used to assess the potential of a residential development to have low heating and cooling energy requirements once operational.

3.1 MODELLING ASSUMPTIONS

The following has been assumed for the thermal simulation:

- FirstRate5 calculates the transient hourly heat gains and losses for each space inside a building taking • into account the building's thermal storage, typical residential occupancy and operational profiles plus hourly weather data for the site
- Building geometry and orientation were modelled according to supplied drawings .
- The "base-case" building fabric and glazing and associated thermal performance specifications are • described in Table 2 below: Note these assumptions are based on the nominated preferred construction materials indicated by the architect.

Table 2: Base Case Construction and Fabric

Element	Details
External walls	
Internal walls	
Ceilings	
Roof	As per the thermal assessment certificate and stamped architectural drawings.
Windows	
Floors	



3.2 REFERENCE DOCUMENTS

Our review is based on the following architectural drawings provided by Nordon-Jago Architects, inputs used in the previous BASIX certificate and details directly provided by Merhis.

Dwg No.	Rev	Current Revision Date	
S-96.000	В	COVER SHEET	11-08-2016
S-96.091	A	BASEMENT 02 FLOOR PLAN	05-08-2016
S-96.095	A	BASEMENT 01 FLOOR PLAN	05-08-2016
S-96.100	A	GROUND FLOOR PLAN	05-08-2016
S-96.104	A	LEVEL-01 TO 04 (TYPICAL FLOOR PLAN)	05-08-2016
S-96.120	В	LEVEL-05 FLOOR PLAN	10-08-2016
S-96.124	В	LEVEL-06 FLOOR PLAN	10-08-2016
S-96.128	В	ROOF PLAN	10-08-2016
S-96.140	A	SHADOW DIAGRAM - 21 MARCH	05-08-2016
S-96.141	A	SHADOW DIAGRAM - 21 JUNE	05-08-2016
S-96.142	A	SHADOW DIAGRAM - 21 JUNE	05-08-2016
S-96.143	A	SHADOW DIAGRAM - 21 JUNE	05-08-2016
S-96.144	A	SHADOW DIAGRAM - 21 SEPTEMBER	05-08-2016
S-96.145	A	SHADOW DIAGRAM - 21 DECEMBER	05-08-2016
S-96.150	A	DA-DETAILED SHADOW STUDIES	05-08-2016
S-96.151	A	S96-DETAILED SHADOW STUDIES	05-08-2016
S-96.152	A	S96-L6 DETAILED SHADOW STUDIES	05-08-2016
S-96.200	A	SECTIONS	05-08-2016
S-96.300	A	ELEVATIONS NORTH AND SOUTH	05-08-2016
S-96.301	A	ELEVATIONS EAST AND WEST	05-08-2016



3.3 THERMAL COMFORT MODELLING RESULTS (FIRSRATE5 SOFTWARE)

The simulated heating and cooling loads per dwelling are summarized in Tables 3 and 4 below.

Table 3: FirstRate Thermal Modelling Results

mal performa	ance specifi	cations	Assess		3965170036
	Floor	Areas		Loads	
Unit No.	Cond	Uncond	(MJ/I Heat	VI2/y) Cool	Star Rating
0.01	72.2	0.0	32.0	10.4	6.7
0.01	74.2	0.0	21.3	19.4	6.9
0.02	87.4	0.0	21.3	12.5	7.3
0.03	87.4	0.0	35.0	7.7	6.7
0.04	74.5	0.0	45.7	15.0	5.3
0.06	50.2	0.0	48.8	8.0	5.6
0.07	74.4	0.0	46.7	20.2	4.9
0.08	88.4	0.0	36.8	17.7	5.7
0.09	50.2	0.0	26.7	8.3	7.3
0.10	90.4	0.0	28.2	16.6	6.5
0.11	77.7	0.0	48.7	13.7	5.2
0.12	51.2	0.0	47.1	15.0	5.2
0.13	70.5	0.0	13.2	41.5	5.7
0.14	70.6	0.0	57.9	4.7	5.2
0.15	79.8	0.0	12.8	16.2	7.8
0.16	75.1	0.0	33.0	12.6	6.4
0.17	77.8	0.0	37.7	9.5	6.3
0.18	75.4	0.0	24.5	13.2	7.1
0.19	72.3	0.0	32.8	5.0	7.1
0.20	69.6	0.0	26.6	8.4	7.3
0.21	72.3	0.0	38.8	5.7	6.5
1.01	70.7	0.0	8.4	19.9	7.8
1.02	74.2	0.0	5.8	22.0	7.8
1.03	87.4	0.0	9.3	14.5	8.2
1.04	87.4	0.0	4.8	16.4	8.4
1.05	72.5	0.0	18.9	25.1	6.6
1.06	72.5	0.0	18.9	25.1	6.6
1.07	74.4	0.0	49.3	18.0	4.9
1.08	77.9	0.0	14.6	10.7	8.1
1.09	73.0	0.0	1.3	9.4	9.3
1.10	50.2	0.0	14.1	10.9	8.1
1.10	90.4	0.0	18.5	12.5	7.6
1.12	78.6	0.0	3.3	8.2	9.3
1.12	67.3	6.5	5.8	11.8	8.7
1.13	51.2	0.0	25.7	16.1	6.8
1.14	70.5	0.0	14.4	40.1	5.8
1.16	49.2	0.0	6.6	19.9	7.9
1.17	74.3	0.0	13.6	14.0	7.9
1.17	74.5	0.0	1.9	27.6	7.7
1.19	74.0	0.0	12.1	15.3	7.9
1.19	77.8	0.0	17.0	11.0	7.9
1.55900579	75.4	1025-01275	13.2	205222488	7.8
1.21	100000000	0.0	0.000000	16.9	
1.22	72.3	0.0	8.3	6.4	8.9
1.23	69.6	0.0	5.1	9.5	8.9
1.24	72.3	0.0	11.8	7.7	8.5

17 Mar 2017



Merhis Management Group Pty Ltd 74-80 Restw ell Street Bankstow n BASIX Assessment Report

Thermal performance	ce specifi	cations	Assess	ment#	3965170036
	Floor	Floor Areas		Loads	
Unit No.			(MJ/N	46.9307	Star Rating
	Cond	Uncond	Heat	Cool	
2.01	70.7	0.0	9.0	18.4	7.9
2.02	74.2	0.0	6.4	20.5	7.9
2.03	87.4	0.0	10.0	13.5	8.2
2.04	87.4	0.0	5.2	15.7	8.4
2.05	72.5	0.0	19.9	24.1	6.6
2.06	72.5	0.0	19.9	24.1	6.6
2.07	74.4	0.0	50.9	17.9	4.8
2.08	77.9	0.0	15.4	10.2	8.0
2.09	73.0	0.0	1.5	9.0	9.4
2.10	50.2	0.0	15.1	10.7	8.0
2.11	90.4	0.0	19.4	11.7	7.6
2.12	78.6	0.0	3.6	7.8	9.3
2.13	67.3	6.5	6.5	11.4	8.7
2.14	51.2	0.0	27.0	15.2	6.7
2.15	70.5	0.0	15.0	37.9	5.9
2.16	49.2	0.0	7.3	18.3	8.0
2.17	74.3	0.0	14.5	13.2	7.9
2.18	74.6	0.0	2.1	26.4	7.8
2.19	75.1	0.0	12.9	14.8	7.9
2.20	77.8	0.0	17.8	10.6	7.8
2.21	75.4	0.0	13.9	16.5	7.6
2.22	72.3	0.0	9.0	6.5	8.9
2.23	69.6	0.0	5.7	9.1	8.9
2.24	72.3	0.0	12.6	7.3	8.5
3.01	70.7	0.0	9.6	17.8	7.9
3.02	74.2	0.0	6.9	19.9	7.9
3.03	87.4	0.0	10.5	13.3	8.2
3.04	87.4	0.0	5.8	15.2	8.4
3.05	72.5	0.0	20.7	22.7	6.6
3.06	72.5	0.0	20.7	22.7	6.6
3.07	74.4	0.0	52.3	17.0	4.8
3.08	77.9	0.0	16.1	9.8	8.0
3.09	73.0	0.0	1.6	8.8	9.4
3.10	50.2	0.0	15.9	9.7	8.0
3.11	90.4	0.0	20.1	12.1	7.4
3.12	78.6	0.0	3.9	7.7	9.2
3.13	67.3	6.5	7.1	11.3	8.6
3.14	51.2	0.0	28.1	14.2	6.7
3.15	70.5	0.0	15.7	34.5	6.1
3.16	49.2	0.0	8.1	17.3	8.1
3.17	74.3	0.0	15.1	12.8	7.8
3.18	74.6	0.0	2.5	25.8	7.8
3.19	75.1	0.0	13.5	14.2	7.9
3.20	77.8	0.0	18.4	10.4	7.8
3.21	75.4	0.0	14.4	15.9	7.6

205-11-0040-155-010481-



Merhis Management Group Pty Ltd 74-80 Restw ell Street Bankstow n BASIX Assessment Report

Thermal performance	ce specifi	cations	Assess	ment#	3965170036
	Floor	Areas	Predict. Loads		
Unit No.			(MJ/N	/l2/y)	Star Rating
	Cond	Uncond	Heat	Cool	2514.24
3.22	72.3	0.0	9.6	6.5	8.8
3.23	69.6	0.0	6.1	8.7	8.9
3.24	72.3	0.0	13.3	7.5	8.4
4.01	70.7	0.0	12.3	13.7	7.9
4.02	74.2	0.0	9.2	13.0	8.3
4.03	87.4	0.0	13.5	11.4	8.1
4.04	87.4	0.0	7.9	13.1	8.4
4.05	72.5	0.0	24.0	17.3	6.8
4.06	72.5	0.0	24.0	17.3	6.8
4.07	74.4	0.0	58.4	13.1	4.7
4.08	77.9	0.0	19.1	7.9	7.9
4.09	73.0	0.0	2.4	6.9	9.4
4.10	50.2	0.0	19.5	8.3	7.9
4.11	90.4	0.0	23.2	9.4	7.4
4.12	78.6	0.0	5.4	6.3	9.2
4.13	67.3	6.5	9.7	8.7	8.6
4.14	51.2	0.0	32.7	12.1	6.5
4.15	70.5	0.0	18.8	29.8	6.2
4.16	49.2	0.0	11.2	13.9	8.1
4.17	74.3	0.0	18.1	9.7	7.9
4.18	74.6	0.0	4.2	21.6	8.0
4.19	75.1	0.0	16.4	10.9	7.9
4.20	77.8	0.0	21.2	7.6	7.8
4.21	75.4	0.0	17.0	12.2	7.7
4.22	72.3	0.0	12.3	5.9	8.7
4.23	69.6	0.0	8.3	8.1	8.8
4.24	72.3	0.0	16.1	6.4	8.3
5.01	70.7	0.0	12.7	13.4	7.9
5.02	74.2	0.0	9.6	12.9	8.3
5.03	87.4	0.0	13.9	11.3	8.1
5.04	87.4	0.0	8.3	13.1	8.4
5.05	72.5	0.0	24.6	16.8	6.8
5.06	72.5	0.0	24.6	16.8	6.8
5.07	74.4	0.0	59.4	12.8	4.7
5.08	77.9	0.0	19.6	7.7	7.9
5.09	73.0	0.0	2.5	6.7	9.4
5.10	50.2	0.0	29.4	8.2	7.1
5.11	90.4	0.0	33.3	9.2	6.7
5.12	78.6	0.0	12.0	6.2	8.7
5.13	67.3	6.5	17.4	8.8	7.9
5.14	51.2	0.0	33.5	12.0	6.4
5.15	70.5	0.0	19.3	29.2	6.2
5.16	49.2	0.0	11.7	13.8	8.0
5.17	74.3	0.0	18.6	9.4	7.8
5.18	74.6	0.0	4.5	21.8	7.9

200-11-0040-100-010491-



Merhis Management Group Pty Ltd 74-80 Restw ell Street Bankstow n BASIX Assessment Report

mal performation	ications	Assess	ment#	3965170036	
Unit No.	Floor	Floor Areas		. Loads M2/y)	Star Rating
	Cond	Uncond	Heat	Cool	÷
5.19	75.1	0.0	16.9	10.7	7.9
5.20	77.8	0.0	21.7	7.6	7.7
5.21	75.4	0.0	17.5	12.2	7.7
5.22	72.3	0.0	12.7	5.9	8.6
5.23	69.6	0.0	8.7	8.0	8.8
5.24	72.3	0.0	16.5	6.2	8.3
6.01	70.7	0.0	28.4	16.0	6.6
6.02	74.2	0.0	24.0	16.6	6.9
6.03	87.4	0.0	27.7	14.2	6.8
6.04	87.4	0.0	19.7	15.2	7.3
6.05	72.5	0.0	38.3	18.8	5.6
6.06	72.5	0.0	38.3	18.8	5.6
6.07	74.4	0.0	64.1	12.5	4.4
6.08	71.7	0.0	56.1	17.2	4.6
6.14	51.2	0.0	48.6	13.9	5.2
6.15	70.5	0.0	34.2	34.2	4.9
6.16	49.2	0.0	24.5	16.1	6.9
6.17	74.3	0.0	33.5	12.5	6.4
6.18	74.6	0.0	15.9	26.9	6.7
6.19	75.1	0.0	33.0	12.2	6.4
6.20	77.8	0.0	36.3	9.8	6.4
6.21	89.2	0.0	29.4	14.2	6.6
6.22	72.3	0.0	28.7	8.9	7.1
6.23	69.6	0.0	22.0	9.6	7.5
6.24	86.3	0.0	17.9	13.4	7.6



4 BASIX ENERGY SECTION

The Energy performance of the development has been assessed using the online BASIX Tool. The assessment has considered Common Area and Central System features including the lifts, ventilation and lighting for common areas (corridors, lobbies, car park etc), centralised domestic hot water and the efficiency of preferred lighting and appliances in the dwellings.

The proposed development will meet the mandatory BASIX Energy target of 20% as long as the energy commitments detailed in Table are installed.

Table 4: Energy Commitments

Component		Commitment
Common Areas and	Centralised Hot Water System	Gas Instantaneous System with internal and external piping insulation of R0.45 (~20mm)
Central Systems	Lifts	All lifts to use Gearless traction with VWF motor servicing all levels
	Ventilation	 Carpark: ventilation (supply + exhaust), carbon monoxide monitor + VSD fan Garbage Rooms: supply and exhaust ventilation Plant/Service Rooms, Lift Motor Rooms, Switch Rooms: supply and exhaust ventilation, interlocked to light Hallways & lobbies: No mechanical ventilation Communityroom: air conditioned, controlled via time clock or BMS Carpark: Fluorescent lighting with daylight sensors Lifts: connected to lift call button
		 Garbage Rooms: Fluorescent lighting with manual on/off switch Plant/Service Rooms, Lift Motor Rooms, Switch Rooms: Fluorescent lighting with manual on/off switch Hallways & lobbies: Compact Fluorescent lighting with daylight sensors Ground floor lobby type: Fluorescent lighting with daylight sensors Communityroom: air conditioned, controlled via time clock or BMS
Private Dwellings	Ventilation	 Kitchen Exhaust: Individual fan, ducted to roof or façade, interlocked to light Bathroom & Laundry Exhaust: Individual fan, ducted to roof or façade, manual switch on / off
	Heating & Cooling	 Heat: Living & Beds to have individual 1-phase air-conditioning 3.5 Stars (new energy rating) 1 Cool: Living & Beds to have individual 1-phase air-conditioning 3.5 Stars (new energy rating) 2
	Lighting	 All hallways, laundries, bathrooms, kitchens and bedrooms areas to use Fluorescent or LED lights with dedicated fittings³ Kitchen are to naturally lit by either window or skylight
	Appliances & Other	 Electric cooktop and electric oven 2.5-stars (EnergyRating) dishwashers 1.5-stars (EnergyRating) clothes dryers

¹ Changes in energy labelling standards for air conditioners and refrigerators came into effect as of April 1st 2010. For more information, please see <u>http://www.basix.nsw.gov.au/docs/energy/newStarRating.pdf</u>

² Changes in energy labelling standards for air conditioners and refrigerators came into effect as of April 1st 2010. For more information, please see <u>http://www.basix.nsw.gov.au/docs/energy/newStarRating.pdf</u>

³ Definition of dedicated fittings is a light fitting that is only capable of accepting fluorescent or LED (Light Emitting Diode) lamps. It will not accept incandescent, halogen or any other non-fluorescent or non-LED lamps.



5 SUMMARY & CONCLUSION

The proposed development has been assessed to optimise its thermal performance (passive and fabric design) using the BASIX thermal comfort protocol.

The proposed development has also been assessed in terms of its ability to conserve water and minimise energy consumption.

With the recommendations contained within this report the proposed development is able to achieve the BASIX requirements and is eligible for BASIX certification.

For further details, please refer to the BASIX Certificate 630024M_05 provided and stamped drawings and certificates.