

# DRUMMOYNE

227 - 231 VICTORIA ROAD

# **DEVELOPMENT APPLICATION**

Dickson Rothschild D.R. Design (NSW) Pty. Ltd. 9 Argyle Place, ABN: 35 134 237 540

Phone: +61 2 8540 8720 ndickson@dicksonrothschild.com.au www.dicksonrothschild.com.au Millers Point, Sydney, NSW 2000 Nominated Architect: Robert Nigel Dickson Registration No: 5364

This drawing and design is subject to D.R. Design (NSW) Pty Ltd copyright and may not be reproduced without prior written consent. Contractor to verify all dimensions on site before commencing work.

Resolve all discrepancies with the Architect before proceeding. Figured dimensions to be taken in preference to scaled drawings. All work is to conform to relevant Australian Standards and other Codes as applicable, together with other Authorities' requirements and regulations.

REV	DESCRIPTION	DATE	ISSUED	CHECKE
Α	ISSUE FOR DA	28/10/2016	NT	AC
В	AMENDED AS PER COUNCIL RFI	10/04/2016	MC	AC

DRU

227 - 2

J. BARTOLOTTA

т	DRAWING			
UMMOYNE	COVER	SHEET		
- 231 VICTORIA ROAD	PROJECT NO.	DRAWING NO.	REVISION	DATE







Phone: +61 2 8540 8720 ndickson@dicksonrothschild.com.au www.dicksonrothschild.com.au Nominated Architect: Robert Nigel Dickson Registration No: 5364

This drawing and design is subject to D.R. Design (NSW) Pty Ltd copyright and may not be reproduced without prior written consent. Contractor to verify all dimensions on site before commencing work. Resolve all discrepancies with the Architect before proceeding. Figured dimensions to be taken in preference to scaled drawings. All work is to conform to relevant Australian Standards and other Codes as applicable, together with other Authorities' requirements and regulations.

REV	DESCRIPTION	DATE	ISSUED	CHECKED
Α	ISSUE FOR DA	28/10/2016	NT	AC
В	AMENDED AS PER COUNCIL RFI	10/04/2016	MC	AC

DRUMMOYNE

227 - 231 VICTORIA ROAD

J. BARTOLOTTA

DEVELOPMENT APPLICATION

PHOTOMONTAGE SHEET 1

 PROJECT NO.
 DRAWING NO.
 REVISION
 DATE

 15-030
 DA-0-002
 B
 27/06/2016

 SCALE @ A3
 DRAWN
 AUTHORISED

 CP
 AC





Phone: +61 2 8540 8720 ndickson@dicksonrothschild.com.au www.dicksonrothschild.com.au Nominated Architect: Robert Nigel Dickson Registration No: 5364

This drawing and design is subject to D.R. Design (NSW) Pty Ltd copyright and may not be reproduced without prior written consent. Contractor to verify all dimensions on site before commencing work. Resolve all discrepancies with the Architect before proceeding. Figured dimensions to be taken in preference to scaled drawings. All work is to conform to relevant Australian Standards and other Codes as applicable, together with other Authorities' requirements and regulations.

	REV	DESCRIPTION	DATE	ISSUED	CHECKED
	Α	ISSUE FOR DA	28/10/2016	NT	AC
	В	AMENDED AS PER COUNCIL RFI	10/04/2016	MC	AC
5					

DRUMMOYNE

227 - 231 VICTORIA ROAD

J. BARTOLOTTA

DEVELOPMENT APPLICATION

PHOTOMONTAGE SHEET 2

PROJECT NO. DRAWING NO. REVISION DATE

15-030 DA-0-003 B 27/06/2016

SCALE @ A3 DRAWN AUTHORISED CP AC



	DRAWING LIST	
SHEET	DRAWING NAME	REV
0xx - GENEI	RAL	~
DA-0-001	COVER SHEET	В
DA-0-002	PHOTOMONTAGE SHEET 1	<b>▶</b> B →
DA-0-003	PHOTOMONTAGE SHEET 2	В
DA-0-004	DRAWING LIST	В
DA-0-005	PROJECT SUMMARY	\ B →
1xx - SITE		
DA-0-101	SITE ANALYSIS 1	A
DA-0-102	SITE ANALYSIS 2	А
DA-0-103	SITE ANALYSIS 3	А
DA-0-104	SITE ANALYSIS 4	A
DA-0-105	SITE PLAN 1	В
DA-0-106	SITE PLAN 2	В
DA-0-107	DEMOLITION PLAN	A
DA-0-108	SURVEY	
DA-0-109	AMALGAMATION PLAN	A
2xx - PLANS	5	
DA-0-200	BASEMENT 2	В
DA-0-201	BASEMENT 1	В
DA-0-202	GROUND FLOOR PLAN	В
DA-0-203	LEVEL 1 FLOOR PLAN	В
DA-0-204	LEVEL 2 FLOOR PLAN	В
DA-0-205	LEVEL 3 FLOOR PLAN	В
DA-0-206	LEVEL 4 FLOOR PLAN	B
DA-0-207	LEVEL 5 FLOOR PLAN	В
DA-0-208	LEVEL 6 FLOOR PLAN	B
DA-0-210	COMMUNAL OPEN SPACE	В
DA-0-211	ROOF	But
DA-0-212	ROOFTOP LIGHTING PLAN	A
DA-0-251	GFA PLANS	B

	DRAWING LIST	
SHEET	DRAWING NAME	REV
3xx - ELEVA	TIONS	
DA-0-301	NORTH ELEVATION	( B)
DA-0-302	SOUTH ELEVATION	А
DA-0-303	WEST ELEVATION	(B)
DA-0-304	EAST ELEVATION	} B≺
DA-0-305	VICTORIA ROAD ELEVATION	В
4xx - SECTIO	DNS	
DA-0-401	SECTION AA	B
DA-0-402	SECTION BB	В
DA-0-403	ACCESS RAMPS	B
DA-0-404	FACADE SECTIONS	В
6xx - DETAI	LS	
DA-0-601	ADAPTABLE UNITS	(B)
DA-0-602	LIVEABLE HOUSING DESIGN - SILVER LEVEL	A
9xx - DIAGR	AMS & SCHEDULES	
DA-0-901	FINISHES SCHEDULE	B
DA-0-902	SHADOW ANALYSIS - SHEET 1	} B√
DA-0-903	SHADOW ANALYSIS - SHEET 2	(B)
DA-0-904	SHADOW ANALYSIS - SHEET 3	A
DA-0,905	DCP/ADG ENVELOPE DIAGRAM	A
DA-0-911	HEIGHT PLANE DIAGRAM - TOP OF PARAPET 1	В
DA-0-912	HEIGHT PLANE DIAGRAM - TOP OF PARAPET 2	A
DA-0-913	HEIGHT PLANE DIAGRAM - TOP OF PARAPET 3	Α
DA-0-914	VIEW ANALYSIS 1	А
DA-0-915	VIEW ANALYSIS 2	A
DA-0-921	SOLAR & CV - SHEET 1	B
DA-0-922	SOLAR & CV - SHEET 2	} B≺
DA-0-922	COLAD COLA CUEFT 3	B
DA-0-922 DA-0-923	SOLAR & CV - SHEET 2	_~~
	FUTURE BUILT FORM ANALYSIS - VICTORIA ROAD 1	A
DA-0-923		$\sim$
DA-0-923 DA-0-933	FUTURE BUILT FORM ANALYSIS - VICTORIA ROAD 1	A

Dickson Rothschild
D.R. Design (NSW) Pty. Ltd.
9 Argyle Place,
Millers Point, Sydney, NSW 2000
ABN: 35 134 237 540

Phone: +61 2 8540 8720 ndickson@dicksonrothschild.com.au www.dicksonrothschild.com.au Nominated Architect: Robert Nigel Dickson Registration No: 5364

This drawing and design is subject to D.R. Design (NSW) Pty Ltd copyright and may not be reproduced without prior written consent. Contractor to verify all dimensions on site before commencing work. Resolve all discrepancies with the Architect before proceeding. Figured dimensions to be taken in preference to scaled drawings. All work is to conform to relevant Australian Standards and other Codes as applicable, together with other Authorities' requirements and regulations.

REV	DESCRIPTION	DATE	ISSUED	CHECKED
Α	ISSUE FOR DA	28/10/2016	NT	AC
В	AMENDED AS PER COUNCIL RFI	10/04/2016	MC	AC

1 HOSECT	
DRUMMOYNE	

227 - 231 VICTORIA ROAD

DEVELOPMENT APPLICATION

J. BARTOLOTTA

DRAWING LIST

PROJECT NO. DRAWING NO. REVISION DATE
15-030 DA-0-004 B 27/06/2016 DRAWN AUTHORISED NT AC



#### 227 & 231 Victoria Road, Drummoyne

Project No: Apr-17 Date:

Site area (m²): 867.0 m<sup>2</sup> (DP650973, DP518568)

#### Canada Bay LEP 2013

Land use	B4 Mixed Use	
FSR	2.0:1	
GFA	1734.0	
Height (m)	20m	

#### Canada Bay DCP 2017

Adaptable Units 3 units (Between 21 and 29 dwellings)

Note: all amounts are approximate with a potential variance of up to 5%

		GFA		COMMERCIAL		RESIDEN	NTIAL	
Level	Car Parking spaces	Comm GFA	Res GFA	Comm tenancies	Studio	1 bdrm units	2 bdrm units	3 bdrm units
Level 6	**		249			1	2	
Level 5			279				3	
Level 4			279 🗸				3	
Level 3			369				4	
Level 2			369				4	
Level 1			446		1	5		
Ground Floor	~~	111	49	1	120			
Basement 1	15.0							
Basement 2	10.0		~\					
Total	27	111	2040	1	1	6	16	0
nit Mix		~~	$\overline{\zeta}$		4.3%	26.1%	69.6%	0.0%

Proposed FSR Commercial	0.13:1
Total Residential	23
Total GFA	2151
Total parking	27
Proposed FSR	2.48:1

#### Notes

#### Canada Bay LEP 2013- GFA Definition

gross floor area means the sum of the floor area of each floor of a building measured from the internal face of external walls, or from the internal face of walls separating the building from any other building, measured at a height of 1.4 metres above the floor, and includes:

- (a) the area of a mezzanine, and
- (b) habitable rooms in a basement or an attic, and

but excludes:

- (d) any area for common vertical circulation, such as lifts and stairs, and
- (e) any basement:
- (i) storage, and
- (ii) vehicular access, loading areas, garbage and services, and
- (f) plant rooms, lift towers and other areas used exclusively for mechanical services or ducting, and
- (g) car parking to meet any requirements of the consent authority (including access to that car parking), and
- (h) any space used for the loading or unloading of goods (including access to it), and
- (i) terraces and balconies with outer walls less than 1.4 metres high, and

as applicable, together with other Authorities' requirements and regulations.

(j) voids above a floor at the level of a storey or storey above.

## SEPP 65 Apartment Design Guide

		SOLAR		
_evel	Min. Req	Achieved	Min. Req	Achieved
Ground Floor				
Level 1		2/6	60%	2/6
Level 2		4/4		2/4
Level 3	70%	4/4		4/4
Level 4		3/3		2/3
Level 5		3/3		2/3
Level 6		3/3		3/3
Total		19/23 (82.60%)		15/23 (65.21%)

### Canada Bay DCP 2017 Part C requirements

Commercial Car Parking Requirements	Unit of measure	Min. Rate	Allowable	Provided
TOTAL (including 1 Adaptable car space)	111	1/40m²	2.78	3

Residential Car Parking Requirements (*)	No. of Units	Max. Rate	Required	Provided
Residential (Non-Adaptable Units)		<u> </u>	$\wedge \wedge \wedge \wedge$	~ /~ /
Studio	1	0.6	0.60	
1 bdrm	5	0.6	3.00	3
2 bdrm	14	0.9	12.60	13
3 bdrm		1.4		
SUB-TOTAL	20	>	16.20	16
Non-adaptable Visitor		1 per 5 apartments	4	4
TOTAL NON-ADAPTABLE CAR SPACES		7 2 2	<del>~</del> ~ ~ ~	~ 20 ~
Residential (Adaptable Units)				
1 bdrm	1	1/Adaptable unit	1	1
2 bdrm	2	1/Adaptable unit	2	2
3 bdrm				
SUB-TOTAL	3		3	3
Adaptable Visitor		12	7	1 1 1
TOTAL ADAPTABLE CAR SPACES			<u> </u>	4
	·	·		
TOTAL CAR SPACES	23		26.98	27

vided	
$\overline{}$	
24	$\overline{}$
2	,
1 3	$\overline{}$
1	7
28	/
A	28

Open Spaces (in m²)	Min. Rate	Allowable	Provided
Common open space	25% of site area	216.75	219m²

Private Contractor Collection		General	Recycling
RETAIL WASTE	Rate:	50L/100m2/day	25L/100m2/day
	Total Volume weekly	389	194
	Bins 240L	(4)	0.8
	Bins 660L	0.6	
	Bins provided	1	1
Council Collection			
RESIDENTIAL	Rate:	120L/unit/week	120L/unit/week
	Total Volume	2,760	2,760
	Bins 1100L(WASTE), 1100L(RECYCLING	2.51	2.51
	Bins provided	3	3

Dickson Rothschild	Phone: +61 2 8540 8720	REV	DESCRIPTION	DATE	ISSUED	CHECKED
D.R. Design (NSW) Pty. Ltd.	ndickson@dicksonrothschild.com.au	Α	ISSUE FOR DA	28/10/2016	NT	AC
9 Argyle Place,	www.dicksonrothschild.com.au	В	AMENDED AS PER COUNCIL RFI	10/04/2016	MC	AC
Millers Point, Sydney, NSW 2000	Nominated Architect: Robert Nigel Dickson					
ABN: 35 134 237 540	Registration No: 5364					
This drawing and design is subject to D.R. [	Design (NSW) Pty Ltd copyright and may not be reproduced					
	to verify all dimensions on site before commencing work.					
Resolve all discrepancies with the Architect before proceeding. Figured dimensions to be taken in						
preference to scaled drawings. All work is t	to conform to relevant Australian Standards and other Codes					<del></del>

DRUMMOYNE	PROJECT SUMMARY			
227 - 231 VICTORIA ROAD	PROJECT NO.	DRAWING NO.	REVISION	DATE
CLIENT	15-030	DA-0-005	В	_27/06/20
J. BARTOLOTTA	SCALE @ A3		MC DRAWN	AUTHORISED AC





Phone: +61 2 8540 8720 ndickson@dicksonrothschild.com.au www.dicksonrothschild.com.au Millers Point, Sydney, NSW 2000 Nominated Architect: Robert Nigel Dickson Registration No: 5364

This drawing and design is subject to D.R. Design (NSW) Pty Ltd copyright and may not be reproduced without prior written consent. Contractor to verify all dimensions on site before commencing work. Resolve all discrepancies with the Architect before proceeding. Figured dimensions to be taken in preference to scaled drawings. All work is to conform to relevant Australian Standards and other Codes as applicable, together with other Authorities' requirements and regulations.

	REV	DESCRIPTION	DATE	ISSUED	CHECKED
	Α	ISSUE FOR DA	28/10/2016	NT	AC
S					



DRUMMOYNE 227 - 231 VICTORIA ROAD

J. BARTOLOTTA

DEVELOPMENT APPLICATION

SITE ANALYSIS 1

15-030 DA-0-101 A 27/06/2016 DRAWN AUTHO NOT TO SCALE















Phone: +61 2 8540 8720 ndickson@dicksonrothschild.com.au www.dicksonrothschild.com.au Millers Point, Sydney, NSW 2000 Nominated Architect: Robert Nigel Dickson Registration No: 5364

This drawing and design is subject to D.R. Design (NSW) Pty Ltd copyright and may not be reproduced without prior written consent. Contractor to verify all dimensions on site before commencing work. Resolve all discrepancies with the Architect before proceeding. Figured dimensions to be taken in preference to scaled drawings. All work is to conform to relevant Australian Standards and other Codes as applicable, together with other Authorities' requirements and regulations.

REV	DESCRIPTION	DATE	ISSUED	CHECKED
Α	ISSUE FOR DA	28/10/2016	NT	AC



DRUMMOYNE

227 - 231 VICTORIA ROAD


J. BARTOLOTTA

DEVELOPMENT APPLICATION

SITE ANALYSIS 2

A 27/06/2016 15-030 DA-0-102 A NOT TO SCALE HW AC



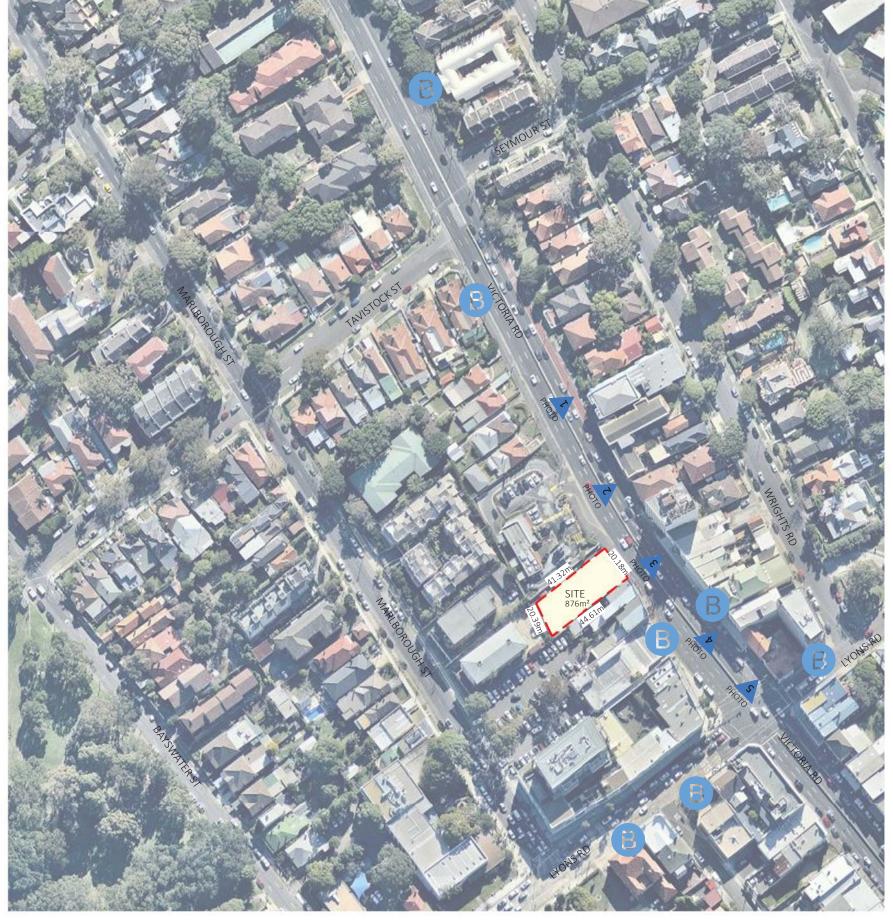











Phone: +61 2 8540 8720 ndickson@dicksonrothschild.com.au www.dicksonrothschild.com.au Millers Point, Sydney, NSW 2000 Nominated Architect: Robert Nigel Dickson Registration No: 5364

This drawing and design is subject to D.R. Design (NSW) Pty Ltd copyright and may not be reproduced without prior written consent. Contractor to verify all dimensions on site before commencing work. Resolve all discrepancies with the Architect before proceeding. Figured dimensions to be taken in preference to scaled drawings. All work is to conform to relevant Australian Standards and other Codes as applicable, together with other Authorities' requirements and regulations.

REV	DESCRIPTION	DATE	ISSUED	CHECKED
Α	ISSUE FOR DA	28/10/2016	NT	AC



DRUMMOYNE

227 - 231 VICTORIA ROAD


J. BARTOLOTTA

DEVELOPMENT APPLICATION

SITE ANALYSIS 3

15-030 DA-0-103 A 27/06/2016 NOT TO SCALE HW AC



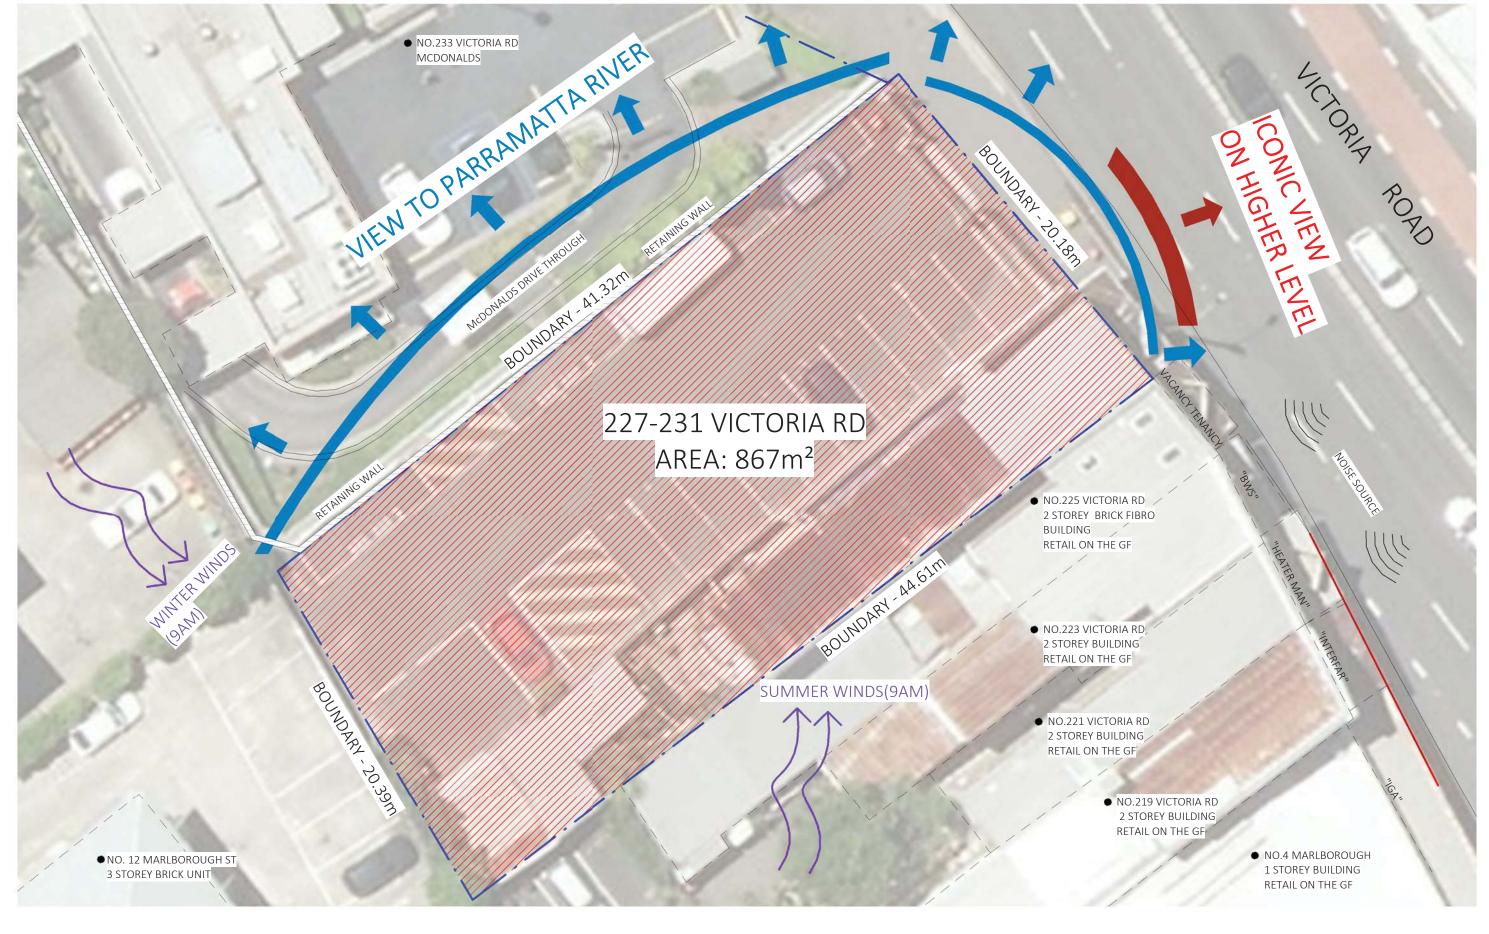

Phone: +61 2 8540 8720 ndickson@dicksonrothschild.com.au www.dicksonrothschild.com.au Nominated Architect: Robert Nigel Dickson Registration No: 5364

This drawing and design is subject to D.R. Design (NSW) Pty Ltd copyright and may not be reproduced without prior written consent. Contractor to verify all dimensions on site before commencing work. Resolve all discrepancies with the Architect before proceeding. Figured dimensions to be taken in preference to scaled drawings. All work is to conform to relevant Australian Standards and other Codes as applicable, together with other Authorities' requirements and regulations.

REV	DESCRIPTION	DATE	ISSUED	CHECKE
Α	ISSUE FOR DA	28/10/2016	NT	AC



DRUMMOYNE

227 - 231 VICTORIA ROAD

CLIENT

J. BARTOLOTTA

SITE A	NALYSIS 4	4	
PROJECT NO. 15-030	DRAWING NO. DA-0-104	REVISION A	DATE 27/06/2016
SCALE @ A3 1:200		DRAWN SC	AUTHORISED AC
(	SCALE	1:200	10





LEGEND

SKL SKY LIGHT
T.O.P TOP OF PARAPET
T.O.B TOP OF BALUSTRADE

Dickson Rothschild D.R. Design (NSW) Pty. Ltd. 9 Argyle Place, Millers Point, Sydney, NSW 2000 ABN: 35 134 237 540 Phone: +61 2 8540 8720 ndickson@dicksonrothschild.com.au www.dicksonrothschild.com.au Nominated Architect: Robert Nigel Dickson Registration No: 5364

This drawing and design is subject to D.R. Design (NSW) Pty Ltd copyright and may not be reproduced without prior written consent. Contractor to verify all dimensions on site before commencing work. Resolve all discrepancies with the Architect before proceeding. Figured dimensions to be taken in preference to scaled drawings. All work is to conform to relevant Australian Standards and other Codes as applicable, together with other Authorities' requirements and regulations.

	REV	DESCRIPTION	DATE	ISSUED	CHECKE
	Α	ISSUE FOR DA	28/10/2016	NT	AC
	В	AMENDED AS PER COUNCIL RFI	10/04/2016	MC	AC
ł					
es					



DRUMMOYNE


227 - 231 VICTORIA ROAD

J. BARTOLOTTA

SITE	PLAN	1

PROJECT NO.	DRAWING NO.	REVISION	DATE
15-030	DA-0-105	В	27/06/2016
SCALE @ A3		DRAWN	AUTHORISED
1:500		SC	AC
(	SCALE	1:500	25



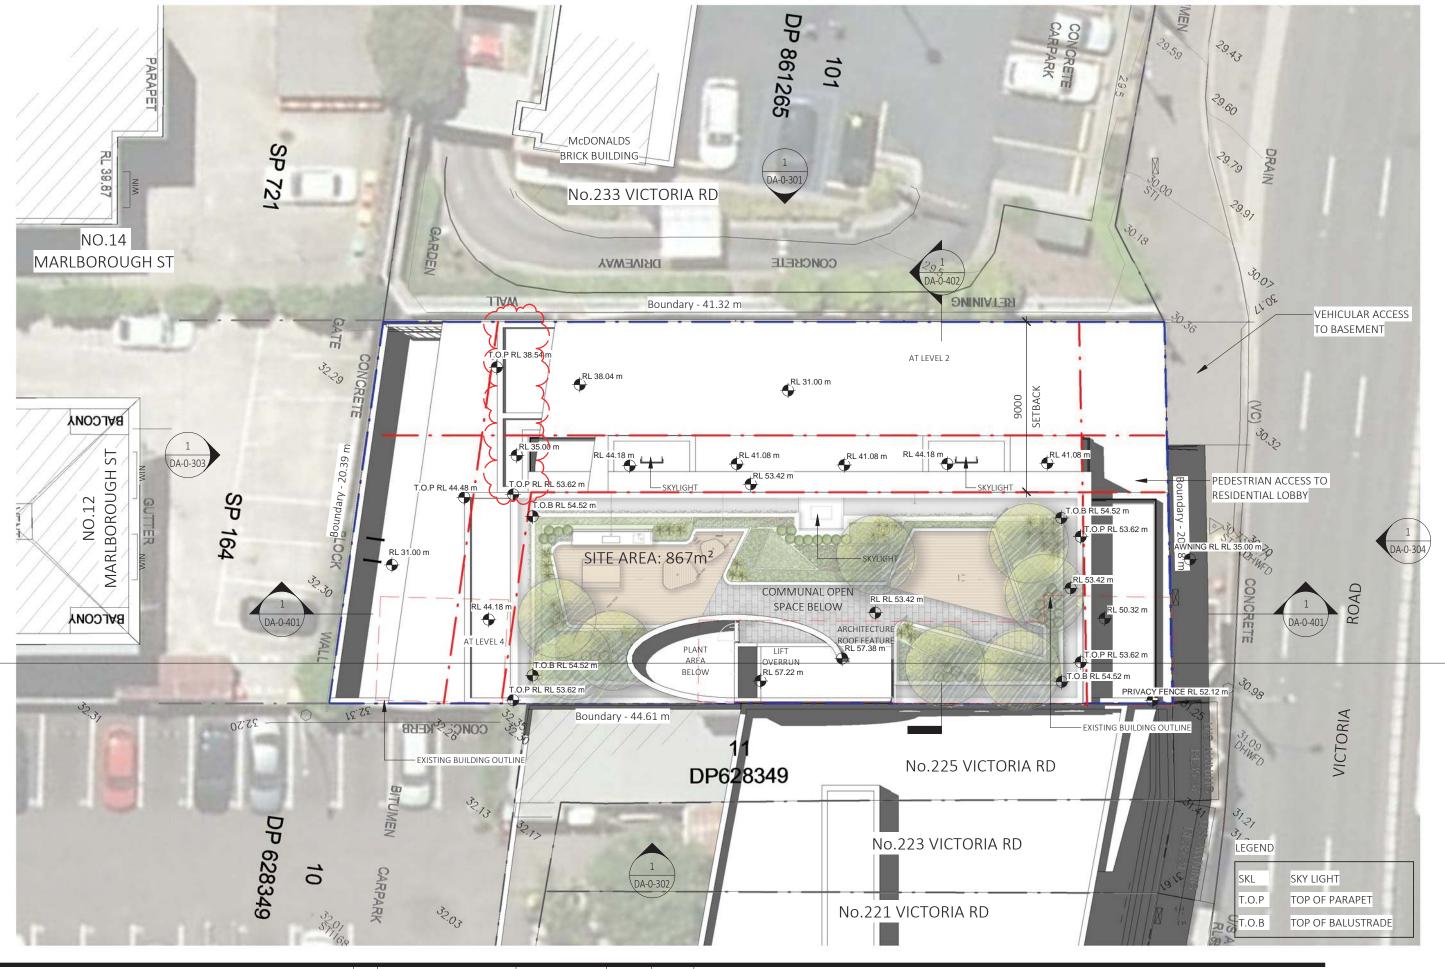

Phone: +61 2 8540 8720 ndickson@dicksonrothschild.com.au www.dicksonrothschild.com.au Nominated Architect: Robert Nigel Dickson Registration No: 5364

This drawing and design is subject to D.R. Design (NSW) Pty Ltd copyright and may not be reproduced without prior written consent. Contractor to verify all dimensions on site before commencing work. Resolve all discrepancies with the Architect before proceeding. Figured dimensions to be taken in preference to scaled drawings. All work is to conform to relevant Australian Standards and other Codes as applicable, together with other Authorities' requirements and regulations.


	REV	DESCRIPTION	DATE	ISSUED	CHECKED
	Α	ISSUE FOR DA	28/10/2016	NT	AC
	В	AMENDED AS PER COUNCIL RFI	10/04/2016	MC	AC
S					
					,



PROJECT	
DRUMMOYNE	
227 - 231 VICTORIA ROAD	-
CLIENT	
J. BARTOLOTTA	
	_

SITE PLAN 2						
PROJECT NO.	DRAWING NO.	REVISION	DATE			
15-030	DA-0-106	В	27/06/2016			
SCALE @ A3		DRAWN	AUTHORISED			
1:200		RD	AC			



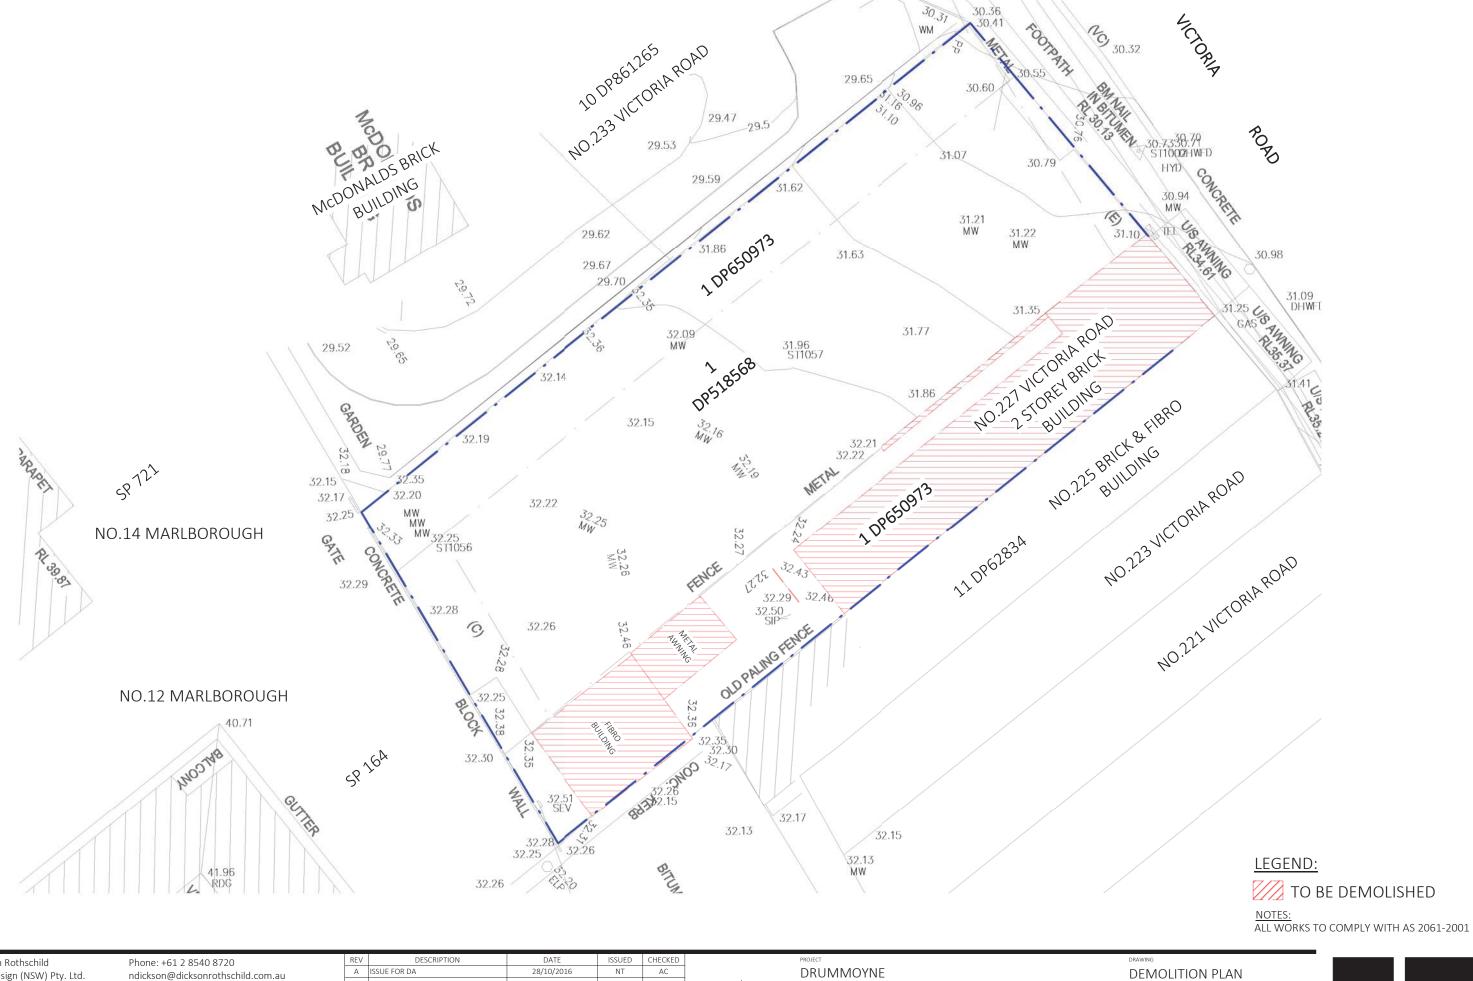

Phone: +61 2 8540 8720 ndickson@dicksonrothschild.com.au www.dicksonrothschild.com.au Nominated Architect: Robert Nigel Dickson Registration No: 5364

This drawing and design is subject to D.R. Design (NSW) Pty Ltd copyright and may not be reproduced without prior written consent. Contractor to verify all dimensions on site before commencing work. Resolve all discrepancies with the Architect before proceeding. Figured dimensions to be taken in preference to scaled drawings. All work is to conform to relevant Australian Standards and other Codes as applicable, together with other Authorities' requirements and regulations.

	REV	DESCRIPTION	DATE	ISSUED	CHECKED
	Α	ISSUE FOR DA	28/10/2016	NT	AC
d					
les					



DRUMMOYNE


227 - 231 VICTORIA ROAD

CLIENT


J. BARTOLOTTA






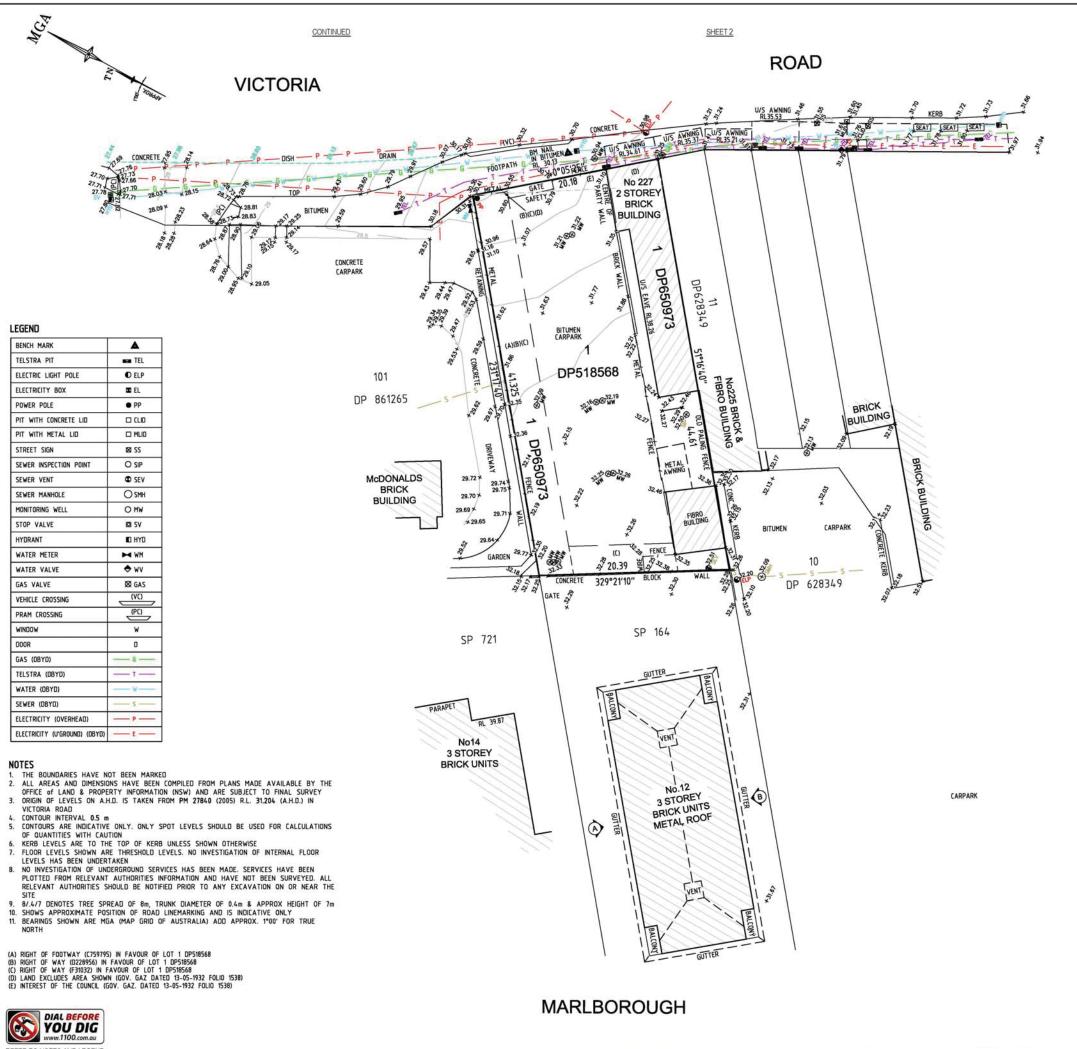


SCALE 1: 200 @ A1

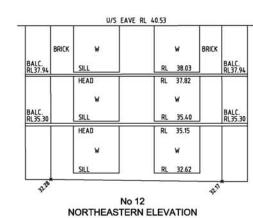


(SCALE 1:100)

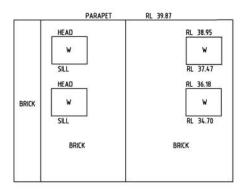

No 14 NORTHEASTERN ELEVATION (SCALE 1:100)

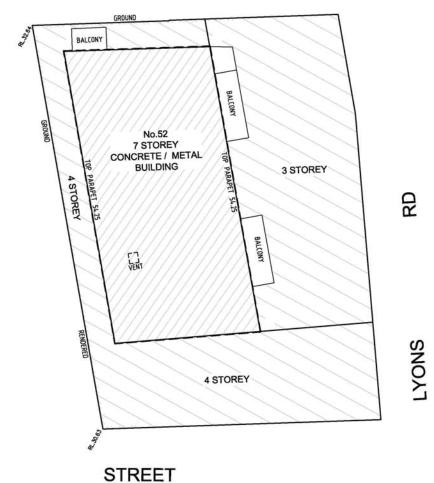

C	7/10/16	DESCRIPTION UPDATED TO No.52	43767	THIS IS THE PLAN REFERRED TO		Sulte 1, Level 1	Client BARTOLOTTA PROPERTIES P/L	datum	project number	reference number
В	6/10/16	ADJOINING BOUNDARIES ADDED, SITE ADDRESS UPDATED	43767	IN MY LETTER DATED:		Gordon NSW 2072	Drawing title	AHD	42256	42256DT
A	22/09/16	ROAD WIDENED AREA ADDED BACK INTO PLAN	43767			Locked Bag 5	PLAN OF DETAIL AND LEVELS OVER LOT 1 IN DP650973	site Area 867.1 m <sup>2</sup>	1:200 @A1	29/07/15
		ADJOINING BUILDINGS DETAIL & ELEVATIONS ADDED	43767		LOCKLEY	Gordon NSW 2072	AND LOT 1 IN DP518568 KNOWN AS No 227-231	007.1111	1.200 GAT	27/07/13
evision	Date	Description	Reference	Desistent of Supremental National	Registered Surveyors NSW	P 1300 587 000	MICTORIA DOAD DOUGHANOVAS	CANADA BAY	SHEE	1

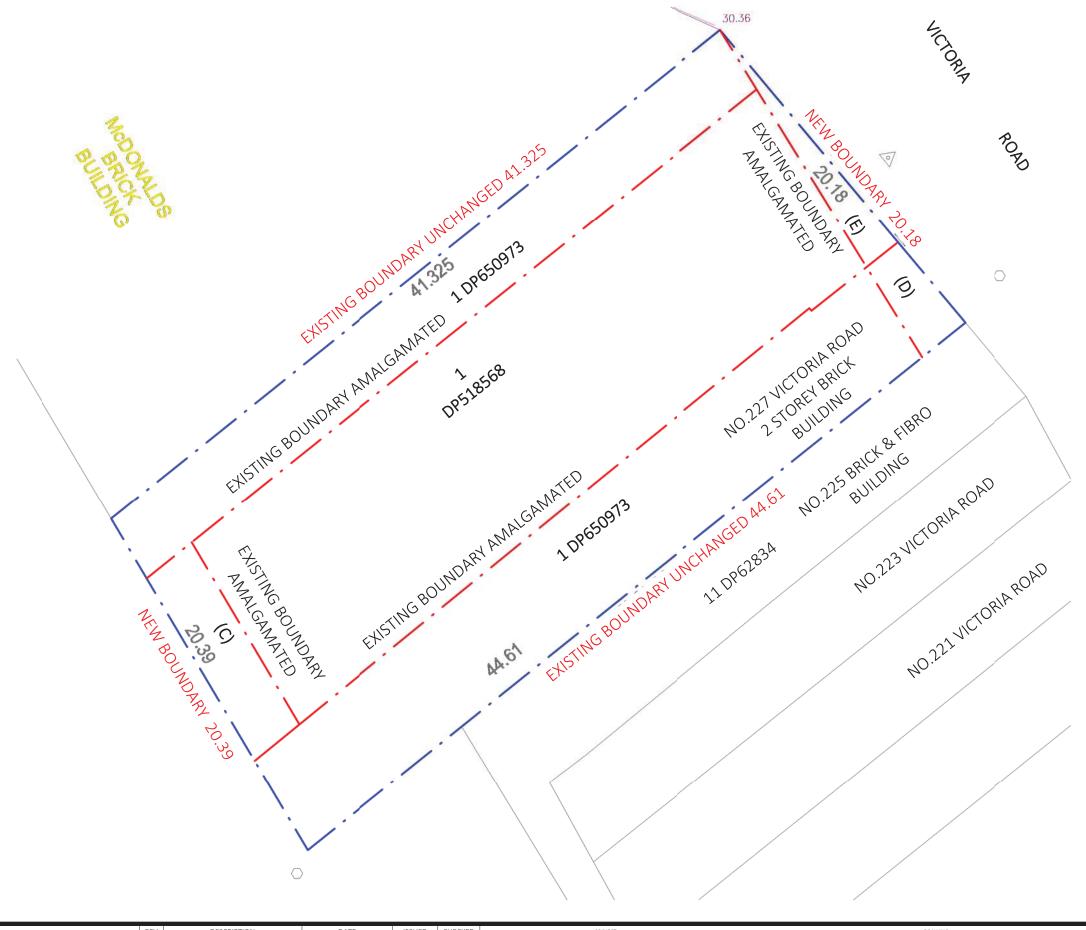

Phone: +61 2 8540 8720 ndickson@dicksonrothschild.com.au www.dicksonrothschild.com.au Nominated Architect: Robert Nigel Dickson Registration No: 5364

This drawing and design is subject to D.R. Design (NSW) Pty Ltd copyright and may not be reproduced without prior written consent. Contractor to verify all dimensions on site before commencing work. Resolve all discrepancies with the Architect before proceeding. Figured dimensions to be taken in preference to scaled drawings. All work is to conform to relevant Australian Standards and other Codes as applicable, together with other Authorities' requirements and regulations.

	REV	DESCRIPTION	DATE	ISSUED	CHECKED
	Α	ISSUE FOR DA	28/10/2016	NT	AC
1					
es					



DRUMMOYNE AN

227 - 231 VICTORIA ROAD

CLIENT

J. BARTOLOTTA

SCALE

DEVELOPMENT APPLICATION

AMALGAMATION PLAN

PROJECT NO. DRAWING NO. REVISION DATE
15-030 DA-0-109 A 27/06/2016

SCALE @ A3
1:200 DRAWN AUTHORISED

NT AC

SCALE 1200 10m



#### (a) Dwellings

#### (i) Water:

(b) The applicant must plant indigenous or low water use species of vegetation throughout the area of land specified for the dwelling in the "Indigenous species" column of the table below, as private landscaping for that dwelling. (This area of indigenous vegetation is to be contained within the "Area of garden and lawn" for the dwelling specified in the "Description of Project" table).

(e) The applicant must not install a private swimming pool or spa for the dwelling, with a volume exceeding that specified for it in the table below.

(g) The pool or spa must be located as specified in the

(h) The applicant must install, for the dwelling, each alternative water supply system, with the specified size. listed for that dwelling in the table below. Each system must be configured to collect run-off from the areas specified (excluding any area which supplies any other alternative water supply system), and to divert overflow as specified. Each system must be connected as

#### (ii) Energy:

(b) The applicant must install each hot water system specified for the dwelling in the table below, so that the dwelling's hot water is supplied by that system. If the table specifies a central hot water system for the dwelling, then the applicant must connect that central system to the dwelling, so that the dwelling's hot water is supplied by that central system.

(f) This commitment applies to each room or area of the dwelling which is referred to in a heading to the "Natural lighting" column of the table below (but only to the extent specified for that room or area). The applicant must ensure that each such room or area is fitted with a window and/or skylight.

#### (iii) Thermal Comfort;

(g) Where there is an in-slab heating or cooling system, the applicant must:

(aa) Install insulation with an R-value of not less than 1.0 around the vertical edges of the perimeter of the slab; or (bb) On a suspended floor, install insulation with an Rvalue of not less than 1.0 underneath the slab and around the vertical edges of the perimeter of the slab.

applicant must construct the floors and walls of pment in accordance with the specifications the dev DA-0-905

# (b) Common areas and central systems/facilities MARLBOROUGH ST

without prior written consent. Contractor to verify all dimensions on site before commencing work. Resolve all discrepancies with the Architect before proceeding. Figured dimensions to be taken in

as applicable, together with other Authorities' requirements and regulations.

preference to scaled drawings. All work is to conform to relevant Australian Standards and other Codes

# (i) Water:

(b) The applicant must install (or ensure that the development is serviced by) the alternative water supply system(s) specified in the "Central systems" column of the table below. In each case, the system must be sized, be configured, and be connected, as specified in table.

(c) A swimming pool or spa listed in the table must not have a volume in (kLs) greater than that specified for the pool or spa in the table

#### (ii) Energy:


(c) The applicant must install the systems and fixtures specified in the "Central energy systems" column of the table below. In each case, the system of fixture must be of the type, and meet the specifications, listed for it in

Dickson Rothschild

ABN: 35 134 237 540

9 Argyle Place,

D.R. Design (NSW) Pty. Ltd.

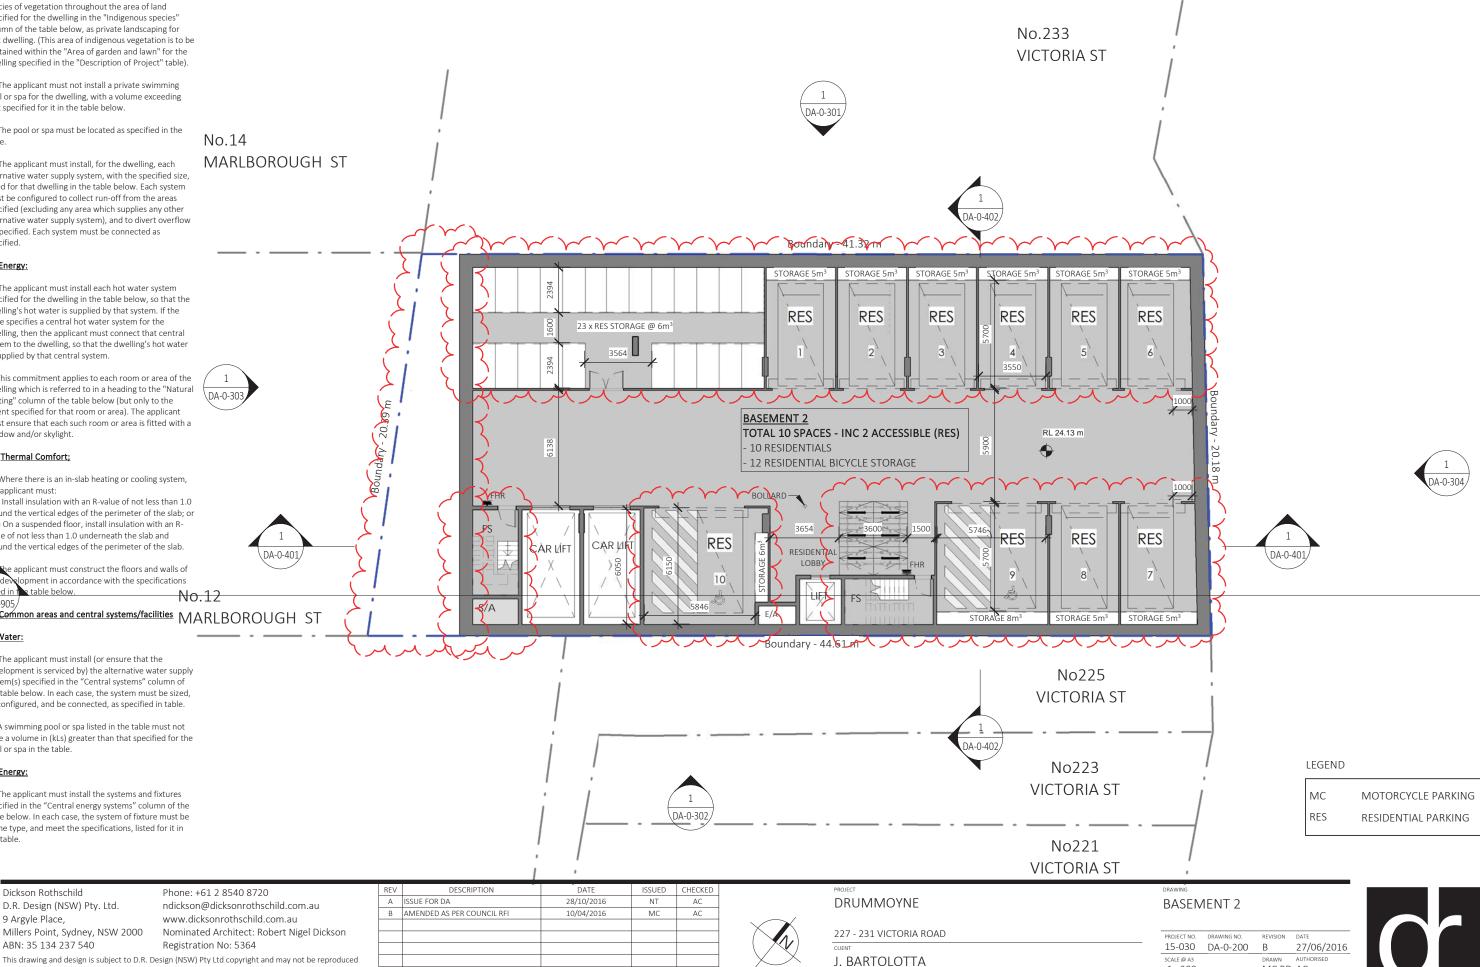

DEVELOPMENT APPLICATION

**VICTORIA ROAD** 

MC,RD AC

SCALE 1:200

1:200

#### (i) Water:

(b) The applicant must plant indigenous or low water use species of vegetation throughout the area of land specified for the dwelling in the "Indigenous species" column of the table below, as private landscaping for that dwelling. (This area of indigenous vegetation is to be contained within the "Area of garden and lawn" for the dwelling specified in the "Description of Project" table).

(e) The applicant must not install a private swimming pool or spa for the dwelling, with a volume exceeding that specified for it in the table below.

- (g) The pool or spa must be located as specified in the
- (h) The applicant must install, for the dwelling, each alternative water supply system, with the specified size, listed for that dwelling in the table below. Each system must be configured to collect run-off from the areas specified (excluding any area which supplies any other alternative water supply system), and to divert overflow as specified. Each system must be connected as specified.

#### (ii) Energy:

(b) The applicant must install each hot water system specified for the dwelling in the table below, so that the dwelling's hot water is supplied by that system. If the table specifies a central hot water system for the dwelling, then the applicant must connect that central system to the dwelling, so that the dwelling's hot water is supplied by that central system.

(f) This commitment applies to each room or area of the dwelling which is referred to in a heading to the "Natural lighting" column of the table below (but only to the extent specified for that room or area). The applicant must ensure that each such room or area is fitted with a window and/or skylight.

#### (iii) Thermal Comfort;

(g) Where there is an in-slab heating or cooling system, the applicant must:

(aa) Install insulation with an R-value of not less than 1.0 account the vertical edges of the perimeter of the slab; or (bbgOn assigned floor, install insulation with an R-value of novess than 1.0 underneath the slab and

DAOLTHOUS vertical edges of the perimeter of the slab No.12

(h) The applicant must construct the floors and walls dMARLBOROUGH ST the development in accordance with the specifications listed in the table below.

#### (b) Common areas and central systems/facilities


#### (i) Water:

(b) The applicant must install (or ensure that the development is serviced by) the alternative water supply system(s) specified in the "Central systems" column of the table below. In each case, the system must be sized, be configured, and be connected, as specified in table.

(c) A swimming pool or spa listed in the table must not have a volume in (kLs) greater than that specified for the pool or spa in the table.

#### (ii) Energy:

(c) The applicant must install the systems and fixtures specified in the "Central energy systems" column of the table below. In each case, the system of fixture must be of the type, and meet the specifications, listed for it in

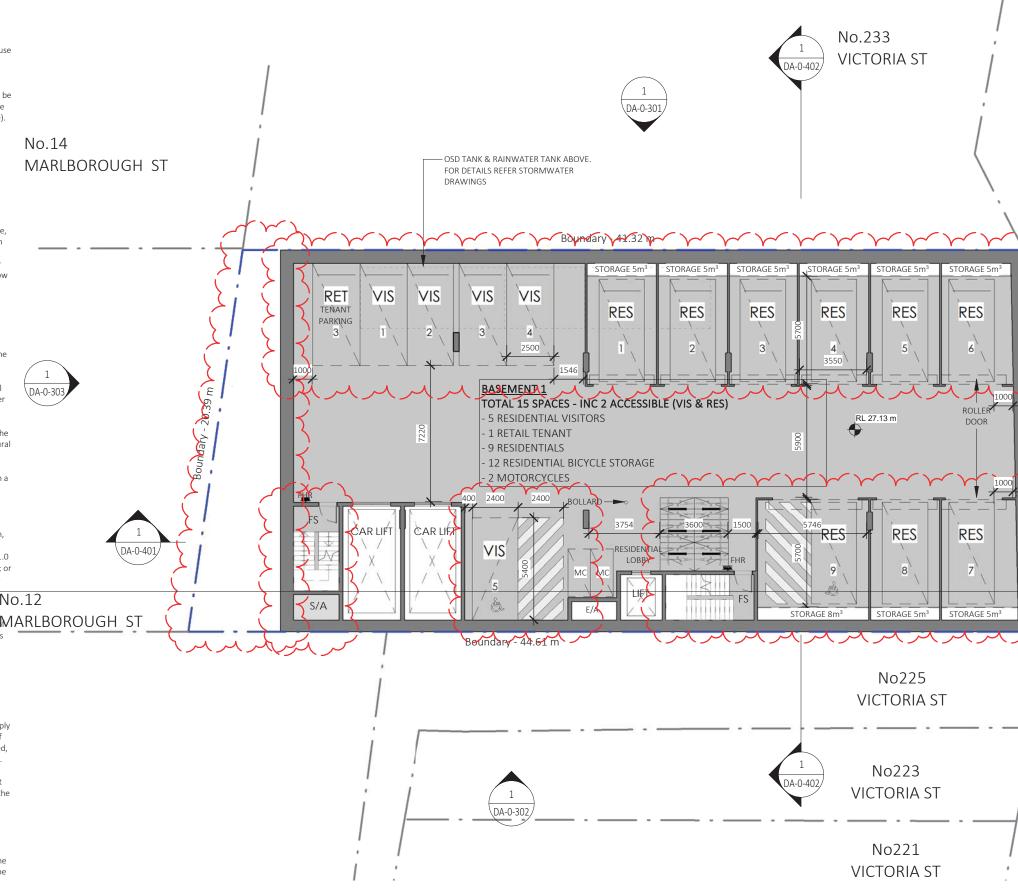



MC	MOTORCYCLE PARKING
RES	RESIDENTIAL PARKING
VIS	VISITORS PARKING
COM	COMMERCIAL PARKING

Dickson Rothschild D.R. Design (NSW) Pty. Ltd. 9 Argyle Place, Millers Point, Sydney, NSW 2000 ABN: 35 134 237 540 Phone: +61 2 8540 8720 ndickson@dicksonrothschild.com.au www.dicksonrothschild.com.au Nominated Architect: Robert Nigel Dickson Registration No: 5364

This drawing and design is subject to D.R. Design (NSW) Pty Ltd copyright and may not be reproduced without prior written consent. Contractor to verify all dimensions on site before commencing work. Resolve all discrepancies with the Architect before proceeding. Figured dimensions to be taken in preference to scaled drawings. All work is to conform to relevant Australian Standards and other Codes as applicable, together with other Authorities' requirements and regulations.

	REV	DESCRIPTION	DATE	ISSUED	CHECKED
	Α	ISSUE FOR DA	28/10/2016	NT	AC
	В	AMENDED AS PER COUNCIL RFI	10/04/2016	MC	AC
5					
					,

X	
$\rightarrow$	

PROJECT	DRAWING
DRUMMOYNE	BASEMENT 1
227 - 231 VICTORIA ROAD	PROJECT NO DRAWING NO
CLIENT	15-030 DA-0-20

DEVELOPMENT APPLICATION

PROJECT NO.	DRAWING NO.	REVISION	DATE
15-030	DA-0-201	В	27/06/2016
SCALE @ A3		DRAWN	AUTHORISED
1:200		MC	AC
	SCALE	1:200	11



VICTORIA ROAD

#### (a) Dwellings

#### (i) Water:

(b) The applicant must plant indigenous or low water use species of vegetation throughout the area of land specified for the dwelling in the "Indigenous species" column of the table below, as private landscaping for that dwelling. (This area of indigenous vegetation is to be contained within the "Area of garden and lawn" for the dwelling specified in the "Description of Project" table).

(e) The applicant must not install a private swimming pool or spa for the dwelling, with a volume exceeding that specified for it in the table below.

(g) The pool or spa must be located as specified in the table.

(h) The applicant must install, for the dwelling, each alternative water supply system, with the specified size. listed for that dwelling in the table below. Each system must be configured to collect run-off from the areas specified (excluding any area which supplies any other alternative water supply system), and to divert overflow as specified. Each system must be connected as specified.

#### (ii) Energy:

(b) The applicant must install each hot water system. specified for the dwelling in the table below, so that the dwelling's hot water is supplied by that system. If the table specifies a central hot water system for the dwelling, then the applicant must connect that central system to the dwelling, so that the dwelling's hot water is supplied by that central system.

(f) This commitment applies to each room or area of the dwelling which is referred to in a heading to the "Natural lighting" column of the table below (but only to the extent specified for that room or area). The applicant must ensure that each such room or area is fitted with a window and/or skylight.

#### (iii) Thermal Comfort;

(g) Where there is an in-slab heating or cooling system, the applicant must:

(aa) Install insulation with an R-value of not less than 1.0 around the vertical edge of the perimeter of the slab; or (bb) On a suspende floog, install insulation with an Rvalue of not less than 1.0 under eath the slab and around the vertical edge 905 perimeter of the slab.

(h) The applicant must construct the floors and walls of the development in accordance with the specifications listed in the table below

#### (b) Common areas and central systems/facilities


#### (i) Water:

(b) The applicant must install (or ensure that the development is serviced by) the alternative water supply system(s) specified in the "Central systems" column of the table below. In each case, the system must be sized, be configured, and be connected, as specified in table.

(c) A swimming pool or spa listed in the table must not have a volume in (kLs) greater than that specified for the pool or spa in the table

#### (ii) Energy:

(c) The applicant must install the systems and fixtures specified in the "Central energy systems" column of the table below. In each case, the system of fixture must be of the type, and meet the specifications, listed for it in

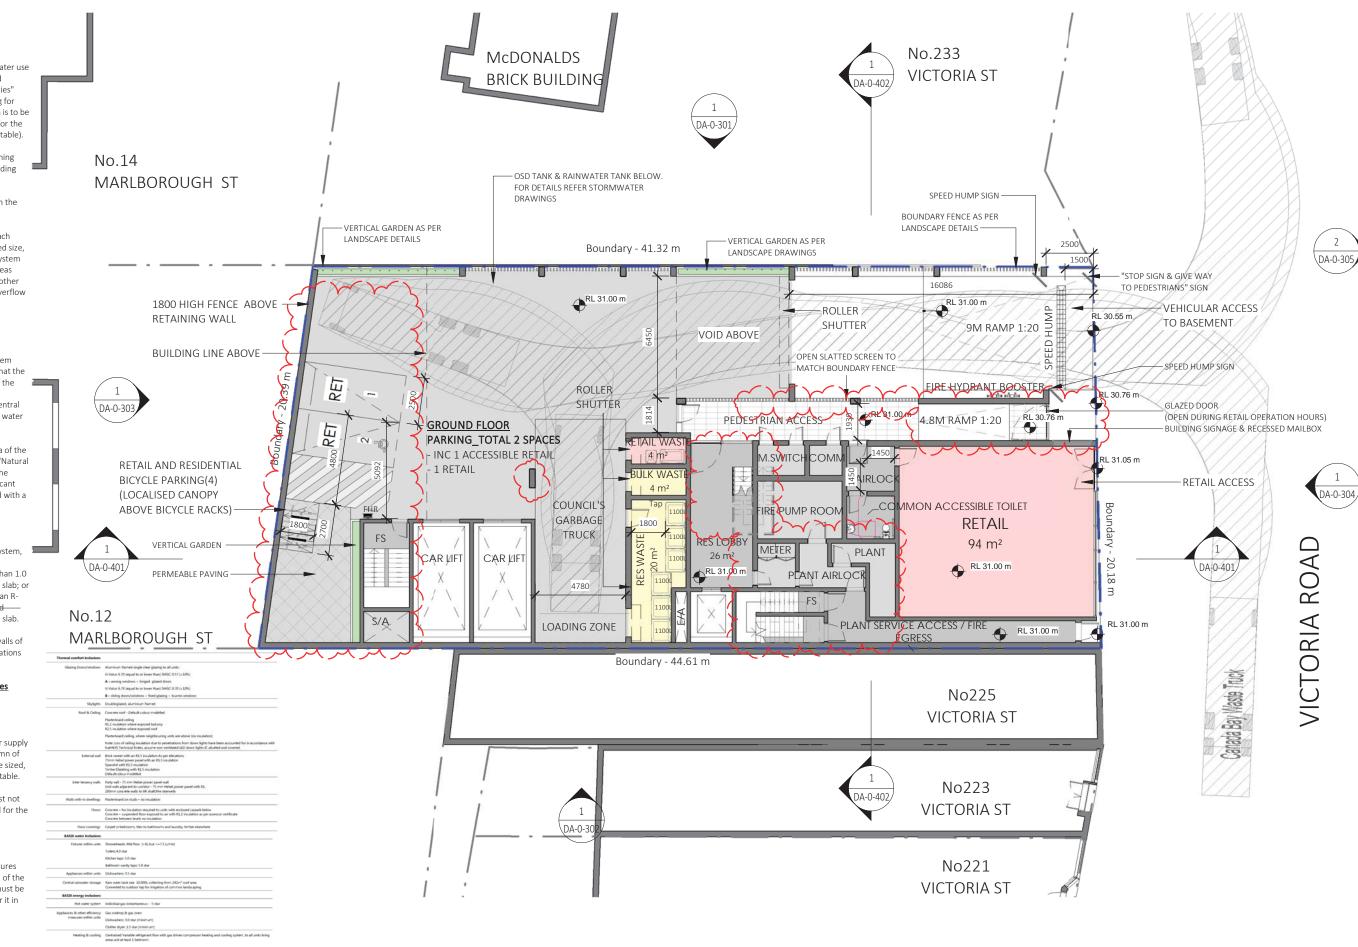

Dickson Rothschild D.R. Design (NSW) Pty. Ltd. 9 Argyle Place, Millers Point, Sydney, NSW 2000 ABN: 35 134 237 540

Phone: +61 2 8540 8720 ndickson@dicksonrothschild.com.au www.dicksonrothschild.com.au Nominated Architect: Robert Nigel Dickson Registration No: 5364

This drawing and design is subject to D.R. Design (NSW) Pty Ltd copyright and may not be reproduced without prior written consent. Contractor to verify all dimensions on site before commencing work. Resolve all discrepancies with the Architect before proceeding. Figured dimensions to be taken in preference to scaled drawings. All work is to conform to relevant Australian Standards and other Codes as applicable, together with other Authorities' requirements and regulations.

	REV	DESCRIPTION	DATE	ISSUED	CHECK
	Α	ISSUE FOR DA	28/10/2016	NT	AC
	В	AMENDED AS PER COUNCIL RFI	10/04/2016	MC	AC
5					



DRUMMOYNE **GROUND FLOOR PLAN** 227 - 231 VICTORIA ROAD J. BARTOLOTTA

DEVELOPMENT APPLICATION

15-030 DA-0-202 27/06/2016 MC,RD AC 1:200 SCALE 1:200



#### (a) Dwellings

#### (i) Water:

(b) The applicant must plant indigenous or low water use species of vegetation throughout the area of land specified for the dwelling in the "Indigenous species" column of the table below, as private landscaping for that dwelling. (This area of indigenous vegetation is to be contained within the "Area of garden and lawn" for the dwelling specified in the "Description of Project" table).

(e) The applicant must not install a private swimming pool or spa for the dwelling, with a volume exceeding that specified for it in the table below.

(g) The pool or spa must be located as specified in the

(h) The applicant must install, for the dwelling, each alternative water supply system, with the specified size, listed for that dwelling in the table below. Each system must be configured to collect run-off from the areas specified (excluding any area which supplies any other alternative water supply system), and to divert overflow as specified. Each system must be connected as specified.

#### (ii) Energy:

(b) The applicant must install each hot water system specified for the dwelling in the table below, so that the dwelling's hot water is supplied by that system. If the table specifies a central hot water system for the dwelling, then the applicant must connect that central system to the dwelling, so that the dwelling's hot water is supplied by that central system.

(f) This commitment applies to each room or area of the dwelling which is referred to in a heading to the "Natural lighting" column of the table below (but only to the extent specified for that room or area). The applicant must ensure that each such room or area is fitted with a window and/or skylight.

#### (iii) Thermal Comfort;

(g) Where there is an in-slab heating or cooling system, the applicant must:

(aa) Install insulation with an R-value of not less than 1.0\_around the vertical each of the perimeter of the slab; or (bb) On a suspended floor, install insulation with an R-value of not less than 1.0 underneath the slab and around the vertical league 90 by he perimeter of the slab.

(h) The applicant must construct the floors and walls of the development in accordance with the specifications listed in the table below.

#### (b) Common areas and central systems/facilities


#### (i) Water:

(b) The applicant must install (or ensure that the development is serviced by) the alternative water supply system(s) specified in the "Central systems" column of the table below. In each case, the system must be sized, be configured, and be connected, as specified in table.

(c) A swimming pool or spa listed in the table must not have a volume in (kLs) greater than that specified for the pool or spa in the table.

#### (ii) Energy:

(c) The applicant must install the systems and fixtures specified in the "Central energy systems" column of the table below. In each case, the system of fixture must be of the type, and meet the specifications, listed for it in the table.

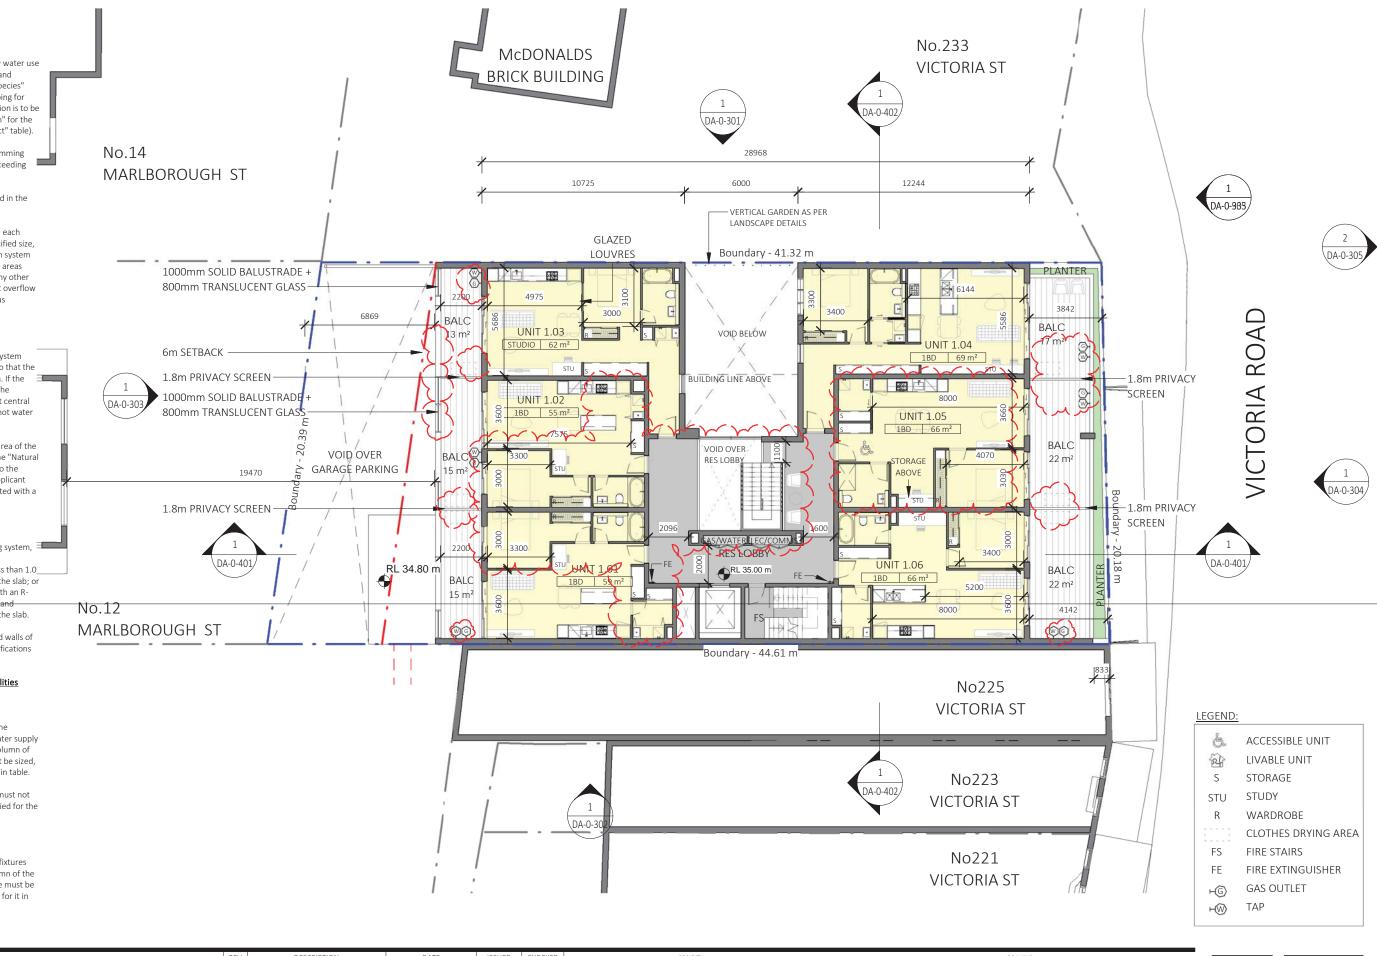

Dickson Rothschild D.R. Design (NSW) Pty. Ltd. 9 Argyle Place, Millers Point, Sydney, NSW 2000 ABN: 35 134 237 540 Phone: +61 2 8540 8720 ndickson@dicksonrothschild.com.au www.dicksonrothschild.com.au Nominated Architect: Robert Nigel Dickson Registration No: 5364

This drawing and design is subject to D.R. Design (NSW) Pty Ltd copyright and may not be reproduced without prior written consent. Contractor to verify all dimensions on site before commencing work. Resolve all discrepancies with the Architect before proceeding. Figured dimensions to be taken in preference to scaled drawings. All work is to conform to relevant Australian Standards and other Codes as applicable, together with other Authorities' requirements and regulations.

F	REV	DESCRIPTION	DATE	ISSUED	CHECKE
	Α	ISSUE FOR DA	28/10/2016	NT	AC
	В	AMENDED AS PER COUNCIL RFI	10/04/2016	MC	AC



DRUMMOYNE

227 - 231 VICTORIA ROAD

CLIENT

J. BARTOLOTTA

DEVELOPMENT APPLICATION

PROJECT NO. DRAWING NO. REVISION DATE
15-030 DA-0-203 B 27/00

PROJECT NO. DRAWING NO. REVISION DATE

15-030 DA-0-203 B 27/06/2016

SCALE @ A3 DRAWN AUTHORISED

1:200 MC,RD AC

SCALE 1:200 10m



#### (a) <u>Dwellings</u>

#### (i) Water:

(b) The applicant must plant indigenous or low water use species of vegetation throughout the area of land specified for the dwelling in the "Indigenous species" column of the table below, as private landscaping for that dwelling. (This area of indigenous vegetation is to be contained within the "Area of garden and lawn" for the dwelling specified in the "Description of Project" table).

(e) The applicant must not install a private swimming pool or spa for the dwelling, with a volume exceeding that specified for it in the table below.

(g) The pool or spa must be located as specified in the table.

(h) The applicant must install, for the dwelling, each alternative water supply system, with the specified size, listed for that dwelling in the table below. Each system must be configured to collect run-off from the areas specified (excluding any area which supplies any other alternative water supply system), and to divert overflow as specified. Each system must be connected as specified.

#### (ii) Energy:

(b) The applicant must install each hot water system specified for the dwelling in the table below, so that the dwelling's hot water is supplied by that system. If the table specifies a central hot water system for the dwelling, then the applicant must connect that central system to the dwelling, so that the dwelling's hot water is supplied by that central system.

(f) This commitment applies to each room or area of the dwelling which is referred to in a heading to the "Natural lighting" column of the table below (but only to the extent specified for that room or area). The applicant must ensure that each such room or area is fitted with a window and/or skylight.

#### (iii) Thermal Comfort;

(g) Where there is an in-slab heating or cooling system, the applicant must:

(aa) Install insulation with an R-value of not less than 1.0 around the vertical edges withe perimeter of the slab; or (bb) On a suspender floog install insulation with an R-value of not less than 1.0 under the slab and around the vertical edges of 98 perimeter of the slab.

(h) The applicant must construct the floors and walls of the development in accordance with the specifications listed in the table below.

#### (b) Common areas and central systems/facilities


#### (i) Water:

(b) The applicant must install (or ensure that the development is serviced by) the alternative water supply system(s) specified in the "Central systems" column of the table below. In each case, the system must be sized, be configured, and be connected, as specified in table.

(c) A swimming pool or spa listed in the table must not have a volume in (kLs) greater than that specified for the pool or spa in the table.

#### (ii) Energy:

(c) The applicant must install the systems and fixtures specified in the "Central energy systems" column of the table below. In each case, the system of fixture must be of the type, and meet the specifications, listed for it in

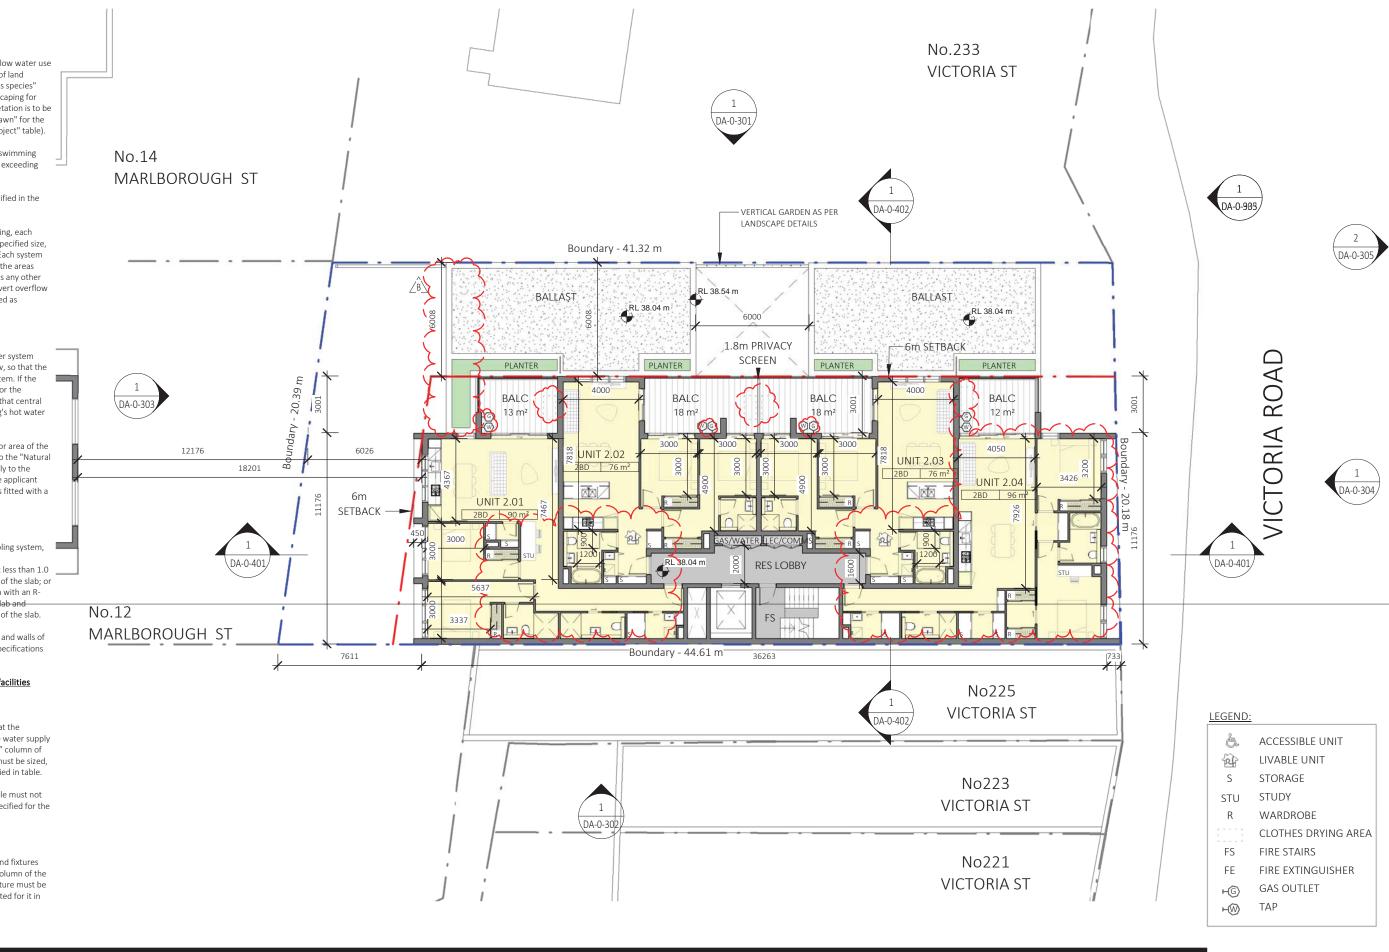

Dickson Rothschild D.R. Design (NSW) Pty. Ltd. 9 Argyle Place, Millers Point, Sydney, NSW 2000 ABN: 35 134 237 540 Phone: +61 2 8540 8720 ndickson@dicksonrothschild.com.au www.dicksonrothschild.com.au Nominated Architect: Robert Nigel Dickson Registration No: 5364

This drawing and design is subject to D.R. Design (NSW) Pty Ltd copyright and may not be reproduced without prior written consent. Contractor to verify all dimensions on site before commencing work. Resolve all discrepancies with the Architect before proceeding. Figured dimensions to be taken in preference to scaled drawings. All work is to conform to relevant Australian Standards and other Codes as applicable, together with other Authorities' requirements and regulations.

REV	DESCRIPTION	DATE	ISSUED	CHECKED
Α	ISSUE FOR DA	28/10/2016	NT	AC
В	AMENDED AS PER COUNCIL RFI	10/04/2016	MC	AC



DRUMMOYNE

227 - 231 VICTORIA ROAD

CLIENT

J. BARTOLOTTA

DEVELOPMENT APPLICATION



PROJECT NO. DRAWING NO. REVISION DATE

15-030 DA-0-204 B 27/06/2016

SCALE @ A3

1:200 DRAWN AUTHORISED

MC,RD AC

( SCALE 1:200 10



#### (a) <u>Dwellings</u>

#### (i) Water:

(b) The applicant must plant indigenous or low water use species of vegetation throughout the area of land specified for the dwelling in the "Indigenous species" column of the table below, as private landscaping for that dwelling. (This area of indigenous vegetation is to be contained within the "Area of garden and lawn" for the dwelling specified in the "Description of Project" table).

(e) The applicant must not install a private swimming pool or spa for the dwelling, with a volume exceeding that specified for it in the table below.

(g) The pool or spa must be located as specified in the

(h) The applicant must install, for the dwelling, each alternative water supply system, with the specified size, listed for that dwelling in the table below. Each system must be configured to collect run-off from the areas specified (excluding any area which supplies any other alternative water supply system), and to divert overflow as specified. Each system must be connected as specified.

#### (ii) Energy:

(b) The applicant must install each hot water system specified for the dwelling in the table below, so that the dwelling's hot water is supplied by that system. If the table specifies a central hot water system for the dwelling, then the applicant must connect that central system to the dwelling, so that the dwelling's hot water is supplied by that central system.

(f) This commitment applies to each room or area of the dwelling which is referred to in a heading to the "Natural lighting" column of the table below (but only to the extent specified for that room or area). The applicant must ensure that each such room or area is fitted with a window and/or skylight.

#### (iii) Thermal Comfort;

(g) Where there is an in-slab heating or cooling system, the applicant must:

(aa) Install insulation with an R-value of not less than 1.0 around the vertical edges of the perimeter of the slab; or (bb) On a suspended floor 3 install insulation with an R-value of not less than 1.0 underneath the slab and around the vertical expersions.

(h) The applicant must construct the floors and walls of the development in accordance with the specifications listed in the table below.

#### (b) Common areas and central systems/facilities


#### (i) Water:

(b) The applicant must install (or ensure that the development is serviced by) the alternative water supply system(s) specified in the "Central systems" column of the table below. In each case, the system must be sized, be configured, and be connected, as specified in table.

(c) A swimming pool or spa listed in the table must not have a volume in (kLs) greater than that specified for the pool or spa in the table.

#### (ii) Energy:

(c) The applicant must install the systems and fixtures specified in the "Central energy systems" column of the table below. In each case, the system of fixture must be of the type, and meet the specifications, listed for it in the table.

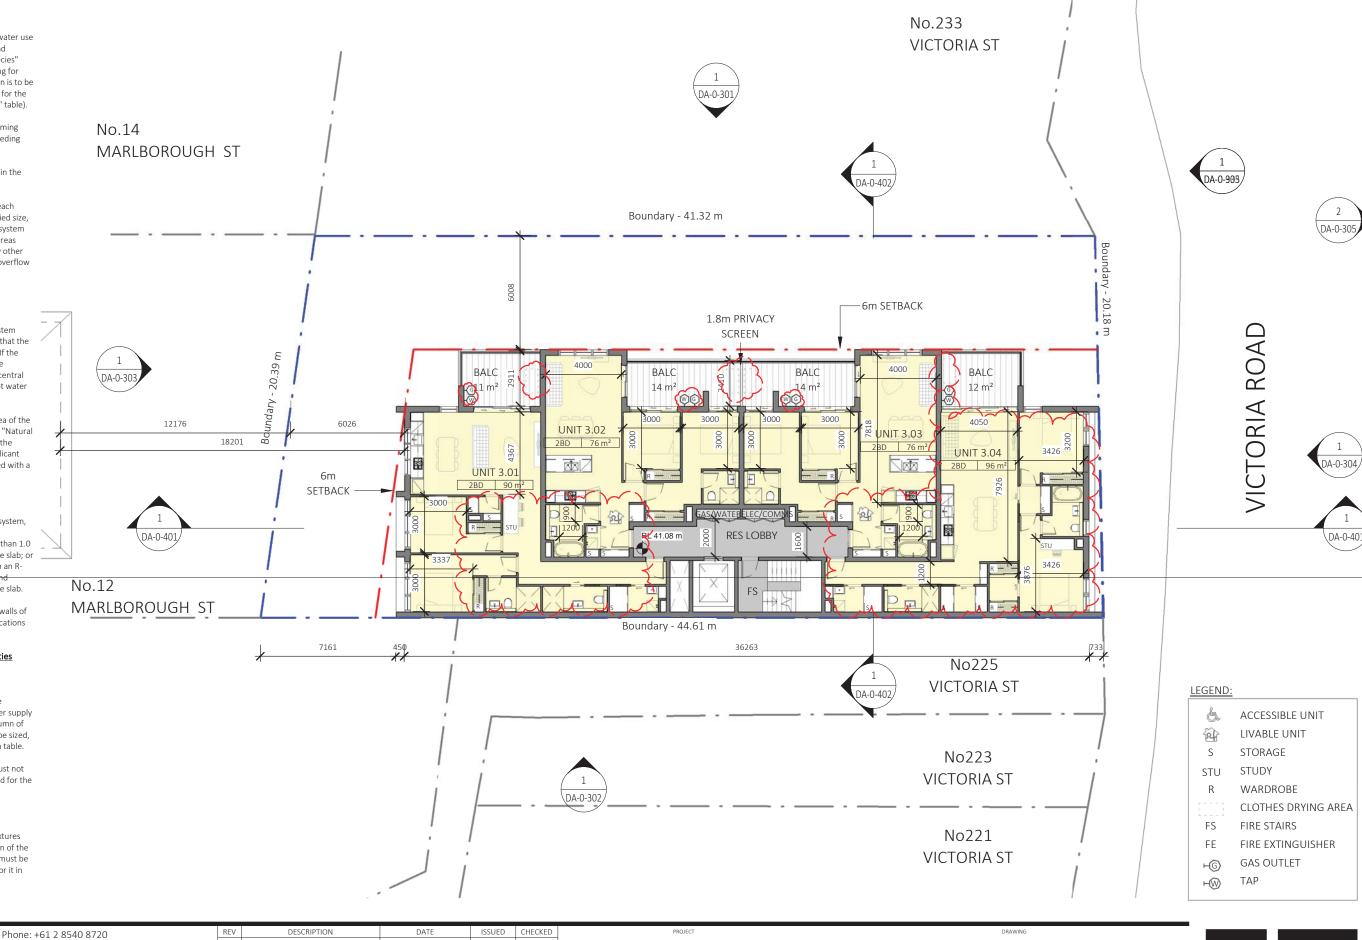

Dickson Rothschild D.R. Design (NSW) Pty. Ltd. 9 Argyle Place, Millers Point, Sydney, NSW 2000 ABN: 35 134 237 540 Phone: +61 2 8540 8720 ndickson@dicksonrothschild.com.au www.dicksonrothschild.com.au Nominated Architect: Robert Nigel Dickson Registration No: 5364

This drawing and design is subject to D.R. Design (NSW) Pty Ltd copyright and may not be reproduced without prior written consent. Contractor to verify all dimensions on site before commencing work. Resolve all discrepancies with the Architect before proceeding. Figured dimensions to be taken in preference to scaled drawings. All work is to conform to relevant Australian Standards and other Codes as applicable, together with other Authorities' requirements and regulations.

REV	DESCRIPTION	DATE	ISSUED	CHECKE
Α	ISSUE FOR DA	28/10/2016	NT	AC
В	AMENDED AS PER COUNCIL RFI	10/04/2016	MC	AC



DRUMMOYNE

LE

227 - 231 VICTORIA ROAD

CLIENT

J. BARTOLOTTA

DRAY

PROJECT

SCAL

1

DEVELOPMENT APPLICATION

LEVEL 3 FLOOR PLAN

PROJECT NO. DRAWING NO. REVISION DATE

15-030 DA-0-205 B 27/06/2016

SCALE @ A3

1:200 DRAWN AUTHORISED

MC,RD AC

SCALE 1:200 10



#### (a) Dwellings

#### (i) Water:

(b) The applicant must plant indigenous or low water use species of vegetation throughout the area of land specified for the dwelling in the "Indigenous species" column of the table below, as private landscaping for that dwelling. (This area of indigenous vegetation is to be contained within the "Area of garden and lawn" for the dwelling specified in the "Description of Project" table).

(e) The applicant must not install a private swimming pool or spa for the dwelling, with a volume exceeding that specified for it in the table below.

(g) The pool or spa must be located as specified in the

(h) The applicant must install, for the dwelling, each alternative water supply system, with the specified size, listed for that dwelling in the table below. Each system must be configured to collect run-off from the areas specified (excluding any area which supplies any other alternative water supply system), and to divert overflow as specified. Each system must be connected as specified.

#### (ii) Energy:

(b) The applicant must install each hot water system specified for the dwelling in the table below, so that the dwelling's hot water is supplied by that system. If the table specifies a central hot water system for the dwelling, then the applicant must connect that central system to the dwelling, so that the dwelling's hot water is supplied by that central system.

(f) This commitment applies to each room or area of the dwelling which is referred to in a heading to the "Natural lighting" column of the table below (but only to the extent specified for that room or area). The applicant must ensure that each such room or area is fitted with a window and/or skylight.

#### (iii) Thermal Comfort;

(g) Where there is an in-slab heating or cooling system, the applicant must: (aa) Install insulation with an R-value of not less than 1.0

around the vertical edge of the perimeter of the slab; or (bb) On a suspended floor stall insulation with an Rvalue of not less han 1.0 under seath the slab and around the vertical DAges 905 the perimeter of the slab. No.12

the development in accordance with the specifications listed in the table below

#### (b) Common areas and central systems/facilities


#### (i) Water:

(b) The applicant must install (or ensure that the development is serviced by) the alternative water supply system(s) specified in the "Central systems" column of the table below. In each case, the system must be sized, be configured, and be connected, as specified in table.

(c) A swimming pool or spa listed in the table must not have a volume in (kLs) greater than that specified for the pool or spa in the table

#### (ii) Energy:

(c) The applicant must install the systems and fixtures specified in the "Central energy systems" column of the table below. In each case, the system of fixture must be of the type, and meet the specifications, listed for it in

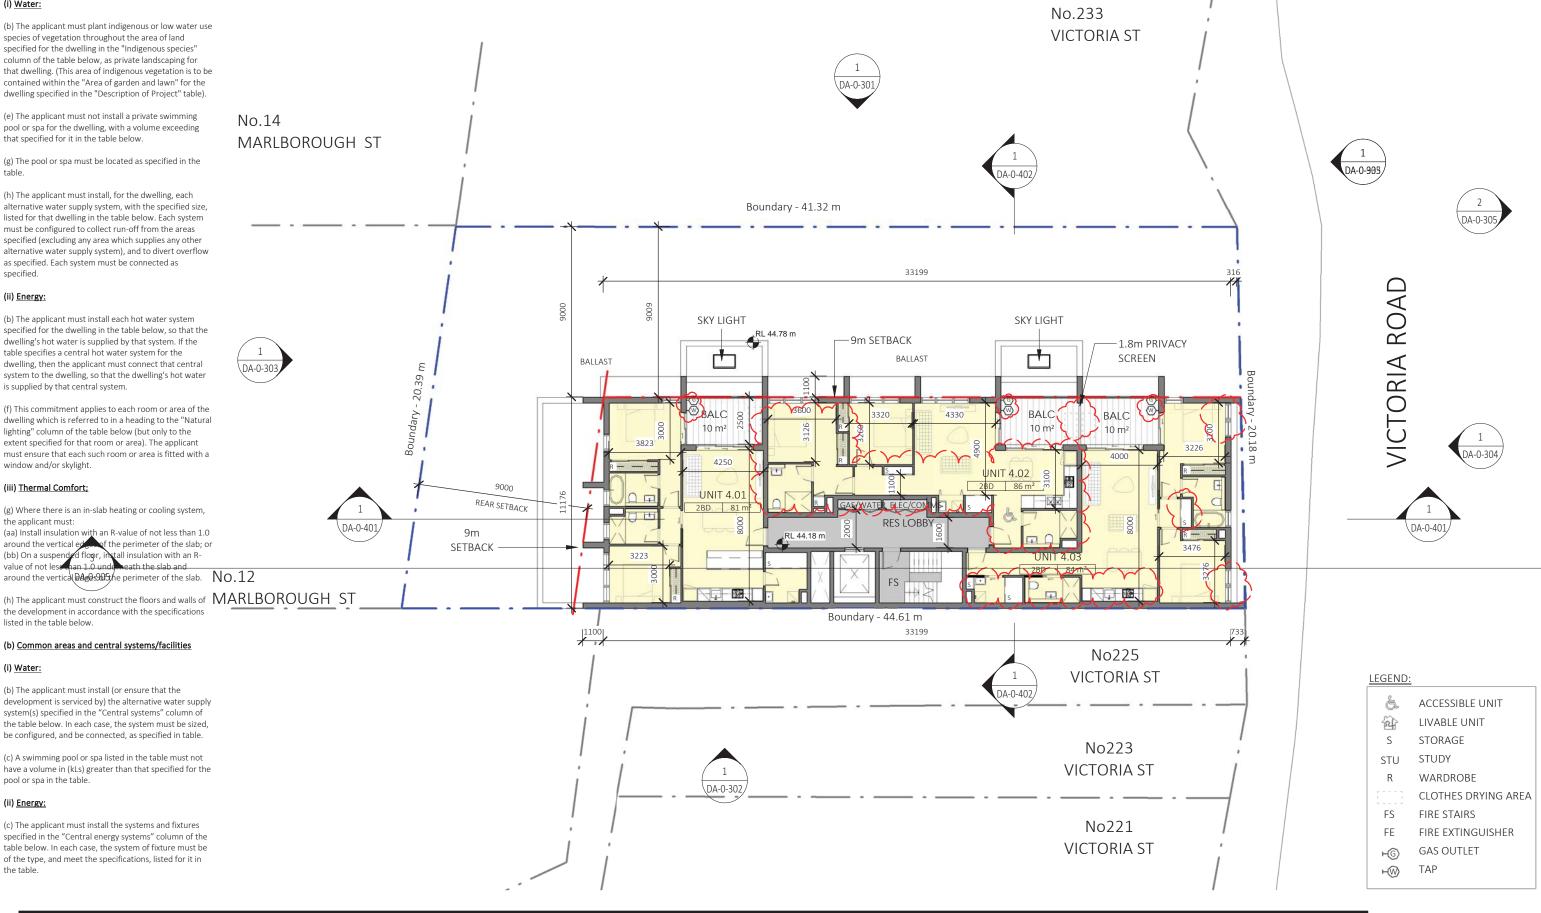

Dickson Rothschild D.R. Design (NSW) Pty. Ltd. 9 Argyle Place, Millers Point, Sydney, NSW 2000 ABN: 35 134 237 540

Phone: +61 2 8540 8720 ndickson@dicksonrothschild.com.au www.dicksonrothschild.com.au Nominated Architect: Robert Nigel Dickson Registration No: 5364

This drawing and design is subject to D.R. Design (NSW) Pty Ltd copyright and may not be reproduced without prior written consent. Contractor to verify all dimensions on site before commencing work. Resolve all discrepancies with the Architect before proceeding. Figured dimensions to be taken in preference to scaled drawings. All work is to conform to relevant Australian Standards and other Codes as applicable, together with other Authorities' requirements and regulations.

REV	DESCRIPTION	DATE	ISSUED	CHECKE
Α	ISSUE FOR DA	28/10/2016	NT	AC
В	AMENDED AS PER COUNCIL RFI	10/04/2016	MC	AC



DRUMMOYNE 227 - 231 VICTORIA ROAD J. BARTOLOTTA

DEVELOPMENT APPLICATION

LEVEL 4 FLOOR PLAN

15-030 DA-0-206 27/06/2016 MC,RD AC 1:200 SCALE 1:200



#### (a) Dwellings

#### (i) Water:

- (b) The applicant must plant indigenous or low water use species of vegetation throughout the area of land specified for the dwelling in the "Indigenous species" column of the table below, as private landscaping for that dwelling. (This area of indigenous vegetation is to be contained within the "Area of garden and lawn" for the dwelling specified in the "Description of Project" table).
- (e) The applicant must not install a private swimming pool or spa for the dwelling, with a volume exceeding that specified for it in the table below.
- (g) The pool or spa must be located as specified in the
- (h) The applicant must install, for the dwelling, each alternative water supply system, with the specified size, listed for that dwelling in the table below. Each system must be configured to collect run-off from the areas specified (excluding any area which supplies any other alternative water supply system), and to divert overflow as specified. Each system must be connected as specified.

#### (ii) Energy:

- (b) The applicant must install each hot water system specified for the dwelling in the table below, so that the dwelling's hot water is supplied by that system. If the table specifies a central hot water system for the dwelling, then the applicant must connect that central system to the dwelling, so that the dwelling's hot water is supplied by that central system.
- (f) This commitment applies to each room or area of the dwelling which is referred to in a heading to the "Natural lighting" column of the table below (but only to the extent specified for that room or area). The applicant must ensure that each such room or area is fitted with a window and/or skylight.

#### (iii) Thermal Comfort;

- (g) Where there is an in-slab heating or cooling system, the applicant must:
- (aa) Install insulation with an R-value of not less than 1.0 around the vertical edges of the perimeter of the slab; or (bb) On a suspended file install insulation with an R-value of not less than 1.9 underneath the slab and around the vertical edges of the perimeter of the slab.

  \[ \DA-0-905\]
- (h) The applicant must construct the floors and walls of the development in accordance with the specifications listed in the table below.

#### (b) Common areas and central systems/facilities

#### (i) Water:

- (b) The applicant must install (or ensure that the development is serviced by) the alternative water supply system(s) specified in the "Central systems" column of the table below. In each case, the system must be sized, be configured, and be connected, as specified in table.
- (c) A swimming pool or spa listed in the table must not have a volume in (kLs) greater than that specified for the pool or spa in the table.

#### (ii) Energy:

(c) The applicant must install the systems and fixtures specified in the "Central energy systems" column of the table below. In each case, the system of fixture must be of the type, and meet the specifications, listed for it in the table



Dickson Rothschild D.R. Design (NSW) Pty. Ltd. 9 Argyle Place, Millers Point, Sydney, NSW 2000 ABN: 35 134 237 540 Phone: +61 2 8540 8720 ndickson@dicksonrothschild.com.au www.dicksonrothschild.com.au Nominated Architect: Robert Nigel Dickson Registration No: 5364

This drawing and design is subject to D.R. Design (NSW) Pty Ltd copyright and may not be reproduced without prior written consent. Contractor to verify all dimensions on site before commencing work. Resolve all discrepancies with the Architect before proceeding. Figured dimensions to be taken in preference to scaled drawings. All work is to conform to relevant Australian Standards and other Codes as applicable, together with other Authorities' requirements and regulations.

REV	DESCRIPTION	DATE	ISSUED	CHECKED
Α	ISSUE FOR DA	28/10/2016	NT	AC
В	AMENDED AS PER COUNCIL RFI	10/04/2016	MC	AC



| PROJECT NO. DRAWING NO. REVISION DATE | 15-030 DA-0-207 B 27/06/2016 | SCALE @ A3 DRAWN AUTHORISED | 1: 200 MC,RD AC

SCALE 1:200



#### (a) Dwellings

#### (i) Water:

- (b) The applicant must plant indigenous or low water use species of vegetation throughout the area of land specified for the dwelling in the "Indigenous species" column of the table below, as private landscaping for that dwelling. (This area of indigenous vegetation is to be contained within the "Area of garden and lawn" for the dwelling specified in the "Description of Project" table).
- (e) The applicant must not install a private swimming pool or spa for the dwelling, with a volume exceeding that specified for it in the table below.
- (g) The pool or spa must be located as specified in the
- (h) The applicant must install, for the dwelling, each alternative water supply system, with the specified size, listed for that dwelling in the table below. Each system must be configured to collect run-off from the areas specified (excluding any area which supplies any other alternative water supply system), and to divert overflow as specified. Each system must be connected as specified.

#### (ii) Energy:

- (b) The applicant must install each hot water system specified for the dwelling in the table below, so that the dwelling's hot water is supplied by that system. If the table specifies a central hot water system for the dwelling, then the applicant must connect that central system to the dwelling, so that the dwelling's hot water is supplied by that central system.
- (f) This commitment applies to each room or area of the dwelling which is referred to in a heading to the "Natural lighting" column of the table below (but only to the extent specified for that room or area). The applicant must ensure that each such room or area is fitted with a window and/or skylight.

#### (iii) Thermal Comfort;

(g) Where there is an in-slab heating or cooling system, the applicant must:
(aa) Install insulation is than R-value of not less than 1.0 around the vertical edges of the perimeter of the slab; or (bb) On a suspended floor, in tall insulation with an R-value of not less than 0.2005/derneath the slab and around the vertical edges of the perimeter of the slab.

(h) The applicant must construct the floors and walls of the development in accordance with the specifications listed in the table below.


#### (b) Common areas and central systems/facilities

#### (i) Water:

- (b) The applicant must install (or ensure that the development is serviced by) the alternative water supply system(s) specified in the "Central systems" column of the table below. In each case, the system must be sized, be configured, and be connected, as specified in table.
- (c) A swimming pool or spa listed in the table must not have a volume in (kLs) greater than that specified for the pool or spa in the table.

#### (ii) Energy:

(c) The applicant must install the systems and fixtures specified in the "Central energy systems" column of the table below. In each case, the system of fixture must be of the type, and meet the specifications, listed for it in the table

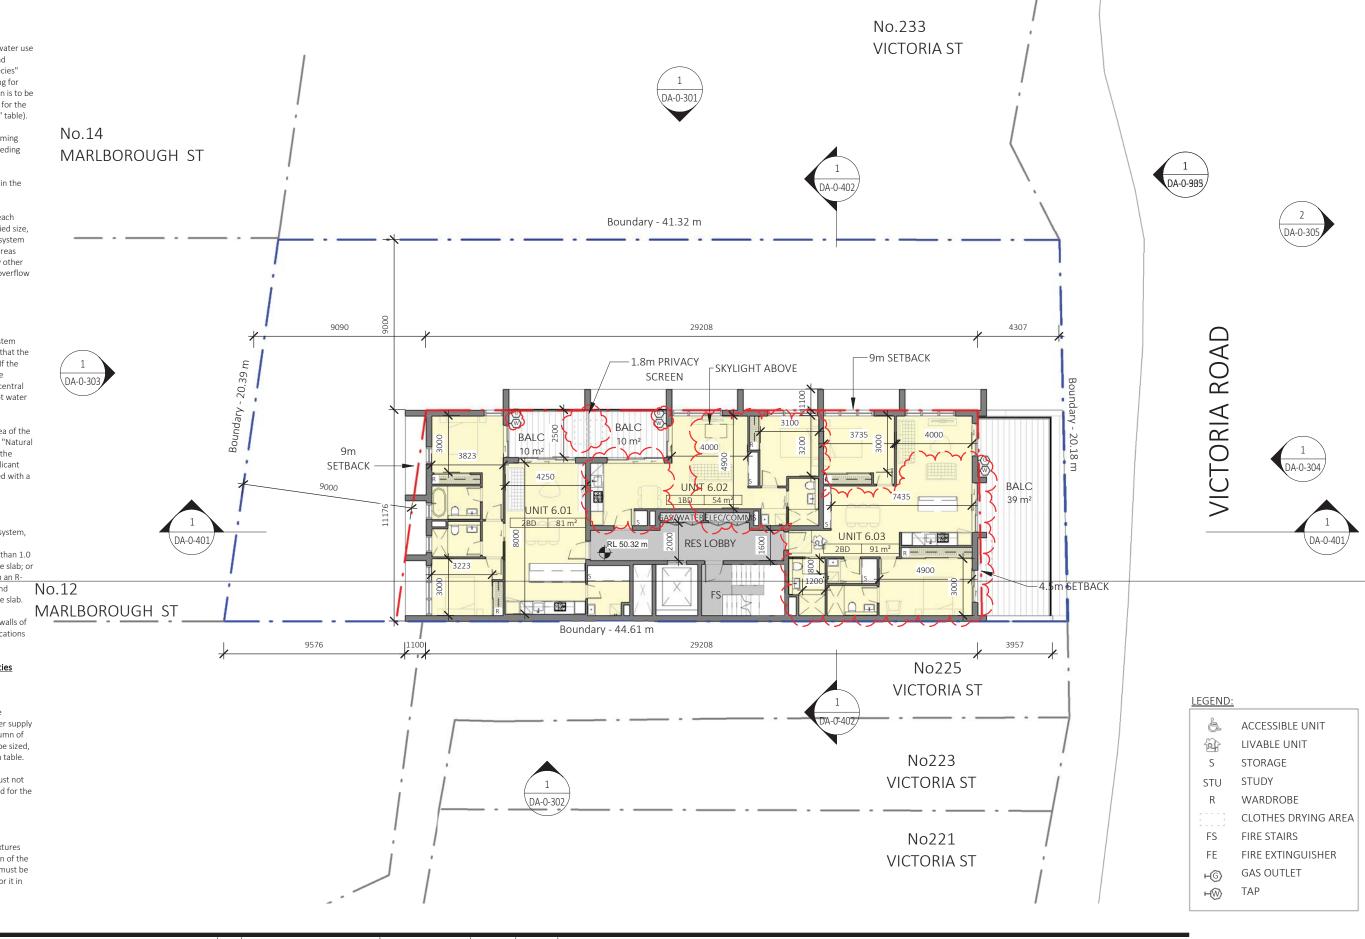

Dickson Rothschild D.R. Design (NSW) Pty. Ltd. 9 Argyle Place, Millers Point, Sydney, NSW 2000 ABN: 35 134 237 540 Phone: +61 2 8540 8720 ndickson@dicksonrothschild.com.au www.dicksonrothschild.com.au Nominated Architect: Robert Nigel Dickson Registration No: 5364

This drawing and design is subject to D.R. Design (NSW) Pty Ltd copyright and may not be reproduced without prior written consent. Contractor to verify all dimensions on site before commencing work. Resolve all discrepancies with the Architect before proceeding. Figured dimensions to be taken in preference to scaled drawings. All work is to conform to relevant Australian Standards and other Codes as applicable, together with other Authorities' requirements and regulations.

	IVE	DESCRIPTION	DAIL	1330ED	CHILCKLE
	Α	ISSUE FOR DA	28/10/2016	NT	AC
	В	AMENDED AS PER COUNCIL RFI	10/04/2016	MC	AC
5					



DRUMMOYNE

LE

227 - 231 VICTORIA ROAD

CUENT

J. BARTOLOTTA

DRA

DRA

DRA

PROJECT

SCA

1

DEVELOPMENT APPLICATION

PROJECT NO. DRAWING NO. REVISION D



#### (a) <u>Dwellings</u>

# (i) Water:

(b) The applicant must plant indigenous or low water use species of vegetation throughout the area of land specified for the dwelling in the "Indigenous species" column of the table below, as private landscaping for that dwelling. (This area of indigenous vegetation is to be contained within the "Area of garden and lawn" for the dwelling specified in the "Description of Project" table).

(e) The applicant must not install a private swimming pool or spa for the dwelling, with a volume exceeding that specified for it in the table below.

(g) The pool or spa must be located as specified in the table.

(h) The applicant must install, for the dwelling, each alternative water supply system, with the specified size, listed for that dwelling in the table below. Each system must be configured to collect run-off from the areas specified (excluding any area which supplies any other alternative water supply system), and to divert overflow as specified. Each system must be connected as specified.

#### (ii) Energy:

(b) The applicant must install each hot water system specified for the dwelling in the table below, so that the dwelling's hot water is supplied by that system. If the table specifies a central hot water system for the dwelling, then the applicant must connect that central system to the dwelling, so that the dwelling's hot water is supplied by that central system.

(f) This commitment applies to each room or area of the dwelling which is referred to in a heading to the "Natural lighting" column of the table below (but only to the extent specified for that room or area). The applicant must ensure that each such room or area is fitted with a window and/or skylight.

#### (iii) Thermal Comfort;

(g) Where there is an in-slab heating or cooling system, the applicant must:
(aa) Install insulation with an R-value of nothers than 1.

around the vertical edges of the parimeter of the slab; or (bb) On a suspended floor, install insulation with an No.12 value of not less than 1.0 underneath the slab and around the vertical edges of the perimeter of the slab MARLBOROUGH ST

(h) The applicant must construct the floors and walls of the development in accordance with the specifications listed in the table below.

#### (b) Common areas and central systems/facilities


#### (i) Water:

(b) The applicant must install (or ensure that the development is serviced by) the alternative water supply system(s) specified in the "Central systems" column of the table below. In each case, the system must be sized, be configured, and be connected, as specified in table.

(c) A swimming pool or spa listed in the table must not have a volume in (kLs) greater than that specified for the pool or spa in the table.

#### (ii) Energy:

(c) The applicant must install the systems and fixtures specified in the "Central energy systems" column of the table below. In each case, the system of fixture must be of the type, and meet the specifications, listed for it in the table

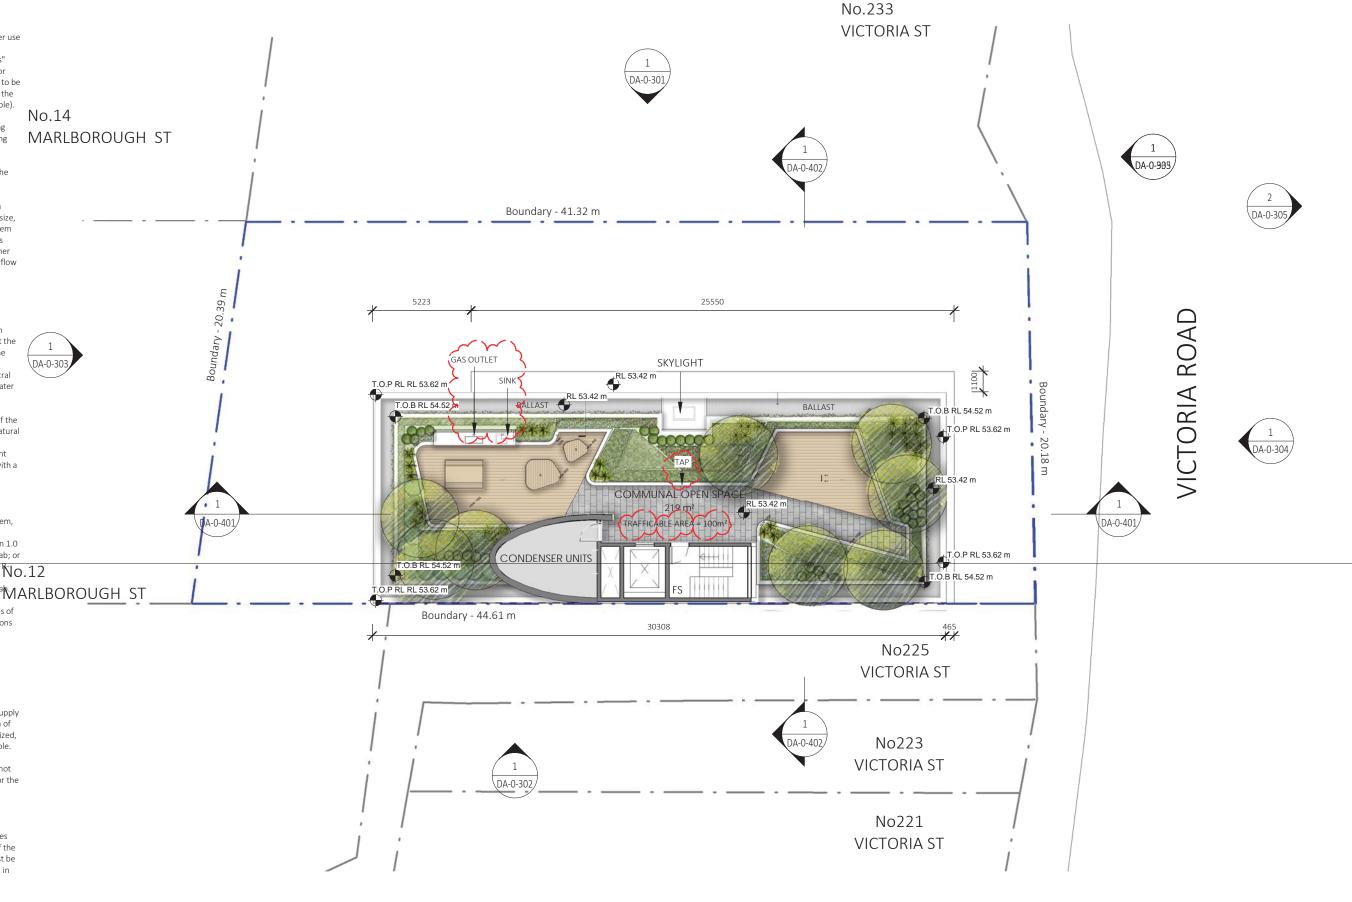

Dickson Rothschild
D.R. Design (NSW) Pty. Ltd.
9 Argyle Place,
Millers Point, Sydney, NSW 2000
ABN: 35 134 237 540

Phone: +61 2 8540 8720 ndickson@dicksonrothschild.com.au www.dicksonrothschild.com.au Nominated Architect: Robert Nigel Dickson Registration No: 5364

This drawing and design is subject to D.R. Design (NSW) Pty Ltd copyright and may not be reproduced without prior written consent. Contractor to verify all dimensions on site before commencing work. Resolve all discrepancies with the Architect before proceeding. Figured dimensions to be taken in preference to scaled drawings. All work is to conform to relevant Australian Standards and other Codes as applicable, together with other Authorities' requirements and regulations.

IVEV	DESCRIPTION	DAIL	1330ED	CHILCKED
Α	ISSUE FOR DA	28/10/2016	NT	AC
В	AMENDED AS PER COUNCIL RFI	10/04/2016	MC	AC



DRAWING
CON
PROJECT
15-0
SCALE @ 1:2



#### (a) <u>Dwellings</u>

#### (i) Water:

(b) The applicant must plant indigenous or low water use species of vegetation throughout the area of land specified for the dwelling in the "Indigenous species" column of the table below, as private landscaping for that dwelling. (This area of indigenous vegetation is to be contained within the "Area of garden and lawn" for the dwelling specified in the "Description of Project" table).

(e) The applicant must not install a private swimming pool or spa for the dwelling, with a volume exceeding that specified for it in the table below.

(g) The pool or spa must be located as specified in the table.

(h) The applicant must install, for the dwelling, each alternative water supply system, with the specified size, listed for that dwelling in the table below. Each system must be configured to collect run-off from the areas specified (excluding any area which supplies any other alternative water supply system), and to divert overflow as specified. Each system must be connected as specified.

#### (ii) Energy:

(b) The applicant must install each hot water system specified for the dwelling in the table below, so that the dwelling's hot water is supplied by that system. If the table specifies a central hot water system for the dwelling, then the applicant must connect that central system to the dwelling, so that the dwelling's hot water is supplied by that central system.

(f) This commitment applies to each room or area of the dwelling which is referred to in a heading to the "Natural lighting" column of the table below (but only to the extent specified for that room or area). The applicant must ensure that each such room or area is fitted with a window and/or skylight.

#### (iii) Thermal Comfort;

(g) Where there is an in-slab heating or cooling system, the applicant must:

(aa) Install insulation with an R-value of not less than 1.0 around the vertical edges of the perimeter of the ship; or (bb) On a suspended floor, install insulation with an R-value of not less than 1.0 underneath the slat and  $\frac{3}{3}$  around the vertical edges of the perimeter of the slat and  $\frac{3}{3}$  around the vertical edges of the perimeter of the slat and  $\frac{3}{3}$  around the ver

(h) The applicant must construct the floors and walls of the development in accordance with the specifications listed in the table below.

#### (b) Common areas and central systems/facilities


#### (i) Water:

(b) The applicant must install (or ensure that the development is serviced by) the alternative water supply system(s) specified in the "Central systems" column of the table below. In each case, the system must be sized, be configured, and be connected, as specified in table.

(c) A swimming pool or spa listed in the table must not have a volume in (kLs) greater than that specified for the pool or spa in the table.

#### (ii) Energy:

(c) The applicant must install the systems and fixtures specified in the "Central energy systems" column of the table below. In each case, the system of fixture must be of the type, and meet the specifications, listed for it in

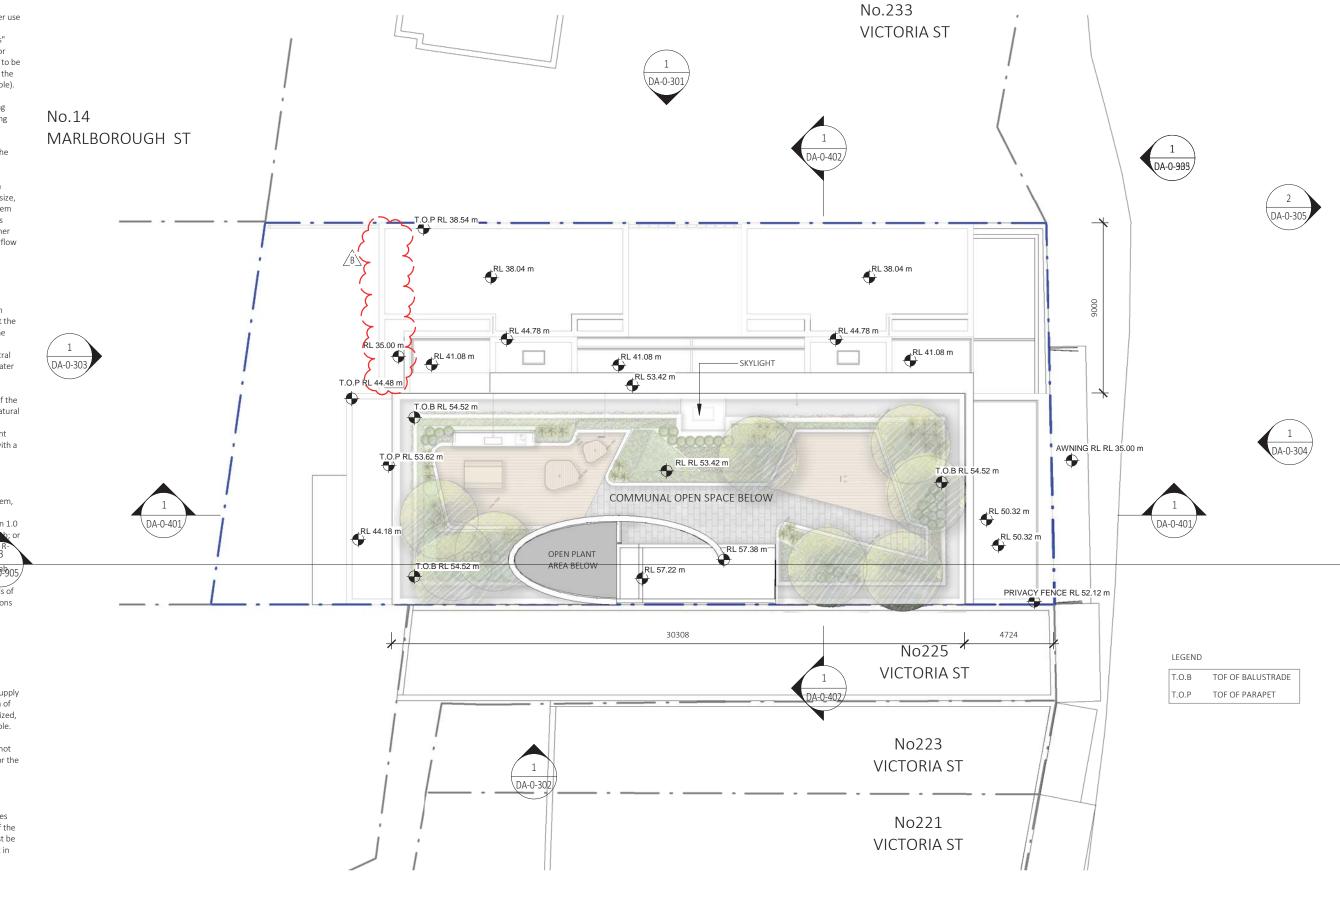

Dickson Rothschild D.R. Design (NSW) Pty. Ltd. 9 Argyle Place, Millers Point, Sydney, NSW 2000 ABN: 35 134 237 540 Phone: +61 2 8540 8720 ndickson@dicksonrothschild.com.au www.dicksonrothschild.com.au Nominated Architect: Robert Nigel Dickson Registration No: 5364

This drawing and design is subject to D.R. Design (NSW) Pty Ltd copyright and may not be reproduced without prior written consent. Contractor to verify all dimensions on site before commencing work. Resolve all discrepancies with the Architect before proceeding. Figured dimensions to be taken in preference to scaled drawings. All work is to conform to relevant Australian Standards and other Codes as applicable, together with other Authorities' requirements and regulations.

REV	DESCRIPTION	DATE	ISSUED	CHECKE
Α	ISSUE FOR DA	28/10/2016	NT	AC
В	AMENDED AS PER COUNCIL RFI	10/04/2016	MC	AC



DEVELOPMENT APPLICATION

PROJECT NO. DRAWING NO. REVISION DATE

15-030 DA-0-211 B 27/06/2016


SCALE @ A3 DRAWN AUTHORISED

1 : 200 RD AC

( SCALE 1:200 10m

ROOF



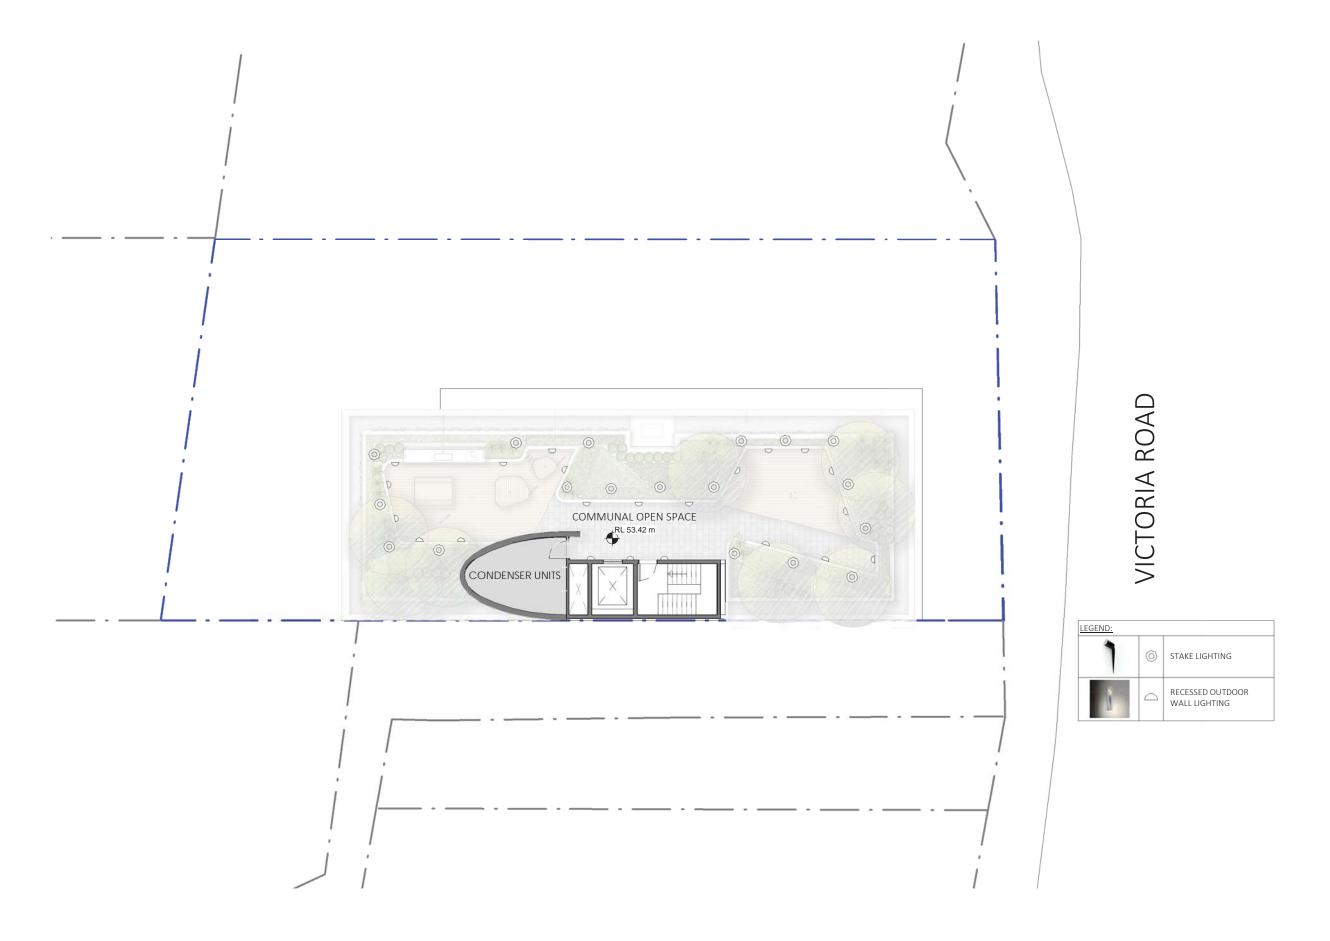

Phone: +61 2 8540 8720 ndickson@dicksonrothschild.com.au www.dicksonrothschild.com.au Millers Point, Sydney, NSW 2000 Nominated Architect: Robert Nigel Dickson Registration No: 5364

This drawing and design is subject to D.R. Design (NSW) Pty Ltd copyright and may not be reproduced without prior written consent. Contractor to verify all dimensions on site before commencing work.

Resolve all discrepancies with the Architect before proceeding. Figured dimensions to be taken in preference to scaled drawings. All work is to conform to relevant Australian Standards and other Codes as applicable, together with other Authorities' requirements and regulations.

	REV	DESCRIPTION	DATE	ISSUED	CHECKED
	Α	AMENDED AS PER COUNCIL RFI	10/04/2016	MC	AC
5					



DRUMMOYNE 227 - 231 VICTORIA ROAD


J. BARTOLOTTA


DEVELOPMENT APPLICATION


ROOFTOP LIGHTING PLAN


PROJECT NO.	DRAWING NO.	REVISION	DATE
15-030	DA-0-212	Α	27/06/2016
SCALE @ A3		DRAWN	AUTHORISED
1:200		RD	AC



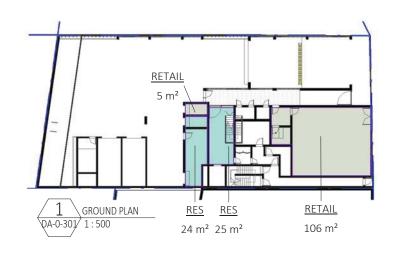


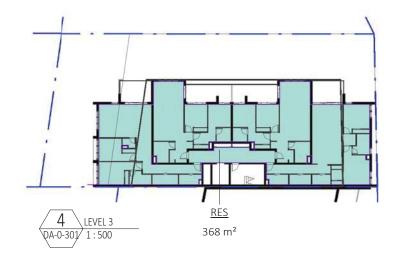


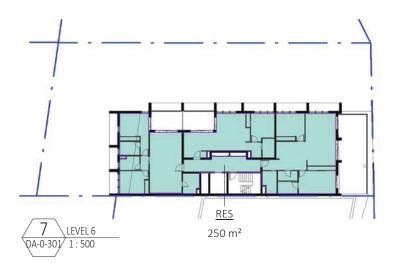

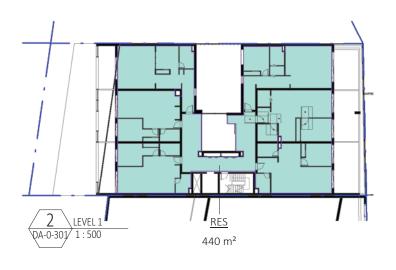



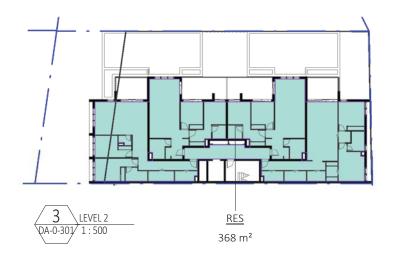

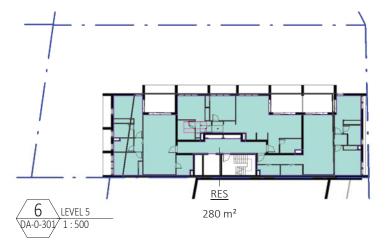

Phone: +61 2 8540 8720 ndickson@dicksonrothschild.com.au www.dicksonrothschild.com.au Millers Point, Sydney, NSW 2000 Nominated Architect: Robert Nigel Dickson Registration No: 5364

This drawing and design is subject to D.R. Design (NSW) Pty Ltd copyright and may not be reproduced without prior written consent. Contractor to verify all dimensions on site before commencing work.

Resolve all discrepancies with the Architect before proceeding. Figured dimensions to be taken in preference to scaled drawings. All work is to conform to relevant Australian Standards and other Codes as applicable, together with other Authorities' requirements and regulations.

	REV	DESCRIPTION	DATE	ISSUED	CHECKED
	Α	ISSUE FOR DA	28/10/2016	NT	AC
	В	AMENDED AS PER COUNCIL RFI	10/04/2016	MC	AC
d					
les					



PROJECT
DRUMMOYNE
227 221 VICTORIA BOAD

227 - 231 VICTORIA ROAD

DEVELOPMENT APPLICATION

CLIE	INI
J.	BARTOLOTTA

PROJECT NO.	DRAWING NO.	REVISION	DATE
15-030	DA-0-251	В	27/06/2016
SCALE @ A3		DRAWN	AUTHORISED
1:500		MC,RD	AC
	SCALE	1:500	2

GFA PLANS

