

227 - 231 VICTORIA ROAD

DEVELOPMENT APPLICATION

Dickson Rothschild D.R. Design (NSW) Pty. Ltd. 65-69 Kent Street, ABN: 35 134 237 540

Phone: +61 2 8540 8720 ndickson@dicksonrothschild.com.au www.dicksonrothschild.com.au Millers Point, Sydney, NSW 2000 Nominated Architect: Robert Nigel Dickson Registration No: 5364

This drawing and design is subject to D.R. Design (NSW) Pty Ltd copyright and may not be reproduced without prior written consent. Contractor to verify all dimensions on site before commencing work.

Resolve all discrepancies with the Architect before proceeding. Figured dimensions to be taken in preference to scaled drawings. All work is to conform to relevant Australian Standards and other Codes as applicable, together with other Authorities' requirements and regulations.

	REV	DESCRIPTION	DATE	ISSUED	CHECKED
	Α	ISSUE FOR DA	28/10/2016	NT	AC
	В	AMENDED AS PER COUNCIL RFI	10/04/2016	MC	AC
	С	FURTHER COUNCIL RFI	06/09/2017	MC	KR
	D	ISSUE FOR PLANNING PANEL	23/11/2017	MC	KR
25					

DRUMMOYNE **COVER SHEET** 227 - 231 VICTORIA ROAD 15-030 DA-0-001 D J. BARTOLOTTA

DEVELOPMENT APPLICATION



DRAWN MC

AC

	DRAWING LIST	
SHEET	DRAWING NAME REV	/
0xx - GENER	RAL	_
DA-0-001	COVER SHEET D	}
-DA-0-002-	PHOTOMONTAGE-SHEET-1 — — — — — — B-	
-DA-0-003-	PHOTOMONTAGE-SHEET-2 — — — — — — — — — — — — —	
DA-0-004	DRAWING LIST	<u>}</u>
DA-0-005	PROJECT SUMMARY D	الر
1xx - SITE	• • • • • • • • • • • • • • • • • • • •	_
DA-0-101	SITE ANALYSIS 1 A	
DA-0-102	SITE ANALYSIS 2 A	
DA-0-103	SITE ANALYSIS 3 A	
DA-0-104	SITE ANALYSIS 4	
DA-0-104a	SITE ANALYSIS 5	T/D)
DA-0-105	SITE PLAN 1	$\mathbf{\chi}$
DA-0-106	SITE PLAN 2	لر
DA-0-107	DEMOLITION PLAN A	
DA-0-108	SURVEY	
DA-0-109	AMALGAMATION PLAN A	
2xx - PLANS		_
DA-0-200	BASEMENT 2 C	╛.
DA-0-201	BASEMENT 1	E
DA-0-202	GROUND FLOOR PLAN	<i>y</i>
DA-0-203	LEVEL 1 FLOOR PLAN	
DA-0-204	LEVEL 2 FLOOR PLAN	1
DA-0-205	LEVEL 3 FLOOR PLAN	ZÔ\
DA-0-206	LEVEL 4 FLOOR PLAN C	
DA-0-207	LEVEL 5 FLOOR PLAN	م
D A-0-208	LEVEL 6 FLOOR PLAN	
DA-0-210	COMMUNAL OPEN SPACE C	3
DA-0-211	ROOF C	d
DA-0-212	ROOFTOP LIGHTING PLAN B	\supset

	DRAWING LIST	
SHEET	DRAWING NAME	REV.
DA-0-251	GFA PLANS	E
xx - ELEVA	TIONS	~~
DA-0-301	NORTH ELEVATION	E
DA-0-302	SOUTH ELEVATION	В
DA-0-303	WEST ELEVATION	\ D
DA-0-304	EAST ELEVATION	E
DA-0-305	VICTORIA ROAD ELEVATION	D
1xx - SECTIO	DNS	~~
DA-0-401	SECTION AA	D
DA-0-402	SECTION BB	E
DA-0-403	ACCESS RAMPS	Ç
DA-0-404	FACADE SECTIONS	CC
6xx - DETAII	LS	
DA-0-601	ADAPTABLE UNITS	C
DA-0-602	LIVEABLE HOUSING DESIGN – SILVER LEVEL	В
9xx - DIAGR	AMS & SCHEDULES	3
DA-0-901	FINISHES SCHEDULE	(c
DA-0-902	SHADOW ANALYSIS - SHEET 1	∂ c •
DA-0-903	SHADOW ANALYSIS - SHEET 2	کر دی
DA-0-905	DCP/ADG ENVELOPE DIAGRAM	А
DA-0-911	HEIGHT PLANE DIAGRAM - TOP OF PARAPET 1	(C)
DA-0-912	HEIGHT PLANE DIAGRAM - TOP OF PARAPET 2	В
DA-0-913	HEIGHT PLANE DIAGRAM - TOP OF PARAPET 3	В
DA-0-91 4	VIEW ANALYSIS 1	− \ }
DA-0-915	VIEW ANALYSIS 2	
DA-0-921	SOLAR & CV - SHEET 1	C
DA-0-922	SOLAR & CV - SHEET 2	C
DA-0-923	SOLAR & CV - SHEET 2	C
DA-0-933	FUTURE BUILT FORM ANALYSIS - VICTORIA ROAD 1	В
DA-0-934	FUTURE BUILT FORM ANALYSIS - VICTORIA ROAD 2	В
DA-0-935	FUTURE BUILT FORM ANALYSIS - VICTORIA ROAD 3	В
DA-0-936	FUTURE BUILT FORM ANALYSIS - VICTORIA ROAD 4	A
	-	

REVISION D - REVISED DRAWING LIST **REVISION E**

- REVISED THERMAL PERFORMANCE SPECIFICATIONS

Dickson Rothschild D.R. Design (NSW) Pty. Ltd. 65-69 Kent Street, ABN: 35 134 237 540

Phone: +61 2 8540 8720 ndickson@dicksonrothschild.com.au www.dicksonrothschild.com.au Millers Point, Sydney, NSW 2000 Nominated Architect: Robert Nigel Dickson Registration No: 5364

This drawing and design is subject to D.R. Design (NSW) Pty Ltd copyright and may not be reproduced without prior written consent. Contractor to verify all dimensions on site before commencing work. Resolve all discrepancies with the Architect before proceeding. Figured dimensions to be taken in preference to scaled drawings. All work is to conform to relevant Australian Standards and other Codes as applicable, together with other Authorities' requirements and regulations.

REV	DESCRIPTION	DATE	ISSUED	CHECKED
Α	ISSUE FOR DA	28/10/2016	NT	AC
В	AMENDED AS PER COUNCIL RFI	10/04/2016	MC	AC
С	FURTHER COUNCIL RFI	06/09/2017	MC	KR
D	ISSUE FOR PLANNING PANEL	23/11/2017	MC	KM
E	REVISED THERMAL PERFORMANCE SPECIFICATIONS	05/12/2017	MC	KM

DRUMMOYNE 227 - 231 VICTORIA ROAD J. BARTOLOTTA

15-030 DA-0-004 E 27/06/2016 NT AC

DRAWING LIST



Dickson Rothschild

Project No: 15-030

Date: Nov-17

Site area (m²): 867.0 m² (DP650973, DP518568)

Canada Bay LEP 2013

Land use	B4 Mixed Use	
FSR	2.0:1	
GFA	1734.0	
Height (m)	20m	

227 & 231 Victoria Road, Drummoyne

Canada Bay DCP 2017

Adaptable Units (Between 15 and 21 dwellings)

Note: all amounts are approximate with a potential variance of up to 5%

		GFA		COMMERCIAL	RESIDENTIAL			
Level	Car Parking spaces	Comm GFA	Res GFA	Comm tenancies	Studio	1 bdrm units	2 bdrm units	3 bdrm units
Level 5			280				(*)	
Level 4			280				3	
Level 3			368				4	
Level 2			368		\sim	\sim	4	
Level 1		\sim	266		(0)	{ 4 }		
Ground Floor	2	107	64	1		\sim		
Basement 1	15.0	\sim	()					
Basement 2	10.0	\sim	~ \		~ \	~ \	~ \	
Total	27	107	1626	1	(0)	4	14	0
Unit Mix		₩		10	0.0%	22.2%	77.8%	0.0%

	~ \
Proposed FSR Commercial	0.12:1
Total Residential	(18)
Total GFA	(1733)
Total parking	27
Proposed FSR	(2.00:1)

Notes

Canada Bay LEP 2013- GFA Definition

gross floor area means the sum of the floor area of each floor of a building measured from the internal face of external walls, or from the internal face of walls separating the building from any other building, measured at a height of 1.4 metres above the floor, and includes:

- (a) the area of a mezzanine, and
- (b) habitable rooms in a basement or an attic, and

but excludes:

- (d) any area for common vertical circulation, such as lifts and stairs, and
- (e) any basement:
- (i) storage, and
- (ii) vehicular access, loading areas, garbage and services, and
- (f) plant rooms, lift towers and other areas used exclusively for mechanical services or ducting, and
- (g) car parking to meet any requirements of the consent authority (including access to that car parking), and(h) any space used for the loading or unloading of goods (including access to it), and
- (i) terraces and balconies with outer walls less than 1.4 metres high, and
- (j) voids above a floor at the level of a storey or storey above.

REVISION D

- REVISED PROJECT SUMMARY

SEPP 65 Apartment Design Guide

		SOLAR	CROSS VENTILATIO	
Level	Min. Req	Achieved	Min. Req	Achieved
Ground Floor				
Level 1		2/4		(4/4)
Level 2		474		2/4
Level 3	70%	4/4	60%	(2/4)
Level 4		3/3		2/3
Level 5		3/3		2/3
		~~~		~~~
Total		16/18 (88.88%)		12/18 (66.669
		\ \ \ \ \ \ \ \ \ \ \ \ \ \ \ \ \ \ \		۲. ۸

## Canada Bay DCP 2017 Part C requirements

Commercial Car Parking Requirements	Unit of measure	Min. Rate	Allowable	Provided
	~		~ \	
TOTAL (including 1 Adaptable car space)	107	1/40m ²	2.68	3
	1			

Residential Car Parking Requirements (*)	No. of Units	Max. Rate	Required	Provided
Residential (Non-Adaptable Units)	~		~``	
Studio	<b>7</b> 55	0.6	0.00	
1 bdrm	4	0.6	2.40	3
2 bdrm	12 /	0.9	10.80	13
3 bdrm	$\sim$	1.4		
SUB-TOTAL	(16)		13.20	16
Non-adaptable Visitor		1 per 5 apartments	3 )	4
TOTAL NON-ADAPTABLE CAR SPACES		at to	<del>\</del>	20
Residential (Adaptable Units)	~			
1 bdrm		1/Adaptable unit	(b)	1
2 bdrm	2	1/Adaptable unit	2	2
3 bdrm	_			
SUB-TOTAL	(2)		(2)	3
Adaptable Visitor			1	1
TOTAL ADAPTABLE CAR SPACES				4
	٧ ٧			
TOTAL CAR SPACES	18	)	22.08	27

Misc. Parking Requirements	Min. Rate	Allowable	Provided		
Bicycle Parking Requirements	~				
Bicycle Storage facility	1 per every dwelling	18.0	24		
Bicycle parking facility	1 per 12 dwelling	1.5	2		
Bicycle parking facility retail	1per 300 sqm	0.4	1		
Bicycle storage facility retail	1per 300 sqm	0.4	1		
Total Bicycles	20 %	(20.2)	28		

Open Spaces (in m²)	Min. Rate	Allowable	Provided
Common open space	25% of site area	216.75	219m²

Waste Management			
Private Contractor Collection		General	Recycling
RETAIL WASTE	Rate:	50L/100m2/day	25L/100m2/day
	Total Volume weekly	375	187
	Bins 240L	17.0	0.8
	Bins 660L	0.6	
	Bins provided	1	1
Council Collection			
RESIDENTIAL	Rate:	120L/upit/week	120L/unit/week
	Total Volume	2,160	2,160
	Bins 1100L(WASTE), 1100L(RECYCLING	1.96	1.96
	Bins provided	2 _	, 2
	The state of the s	\ \ \	₹ ~

Dickson Rothschild	Phone: +61 2 8540 8720
D.R. Design (NSW) Pty. Ltd.	ndickson@dicksonrothschild.com.au
65-69 Kent Street,	www.dicksonrothschild.com.au
Millers Point, Sydney, NSW 2000	Nominated Architect: Robert Nigel Dickson
ABN: 35 134 237 540	Registration No: 5364
0 0 ,	sign (NSW) Pty Ltd copyright and may not be reproduced verify all dimensions on site before commencing work.
	before proceeding. Figured dimensions to be taken in
preference to scaled drawings. All work is to	conform to relevant Australian Standards and other Codes

as applicable, together with other Authorities' requirements and regulations.

	REV	DESCRIPTION	DATE	ISSUED	CHECKED
	Α	ISSUE FOR DA	28/10/2016	NT	AC
	В	AMENDED AS PER COUNCIL RFI	10/04/2016	MC	AC
	С	FURTHER COUNCIL RFI	06/09/2017	MC	KR
	D	ISSUE FOR PLANNING PANEL	23/11/2017	MC	KR
t					
es					

PROJECT	DRAWING			
DRUMMOYNE	PROJE	CT SUMN	1ARY	
227 - 231 VICTORIA ROAD	PROJECT NO.	DRAWING NO.	REVISION	DATE
CLIENT	15-030	DA-0-005	D	27/06
J. BARTOLOTTA	SCALE @ A3		MC DRAWN	AC AC





Phone: +61 2 8540 8720 ndickson@dicksonrothschild.com.au www.dicksonrothschild.com.au Nominated Architect: Robert Nigel Dickson Registration No: 5364

This drawing and design is subject to D.R. Design (NSW) Pty Ltd copyright and may not be reproduced without prior written consent. Contractor to verify all dimensions on site before commencing work. Resolve all discrepancies with the Architect before proceeding. Figured dimensions to be taken in preference to scaled drawings. All work is to conform to relevant Australian Standards and other Codes as applicable, together with other Authorities' requirements and regulations.

REV	DESCRIPTION	DATE	ISSUED	CHECKE
Α	ISSUE FOR DA	28/10/2016	NT	AC



DRUMMOYNE

227 - 231 VICTORIA ROAD

CUENT


J. BARTOLOTTA

DEVELOPMENT APPLICATION

PROJECT NO.	DRAWING NO.	REVISION	DATE
15-030	DA-0-101	Α	27/06/2016
		DRAWN	AUTHORISED
NOT TO	SCALE	HW	AC

SITE ANALYSIS 1



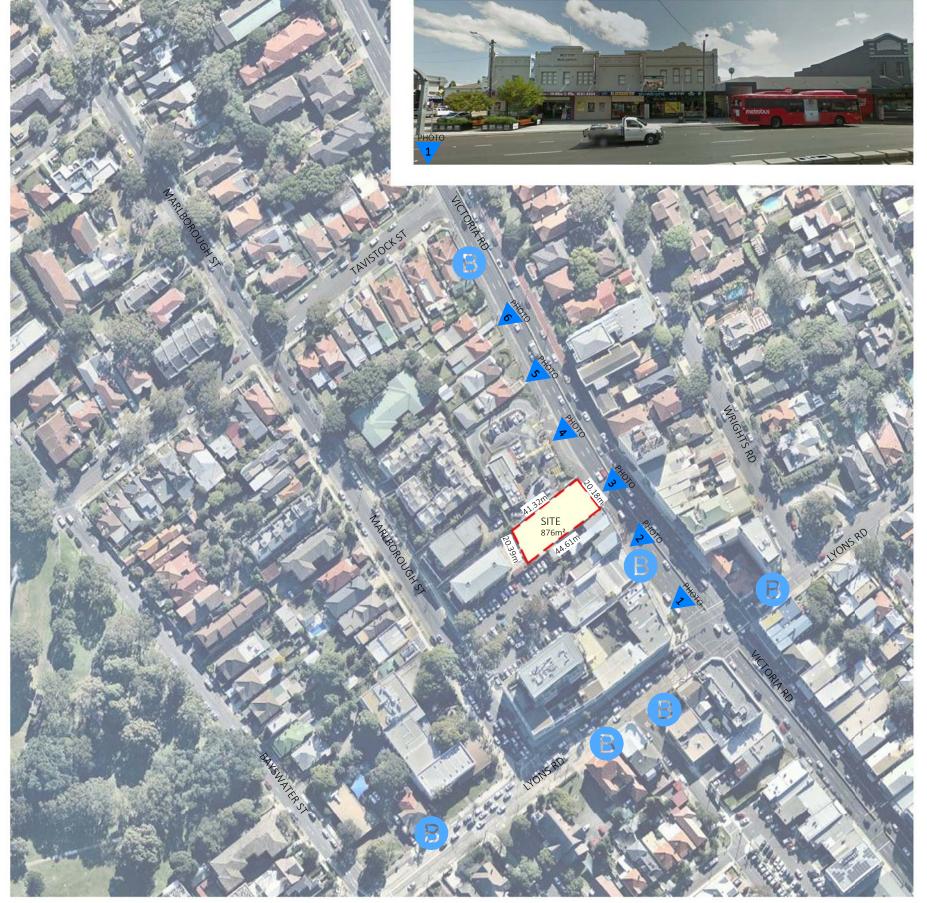











Dickson Rothschild D.R. Design (NSW) Pty. Ltd. 65-69 Kent Street, ABN: 35 134 237 540

Phone: +61 2 8540 8720 ndickson@dicksonrothschild.com.au www.dicksonrothschild.com.au Millers Point, Sydney, NSW 2000 Nominated Architect: Robert Nigel Dickson Registration No: 5364

This drawing and design is subject to D.R. Design (NSW) Pty Ltd copyright and may not be reproduced without prior written consent. Contractor to verify all dimensions on site before commencing work. Resolve all discrepancies with the Architect before proceeding. Figured dimensions to be taken in preference to scaled drawings. All work is to conform to relevant Australian Standards and other Codes as applicable, together with other Authorities' requirements and regulations.

REV	DESCRIPTION	DATE	ISSUED	CHECKED
Α	ISSUE FOR DA	28/10/2016	NT	AC



DRUMMOYNE

227 - 231 VICTORIA ROAD


J. BARTOLOTTA

DEVELOPMENT APPLICATION

SITE ANALYSIS 2

REVISION DATE A 27/06/2016 15-030 DA-0-102 A NOT TO SCALE HW AC



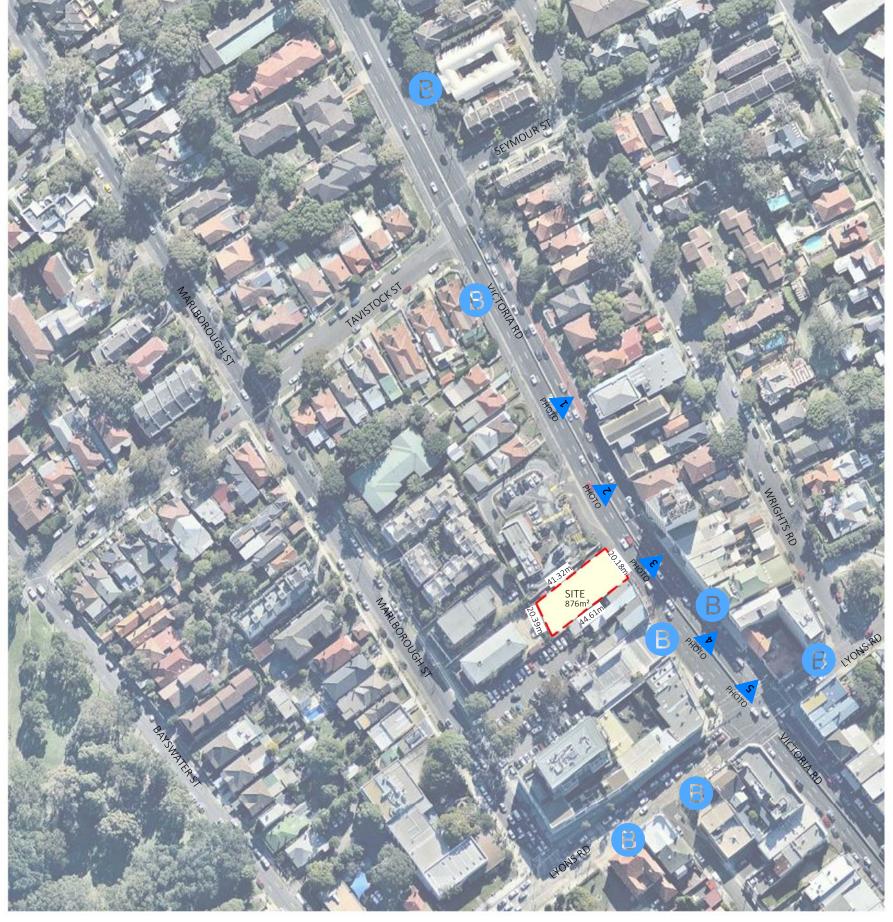











Dickson Rothschild D.R. Design (NSW) Pty. Ltd. 65-69 Kent Street, ABN: 35 134 237 540

Phone: +61 2 8540 8720 ndickson@dicksonrothschild.com.au www.dicksonrothschild.com.au Millers Point, Sydney, NSW 2000 Nominated Architect: Robert Nigel Dickson Registration No: 5364

This drawing and design is subject to D.R. Design (NSW) Pty Ltd copyright and may not be reproduced without prior written consent. Contractor to verify all dimensions on site before commencing work. Resolve all discrepancies with the Architect before proceeding. Figured dimensions to be taken in preference to scaled drawings. All work is to conform to relevant Australian Standards and other Codes as applicable, together with other Authorities' requirements and regulations.

REV	DESCRIPTION	DATE	ISSUED	CHECKED
Α	ISSUE FOR DA	28/10/2016	NT	AC
			•	•



DRUMMOYNE

227 - 231 VICTORIA ROAD


J. BARTOLOTTA

DEVELOPMENT APPLICATION

SITE ANALYSIS 3

15-030 DA-0-103 A 27/06/2016 NOT TO SCALE HW AC



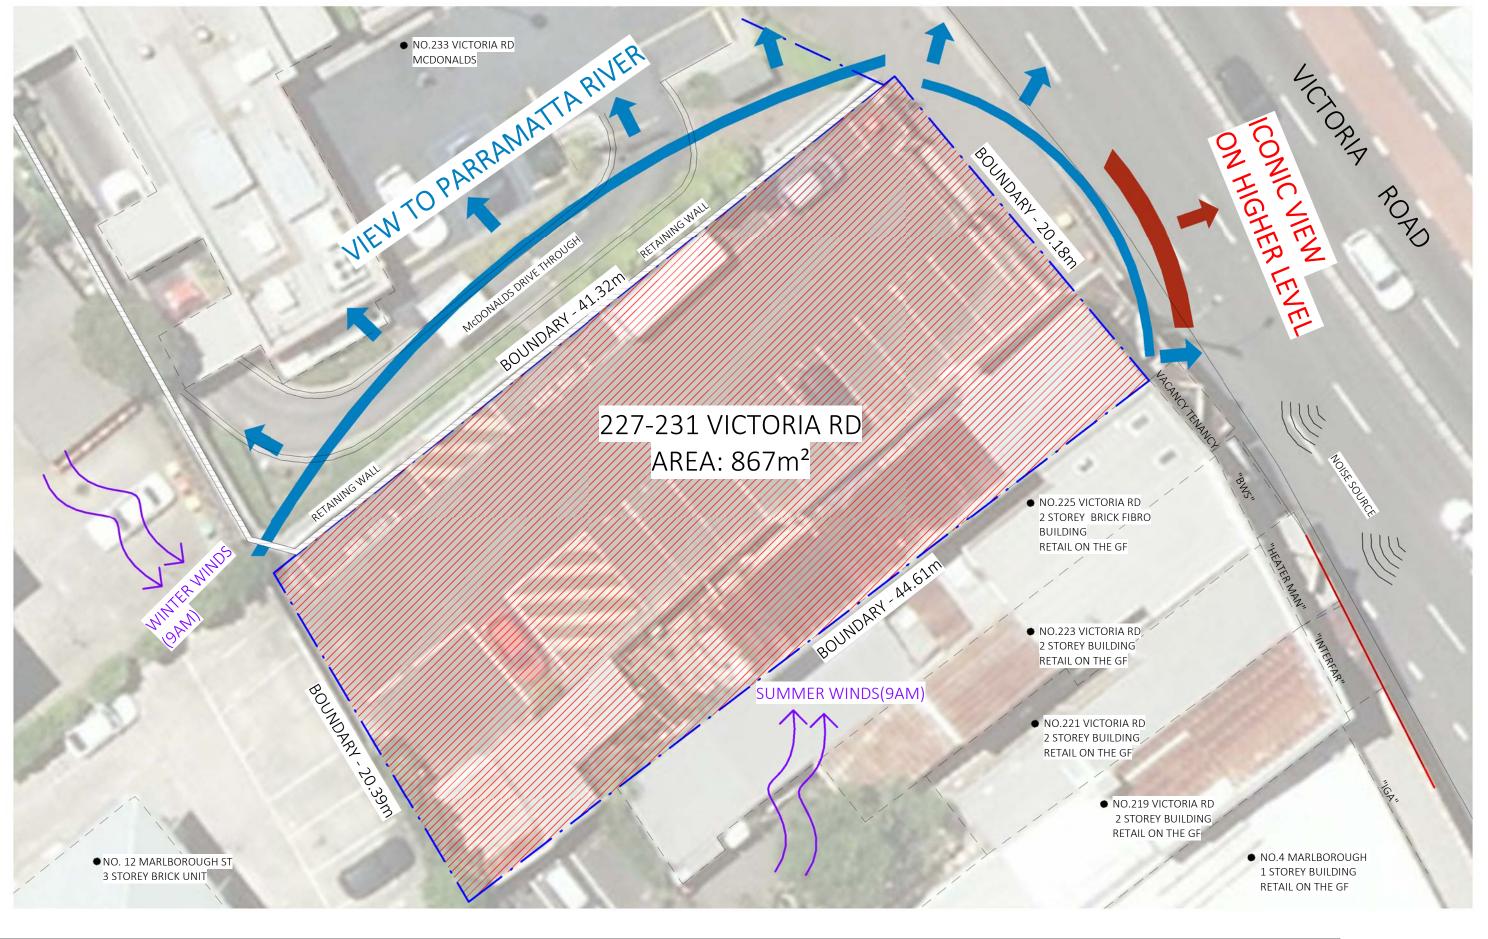

Phone: +61 2 8540 8720 ndickson@dicksonrothschild.com.au www.dicksonrothschild.com.au Nominated Architect: Robert Nigel Dickson Registration No: 5364

This drawing and design is subject to D.R. Design (NSW) Pty Ltd copyright and may not be reproduced without prior written consent. Contractor to verify all dimensions on site before commencing work. Resolve all discrepancies with the Architect before proceeding. Figured dimensions to be taken in preference to scaled drawings. All work is to conform to relevant Australian Standards and other Codes as applicable, together with other Authorities' requirements and regulations.

A ISSUE FOR DA 28/10/2016 NT AC		REV	DESCRIPTION	DATE	ISSUED	CHECKEE
		Α	ISSUE FOR DA	28/10/2016	NT	AC
	5					



DRUMMOYNE

227 - 231 VICTORIA ROAD

J. BARTOLOTTA

DEVELOPMENT APPLICATION







**REVISION B** 

- REVISED RL'S

Phone: +61 2 8540 8720 ndickson@dicksonrothschild.com.au www.dicksonrothschild.com.au Nominated Architect: Robert Nigel Dickson Registration No: 5364

This drawing and design is subject to D.R. Design (NSW) Pty Ltd copyright and may not be reproduced without prior written consent. Contractor to verify all dimensions on site before commencing work.

Resolve all discrepancies with the Architect before proceeding. Figured dimensions to be taken in preference to scaled drawings. All work is to conform to relevant Australian Standards and other Codes as applicable, together with other Authorities' requirements and regulations.

REV	DESCRIPTION	DATE	ISSUED	CHECKED
Α	AMENDED AS PER COUNCIL RFI	10/04/2016	MC	AC
В	ISSUE FOR PLANNING PANEL	23/11/2017	MC	KR



## DRUMMOYNE

227 - 231 VICTORIA ROAD

J. BARTOLOTTA

# SITE ANALYSIS 5

PROJECT NO.	DRAWING NO.	REVISION	DATE
15-030	DA-0-104a	В	27/06/2016
SCALE @ A3		DRAWN	AUTHORISED
1:500		MC	AC
	SCALE	1:500	25





LEGEND

SKL SKY LIGHT

T.O.P TOP OF PARAPET

T.O.B TOP OF BALUSTRADE

Dickson Rothschild D.R. Design (NSW) Pty. Ltd. 65-69 Kent Street, Millers Point, Sydney, NSW 2000

Phone: +61 2 8540 8720 ndickson@dicksonrothschild.com.au www.dicksonrothschild.com.au Nominated Architect: Robert Nigel Dickson

ABN: 35 134 237 540 Registration No: 5364 This drawing and design is subject to D.R. Design (NSW) Pty Ltd copyright and may not be reproduced without prior written consent. Contractor to verify all dimensions on site before commencing work.

Resolve all discrepancies with the Architect before proceeding. Figured dimensions to be taken in preference to scaled drawings. All work is to conform to relevant Australian Standards and other Codes as applicable, together with other Authorities' requirements and regulations.

	REV	DESCRIPTION	DATE	ISSUED	CHECKE
	Α	ISSUE FOR DA	28/10/2016	NT	AC
	В	AMENDED AS PER COUNCIL RFI	10/04/2016	MC	AC
	С	ISSUE FOR PLANNING PANEL	23/11/2017	MC	KR
es es					



DRUMMOYNE


227 - 231 VICTORIA ROAD

J. BARTOLOTTA

SITE PLAN	1

PROJECT NO.	DRAWING NO.	REVISION	DATE
15-030	DA-0-105	С	27/06/2016
SCALE @ A3		DRAWN	AUTHORISED
1:500		SC	AC
	SCALE	1:500	25



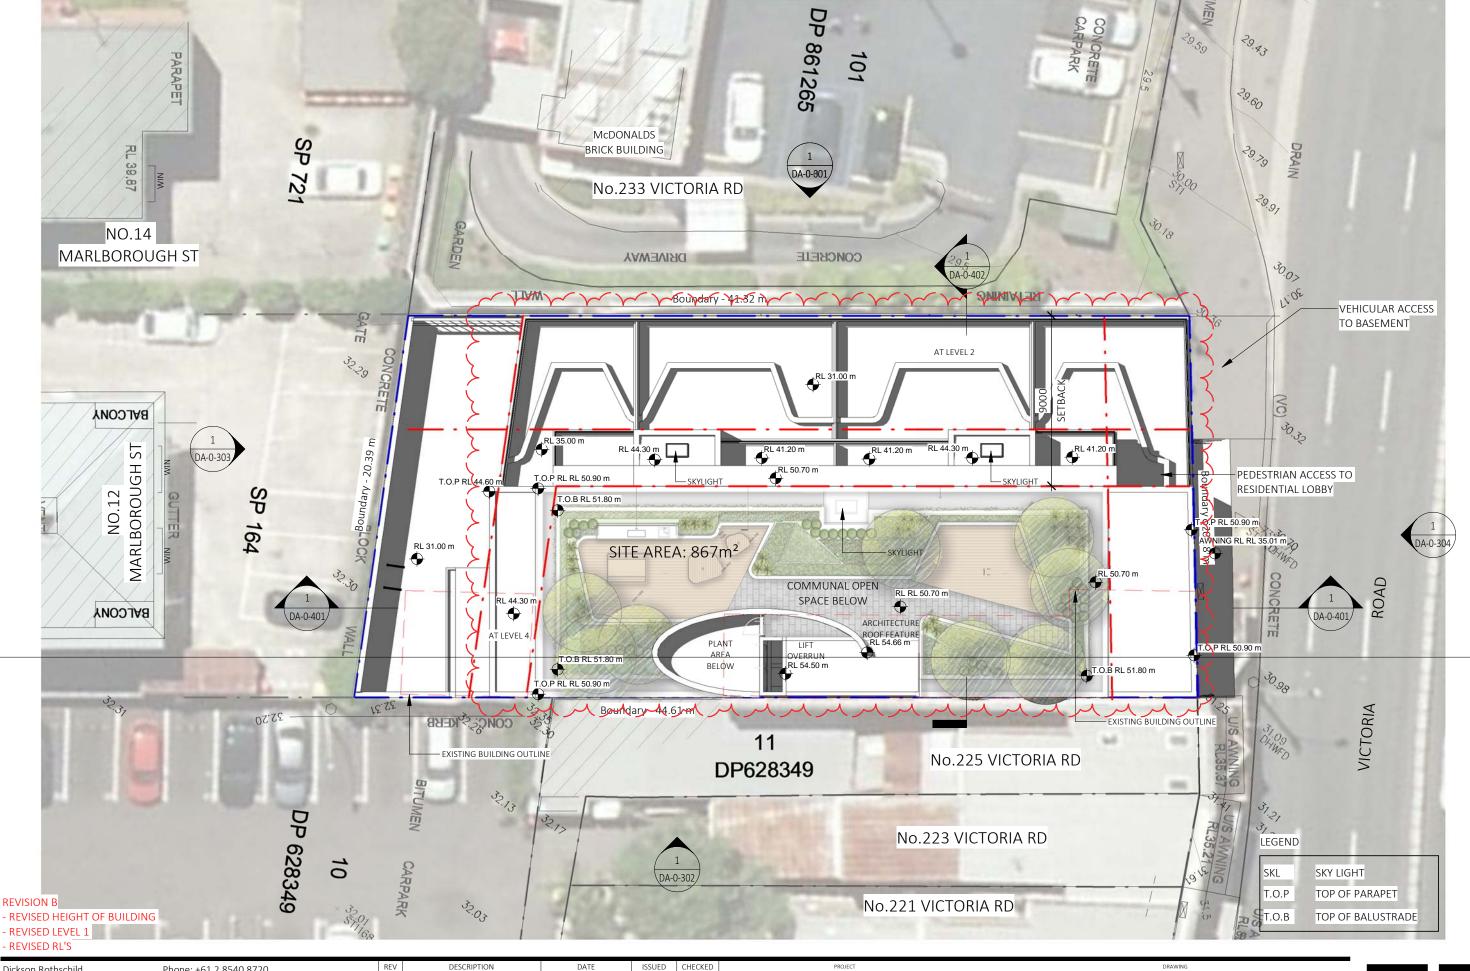

Phone: +61 2 8540 8720

ndicks on @dicks on roth schild.com. auwww.dicksonrothschild.com.au Nominated Architect: Robert Nigel Dickson Registration No: 5364 This drawing and design is subject to D.R. Design (NSW) Pty Ltd copyright and may not be reprodu

	D.M. Design (NSVV) I ty. Eta.	raickson@aickson.aa		AMENDED AS PER COUNCIL RFI	10/04/2016
65-69 Kent Street.		www.dicksonrothschild.com.au	В	AIVIENDED AS PER COUNCIL RFI	10/04/2016
	,		C	ISSUE FOR PLANNING PANEL	23/11/2017
	Millers Point, Sydney, NSW 2000	Nominated Architect: Robert Nigel Dickson			
	ABN: 35 134 237 540	Registration No: 5364			
	ABN: 33 134 237 340	Registration No. 5304			
	This drawing and design is subject to D.R. De				
		verify all dimensions on site before commencing work.			
	•	,			
Resolve all discrepancies with the Architect before proceeding. Figured dimensions to be taken in preference to scaled drawings. All work is to conform to relevant Australian Standards and other Codes					
	as applicable, together with other Authoritie				
as applicable, together with other Authorities requirements and regulations.					

A ISSUE FOR DA



NT

MC

MC

AC.


AC

KR

PROJECT	DR
DRUMMOYNE	SI
227 - 231 VICTORIA ROAD	
CLIENT	
J. BARTOLOTTA	SC. 1

DRAWING	•	•	
SITE PL	LAN 2		
PROJECT NO.	DRAWING NO.	REVISION	DATE
15-030	DA-0-106	C	27/06/2016
SCALE @ A3		DRAWN	AUTHORISED
1:200		RD	AC
	SCALE	1:200	10n



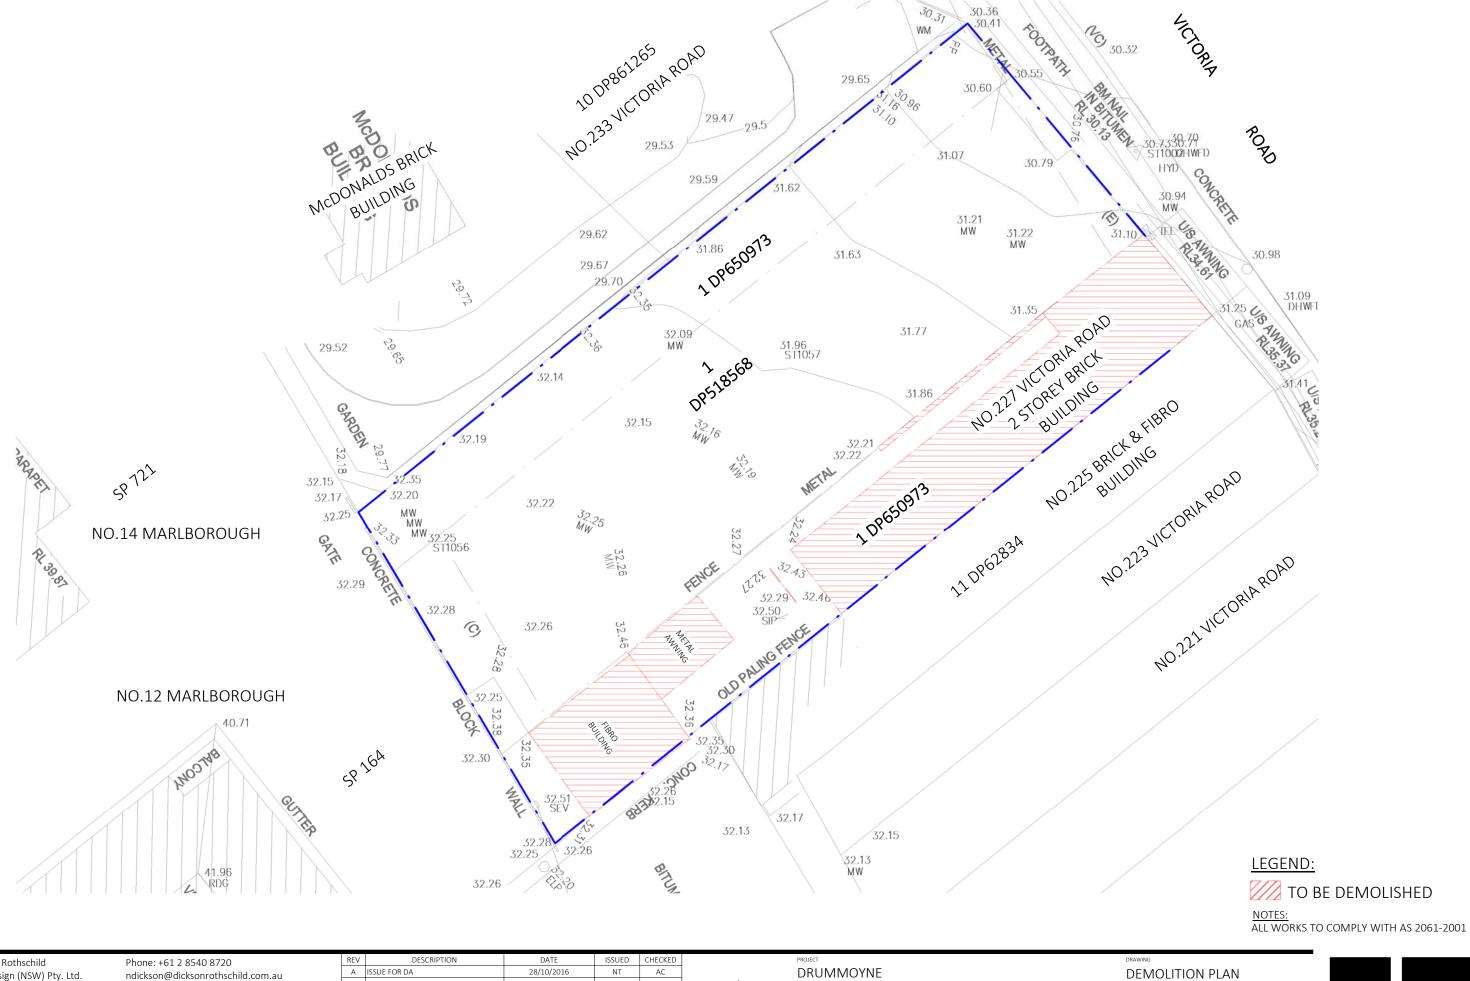

Phone: +61 2 8540 8720 ndickson@dicksonrothschild.com.au www.dicksonrothschild.com.au Nominated Architect: Robert Nigel Dickson Registration No: 5364

This drawing and design is subject to D.R. Design (NSW) Pty Ltd copyright and may not be reproduced without prior written consent. Contractor to verify all dimensions on site before commencing work. Resolve all discrepancies with the Architect before proceeding. Figured dimensions to be taken in preference to scaled drawings. All work is to conform to relevant Australian Standards and other Codes as applicable, together with other Authorities' requirements and regulations.

	REV	DESCRIPTION	DATE	ISSUED	CHECKED
	Α	ISSUE FOR DA	28/10/2016	NT	AC
d					
es					




DRUMMOYNE


227 - 231 VICTORIA ROAD


CLIENT

J. BARTOLOTTA

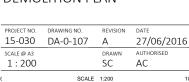




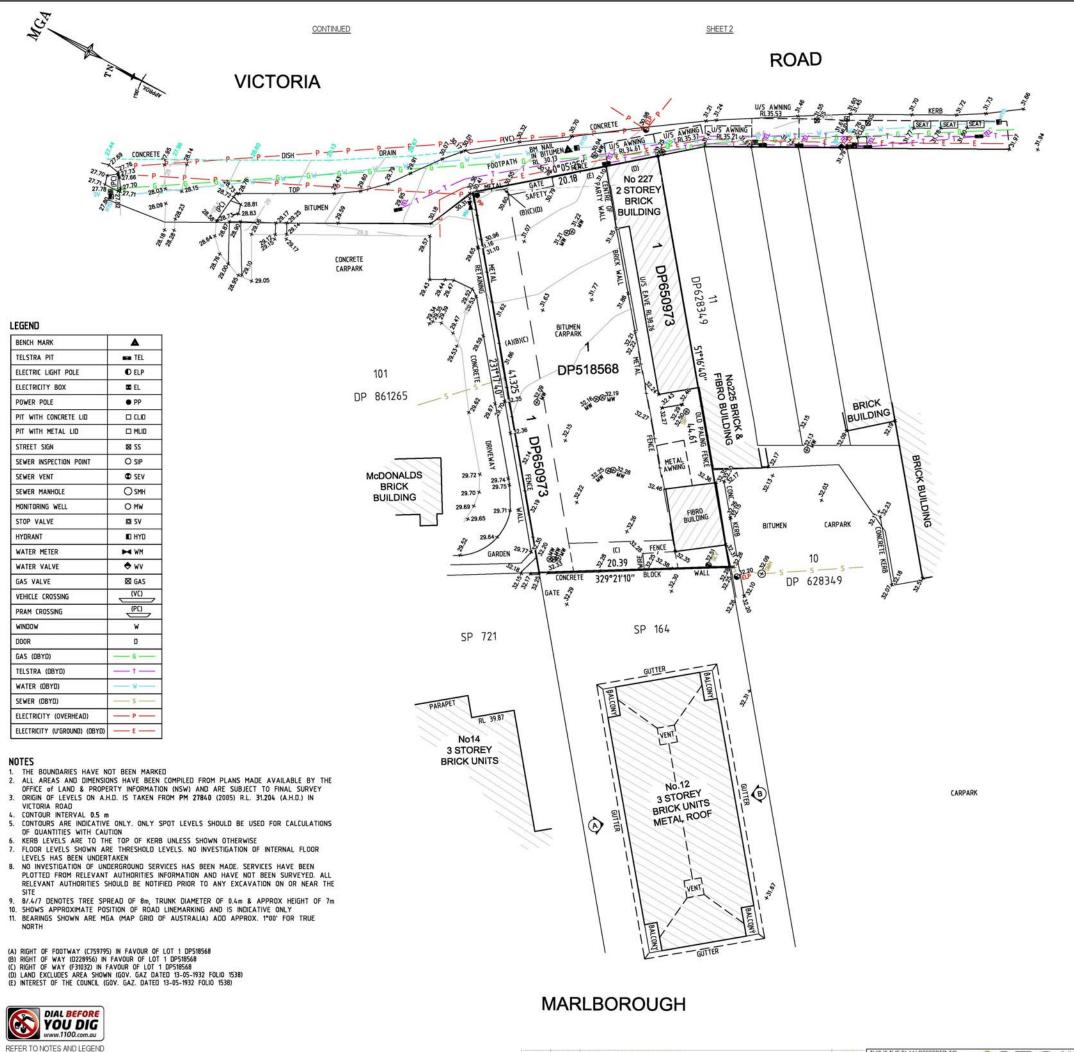


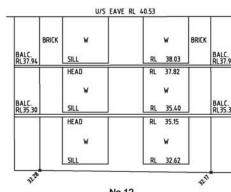

NORTHEASTERN ELEVATION (SCALE 1:100)

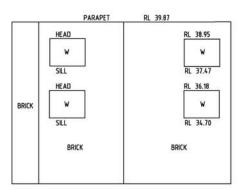

NORTHEASTERN ELEVATION (SCALE 1:100)

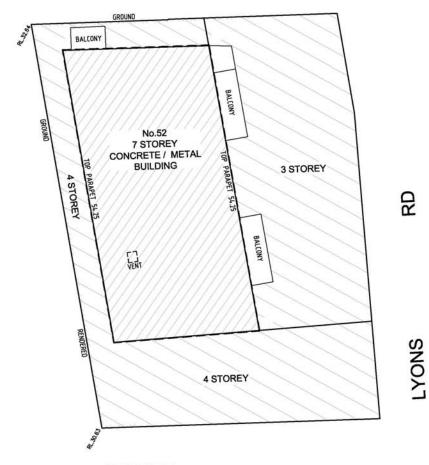


STREET

C	7/10/16	DESCRIPTION UPDATED TO No.52	43767	THIS IS THE PLAN REFERRED TO		Suite 1, Level 1	Client BARTOLOTTA PROPERTIES P/L	datum	project number	reference num
В	6/10/16	ADJOINING BOUNDARIES ADDED, SITE ADDRESS UPDATED	43767	IN MY LETTER DATED:		Gordon NSW 2072	Drawing title	AHD	42256	42256DT
A	22/09/16	ROAD WIDENED AREA ADDED BACK INTO PLAN	43767			Locked Bag 5	PLAN OF DETAIL AND LEVELS OVER LOT 1 IN DP650973	site Area 867.1 m ²	1:200 @A1	date of survey
		ADJOINING BUILDINGS DETAIL & ELEVATIONS ADDED	43767		LOCKLEY -	Gordon NSW 2072	AND LOT 1 IN DP518568 KNOWN AS No 227-231	007.1111	1.200 WAT	27/0//13
evision	Date	Description	Reference	D - 1-1	Registered Surveyors NSV	P 1300 587 000	MOTORIA DO AR BRUMANOVATA	CANADA BAY	SHEE	1 1



SCALE 1: 200 @ A1

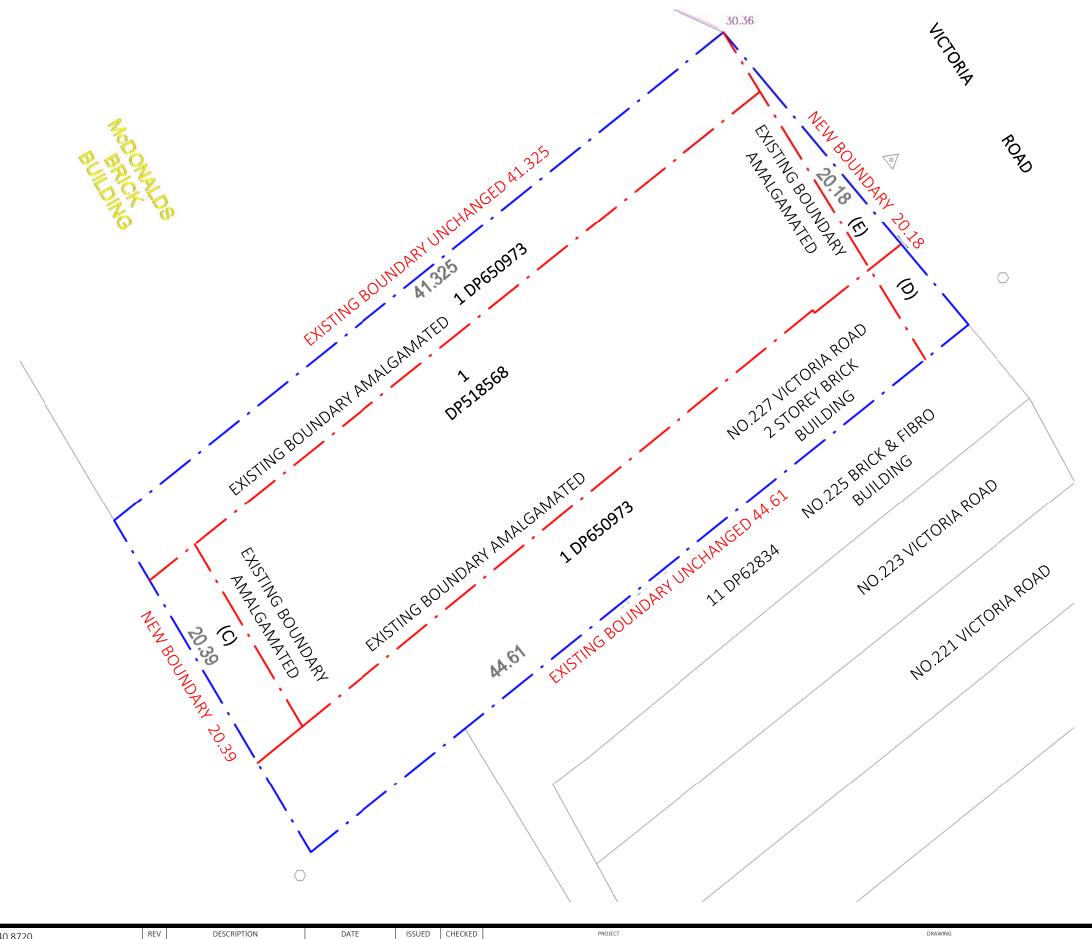

Phone: +61 2 8540 8720 ndickson@dicksonrothschild.com.au www.dicksonrothschild.com.au Nominated Architect: Robert Nigel Dickson Registration No: 5364

This drawing and design is subject to D.R. Design (NSW) Pty Ltd copyright and may not be reproduced without prior written consent. Contractor to verify all dimensions on site before commencing work. Resolve all discrepancies with the Architect before proceeding. Figured dimensions to be taken in preference to scaled drawings. All work is to conform to relevant Australian Standards and other Codes as applicable, together with other Authorities' requirements and regulations.

	REV	DESCRIPTION	DATE	ISSUED	CHECKED
	Α	ISSUE FOR DA	28/10/2016	NT	AC
es					
_					



 DRUMMOYNE
 AMALGAMATION PLAN

 227 - 231 VICTORIA ROAD
 PROJECT NO. DRAWING NO. REVISION DA

 CLIENT
 15-030 DA-0-109 A
 27

 J. BARTOLOTTA
 SCALE @ A3
 DRAWN AU

DEVELOPMENT APPLICATION

PROJECT NO. DRAWING NO. REVISION DATE
15-030 DA-0-109 A 27/06/2016

SCALE @ A3
1:200 NT AC

( SCALE 1:200 10m



(e) The applicant must not install a private swimming pool or spa for the dwelling, with a volume exceeding that specified for it in the table below.

(g) The pool or spa must be located as specified in the

(h) The applicant must install, for the dwelling, each alternative water supply system, with the specified size. listed for that dwelling in the table below. Each system must be configured to collect run-off from the areas specified (excluding any area which supplies any other alternative water supply system), and to divert overflow as specified. Each system must be connected as  $% \left\{ \left( 1\right) \right\} =\left\{ \left( 1$ 

## (ii) Energy:

(b) The applicant must install each hot water system specified for the dwelling in the table below, so that the dwelling's hot water is supplied by that system. If the table specifies a central hot water system for the dwelling, then the applicant must connect that central system to the dwelling, so that the dwelling's hot water is supplied by that central system.

(f) This commitment applies to each room or area of the dwelling which is referred to in a heading to the "Natural lighting" column of the table below (but only to the extent specified for that room or area). The applicant must ensure that each such room or area is fitted with a window and/or skylight.

#### (iii) Thermal Comfort;

(g) Where there is an in-slab heating or cooling system, the applicant must:

(aa) Install insulation with an R-value of not less than 1.0 around the vertical edges of the perimeter of the slab; or (bb) On a suspended floor, install insulation with an Rvalue of not less than 1.0 underneath the slab and around the vertical edges of the perimeter of the slab.

ant must construct the floors and walls of nt in accordance with the specifications

(b) Common areas and central systems/facilities MARLBOROUGH ST

# (i) Water:

(b) The applicant must install (or ensure that the development is serviced by) the alternative water supply system(s) specified in the "Central systems" column of the table below. In each case, the system must be sized, be configured, and be connected, as specified in table.

(c) A swimming pool or spa listed in the table must not have a volume in (kLs) greater than that specified for the pool or spa in the table

#### (ii) Energy:

(c) The applicant must install the systems and fixtures specified in the "Central energy systems" column of the table below. In each case, the system of fixture must be of the type, and meet the specifications, listed for it in

No.233 **VICTORIA ST** MARLBOROUGH ST Boundary - 41.32 m STORAGE 5m³ STORAGE 5m³ STORAGE 5m³ STORAGE 5m³ STORAGE 5m³ STORAGE 5m3 RES RES RES RES RES RES 23 x RES STORAGE @ 6m3 **BASEMENT 2** TOTAL 10 SPACES - INC 2 ACCESSIBLE (RES) RL 24.13 m - 10 RESIDENTIALS - 12 RESIDENTIAL BICYCLE STORAGE MAINTENANCE ROOM CAR LIFT WITH BACK UP POWER SUPPLY 1000 RES RES RES CAR LIF CÀR LÍFT LOBBY No.12 LIĘT S/A STORAGE 5m³ Boundary - 44.61 m No225 **VICTORIA ST** No223 **VICTORIA ST** DA-0-302 No221

Dickson Rothschild D.R. Design (NSW) Pty. Ltd. 9 Argyle Place, Millers Point, Sydney, NSW 2000

ABN: 35 134 237 540

Phone: +61 2 8540 8720 ndickson@dicksonrothschild.com.au www.dicksonrothschild.com.au Nominated Architect: Robert Nigel Dickson Registration No: 5364

This drawing and design is subject to D.R. Design (NSW) Pty Ltd copyright and may not be reproduced without prior written consent. Contractor to verify all dimensions on site before commencing work. Resolve all discrepancies with the Architect before proceeding. Figured dimensions to be taken in preference to scaled drawings. All work is to conform to relevant Australian Standards and other Codes as applicable, together with other Authorities' requirements and regulations.

	REV	DESCRIPTION	DATE	ISSUED	CHECKED
	Α	ISSUE FOR DA	28/10/2016	NT	AC
	В	AMENDED AS PER COUNCIL RFI	10/04/2016	MC	AC
	С	FURTHER COUNCIL RFI	06/09/2017	MC	KR
5					



DRUMMOYNE 227 - 231 VICTORIA ROAD J. BARTOLOTTA

DEVELOPMENT APPLICATION

**VICTORIA ST** 

BASEMENT 2

15-030 DA-0-<u>200</u> 27/06/2016 MC,RD AC 1:200 SCALE 1:200

LEGEND

RES



MOTORCYCLE PARKING

RESIDENTIAL PARKING

**VICTORIA ROAD** 

dwelling specified in the "Description of Project" table).

(e) The applicant must not install a private swimming pool or spa for the dwelling, with a volume exceeding that specified for it in the table below.

(g) The pool or spa must be located as specified in the table.

(h) The applicant must install, for the dwelling, each alternative water supply system, with the specified size, listed for that dwelling in the table below. Each system must be configured to collect run-off from the areas specified (excluding any area which supplies any other alternative water supply system), and to divert overflow as specified. Each system must be connected as specified.

## (ii) Energy:

(b) The applicant must install each hot water system specified for the dwelling in the table below, so that the dwelling's hot water is supplied by that system. If the table specifies a central hot water system for the dwelling, then the applicant must connect that central system to the dwelling, so that the dwelling's hot water is supplied by that central system.

(f) This commitment applies to each room or area of the dwelling which is referred to in a heading to the "Natural lighting" column of the table below (but only to the extent specified for that room or area). The applicant must ensure that each such room or area is fitted with a window and/or skylight.

#### (iii) Thermal Comfort;

(g) Where there is an in-slab heating or cooling system, the applicant must:

(aa) Install insulation with an R-value of not less than 1.0 around 12c. artical edges of the perimeter of the slab; or (bb) on a sysper ded floor, install insulation with an R-value of not less than 1.0 underneath the slab and around the 2005 cal edges of the perimeter of the slab No.12

(h) The applicant must construct the floors and walls  $d\!MARLBOROUGH$  ST the development in accordance with the specifications listed in the table below.

### (b) Common areas and central systems/facilities


#### (i) Water:


(b) The applicant must install (or ensure that the development is serviced by) the alternative water supply system(s) specified in the "Central systems" column of the table below. In each case, the system must be sized, be configured, and be connected, as specified in table.

(c) A swimming pool or spa listed in the table must not have a volume in (kLs) greater than that specified for the pool or spa in the table.

#### (ii) Energy:

(c) The applicant must install the systems and fixtures specified in the "Central energy systems" column of the table below. In each case, the system of fixture must be of the type, and meet the specifications, listed for it in

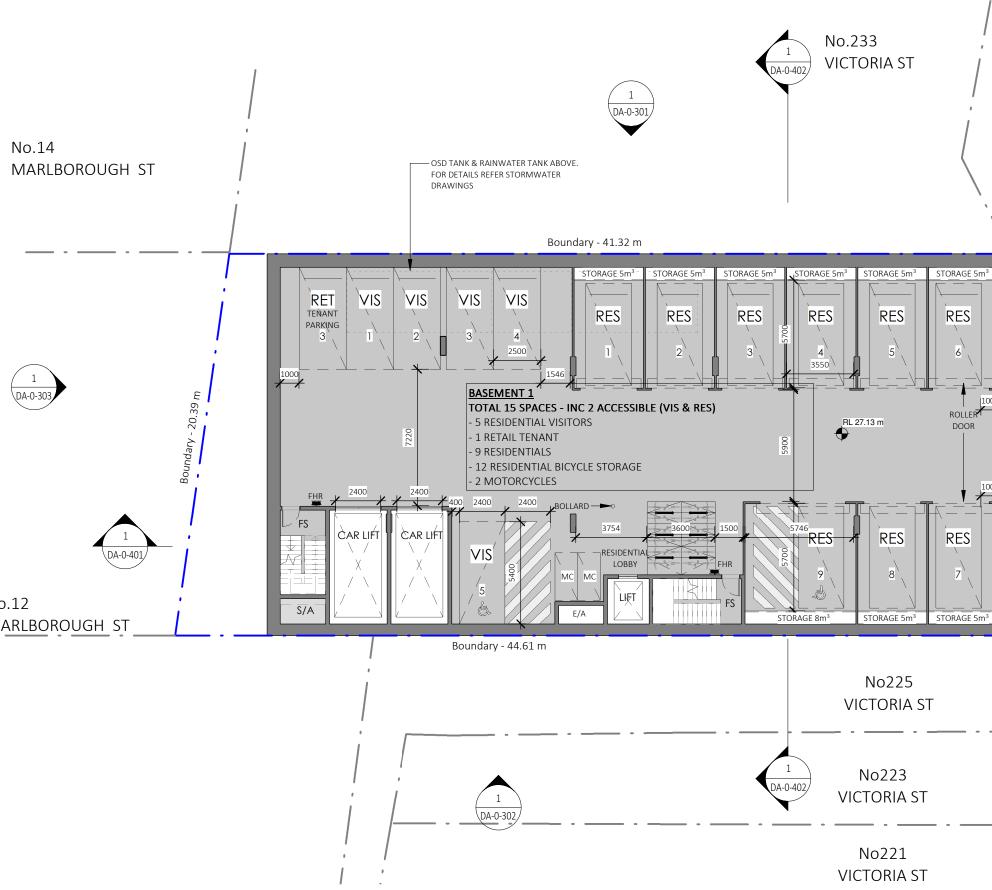

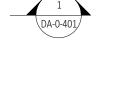

LEGEND

MC	MOTORCYCLE PARKING
RES	RESIDENTIAL PARKING
VIS	VISITORS PARKING
сом	COMMERCIAL PARKING

Dickson Rothschild D.R. Design (NSW) Pty. Ltd. 9 Argyle Place, Millers Point, Sydney, NSW 2000 ABN: 35 134 237 540 Phone: +61 2 8540 8720 ndickson@dicksonrothschild.com.au www.dicksonrothschild.com.au Nominated Architect: Robert Nigel Dickson Registration No: 5364

This drawing and design is subject to D.R. Design (NSW) Pty Ltd copyright and may not be reproduced without prior written consent. Contractor to verify all dimensions on site before commencing work. Resolve all discrepancies with the Architect before proceeding. Figured dimensions to be taken in preference to scaled drawings. All work is to conform to relevant Australian Standards and other Codes as applicable, together with other Authorities' requirements and regulations.

	REV	DESCRIPTION	DATE	ISSUED	CHECKE
	Α	ISSUE FOR DA	28/10/2016	NT	AC
	В	AMENDED AS PER COUNCIL RFI	10/04/2016	MC	AC
	С	FURTHER COUNCIL RFI	06/09/2017	MC	KR
5					

PROJECT	DRAWING
DRUMMOYNE	BASEMENT 1
227 - 231 VICTORIA ROAD	PROJECT NO DRAWING NO
CLIENT	15-030 DA-0-201
J. BARTOLOTTA	SCALE @ A3 1:200

PROJECT NO.	DRAWING NO.	REVISION	DATE
15-030	DA-0-201	C	27/06/201
SCALE @ A3		DRAWN	AUTHORISED
1:200		MC	AC
	SCALE	1:200	



#### **BASIX REQUIREMENTS** 1285 0 (a) Dwellings (i) Water: No.233 **McDONALDS** (b) The applicant must plant indigenous or low water use **VICTORIA ST** species of vegetation throughout the area of land **BRICK BUILDING** specified for the dwelling in the "Indigenous species" 0 column of the table below, as private landscaping for "U that dwelling. (This area of indigenous vegetation is to be contained within the "Area of garden and lawn" for the \DA-0-801 dwelling specified in the "Description of Project" table). NO N9.00 (e) The applicant must not install a private swimming No.14 pool or spa for the dwelling, with a volume exceeding OSD TANK & RAINWATER TANK BELOW. that specified for it in the table below. MARLBOROUGH ST FOR DETAILS REFER STORMWATER SPEED HUMP SIGN DRAWINGS (g) The pool or spa must be located as specified in the DRIVEWAY NCKELLE table BOUNDARY FENCE AS PER - VERTICAL GARDEN AS PER LANDSCAPE DETAILS -- VERTICAL GANDEL.... LANDSCAPE DETAILS (h) The applicant must install, for the dwelling, each Boundary - 41.32 m-01/1/ L-LC RETAINING alternative water supply system, with the specified size. listed for that dwelling in the table below. Each system must be configured to collect run-off from the areas specified (excluding any area which supplies any other PAINTED TRAFFIC ISLAND alternative water supply system), and to divert overflow RL 31.00 m as specified. Each system must be connected as 1800 HIGH FENCE ABOVE -RL 31.00 m VEHICULAR ACCESS ROLLER specified. **RETAINING WALL** TO BASEMENT SHUTTER 9M RAMP 1:20 RL 30.55 m VOID ABOVE (ii) Energy: **BUILDING LINE ABOVE** OPEN SLATTED SCREEN TO (b) The applicant must install each hot water system SPEED HUMP SIGN MATCH BOUNDARY FENCE specified for the dwelling in the table below, so that the dwelling's hot water is supplied by that system. If the RET ROLLER GLAZED DOOR table specifies a central hot water system for the SHUTTER (OPEN DURING RETAIL OPERATION HOURS) dwelling, then the applicant must connect that central DA-0-303 CO system to the dwelling, so that the dwelling's hot water PEDESTRIAN ACCESS is supplied by that central system. **BUILDING SIGNAGE & RECESSED MAILBOX** PARKING_TOTAL 2 SPACES FIRE HYDRANT BOOSTER (f) This commitment applies to each room or area of the INC 1 ACCESSIBLE RETAIL A.SWITCH COM dwelling which is referred to in a heading to the "Natural RETAIL AND RESIDENTIAL 1 RETAIL lighting" column of the table below (but only to the BULK WAS VISITOR BICYCLE PARKING AIRLOC RETAIL ACCESS extent specified for that room or area). The applicant 1 4 m² ZE\ (4)(LOCALISED CANOPY must ensure that each such room or area is fitted with a CH Tap/D MMON ACCESSIBLE TOILET COUNCIL'S 2400 2400 window and/or skylight. ABOVE BICYCLE RACKS) RE PUMP ROOM GARBAGE 1800 ES LOBBY (iii) Thermal Comfort; TRUCK 90 m² 21 m² VERTICAL GARDEN METER (g) Where there is an in-slab heating or cooling system, **PLANT** CAR LIFT CAR LIFT the applicant must: RL 31.00 m DA-0-401 DA-0-401 PERMEABLE PAVING (aa) Install insulation with an R-value of not less than 1.0 PLANT AIRLOCK around the vertical edges of the perimeter of the slab; or 4780 (bb) On a suspended floor, install insulation with an R-FS value of not less than 1.0 underneath the slab and No.12 around the vertical edges of the perimeter of the slab. RL 31.00 m PLANT SERVICE ACCESS / FIRE S/A LOADING ZONE RL 31.00 m MARLBORQUEH ST (h) The applicant must construct the floors and walls of the development in accordance with the specifications Boundary - 44.61 m listed in the table below CONCES SKERB DP628349 (b) Common areas and central systems/facilities PIBRO No225 NOSSP BRICK & (i) Water: **VICTORIA ST** 03 (b) The applicant must install (or ensure that the NEW DE 3.73 development is serviced by) the alternative water supply system(s) specified in the "Central systems" column of the table below. In each case, the system must be sized, be configured, and be connected, as specified in table. No223 (c) A swimming pool or spa listed in the table must not **VICTORIA ST** have a volume in (kLs) greater than that specified for the pool or spa in the table \DA-0-30 (ii) Energy: No221 2060

(c) The applicant must install the systems and fixtures specified in the "Central energy systems" column of the table below. In each case, the system of fixture must be , of the type, and meet the specifications, listed for it in

Dickson Rothschild D.R. Design (NSW) Pty. Ltd. 65-69 Kent Street, Millers Point, Sydney, NSW 2000 ABN: 35 134 237 540

Phone: +61 2 8540 8720 ndickson@dicksonrothschild.com.au www.dicksonrothschild.com.au Nominated Architect: Robert Nigel Dickson Registration No: 5364

This drawing and design is subject to D.R. Design (NSW) Pty Ltd copyright and may not be reproduced without prior written consent. Contractor to verify all dimensions on site before commencing work. Resolve all discrepancies with the Architect before proceeding. Figured dimensions to be taken in preference to scaled drawings. All work is to conform to relevant Australian Standards and other Codes as applicable, together with other Authorities' requirements and regulations.

、ノ	REV	DESCRIPTION	DATE	ISSUED	CHECKED
	Α	ISSUE FOR DA	28/10/2016	NT	AC
	В	AMENDED AS PER COUNCIL RFI	10/04/2016	MC	AC
	С	FURTHER COUNCIL RFI	06/09/2017	MC	KR
	D	ISSUE FOR PLANNING PANEL	23/11/2017	MC	KR
	E	ENLARGED PEDESTRIAN ACCESSWAYS	30/11/2017	MC	KR
	F	REVISED THERMAL PERFORMANCE SPECIFICATIONS	05/12/2017	MC	KR
S					

- REVISED RESIDENTIAL LOBBY AREA

REVISED RESIDENTIAL WASTE REQUIREMENTS

REVISION D



**REVISION E** 

- ENLARGED PEDESTRIAN ACCESSWAYS

DEVELOPMENT APPLICATION

DRUMMOYNE 227 - 231 VICTORIA ROAD J. BARTOLOTTA

**REVISION F** 

**VICTORIA ST** 

- REVISED THERMAL PERFORMANCE SPECIFICATIONS

**GROUND FLOOR PLAN** 15-030 DA-0-202 27/06/2016 MC,RD AC 1:200 SCALE 1:200

8



ROA

**VICTORIA** 

#### (a) Dwellings

#### (i) Water:

(b) The applicant must plant indigenous or low water use species of vegetation throughout the area of land specified for the dwelling in the "Indigenous species" column of the table below, as private landscaping for that dwelling. (This area of indigenous vegetation is to be contained within the "Area of garden and lawn" for the dwelling specified in the "Description of Project" table).

(e) The applicant must not install a private swimming pool or spa for the dwelling, with a volume exceeding that specified for it in the table below.

(g) The pool or spa must be located as specified in the

(h) The applicant must install, for the dwelling, each alternative water supply system, with the specified size. listed for that dwelling in the table below. Each system must be configured to collect run-off from the areas specified (excluding any area which supplies any other alternative water supply system), and to divert overflow as specified. Each system must be connected as specified.

#### (ii) Energy:

(b) The applicant must install each hot water system specified for the dwelling in the table below, so that the dwelling's hot water is supplied by that system. If the table specifies a central hot water system for the dwelling, then the applicant must connect that central system to the dwelling, so that the dwelling's hot water is supplied by that central system.

(f) This commitment applies to each room or area of the dwelling which is referred to in a heading to the "Natural lighting" column of the table below (but only to the extent specified for that room or area). The applicant must ensure that each such room or area is fitted with a window and/or skylight.

#### (iii) Thermal Comfort;

(g) Where there is an in-slab heating or cooling system, the applicant must:

(aa) Install insulation with an R-value of not less than 1.0_ around the vertical edges of the perimeter of the slab; or (bb) On a suspended floor, install insulation with an Rvalue of not less than 1.0 underneath the slab and around the vertical edges of the perimeter of the slab.

(h) The applicant must construct the floors and walls of the development in accordance with the specifications listed in the table below

#### (b) Common areas and central systems/facilities


#### (i) Water:

(b) The applicant must install (or ensure that the development is serviced by) the alternative water supply system(s) specified in the "Central systems" column of the table below. In each case, the system must be sized, be configured, and be connected, as specified in table.

(c) A swimming pool or spa listed in the table must not have a volume in (kLs) greater than that specified for the pool or spa in the table

#### (ii) Energy:

(c) The applicant must install the systems and fixtures specified in the "Central energy systems" column of the table below. In each case, the system of fixture must be of the type, and meet the specifications, listed for it in

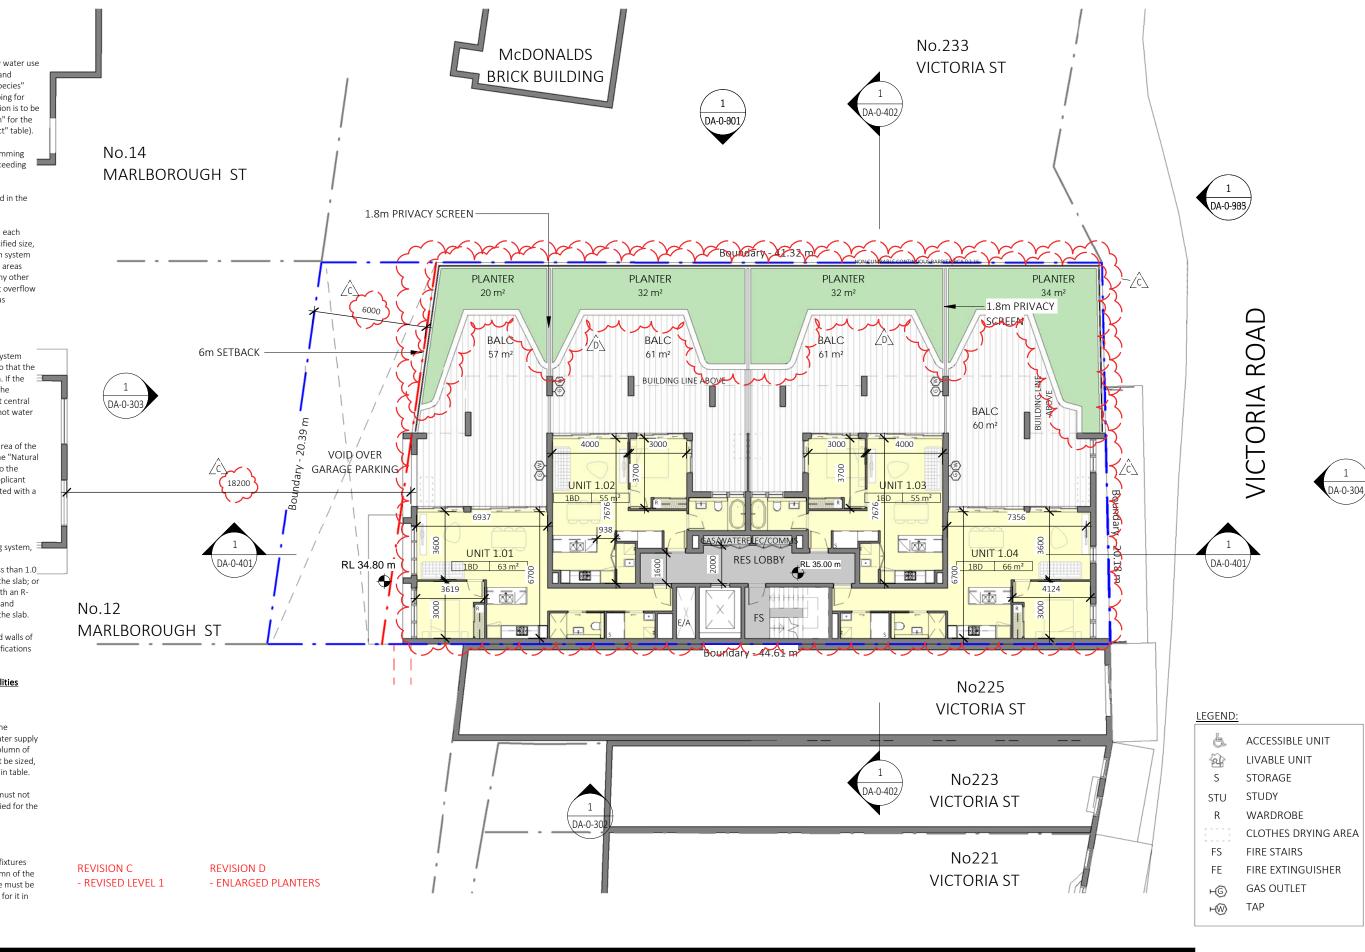

Dickson Rothschild D.R. Design (NSW) Pty. Ltd. 65-69 Kent Street, Millers Point, Sydney, NSW 2000 ABN: 35 134 237 540

Phone: +61 2 8540 8720 ndickson@dicksonrothschild.com.au www.dicksonrothschild.com.au Nominated Architect: Robert Nigel Dickson Registration No: 5364

This drawing and design is subject to D.R. Design (NSW) Pty Ltd copyright and may not be reproduced without prior written consent. Contractor to verify all dimensions on site before commencing work. Resolve all discrepancies with the Architect before proceeding. Figured dimensions to be taken in preference to scaled drawings. All work is to conform to relevant Australian Standards and other Codes as applicable, together with other Authorities' requirements and regulations.

	REV	DESCRIPTION	DATE	ISSUED	CHECK
	Α	ISSUE FOR DA	28/10/2016	NT	AC
	В	AMENDED AS PER COUNCIL RFI	10/04/2016	MC	AC
	С	ISSUE FOR PLANNING PANEL	23/11/2017	MC	KR
	D	ENLARGED PLANTERS	30/11/2017	MC	KR
5					



DRUMMOYNE LEVEL 1 FLOOR PLAN 227 - 231 VICTORIA ROAD J. BARTOLOTTA

DEVELOPMENT APPLICATION

15-030 DA-<u>0-203 D</u> 27/06/2016 MC,RD AC 1:200 SCALE 1:200



#### (a) Dwellings

#### (i) Water:

(b) The applicant must plant indigenous or low water use species of vegetation throughout the area of land specified for the dwelling in the "Indigenous species" column of the table below, as private landscaping for that dwelling. (This area of indigenous vegetation is to be contained within the "Area of garden and lawn" for the dwelling specified in the "Description of Project" table).

(e) The applicant must not install a private swimming pool or spa for the dwelling, with a volume exceeding that specified for it in the table below.

(g) The pool or spa must be located as specified in the table.

(h) The applicant must install, for the dwelling, each alternative water supply system, with the specified size. listed for that dwelling in the table below. Each system must be configured to collect run-off from the areas specified (excluding any area which supplies any other alternative water supply system), and to divert overflow as specified. Each system must be connected as specified.

#### (ii) Energy:

(b) The applicant must install each hot water system specified for the dwelling in the table below, so that the dwelling's hot water is supplied by that system. If the table specifies a central hot water system for the dwelling, then the applicant must connect that central system to the dwelling, so that the dwelling's hot water is supplied by that central system.

(f) This commitment applies to each room or area of the dwelling which is referred to in a heading to the "Natural lighting" column of the table below (but only to the extent specified for that room or area). The applicant must ensure that each such room or area is fitted with a window and/or skylight.

#### (iii) Thermal Comfort;

(g) Where there is an in-slab heating or cooling system, the applicant must:

(aa) Install insulation with an R-value of not less than 1.0 around the vertical edges of the perimeter of the slab; or (bb) On a suspended floor, install insulation with an Rvalue of not less than 1.0 underneath the slab and around the vertical edges of the perimeter of the slab.

(h) The applicant must construct the floors and walls of the development in accordance with the specifications listed in the table below

#### (b) Common areas and central systems/facilities


#### (i) Water:

(b) The applicant must install (or ensure that the development is serviced by) the alternative water supply system(s) specified in the "Central systems" column of the table below. In each case, the system must be sized, be configured, and be connected, as specified in table.

(c) A swimming pool or spa listed in the table must not have a volume in (kLs) greater than that specified for the pool or spa in the table

#### (ii) Energy:

(c) The applicant must install the systems and fixtures specified in the "Central energy systems" column of the table below. In each case, the system of fixture must be of the type, and meet the specifications, listed for it in

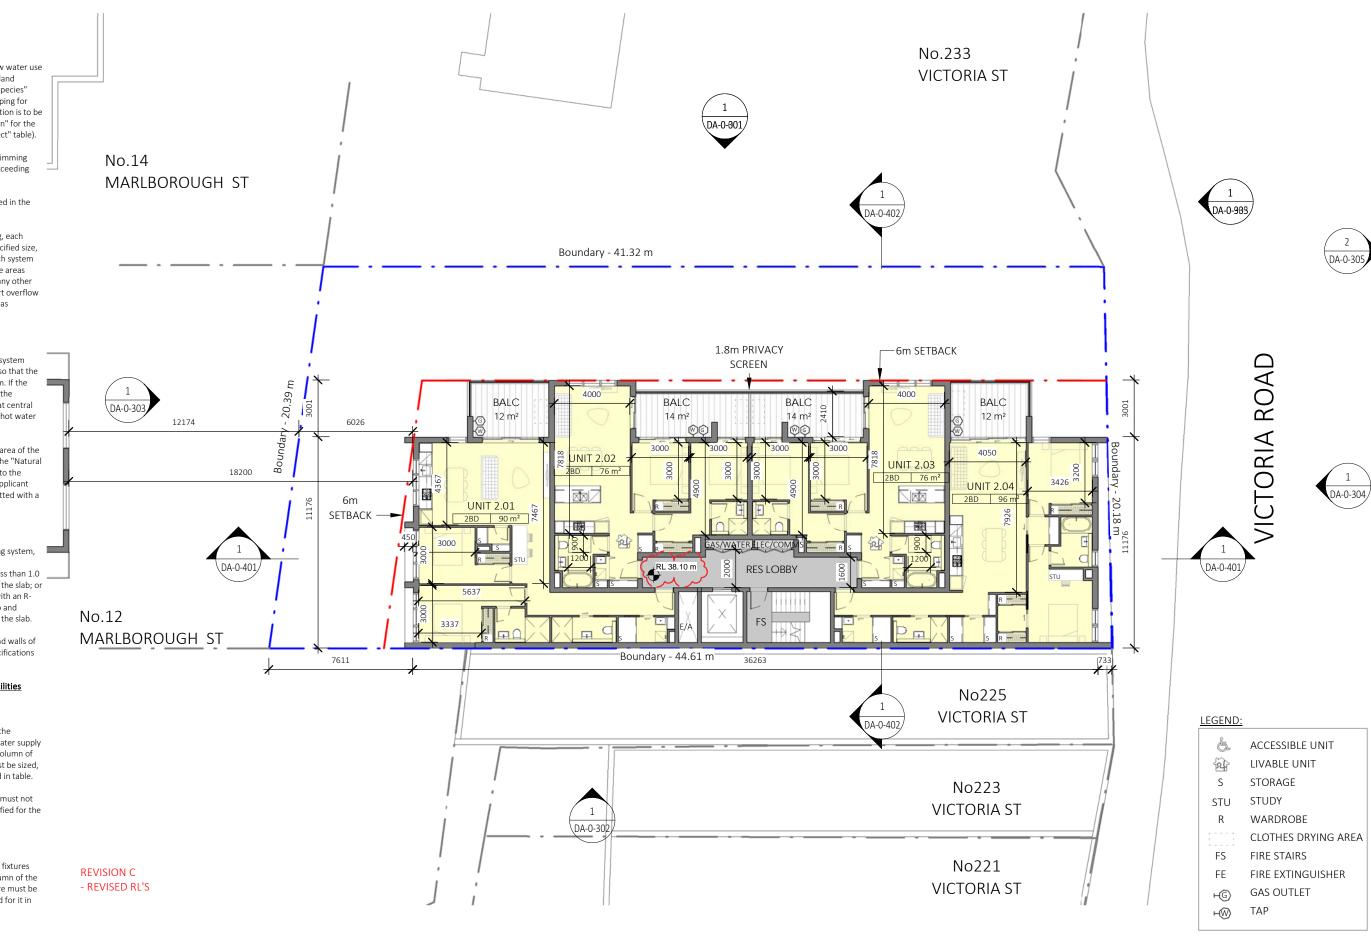

Dickson Rothschild D.R. Design (NSW) Pty. Ltd. 65-69 Kent Street, Millers Point, Sydney, NSW 2000 ABN: 35 134 237 540

Phone: +61 2 8540 8720 ndickson@dicksonrothschild.com.au www.dicksonrothschild.com.au Nominated Architect: Robert Nigel Dickson Registration No: 5364

This drawing and design is subject to D.R. Design (NSW) Pty Ltd copyright and may not be reproduced without prior written consent. Contractor to verify all dimensions on site before commencing work. Resolve all discrepancies with the Architect before proceeding. Figured dimensions to be taken in preference to scaled drawings. All work is to conform to relevant Australian Standards and other Codes as applicable, together with other Authorities' requirements and regulations.

ILLV	DESCRIT FION	DATE	1330ED	CHECKEL
Α	ISSUE FOR DA	28/10/2016	NT	AC
В	AMENDED AS PER COUNCIL RFI	10/04/2016	MC	AC
С	ISSUE FOR PLANNING PANEL	23/11/2017	MC	KR



PROJECT	DRAWING	
DRUMMOYNE	LEVEL 2 FLOOR	PLAN
227 - 231 VICTORIA ROAD	PROJECT NO. DRAWING NO.	REVISION
CLIENT	15-030 DA-0-204	С
J. BARTOLOTTA	SCALE @ A3 1:200	DRAWN MC,RD

DEVELOPMENT APPLICATION

5-030 DA-0-2<u>04</u> 27/06/2016 ALE @ A3 : 200 MC,RD AC SCALE 1:200



#### (a) Dwellings

#### (i) Water:

(b) The applicant must plant indigenous or low water use species of vegetation throughout the area of land specified for the dwelling in the "Indigenous species" column of the table below, as private landscaping for that dwelling. (This area of indigenous vegetation is to be contained within the "Area of garden and lawn" for the dwelling specified in the "Description of Project" table).

(e) The applicant must not install a private swimming pool or spa for the dwelling, with a volume exceeding that specified for it in the table below.

(g) The pool or spa must be located as specified in the

(h) The applicant must install, for the dwelling, each alternative water supply system, with the specified size, listed for that dwelling in the table below. Each system must be configured to collect run-off from the areas specified (excluding any area which supplies any other alternative water supply system), and to divert overflow as specified. Each system must be connected as

#### (ii) Energy:

(h) The applicant must install each hot water system specified for the dwelling in the table below, so that the dwelling's hot water is supplied by that system. If the table specifies a central hot water system for the dwelling, then the applicant must connect that central system to the dwelling, so that the dwelling's hot water is supplied by that central system.

(f) This commitment applies to each room or area of the dwelling which is referred to in a heading to the "Natural lighting" column of the table below (but only to the extent specified for that room or area). The applicant must ensure that each such room or area is fitted with a window and/or skylight.

#### (iii) Thermal Comfort;

(g) Where there is an in-slab heating or cooling system, the applicant must:

(aa) Install insulation with an R-value of not less than 1.0 around the vertical edges of the perimeter of the slab; or (bb) On a suspended floor, install insulation with an Rvalue of not less than 1.0 underneath the slab and around the vertical edges of the perimeter of the slab.

(h) The applicant must construct the floors and walls of the development in accordance with the specifications listed in the table below

#### (b) Common areas and central systems/facilities


#### (i) Water:

(b) The applicant must install (or ensure that the development is serviced by) the alternative water supply system(s) specified in the "Central systems" column of the table below. In each case, the system must be sized, be configured, and be connected, as specified in table.

(c) A swimming pool or spa listed in the table must not have a volume in (kLs) greater than that specified for the pool or spa in the table

#### (ii) Energy:

(c) The applicant must install the systems and fixtures specified in the "Central energy systems" column of the table below. In each case, the system of fixture must be of the type, and meet the specifications, listed for it in

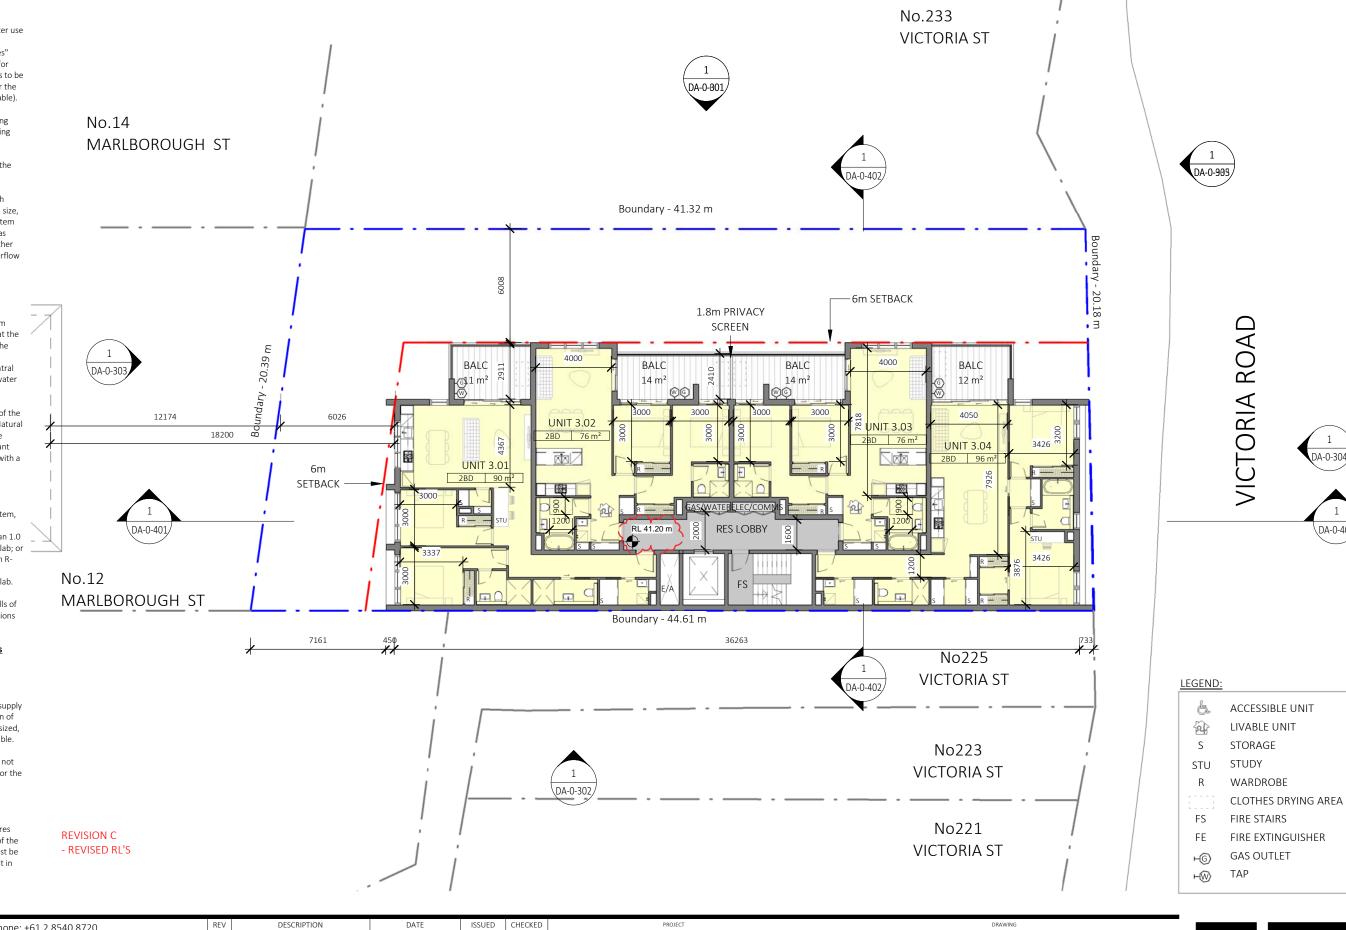

Dickson Rothschild D.R. Design (NSW) Pty. Ltd. 65-69 Kent Street, Millers Point, Sydney, NSW 2000 ABN: 35 134 237 540

Phone: +61 2 8540 8720 ndickson@dicksonrothschild.com.au www.dicksonrothschild.com.au Nominated Architect: Robert Nigel Dickson Registration No: 5364

This drawing and design is subject to D.R. Design (NSW) Pty Ltd copyright and may not be reproduced without prior written consent. Contractor to verify all dimensions on site before commencing work. Resolve all discrepancies with the Architect before proceeding. Figured dimensions to be taken in preference to scaled drawings. All work is to conform to relevant Australian Standards and other Codes as applicable, together with other Authorities' requirements and regulations.

REV	DESCRIPTION	DATE	ISSUED	CHECKED
Α	ISSUE FOR DA	28/10/2016	NT	AC
В	AMENDED AS PER COUNCIL RFI	10/04/2016	MC	AC
С	ISSUE FOR PLANNING PANEL	23/11/2017	MC	KR



DRUMMOYNE	LEVEL 3 FLOOR PLAN
227 - 231 VICTORIA ROAD	PROJECT NO. DRAWING NO. REVISION
CLIENT	15-030 DA-0-205 C
J. BARTOLOTTA	SCALE @ A3 DRAWN 1:200 MC,RD

DEVELOPMENT APPLICATION

15-030 DA-0-205 27/06/2016 MC,RD AC 1:200 SCALE 1:200



#### (a) Dwellings

#### (i) Water:

(b) The applicant must plant indigenous or low water use species of vegetation throughout the area of land specified for the dwelling in the "Indigenous species" column of the table below, as private landscaping for that dwelling. (This area of indigenous vegetation is to be contained within the "Area of garden and lawn" for the dwelling specified in the "Description of Project" table).

(e) The applicant must not install a private swimming pool or spa for the dwelling, with a volume exceeding that specified for it in the table below.

(g) The pool or spa must be located as specified in the table.

(h) The applicant must install, for the dwelling, each alternative water supply system, with the specified size, listed for that dwelling in the table below. Each system must be configured to collect run-off from the areas specified (excluding any area which supplies any other alternative water supply system), and to divert overflow as specified. Each system must be connected as specified.

#### (ii) Energy:

(b) The applicant must install each hot water system specified for the dwelling in the table below, so that the dwelling's hot water is supplied by that system. If the table specifies a central hot water system for the dwelling, then the applicant must connect that central system to the dwelling, so that the dwelling's hot water is supplied by that central system.

(f) This commitment applies to each room or area of the dwelling which is referred to in a heading to the "Natural lighting" column of the table below (but only to the extent specified for that room or area). The applicant must ensure that each such room or area is fitted with a window and/or skylight.

#### (iii) Thermal Comfort;

(g) Where there is an in-slab heating or cooling system, the applicant must:

(aa) Install insulation with an R-value of not less than 1.0 around the stall edges of the perimeter of the slab; or (bb) On a suspended floor, install insulation with an Rvalue anot less that 0 underneath the slab and around the Acot 1905 edges of the perimeter of the slab. No.12

the development in accordance with the specifications listed in the table below

#### (b) Common areas and central systems/facilities


#### (i) Water:

(b) The applicant must install (or ensure that the development is serviced by) the alternative water supply system(s) specified in the "Central systems" column of the table below. In each case, the system must be sized, be configured, and be connected, as specified in table.

(c) A swimming pool or spa listed in the table must not have a volume in (kLs) greater than that specified for the pool or spa in the table

#### (ii) Energy:

(c) The applicant must install the systems and fixtures specified in the "Central energy systems" column of the table below. In each case, the system of fixture must be of the type, and meet the specifications, listed for it in the table

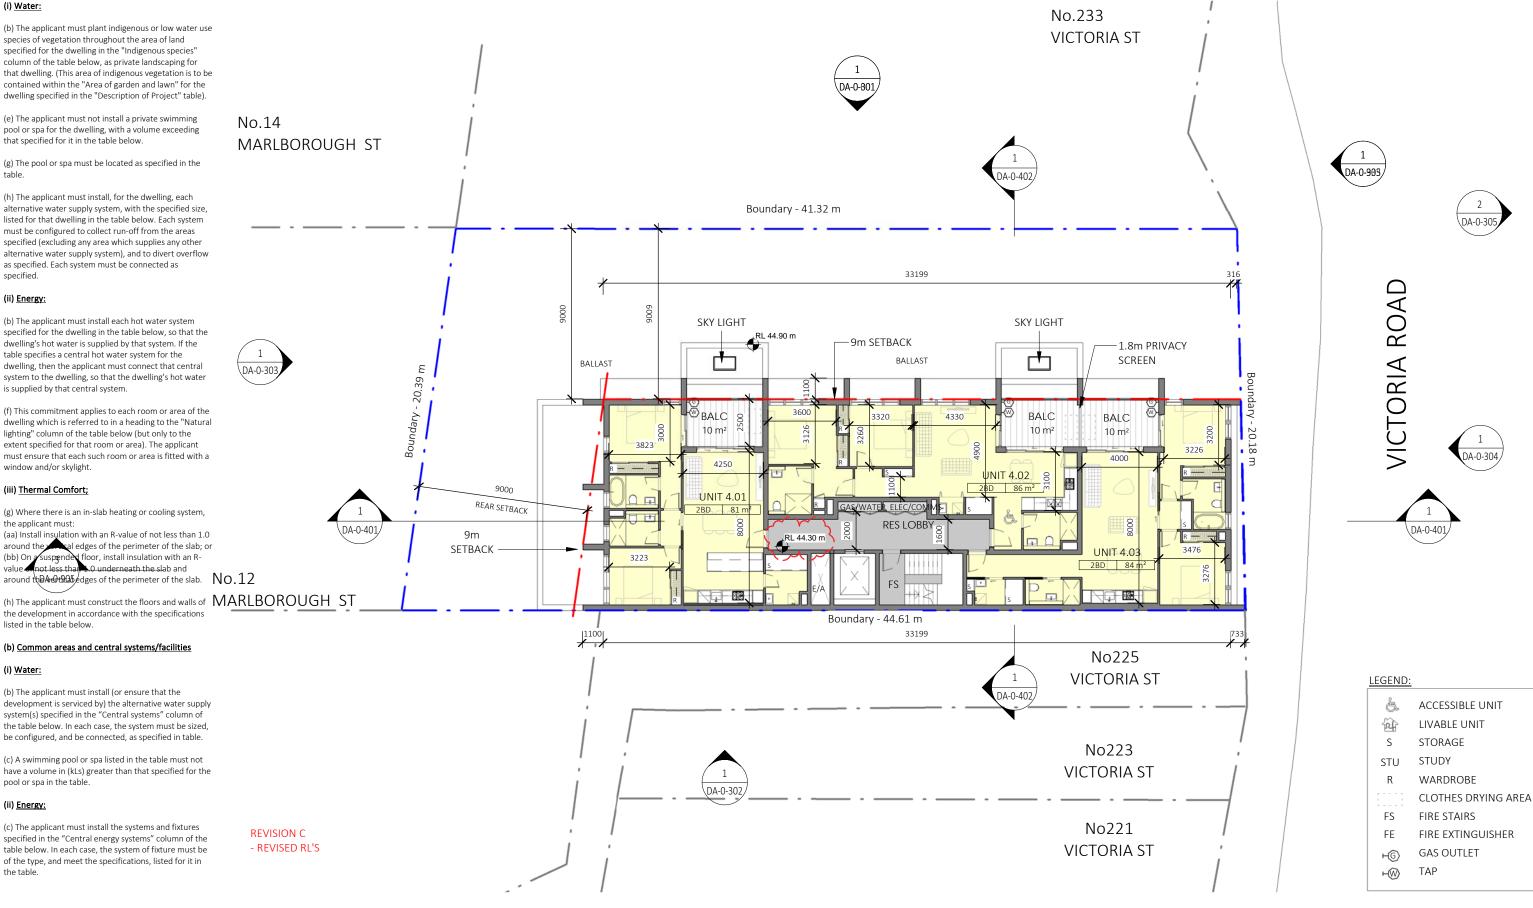

Dickson Rothschild D.R. Design (NSW) Pty. Ltd. 65-69 Kent Street, Millers Point, Sydney, NSW 2000 ABN: 35 134 237 540

Phone: +61 2 8540 8720 ndickson@dicksonrothschild.com.au www.dicksonrothschild.com.au Nominated Architect: Robert Nigel Dickson Registration No: 5364

This drawing and design is subject to D.R. Design (NSW) Pty Ltd copyright and may not be reproduced without prior written consent. Contractor to verify all dimensions on site before commencing work. Resolve all discrepancies with the Architect before proceeding. Figured dimensions to be taken in preference to scaled drawings. All work is to conform to relevant Australian Standards and other Codes as applicable, together with other Authorities' requirements and regulations.

	I/L V	DESCRIFTION	DATE	1330LD	CHILCKLE
	Α	ISSUE FOR DA	28/10/2016	NT	AC
	В	AMENDED AS PER COUNCIL RFI	10/04/2016	MC	AC
	С	ISSUE FOR PLANNING PANEL	23/11/2017	MC	KR
5					



DRUMMOYNE 227 - 231 VICTORIA ROAD J. BARTOLOTTA

DEVELOPMENT APPLICATION

LEVEL 4 FLOOR PLAN

15-030 DA-0-206 27/06/2016 MC,RD AC 1:200 SCALE 1:200



#### (a) Dwellings

#### (i) Water:

- (b) The applicant must plant indigenous or low water use species of vegetation throughout the area of land specified for the dwelling in the "Indigenous species" column of the table below, as private landscaping for that dwelling. (This area of indigenous vegetation is to be contained within the "Area of garden and lawn" for the dwelling specified in the "Description of Project" table).
- (e) The applicant must not install a private swimming pool or spa for the dwelling, with a volume exceeding that specified for it in the table below.
- (g) The pool or spa must be located as specified in the
- (h) The applicant must install, for the dwelling, each alternative water supply system, with the specified size, listed for that dwelling in the table below. Each system must be configured to collect run-off from the areas specified (excluding any area which supplies any other alternative water supply system), and to divert overflow as specified. Each system must be connected as specified.

#### (ii) Energy:

- (b) The applicant must install each hot water system specified for the dwelling in the table below, so that the dwelling's hot water is supplied by that system. If the table specifies a central hot water system for the dwelling, then the applicant must connect that central system to the dwelling, so that the dwelling's hot water is supplied by that central system.
- (f) This commitment applies to each room or area of the dwelling which is referred to in a heading to the "Natural lighting" column of the table below (but only to the extent specified for that room or area). The applicant must ensure that each such room or area is fitted with a window and/or skylight.

#### (iii) Thermal Comfort;

- (g) Where there is an in-slab heating or cooling system, the applicant must:
- (aa) Install insulation with an R-value of not less than 1.0 around the vertical edges of the perimeter of the slab; or (bb) On a susper at floor, install insulation with an R-value of not less than 1.0 underneath the slab and around the vertical edge of the perimeter of the slab.

  \[ DA-0-905 \]
- (h) The applicant must construct the floors and walls of the development in accordance with the specifications listed in the table below.


#### (b) Common areas and central systems/facilities

#### (i) Water:

- (b) The applicant must install (or ensure that the development is serviced by) the alternative water supply system(s) specified in the "Central systems" column of the table below. In each case, the system must be sized, be configured, and be connected, as specified in table.
- (c) A swimming pool or spa listed in the table must not have a volume in (kLs) greater than that specified for the pool or spa in the table.

#### (ii) Energy:

(c) The applicant must install the systems and fixtures specified in the "Central energy systems" column of the table below. In each case, the system of fixture must be of the type, and meet the specifications, listed for it in the table.

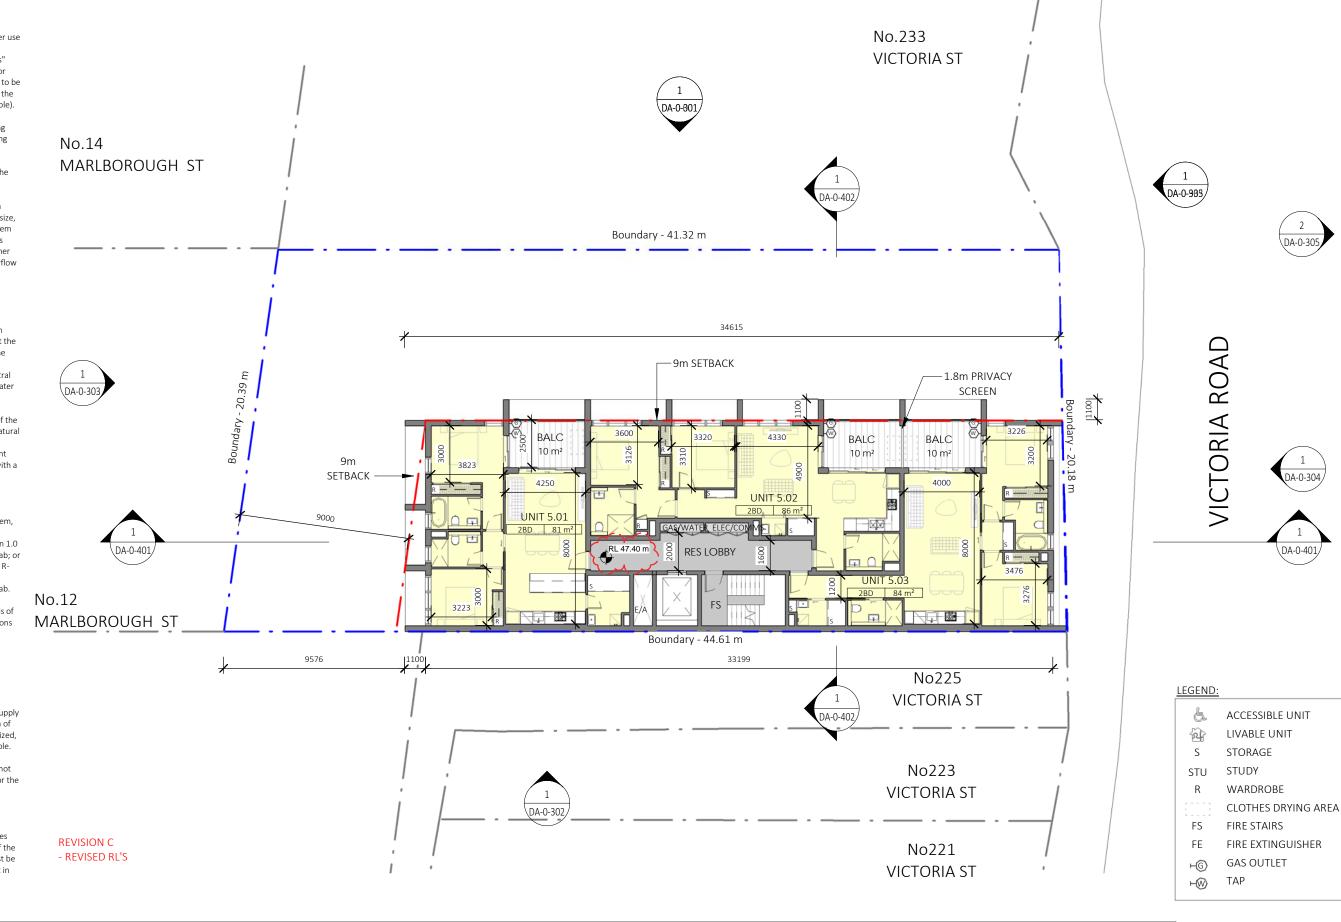

Dickson Rothschild D.R. Design (NSW) Pty. Ltd. 65-69 Kent Street, Millers Point, Sydney, NSW 2000 ABN: 35 134 237 540 Phone: +61 2 8540 8720 ndickson@dicksonrothschild.com.au www.dicksonrothschild.com.au Nominated Architect: Robert Nigel Dickson Registration No: 5364

This drawing and design is subject to D.R. Design (NSW) Pty Ltd copyright and may not be reproduced without prior written consent. Contractor to verify all dimensions on site before commencing work. Resolve all discrepancies with the Architect before proceeding. Figured dimensions to be taken in preference to scaled drawings. All work is to conform to relevant Australian Standards and other Codes as applicable, together with other Authorities' requirements and regulations.

	REV	DESCRIPTION	DATE	ISSUED	CHECKEL
	Α	ISSUE FOR DA	28/10/2016	NT	AC
	В	AMENDED AS PER COUNCIL RFI	10/04/2016	MC	AC
	С	ISSUE FOR PLANNING PANEL	23/11/2017	MC	KR
5					



DRUMMOYNE

227 - 231 VICTORIA ROAD

CLIENT

J. BARTOLOTTA

DEVELOPMENT APPLICATION

LEVEL 5 FLOOR PLAN



#### (a) Dwellings

## (i) Water:

(b) The applicant must plant indigenous or low water use species of vegetation throughout the area of land specified for the dwelling in the "Indigenous species" column of the table below, as private landscaping for that dwelling. (This area of indigenous vegetation is to be contained within the "Area of garden and lawn" for the dwelling specified in the "Description of Project" table).

(e) The applicant must not install a private swimming pool or spa for the dwelling, with a volume exceeding that specified for it in the table below.

(g) The pool or spa must be located as specified in the

(h) The applicant must install, for the dwelling, each alternative water supply system, with the specified size. listed for that dwelling in the table below. Each system must be configured to collect run-off from the areas specified (excluding any area which supplies any other alternative water supply system), and to divert overflow as specified. Each system must be connected as specified.

## (ii) Energy:

(b) The applicant must install each hot water system specified for the dwelling in the table below, so that the dwelling's hot water is supplied by that system. If the table specifies a central hot water system for the dwelling, then the applicant must connect that central system to the dwelling, so that the dwelling's hot water is supplied by that central system.

(f) This commitment applies to each room or area of the dwelling which is referred to in a heading to the "Natural lighting" column of the table below (but only to the extent specified for that room or area). The applicant must ensure that each such room or area is fitted with a window and/or skylight.

#### (iii) Thermal Comfort;

(g) Where there is an in-slab heating or cooling system, the applicant must:

(aa) Install insulation with an R-value of not less than 1.0 around the vertical edges of the perimeter of the slab; or (bb) On a suspended floor, install insulation with an No.12 value of not less than 1.0 underneath the slab and around the vertical edges of the perimeter of the slaMARLBOROUGH ST

(h) The applicant must construct the floors and walls of the development in accordance with the specifications listed in the table below

#### (b) Common areas and central systems/facilities


#### (i) Water:

(b) The applicant must install (or ensure that the development is serviced by) the alternative water supply system(s) specified in the "Central systems" column of the table below. In each case, the system must be sized, be configured, and be connected, as specified in table.

(c) A swimming pool or spa listed in the table must not have a volume in (kLs) greater than that specified for the pool or spa in the table

#### (ii) Energy:

(c) The applicant must install the systems and fixtures specified in the "Central energy systems" column of the table below. In each case, the system of fixture must be of the type, and meet the specifications, listed for it in

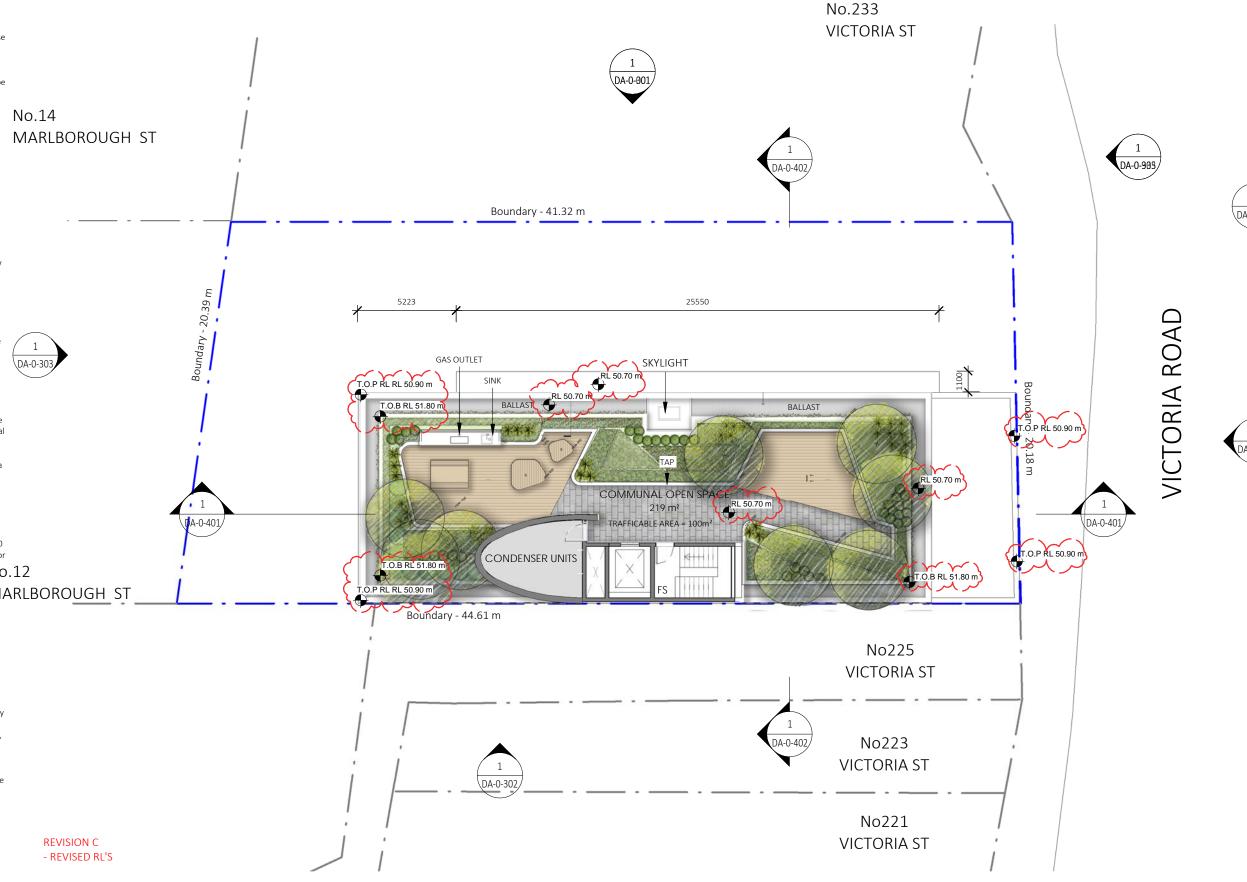

Dickson Rothschild D.R. Design (NSW) Pty. Ltd. 65-69 Kent Street, Millers Point, Sydney, NSW 2000 ABN: 35 134 237 540

Phone: +61 2 8540 8720 ndickson@dicksonrothschild.com.au www.dicksonrothschild.com.au Nominated Architect: Robert Nigel Dickson Registration No: 5364

This drawing and design is subject to D.R. Design (NSW) Pty Ltd copyright and may not be reproduced without prior written consent. Contractor to verify all dimensions on site before commencing work. Resolve all discrepancies with the Architect before proceeding. Figured dimensions to be taken in preference to scaled drawings. All work is to conform to relevant Australian Standards and other Codes as applicable, together with other Authorities' requirements and regulations.

L	REV	DESCRIPTION	DATE	ISSUED	CHECKED
	Α	ISSUE FOR DA	28/10/2016	NT	AC
	В	AMENDED AS PER COUNCIL RFI	10/04/2016	MC	AC
	С	ISSUE FOR PLANNING PANEL	23/11/2017	MC	KR



DRUMMOYNE COMMUNAL OPEN SPACE 227 - 231 VICTORIA ROAD J. BARTOLOTTA 1:200





#### (a) Dwellings

#### (i) Water:

(b) The applicant must plant indigenous or low water use species of vegetation throughout the area of land specified for the dwelling in the "Indigenous species" column of the table below, as private landscaping for that dwelling. (This area of indigenous vegetation is to be contained within the "Area of garden and lawn" for the dwelling specified in the "Description of Project" table).

(e) The applicant must not install a private swimming pool or spa for the dwelling, with a volume exceeding that specified for it in the table below.

(g) The pool or spa must be located as specified in the table.

(h) The applicant must install, for the dwelling, each alternative water supply system, with the specified size, listed for that dwelling in the table below. Each system must be configured to collect run-off from the areas specified (excluding any area which supplies any other alternative water supply system), and to divert overflow as specified. Each system must be connected as specified.

#### (ii) Energy:

(h) The applicant must install each hot water system specified for the dwelling in the table below, so that the dwelling's hot water is supplied by that system. If the table specifies a central hot water system for the dwelling, then the applicant must connect that central system to the dwelling, so that the dwelling's hot water is supplied by that central system.

(f) This commitment applies to each room or area of the dwelling which is referred to in a heading to the "Natural lighting" column of the table below (but only to the extent specified for that room or area). The applicant must ensure that each such room or area is fitted with a window and/or skylight.

#### (iii) Thermal Comfort;

(g) Where there is an in-slab heating or cooling system, the applicant must:

(aa) Install insulation with an R-value of not less than 1.0 around the vertical edges of the perimeter of the slab; or (bb) On a suspended floor, install insulation with an Rvalue of not less than 1.0 underneath the slab and around the vertical edges of the perimeter of the slab.

(h) The applicant must construct the floors and walls of the development in accordance with the specifications listed in the table below

#### (b) Common areas and central systems/facilities


#### (i) Water:

(b) The applicant must install (or ensure that the development is serviced by) the alternative water supply system(s) specified in the "Central systems" column of the table below. In each case, the system must be sized, be configured, and be connected, as specified in table.

(c) A swimming pool or spa listed in the table must not have a volume in (kLs) greater than that specified for the pool or spa in the table

#### (ii) Energy:

(c) The applicant must install the systems and fixtures specified in the "Central energy systems" column of the table below. In each case, the system of fixture must be of the type, and meet the specifications, listed for it in

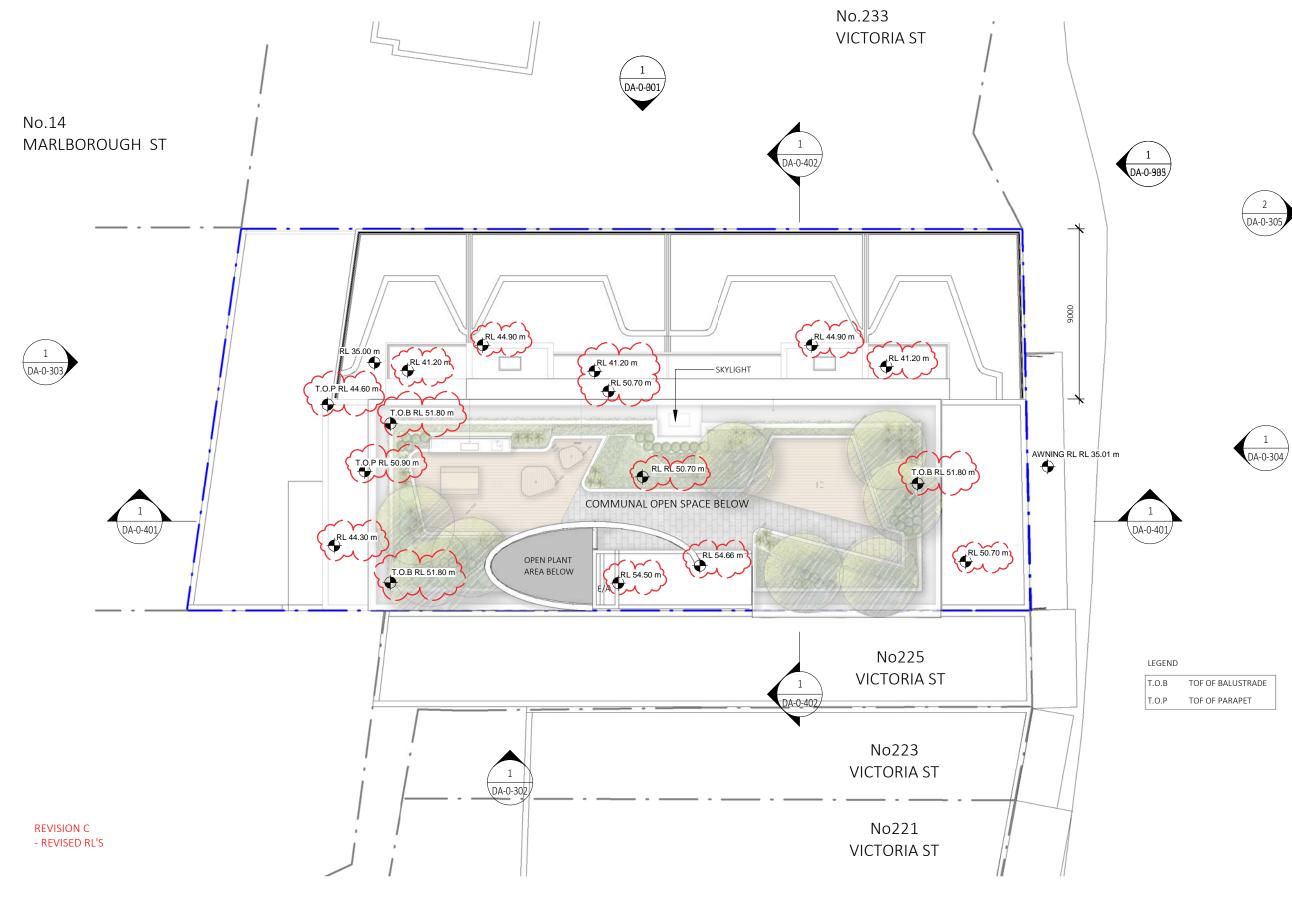

Dickson Rothschild D.R. Design (NSW) Pty. Ltd. 65-69 Kent Street, Millers Point, Sydney, NSW 2000 ABN: 35 134 237 540

Phone: +61 2 8540 8720 ndickson@dicksonrothschild.com.au www.dicksonrothschild.com.au Nominated Architect: Robert Nigel Dickson Registration No: 5364

This drawing and design is subject to D.R. Design (NSW) Pty Ltd copyright and may not be reproduced without prior written consent. Contractor to verify all dimensions on site before commencing work. Resolve all discrepancies with the Architect before proceeding. Figured dimensions to be taken in preference to scaled drawings. All work is to conform to relevant Australian Standards and other Codes as applicable, together with other Authorities' requirements and regulations.

REV	DESCRIPTION	DATE	ISSUED	CHECKED
Α	ISSUE FOR DA	28/10/2016	NT	AC
В	AMENDED AS PER COUNCIL RFI	10/04/2016	MC	AC
С	ISSUE FOR PLANNING PANEL	23/11/2017	MC	KR



DEVELOPMENT APPLICATION


DRUMMOYNE ROOF 227 - 231 VICTORIA ROAD 15-030 DA-0-<u>211</u> J. BARTOLOTTA 1:200

27/06/2016 AC

RD

SCALE 1:200



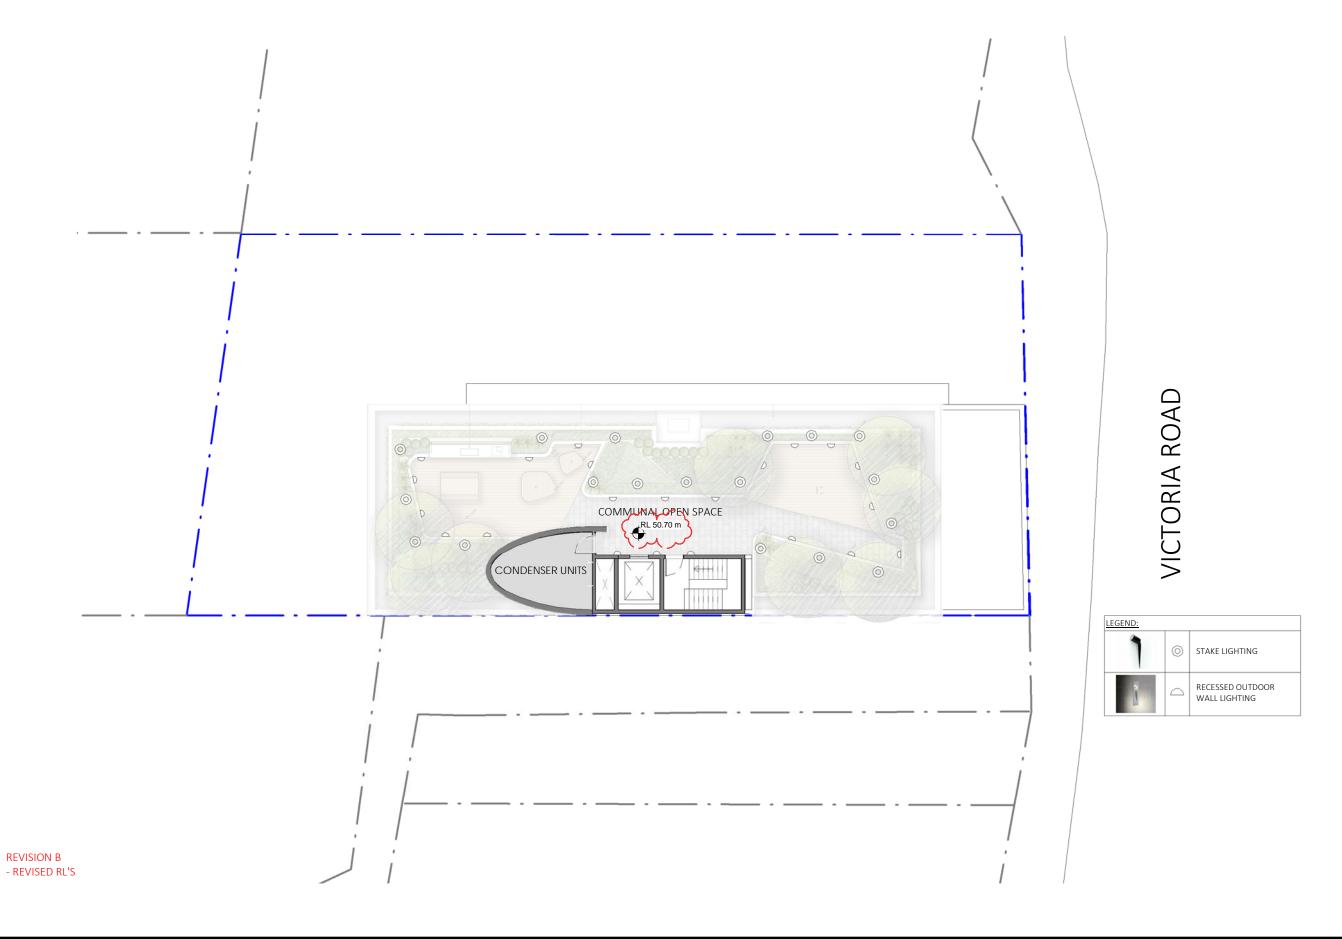

Dickson Rothschild D.R. Design (NSW) Pty. Ltd. 65-69 Kent Street, ABN: 35 134 237 540

Phone: +61 2 8540 8720 ndicks on @dicks on roth schild.com. auwww.dicksonrothschild.com.au Millers Point, Sydney, NSW 2000 Nominated Architect: Robert Nigel Dickson Registration No: 5364

This drawing and design is subject to D.R. Design (NSW) Pty Ltd copyright and may not be reproduced without prior written consent. Contractor to verify all dimensions on site before commencing work. Resolve all discrepancies with the Architect before proceeding. Figured dimensions to be taken in preference to scaled drawings. All work is to conform to relevant Australian Standards and other Codes as applicable, together with other Authorities' requirements and regulations.

	REV	DESCRIPTION	DATE	ISSUED	CHECKED
	Α	AMENDED AS PER COUNCIL RFI	10/04/2016	MC	AC
	В	ISSUE FOR PLANNING PANEL	23/11/2017	MC	KR
5					



DRUMMOYNE 227 - 231 VICTORIA ROAD


C	LIEINI
J	. BARTOLOTTA


3. 57 1111 020 1 171	
DEVELOPMENT APPLICATION	


ROOFTOP LIGHTING PLAN


PROJECT NO.	DRAWING NO.	REVISION	DATE
15-030	DA-0-212	В	27/06/2016
SCALE @ A3		DRAWN	AUTHORISED
1:200		RD	AC




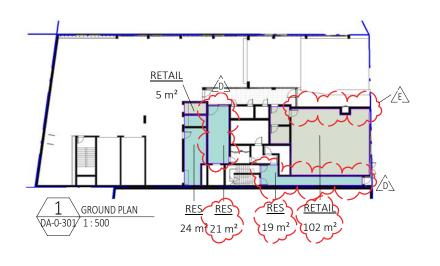


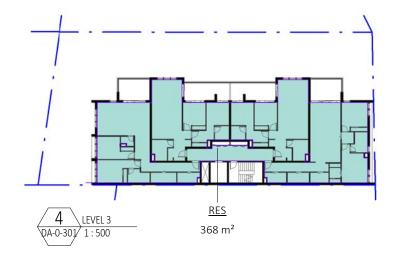


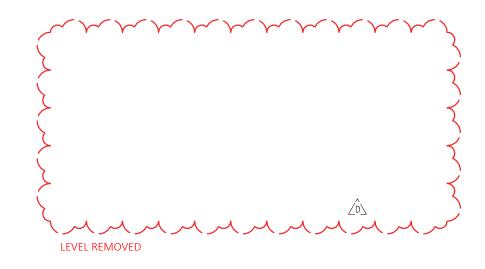

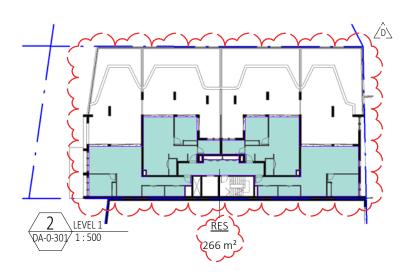

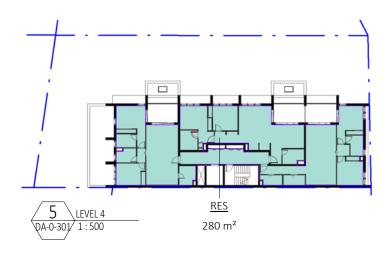

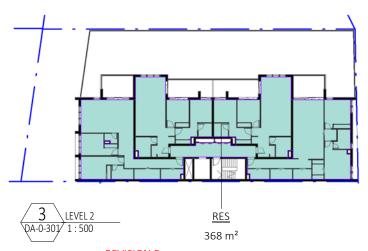

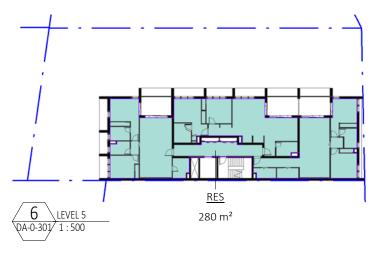

## REVISION D

- REVISED RESIDENTIAL GFA

## REVISION E

- ENLARGED PEDESTRIAN ACCESSWAYS

Dickson Rothschild D.R. Design (NSW) Pty. Ltd. 65-69 Kent Street, ABN: 35 134 237 540

Phone: +61 2 8540 8720 ndickson@dicksonrothschild.com.au www.dicksonrothschild.com.au Millers Point, Sydney, NSW 2000 Nominated Architect: Robert Nigel Dickson Registration No: 5364

This drawing and design is subject to D.R. Design (NSW) Pty Ltd copyright and may not be reproduced without prior written consent. Contractor to verify all dimensions on site before commencing work.

Resolve all discrepancies with the Architect before proceeding. Figured dimensions to be taken in preference to scaled drawings. All work is to conform to relevant Australian Standards and other Codes as applicable, together with other Authorities' requirements and regulations.

	REV	DESCRIPTION	DATE	ISSUED	CHECKED
	Α	ISSUE FOR DA	28/10/2016	NT	AC
	В	AMENDED AS PER COUNCIL RFI	10/04/2016	MC	AC
	С	FURTHER COUNCIL RFI	06/09/2017	MC	KR
	D	ISSUE FOR PLANNING PANEL	23/11/2017	MC	KR
	Е	ENLARGED PEDESTRIAN ACCESSWAYS	30/11/2017	MC	KR
es					



PROJECT	DRAWING
DRUMMOYNE	GFA PLANS
227 - 231 VICTORIA ROAD	PROJECT NO. DRAWING N
CLIENT	15-030 DA-0-2
J. BARTOLOTTA	SCALE @ A3

PROJECT NO.	DRAWING NO.	REVISION	DATE
15-030	DA-0-251	E	27/06/2016
SCALE @ A3		DRAWN	AUTHORISED
1:500		MC,RD	AC
r	SCALE	1:500	25





#### **REVISION D**

- REVISED HEIGHT OF BUILDING
- REVISED LEVEL 1
- REVISED RL'S

Dickson Rothschild D.R. Design (NSW) Pty. Ltd. 65-69 Kent Street, Millers Point, Sydney, NSW 2000 ABN: 35 134 237 540

Phone: +61 2 8540 8720 ndickson@dicksonrothschild.com.au www.dicksonrothschild.com.au Nominated Architect: Robert Nigel Dickson Registration No: 5364

This drawing and design is subject to D.R. Design (NSW) Pty Ltd copyright and may not be reproduced without prior written consent. Contractor to verify all dimensions on site before commencing work. Resolve all discrepancies with the Architect before proceeding. Figured dimensions to be taken in preference to scaled drawings. All work is to conform to relevant Australian Standards and other Codes as applicable, together with other Authorities' requirements and regulations.

REV	DESCRIPTION	DATE	ISSUED	CHECKE
Α	ISSUE FOR DA	28/10/2016	NT	AC
В	AMENDED AS PER COUNCIL RFI	10/04/2016	MC	AC
С	FURTHER COUNCIL RFI	06/09/2017	MC	KR
D	ISSUE FOR PLANNING PANEL	23/11/2017	MC	KR
Ε	ENLARGED PLANTERS	30/11/2017	MC	KR

DRUMMOYNE DRUMMOYNE NORTH ELEVA		
227 - 231 VICTORIA ROAD	PROJECT NO. DRAWING NO.	REVISION
CLIENT	15-030 DA-0-301	E
J. BARTOLOTTA	SCALE @ A3 1:200	DRAWN MC

DEVELOPMENT APPLICATION




TOP OF PARAPET

TOP OF BALUSTRADE

LEGEND T.O.P

DRAWN

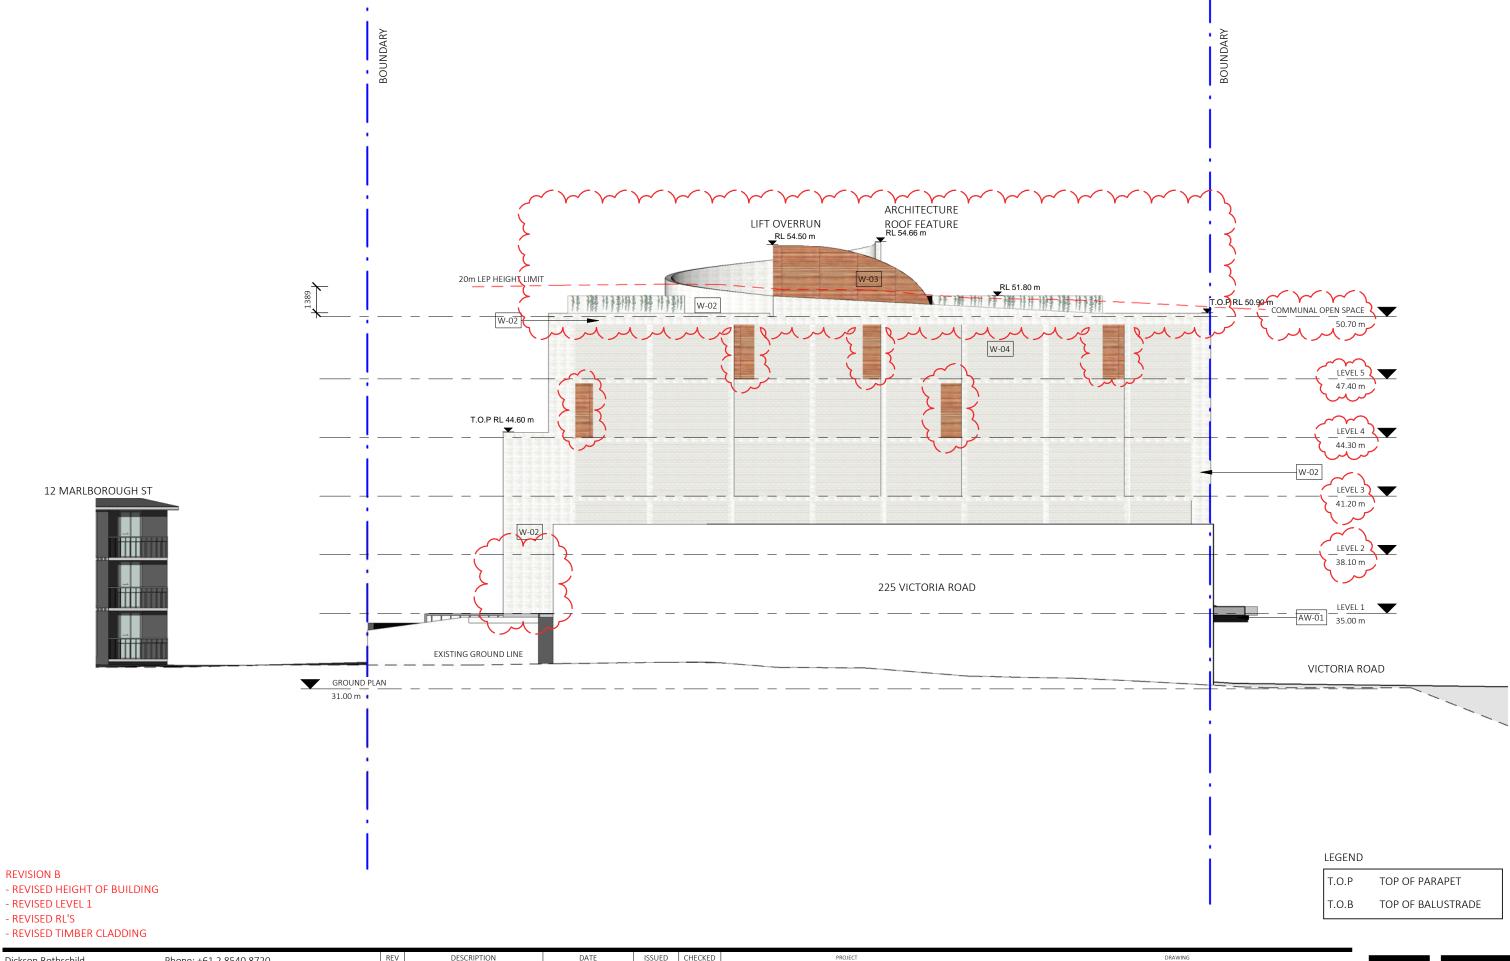

Phone: +61 2 8540 8720 ndicks on @dicks on roth schild.com. auwww.dicksonrothschild.com.au Nominated Architect: Robert Nigel Dickson

Registration No: 5364 This drawing and design is subject to D.R. Design (NSW) Pty Ltd copyright and may not be reproduced without prior written consent. Contractor to verify all dimensions on site before commencing work. Resolve all discrepancies with the Architect before proceeding. Figured dimensions to be taken in preference to scaled drawings. All work is to conform to relevant Australian Standards and other Codes as applicable, together with other Authorities' requirements and regulations.


REV	DESCRIPTION	DATE	ISSUED	CHECKED
Α	ISSUE FOR DA	28/10/2016	NT	AC
В	ISSUE FOR PLANNING PANEL	23/11/2017	MC	KR

DRUMMOYNE	SOUTH ELEVAT	ION
227 - 231 VICTORIA ROAD	PROJECT NO. DRAWING NO.	REVISIO
CLIENT	15-030 DA-0-302	В
J. BARTOLOTTA	SCALE @ A3 1:200	SC DRAWN
	( SCALE	1:200

DEVELOPMENT APPLICATION



SCALE 1:200

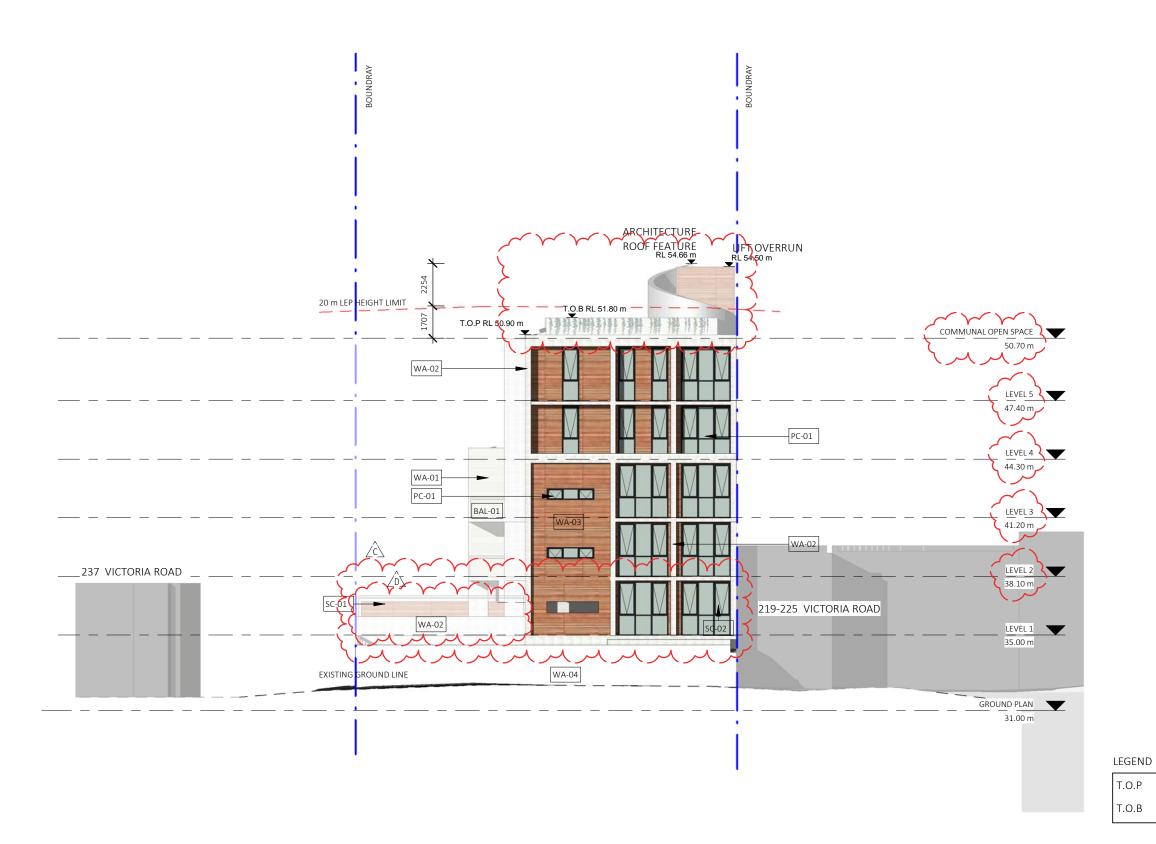

#### **REVISION C**

- REVISED HEIGHT OF BUILDING
- REVISED LEVEL 1
- REVISED RL'S

Dickson Rothschild D.R. Design (NSW) Pty. Ltd. 65-69 Kent Street, Millers Point, Sydney, NSW 2000 ABN: 35 134 237 540

Phone: +61 2 8540 8720 ndickson@dicksonrothschild.com.au www.dicksonrothschild.com.au Nominated Architect: Robert Nigel Dickson Registration No: 5364

This drawing and design is subject to D.R. Design (NSW) Pty Ltd copyright and may not be reproduced without prior written consent. Contractor to verify all dimensions on site before commencing work. Resolve all discrepancies with the Architect before proceeding. Figured dimensions to be taken in preference to scaled drawings. All work is to conform to relevant Australian Standards and other Codes as applicable, together with other Authorities' requirements and regulations.

REV	DESCRIPTION	DATE	ISSUED	CHECKED
Α	ISSUE FOR DA	28/10/2016	NT	AC
В	AMENDED AS PER COUNCIL RFI	10/04/2016	MC	AC
С	ISSUE FOR PLANNING PANEL	23/11/2017	MC	KR
D	ENLARGED PLANTERS	30/11/2017	MC	KR

PROJECT DRUMMOYNE	DRAWING WEST FI FVATI	ΟN
227 - 231 VICTORIA ROAD		
227 - 231 VICTORIA ROAD	PROJECT NO. DRAWING NO.	REVISION
CLIENT	15-030 DA-0-303	D
J. BARTOLOTTA	SCALE @ A3	DRAWN

DEVELOPMENT APPLICATION



AC

MC

SCALE 1:200

TOP OF PARAPET

TOP OF BALUSTRADE



#### **REVISION D**

- REVISED HEIGHT OF BUILDING
- REVISED LEVEL 1
- REVISED RL'S

Dickson Rothschild D.R. Design (NSW) Pty. Ltd. 65-69 Kent Street, Millers Point, Sydney, NSW 2000 ABN: 35 134 237 540

Phone: +61 2 8540 8720 ndickson@dicksonrothschild.com.au www.dicksonrothschild.com.au Nominated Architect: Robert Nigel Dickson Registration No: 5364

This drawing and design is subject to D.R. Design (NSW) Pty Ltd copyright and may not be reproduced without prior written consent. Contractor to verify all dimensions on site before commencing work. Resolve all discrepancies with the Architect before proceeding. Figured dimensions to be taken in preference to scaled drawings. All work is to conform to relevant Australian Standards and other Codes as applicable, together with other Authorities' requirements and regulations.

REV	DESCRIPTION	DATE	ISSUED	CHECKED
Α	ISSUE FOR DA	28/10/2016	NT	AC
В	AMENDED AS PER COUNCIL RFI	10/04/2016	MC	AC
С	FURTHER COUNCIL RFI	06/09/2017	MC	KR
D	ISSUE FOR PLANNING PANEL	23/11/2017	MC	KR
E	ENLARGED PLANTERS	30/11/2017	MC	KR

DRUMMOYNE EAST ELEVATION 227 - 231 VICTORIA ROAD 15-030 DA-0-304 E SCALE @ A3 1:200 J. BARTOLOTTA

DEVELOPMENT APPLICATION

TOP OF BALUSTRADE

AC

MC

SCALE 1:200


LEGEND

T.O.P



TOP OF PARAPET



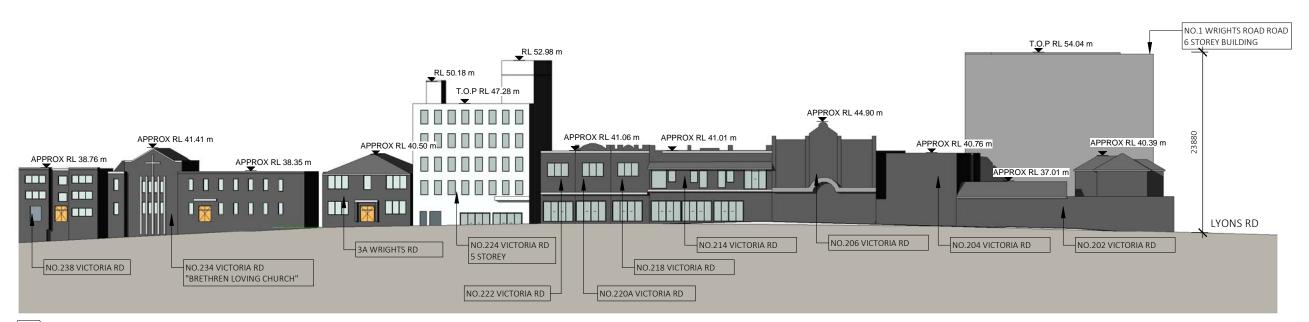

- REVISED HEIGHT OF BUILDING TORIA ROAD NORTH EASTERN SIDE ELEVATION
- REVISED LEVEL 1 \(\text{QA-0-202}\) 1 : 500
- REVISED RL'S

Phone: +61 2 8540 8720 ndickson@dicksonrothschild.com.au www.dicksonrothschild.com.au

Nominated Architect: Robert Nigel Dickson Registration No: 5364

This drawing and design is subject to D.R. Design (NSW) Pty Ltd copyright and may not be reproduced without prior written consent. Contractor to verify all dimensions on site before commencing work. Resolve all discrepancies with the Architect before proceeding. Figured dimensions to be taken in preference to scaled drawings. All work is to conform to relevant Australian Standards and other Codes as applicable, together with other Authorities' requirements and regulations.


IVLV	DESCRIT FION	DATE	1330ED	CHECKE
Α	ISSUE FOR DA	28/10/2016	NT	AC
В	AMENDED AS PER COUNCIL RFI	10/04/2016	MC	AC
С	FURTHER COUNCIL RFI	06/09/2017	MC	KR
D	ISSUE FOR PLANNING PANEL	23/11/2017	MC	KR

PROJECT DRUMMOYNE	DRAWING VICTORIA ROAD	DRAWING VICTORIA ROAD ELEVATION				
227 - 231 VICTORIA ROAD	PROJECT NO. DRAWING NO.	REVISION	DATE			
CLIENT	15-030 DA-0-305	D	27/06/20			
J. BARTOLOTTA	SCALE @ A3 1:500	DRAWN SC	AUTHORISED AC			

DEVELOPMENT APPLICATION



SCALE 1:500

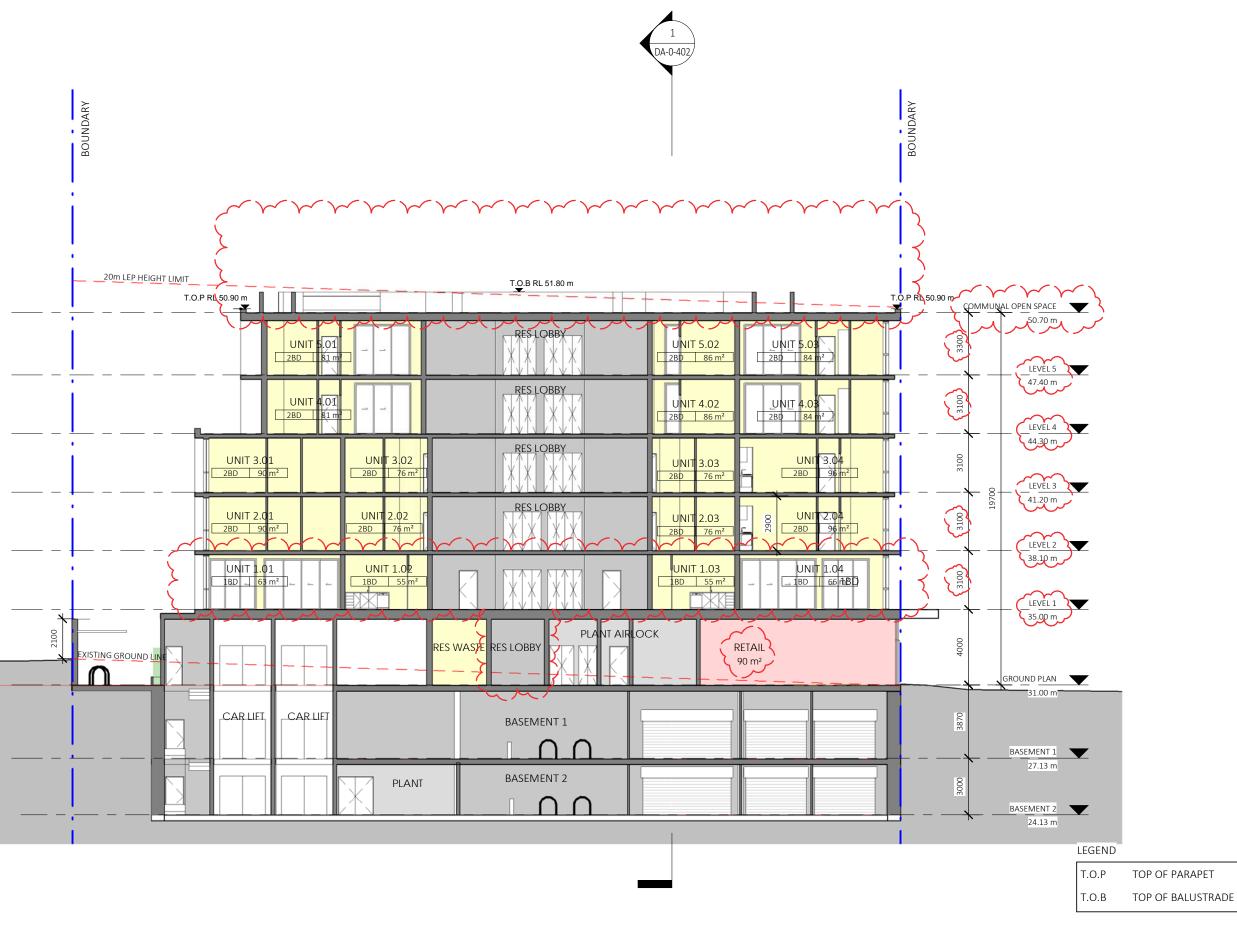

#### **REVISION D**


- REVISED HEIGHT OF BUILDING
- REVISED LEVEL 1
- REVISED RL'S

Dickson Rothschild	Phone: +61 2 8540 8720	REV	DESCRIPTION	DATE	ISSUED	CHECKED
D.R. Design (NSW) Pty. Ltd.	ndickson@dicksonrothschild.com.au	Α	ISSUE FOR DA	28/10/2016	NT	AC
65-69 Kent Street,	www.dicksonrothschild.com.au	В	AMENDED AS PER COUNCIL RFI	10/04/2016	MC	AC
•		С	FURTHER COUNCIL RFI	06/09/2017	MC	KR
Millers Point, Sydney, NSW 2000	Nominated Architect: Robert Nigel Dickson	D	ISSUE FOR PLANNING PANEL	23/11/2017	MC	KR
ABN: 35 134 237 540	Registration No: 5364					
	esign (NSW) Pty Ltd copyright and may not be reproduced					
	o verify all dimensions on site before commencing work.					
Resolve all discrepancies with the Architect before proceeding. Figured dimensions to be taken in preference to scaled drawings. All work is to conform to relevant Australian Standards and other Codes as applicable, together with other Authorities' requirements and regulations.						
as applicable, together with other Authorit	ies' requirements and regulations.					

PROJECT	DRAW
DRUMMOYNE	SEC
	-
227 - 231 VICTORIA ROAD	PROJE
CLIENT	15-
J. BARTOLOTTA	SCALE
J. DAINIOLOTTA	1:

DRAWING			
SECTIO	ON AA		
PROJECT NO	DRAWING NO	REVISION	DATE
PROJECT NO.	DRAWING NO.	KEVISION	DATE
1E 020	DA 0 401	D	27/06/2016
15-030	DA-0-401	D	27/06/2016
15-030 SCALE @ A3	DA-0-401	D	27/06/2016 AUTHORISED



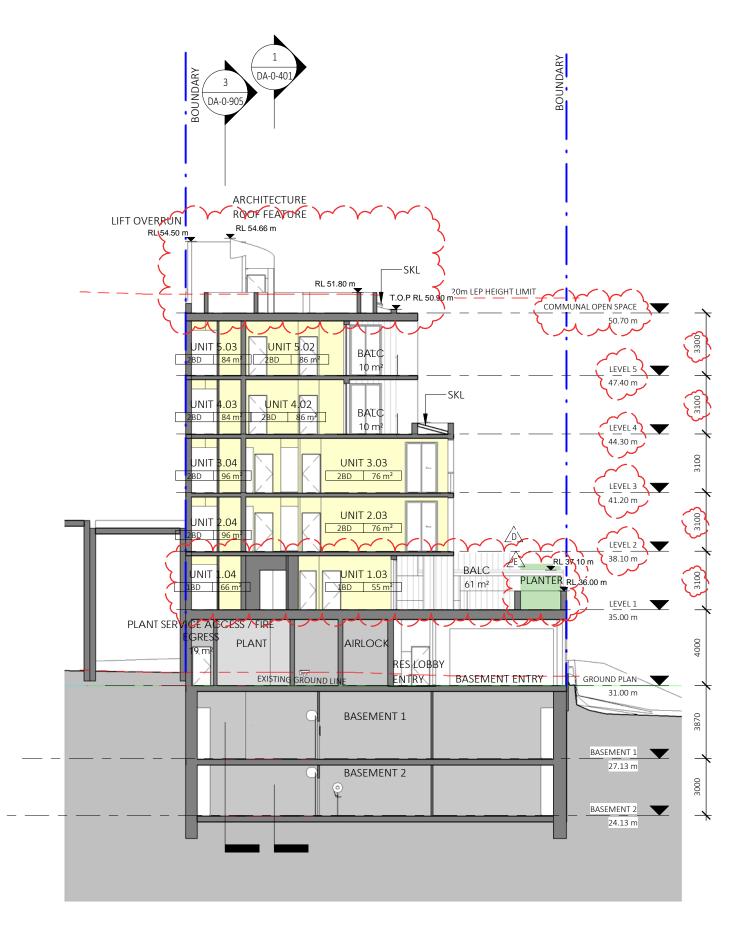

## LEGEND

T.O.P TOP OF PARAPET

T.O.B TOP OF BALUSTRADE

SKL SKY LIGHT

#### **REVISION D**

- REVISED HEIGHT OF BUILDING
- REVISED LEVEL 1
- REVISED RL'S

Dickson Rothschild D.R. Design (NSW) Pty. Ltd. 65-69 Kent Street, Millers Point, Sydney, NSW 2000 ABN: 35 134 237 540

Phone: +61 2 8540 8720 ndickson@dicksonrothschild.com.au www.dicksonrothschild.com.au Nominated Architect: Robert Nigel Dickson Registration No: 5364


This drawing and design is subject to D.R. Design (NSW) Pty Ltd copyright and may not be reproduced without prior written consent. Contractor to verify all dimensions on site before commencing work. Resolve all discrepancies with the Architect before proceeding. Figured dimensions to be taken in preference to scaled drawings. All work is to conform to relevant Australian Standards and other Codes as applicable, together with other Authorities' requirements and regulations.

	REV	DESCRIPTION	DATE	ISSUED	CHECKED
	Α	ISSUE FOR DA	28/10/2016	NT	AC
	В	AMENDED AS PER COUNCIL RFI	10/04/2016	MC	AC
	С	FURTHER COUNCIL RFI	06/09/2017	MC	KR
	D	ISSUE FOR PLANNING PANEL	23/11/2017	MC	KR
	E	ENLARGED PLANTERS	30/11/2017	MC	KR
,					

PROJECT	DF
DRUMMOYNE	S
227 - 231 VICTORIA ROAD	PF
CLIENT	1
J. BARTOLOTTA	SC
	_
DEVELOPMENT ADDITION	(
DEVELOPMENT APPLICATION	

SECTIO	ON BB		
PROJECT NO. 15-030	DRAWING NO.	REVISION E	DATE 27/06/2016
SCALE @ A3		DRAWN	AUTHORISED
1:200		RD	AC



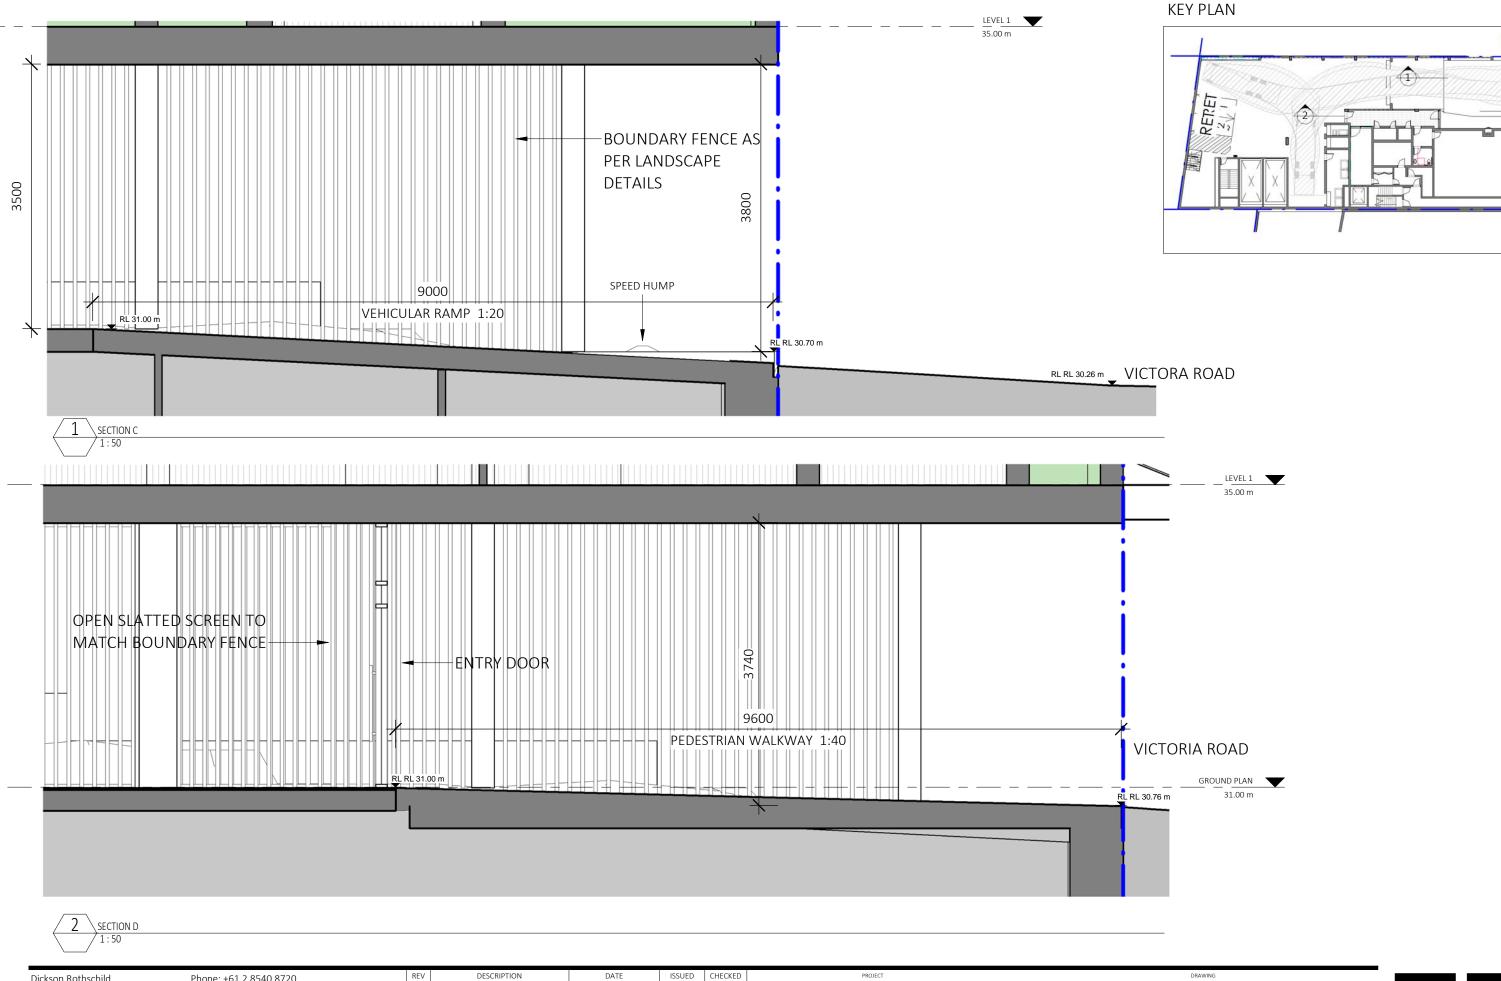

Phone: +61 2 8540 8720 ndickson@dicksonrothschild.com.au www.dicksonrothschild.com.au Nominated Architect: Robert Nigel Dickson Registration No: 5364


This drawing and design is subject to D.R. Design (NSW) Pty Ltd copyright and may not be reproduced without prior written consent. Contractor to verify all dimensions on site before commencing work. Resolve all discrepancies with the Architect before proceeding. Figured dimensions to be taken in preference to scaled drawings. All work is to conform to relevant Australian Standards and other Codes as applicable, together with other Authorities' requirements and regulations.

Α	ISSUE FOR DA	28/10/2016	NT	AC
В	AMENDED AS PER COUNCIL RFI	10/04/2016	MC	AC
С	FURTHER COUNCIL RFI	06/09/2017	MC	KR

DRUMMOYNE	
227 - 231 VICTORIA ROAD	-
J. BARTOLOTTA	-
DEVELOPMENT APPLICATION	(

ACCES:	S RAMPS			
PROJECT NO.	DRAWING NO.	REVISION	DATE	_
15-030	DA-0-403	C	27/06/202	16_
SCALE @ A3		DRAWN	AUTHORISED	
As		NT	AC	
indicated	SCALE	1:50 I	1	2.5m



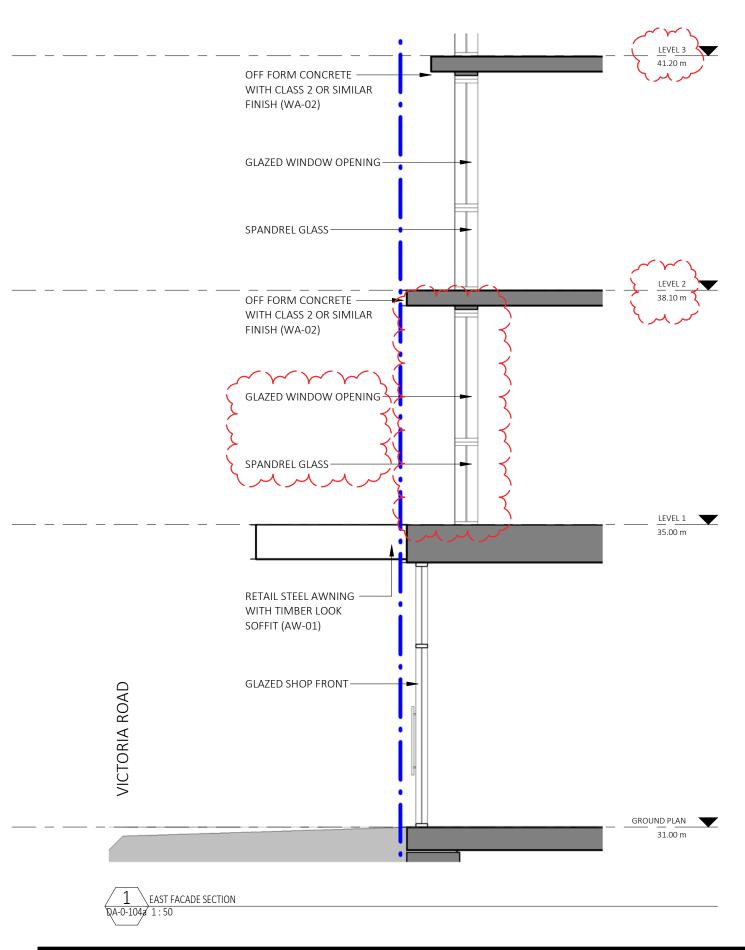

TIMBER/TIMBER LOOK LIKE EXTERNAL CLADDING GLAZED WINDOW OPENING -OFF FORM CONCRETE WITH CLASS 2 OR SIMILAR FINISH (WA-02) OPENING LEVEL 1 35.00 m GROUND PLAN 31.00 m

WEST FACADE SECTION

**REVISION C** - REVISED LEVEL 1 ELEVATIONS - REVISED RL'S

Dickson Rothschild D.R. Design (NSW) Pty. Ltd. 65-69 Kent Street, Millers Point, Sydney, NSW 2000 ABN: 35 134 237 540

Phone: +61 2 8540 8720 ndickson@dicksonrothschild.com.au www.dicksonrothschild.com.au Nominated Architect: Robert Nigel Dickson Registration No: 5364

This drawing and design is subject to D.R. Design (NSW) Pty Ltd copyright and may not be reproduced without prior written consent. Contractor to verify all dimensions on site before commencing work. Resolve all discrepancies with the Architect before proceeding. Figured dimensions to be taken in preference to scaled drawings. All work is to conform to relevant Australian Standards and other Codes as applicable, together with other Authorities' requirements and regulations.

REV	DESCRIPTION	DATE	ISSUED	CHECKED
Α	ISSUE FOR DA	28/10/2016	NT	AC
В	AMENDED AS PER COUNCIL RFI	10/04/2016	MC	AC
С	ISSUE FOR PLANNING PANEL	23/11/2017	MC	KR


DRUMMOYNE

227 - 231 VICTORIA ROAD


15-030 DA-0-404 C 27/06/2016 J. BARTOLOTTA NT AC SCALE 1:50 DEVELOPMENT APPLICATION

FACADE SECTIONS



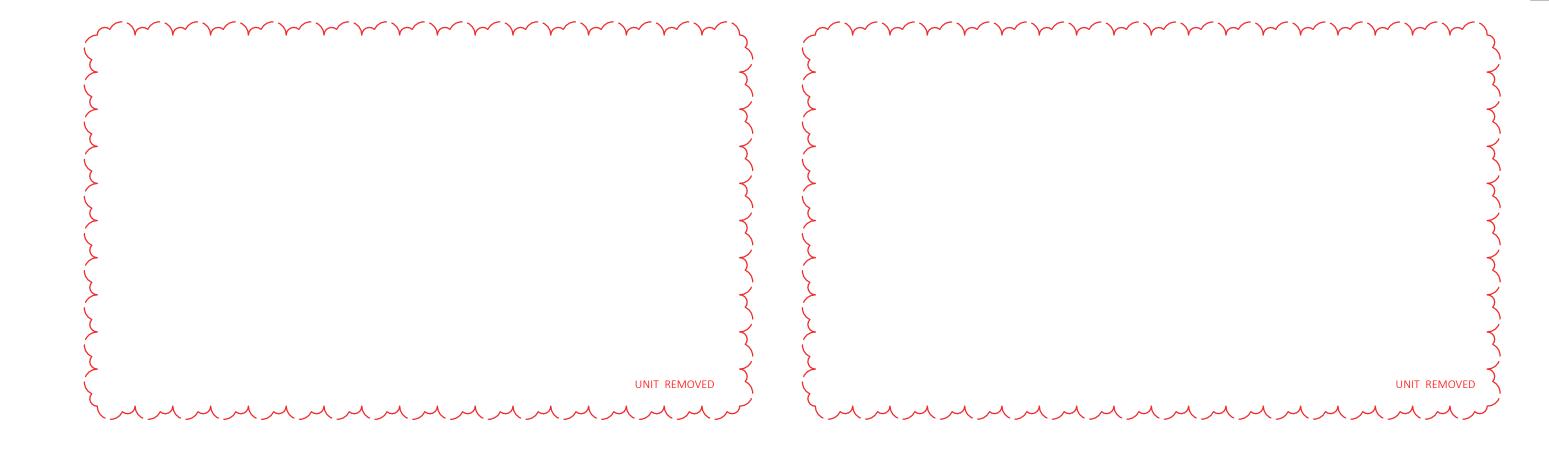



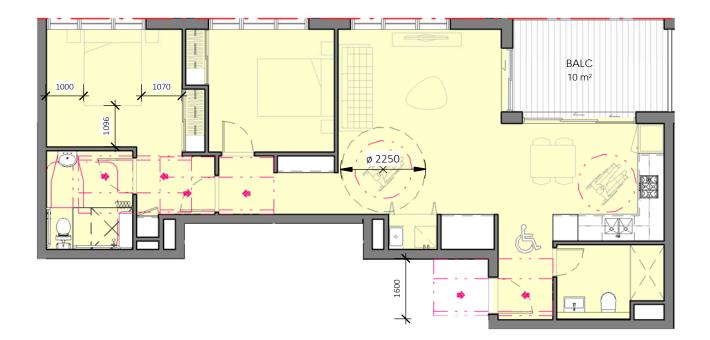

LEVEL 4 & LEVEL 5 - PRE ADAPTABLE UNIT QA-0-301 1:100

UNIT 4.02, UNIT 5.02

LEVEL 4 & LEVEL 5- POSTADAPTABLE UNIT QA-0-301 1:100

DEVELOPMENT APPLICATION

UNIT 4.02, UNIT 5.02

- REVISED NUMBER OF ADAPATABLE UNITS (CANADA BAY DCP 2017)

Dickson Rothschild
D.R. Design (NSW) Pty. Ltd.
65-69 Kent Street,
Millers Point, Sydney, NSW 2000
ABN: 35 134 237 540

Phone: +61 2 8540 8720 ndickson@dicksonrothschild.com.au www.dicksonrothschild.com.au Nominated Architect: Robert Nigel Dickson Registration No: 5364

This drawing and design is subject to D.R. Design (NSW) Pty Ltd copyright and may not be reproduced without prior written consent. Contractor to verify all dimensions on site before commencing work.

Resolve all discrepancies with the Architect before proceeding. Figured dimensions to be taken in preference to scaled drawings. All work is to conform to relevant Australian Standards and other Codes as applicable, together with other Authorities' requirements and regulations.

	REV	DESCRIPTION	DATE	ISSUED	CHECKED
Γ	Α	ISSUE FOR DA	28/10/2016	NT	AC
	В	AMENDED AS PER COUNCIL RFI	10/04/2016	MC	AC
	С	ISSUE FOR PLANNING PANEL	23/11/2017	MC	KR
Ī					
Ī					
Ī					
Γ					
_					


PROJECT	DRAWING	
DRUMMOYNE	ADAPTABLE UN	NITS
227 - 231 VICTORIA ROAD	PROJECT NO. DRAWING NO.	REVISIO
CLIENT	15-030 DA-0-601	С
J. BARTOLOTTA	SCALE @ A3 1:100	DRAWN

DATE 27/06/2016	
AUTHORISED	
AC	
5m	

SCALE 1:100






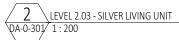





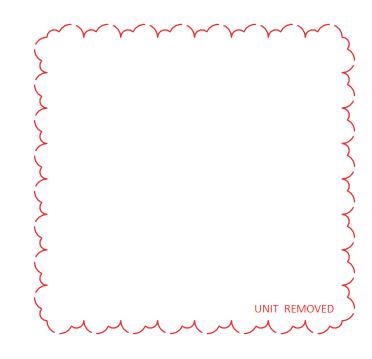

#### REVISION B

#### - REVISED NUMBER OF LIVEABLE HOUSING DESIGN - SILVER LEVEL UNITS

Dickson Rothschild	
D.R. Design (NSW) Pty. Ltd.	
65-69 Kent Street,	
Millers Point, Sydney, NSW 2000	
ABN: 35 134 237 540	

Phone: +61 2 8540 8720 ndickson@dicksonrothschild.com.au www.dicksonrothschild.com.au Nominated Architect: Robert Nigel Dickson Registration No: 5364

This drawing and design is subject to D.R. Design (NSW) Pty Ltd copyright and may not be reproduced without prior written consent. Contractor to verify all dimensions on site before commencing work. Resolve all discrepancies with the Architect before proceeding. Figured dimensions to be taken in preference to scaled drawings. All work is to conform to relevant Australian Standards and other Codes as applicable, together with other Authorities' requirements and regulations.

	REV	DESCRIPTION	DATE	ISSUED	CHECKED
	Α	AMENDED AS PER COUNCIL RFI	10/04/2016	MC	AC
	В	ISSUE FOR PLANNING PANEL	23/11/2017	MC	KR
5					

DRUMMOYNE	
227 - 231 VICTORIA ROAD	
J. BARTOLOTTA	

DEVELOPMENT APPLICATION





REFERENCE	E ELEVATION NOTATION	ELEMENT	MATERIAL	FINISH
NALLS & B	BALUSTRADES			
1	WA-01	EXTERNAL WALL	BRICK	"AUSTRAL BRICKS - LA PALOMA - MIRO " OR SIMILAR
2	WA-02	EXTERNAL WALL	OFF FORM CONCRETE	CLASS 2 FINISH OR SIMILAR
3	WA-03	EXTERNAL WALL	TIMBER CLADDING	INNOWOOD - INNOVATIVE TEXTURE "IRON BARK" OR SIMILAR
4	WA-04	EXTERNAL WALL	BRICK + PAINT	DULUX "NATURAL WHITE" PN1E1 OR SIMILAR
5	BAL-01	BALCONY	FRAMELESS CLEAR GLASS	N/A
10	SC-01	PRIVACY SCREEN	TIMBER CLADDING	INNOWOOD - INNOVATIVE TEXTURE "IRON BARK" OR SIMILAR
11	SC-02	PRIVACY-SCREEN	TRANSLUCENT GLASS AND ALUMINIUM FRAME	DULUX DURATEC "ZEUS BLACK MATT" 90088702 OR SIMILAR
VINDOWS	S & DOORS			
6	PC-01	WINDOWS AND DOORS	CLEAR GLASS AND ALUMINIUM FRAME	DULUX DURATEC "ZEUS BLACK MATT" 90088702 OR SIMILAR
7	R-01	PANEL LIFT GARAGE DOOR	POWDERCOATED ALUMINIUM	DULUX DURATEC "ZEUS BLACK MATT" 90088702 OR SIMILAR
8	LV-01	FIXED LOUVER	ALUMINIUM	DULUX DURATEC "ZEUS BLACK MATT" 90088702 OR SIMILAR
WNING/F	ROOF			
9	AW-01	RETAIL AWNING	EXPOSED STRUCTURAL STEEL WITH TIMBER LOOK SOFFIT	DULUX DURATEC "ZEUS BLACK MATT" 90088702 OR SIMILAR







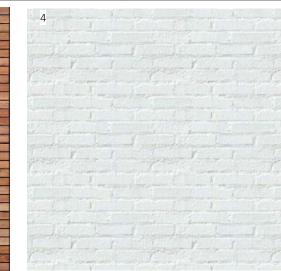

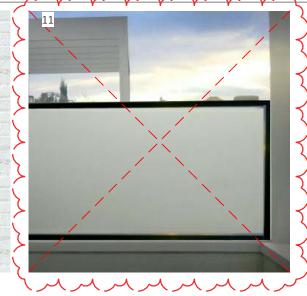











Dickson Rothschild D.R. Design (NSW) Pty. Ltd. 65-69 Kent Street,

REVISION C

Phone: +61 2 8540 8720 ndickson@dicksonrothschild.com.au www.dicksonrothschild.com.au Millers Point, Sydney, NSW 2000 Nominated Architect: Robert Nigel Dickson Registration No: 5364

ABN: 35 134 237 540 This drawing and design is subject to D.R. Design (NSW) Pty Ltd copyright and may not be reproduced without prior written consent. Contractor to verify all dimensions on site before commencing work. Resolve all discrepancies with the Architect before proceeding. Figured dimensions to be taken in preference to scaled drawings. All work is to conform to relevant Australian Standards and other Codes as applicable, together with other Authorities' requirements and regulations.

	REV	DESCRIPTION	DATE	ISSUED	CHECKED
	Α	ISSUE FOR DA	28/10/2016	NT	AC
	В	AMENDED AS PER COUNCIL RFI	10/04/2016	MC	AC
	С	ISSUE FOR PLANNING PANEL	23/11/2017	MC	KR
S					

DRUMMOYNE	

227 - 231 VICTORIA ROAD


J. BARTOLOTTA


DEVELOPMENT	APPLICATION


# FINISHES SCHEDULE


PROJECT NO. DRAWING NO. REVISION DATE
15-030 DA-0-901 C 27/06/2016 DRAWN SC AUTHORISED AC SCALE @ A3



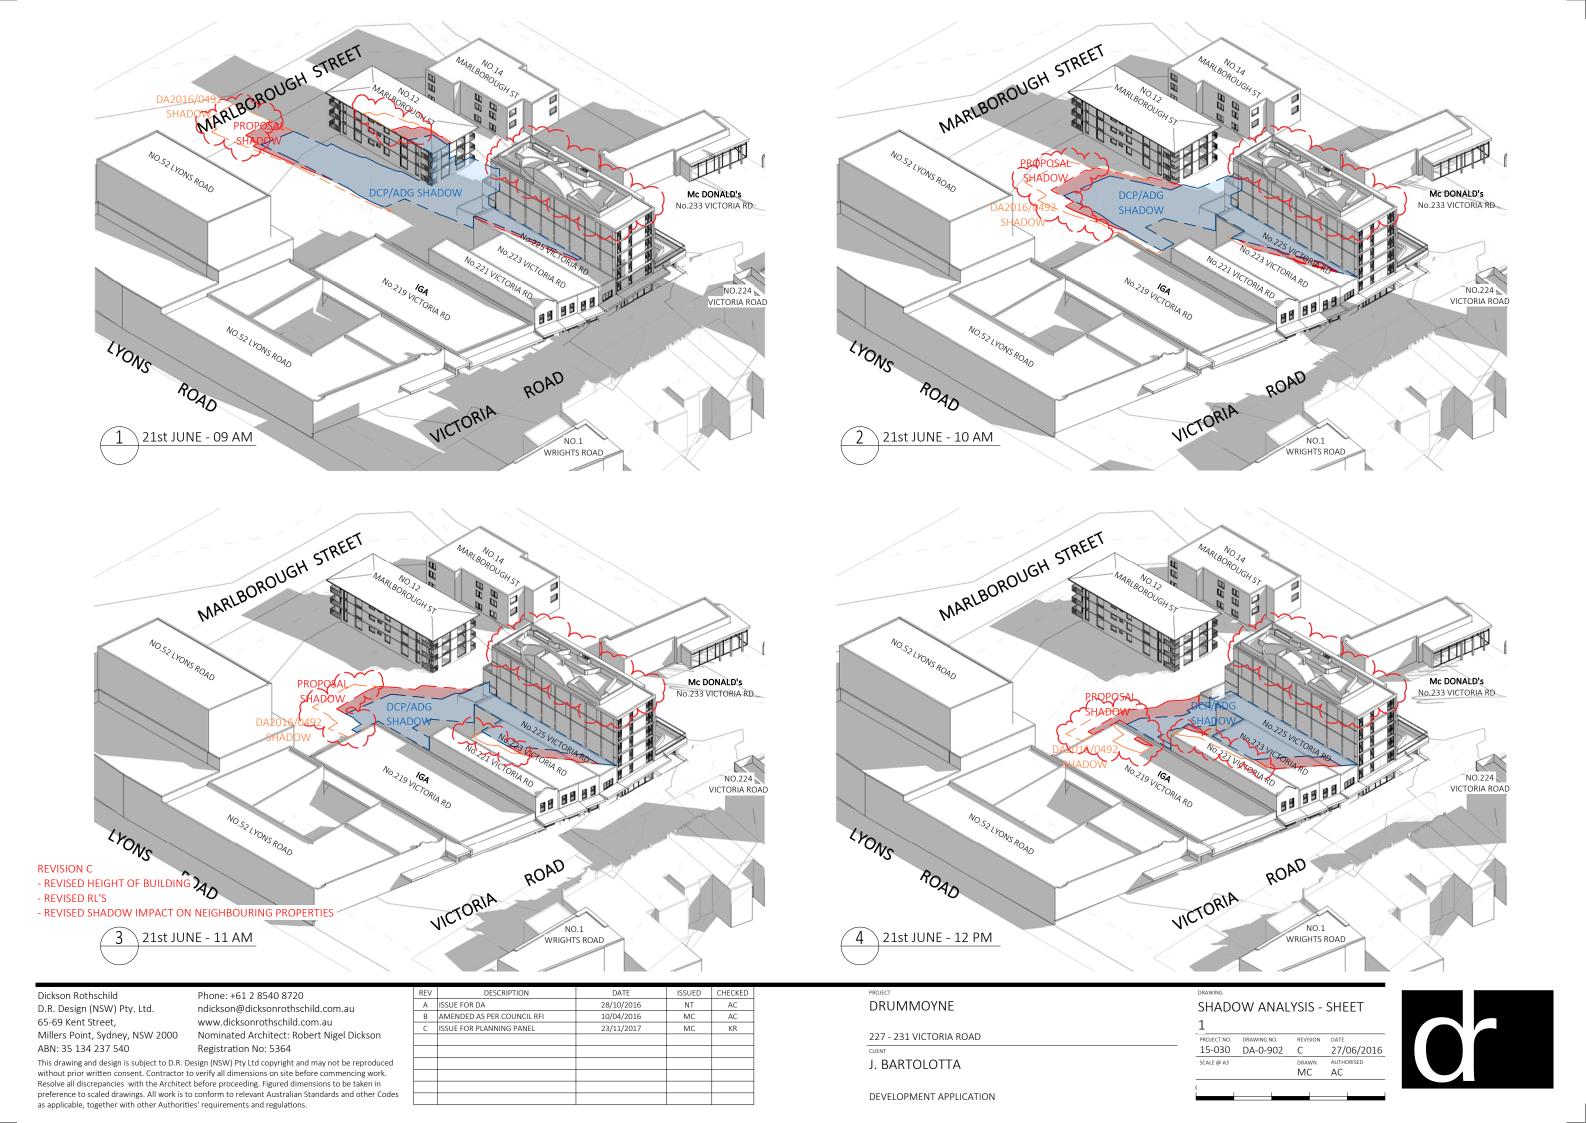

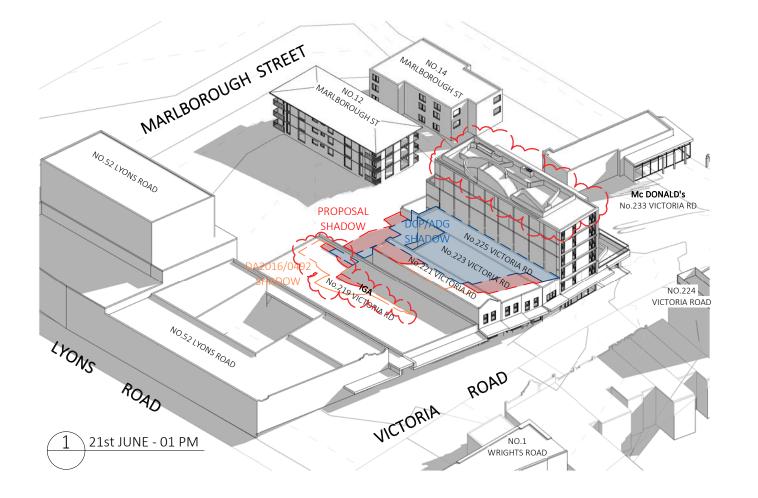

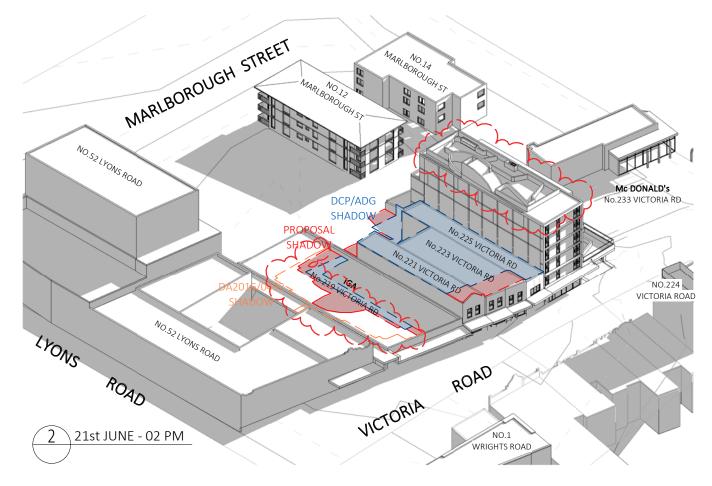

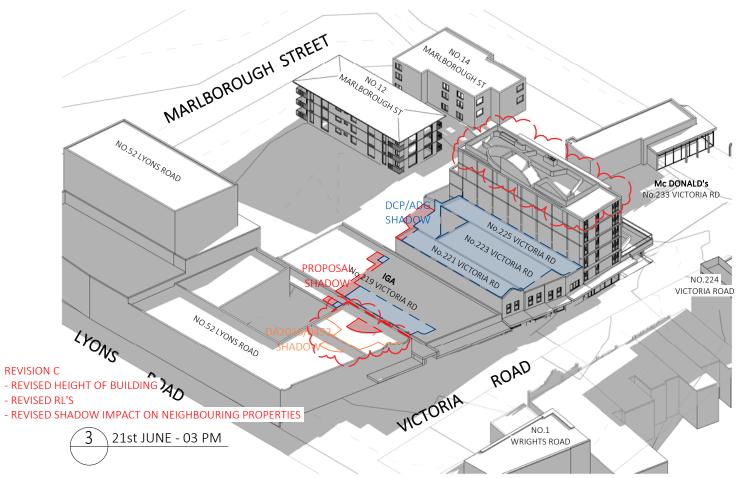

Dickson Rothschild D.R. Design (NSW) Pty. Ltd. 65-69 Kent Street, Millers Point, Sydney, NSW 2000 ABN: 35 134 237 540

Phone: +61 2 8540 8720 ndickson@dicksonrothschild.com.au www.dicksonrothschild.com.au Nominated Architect: Robert Nigel Dickson

Registration No: 5364 This drawing and design is subject to D.R. Design (NSW) Pty Ltd copyright and may not be reproduced without prior written consent. Contractor to verify all dimensions on site before commencing work. Resolve all discrepancies with the Architect before proceeding. Figured dimensions to be taken in preference to scaled drawings. All work is to conform to relevant Australian Standards and other Codes as applicable, together with other Authorities' requirements and regulations.

REV	DESCRIPTION	DATE	ISSUED	CHECKED
Α	ISSUE FOR DA	28/10/2016	NT	AC
В	AMENDED AS PER COUNCIL RFI	10/04/2016	MC	AC
С	ISSUE FOR PLANNING PANEL	23/11/2017	MC	KR

PROJECT
DRUMMOYNE
227 - 231 VICTORIA ROAD
CLIENT
J. BARTOLOTTA
DEVELOPMENT APPLICATION
DEVELOTIVIENT ATTECATION





**SHADOW ANALYSIS - SHEET** 

DRAWN MC

AC

15-030 DA-0-903 C

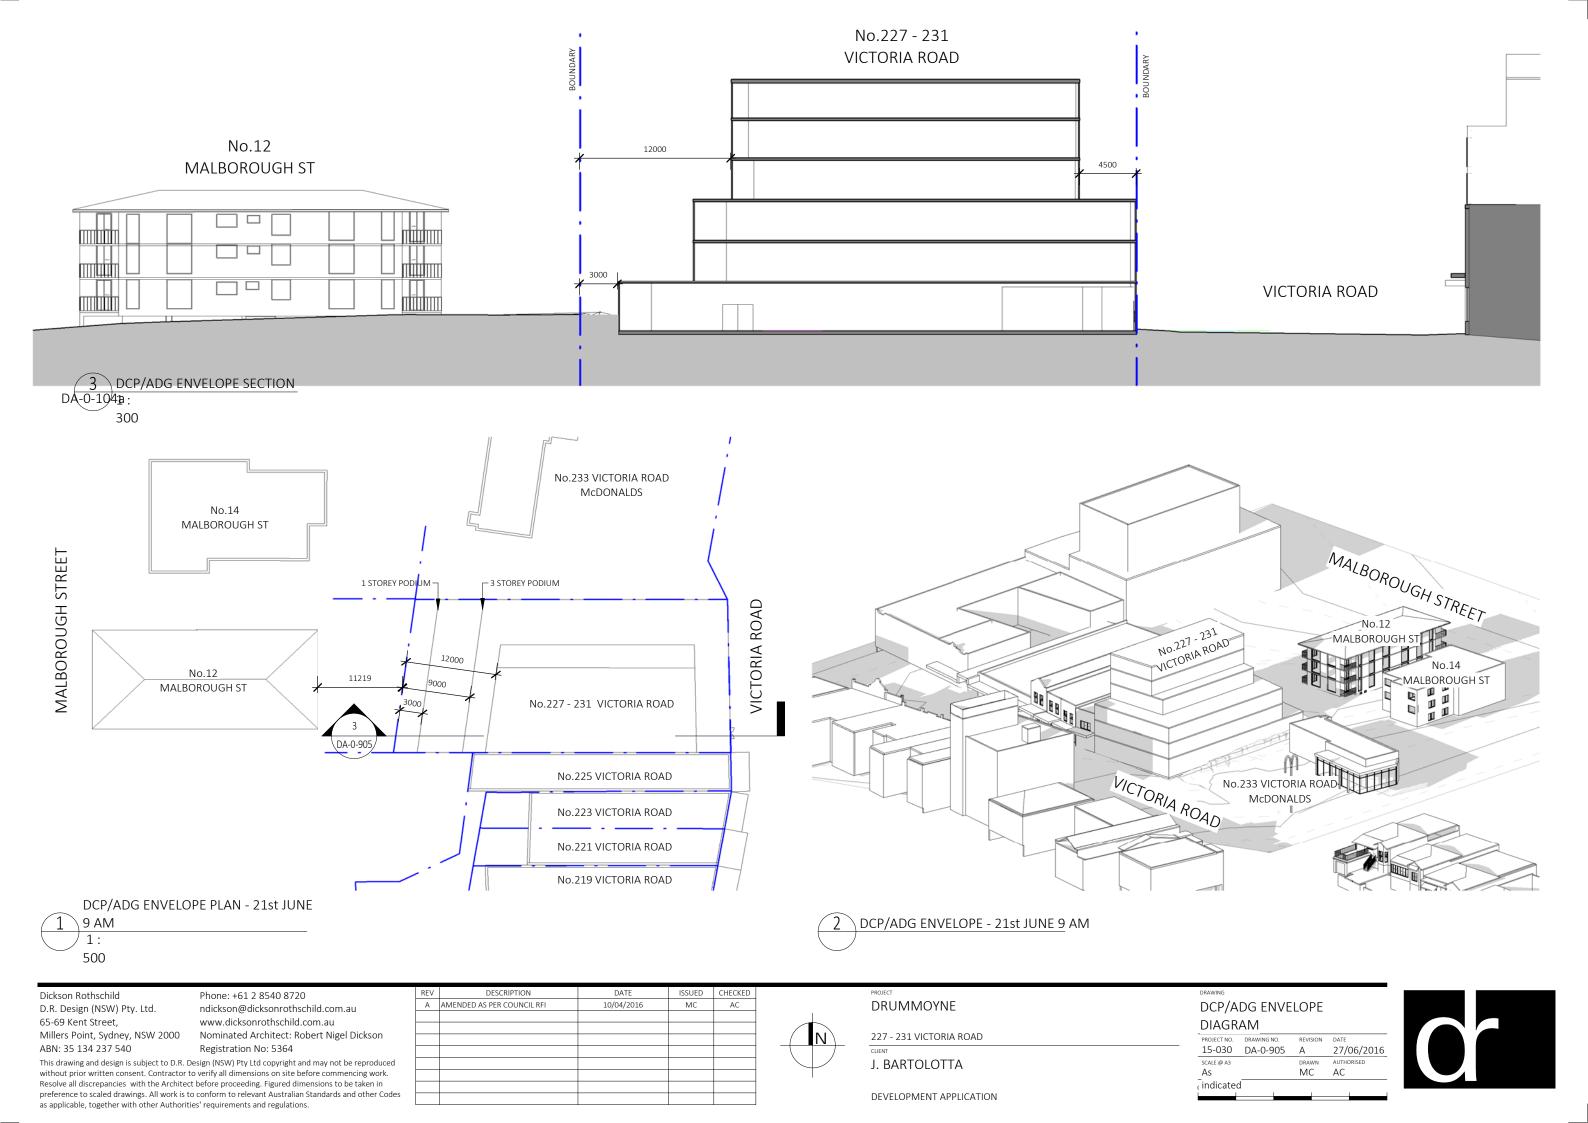

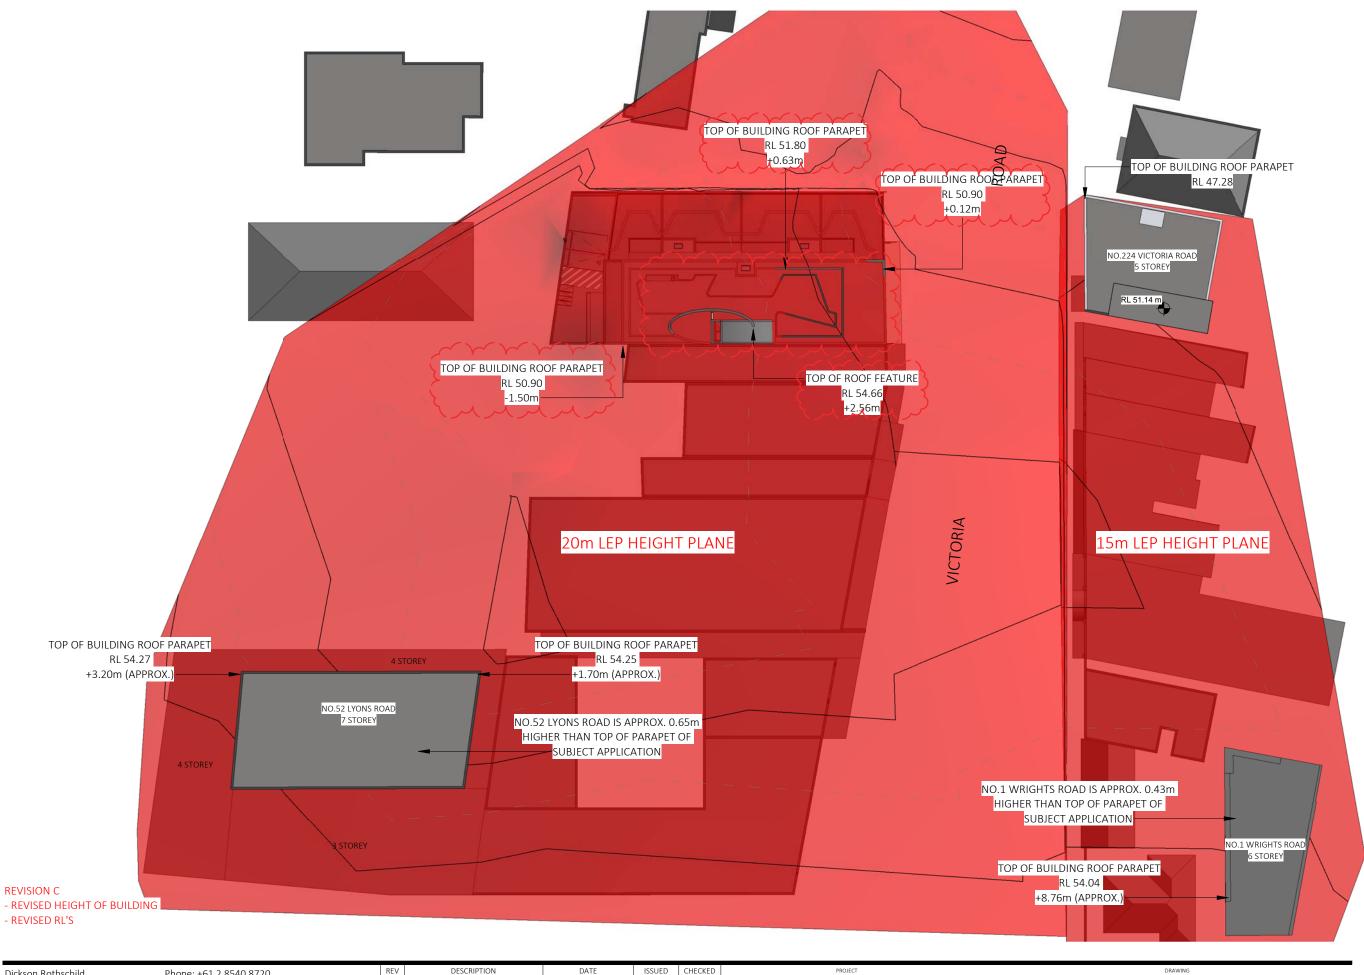

Dickson Rothschild D.R. Design (NSW) Pty. Ltd. 65-69 Kent Street, Millers Point, Sydney, NSW 2000 ABN: 35 134 237 540

as applicable, together with other Authorities' requirements and regulations.

Phone: +61 2 8540 8720 ndickson@dicksonrothschild.com.au www.dicksonrothschild.com.au Nominated Architect: Robert Nigel Dick

Millers Point, Sydney, NSW 2000 Nominated Architect: Robert Nigel Dickson
ABN: 35 134 237 540 Registration No: 5364
This drawing and design is subject to D.R. Design (NSW) Pty Ltd copyright and may not be reproduced without prior written consent. Contractor to verify all dimensions on site before commencing work.
Resolve all discrepancies with the Architect before proceeding. Figured dimensions to be taken in preference to scaled drawings. All work is to conform to relevant Australian Standards and other Codes

	Α	ISSUE FOR DA	28/10/2016	NT	AC
	В	AMENDED AS PER COUNCIL RFI	10/04/2016	MC	AC
	С	ISSUE FOR PLANNING PANEL	23/11/2017	MC	KR
5					




DRUMMOYNE		
227 - 231 VICTORIA ROAD		
CLIENT		
J. BARTOLOTTA		

DEVELOPMENT APPLICATION

HEIGHT PLANE DIAGRAM -TOP OF PARAPET 1





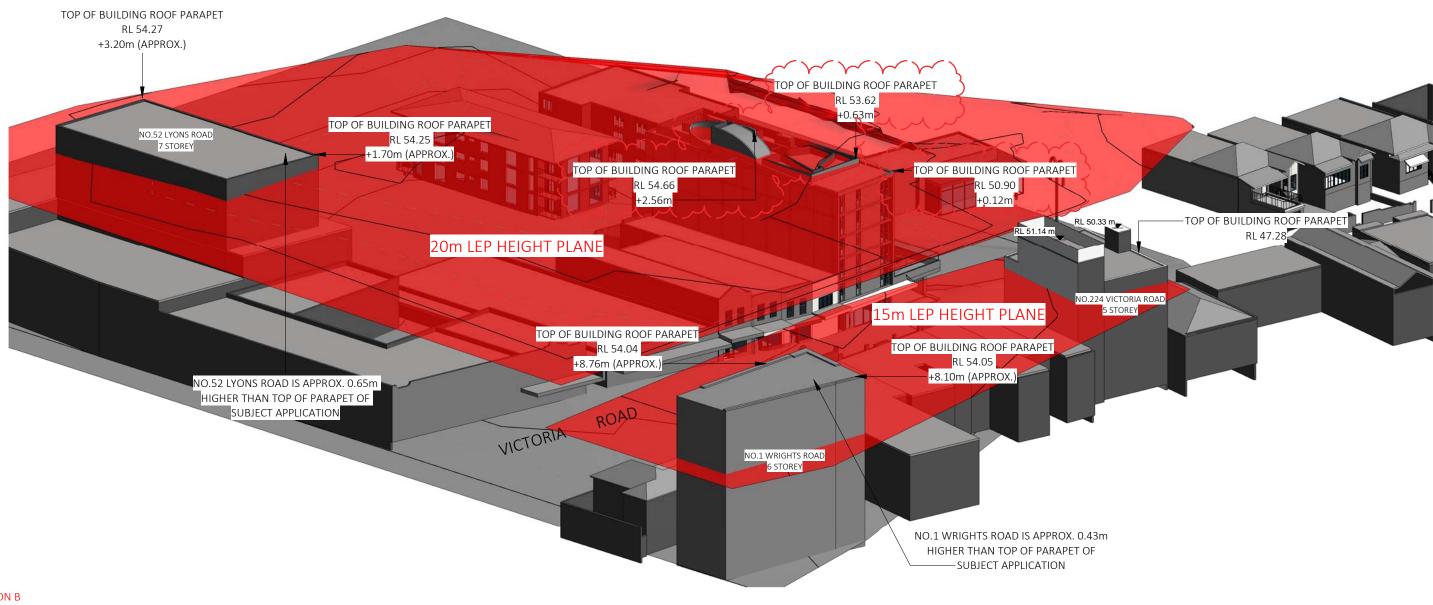

### **REVISION B**

- REVISED HEIGHT OF BUILDING

- REVISED RL'S

Dickson Rothschild
D.R. Design (NSW) Pty. Ltd.
65-69 Kent Street,
Millers Point, Sydney, NSW 2000
ABN: 35 134 237 540


Phone: +61 2 8540 8720 ndickson@dicksonrothschild.com.au www.dicksonrothschild.com.au Nominated Architect: Robert Nigel Dickson Registration No: 5364

This drawing and design is subject to D.R. Design (NSW) Pty Ltd copyright and may not be reproduced without prior written consent. Contractor to verify all dimensions on site before commencing work. Resolve all discrepancies with the Architect before proceeding. Figured dimensions to be taken in preference to scaled drawings. All work is to conform to relevant Australian Standards and other Codes as applicable, together with other Authorities' requirements and regulations.

	REV	DESCRIPTION	DATE	ISSUED	CHECKED
	Α	AMENDED AS PER COUNCIL RFI	10/04/2016	MC	AC
	В	ISSUE FOR PLANNING PANEL	23/11/2017	MC	KR
5					


DRUMMOYNE 227 - 231 VICTORIA ROAD J. BARTOLOTTA

DEVELOPMENT APPLICATION

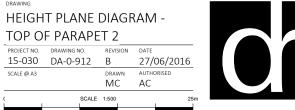

15-030 DA-<u>0-912 B</u>

SCALE 1:500

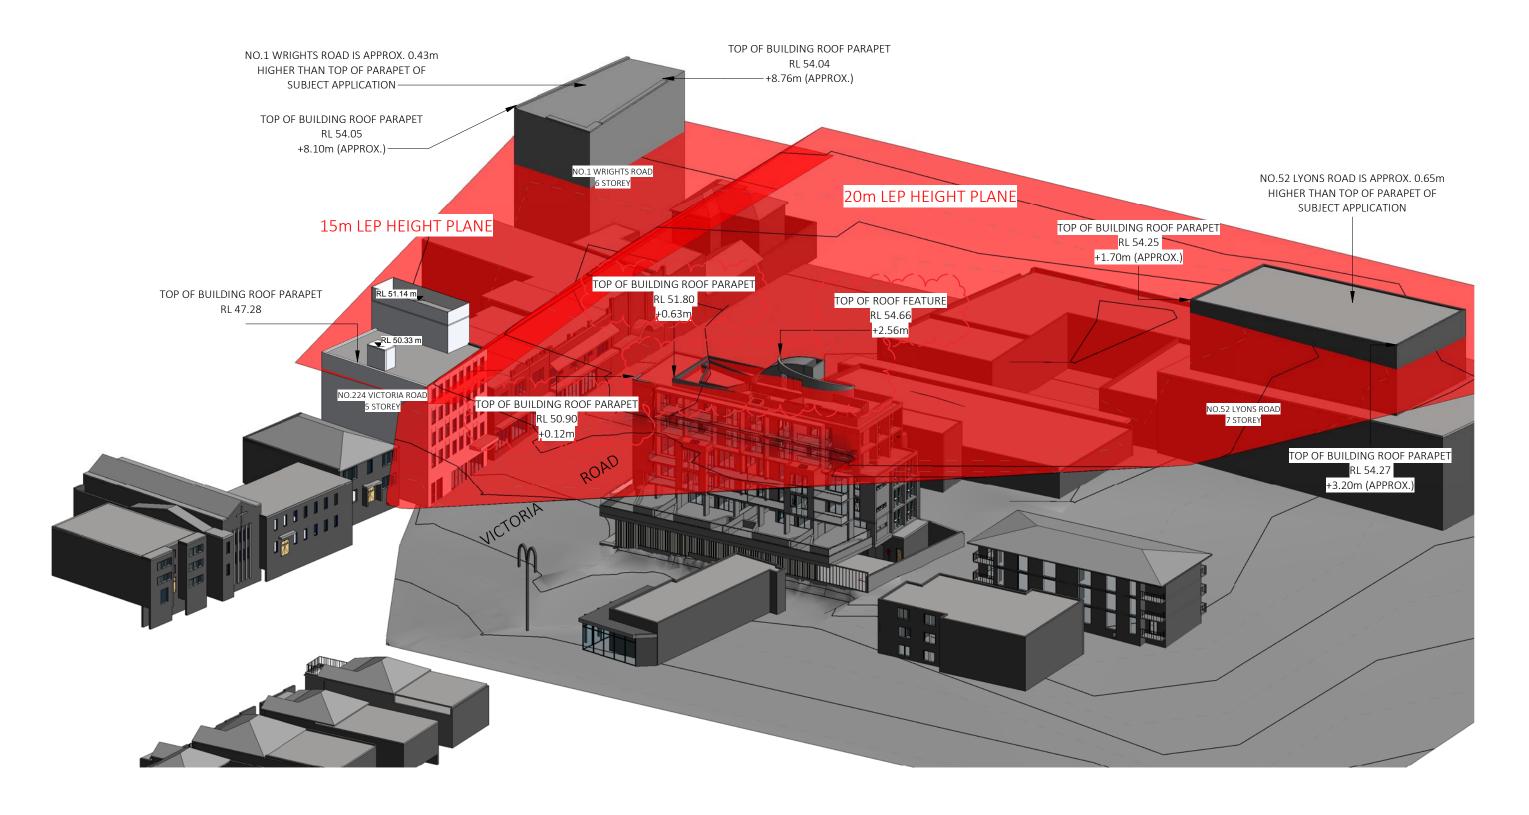

### **REVISION C**

- REVISED HEIGHT OF BUILDING
- REVISED RL'S

Dickson Rothschild
D.R. Design (NSW) Pty. Ltd.
65-69 Kent Street,
Millers Point, Sydney, NSW 2000
ABN: 35 134 237 540
-I: I : II : I I :

Phone: +61 2 8540 8720 ndickson@dicksonrothschild.com.au www.dicksonrothschild.com.au Nominated Architect: Robert Nigel Dickson Registration No: 5364


This drawing and design is subject to D.R. Design (NSW) Pty Ltd copyright and may not be reproduced without prior written consent. Contractor to verify all dimensions on site before commencing work. Resolve all discrepancies with the Architect before proceeding. Figured dimensions to be taken in preference to scaled drawings. All work is to conform to relevant Australian Standards and other Codes as applicable, together with other Authorities' requirements and regulations.


REV	DESCRIPTION	DATE	ISSUED	CHECKED
Α	AMENDED AS PER COUNCIL RFI	10/04/2016	MC	AC
В	ISSUE FOR PLANNING PANEL	23/11/2017	MC	KR

DRUMMOYNE	
227 - 231 VICTORIA ROAD	
J. BARTOLOTTA	


DEVELOPMENT APPLICATION

DRAWING				•	
HEIGH	T PLANE	DIAGF	RAM -		
ТОР О	F PARAPE	ET 3			
PROJECT NO. 15-030	DRAWING NO.	REVISION B	DATE 27/06/2016	- 5	
SCALE @ A3		DRAWN MC	AUTHORISED AC	-	
,	SCALE	1:500		25m	

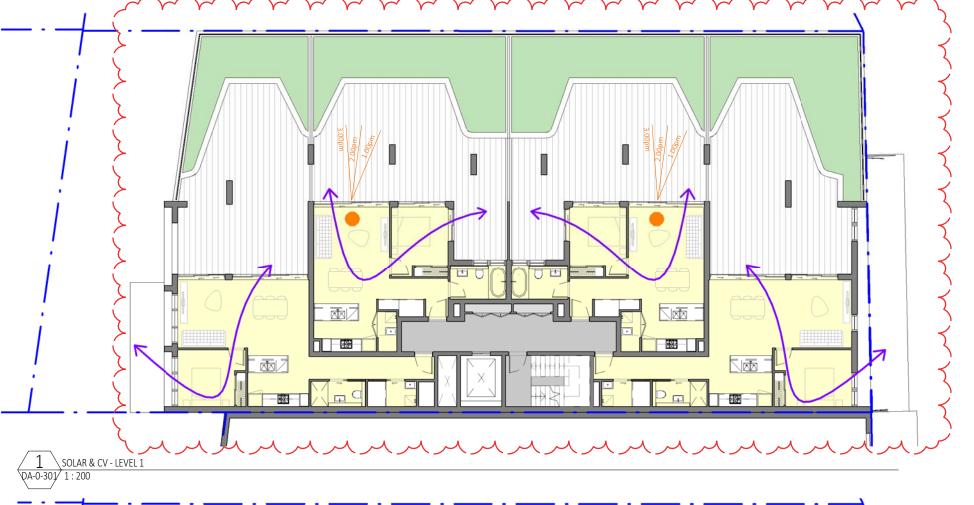

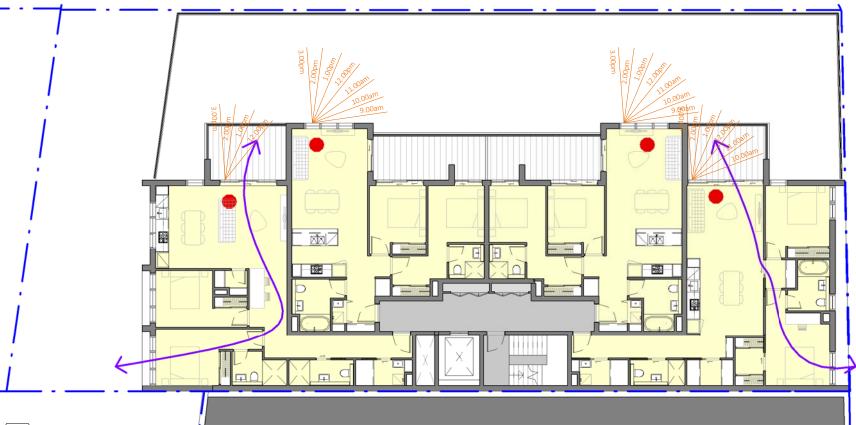

# LEGEND

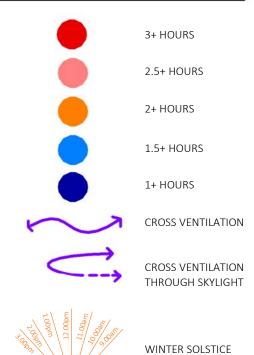

REVISION C - REVISED LEVEL 1 2 OA-0-301 1 : 200

Dickson Rothschild Phone: +61 2 85
D.R. Design (NSW) Pty. Ltd. ndickson@dicks
65-69 Kent Street, www.dicksonrot
Millers Point, Sydney, NSW 2000 Nominated Arch
ABN: 35 134 237 540 Registration No:

Phone: +61 2 8540 8720 ndickson@dicksonrothschild.com.au www.dicksonrothschild.com.au Nominated Architect: Robert Nigel Dickson Registration No: 5364

This drawing and design is subject to D.R. Design (NSW) Pty Ltd copyright and may not be reproduced without prior written consent. Contractor to verify all dimensions on site before commencing work. Resolve all discrepancies with the Architect before proceeding. Figured dimensions to be taken in preference to scaled drawings. All work is to conform to relevant Australian Standards and other Codes as applicable, together with other Authorities' requirements and regulations.

REV	DESCRIPTION	DATE	ISSUED	CHECKED
Α	ISSUE FOR DA	28/10/2016	NT	AC
В	AMENDED AS PER COUNCIL RFI	10/04/2016	MC	AC
С	ISSUE FOR PLANNING PANEL	23/11/2017	MC	KR



DRUMMOYNE

227 - 231 VICTORIA ROAD

J. BARTOLOTTA


DEVELOPMENT APPLICATION


DRAWING

SOLA	λR &	CV	- SHEET


DRAWING NO.	REVISION	DATE
DA-0-921	С	27/06/2016
	DRAWN	AUTHORISED
	NT	AC
		DA-0-921 C



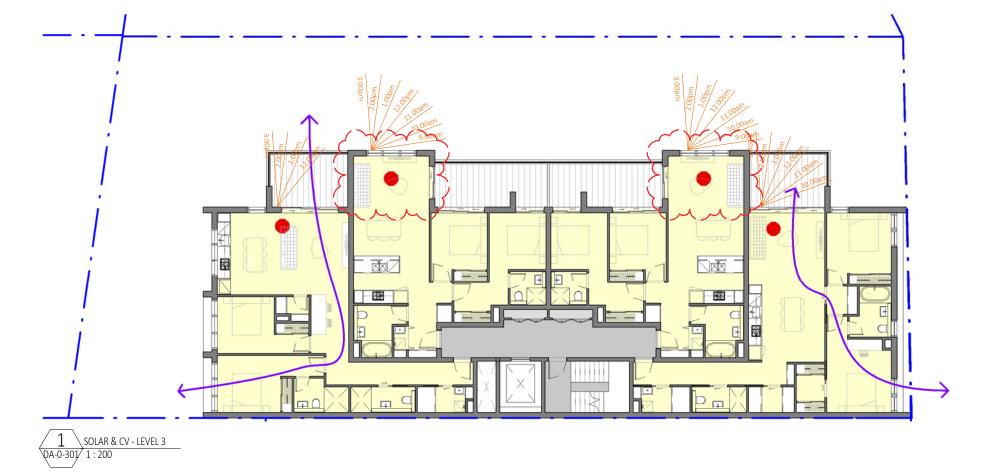

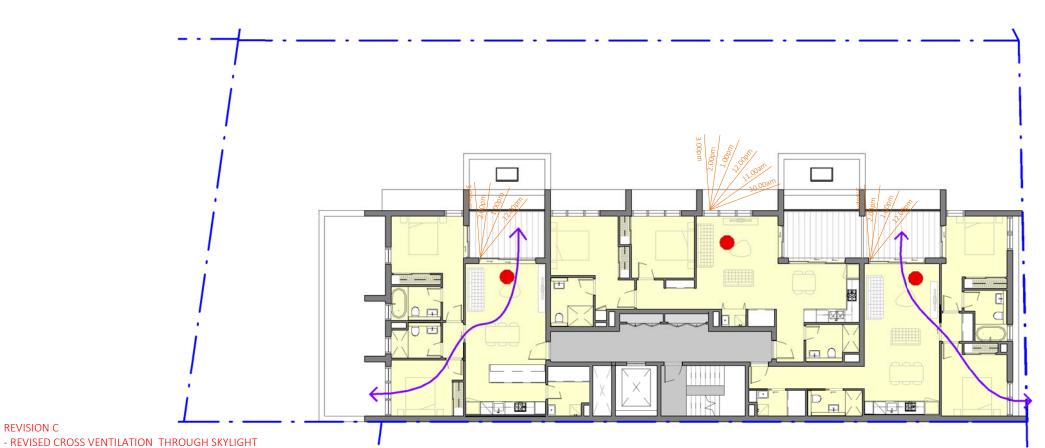

## LEGEND

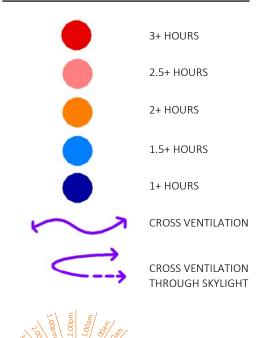

2 SOLAR & CV - LEVEL 4 QA-0-301/1:200

Dickson Rothschild D.R. Design (NSW) Pty. Ltd. 65-69 Kent Street, Millers Point, Sydney, NSW 2000 ABN: 35 134 237 540

**REVISION C** 

Phone: +61 2 8540 8720 ndickson@dicksonrothschild.com.au www.dicksonrothschild.com.au Nominated Architect: Robert Nigel Dickson Registration No: 5364

This drawing and design is subject to D.R. Design (NSW) Pty Ltd copyright and may not be reproduced without prior written consent. Contractor to verify all dimensions on site before commencing work.

Resolve all discrepancies with the Architect before proceeding. Figured dimensions to be taken in preference to scaled drawings. All work is to conform to relevant Australian Standards and other Codes as applicable, together with other Authorities' requirements and regulations.

	REV	DESCRIPTION	DATE	ISSUED	CHECKED
	Α	ISSUE FOR DA	28/10/2016	NT	AC
	В	AMENDED AS PER COUNCIL RFI	10/04/2016	MC	AC
	С	ISSUE FOR PLANNING PANEL	23/11/2017	MC	KR
5					



DRUMMOYNE

227 - 231 VICTORIA ROAD

J. BARTOLOTTA

DEVELOPMENT APPLICATION


SOLAR & CV - SHEET 2


indicated

15-030 DA-0-922 C 27/06/2016 SCALE @ A3 DRAWN NT AC




WINTER SOLSTICE

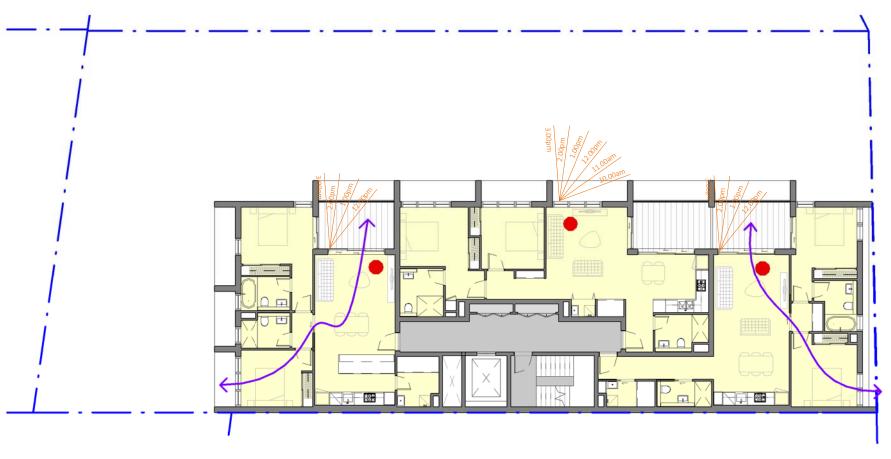

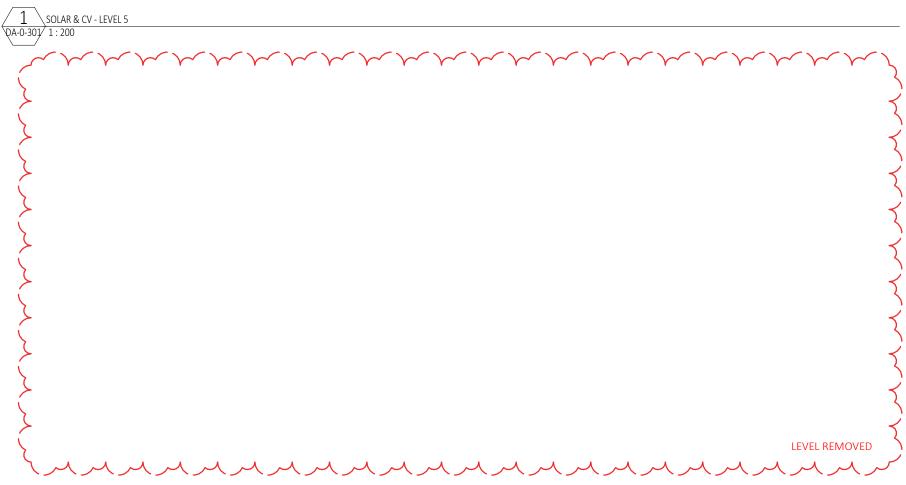

# **LEGEND**

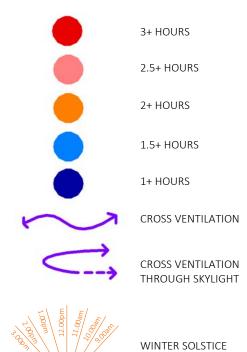

### REVISION C

## - REVISED DRAWING LEVEL REMOVED

Dickson Rothschild D.R. Design (NSW) Pty. Ltd. 65-69 Kent Street, Millers Point, Sydney, NSW 2000 ABN: 35 134 237 540

Phone: +61 2 8540 8720 ndickson@dicksonrothschild.com.au www.dicksonrothschild.com.au Nominated Architect: Robert Nigel Dickson Registration No: 5364

This drawing and design is subject to D.R. Design (NSW) Pty Ltd copyright and may not be reproduced without prior written consent. Contractor to verify all dimensions on site before commencing work. Resolve all discrepancies with the Architect before proceeding. Figured dimensions to be taken in preference to scaled drawings. All work is to conform to relevant Australian Standards and other Codes as applicable, together with other Authorities' requirements and regulations.

REV	DESCRIPTION	DATE	ISSUED	CHECKED
Α	ISSUE FOR DA	28/10/2016	NT	AC
В	AMENDED AS PER COUNCIL RFI	10/04/2016	MC	AC
С	ISSUE FOR PLANNING PANEL	23/11/2017	MC	KR



DRUMMOYNE

227 - 231 VICTORIA ROAD


J. BARTOLOTTA

DEVELOPMENT APPLICATION

SOLAR & CV - SHEET 2

As		NT	AC
SCALE @ A3		DRAWN	AUTHORISED
15-030	DA-0-923	С	_27/06/2016
PROJECT NO.	DRAWING NO.	REVISION	DATE



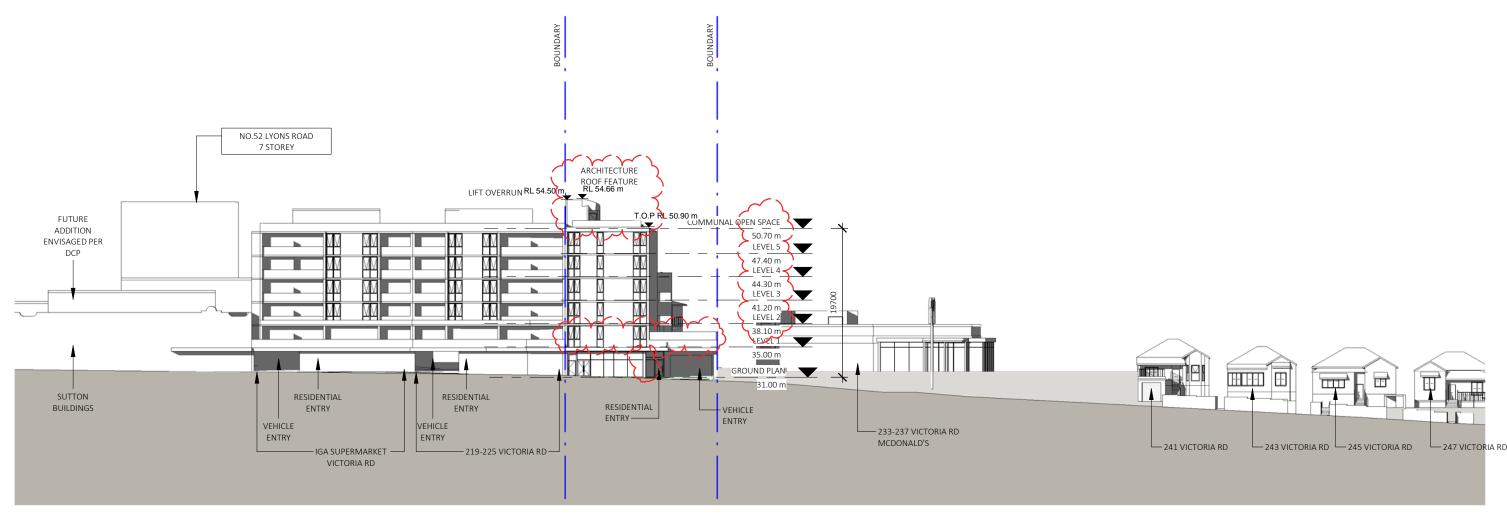



### **REVISION B**

- REVISED HEIGHT OF BUILDING
- REVISED LEVEL 1
- REVISED RL'S


as applicable, together with other Authorities' requirements and regulations.

Phone: +61 2 8540 8720 ndickson@dicksonrothschild.com.au www.dicksonrothschild.com.au


Nominated Architect: Robert Nigel Dickson Registration No: 5364 This drawing and design is subject to D.R. Design (NSW) Pty Ltd copyright and may not be reproduced without prior written consent. Contractor to verify all dimensions on site before commencing work. Resolve all discrepancies with the Architect before proceeding. Figured dimensions to be taken in preference to scaled drawings. All work is to conform to relevant Australian Standards and other Codes

REV	DESCRIPTION	DATE	ISSUED	CHECKED
Α	AMENDED AS PER COUNCIL RFI	10/04/2016	MC	AC
В	ISSUE FOR PLANNING PANEL	23/11/2017	MC	KR

PROJECT
DRUMMOYNE
51.01
227 - 231 VICTORIA ROAD
CLIENT
I. BARTOLOTTA
V 5/ 11/1 0 2 0 1 1/ 1
DEVELOPMENT APPLICATION

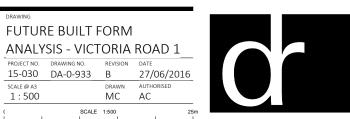


SCALE @ A3 1:500

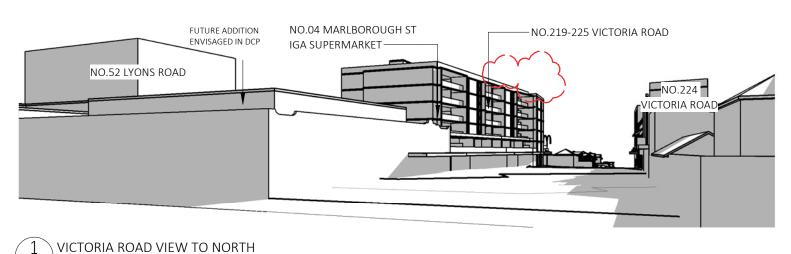



VICTORIA ROAD VIEW TO SOUTH

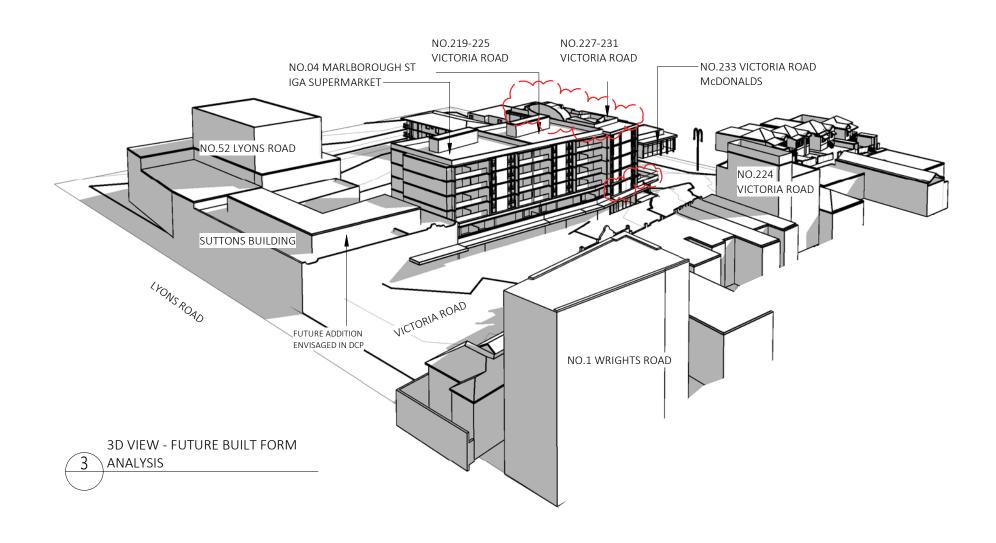

### **REVISION B**

- REVISED HEIGHT OF BUILDING
- REVISED LEVEL 1
- REVISED RL'S

Dickson Rothschild
D.R. Design (NSW) Pty. Ltd.
65-69 Kent Street,
Millers Point, Sydney, NSW 2000
ABN: 35 134 237 540

Phone: +61 2 8540 8720 ndickson@dicksonrothschild.com.au www.dicksonrothschild.com.au

Nominated Architect: Robert Nigel Dickson Registration No: 5364

This drawing and design is subject to D.R. Design (NSW) Pty Ltd copyright and may not be reproduced without prior written consent. Contractor to verify all dimensions on site before commencing work. Resolve all discrepancies with the Architect before proceeding. Figured dimensions to be taken in preference to scaled drawings. All work is to conform to relevant Australian Standards and other Codes as applicable, together with other Authorities' requirements and regulations.


REV	DESCRIPTION	DATE	ISSUED	CHECKE
Α	AMENDED AS PER COUNCIL RFI	10/04/2016	MC	AC
В	ISSUE FOR PLANNING PANEL	23/11/2017	MC	KR

DRUMMOYNE
227 - 231 VICTORIA ROAD CLIENT J. BARTOLOTTA

DEVELOPMENT APPLICATION

**FUTURE BUILT FORM** ANALYSIS - VICTORIA ROAD 2 15-030 DA-0-934 B



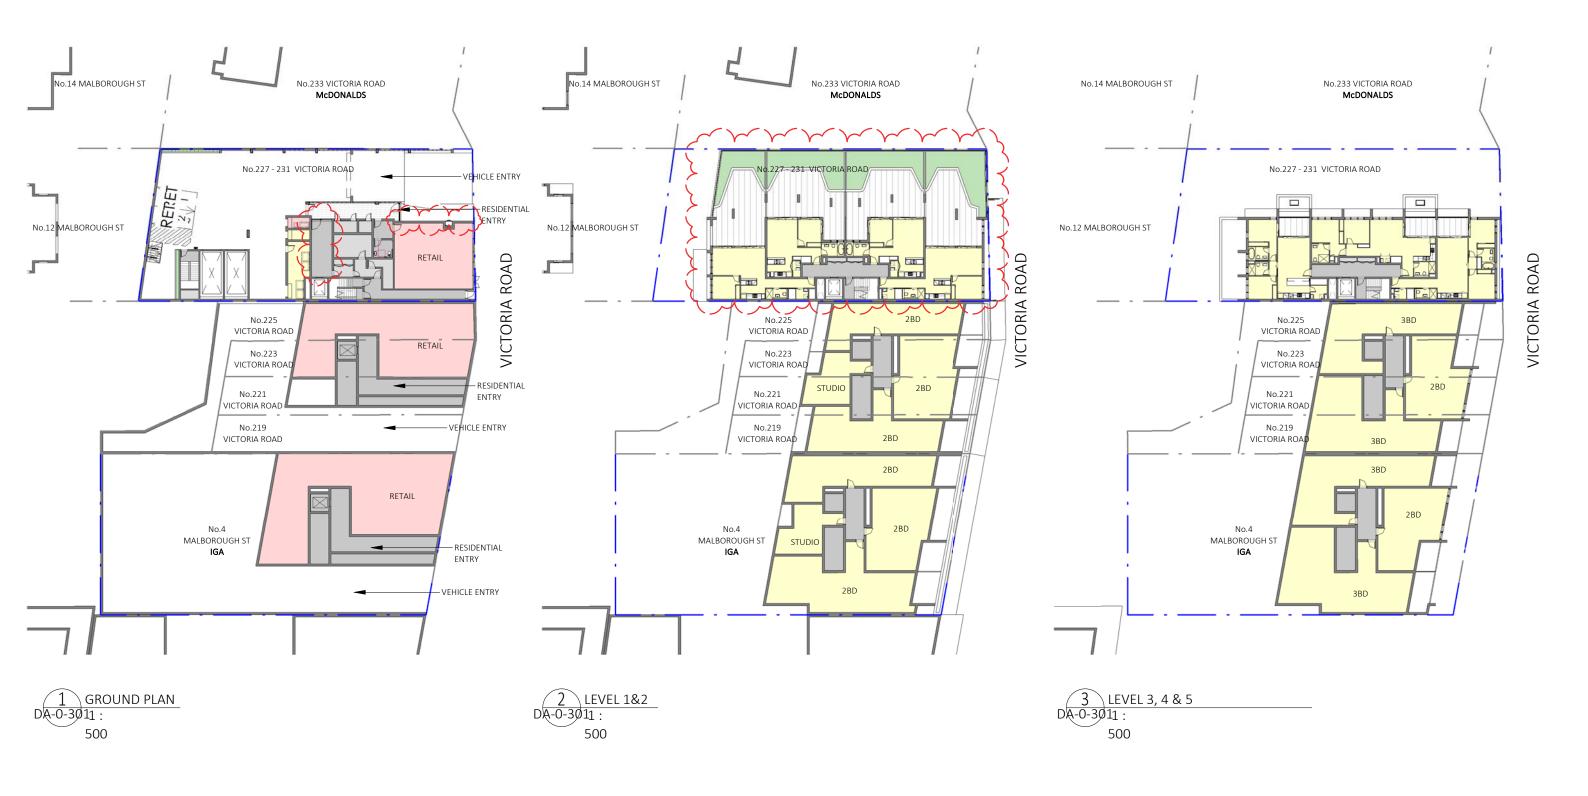

# REVISION B - REVISED LEVEL 1

Dickson Rothschild D.R. Design (NSW) Pty. Ltd. 65-69 Kent Street, Millers Point, Sydney, NSW 2000 ABN: 35 134 237 540 Phone: +61 2 8540 8720 ndickson@dicksonrothschild.com.au www.dicksonrothschild.com.au Nominated Architect: Robert Nigel Dickson Registration No: 5364

This drawing and design is subject to D.R. Design (NSW) Pty Ltd copyright and may not be reproduced without prior written consent. Contractor to verify all dimensions on site before commencing work. Resolve all discrepancies with the Architect before proceeding. Figured dimensions to be taken in preference to scaled drawings. All work is to conform to relevant Australian Standards and other Codes as applicable, together with other Authorities' requirements and regulations.

REV	DESCRIPTION	DATE	ISSUED	CHECKEL
Α	AMENDED AS PER COUNCIL RFI	10/04/2016	MC	AC
В	ISSUE FOR PLANNING PANEL	23/11/2017	MC	KR



PROJECT	DRAWING				
DRUMMOYNE	FUTURE BUILT FORM				
227 221 VICTORIA ROAD	ANALYSIS - VICTORIA ROAD 3				
227 - 231 VICTORIA ROAD	PROJECT NO. DRAWING NO. REVISION DATE				
CLIENT	15-030 DA-0-935 B 27/06/2016				
J. BARTOLOTTA	SCALE @ A3 DRAWN AUTHORISED				
3. B 323	1:500 MC AC				
	( SCALE 1:500				
DEVELOPMENT APPLICATION					



### 219-225 Victoria Road, Drummoyne

Project No: Date: Apr-16

747.7 m² Site area (m²):

### Canada Bay LEP 2013

Land use	B4 Mixed Use	
FSR	2.0:1	
GFA	1495.4	
Height (m)	20m	

	GFA	GFA		RESIDENTIAL			
Level	Comm GFA	Res GFA	Comm tenancies	Studio	1 bdrm units	2 bdrm units	3 bdrm units
Level 5		315				1	2
Level 4		315				1	2
Level 3		315				1	2
Level 2		309		1		3	
Level 1		310		1		3	
Ground Floor	190	42	1			7.14	
Basement 1							
Basement 2							
Total	190	1606	1	2	0	9	6
nit Mix				11.8%	0.0%	52.9%	35.3%

Proposed FSR Commercial	0.25:1
Total Residential	17
Total GFA	1796
Proposed FSR	2.40:1

## **Dickson Rothschild**

#### SEPP 65 Apartment Design Guide

		CROSS VENTILATION		
Level	Min. Req	Achieved	Min. Req	Achieved
Ground Floor				2200
Level 1	70%	3/4	60%	2/4
Level 2		3/4		2/4
Level 3		3/3		2/3
Level 4		3/3		2/3
Level 5		3/3		2/3
Total		15/17 (88.23%)	1	10/17 (58.82%

## IGA Victoria Road, Drummoyne

Project No: 15-030 Apr-16

Site area (m²): 960.0 m²

### Canada Bay LEP 2013

Land use	B4 Mixed Use	
FSR	2.0:1	
GFA	1920.0	
Height (m)	20m	

	GFA		COMMERCIAL		RESIDE	NTIAL	
Level	Comm GFA	Res GFA	Comm tenancies	Studio	1 bdrm units	2 bdrm units	3 bdrm units
Level 5		330				1	2
Level 4		330				1	2
Level 3		330				1	2
Level 2		324		1		3	
Level 1		327		1		3	
Ground Floor	236	43	1				
Basement 1							
Basement 2							
Total	236	1684	1	2	0	9	6
Init Mix			7//	11.8%	0.0%	52.9%	35.3%

Proposed FSR Commercial	0.25:1
Total Residential	17
Total GFA	1920
Proposed FSR	2.00:1

## Dickson Rothschild

#### SEPP 65 Apartment Design Guide

	;	CROSS VENTILATION		
Level	Min. Req	Achieved	Min. Req	Achieved
Ground Floor				
Level 1		3/4	60%	2/4
Level 2		3/4		2/4
Level 3	70%	3/3		2/3
Level 4		3/3		2/3
Level 5		3/3		2/3
Total		15/17 (88.23%)		10/17 (58.82%)

Dickson Rothschild D.R. Design (NSW) Pty. Ltd. 65-69 Kent Street, ABN: 35 134 237 540

Phone: +61 2 8540 8720 ndickson@dicksonrothschild.com.au www.dicksonrothschild.com.au Millers Point, Sydney, NSW 2000 Nominated Architect: Robert Nigel Dickson Registration No: 5364

This drawing and design is subject to D.R. Design (NSW) Pty Ltd copyright and may not be reproduced without prior written consent. Contractor to verify all dimensions on site before commencing work.

Resolve all discrepancies with the Architect before proceeding. Figured dimensions to be taken in preference to scaled drawings. All work is to conform to relevant Australian Standards and other Codes as applicable, together with other Authorities' requirements and regulations.

REV	DESCRIPTION	DATE	ISSUED	CHECKED
Α	AMENDED AS PER COUNCIL RFI	10/04/2016	MC	AC

DRUMMOYNE 227 - 231 VICTORIA ROAD J. BARTOLOTTA

DEVELOPMENT APPLICATION

FUTURE BUILT FORM ANALYSIS - VICTORIA ROAD 4 15-030 DA-0-936 A 27/06/2016 MC AC

