
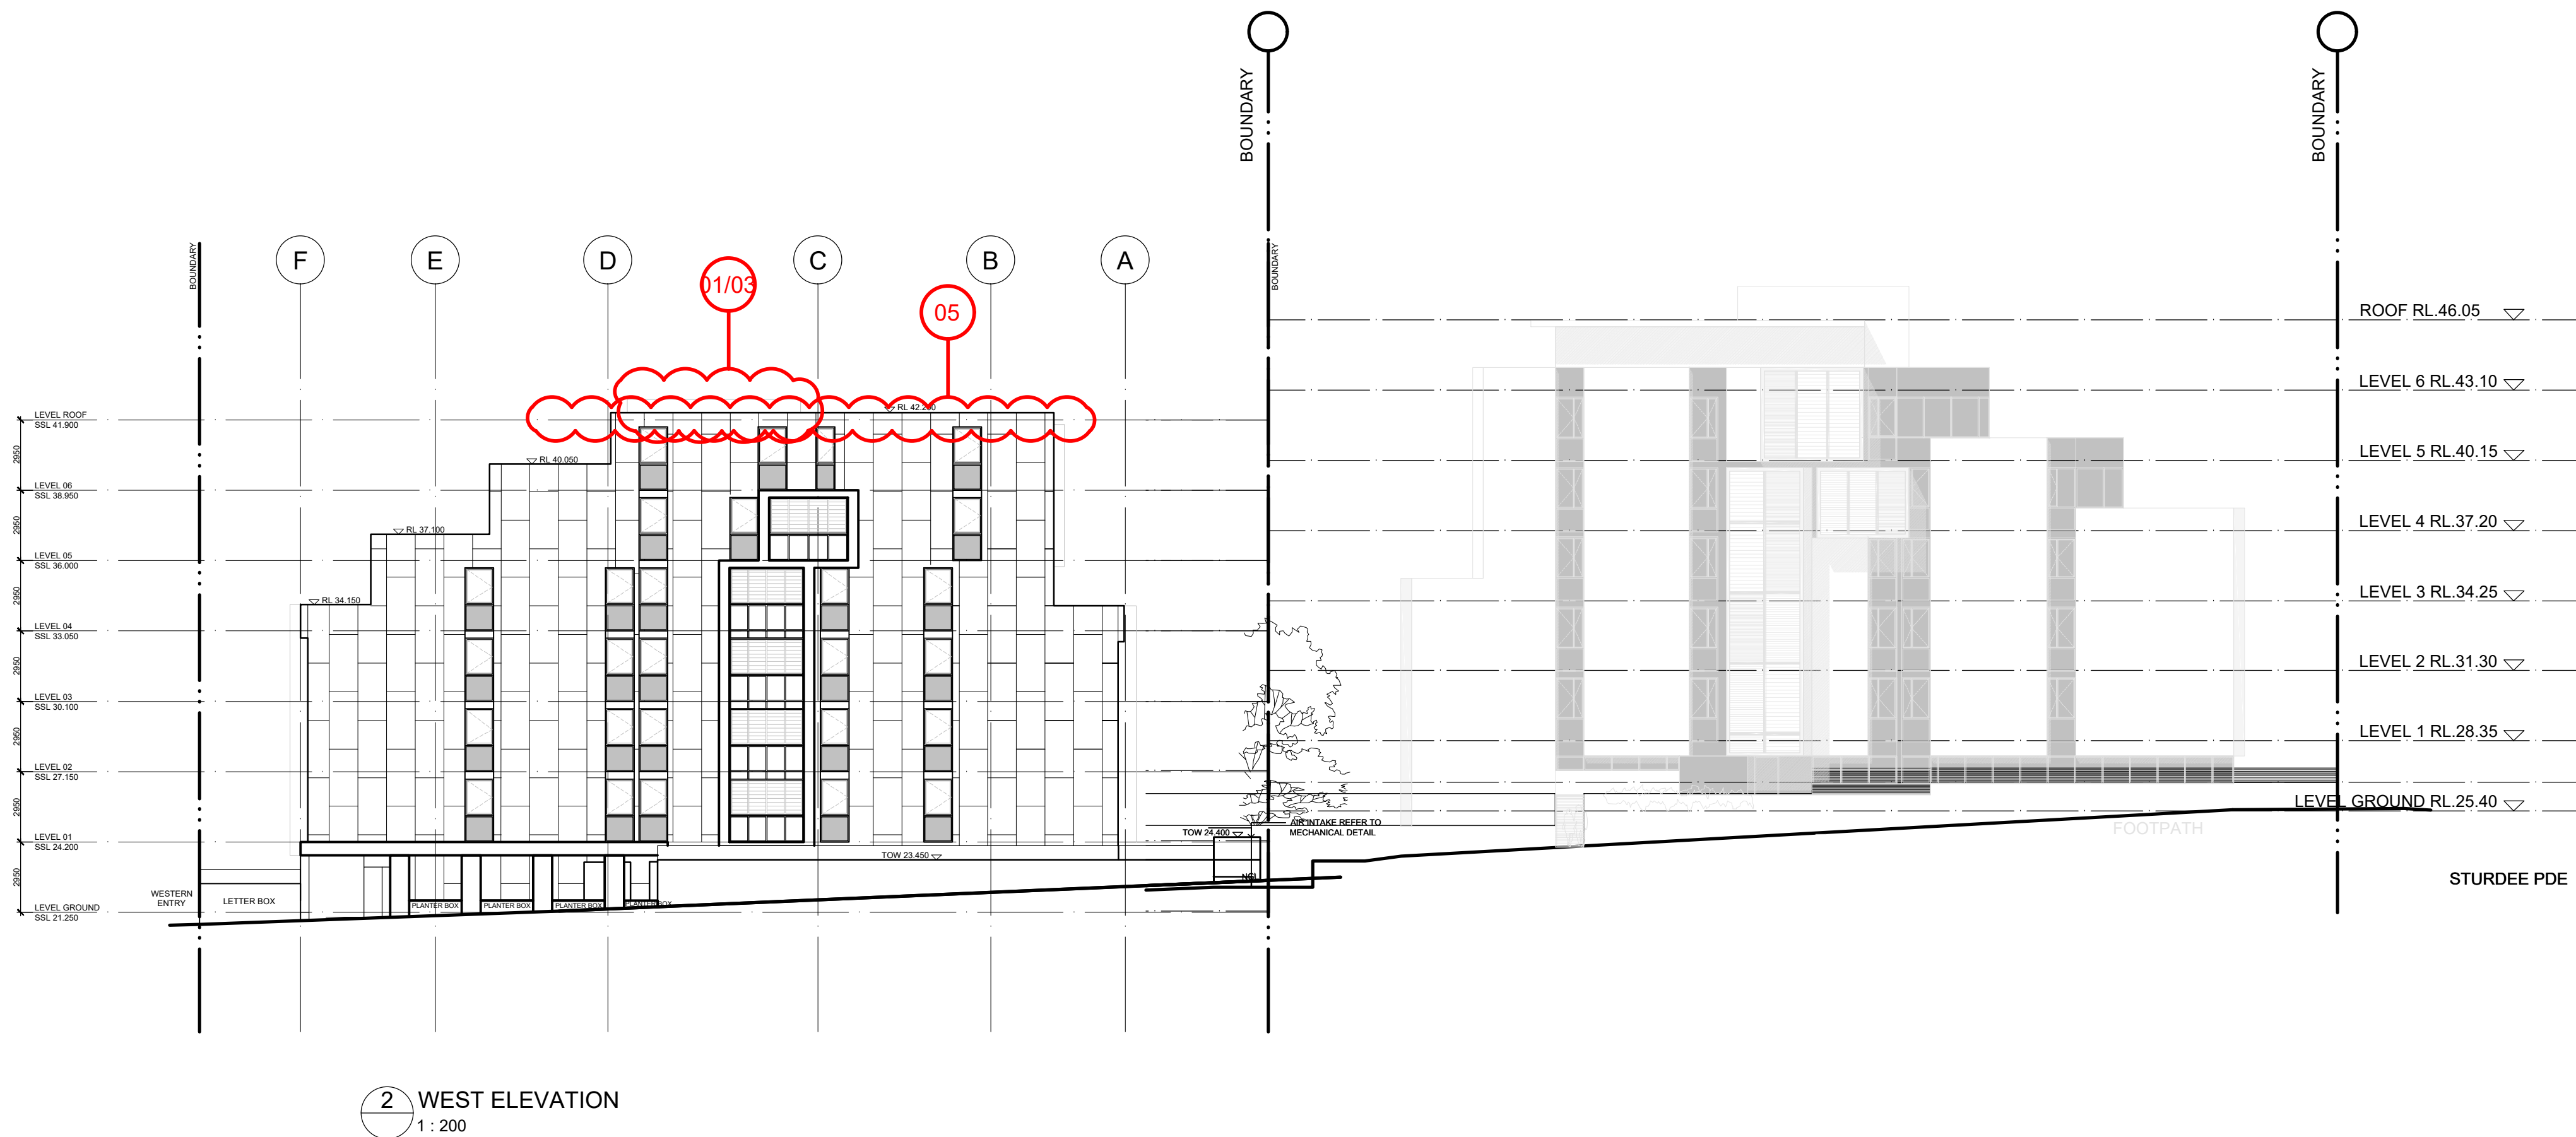



S96 AMENDMENTS

12/10/2017

- 01 AMENDED TOP OF LIFT 'AS BUILT'
(TOP OF LIFT AT RL43.140)
- 02 AMENDED TOP OF LIFT 'AS BUILT'
(TOP OF LIFT AT RL43.110)
- 03 RELOCATED AC CONDENSER PLANT AT ROOF
LEVEL (TOP OF PLANT AT RL43.320)
- 04 RELOCATED AC CONDENSER PLANT AT ROOF
LEVEL (TOP OF PLANT AT RL43.300)
- 05 INCREASE TO ROOF LEVEL PARAPET
(TOP OF PARAPET AT RL42.240)

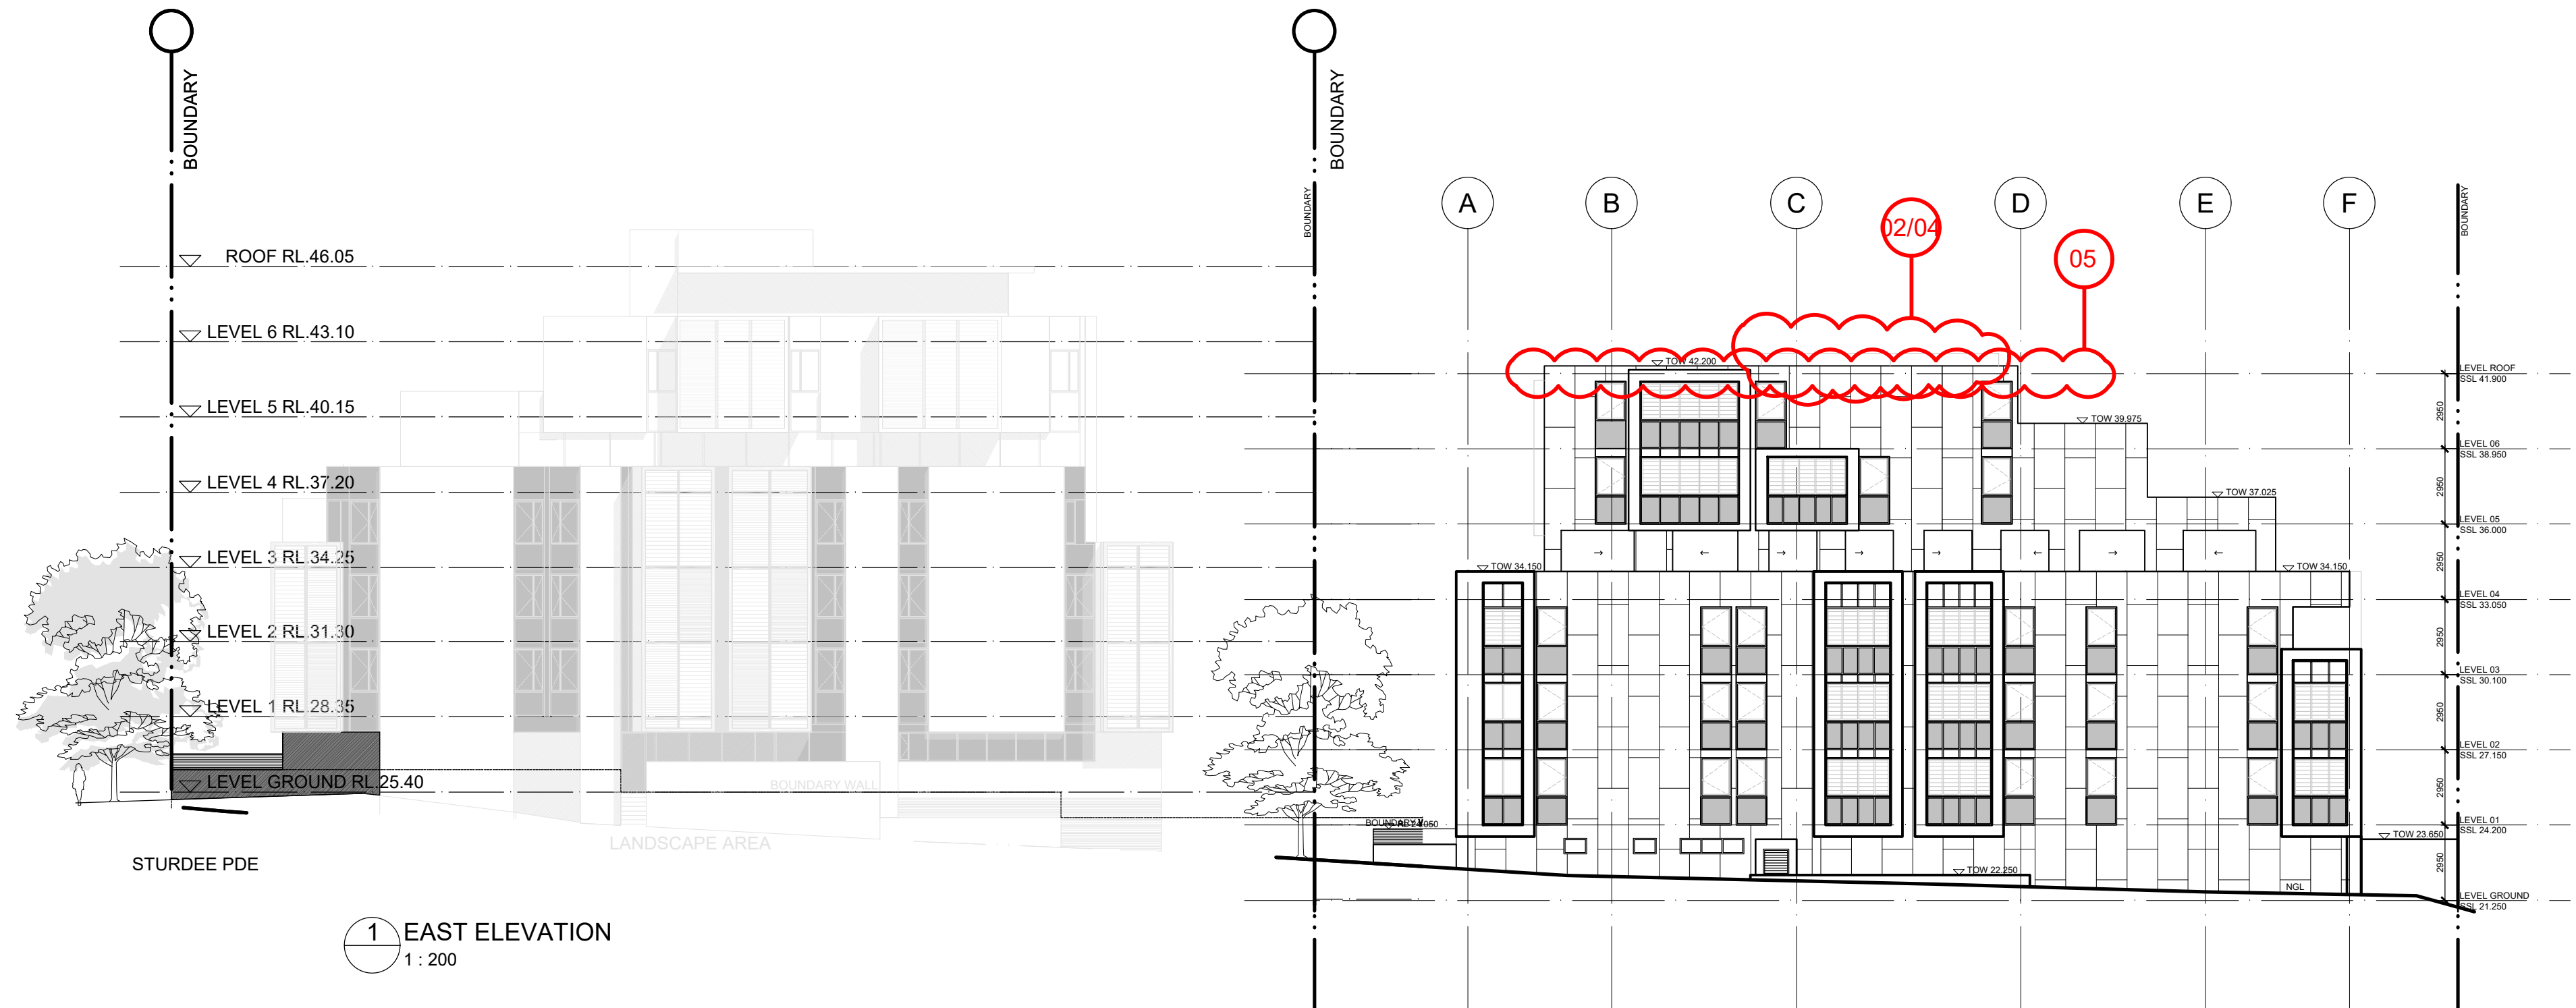

IMPORTANT NOTES: Do not scale from drawings. All dimensions to be checked on site before commencement of work. All discrepancies to be brought to the attention of the Architect. Larger scale drawings and written dimensions take preference. This drawing is copyright and the property of the author, and must not be retained, copied or used without the express authority of MARCHESE + PARTNERS INTERNATIONAL PTY. LTD. SECTION 96 NOT FOR CONSTRUCTION	REVISION	DATE	DESCRIPTION	BY	marchesepartners Marchese Partners International Pty Ltd Level 1, 53 Walker Street, North Sydney, NSW 2060 Australia P +61 2 9922 4375 F +61 2 9929 5786 E info@marchesepartners.com.au www.marchesepartners.com.au Sydney · Brisbane · Melbourne · Canberra · Adelaide · Perth · San Francisco · Kuala Lumpur ACN 098 552 151 ABN 20 098 552 151		CLIENT		DRAWING TITLE			
	ORACLE ESTATES PTY LTD		EAST & WEST ELEVATION									
	PROJECT		SCALE	DATE			DRAWN	CHECKED				
	PURE APARTMENTS - DEE WHY 23-29 PACIFIC PARADE DEE WHY NSW 2099		1 : 200 @ A1	17/10/16			LK	PD				
	JOB	DRAWING	REVISION									
	14099	DA 2.02	O									

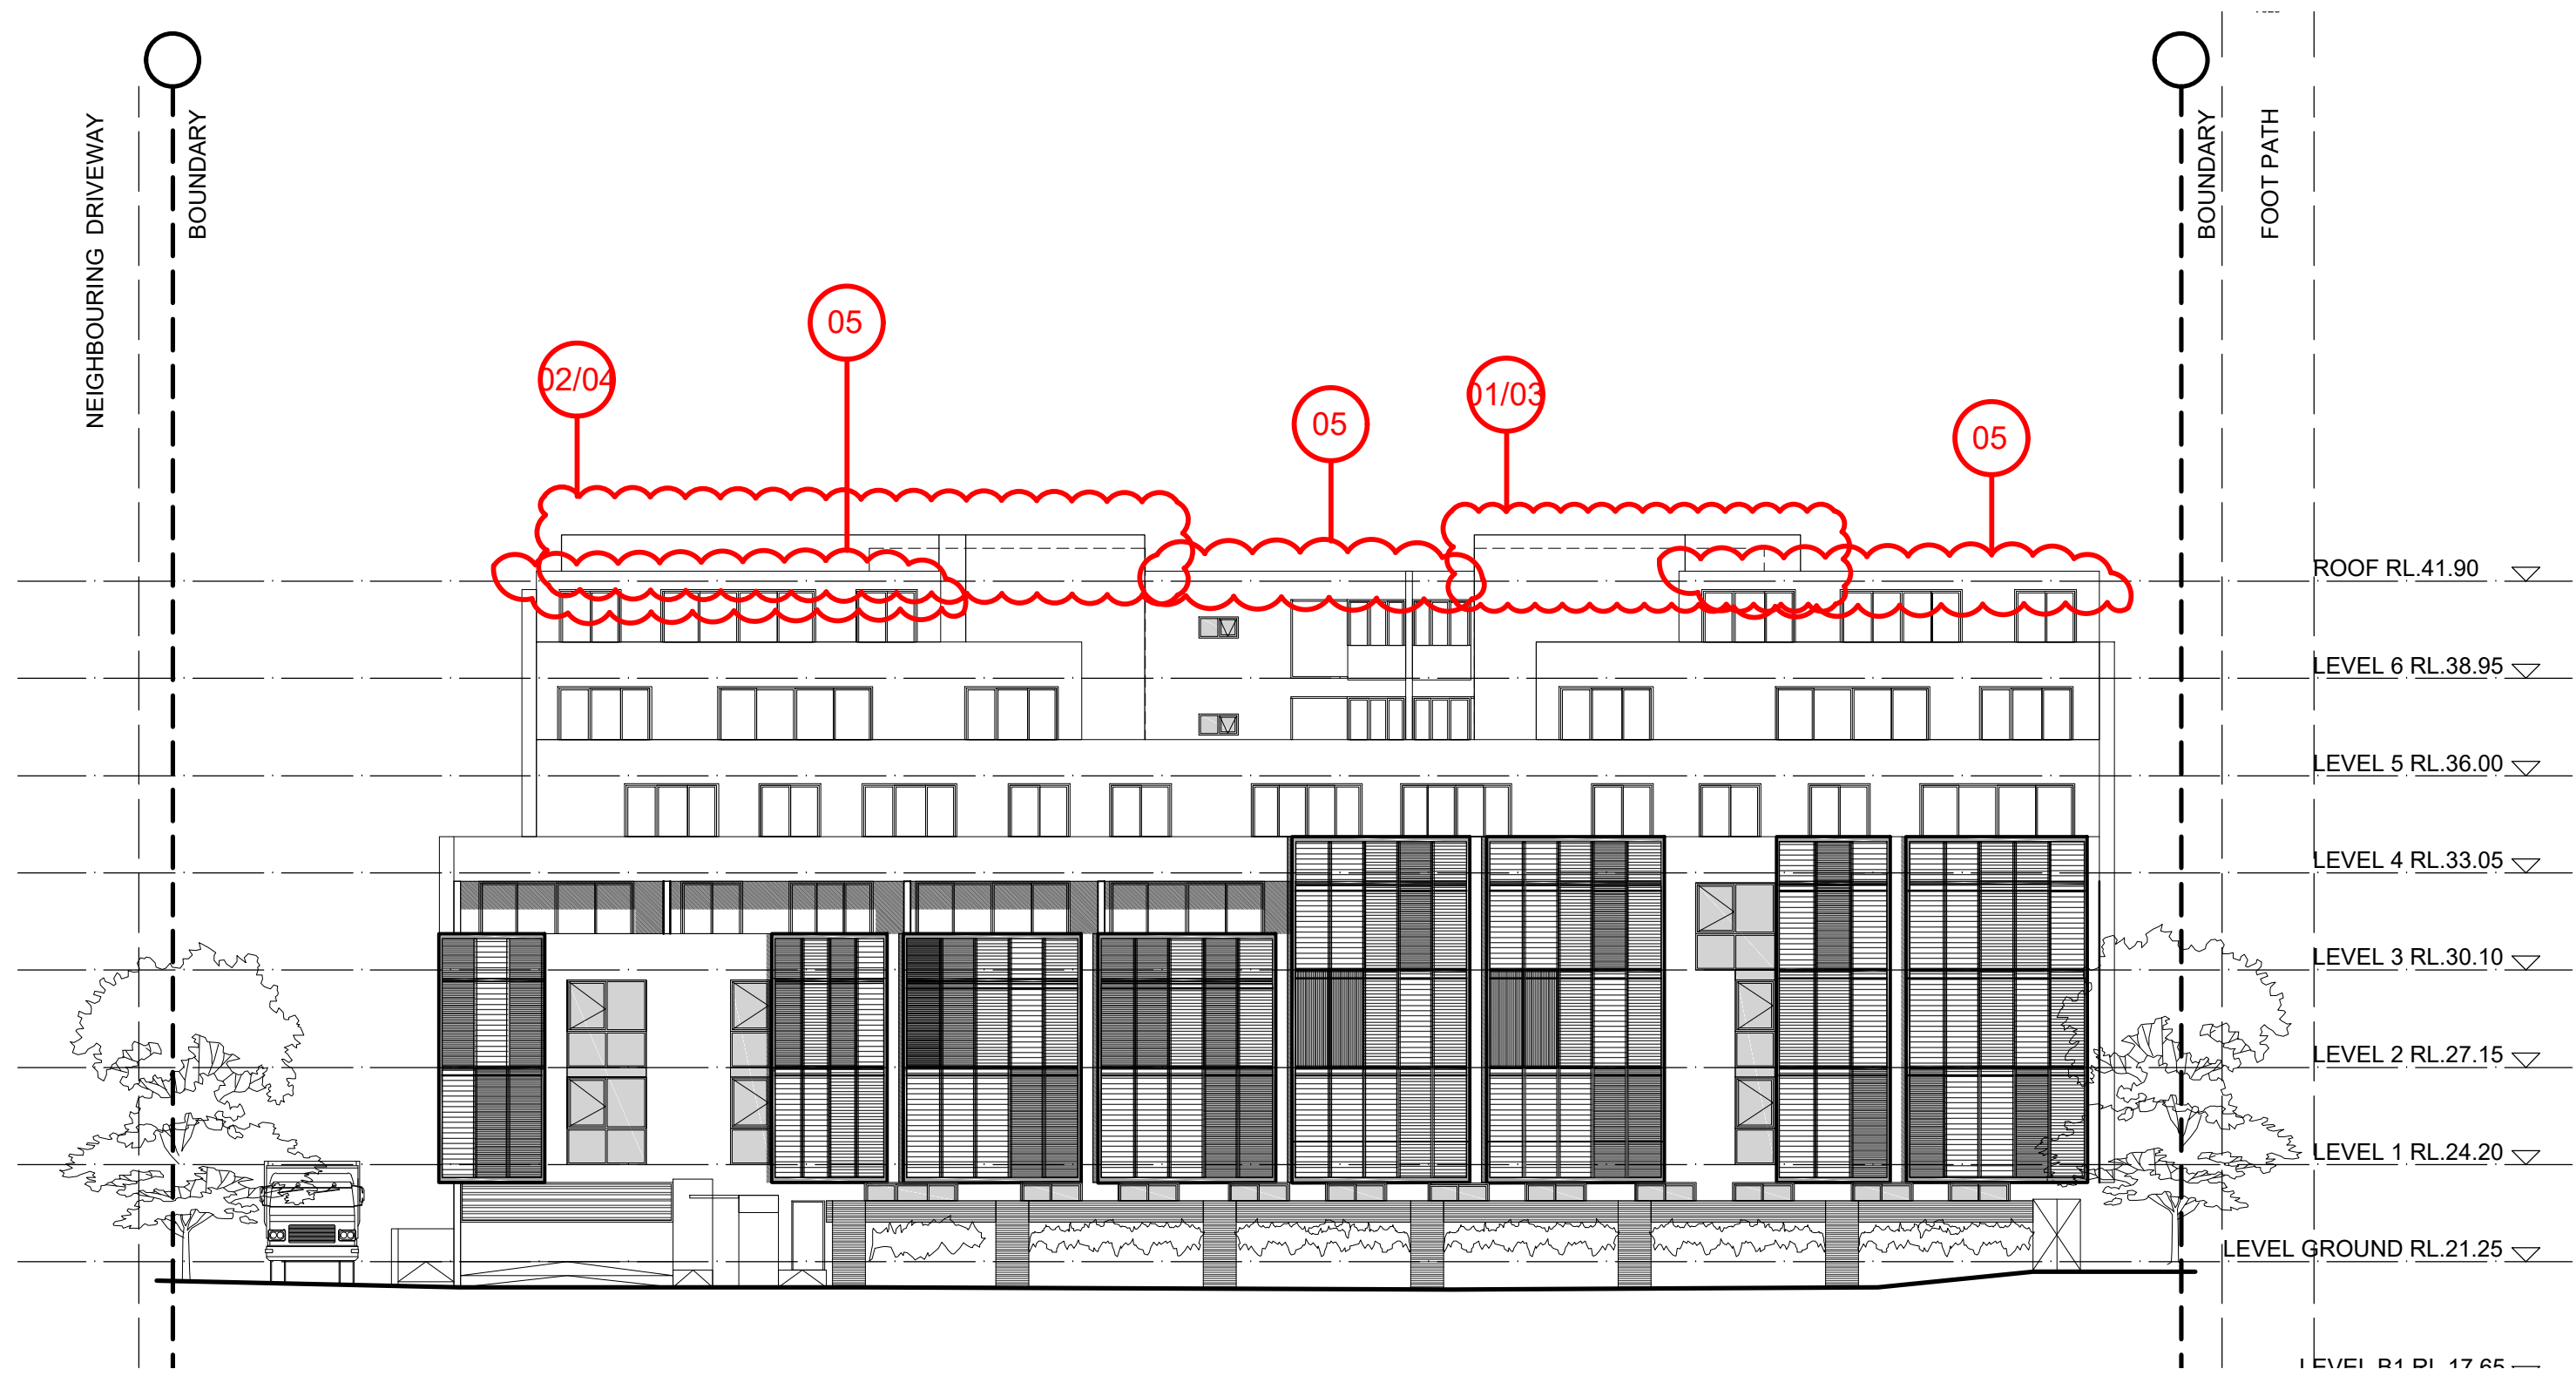

S96 AMENDMENTS

08/08/2017

- 01 AMENDED TOP OF LIFT 'AS BUILT'
RL43.140 (RL42.90 APPROVED)
- 02 AMENDED TOP OF LIFT 'AS BUILT'
RL43.110 (RL42.90 APPROVED)
- 03 RELOCATED AC CONDENSER PLANT AT ROOF
LEVEL (TOP OF PLANT AT RL43.320)
- 04 RELOCATED AC CONDENSER PLANT AT ROOF
LEVEL (TOP OF PLANT AT RL43.300)
- 05 INCREASE TO ROOF LEVEL PARAPET TO
RL42.240 (RL 42.200 APPROVED)




IMPORTANT NOTES: Do not scale from drawings. All dimensions to be checked on site before commencement of work. All discrepancies to be brought to the attention of the Architect. Larger scale drawings and written dimensions take preference. This drawing is copyright and the property of the author, and must not be retained, copied or used without the express authority of MARCHESE + PARTNERS INTERNATIONAL PTY. LTD. SECTION 96 NOT FOR CONSTRUCTION	REVISION	DATE	DESCRIPTION	BY	marchesepartners Marchese Partners International Pty Ltd Level 1, 53 Walker Street, North Sydney, NSW 2060 Australia P +61 2 9922 4375 F +61 2 9929 5786 E info@marchesepartners.com.au www.marchesepartners.com.au Sydney · Brisbane · Melbourne · Canberra · Adelaide · Perth · San Francisco · Kuala Lumpur ACN 098 552 151 ABN 20 098 552 151	CLIENT		DRAWING TITLE			
	ORACLE ESTATES PTY LTD										
	PROJECT		PURE APARTMENTS - DEE WHY 23-29 PACIFIC PARADE DEE WHY NSW 2099								
							SCALE	DATE	DRAWN	CHECKED	
	1 : 200 @ A1		17/10/16	LK		PD					
	JOB		DRAWING			REVISION					
	14099		DA 2.01			O					

S96 AMENDMENTS

08/08/2017

- 01 AMENDED TOP OF LIFT 'AS BUILT'
(TOP OF LIFT AT RL43.140)
- 02 AMENDED TOP OF LIFT 'AS BUILT'
(TOP OF LIFT AT RL43.110)
- 03 RELOCATED AC CONDENSER PLANT AT ROOF
LEVEL (TOP OF PLANT AT RL43.320)
- 04 RELOCATED AC CONDENSER PLANT AT ROOF
LEVEL (TOP OF PLANT AT RL43.300)
- 05 INCREASE TO ROOF LEVEL PARAPET
(TOP OF PARAPET AT RL42.240)

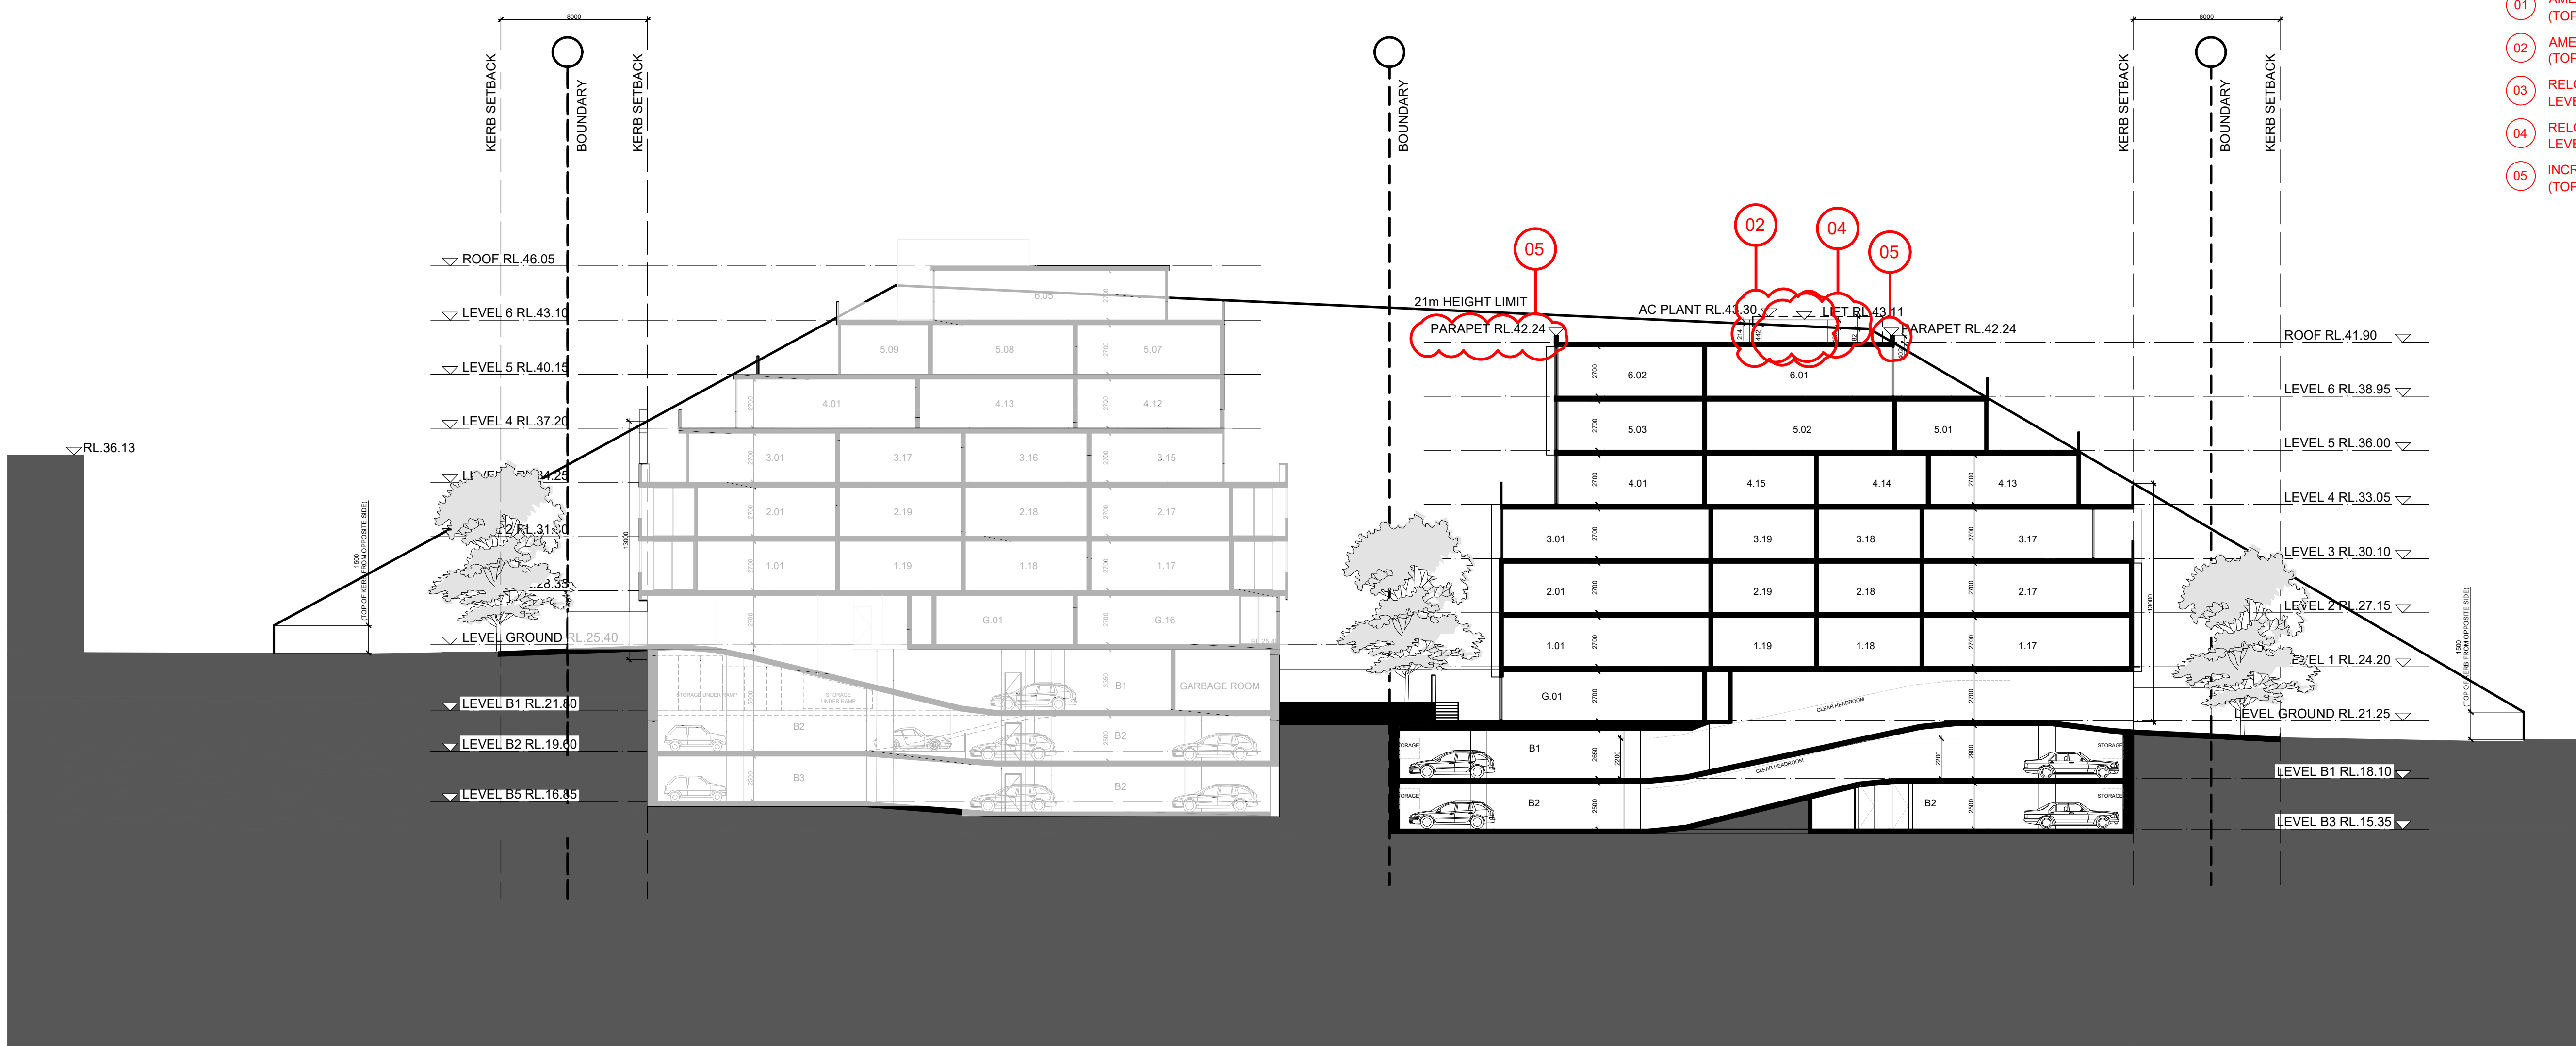

21m HEIGHT LIMIT

AC PLANT RL.43.30

LIFT RL.43.11

PARAPET RL.42.24

PARAPET RL.42.24

6.02

6.01

IMPORTANT NOTES:
Do not scale from drawings. All dimensions to be checked on site before commencement of work. All discrepancies to be brought to the attention of the Architect. Larger scale drawings and written dimensions take preference. This drawing is copyright and the property of the author, and must not be retained, copied or used without the express authority of MARCHESE + PARTNERS INTERNATIONAL PTY. LTD.

SECTION 96
NOT FOR CONSTRUCTION

REVISION	DATE	DESCRIPTION	BY
A	25/06/2015	IN HOUSE SECTION 96	KF
B	06/07/2015	IN HOUSE SECTION 96	KF
C	23/07/2015	IN HOUSE SECTION 96	KF
D	25/11/2015	IN HOUSE SECTION 96	KF
E	03/12/2015	IN HOUSE SECTION 96	KF
F	11/12/2015	IN HOUSE SECTION 96	KF
G	14/12/2015	IN HOUSE SECTION 96	KF
H	17/12/2015	SECTION 96 APPLICATION ISSUE	KF
K	18/10/2016	SECTION 96 APPLICATION ISSUE	LK
L	22/12/2016	SECTION 96 APPLICATION ISSUE	LK
M	06/02/2017	SECTION 96 APPLICATION ISSUE	PMD
N	06/08/2017	ISSUED FOR INFORMATION	PMD
O	12/10/2017	ISSUED FOR SECTION 96 APPLICATION	

marchesepartners

Marchese Partners International Pty Ltd
Level 1, 53 Walker Street, North Sydney, NSW 2060 Australia
P +61 2 9922 4375 F +61 2 9929 5786 E info@marchesepartners.com.au
www.marchesepartners.com.au
Sydney · Brisbane · Melbourne · Canberra · Adelaide · Perth · San Francisco · Kuala Lumpur
ACN 098 552 151 ABN 20 098 552 151

CLIENT
ORACLE
ESTATES PTY LTD

PROJECT
PURE APARTMENTS - DEE WHY
23-29 PACIFIC PARADE
DEE WHY NSW 2099


DRAWING TITLE
SECTION THRU CARPARK RAMP

SCALE	DATE	DRAWN	CHECKED
1 : 200 @ A1	17/10/16	KF	PD
JOB	DRAWING	REVISION	
14099	DA 3.01	O	


S96 AMENDMENTS

12/10/2017


- 01 AMENDED TOP OF LIFT 'AS BUILT'
(TOP OF LIFT AT RL43.140)
- 02 AMENDED TOP OF LIFT 'AS BUILT'
(TOP OF LIFT AT RL43.110)
- 03 RELOCATED AC CONDENSER PLANT AT ROOF
LEVEL (TOP OF PLANT AT RL43.320)
- 04 RELOCATED AC CONDENSER PLANT AT ROOF
LEVEL (TOP OF PLANT AT RL43.300)
- 05 INCREASE TO ROOF LEVEL PARAPET
(TOP OF PARAPET AT RL42.240)

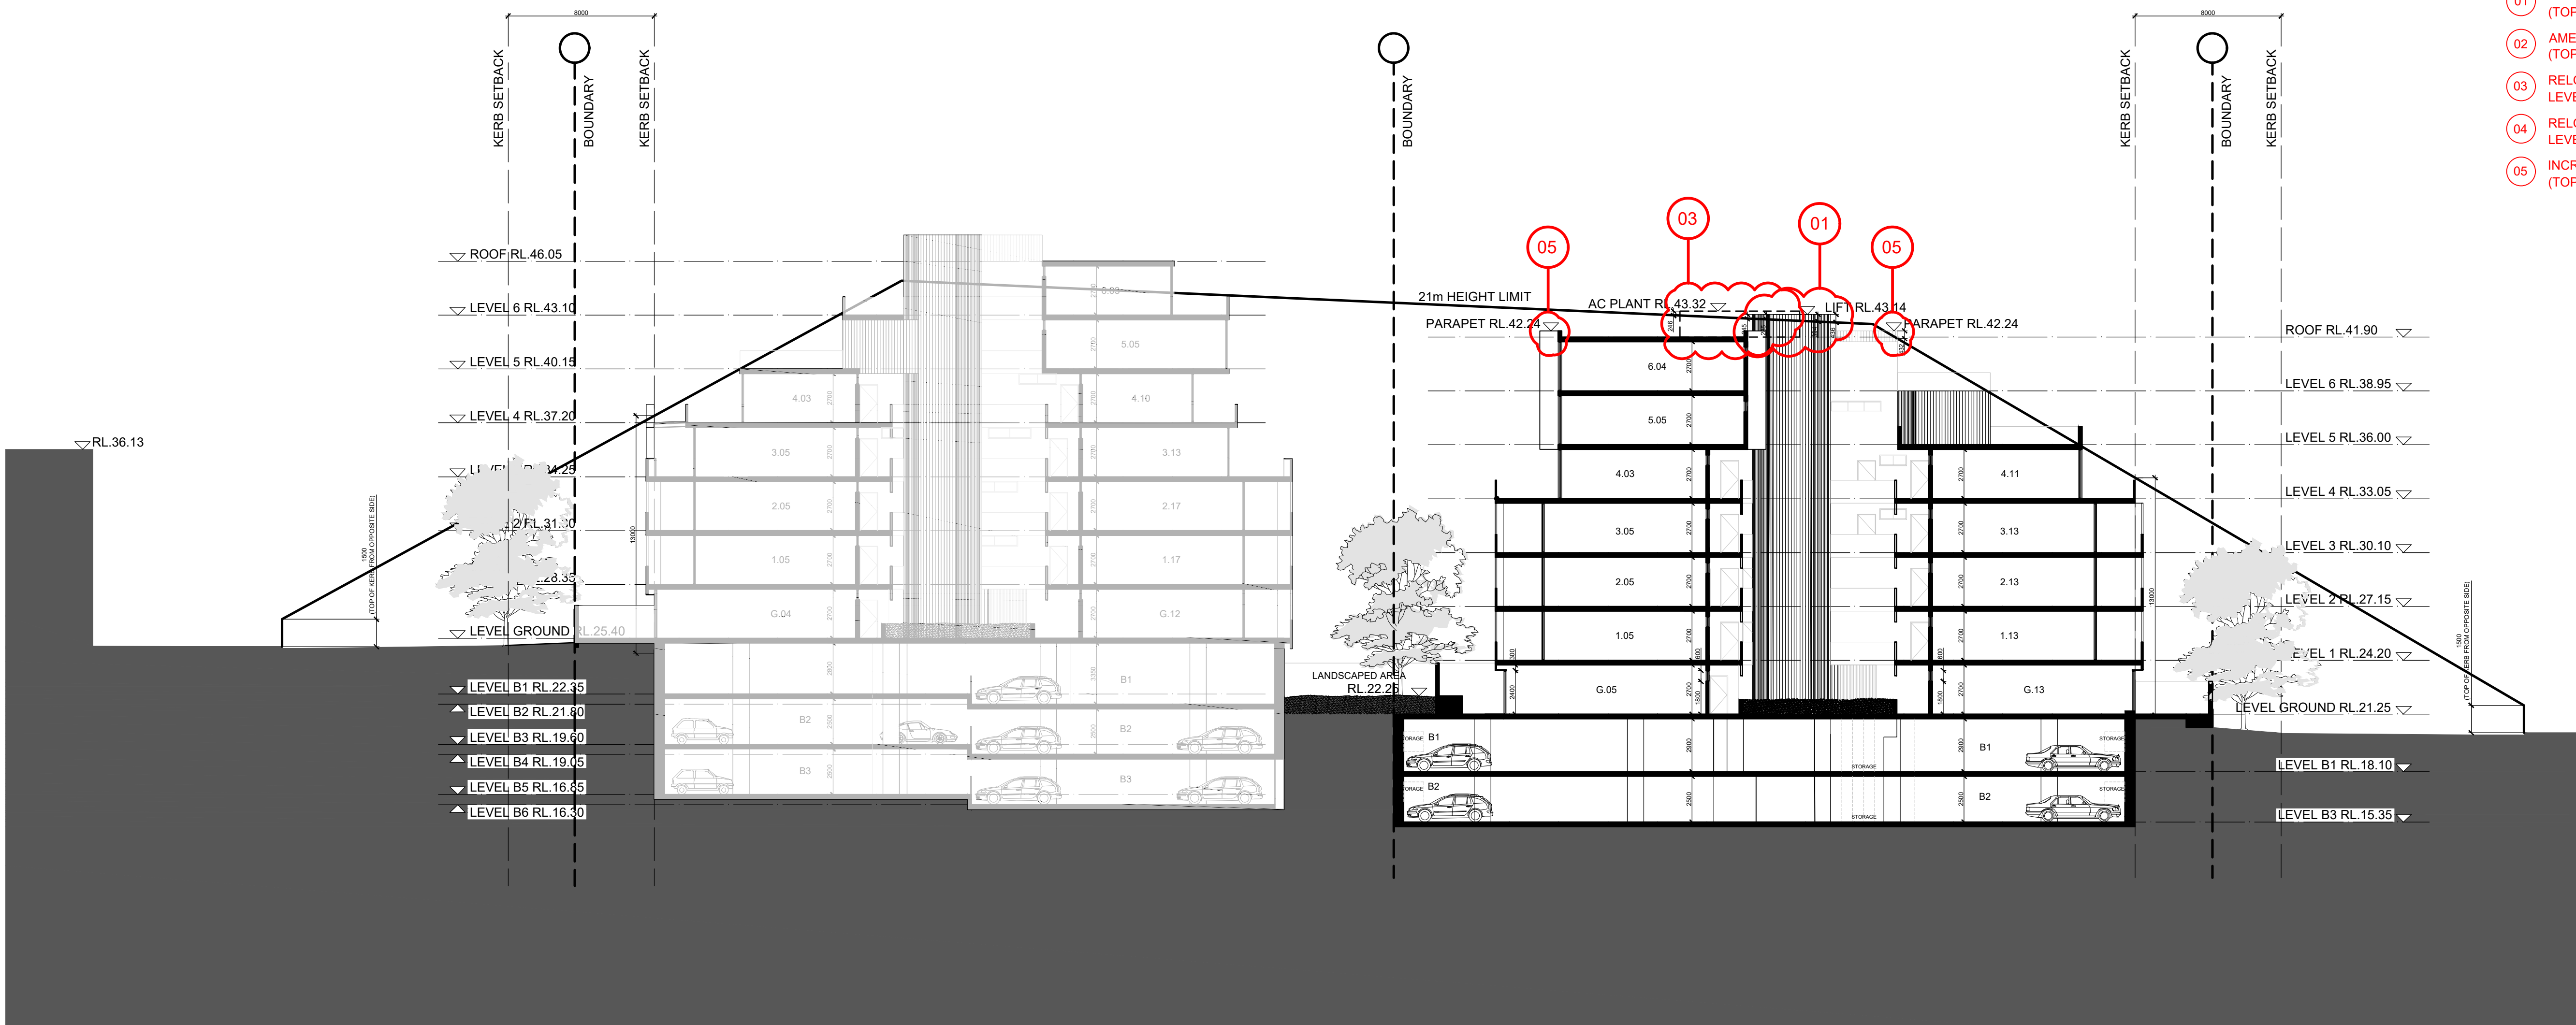

21m HEIGHT LIMIT

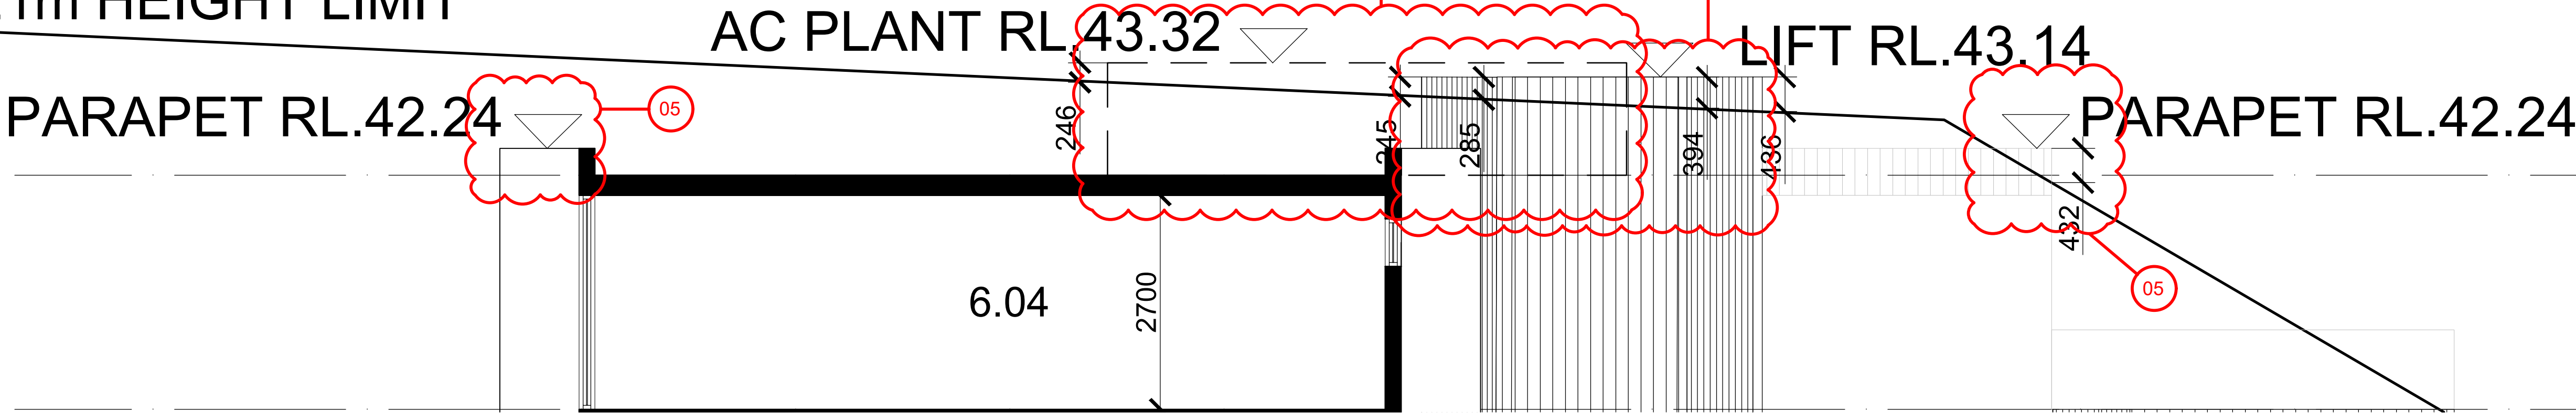

IMPORTANT NOTES: Do not scale from drawings. All dimensions to be checked on site before commencement of work. All discrepancies to be brought to the attention of the Architect. Larger scale drawings and written dimensions take preference. This drawing is copyright and the property of the author, and must not be retained, copied or used without the express authority of MARCHESE + PARTNERS INTERNATIONAL PTY. LTD. SECTION 96 NOT FOR CONSTRUCTION	REVISION	DATE	DESCRIPTION	BY	marchesepartners Marchese Partners International Pty Ltd Level 1, 53 Walker Street, North Sydney, NSW 2060 Australia P +61 2 9922 4375 F +61 2 9929 5786 E info@marchesepartners.com.au www.marchesepartners.com.au Sydney · Brisbane · Melbourne · Canberra · Adelaide · Perth · San Francisco · Kuala Lumpur ACN 098 552 151 ABN 20 098 552 151		CLIENT		DRAWING TITLE			
	ORACLE ESTATES PTY LTD		SECTION THUR COURTYARD									
	PROJECT		SCALE	DATE			DRAWN	CHECKED				
	PURE APARTMENTS - DEE WHY 23-29 PACIFIC PARADE DEE WHY NSW 2099		1 : 200 @ A1	17/10/16			KF	PD				
	JOB	DRAWING	REVISION									
	14099	DA 3.02	O									

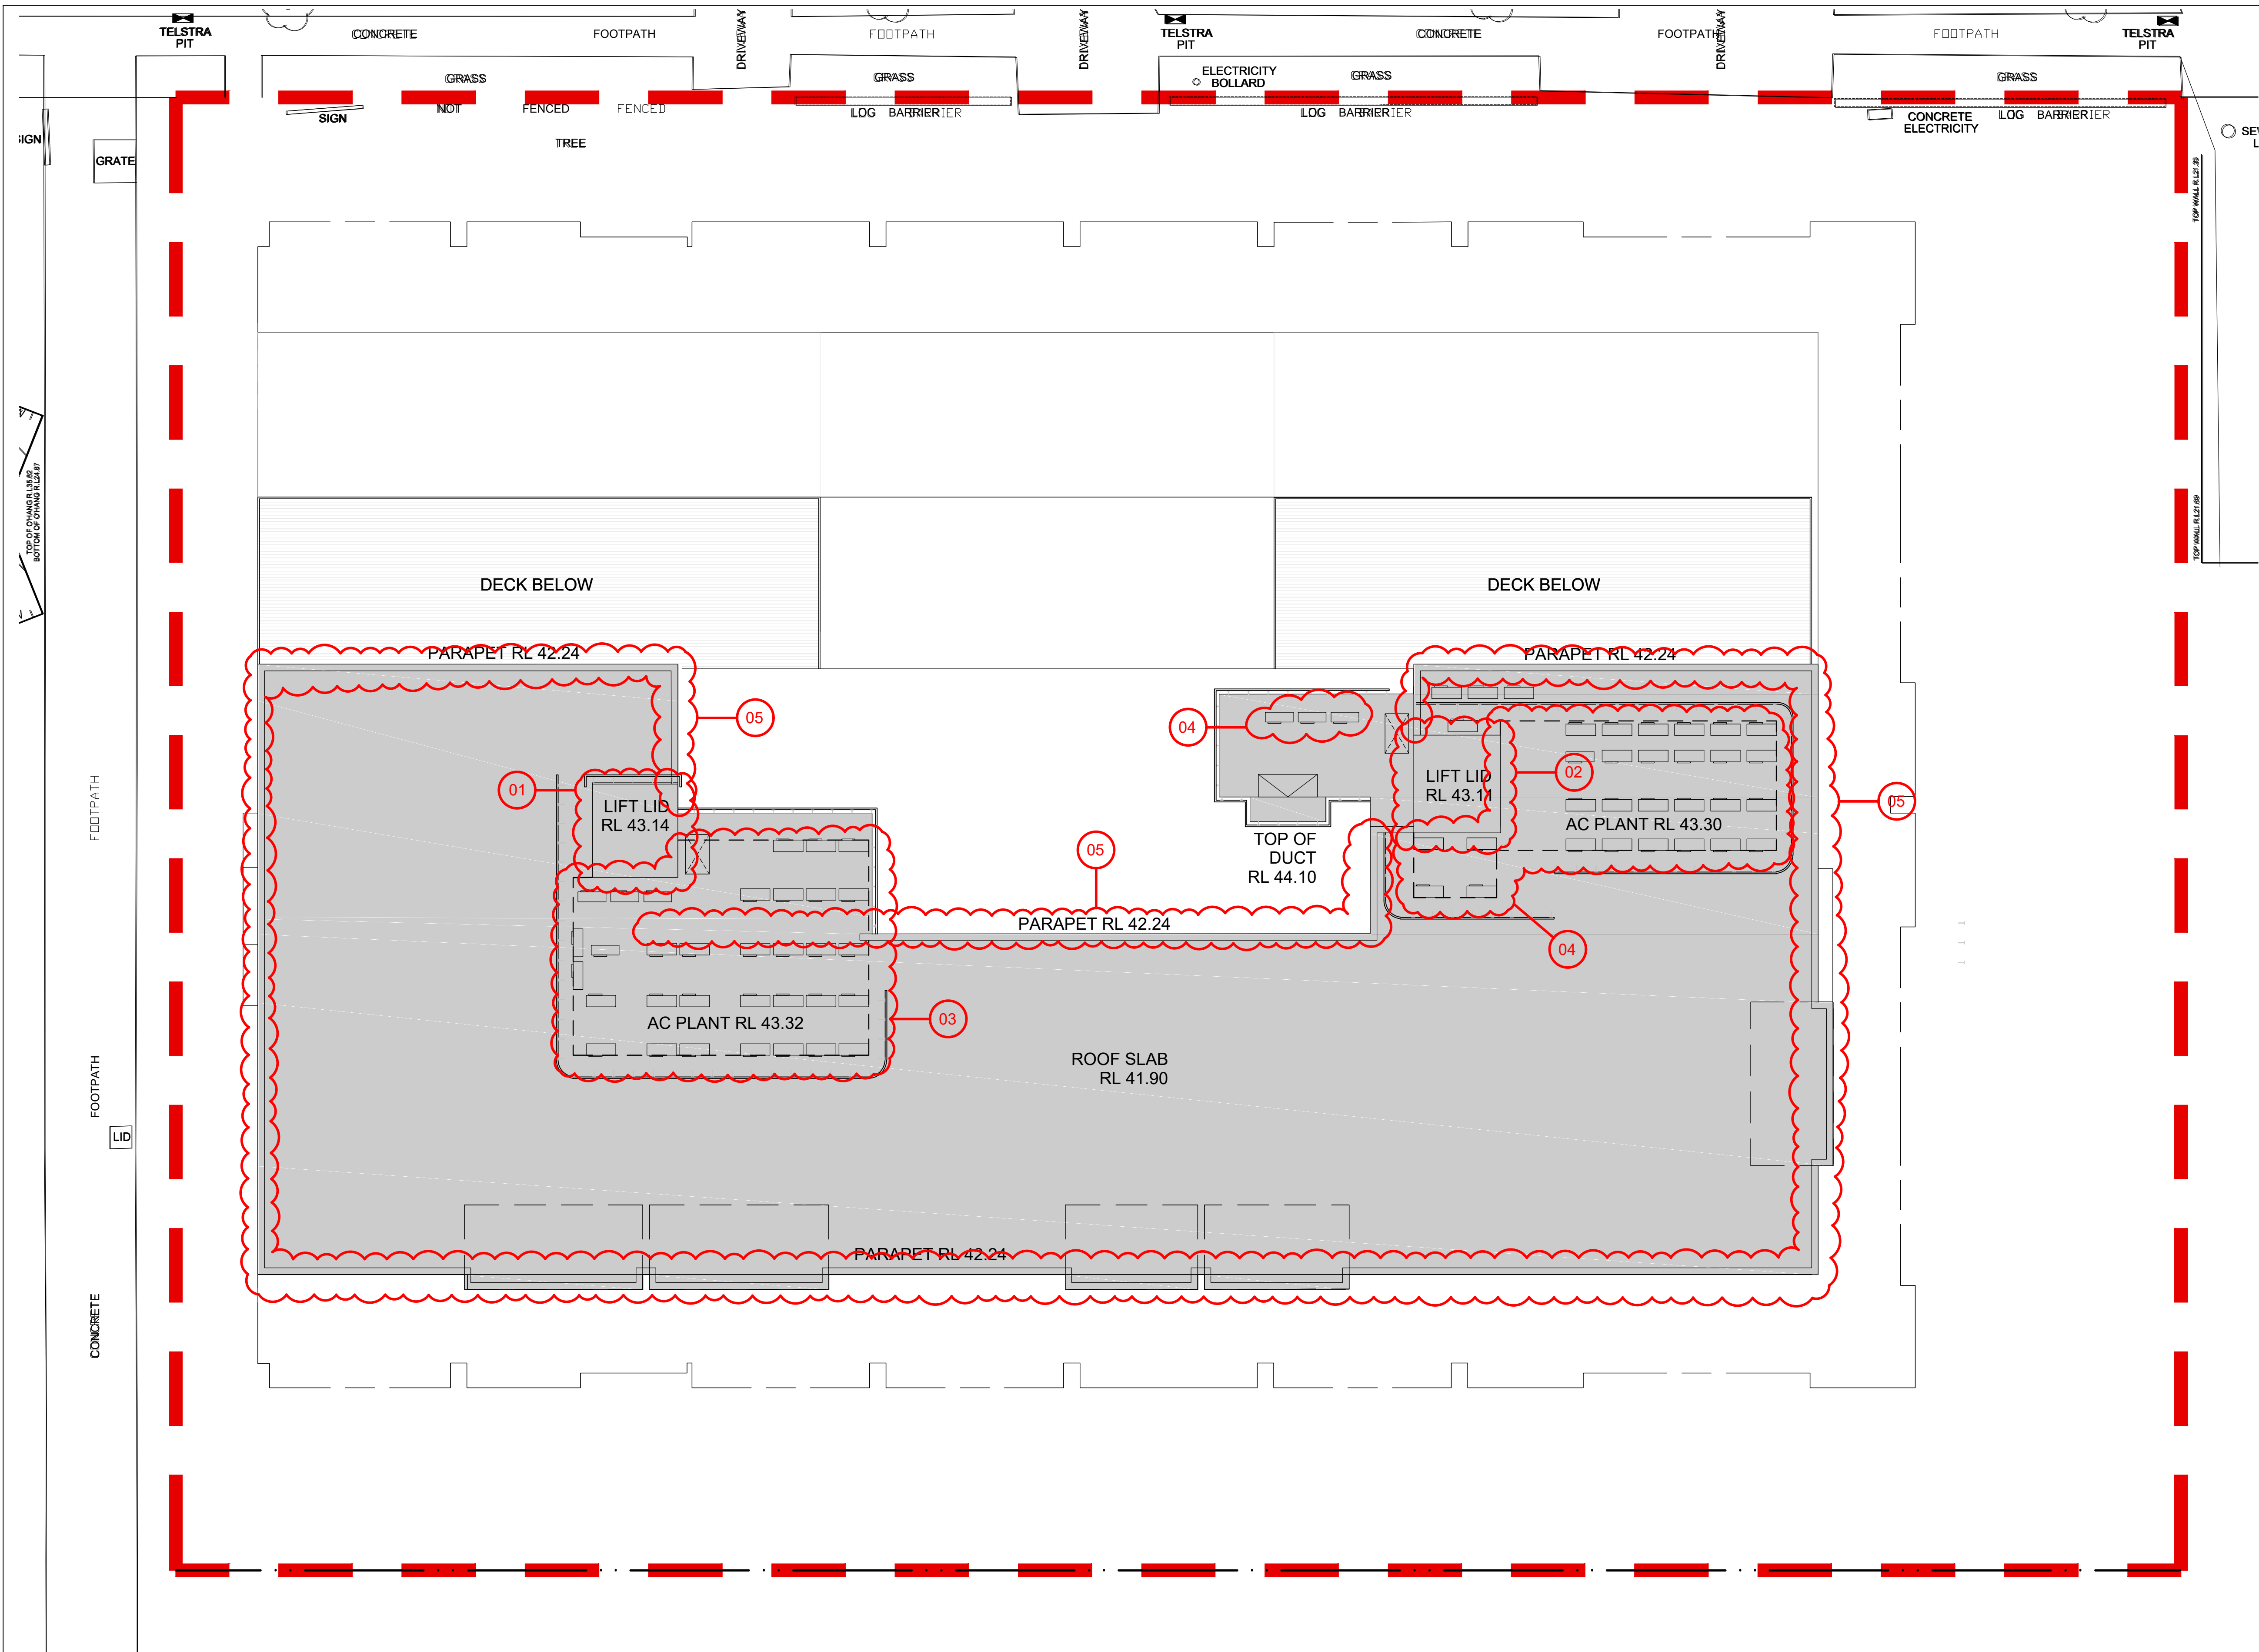

- S96 AMENDMENTS**
12/10/2017
- 01 AMENDED TOP OF LIFT 'AS BUILT' (TOP OF LIFT AT RL43.140)
 - 02 AMENDED TOP OF LIFT 'AS BUILT' (TOP OF LIFT AT RL43.110)
 - 03 RELOCATED AC CONDENSER PLANT AT ROOF LEVEL (TOP OF PLANT AT RL43.320)
 - 04 RELOCATED AC CONDENSER PLANT AT ROOF LEVEL (TOP OF PLANT AT RL43.300)
 - 05 INCREASE TO ROOF LEVEL PARAPET (TOP OF PARAPET AT RL42.240)

IMPORTANT NOTES: Do not scale from drawings. All dimensions to be checked on site before commencement of work. All discrepancies to be brought to the attention of the Architect. Larger scale drawings and written dimensions take preference. This drawing is copyright and the property of the author, and must not be retained, copied or used without the express authority of MARCHESE + PARTNERS INTERNATIONAL PTY. LTD. SECTION 96 NOT FOR CONSTRUCTION	REVISION	DATE	DESCRIPTION	BY	marchesepartners Marchese Partners International Pty Ltd Level 1, 53 Walker Street, North Sydney, NSW 2060 Australia P +61 2 9922 4375 F +61 2 9929 5786 E info@marchesepartners.com.au www.marchesepartners.com.au Sydney · Brisbane · Melbourne · Canberra · Adelaide · Perth · San Francisco · Kuala Lumpur ACN 098 552 151 ABN 20 098 552 151	N	CLIENT ORACLE ESTATES PTY LTD		DRAWING TITLE ROOF PLAN			
	A	25/05/2015	IN HOUSE SECTION 96	KF			PROJECT PURE APARTMENTS - DEE WHY 23-29 PACIFIC PARADE DEE WHY NSW 2099	SCALE 1 : 100 @ A1 1 : 200 @ A3	DATE 17/10/16	DRAWN KF	CHECKED PD	
	B	06/07/2015	IN HOUSE SECTION 96	KF								
	C	23/07/2015	IN HOUSE SECTION 96	KF								
	D	25/11/2015	IN HOUSE SECTION 96	KF								
E	03/12/2015	IN HOUSE SECTION 96	KF									
F	11/12/2015	IN HOUSE SECTION 96	KF									
G	14/12/2015	IN HOUSE SECTION 96	KF									
H	17/12/2015	SECTION 96 APPLICATION ISSUE	KF									
K	18/10/2016	SECTION 96 APPLICATION ISSUE	LK									
L	22/12/2016	SECTION 96 APPLICATION ISSUE	LK									
M	06/02/2017	SECTION 96 APPLICATION ISSUE	PMD									
N	06/06/2017	ISSUED FOR INFORMATION	PMD									
O	12/10/2017	ISSUED FOR SECTION 96 APPLICATION										