


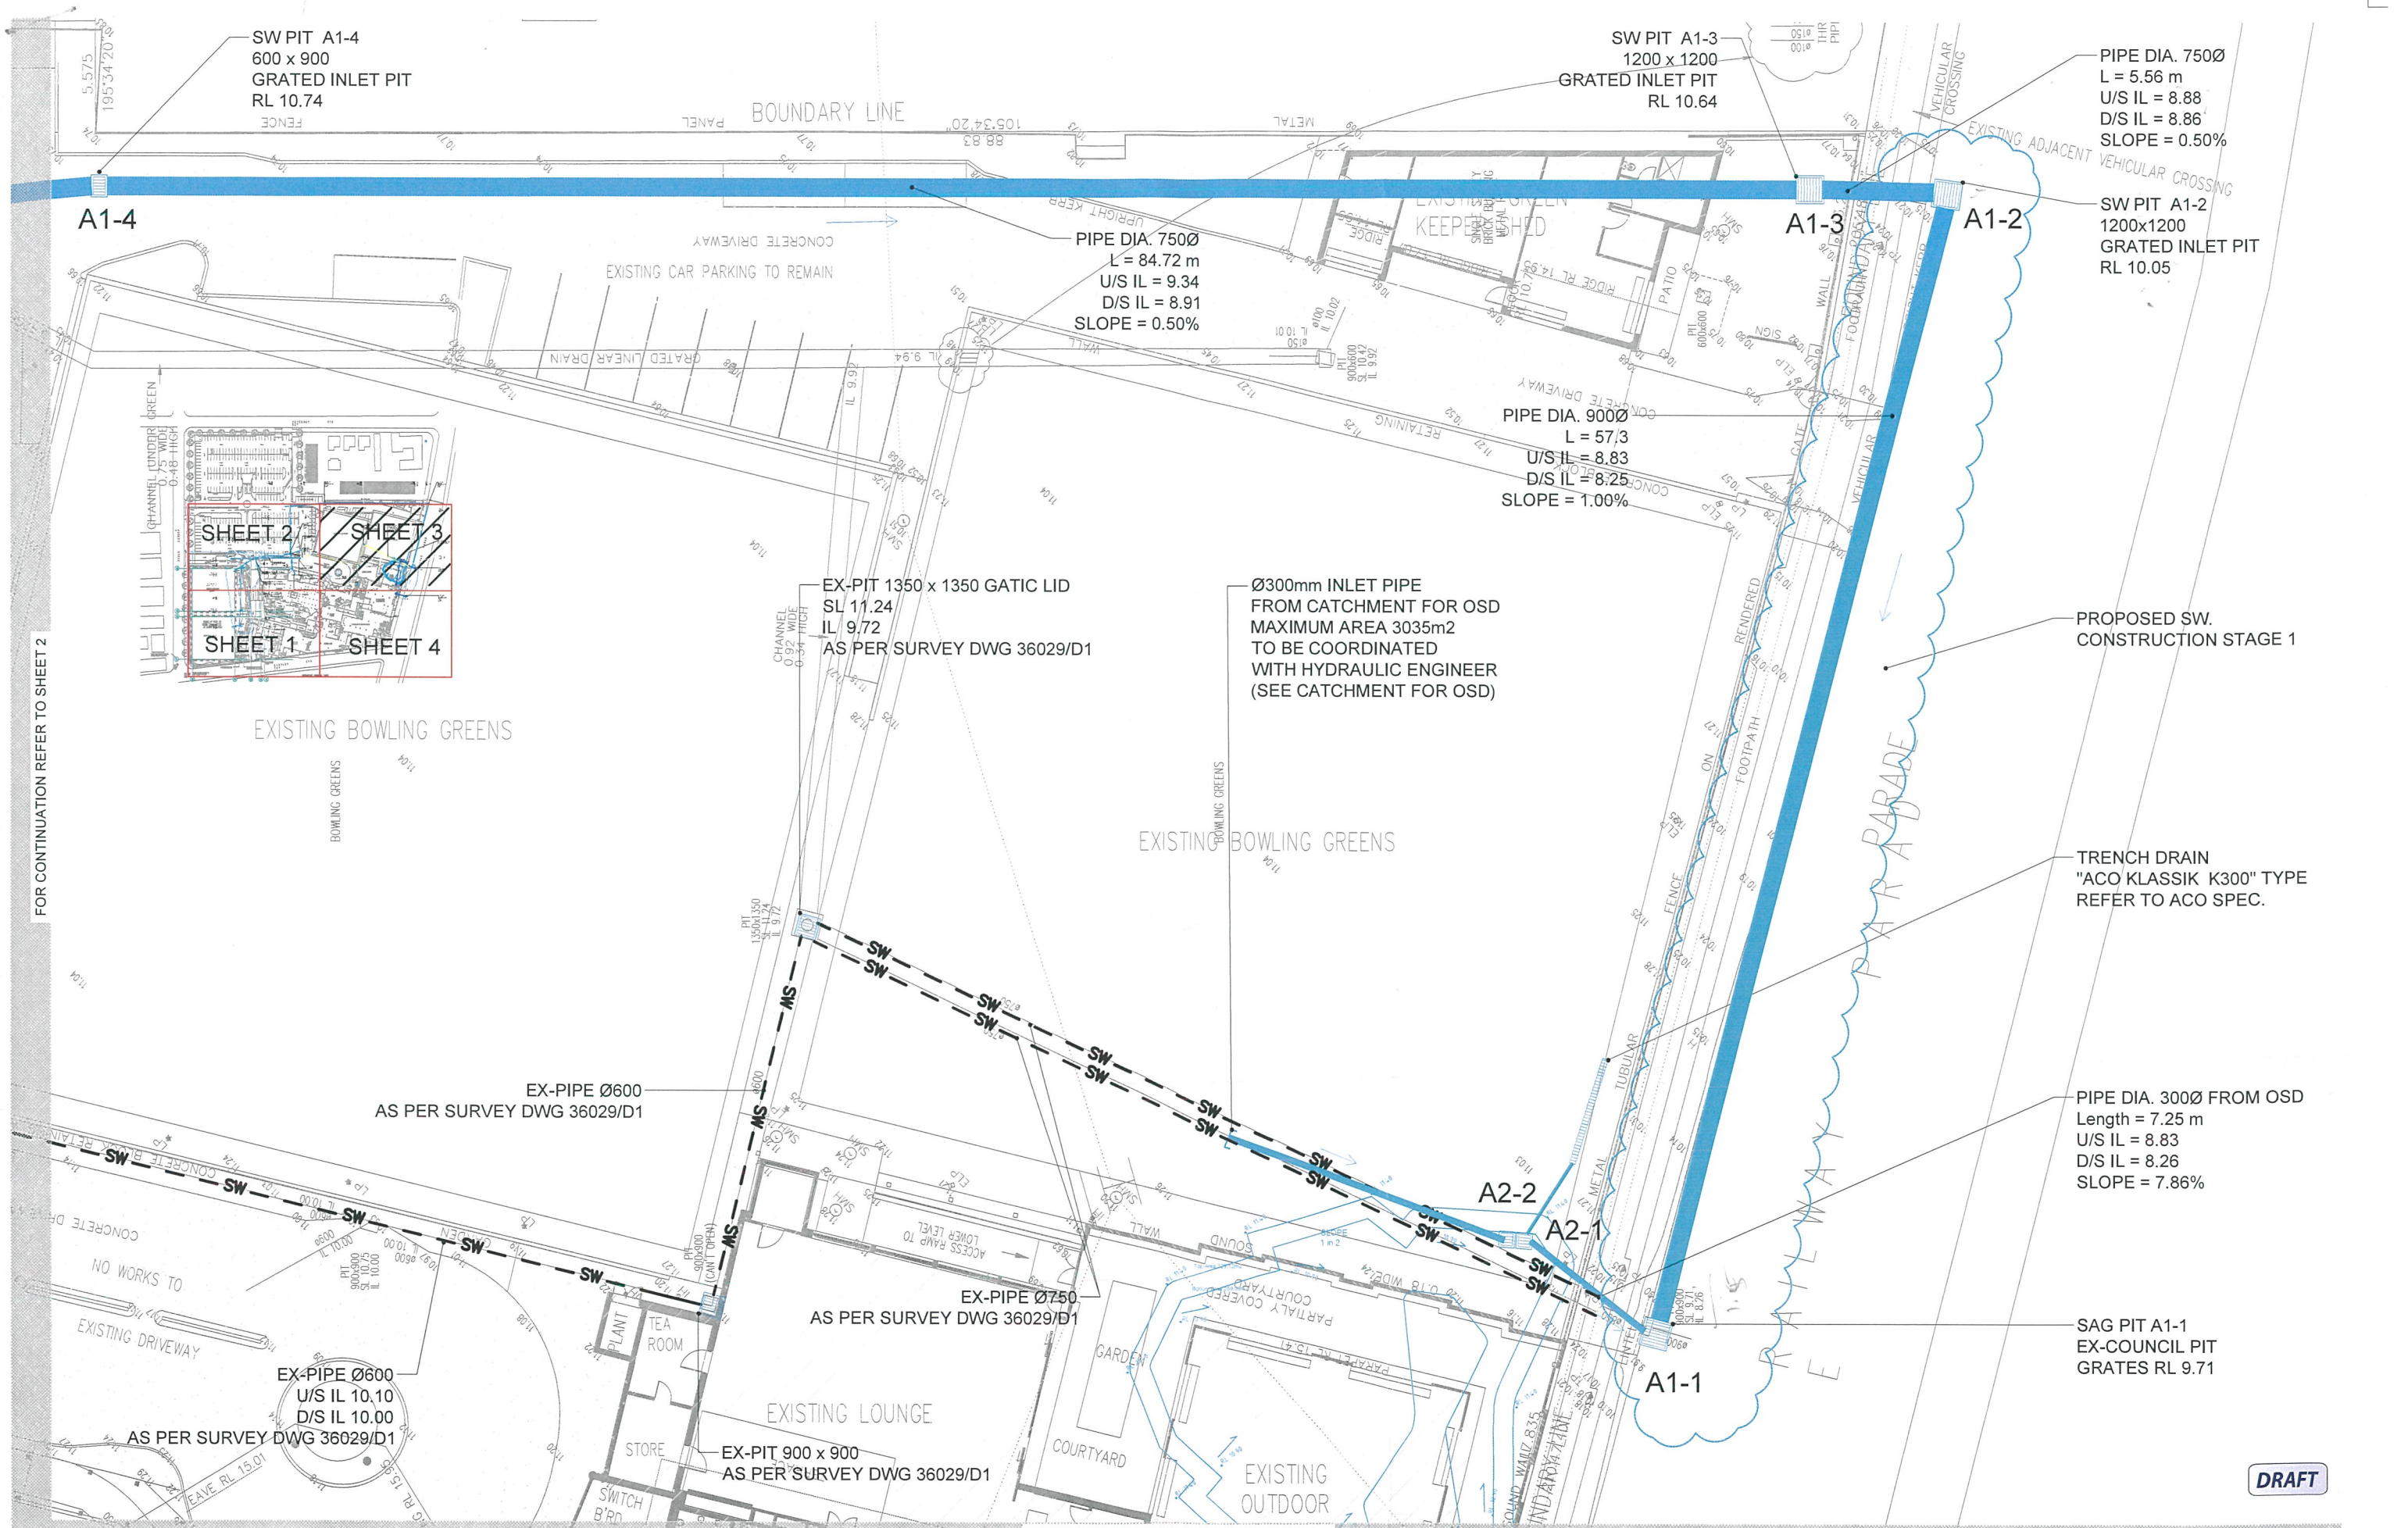

FOR CONTINUATION REFER TO SHEET 2

FOR CONTINUATION REFER TO SHEET 4



REV	DATE	REVISION DETAILS	LAST EDITED	REV	DATE	REVISION DETAILS	LAST EDITED
1	05-24-18	INITIAL MARK UP FOR REVIEW	05-24-18	1	05-24-18	INITIAL MARK UP FOR REVIEW	05-24-18
2	12-05-18	RE-DESIGN BASED ON INITIAL MARK UP	12-05-18	2	12-05-18	RE-DESIGN BASED ON INITIAL MARK UP	12-05-18
3	14-05-18	RE-DESIGN AFTER COUNCIL COMMENTS	14-05-18	3	14-05-18	RE-DESIGN AFTER COUNCIL COMMENTS	14-05-18
4	19-05-18	FOR APPROVAL	19-05-18	4	19-05-18	FOR APPROVAL	19-05-18

SCALE	SIZE
1:100	A0
DRAWN	AC
DESIGNED	TR
VERIFIED	WZ




PROJECT	PROPOSED DEVELOPMENT AT CABRA-VALE, DIGGERS
DRG. TITLE	CIVIL WORKS PACKAGE STORMWATER PLAN SHEET 3 OF 4
DRAWING No.	C17216601
DATE	19-05-18
REV	04

DRAFT

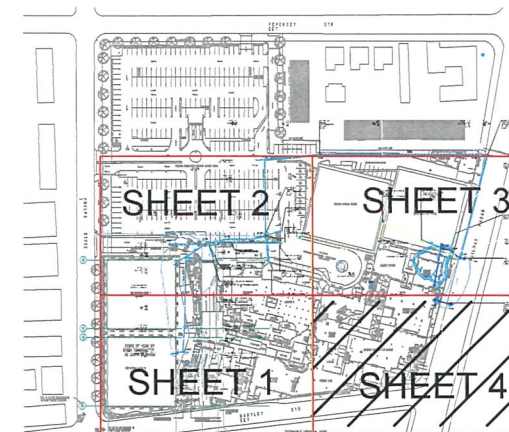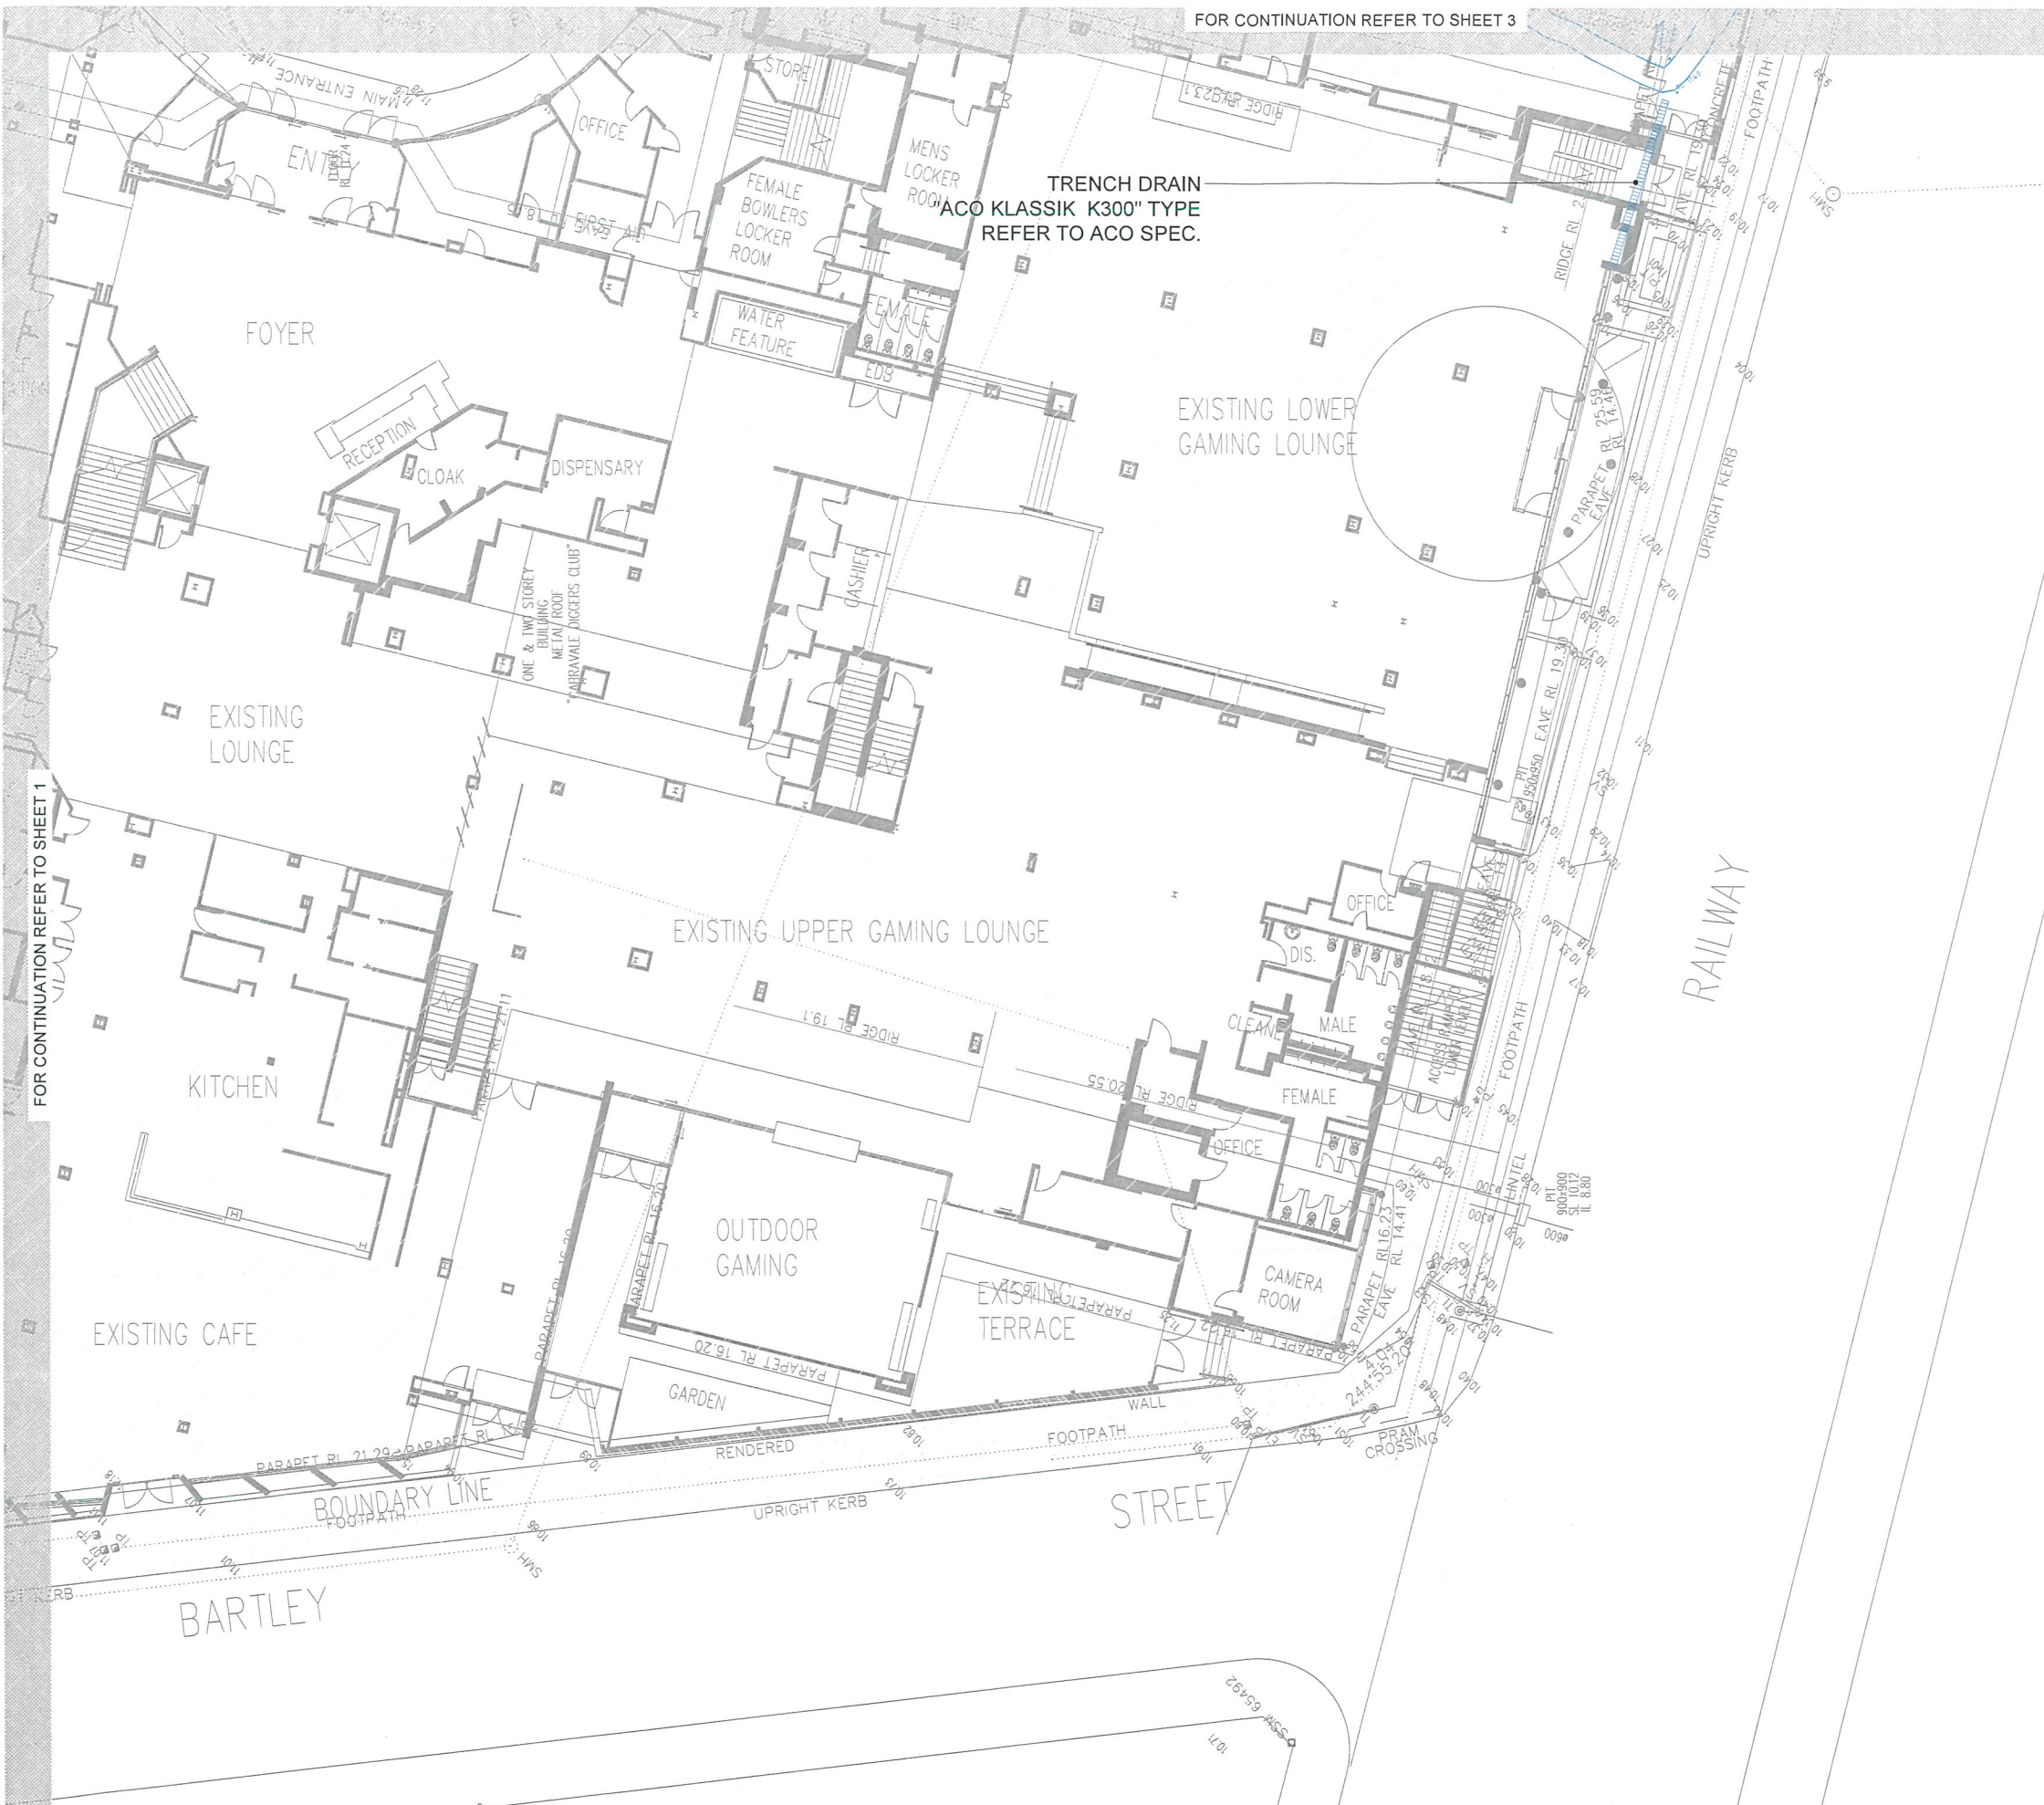

DRAFT



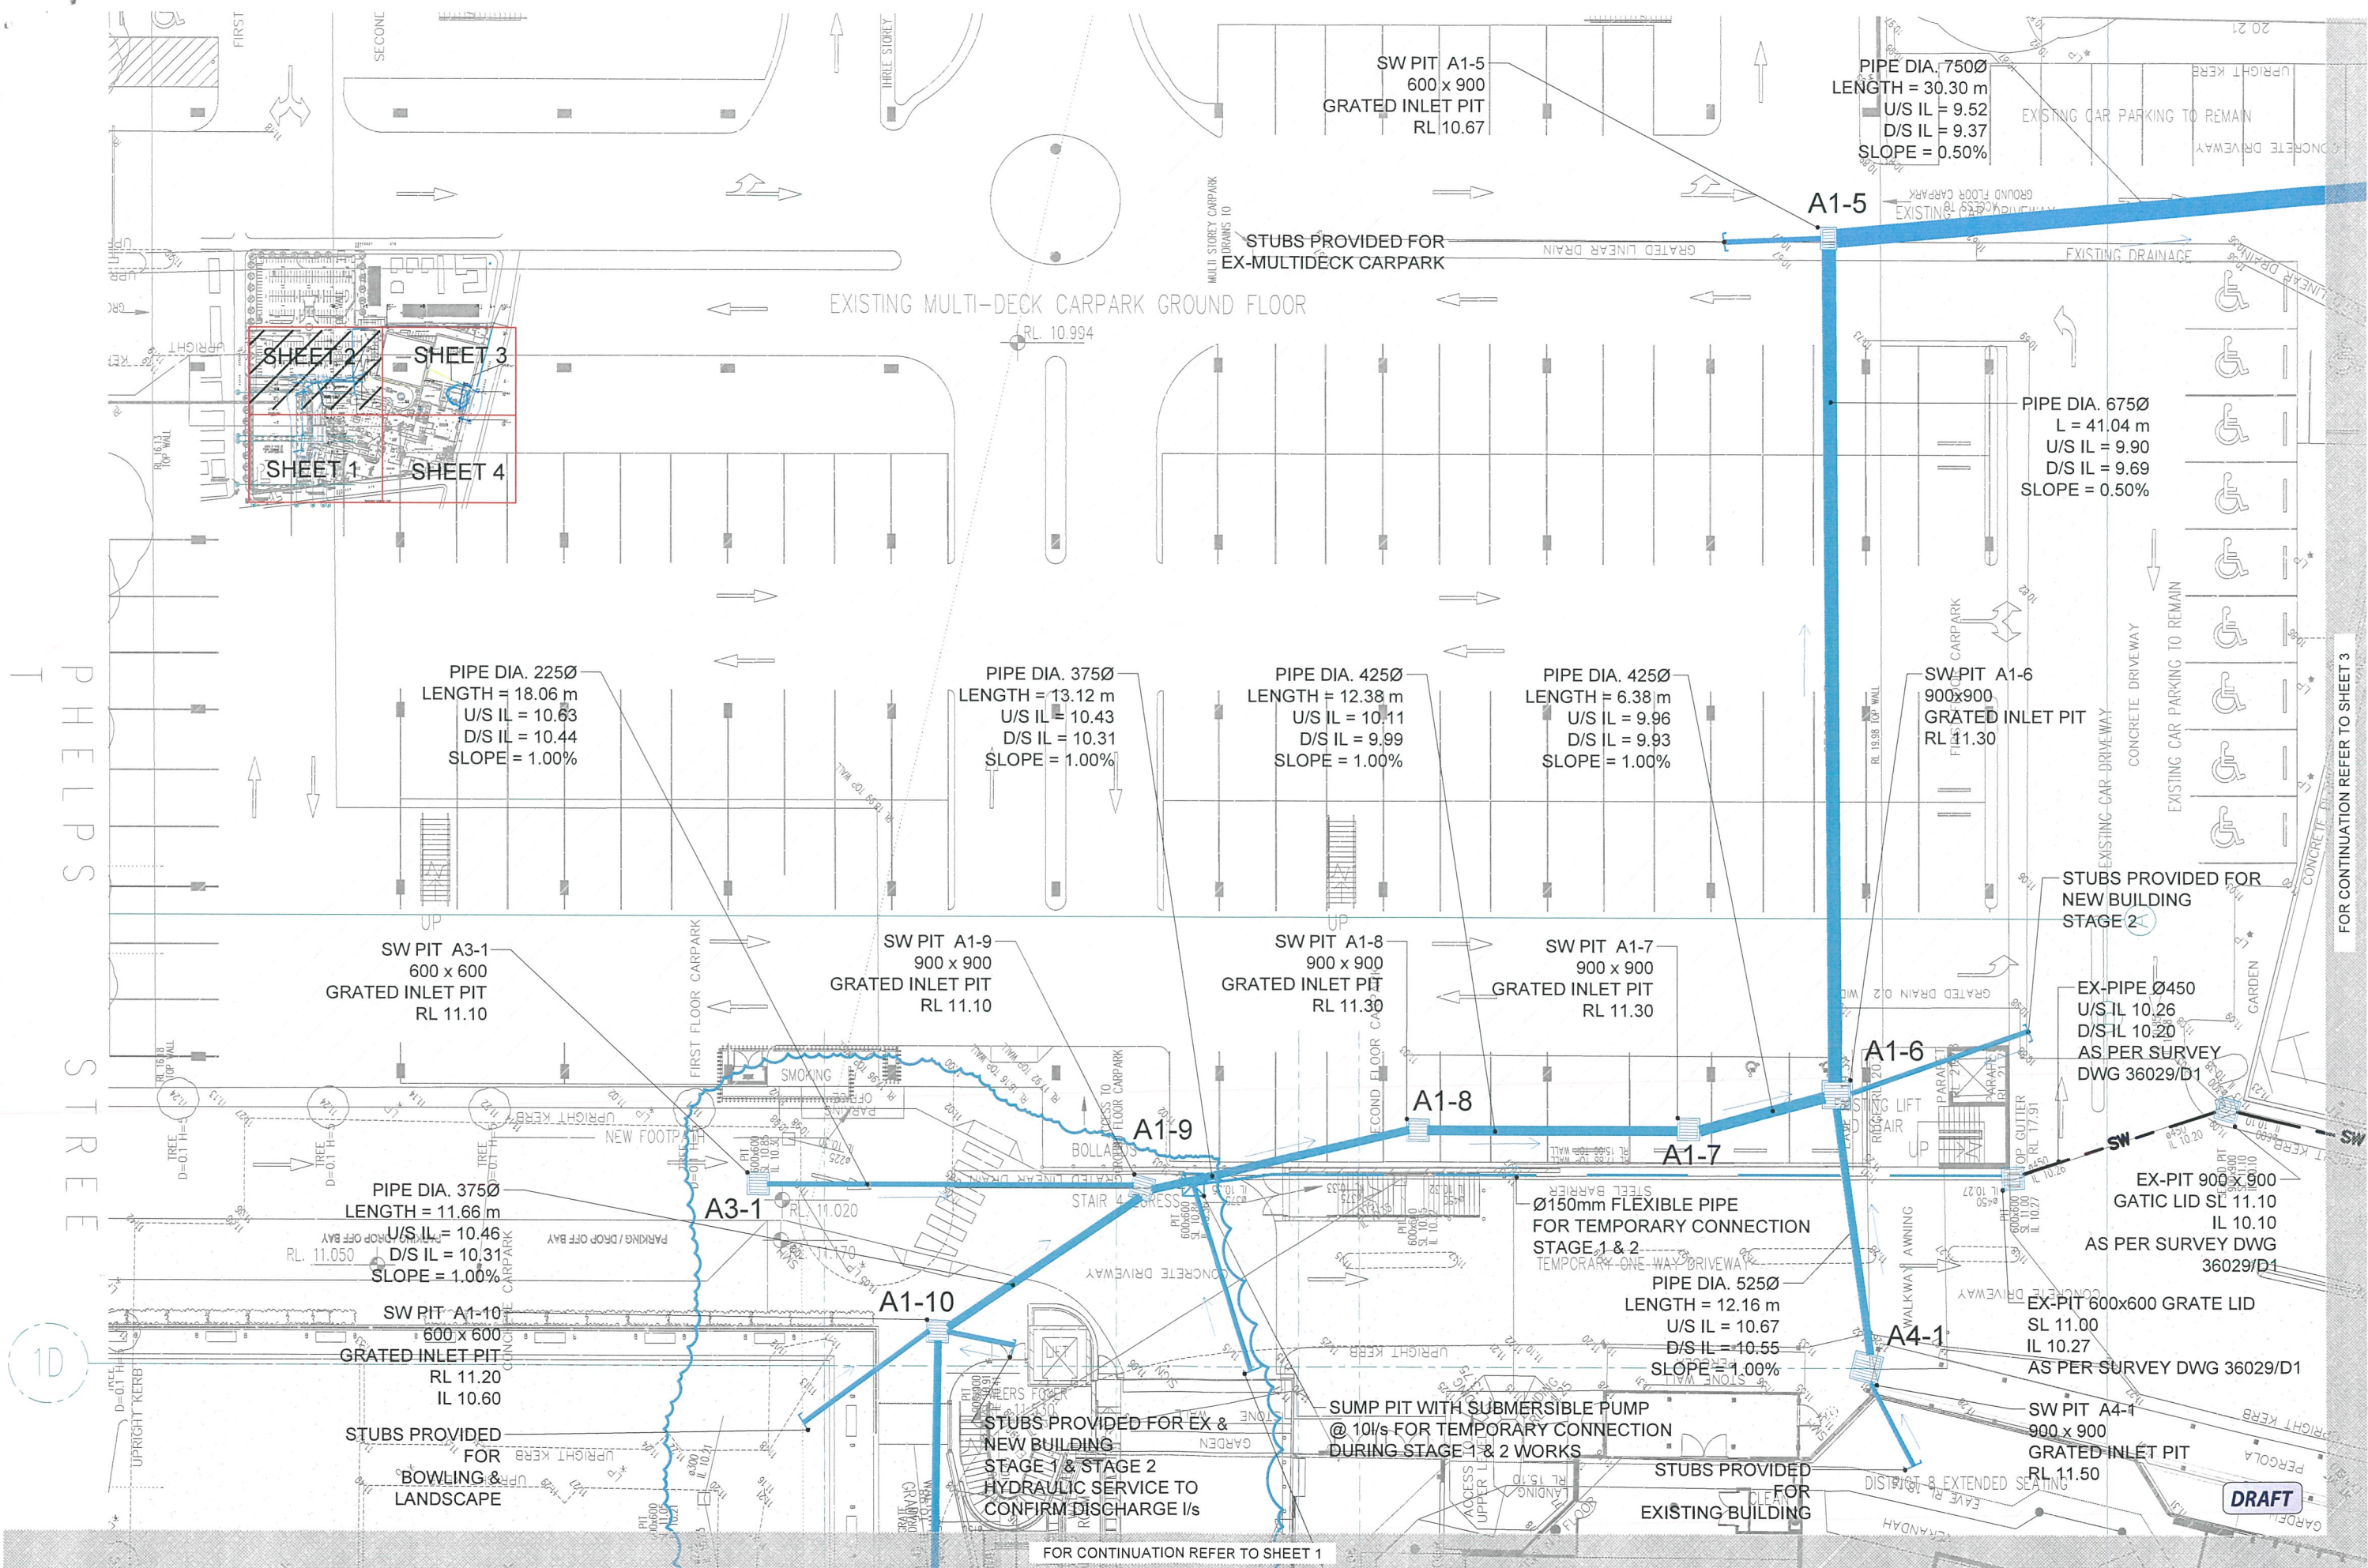

FOR CONTINUATION REFER TO SHEET 3

FOR CONTINUATION REFER TO SHEET 1

NEW BOWLING GREEN 1
UP. R.L. 11.800

PIPE DIA. 375Ø
LENGTH = 41.22 m
U/S IL = 10.88
D/S IL = 10.46
SLOPE = 1.00%

51
3.294 ha

DP 1120245

A1-11

SW PIT A1-11
900 x 900
GRADED INLET PIT
RL 12.45

SCOPE OF WORK BY
GREEN CONSTRUCTOR
AS SHOWN IN HATCH

NEW BOWLING GREEN

PROPOSED SW.
CONSTRUCTION
STAGE 1

SHEET 2
SHEET 3
SHEET 1
SHEET 4

STUBS PROVIDED FOR EX & NEW BUILDING
STAGE 1 & STAGE 2
HYDRAULIC SERVICE TO CONFIRM
DISCHARGE I/S

STUBS PROVIDED FOR EX & NEW BUILDING
STAGE 1 & STAGE 2
HYDRAULIC SERVICE TO CONFIRM
DISCHARGE I/S

FOR CONTINUATION REFER TO SHEET 4

DRAFT

