
HERMITAGE HEALTHCARE LOT 833 & 832, CNR HERMITAGE WAY **& GREGORY HILLS DRIVE GLEDSWOOD HILL SECTION 4.55 APPLICATION**

NO.	<u>REV</u>	DRAWING TITLE
00	B	COVER SHEET
01	Ă	PERSPECTIVE 1
02	А	PERPSECTIVE 2
03	A	PERSPECTIVE 3
00	(B)	GROUND LEVEL FLOOR F
01	А	LEVEL 1 FLOOR PLAN
02	А	LEVEL 2 FLOOR PLAN
03	A	LEVEL 3 FLOOR PLAN
04	₹ ₿}	ROOF PLAN
05	A	BASEMENT FLOOR PLAN
00	А	SITE SECTIONS
00	A	SITE ELEVATIONS
01	A	BUILDING A ELEVATIONS
02	A	BUILDING A ELEVATIONS
03	A	BUILDING B ELEVATIONS
04	A	BUILDING B ELEVATIONS
00	B	SHADOW DIAGRAMS
00	А	GFA CALCULATION

DRAWING NO.
S4.55-D0000
S4.55-D0001
S4.55-D0002
S4.55-D0003
S4.55-D1000
S4.55-D1001
S4.55-D1002
S4.55-D1003
S4.55-D1004
S4.55-D1005
S4.55-D2000
S4.55-D3000
S4.55-D3001
S4.55-D3002
S4.55-D3003
S4.55-D3004
S4.55-D7000
S4.55-D8000

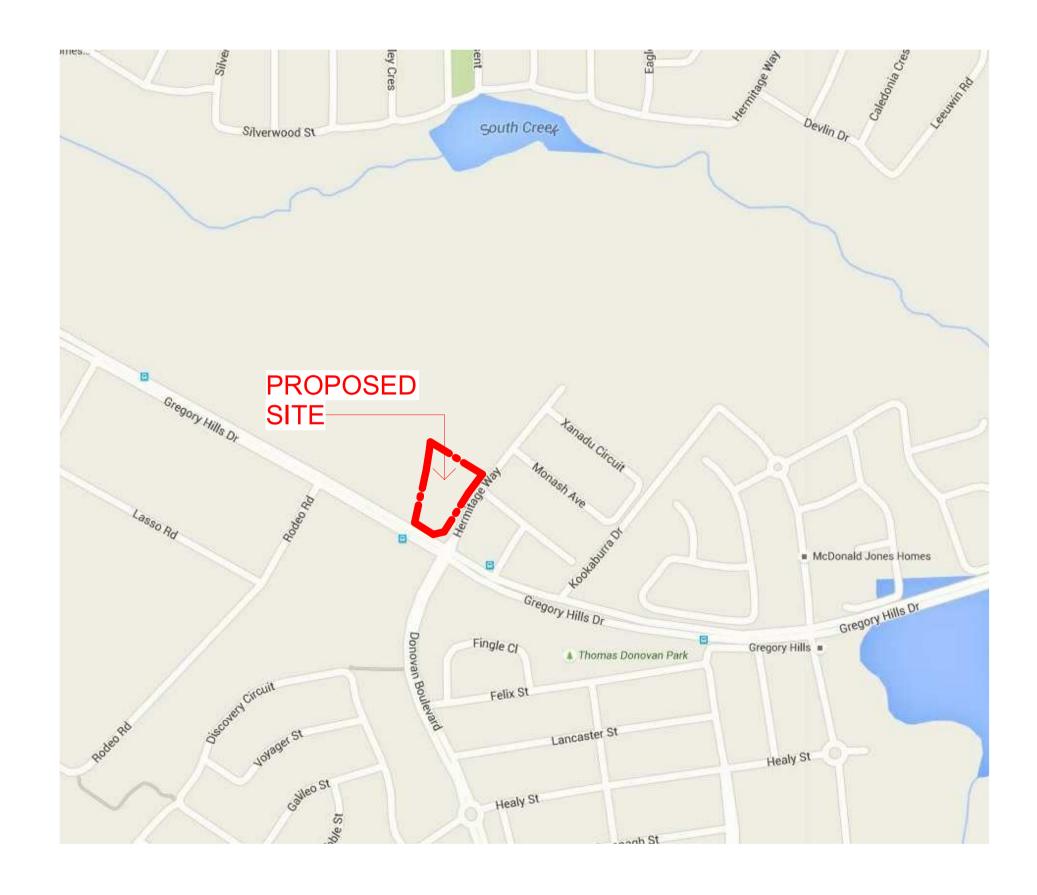

PLAN

IS SE AND SW S NW AND NE S SW AND SE S NE AND NW

NOTE All dimensions to be verified prior to commencement of any shop drawings or fabrication. shop drawings are to be approved before construction. all dimensions are in nillimeters unless otherwise noted. Annotated dimens are to be used in preference to scaling from drawings

This drawing is the property of ANTHONY VAVAYIS ASSOCIATES PTY LTD and any reproduction or distribution without prior consent constitutes a l

LEGEND

 B
 01.05.2019
 Section 4.55 Application - response

 A
 23.01.2019
 Section 4.55 Application

rev date REVISION

ARCHITECTS

PROJECT TITLE

DRAWING TITLE COVER SHEET

SCALE @ A1 1 : 1

DRAWN BYAuthor

CLIENT

HERMITAGE HEALTHCARE Lot 832 & 833, Cnr Hermitage Way & Gregory Hills Drive, Gledswood Hill

Hermitage Healthcare Pty Ltd

amendme

DESIGNERS PLANNERS 24 LIME STREET KING STREET WHARF

E: admin@avaarchitects.com.au T: 02 9290 1810 F: 02 9290 1860 W: www.avaarchitects.com.au P: 20/26A LIME STREET KING STREET WHARF

ANTHONY VAVAYIS & ASSOCIATES PTY. LTD.

DATE MARCH 2017

PROJECT 14018

S4.55-D0000^B

NOMINATED ARCHITECT - ANTHONY VAVAYIS NO.5243

SYDNEY NSW 2000

SYDNEY NSW 2000

ACN 069 737 935

ANTHONY VAVAYIS +ASSOCIATES

55 4 ZO -----S





CNR GREGORY HILLS DRIVE & HERMITAGE WAY

NOTE All dimensions to be verified prior to commencement of any shop drawings or fabrication. shop drawings are to be approved before construction. all dimensions are in millimeters unless otherwise noted. Annotated dimensions are to be used in preference to scaling from drawings. This drawing is the property of ANTHONY VAVAYIS + ASSOCIATES PTY LTD and any reproduction or distribution without prior consent constitutes a breach of copyright.

LEGEND



ANTHONY VAVAYIS +ASSOCIATES Architects designers planners 24 LIME STREET KING STREET WHARF SYDNEY NSW 2000 E: admin@avaarchitects.com.au T: 02 9290 1810 F: 02 9290 1860 W: www.avaarchitects.com.au

P: 20/26A LIME STREET KING STREET WHARF SYDNEY NSW 2000 ANTHONY VAVAYIS & ASSOCIATES PTY. LTD. ACN 069 737 935 NOMINATED ARCHITECT - ANTHONY VAVAYIS NO.5243

PROJECT TITLE HERMITAGE HEALTHCARE Lot 832 & 833, Cnr Hermitage Way & Gregory Hills Drive, Gledswood Hill

CLIENT Hermitage Healthcare Pty Ltd

DRAWING TITLE PERSPECTIVE 1

SCALE @ A1 DRAWN BYAuthor

DATE MARCH 2017 PROJECT 14018

S4.55-D0001



55 4 NO S



VIEW LOOKING EAST FROM GREGORY HILLS DRIVE ACROSS THE RIPARIAN ZONE

NOTE All dimensions to be verified prior to commencement of any shop drawings or fabrication. shop drawings are to be approved before construction. all dimensions are in millimeters unless otherwise noted. Annotated dimensions are to be used in preference to scaling from drawings. This drawing is the property of ANTHONY VAVAYIS + ASSOCIATES PTY LTD and any reproduction or distribution without prior consent constitutes a breach of copyright.

LEGEND

A 23.01.2019 Section 4.55 Application rev date REVISION

24 LIME STREET KING STREET WHARF SYDNEY NSW 2000 E: admin@avaarchitects.com.au T: 02 9290 1810 F: 02 9290 1860 W: www.avaarchitects.com.au P: 20/26A LIME STREET KING STREET WHARF SYDNEY NSW 2000 ANTHONY VAVAYIS & ASSOCIATES PTY. LTD. ACN 069 737 935 NOMINATED ARCHITECT - ANTHONY VAVAYIS NO.5243 PROJECT TITLE HERMITAGE HEALTHCARE

ANTHONY VAVAYIS +ASSOCIATES Architects designers planners

Lot 832 & 833, Cnr Hermitage Way & Gregory Hills Drive, Gledswood Hill

CLIENT Hermitage Healthcare Pty Ltd

DRAWING TITLE PERPSECTIVE 2

SCALE @ A1 DRAWN BYAuthor DATE MARCH 2017 PROJECT 14018

S4.55-D0002 ^A

55 4 Z S





WESTERN VIEW ON HERMITAGE WAY

NOTE All dimensions to be verified prior to commencement of any shop drawings or fabrication. shop drawings are to be approved before construction. all dimensions are in millimeters unless otherwise noted. Annotated dimensions are to be used in preference to scaling from drawings. This drawing is the property of ANTHONY VAVAYIS + ASSOCIATES PTY LTD and any reproduction or distribution without prior consent constitutes a breach of copyright.

LEGEND

A 23.01.2019 Section 4.55 Application rev date REVISION

ANTHONY VAVAYIS +ASSOCIATES Architects designers planners 24 LIME STREET KING STREET WHARF SYDNEY NSW 2000 E: admin@avaarchitects.com.au T: 02 9290 1810 F: 02 9290 1860 W: www.avaarchitects.com.au

amendme

P: 20/26A LIME STREET KING STREET WHARF SYDNEY NSW 2000 ANTHONY VAVAYIS & ASSOCIATES PTY. LTD. ACN 069 737 935 NOMINATED ARCHITECT - ANTHONY VAVAYIS NO.5243

PROJECT TITLE HERMITAGE HEALTHCARE Lot 832 & 833, Cnr Hermitage Way & Gregory Hills Drive, Gledswood Hill


CLIENT Hermitage Healthcare Pty Ltd

DRAWING TITLE PERSPECTIVE 3

SCALE @ A1 DRAWN BYAuthor

DATE MARCH 2017 PROJECT 14018

S4.55-D0003 ^A

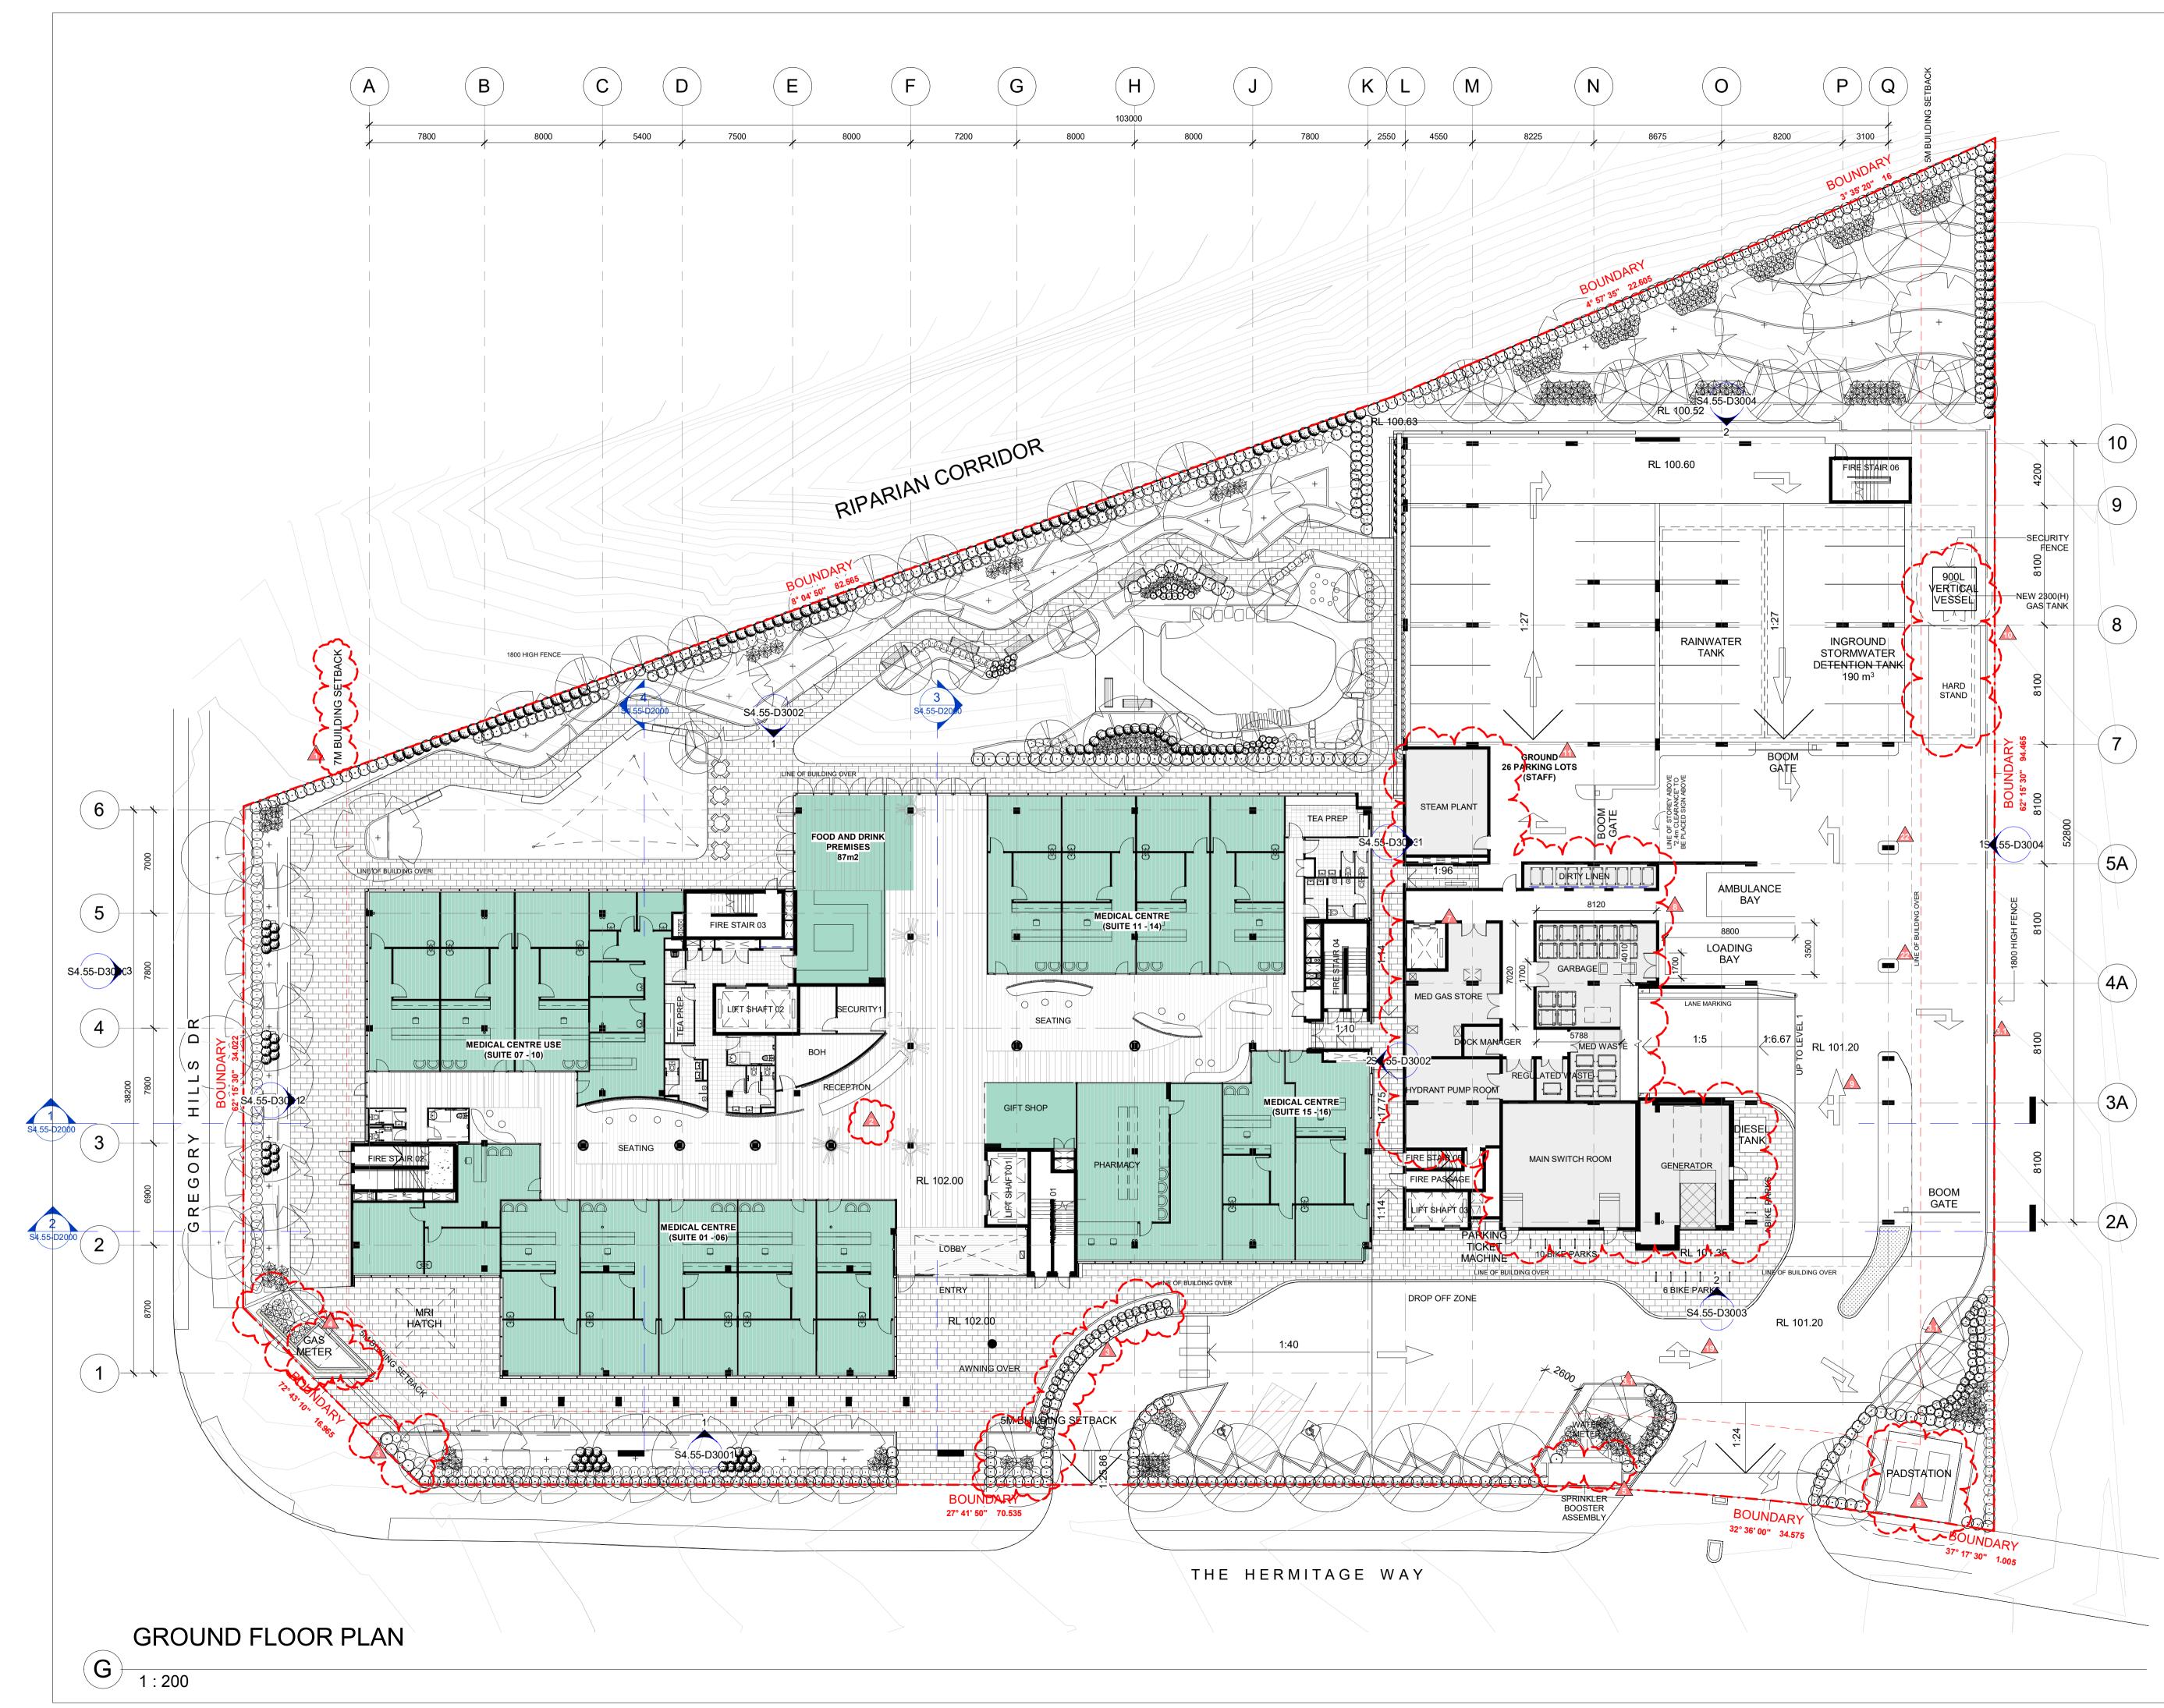

All dimensions to be verified prior to commencement of any shop drawings or fabrication. shop drawings are to be approved before construction. all dimensions are in millimeters unless otherwise noted. Annotated dimensions are to be used in preference to scaling from drawings. This drawing is the property of ANTHONY VAVAYIS + ASSOCIATES PTY LTD and any reproduction or distribution without prior consent constitutes a breach of copyright.

LEGEND

PARKING CALULCATION		
<u>BIKE PARKS:</u> STAFF VISITORS TOTAL	= 11 = 13 = 24	
CAR PARKS: GROUND (STAFF) (FRONT PARKING) LEVEL 01 LEVEL 02 LEVEL 03 TOTAL	= 26 = 7 = 58 = 59 = 63 = 213	

LEGEND - USE

MEDICAL - CENTRE USE	
HOSPITAL USE	
PLANT / STORE	

BED COUNTS

LEVEL 1 = 14 LEVEL 2 = 53 (INCL. 11 COTS) LEVEL 3 = 11 **TOTAL = 79**

ITEM	CHANGE DESCRIPTION
1	7m building setback is provided per Development Consent (3)j)
2	Update ground level Medical Centre fit-out layout
2.1	Hospital fit-out included
3	Additional Landscaping
3.1	Additional Landscaping per Development Consent No. 2.0(11)
4	New screening around Gas Meter at boundary with building signage intergrated
5	Adjust position of Sprinkler Booster
6	New padstation
7	New BOH lift
8	Update BOH layout
9	A through and left arrow is provided per Development Consent (3)c)
10	New vertical gas tank and security fencing
11	Update parking lot numbers
12	Change 2x 1-way to 1x 2-way driveway
13	Increase building area
14	New roof terrace pergola
15	Update plant layout and acoustic screen location on Car park Roof. Omit 1x approved Chiller and add new DAS room, Boiler + Hydronic Pump
16	Proposed mechanical duct and plant for staircase pressuriser
17	Increase building basement
18	New underground rainwater tank
19	Combined left and through arrow per Development Consent Condition No. (3)c)
21	Omit approved Level 3 roof mounted AC plant and screens
22	Additional columns
23	Proposed services linkbridge
24	Proposed roof air extract duct and fan
25	Increase building height
26	Change of use

 26
 Change or use

 27
 Amend glazing arrangement

 B
 01.05.2019
 Section 4.55 Application - response

 A
 23.01.2019
 Section 4.55 Application
 amendment date REVISION



ANTHONY VAVAYIS +ASSOCIATES Architects designers planners 24 LIME STREET KING STREET WHARF SYDNEY NSW 2000

E: admin@avaarchitects.com.au T: 02 9290 1810 F: 02 9290 1860 W: www.avaarchitects.com.au P: 20/26A LIME STREET KING STREET WHARF SYDNEY NSW 2000 ANTHONY VAVAYIS & ASSOCIATES PTY. LTD. ACN 069 737 935 NOMINATED ARCHITECT - ANTHONY VAVAYIS NO.5243

PROJECT TITLE HERMITAGE HEALTHCARE Lot 832 & 833, Cnr Hermitage Way & Gregory Hills Drive, Gledswood Hill


CLIENT Hermitage Healthcare Pty Ltd

DRAWING TITLE GROUND LEVEL FLOOR PLAN

SCALE @ A1 1:200 DRAWN BYDK

DATE MARCH 2017 PROJECT 14018

S4.55-D1000

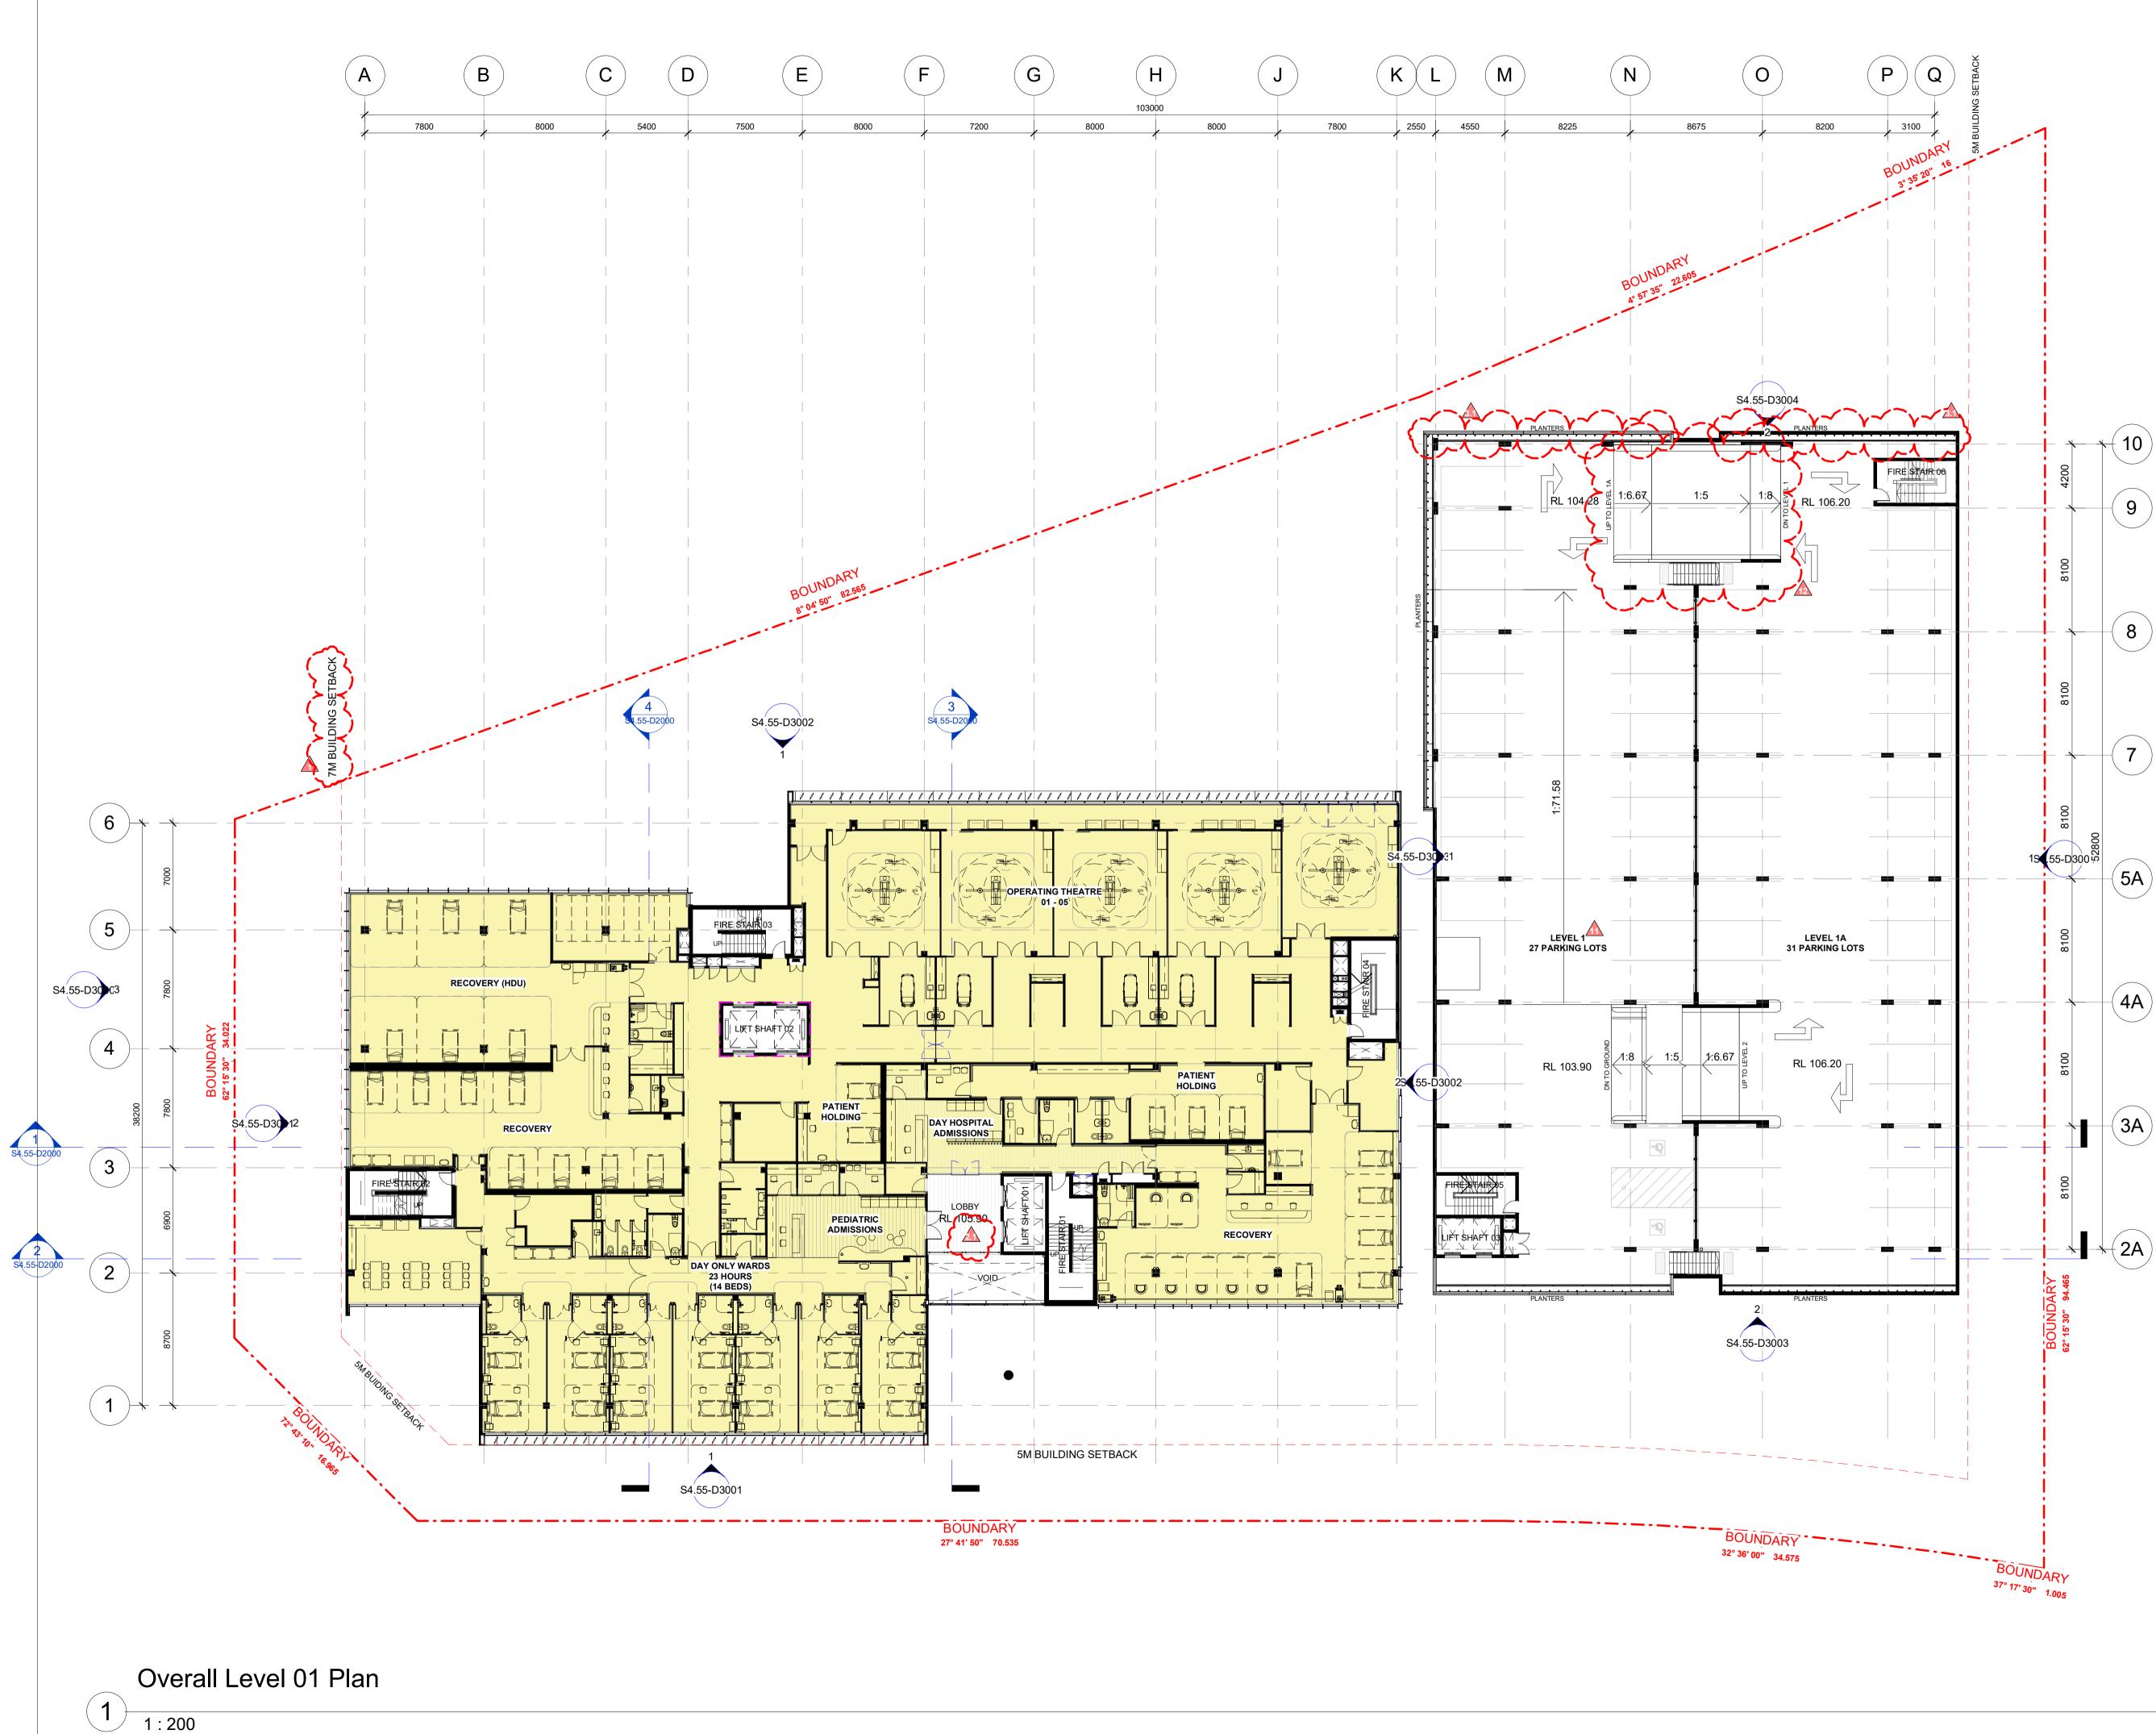

All dimensions to be verified prior to commencement of any shop drawings or fabrication. shop drawings are to be approved before construction. all dimensions are in millimeters unless otherwise noted. Annotated dimensions are to be used in preference to scaling from drawings. This drawing is the property of ANTHONY VAVAYIS + ASSOCIATES PTY LTD and any reproduction or distribution without prior consent constitutes a breach of copyright.

LEGEND

PARKING CALULCATION		
<u>BIKE PARKS:</u> STAFF VISITORS TOTAL	= 11 = 13 = 24	
CAR PARKS: GROUND (STAFF) (FRONT PARKING) LEVEL 01 LEVEL 02 LEVEL 03 TOTAL	= 26 = 7 = 58 = 59 = 63 = 213	

LEGEND - USE

MEDICAL - CENTRE USE
HOSPITAL USE
PLANT / STORE

BED COUNTS

LEVEL 1 = 14 LEVEL 2 = 53 (INCL. 11 COTS) LEVEL 3 = 11 **TOTAL = 79**

ITEM	CHANGE DESCRIPTION
1	7m building setback is provided per Development Consent (3)j)
2	Update ground level Medical Centre fit-out layout
2.1	Hospital fit-out included
3	Additional Landscaping
3.1	Additional Landscaping per Development Consent No. 2.0(11)
4	New screening around Gas Meter at boundary with building signage intergrated
5	Adjust position of Sprinkler Booster
6	New padstation
7	New BOH lift
8	Update BOH layout
9	A through and left arrow is provided per Development Consent (3)c)
10	New vertical gas tank and security fencing
11	Update parking lot numbers
12	Change 2x 1-way to 1x 2-way driveway
13	Increase building area
14	New roof terrace pergola
15	Update plant layout and acoustic screen location on Car park Roof. Omit 1x approved Chiller and add new DAS room, Boiler + Hydronic Pump
16	Proposed mechanical duct and plant for staircase pressuriser
17	Increase building basement
18	New underground rainwater tank
19	Combined left and through arrow per Development Consent Condition No. (3)c)
20	One left turn only lane to exit onto The Hermitage Way is provided per Development Consent (3)a)
21	Omit approved Level 3 roof mounted AC plant and screens
22	Additional columns
23	Proposed services linkbridge
24	Proposed roof air extract duct and fan
25	Increase building height
26	Change of use
27	Amend glazing arrangement

A 23.01.2019 Section 4.55 Application rev date REVISION

ANTHONY VAVAYIS +ASSOCIATES Architects designers planners 24 LIME STREET KING STREET WHARF SYDNEY NSW 2000 E: admin@avaarchitects.com.au T: 02 9290 1810 F: 02 9290 1860 W: www.avaarchitects.com.au

amendmen

P: 20/26A LIME STREET KING STREET WHARF SYDNEY NSW 2000 ANTHONY VAVAYIS & ASSOCIATES PTY. LTD. ACN 069 737 935 NOMINATED ARCHITECT - ANTHONY VAVAYIS NO.5243

PROJECT TITLE HERMITAGE HEALTHCARE Lot 832 & 833, Cnr Hermitage Way & Gregory Hills Drive, Gledswood Hill


CLIENT Hermitage Healthcare Pty Ltd

DRAWING TITLE LEVEL 1 FLOOR PLAN

SCALE @ A1 1:200 DRAWN BYDK

DATE MARCH 2017 PROJECT 14018

S4.55-D1001 ^A

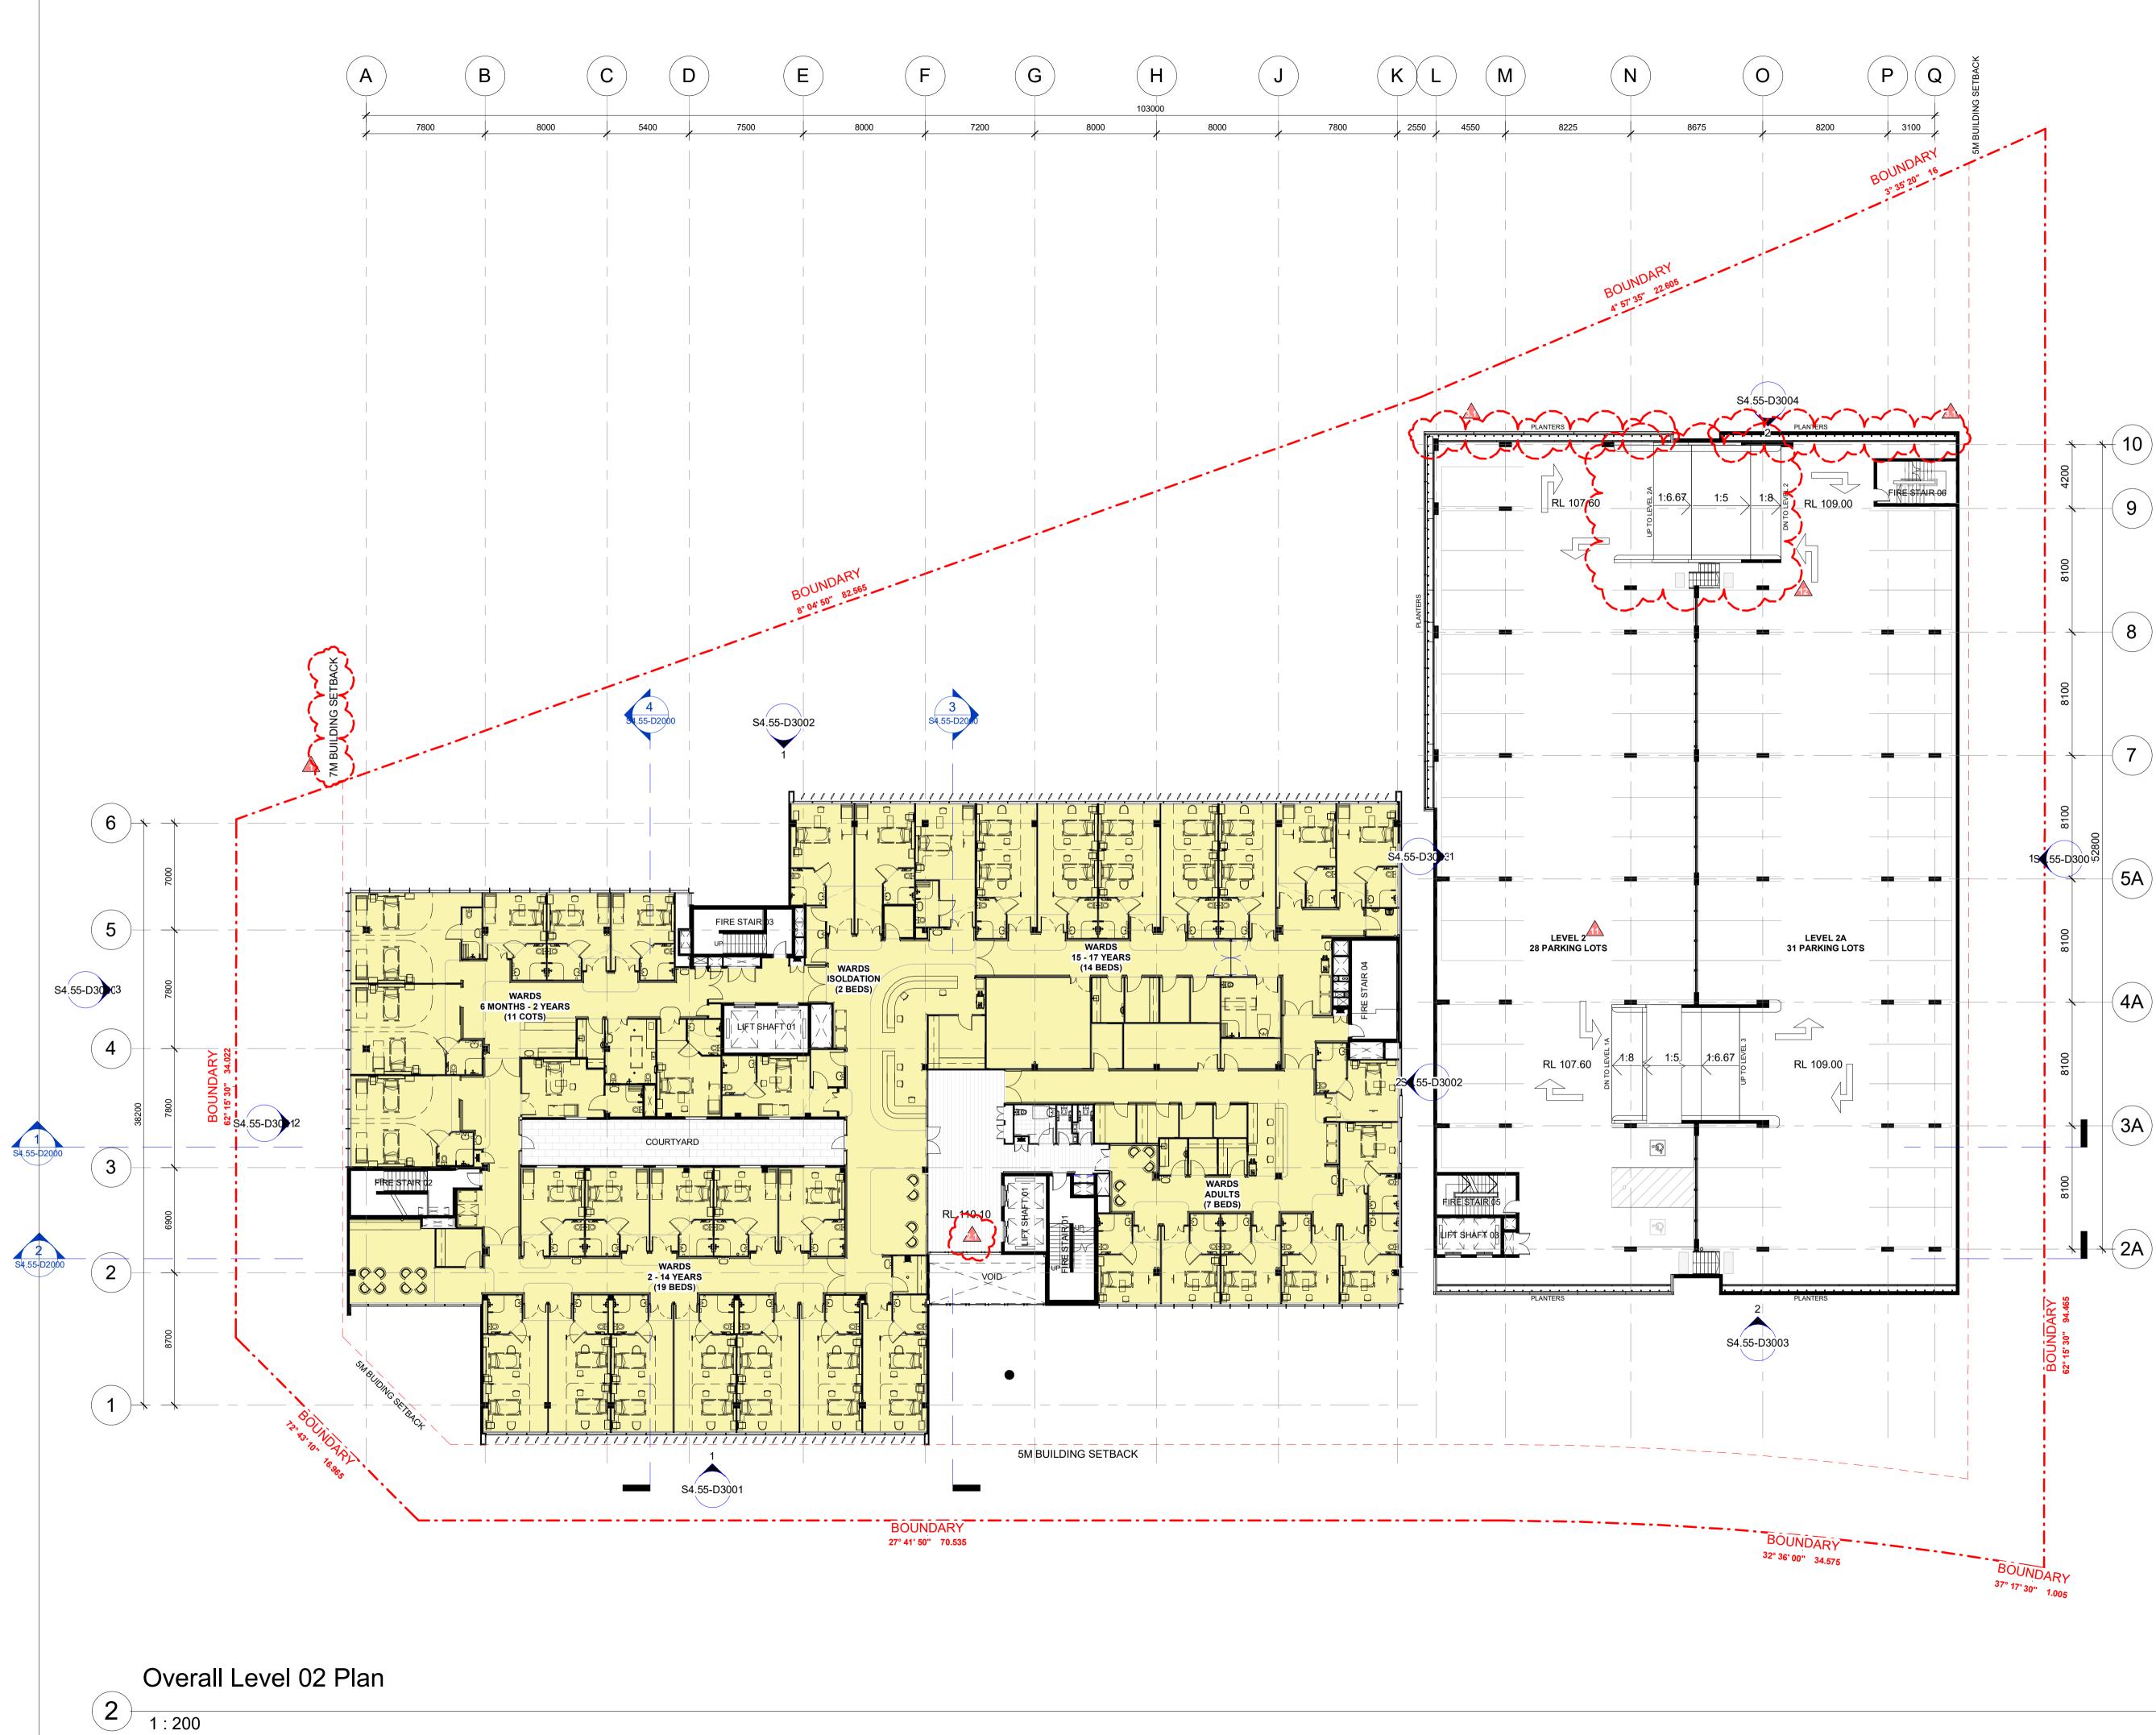

All dimensions to be verified prior to commencement of any shop drawings or fabrication. shop drawings are to be approved before construction. all dimensions are in millimeters unless otherwise noted. Annotated dimensions are to be used in preference to scaling from drawings. This drawing is the property of ANTHONY VAVAYIS + ASSOCIATES PTY LTD and any reproduction or distribution without prior consent constitutes a breach of copyright.

LEGEND

PARKING CALULCATION		
<u>BIKE PARKS:</u> STAFF VISITORS TOTAL	= 11 = 13 = 24	
CAR PARKS: GROUND (STAFF) (FRONT PARKING) LEVEL 01 LEVEL 02 LEVEL 03 TOTAL	= 26 = 7 = 58 = 59 = 63 = 213	

LEGEND - USE

MEDICAL - CENTRE USE
HOSPITAL USE
PLANT / STORE

BED COUNTS

LEVEL 1 = 14 LEVEL 2 = 53 (INCL. 11 COTS) LEVEL 3 = 11 **TOTAL = 79**

<u>ITEM</u>	CHANGE DESCRIPTION
1	7m building setback is provided per Development Consent (3)j)
2	Update ground level Medical Centre fit-out layout
2.1	Hospital fit-out included
3	Additional Landscaping
3.1	Additional Landscaping per Development Consent No. 2.0(11)
4	New screening around Gas Meter at boundary with building signage intergrated
5	Adjust position of Sprinkler Booster
6	New padstation
7	New BOH lift
8	Update BOH layout
9	A through and left arrow is provided per Development Consent (3)c)
10	New vertical gas tank and security fencing
11	Update parking lot numbers
12	Change 2x 1-way to 1x 2-way driveway
13	Increase building area
14	New roof terrace pergola
15	Update plant layout and acoustic screen location on Car park Roof. Omit 1x approved Chiller and add new DAS room, Boiler + Hydronic Pump
16	Proposed mechanical duct and plant for staircase pressuriser
17	Increase building basement
18	New underground rainwater tank
19	Combined left and through arrow per Development Consent Condition No. (3)c)
20	One left turn only lane to exit onto The Hermitage Way is provided per Development Consent (3)a)
21	Omit approved Level 3 roof mounted AC plant and screens
22	Additional columns
23	Proposed services linkbridge
24	Proposed roof air extract duct and fan
25	Increase building height
26	Change of use
27	Amend glazing arrangement

A 23.01.2019 Section 4.55 Application rev date REVISION

ANTHONY VAVAYIS +ASSOCIATES Architects designers planners

24 LIME STREET KING STREET WHARF SYDNEY NSW 2000 E: admin@avaarchitects.com.au T: 02 9290 1810 F: 02 9290 1860 W: www.avaarchitects.com.au

amendmen

P: 20/26A LIME STREET KING STREET WHARF SYDNEY NSW 2000 ANTHONY VAVAYIS & ASSOCIATES PTY. LTD. ACN 069 737 935 NOMINATED ARCHITECT - ANTHONY VAVAYIS NO.5243

PROJECT TITLE HERMITAGE HEALTHCARE Lot 832 & 833, Cnr Hermitage Way & Gregory Hills Drive, Gledswood Hill


CLIENT Hermitage Healthcare Pty Ltd

DRAWING TITLE LEVEL 2 FLOOR PLAN

SCALE @ A1 1:200 DRAWN BYDK

DATE MARCH 2017 PROJECT 14018

S4.55-D1002 ^A

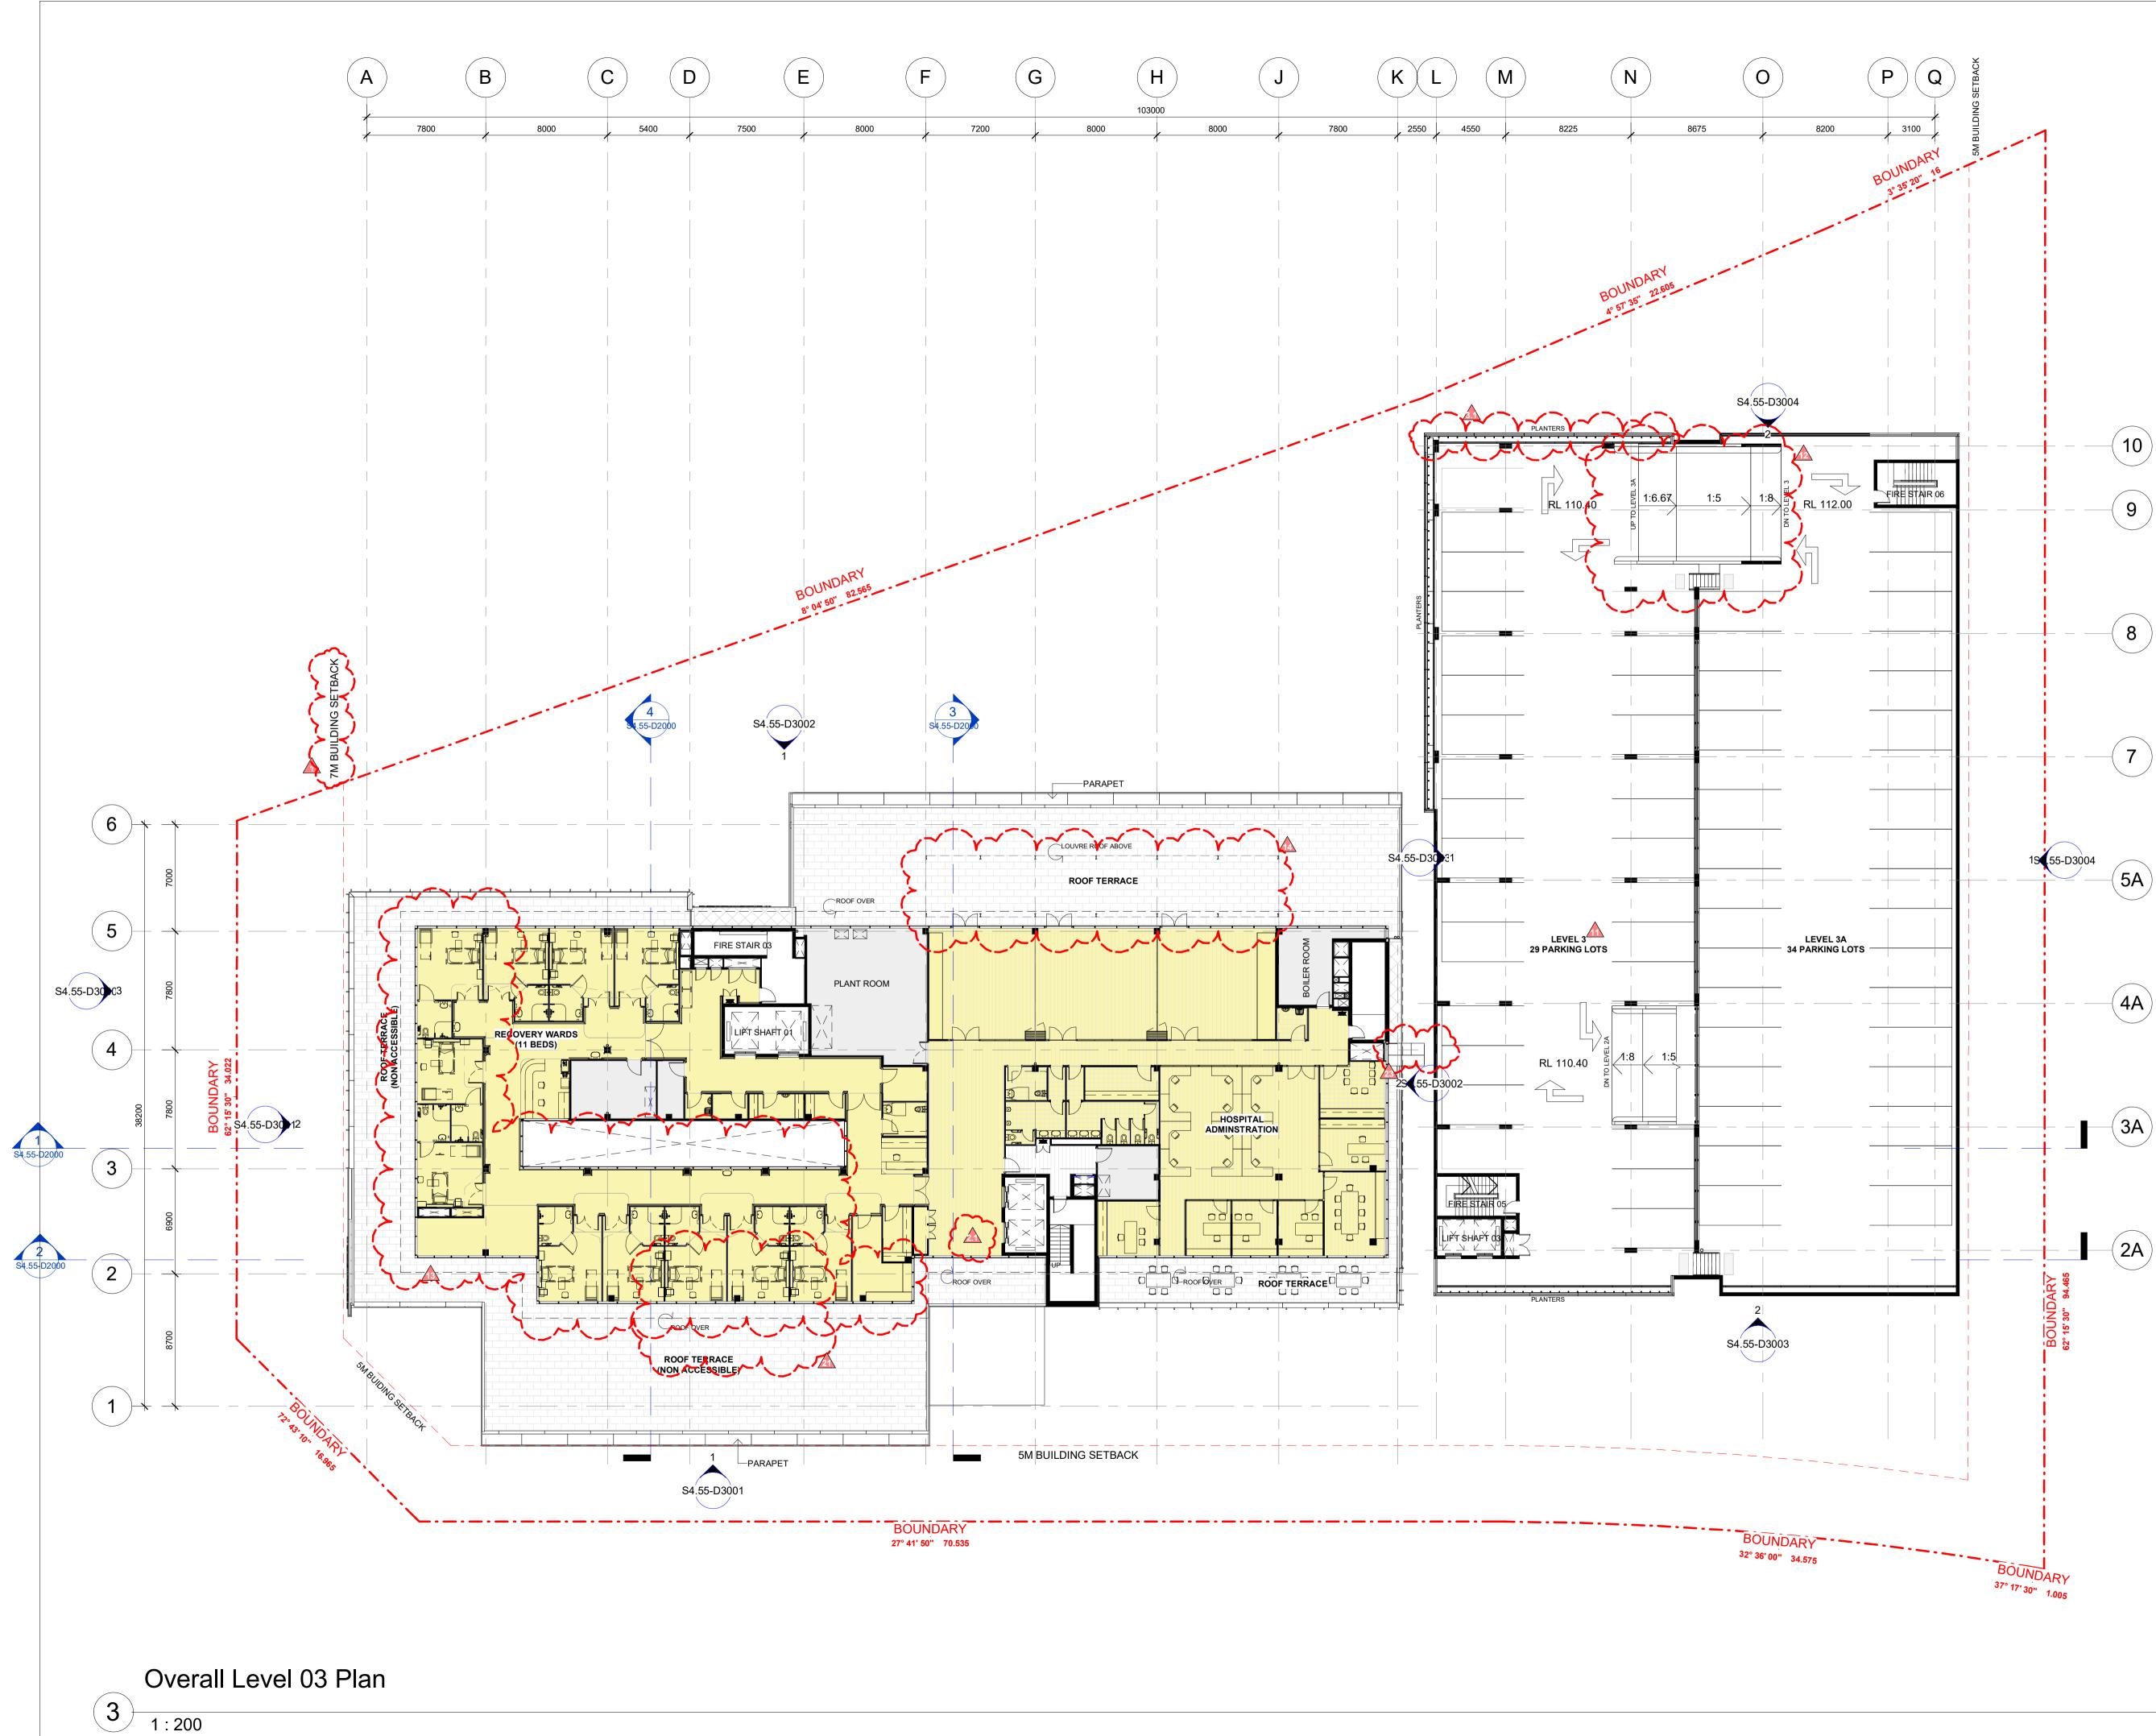

All dimensions to be verified prior to commencement of any shop drawings or fabrication. shop drawings are to be approved before construction. all dimensions are in millimeters unless otherwise noted. Annotated dimensions are to be used in preference to scaling from drawings. This drawing is the property of ANTHONY VAVAYIS + ASSOCIATES PTY LTD and any reproduction or distribution without prior consent constitutes a breach of copyright.

LEGEND

PARKING CALULC	ATION
<u>BIKE PARKS:</u> STAFF VISITORS TOTAL	= 11 = 13 = 24
<u>CAR PARKS:</u> GROUND (STAFF) (FRONT PARKING) LEVEL 01 LEVEL 02 LEVEL 03 TOTAL	= 26 = 7 = 58 = 59 = 63 = 213

LEGEND - USE

MEDICAL - CENTRE USE
HOSPITAL USE
PLANT / STORE

BED COUNTS

LEVEL 1 = 14 LEVEL 2 = 53 (INCL. 11 COTS) LEVEL 3 = 11 **TOTAL = 79**

<u>ITEM</u>	CHANGE DESCRIPTION
1	7m building setback is provided per Development Consent (3)j)
2	Update ground level Medical Centre fit-out layout
2.1	Hospital fit-out included
3	Additional Landscaping
3.1	Additional Landscaping per Development Consent No. 2.0(11)
4	New screening around Gas Meter at boundary with building signage intergrated
5	Adjust position of Sprinkler Booster
6	New padstation
7	New BOH lift
8	Update BOH layout
9	A through and left arrow is provided per Development Consent (3)c)
10	New vertical gas tank and security fencing
11	Update parking lot numbers
12	Change 2x 1-way to 1x 2-way driveway
13	Increase building area
14	New roof terrace pergola
15	Update plant layout and acoustic screen location on Car park Roof. Omit 1x approved Chiller and add new DAS room, Boiler + Hydronic Pump
16	Proposed mechanical duct and plant for staircase pressuriser
17	Increase building basement
18	New underground rainwater tank
19	Combined left and through arrow per Development Consent Condition No. (3)c)
20	One left turn only lane to exit onto The Hermitage Way is provided per Development Consent (3)a)
21	Omit approved Level 3 roof mounted AC plant and screens
22	Additional columns
23	Proposed services linkbridge
24	Proposed roof air extract duct and fan
25	Increase building height
26	Change of use
27	Amend glazing arrangement

A 23.01.2019 Section 4.55 Application rev date REVISION

ANTHONY VAVAYIS +ASSOCIATES Architects designers planners 24 LIME STREET KING STREET WHARF SYDNEY NSW 2000 E: admin@avaarchitects.com.au T: 02 9290 1810 F: 02 9290 1860 W: www.avaarchitects.com.au

P: 20/26A LIME STREET KING STREET WHARF SYDNEY NSW 2000 ANTHONY VAVAYIS & ASSOCIATES PTY. LTD. ACN 069 737 935 NOMINATED ARCHITECT - ANTHONY VAVAYIS NO.5243 PROJECT TITLE HERMITAGE HEALTHCARE

amendmen

Lot 832 & 833, Cnr Hermitage Way & Gregory Hills Drive, Gledswood Hill

CLIENT Hermitage Healthcare Pty Ltd


DRAWING TITLE LEVEL 3 FLOOR PLAN


SCALE @ A1 1:200 DRAWN BYDK

DATE MARCH 2017

S4.55-D1003 ^A

PROJECT 14018

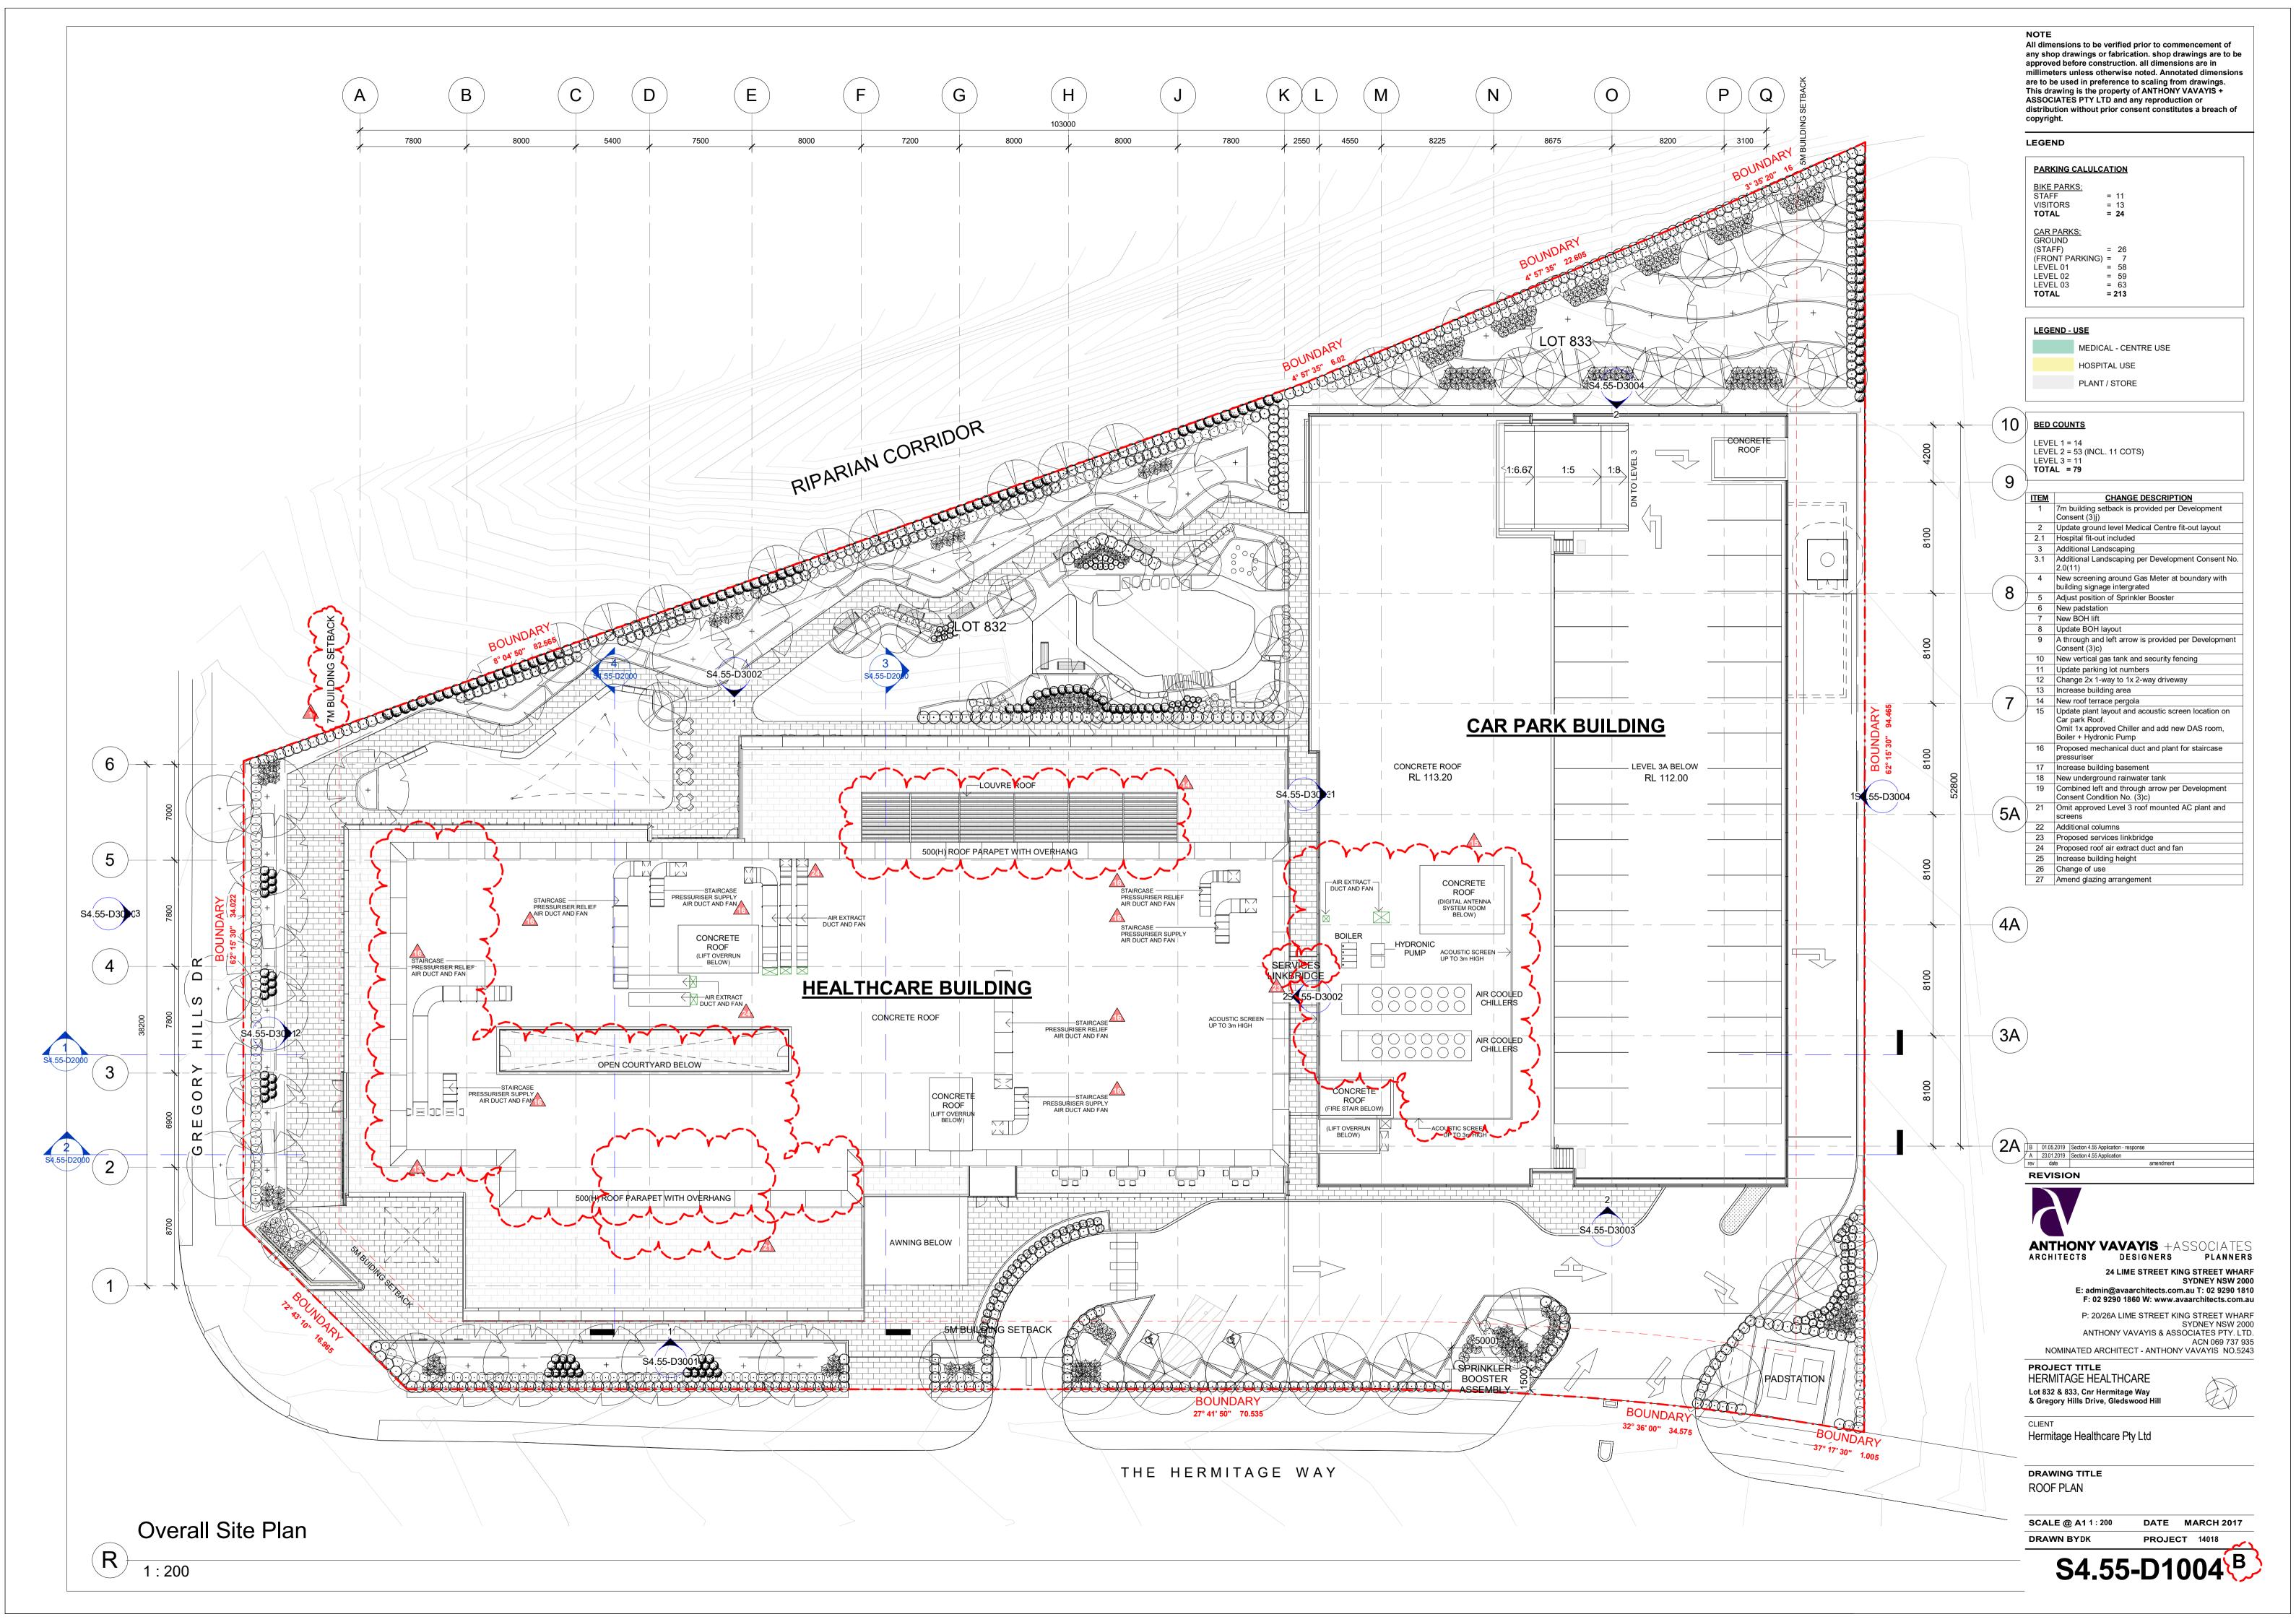

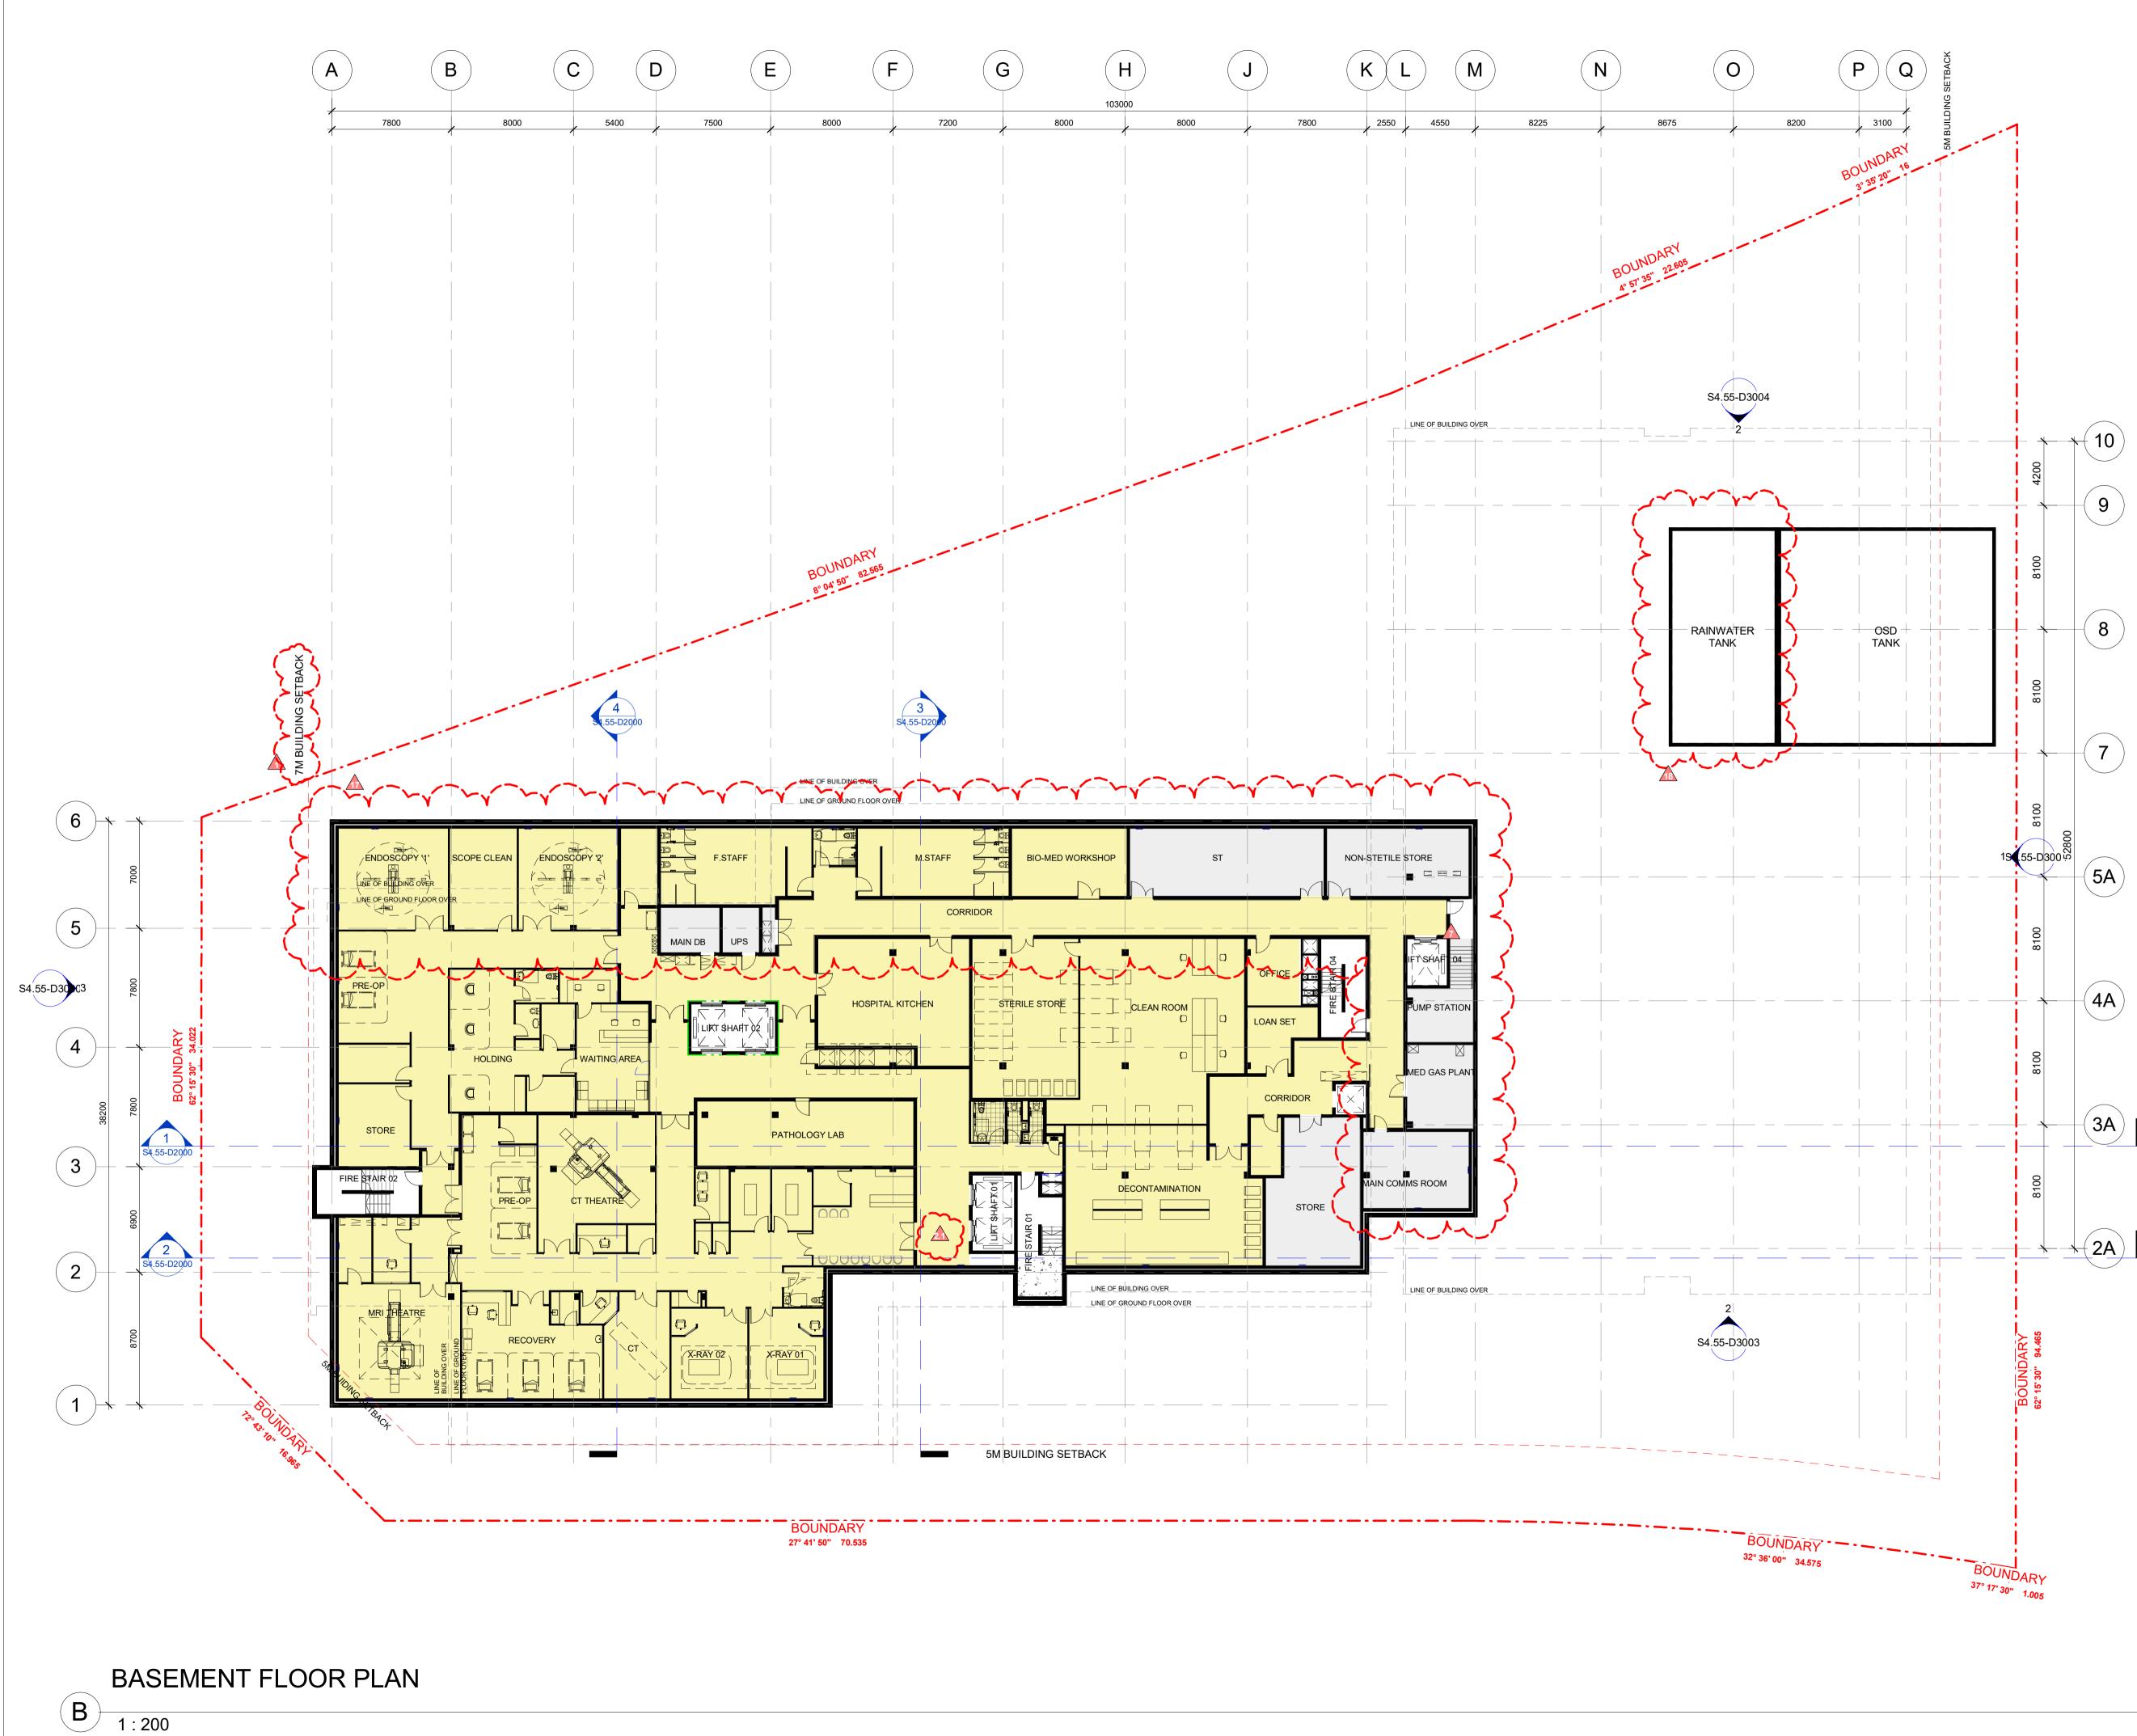

All dimensions to be verified prior to commencement of any shop drawings or fabrication. shop drawings are to be approved before construction. all dimensions are in millimeters unless otherwise noted. Annotated dimensions are to be used in preference to scaling from drawings. This drawing is the property of ANTHONY VAVAYIS + ASSOCIATES PTY LTD and any reproduction or distribution without prior consent constitutes a breach of copyright.

LEGEND

PARKING CALULC	ATION
<u>BIKE PARKS:</u> STAFF VISITORS TOTAL	= 11 = 13 = 24
CAR PARKS: GROUND (STAFF) (FRONT PARKING) LEVEL 01 LEVEL 02 LEVEL 03 TOTAL	= 26 = 7 = 58 = 59 = 63 = 213

LEGEND - USE

MEDICAL - CENTRE USE
HOSPITAL USE
PLANT / STORE

BED COUNTS

LEVEL 1 = 14 LEVEL 2 = 53 (INCL. 11 COTS) LEVEL 3 = 11 **TOTAL = 79**

ITEM	CHANGE DESCRIPTION
1	7m building setback is provided per Development Consent (3)j)
2	Update ground level Medical Centre fit-out layout
2.1	Hospital fit-out included
3	Additional Landscaping
3.1	Additional Landscaping per Development Consent No. 2.0(11)
4	New screening around Gas Meter at boundary with building signage intergrated
5	Adjust position of Sprinkler Booster
6	New padstation
7	New BOH lift
8	Update BOH layout
9	A through and left arrow is provided per Development Consent (3)c)
10	New vertical gas tank and security fencing
11	Update parking lot numbers
12	Change 2x 1-way to 1x 2-way driveway
13	Increase building area
14	New roof terrace pergola
15	Update plant layout and acoustic screen location on Car park Roof. Omit 1x approved Chiller and add new DAS room, Boiler + Hydronic Pump
16	Proposed mechanical duct and plant for staircase pressuriser
17	Increase building basement
18	New underground rainwater tank
19	Combined left and through arrow per Development Consent Condition No. (3)c)
20	One left turn only lane to exit onto The Hermitage Way is provided per Development Consent (3)a)
21	Omit approved Level 3 roof mounted AC plant and screens
22	Additional columns
23	Proposed services linkbridge
24	Proposed roof air extract duct and fan
25	Increase building height
26	Change of use
27	Amend glazing arrangement

A 23.01.2019 Section 4.55 Application rev date REVISION

ANTHONY VAVAYIS +ASSOCIATES Architects designers planners 24 LIME STREET KING STREET WHARF SYDNEY NSW 2000 E: admin@avaarchitects.com.au T: 02 9290 1810 F: 02 9290 1860 W: www.avaarchitects.com.au

amendment

P: 20/26A LIME STREET KING STREET WHARF SYDNEY NSW 2000 ANTHONY VAVAYIS & ASSOCIATES PTY. LTD. ACN 069 737 935 NOMINATED ARCHITECT - ANTHONY VAVAYIS NO.5243

PROJECT TITLE HERMITAGE HEALTHCARE Lot 832 & 833, Cnr Hermitage Way & Gregory Hills Drive, Gledswood Hill


CLIENT Hermitage Healthcare Pty Ltd


DRAWING TITLE BASEMENT FLOOR PLAN


SCALE @ A1 1:200 DRAWN BYDK

DATE MARCH 2017 PROJECT 14018

S4.55-D1005 ^A

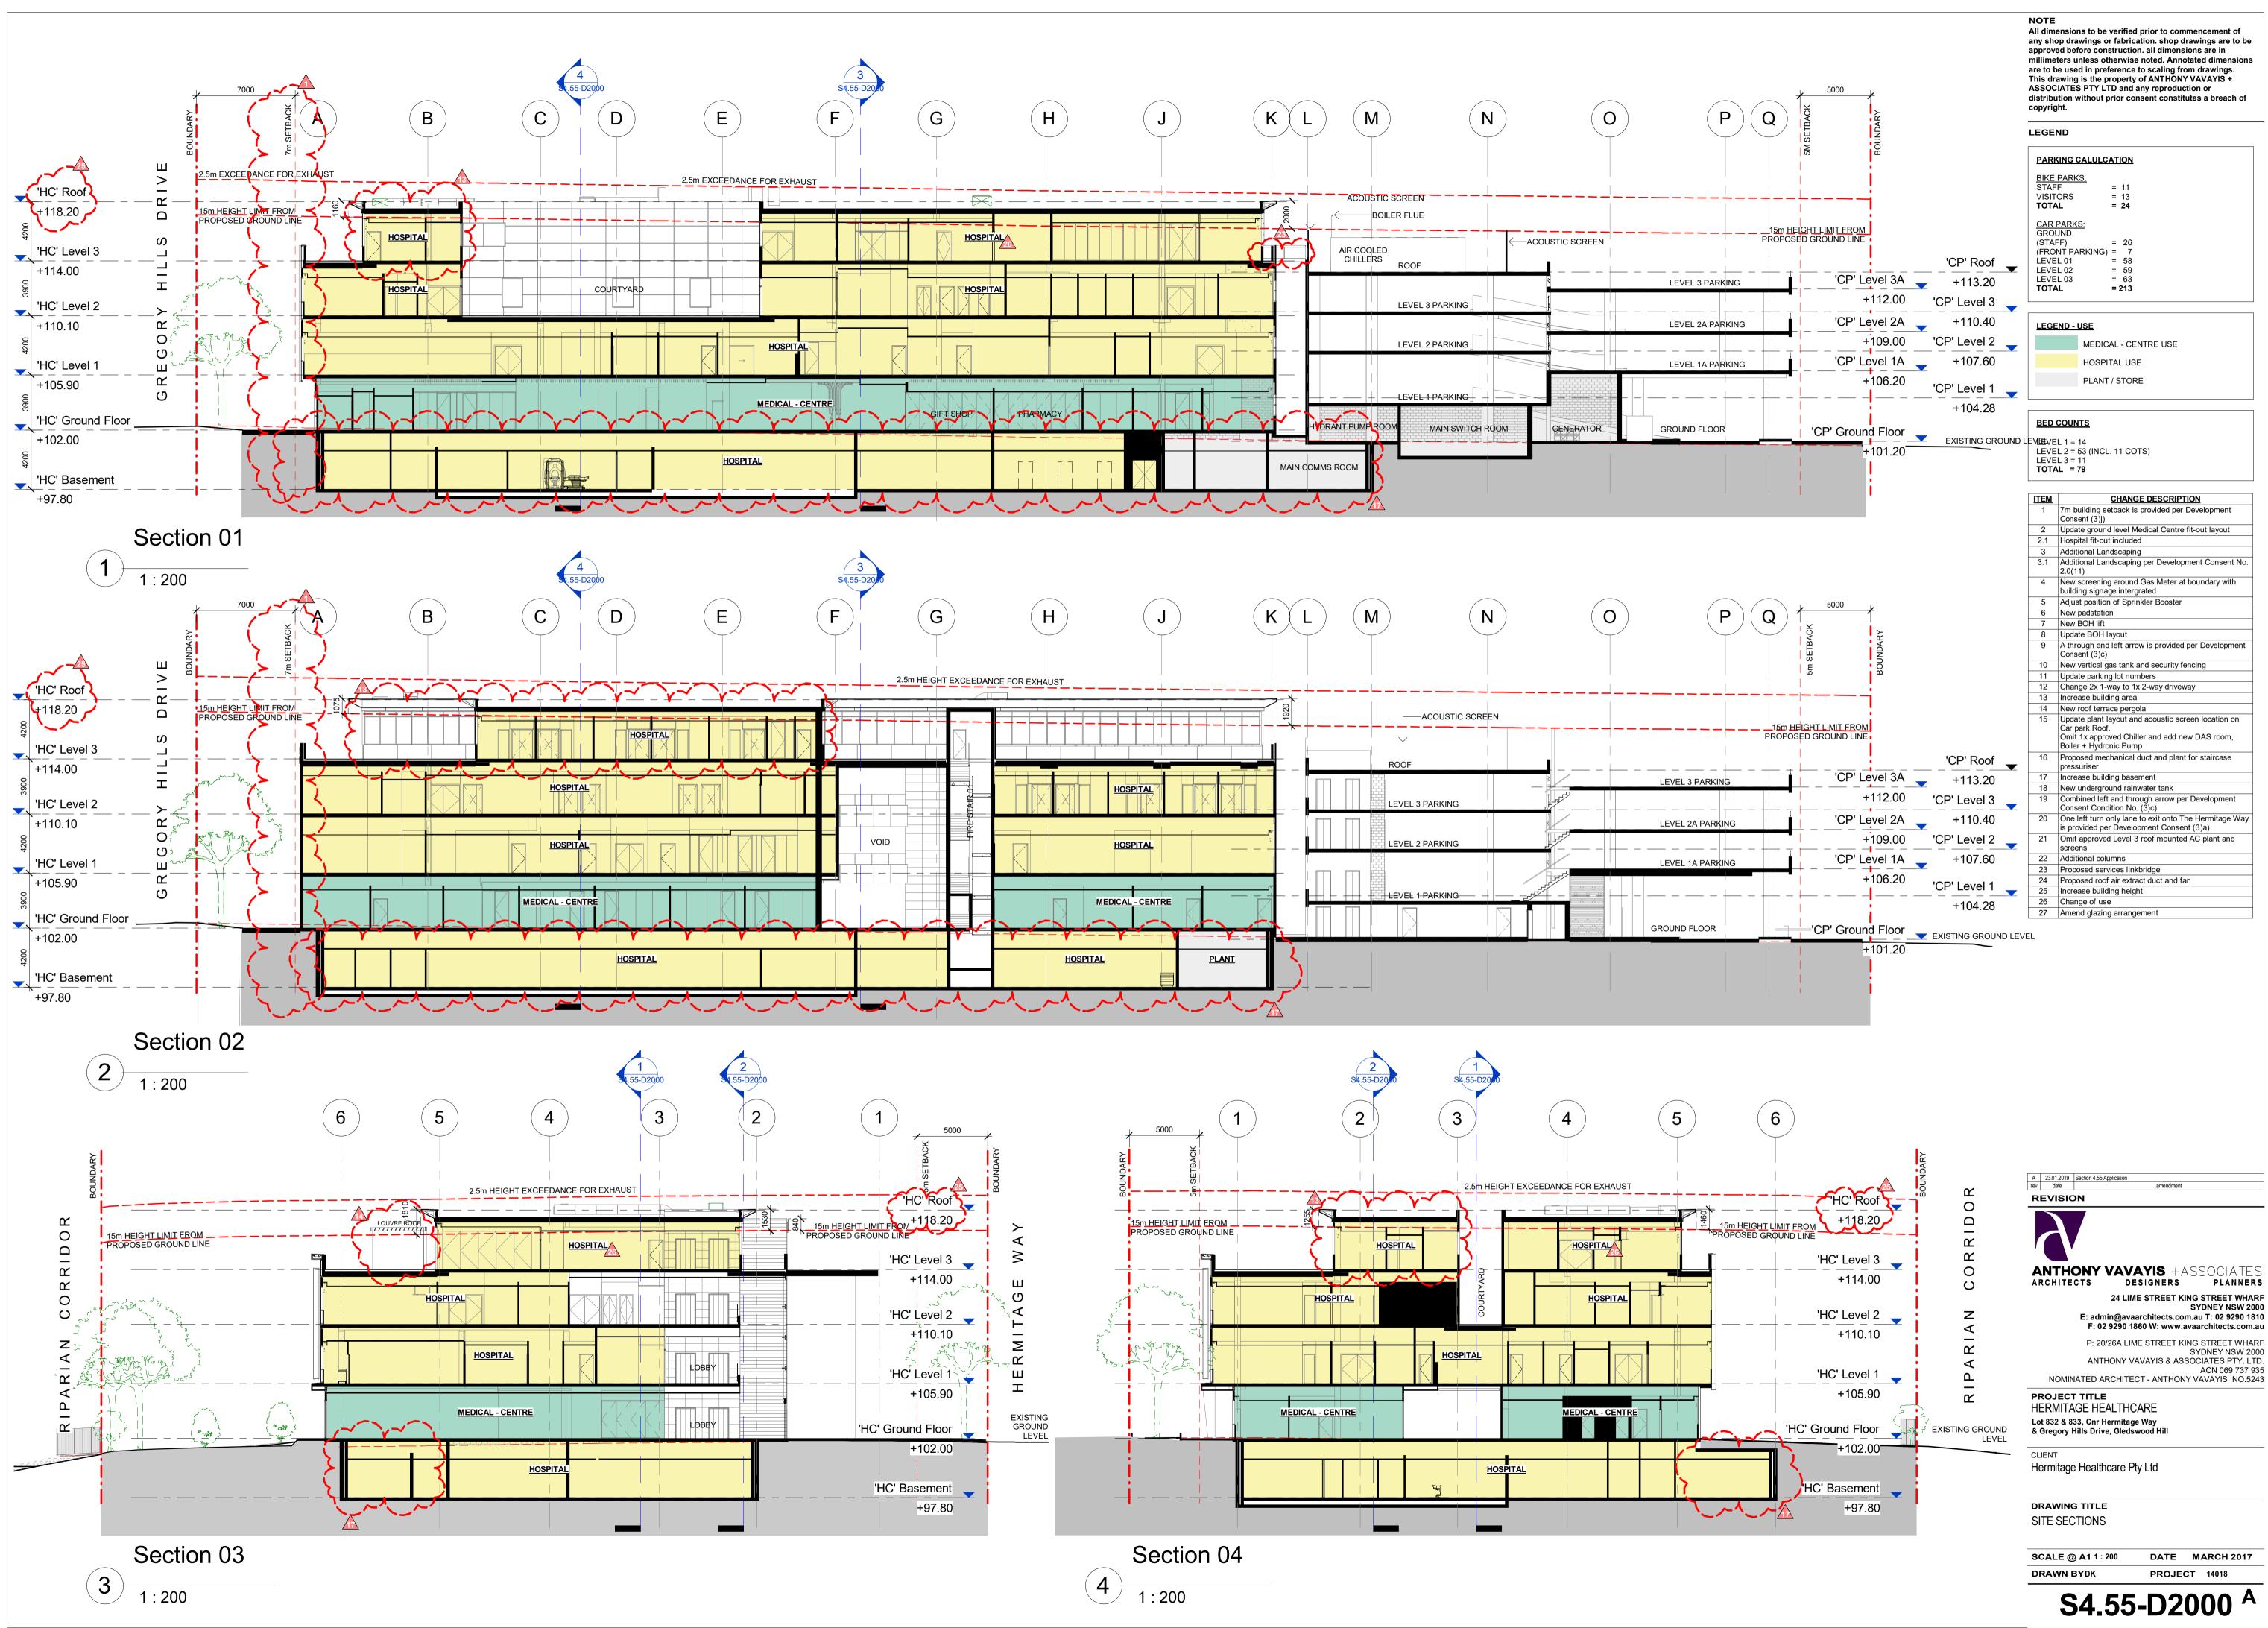

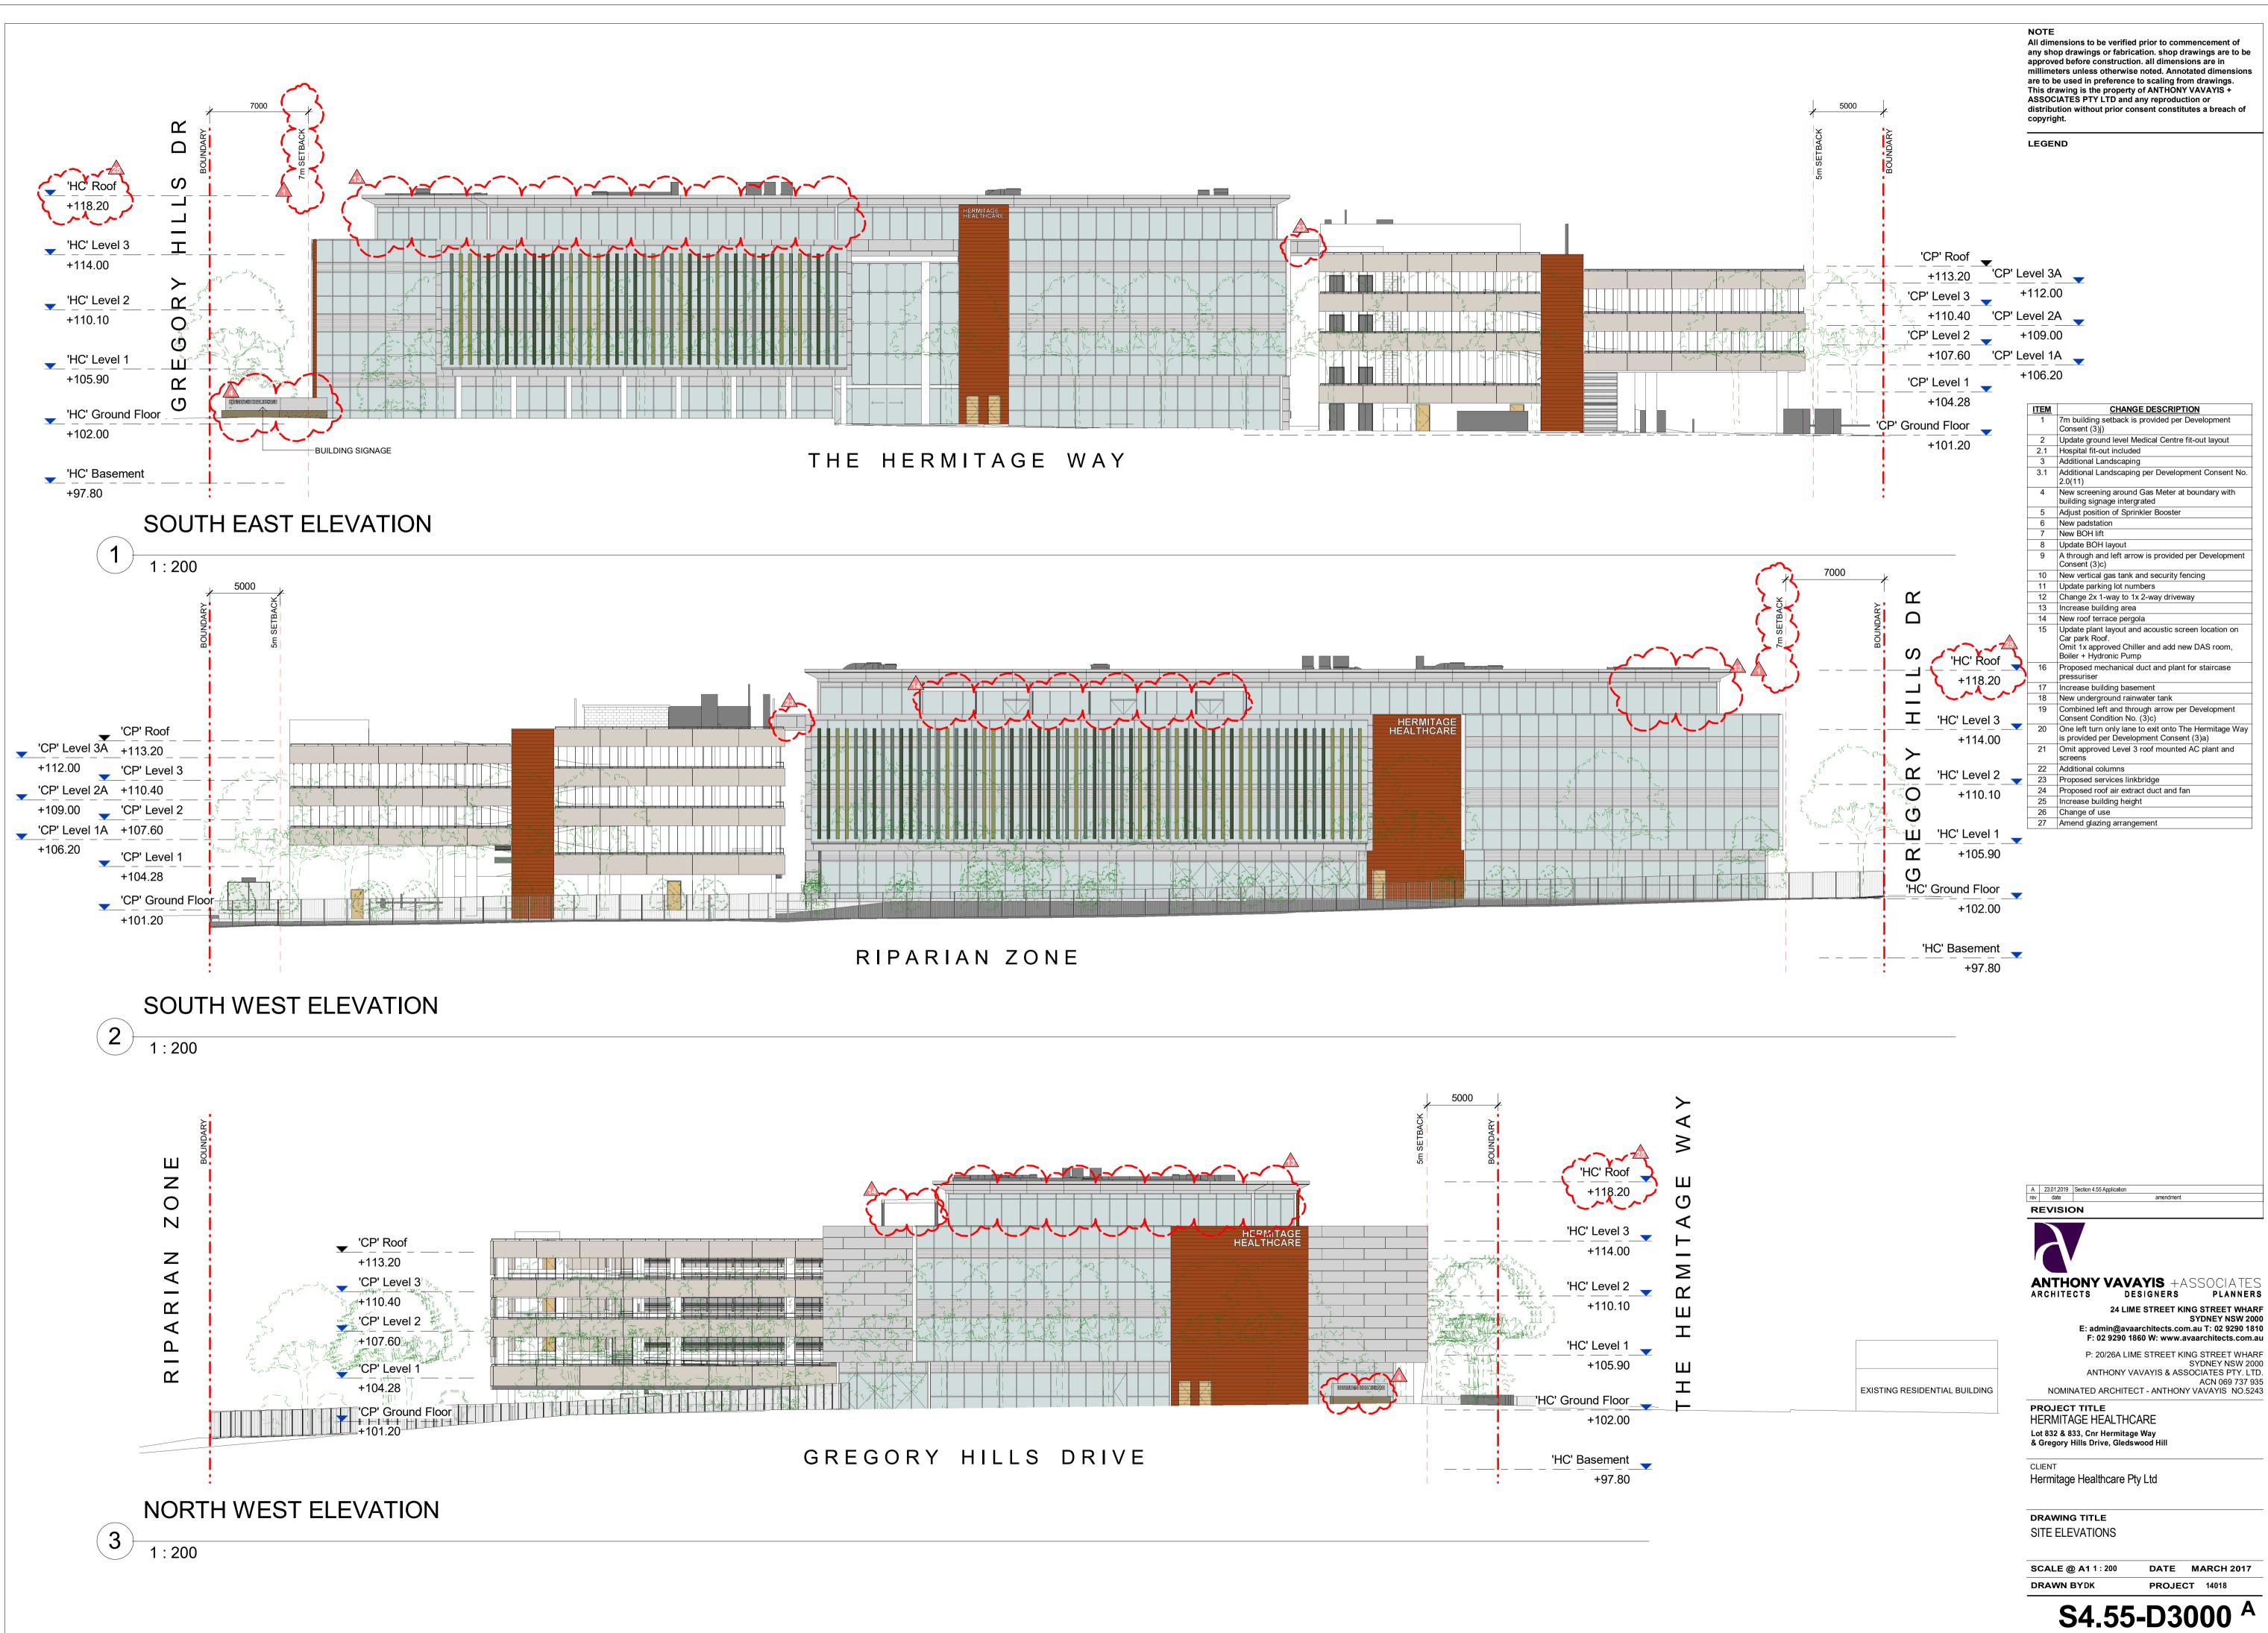

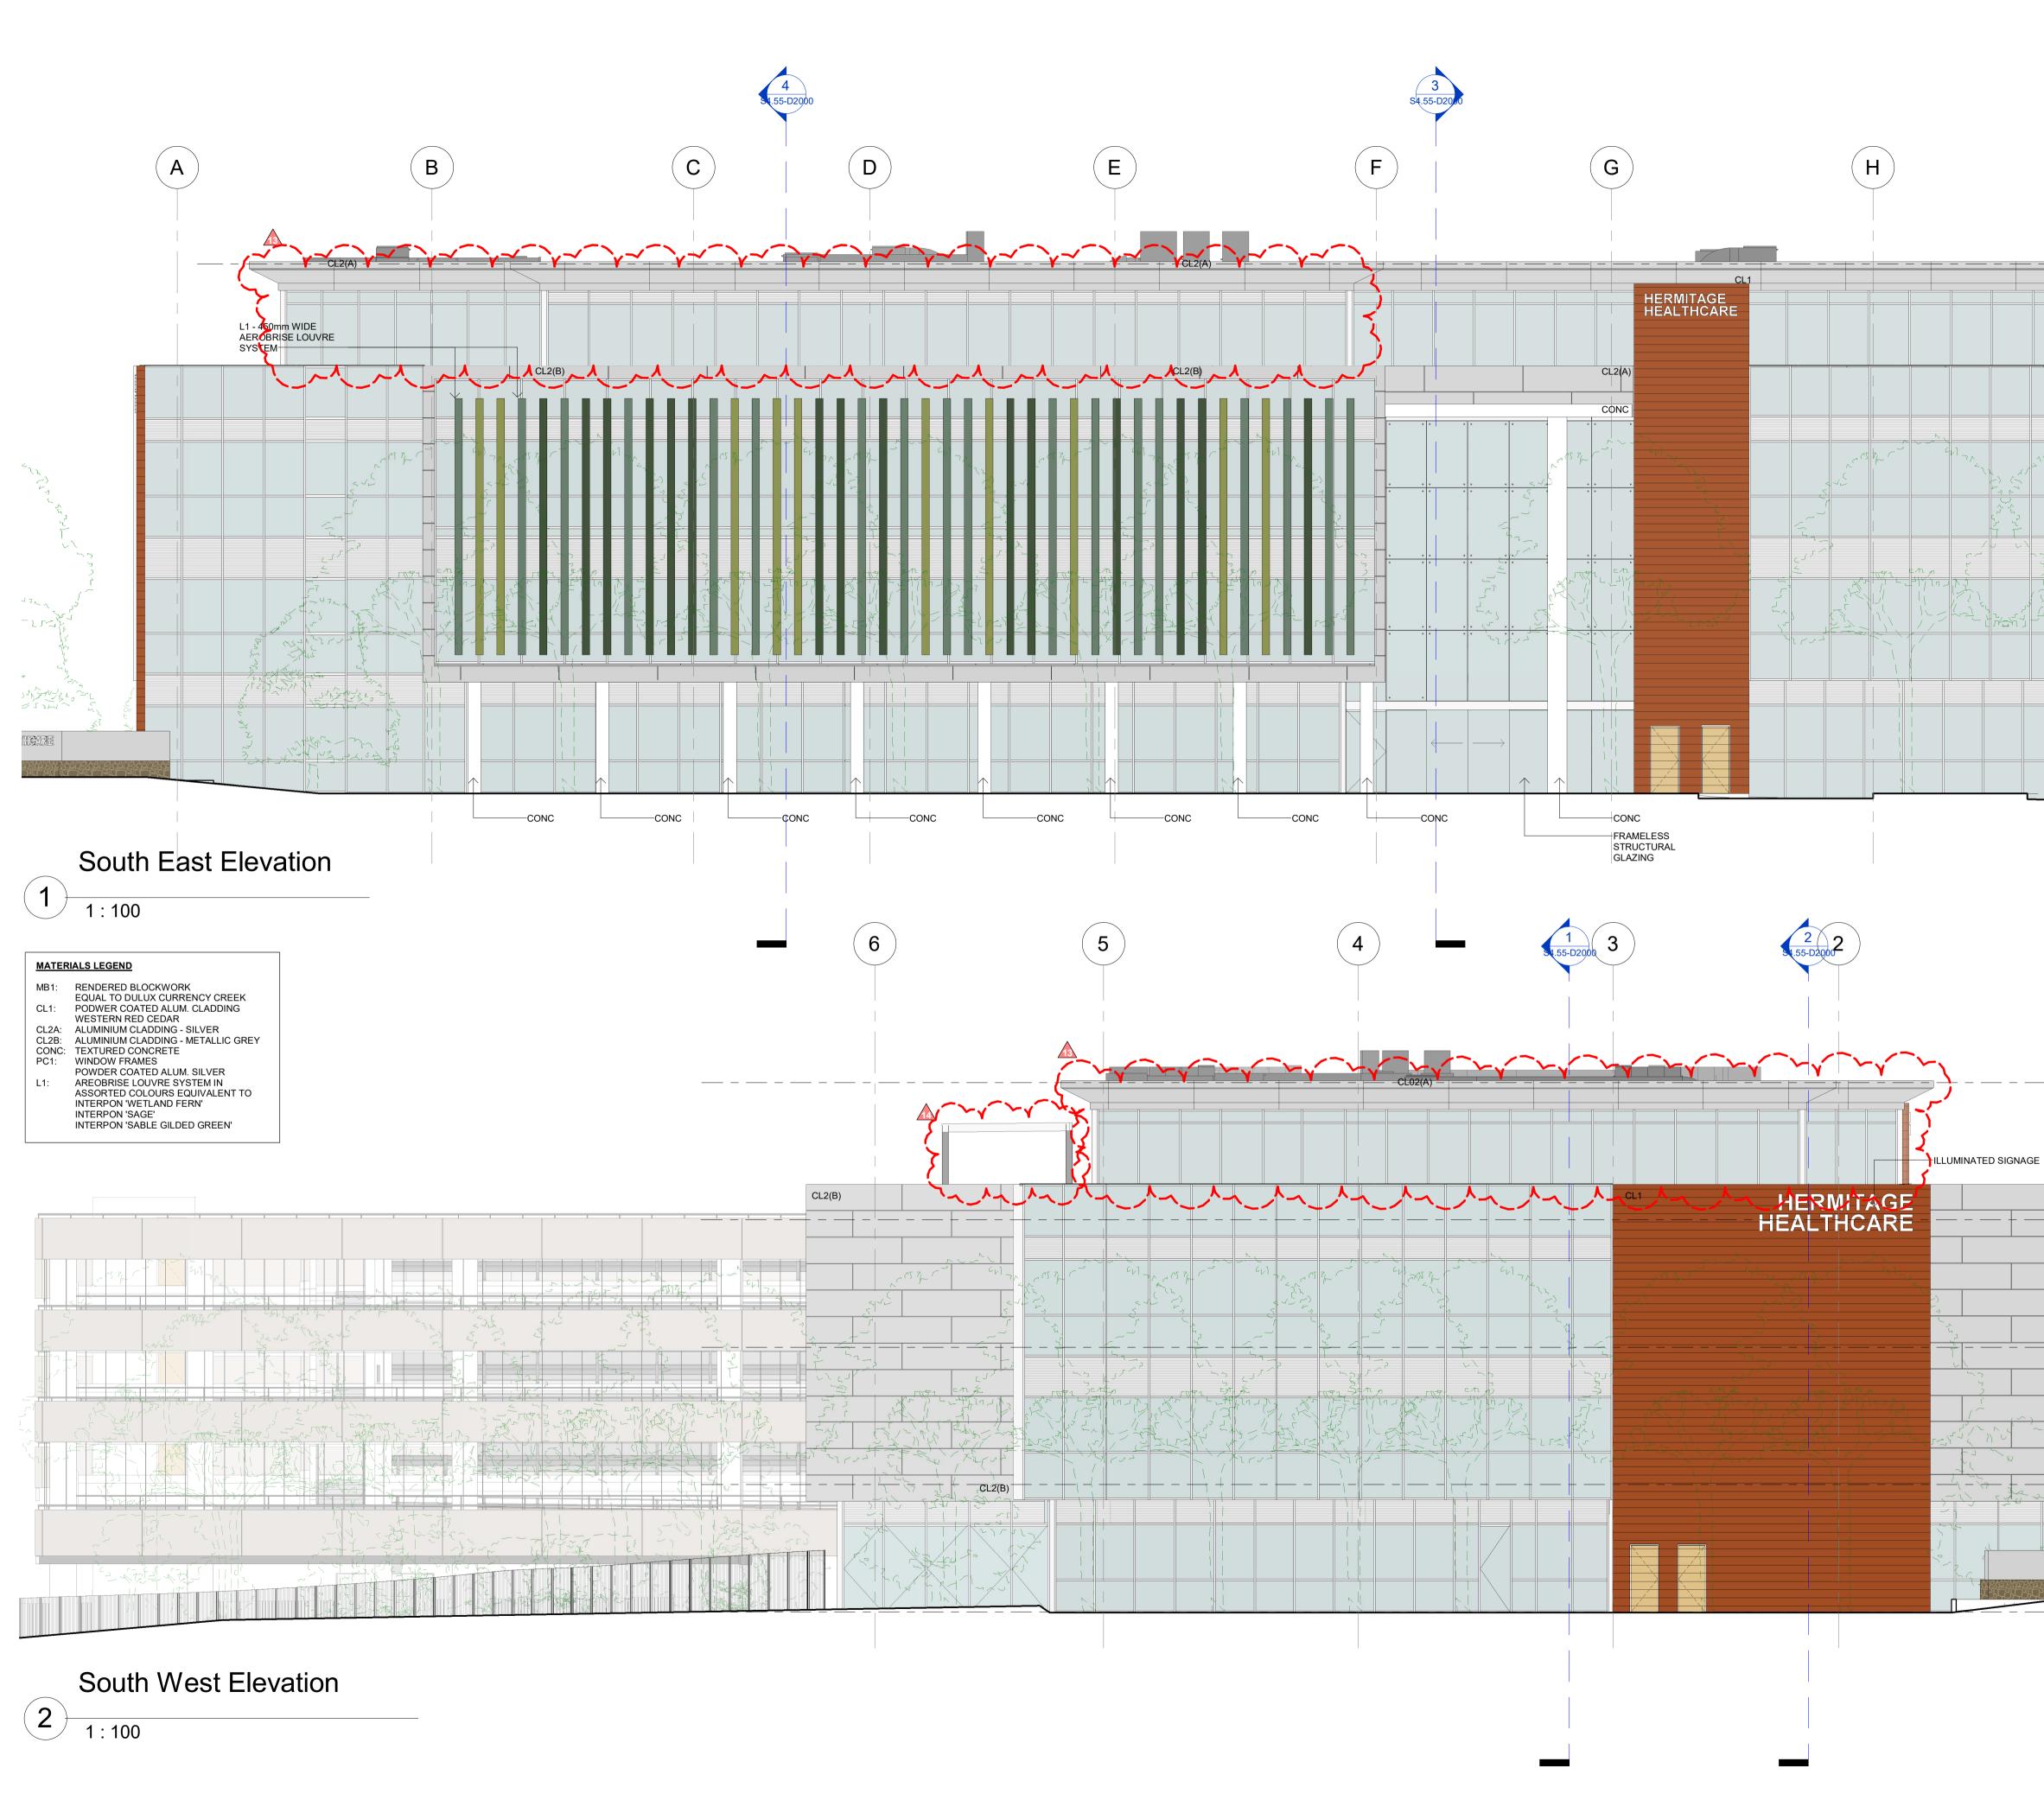


NOTE All dimensions to be verified prior to commencement of any shop drawings or fabrication. shop drawings are to be approved before construction. all dimensions are in millimeters unless otherwise noted. Annotated dimensions are to be used in preference to scaling from drawings. This drawing is the property of ANTHONY VAVAYIS + ASSOCIATES PTY LTD and any reproduction or distribution without prior consent constitutes a breach of copyright. LEGEND J Κ v~' 'HC' Roof CL2(A) +118.20 HC' Level 3 +114.00 7 7 7 SVL 'HC' Level 2 +110.10 'HC' Level 1 +105.90 HC' Ground Floor +102.00 ITEM CHANGE DESCRIPTION 7m building setback is provided per Development Consent (3)j) 2 Update ground level Medical Centre fit-out layout 2.1 Hospital fit-out included 3 Additional Landscaping 3.1 Additional Landscaping per Development Consent No. 2.0(11) 4 New screening around Gas Meter at boundary with 1 building signage intergrated 5 Adjust position of Sprinkler Booster 6 New padstation 7 New BOH lift 8 Update BOH layout 9 A through and left arrow is provided per Development Consent (3)c) 10 New vertical gas tank and security fencing 11 Update parking lot numbers 12 Change 2x 1-way to 1x 2-way driveway 'HC' Roof Increase building area 14 New roof terrace pergola +118.20 15 Update plant layout and acoustic screen location on Car park Roof. Omit 1x approved Chiller and add new DAS room, Boiler + Hydronic Pump 16 Proposed mechanical duct and plant for staircase pressuriser Increase building basement 18 New underground rainwater tank 19 Combined left and through arrow per Development CL2(B) Consent Condition No. (3)c)


 'HC' Level 3
 20
 One left turn only lane to exit onto The Hermitage Way is provided per Development Consent (3)a)

 _____ +114.00 21 Omit approved Level 3 roof mounted AC plant and screens 22 Additional columns 23 Proposed services linkbridge 24 Proposed roof air extract duct and fan 25 Increase building height 26 Change of use A 2723.01 2019 93 4 5 A Sharing angement amendment rev date REVISION +110.10 **ANTHONY VAVAYIS** +ASSOCIATES ARCHITECTS DESIGNERS PLANNERS 24 LIME STREET KING STREET WHARF 'HC' Level 1 SYDNEY NSW 2000 E: admin@avaarchitects.com.au T: 02 9290 1810 +105.90 F: 02 9290 1860 W: www.avaarchitects.com.au P: 20/26A LIME STREET KING STREET WHARF SYDNEY NSW 2000 ANTHONY VAVAYIS & ASSOCIATES PTY. LTD. ACN 069 737 935 NOMINATED ARCHITECT - ANTHONY VAVAYIS NO.5243 THCARE PROJECT TITLE HERMITAGE HEALTHCARE HC' Ground Floor Lot 832 & 833, Cnr Hermitage Way & Gregory Hills Drive, Gledswood Hill +102.00 CLIENT Hermitage Healthcare Pty Ltd DRAWING TITLE **BUILDING A ELEVATIONS SE** AND SW SCALE @ A1As indicated DATE MARCH 2017 DRAWN BYDK PROJECT 14018

S4.55-D3001 ^A

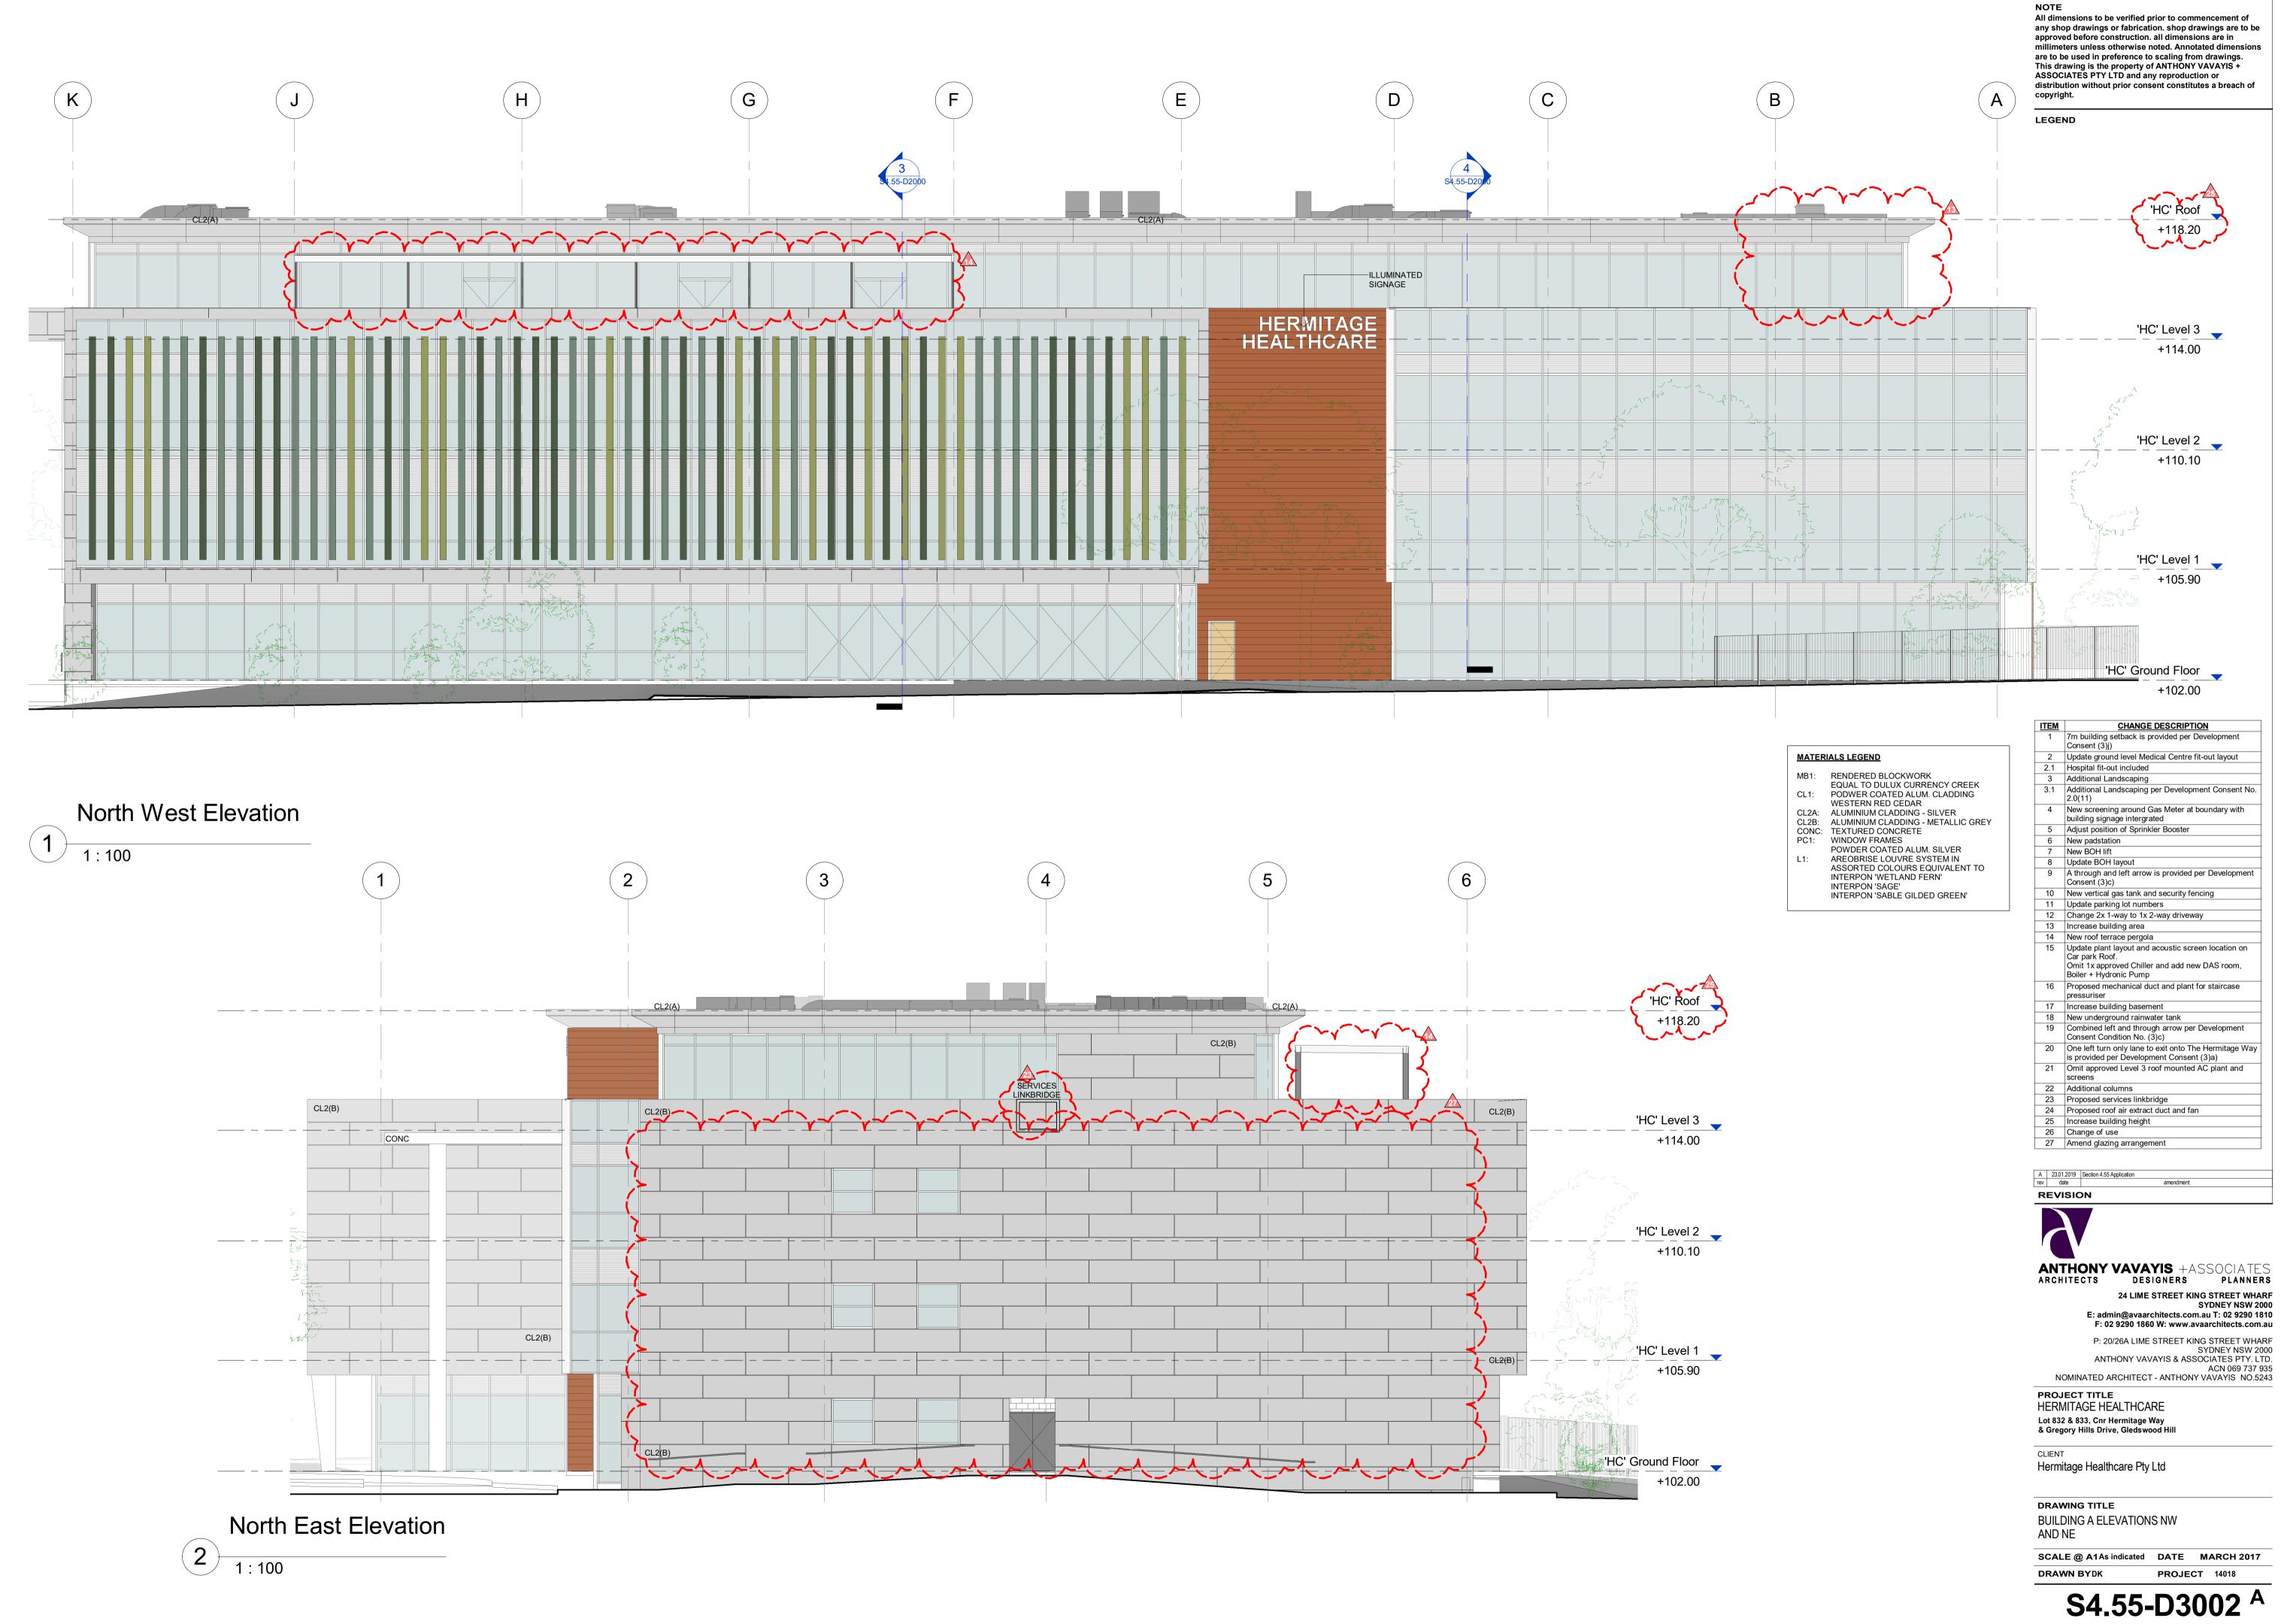

MATERIALS LEGEND				
MB1:	RENDERED BLOCKWORK			
	EQUAL TO DULUX CURRENCY CREEK			
CL1:	PODWER COATED ALUM. CLADDING			
	WESTERN RED CEDAR			
CL2A:	ALUMINIUM CLADDING - SILVER			
CL2B:	ALUMINIUM CLADDING - METALLIC GREY			
CONC:	TEXTURED CONCRETE			
PC1:	WINDOW FRAMES			
	POWDER COATED ALUM. SILVER			
L1:	AREOBRISE LOUVRE SYSTEM IN			
	ASSORTED COLOURS EQUIVALENT TO			
	INTERPON 'WETLAND FERN'			
	INTERPON 'SAGE'			
	INTERPON 'SABLE GILDED GREEN'			

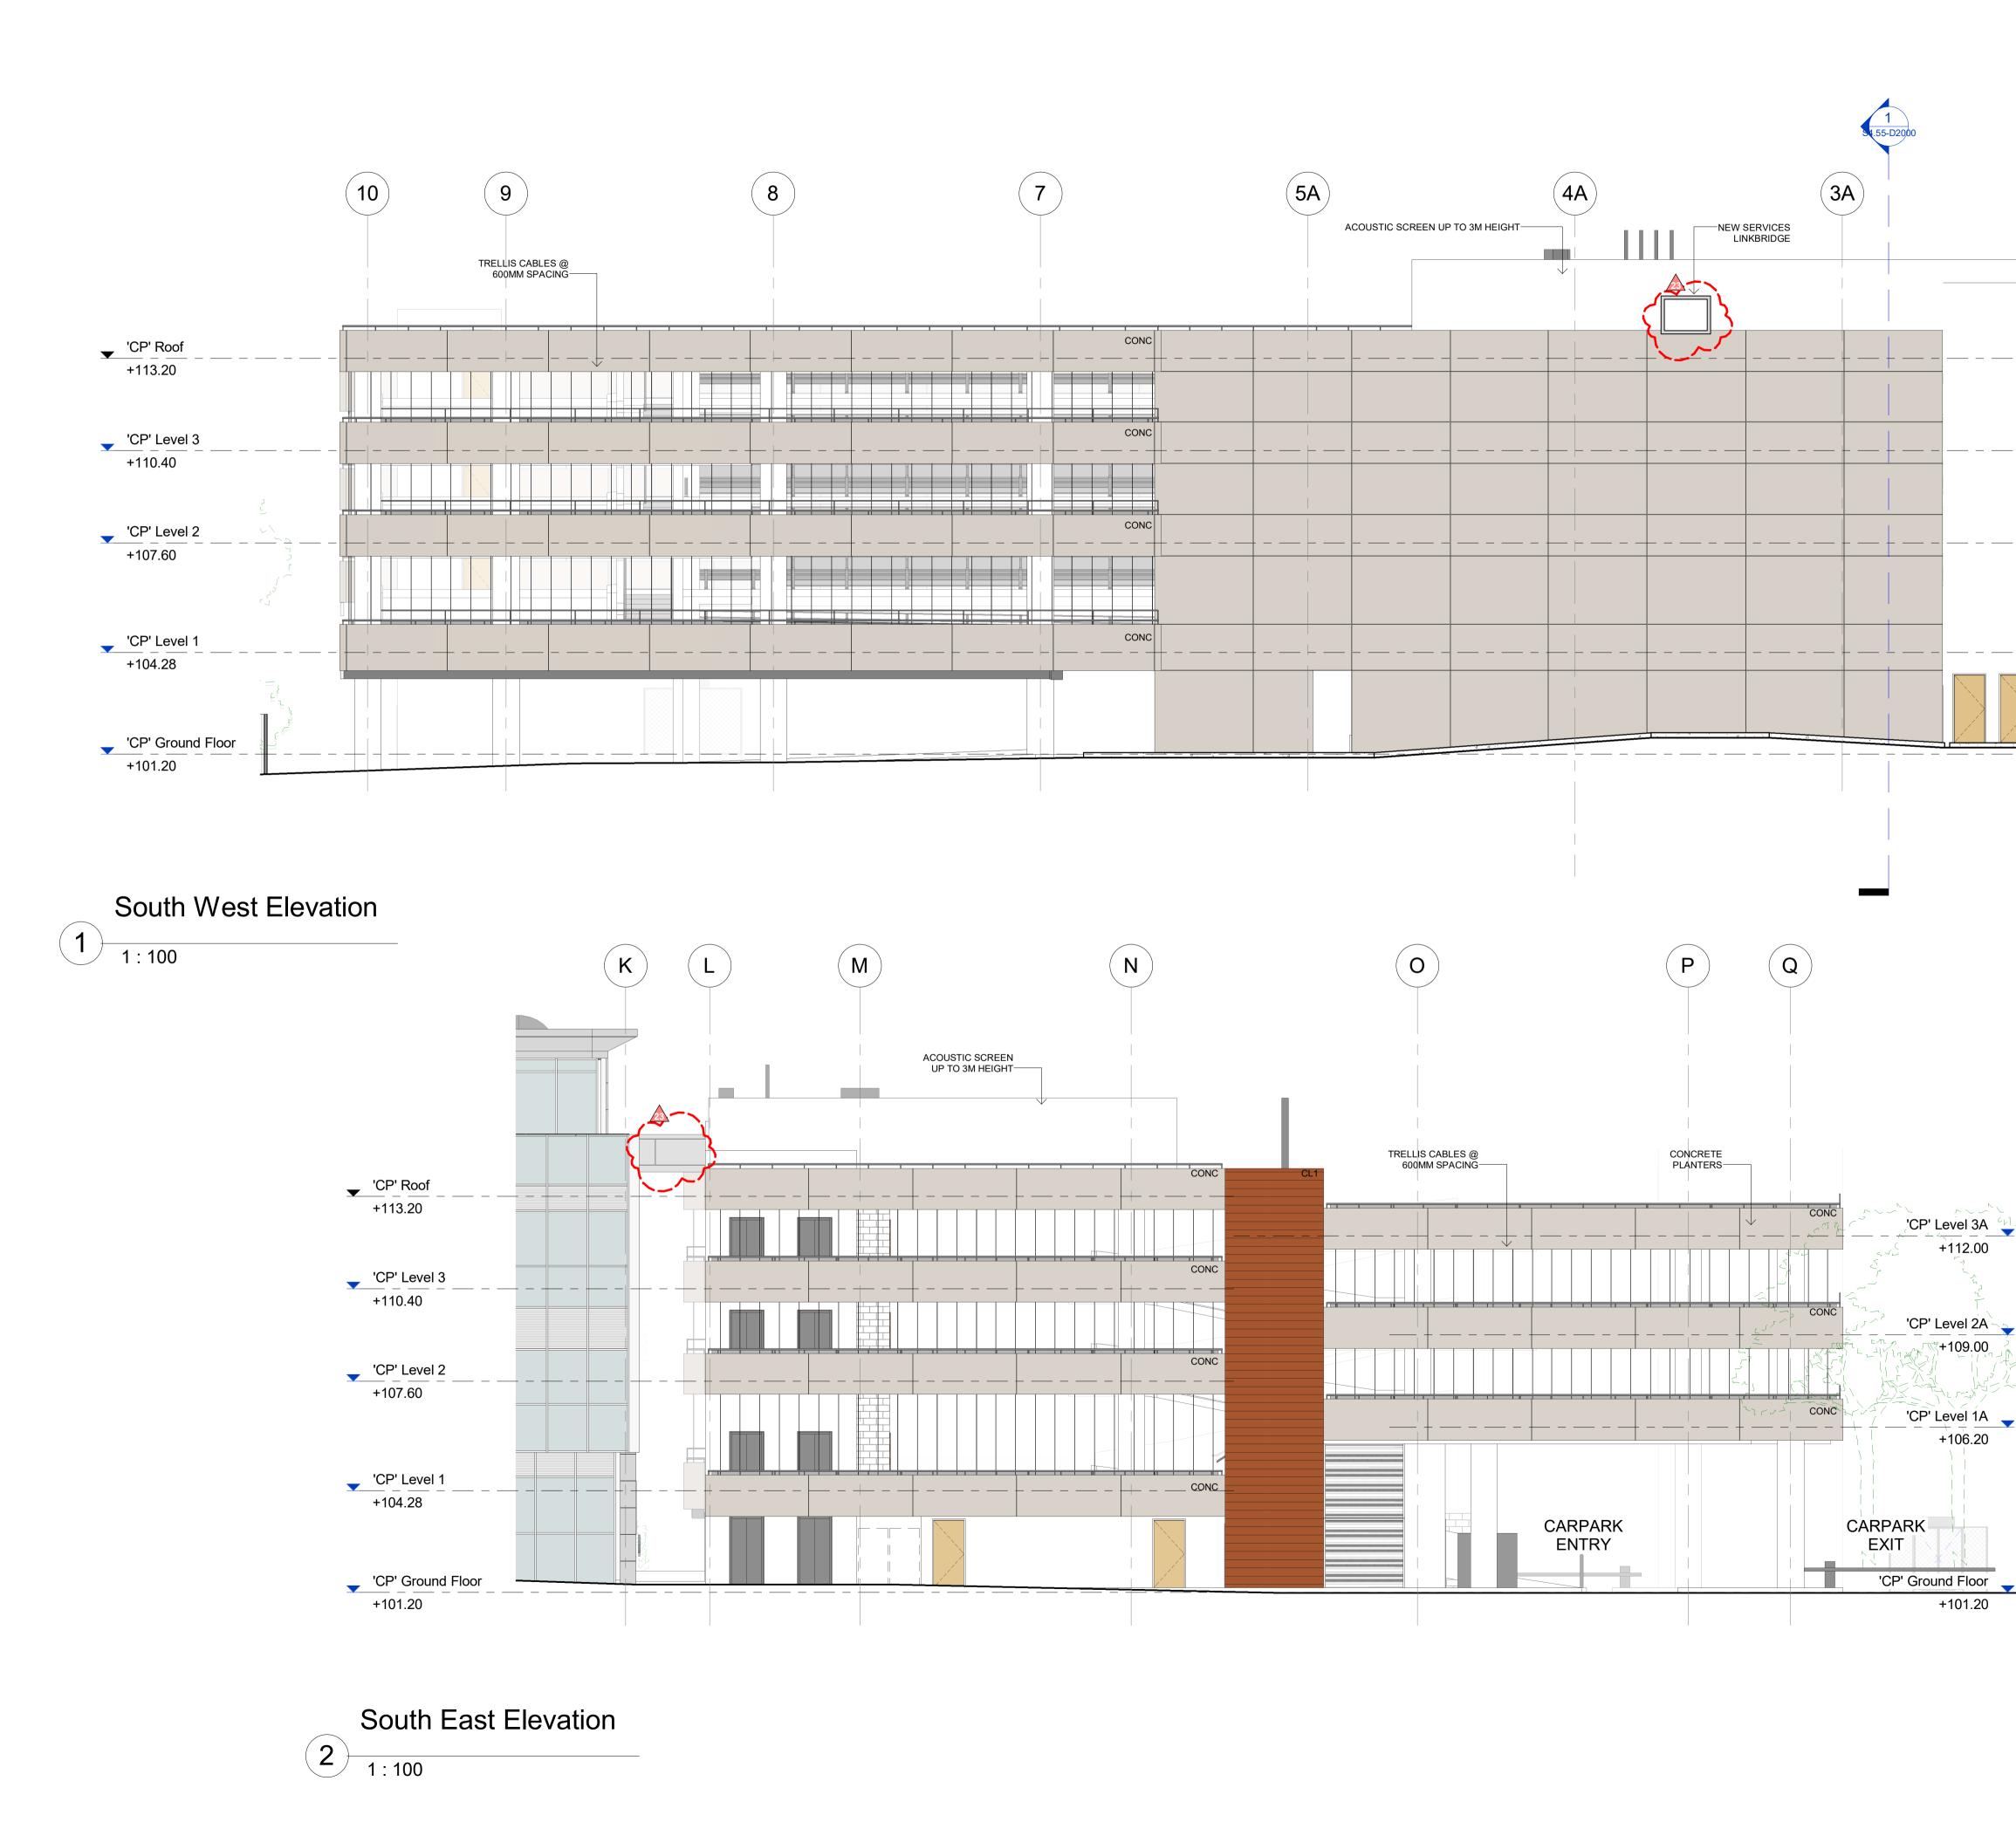

NOTE All dimensions to be verified prior to commencement of any shop drawings or fabrication. shop drawings are to be approved before construction. all dimensions are in millimeters unless otherwise noted. Annotated dimensions are to be used in preference to scaling from drawings. This drawing is the property of ANTHONY VAVAYIS + ASSOCIATES PTY LTD and any reproduction or distribution without prior consent constitutes a breach of copyright. LEGEND 4.55-D20¢ (2A) MB1 CONC 'CP' Roof +113.20 CONC 'CP' Level 3 +110.40 CONC 'CP' Level 2 🚽 +107.60 'CP' Level 1 CONC +104.28 'CP' Ground Floor +101.20
 <u>CHANGE DESCRIPTION</u>

 7m building setback is provided per Development
 ITEM Consent (3)j) 2 Update ground level Medical Centre fit-out layout 2.1 Hospital fit-out included Additional Landscaping 3.1 Additional Landscaping per Development Consent No 2.0(11) 4 New screening around Gas Meter at boundary with building signage intergrated Adjust position of Sprinkler Booster MATERIALS LEGEND 6 New padstation MB1: RENDERED BLOCKWORK 7 New BOH lift EQUAL TO DULUX CURRENCY CREEK 8 Update BOH layout CL1: PODWER COATED ALUM. CLADDING WESTERN RED CEDAR CL2A: ALUMINIUM CLADDING - SILVER CL2B: ALUMINIUM CLADDING - METALLIC GREY 9 A through and left arrow is provided per Development Consent (3)c) 10 New vertical gas tank and security fencing Update parking lot numbers
 Change 2x 1-way to 1x 2-way driveway CONC: TEXTURED CONCRETE PC1: WINDOW FRAMES POWDER COATED ALUM. SILVER 13 Increase building area L1: AREOBRISE LOUVRE SYSTEM IN 14 New roof terrace pergola ASSORTED COLOURS EQUIVALENT TO 15 Update plant layout and acoustic screen location on INTERPON 'WETLAND FERN' Car park Roof. INTERPON 'SAGE' Omit 1x approved Chiller and add new DAS room, INTERPON 'SABLE GILDED GREEN' Boiler + Hydronic Pump 16 Proposed mechanical duct and plant for staircase pressuriser 17Increase building basement18New underground rainwater tank 19 Combined left and through arrow per Development Consent Condition No. (3)c) 20 One left turn only lane to exit onto The Hermitage Way is provided per Development Consent (3)a) 21 Omit approved Level 3 roof mounted AC plant and screens

22 Additional columns 23 Proposed services linkbridge 24 Proposed roof air extract duct and fan 25 Increase building height
 26
 Change of use

 27
 Amend glazing arrangement
 A 23.01.2019 Section 4.55 Application rev date amendme REVISION

ANTHONY VAVAYIS +ASSOCIATES Architects designers planners 24 LIME STREET KING STREET WHARF SYDNEY NSW 2000 E: admin@avaarchitects.com.au T: 02 9290 1810 F: 02 9290 1860 W: www.avaarchitects.com.au P: 20/26A LIME STREET KING STREET WHARF SYDNEY NSW 2000

ANTHONY VAVAYIS & ASSOCIATES PTY. LTD. ACN 069 737 935 NOMINATED ARCHITECT - ANTHONY VAVAYIS NO.5243 PROJECT TITLE HERMITAGE HEALTHCARE


Lot 832 & 833, Cnr Hermitage Way & Gregory Hills Drive, Gledswood Hill

CLIENT Hermitage Healthcare Pty Ltd

DRAWING TITLE **BUILDING B ELEVATIONS SW** AND SE

SCALE @ A1As indicated DATE MARCH 2017 DRAWN BYDK PROJECT 14018

S4.55-D3003 ^A

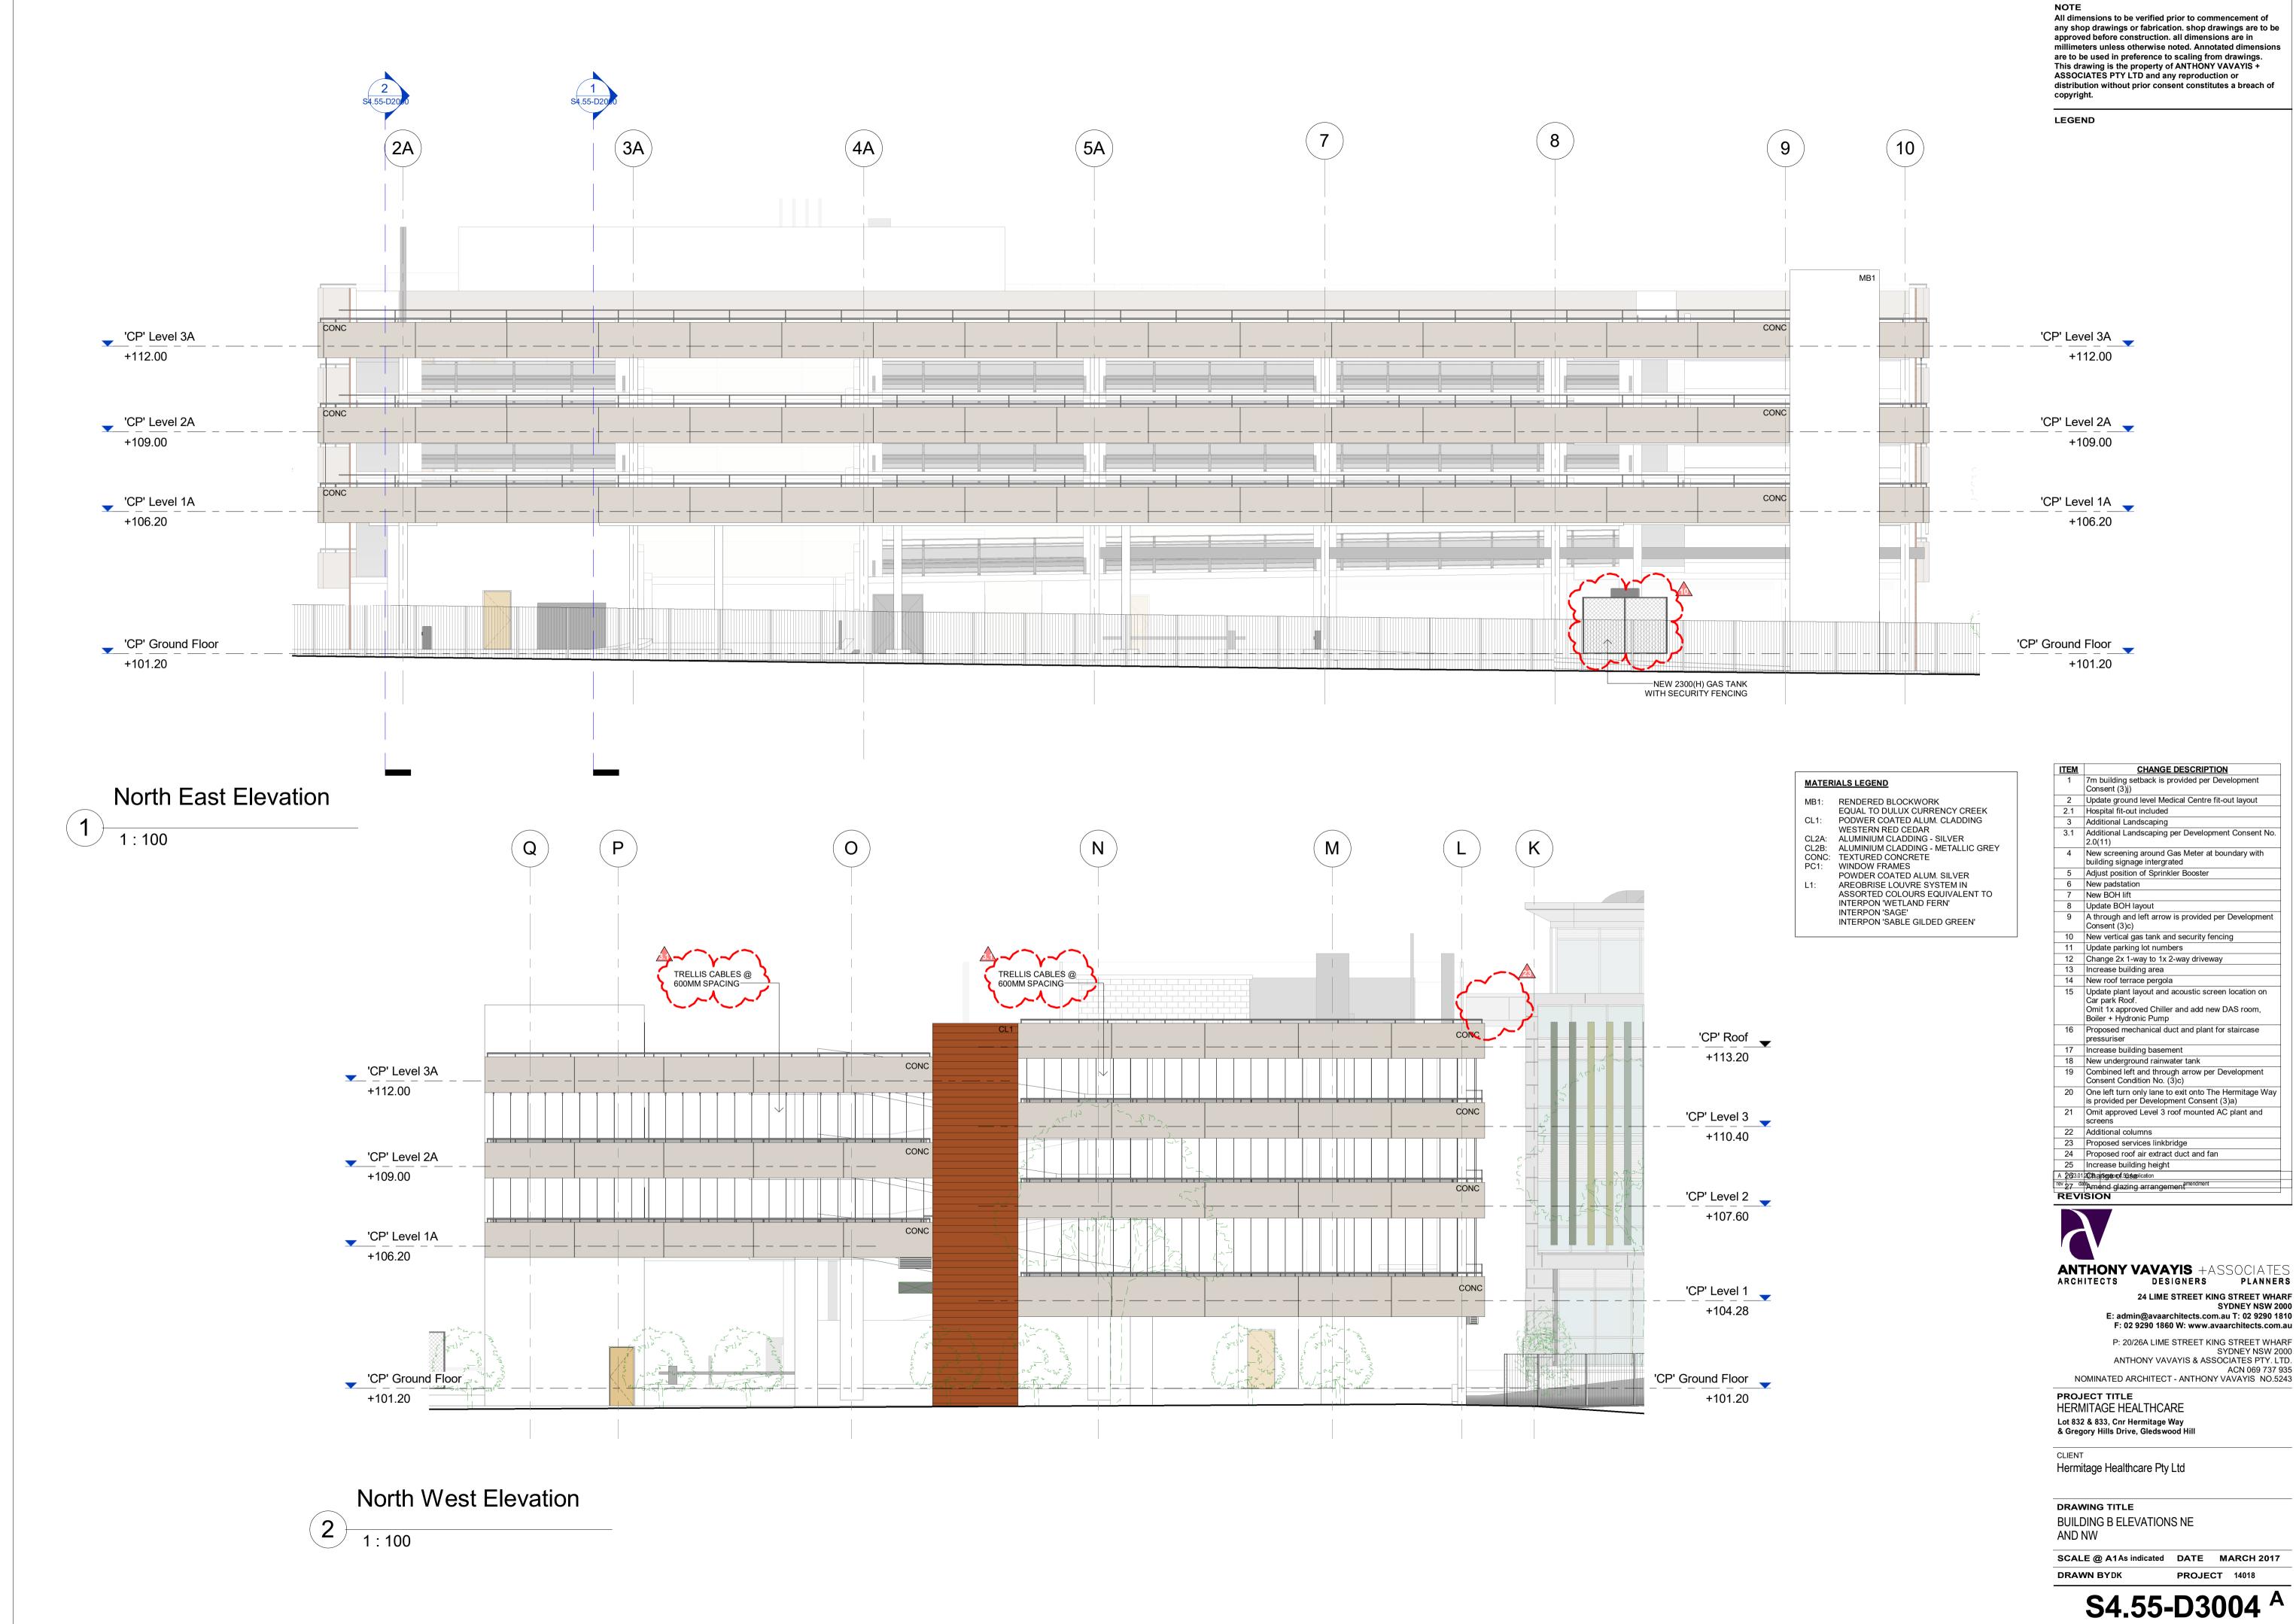

millimeters unless otherwise noted. Annotated dimensions

MATER	IALS LEGEND
MB1:	RENDERED BLOCKWORK
	EQUAL TO DULUX CURRENCY CREEK
CL1:	PODWER COATED ALUM. CLADDING
	WESTERN RED CEDAR
CL2A:	ALUMINIUM CLADDING - SILVER
CL2B:	ALUMINIUM CLADDING - METALLIC GREY
CONC:	TEXTURED CONCRETE
PC1:	WINDOW FRAMES
	POWDER COATED ALUM. SILVER
L1:	AREOBRISE LOUVRE SYSTEM IN
	ASSORTED COLOURS EQUIVALENT TO
	INTERPON 'WETLAND FERN'
	INTERPON 'SAGE'
	INTERPON 'SABLE GILDED GREEN'

ITEM	CHANGE DESCRIPTION
1	7m building setback is provided per Development Consent (3)j)
2	Update ground level Medical Centre fit-out layout
2.1	Hospital fit-out included
3	Additional Landscaping
3.1	Additional Landscaping per Development Consent No. 2.0(11)
4	New screening around Gas Meter at boundary with building signage intergrated
5	Adjust position of Sprinkler Booster
6	New padstation
7	New BOH lift
8	Update BOH layout
9	A through and left arrow is provided per Development Consent (3)c)
10	New vertical gas tank and security fencing
11	Update parking lot numbers
12	Change 2x 1-way to 1x 2-way driveway
13	Increase building area
14	New roof terrace pergola
15	Update plant layout and acoustic screen location on Car park Roof. Omit 1x approved Chiller and add new DAS room, Boiler + Hydronic Pump
16	Proposed mechanical duct and plant for staircase pressuriser
17	Increase building basement
18	New underground rainwater tank
19	Combined left and through arrow per Development Consent Condition No. (3)c)
20	One left turn only lane to exit onto The Hermitage Way is provided per Development Consent (3)a)
21	Omit approved Level 3 roof mounted AC plant and screens
22	Additional columns
23	Proposed services linkbridge
24	Proposed roof air extract duct and fan
25	Increase building height
A 26 3.01	2018 alseption f.50 septication
	ateAmend glazing arrangement
	ISION

24 LIME STREET KING STREET WHARF SYDNEY NSW 2000 E: admin@avaarchitects.com.au T: 02 9290 1810 F: 02 9290 1860 W: www.avaarchitects.com.au P: 20/26A LIME STREET KING STREET WHARF SYDNEY NSW 2000 ANTHONY VAVAYIS & ASSOCIATES PTY. LTD. ACN 069 737 935 NOMINATED ARCHITECT - ANTHONY VAVAYIS NO.5243

HERMITAGE HEALTHCARE Lot 832 & 833, Cnr Hermitage Way & Gregory Hills Drive, Gledswood Hill Section 4.55

DRAWINGS

DWG NO.	DRAWING TITLE	SCAL
L-000	COVER SHEET	N/A
L-C100	LANDSCAPE MASTERPLAN RENDER	1:200
L-100	LANDSCAPE MASTERPLAN	1:200
L-101	LANDSCAPE PLAN A	1:100
L-102	LANDSCAPE PLAN B	1:100
L-103	LANDSCAPE PLAN C	1:100
L-104	LANDSCAPE PLAN D	1:100
L-501	LANDSCAPE SPECIFICATION & PLANT SCHEDULE	N/A
L-502	LANDSCAPE DETAILS	As Sho

SCALE

N/A As Shown

© 2018 Site Image (NSW) Pty Ltd ABN 44 801 262 380 as agent for Site Image NSW Partnership. All rights reserved. This drawing is copyright and shall not be reproduced or copied in any form or by any means (graphic, electronic or mechanical including photocopy) without the written permission of Site Image (NSW) Pty Ltd Any license, expressed or implied, to use this document for any purpose what so ever is restricted to the terms of the written agreement between Site Image (NSW) Pty Ltd and the instructing party.

The contractor shall check and verify all work on site (including work by others) before commencing the landscape installation. Any discrepancies are to be reported to the Project Manager or Landscape Architect prior to commencing work. Do not scale this drawing. Any required dimensions not shown shall be referred to the Landscape Architect for confirmation.

B Section 4.55 NPE RS 29.04.2019 A For Coordination NPi RS 10.12.2018 Issue Revision Description Drawn Check Date

LEGEND

Key Plan:

Client: Hermitage Healthcare Pty Ltd

Architect: Anthony Vavayis + Associates

Project:

Hermitage Health Care Lot 832 & 833, Cnr Hermitage Way & Gregory Hills Drive, Gledswood Hill

Level 1, 3-5 Baptist Street Redfern NSW 2016 Australia

Tel: (61 2) 8332 5600 Fax: (61 2) 9698 2877 www.siteimage.com.au Site Image (NSW) Pty Ltd ABN 44 801 262 380



SECTION 4.55

Drawing Name:

Cover Sheet

Scale: Job Number SS18-3998

Drawing Numbe

L-000 B

Sheet _ of _



© 2018 Site Image (NSW) Pty Ltd ABN 44 801 262 380 as agent for Site Image NSW Partnership. All rights reserved. This drawing is copyright and shall not be reproduced or copied in any form or by any means (graphic, electronic or mechanical including photocopy) without the written permission of Site Image (NSW) Pty Ltd Any license, expressed or implied, to use this document for any purpose what so ever is restricted to the terms of the written agreement between Site Image (NSW) Pty Ltd and the instructing party. party.

The contractor shall check and verify all work on site (including work by others) before commencing the landscape installation. Any discrepancies are to be reported to the Project Manager or Landscape Architect prior to commencing work. Do not scale this drawing. Any required dimensions not shown shall be referred to the Landscape Architect for confirmation.

В	Section 4.55	NPE RS 29.04.2019
A	For Coordination	NPi RS 10.12.2018
Issue	Revision Description	Drawn Check Date
LEG	END	
$(\cdot$	Tree to be Retained	TS1 - Table Setting 1 (refer materials schedule)
X.	Proposed Tree Planting (refer planting plans)	BS1 - Bench Seat 1 (refer materials schedule)
	Proposed Shrub / Accent Planting (refer planting plans)	BS2 - Bench Seat 2 (refer materials schedule & details)
	Proposed Groundcover & Grass Planting (refer planting plans)	BS3 - Bench Seat 3 (refer materials schedule & details)
	Turf (refer specification)	HT - Hose Tap (refer Hydraulic docs.)
*	P1 - Paving Type 1 Insitu Concrete Path & BL	BL - Bollard Light (Refer Elec. Eng. Drawings) UL - Uplight
	P2 - Paving Type 2	(Refer Elec. Eng. Drawings)
	P3 - Paving Type 3 Composite Timber Decking	Grated Inlet Pit (Refer Civil Drawings)
	P4 - Paving Type 4 Softfall Mulch	
	P5 - Paving Type 5 Artificial Turf	
	TE - Timber Edging SE - Steel Edging (refer materials schedule)	
	Sandstone Stepping Stones (refer materials schedule)	
	Timber Sleeper Path (refer materials schedule)	
	Sandstone Log Bench (refer materials schedule)	
000	C (refer materials schedule)	
\otimes	Balancing Beam (refer materials schedule)	
So Be	Timber Totems	
\$	Pot Plants (refer planting plans & materials schedule)	

Key Plan:

Client:

Hermitage Healthcare Pty Ltd

Architect: Anthony Vavayis + Associates

Project:

Hermitage Health Care Lot 832 & 833, Cnr Hermitage Way & Gregory Hills Drive, Gledswood Hill

Level 1, 3-5 Baptist Street Redfern NSW 2016 Australia

Tel: (61 2) 8332 5600 Fax: (61 2) 9698 2877 www.siteimage.com.au Site Image (NSW) Pty Ltd ABN 44 801 262 380





SECTION 4.55

Drawing Name:

Landscape Masterplan Render

Scale: 1:200 @ A1 Job Number:

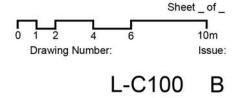

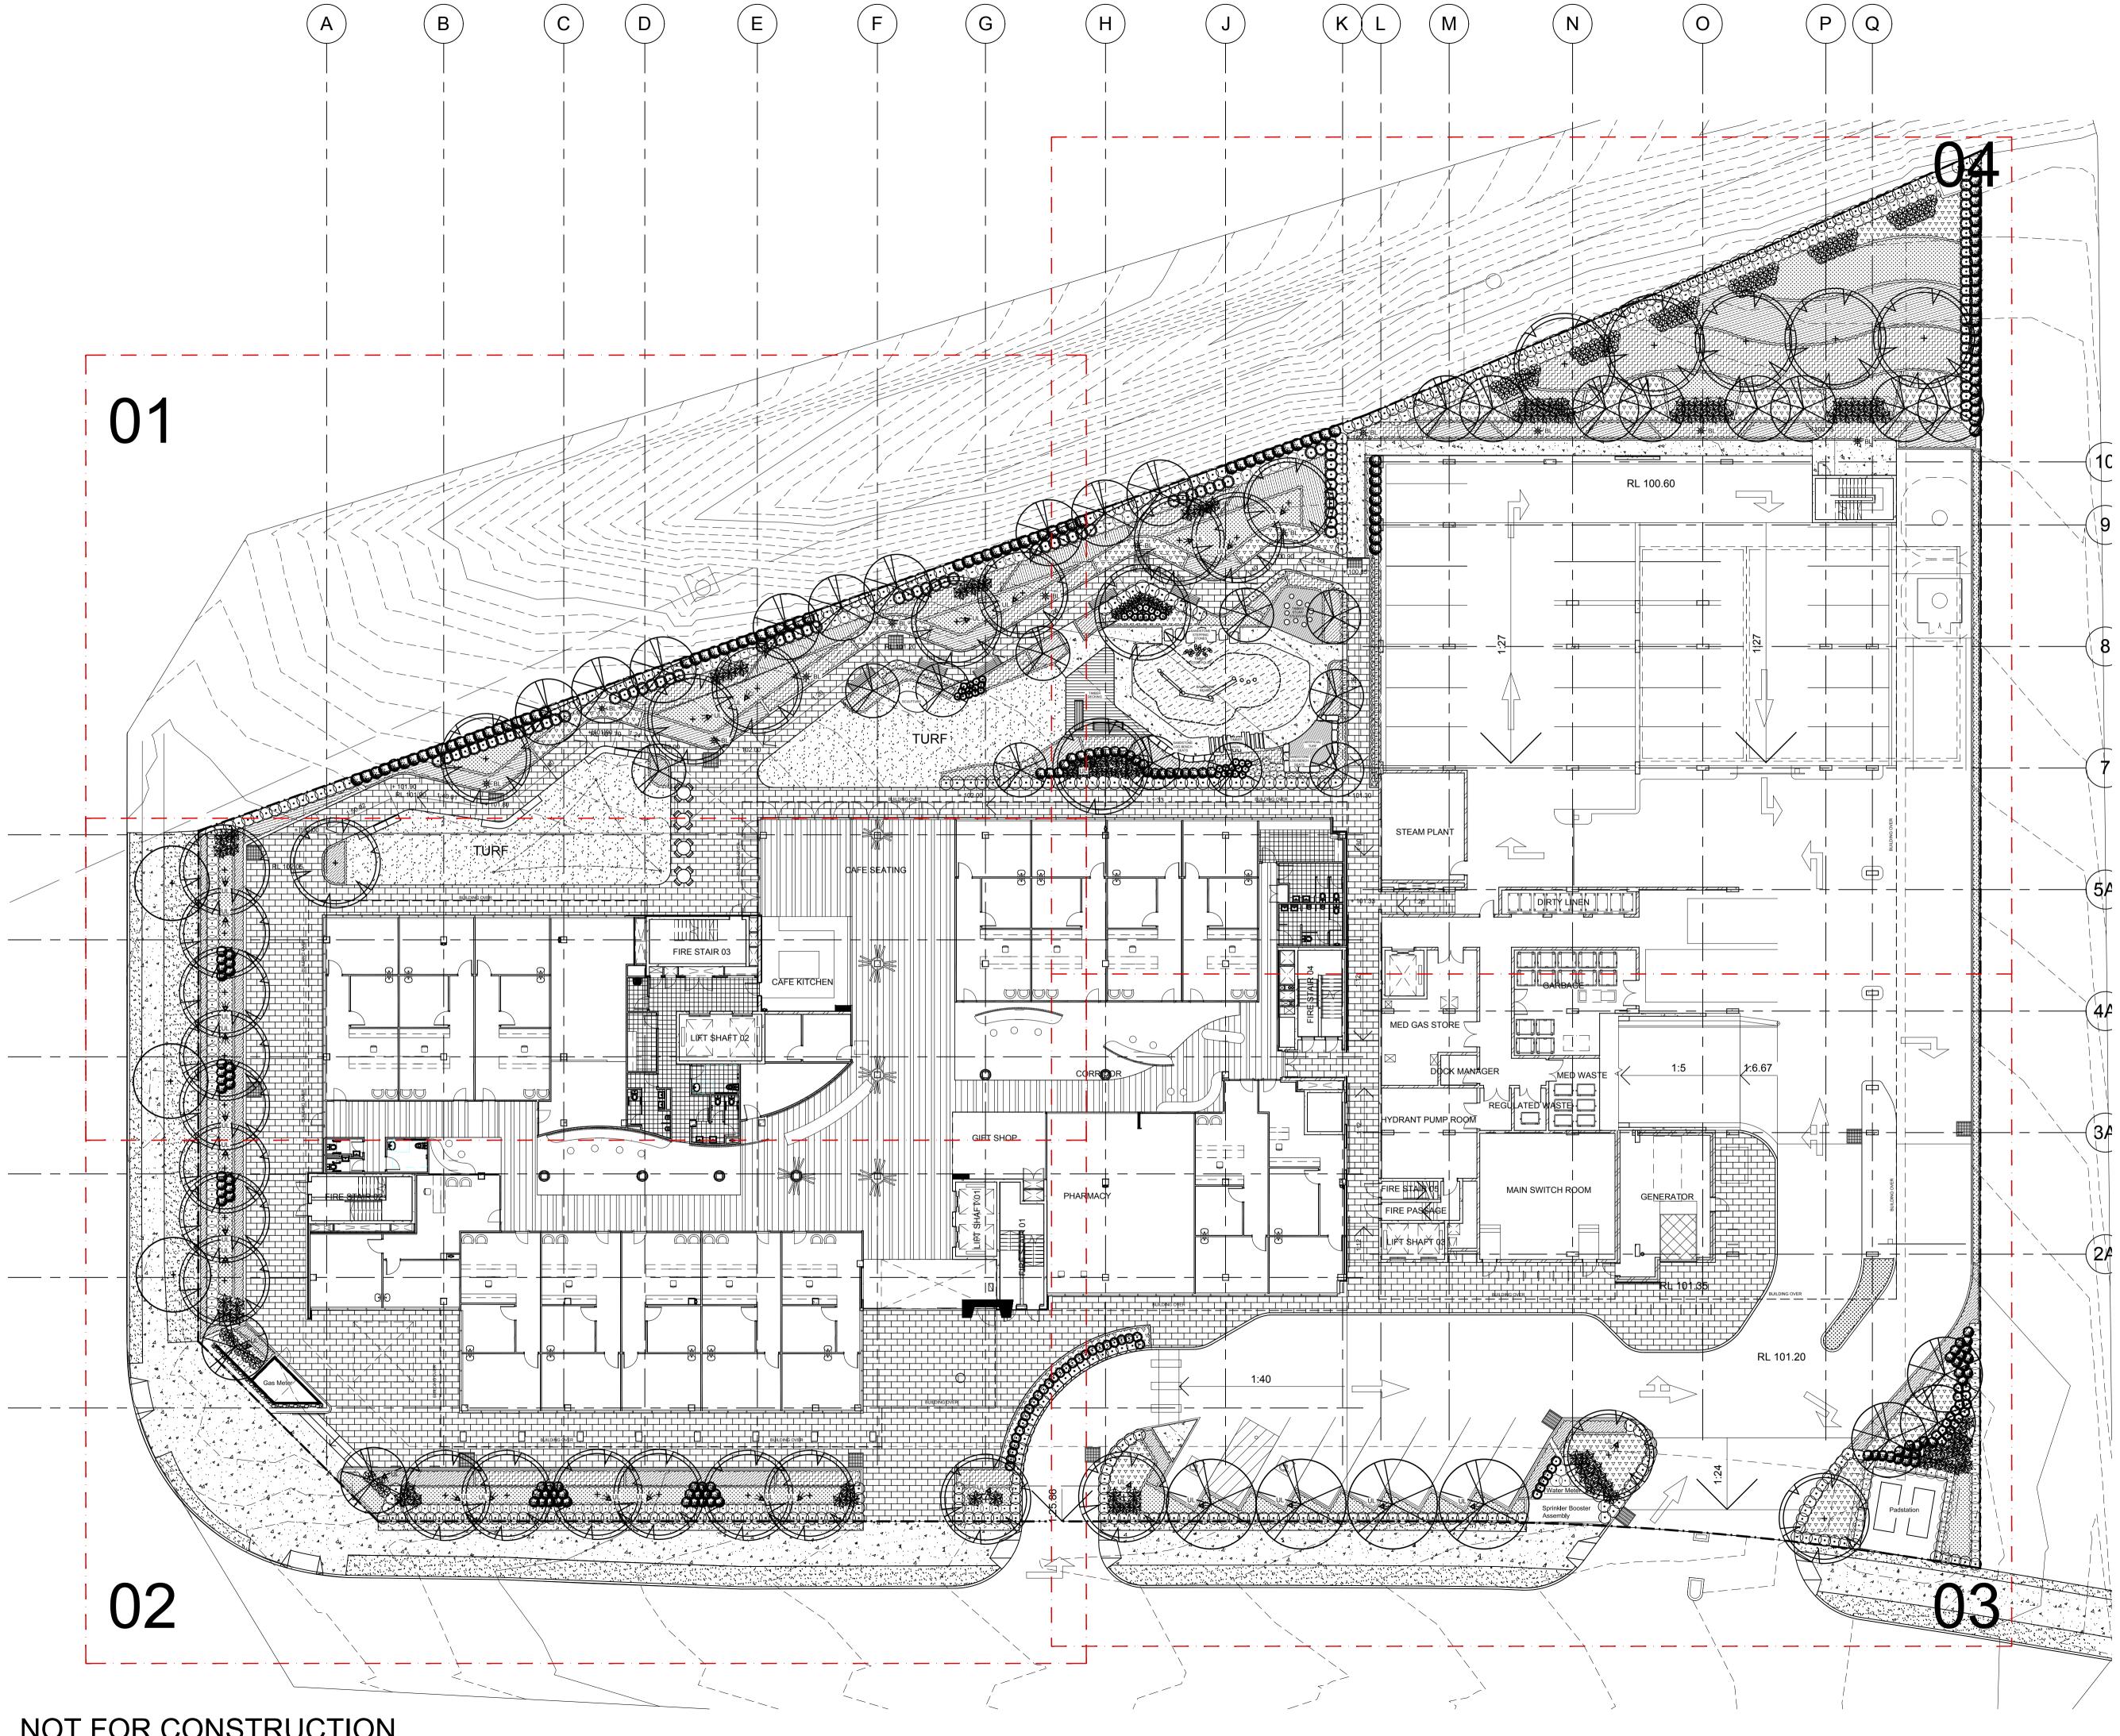

© 2018 Site Image (NSW) Pty Ltd ABN 44 801 262 380 as agent for Site Image NSW Partnership. All rights reserved. This drawing is copyright and shall not be reproduced or copied in any form or by any means (graphic, electronic or mechanical including photocopy) without the written permission of Site Image (NSW) Pty Ltd Any license, expressed or implied, to use this document for any purpose what so ever is restricted to the terms of the written agreement between Site Image (NSW) Pty Ltd and the instructing party.

The contractor shall check and verify all work on site (including work by others) before commencing the landscape installation. Any discrepancies are to be reported to the Project Manager or Landscape Architect prior to commencing work. Do not scale this drawing. Any required dimensions not shown shall be referred to the Landscape Architect for confirmation.

B Se	ection 4.55		NPE	RS	29.04.2019
A Fo	or Coordination		NPi	RS	10.12.2018
Issue Re	evision Description		Drawn	Check	Date
LEGE	ND				
$(\cdot$	Tree to be Retained	\bigcirc	TS1 - Tab (refer materials		g 1
	Proposed Tree Planting (refer planting plans)		BS1 - Ber (refer materials		1
	Proposed Shrub / Accent Planting (refer planting plans)		BS2 - Ber (refer materials		
	Grass Planting plants)		BS3 - Ber (refer materials		
	Turf (refer specification)		HT - Hose (refer Hydrauli		
	P1 - Paving Type 1 Insitu Concrete Path	₩ BL	BL - Bolla (Refer Elec. UL - Uplig	Eng. Draw	ings)
	P2 - Paving Type 2 Unit Pavers		(Refer Elec.	Eng. Draw	ings)
	P3 - Paving Type 3 Composite Timber Decking		Grated Inl (Refer Civil I		
	P4 - Paving Type 4 Softfall Mulch				
	P5 - Paving Type 5 Artificial Turf				
	 TE - Timber Edging SE - Steel Edging (refer materials schedule) 				
000	Sandstone Stepping Stones (refer materials schedule)				
	Timber Sleeper Path (refer materials schedule)				
	Sandstone Log Bench (refer materials schedule)				
$\begin{array}{c} 0 \\ 0 \\ 0 \\ 0 \end{array}$	Timber Stump Steppers (refer materials schedule)				
$\langle \cdot \rangle$	Balancing Beam (refer materials schedule)				
688 68 68 C	Timber Totems (refer materials schedule)				
	Pot Plants (refer planting plans & materials schedule)				

Key Plan:

Client

Hermitage Healthcare Pty Ltd

Anthony Vavayis + Associates

Hermitage Health Care Lot 832 & 833, Cnr Hermitage Way & Gregory Hills Drive, Gledswood Hill

Level 1, 3-5 Baptist Street Redfern NSW 2016 Australia

Tel: (61 2) 8332 5600 Fax: (61 2) 9698 2877 www.siteimage.com.au Site Image (NSW) Pty Ltd ABN 44 801 262 380




SECTION 4.55

Drawing Name:

Landscape Masterplan


Scale: 1:200 @ A1 Job Number:

Sheet _ of _ Drawing Number L-100 B

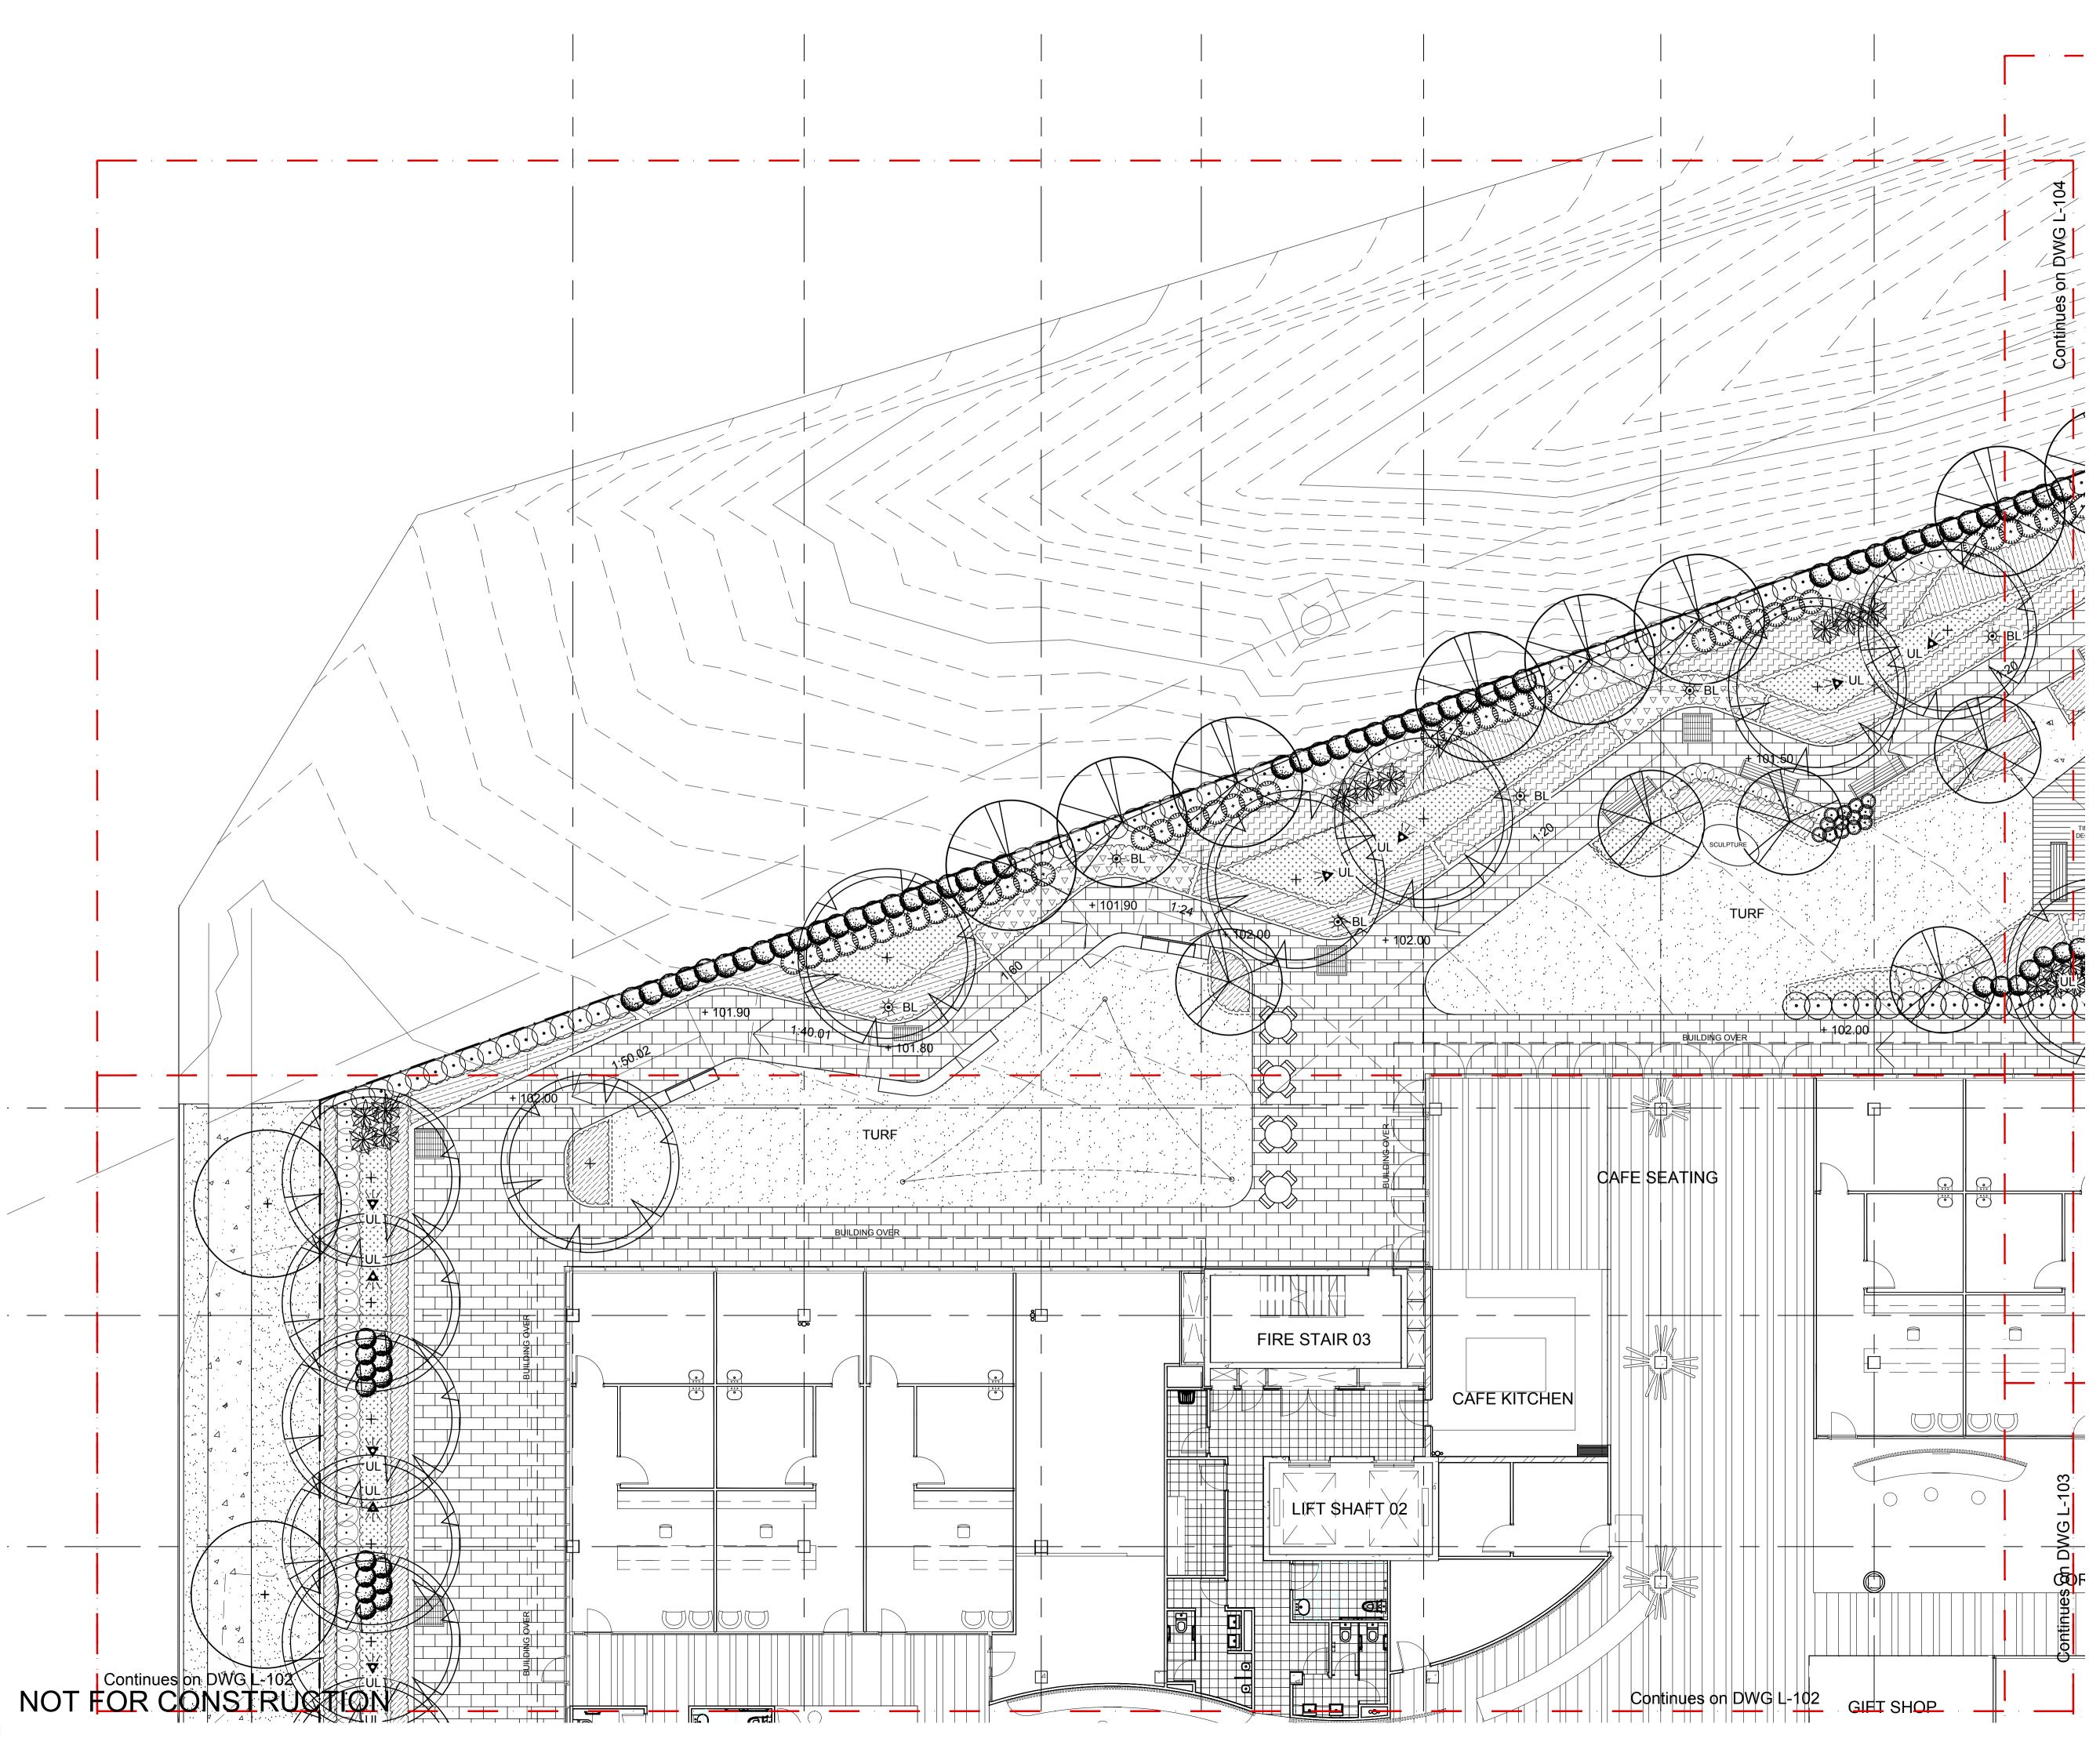

© 2018 Site Image (NSW) Pty Ltd ABN 44 801 262 380 as agent for Site Image NSW Partnership. All rights reserved. This drawing is copyright and shall not be reproduced or copied in any form or by any means (graphic, electronic or mechanical including photocopy) without the written permission of Site Image (NSW) Pty Ltd Any license, expressed or implied, to use this document for any purpose what so ever is restricted to the terms of the written agreement between Site Image (NSW) Pty Ltd and the instructing party.

The contractor shall check and verify all work on site (including work by others) before commencing the landscape installation. Any discrepancies are to be reported to the Project Manager or Landscape Architect prior to commencing work. Do not scale this drawing. Any required dimensions not shown shall be referred to the Landscape Architect for confirmation.

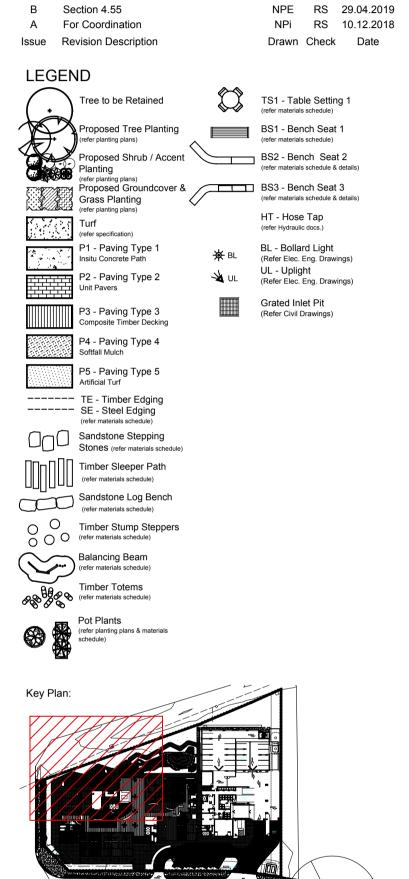

Client: Hermitage Healthcare Pty Ltd

Architect: Anthony Vavayis + Associates

Project:

Hermitage Health Care Lot 832 & 833, Cnr Hermitage Way & Gregory Hills Drive, Gledswood Hill

Level 1, 3-5 Baptist Street Redfern NSW 2016 Australia

Tel: (61 2) 8332 5600 Fax: (61 2) 9698 2877 www.siteimage.com.au Site Image (NSW) Pty Ltd ABN 44 801 262 380




SECTION 4.55

Drawing Name:


Landscape Plan A

Scale: 1:100 @ A1 Job Number: Sheet_of_ 0 1 2 3 4 5m Drawing Number: Issue: L-101 B

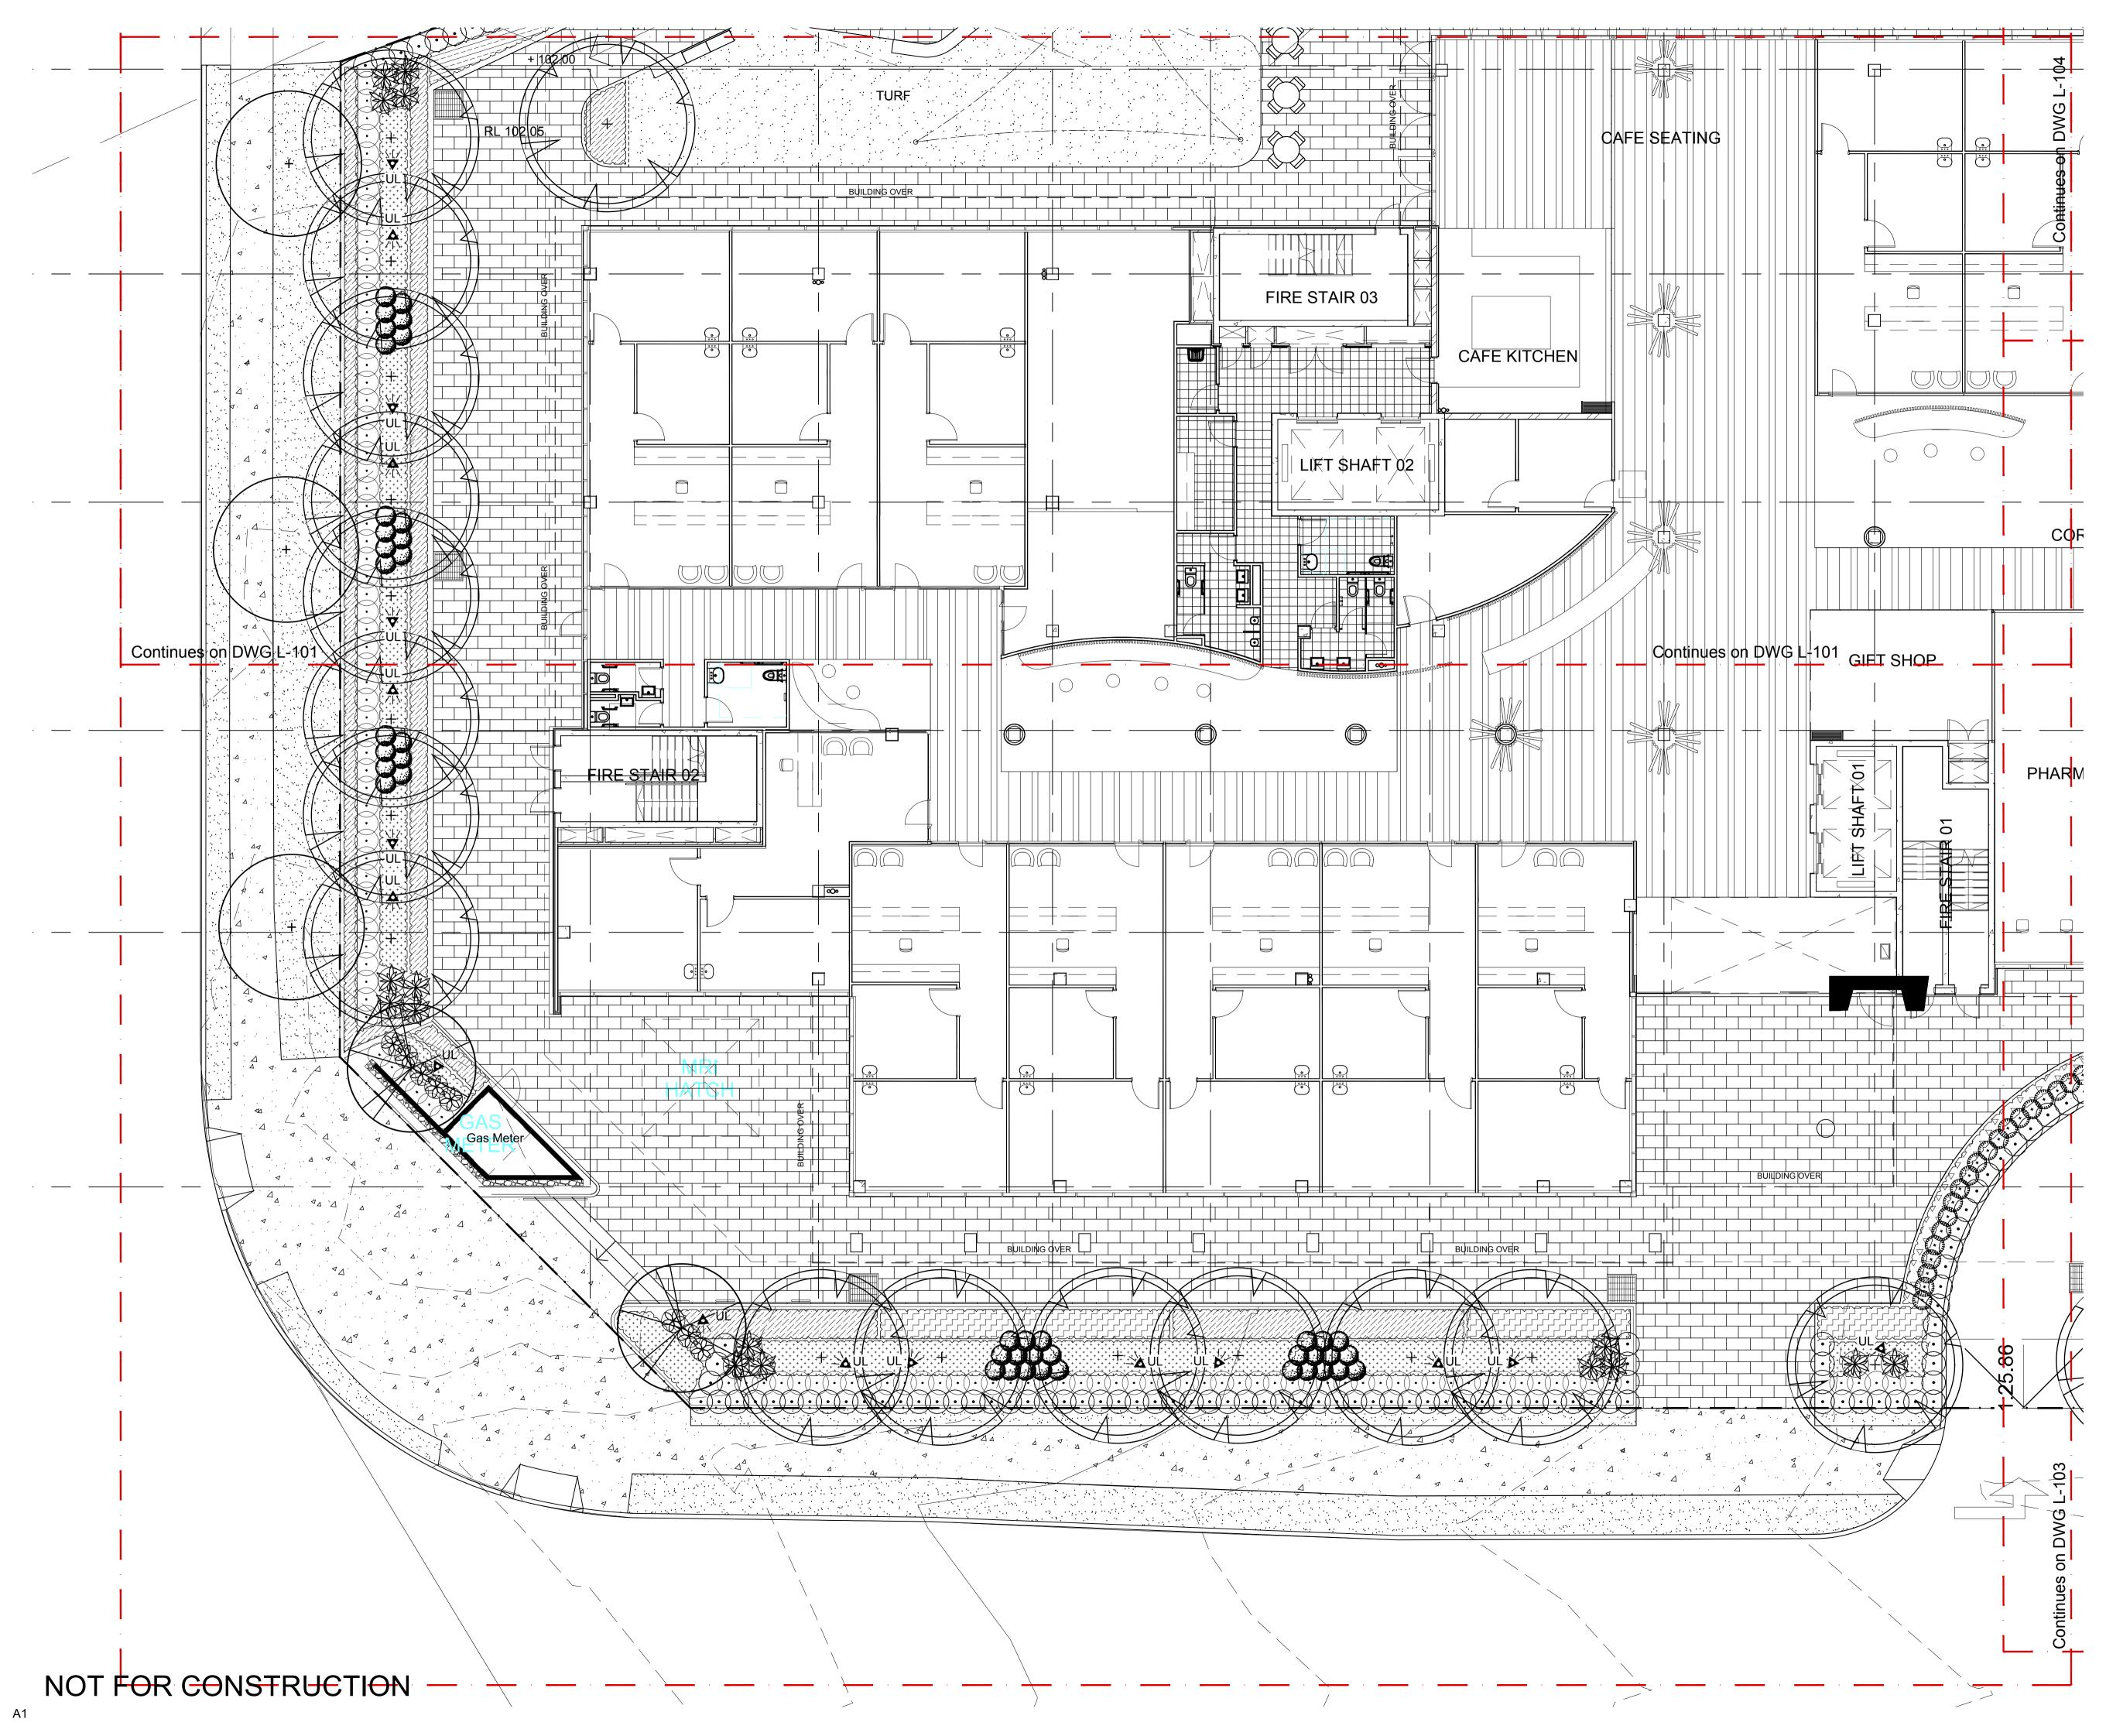

© 2018 Site Image (NSW) Pty Ltd ABN 44 801 262 380 as agent for Site Image NSW Partnership. All rights reserved. This drawing is copyright and shall not be reproduced or copied in any form or by any means (graphic, electronic or mechanical including photocopy) without the written permission of Site Image (NSW) Pty Ltd Any license, expressed or implied, to use this document for any purpose what so ever is restricted to the terms of the written agreement between Site Image (NSW) Pty Ltd and the instructing party.

The contractor shall check and verify all work on site (including work by others) before commencing the landscape installation. Any discrepancies are to be reported to the Project Manager or Landscape Architect prior to commencing work. Do not scale this drawing. Any required dimensions not shown shall be referred to the Landscape Architect for confirmation.

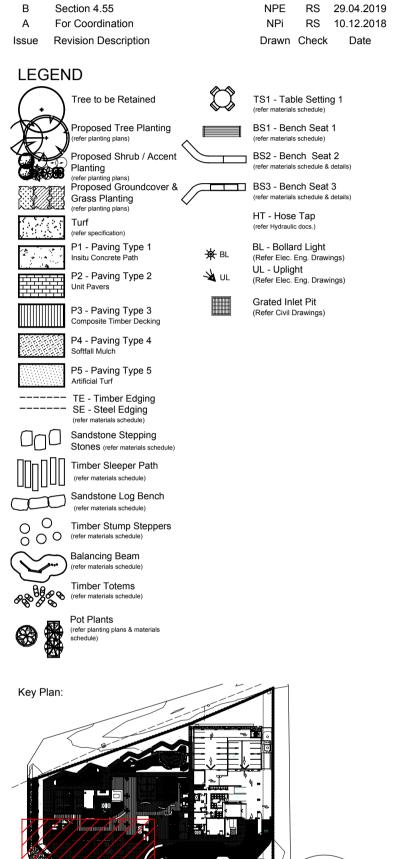

Client: Hermitage Healthcare Pty Ltd

Anthony Vavayis + Associates

Project:

Hermitage Health Care Lot 832 & 833, Cnr Hermitage Way & Gregory Hills Drive, Gledswood Hill

Level 1, 3-5 Baptist Street Redfern NSW 2016 Australia

Tel: (61 2) 8332 5600 Fax: (61 2) 9698 2877 www.siteimage.com.au Site Image (NSW) Pty Ltd ABN 44 801 262 380





SECTION 4.55

Drawing Name:

Landscape Plan B

Scale: 1:100 @ A1 Job Number:

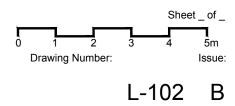

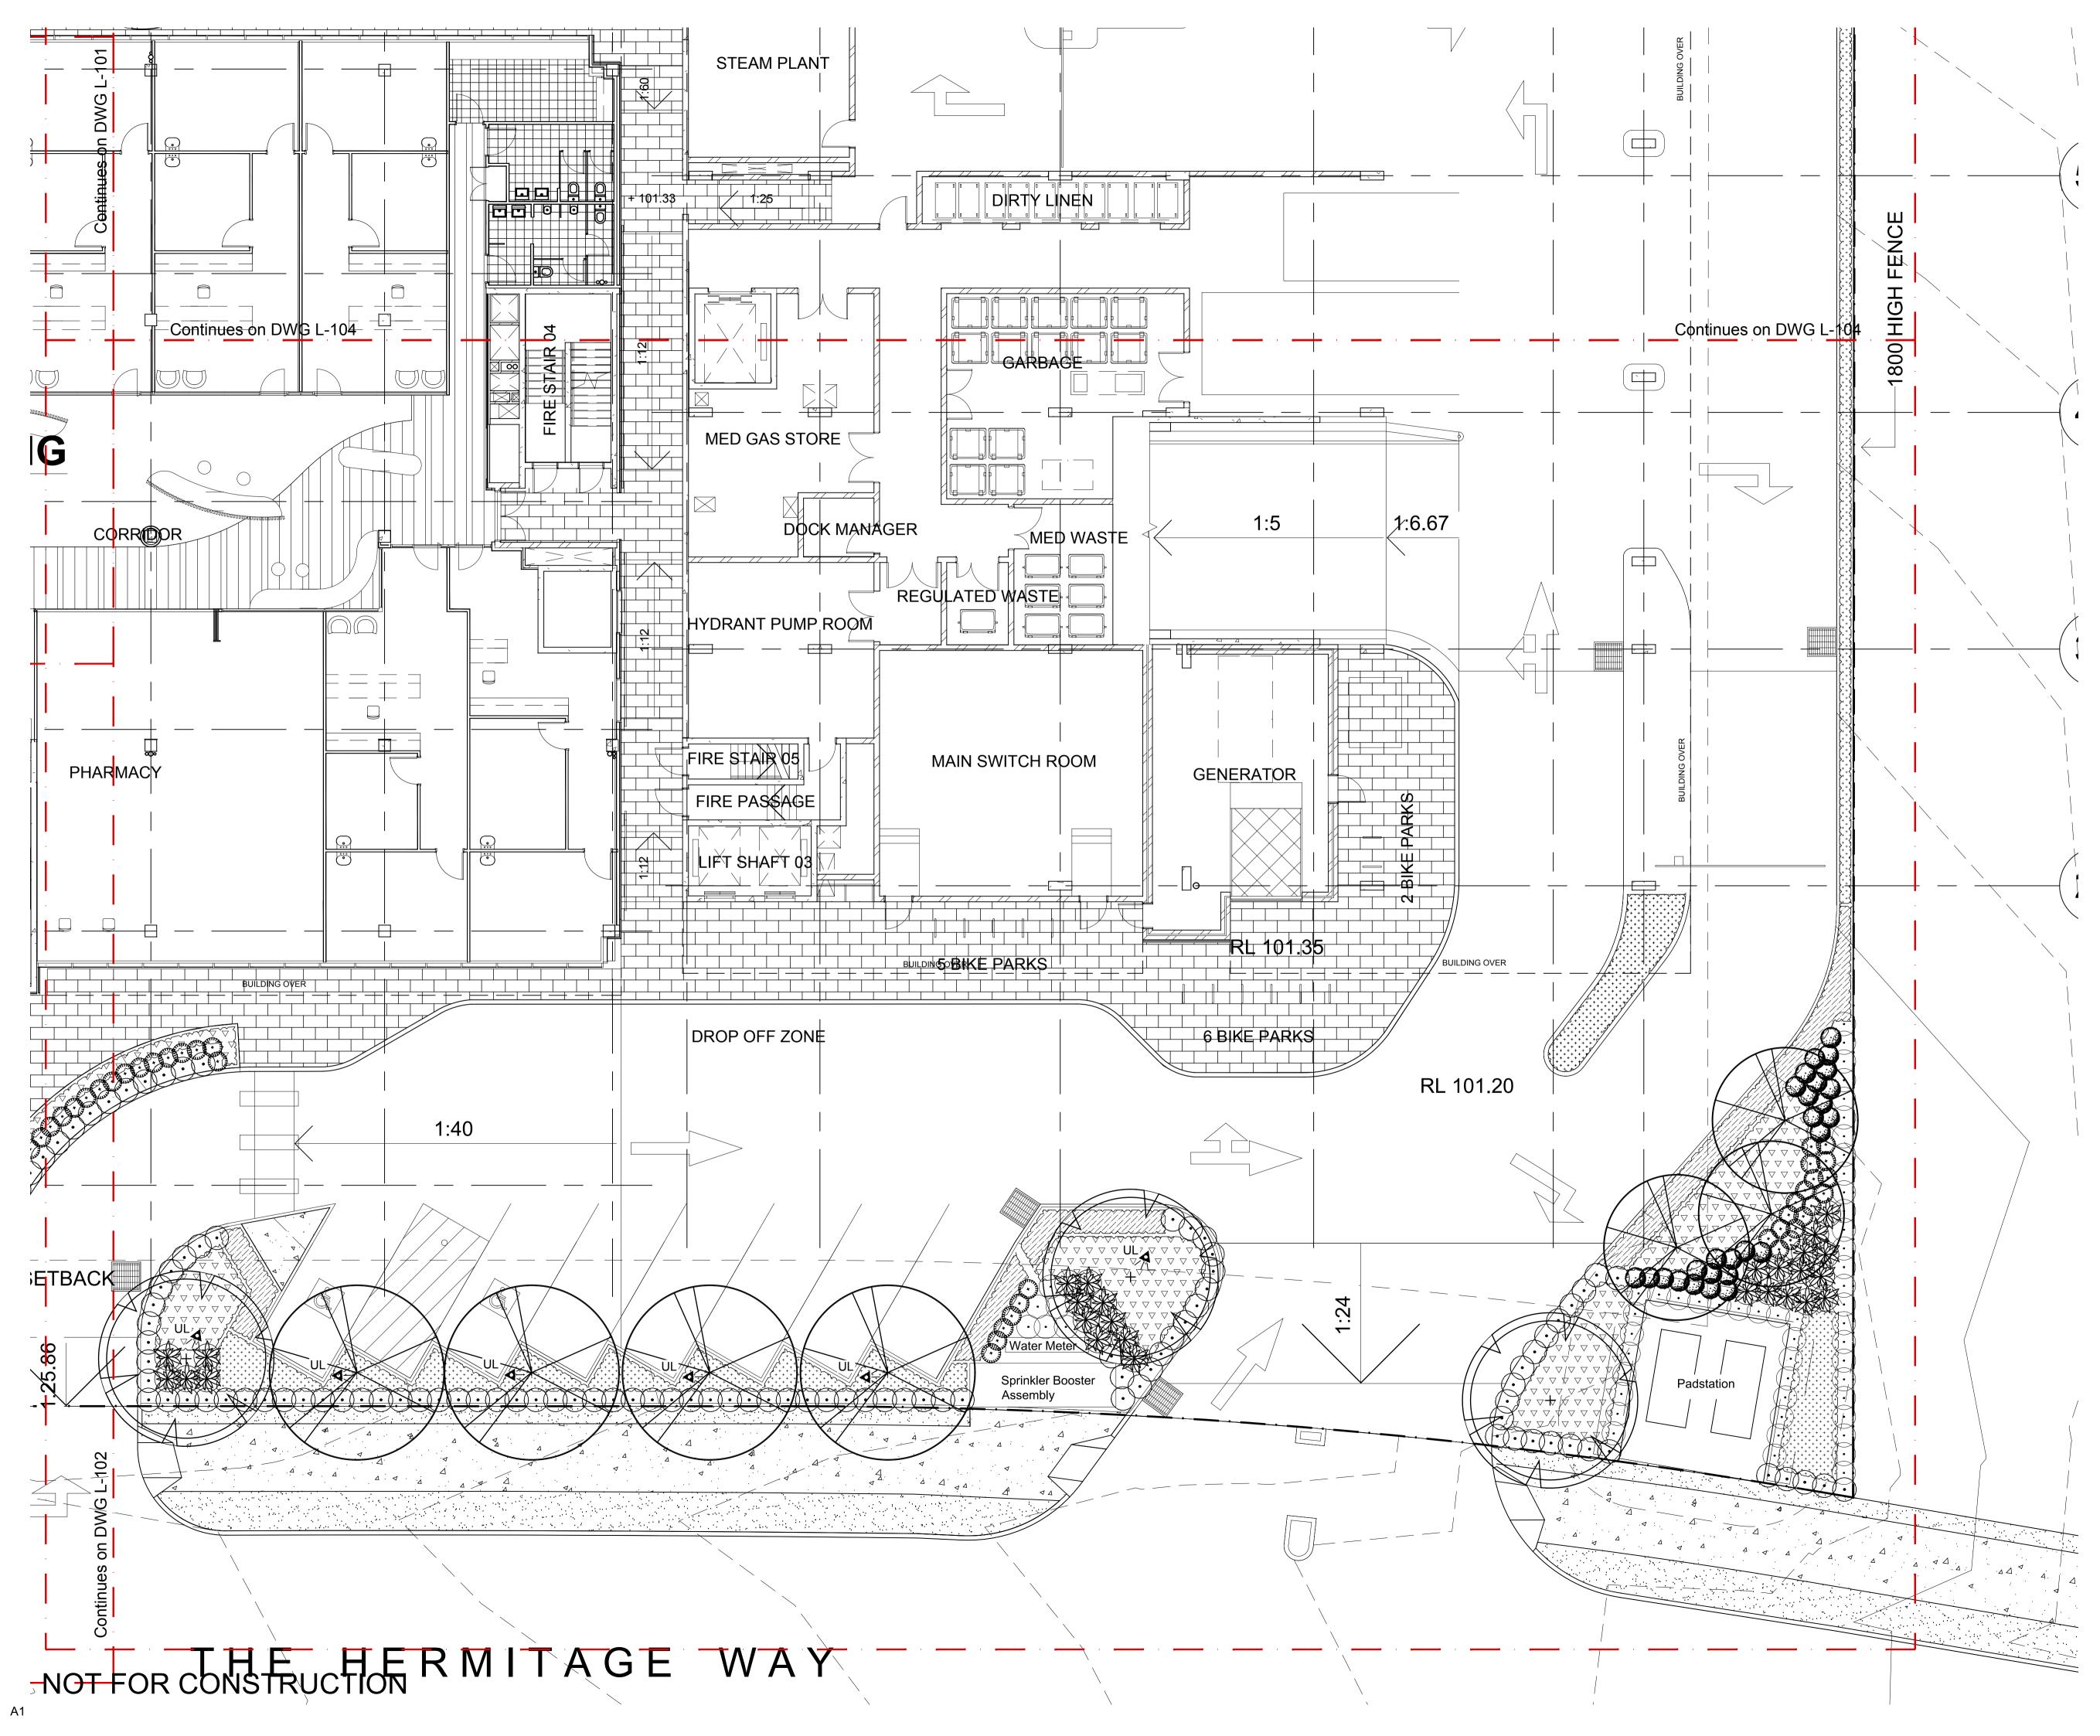

© 2018 Site Image (NSW) Pty Ltd ABN 44 801 262 380 as agent for Site Image NSW Partnership. All rights reserved. This drawing is copyright and shall not be reproduced or copied in any form or by any means (graphic, electronic or mechanical including photocopy) without the written permission of Site Image (NSW) Pty Ltd Any license, expressed or implied, to use this document for any purpose what so ever is restricted to the terms of the written agreement between Site Image (NSW) Pty Ltd and the instructing party.

The contractor shall check and verify all work on site (including work by others) before commencing the landscape installation. Any discrepancies are to be reported to the Project Manager or Landscape Architect prior to commencing work. Do not scale this drawing. Any required dimensions not shown shall be referred to the Landscape Architect for confirmation.

	ection 4.55 or Coordination		NPE NPi	RS RS	29.04.2019 10.12.2018
	vision Description		Drawn		Date
LEGEN	ND				
(\cdot)	Tree to be Retained		TS1 - Tat (refer material		g 1
	Proposed Tree Planting (refer planting plans)		BS1 - Ber (refer material		1
	Proposed Shrub / Accent Planting (refer planting plans)		BS2 - Ber (refer material		
	Grass Planting plans) (refer planting plans)		BS3 - Ber (refer material		
	Turf (refer specification)		HT - Hose (refer Hydrauli		
	P1 - Paving Type 1 Insitu Concrete Path	读 BL	BL - Bolla (Refer Elec. UL - Uplic	Eng. Draw	ings)
	P2 - Paving Type 2 Unit Pavers		(Refer Elec.	Eng. Draw	ings)
	P3 - Paving Type 3 Composite Timber Decking		Grated In (Refer Civil I		
	P4 - Paving Type 4 Softfall Mulch				
	P5 - Paving Type 5 Artificial Turf				
	TE - Timber Edging SE - Steel Edging (refer materials schedule)				
000	Sandstone Stepping Stones (refer materials schedule)				
	Timber Sleeper Path (refer materials schedule)				
	Sandstone Log Bench (refer materials schedule)				
$\begin{array}{c} 0 \\ 0 \\ 0 \\ 0 \end{array}$	Timber Stump Steppers (refer materials schedule)				
$\langle \rangle$	Balancing Beam (refer materials schedule)				
AS BEES	Timber Totems (refer materials schedule)				
89	Pot Plants (refer planting plans & materials schedule)				
Key Plan:					

Client: Hermitage Healthcare Pty Ltd

Architect: Anthony Vavayis + Associates

Hermitage Health Care Lot 832 & 833, Cnr Hermitage Way & Gregory Hills Drive, Gledswood Hill

Level 1, 3-5 Baptist Street Redfern NSW 2016 Australia

Tel: (61 2) 8332 5600 Fax: (61 2) 9698 2877 www.siteimage.com.au Site Image (NSW) Pty Ltd ABN 44 801 262 380





SECTION 4.55

Drawing Name:

Landscape Plan C

Scale: 1:100 @

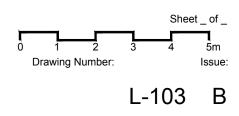

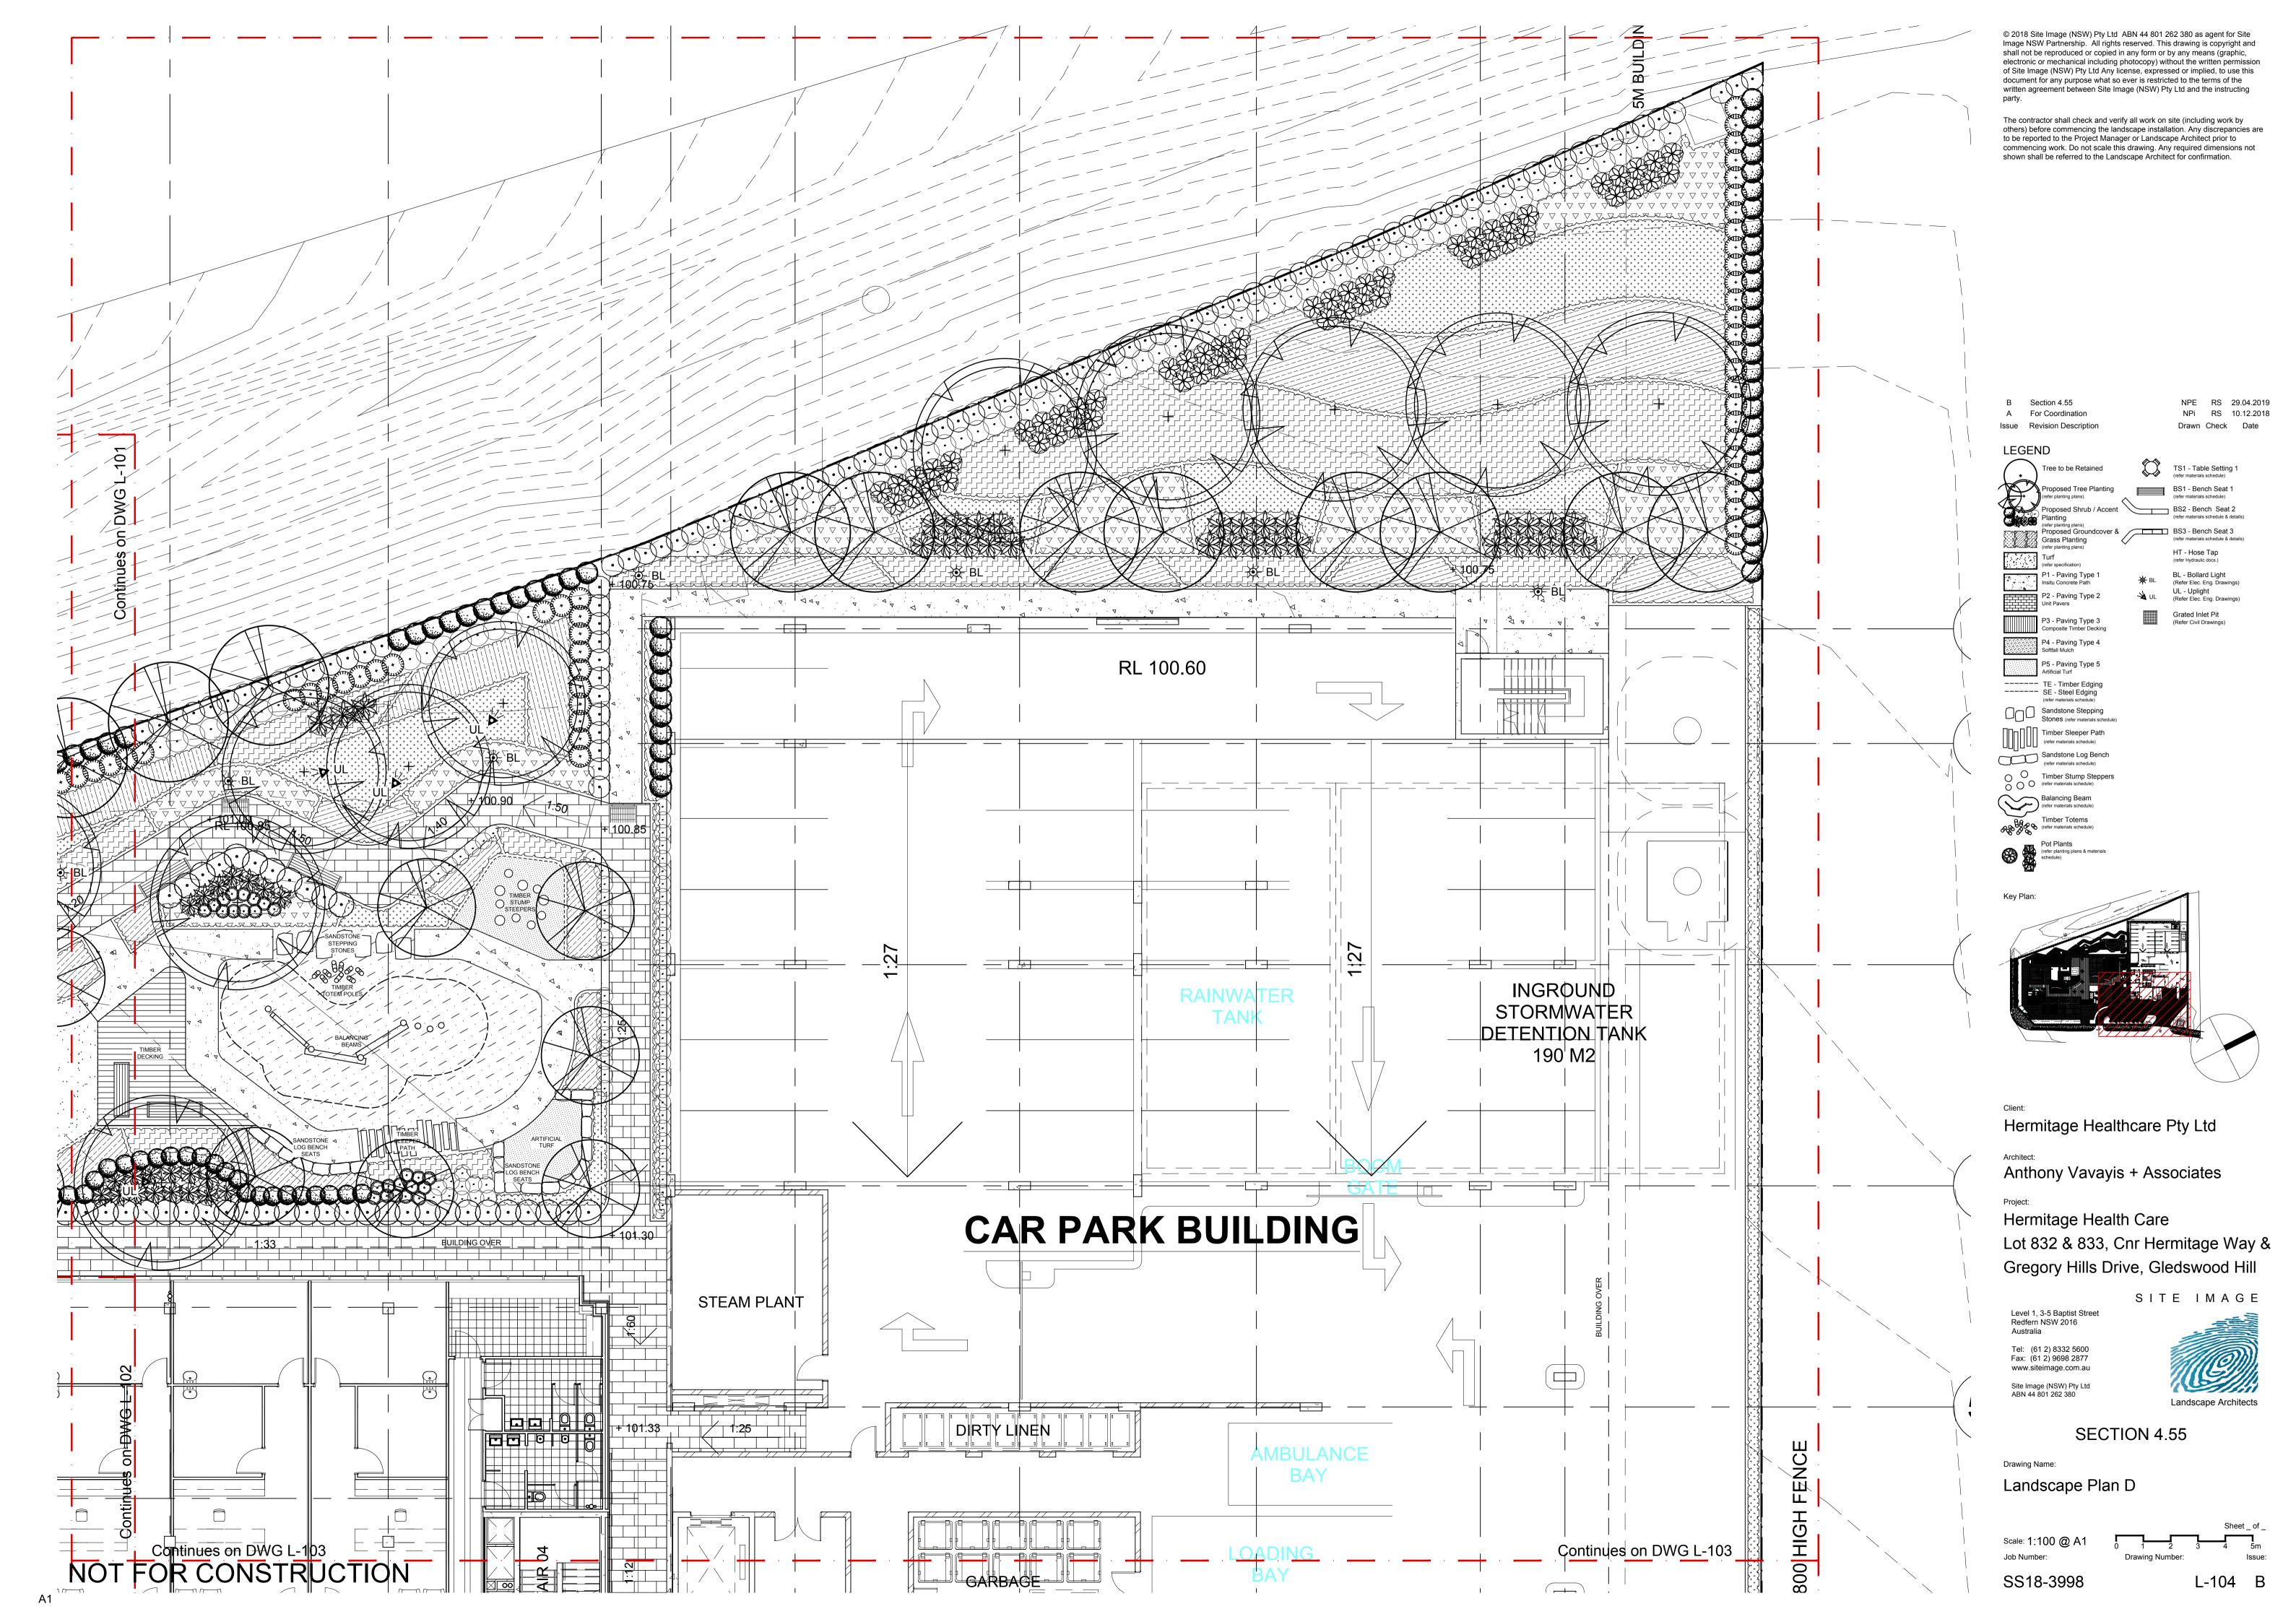

SPECIFICATION - GENERAL NOTES

References

All plans and details included in the project documents shall be read in conjunction with this specification. All structural and civil works components of the landscape design shall be referenced to engineers' details and specifications. Read this specification in conjunction with the plant and materials schedules on the drawings. If in doubt about any detail or if conflicts are found in the documents, seek advice.

Workmanship and Materials

The whole of the landscape works shall be carried out by a competent, trained and qualified landscape contractor who is experienced in horticultural practices, landscape construction and planting techniques. The landscape contractor shall hold a current Building Contractors License and/or be a financial member of LNA Landscape Association NSW & ACT or equivalent organisations in other states.

EXISTING TREES AND SHRUBS

Trees and Shrubs to be Retained and Protected

Identify and mark trees and shrubs to be retained using a suitable non-injurious, easily visible and removable means of identification. Protect from damage the trees and shrubs to be retained, including those beyond the site area, both above and below the ground. If a tree becomes damaged during the works or it is proposed to perform work on a tree, give written notice immediately and obtain instructions.

Work Near Trees and Shrubs

Keep the area of the drip-line free from construction material and debris. Do not place bulk materials and harmful materials under foliage canopies or near trees. Do not place spoil from excavations against tree trunks. Prevent wind-blown building materials, such as cement, from covering trees and other plants. Do not remove topsoil from, or add topsoil to, the area within the drip-line of trees.

EARTHWORKS

Excavation, Trimming and Filling

Except as otherwise noted in the contract, bulk excavation is excluded from the landscape works. After the completion of bulk excavation by others, trim and fill the excavated ground surfaces to achieve design levels to accommodate finish materials as detailed. Prepare the sub-grade surface as required for the various finished ground treatments.

Sub-soil Drainage

Keep the excavated works drained and free of standing water. Allow to supply and install sub-soil drainage pipes as required for the new works to ensure that all gardens are well drained. Connect the sub-soil drainage pipes to the nearest downstream stormwater pits. Include pipe filter socks and course sharp aggregate backfilling of trenches.

HARDWORKS

Furniture, Handrails, Balustrades

Supply and install the scheduled items in accordance with the manufacturer's recommendations, as detailed and in the locations shown on plan. Provide all footings and fixings required for the items to be stable and in accordance with applicable codes and standards.

Garden Walls, Fences, Steps, TGSI and Edging

Construct garden walls, fences, steps, TGSI and edging as shown on plan, as detailed and of the material scheduled. Provide footings, step nosings, tactile surfaces to comply with Australian Standards and applicable legislation. Refer to engineer's details for structural retaining walls, concrete stairs, concrete strength, reinforcing and joint placement.

Continuous, Unit and Loose Pavement

Install the scheduled material pavement to the locations shown on plan. Ensure that all subgrade/subsurface works are complete prior to commencing paving. Confer with the engineer to ensure the structural integrity of the subgrade. Ensure that the base course under paved surfaces is a continuous plane offering a constant depth of bedding material not exceeding 50mm. If laying unit pavers in a cement mortar bed on a concrete sub-base ensure that joints in paving match the location of joints in the concrete. Refer to engineer's details for heavy duty slabs, concrete stairs, concrete strength, reinforcing, and joint type and placement.

SOFTWORKS

Site Soil Testing Where site soil is to be retrieved from site and stored on site for reuse, undertake at least two (2) soil tests in locations as advised by the Project Manager or as shown on the plans. Provide results and recommendations regarding soil additives for the benefit of healthy plant growth and to adjust the soil components to achieve an appropriate planting medium for successful plant development.

Subsoil

Excavate and/or fill all garden beds to bring the top of subsoil to at least 300mm below finished design soil levels. Excavate all turf areas to bring the subsoil to at least 100mm below finished design levels. In all areas shape the subsoil to fall to subsoil drains where applicable. Do not excavate within the drip line of trees and shrubs to be retained. Cultivate or rip the subsoil to a further depth of 100mm before placing top soil. Remove stones of size exceeding 25mm, clods of earth exceeding 50mm, and weeds, rubbish or other deleterious material brought to the surface during cultivation. Do not disturb services or existing tree roots. If necessary cultivate these areas by hand. During cultivation, thoroughly mix in materials required to be incorporated into the subsoil, as recommended in the soil testing results and to manufacturer's recommendations. Trim the surface to design levels again after cultivation.

Topsoil

Import topsoil for the garden and turf areas, unless the topsoil can be provided from material recovered from the site, as recommended in the soil testing results. Spread the topsoil on the prepared subsoil and grade evenly, compact lightly and uniformly in 150mm layers. Avoid differential subsidence and excess compaction and produce a finished topsoil surface which has the following characteristics:

• Finished to design levels, allowing for mulch or turf, which is to finish flush

with adjoining hard surfaces such as paths and edges;

- Smooth and free from inorganic matter, stones or clods of soil;
 Graded to drain freely, without ponding, to catchment and/or sub-soil drains:
- Graded evenly to adjoining surfaces; and

Compost

• Ready for planting.

Provide, in accordance with AS 4454, well rotted vegetative material or animal manure, free from harmful chemicals, inorganic matter, grass, weeds and the reproductive parts of unwanted plants.

Fertiliser

Provide proprietary fertilisers, delivered to the site in sealed containers marked to show manufacturer or vendor, weight, fertiliser type, N:P:K ratio, recommended uses, application rates and safety procedures. Apply appropriate fertiliser suited to the provenance of plants (indigenous or exotic) included in the design.

Plants

Supply plants in accordance with the landscape design drawings and schedules, which have the following characteristics:

- Large healthy root systems, with no evidence of root curl, restriction or damage;
- Vigorous, well established, free from disease and pests, of good form consistent with the species/variety;
- Hardened off, not soft or forced, and suitable for planting in the natural climatic conditions prevailing at the site in full sun, partial shade or full shade conditions;
- Grown in final containers for not less than twelve weeks;
 Trees, unless required to be multi-stemmed, shall have a single leading shoot; and
- Containers shall be free from weeds and of appropriate size in relation to the specified plant size.

Plant Installation

Following excavation of the planting hole, place and spread 15gms of wetting agent pre-mixed with one (1) litre of water. Place the plant correctly orientated to north or for best presentation. Backfill the planting holes with specified topsoil mixture. Lightly tamp and water to eliminate air pockets. Ensure that the backfill soil is not placed over the top of the root ball and that the root ball is not higher than the soil in which it is planted. Apply fertiliser, as specified around the plants in the soil at the time of planting.

Root Barrier

Supply and install root control barriers to all new tree plantings adjacent to walls, paths, kerbs and all service trenches, where their proximity poses a threat to the stability of the built infrastructure. Install in accordance with manufacturer's recommendations.

Mulch

Unless noted otherwise, mulch shall be approved Forest Fines bark material, sourced from Australian Native Landscapes or approved equivalent. Place mulch in all garden beds to a depth of 75mm after all specified plants are installed. Keep mulch clear of all plant stems and rake to an even plane, flush with the surrounding surfaces evenly graded between design surface levels. Over fill to allow mulch to settle to the specified depth.

Stakes and Ties

Stakes shall be durable hardwood, straight, free of knots and twists, pointed at one end, in the following quantities and sizes for each of the various plant pot sizes:

- Plants >25 lt: 1 off 38 x 38 x 1200mm;
- Semi-advanced plants >75 lt: 2 off 50x50x 1800mm;
- Advanced plants \geq 100 lt: 3 off 50 x 50 x 2400mm.

Turf

Turf shall be delivered to site as 25mm minimum thick cut rolls. Obtain turf from a specialist grower of cultivated turf. Turf shall have an even thickness, free from weeds and other foreign matter. Deliver turf to the site within 24 hours of being cut and lay it within 24 hours of delivery. Prevent it form drying out between cutting and laying. Lay the turf in the following manner:

- In stretcher pattern, joints staggered and close butted;
 Parallel long sides of level areas, with contours on slopes; and
- To finish flush, after lightly tamping, with adjacent finished surfaces and design levels.

Species: Stenotaphrum secundatum Sir Walter Soft-leaf Buffalo.

IRRIGATION

Scope: Unless otherwise noted or instructed irrigate all planted areas shown on plans including planters, tubs, gardens, turf and the like. The irrigation system shall be an automatic permanent system, with an irrigation controller self operated via a soil moisture sensor. The system shall be calibrated to deliver the optimum rate and volume of water appropriate to the type of plants in the design. The system shall be adjustable and fully serviceable. The layout of the entire irrigation system shall focus on delivering the required amount of water to maintain healthy and vigorous growth. The irrigation system shall be such that, component theft, vandalism, over-spray and wetting of paths shall be reduced to a minimum or completely eliminated by the use of drip, pop-up sprinklers and judiciously placed fixed spray emitters. Generally do not use fine mist emitters that provide a drifting mist that may wet paths and the buildings unless specifically required by the design.

LANDSCAPE MAINTENANCE

The Landscape Contractor shall rectify defects during installation and that become apparent in the works under normal use for the duration of the contract Defects Liability Period. Unless contracted otherwise, the Landscape Contractor shall maintain the contract areas by the implementation of industry accepted horticultural practices for 52 weeks from Practical Completion of the works. The landscape maintenance works shall include, but not be limited to:

- Replacing failed plants;
 Pruning;
- Pruning; Insect and pest control;
- Fertilising;
- Maintaining and removing stakes and ties;
- Maintaining mulch;

- Mowing and top dressing;
- Irrigation and watering;
- Erosion control; and
 Weeding and rubbish removal.

Maintenance Log Book

Implement and keep a maintenance log book recording when and what maintenance work has been undertaken and what materials, actions and decisions have been used, implemented and concluded to keep the landscape always looking its best. Enter data daily and review information every 2 weeks. Observe trends and develop a maintenance regime around seasonal and observed event occurrences.

ers Maintenance Activities

During the defects maintenance period schedule the following activities to occur on a timely basis.

- Plant replacement Replace plants that have failed to mature, die or are damaged. Replacement plants shall be in a similar size and quality and identical species or variety to the plant that has failed. Replacement of plants shall be at the cost of the landscape contractor unless advised otherwise. If the cause of the failure is due to a controllable situation then correct the situation prior to replacing plants. Observe and replace failed plants within 2 weeks of observation.
- Pruning Prune dead wood, broken limbs, dead or infected foliage and as needed to develop strong, healthy plants to achieve the shape and form expected of the plant type. Observe daily and prune plants on a needs basis.
- Insect, disease and pest control Avoid spraying:
 o if ever possible;
- o in wet weather or if wet weather is imminent;
- if target plants are still wet after rain;
- in windy weather; and
- if non-target species are too close.
 Immediately report to the Project Manager any evidence of intensive weed infestation, insect attack or disease amongst plant material. Submit all proposals to apply chemicals and obtain approval before starting this work. When approved, spray with herbicide, insecticide, fungicide as appropriate in accordance with the manufacturers' recommendations. Observe daily and act as necessary to control any infestation or disease. Record in the logbook all relevant details of spraying activities including:
 Product brand / manufacturer's name,
- Chemical / product name,
- Chemical contents,
- Application quantity and rate,
- Date of application and location,
 Results of application, and
- Use approval authority.
- Fertilising Fertilise gardens with a proprietary slow release fertiliser applied in accordance with the manufacturer's directions and recommendations. Apply 6-12 monthly. Record in the logbook all relevant details of fertilising including:
- Product brand / manufacturer's name,
- Fertiliser / product name,
- Application quantity and rate, and
- Date of application and location.
- Stakes and ties Adjust and replace as required to ensure plants remain correctly staked. Remove those not required at the end of the planting establishment period (Defects Liability Period). Inspect and act at least every 2 weeks.
- Maintaining mulch Maintain the surface in a clean, tidy and weed free condition and reinstate the mulch as necessary to ensure correct depth as specified. Observe weekly and replenish mulch as required.
- Mowing and top dressing Mow the turf to maintain a grass height of between 30-50mm. Do not remove more than one third of the grass height at any one time. Remove grass clippings from the site after each mowing. Top dress to a maximum of 10mm to fill depressions and hollows in the surface. Mow weekly/fortnightly in warmer months. Mow monthly or as required in cooler months. Top dress at approximately 6 monthly intervals.
- Irrigation and watering Maintain the irrigation system to sure that each individual plant receives the required amount of water to maintain healthy and vigorous growth. Adjust and calibrate as required. Provide additional watering, if necessary but inspect irrigation weekly and make repairs as necessary.
- Erosion control Where necessary, maintain the erosion control fabric in a tidy and weed free condition and reinstate as necessary to ensure control measures are effective where deemed necessary. Inspect every 2 weeks and act to repair any damage as soon as possible.
- Weeding and rubbish removal During the plant establishment period remove by hand, rubbish and weed growth that may occur or re-occur throughout all planted, mulched and paved areas. The contractor shall target weeds that are capable of producing a major infestation of unwanted plants by seed distribution. Whenever possible, time weed removal to precede flowering and seed set. Constant observation and removal of weeds is essential.

SS18-3998 Hermitage Healthcare Gledswood Plant Schedule										
SYMBOL	BOTANIC NAME	COMMON NAME	MATURE SIZE	SPACING	POT SIZE					
OTMBOL			(h x w) (m)							
TREES			(11 × • •) (11)							
Ac	Angophora costata	Smooth Barked Apple	25.0 x 14.0	As Shown	200L					
As	Acmena smithii		12.0 x 6.0	As Shown	100L					
Bs	Banksia serrata	Old Man Banksia	4.0 x 3.0	As Shown	100L					
Cc	Casuarina cunninghamiana	River She Oak	12.0 x 7.0	As Shown	100L					
Ca	Cupaniopsis anacardioides	Tuckeroo	15.0 x 7.0	As Shown	200L					
Cc	Corymbia citriodora	Lemon Scented Gum	10.0 x 7.0	As Shown	100L					
Cg	Corymbia gummifera	Red Bloodwood	22.0 x 14.0	As Shown	200L					
Cm	Corymbia maculata	Grey Box	22.0 x 13.0	As Shown	200L					
Er	Elaeocarpus reticulatus	Blueberry Ash	10.0 x 5.0	As Shown	200L					
Em	Eucalyptus moluccana	Grey Box	25.0 x 10.0	As Shown	200L					
LiN	Lagerstroemia indica 'Natchez'	Natchez Crepe Myrtle	5.0 x 3.0	As shown	100L					
MLG	Magnolia grandiflora 'Little Gem'	Dwarf Magnolia	6.0 x 3.0	As Shown	100L					
MI	Melaleuca lineariifolia	Snow in Summer	8.0 x 4.0	As Shown	100L					
TIL	Tristaniopsis laurina 'Luscious'	Water Gum	8.0 x 6.0	As Shown	100L					
PcC	Pyrus calleryana 'Chanticleer'	Chanticleer Capital Pear	11.0 x 6.0	As Shown	200L					
					2002					
SHRUBS	I		1	1						
Aa	Asplenium australasicum	Birds Nest Fern	1.5 x 2.0	As Shown	300mm					
AiR	Alcantarea imperialis 'Rubra'	Imperial Bromeliad	1.0 x 1.0	As Shown	300mm					
Br	Banksia robour	Swamp Banksia	2.0 x 2.0	As Shown	300mm					
BJ	Buxus microphylla var. japonica	Japanese Box	1 x 0.5	As Shown	300mm					
Cmi	Clivia miniata	Kaffir Lilly	0.6 x 0.6	As Shown	300mm					
Cr	Cycas revoluta	Sago Palm	1.5 x 1.0	As Shown	300mm					
	Callistemon viminalis 'Macarthur'	Camellia	1.8 x 1.5	As Shown	300mm					
De	Doryanthes excelsa	Gymea Lilly	2.0 x 2.0	As Shown	300mm					
GRG	Grevillea 'Robyn Gordon'	Grevillea	1.5 x 1.5	As Shown	300mm					
la	Indigofera australis	Australian Indigo	2.0 x 2.0	As Shown	300mm					
Mt	Melaleuca thymifolia	Thyme Honey Myrtle	1.2 x 1.2	As Shown	300mm					
Мр	Murraya paniculata	Orange Jessamine	3.0 x 2.0	As Shown	300mm					
NdO	Nandina domestica 'Obsession'	Dwarf Sacred Bamboo	0.6 x 0.6	As Shown	300mm					
PBB	Phomium tenax 'Bronze Baby'	Bronze Baby NZ Flax	0.8 x 0.8	As Shown	300mm					
PDD Px	Philodendron xanadu	Xanadu	1.2 x 1.2	As Shown	300mm					
Re	Rhapis excelsa	Broad-Leaf Lady Palm	2.0 x 1.0	As Shown	300mm					
ROP	Rhaphiolepis indica 'Oriental Pearl'	Indian Hawthorn Oriental Pearl	1.5 x 1.0	As Shown	300mm					
RSM	Rhaphiolepis indica 'Snow Maiden'	Indian Hawthorn Snow Maiden	0.75 x 0.5	As Shown	300mm					
SIC	Syzygium luehmannii 'Cascade'			As Shown	300mm					
Vo	Viburnum odoratissimum	Lilly Pilly Sweet Viburnum	2.0 x 1.5 3.0 x 2.0	As Shown	300mm					
WfN	Westringia fruticosa 'Naringa'	Naringa Coastal Rosemary	1.2 x 1.0	As Shown	300mm					
Zf	Zamia furfuracea	Cardboard Cycad	1.2 x 1.0	As Shown	300mm					
21				AS SHOWIT	300mm					
	S & GROUNDCOVER PLANTING	Dia Dad Kanasara Da	10,40	E / 2	140					
ABR	Anigozanthos 'Big Red'	Big Red Kangaroo Paw	1.0 x 1.0	5/m²	140mm					
DLJ	Dianella caerulea 'Little Jess'	Little Jess blue flax Lilly	0.4 x 0.4	5/m²	140mm					
Dr	Dichondra repens	Kidney Weed	0.1 x 0.5	5/m²	140mm					
DSF	Dichondra argenta 'Silver Falls'	Silver Falls Kidney Weed	0.1 x 0.5	5/m²	140mm					
HvM	Hardenbergia violacea 'Meema'	Meema Purple Coral Pea	0.5 x 1.0	5/m²	140mm					
Hs	Hibbertia scandens	Snake Vine	0.5 x 1.0	5/m²	140mm					
LEG	Liriope muscari 'Evergreen Giant'	Just Right Lilly Turf	0.4 x 0.4	5/m²	140mm					
LT	Lomandra longifolia 'Tankia'	Tanika Mat Rush	0.8 x 0.8	As shown	140mm					
Mpa D - N	Myoporum parvifolium	Creeping Boobialla	0.1 x 1.0	5/m²	140mm					
PaN	Pennisetum alopecuroides 'Nafray'	Swamp Foxtail Grass	1.0 x 1.0	5/m²	140mm					
PPL	Pennisetum alopecuroides 'Purple Lea'	Purple Lea Swamp Foxtail	1.0 x 1.0	5/m²	140mm					
РрК	Poa poiformis 'Kingsdale'	Eskdale Tussock	0.9 x 0.6	5/m²	140mm					
Та	Themeda australis	Kangaroo Grass	0.7 x 0.5	3/m²	140mm					
Tj	Trachelospermum jasminoides	Star Jasmine	0.75 x 1	5/m²	140mm					
Turf		Sir Walter Buffallo								

© 2018 Site Image (NSW) Pty Ltd ABN 44 801 262 380 as agent for Site Image NSW Partnership. All rights reserved. This drawing is copyright and shall not be reproduced or copied in any form or by any means (graphic, electronic or mechanical including photocopy) without the written permission of Site Image (NSW) Pty Ltd Any license, expressed or implied, to use this document for any purpose what so ever is restricted to the terms of the written agreement between Site Image (NSW) Pty Ltd and the instructing party.

The contractor shall check and verify all work on site (including work by others) before commencing the landscape installation. Any discrepancies are to be reported to the Project Manager or Landscape Architect prior to commencing work. Do not scale this drawing. Any required dimensions not shown shall be referred to the Landscape Architect for confirmation.

B	Section 4.55	NPE		29.04.2019
A	For Coordination	NPi		10.12.2018
Issue	Revision Description	Drawn	Check	Date

LEGEND

Key Plan:

Client:

Hermitage Healthcare Pty Ltd

Anthony Vavayis + Associates

Project[.]

Hermitage Health Care Lot 832 & 833, Cnr Hermitage Way & Gregory Hills Drive, Gledswood Hill

Level 1, 3-5 Baptist Street Redfern NSW 2016 Australia

Tel: (61 2) 8332 5600 Fax: (61 2) 9698 2877 www.siteimage.com.au Site Image (NSW) Pty Ltd ABN 44 801 262 380



SECTION 4.55

Drawing Name:


Landscape Specification & Plant Schedule

Sheet _ of _


Scale: Job Number: SS18-3998

Drawing Number:

L-501 B

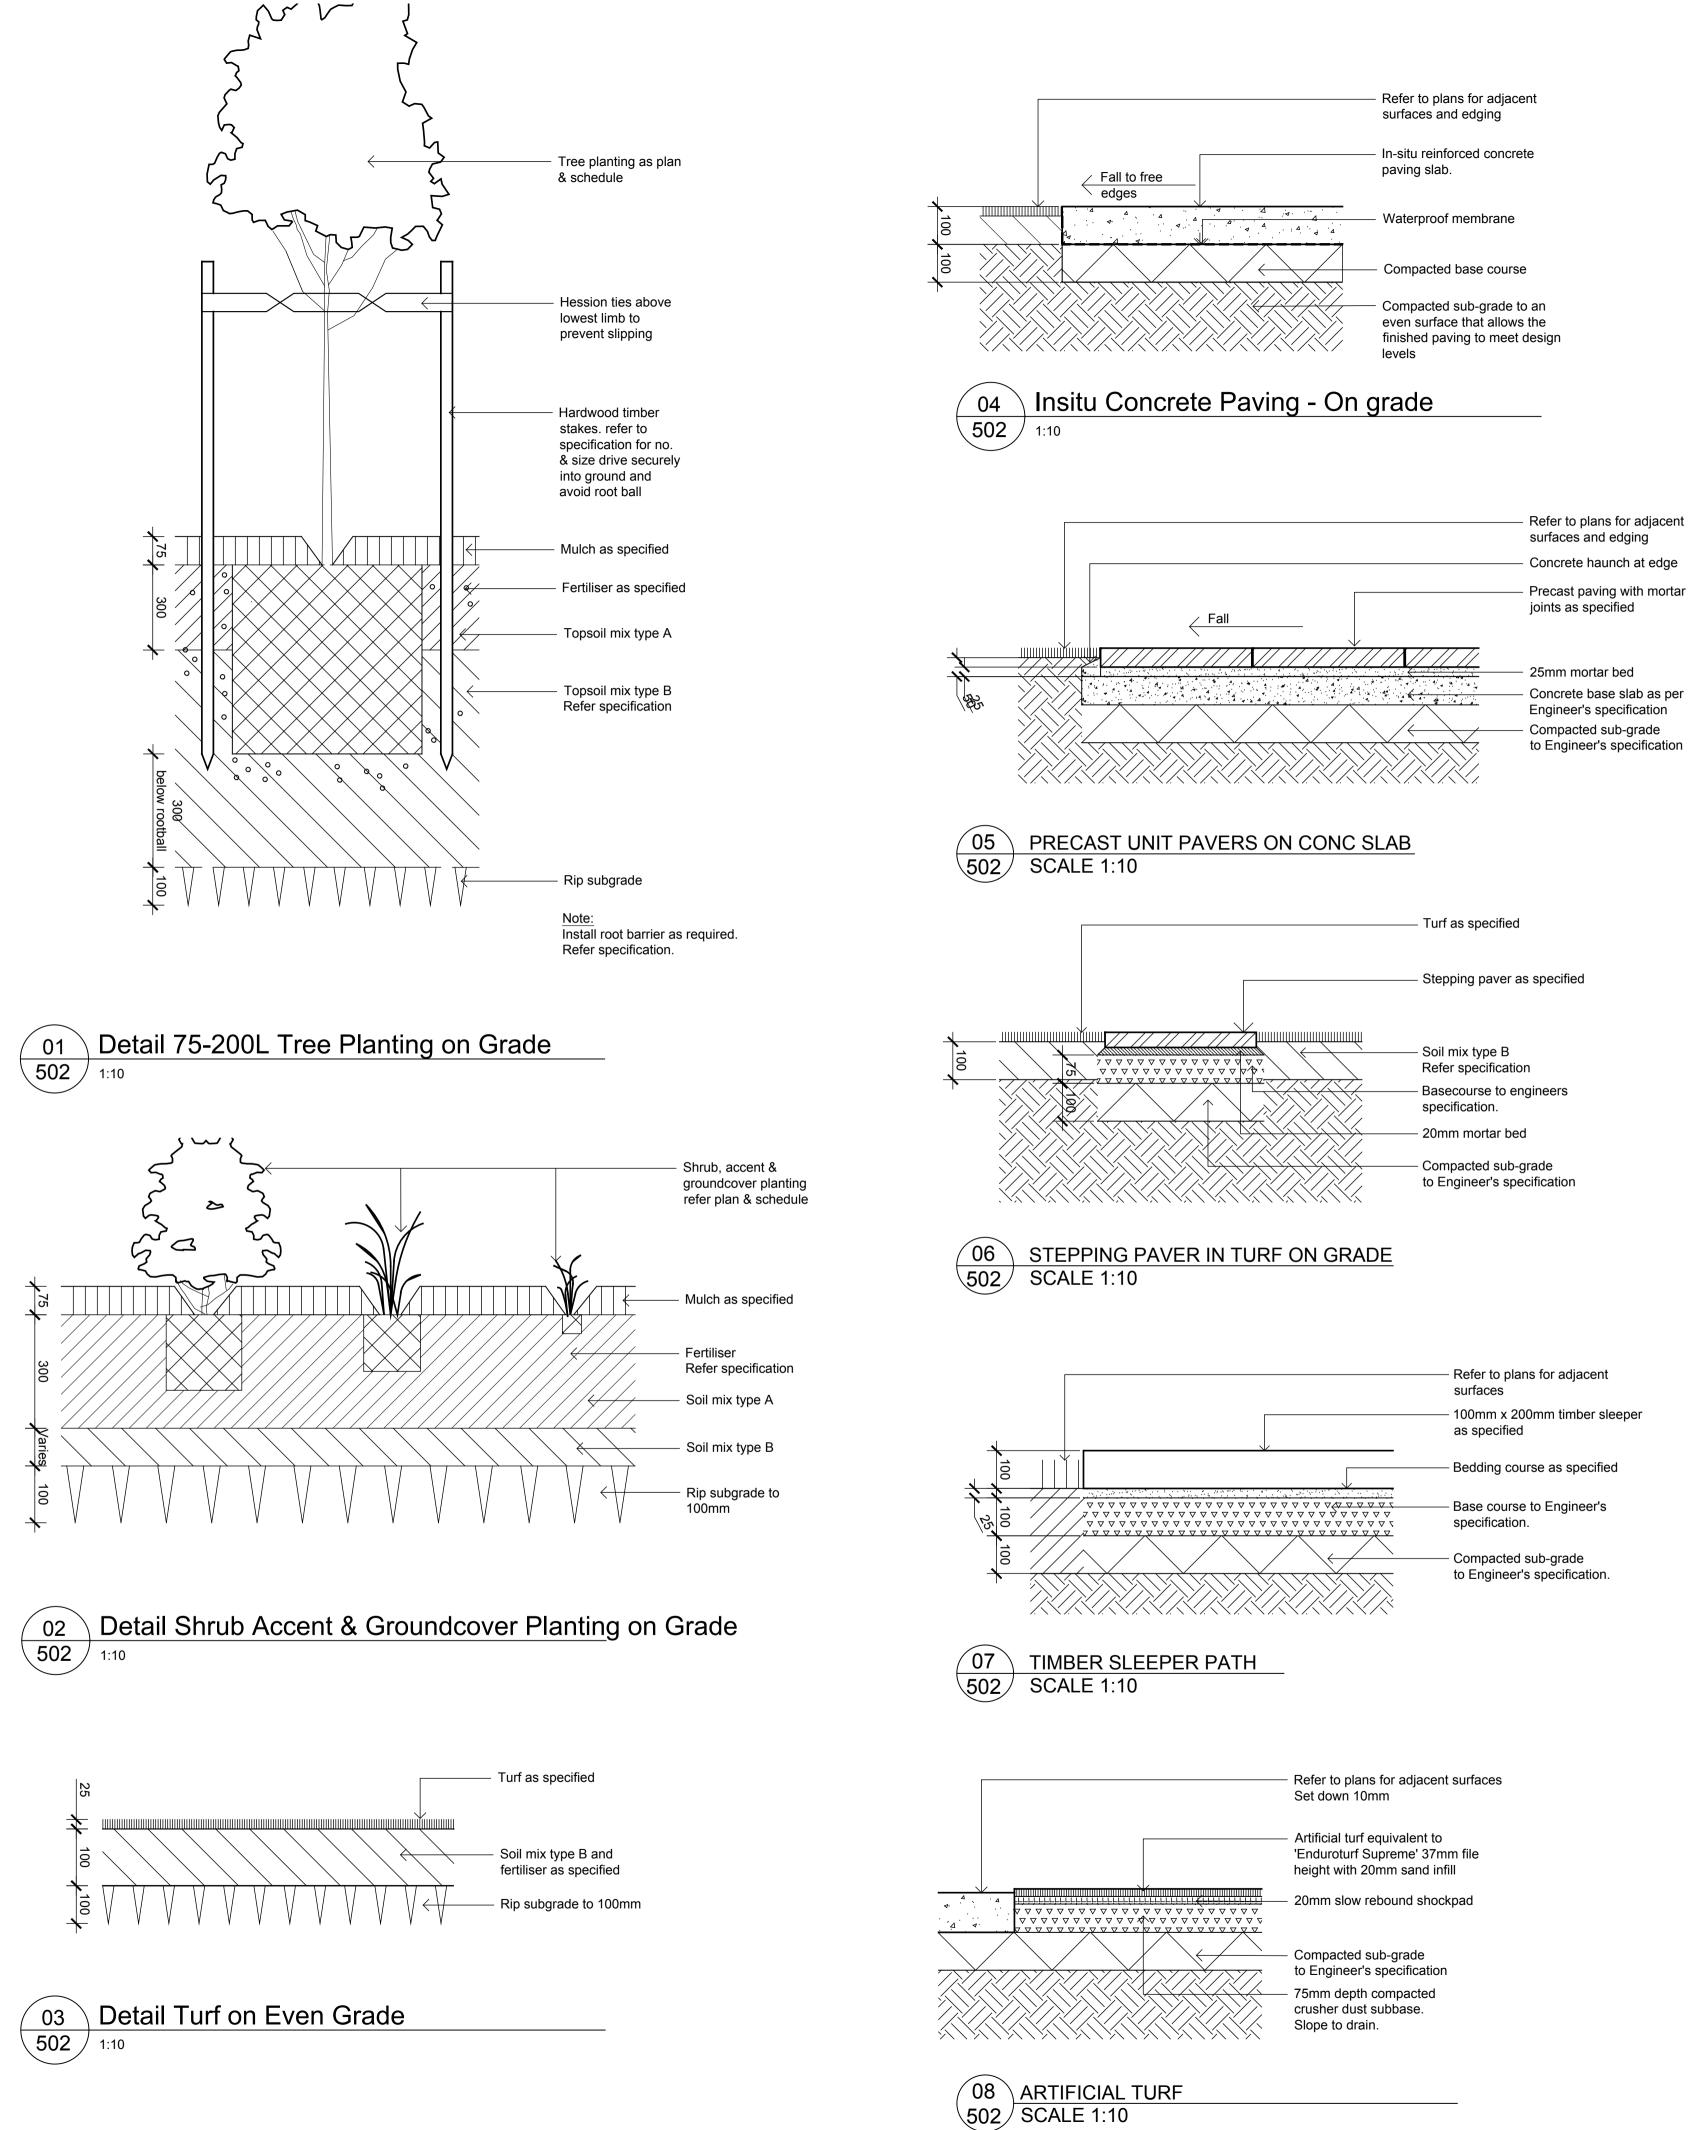

NOT FOR CONSTRUCTION

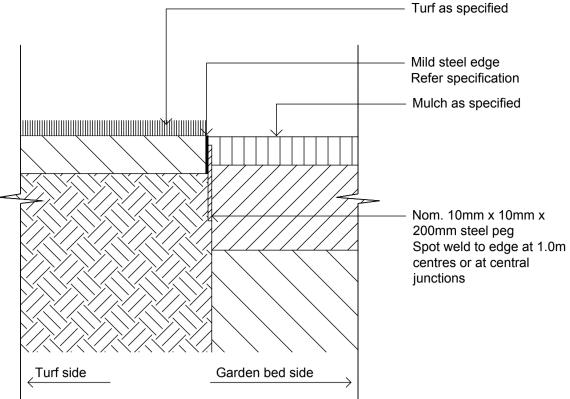



© 2018 Site Image (NSW) Pty Ltd ABN 44 801 262 380 as agent for Site Image NSW Partnership. All rights reserved. This drawing is copyright and shall not be reproduced or copied in any form or by any means (graphic, electronic or mechanical including photocopy) without the written permission of Site Image (NSW) Pty Ltd Any license, expressed or implied, to use this document for any purpose what so ever is restricted to the terms of the written agreement between Site Image (NSW) Pty Ltd and the instructing party.

The contractor shall check and verify all work on site (including work by others) before commencing the landscape installation. Any discrepancies are to be reported to the Project Manager or Landscape Architect prior to commencing work. Do not scale this drawing. Any required dimensions not shown shall be referred to the Landscape Architect for confirmation.

B Section 4.55 NPE RS 29.04.2019 NPi RS 10.12.2018 A For Coordination Issue Revision Description Drawn Check Date

LEGEND

Key Plan:

Client: Hermitage Healthcare Pty Ltd

Architect: Anthony Vavayis + Associates

Project: Hermitage Health Care Lot 832 & 833, Cnr Hermitage Way & Gregory Hills Drive, Gledswood Hill

Level 1, 3-5 Baptist Street Redfern NSW 2016 Australia

Tel: (61 2) 8332 5600 Fax: (61 2) 9698 2877 www.siteimage.com.au Site Image (NSW) Pty Ltd ABN 44 801 262 380



SECTION 4.55


Drawing Name:

Landscape Details

Scale: Job Number SS18-3998

L-502 B


Sheet _ of _

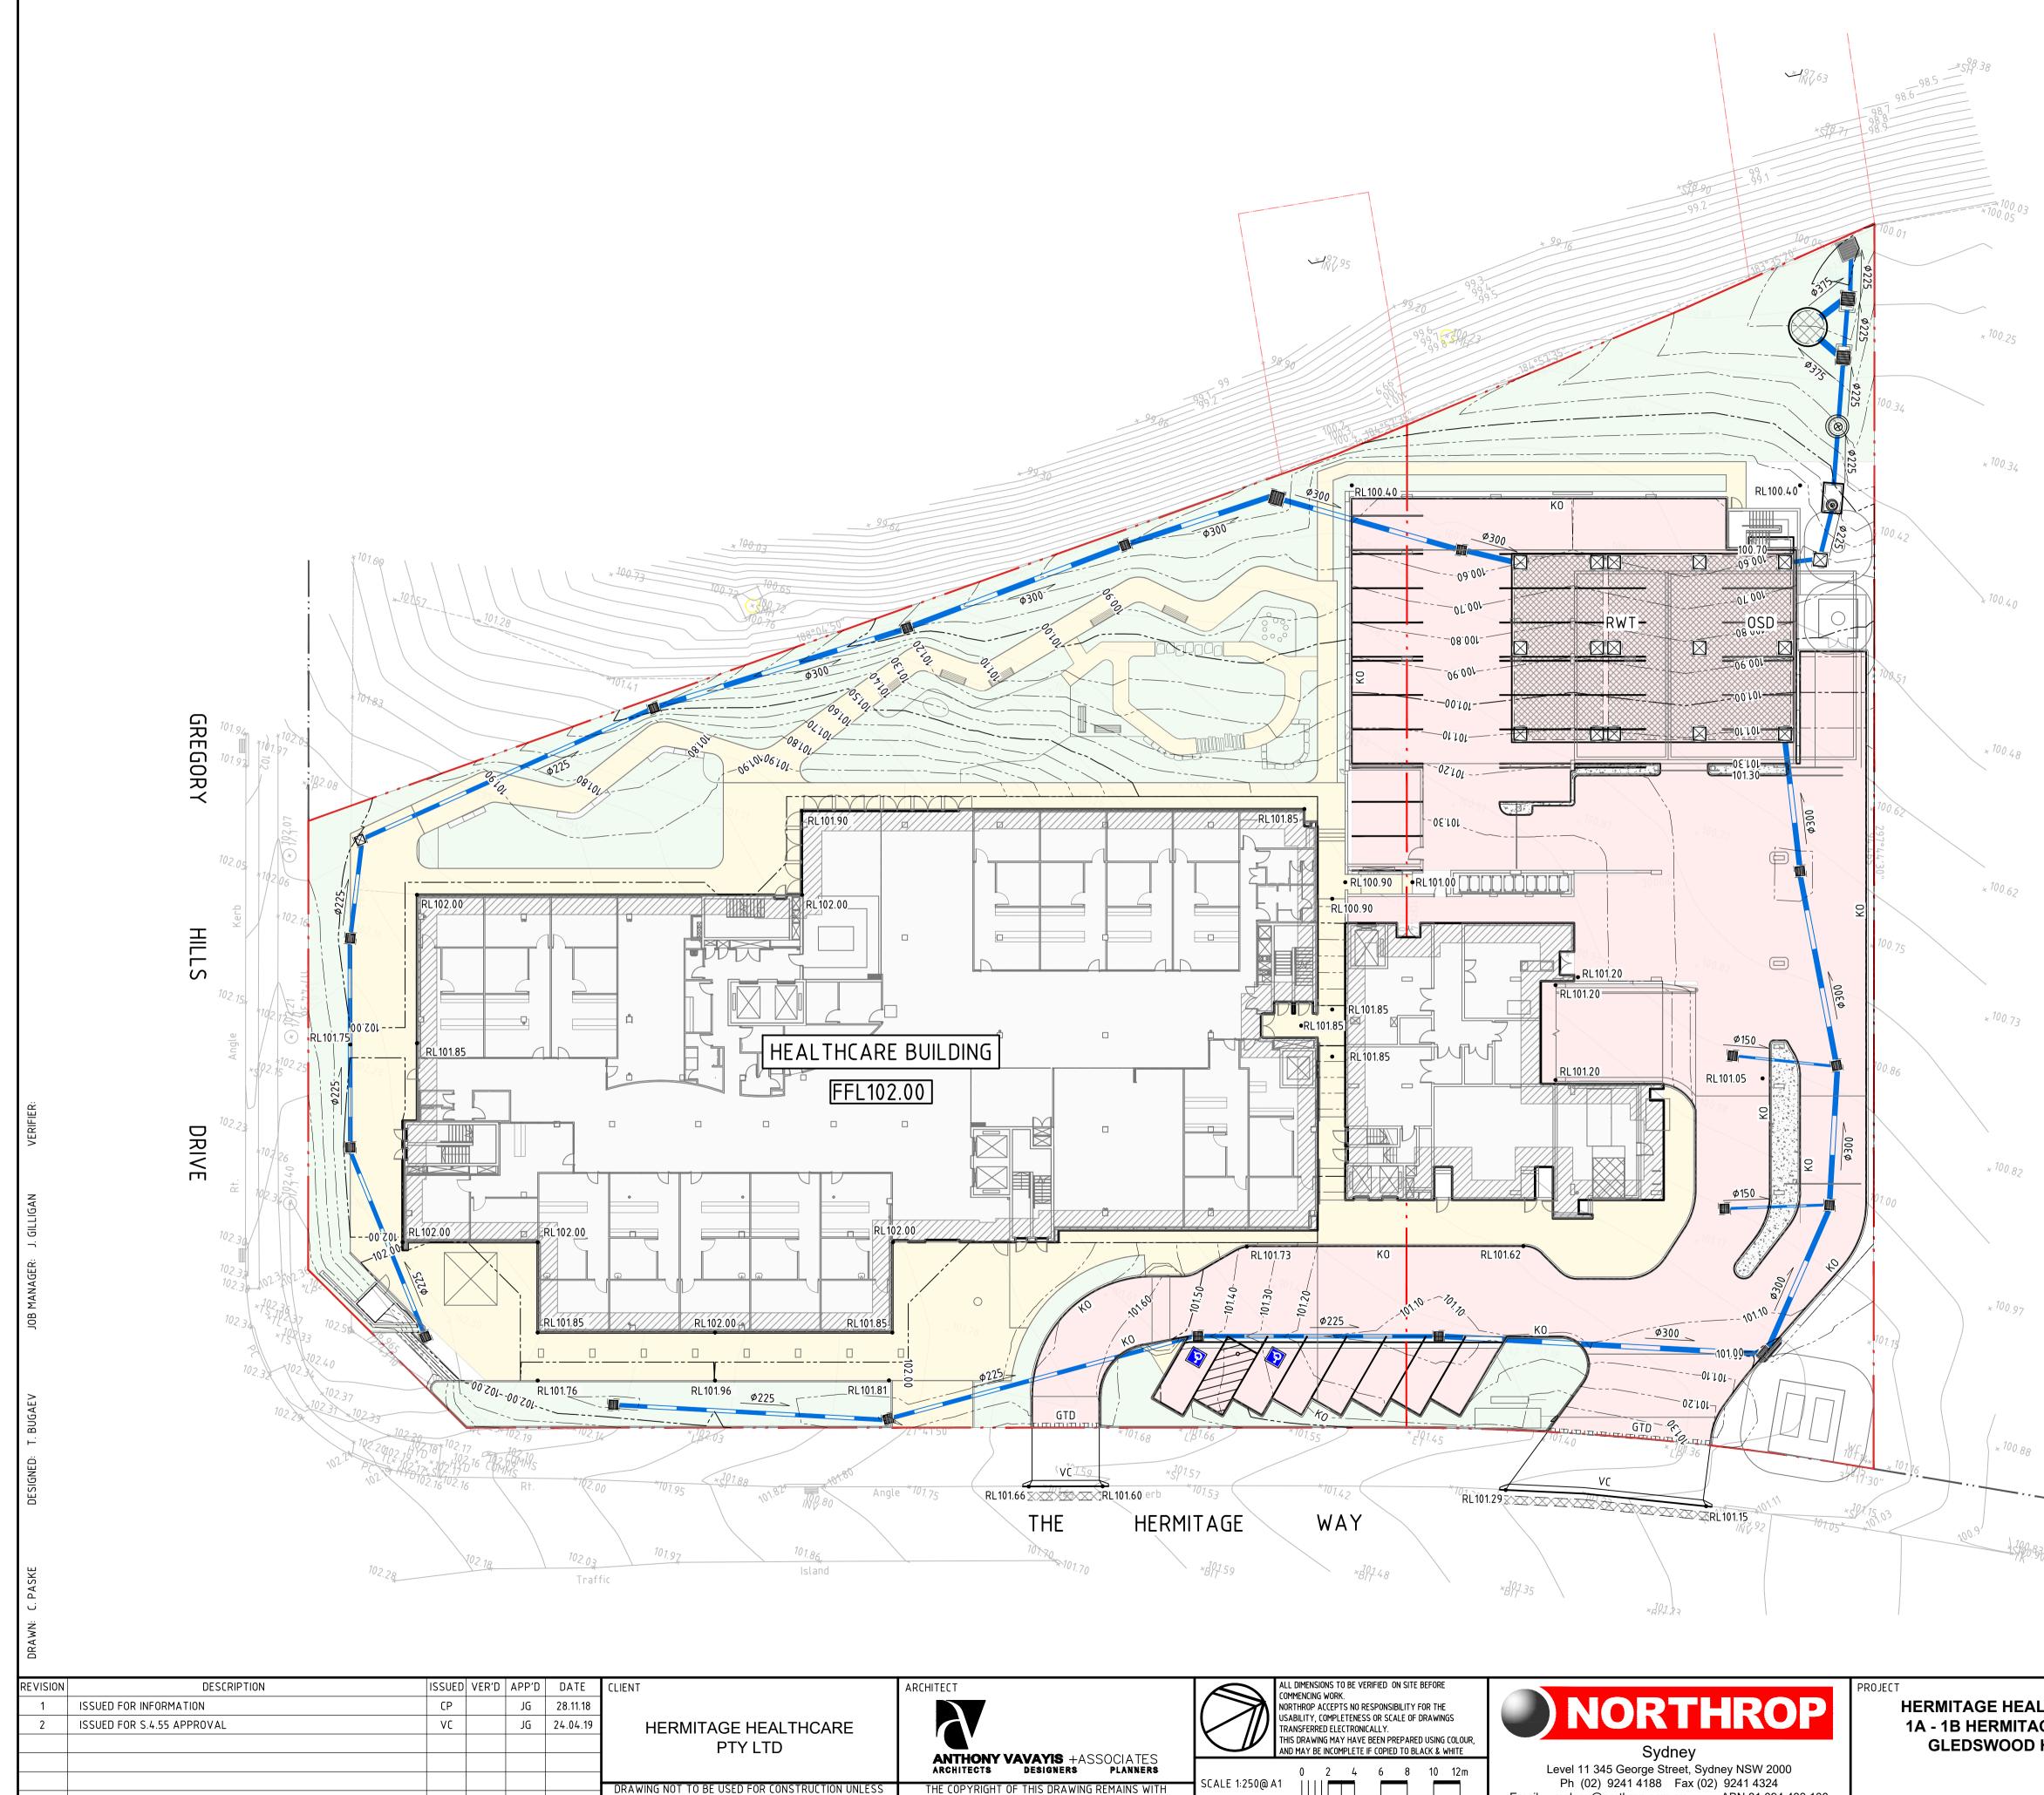

VERIFICATION SIGNATURE HAS BEEN ADDED

Level 11 345 George Street, Sydney NSW 2000 Ph (02) 9241 4188 Fax (02) 9241 4324 Email sydney@northrop.com.au ABN 81 094 433 100 SCALE 1:250@ A1 NORTHROP CONSULTING ENGINEERS PTY LTD

HERMITAGE HEALTHCARE 1A - 1B HERMITAGE WAY, **GLEDSWOOD HILLS**

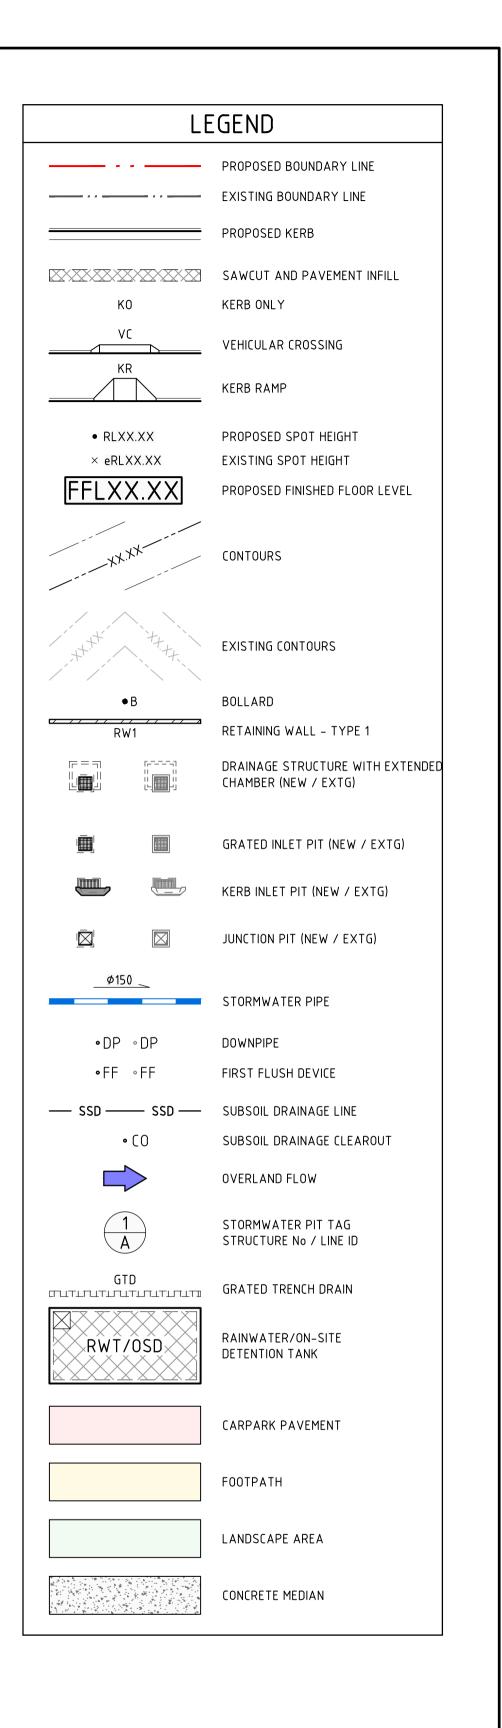

NOT FOR CONSTRUCTION DRAWING TITLE

CIVIL ENGINEERING WORKS

SITEWORKS AND STORMWATER MANAGEMENT PLAN

JOB NUMBER 161992 DRAWING NUMBER REVISION C04.01 2 DRAWING SHEET SIZE = A1