


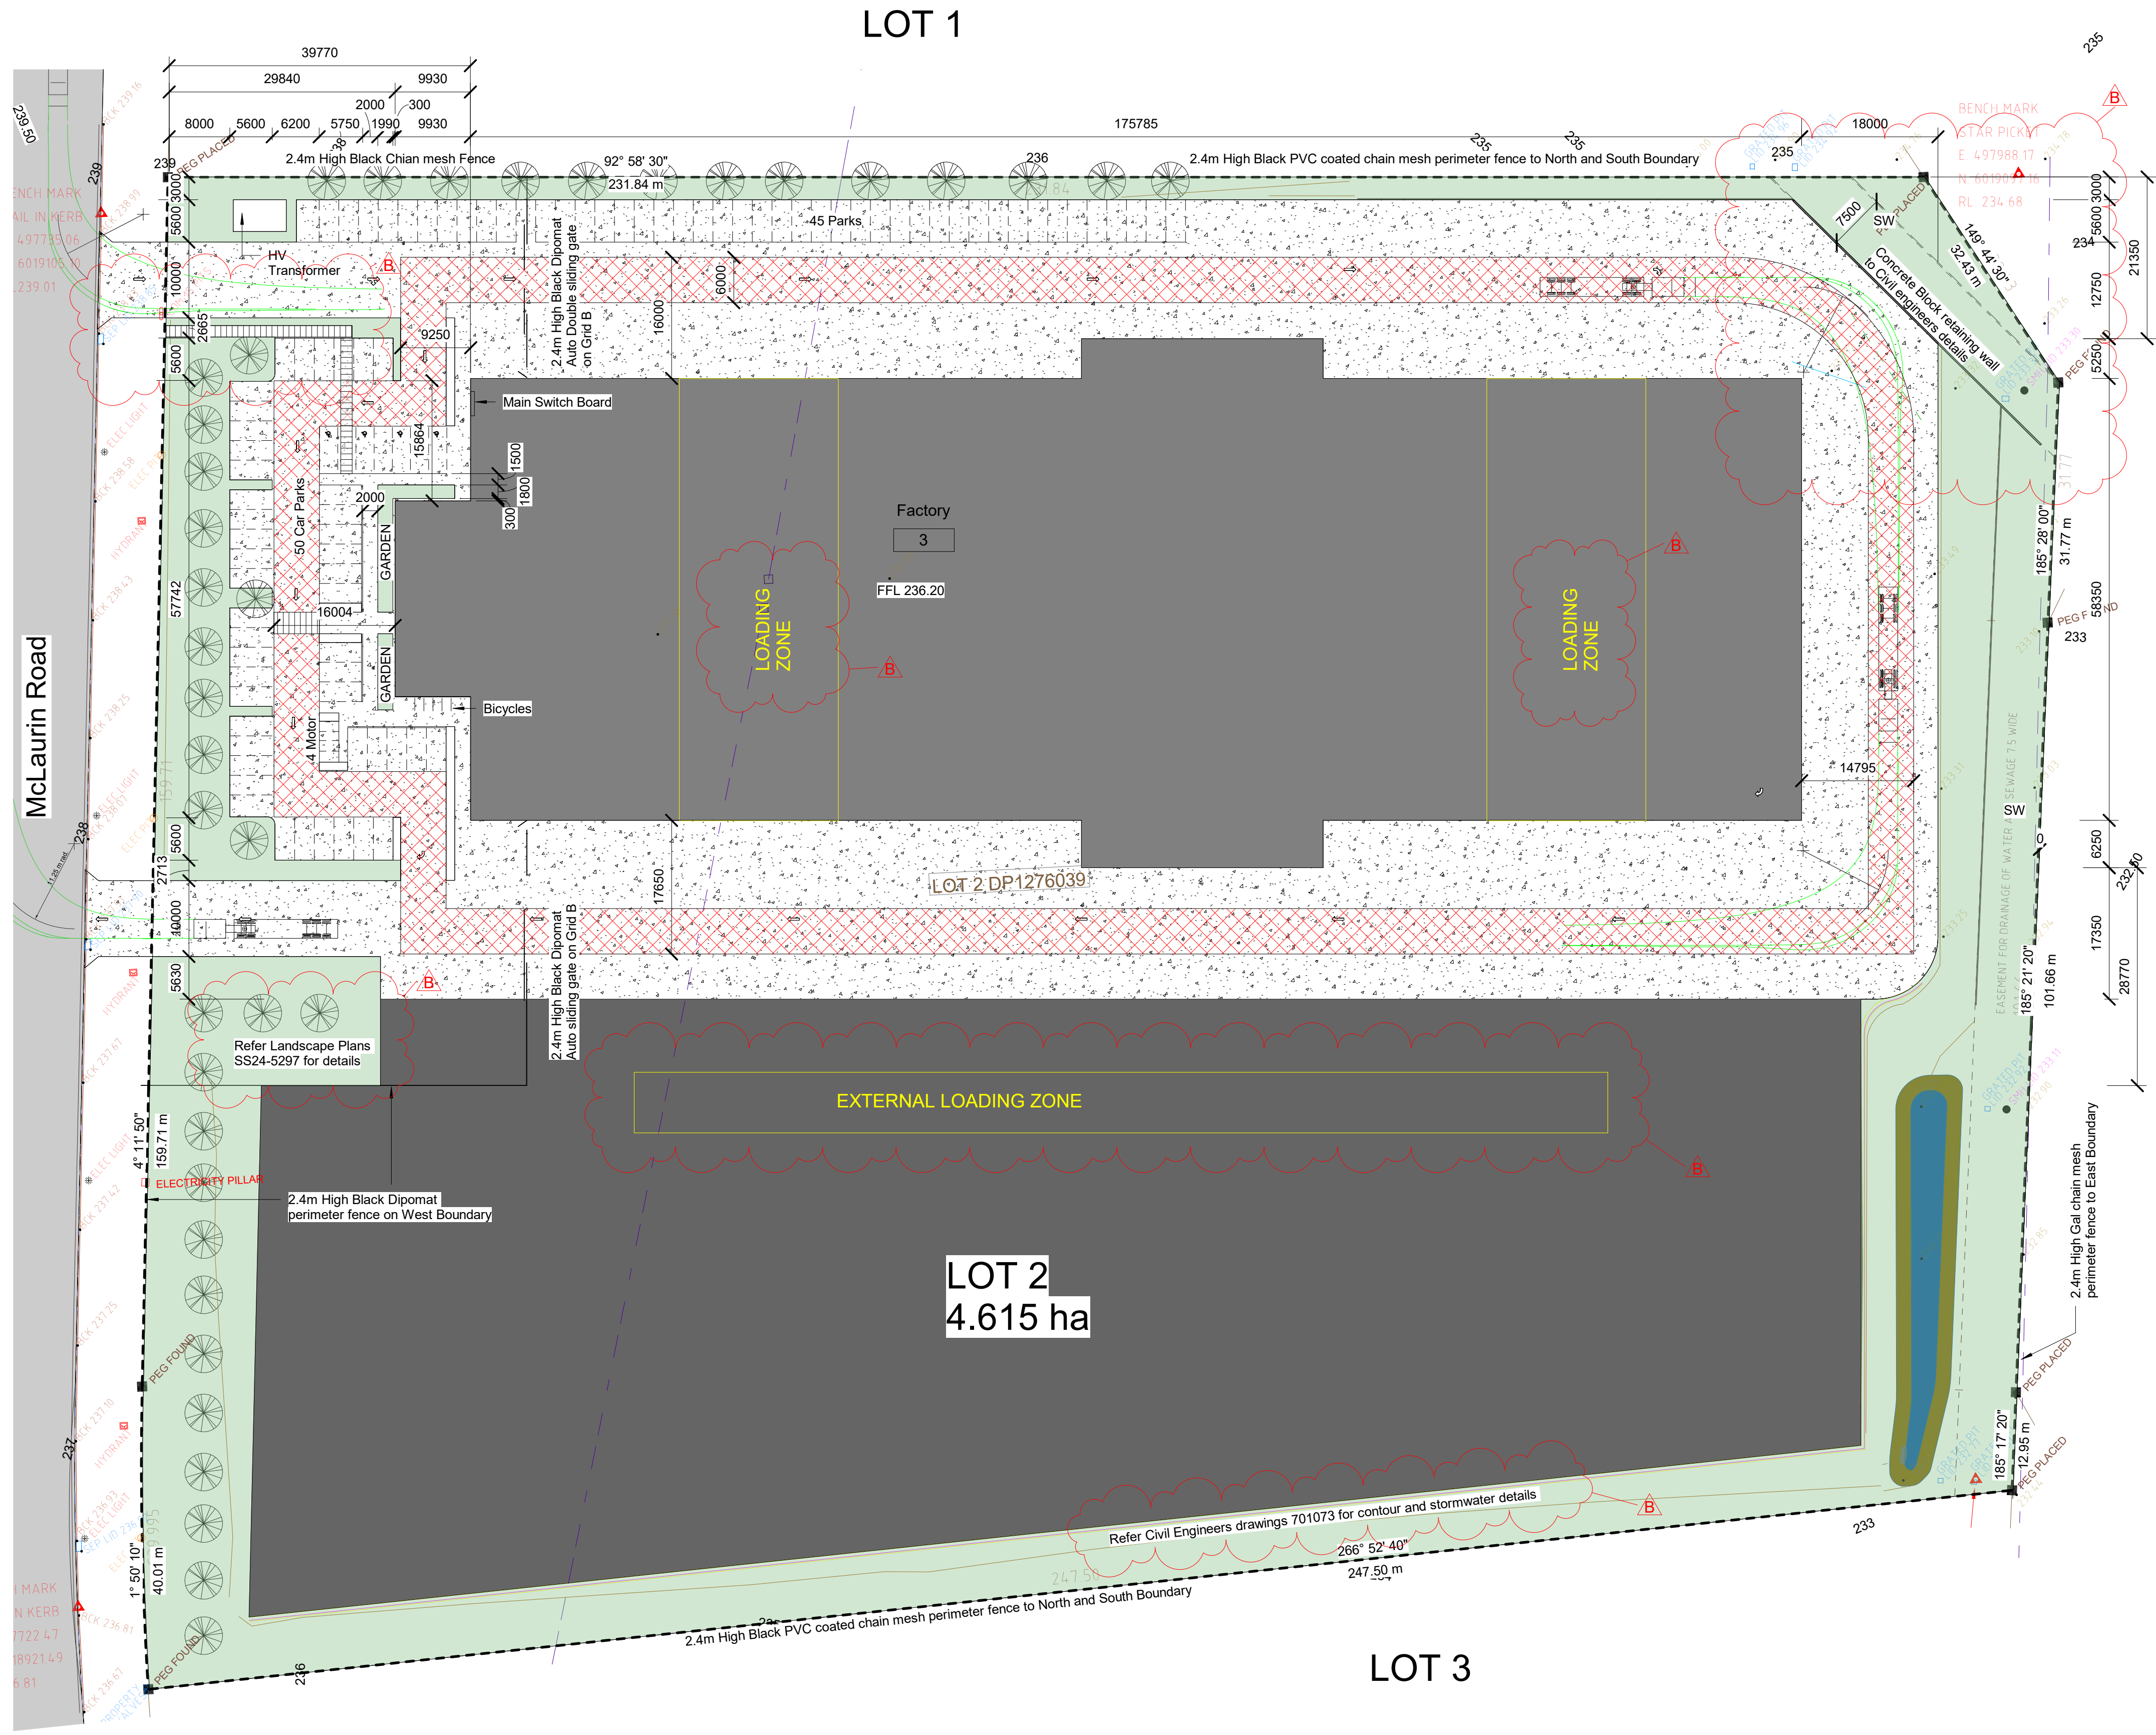

1 Site Plan
1 : 500



PO BOX 3490 ALBURY NSW 2640
MOBILE 0414 576 547
EMAIL travis@barkergroup.net.au


Revisions


No.	Description	Date
B	Council RFI	27.6.2024

Client Name
NEXUS Barker

Project Name
New Premises
NEXUS Lot 2 - DP1276039
Ettamogah NSW 2640

Project number	2023 Nexus Lot 2	Sheet Name	SITE LAYOUT
Project Date	24/06/2024	Sheet Number	A01
Drawn by	RB	Checked by	B
Status	CC - Backgrounds	Scale @ A1	1 : 500

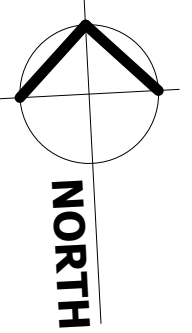

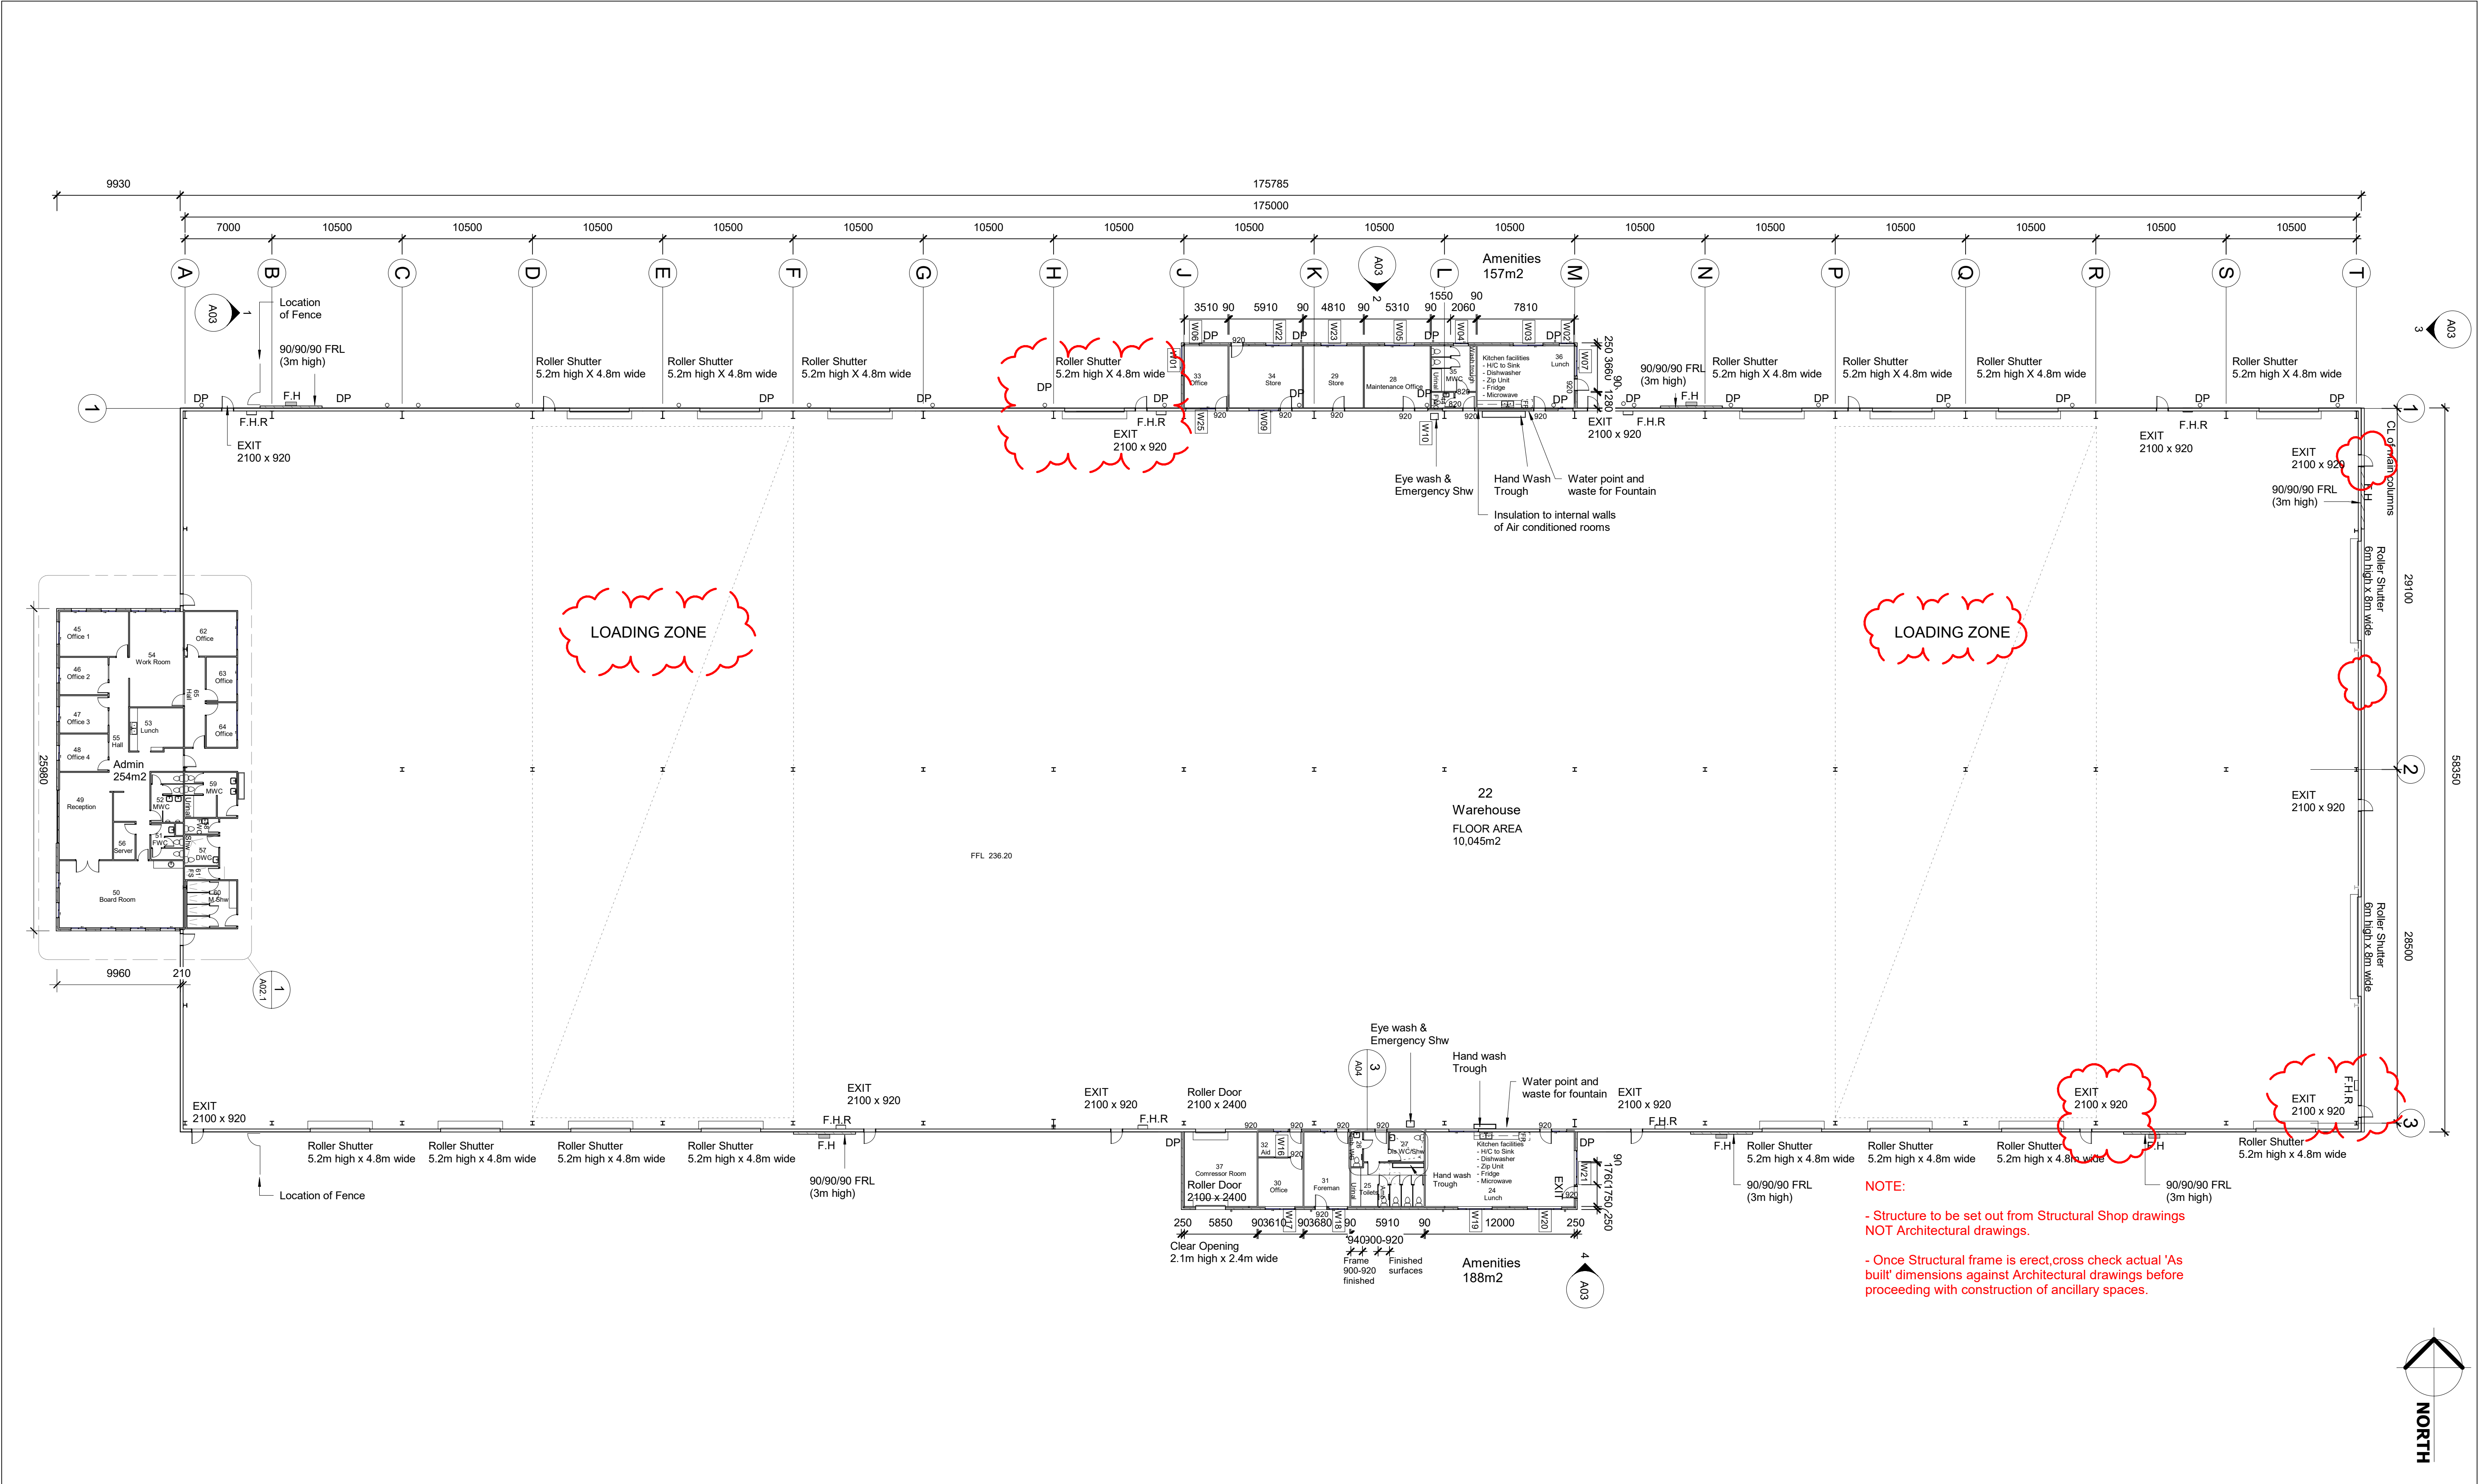

NOTE:
- Structure to be set out from Structural Shop drawings
NOT Architectural drawings.
- Once Structural frame is erect, cross check actual 'As built' dimensions against Architectural drawings before proceeding with construction of ancillary spaces.

 PO BOX 3490 ALBURY NSW 2640 MOBILE 0414 576 547 EMAIL travis@barkergroup.net.au	Revisions			Client Name NEXUS Barker Project Name New Premises NEXUS Lot 2 - DP1276039 Ettamogah NSW 2640	Sheet Name SHED - PLAN Sheet Number A02 Revision No. B			
	No.	Description	Date					
	B	Council RFI	27.6.2024					
					Project number	2023 Nexus Lot 2	Scale @ A1 1 : 250	
					Project Date	27/06/2024		
					Drawn by	RB		Checked by
					Status	DA - Submission		



PO BOX 3490 ALBURY NSW 2640
MOBILE 0414 576 547
EMAIL travis@barkergroup.net.au

Revisions

No.	Description	Date

Client Name

NEXUS Barker

Project Name

New Premises
NEXUS Lot 2 - DP1276039
Ettamogah NSW 2640

Project number 2023 Nexus Lot 2

Project Date 27/06/2024

Drawn by RB Checked by

Status DA - Submission

Sheet Name

OFFICE PLAN

Sheet Number




A02.1

Revision No.

B

Scale @ A1

1 : 50

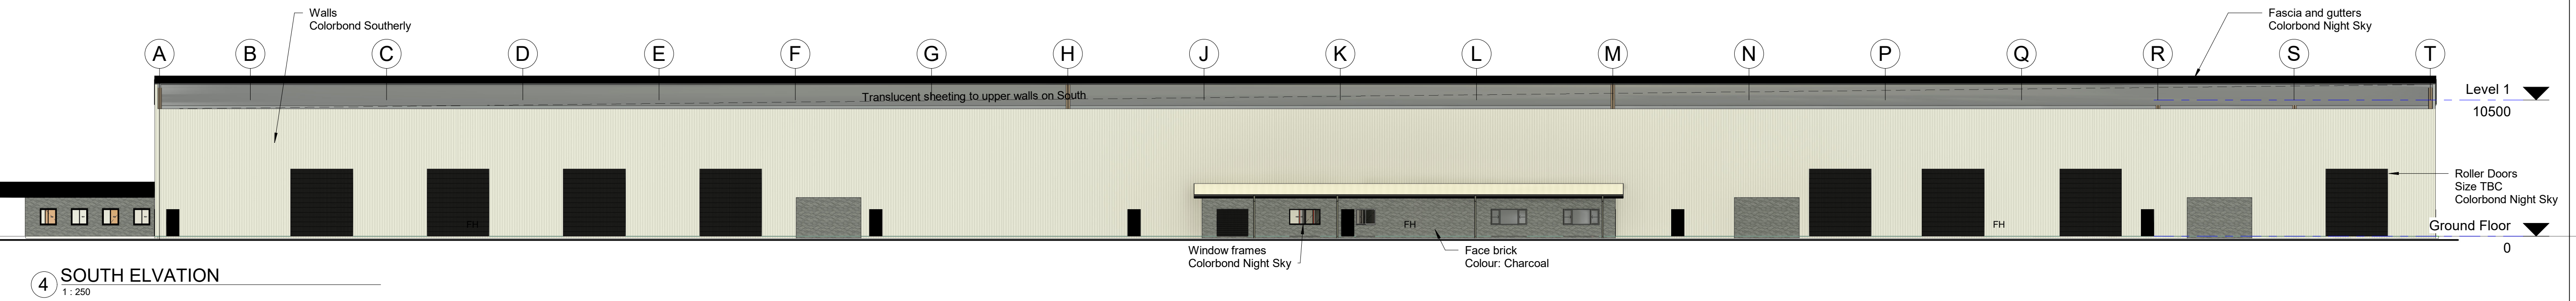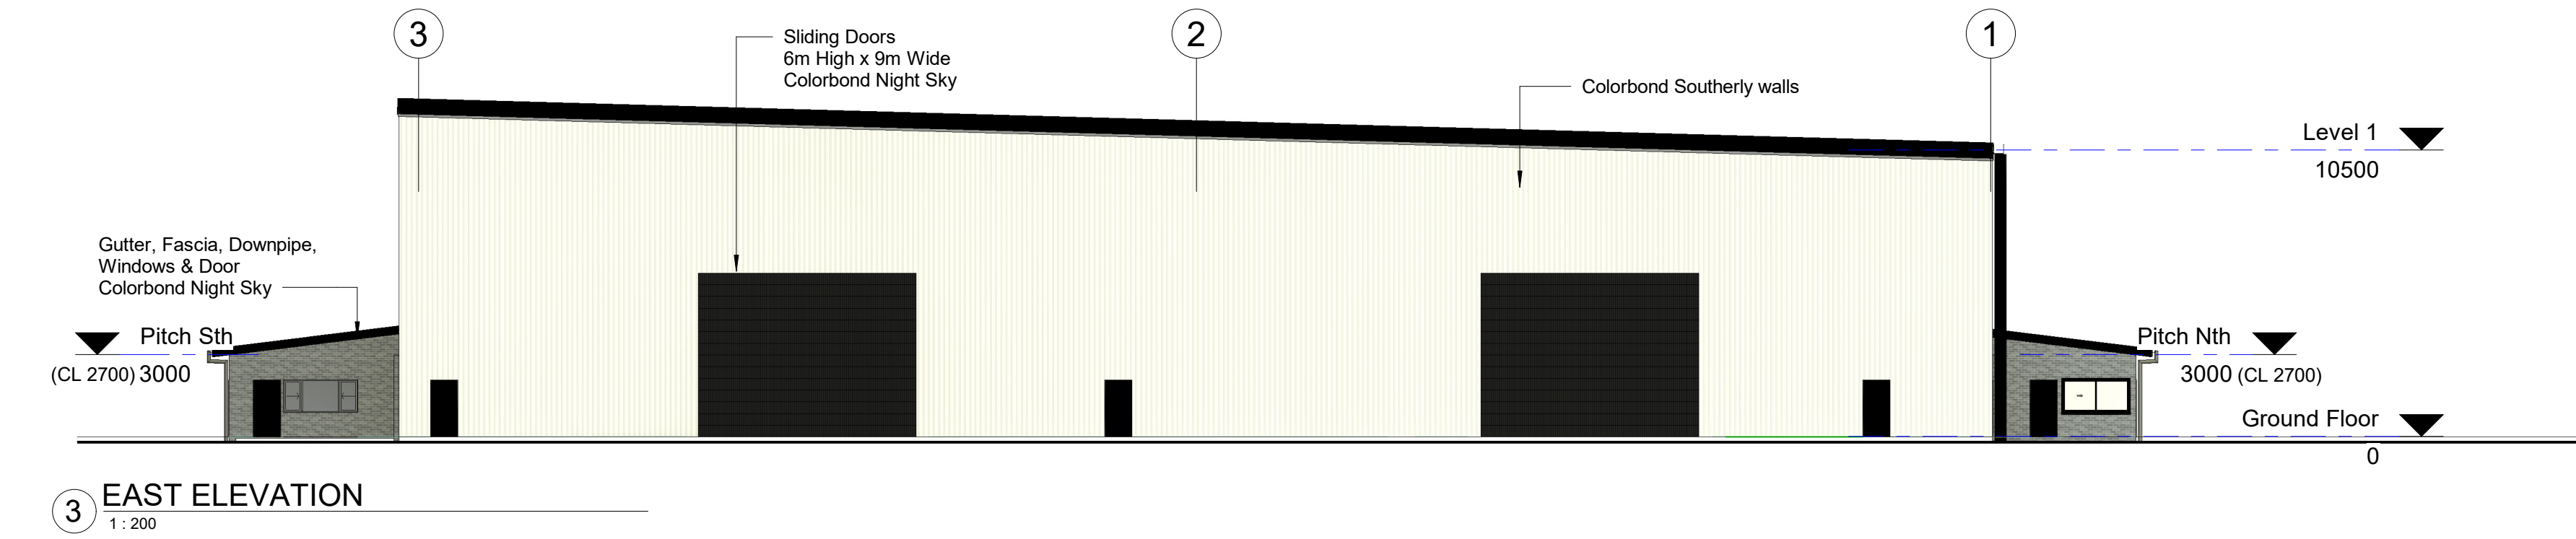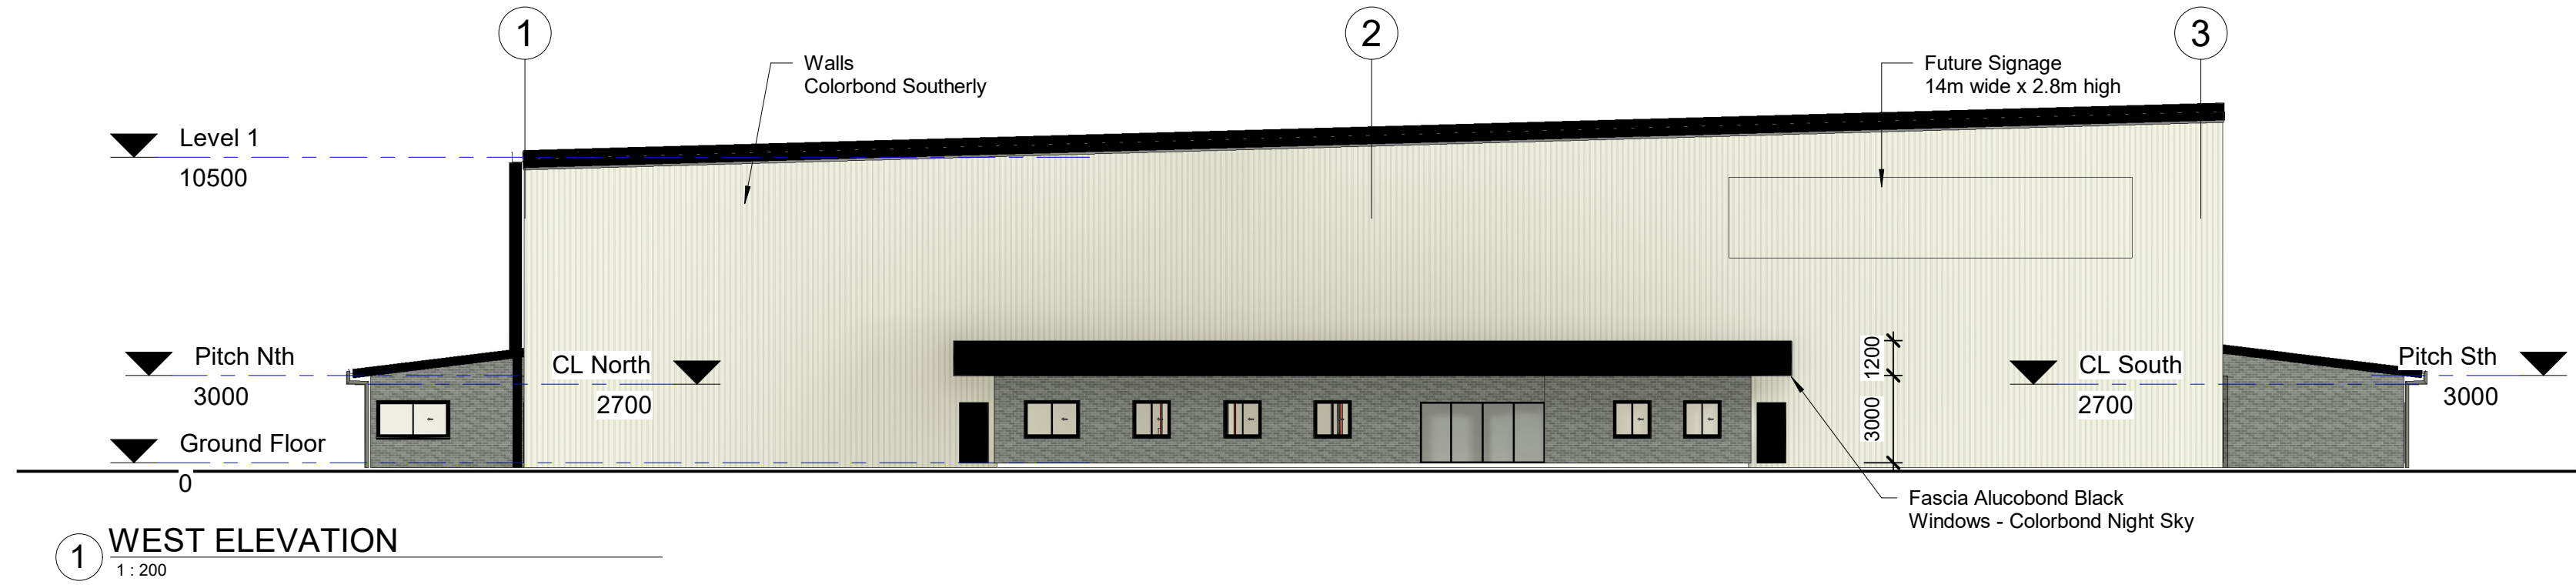

NOTE:
Number / Size & location of Downpipe to be confirmed
Fire hose reel, Fire Hydrant locations to be confirmed

Barker
GROUP

PO BOX 3490 ALBURY NSW 2640
MOBILE 0414 576 547
EMAIL travis@barkergroup.net.au

Revisions		
No.	Description	Date

Client Name
NEXUS Barker

Project Name
New Premises
NEXUS Lot 2 - DP1276039
Ettamogah NSW 2640

Project number 2023 Nexus Lot 2		Sheet Name SHED - ELEVATIONS
Project Date 27/06/2024		Sheet Number A03
Drawn by RB Checked by		Revision No. B
Status DA - Submission		Scale @ A1 As indicated