


4/08/2025 12:01:23 PM

24.55

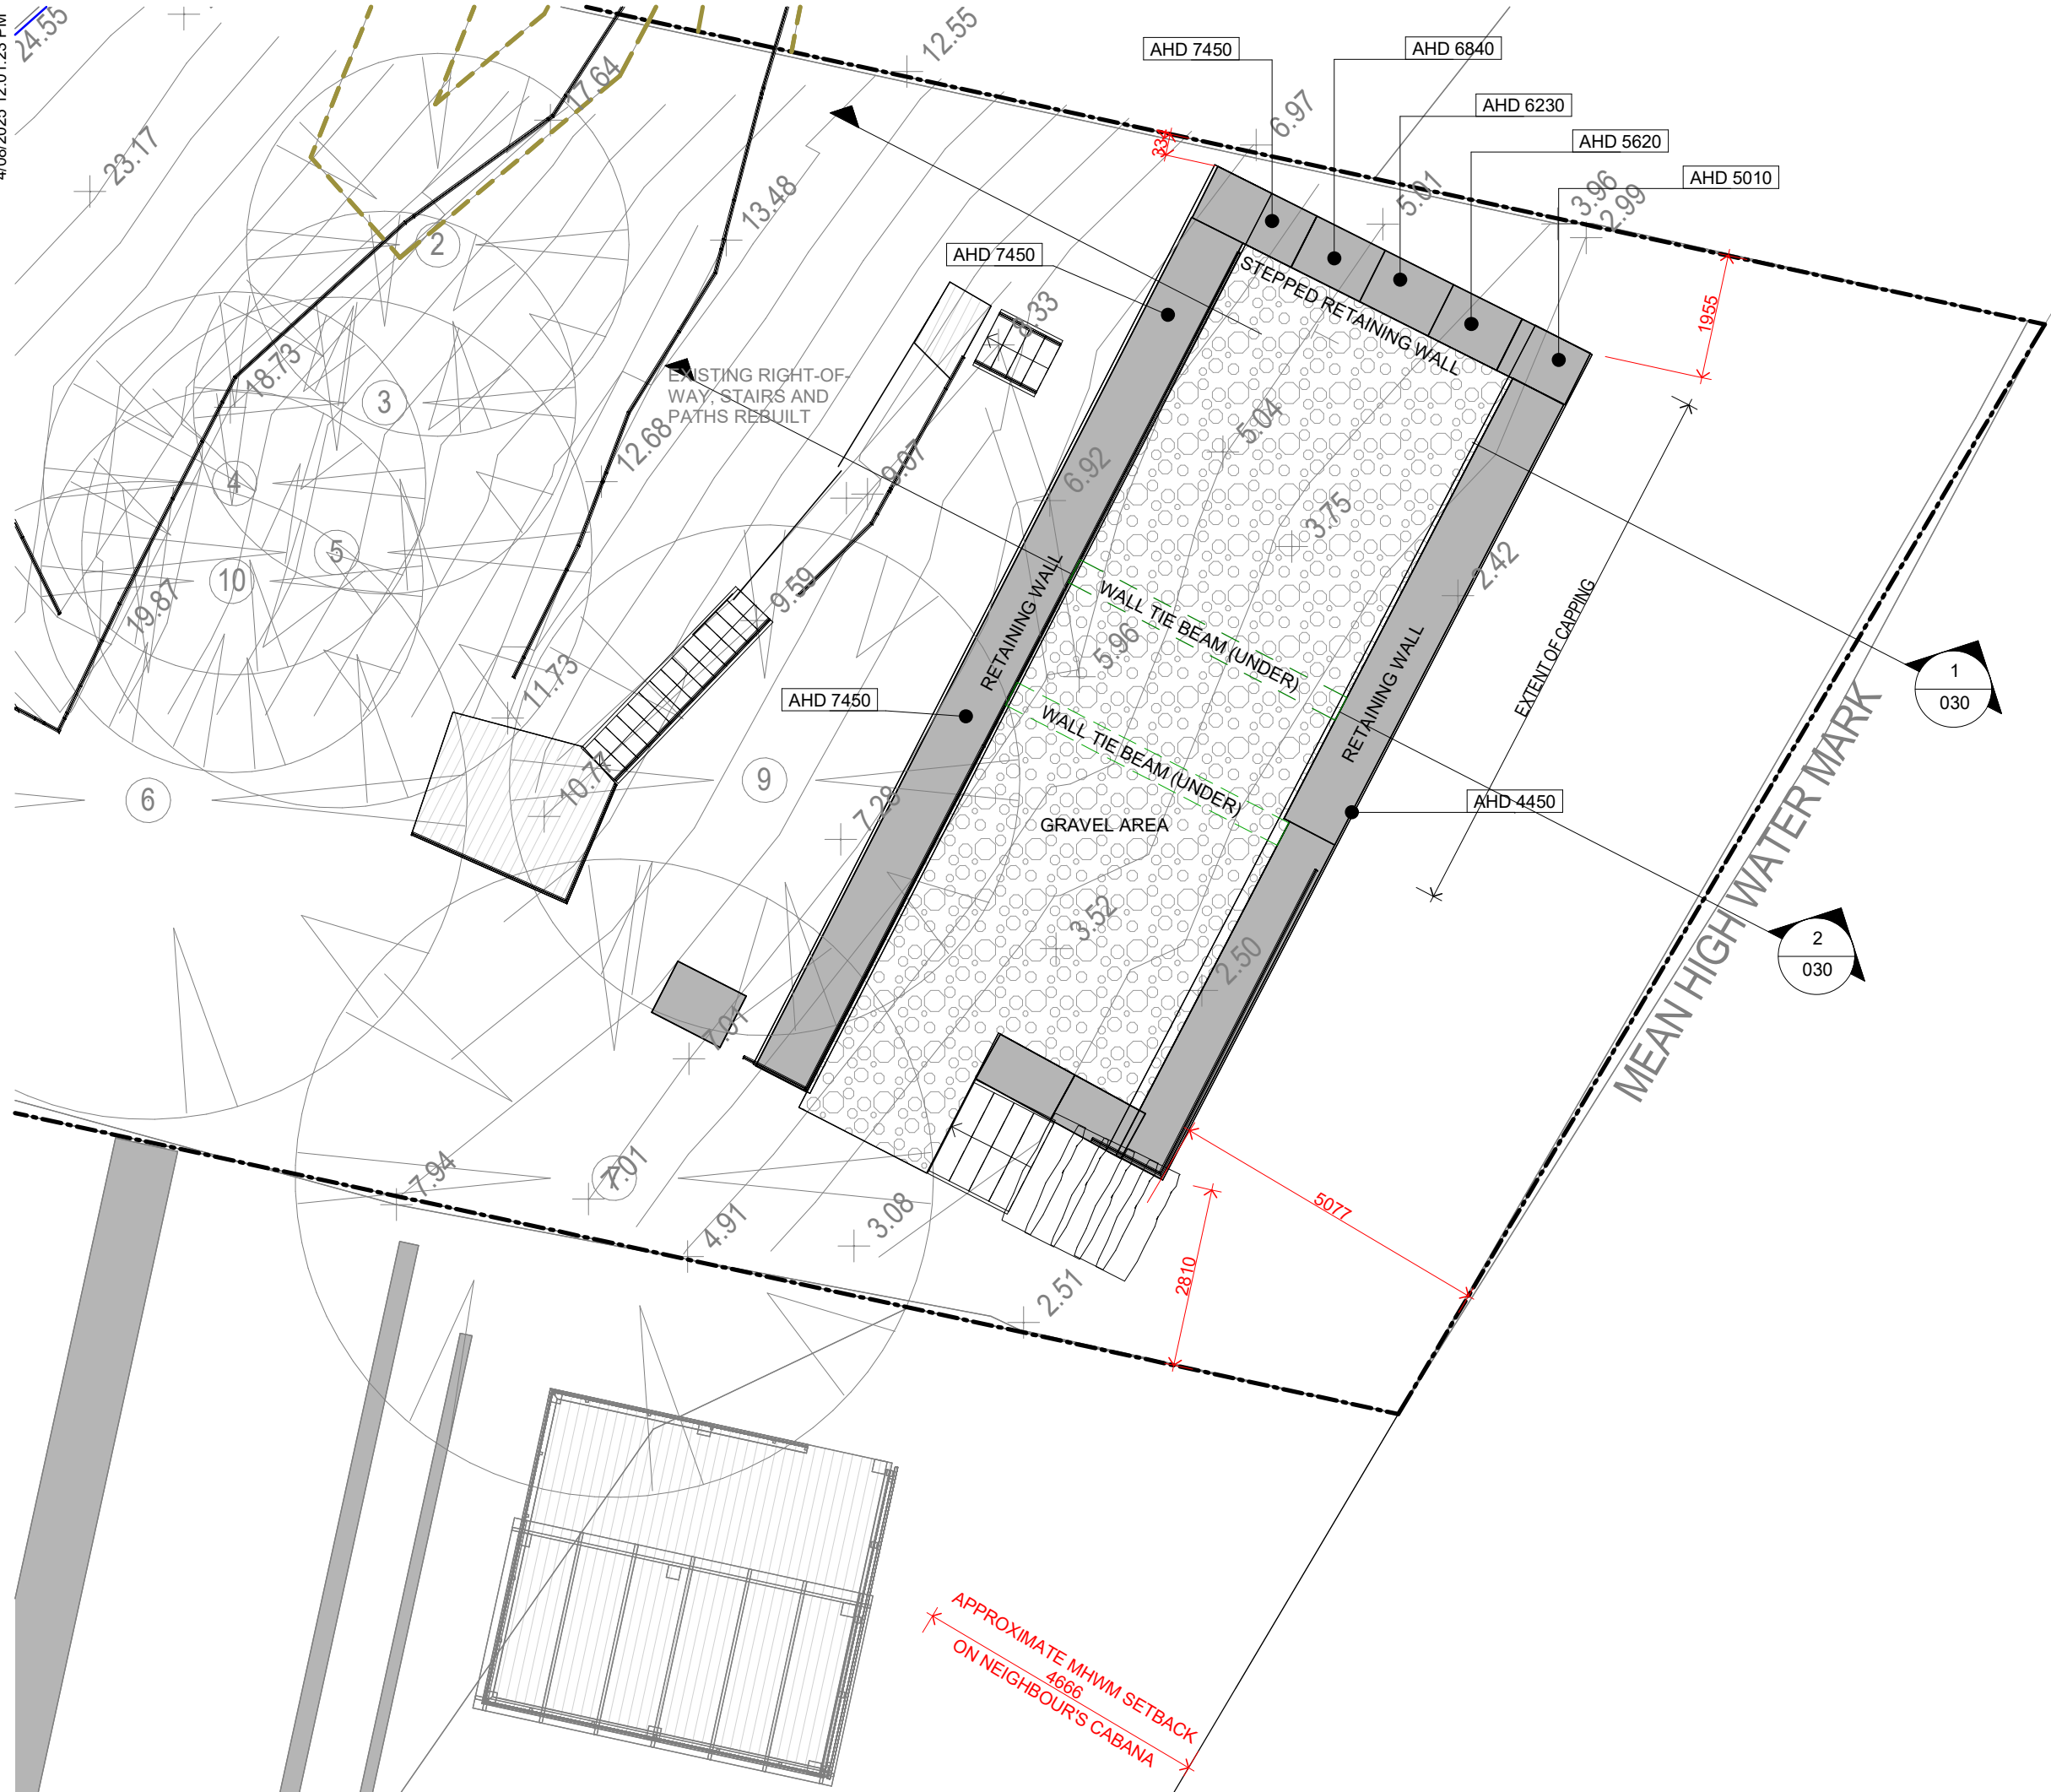

DA02 04.08.25 S.83 RECONSIDERATION
ISS DATE ISSUE DESCRIPTION

REV DATE REV DESCRIPTION



adhami pender architecture
welcome@adhamipenderarchitecture.com
Tel: (02) 62477242
Shop 21,
84 Ainsworth St
Mawson ACT 2607

CLIENT
Colbert


PROJECT
DENHAMS BEACH DUPLEX

LOT 2 DP 773132
@ 217a BEACH ROAD
DENHAMS BEACH NSW


DESCRIPTION
AS-BUILT RETAINING WALLS PLAN

PROJECT STATUS
AUTHORITIES APPROVAL


SCALE at A3
1 : 100
DESIGNED
APA
DRAWN
AH
CHECKED
NA

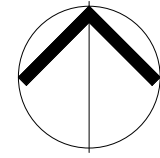


DATE
31/07/25
JOB NO
J000167
DRAWING NO
029
ISSUE
DA02

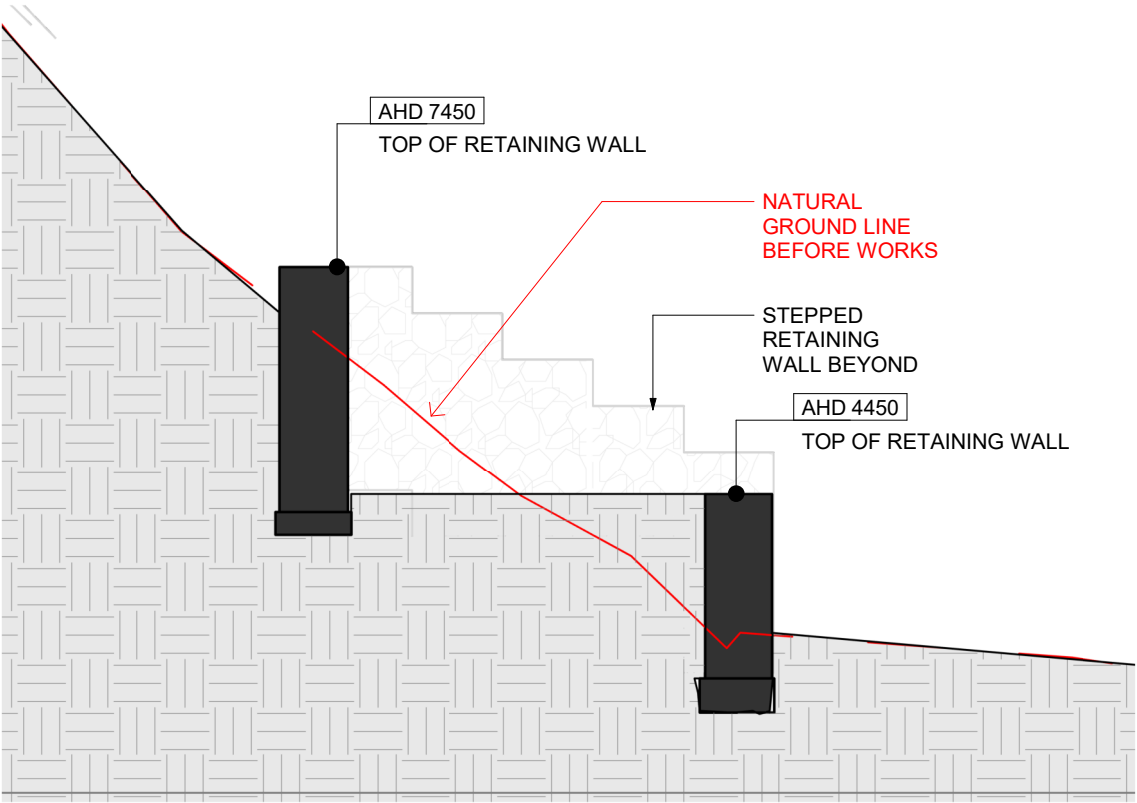

AS-BUILT RETAINING WALL SECTION 1
1 : 100

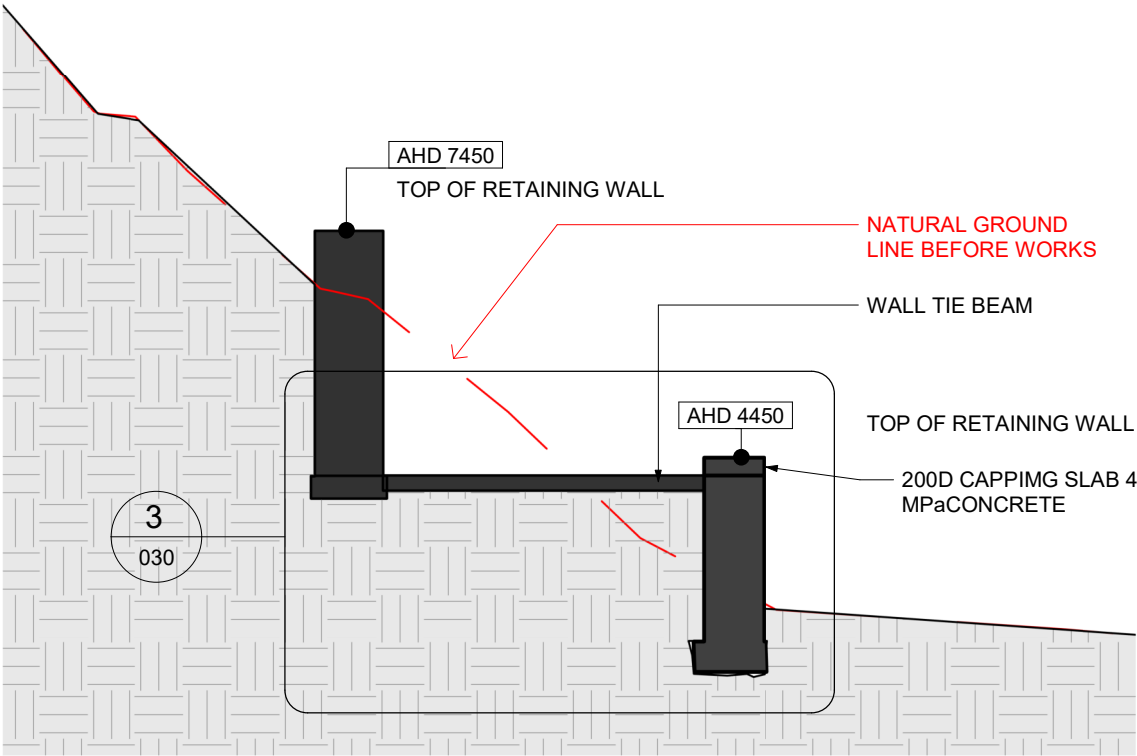

AS-BUILT RETAINING WALL SECTION 2
1 : 100

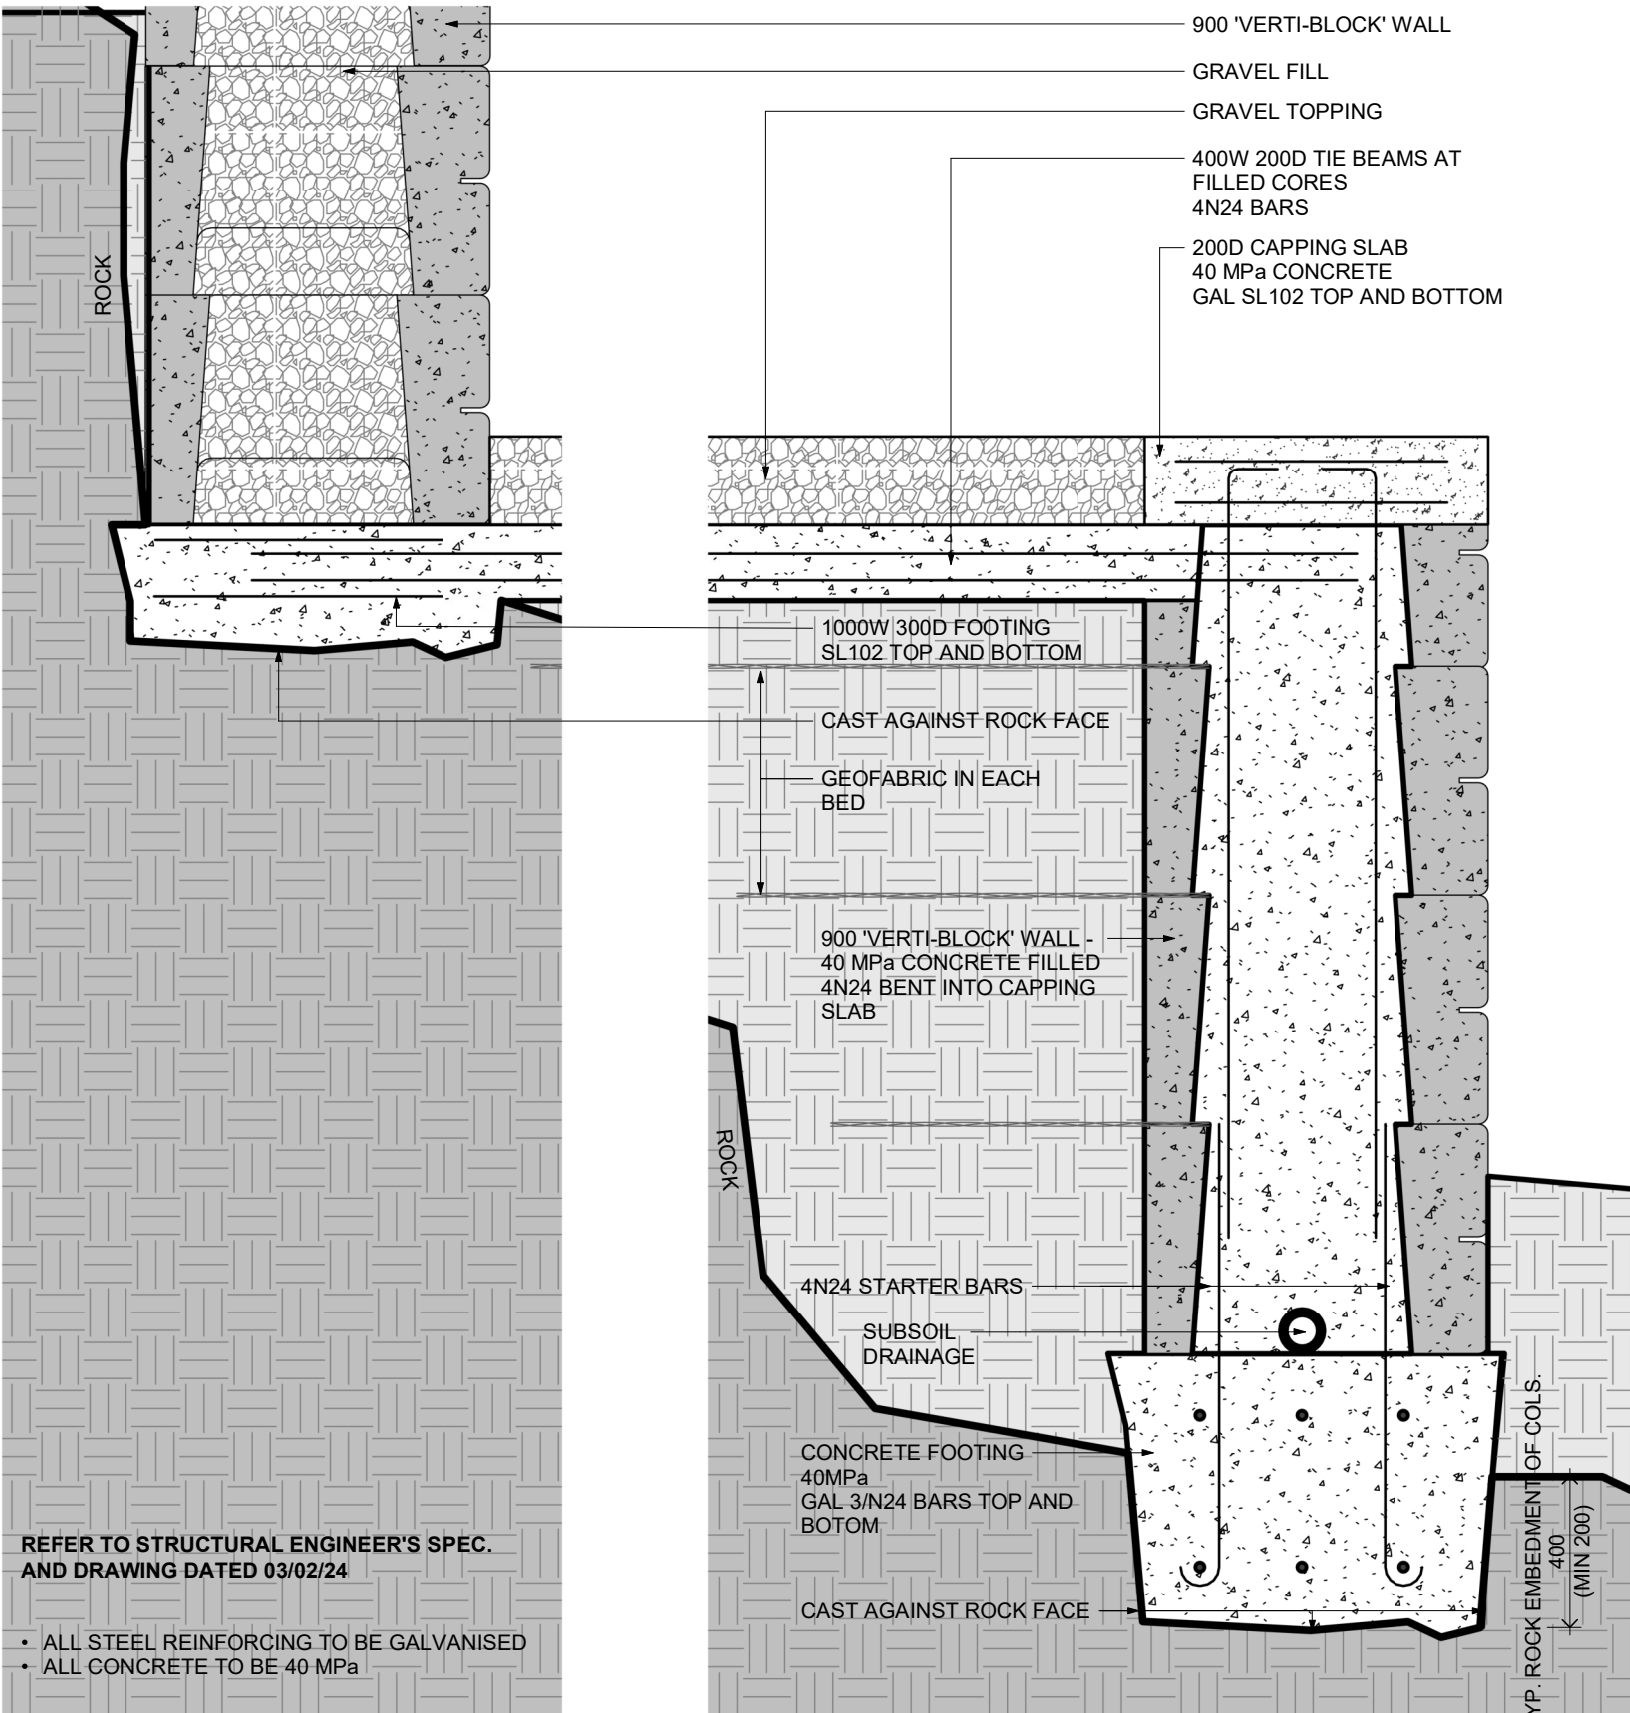

AS-BUILT RETAINING WALL DETAIL SECTION
1 : 20