## Western Sydney Community & Conference Centre

Mulgoa Road, Penrith

### Concept Proposal Application

#### Architectural Drawings

Layout ID	Layout Name	Drawing Scale
DA-001-001_L	Title Sheet	
DA-100-0_K	Location Plan	NTS
DA-100-002_L	Site Analysis Plan	1:1000
DA-110-007_K	Basement 02	1:500)← <b>−</b> 1
DA-110-008_K	Basement 01	1:500
DA-110-009_K	Ground Level	1:500
DA-110-010_K	Level 01	1:500
DA-110-020_L	Level 02	1:500
DA-110-030_L	Level 03 to Level 06	1:500
DA-110-070_L	Roof Plan	1:500
DA-200-001_L	Site Elevations 01	1:500
DA-200-002_K	Site Elevations 02	1:500
DA-300-001_L	Longitudinal Section	1:500
DA-720-001_L	GFA Diagrams	1:1000
DA-740-001_K	FSR Diagrams	1:1000
DA-760-001_L	Shadow Diagrams	1:1000
DA-760-002_L	Shadow Diagrams	1:1000
DA-800-001_L	Staging Diagrams	NTS
DA-800-002_K	Building Height Diagram	1:300
DA-850-010_K	Notification Plan	1:650
DA-850-020_K	Notification Plan	1:800

#### Amendments:

- Additional Basement 02
- Reconfiguration of vertical circulation
- Adjustment of internal GBA
- Change to staging arrangement
- Updated storey levels, with additional envelope to accommodate fire stair
- Reduction in hotel envelope to

DA-001-001\_L

south west

NOTE: No change to Phase 3 as approved under DA 180340 16065 TURNER @A1, 50%@A3

**Western Sydney Community and Conference Centre** 



Mulgoa Road, Penrith NSW 2750

Rev Date Approved by Revision Notes D1 26.11.18 DS DA Submission

JG Concept Amendment

JG Concept Amendment


JG Concept Update

J 03.6.19

L 10.07.19

05.06.19

Concept Update

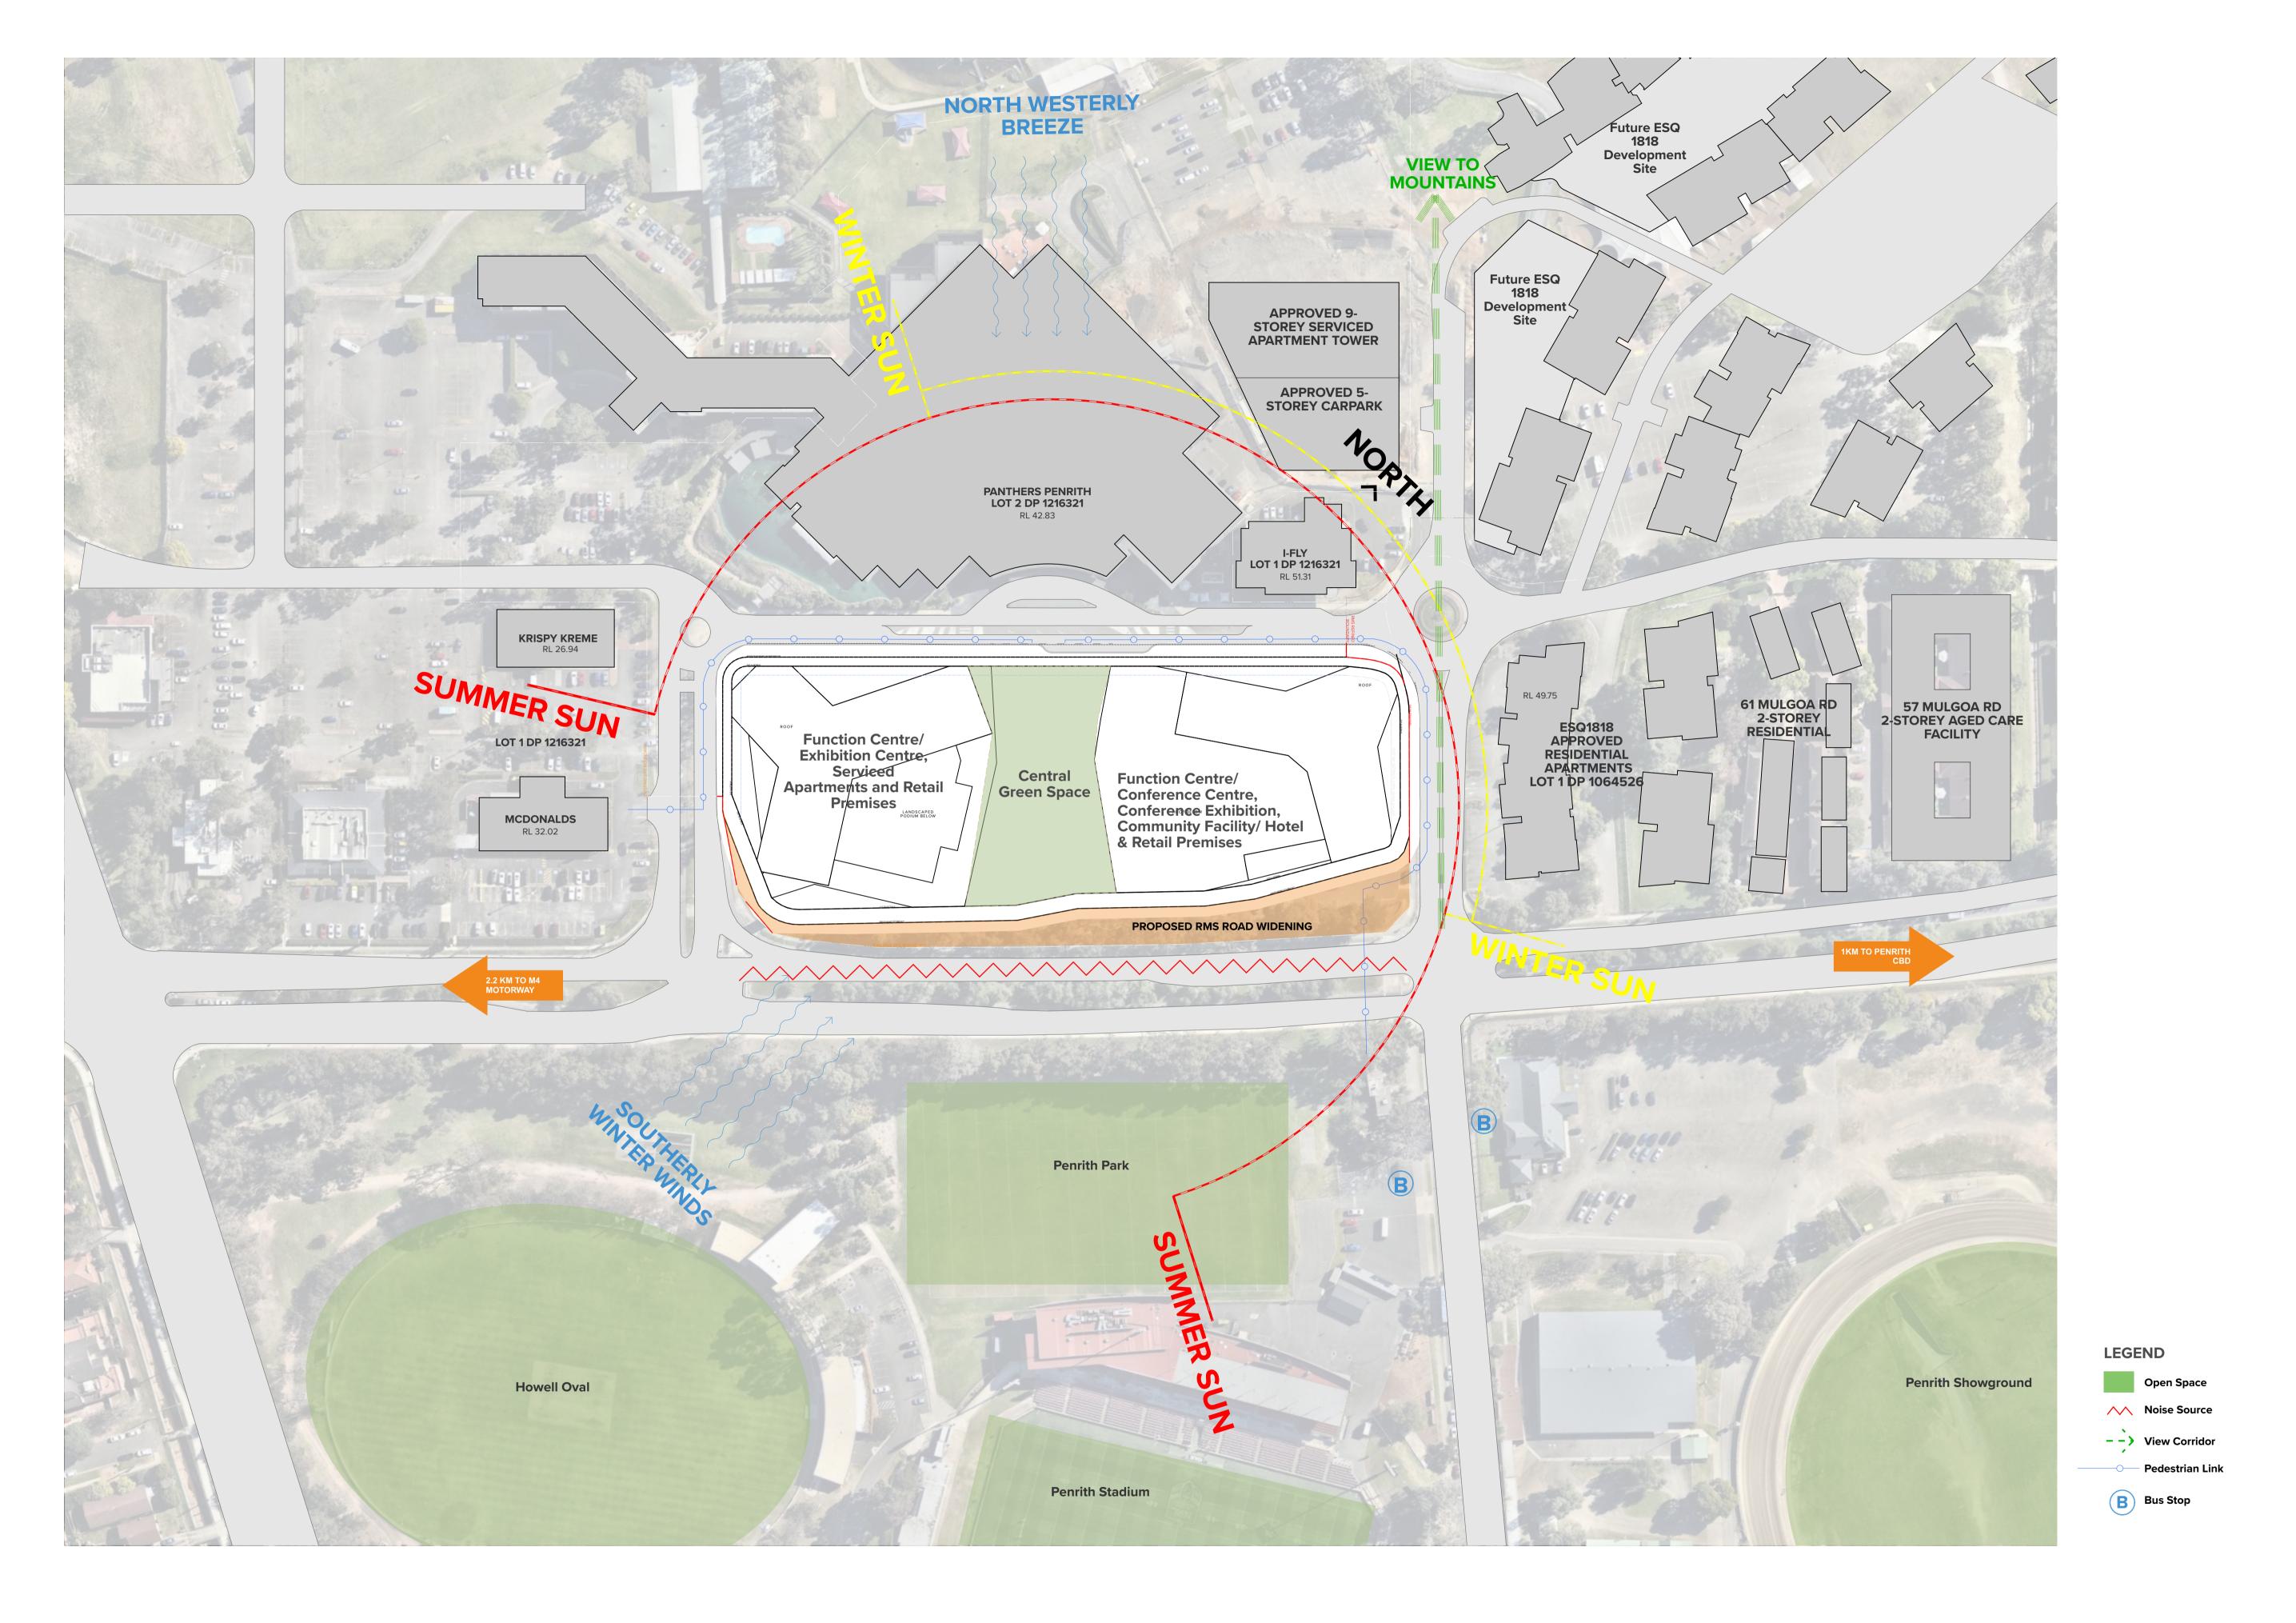

NOTES

THIS DRAWING IS COPYRIGHT © OF TURNER. NO REPRODUCTION WITHOUT PERMISSION. UNLESS NOTED OTHERWISE THIS DRAWING IS NOT FOR CONSTRUCTION. ALL DIMENSIONS AND LEVELS ARE TO BE CHECKED ON SITE PRIOR TO THE COMMENCEMENT OF WORK. INFORM TURNER OF ANY DISCREPANCIES FOR CLARIFICATION BEFORE PROCEDING WITH WORK, DRAWINGS ARE NOT TO BE SCALED, USE ONLY FIGURED DIMENSIONS. REFER TO CONSULTANT DOCUMENTATION FOR FURTHER INFORMATION.

Penrith Rugby League Club Limited
123 Mulgoa Rd, Penrith NSW

PANTHERS
GROUP

Rev Date Approved by Revision Notes
01 26:11:18 DS DA Submission
J 03:6:19 JG Concept Amendment
K 05:06:19 JG Concept Amendment
L 10:07:19 JG Concept Update

Project Title

Western Sydney Community and Conference Centre
Mulgoa Road, Penrith NSW 2750

Drawing Title


Concept Proposal Update


Site Analysis Plan


Scale Project No. Drawn by North


1:1000 @A1, 50%@A3
Status Dwg No.

Concept Update DA-100-002\_L L

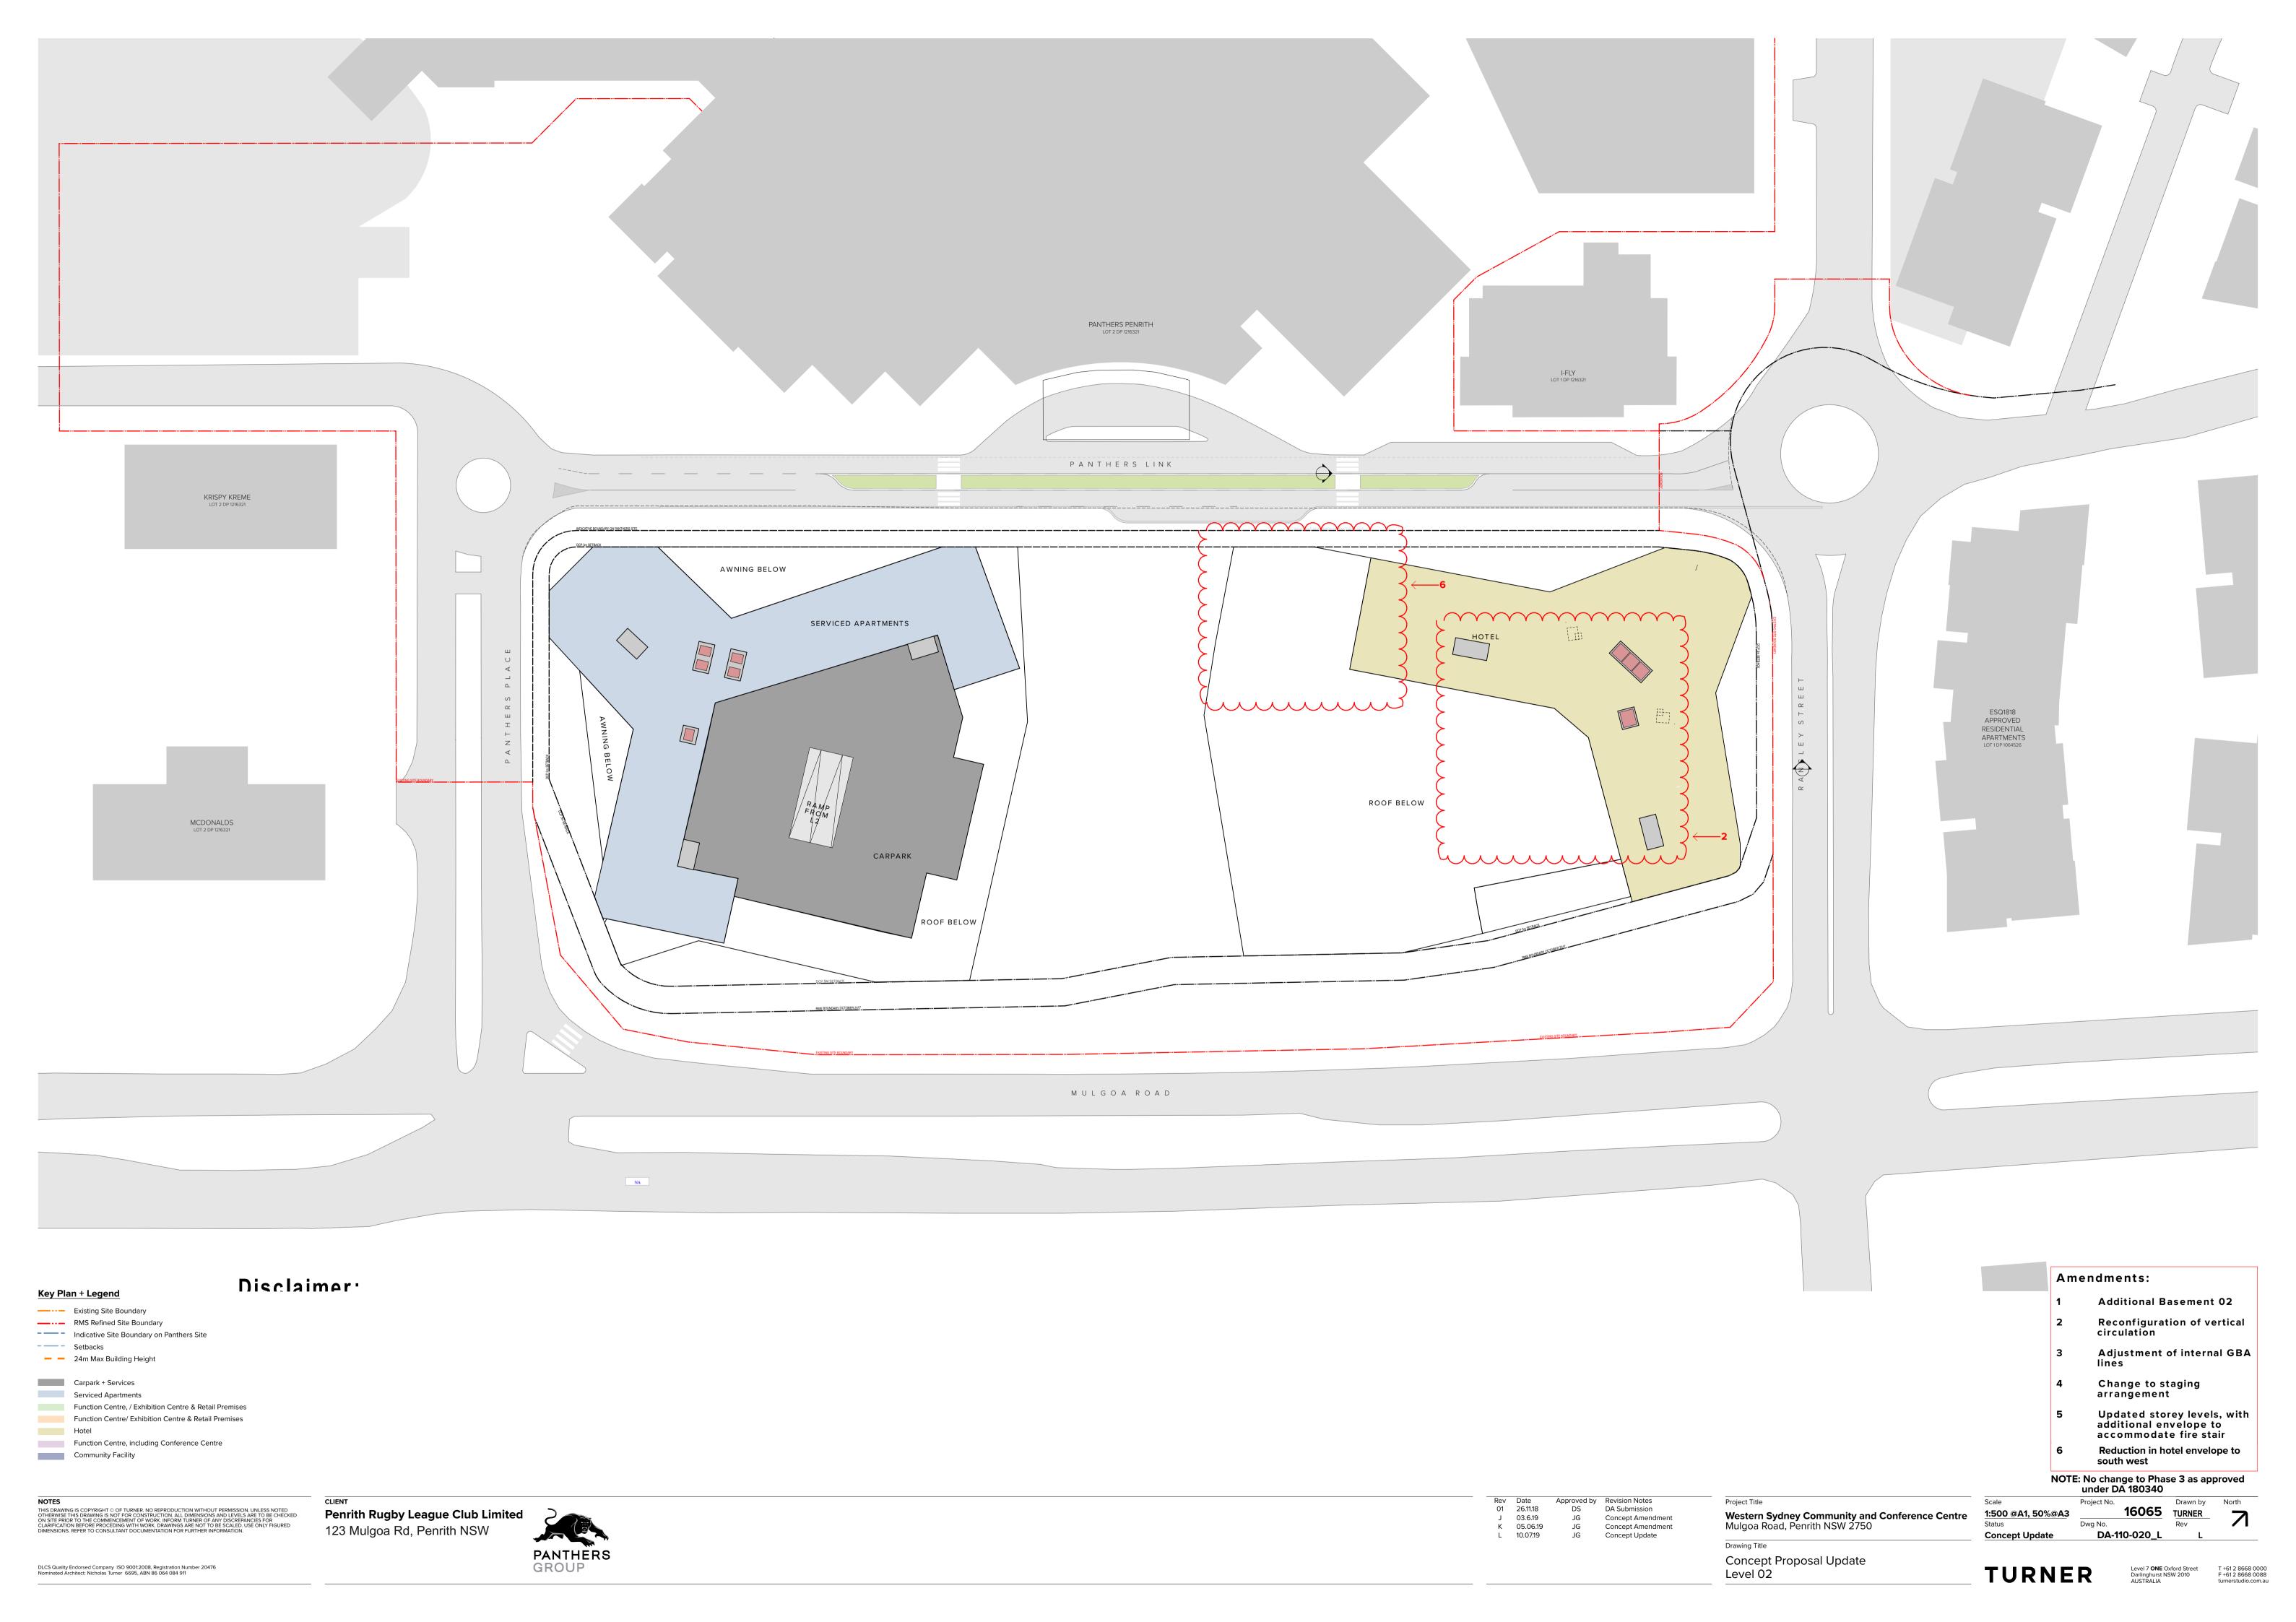


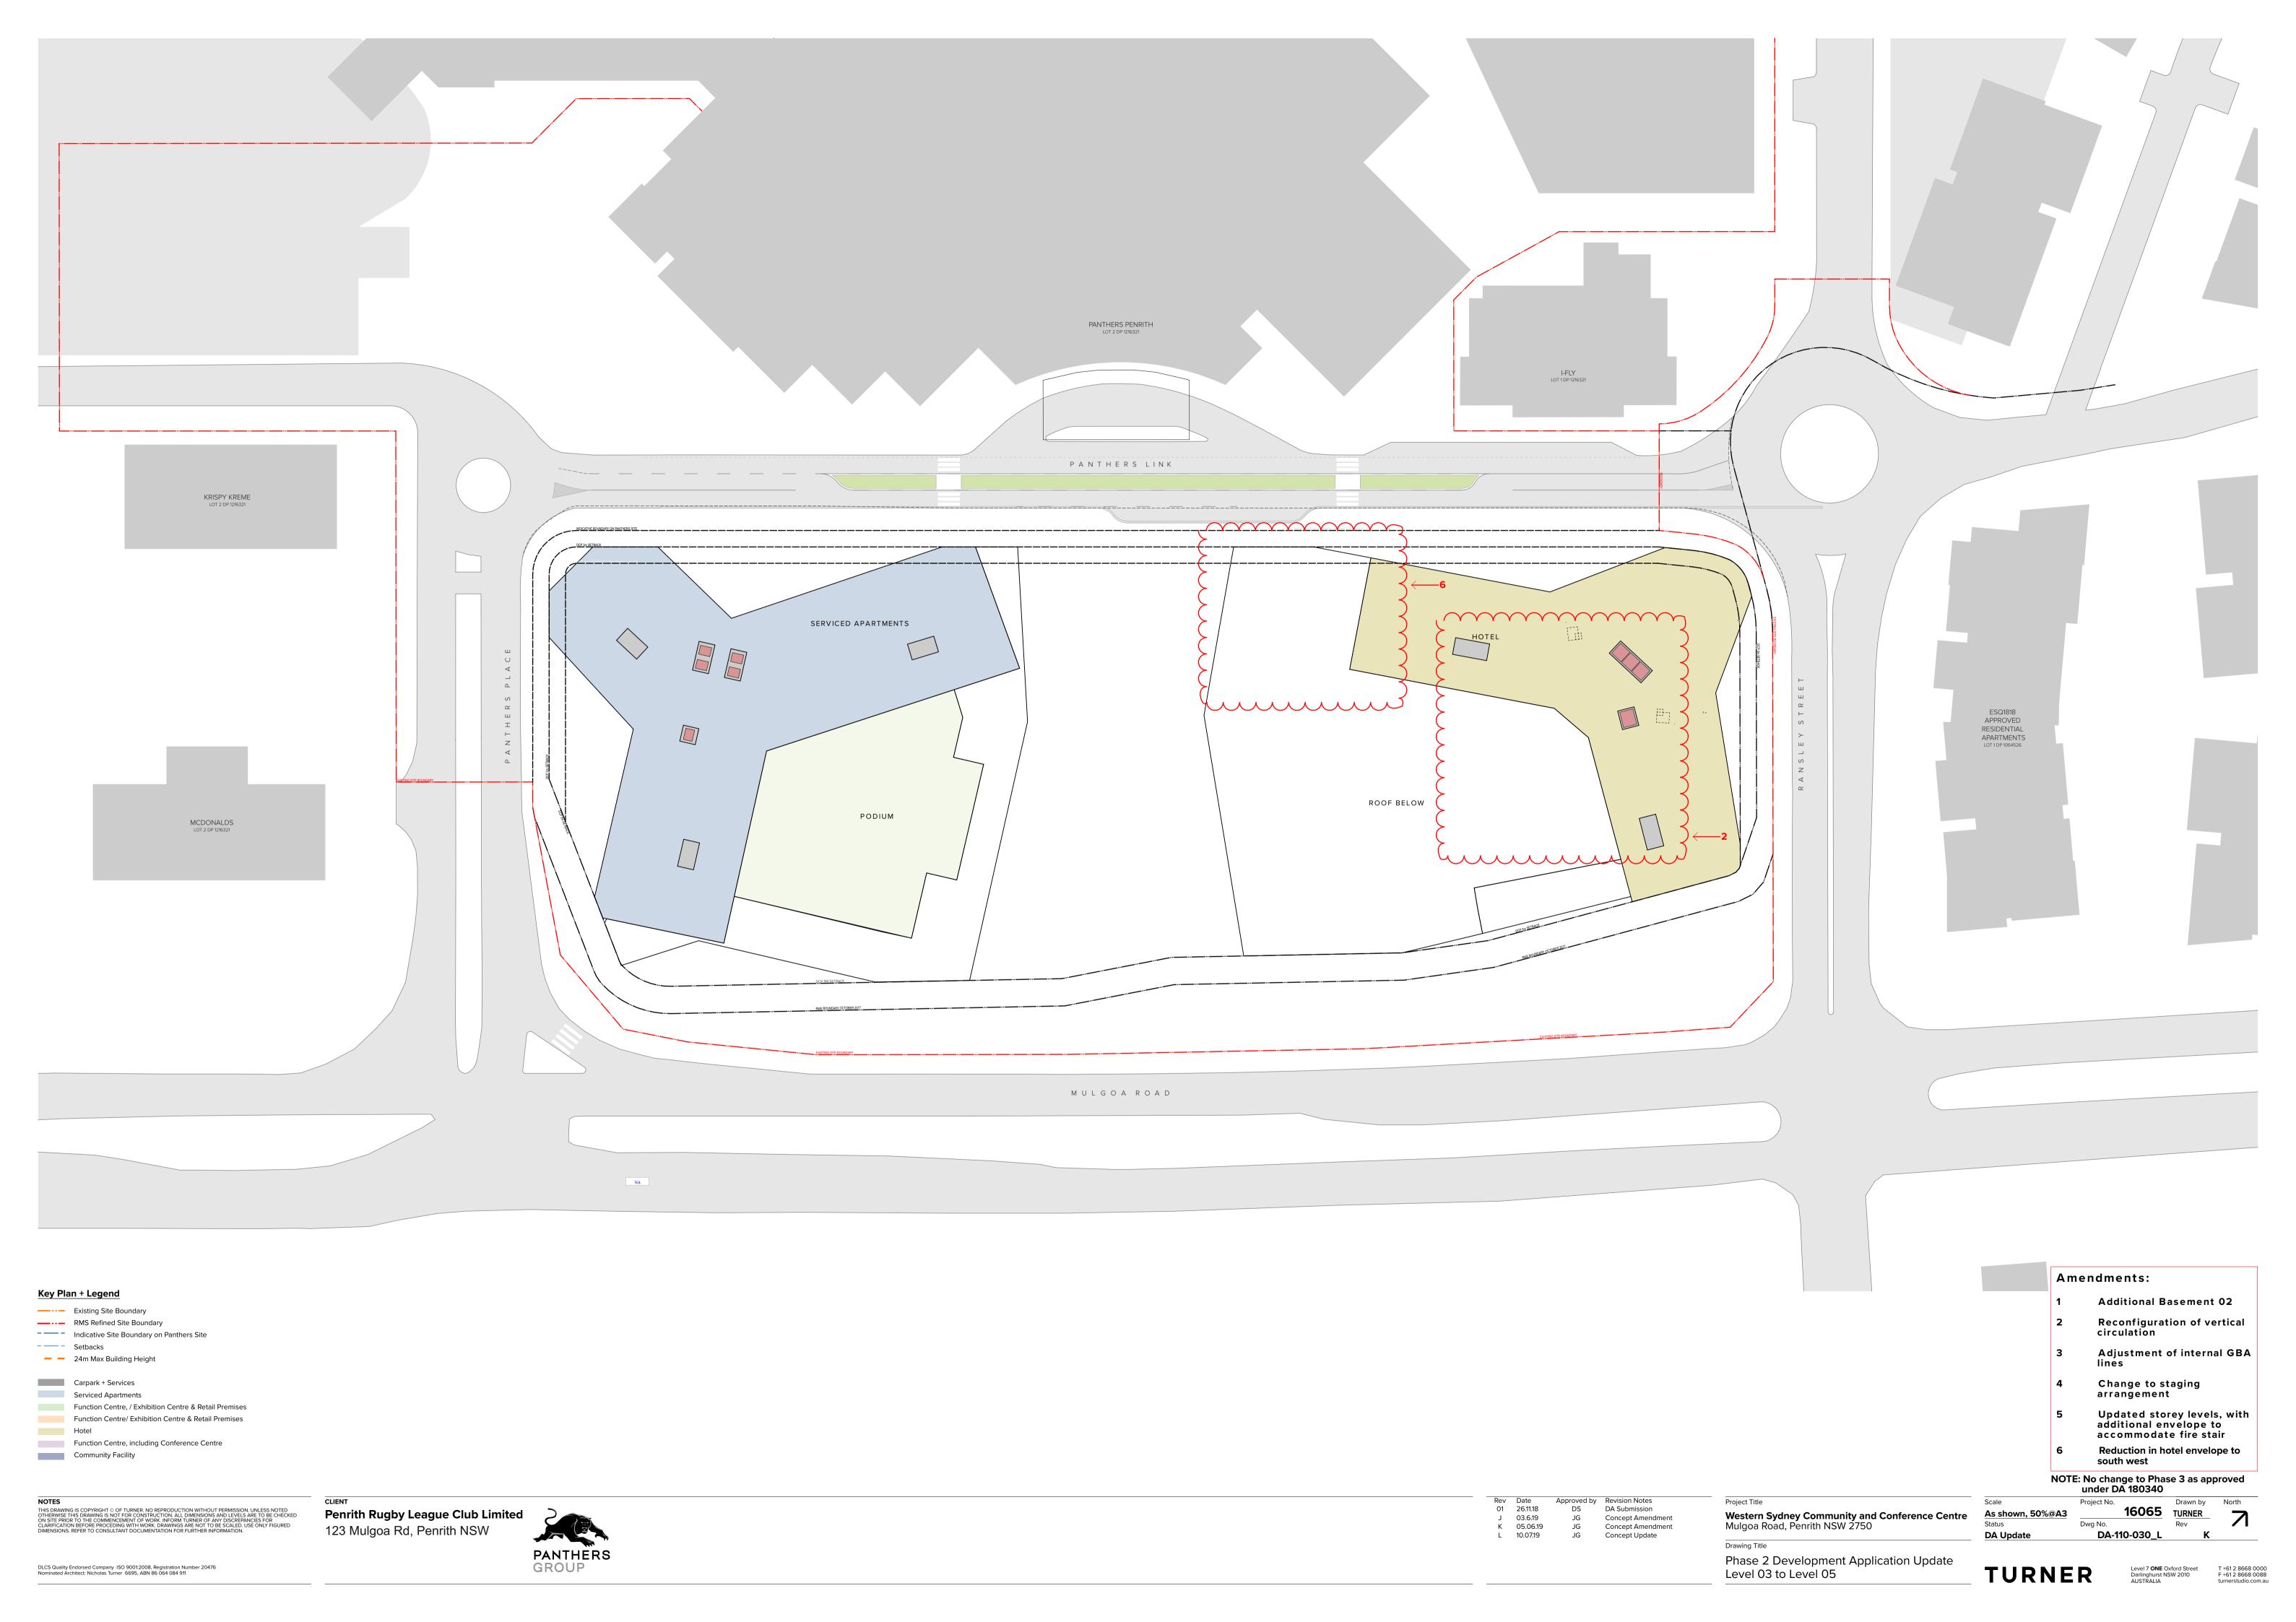

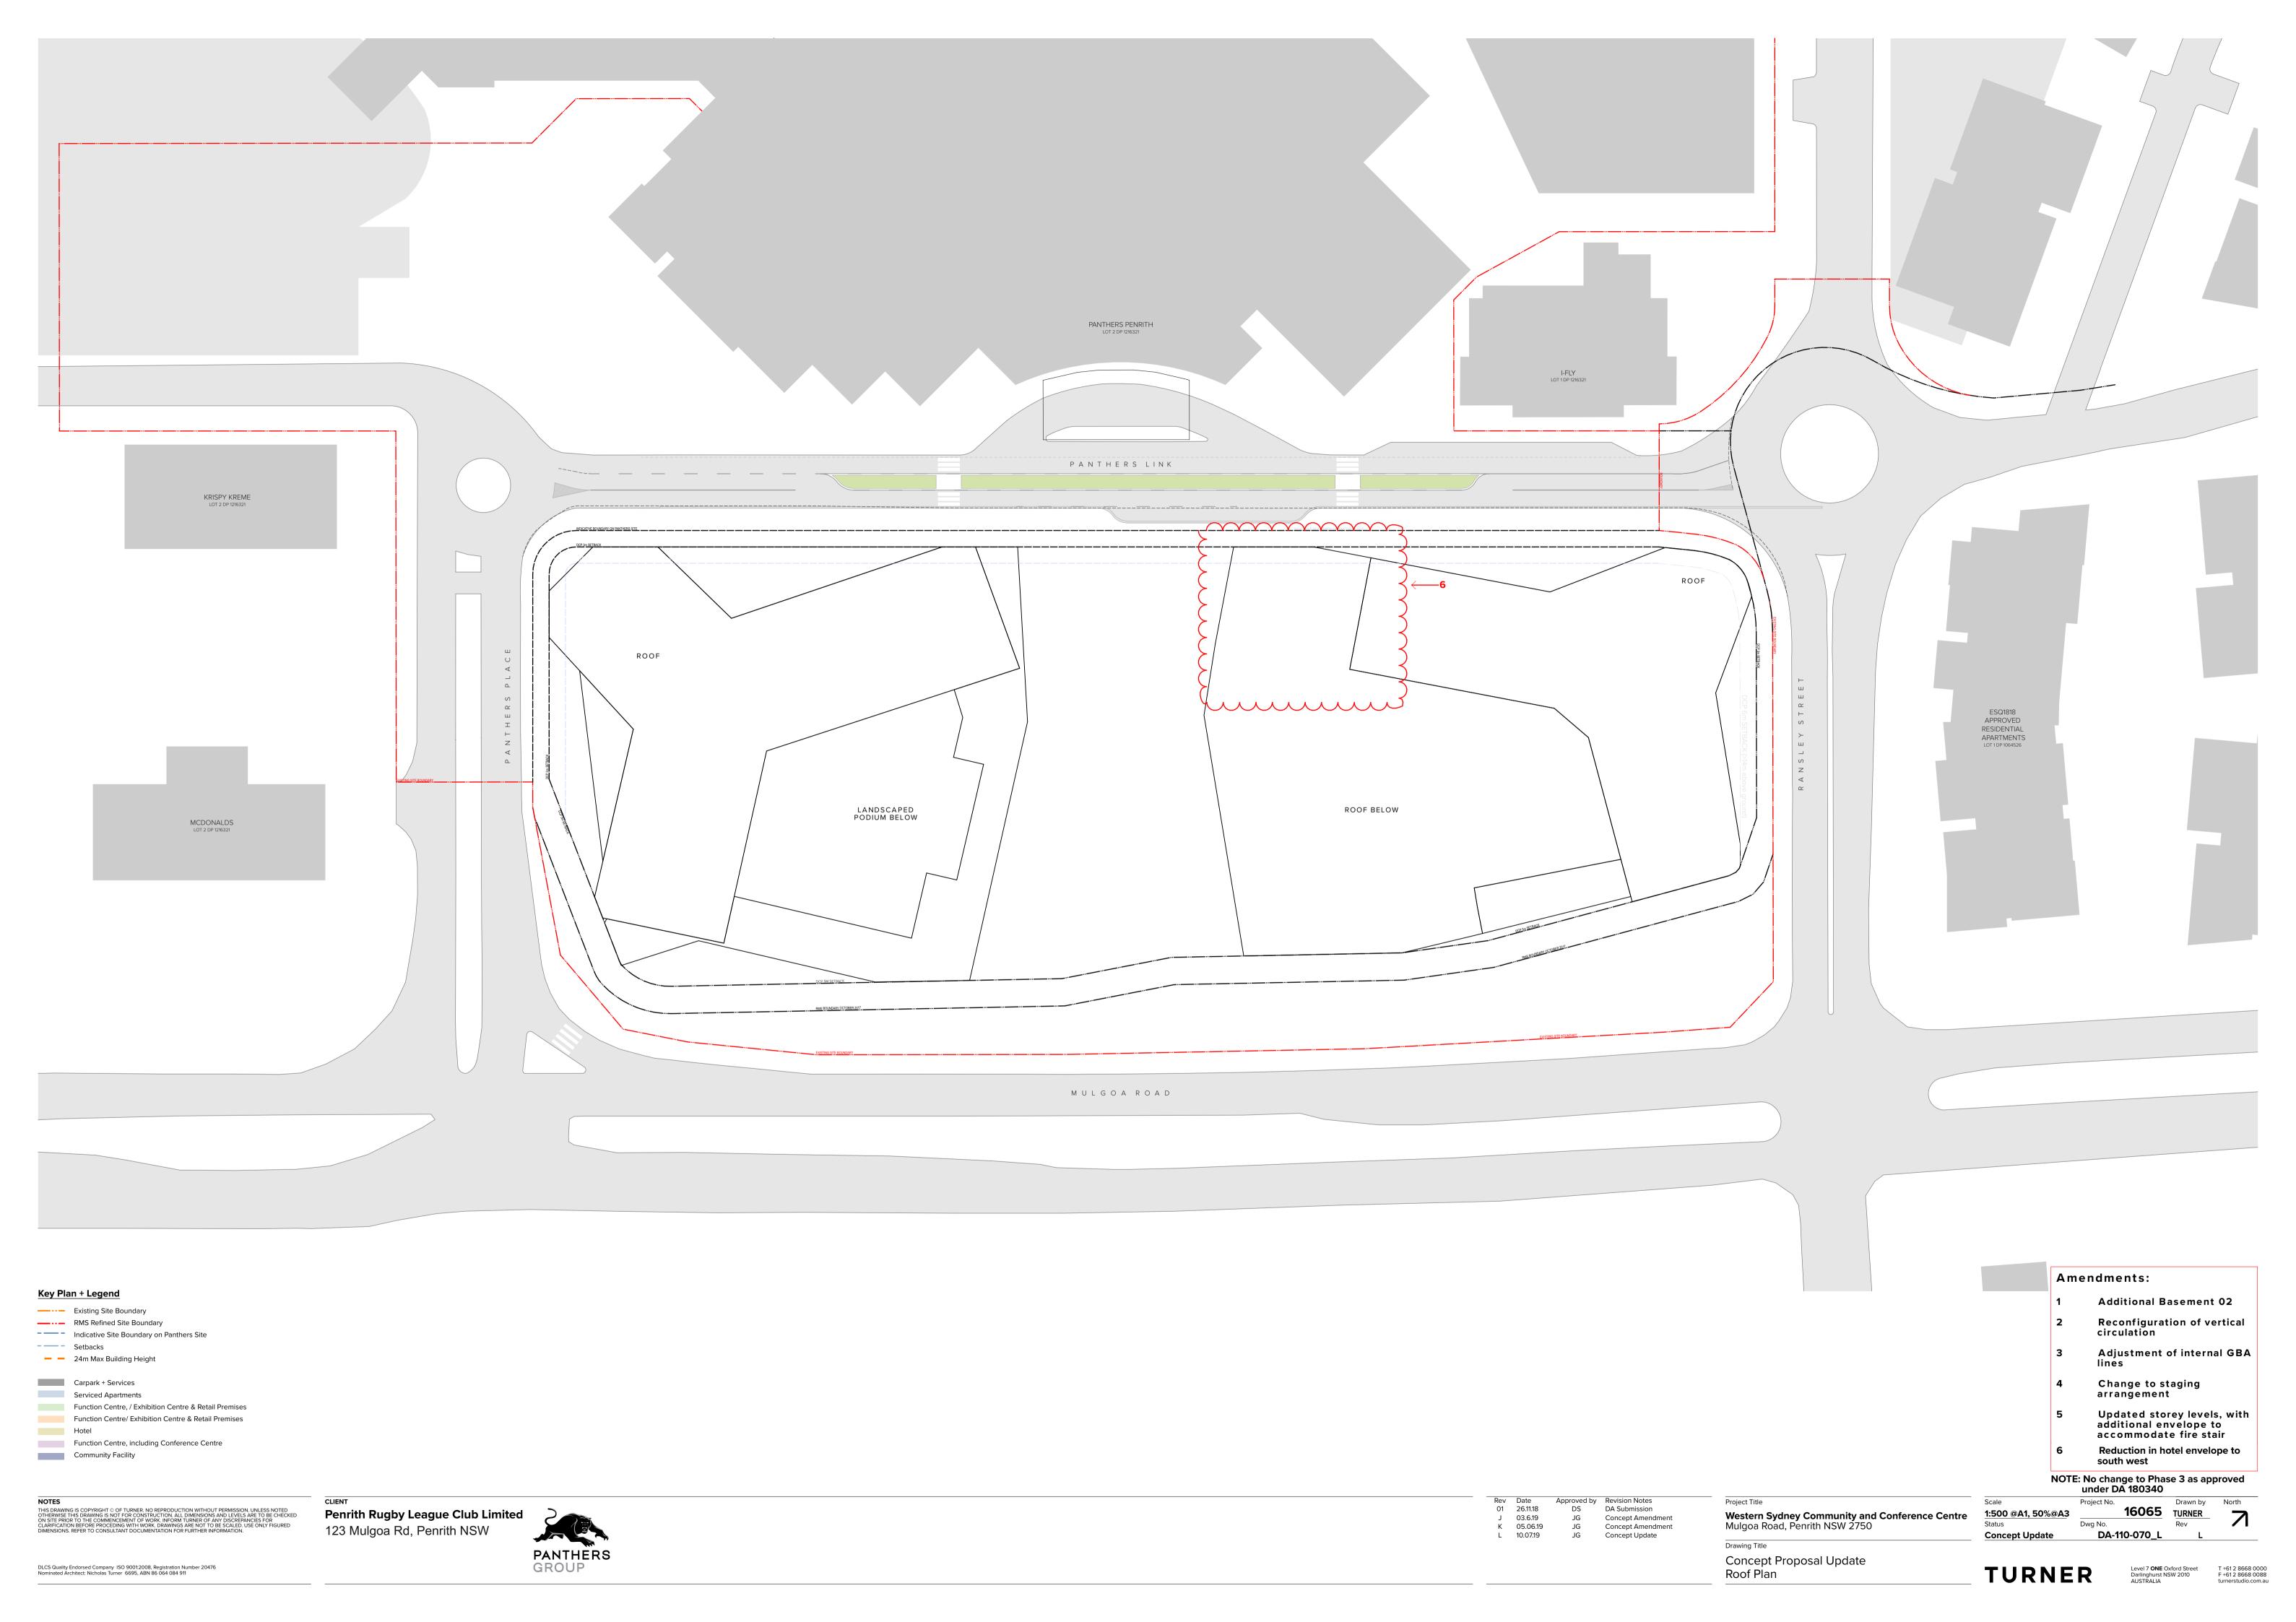


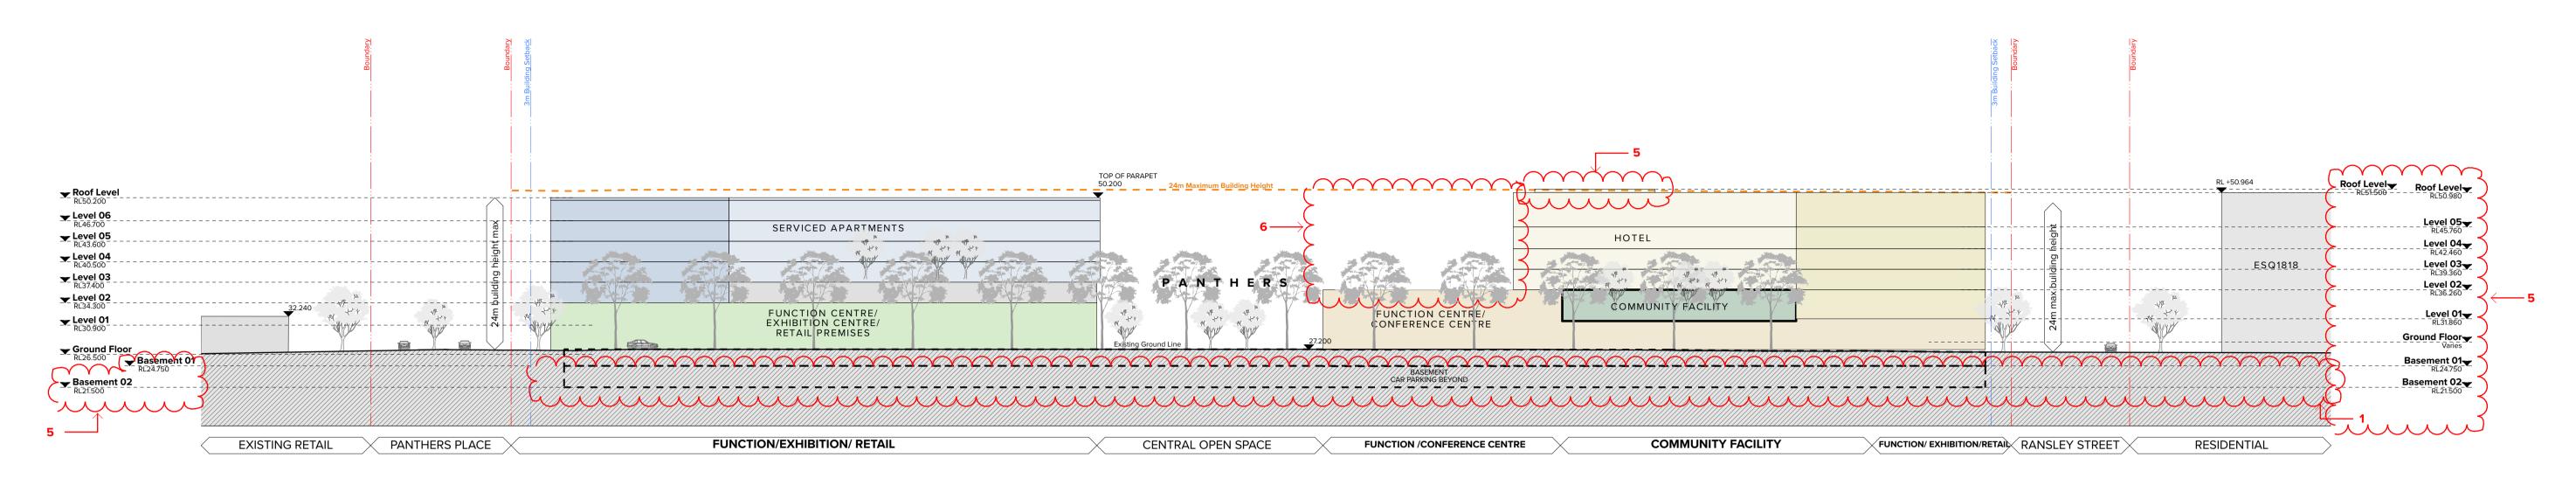

#### SOUTH EAST ELEVATION

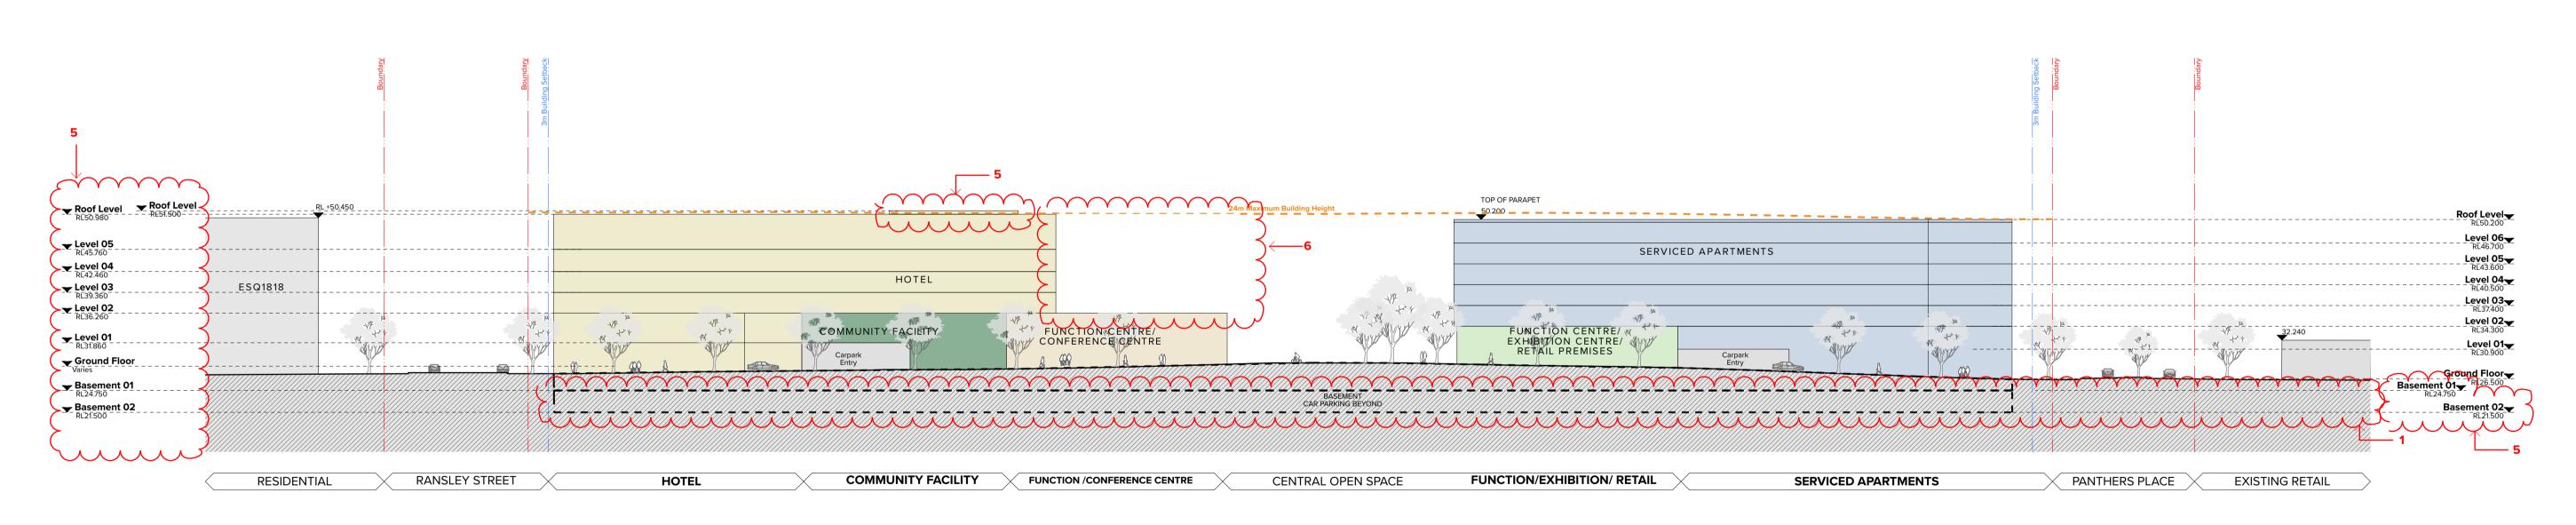

#### NORTH WEST ELEVATION

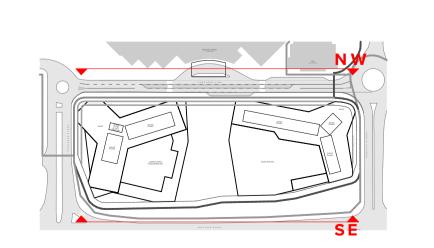

NOTES

THIS DRAWING IS COPYRIGHT © OF TURNER. NO REPRODUCTION WITHOUT PERMISSION, UNLESS NOTED OTHERWISE THIS DRAWING IS NOT FOR CONSTRUCTION, ALL DIMENSIONS AND LEVELS ARE TO BE CHECKED ON SITE PRIOR TO THE COMMENCEMENT OF WORK. INFORM TURNER OF ANY DISCREPANCIES FOR CLARIFICATION BEFORE PROCEDING WITH WORK. DRAWINGS ARE NOT TO BE SCALED. USE ONLY FIGURED DIMENSIONS, REFER TO CONSULTANT DOCUMENTATION FOR FURTHER INFORMATION.

Penrith Rugby League Club Limited
123 Mulgoa Rd, Penrith NSW

PANTHERS

PANTHERS

 Rev
 Date
 Approved by DA Submission

 01
 26.11.18
 DS
 DA Submission

 J
 03.6.19
 JG
 Concept Amendment

 K
 05.06.19
 JG
 Concept Amendment

 L
 10.07.19
 JG
 Concept Update

Project Title

Western Sydney Community and Conference Centre
Mulgoa Road, Penrith NSW 2750

Drawing Title

Concept Proposal Update

Site Elevations 01

NOTE: No change to Phase 3 as approved under DA 180340

Scale Project No.

1:500 @A1, 50%@A3
Status Drawn by TURNER
Rev North
Rev

south west

DA-200-001\_L

Amendments:

circulation

Additional Basement 02

Reconfiguration of vertical

Adjustment of internal GBA

Updated storey levels, with


Reduction in hotel envelope to


additional envelope to accommodate fire stair

Change to staging arrangement

TURNER

evel 7 **ONE** Oxford Street Tlarlinghurst NSW 2010 F-USTRALIA tui

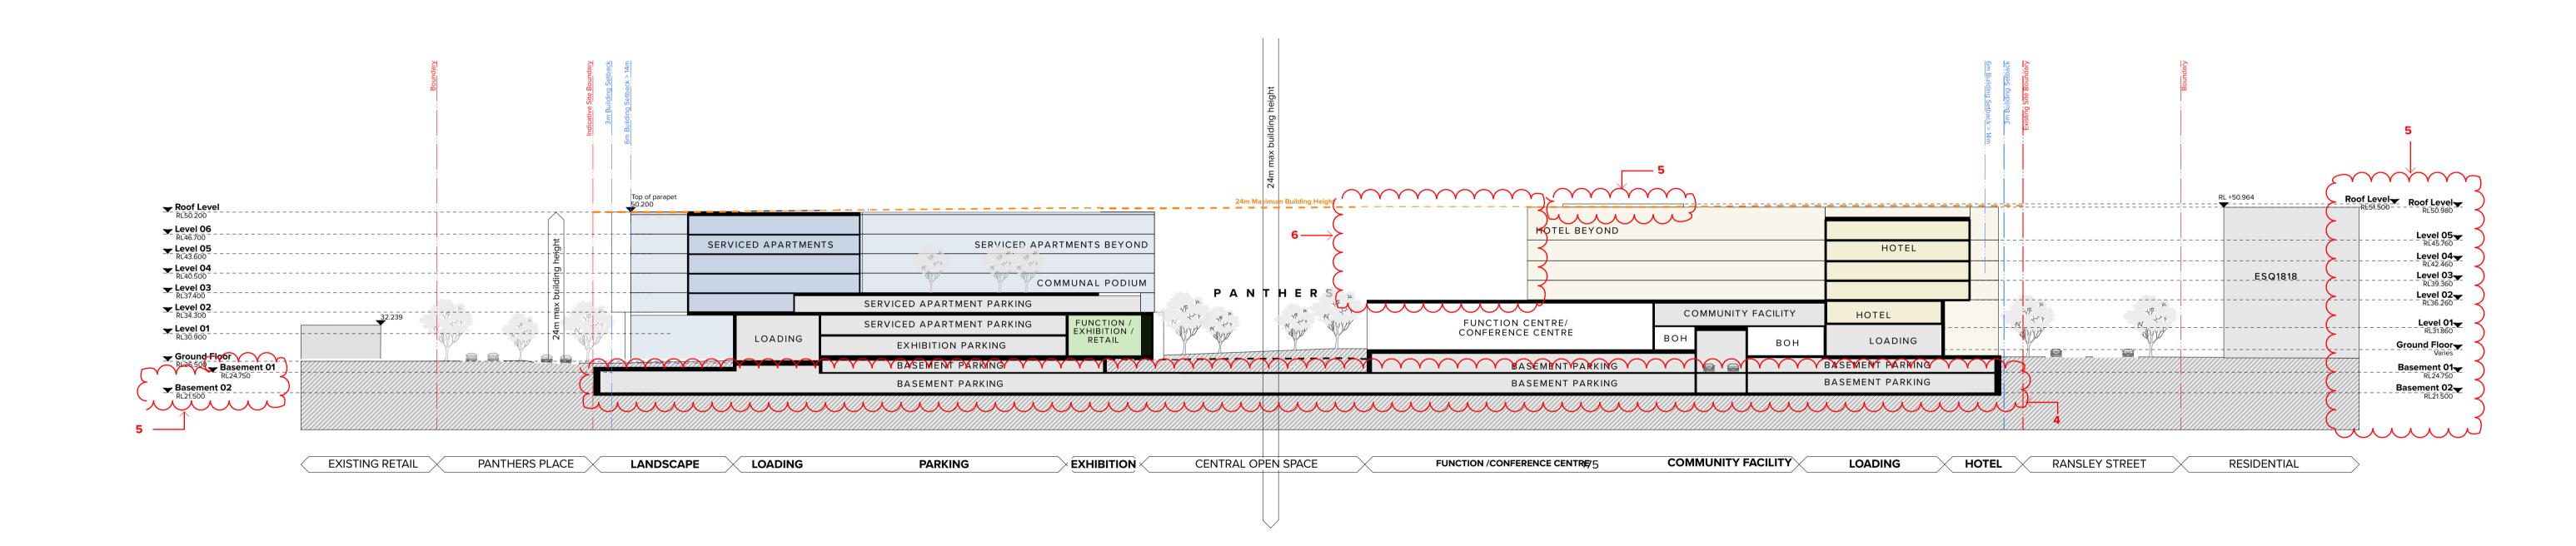

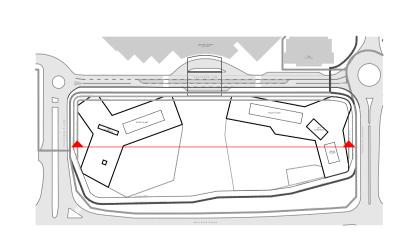

THIS DRAWING IS COPYRIGHT © OF TURNER. NO REPRODUCTION WITHOUT PERMISSION. UNLESS NOTED OTHERWISE THIS DRAWING IS NOT FOR CONSTRUCTION. ALL DIMENSIONS AND LEVELS ARE TO BE CHECKED ON SITE PRIOR TO THE COMMENCEMENT OF WORK. INFORM TURNER OF ANY DISCREPANCIES FOR CLARIFICATION BEFORE PROCEDING WITH WORK. DRAWINGS ARE NOT TO BE SCALED. USE ONLY FIGURED DIMENSIONS. REFER TO CONSULTANT DOCUMENTATION FOR FURTHER INFORMATION.

Penrith Rugby League Club Limited 123 Mulgoa Rd, Penrith NSW **PANTHERS** 

Rev Date 01 26.11.18 Approved by Revision Notes
DS DA Submission J 03.6.19 Concept Amendment K 05.06.19 Concept Amendment L 10.07.19 JG Concept Update

**Western Sydney Community and Conference Centre** Mulgoa Road, Penrith NSW 2750

Drawing Title

Concept Proposal Update

Longitudinal Section

south west NOTE: No change to Phase 3 as approved under DA 180340 16065 TURNER Rev 1:500 @A1, 50%@A3

Amendments:

circulation

Additional Basement 02

Reconfiguration of vertical

Adjustment of internal GBA

Updated storey levels, with additional envelope to accommodate fire stair

Reduction in hotel envelope to


Change to staging arrangement

DA-300-001\_L


Dwg No.

**TURNER** 


#### **BASEMENT 02**

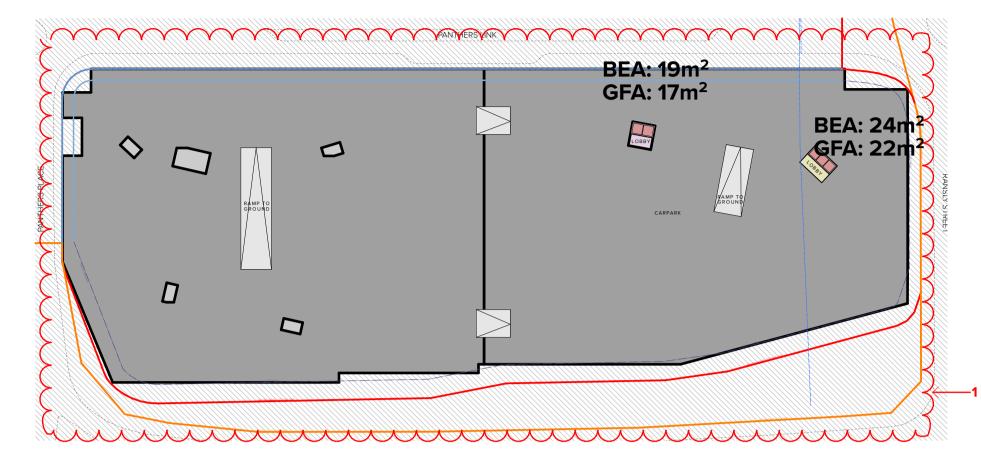


#### FIRST FLOOR

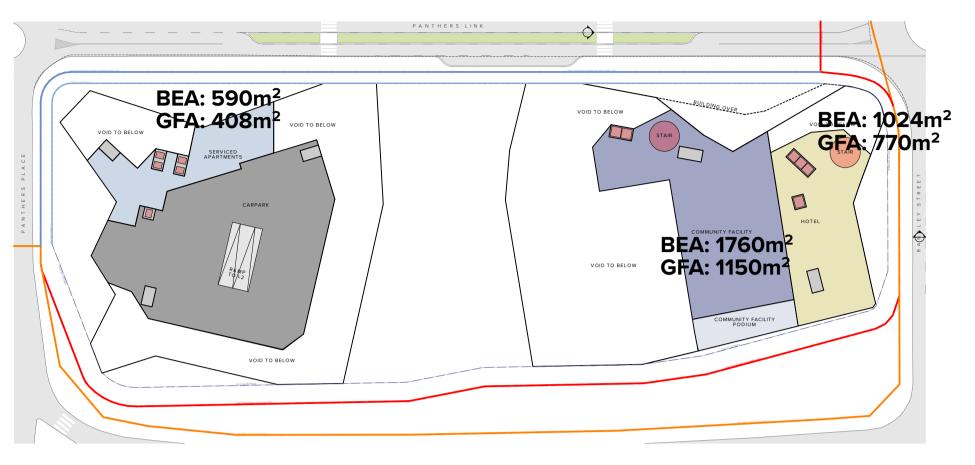


#### BASEMENT 01

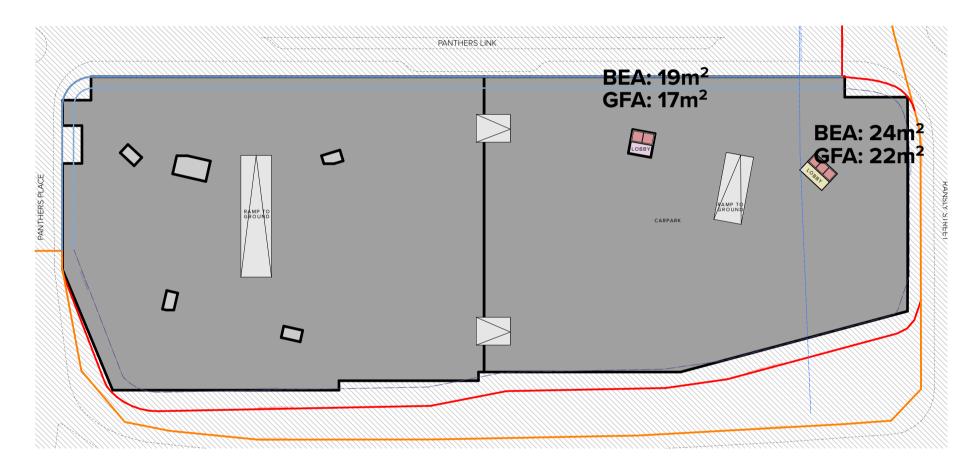


SECOND FLOOR

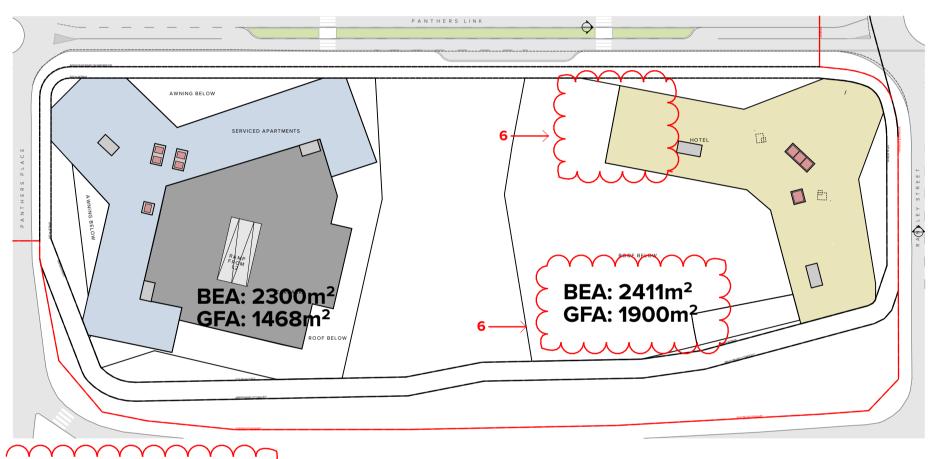

**GROUND FLOOR** 

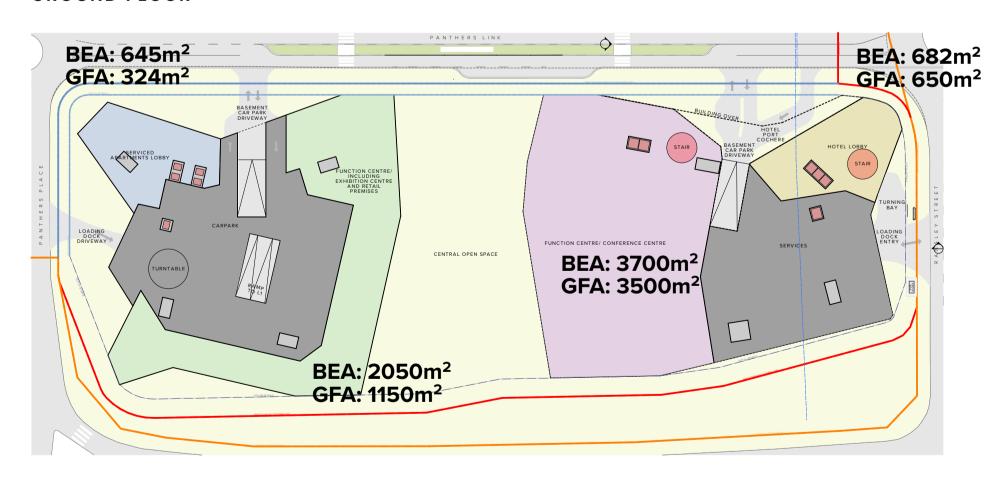

THIRD TO FIFTH FLOOR

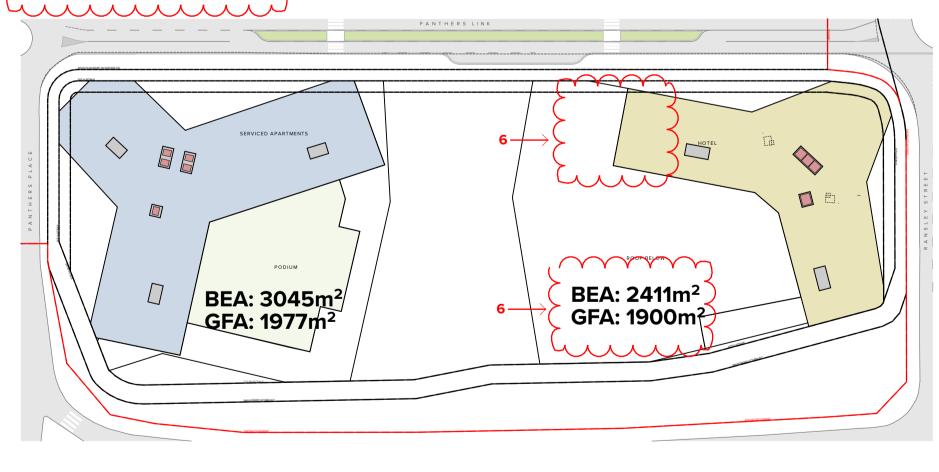

#### **GROSS FLOOR AREA**

Permissible FSR	1:1						
Lot 2 DP1216321		61,200n	1 <sup>2</sup>				
Existing GFA		33,445ı	m²				
Proposed GFA		27,755 ı	m²				
Proposed FSR		1:1					
		STAGE 1	I	STAGE	2	STAGE 3	
		BEA (m²	) GEA (m	2)_BEA (m2	V V 1	BEA (m <sup>2</sup> )	GFA (n
BASEMENT 02		<b>\</b> 19 ' '	17	24	22 4		
BASEMENT 01		19	17	24	22 🗸		
GROUND		( 3700	3500	682	650	2695	1474
LEVEL 01	3	→ <b>(</b> 1760	1150	1024	770)	590	408
LEVEL 02				<del>/\2</del> 411 /\	~1 <del>90</del> 0 )	2300	1468
LEVEL 03				2411	1900	3045	1977
LEVEL 04			<b>6</b> ──	2411	1900	3045	1977
LEVEL 05				2411	1900	3045	1977
LEVEL 06						3045	1977
STAGE TOTAL		5,141	4,684	11,398	9,064	17,760	11,258

**Total Proposed GFA** 25,006m<sup>2</sup>

GFA Diagrams

Amendments: Additional Basement 02

Reconfiguration of vertical circulation Adjustment of internal GBA

Change to staging arrangement

Updated storey levels, with additional envelope to accommodate fire stair

Reduction in hotel envelope to south west


NOTE: No change to Phase 3 as approved under DA 180340


Concept Update


16065 TURNER <u>1:1000 @A1, 50%@A</u>3 Dwg No. DA-720-001\_L

THIS DRAWING IS COPYRIGHT © OF TURNER. NO REPRODUCTION WITHOUT PERMISSION. UNLESS NOTED OTHERWISE THIS DRAWING IS NOT FOR CONSTRUCTION. ALL DIMENSIONS AND LEVELS ARE TO BE CHECKED ON SITE PRIOR TO THE COMMENCEMENT OF WORK. INFORM TURNER OF ANY DISCREPANCIES FOR CLARIFICATION BEFORE PROCEDING WITH WORK. DRAWINGS ARE NOT TO BE SCALED. USE ONLY FIGURED DIMENSIONS. REFER TO CONSULTANT DOCUMENTATION FOR FURTHER INFORMATION.



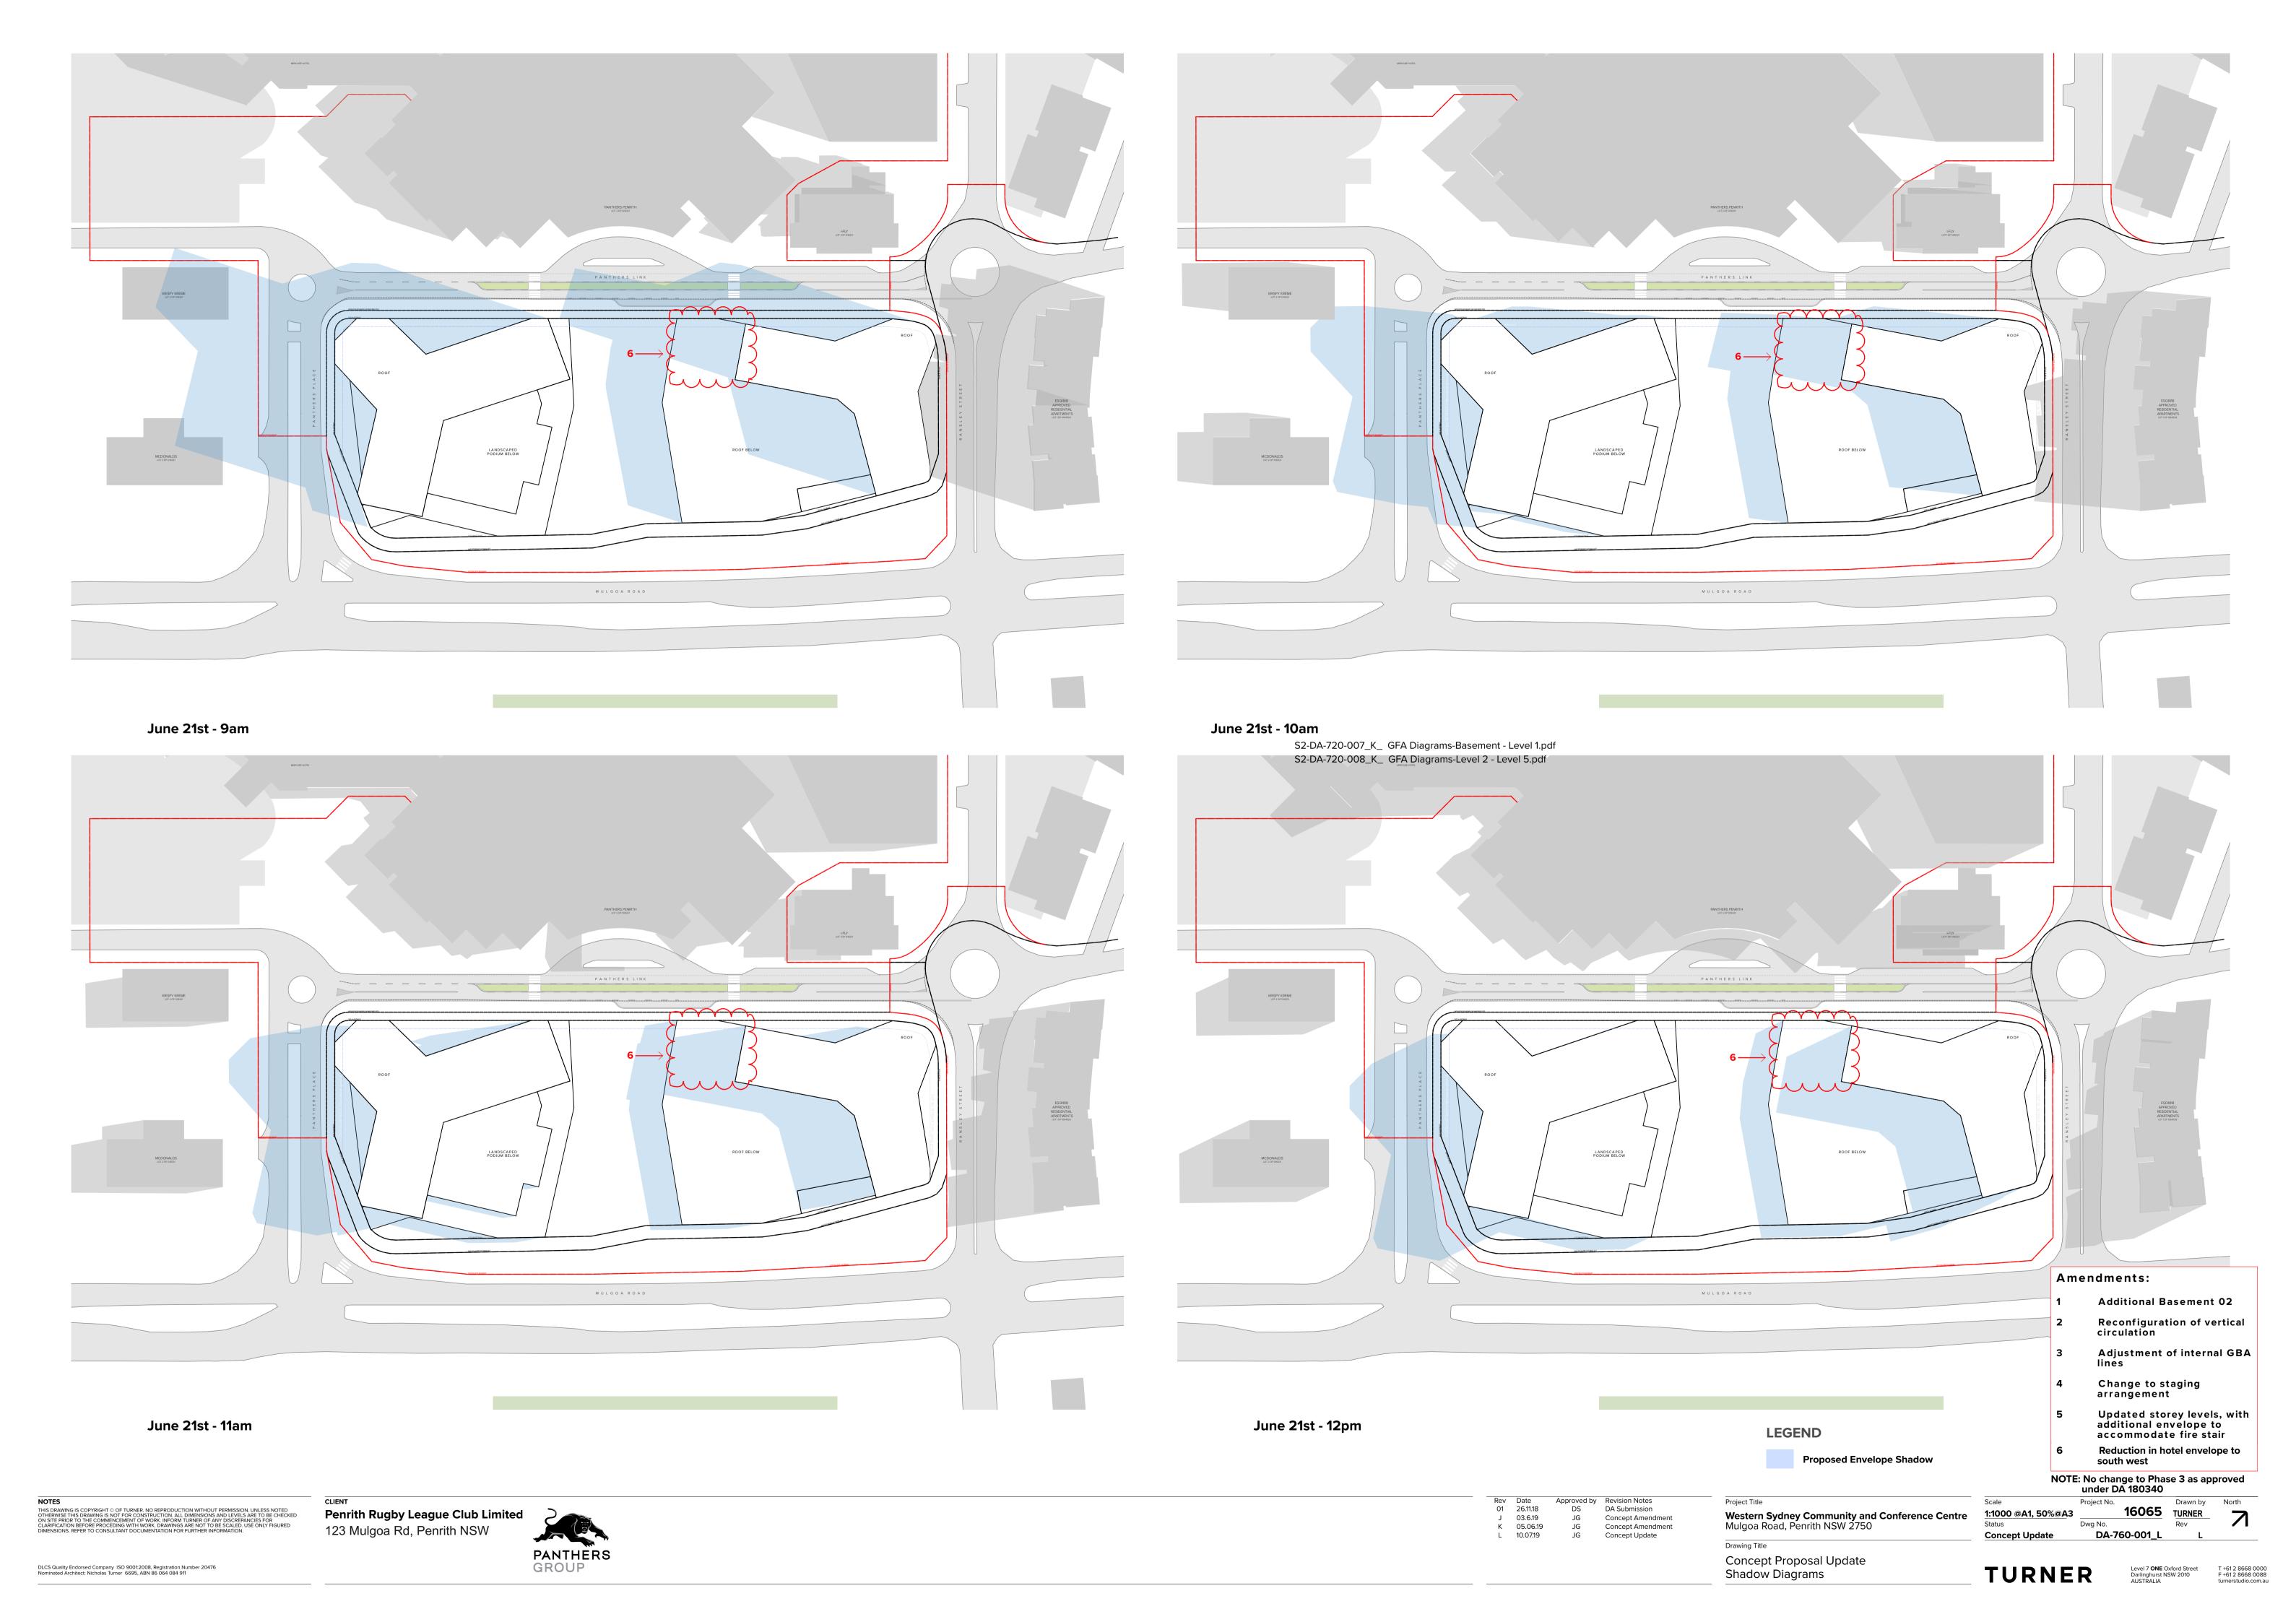

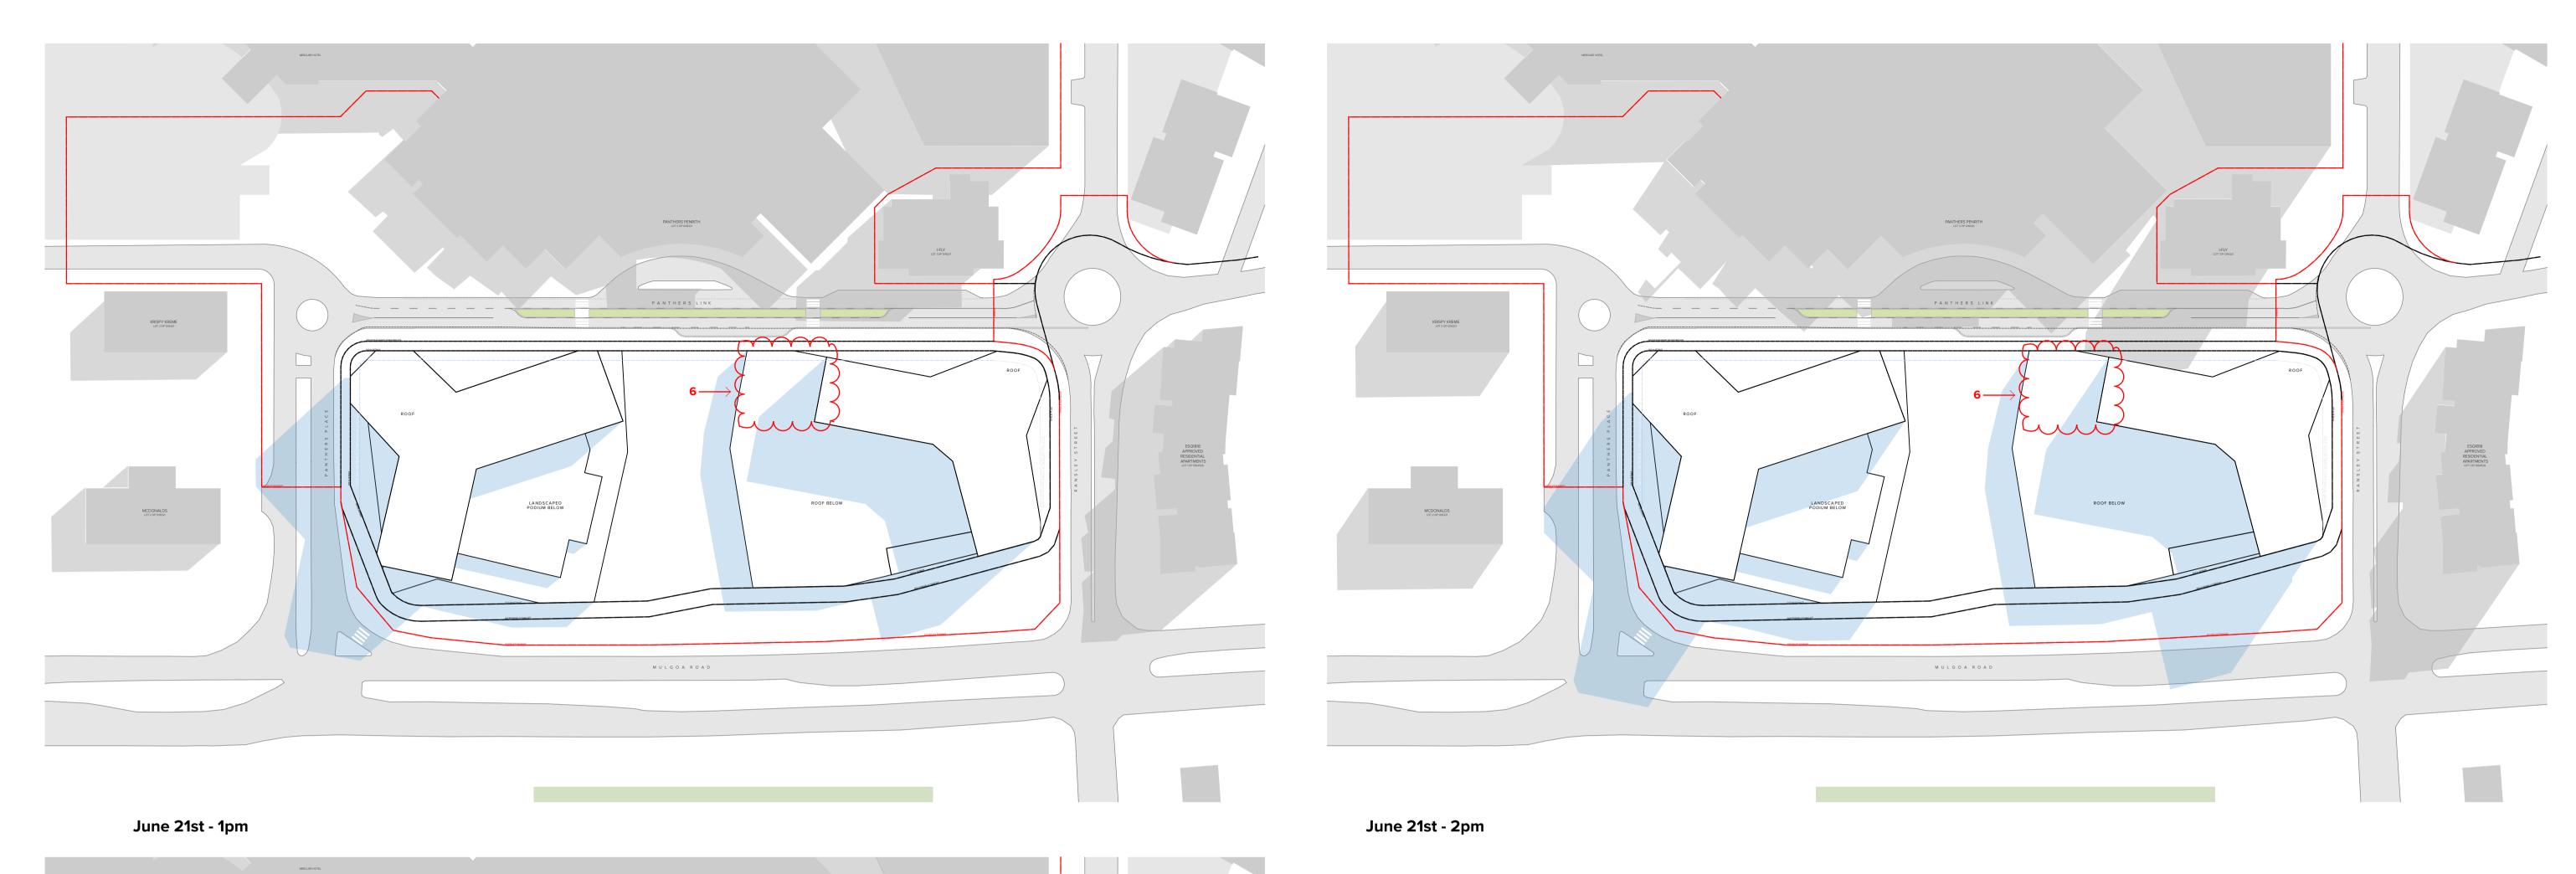

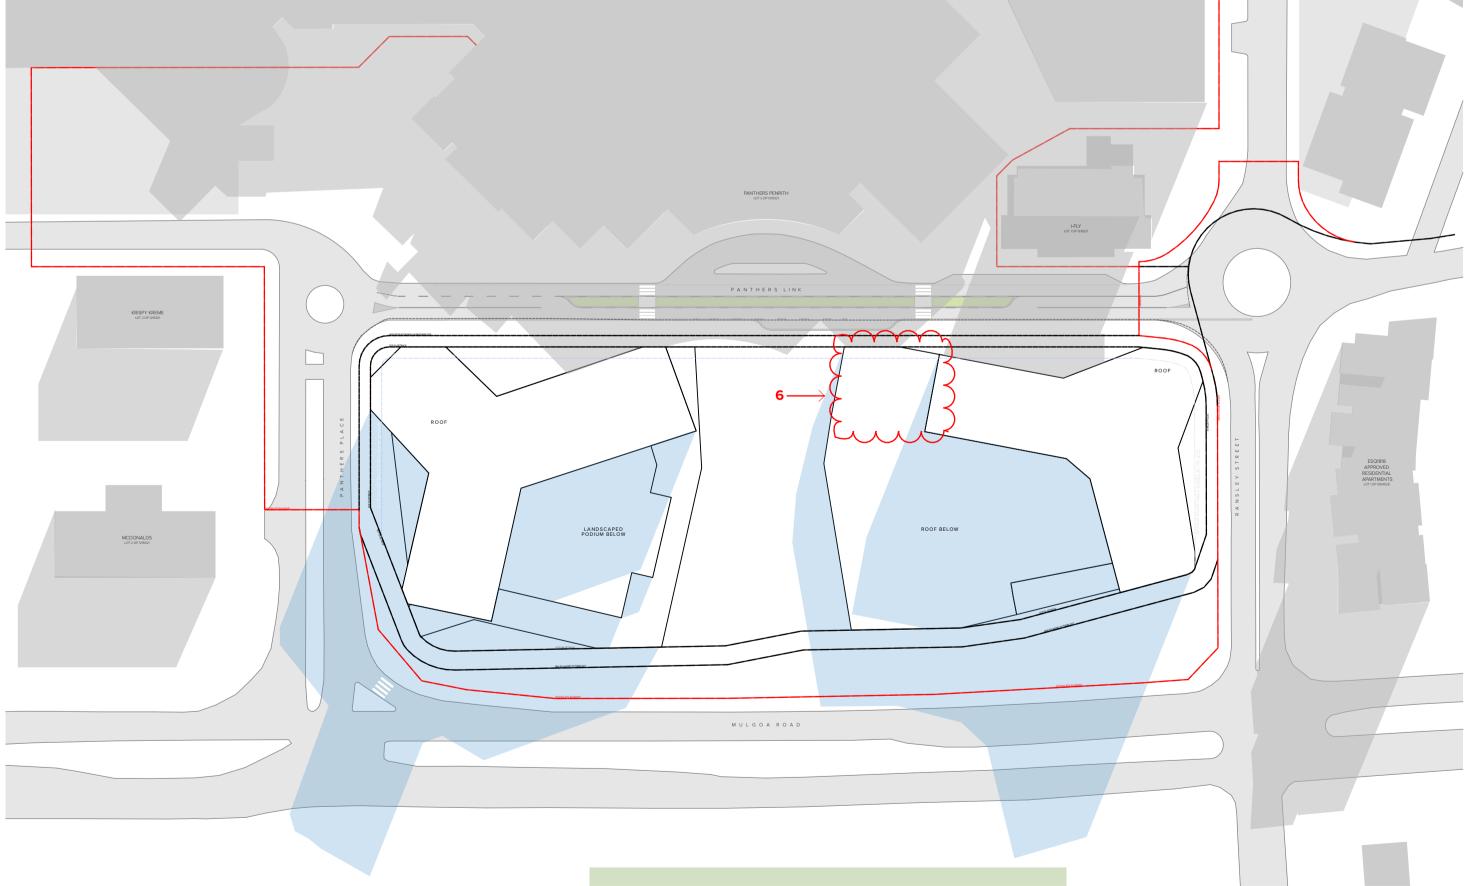

June 21st - 3pm

**LEGEND** 

Proposed Envelope Shadow

THIS DRAWING IS COPYRIGHT © OF TURNER. NO REPRODUCTION WITHOUT PERMISSION, UNLESS NOTED OTHERWISE THIS DRAWING IS NOT FOR CONSTRUCTION. ALL DIMENSIONS AND LEVELS ARE TO BE CHECKED ON SITE PRIOR TO THE COMMENCEMENT OF WORK. INFORM TURNER OF ANY DISCREPANCIES FOR CLARIFICATION BEFORE PROCEDING WITH WORK. DRAWINGS ARE NOT TO BE SCALED. USE ONLY FIGURED DIMENSIONS. REFER TO CONSULTANT DOCUMENTATION FOR FURTHER INFORMATION.

Penrith Rugby League Club Limited 123 Mulgoa Rd, Penrith NSW



RevDateApproved byRevision Notes0126.11.18DSDA SubmissionJ03.6.19JGConcept AmendmentK05.06.19JGConcept AmendmentL10.07.19JGConcept Update

**Western Sydney Community and Conference Centre** Mulgoa Road, Penrith NSW 2750

Drawing Title Concept Proposal Update Shadow Diagrams Amendments:

Additional Basement 02

Reconfiguration of vertical circulation

Adjustment of internal GBA

Change to staging arrangement

Updated storey levels, with additional envelope to accommodate fire stair

Reduction in hotel envelope to south west

DA-760-002\_L

NOTE: No change to Phase 3 as approved under DA 180340


16065 TURNER Rev 1:1000 @A1, 50%@A3 Dwg No.


**TURNER** 

Concept Update

# BASEMENT 02 PANTHERS LINK BASEMENT 01 PANTHERS LINK

## SECOND FLOOR

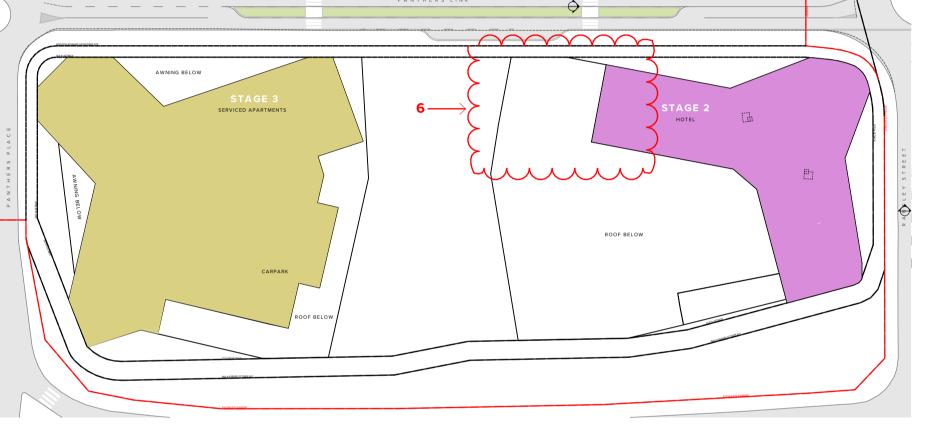

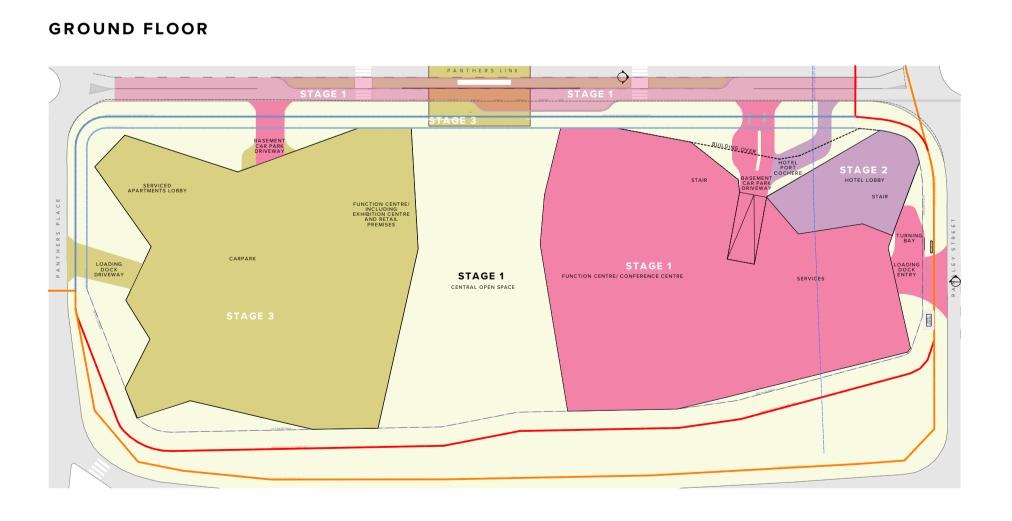


tururur -4



FIRST FLOOR



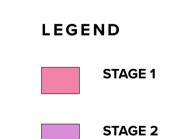

STAGE 3

Amendments:

Additional Basement 02 Reconfiguration of vertical circulation

Adjustment of internal GBA

Change to staging arrangement

Updated storey levels, with additional envelope to accommodate fire stair

Reduction in hotel envelope to

DA-800-001\_L

south west

NOTE: No change to Phase 3 as approved under DA 180340 16065 TURNER Rev

THIS DRAWING IS COPYRIGHT © OF TURNER. NO REPRODUCTION WITHOUT PERMISSION. UNLESS NOTED OTHERWISE THIS DRAWING IS NOT FOR CONSTRUCTION. ALL DIMENSIONS AND LEVELS ARE TO BE CHECKED ON SITE PRIOR TO THE COMMENCEMENT OF WORK. INFORM TURNER OF A NY DISCREPANCIES FOR CLARIFICATION BEFORE PROCEDING WITH WORK. DRAWINGS ARE NOT TO BE SCALED. USE ONLY FIGURED DIMENSIONS. REFER TO CONSULTANT DOCUMENTATION FOR FURTHER INFORMATION.



123 Mulgoa Rd, Penrith NSW

Rev Date Approved by Revision Notes
01 26.11.18 DS DA Submission JG Concept Amendment J 03.6.19 K 05.06.19 JG Concept Amendment L 10.07.19 JG Concept Update

**Western Sydney Community and Conference Centre** Mulgoa Road, Penrith NSW 2750

@A1, 50%@A3

Concept Update