

PREPARED FOR:





LOCALITY SKETCH


LOT 5 DP1272931 LANDCOM EDMONDSON PARK PRECINCT 3 DA CIVIL DRAWINGS

ISSUED FOR DEVELOPMENT APPLICATION NOT FOR CONSTRUCTION 22-514-DA-C010 E 27.05.2024

DRAWING LIST TABLE

DRAWING NUMBER DRAWING TITI F

ING NUMBER	DRAWING TITLE	DRAWING NUMBER
C010	COVER SHEET	C170
C100	GENERAL ARRANGEMENT PLAN	C171
C105	NOTES AND LEGENDS SHEET	C175
C120	SEDIMENT AND EROSION CONTROL PLAN SHEET 1	C176
C121	SEDIMENT AND EROSION CONTROL PLAN SHEET 2	C200
C122	SEDIMENT AND EROSION CONTROL PLAN SHEET 3	C200
C130	SITE CUT AND FILL PLAN SHEET 1	C202
C131	SITE CUT AND FILL PLAN SHEET 2	C202
C135	SITE SECTIONS SHEET 1	C203
C136	SITE SECTIONS SHEET 2	
C137	SITE SECTIONS SHEET 3	C205
C138	SITE SECTIONS SHEET 4	C206
C150	ALIGNMENT CONTROL PLAN SHEET 1	C207
C151	ALIGNMENT CONTROL PLAN SHEET 2	C208
C155	TYPICAL ROAD SECTIONS SHEET 1	C209
C156	TYPICAL ROAD SECTIONS SHEET 2	C210
C157	TYPICAL ROAD SECTIONS SHEET 3	C211
C160	ROAD LONGITUDINAL SECTIONS SHEET 1	C215
C161	ROAD LONGITUDINAL SECTIONS SHEET 2	C216
C162	ROAD LONGITUDINAL SECTIONS SHEET 3	C230
C163	ROAD LONGITUDINAL SECTIONS SHEET 4	C231
C164	ROAD LONGITUDINAL SECTIONS SHEET 5	C240
C165	ROAD LONGITUDINAL SECTIONS SHEET 6	C241
C166	ROAD LONGITUDINAL SECTIONS SHEET 7	C245
0100		C250

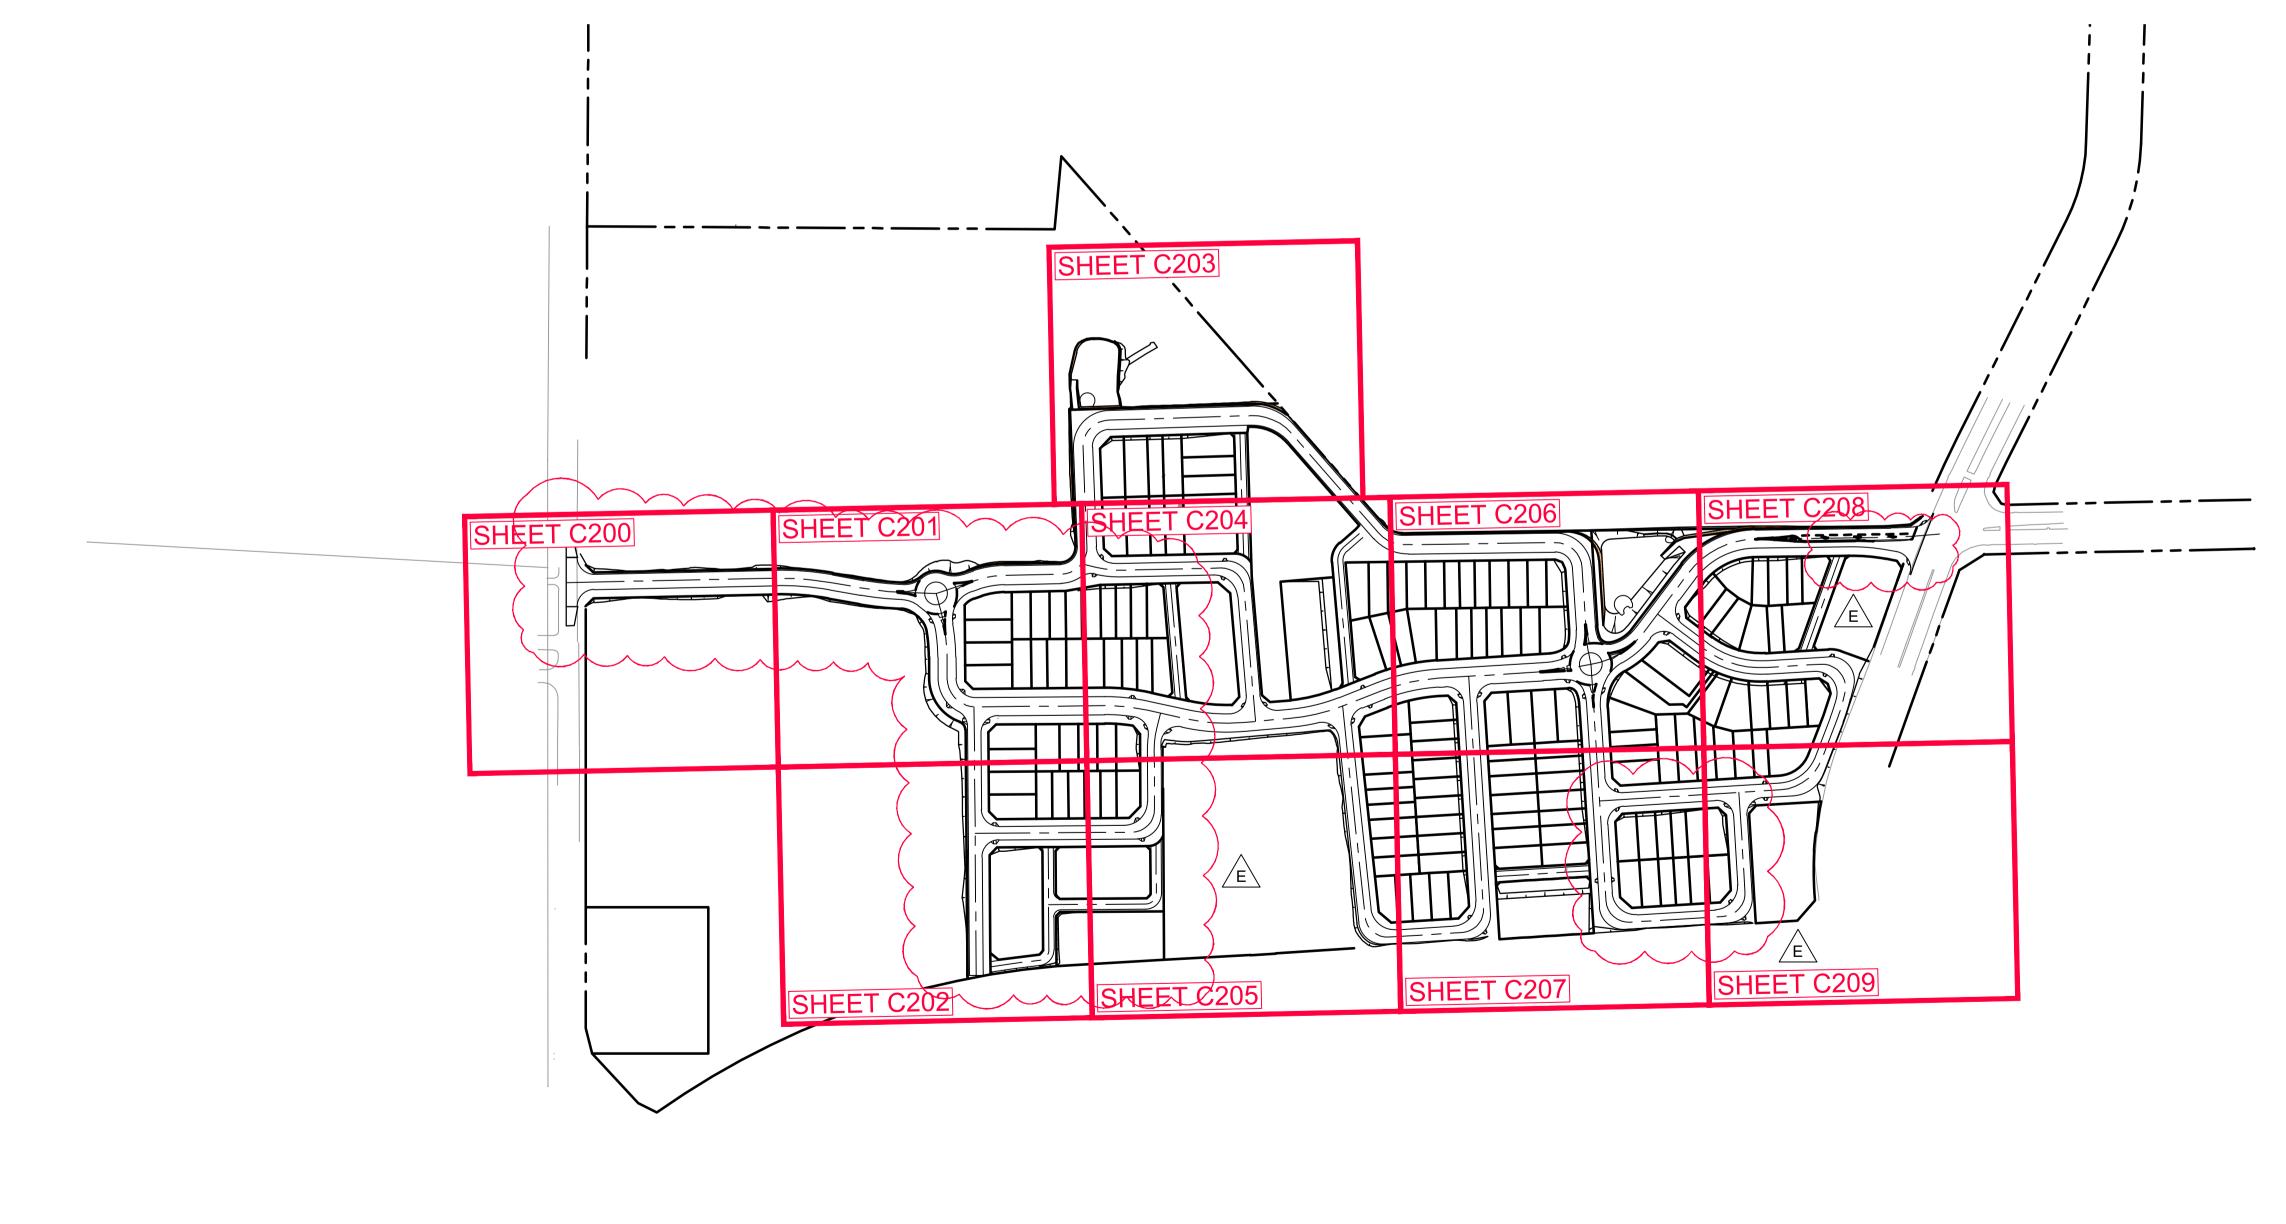

DRAWING LIST TABLE

DRAWING TITLE

LANEWAY ALIGNMENT CONTROL PLAN SHEET 1 LANEWAY ALIGNMENT CONTROL PLAN SHEET 2 LANEWAY LONGITUDINAL SECTIONS SHEET 1 LANEWAY LONGITUDINAL SECTIONS SHEET 2 SITEWORKS PLAN SHEET 1

SITEWORKS PLAN SHEET 2 SITEWORKS PLAN SHEET 3 SITEWORKS PLAN SHEET 4 SITEWORKS PLAN SHEET 5 SITEWORKS PLAN SHEET 6 SITEWORKS PLAN SHEET 7 SITEWORKS PLAN SHEET 8 SITEWORKS PLAN SHEET 9 SITEWORKS PLAN SHEET 10 PAVEMENT PLAN SHEET 1 PAVEMENT PLAN SHEET 2 RETAINING WALL PLAN SHEET 1 **RETAINING WALL PLAN SHEET 2** TEMPORARY BASIN PLAN SHEET 1

TEMPORARY BASIN PLAN SHEET 2 DRAINS CATCHMENT PLAN SHEET 1 DRAINS CATCHMENT PLAN SHEET 2 MUSIC CATCHMENT PLAN

SIGNAGE AND LINEMARKING PLAN SHEET 1

DRAWING LIST TABLE

DRAWING NUMBER

C251
C252
C253
C255
C256
C257
C258
C259
C260
C261
C262
C263
C264

C265

DRAWING TITLE SIGNAGE AND LINEMARKING PLAN SHEET 2 SIGNAGE AND LINEMARKING PLAN SHEET 3 SIGNAGE AND LINEMARKING PLAN SHEET 4 VEHICLE SIMULATION PLAN SHEET 1 VEHICLE SIMULATION PLAN SHEET 2 VEHICLE SIMULATION PLAN SHEET 3 VEHICLE SIMULATION PLAN SHEET 4 VEHICLE SIMULATION PLAN SHEET 5 VEHICLE SIMULATION PLAN SHEET 6 VEHICLE SIMULATION PLAN SHEET 7 VEHICLE SIMULATION PLAN SHEET 8 VEHICLE SIMULATION PLAN SHEET 9 VEHICLE SIMULATION PLAN SHEET 10 VEHICLE SIMULATION PLAN SHEET 11

				r
	07.05.01		0.15	
E	27.05.24	RE-ISSUED FOR DA RE-ISSUED FOR DA	GAP GAP	DF DF
D C	13.09.23	RE-ISSUED FOR DA	GAP GAP	
В	24.01.23	ISSUED FOR DA	GAP	
A	20.01.23	ISSUED FOR INFORMATION	GAP	C.
	Date	Description	Drawn	
Rev	0			
O	- A A A A A A A A A A A A A A A A A A A	infrastructure & development Suite 8.01, 56 Clarence Stree Sydney, NSW 2000 e admin@idcaus.com w www.idcaus.com		
PRO	JECT LAND EDMC LOT 5	Suite 8.01, 56 Clarence Stree Sydney, NSW 2000 e admin@idcaus.com www.idcaus.com	et	
PRO	JECT LAND EDMC LOT 5 CAMP	Suite 8.01, 56 Clarence Stree Sydney, NSW 2000 e admin@idcaus.com www.idcaus.com	^{et}	
PRO	JECT LANDO EDMC LOT 5 CAMP	STATUS	^{et}	

GENERAL NOTES

- ALL WORKS TO BE CARRIED OUT IN ACCORDANCE WITH COUNCIL REQUIREMENTS AND / OR AS DIRECTED BY THEIR REPRESENTATIVE;
- 2. THESE DRAWINGS ARE TO BE READ IN CONJUNCTION WITH ALL RELEVANT COUNCIL SPECIFICATIONS AND OTHER CONSULTANT DRAWINGS. ANY DISCREPANCIES SHALL BE REPORTED TO THE SUPERINTENDENT FOR CLARIFICATION BEFORE PROCEEDING WITH THE WORK;
- THE CONTRACTOR SHALL NOT ENTER UPON NOR DO ANY WORK WITHIN ADJOINING PROPERTIES WITHOUT THE WRITTEN PERMISSION OF THE OWNERS OR THE RELEVANT AUTHORITY;
- NO TREES ARE TO BE REMOVED OTHER THAN THOSE NOTED ON PLAN WITHOUT FIRST OBTAINING WRITTEN PERMISSION FROM COUNCIL;
- TREES TO BE RETAINED ON SITE SHALL BE PROTECTED BY SUITABLE BARRIER FENCING OR APPROVED EQUIVALENT PRIOR TO THE COMMENCEMENT OF WORKS;
- 6. INFRASTRUCTURE & DEVELOPMENT CONSULTING ACCEPTS NO RESPONSIBILITY FOR ANY SURVEY INFORMATION PROVIDED. ALL SURVEY INFORMATION SHOULD BE CONFIRMED BY A REGISTERED SURVEYOR PRIOR TO CONSTRUCTION. ANY DISCREPANCIES, OMISSIONS OR ERRORS SHALL BE REPORTED TO THE SUPERINTENDENT FOR CLARIFICATION BEFORE PROCEEDING WITH THE WORK;
- SURVEY MARKS SHALL BE RETAINED AT ALL TIMES WHERE POSSIBLE. IF A SURVEY MARK IS TO BE REMOVED THE SUPERINTENDENT IS TO BE NOTIFIED AND THE CONTRACTOR IS TO FIRST OBTAIN CONSENT FROM THE DEPARTMENT OF LAND AND PROPERTY INFORMATION NSW PRIOR TO REMOVAL;
- 8. THE CONTRACTOR IS TO ARRANGE FOR ALL SITE SET OUT AND CONTROL POINTS BY A REGISTERED SURVEYOR;
- 9. IT IS THE CONTRACTORS RESPONSIBILITY TO LOCATE THE LINE AND LEVEL OF ALL EXISTING SERVICES PRIOR TO THE COMMENCEMENT OF ANY CONSTRUCTION WORKS AND MAKE ARRANGEMENTS TO RELOCATE OR ADJUST IF NECESSARY. ANY DISCREPANCIES SHALL BE REPORTED TO THE SUPERINTENDENT;
- 10. THE CONTRACTOR SHALL OBTAIN ALL REGULATORY AUTHORITY APPROVALS AT THEIR OWN EXPENSE;
- 11. THE CONTRACTOR SHALL MAINTAIN SERVICES AND ALL WEATHER ACCESS TO ADJOINING PROPERTIES AT ALL TIMES. IF REQUIRED THE CONTRACTOR SHALL PROVIDE TEMPORARY SERVICES TO MAINTAIN SUPPLY TO EXISTING BUILDINGS REMAINING IN OPERATION DURING THE WORKS. ONCE DIVERSION IS COMPLETE THE CONTRACTOR SHALL REMOVE ALL SUCH TEMPORARY SERVICES AND MAKE GOOD. ALL WORKS TO BE TO THE SATISFACTION OF THE SUPERINTENDENT AND THE RELEVANT SERVICE AUTHORITY;
- 12. CARE IS TO BE TAKEN WHEN EXCAVATING NEAR EXISTING SERVICES;
- 13. ALL NEW WORKS TO MAKE SMOOTH TRANSITION WITH EXISTING CONDITIONS;
- 14. THE CONTRACTOR SHALL UNDERTAKE ANY TEMPORARY TRAFFIC CONTROL MEASURES AS REQUIRED BY COUNCIL. ALL WORKS TO BE IN ACCORDANCE WITH COUNCIL'S TRAFFIC MANAGEMENT POLICY. ALL APPROPRIATE WARNING SIGNAGE TO BE DISPLAYED FOR THE DURATION OF THE WORKS;
- 15. ALL WORKMANSHIP AND MATERIALS TO COMPLY WITH THE RELEVANT CURRENT AUSTRALIAN STANDARDS AND LOCAL STATUTORY AUTHORITY CODES;
- 16. MEASUREMENTS ARE NOT TO BE SCALED FROM THE DRAWINGS;

EARTHWORKS NOTES

- 1. ALL EARTHWORKS TO BE CARRIED OUT IN ACCORDANCE WITH AS3798 (2007) - GUIDELINES ON EARTHWORKS FOR COMMERCIAL AND RESIDENTIAL DEVELOPMENTS;
- 2. ALL WORK IS TO COMPLY WITH THE REQUIREMENTS OF THE PROJECT GEOTECHNICAL REPORT;
- 3. ALL UNSUITABLE, SOFT OR WET MATERIALS ARE TO BE REMOVED AND REPLACED PRIOR TO FILLING;
- 4. ALL FILL MATERIAL TO BE FROM A SOURCE APPROVED BY THE SUPERINTENDENT AND IS TO BE OF SOUND CLEAN MATERIAL, OF REASONABLE STANDARD AND FREE FROM LARGE ROCKS, STUMPS, ORGANIC MATTER AND OTHER DEBRIS. MAXIMUM PARTICLE SIZE 75mm. PLASTICITY INDEX BETWEEN 2% AND 15%;
- 5. ALL FILL MATERIAL IS TO BE PLACED IN MAXIMUM 200mm LAYERS. COMPACTION OF EARTHWORKS AT OPTIMUM MOISTURE CONTENT (-1 TO +3%) SHALL CONTINUE UNTIL A DRY DENSITY RATIO OF 95% FOR LOT, LANDSCAPE AND NON-VEHICULAR PAVED AREAS, 100% FOR VEHICULAR AND ROAD PAVEMENT SUBGRADES, AND 96% BENEATH BUILDING SLABS ARE ACHIEVED IN ACCORDANCE WITH TEST METHOD AS1289 5.1.1;
- 6. ALL EARTHWORKS TO TAKE PLACE UNDER LEVEL 1 GEOTECHNICAL SUPERVISION UNLESS DIRECTED OTHERWISE BY THE SUPERINTENDENT OR THE CONDITIONS OF CONSENT. TESTING OF THE FILL MATERIAL SHALL BE CARRIED OUT BY AN APPROVED NATA REGISTERED LABORATORY;
- 7. EARTHWORKS TO BE STAGED SO THAT THE WORKING SURFACE IS ADEQUATELY DRAINED DURING THE PERIOD OF CONSTRUCTION;
- 8. IN AREAS OF FILL WHERE THE NATURAL SURFACE EXCEEDS 1(V):4(H) BENCHES ARE TO BE CUT TO PREVENT SLIPPING OF THE PLACED FILL MATERIAL AS REQUIRED BY THE SUPERINTENDENT;
- 9. ALL BATTERS TO BE SCARIFIED TO ASSIST WITH ADHESION OF TOPSOIL TO BATTER FACE:
- 10. THE CONTRACTOR IS TO CONTROL SEDIMENTATION, EROSION AND POLLUTION DURING EARTHWORKS IN ACCORDANCE WITH THE REQUIREMENTS OF "MANAGING URBAN STORMWATER: SOILS AND CONSTRUCTION";

CONCRETE NOTES

- 1. ALL WORKMANSHIP AND MATERIALS SHALL COMPLY WITH AS 3600 (UNO);
- 2. CONCRETE MIX PARAMETERS
- MAXIMUM AGGREGATE SIZE = 20mm - SLUMP = 80mm
- ALL CONCRETE MUST BE CONSOLIDATED WITH MECHANICAL VIBRATORS
- CONCRETE STRENGTH AS PER BELOW

CONCRETE STRENGTHS (CIVIL WORKS ONLY)						
USE	STRENGTH GRADE	CEMENT TYPE TO				
	(28 DAYS)	AS 3972				
PITS	F'c = 32MPa	SL				
PAVEMENTS	F'c = 32MPa	SL				
KERBS	F'c = 25MPa	SL				
MASS CONCRETE	F'c = 25MPa	GP				

3. ALL REINFORCEMENT TO BE SUPPORTED IN ITS CORRECT POSITION DURING CONCRETING BY PLASTIC BAR CHAIRS. WIRE CHAIRS NOT PERMITTED. COVER MUST BE MAINTAINED AT ALL TIMES INCLUDING DRIP GROOVES. ENSURE TIE WIRES DO NOT PROTRUDE INTO THE COVER ZONE;

- 4. MINIMUM 40mm COVER TO REINFORCEMENT (UNO);
- REINFORCEMENT AS SHOWN ON THESE PLANS IS REPRESENTED DIAGRAMMATICALLY AND NOT NECESSARILY SHOWN IN THE TRUE PROJECTION OR SCALE;
- 6. ALL CONCRETE TO BE CURED AS FOLLOWS:
- KEEP SURFACE CONTINUOUSLY WET FOR 3 DAYS; PREVENT MOISTURE LOSS FOR THE NEXT 4 DAYS USING
- POLYTHENE SHEETING OR WET HESSIAN PROTECTED FROM WIND AND TRAFFIC, AND THEN ALLOW DRYING OUT;
- CURING COMPOUNDS MAY BE USED PROVIDED THAT THEY APPLY WITH AS3799 AND DO NOT AFFECT FINISHES;
- PVA BASED CURING COMPOUNDS MAY NOT BE USED.
- 7. REINFORCEMENT SYMBOLS AS FOLLOWS AS PER AS4671:
- HOT ROLLED DEFORMED BAR, GRADE 500 PLAIN ROUND BAR, GRADE 250 HARD DRAWN WIRE FABRIC (SQUARE OR SL / RL RECTANGULAR)
- 8. MINIMUM ALLOWABLE BEARING CAPACITY UNDER ALL CONCRETE FOUNDATIONS TO BE 150 KPa (UNO). BEARING CAPACITY TO BE CONFIRMED ON SITE BY A GEOTECHNICAL ENGINEER PRIOR TO COMMENCEMENT OF WORKS

STORMWATER NOTES

1. STORMWATER DRAINAGE DESIGN CRITERIA: - MINOR SYSTEM = 5YR ARI - MAJOR SYSTEM = 100YR ARI

2. ALL STORMWATER PIPES Ø375 TO Ø600 SHALL BE CLASS 2 APPROVED SIGPOT AND SOCKET REINFORCED CONCRETE PIPES WITH RUBBER RING JOINT (UNO);

3. ALL STORMWATER PIPES Ø675 OR LARGER SHALL BE CLASS 3 APPROVED SIGPOT AND SOCKET REINFORCED CONCRETE PIPES WITH RUBBER RING JOINT (UNO);

4. ALL UPVC STORMWATER PIPES TO BE DWV CLASS GRADE SN8 IN ACCORDANCE WITH AS 1260 (UNO)

5. IT IS THE CONTRACTORS RESPONSIBILITY TO VERIFY THAT THE STORMWATER PIPE CLASSES SUIT THEIR CONSTRUCTION EQUIPMENT AND METHODOLOGY AND TO CHECK ALL CONSTRUCTION LOADINGS ON THE PIPES. THE CONTRACTOR MUST ENSURE THAT THE MINIMUM COVER ABOVE EACH PIPE IS MAINTAINED AT ALL TIMES;

6. ALL STORMWATER PIPES TO BE LAID AT A MINIMUM GRADE OF 1% (UNO);

PIPE BEDDING TO BE TYPE H2 (UNO) FOR PIPES NOT UNDER PAVEMENTS AND TYPE HS2 FOR PIPES UNDER PAVEMENTS AS PER AS 3725. IN ALL CASES BACKFILL TRENCH WITH SAND TO 300mm ABOVE PIPE (UNO). WHERE PIPE IS UNDER PAVEMENT BACKFILL REMAINDER OF TRENCH TO UNDERSIDE OF PAVEMENT WITH SAND OR APPRVOED GRANULAR MATERIAL COMPACTED IN 150mm LAYERS TO MINIMUM 98% STANDARD MAXIMUM DRY DENSITY IN ACCORDANCE WITH AS 1289 5.2.1;

8. ALL CONNECTIONS TO EXISTING DRAINAGE PITS TO BE MADE IN A TRADESMAN LIKE MANNER AND THE INTERNAL WALL OF THE PIT AT THE POINT OF ENTRY TO BE CEMENT RENDERED TO ENSURE A SMOOTH FINISH WITH NO PROTRUSIONS:

9. ALL CAST-IN-SITU CONCRETE STOMRWATER PITS TO BE MINIMUM 32MPa AT 28 DAYS (UNO);

10. PRECAST CONCRETE PITS MAY BE USED IN LIEU OF CAST-IN-SITU PITS SUBJECT TO REVIEW AND APPROVAL BY THE SUPERINTENDENT;

11. STORMWATER PITS DEEPER THAN 1m TO HAVE STEP IRONS INSTALLED IN ACCORDANCE WITH THE LOCAL OR STATUTORY AUTHORITY REQUIREMENTS:

12. 3m LENGTH OF SUBSOIL DRAIN WRAPPED IN APPROVED FILTER SOCK TO BE PROVIDED AT THE INVERT OF EACH INCOMING UPSTREAM PIPE ON EACH PIT;

13. DRAINAGE LINES ON PLAN ARE DIAGRAMMATIC ONLY AND PIPE CENTRELINES ARE TO ENTER AND EXIT PITS AT THE CENTRE OF THE RESPECTIVE PIT WALLS (UNO);

14. THE BASE OF ALL STORMWATER PITS TO BE BENCHED TO FACILITATE THE SMOOTH FLOW OF WATER;

15. IT IS THE CONTRACTORS RESPONSIBILITY TO ENSURE ADEQUATE SAFETY MEASURES SHALL BE PUT IN PLACE AT ALL TIMES DURING CONSTRUCTION TO MITIGATE THE POSSIBILITY OF PERSONNEL FALLING DOWN PITS;

ASPHALTIC CONCRETE NOTES

- 1. ASPHALTIC CONCRETE MIX DESIGN, MANUFACTURE, PLACING AND COMPACTION TO BE IN ACCORDANCE WITH:
- THE REQUIREMENTS OF THE PROJECT GEOTECHNICAL REPORT: AND
- COUNCIL'S RELEVANT CONSTRUCTION SPECIFICATION

SIGNAGE AND LINEMARKING

- 1. ALL SIGNPOSTING AND LINEMARKING TO BE PLACED IN ACCORDANCE WITH THE FOLLOWING GUIDELINES: AS 1742.2 MANUAL OF UNIFORM TRAFFIC CONTROL DEVICES; COUNCIL'S RELEVANT STANDARDS.
- 2. LOCATIONS OF SIGNS SHOWN ON THESE PLANS ARE INDICATIVE ONLY. SIGNS TO BE SETOUT IN ACCORDANCE WITH THE REQUIREMENTS OF THE ABOVE GUIDELINES;
- 3. ALL STREET SIGNS TO BE CHARCOAL POWDER COATED (UNO)

PAVE	EMENT LEGEND
	ASPHALTIC CONCRETE PAVEME TO BE CONFIRMED BY GEOTECH ENGINEER DURING DETAILED DE STAGE
	CONCRETE FOOTPATH PAVEME IN ACCORDANCE WITH COUNCIL DRAWING No. R23
* * <td>PROPOSED LANDSCAPING IN ACCORDANCE WITH LANDSCA ARCHITECTS REQUIREMENTS</td>	PROPOSED LANDSCAPING IN ACCORDANCE WITH LANDSCA ARCHITECTS REQUIREMENTS
	PROPOSED MEDIAN PAVEMENT IN ACCORDANCE WITH COUNCIL STANDARD DRAWING No. R23A
	CONCRETE DRIVEWAY PAVEMENT IN ACCORDANCE WITH COUNCIL STANDARD DRAWING No. R25
ALL PAVEMENTS ARE	INDICATIVE ONLY. TO BE CONFIR

DESIGN STAGE

CIVIL	WORKS LEGEND
KG	CONSTRUCT KERB AND GUTTER IN ACCORDANCE WITH COUNCIL DRAWING No. R2
VC	CONSTRUCT VEHICLE CROSSING IN ACCORDANCE WITH COUNCIL DRAWING No. R25
PR	CONSTRUCT KERB PRAM RAMP IN ACCORDANCE WITH COUNCIL DRAWING No. R17
	CONSTRUCT BATTER
10.0	MAJOR CONTOUR
	MINOR CONTOUR
(A1)	STORMWATER DRAINAGE STRUG / PIT NUMBER
	KERB INLET PIT WITH LINTEL IN ACCORDANCE WITH COUNCIL DRAWING No. D8
	SURFACE INLET PIT/JUNTION PIT ACCORDANCE WITH COUNCIL DRAWING NO. D23
SW	PROPOSED STORMWATER DRAI LINE
—	PROPOSED HEADWALL
	GROSS POLLUTANT TRAP "GPT"
	PROPOSED INLET SCOUR PROTI DETAILS TO BE CONFIRMED DUF DETAILS DESIGN STAGE
	PROPOSED REGIONAL BIORETE BASIN. REFER TO DRAWING C23 FOR DETAILS
RW	PROPOSED RETAINING WALL. DI TO BE CONFIRMED DURING DET DESIGN PHASE
RW1	PROPOSED GABION WALL OR SIMILAR. DETAILS TO BE CONFIR DURING DETAILED DESIGN PHAS

IN ACCORDANCE WITH LANDSCAPE ARCHITECTS REQUIREMENTS						
PROPOSED MEDIAN PAVEMENT IN ACCORDANCE WITH COUNCIL STANDARD DRAWING No. R23A						
CONCRETE DRIVEWAY PAVEMENT IN ACCORDANCE WITH COUNCIL STANDARD DRAWING No. R25						
E INDICATIVE ONLY. TO BE CONFIRMED BY GINEER DURING SUBSEQUENT DETAILED						
WORKS LEGEND						
CONSTRUCT KERB AND GUTTER IN ACCORDANCE WITH COUNCIL DRAWING No. R2						
CONSTRUCT VEHICLE CROSSING IN ACCORDANCE WITH COUNCIL DRAWING No. R25						
CONSTRUCT KERB PRAM RAMP IN ACCORDANCE WITH COUNCIL DRAWING No. R17						
CONSTRUCT BATTER						
MAJOR CONTOUR						
MINOR CONTOUR						
STORMWATER DRAINAGE STRUCTURE / PIT NUMBER						
KERB INLET PIT WITH LINTEL IN ACCORDANCE WITH COUNCIL DRAWING No. D8						
SURFACE INLET PIT/JUNTION PIT IN ACCORDANCE WITH COUNCIL DRAWING NO. D23						
PROPOSED STORMWATER DRAINAGE LINE						
PROPOSED HEADWALL						
GROSS POLLUTANT TRAP "GPT"						
PROPOSED INLET SCOUR PROTECTION. DETAILS TO BE CONFIRMED DURING DETAILS DESIGN STAGE		27.05.24	RE-ISSUED FOR D	24	GAP	DR
PROPOSED REGIONAL BIORETENTION	D	20.10.23	RE-ISSUED FOR L		GAP	DR
BASIN. REFER TO DRAWING C230-C231 FOR DETAILS	С	13.09.23	RE-ISSUED FOR D	A	GAP	DR
PROPOSED RETAINING WALL. DETAILS	B	24.01.23 20.01.23	ISSUED FOR DA	DRMATION	GAP GAP	CJA CJA
TO BE CONFIRMED DURING DETAILED DESIGN PHASE	Rev	Date	Description		Drawn	Appr
PROPOSED GABION WALL OR SIMILAR. DETAILS TO BE CONFIRMED DURING DETAILED DESIGN PHASE	0	infrastructure	end of the second secon	infrastructure & developme Suite 8.01, 56 Clarence Str Sydney, NSW 2000 e admin@idcaus.com w www.idcaus.com		ing
		_ANDO EDMO _OT 5			Т 3	
		VING TITLE	S AND LEC	GENDS SHEET	-	
	SCAL	E		STATUS DA		
	DRAW	/ING NO.	2-514-1		REV E	
		-				

E PAVEMENT GEOTECHNICAL TAILED DESIGN

LEGEND

GEOTECHNICAL ENGINEER DURING SUBSEQUENT DE

PING LANDSC MENTS

I PAVEMENT

COUNCIL





	ſ	7	Ĩ	SANDBAG SEDIMENT TRAP I ACCORDANCE WITH COUNC		VING D2	2
		·		DROP INLET SEDIMENT TRA ACCORDANCE WITH COUNC		VING D4	4
				STABILISED CONSTRUCTION ACCORDANCE WITH COUNC		ANCE IN	
				NON-CERTIFIED LAND AREA	۱.		
				EXISTING TREES TO BE REM NOTE: TREE CLEARING TO T PART OF SEPERATE DA APF REFER TO DRAWING 22-514 C PREPARED BY IDC FOR DI	TAKE PL PLICATIC -SK-C12	DN.	;
	<u> </u>	וחם		T CONTROL NO			J
							-
	MA <u>NA</u> FO AN AP	NAGE TURE R THE D PRE PROV	MENT ST ONLY. TH E ESTABLI EPARING / AL FROM	NTS AN INDICATIVE SOIL ANE RATEGY AND IS OF A <u>CONCE</u> E CONTRACTOR SHALL BE R SHMENT AND MANAGEMENT A DETAILED PLAN AND OBTAI THE RELEVANT AUTHORITY I OF ANY WORKS;	PTUAL ESPONS OF THE NING	SIBLE SITE	
	RE OL	LEVAI	NT ENGIN MANAGIN	E READ IN CONJUNCTION WI EERING PLANS AND THE GUII G URBAN STORMWATER: SOI ALSO KNOWN AS THE "BLUE	DELINES LS AND	S SET	
	INF PC	ORME TENT	ED OF THI IAL FOR S	D SUB-CONTRACTORS SHAL EIR RESPONSIBILITIES IN MIN OIL EROSION AND POLLUTIO DS AND WATERWAYS;	IIMISING	THE	
	CC NC LO	ONSTR OMINA CATIC	UCTION V TED SITE N DETER	FIC SHALL BE CONTROLLED I ORKS WITH ACCESS CONFIN ENTRANCE AS SHOWN ON TH MINED BY THE SUPERINTENE TURBED SHALL BE MARKED	NED TO HIS PLAN DENT. AF	THE N OR A	
	SIT			MMENCEMENT OF ANY EART PECTED TO IDENTIFY AND AF			
		TH TH		TO BE REMOVED; TO BE RETAINED AND APPRC)PRIATE	LY	
				REAS SHALL BE REVEGETAT F COMPLETION OF FORMATI		HN 14	
				BE REMOVED WITHOUT WR M COUNCIL;	ITTEN		
	BA SH	ISIS. W	/HERE CL E REMOV	VICES TO BE MAINTAINED ON EANING IS REQUIRED THE SE ED TO AN APPROPRIATE LOC IE SUPERINTENDENT;		Г	
	9. DU	IST TC) BE MININ	IISED BY SPRINKLING LARGE ER WHEN REQUIRED	DISTUR	RBED	
				VICES TO REMAIN IN PLACE U THE MAINTENANCE PERIOD.	JNTIL TH	ΗE	
							_
E D	27.05.2			D FOR DA		GAP GAP	DR DR
C	13.09.2	_	_	D FOR DA		GAP	
В	24.01.2	-	ISSUED F			GAP	CJA
A	20.01.2	-	_	OR INFORMATION		GAP	CJA
Rev	v Date		Descriptio	l		Drawn	Appr
Ć	- () infras	structure &		infrastructure & deve Suite 8.01, 56 Clare Sydney, NSW 2000 e admin@idcau w www.idcaus.c	nce Stree Is.com		ing
	LOT CAN	101 5 [1PE	NDSC DP12	N PARK PRECI 72931 OWN ROAD	INCT	Г З	
DR/			ROL F	AND EROSION LAN			
SCA	^{ALE} 1:	500)	STATUS DA			
DR/	AWING NC	^{).} 2	2-5´	4-DA-C120) RE	E E	
<u> </u>							

LEGEND

TEMPORARY SEDIMENT FENCE IN ACCORDANCE WITH COUNCIL DRAWING D1


LEGEND

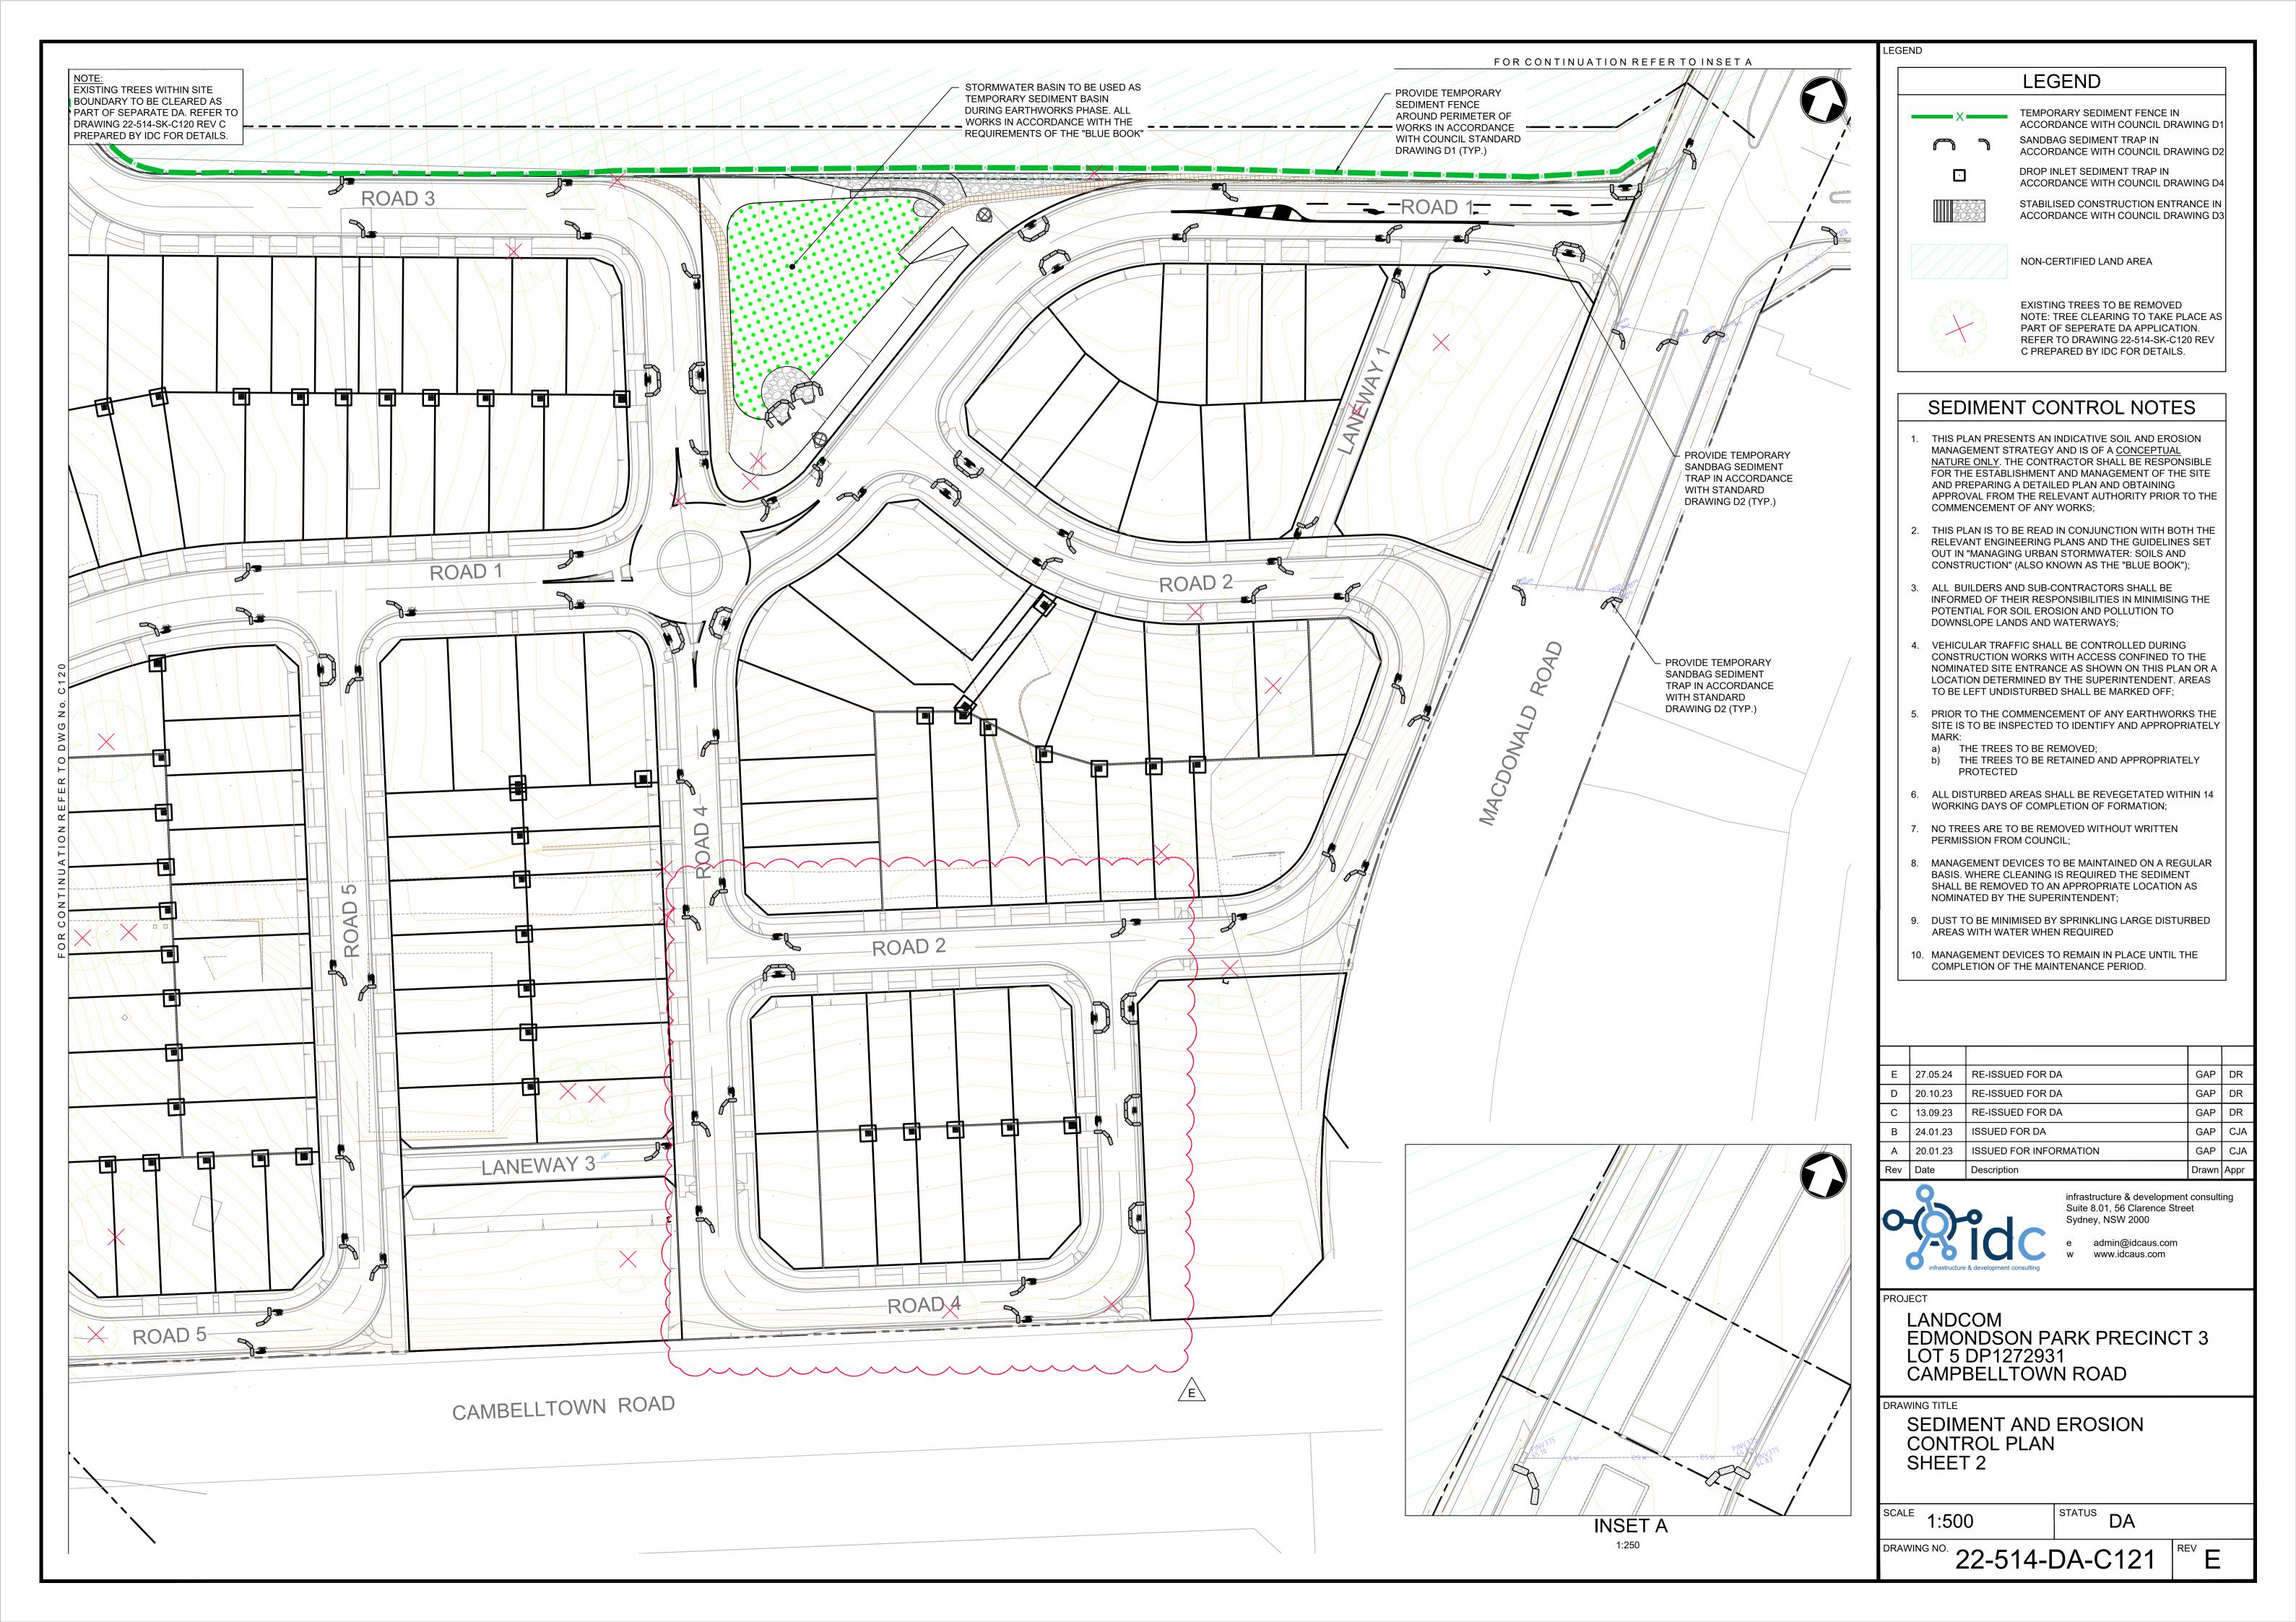


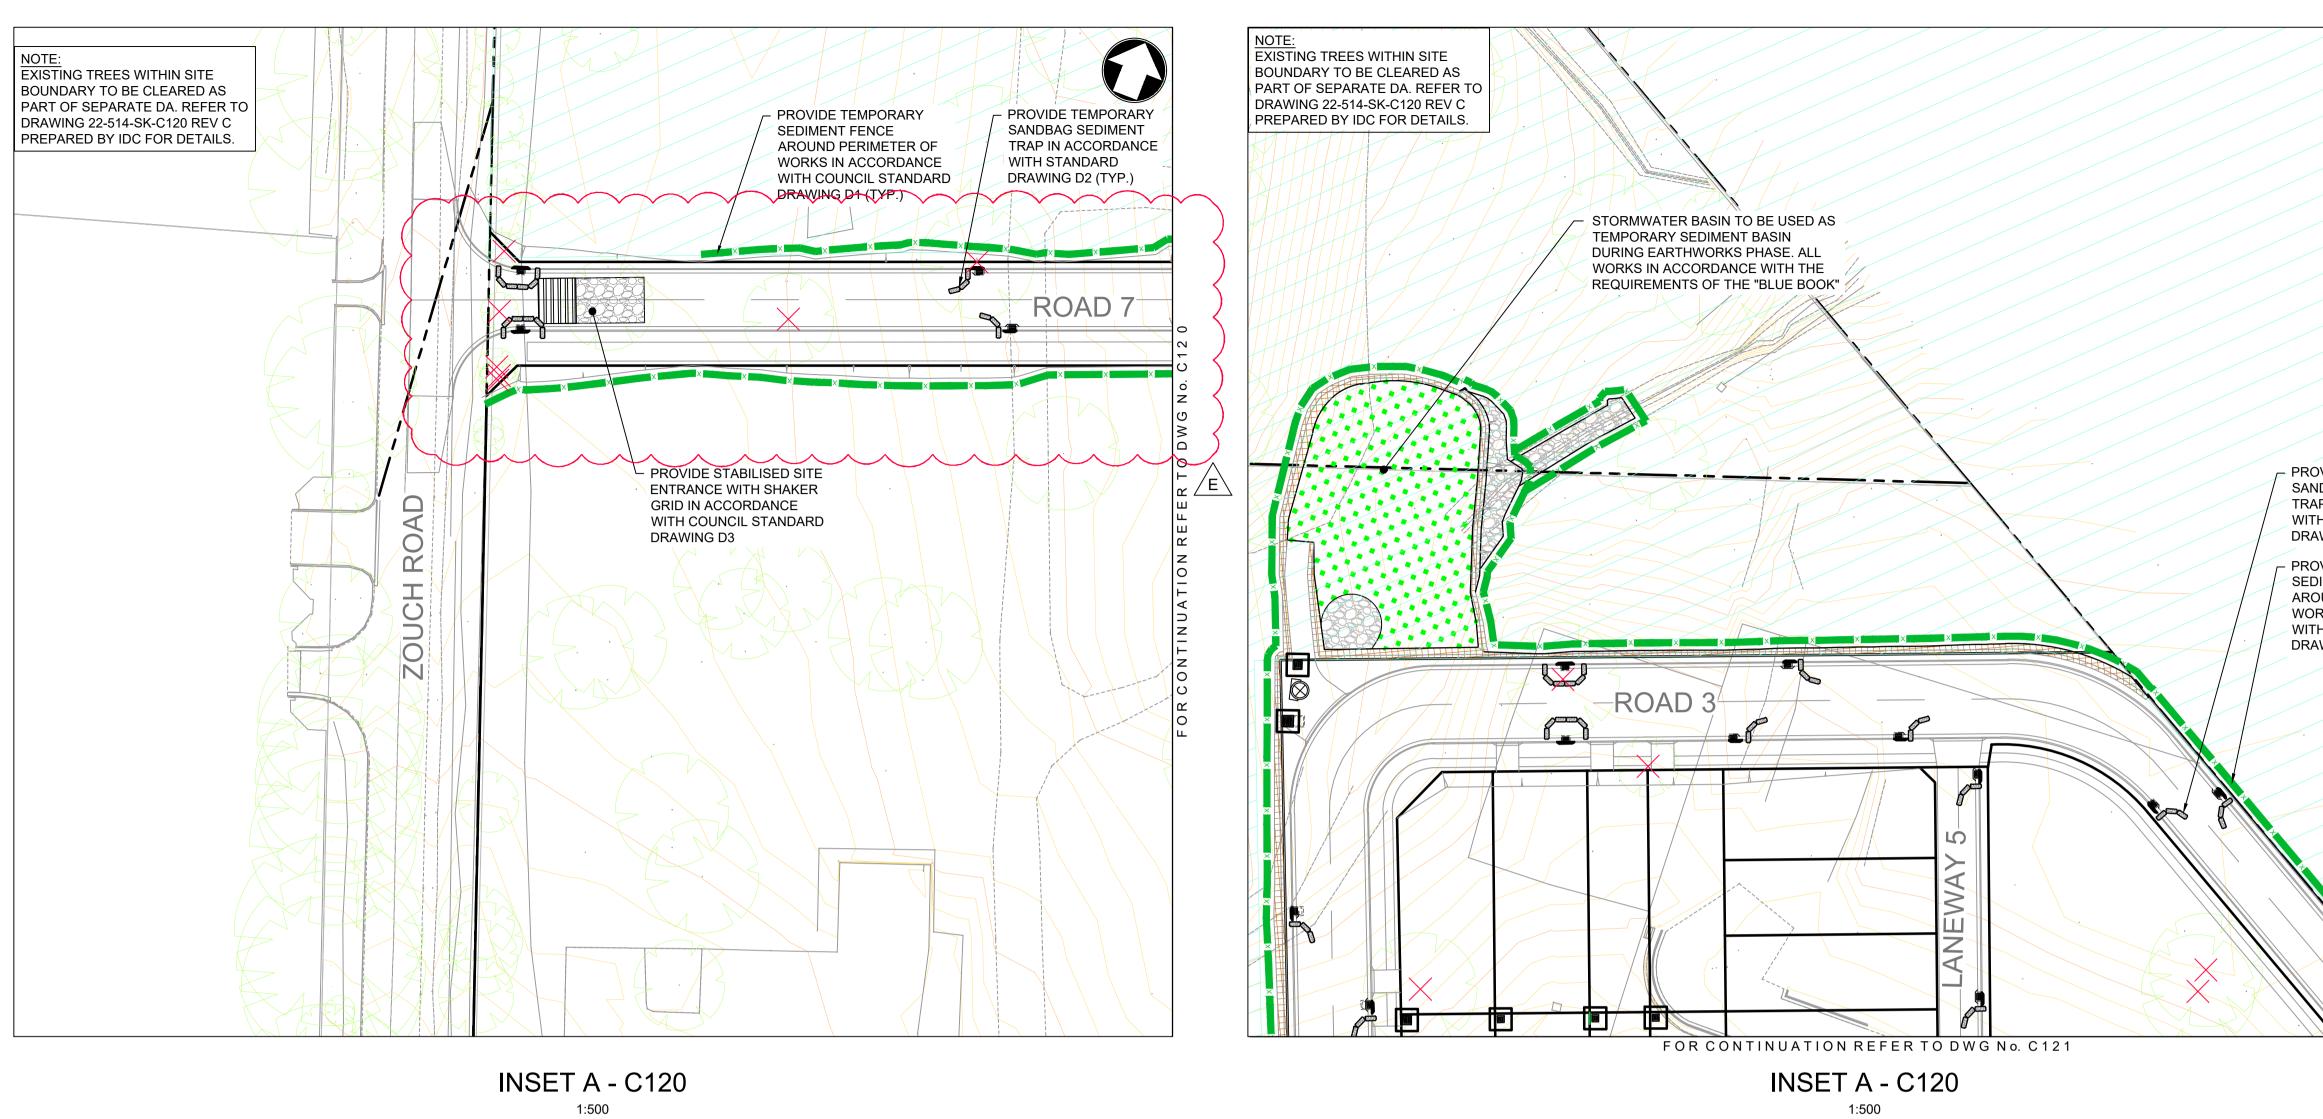


1:500

				_
		LEGEND		
	X	TEMPORARY SEDIMENT FENCE IN ACCORDANCE WITH COUNCIL DRA	WING D1	
		SANDBAG SEDIMENT TRAP IN		
		ACCORDANCE WITH COUNCIL DRA	WING D2	2
		ACCORDANCE WITH COUNCIL DRA	WING D4	L I
		STABILISED CONSTRUCTION ENTRA ACCORDANCE WITH COUNCIL DRA		
		NON-CERTIFIED LAND AREA		
		EXISTING TREES TO BE REMOVED NOTE: TREE CLEARING TO TAKE PL PART OF SEPERATE DA APPLICATIO REFER TO DRAWING 22-514-SK-C12 C PREPARED BY IDC FOR DETAILS.	LACE AS ON. 20 REV	
VIDE TEMPORARY DBAG SEDIMENT PIN ACCORDANCE	SEDIMI	ENT CONTROL NOTE	S]
STANDARD /ING D2 (TYP.)		RESENTS AN INDICATIVE SOIL AND EROS		
VIDE TEMPORARY MENT FENCE IND PERIMETER OF (S IN ACCORDANCE COUNCIL STANDARD VING D1 (TYP.)	MANAGEMEN NATURE ONL FOR THE EST AND PREPAR APPROVAL F	RESENTS AN INDICATIVE SOIL AND EROS NT STRATEGY AND IS OF A <u>CONCEPTUAL</u> . <u>Y</u> . THE CONTRACTOR SHALL BE RESPON TABLISHMENT AND MANAGEMENT OF THE RING A DETAILED PLAN AND OBTAINING ROM THE RELEVANT AUTHORITY PRIOR ⁻ MENT OF ANY WORKS;	ISIBLE E SITE	
	RELEVANT E OUT IN "MAN	TO BE READ IN CONJUNCTION WITH BOT NGINEERING PLANS AND THE GUIDELINE AGING URBAN STORMWATER: SOILS AND ION" (ALSO KNOWN AS THE "BLUE BOOK"	S SET	
	INFORMED O POTENTIAL F	RS AND SUB-CONTRACTORS SHALL BE F THEIR RESPONSIBILITIES IN MINIMISING FOR SOIL EROSION AND POLLUTION TO E LANDS AND WATERWAYS;	G THE	
	CONSTRUCT NOMINATED LOCATION DI	TRAFFIC SHALL BE CONTROLLED DURING ION WORKS WITH ACCESS CONFINED TO SITE ENTRANCE AS SHOWN ON THIS PLA ETERMINED BY THE SUPERINTENDENT. A JNDISTURBED SHALL BE MARKED OFF;	N OR A	
	MARK:		RIATELY	
		REES TO BE REMOVED; REES TO BE RETAINED AND APPROPRIATE CTED	ELY	
	WORKING DA	BED AREAS SHALL BE REVEGETATED WIT	HIN 14	
		RE TO BE REMOVED WITHOUT WRITTEN FROM COUNCIL;		
	BASIS. WHEF SHALL BE RE	NT DEVICES TO BE MAINTAINED ON A REG RE CLEANING IS REQUIRED THE SEDIMEN EMOVED TO AN APPROPRIATE LOCATION BY THE SUPERINTENDENT;	IT	
	AREAS WITH	MINIMISED BY SPRINKLING LARGE DISTU WATER WHEN REQUIRED IT DEVICES TO REMAIN IN PLACE UNTIL T	RBED	
		N OF THE MAINTENANCE PERIOD.	HE	
			ΉE	
	E 27.05.24 RE-I	SSUED FOR DA	GAP	DR
	E 27.05.24 RE-I D 20.10.23 RE-I			DR DR
	E 27.05.24 RE-I D 20.10.23 RE-I C 13.09.23 RE-I	SSUED FOR DA SSUED FOR DA	GAP GAP	DR
	E 27.05.24 RE-I D 20.10.23 RE-I C 13.09.23 RE-I B 24.01.23 ISSU A 20.01.23 ISSU	SSUED FOR DA SSUED FOR DA SSUED FOR DA JED FOR DA JED FOR INFORMATION	GAP GAP GAP GAP GAP GAP	DR DR CJA CJA
	E 27.05.24 RE-I D 20.10.23 RE-I C 13.09.23 RE-I B 24.01.23 ISSU A 20.01.23 ISSU	SSUED FOR DA SSUED FOR DA SSUED FOR DA JED FOR DA JED FOR INFORMATION cription infrastructure & developmen Suite 8.01, 56 Clarence Stre Sydney, NSW 2000 e admin@idcaus.com	GAP GAP GAP GAP GAP Drawn	DR DR CJA CJA
R	E 27.05.24 RE-I D 20.10.23 RE-I C 13.09.23 RE-I B 24.01.23 ISSL ev Date Desc Desc C Date Desc C I C Date Desc C DA	SSUED FOR DA SSUED FOR DA SSUED FOR DA JED FOR DA JED FOR INFORMATION cription infrastructure & development Suite 8.01, 56 Clarence Street Sydney, NSW 2000 e admin@idcaus.com w www.idcaus.com W	GAP GAP GAP GAP Drawn	DR DR CJA CJA Appr
R PF	E 27.05.24 RE-I D 20.10.23 RE-I C 13.09.23 RE-I B 24.01.23 ISSL ev Date Desc Desc C Date Desc C Infrastructure & develo	SSUED FOR DA SSUED FOR DA SSUED FOR DA JED FOR INFORMATION pription	GAP GAP GAP GAP Drawn	DR DR CJA CJA Appr
PF	E 27.05.24 RE-I D 20.10.23 RE-I C 13.09.23 RE-I B 24.01.23 ISSL ev Date Desc Date Desc Contrastructure & develo Contrastructure & develo ROJECT LANDCON EDMOND LOT 5 DP CAMPBEL	SSUED FOR DA SSUED FOR DA SSUED FOR DA JED FOR INFORMATION pription	GAP GAP GAP GAP Drawn	DR DR CJA CJA Appr

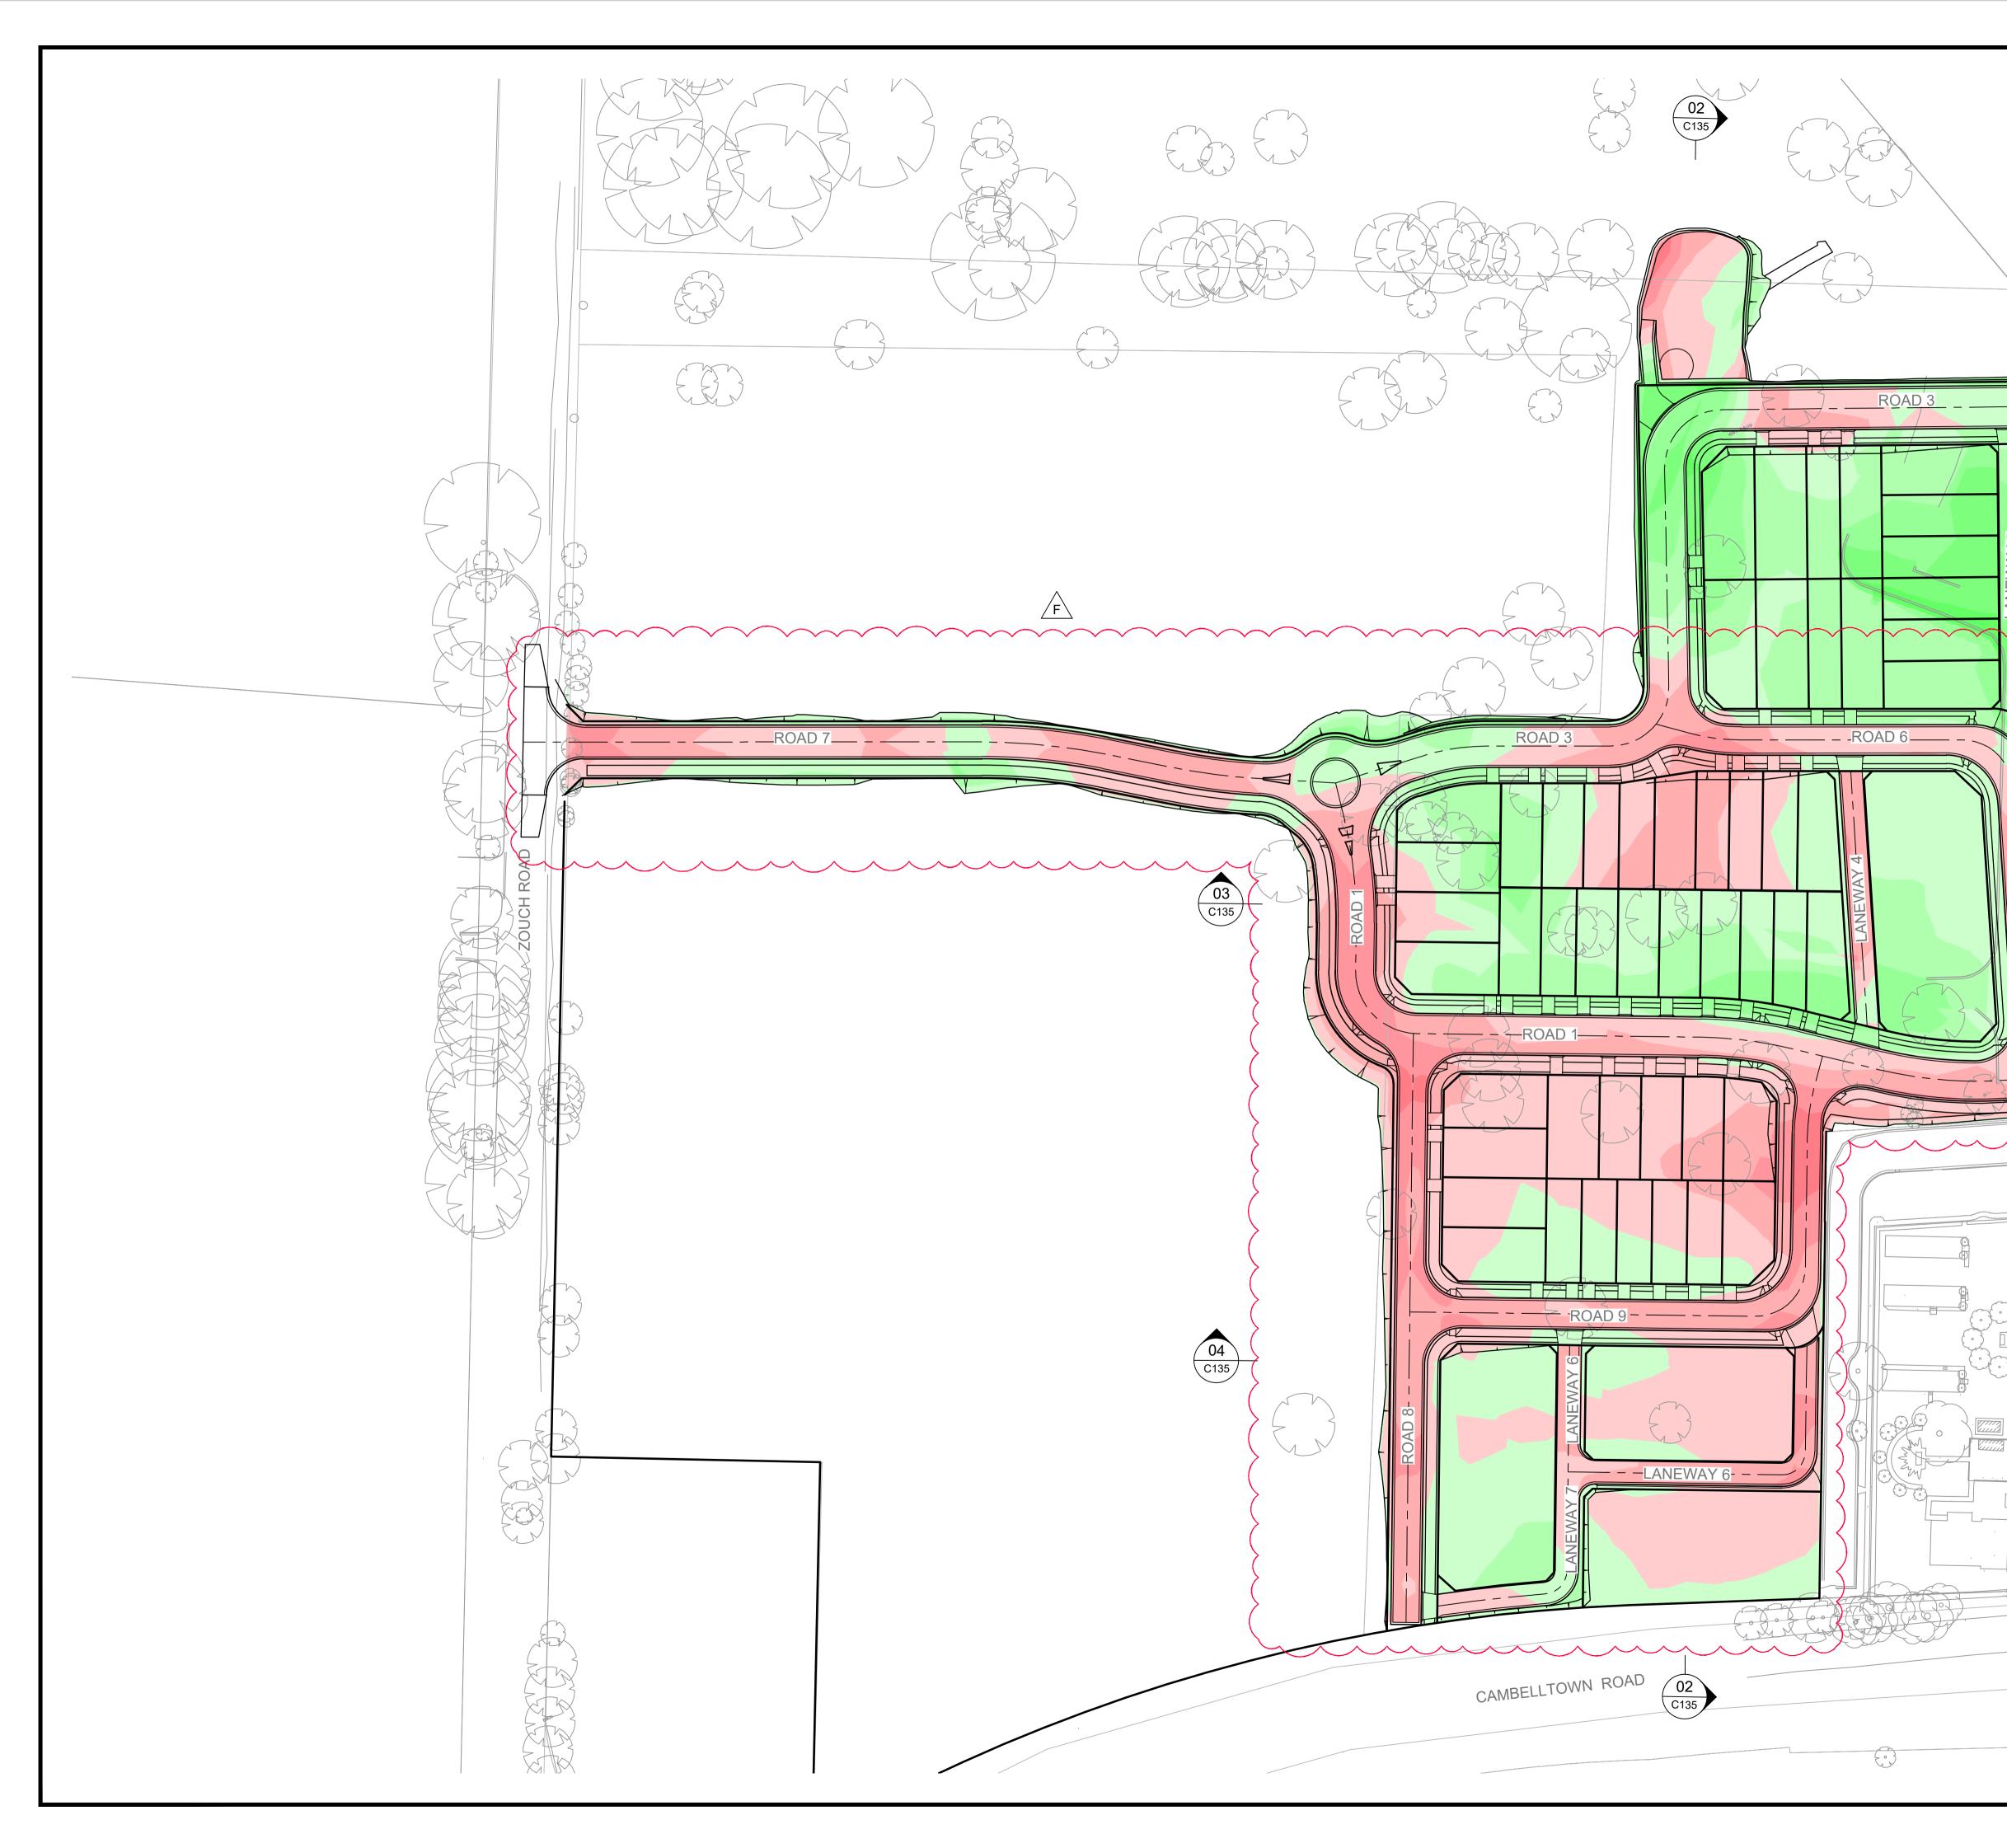


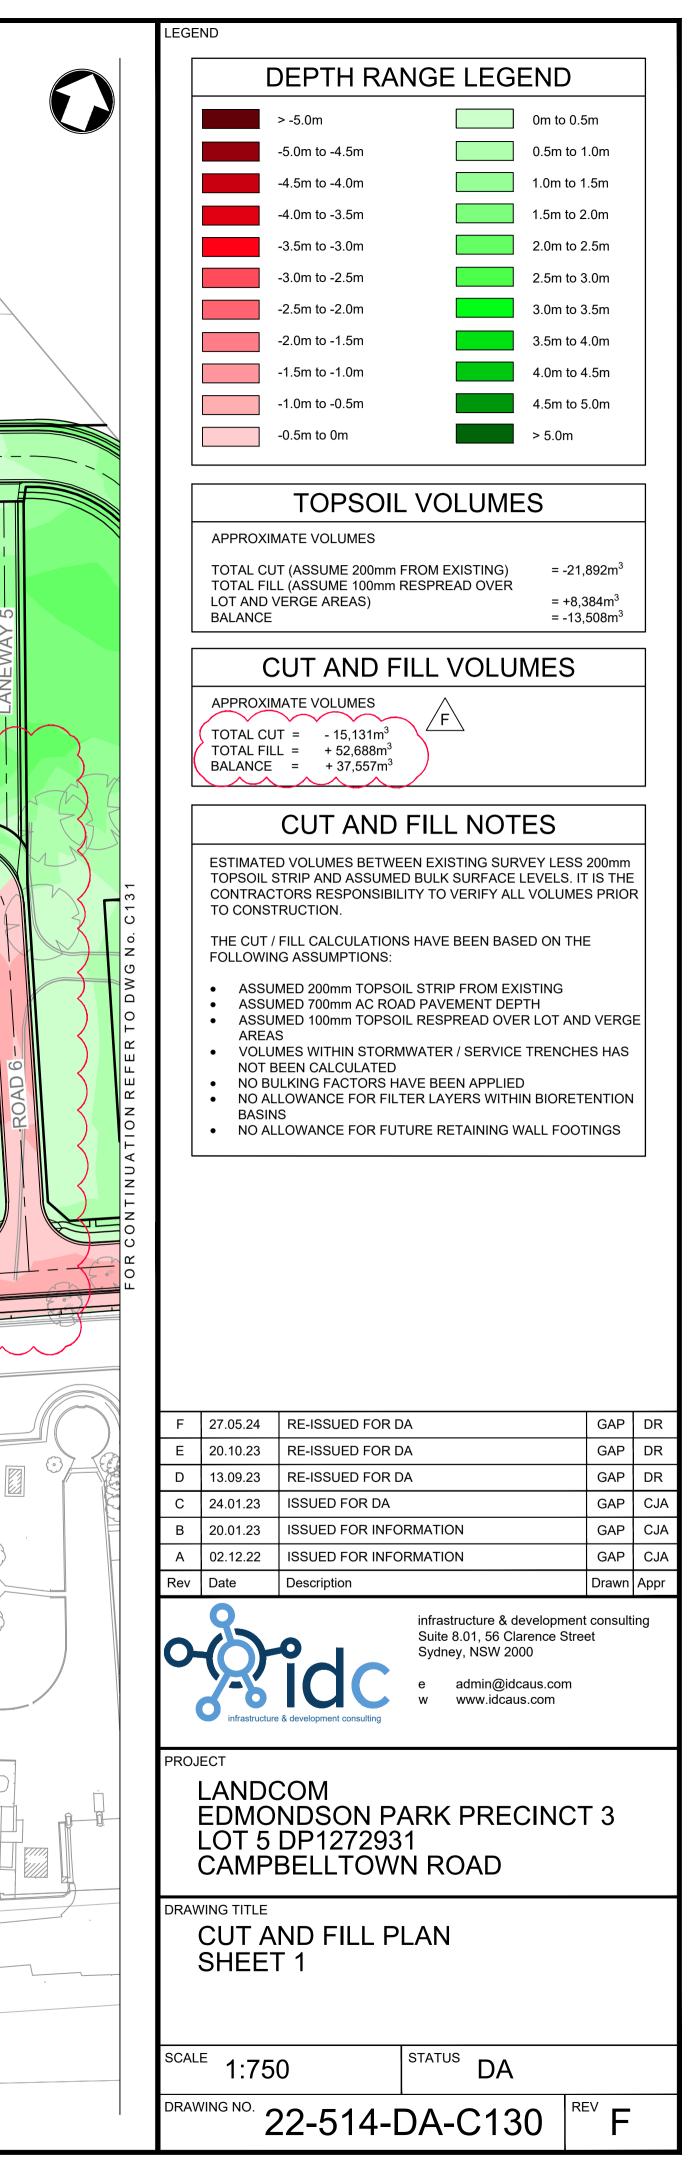


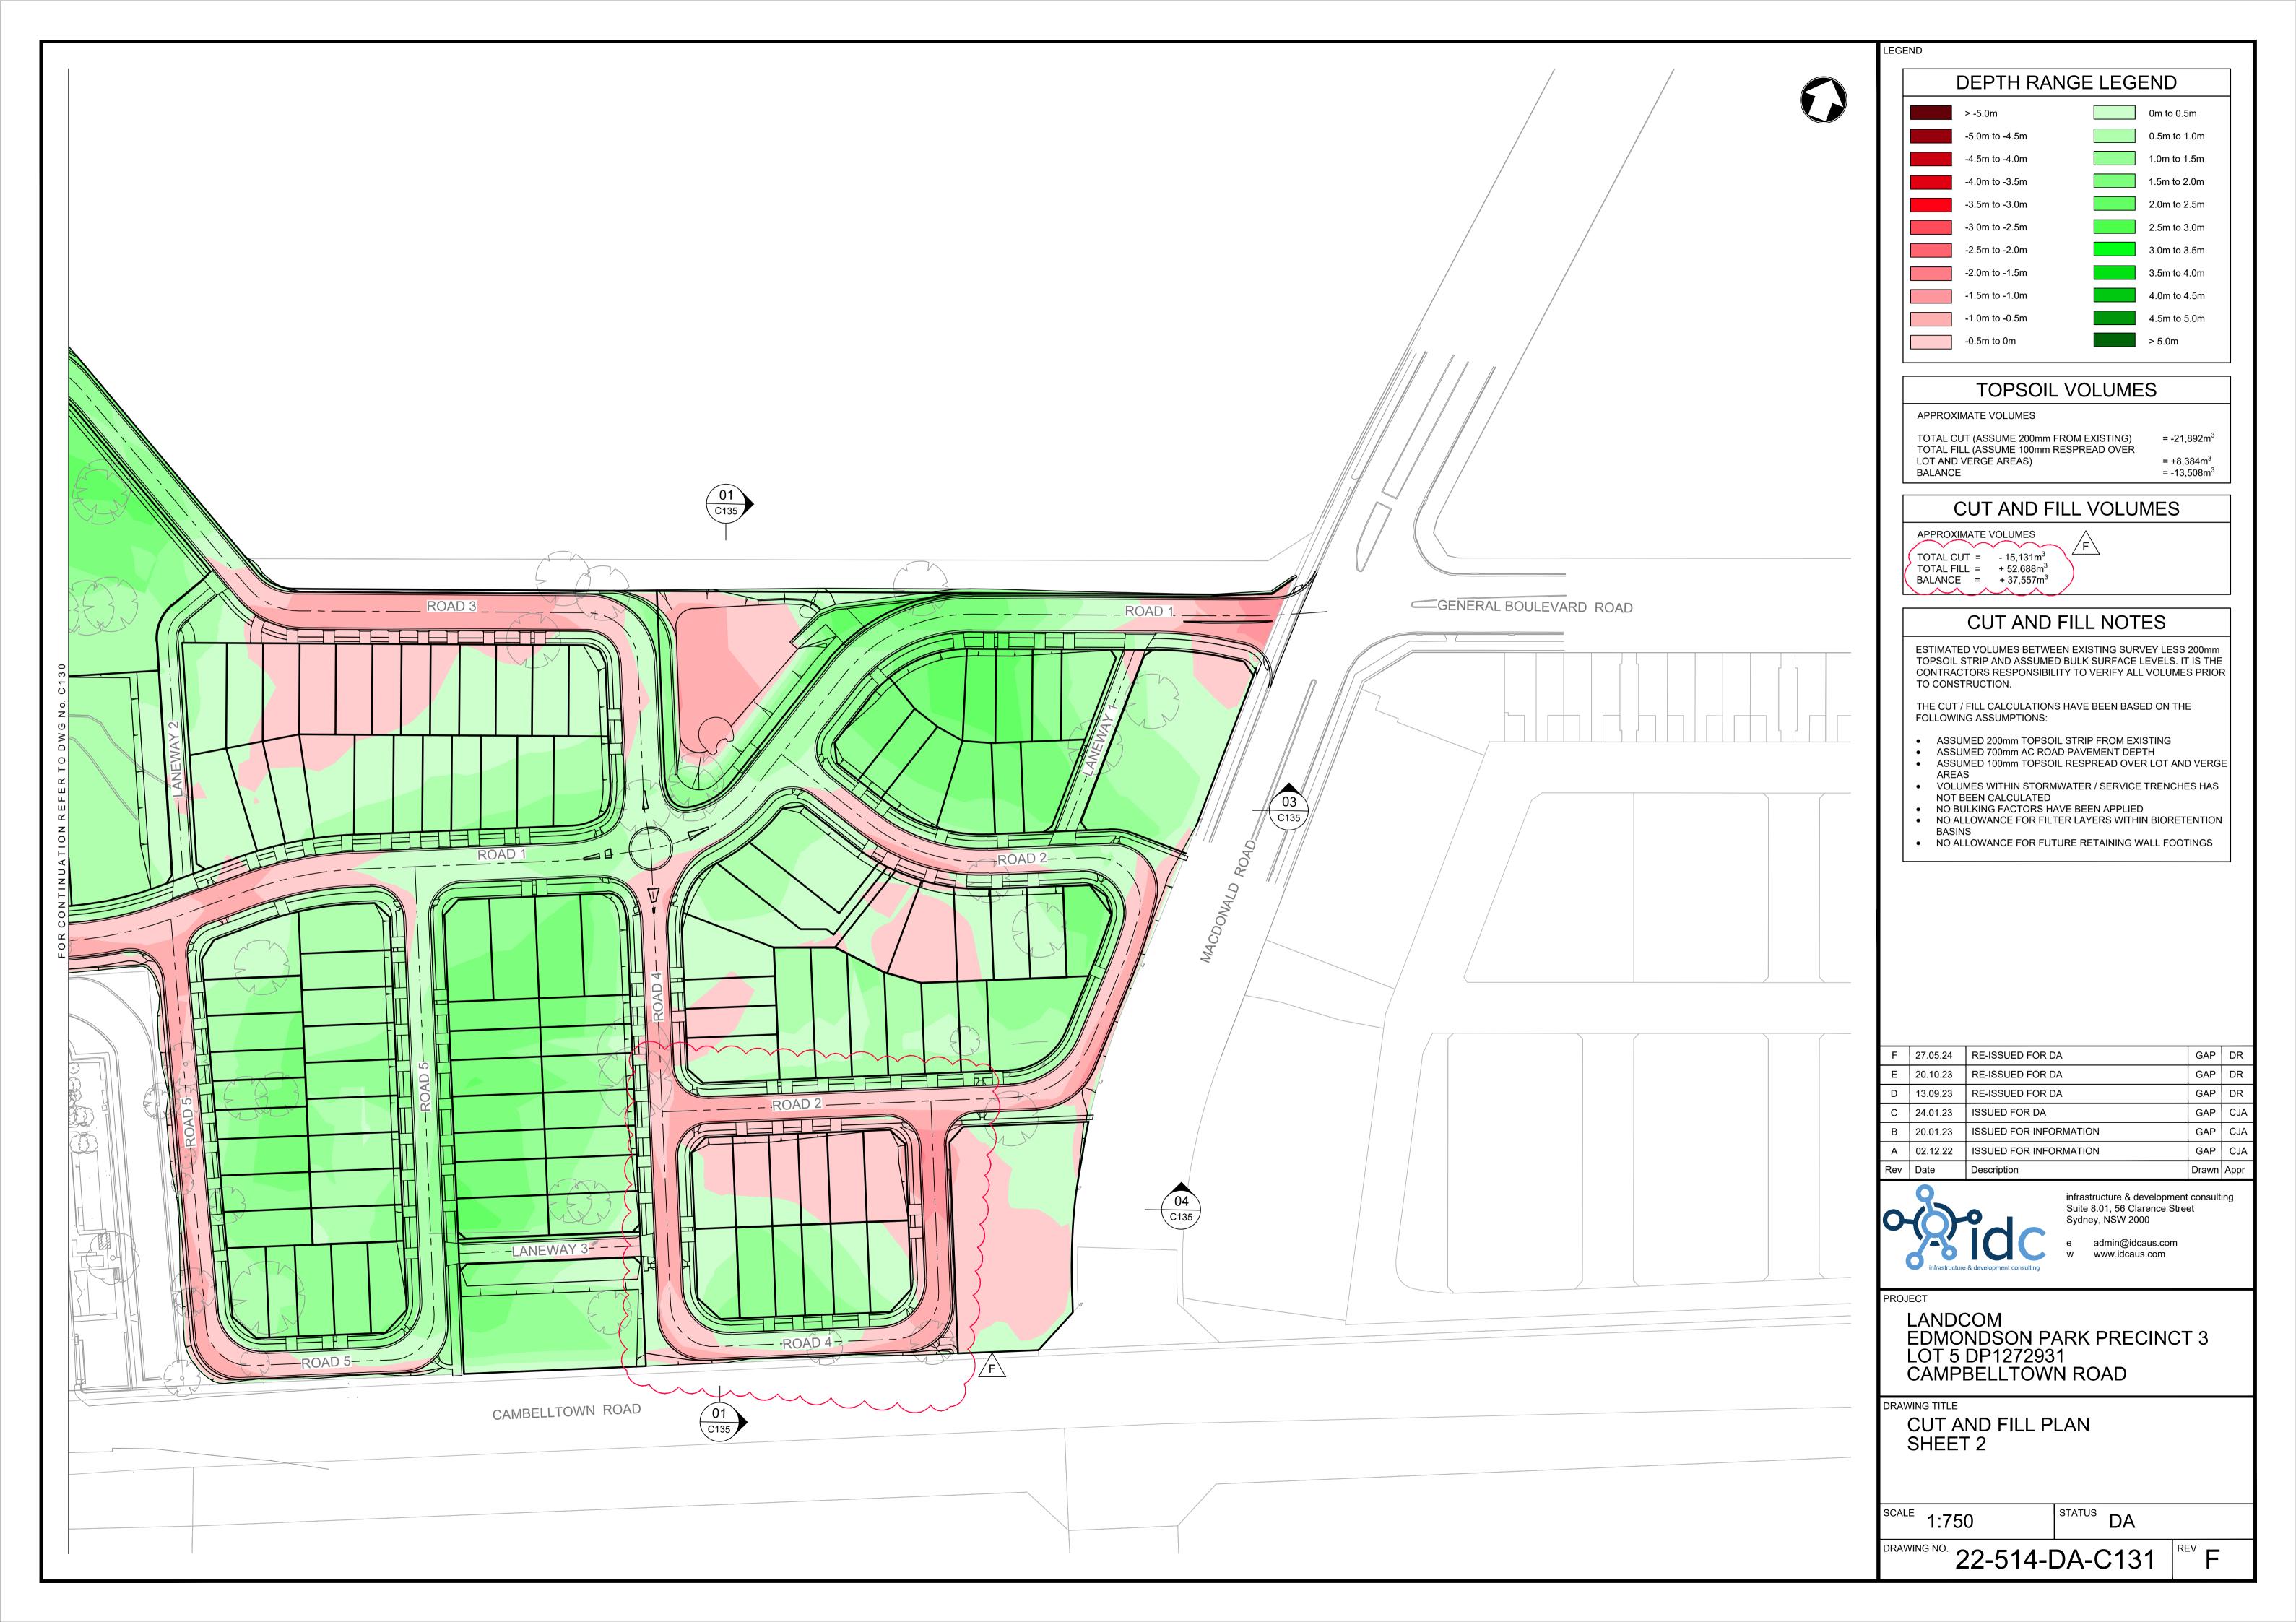

		PROPO		OPOSED		
		BASI	N 15	m ROAD		
DESIGN LEVEL		67.000	67.000	70.048	70.844	70.865
BULK LEVEL		62.000	67.000			70.865
EXISTING LEVEL	68.506	67.757	67.240 67.240 67.260	68.334	69.576	69.614
CHAINAGE	0.000	20.000	40.000	80.000	100.000	100.537
1:500 HOR - 1:100 VER						

1:500 HOR - 1:100 VER

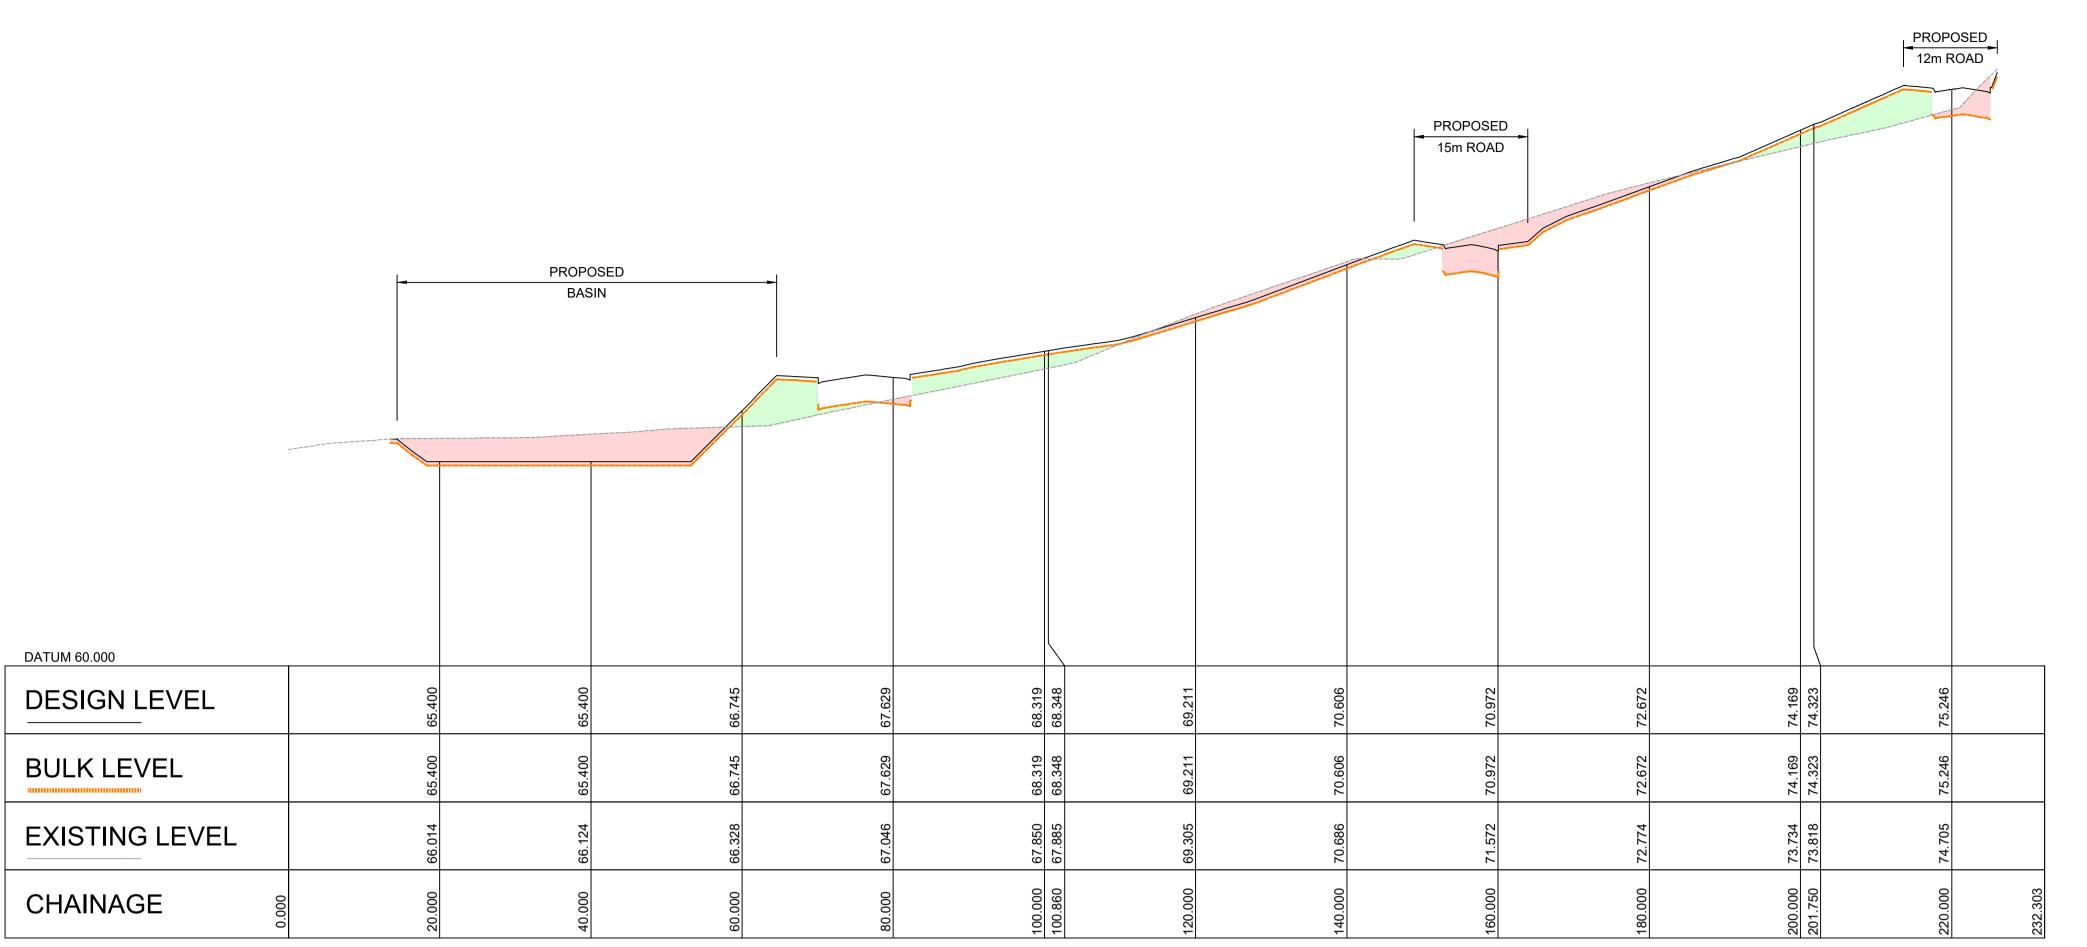

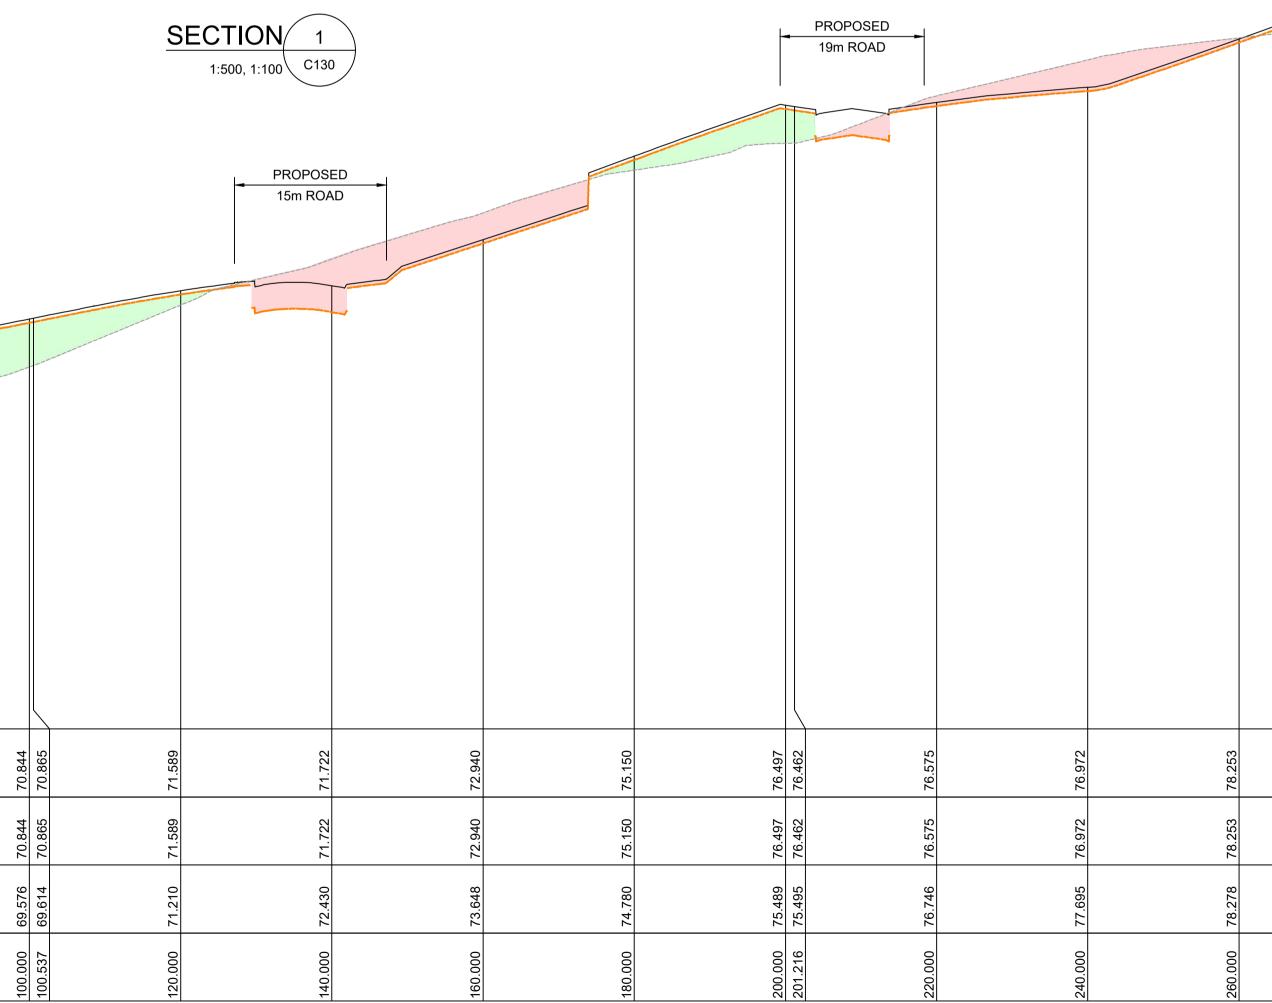



	LEGEND	
	LEGEND	
	PROPOSED CUT AREAS	
	PROPOSED FILL AREAS	
FOR CONTINUATION REFER SHEET 2		
PROPOSED 15m ROAD		
	E 27.05.24 RE-ISSUED FOR DA	GAP DR
	D 20.10.23 RE-ISSUED FOR DA	GAP DR
	C 13.09.23 RE-ISSUED FOR DA B 24.01.23 ISSUED FOR DA	GAP DR GAP CJA
	A 20.01.23 ISSUED FOR INFORMATION Rev Date Description	GAP CJA Drawn Appr
	infrastructure & developmen Suite 8.01, 56 Clarence Stre Sydney, NSW 2000 e admin@idcaus.com w www.idcaus.com	t consulting
78.253 78.744	PROJECT	
78.253 78 78.744 78	LANDCOM EDMONDSON PARK PRECINC LOT 5 DP1272931	ГЗ
78.278 78.78	CAMPBELLTOWN ROAD	
	BULK CUT AND FILL SITE SEC SHEET 1	TIONS
260.000		
	SCALE 1:500, 1:100 STATUS DA	
	DRAWING NO. 22-514-DA-C135	E

1:500 HOR - 1	1:100 VER
---------------	-----------

	PROPOSED 19m ROAD				PROPOSED 7m LANE			POSED ROAD	PRi 7r	DPOSED	FOR CONTINUATION REFER SHEET 3
$\left. \right\rangle$											
DATUM 60.000											
	73.710	74.298 74.629	74.806	74.983	74.836	74.607	73.740	74.035	73.931	73.066	72.175
BULK LEVEL	73.710	74.298 74.629	74.806	74.983	74.836	74.607	73.740	74.035	73.931	73.066	72.175
	74.482	74.575	74.768	74.754	74.504	74.209	73.819	73.586	73.163	73.127	72.243
CHAINAGE	20.000	50.000 50.000	80.000	000.000	40.000	000 60.000	80.000	000.000	20.000	40.000	560.000
1:500 HOR - 1:100 VER	` <u>`</u>		·	<u> </u>	- <u> </u>	<u> </u>	-	N	<u> </u>	<u> </u>	(N)

E

FOR CONTINUATIO			ROPOSED 7m LANE			
DATUM 75.000						
DESIGN LEVEL	78.744	79.024	79.143	78.990	78.594	
BULK LEVEL	78.744	79.024	79.143	78.990	78.594	
EXISTING LEVEL	78.740	79.035	79.083	79.004	78.703	
CHAINAGE	280.000	300.000	310.062	320.000	340.000	360.000
1:500 HOR - 1:100 VER						

SECTION 2


1:500, 1:100 C130



 $\overline{\ }$

	LEGEND	
	LEGEND	
	PROPOSED CUT AREAS	
	PROPOSED FILL AREAS	
FOR CONTINUATION		
	E27.05.24RE-ISSUED FOR DAGAD20.10.23RE-ISSUED FOR DAGA	AP DR
	C 13.09.23 RE-ISSUED FOR DA GA B 24.01.23 ISSUED FOR DA GA	
	A 20.01.23 ISSUED FOR INFORMATION GA	AP CJA
	Rev Date Description Dramon Image: Construction of the second sec	wn Appr sulting
	Suite 8.01, 56 Clarence Street Sydney, NSW 2000	
	e admin@idcaus.com www.idcaus.com	
72.175	PROJECT	
	LANDCOM EDMONDSON PARK PRECINCT 3	
72.175 71.407	LOT 5 DP1272931 CAMPBELLTOWN ROAD	
72.243	DRAWING TITLE	
	BULK CUT AND FILL SITE SECTION	ONS
560.000	SHEET 2	
$\langle \rangle$		
\langle	SCALE 1:500, 1:100 STATUS DA	
	DRAWING NO. 22-514-DA-C136	E
	-	

>						
>						
>						
7	FOR CONTINUATION REFER SHEET 2					
>						
>					PROF	POSED
>					-	ROAD
>						
>						
>						
\rightarrow						
>						
>						
	DATUM 60.000					
	DESIGN LEVEL	70.625	69.728	776	.746	
>		70.	6 <u>9</u> .		67.	
>		70.625	69.728	3.776	67.746	
>	λ.			00 00		
>		70.069	68.940	67.778	66.823	
>	CHAINAGE	300.000	320.000	340.000	360.000	
>	1:500 HOR - 1:100 VER	<u> </u>	33	8	<u> </u>	

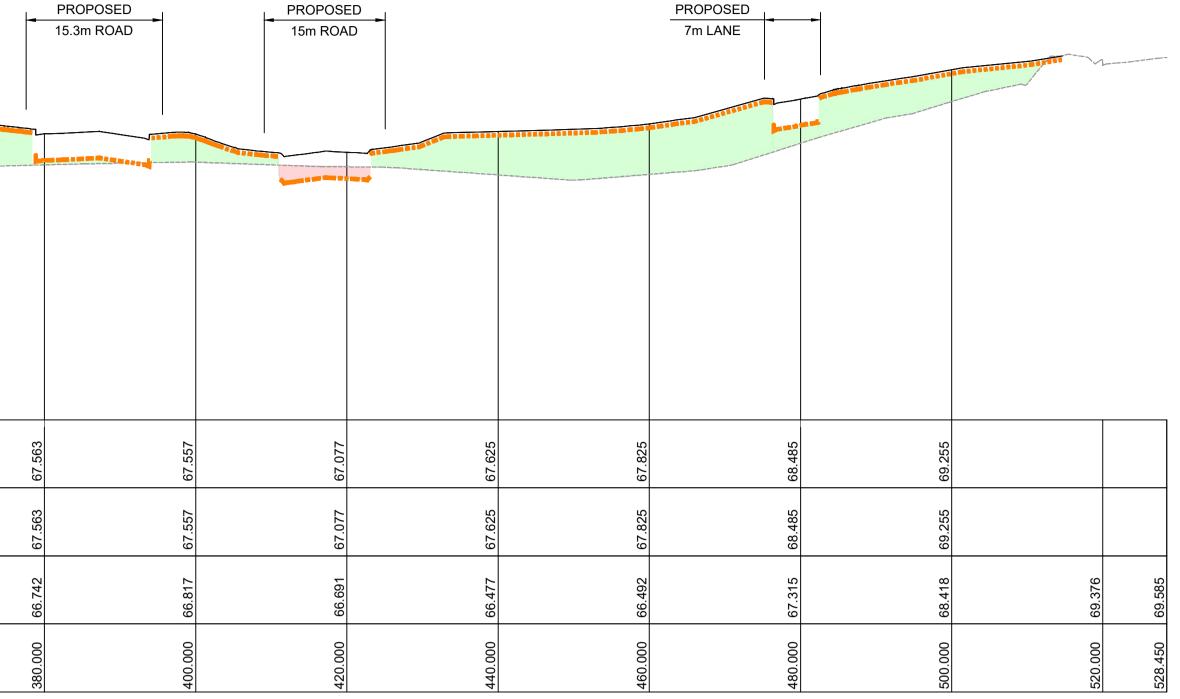

 $\sim \sim$

 \searrow

 \sim

 $\checkmark \checkmark \checkmark \checkmark \checkmark \checkmark \checkmark$

 \sim



E

	LEGE	ND			
]
$\langle \rangle$	▌┝		LEGEND		
\leq					
\leq			PROPOSED CUT AREAS		
\leq					
$\langle $			PROPOSED FILL AREAS		
\langle					
5					
\langle					
$\langle \rangle$					
\langle					
\langle					
5					
5					
$\langle \rangle$					
$\sum_{i=1}^{n}$					
$\langle \rangle$					
69.585					
528.450					
·					
\leq					
\langle					
	E D	27.05.24 20.10.23	RE-ISSUED FOR DA RE-ISSUED FOR DA	GAP GAP	DR DR
	C D	20.10.23 13.09.23	RE-ISSUED FOR DA	GAP GAP	DR
	В	24.01.23	ISSUED FOR DA	GAP	CJA
	A Rev	20.01.23 Date	ISSUED FOR INFORMATION	GAP	CJA
	Rev		Description	Drawn	
		1	 infrastructure & developmen Suite 8.01, 56 Clarence Stre Sydney, NSW 2000 	nt consulti eet	ng
		Y.	Sydney, NSW 2000 e admin@idcaus.com w www.idcaus.com		
	(& development consulting		
	PPC -				
	PROJ	LANDC	COM		
		EDMO	NDSON PARK PRECINC ⁻	Т3	
		LOT 5	DP1272931 BELLTOWN ROAD		
		VING TITLE	CUT AND FILL SITE SEC		19
		SHEET			UN
	SCAL	^E 1:50	0, 1:100 STATUS DA		
	DRAV				
		Z	22-514-DA-C137	E	

FOR CONTINUATION REFER ABOVE		ROPOSED 5m ROAD		
		11 11 12 12 12 12 12 12 12 12 12 12 12 1		
DATUM 60.000				
DESIGN LEVEL	73.580	73.680	73.319	
BULK LEVEL	73.580	73.680	73.319	
EXISTING LEVEL	72.513	71.820	72.357	
CHAINAGE	300.000	320.000	340.000	
1:500 HOR - 1:100 VER				


DATUM 60.000								
DESIGN LEVEL			.578	.772	78.958	LC0 07	.737	
			76.	78.	78	4		
BULK LEVEL				772	80		22	
DULNLEVEL				78.7	78.958		78.737	
EXISTING LEVEL	79.454	79.346	.578	79.115	79.024		78.845	
	79.	62	76.	79.	62	10	28	
	0	Q	75	Q	Q			
CHAINAGE	0.000	20.000	234.075	40.000	000		00.000 0000000000000000000000000000000	
		2	й	4	0	<u>م</u>		
1:500 HOR - 1:100 VER								

PROPOSED

15m ROAD

PROPOSED

7m LANE

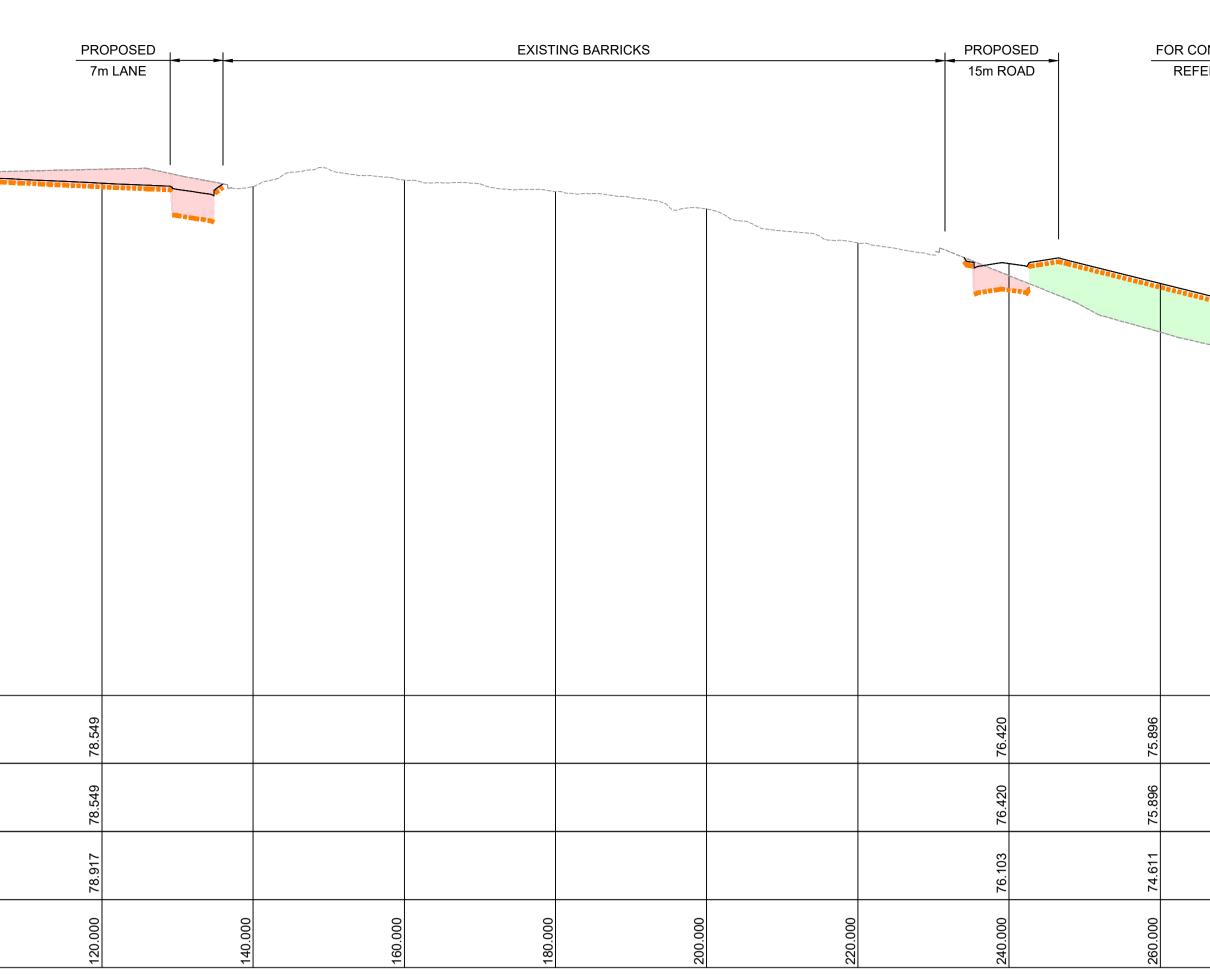

 \sim


 $\sim\sim$




	PROPOSED 15m ROAD			-	ROPOSED		
72.893	72.885	72.958	72.868	72.515	72.962	73.157	
72.893	72.885	72.958	72.868	72.515	72.962	73.157	
72.608	72.894	73.014	73.130	73.112	73.101	73.185	
360.000	380.000	400.000	420.000	440.000			



	LEGE	ND					
· · · ·)				LEC	GEND		
\$							
				PROPO	OSED CUT AREAS		
				PROPO	OSED FILL AREAS		
<							
74.467							
<							
>							
5							
$\sum_{i=1}^{n}$							
$\langle \rangle$							
)							
\leq							
2							
$\sum_{i=1}^{n}$							
\leq							
<							
)			1			1	
	E	27.05.24	RE ISSU	ED FOR I		GAP	DR
<	E D	20.10.23		ED FOR I		GAP	DR
< <	C	13.09.23		ED FOR I		GAP	DR
ζ	В	24.01.23	ISSUED	FOR DA		GAP	CJA
2	А	20.01.23			ORMATION	GAP	CJA
)	Rev	Date	Descripti	on		Drawn	Appr
5		9	-		infrastructure & developmen Suite 8.01, 56 Clarence Stre	it consult	ing
\leq	0-	()	0		Sulte 8.01, 56 Clarence Stre Sydney, NSW 2000		
< 1		/-	ĩd		e admin@idcaus.com w www.idcaus.com		
)			e & development		w www.iucaus.com		
)	PROJ	FCT					
\leq		FDMO	NDS(ARK PRECINC	Т3	
< <		LOT 5	DP12	27293	31		
)					'N ROAD		
5	DRAW	/ING TITLE					
\mathbf{x}			CUT	AND	FILL SITE SEC		IS I
\langle		SHEET	Γ4			- •	-
)							
)							
ý	SCAL		0 1.1	00	STATUS DA		
)			0, 1:1		DA		
\sim	DRAW	VING NO.	22-5	14-1	DA-C138	EN E	
		Ľ		1 1			

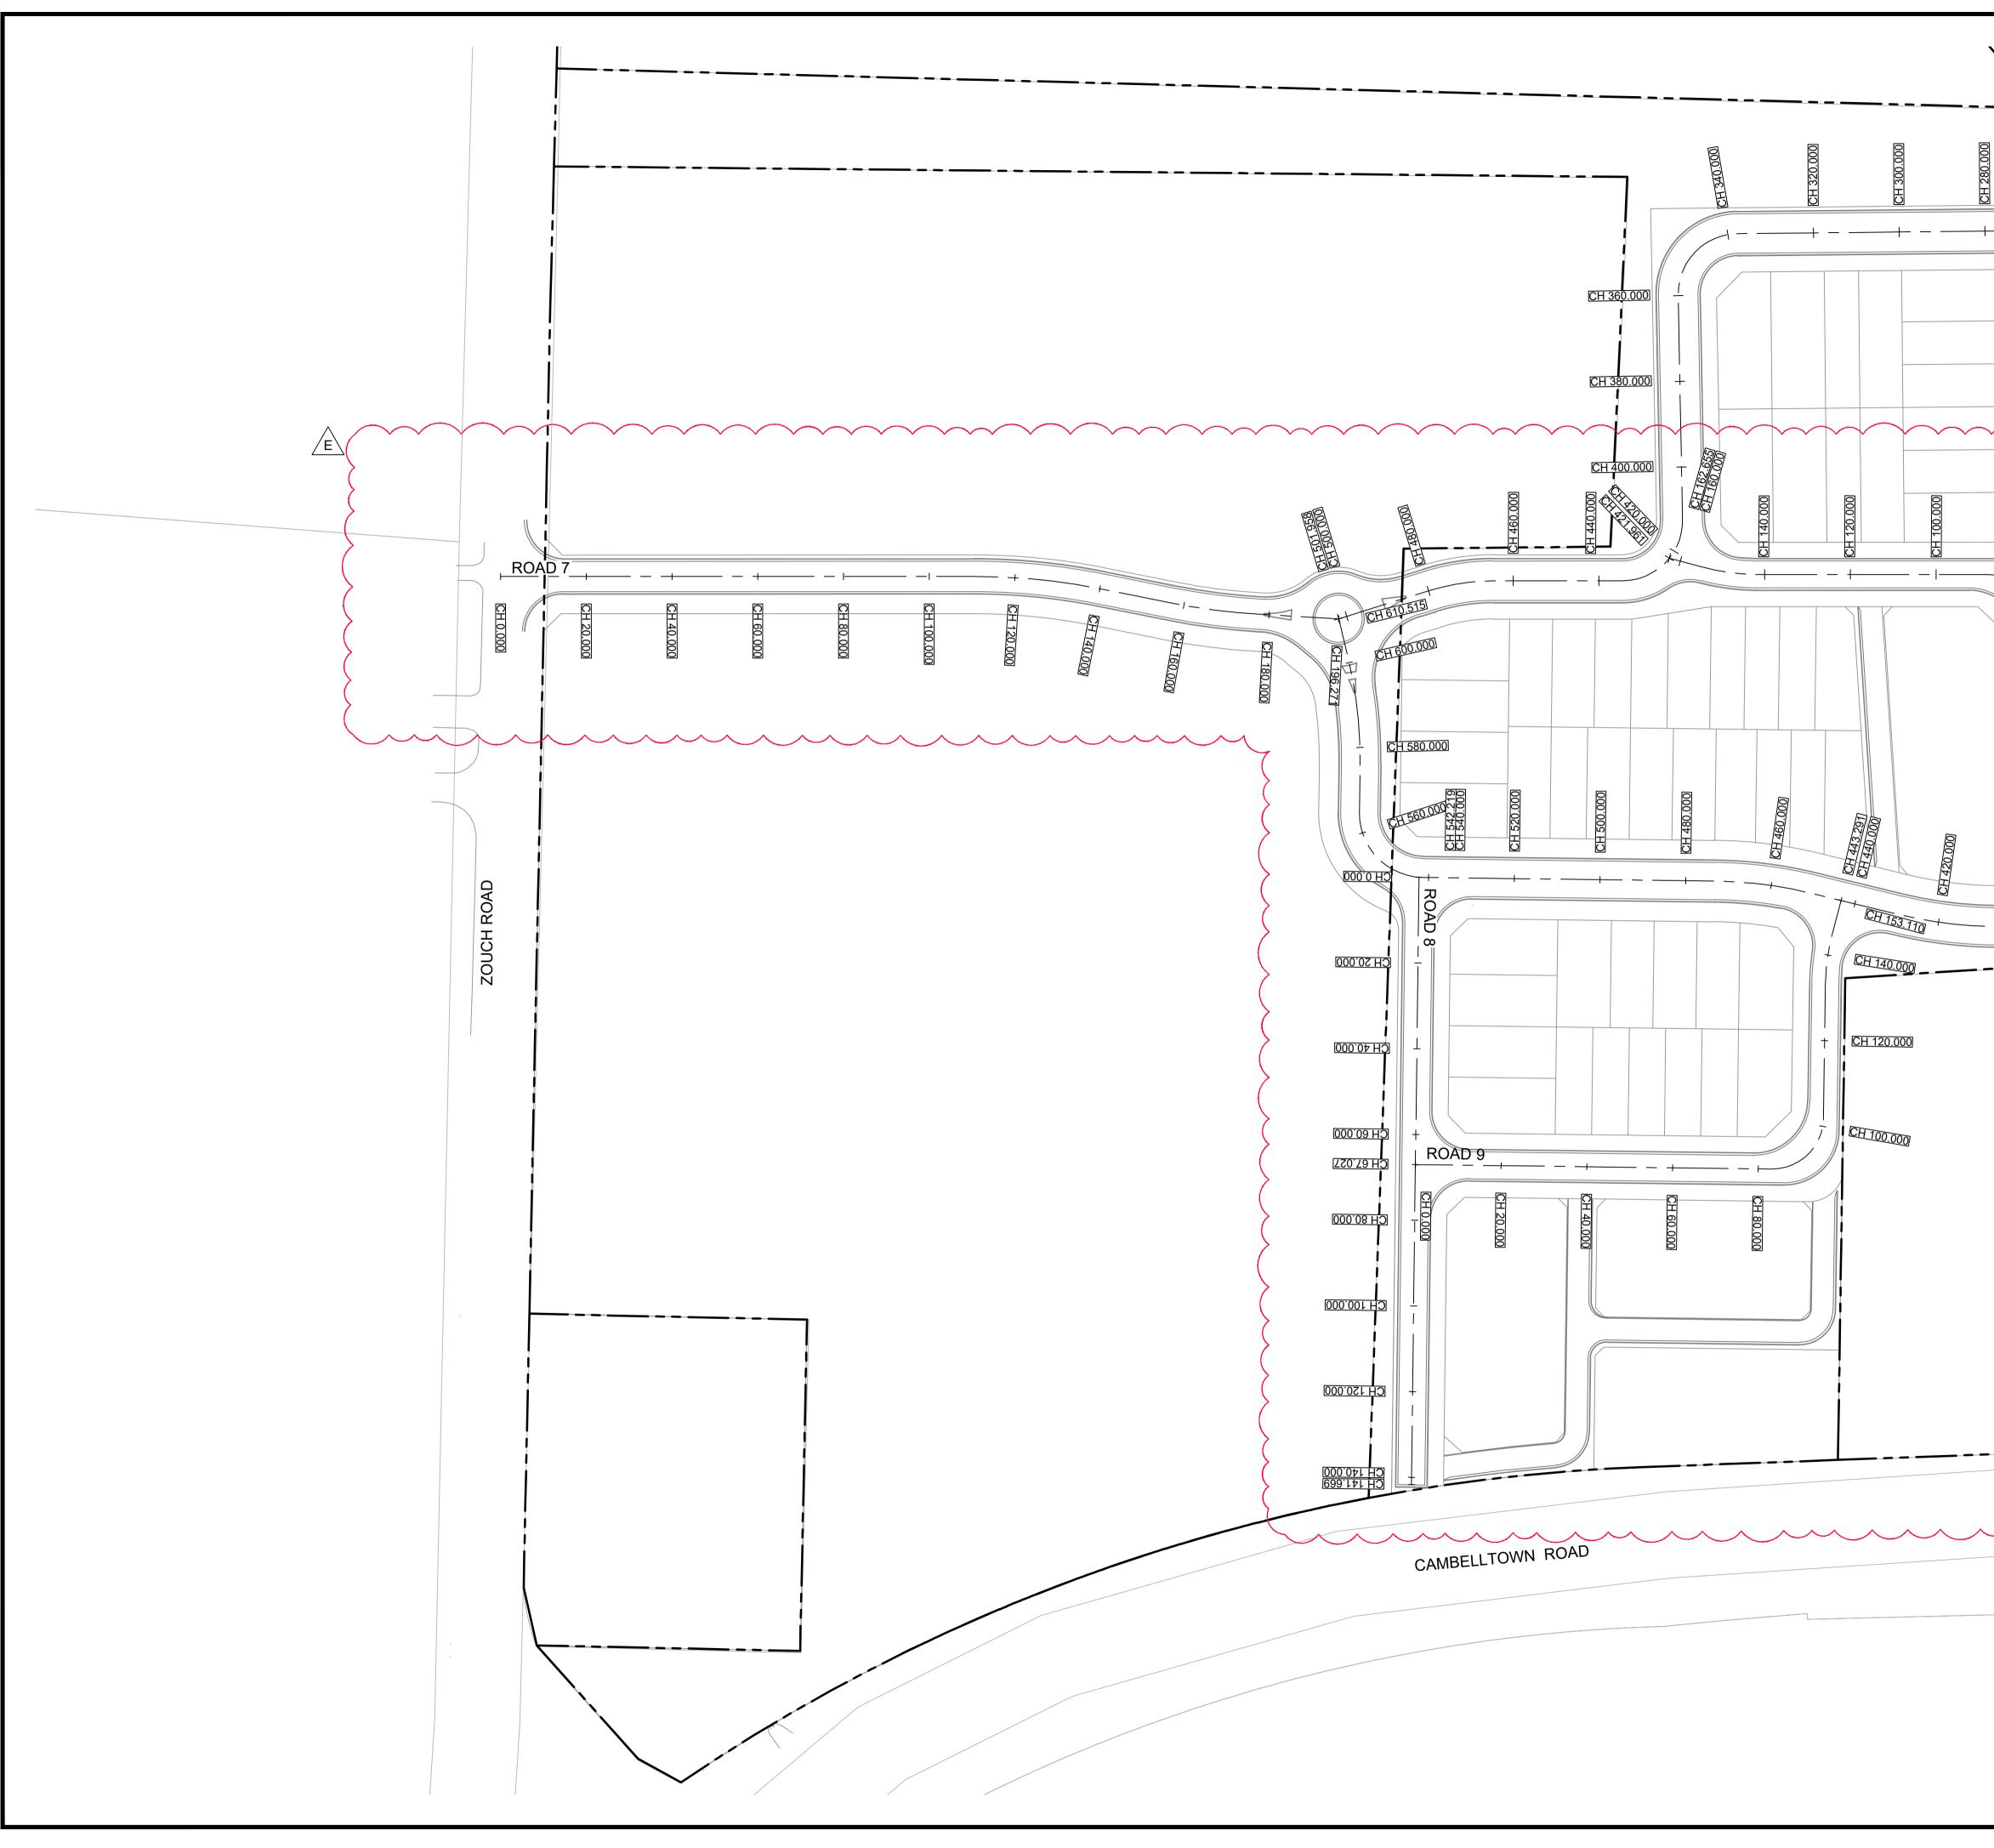


	LEGEND	
0000		
<u>3H 260</u>		
$ \left \right $		
+ <u>CH 60.000</u>		
T CH 40.000		
Z O C		
FORC		
\leq		
)		
\mathbf{i}	E 27.05.24 RE-ISSUED FOR DA	GAP DR
$\langle $	D 20.10.23 RE-ISSUED FOR DA	GAP DR
$\langle $	C13.09.23RE-ISSUED FOR DAB24.01.23ISSUED FOR DA	GAP DR GAP CJA
$\langle $	B24.01.23ISSUED FOR DAA20.01.23ISSUED FOR INFORMATION	GAP CJA GAP CJA
$\langle $	Rev Date Description	Drawn Appr
$\langle \rangle$	infrastructure & developmen	at consulting
)	Suite 8.01, 56 Clarence Stree Sydney, NSW 2000	eet
	Sydney, NSW 2000 e admin@idcaus.com w www.idcaus.com	
	infrastructure & development consulting	
\leq		
\sim	LANDCOM EDMONDSON PARK PRECINC	ТЗ
	LOT 5 DP1272931	
	CAMPBELLTOWN ROAD	
	DRAWING TITLE	——————————————————————————————————————
	ROAD ALIGNMENT CONTROL	PLAN
	SHEET 1	
	SCALE 1:750 STATUS DA	
	DRAWING NO. 22-514-DA-C150	EV 💻

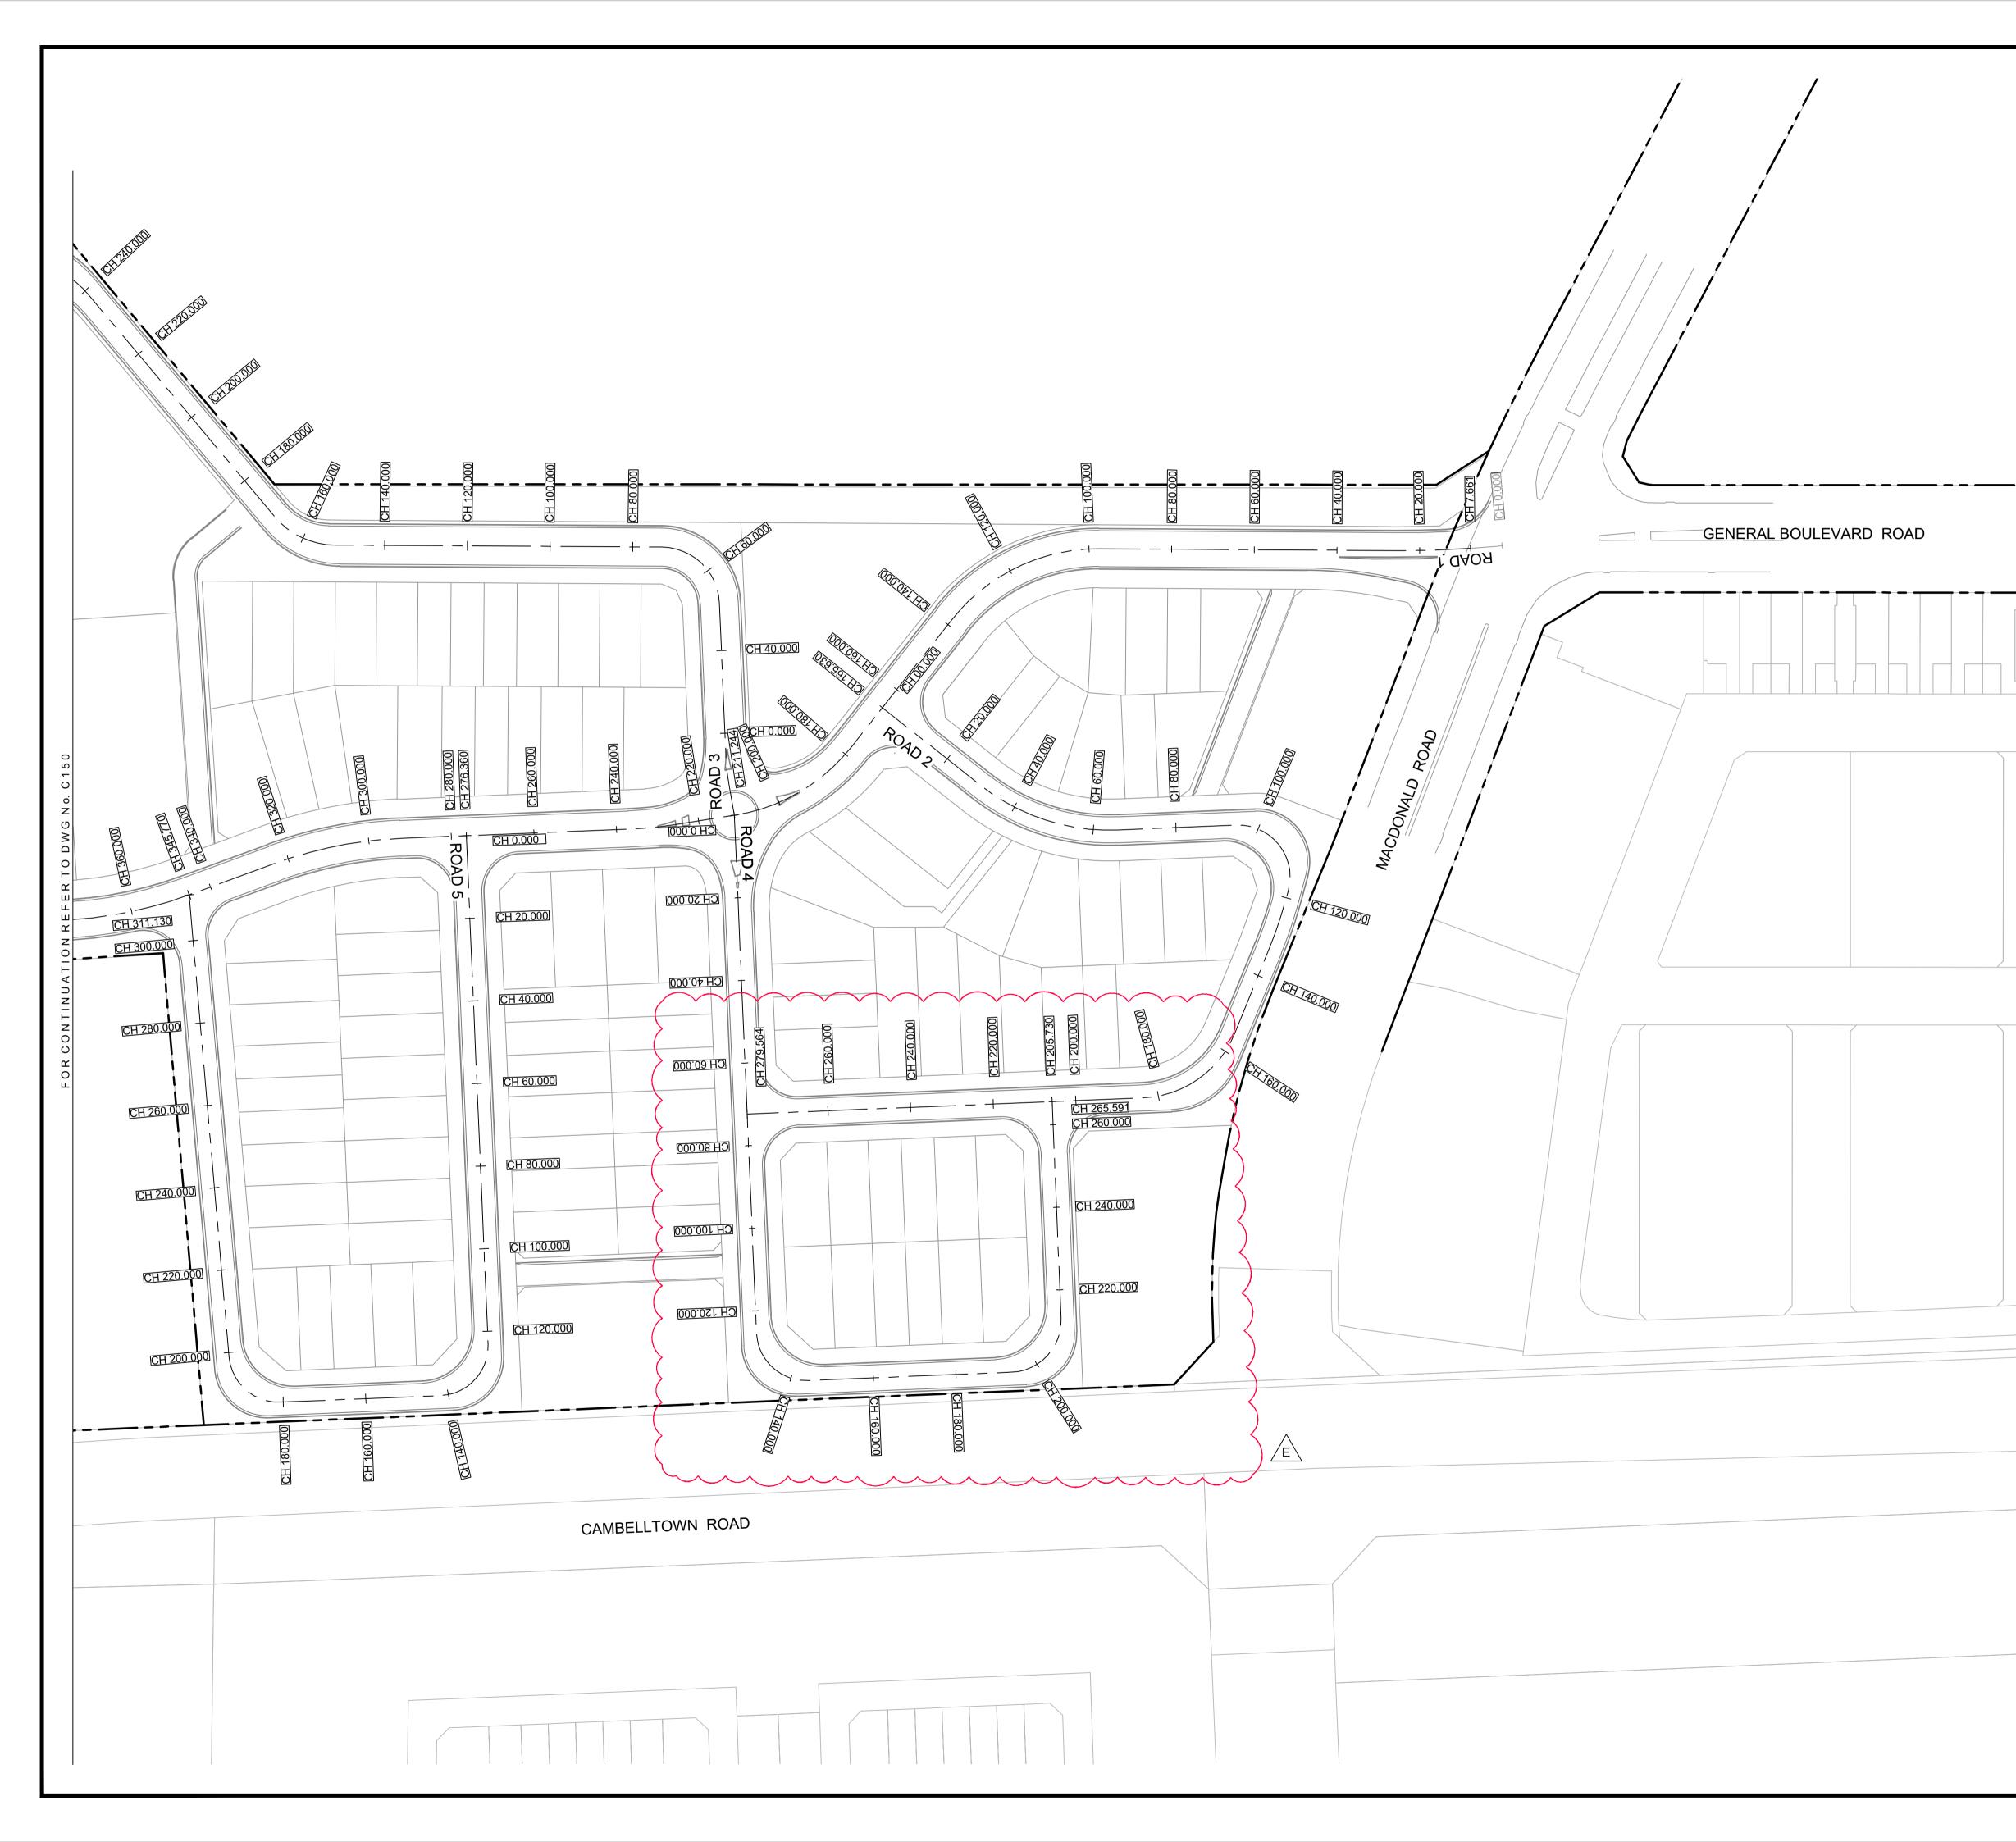


E	27.05.24	RE-ISSUED FOR D	A		GAP	DR
D	20.10.23	RE-ISSUED FOR D			GAP	DR
C B	13.09.23 24.01.23	RE-ISSUED FOR D	A		GAP GAP	DR CJA
A	20.01.23	ISSUED FOR INFO	RMATIC	ON CONTRACTOR OF	GAP	CJA
Rev	Date	Description			Drawn	
0		Pidc & development consulting	Suite	tructure & developmen 8.01, 56 Clarence Stre ey, NSW 2000 admin@idcaus.com www.idcaus.com		ing
	LANDO EDMO LOT 5 CAMPE		1	PRECINC OAD	Г З	
	NING TITLE ROAD SHEET		NT (CONTROL	⊃LAI	N
SCAL	^E 1:75	0	STATU	^{IS} DA		
DRAW	/ING NO. 2	2-514-[DA-	-C151	E	


LEGEND


 \bigcirc

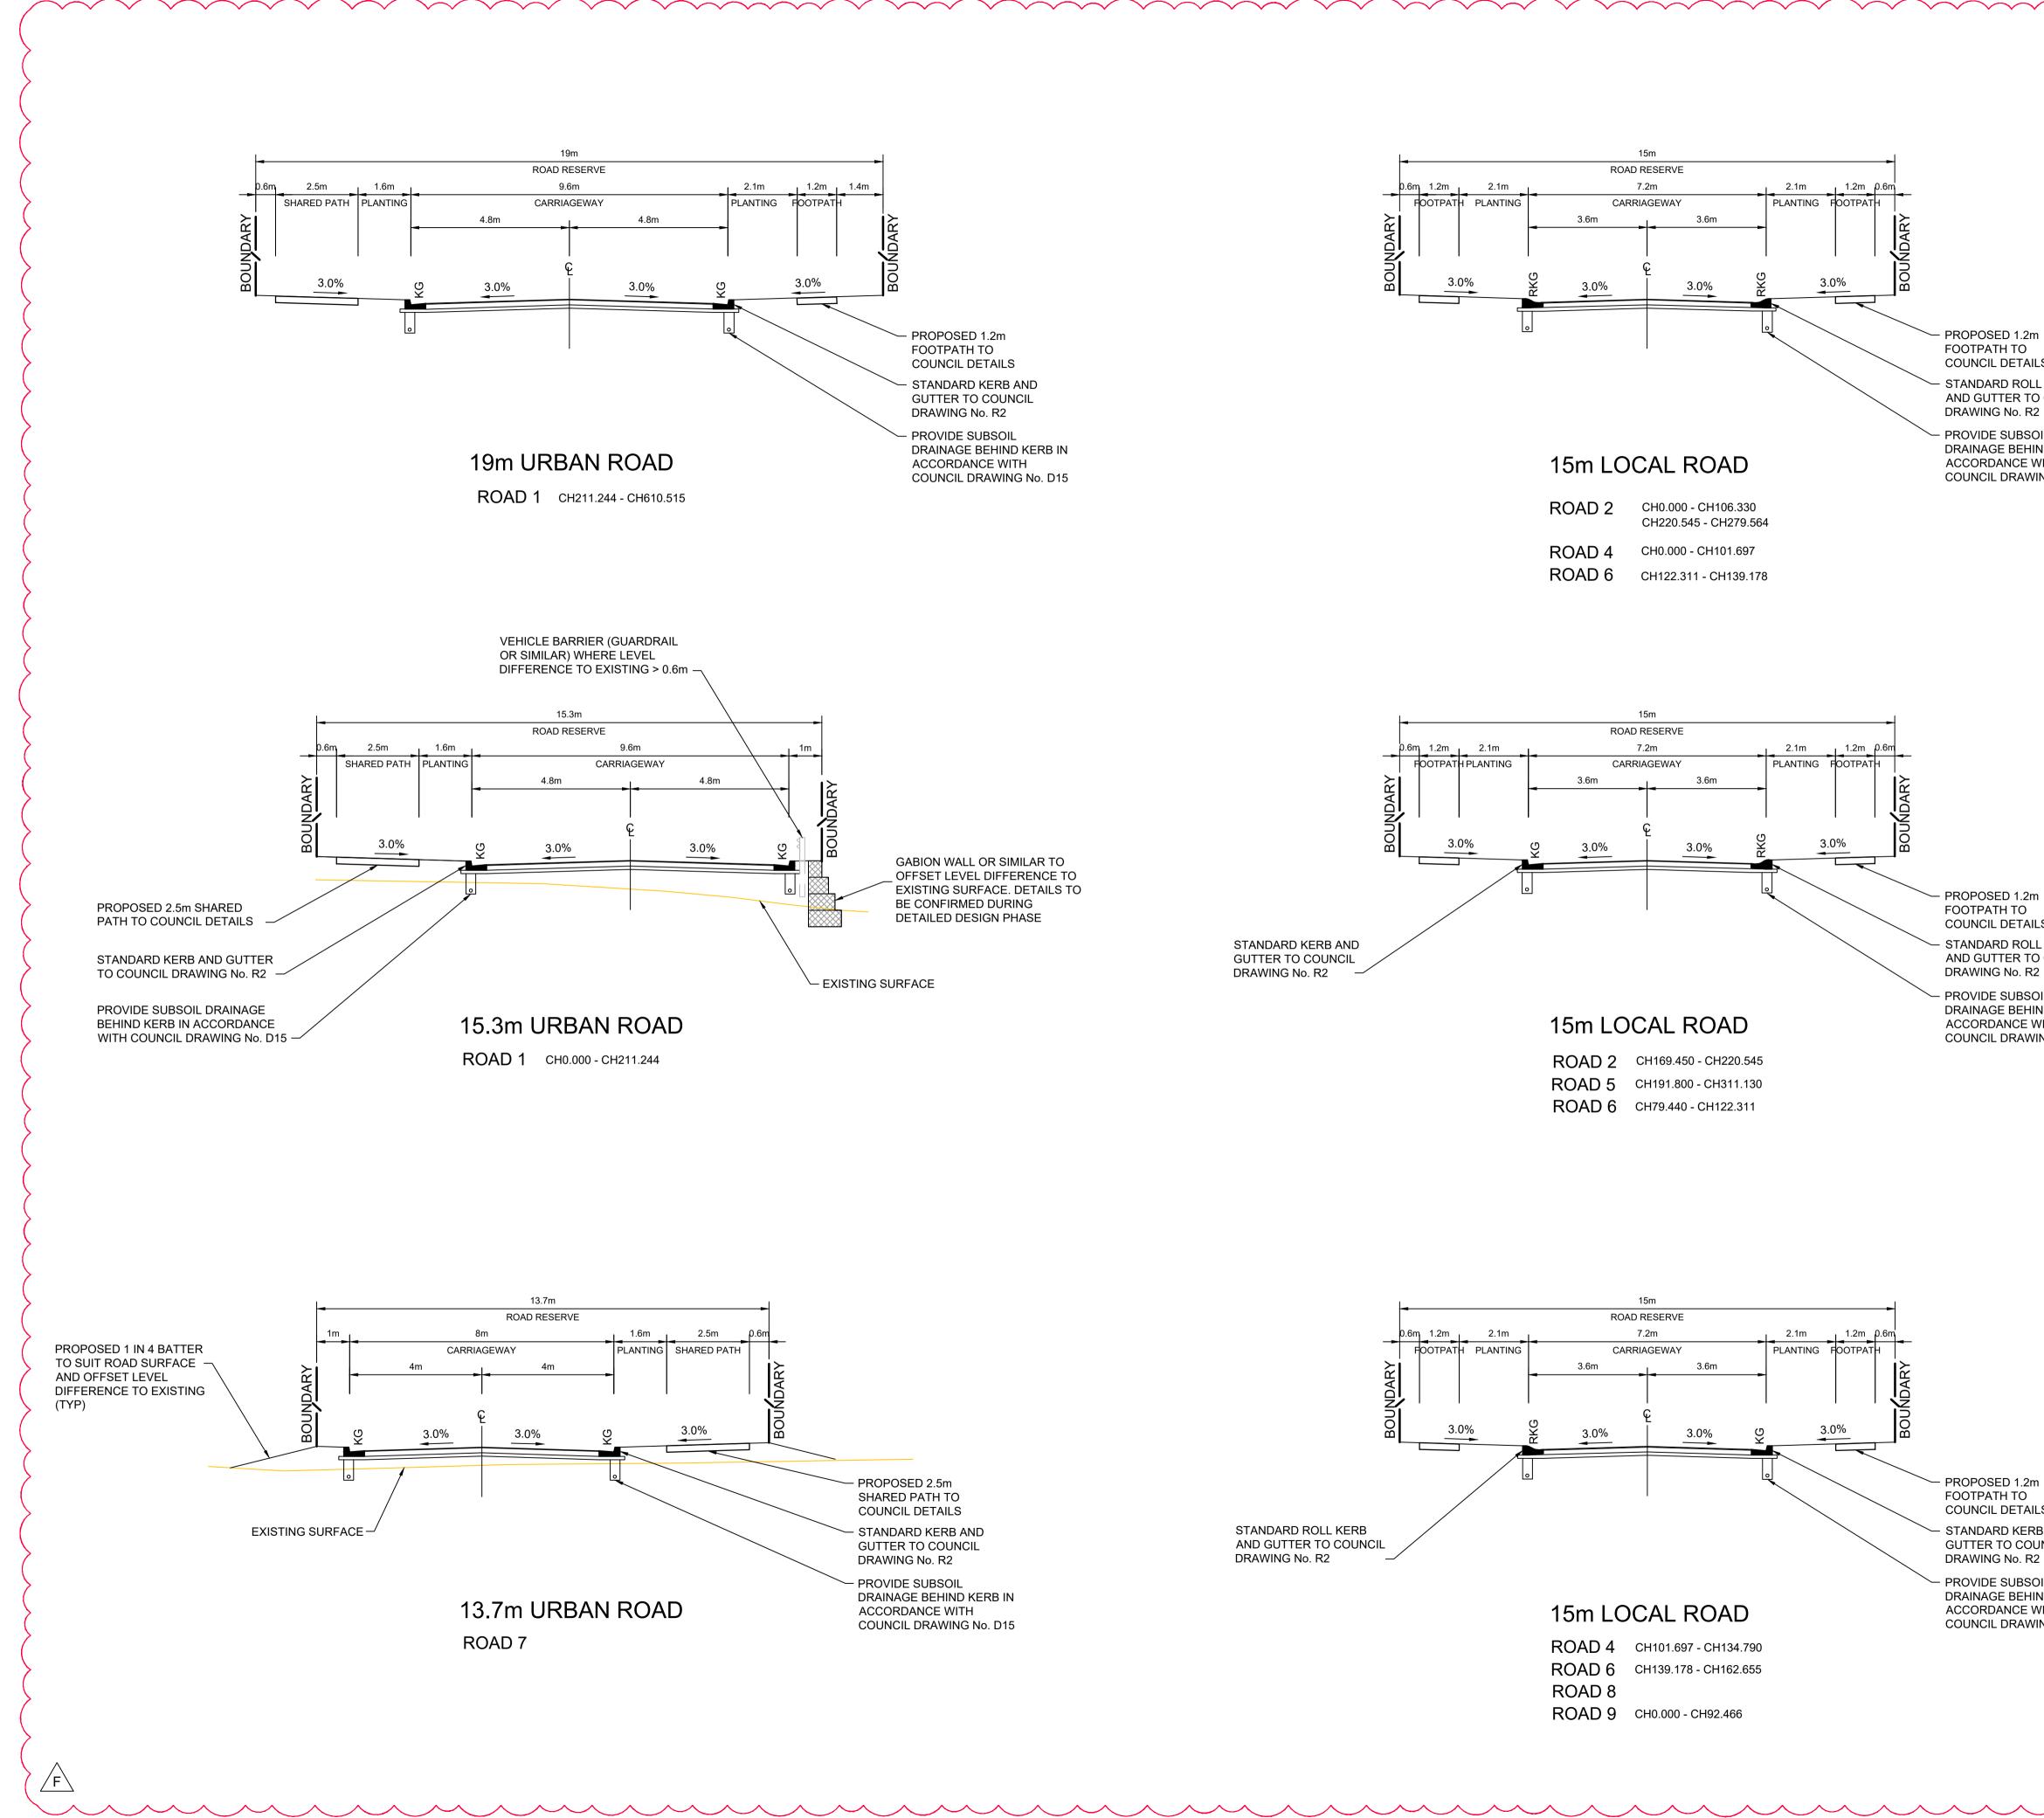



	LEGEND		
$\sum_{i=1}^{n}$			
<			
ζ.			
<			
))			
י 🧹			
LS L KERB			
ND KERB IN VITH			
ING No. D15			
2			
2			
)			
$\sum_{i=1}^{n}$			
ς			
<			
)			
ζ			
$\sum_{i=1}^{n}$			
ζ.			
\langle			
$\left\{ \right.$			
)			
LS L KERB			
LS L KERB D COUNCIL			
LS L KERB D COUNCIL 2 DIL ND KERB IN			
LS L KERB D COUNCIL 2 DIL ND KERB IN VITH			
LS L KERB D COUNCIL 2 DIL ND KERB IN VITH			
LS L KERB D COUNCIL 2 DIL ND KERB IN VITH		GAP	
LS L KERB D COUNCIL 2 DIL ND KERB IN VITH	E 27.05.24 RE-ISSUED FOR DA D 20.10.23 RE-ISSUED FOR DA	GAP	DR
LS L KERB COUNCIL 2 DIL ND KERB IN VITH			
LS L KERB COUNCIL 2 DIL ND KERB IN VITH	D 20.10.23 RE-ISSUED FOR DA C 13.09.23 RE-ISSUED FOR DA B 24.01.23 ISSUED FOR DA	GAP GAP GAP	DR DR CJA
LS L KERB COUNCIL 2 DIL ND KERB IN VITH	D20.10.23RE-ISSUED FOR DAC13.09.23RE-ISSUED FOR DAB24.01.23ISSUED FOR DAA20.01.23ISSUED FOR INFORMATION	GAP GAP GAP GAP	DR DR CJA CJA
LS L KERB D COUNCIL 2 DIL ND KERB IN VITH	D20.10.23RE-ISSUED FOR DAC13.09.23RE-ISSUED FOR DAB24.01.23ISSUED FOR DAA20.01.23ISSUED FOR INFORMATIONRevDateDescription	GAP GAP GAP GAP Drawn	DR DR CJA CJA Appr
LS L KERB D COUNCIL 2 DIL ND KERB IN VITH	D 20.10.23 RE-ISSUED FOR DA C 13.09.23 RE-ISSUED FOR DA B 24.01.23 ISSUED FOR DA A 20.01.23 ISSUED FOR INFORMATION Rev Date Description	GAP GAP GAP GAP Drawn	DR DR CJA CJA Appr
LS L KERB D COUNCIL 2 DIL ND KERB IN VITH	D 20.10.23 RE-ISSUED FOR DA C 13.09.23 RE-ISSUED FOR DA B 24.01.23 ISSUED FOR DA A 20.01.23 ISSUED FOR INFORMATION Rev Date Description	GAP GAP GAP GAP Drawn	DR DR CJA CJA Appr
LS L KERB COUNCIL 2 DIL ND KERB IN VITH	D 20.10.23 RE-ISSUED FOR DA C 13.09.23 RE-ISSUED FOR DA B 24.01.23 ISSUED FOR DA A 20.01.23 ISSUED FOR INFORMATION Rev Date Description infrastructure & development of Suite 8.01, 56 Clarence Street Sydney, NSW 2000 e admin@idcaus.com w www.idcaus.com	GAP GAP GAP GAP Drawn	DR DR CJA CJA Appr
LS L KERB D COUNCIL 2 DIL ND KERB IN VITH ING No. D15	D 20.10.23 RE-ISSUED FOR DA C 13.09.23 RE-ISSUED FOR DA B 24.01.23 ISSUED FOR DA A 20.01.23 ISSUED FOR INFORMATION Rev Date Description	GAP GAP GAP GAP Drawn	DR DR CJA CJA Appr
L KERB O COUNCIL ND KERB IN VITH ING No. D15	D 20.10.23 RE-ISSUED FOR DA C 13.09.23 RE-ISSUED FOR DA B 24.01.23 ISSUED FOR DA A 20.01.23 ISSUED FOR INFORMATION Rev Date Description infrastructure & development of Suite 8.01, 56 Clarence Street Sydney, NSW 2000 e admin@idcaus.com w www.idcaus.com PROJECT	GAP GAP GAP GAP Drawn	DR DR CJA CJA Appr
LS B AND	D 20.10.23 RE-ISSUED FOR DA C 13.09.23 RE-ISSUED FOR DA B 24.01.23 ISSUED FOR INFORMATION A 20.01.23 ISSUED FOR INFORMATION Rev Date Description infrastructure & development of Suite 8.01, 56 Clarence Stree Sydney, NSW 2000 e admin@idcaus.com WWW.idcaus.com WWW.idcaus.com	GAP GAP GAP Drawn consult	DR DR CJA CJA Appr
LS B AND JNCIL	D 20.10.23 RE-ISSUED FOR DA C 13.09.23 RE-ISSUED FOR DA B 24.01.23 ISSUED FOR INFORMATION A 20.01.23 ISSUED FOR INFORMATION Rev Date Description infrastructure & development osuite 8.01, 56 Clarence Stree Sydney, NSW 2000 e admin@idcaus.com www.idcaus.com www.idcaus.com PROJECT LANDCOM PARK PRECINCT	GAP GAP GAP Drawn consult	DR DR CJA CJA Appr
L KERB D COUNCIL DIL ND KERB IN VITH ING No. D15	D 20.10.23 RE-ISSUED FOR DA C 13.09.23 RE-ISSUED FOR DA B 24.01.23 ISSUED FOR INFORMATION A 20.01.23 ISSUED FOR INFORMATION Rev Date Description infrastructure & development of Suite 8.01, 56 Clarence Stree Sydney, NSW 2000 e admin@idcaus.com WWW.idcaus.com WWW.idcaus.com	GAP GAP GAP Drawn consult	DR DR CJA CJA Appr
LS B AND JINCIL 2 DIL ND KERB IN VITH ING No. D15	D 20.10.23 RE-ISSUED FOR DA C 13.09.23 RE-ISSUED FOR DA B 24.01.23 ISSUED FOR DA A 20.01.23 ISSUED FOR INFORMATION Rev Date Description infrastructure & development of Suite 8.01, 56 Clarence Stree Sydney, NSW 2000 e admin@idcaus.com w www.idcaus.com PROJECT LANDCOM EDMONDSON PARK PRECINCT LOT 5 DP1272931 CAMPBELLTOWN ROAD	GAP GAP GAP Drawn consult	DR DR CJA CJA Appr
LS L KERB D COUNCIL 2 DIL ND KERB IN VITH ING No. D15	D 20.10.23 RE-ISSUED FOR DA C 13.09.23 RE-ISSUED FOR DA B 24.01.23 ISSUED FOR DA A 20.01.23 ISSUED FOR INFORMATION Rev Date Description infrastructure & development of Suite 8.01, 56 Clarence Stree Sydney, NSW 2000 e admin@idcaus.com www.idcaus.com www.idcaus.com PROJECT LANDCOM EDMONDSON PARK PRECINCT LOT 5 DP1272931 CAMPBELLTOWN ROAD DRAWING TITLE	GAP GAP GAP Drawn consult	DR DR CJA CJA Appr
LS L KERB D COUNCIL 2 DIL ND KERB IN VITH ING No. D15	D 20.10.23 RE-ISSUED FOR DA C 13.09.23 RE-ISSUED FOR DA B 24.01.23 ISSUED FOR DA A 20.01.23 ISSUED FOR INFORMATION Rev Date Description infrastructure & development of Suite 8.01, 56 Clarence Stree Sydney, NSW 2000 e admin@idcaus.com w www.idcaus.com PROJECT LANDCOM EDMONDSON PARK PRECINCT LOT 5 DP1272931 CAMPBELLTOWN ROAD	GAP GAP GAP Drawn consult	DR DR CJA CJA Appr
LS L KERB D COUNCIL 2 DIL ND KERB IN VITH ING No. D15	D 20.10.23 RE-ISSUED FOR DA C 13.09.23 RE-ISSUED FOR DA B 24.01.23 ISSUED FOR INFORMATION Rev Date Description infrastructure & development of Suite 8.01, 56 Clarence Stree Sydney, NSW 2000 e admin@idcaus.com W www.idcaus.com PROJECT LANDCOM DP1272931 CAMPBELLTOWN ROAD	GAP GAP GAP Drawn consult	DR DR CJA CJA Appr
LS L KERB D COUNCIL 2 DIL ND KERB IN VITH ING No. D15	D 20.10.23 RE-ISSUED FOR DA C 13.09.23 RE-ISSUED FOR DA B 24.01.23 ISSUED FOR INFORMATION Rev Date Description infrastructure & development of Suite 8.01, 56 Clarence Stree Sydney, NSW 2000 e admin@idcaus.com W www.idcaus.com PROJECT LANDCOM DP1272931 CAMPBELLTOWN ROAD	GAP GAP GAP Drawn consult	DR DR CJA CJA Appr
LS L KERB D COUNCIL 2 DIL ND KERB IN VITH ING No. D15	D 20.10.23 RE-ISSUED FOR DA C 13.09.23 RE-ISSUED FOR DA B 24.01.23 ISSUED FOR INFORMATION Rev Date Description infrastructure & development of Suite 8.01, 56 Clarence Stree Sydney, NSW 2000 e admin@idcaus.com www.idcaus.com www.idcaus.com PROJECT LANDCOM EDMONDSON PARK PRECINCT LOT 5 DP1272931 CAMPBELLTOWN ROAD DRAWING TITLE TYPICAL ROAD SECTIONS DRAWING TITLE	GAP GAP GAP Drawn consult	DR DR CJA CJA Appr
n LS L KERB D COUNCIL 2 DIL ND KERB IN WITH ING No. D15 ND KERB IN VITH ING No. D15	D 20.10.23 RE-ISSUED FOR DA C 13.09.23 RE-ISSUED FOR DA B 24.01.23 ISSUED FOR INFORMATION Rev Date Description infrastructure & development of Suite 8.01, 56 Clarence Stree Sydney, NSW 2000 e admin@idcaus.com W Www.idcaus.com PROJECT LANDCOM LANDCOM EDMONDSON PARK PRECINCT LOT 5 DP1272931 CAMPBELLTOWN ROAD	GAP GAP GAP Drawn consult	DR CJA CJA Appr ing

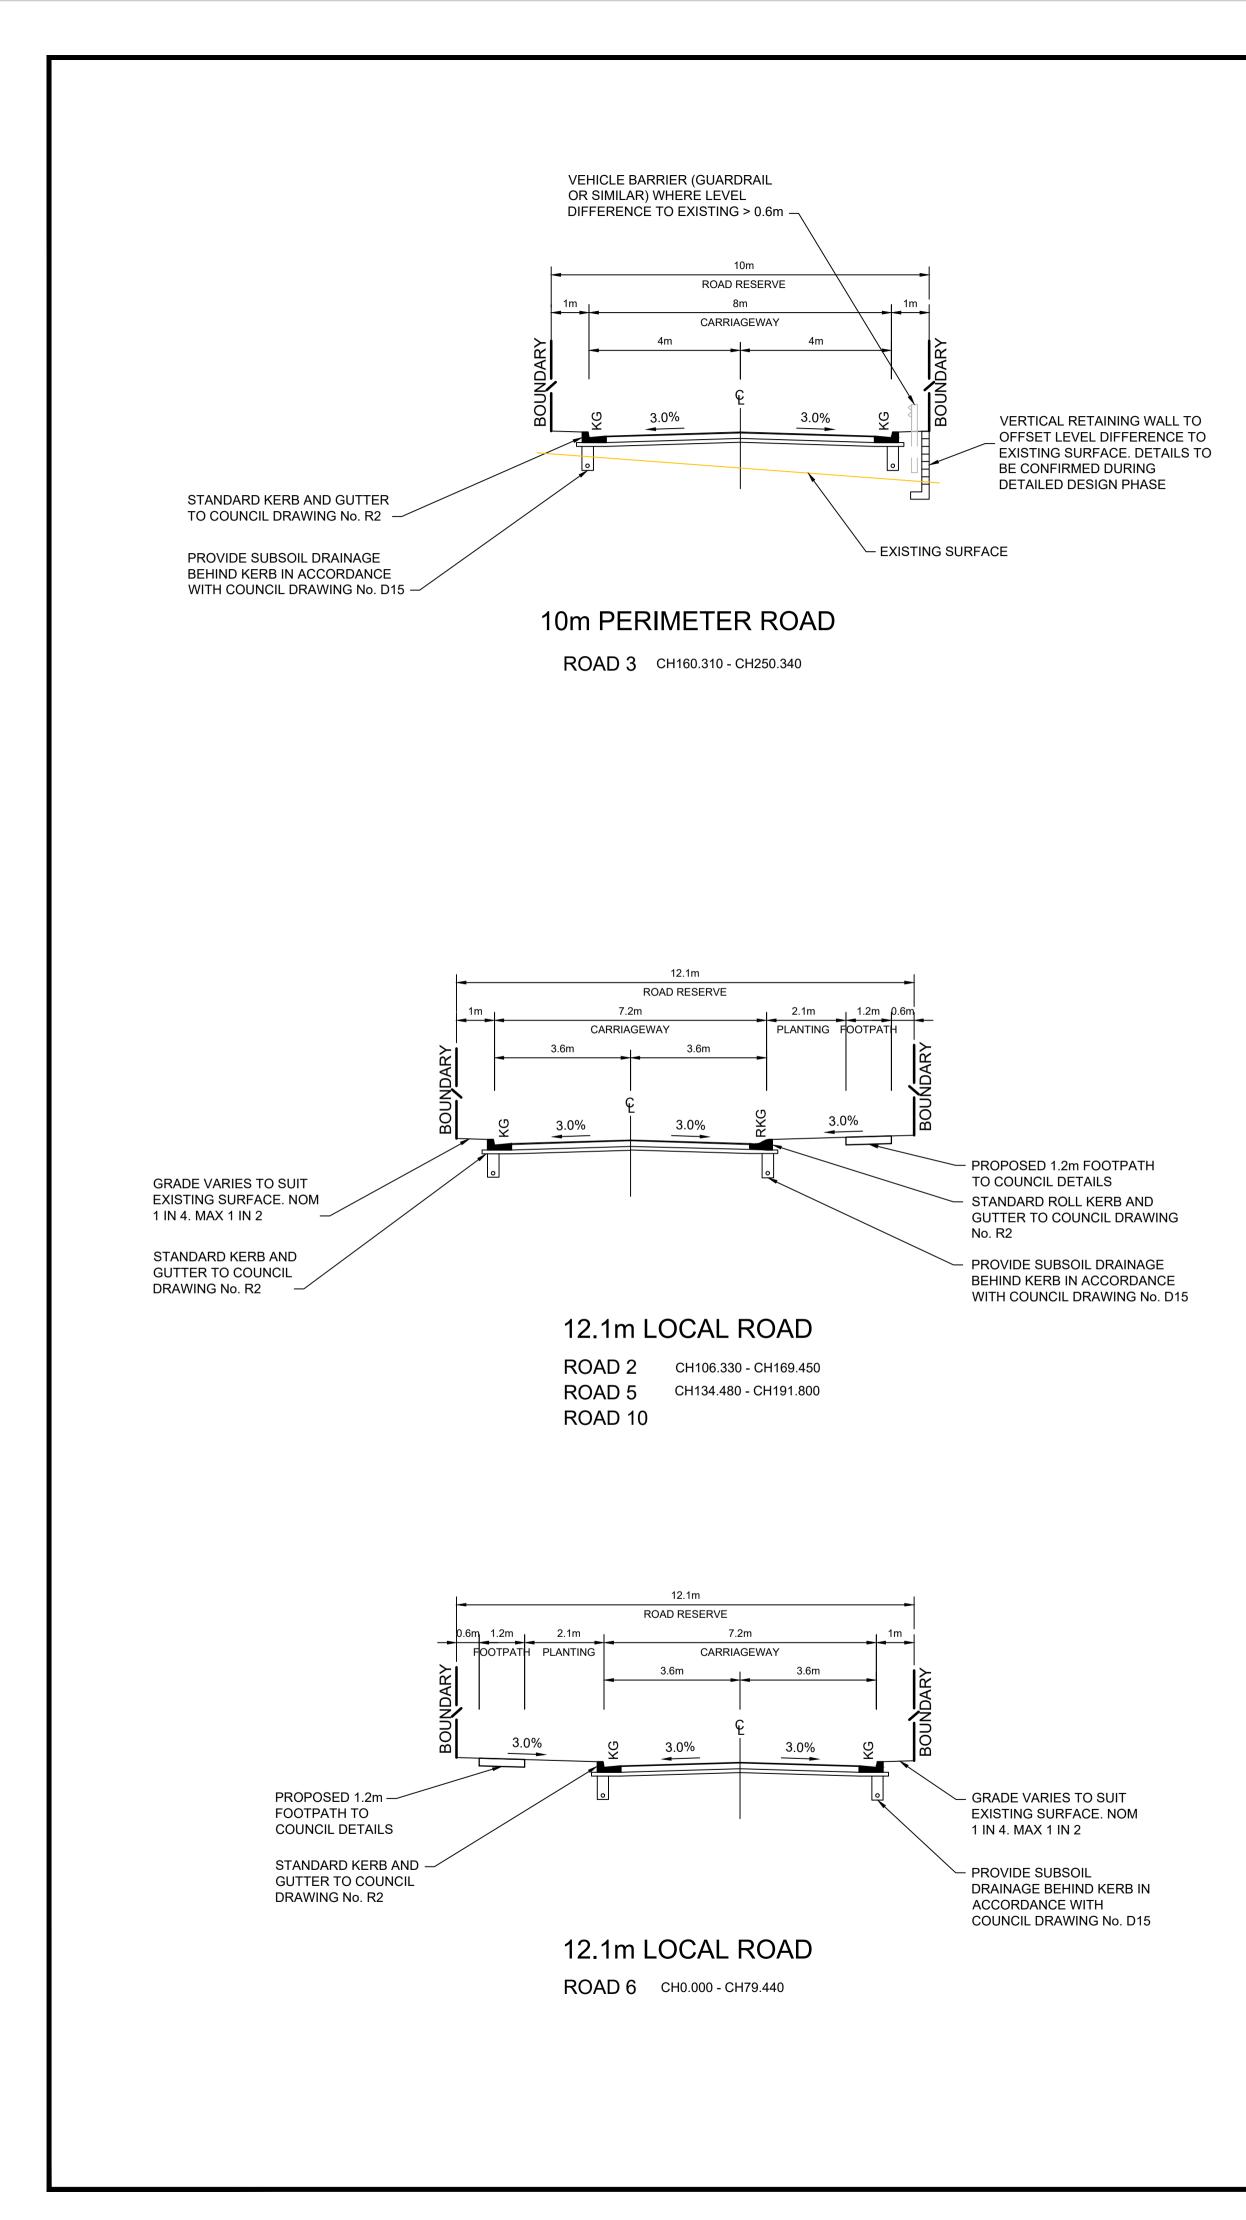

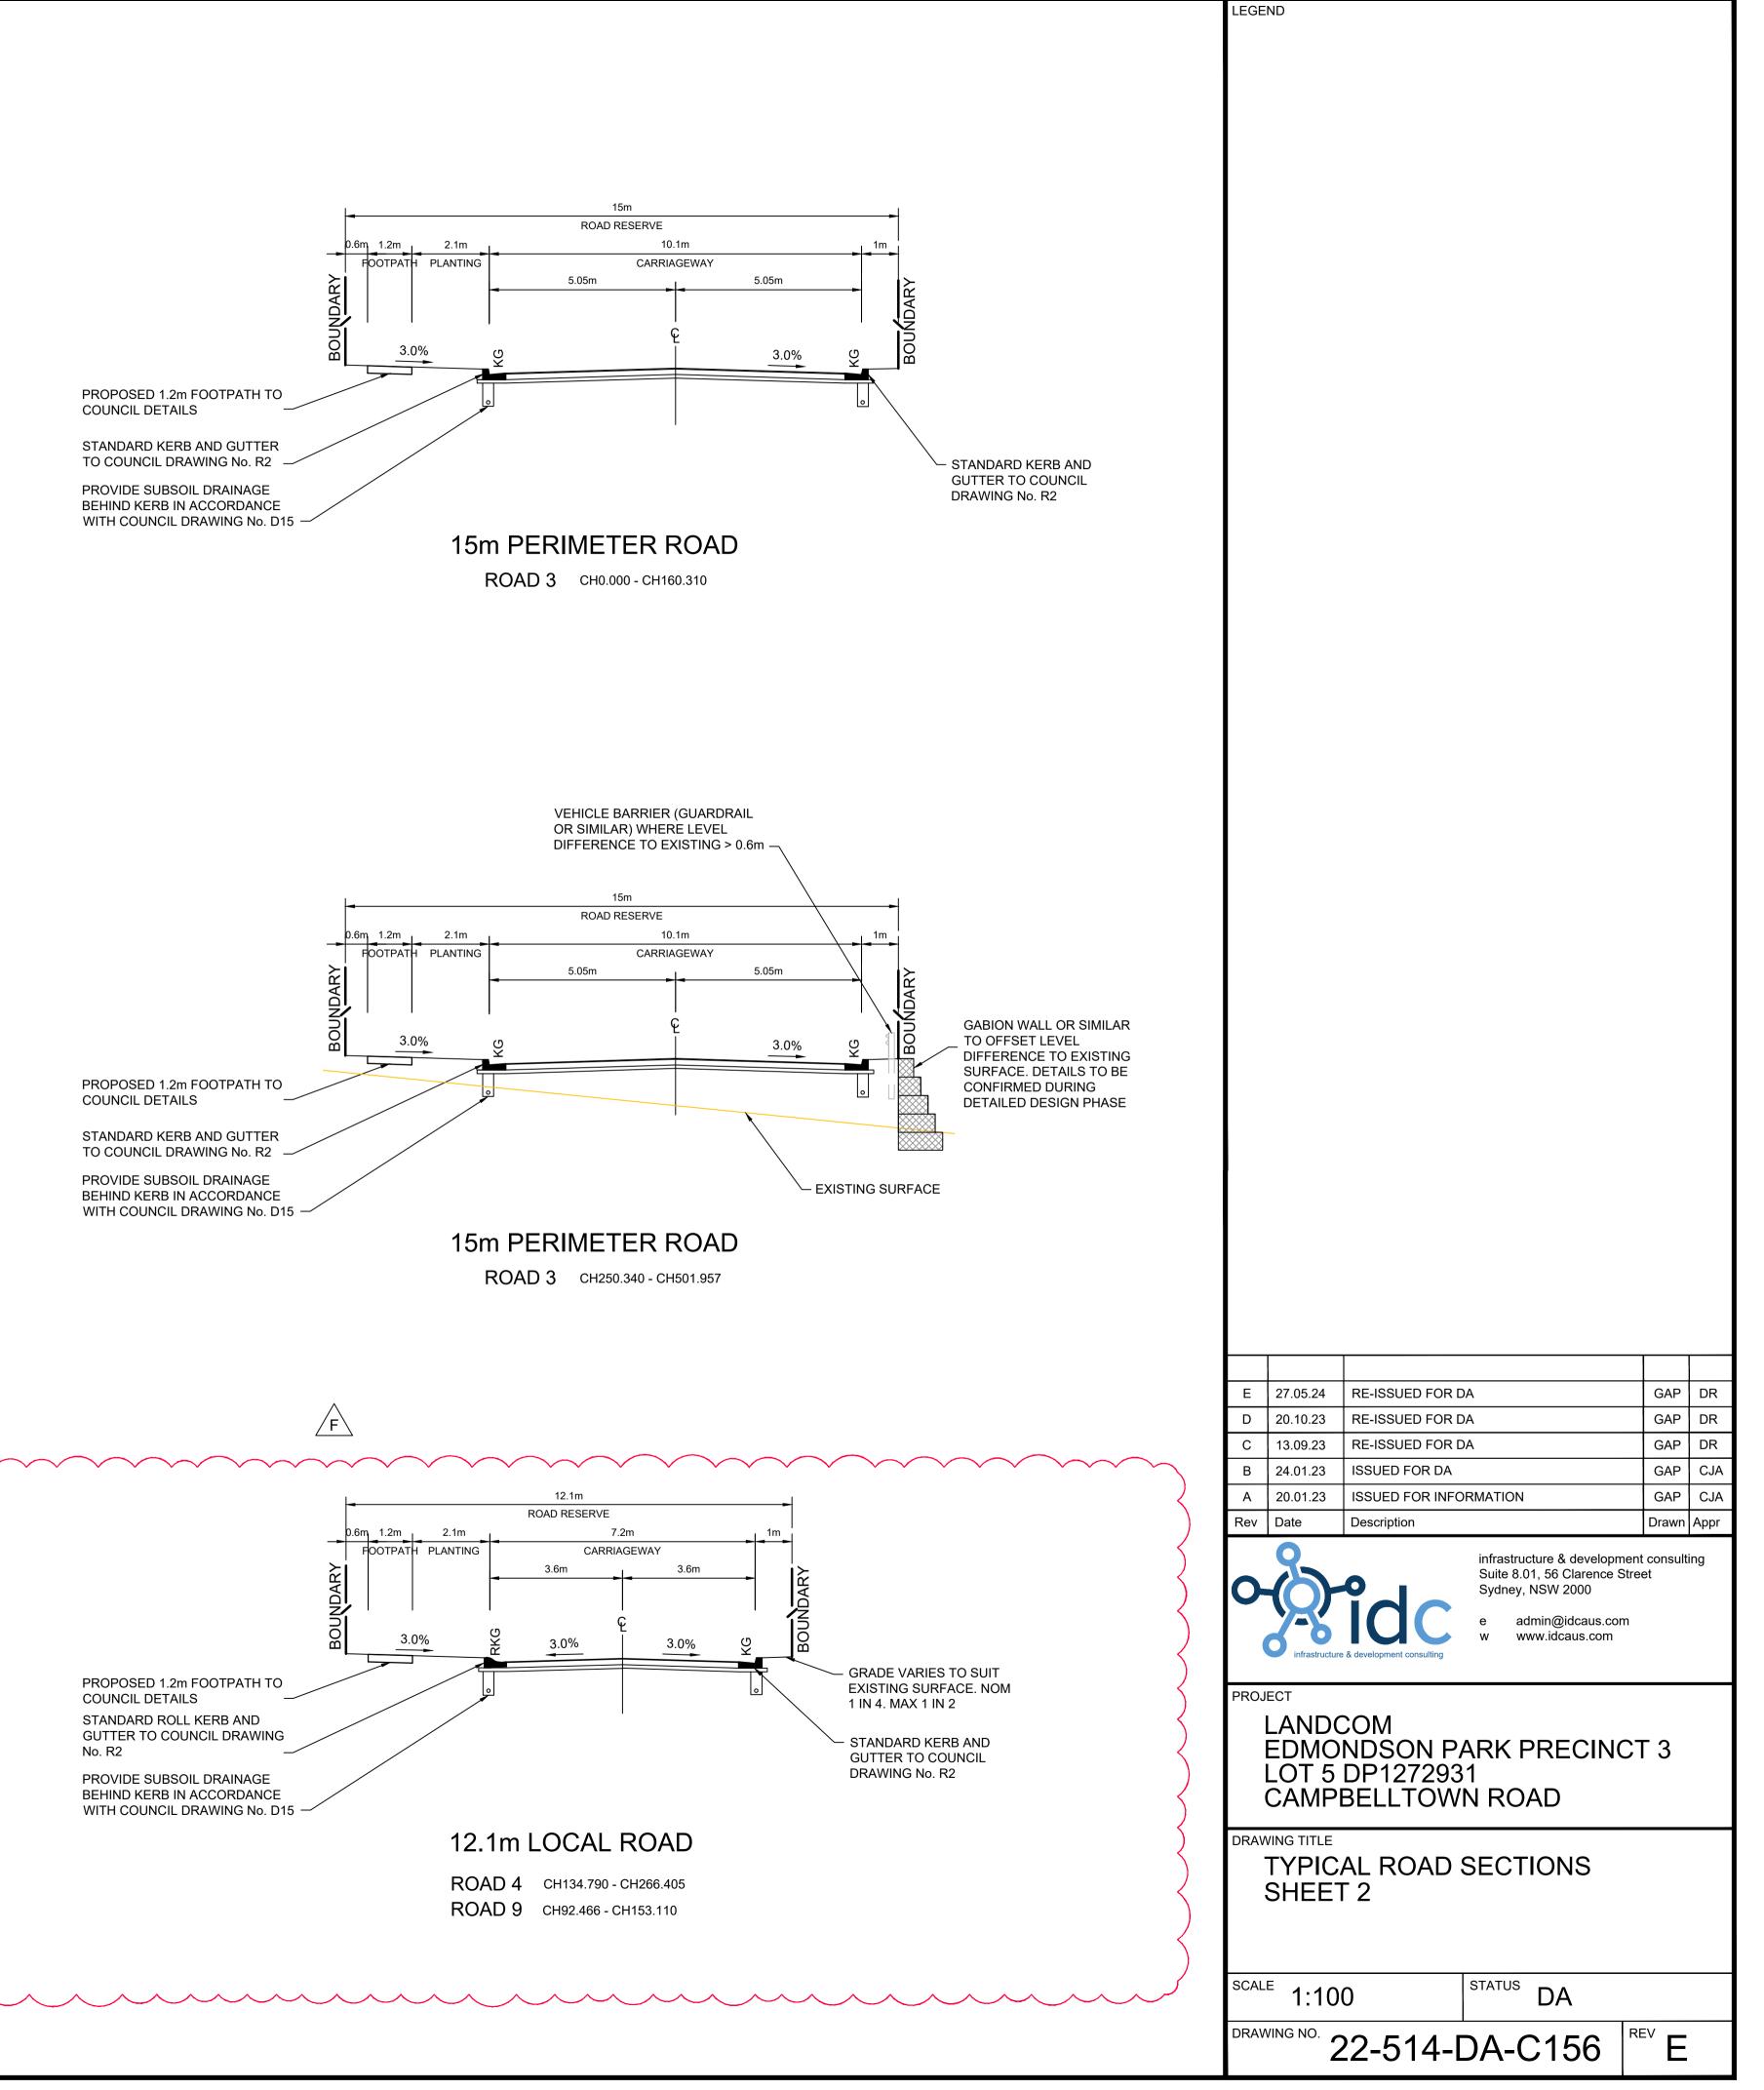

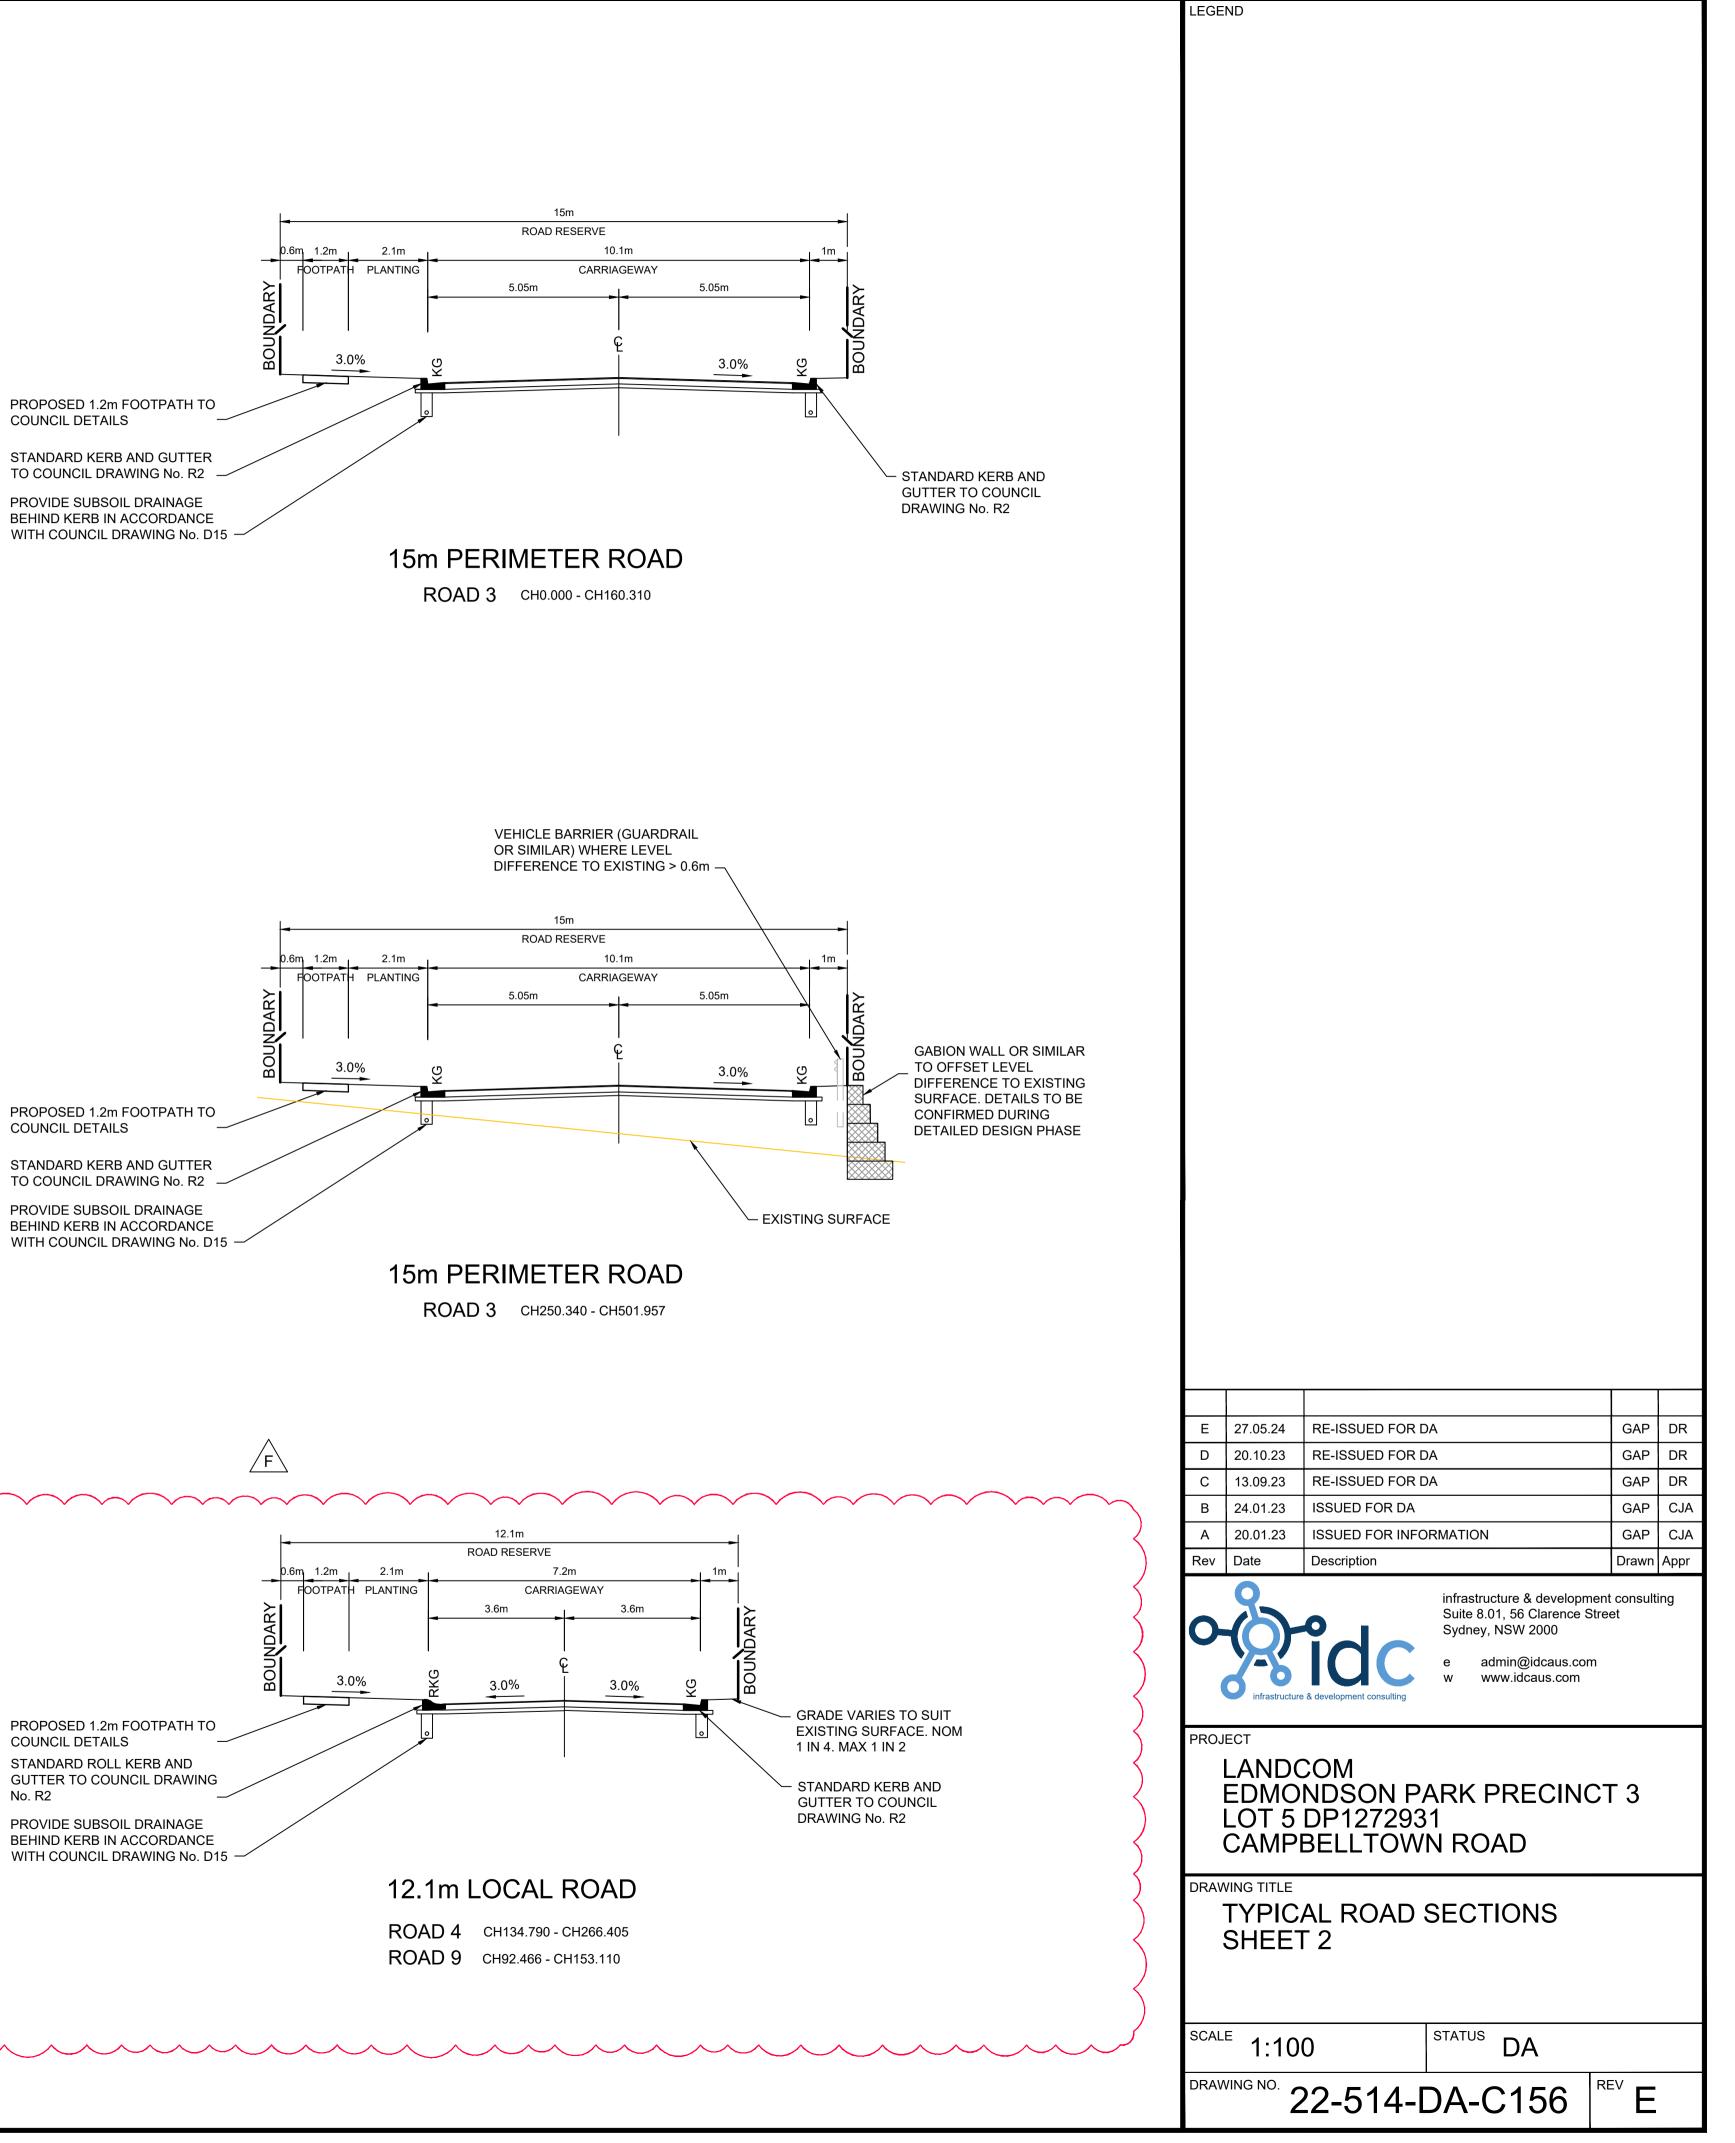

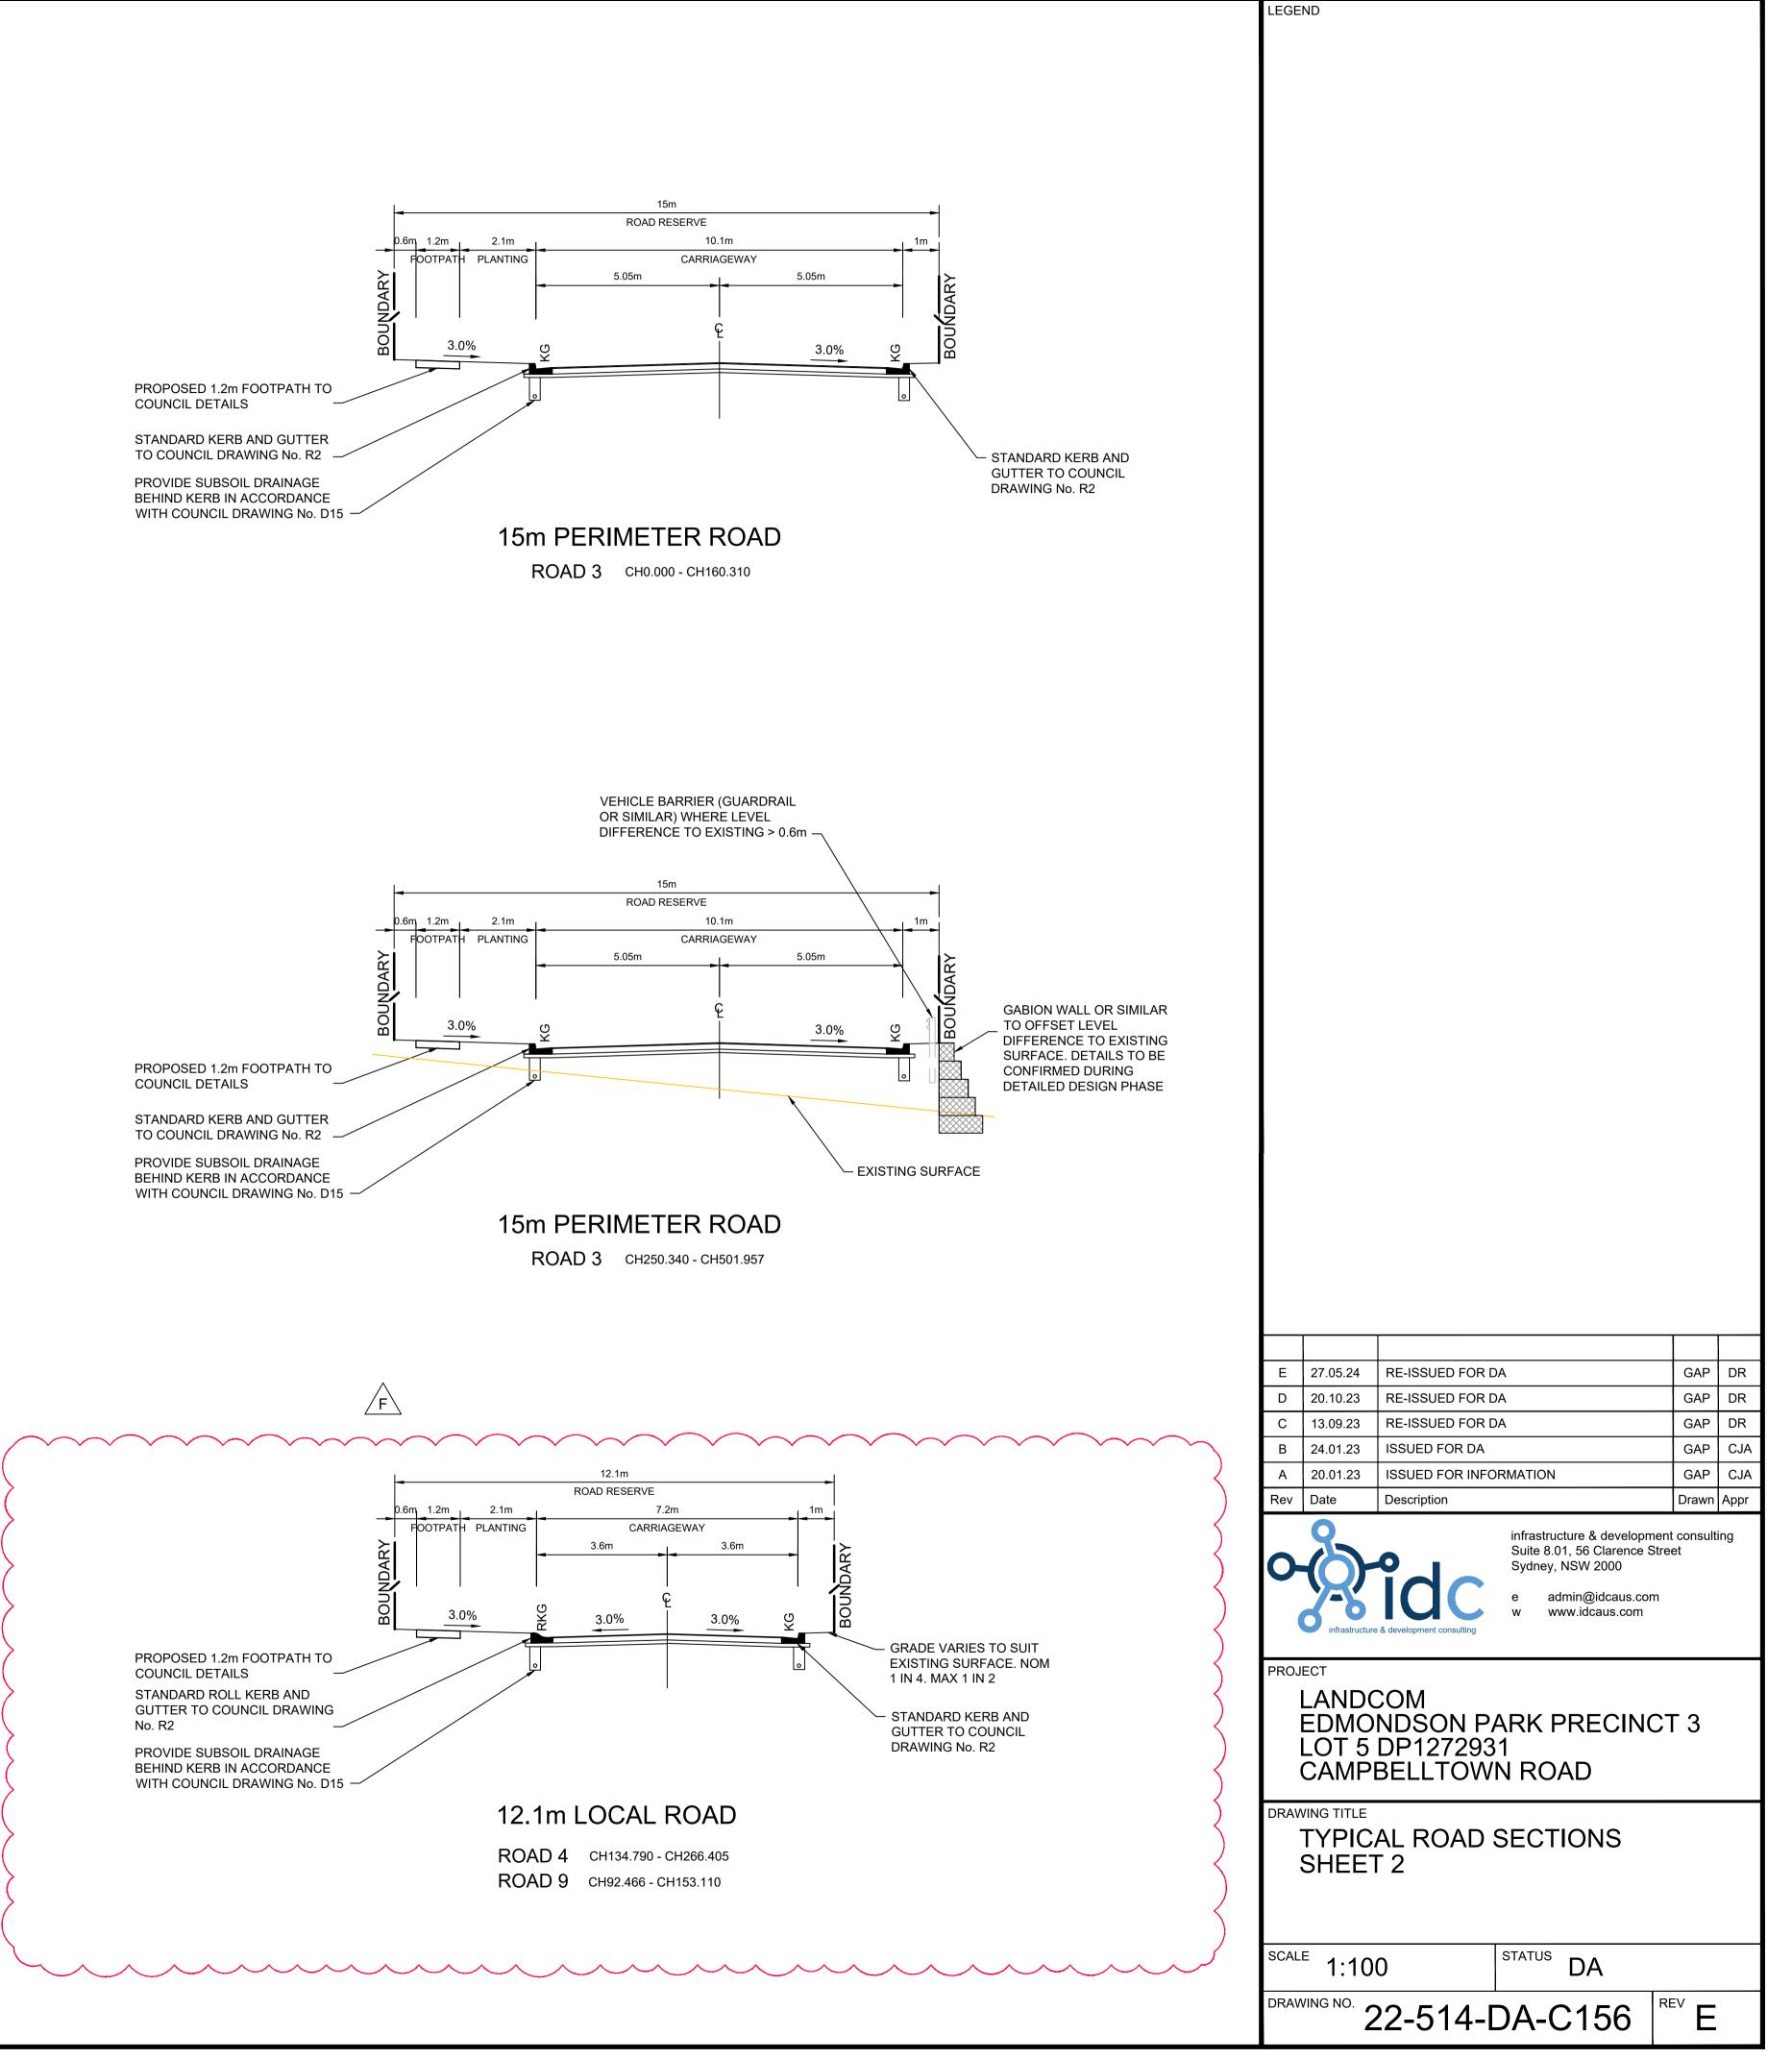

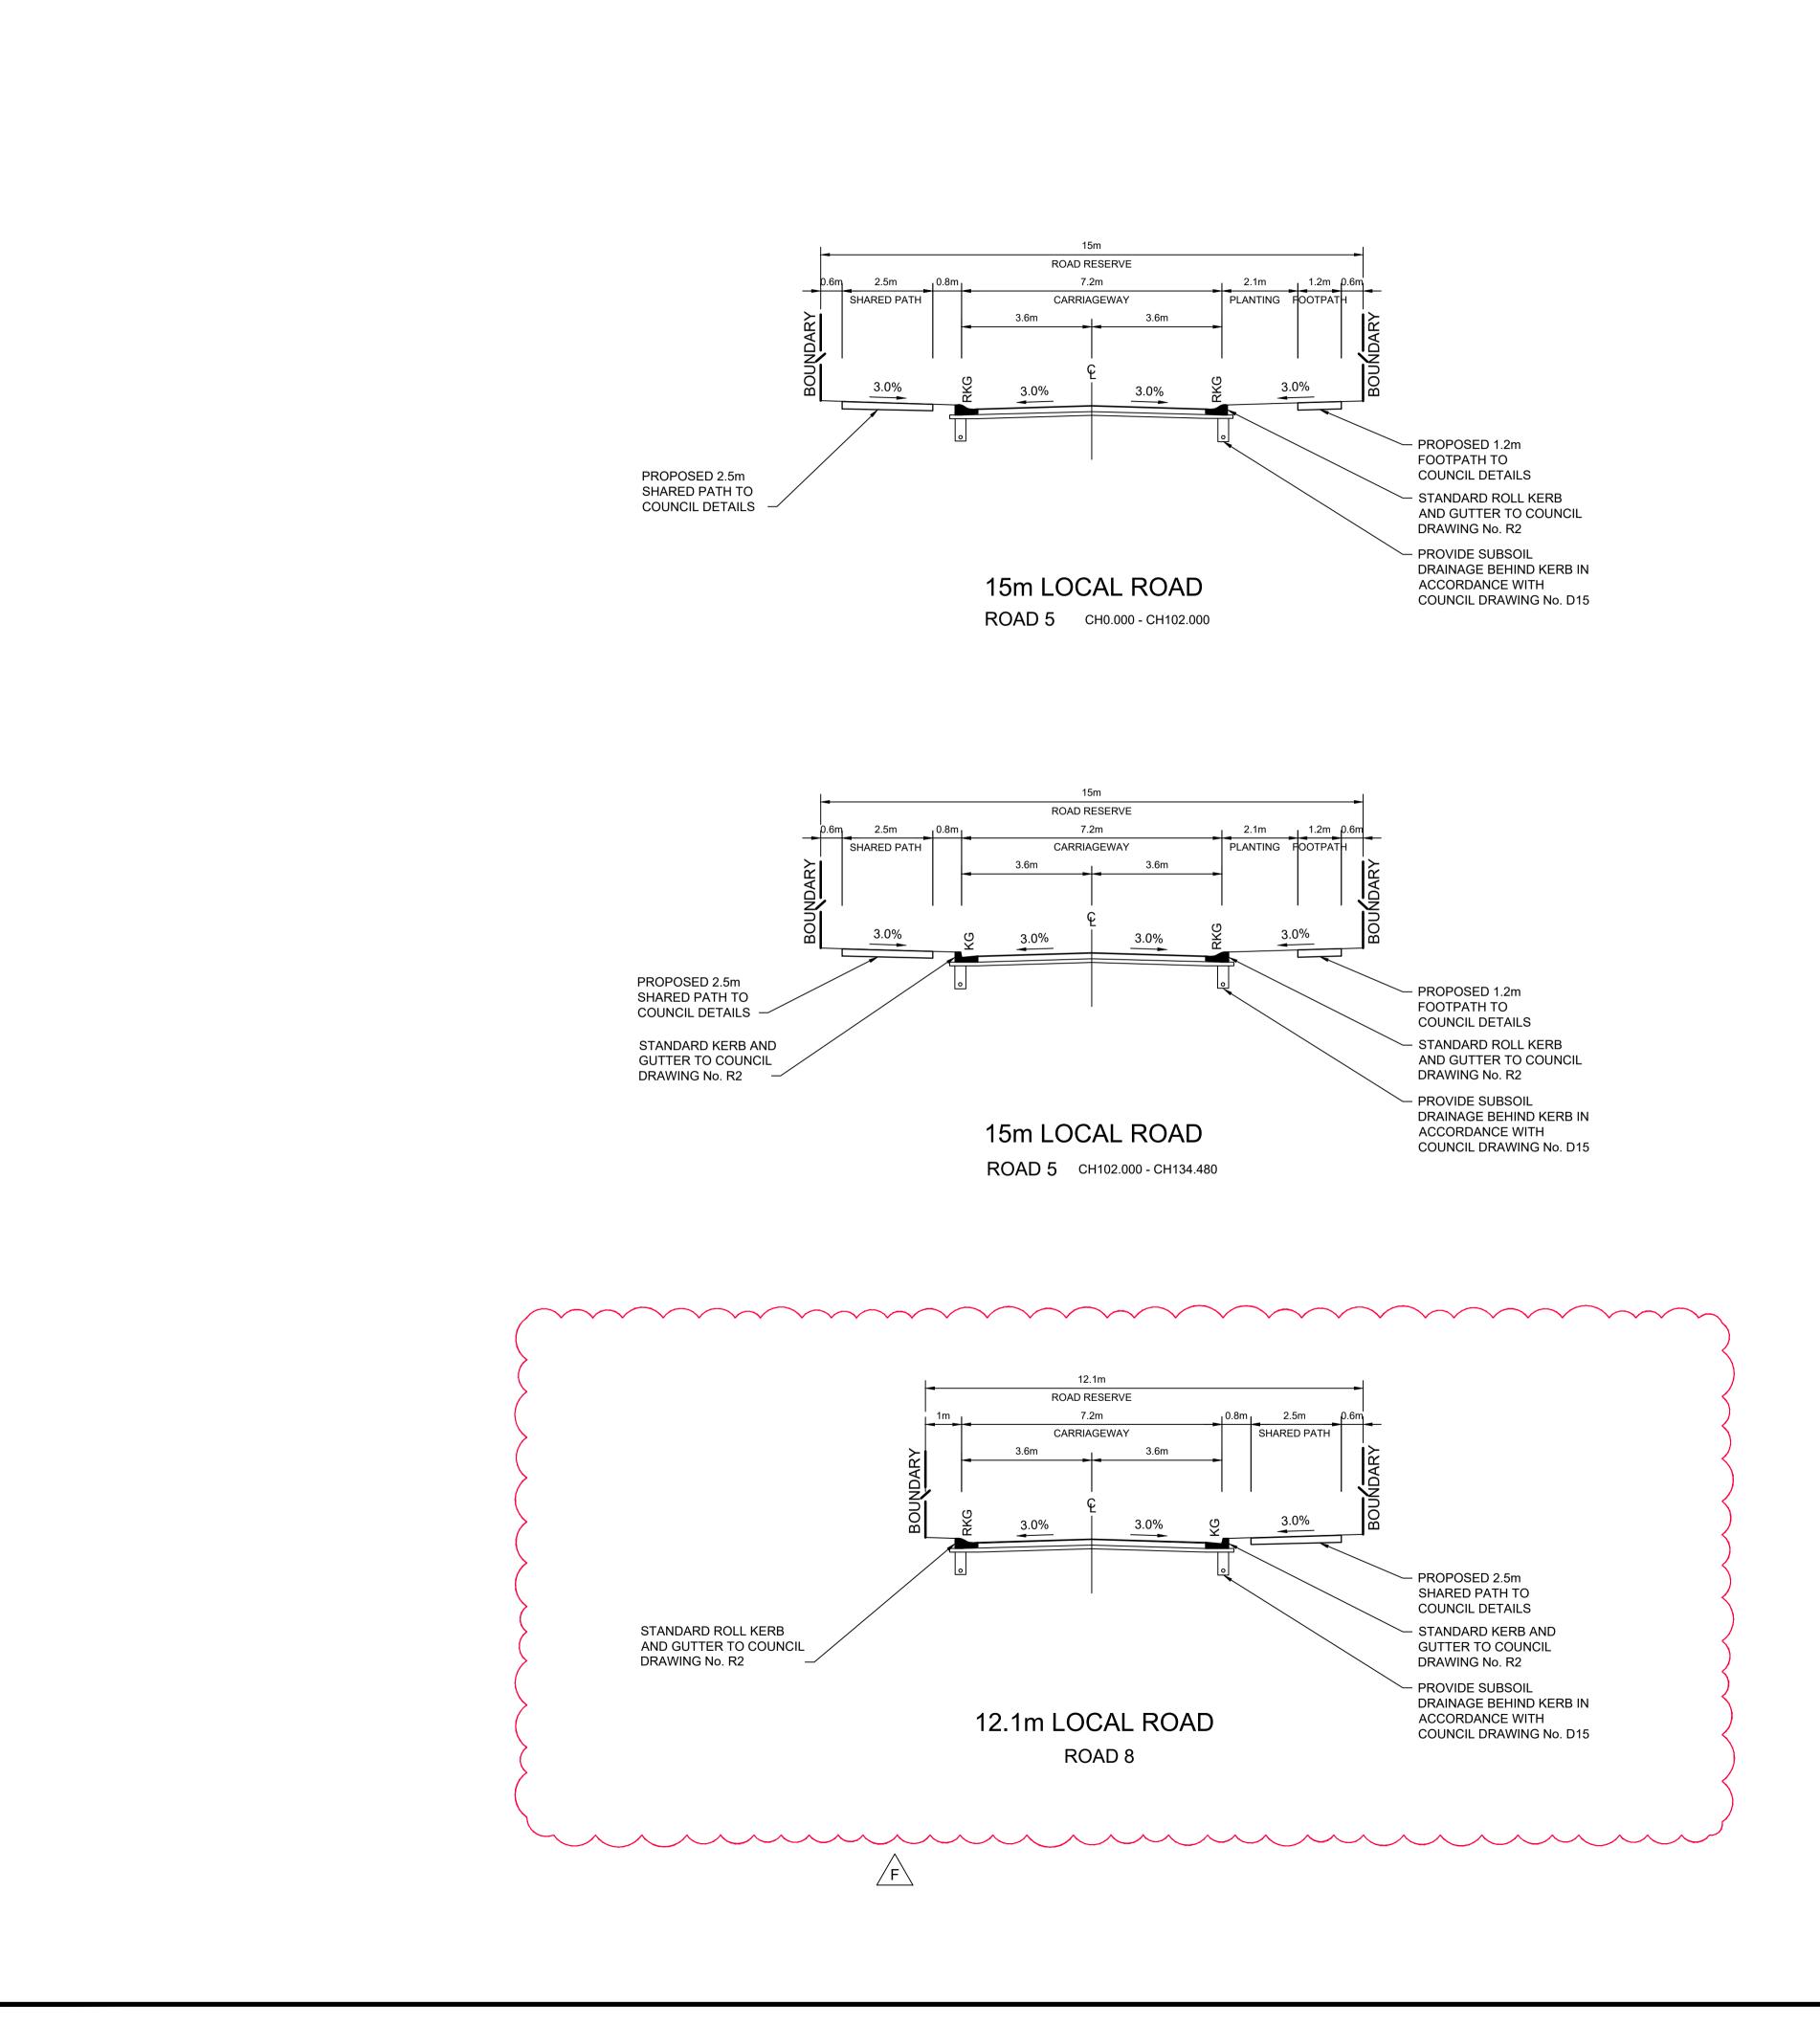

1	LEGE	ND			
	В	20.10.23		-	
			RE-ISSUED FOR DA	GAP	DR
	A Rev	13.09.23	RE-ISSUED FOR DA	GAP	DR
	A Rev		RE-ISSUED FOR DA Description	GAP Drawn	DR Appr
		13.09.23	RE-ISSUED FOR DA Description infrastructure & development Suite 8.01, 56 Clarence Stree	GAP Drawn consulti	DR Appr
		13.09.23	RE-ISSUED FOR DA Description infrastructure & development Suite 8.01, 56 Clarence Stree Sydney, NSW 2000 e admin@idcaus.com	GAP Drawn consulti	DR Appr
		13.09.23 Date	RE-ISSUED FOR DA Description infrastructure & development Suite 8.01, 56 Clarence Stree Sydney, NSW 2000	GAP Drawn consulti	DR Appr
		13.09.23 Date	RE-ISSUED FOR DA Description infrastructure & development Suite 8.01, 56 Clarence Stree Sydney, NSW 2000 e admin@idcaus.com w www.idcaus.com	GAP Drawn consulti	DR Appr
	Rev O-	13.09.23 Date	RE-ISSUED FOR DA Description infrastructure & development Suite 8.01, 56 Clarence Stree Sydney, NSW 2000 e admin@idcaus.com www.idcaus.com	GAP Drawn consulti	DR Appr
	Rev O-	13.09.23 Date	RE-ISSUED FOR DA Description infrastructure & development Suite 8.01, 56 Clarence Stree Sydney, NSW 2000 e admin@idcaus.com w www.idcaus.com COM NDSON PARK PRECINCT DP1272931	GAP Drawn consulti	DR Appr
	Rev O-	13.09.23 Date	RE-ISSUED FOR DA Description infrastructure & development Suite 8.01, 56 Clarence Stree Sydney, NSW 2000 e admin@idcaus.com www.idcaus.com COM COM COM PARK PRECINCI	GAP Drawn consulti	DR Appr
	Rev PROJ	13.09.23 Date	RE-ISSUED FOR DA Description infrastructure & development Suite 8.01, 56 Clarence Stree Sydney, NSW 2000 e admin@idcaus.com www.idcaus.com	GAP Drawn consulti	DR Appr
	Rev PROJ DRAW	13.09.23 Date	RE-ISSUED FOR DA Description infrastructure & development Suite 8.01, 56 Clarence Stree Sydney, NSW 2000 e admin@idcaus.com w www.idcaus.com COM NDSON PARK PRECINCT DP1272931 BELLTOWN ROAD AL ROAD SECTIONS	GAP Drawn consulti	DR Appr
	Rev PROJ DRAW	13.09.23 Date	RE-ISSUED FOR DA Description infrastructure & development Suite 8.01, 56 Clarence Stree Sydney, NSW 2000 e admin@idcaus.com www.idcaus.com WWW.idcaus.com COM NDSON PARK PRECINCI DP1272931 BELLTOWN ROAD AL ROAD SECTIONS T3	GAP Drawn consulti	DR Appr
	Rev PROJ DRAW	13.09.23 Date	RE-ISSUED FOR DA Description infrastructure & development Suite 8.01, 56 Clarence Stree Sydney, NSW 2000 e admin@idcaus.com www.idcaus.com WWW.idcaus.com COM NDSON PARK PRECINCI DP1272931 BELLTOWN ROAD AL ROAD SECTIONS T3	GAP Drawn consulti	DR Appr ng


LONGITUDINAL SECTION - ROAD 1 (CONTINUED)

			INTERSECTION ROAD 3 & ROAD 4	CH 211.244 RL67.992								CH 2/6.359 KL/U.805
HORIZONTAL CURVE VERTICAL CURVE		R4	5.06m	3		A M0=0.134	R100.00) 				
GRADE		-	1.24%		•	-						
DATUM 60.000												
DESIGN LEVEL	67.825	67.879	67.992	68.199	68.217	68.407	68.787	68.912	69.056	70.018	70.805	
EXISTING LEVEL	67.087	67.191	67.259	67.128	67.112	67.074	67.566	67.712	67.881	69 .093	70.075	
CHAINAGE	200.000	204.408	211.244	219.408	220.000	225.523	234.408	237.002	240.000	260.000	276.359	
1:500 HOR - 1:100 VER			<u> </u>		•	. <u> </u>		•				

LONGITUDINAL SECTION - ROAD 1

FOR CONTINUATION

REFER ABOVE

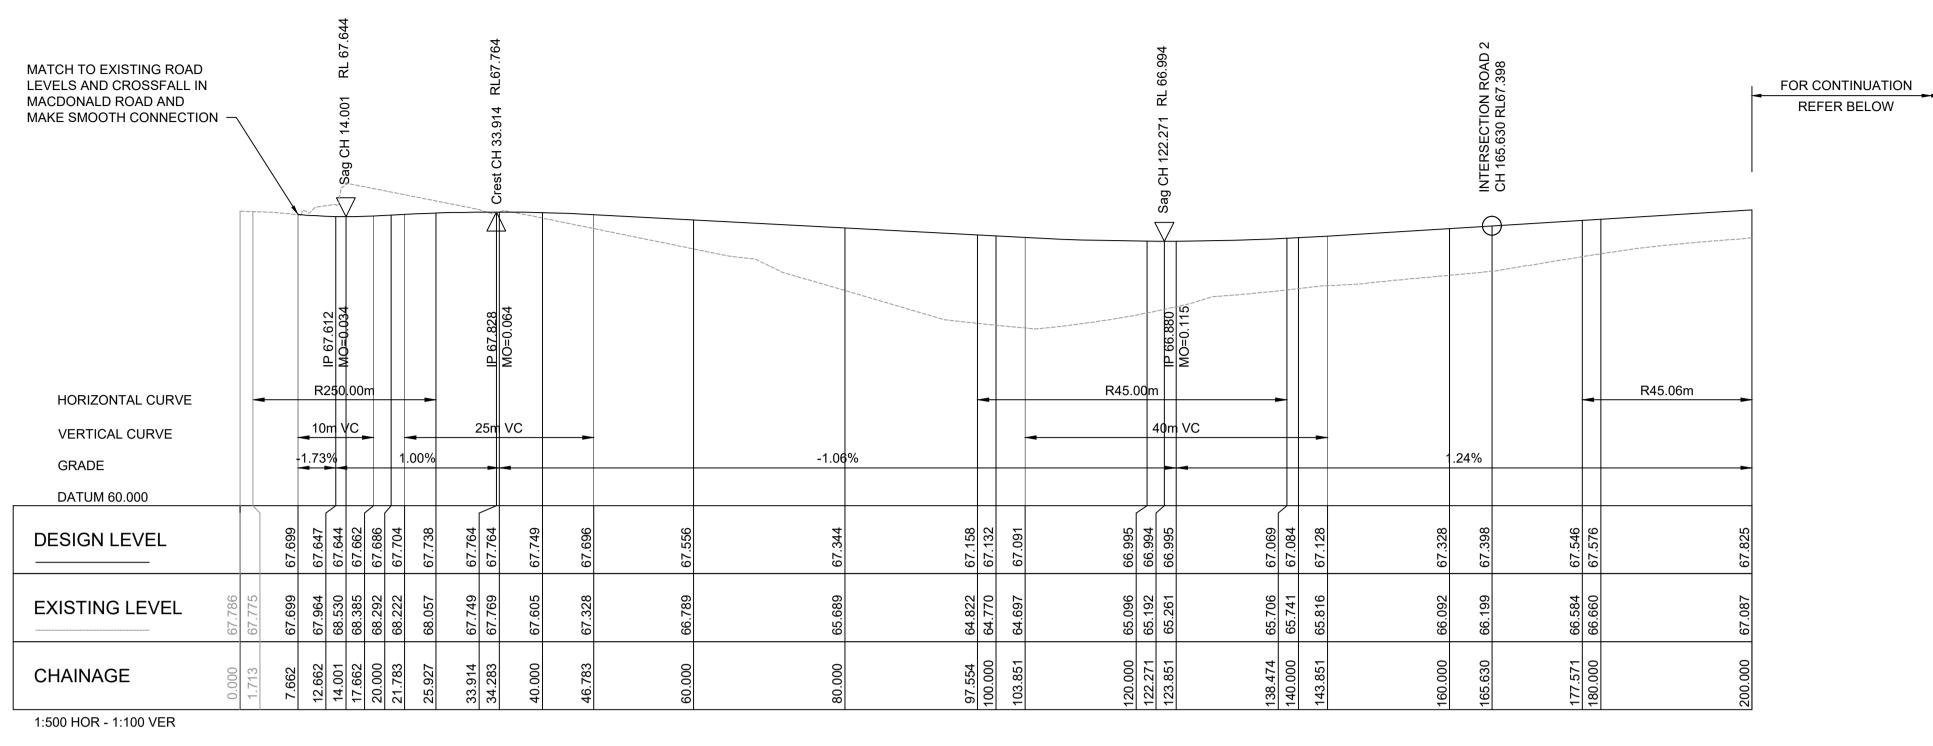

2


 $\sim\sim\sim\sim$

 \sim

 \sim

 $\sim\sim\sim\sim$



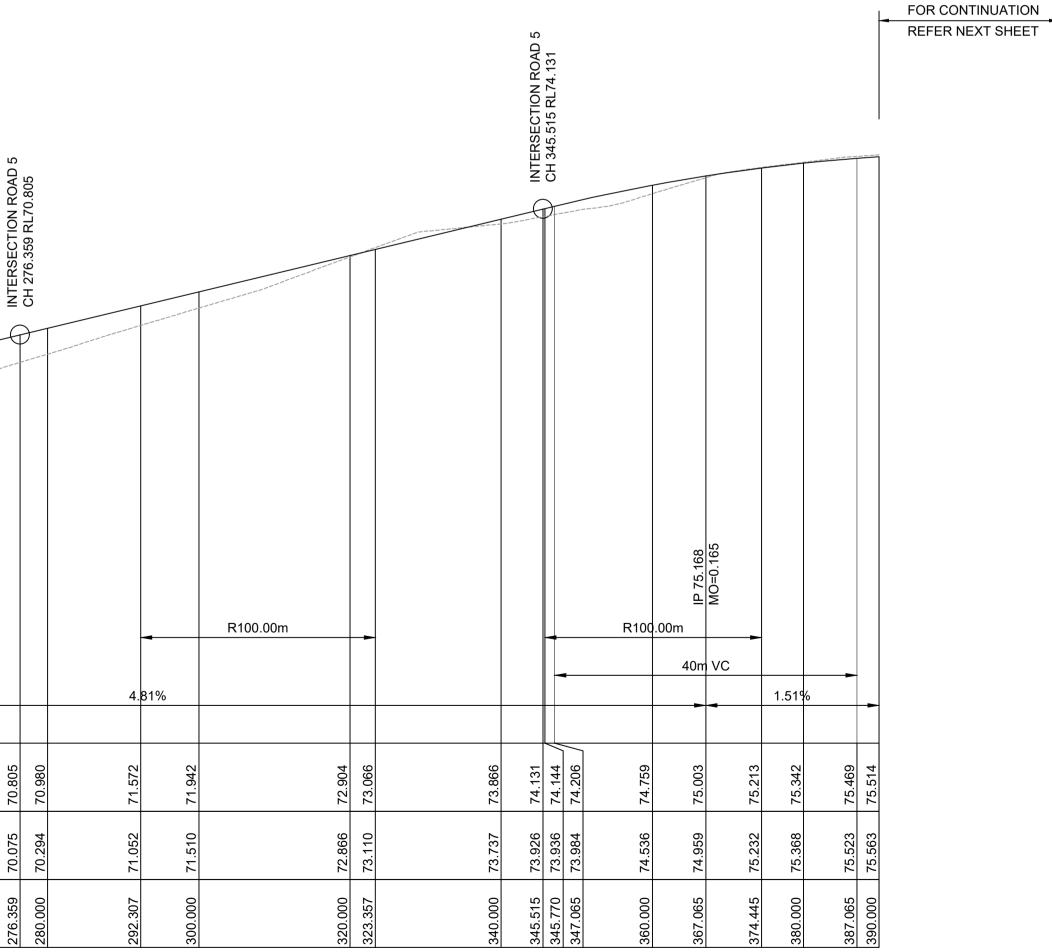

$\left.\right\rangle$		
$\left\{ \right\}$		
$\left\langle \right\rangle$		
$\left\{ \right\}$		
$\left\{ \right\}$		AP DR
\langle		AP DR
<		AP CJA
	A 20.01.23 ISSUED FOR INFORMATION G	AP CJA
	Rev Date Description Dr	awn Appr
$\langle \rangle$	infrastructure & development consulting infrastructure & development consulting infrastructure & development consulting	nsulting
	PROJECT LANDCOM EDMONDSON PARK PRECINCT (LOT 5 DP1272931 CAMPBELLTOWN ROAD	3
	DRAWING TITLE ROAD LONGITUDINAL SECTIONS SHEET 1	S
5	SCALE 1:500,100 STATUS DA	
	DRAWING NO. 22-514-DA-C160 REV	E


LEGEND

E

 $\sim\!\!\sim\!\!\sim\!\!\sim\!\!\sim$

 \searrow

	HORIZONTAL CU	URVE		-	R100.00)m					-		고 IP 76.565	00.0
	VERTICAL CUR	VE								-			40m	vc
	GRADE		-			1.5	1%							-
	DATUM 60.000								+	~				
	DESIGN LEVE	L	75.514 75.551	75.653 75.664		75.966	76 110		76.264 76.267	76.312	76.390		76.440 76.441	76 445
		/EL	75.563 75.551	75.609 75.634		76.032	76 105		75.977 75.978	75.990	76.027		76.064 76.064	76.072
	CHAINAGE		390.000 392.472	399.275 400.000		420.000	429,572		439.803 440.000	443.291	450.538		459.803 460.000	463.847
~~~~~	1:500 Hor - 1	:100 V					~			$\overline{}$		$\overline{}$		
	LONGITI	JDIN	IAL S	ECTI	ON ALON	NG AL	_IG	NM	IEN	Γ-	RO	٩D	1	
	TION ROAD 1 L 67.398	342 RL 67.061												
	INTERSECTION ROAD 1 CH 0.000 RL 67.398 IP 67.005 MO=0.075	SAG CH 16.842							IP 67.637	MO=0.146				
	$\varphi$	SAG CH 16.842							IP 67.637	MO=0.146				
HORIZONTAL CURVE	IP 67.005	MU=UU/5 SAG CH 16.842			 R - 50m									
VERTICAL CURVE	500-C9 4 15m	MU=UU/5 SAG CH 16.842								<u>3</u> MO=0.146				
VERTICAL CURVE GRADE	IP 67.005	MU=UU/5 SAG CH 16.842			R - 50m									
VERTICAL CURVE	-3.00%	MU=U.U/5 SAG CH 16.842			1.00%	7.476	7.511	7.541	25	im		3.348	3.696	
VERTICAL CURVE GRADE DATUM 60.000 DESIGN LEVEL	67.398 67.080 67.080 67.080 67.080 67.080 67.080 67.080 67.005 67.005 67.005	67.075 AG CH 16.842 67.080 SAG CH 16.842			1.00%	67		24 67.541	25	67.932 A B		68 68.348	84 68.696	
VERTICAL CURVE GRADE DATUM 60.000	-3.00%	67.061 a MU=U.0/5 SAG CH 16.842 67.080 a MU=U.0/5			1.00%	67.265 67.476		67.224 67.541	25	67.932 A B		67.368 68.348	67.684 68.696	

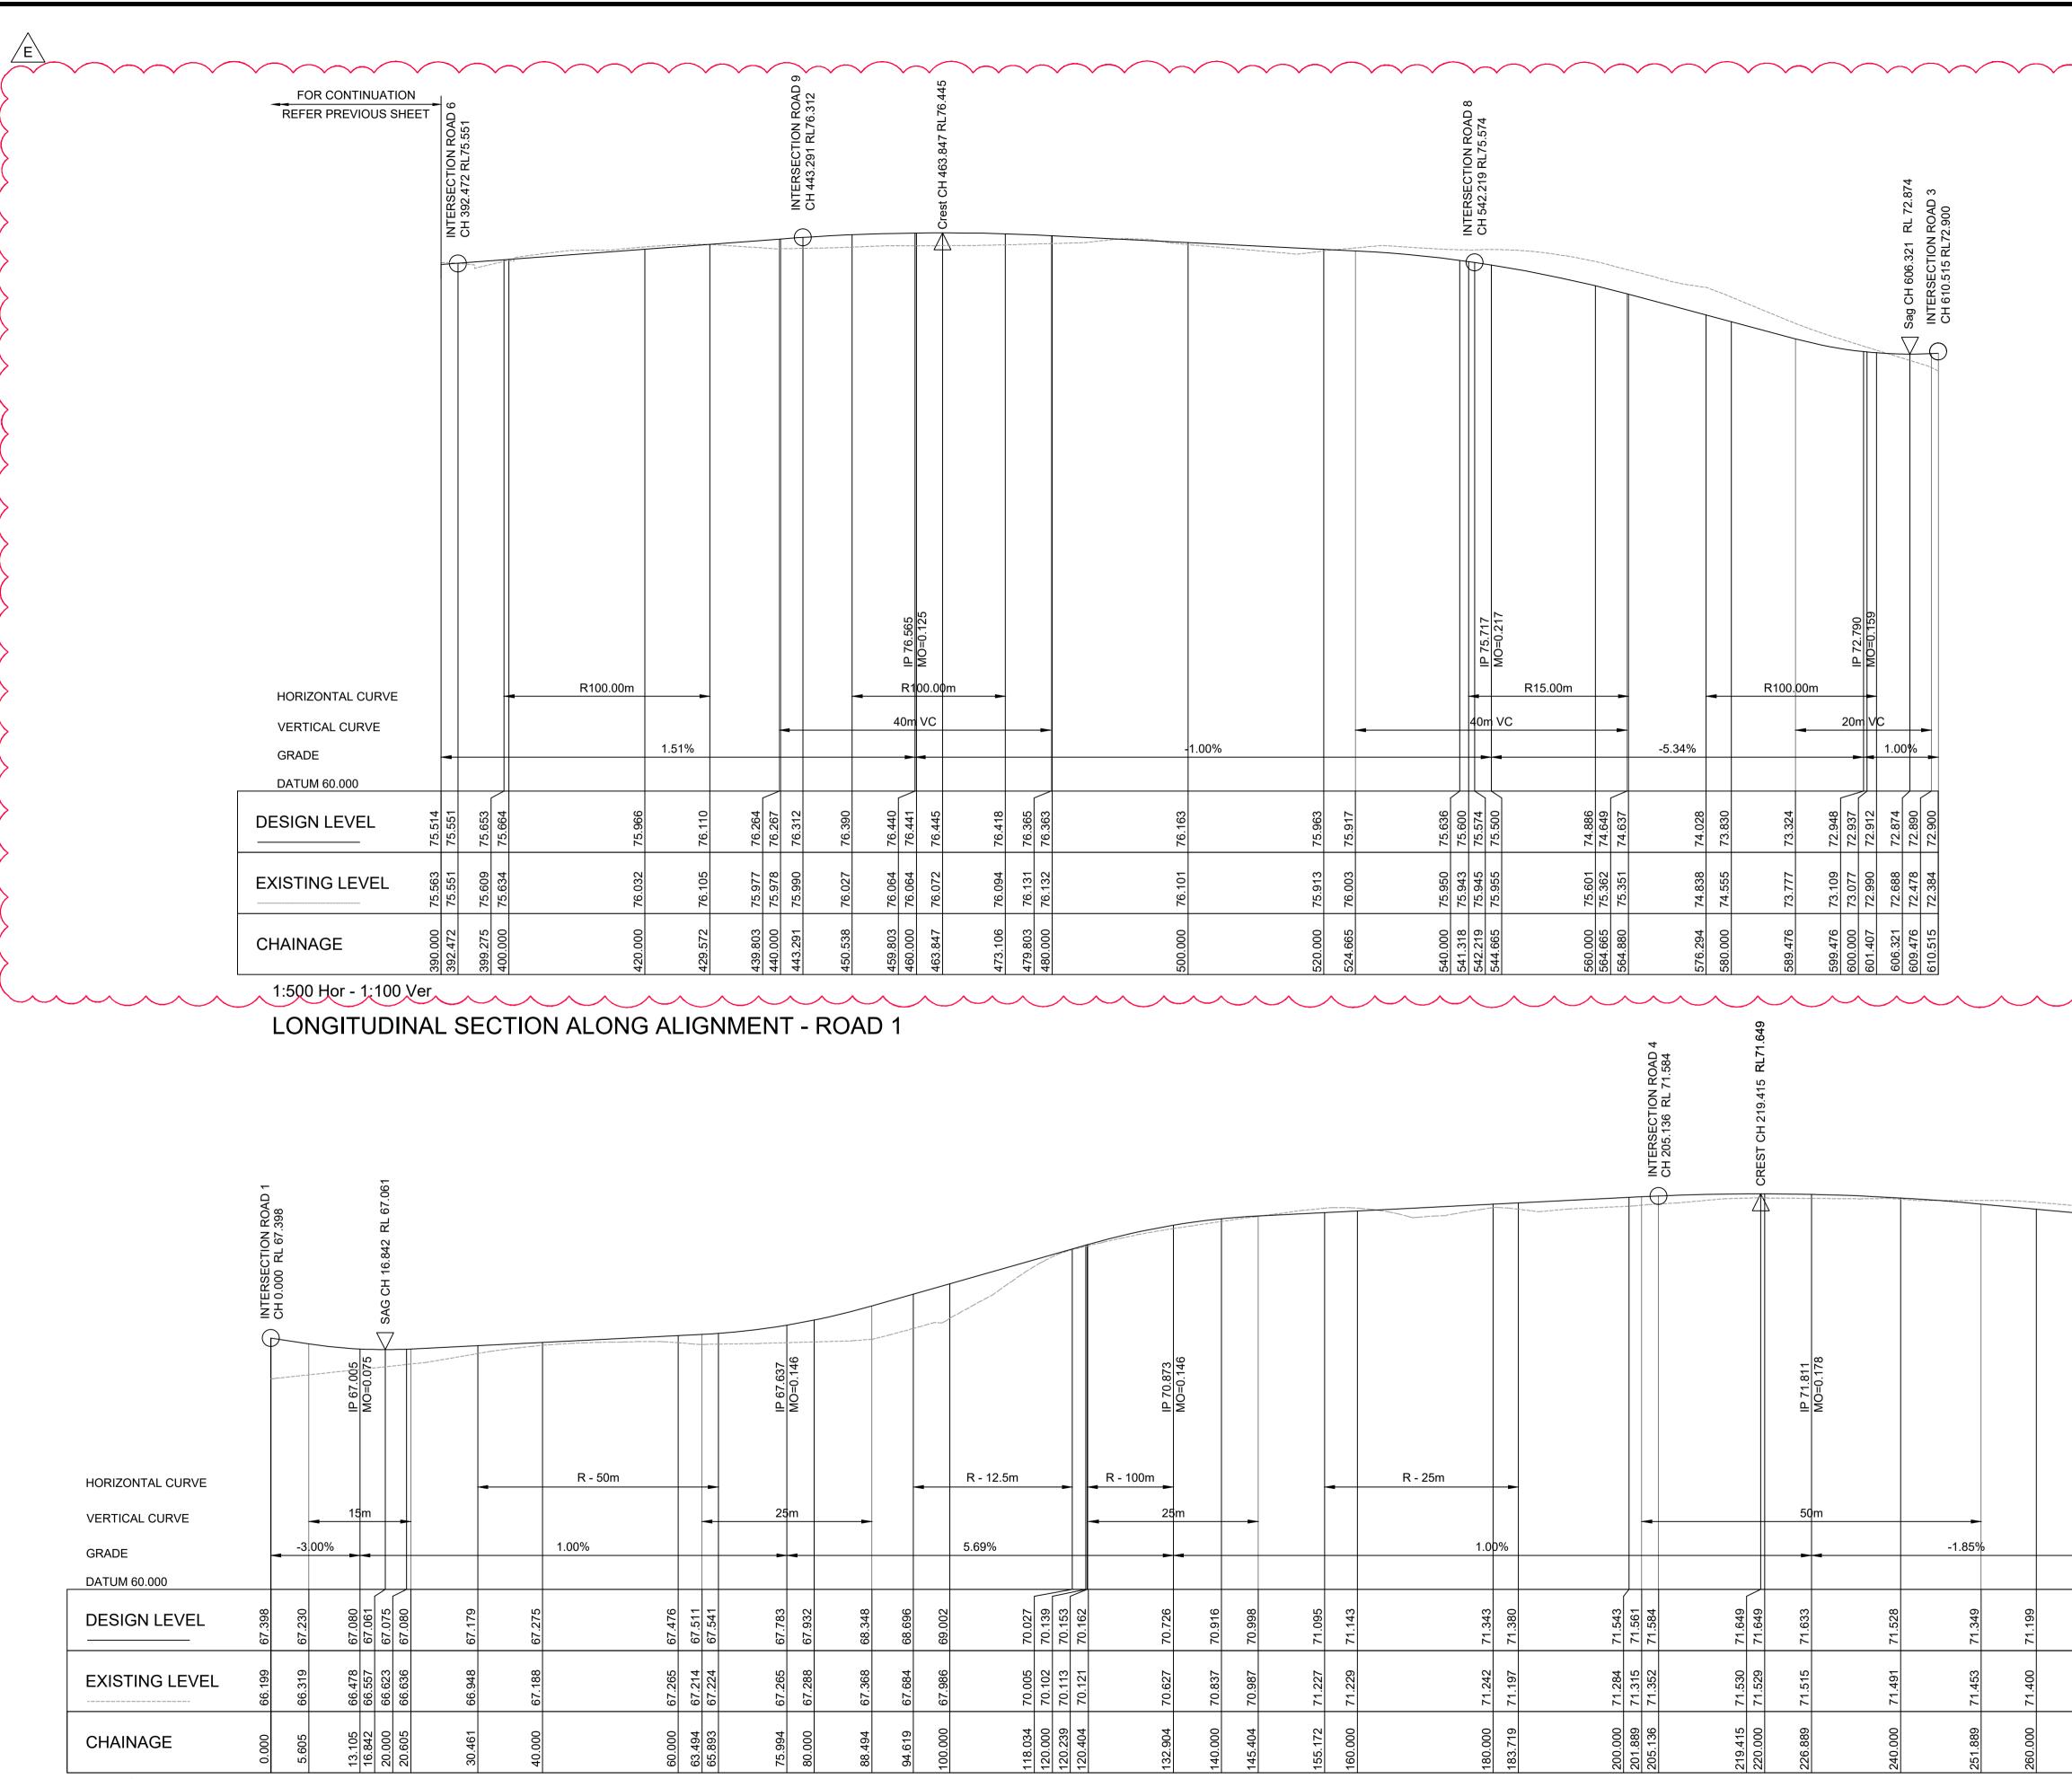

	LEGEND	
$\sum_{i=1}^{n}$		
2		
$\langle \rangle$		
$\langle$		
5		
$\sum$		
$\leq$		
5		
$\langle \rangle$		
$\langle$		
5		
$\langle \rangle$		
$\langle$		
$\leq$		
$\leq$		
$\langle \rangle$		
$\langle$		
$\langle \rangle$		
71.024 ND 4 78		
SAG CH 271.348 RL 71.02 INTERSECTION ROAD 4 CH 279.564 RL 71.178		
H 271.3 SECTIC		
SAG CH INTERS CH 279		
		, , <b>,</b> , , , , , , , , , , , , , , , ,
	E 27.05.24 RE-ISSUED FOR DA	GAP DR
	D20.10.23RE-ISSUED FOR DAC13.09.23RE-ISSUED FOR DA	GAP DR GAP DR
.067	B 24.01.23 ISSUED FOR DA	GAP CJA
<del>IP 70.967</del> MO=0.061	A     20.01.23     ISSUED FOR INFORMATION       Rev     Date     Description	GAP CJA Drawn Appr
	infrastructure & developmen Suite 8.01, 56 Clarence Stre	t consulting
	Sydney, NSW 2000	
<u>10m</u>	e admin@idcaus.com www.idcaus.com	
3.00%	PROJECT	
	LANDCOM	
71.059 71.024 71.177 71.178 71.178	EDMONDSON PARK PRECINC LOT 5 DP1272931	ГЗ
	CAMPBELLTOWN ROAD	
71.272 71.209 71.192 71.118 71.088		
267.534 271.348 272.534 277.534 279.564	ROAD LONGITUDINAL SECTIO SHEET 2	CVI
	SCALE A FOO 400 STATUS DA	
	1:500,100 DA	
	^{DRAWING NO.} 22-514-DA-C161	E


# LONGITUDINAL SECTION - ROAD 3 (CONTINUED)


						3 SAG CH 320 767 RL 68.886				
							IP 68.725	MO=0.253		
HORIZONTAL CURVE										R - 14.05m
VERTICAL CURVE					-		40	m		
GRADE			-1	.00%				-		
DATUM 60.000										
DESIGN LEVEL	69.354	69.254	69.054	68.925	68.886	68.886	68.978	69.066	69.120	69.537
EXISTING LEVEL	68.392	68.425	68.797	68.840	68.879	68.883	68.293	67.539	67.402	67.616
CHAINAGE	270.000	280.000	300.000	312.858	320.000	320.767	332.858	337.666	340.000	352.858
1:500 HOR - 1:100 VER					-			-		

# LONGITUDINAL SECTION - ROAD 3


FOR CONTINUATION

	INTERSECTION ROAD 1 & ROAD 4	CH 0.000 RL 67.992							SAG CH 35.041 RL 67.593											
HORIZONTAL CURVE	ţ.		IP 67.832		- 50m				IP 67.525	MO=0.068			R	14.05m			IP 68.030			
VERTICAL CURVE			<b>6</b>					4	25	m	-				-		25n	n 🗖		
GRADE DATUM 60.000		3.00	0%	╺┼┤		-1	.00%		-	•			1.17%					•		
DESIGN LEVEL	67.992	67.922	67.847	67.812 67 802	67.744	67.686	67.650	67.593	67.593	67.603	67.672	67.708	67.806	67.883	67.974	68.085	68.106	68.397	68.647	
EXISTING LEVEL	67.259	67.192	67.101	67.014 66.078	66.733	66.696	66.779	67.045	67.069	67.161	67.159	67.146	67.249	67.509	67.769	68.022	68.061	68.485	68.683	
CHAINAGE	0.000	2.319	5.319	7.453	14.175	20.000	23.543	35.041	36.043	40.000	48.543	51.604	60.000	66.512	72.988	79.012	80.000	91.512	100.000	
1:500 HOR - 1:100 VER		1	1				I		. 1						·		. 1			

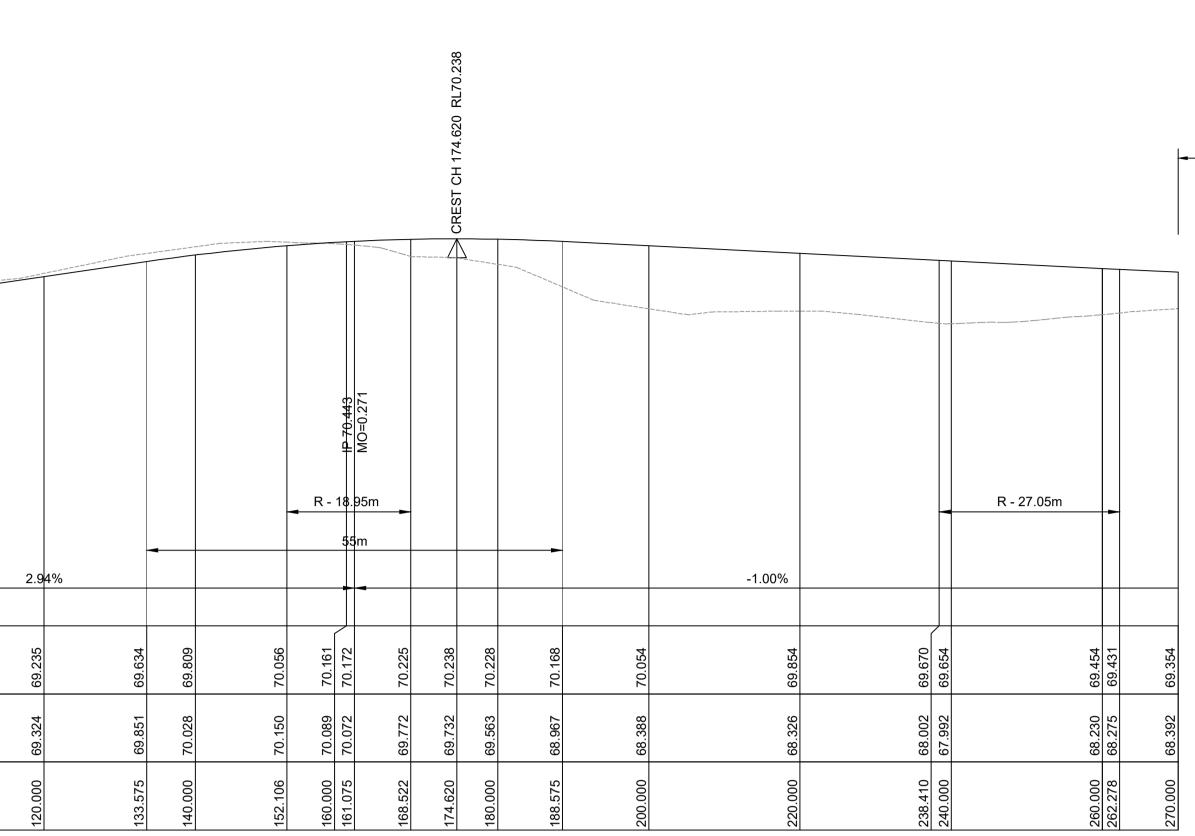

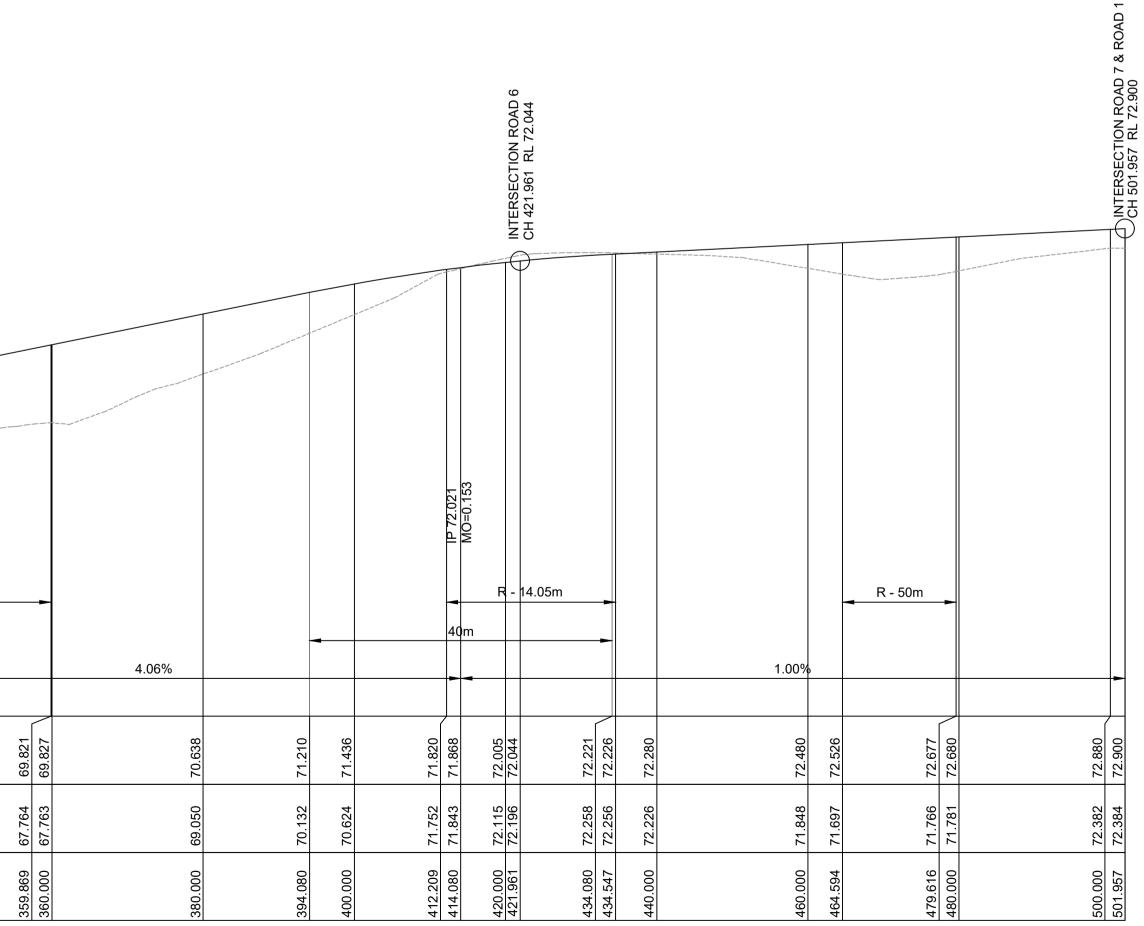


LEGEND		
REFER BELOW		
E 27.05.24 RE-ISSUED FOR DA	GAP	DR
D 20.10.23 RE-ISSUED FOR DA	GAP	DR
D20.10.23RE-ISSUED FOR DAC13.09.23RE-ISSUED FOR DA	GAP GAP	DR DR
D20.10.23RE-ISSUED FOR DAC13.09.23RE-ISSUED FOR DAB24.01.23ISSUED FOR DA	GAP GAP GAP	DR DR CJA
D20.10.23RE-ISSUED FOR DAC13.09.23RE-ISSUED FOR DAB24.01.23ISSUED FOR DA	GAP GAP	DR DR CJA CJA
D20.10.23RE-ISSUED FOR DAC13.09.23RE-ISSUED FOR DAB24.01.23ISSUED FOR DAA20.01.23ISSUED FOR INFORMATIONRevDateDescription	GAP GAP GAP GAP Drawn	DR DR CJA CJA Appr
D20.10.23RE-ISSUED FOR DAC13.09.23RE-ISSUED FOR DAB24.01.23ISSUED FOR DAA20.01.23ISSUED FOR INFORMATIONRevDateDescriptioninfrastructure & development Suite 8.01, 56 Clarence Street Sydney, NSW 2000	GAP GAP GAP GAP Drawn	DR DR CJA CJA Appr
D20.10.23RE-ISSUED FOR DAC13.09.23RE-ISSUED FOR DAB24.01.23ISSUED FOR DAA20.01.23ISSUED FOR INFORMATIONRevDateDescriptioninfrastructure & development Suite 8.01, 56 Clarence Street Sydney, NSW 2000eadmin@idcaus.com	GAP GAP GAP GAP Drawn	DR DR CJA CJA Appr
D20.10.23RE-ISSUED FOR DAC13.09.23RE-ISSUED FOR DAB24.01.23ISSUED FOR DAA20.01.23ISSUED FOR INFORMATIONRevDateDescriptioninfrastructure & development Suite 8.01, 56 Clarence Street Sydney, NSW 2000	GAP GAP GAP GAP Drawn	DR DR CJA CJA Appr
D       20.10.23       RE-ISSUED FOR DA         C       13.09.23       RE-ISSUED FOR DA         B       24.01.23       ISSUED FOR DA         A       20.01.23       ISSUED FOR INFORMATION         Rev       Date       Description         infrastructure & development Suite 8.01, 56 Clarence Street Sydney, NSW 2000         e       admin@idcaus.com         w       www.idcaus.com	GAP GAP GAP GAP Drawn	DR DR CJA CJA Appr
D       20.10.23       RE-ISSUED FOR DA         C       13.09.23       RE-ISSUED FOR DA         B       24.01.23       ISSUED FOR DA         A       20.01.23       ISSUED FOR INFORMATION         Rev       Date       Description         infrastructure & development Suite 8.01, 56 Clarence Street Sydney, NSW 2000         e       admin@idcaus.com         W       Vertex         PROJECT       PROJECT	GAP GAP GAP GAP Drawn	DR DR CJA CJA Appr
D       20.10.23       RE-ISSUED FOR DA         C       13.09.23       RE-ISSUED FOR DA         B       24.01.23       ISSUED FOR INFORMATION         Rev       Date       Description         infrastructure & development Suite 8.01, 56 Clarence Street Sydney, NSW 2000         e       admin@idcaus.com www.idcaus.com         PROJECT       LANDCOM EDMONDSON PARK PRECINCT	GAP GAP GAP Drawn consult et	DR DR CJA CJA Appr
D       20.10.23       RE-ISSUED FOR DA         C       13.09.23       RE-ISSUED FOR DA         B       24.01.23       ISSUED FOR DA         A       20.01.23       ISSUED FOR INFORMATION         Rev       Date       Description         infrastructure & development Suite 8.01, 56 Clarence Street Sydney, NSW 2000         e       admin@idcaus.com         W       Www.idcaus.com         PROJECT         LANDCOM EDMONDSON PARK PRECINCT LOT 5 DP1272931	GAP GAP GAP Drawn consult et	DR DR CJA CJA Appr
D       20.10.23       RE-ISSUED FOR DA         C       13.09.23       RE-ISSUED FOR DA         B       24.01.23       ISSUED FOR INFORMATION         Rev       Date       Description         infrastructure & development Suite 8.01, 56 Clarence Street Sydney, NSW 2000         e       admin@idcaus.com www.idcaus.com         PROJECT       LANDCOM EDMONDSON PARK PRECINCT	GAP GAP GAP Drawn consult et	DR DR CJA CJA Appr
D       20.10.23       RE-ISSUED FOR DA         C       13.09.23       RE-ISSUED FOR DA         B       24.01.23       ISSUED FOR INFORMATION         Rev       Date       Description         Infrastructure & development Suite 8.01, 56 Clarence Stree Sydney, NSW 2000         e         Admin@idcaus.com         W       PROJECT         LANDCOM         EDMONDSON PARK PRECINCT         LOT 5 DP1272931         CAMPBELLTOWN ROAD	GAP GAP GAP Drawn t consult et	DR DR CJA CJA Appr
D       20.10.23       RE-ISSUED FOR DA         C       13.09.23       RE-ISSUED FOR DA         B       24.01.23       ISSUED FOR INFORMATION         Rev       Date       Description         Infrastructure & development Suite 8.01, 56 Clarence Stree Sydney, NSW 2000         e       admin@idcaus.com www.idcaus.com         PROJECT       LANDCOM EDMONDSON PARK PRECINCT LOT 5 DP1272931 CAMPBELLTOWN ROAD         DRAWING TITLE       ROAD LONGITUDINAL SECTIOI	GAP GAP GAP Drawn t consult et	DR DR CJA CJA Appr
D       20.10.23       RE-ISSUED FOR DA         C       13.09.23       RE-ISSUED FOR DA         B       24.01.23       ISSUED FOR INFORMATION         Rev       Date       Description         Infrastructure & development Suite 8.01, 56 Clarence Stree Sydney, NSW 2000         e         Admin@idcaus.com         W       PROJECT         LANDCOM         EDMONDSON PARK PRECINCT         LOT 5 DP1272931         CAMPBELLTOWN ROAD	GAP GAP GAP Drawn t consult et	DR DR CJA CJA Appr
D       20.10.23       RE-ISSUED FOR DA         C       13.09.23       RE-ISSUED FOR DA         B       24.01.23       ISSUED FOR INFORMATION         Rev       Date       Description         Infrastructure & development Suite 8.01, 56 Clarence Stree Sydney, NSW 2000         e       admin@idcaus.com www.idcaus.com         PROJECT       LANDCOM EDMONDSON PARK PRECINCT LOT 5 DP1272931 CAMPBELLTOWN ROAD         DRAWING TITLE       ROAD LONGITUDINAL SECTIOI	GAP GAP GAP Drawn t consult et	DR DR CJA CJA Appr
D       20.10.23       RE-ISSUED FOR DA         C       13.09.23       RE-ISSUED FOR DA         B       24.01.23       ISSUED FOR INFORMATION         Rev       Date       Description         infrastructure & development Suite 8.01, 56 Clarence Stres Sydney, NSW 2000         e       admin@idcaus.com         WWW.idcaus.com       www.idcaus.com         PROJECT       LANDCOM EDMONDSON PARK PRECINCT LOT 5 DP1272931 CAMPBELLTOWN ROAD         DRAWING TITLE       ROAD LONGITUDINAL SECTION SHEET 3	GAP GAP GAP Drawn t consult et	DR DR CJA CJA Appr
D       20.10.23       RE-ISSUED FOR DA         C       13.09.23       RE-ISSUED FOR DA         B       24.01.23       ISSUED FOR INFORMATION         Rev       Date       Description         Infrastructure & development Suite 8.01, 56 Clarence Stree Sydney, NSW 2000         e       admin@idcaus.com www.idcaus.com         PROJECT       LANDCOM EDMONDSON PARK PRECINCT LOT 5 DP1272931 CAMPBELLTOWN ROAD         DRAWING TITLE       ROAD LONGITUDINAL SECTIOI	GAP GAP GAP Drawn t consult et	DR DR CJA CJA Appr
D       20.10.23       RE-ISSUED FOR DA         C       13.09.23       RE-ISSUED FOR DA         B       24.01.23       ISSUED FOR DA         A       20.01.23       ISSUED FOR INFORMATION         Rev       Date       Description         infrastructure & development Suite 8.01, 56 Clarence Stree Sydney, NSW 2000         e       admin@idcaus.com         vwww.idcaus.com       e         PROJECT         LANDCOM EDMONDSON PARK PRECINCT LOT 5 DP1272931 CAMPBELLTOWN ROAD         DRAWING TITLE         ROAD LONGITUDINAL SECTION SHEET 3	GAP GAP GAP Drawn t consult et	DR CJA CJA Appr ing

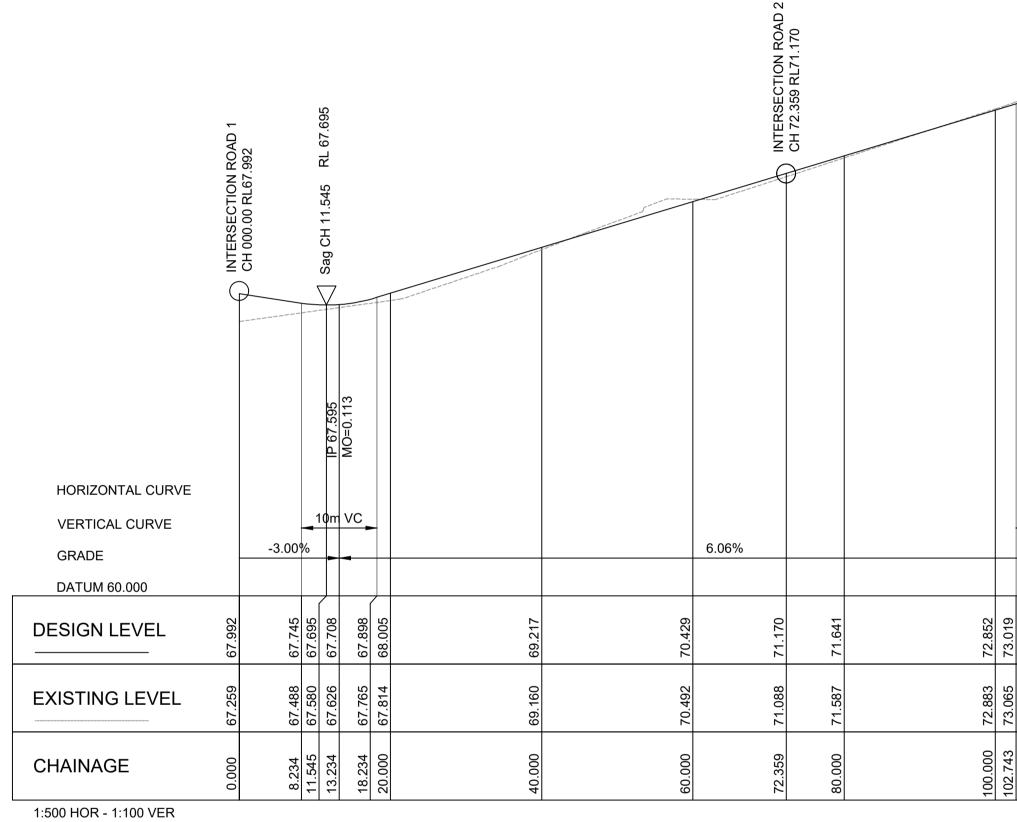


Longitudinal Section Along ALIGNMENT - ROAD 4

	610.0 00=0.010 25m VC		R12.00	Dm		ے 10.137 20س				-3.83%		R12.50m		IP 73.6	MO=0.154	-8.75%		10m		00%
73.019	73.757 74.028	74.328 74.457	74.775	75.087	75.250	75.557	75.575	75.304	75.179	74.799	74.548	74.079	74.046 73.722	73.447		72.264 72.264	71.632	71.341	71.306 71.345	71.428
73.065	73.803 74.004	74.236 74.348	74.624	74.786	74.872		74.709	74.684	74.720	74.758	74.552	74.277	74.253 73.910	73.698		73.066 72.920	72.490			71.704
102.743	115.243	125.379 127.743	133.566	140.000	144.209	158.566	160.000 162.916	180.000	183.566	193.456	200.000	212.229	213.091 220.000	224.729		237.229 240.000	247.225	252.225	254.671 257.225	260.000

	LEGE				
2					
0AD ; 596					
ON RI					
ECTIC 591 R					
INTERSECTION ROAD 2 CH 265.591 RL71.596					
CH CH					
90					
71.596					
71.367					
71.367					
71.367	E	27.05.24	RE-ISSUED FOR DA	GAP	DR
71.367	D	20.10.23	RE-ISSUED FOR DA	GAP	DR
71.367					
71.367	D C	20.10.23 13.09.23	RE-ISSUED FOR DA RE-ISSUED FOR DA	GAP GAP	DR DR
71.367	D C B	20.10.23 13.09.23 24.01.23	RE-ISSUED FOR DA RE-ISSUED FOR DA ISSUED FOR DA	GAP GAP GAP	DR DR CJA CJA
71.367	D C B A	20.10.23 13.09.23 24.01.23 20.01.23 Date	RE-ISSUED FOR DA         RE-ISSUED FOR DA         ISSUED FOR DA         ISSUED FOR INFORMATION         Description	GAP GAP GAP GAP Drawn	DR DR CJA CJA Appr
71.367	D C B A	20.10.23 13.09.23 24.01.23 20.01.23 Date	RE-ISSUED FOR DA RE-ISSUED FOR DA ISSUED FOR DA ISSUED FOR INFORMATION Description infrastructure & developmen Suite 8.01, 56 Clarence Stre Sydney, NSW 2000	GAP GAP GAP GAP Drawn	DR DR CJA CJA Appr
71.367	D C B A Rev	20.10.23 13.09.23 24.01.23 20.01.23 Date	RE-ISSUED FOR DA         RE-ISSUED FOR DA         ISSUED FOR DA         ISSUED FOR INFORMATION         Description	GAP GAP GAP GAP Drawn	DR DR CJA CJA Appr
71.367	D C B A	20.10.23 13.09.23 24.01.23 20.01.23 Date	RE-ISSUED FOR DA         RE-ISSUED FOR DA         ISSUED FOR DA         ISSUED FOR INFORMATION         Description         infrastructure & developmen         Suite 8.01, 56 Clarence Stres         Sydney, NSW 2000         e       admin@idcaus.com         w       www.idcaus.com	GAP GAP GAP GAP Drawn	DR DR CJA CJA Appr
71.367	D C B A Rev PROJ	20.10.23 13.09.23 24.01.23 20.01.23 Date	RE-ISSUED FOR DA         RE-ISSUED FOR DA         ISSUED FOR DA         ISSUED FOR INFORMATION         Description         infrastructure & developmen         Suite 8.01, 56 Clarence Stres         Sydney, NSW 2000         e       admin@idcaus.com         w       www.idcaus.com         COM	GAP GAP GAP Drawn t consulti	DR DR CJA CJA Appr
71.367	D C B A Rev PROJ	20.10.23 13.09.23 24.01.23 Date	RE-ISSUED FOR DA RE-ISSUED FOR DA ISSUED FOR DA ISSUED FOR INFORMATION Description infrastructure & developmen Suite 8.01, 56 Clarence Stre Sydney, NSW 2000 e admin@idcaus.com w www.idcaus.com W www.idcaus.com	GAP GAP GAP Drawn t consulti	DR DR CJA CJA Appr
71.367	D C B A Rev PROJ	20.10.23 13.09.23 24.01.23 Date	RE-ISSUED FOR DA         RE-ISSUED FOR DA         ISSUED FOR DA         ISSUED FOR INFORMATION         Description         infrastructure & developmen         Suite 8.01, 56 Clarence Stres         Sydney, NSW 2000         e       admin@idcaus.com         w       www.idcaus.com         COM         DSON PARK PRECINCT	GAP GAP GAP Drawn t consulti	DR DR CJA CJA Appr
71.367	D C B A Rev PROJ	20.10.23 13.09.23 24.01.23 Date	RE-ISSUED FOR DA RE-ISSUED FOR DA ISSUED FOR DA ISSUED FOR INFORMATION Description infrastructure & developmen Suite 8.01, 56 Clarence Stre Sydney, NSW 2000 e admin@idcaus.com w www.idcaus.com W www.idcaus.com	GAP GAP GAP Drawn t consulti	DR DR CJA CJA Appr
71.367	D C B A Rev PROJ	20.10.23 13.09.23 24.01.23 Date Date ECT LANDO EDMO LOT 5 CAMP	RE-ISSUED FOR DA RE-ISSUED FOR DA ISSUED FOR DA ISSUED FOR INFORMATION Description infrastructure & developmen Suite 8.01, 56 Clarence Stre Sydney, NSW 2000 e admin@idcaus.com w www.idcaus.com W www.idcaus.com	GAP GAP GAP Drawn t consulti	DR DR CJA CJA Appr
71.367	D C B A Rev PROJ	20.10.23 13.09.23 24.01.23 Date Date ECT LANDO EDMO LOT 5 CAMP	RE-ISSUED FOR DA RE-ISSUED FOR DA ISSUED FOR DA ISSUED FOR INFORMATION Description Description	GAP GAP GAP Drawn t consulti	DR DR CJA CJA Appr
71.367	D C B A Rev PROJ	20.10.23 13.09.23 24.01.23 Date Date ECT LANDO EDMO LOT 5 CAMP VING TITLE ROAD SHEE	RE-ISSUED FOR DA RE-ISSUED FOR DA ISSUED FOR INFORMATION Description Description	GAP GAP GAP Drawn t consulti	DR DR CJA CJA Appr
71.367	D C B A Rev PROJ	20.10.23 13.09.23 24.01.23 Date Date ECT LANDO EDMO LOT 5 CAMP VING TITLE ROAD SHEE SHEE	RE-ISSUED FOR DA         RE-ISSUED FOR DA         ISSUED FOR INFORMATION         Description         ISSUED FOR INFORMATION         ISSUE FOR INFORMATION	GAP GAP GAP Drawn t consulti eet	DR DR CJA CJA Appr
71.367	D C B A Rev PROJ	20.10.23 13.09.23 24.01.23 Date Date ECT LANDO EDMO LOT 5 CAMP VING TITLE ROAD SHEE SHEE	RE-ISSUED FOR DA         RE-ISSUED FOR DA         ISSUED FOR INFORMATION         Description         ISSUED FOR INFORMATION         Description         ISSUED FOR INFORMATION         Description         Infrastructure & developmen         Suite 8.01, 56 Clarence Stresydney, NSW 2000         e       admin@idcaus.com         W       www.idcaus.com         COM       e         NDSON PARK PRECINCT         DP1272931         BELLTOWN ROAD         LONGITUDINAL SECTIO         T4         0,100       STATUS	GAP GAP GAP Drawn t consulti	DR DR CJA CJA Appr

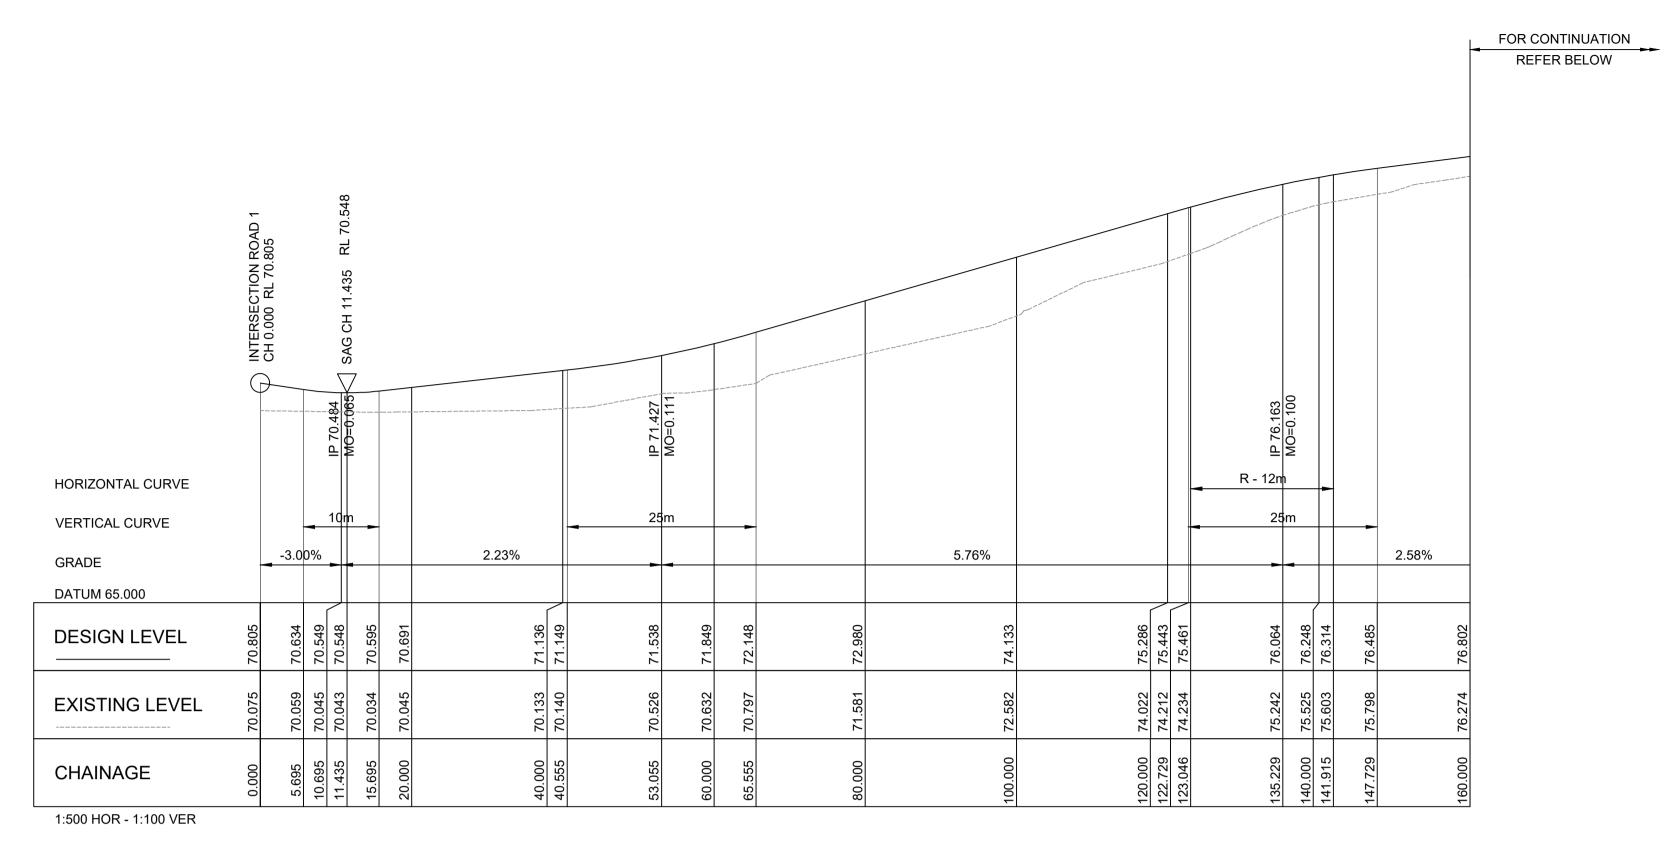




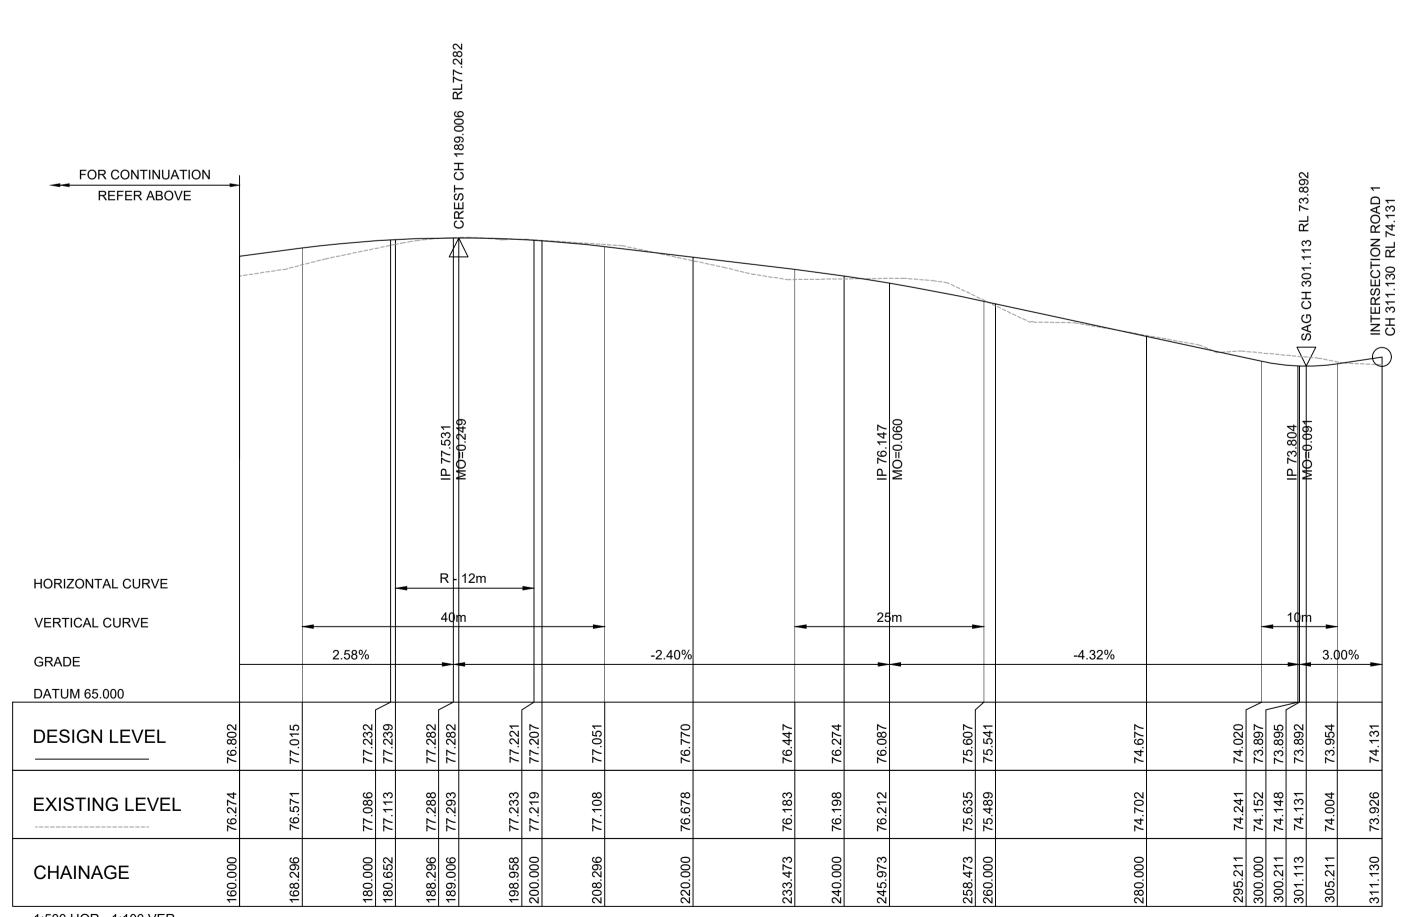


1:500 HOR - 1:100 VER

LONGITUDINAL SECTION - ROAD 5 (CONTINUED)

LEGE				
E	27.05.24	RE-ISSUED FOR DA	GAP	DR
D	20.10.23	RE-ISSUED FOR DA	GAP	DR
D C	20.10.23 13.09.23	RE-ISSUED FOR DA RE-ISSUED FOR DA	GAP GAP	DR DR
D	20.10.23	RE-ISSUED FOR DA	GAP	DR
D C B	20.10.23 13.09.23 24.01.23	RE-ISSUED FOR DA RE-ISSUED FOR DA ISSUED FOR DA	GAP GAP GAP	DR DR CJA CJA
D C B A	20.10.23 13.09.23 24.01.23 20.01.23	RE-ISSUED FOR DA RE-ISSUED FOR DA ISSUED FOR DA ISSUED FOR INFORMATION Description infrastructure & development	GAP GAP GAP GAP Drawn	DR DR CJA CJA Appr
D C B A	20.10.23 13.09.23 24.01.23 20.01.23	RE-ISSUED FOR DA RE-ISSUED FOR DA ISSUED FOR DA ISSUED FOR INFORMATION Description infrastructure & development Suite 8.01, 56 Clarence Street	GAP GAP GAP GAP Drawn	DR DR CJA CJA Appr
D C B A	20.10.23 13.09.23 24.01.23 20.01.23	RE-ISSUED FOR DA RE-ISSUED FOR DA ISSUED FOR DA ISSUED FOR INFORMATION Description infrastructure & development Suite 8.01, 56 Clarence Street	GAP GAP GAP GAP Drawn	DR DR CJA CJA Appr
D C B A	20.10.23 13.09.23 24.01.23 20.01.23 Date	RE-ISSUED FOR DA RE-ISSUED FOR DA ISSUED FOR DA ISSUED FOR INFORMATION Description infrastructure & development Suite 8.01, 56 Clarence Street Sydney, NSW 2000	GAP GAP GAP GAP Drawn	DR DR CJA CJA Appr
D C A Rev	20.10.23 13.09.23 24.01.23 20.01.23 Date	RE-ISSUED FOR DA RE-ISSUED FOR DA ISSUED FOR DA ISSUED FOR INFORMATION Description infrastructure & development Suite 8.01, 56 Clarence Strees Sydney, NSW 2000 e admin@idcaus.com w www.idcaus.com	GAP GAP GAP GAP Drawn	DR DR CJA CJA Appr
D C B A	20.10.23 13.09.23 24.01.23 20.01.23 Date	RE-ISSUED FOR DA RE-ISSUED FOR DA ISSUED FOR DA ISSUED FOR INFORMATION Description infrastructure & development Suite 8.01, 56 Clarence Street Sydney, NSW 2000 e admin@idcaus.com w www.idcaus.com	GAP GAP GAP GAP Drawn	DR DR CJA CJA Appr
D C B A Rev	20.10.23 13.09.23 24.01.23 20.01.23 Date	RE-ISSUED FOR DA         RE-ISSUED FOR DA         ISSUED FOR DA         ISSUED FOR INFORMATION         Description         infrastructure & development         Sydney, NSW 2000         e       admin@idcaus.com         w       www.idcaus.com         SCOM	GAP GAP GAP Drawn	DR DR CJA CJA Appr
D C B A Rev	20.10.23 13.09.23 24.01.23 20.01.23 Date	RE-ISSUED FOR DA RE-ISSUED FOR DA ISSUED FOR DA ISSUED FOR INFORMATION Description infrastructure & development Suite 8.01, 56 Clarence Stree Sydney, NSW 2000 e admin@idcaus.com www.idcaus.com Www.idcaus.com	GAP GAP GAP Drawn	DR DR CJA CJA Appr
D C B A Rev	20.10.23 13.09.23 24.01.23 20.01.23 Date	RE-ISSUED FOR DA         RE-ISSUED FOR DA         ISSUED FOR DA         ISSUED FOR INFORMATION         Description         infrastructure & development         Suite 8.01, 56 Clarence Street         Sydney, NSW 2000         e       admin@idcaus.com         w       www.idcaus.com         COM         DOSON PARK PRECINCT	GAP GAP GAP Drawn	DR DR CJA CJA Appr
D C B A Rev	20.10.23 13.09.23 24.01.23 20.01.23 Date	RE-ISSUED FOR DA RE-ISSUED FOR DA ISSUED FOR DA ISSUED FOR INFORMATION Description infrastructure & development Suite 8.01, 56 Clarence Stree Sydney, NSW 2000 e admin@idcaus.com www.idcaus.com Www.idcaus.com	GAP GAP GAP Drawn	DR DR CJA CJA Appr
D C B A Rev PROJ	20.10.23 13.09.23 24.01.23 Date Date ECT LANDC EDMO LOT 5 CAMPI	RE-ISSUED FOR DA RE-ISSUED FOR DA ISSUED FOR INFORMATION Description Description	GAP GAP GAP Drawn consulti	DR DR CJA CJA Appr
D C B A Rev PROJ	20.10.23 13.09.23 24.01.23 Date Date ECT LANDC EDMO LOT 5 CAMPI VING TITLE ROAD SHEET	RE-ISSUED FOR DA RE-ISSUED FOR DA ISSUED FOR INFORMATION Description Description	GAP GAP GAP Drawn consulti	DR DR CJA CJA Appr
D C B A Rev PROJ	20.10.23 13.09.23 24.01.23 Date Date ECT LANDC EDMO LOT 5 CAMPI VING TITLE ROAD SHEET	RE-ISSUED FOR DA RE-ISSUED FOR DA ISSUED FOR INFORMATION Description	GAP GAP GAP Drawn consulti	DR CJA CJA Appr ng

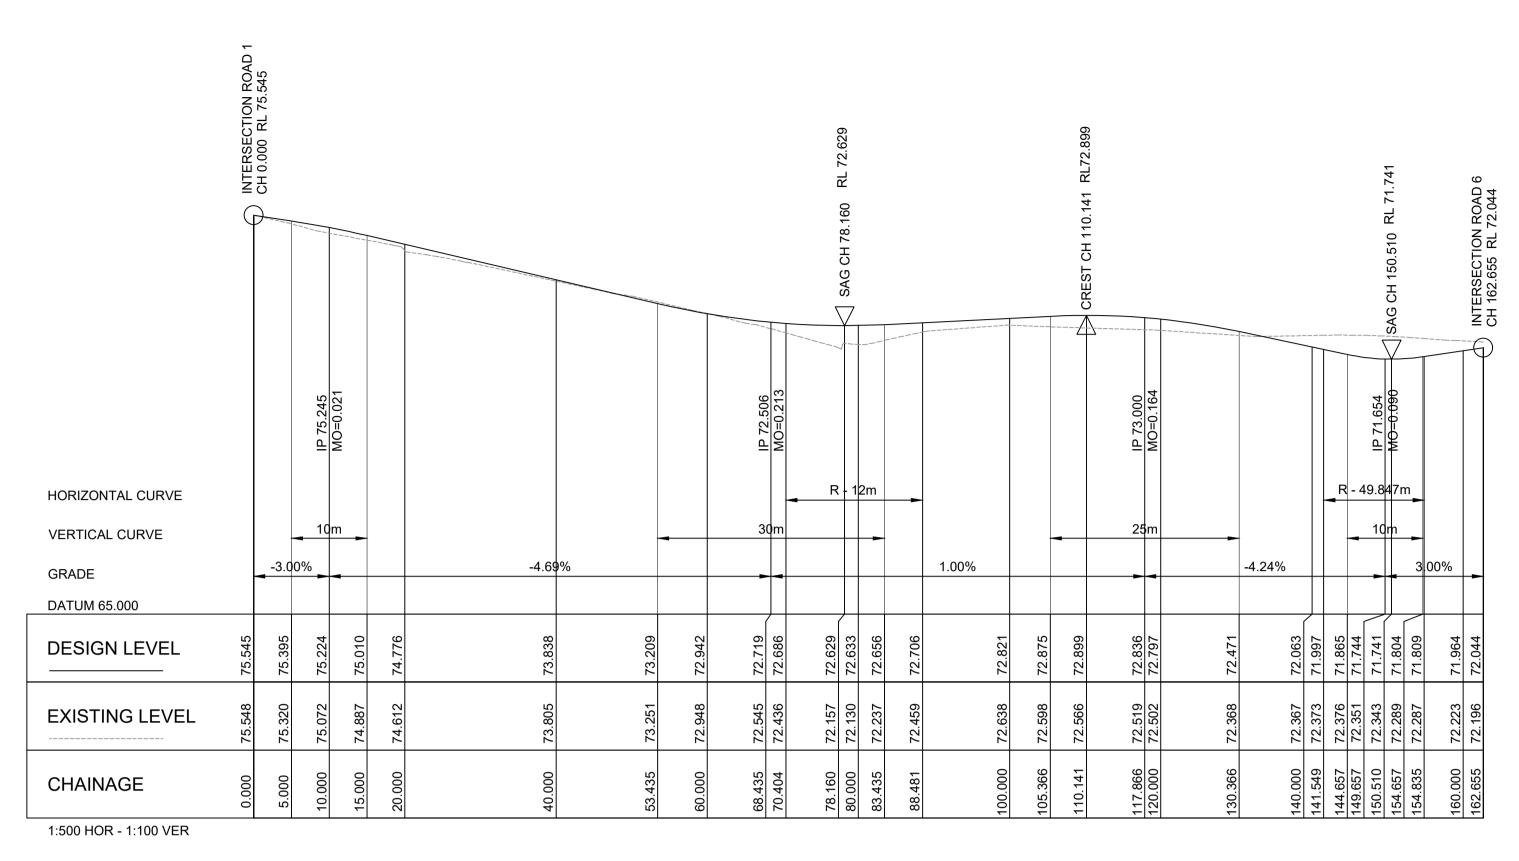



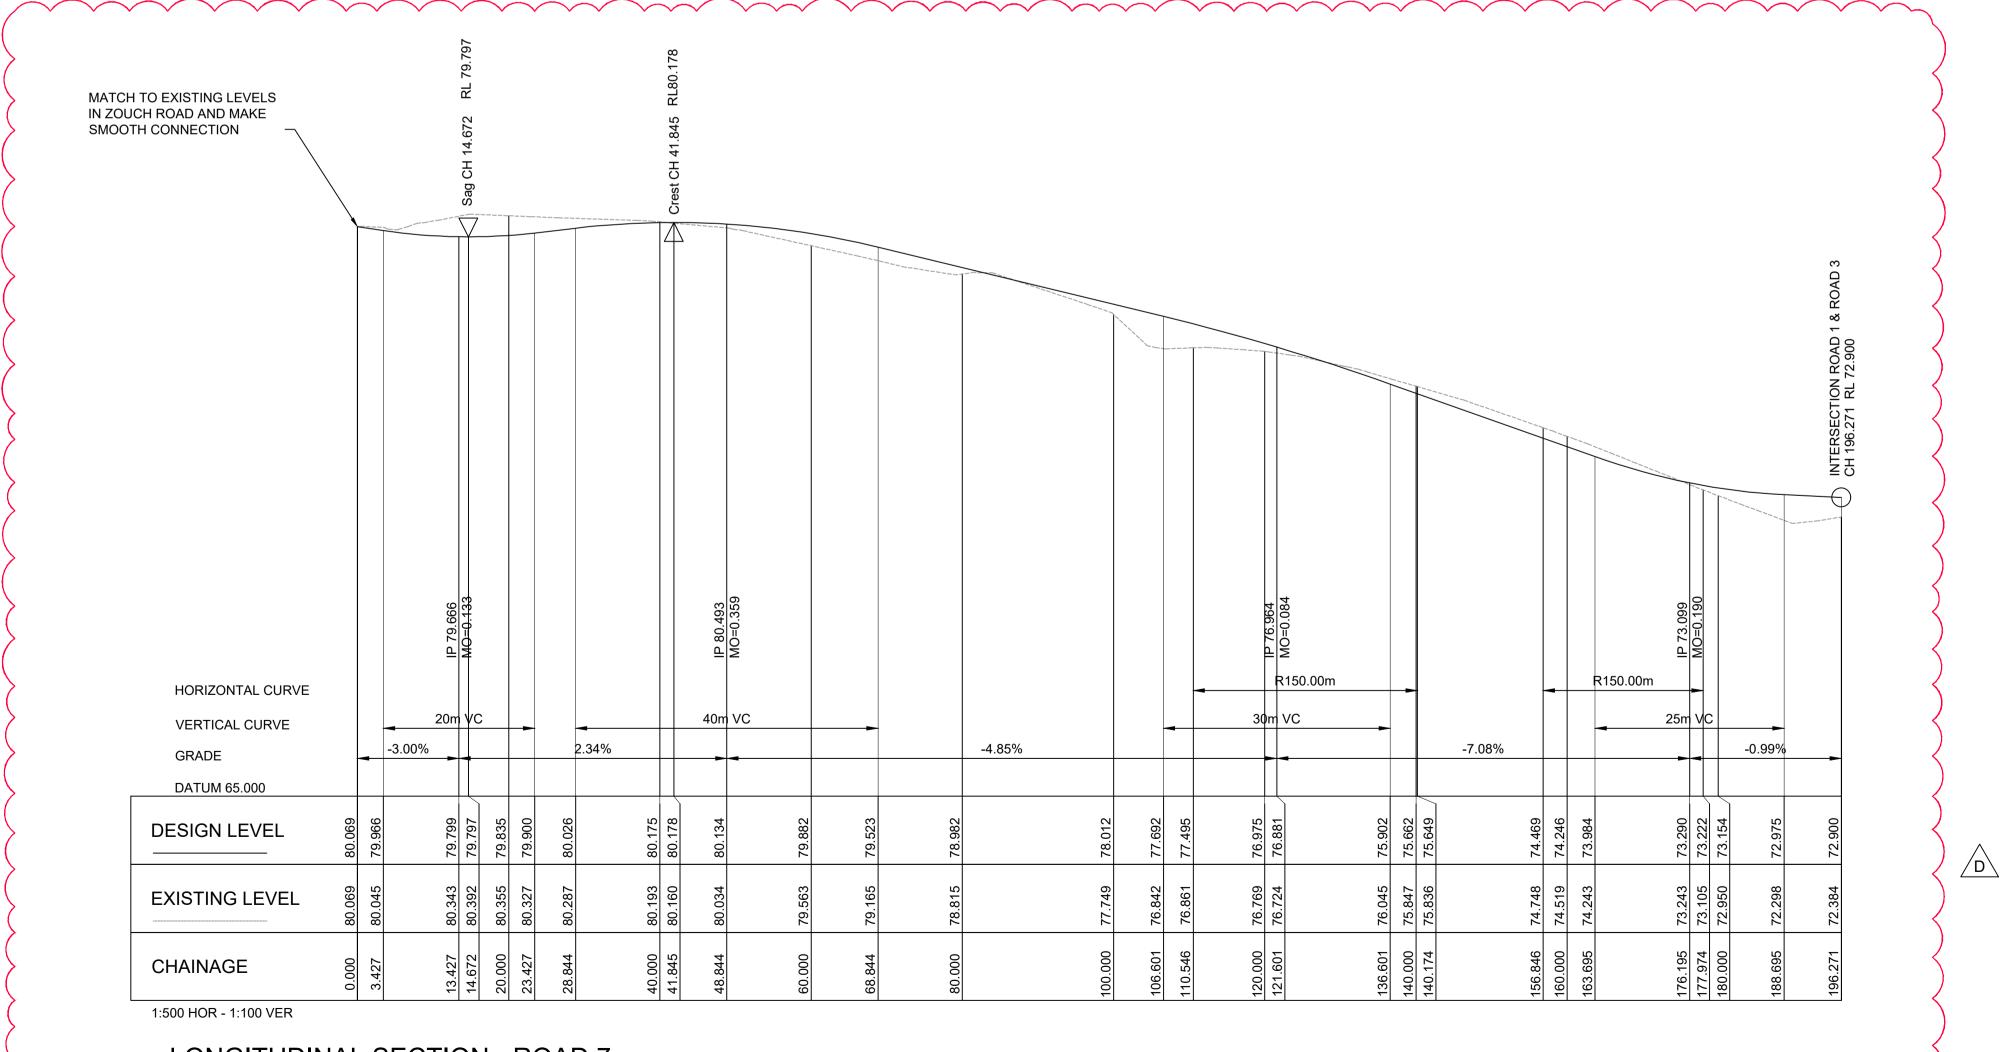

LONGITUDINAL SECTION - ROAD 7

LEGE				_
E	27.05.24	RE-ISSUED FOR DA	GAP	DR
D	20.10.23	RE-ISSUED FOR DA	GAP	DR
С	13.09.23	RE-ISSUED FOR DA	GAP	DR
В	24.01.23	ISSUED FOR DA	GAP	CJA
A Rev	20.01.23 Date	ISSUED FOR INFORMATION Description	GAP Drawn	CJA Appr
	0			
		infrastructure & developmen Suite 8.01, 56 Clarence Stre	t consulti et	ng
0	<b>U</b>	Sydney, NSW 2000 e admin@idcaus.com w www.idcaus.com		
	6-2			
		& development consulting		
PROJ				
			гο	
		NDSON PARK PRECINC ⁻ DP1272931	13	
		BELLTOWN ROAD		
		LONGITUDINAL SECTIO	NS	
	SHEET			
SCAL	E 1.50			
		0,100 STATUS DA		
DRAW		22-514-DA-C165   [®]	E	
 -				

# LONGITUDINAL SECTION - ROAD 9

1:500 HOR - 1:100 VER

	INTERSECTION ROAI	CH 0.000 RL78.469		San CH 10 154 RI 78							
				IP 78.161	MO=0.077				IP 78.867	MO=0.130	L
HORIZONTAL CURVE		-3.0		l0m	VC	-	C	-	25m	VC	
GRADE DATUM 70.000		-3.0	0 /0		•		5	. 13 /6			
DESIGN LEVEL	78.469	78.311	78.238	78.238	78.318	78.467	78.473		78.737	78.771	70 774
EXISTING LEVEL	78.830	78.767	78.711	78.710	78.712	78.717	78.718		78.727	78.747	70 750
CHAINAGE	0.000	5.278	10.154	10.278	15.278	20.000	20.203		32.703	39.136	


#### LONGITUDINAL SECTION - ROAD 8


RL 78.238

4D 8


	INTERSECTION ROAD 8	CH 0.000 RL75.581	Sad CH 5 430 BI 75 458							
		2		MO=0.089					IP 77.139	MO=0.047
HORIZONTAL CURVE										
VERTICAL CURVE			8	nV	C_			2	5m	V
GRADE		-3.	00%	6		Ę	.89%		-	-
DATUM 70.000										
DESIGN LEVEL	75.581	75.499	75.458	75.468	75.614	76.160	76.403		77.092	
EXISTING LEVEL	75.945	76.107	76.275	76.356	76.605	76.971	77.018		77.547	
CHAINAGE	0.000	2.730	5.430	6.730	10.730	20.000	24.123		36.623	
1:500 HOR - 1:100 VER										

E

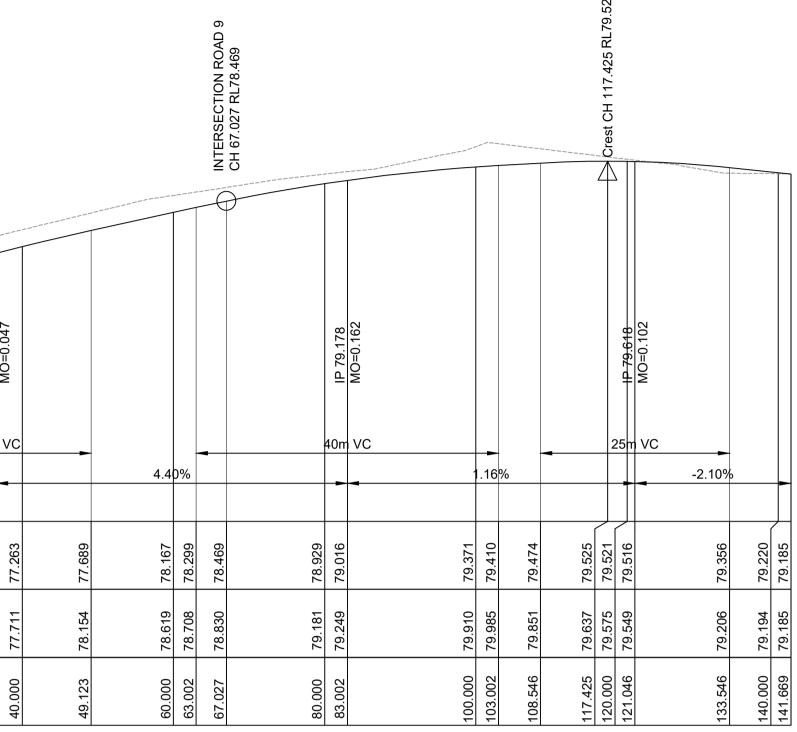


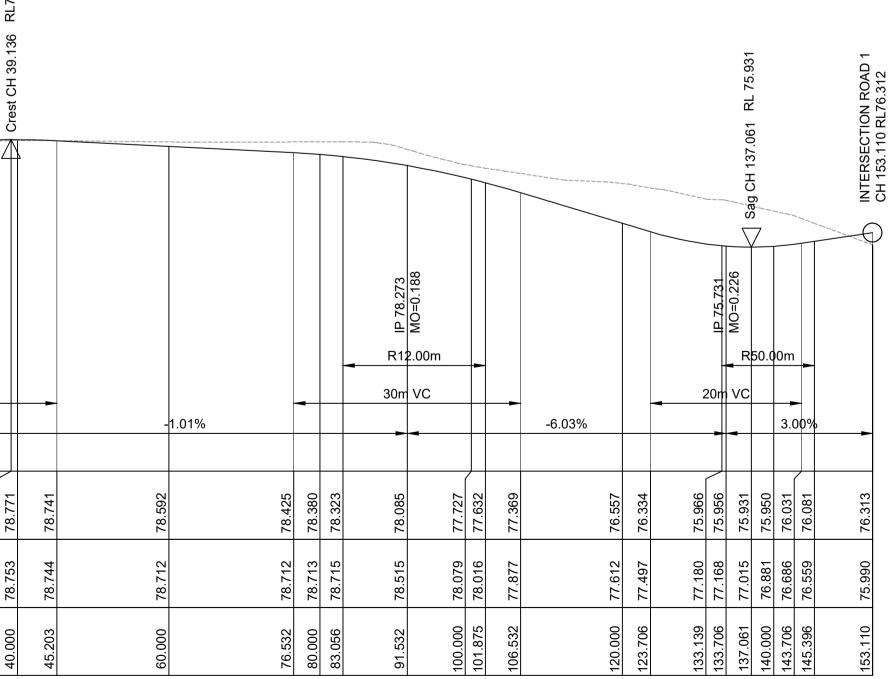


	CAR	
E         27.05.24         RE-ISSUED FOR DA           D         20.10.23         RE-ISSUED FOR DA	GAP GAP	DR DR
D20.10.23RE-ISSUED FOR DAC13.09.23RE-ISSUED FOR DA	GAP GAP	DR DR
D 20.10.23 RE-ISSUED FOR DA	GAP	DR
D20.10.23RE-ISSUED FOR DAC13.09.23RE-ISSUED FOR DAB24.01.23ISSUED FOR DA	GAP GAP GAP	DR DR CJA CJA
D20.10.23RE-ISSUED FOR DAC13.09.23RE-ISSUED FOR DAB24.01.23ISSUED FOR DAA20.01.23ISSUED FOR INFORMATION	GAP GAP GAP GAP Drawn pment consult e Street	DR DR CJA CJA Appr
D       20.10.23       RE-ISSUED FOR DA         C       13.09.23       RE-ISSUED FOR DA         B       24.01.23       ISSUED FOR INFORMATION         Rev       Date       Description         infrastructure & develop Suite 8.01, 56 Clarence Sydney, NSW 2000         e       admin@idcaus.com         PROJECT       LANDCOM EDMONDSON PARK PRECIN LOT 5 DP1272931 CAMPBELLTOWN ROAD	GAP GAP GAP Drawn pment consult e Street	DR DR CJA CJA Appr
D       20.10.23       RE-ISSUED FOR DA         C       13.09.23       RE-ISSUED FOR DA         B       24.01.23       ISSUED FOR INFORMATION         A       20.01.23       ISSUED FOR INFORMATION         Rev       Date       Description         infrastructure & develop Suite 8.01, 56 Clarence Sydney, NSW 2000         e       admin@idcaus.com         W       Www.idcaus.com         PROJECT         LANDCOM EDMONDSON PARK PRECIN LOT 5 DP1272931	GAP GAP GAP Drawn pment consult e Street	DR DR CJA CJA Appr
D       20.10.23       RE-ISSUED FOR DA         C       13.09.23       RE-ISSUED FOR DA         B       24.01.23       ISSUED FOR INFORMATION         Rev       Date       Description         infrastructure & develop Suite 8.01, 56 Clarence Sydney, NSW 2000         e       admin@idcaus.com         PROJECT       LANDCOM EDMONDSON PARK PRECIN LOT 5 DP1272931 CAMPBELLTOWN ROAD         DRAWING TITLE       ROAD LONGITUDINAL SECT	GAP GAP GAP Drawn pment consult e Street	DR DR CJA CJA Appr
D       20.10.23       RE-ISSUED FOR DA         C       13.09.23       RE-ISSUED FOR DA         B       24.01.23       ISSUED FOR INFORMATION         Rev       Date       Description         Infrastructure & develop Suite 8.01, 56 Clarence Sydney, NSW 2000         e         admin@idcaus.c         W       W 2000         e         admin@idcaus.c         W       W 2000         e         admin@idcaus.c         W       W 2000         e       admin@idcaus.c         W       W 2000         e       admin@idcaus.c         W       W 2000         e       admin@idcaus.c         W       WWW.idcaus.com         PROJECT         LANDCOM         DMONDSON PARK PRECIN         LOT 5 DP1272931         CAMPBELLTOWN ROAD         DRAWING TITLE         ROAD LONGITUDINAL SECT         STATUE	GAP GAP GAP Drawn pment consult e Street	DR DR CJA CJA Appr

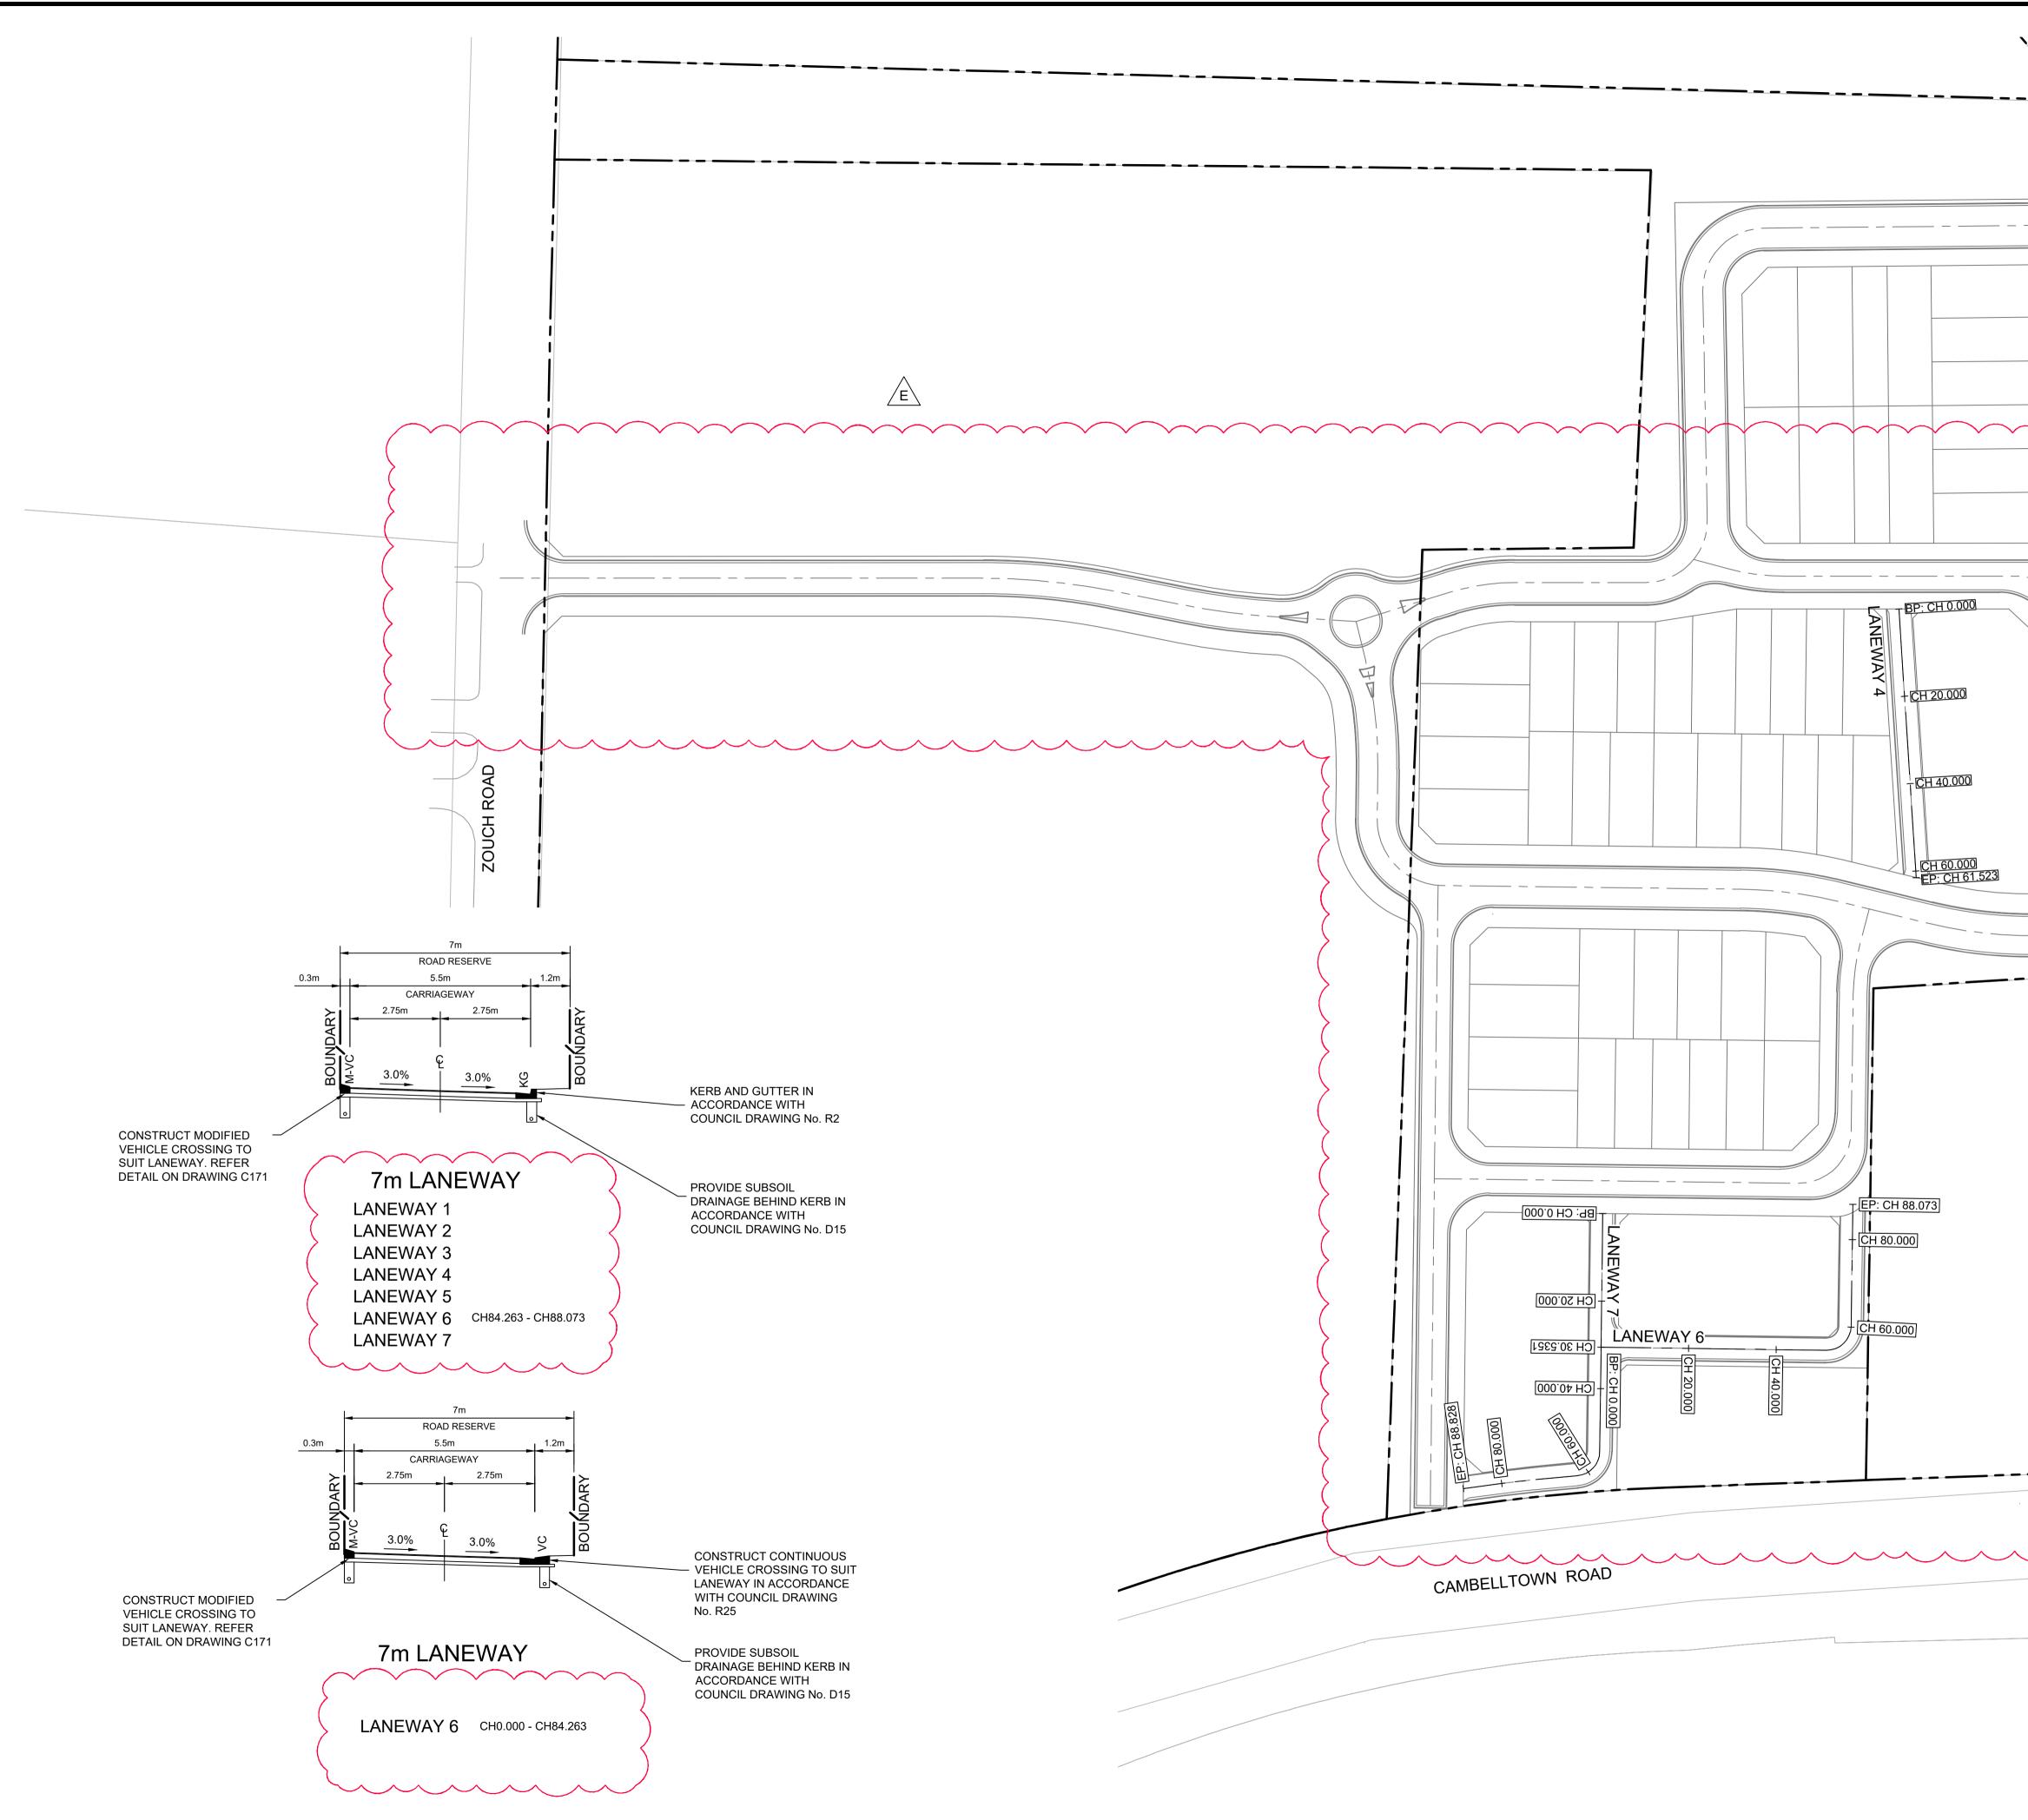

	LEGEND	
$\mathbf{X}$		
$\sim$		
EP: CH 66.610		
+ <u>CH 60.000</u>		
- CH 40.000		
→ CH 20.000		
9 KMANA		
AN		
BP: CH 0.000		
2 1		
5		
o Z		
D × G		
ERT		
ЦШ		
Z Z		
N U N		
⊢ Z		
0 0		
FOR		
$\checkmark$		
)		
5		
) )		
	E 27.05.24 RE-ISSUED FOR DA	GAP DR
$\checkmark$	D 20.10.23 RE-ISSUED FOR DA	GAP DR
$\checkmark$	C13.09.23RE-ISSUED FOR DAB24.01.23ISSUED FOR DA	GAP DR GAP CJA
$\checkmark$	A20.01.23ISSUED FOR INFORMATION	GAP CJA
$\checkmark$	Rev Date Description	Drawn Appr
$\checkmark$	infrastructure & development	consulting
)	Suite 8.01. 56 Clarence Stree	et
	Sydney, NSW 2000 e admin@idcaus.com www.idcaus.com	
	w www.idcaus.com	
$\triangleleft$		
	LANDCOM EDMONDSON PARK PRECINC1	
	LOT 5 DP1272931	
	CAMPBELLTOWN ROAD	
	DRAWING TITLE	
	LANEWAY ALIGNMENT CONTR	OL
	PLAN - SHEET 1	
	SCALE 1:750 STATUS DA	
		=V
I	^{DRAWING NO.} 22-514-DA-C170	Ě

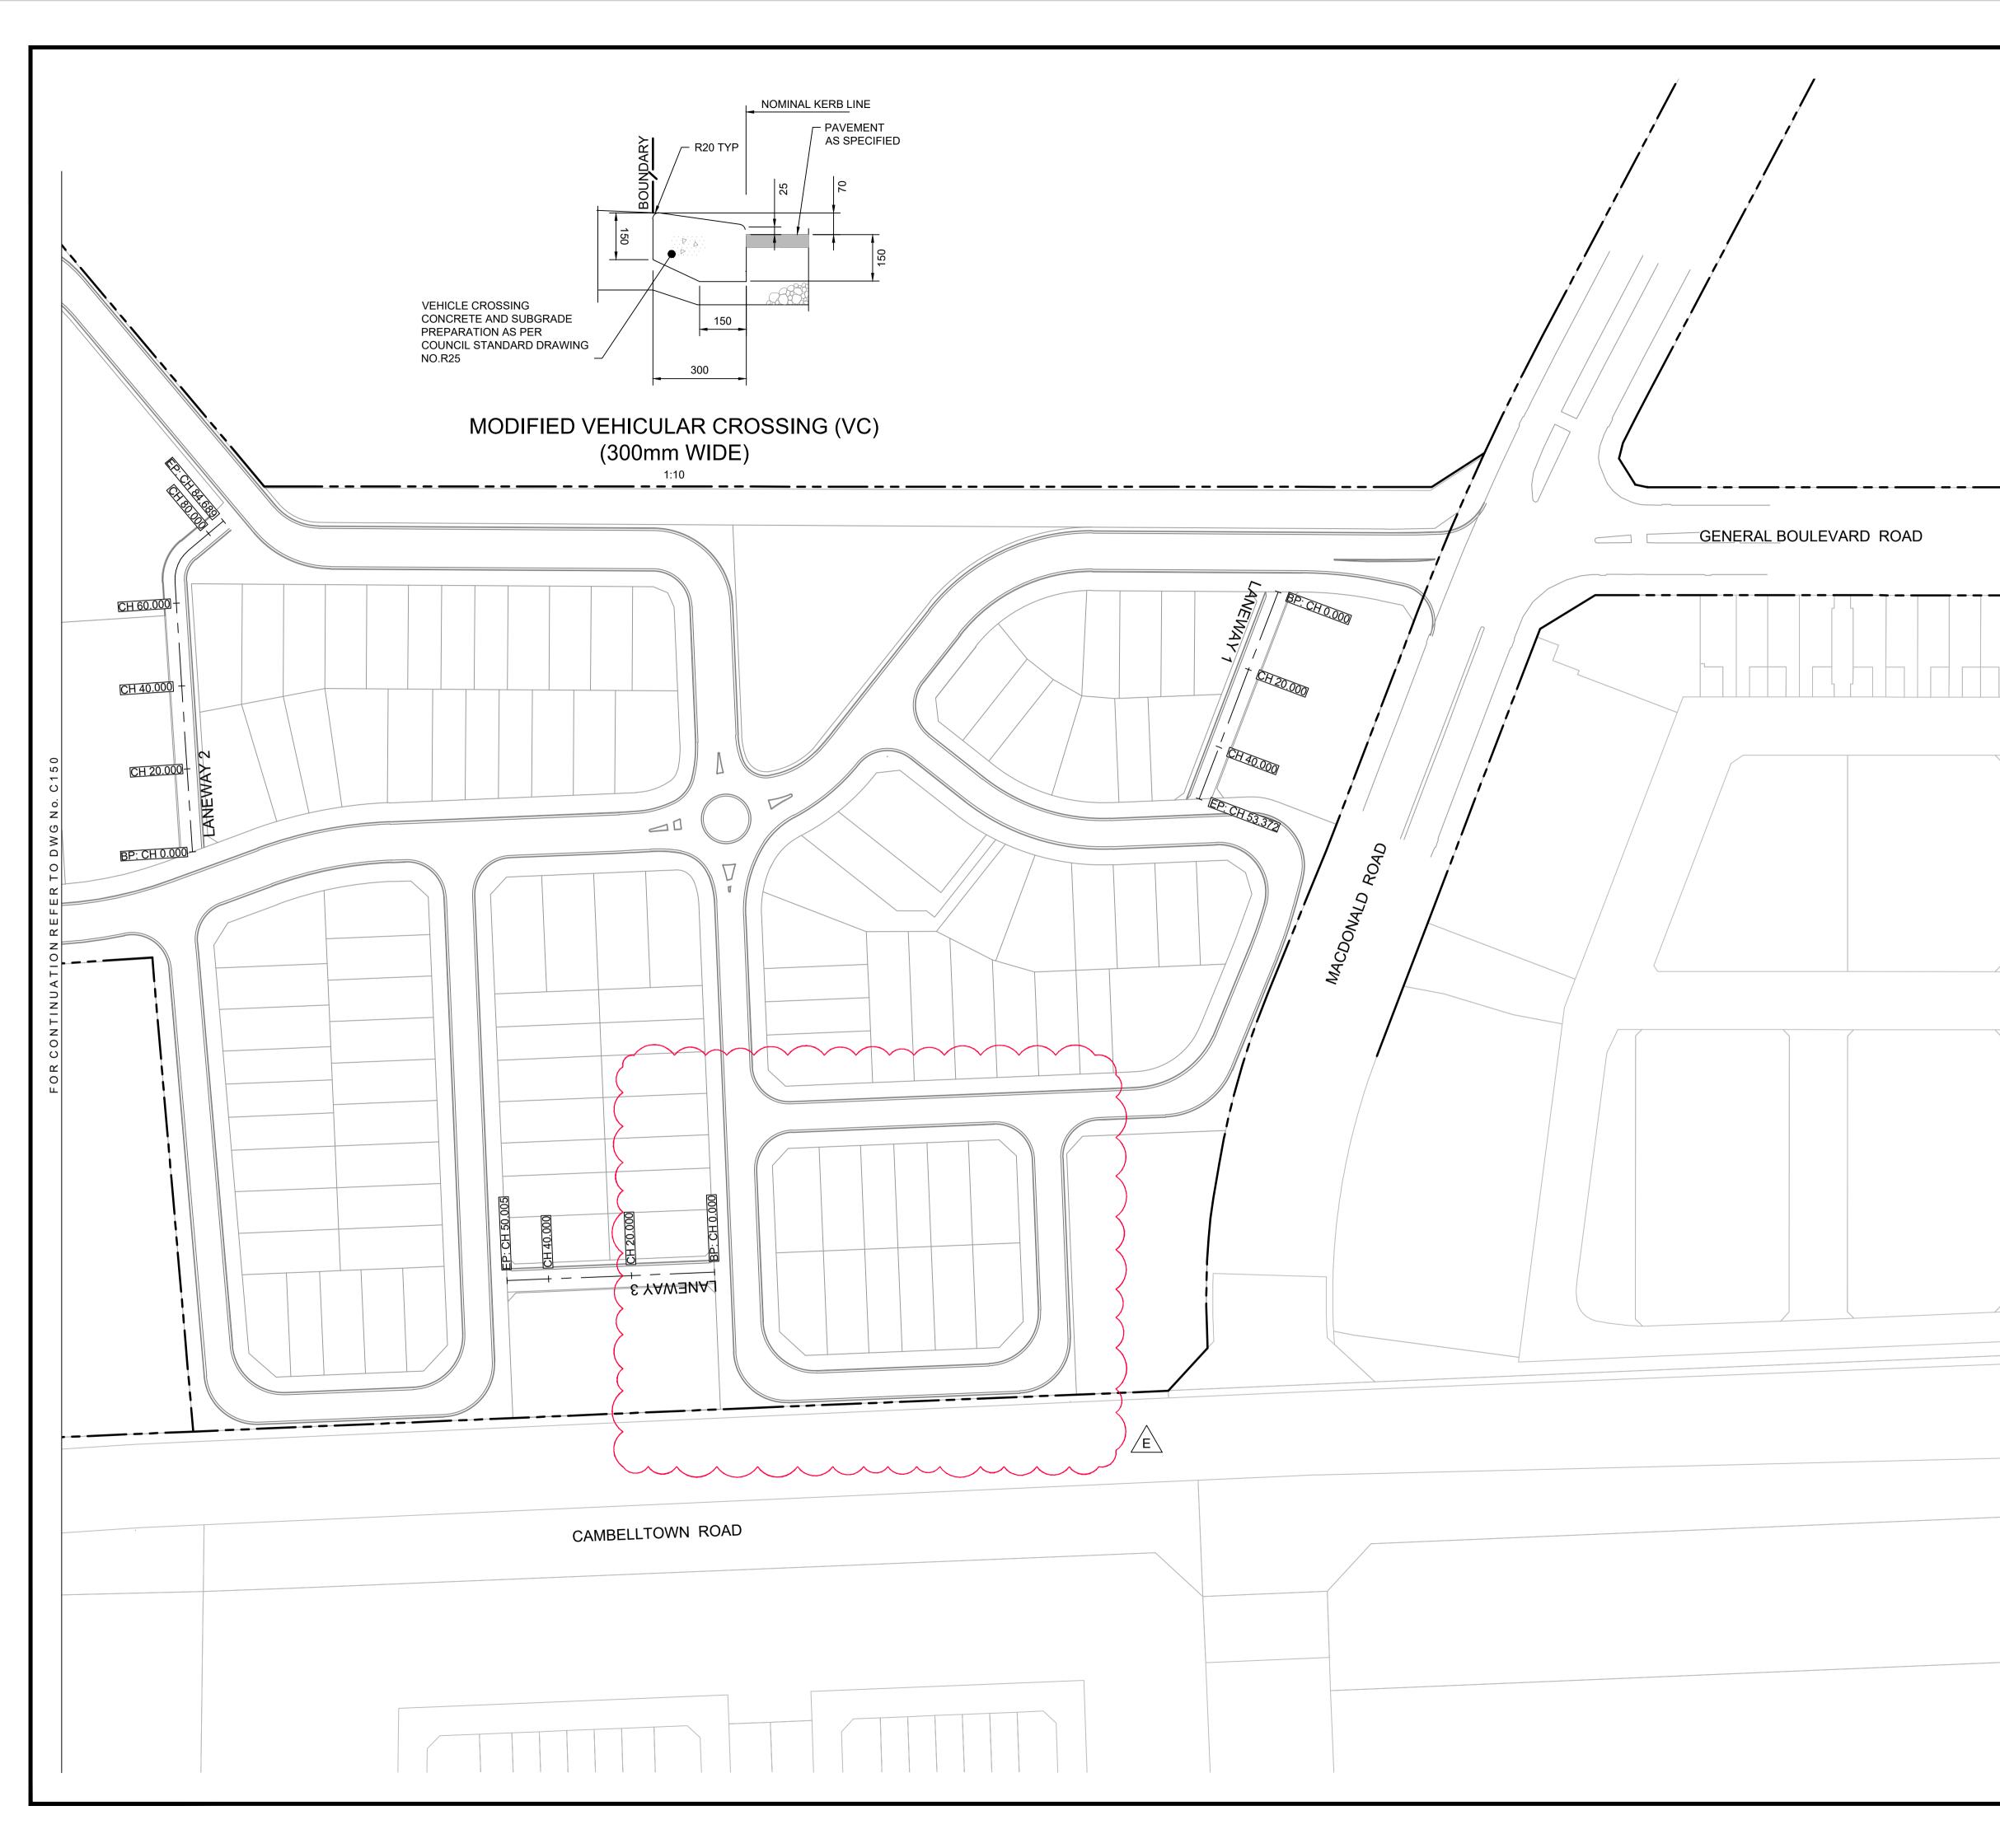


	-ISSUED FOR DA -ISSUED FOR DA		DR
C       13.09.23       RE         B       24.01.23       ISS         A       20.01.23       ISS	E-ISSUED FOR DA SUED FOR DA SUED FOR INFORMATION scription infrastructure & development	GAP GAP GAP Drawn	DR CJA CJA Appr
	e admin@idcaus.com www.idcaus.com	eet	3
LANDCO EDMONE LOT 5 DF	OM OSON PARK PRECINC P1272931 ELLTOWN ROAD	Т3	
LANEWA PLAN - S	STATUS	ROL	
1:750		^{REV} E	

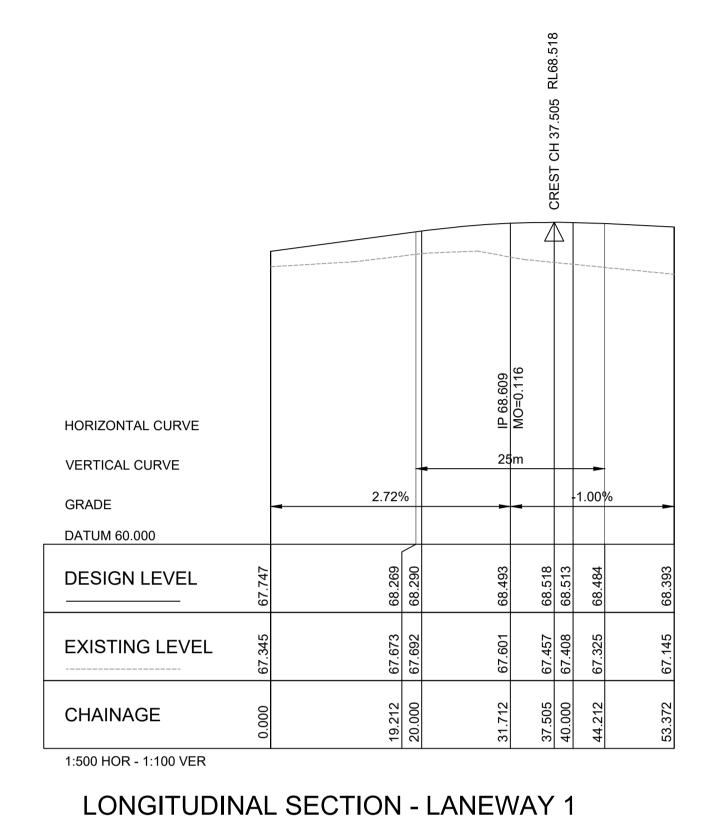


VERTICAL CURVE
GRADE
DATUM 65.000
DESIGN LEVEL
EXISTING LEVEL
CHAINAGE
1:500 HOR - 1:100 VER

HORIZONTAL CURVE

# LONGITUDINAL SECTION - LANEWAY 3

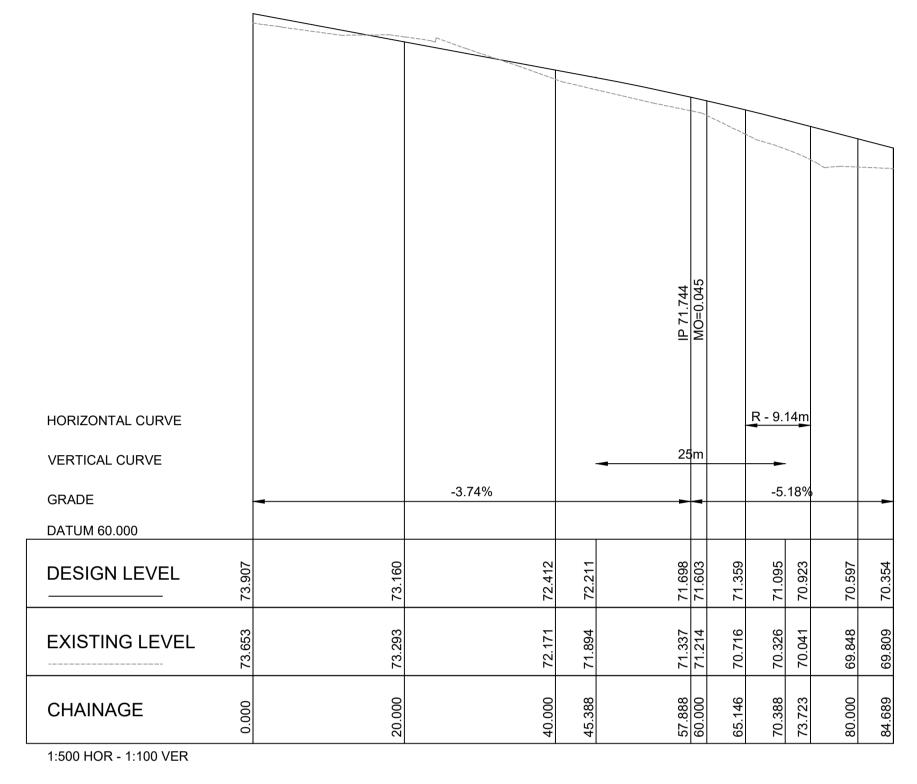

#### LONGITUDINAL SECTION - LANEWAY 2

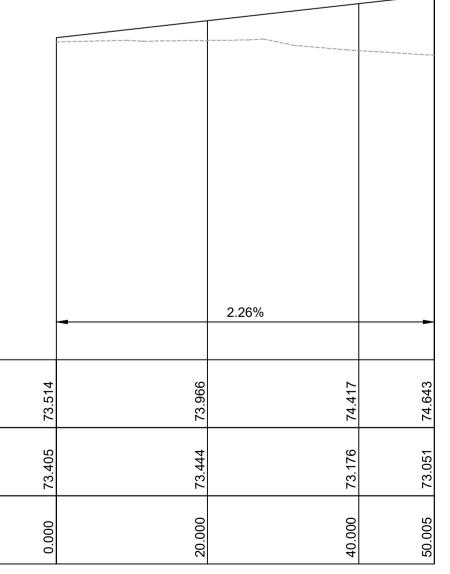

D20.10.23RE-ISSUED FOR DAGAPDRC13.09.23RE-ISSUED FOR DAGAPDRB24.01.23ISSUED FOR DAGAPCJAA20.01.23ISSUED FOR INFORMATIONGAPCJA					
D20.10.23RE-ISSUED FOR DAGAPDRC13.09.23RE-ISSUED FOR DAGAPDRB24.01.23ISSUED FOR DAGAPCJAA20.01.23ISSUED FOR INFORMATIONGAPCJA					
D       20.10.23       RE-ISSUED FOR DA       GAP       DR         C       13.09.23       RE-ISSUED FOR DA       GAP       DR         B       24.01.23       ISSUED FOR DA       GAP       CJA         A       20.01.23       ISSUED FOR INFORMATION       GAP       CJA					
D       20.10.23       RE-ISSUED FOR DA       GAP       DR         C       13.09.23       RE-ISSUED FOR DA       GAP       DR         B       24.01.23       ISSUED FOR DA       GAP       CJA         A       20.01.23       ISSUED FOR INFORMATION       GAP       CJA					
D20.10.23RE-ISSUED FOR DAGAPDRC13.09.23RE-ISSUED FOR DAGAPDRB24.01.23ISSUED FOR DAGAPCJAA20.01.23ISSUED FOR INFORMATIONGAPCJA					
D20.10.23RE-ISSUED FOR DAGAPDRC13.09.23RE-ISSUED FOR DAGAPDRB24.01.23ISSUED FOR DAGAPCJAA20.01.23ISSUED FOR INFORMATIONGAPCJA					
C13.09.23RE-ISSUED FOR DAGAPDRB24.01.23ISSUED FOR DAGAPCJAA20.01.23ISSUED FOR INFORMATIONGAPCJA					
B24.01.23ISSUED FOR DAGAPCJAA20.01.23ISSUED FOR INFORMATIONGAPCJA	E	27.05.24	RE-ISSUED FOR DA	GAP	DR
	D	20.10.23	RE-ISSUED FOR DA	GAP	DR
	D C B	20.10.23 13.09.23 24.01.23	RE-ISSUED FOR DA RE-ISSUED FOR DA ISSUED FOR DA	GAP GAP GAP	DR DR CJA
	D C B A	20.10.23 13.09.23 24.01.23 20.01.23	RE-ISSUED FOR DA RE-ISSUED FOR DA ISSUED FOR DA ISSUED FOR INFORMATION Description infrastructure & deve Suite 8.01, 56 Clarer	GAP GAP GAP GAP Drawn	DR DR CJA CJA
Sydney, NSW 2000 e admin@idcaus.com	D C B A	20.10.23 13.09.23 24.01.23 20.01.23	RE-ISSUED FOR DA RE-ISSUED FOR DA ISSUED FOR DA ISSUED FOR INFORMATION Description infrastructure & deve Suite 8.01, 56 Claren Sydney, NSW 2000 e admin@idcau	GAP GAP GAP GAP Drawn elopment consult nce Street	DR DR CJA CJA
Sydney, NSW 2000 e admin@idcaus.com www.idcaus.com	D C B A	20.10.23 13.09.23 24.01.23 20.01.23 Date	RE-ISSUED FOR DA RE-ISSUED FOR DA ISSUED FOR DA ISSUED FOR INFORMATION Description infrastructure & deve Suite 8.01, 56 Claren Sydney, NSW 2000 e admin@idcau w www.idcaus.c	GAP GAP GAP GAP Drawn elopment consult nce Street	DR DR CJA CJA
PROJECT	D C A Rev	20.10.23 13.09.23 24.01.23 20.01.23 Date	RE-ISSUED FOR DA RE-ISSUED FOR DA ISSUED FOR DA ISSUED FOR INFORMATION Description infrastructure & deve Suite 8.01, 56 Clarent Sydney, NSW 2000 e admin@idcau w www.idcaus.c	GAP GAP GAP GAP Drawn elopment consult nce Street	DR DR CJA CJA
PROJECT LANDCOM EDMONDSON PARK PRECINCT 3	D C A Rev	20.10.23 13.09.23 24.01.23 20.01.23 Date	RE-ISSUED FOR DA RE-ISSUED FOR DA ISSUED FOR DA ISSUED FOR INFORMATION Description infrastructure & deve Suite 8.01, 56 Claren Sydney, NSW 2000 e admin@idcau www.idcaus.c	GAP GAP GAP GAP Drawn com com	DR DR CJA CJA
PROJECT LANDCOM	D C A Rev	20.10.23 13.09.23 24.01.23 20.01.23 Date	RE-ISSUED FOR DA RE-ISSUED FOR DA ISSUED FOR DA ISSUED FOR INFORMATION Description infrastructure & deve Suite 8.01, 56 Claren Sydney, NSW 2000 e admin@idcau w www.idcaus.c COM NDSON PARK PRECI DP1272931	GAP GAP GAP GAP Drawn com com	DR DR CJA CJA
PROJECT LANDCOM EDMONDSON PARK PRECINCT 3 LOT 5 DP1272931 CAMPBELLTOWN ROAD	D A Rev PROJ	20.10.23 13.09.23 24.01.23 Date Date ECT LANDC EDMO LOT 5 CAMP	RE-ISSUED FOR DA RE-ISSUED FOR DA ISSUED FOR INFORMATION Description Description	GAP GAP GAP GAP Drawn elopment consult nce Street	DR DR CJA Appr ting
PROJECT LANDCOM EDMONDSON PARK PRECINCT 3 LOT 5 DP1272931 CAMPBELLTOWN ROAD	D A Rev PROJ	20.10.23 13.09.23 24.01.23 Date Date ECT LANDC EDMO LOT 5 CAMPI	RE-ISSUED FOR DA RE-ISSUED FOR DA ISSUED FOR INFORMATION Description Description	GAP GAP GAP GAP Drawn elopment consult nce Street	DR DR CJA Appr ting
PROJECT LANDCOM EDMONDSON PARK PRECINCT 3 LOT 5 DP1272931 CAMPBELLTOWN ROAD DRAWING TITLE LANEWAY LONGITUDINAL SECTIONS	D A Rev PROJ	20.10.23 13.09.23 24.01.23 Date Date ECT LANDC EDMO LOT 5 CAMPI	RE-ISSUED FOR DA RE-ISSUED FOR DA ISSUED FOR INFORMATION Description Description	GAP GAP GAP GAP Drawn elopment consult nce Street	DR DR CJA Appr ting
PROJECT LANDCOM EDMONDSON PARK PRECINCT 3 LOT 5 DP1272931 CAMPBELLTOWN ROAD DRAWING TITLE LANEWAY LONGITUDINAL SECTIONS	D A Rev PROJ	20.10.23 13.09.23 24.01.23 Date Date ECT LANDC EDMO LOT 5 CAMPI VING TITLE LANEV SHEET	RE-ISSUED FOR DA RE-ISSUED FOR DA ISSUED FOR INFORMATION Description	GAP GAP GAP GAP Drawn elopment consult nce Street	DR DR CJA Appr ting

# LONGITUDINAL SECTION - LANEWAY 6

>	-+-						
$\rangle$							
$\rangle$							
> \							
	IP 79.130	MO=0.007					
HORIZONTAL CURVE					R5.57m		
VERTICAL CURVE	3m	vc					
GRADE	-3.00	%		-1.03%			
DATUM 70.000							
DESIGN LEVEL	79.205 79.175 79.137	79.114 78.950	78.744	78.626	78.539 78.536	70 000	78.250
EXISTING LEVEL	79.103 79.099 79.094	79.032	79.059	79.100	78.994 78.994	70 JOE	78.511
CHAINAGE	0.000 1.016 2.516	4.016 20.000	40.000	51.469	60.000 60.208		88.073
1:500 HOR - 1:100 VER		•			· · · · · ·		

# LONGITUDINAL SECTION - LANEWAY 4

	ſ				
HORIZONTAL CURVE					
VERTICAL CURVE					
GRADE	-	-	5.34%		_
DATUM 65.000					
DESIGN LEVEL	72.997	74.066	75.134	76.203	76.284
EXISTING LEVEL	72.855	73.986	74.790	75.190	75.308
CHAINAGE	0.000	20.000	40.000	60.000	61.523
1:500 HOR - 1:100 VER					

# LONGITUDINAL SECTION - LANEWAY 7


1:500 HOR - 1:100 VER
-----------------------

												Crest CH 6					
				T			-					ō 					T
												MO=0.100					
HORIZONTAL CURVE			R3	49	67m				F	R5.5	9m		R402.42	2m			
VERTICAL CURVE						-	4				40	n VC					
GRADE		-	1.0	00%	ю Г						<b></b> ,		-1.00%	6			
DATUM 70.000																	
DESIGN LEVEL	78.899	79.100	79.228	79.235	79.300	79.334	79.414	79.431	79.434	79.434	79.434	18.434		79.365	79.334	79.283	79.279
EXISTING LEVEL	78.924	79.341	79.131	79.139	79.101	79.039	78.858	78.847	78.869	78.874	78.877	10.01		78.999	79.036	79.076	79.080
CHAINAGE	0.000	20.000	32.764	33.471	40.000	43.334	54.375	60.000	62.631	63.040	63.334	0000.00		80.000	83.334	88.397	88.828
1:500 HOR - 1:100 VER							I			1				1	1		


# LONGITUDINAL SECTION - LANEWAY 5

HORIZONTAL CURVE					
VERTICAL CURVE					
GRADE			-4.92%		
DATUM 60.000					
DESIGN LEVEL	72.732	71.747	70.763	877 QA	69.453
EXISTING LEVEL	71.733	69.810	69.285 69.285	68 486 68	68.499
CHAINAGE	0.000	20.000	40.000	60 DDD	66.610
1:500 HOR - 1:100 VER				1	J

E	27.05.24 20.10.23	RE-ISSUED FOR DA RE-ISSUED FOR DA	GAP         DR           GAP         DR
D C B	20.10.23 13.09.23 24.01.23	RE-ISSUED FOR DA RE-ISSUED FOR DA ISSUED FOR DA	GAP DR GAP DR GAP CJA
D C	20.10.23 13.09.23	RE-ISSUED FOR DA RE-ISSUED FOR DA	GAP DR GAP DR
D C B A	20.10.23 13.09.23 24.01.23 20.01.23	RE-ISSUED FOR DA RE-ISSUED FOR DA ISSUED FOR DA ISSUED FOR INFORMATION Description infrastructure & develo Suite 8.01, 56 Clarence Sydney, NSW 2000	GAP DR GAP DR GAP CJA GAP CJA Drawn Appr
D C B A	20.10.23 13.09.23 24.01.23 20.01.23 Date	RE-ISSUED FOR DA RE-ISSUED FOR DA ISSUED FOR DA ISSUED FOR INFORMATION Description infrastructure & develo Suite 8.01, 56 Clarence	GAP DR GAP DR GAP CJA GAP CJA Drawn Appr
D C B A Rev	20.10.23 13.09.23 24.01.23 20.01.23 Date	RE-ISSUED FOR DA RE-ISSUED FOR DA ISSUED FOR DA ISSUED FOR INFORMATION Description infrastructure & develo Suite 8.01, 56 Clarence Sydney, NSW 2000 e admin@idcaus.com w www.idcaus.com	GAP DR GAP DR GAP CJA GAP CJA Drawn Appr
D C A Rev	20.10.23 13.09.23 24.01.23 20.01.23 Date	RE-ISSUED FOR DA RE-ISSUED FOR DA ISSUED FOR DA ISSUED FOR INFORMATION Description infrastructure & develo Suite 8.01, 56 Clarence Sydney, NSW 2000 e admin@idcaus.e w www.idcaus.com	GAP DR GAP DR GAP CJA GAP CJA Drawn Appr opment consulting te Street
D C A Rev PROJ	20.10.23 13.09.23 24.01.23 Date Date DECT LANDO EDMO LOT 5 CAMP	RE-ISSUED FOR DA RE-ISSUED FOR DA ISSUED FOR INFORMATION Description Description	GAP DR GAP DR GAP CJA GAP CJA Drawn Appr opment consulting e Street
D C A Rev PROJ	20.10.23 13.09.23 24.01.23 Date Date VING TITLE LANDO EDMO LOT 5 CAMP VING TITLE LANEV SHEE	RE-ISSUED FOR DA RE-ISSUED FOR DA ISSUED FOR INFORMATION Description Description	GAP DR GAP DR GAP CJA GAP CJA Drawn Appr opment consulting e Street

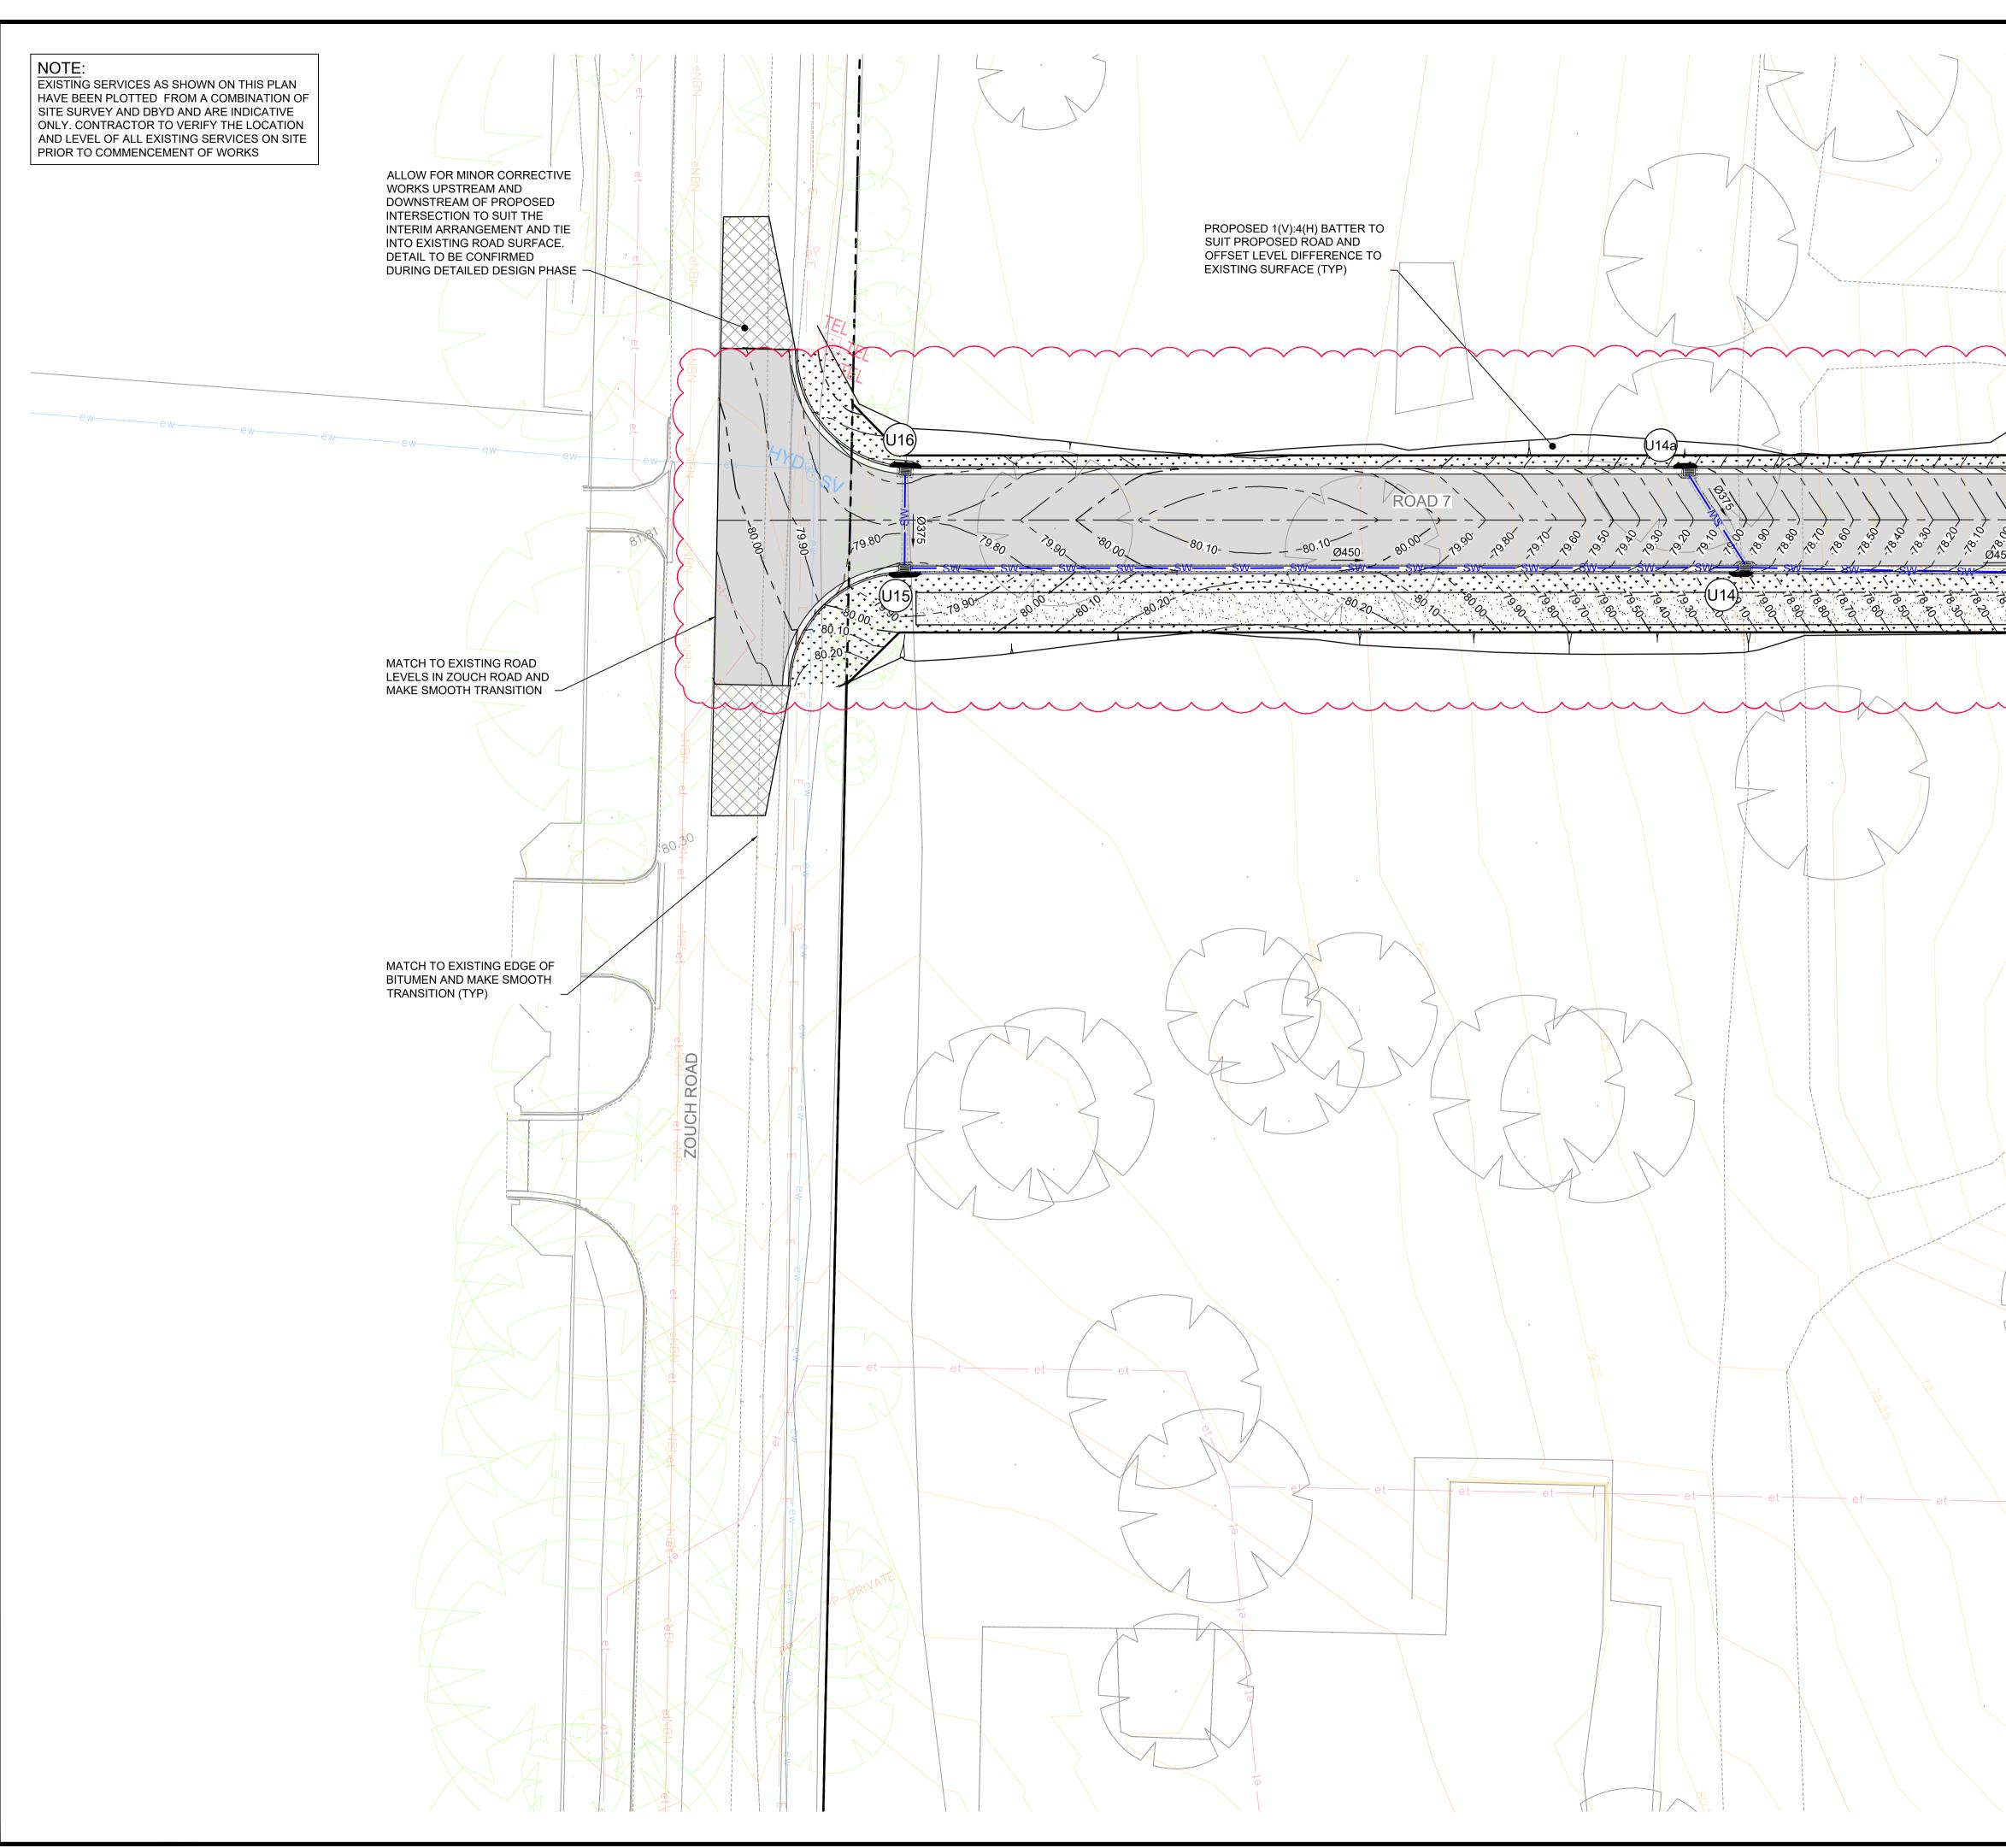



	LEGEND		
e t			
0			
F			
$ \rightarrow \rightarrow$			
1000 100 100			
nn			
C 2 0 1			
D X G N o.			
0 M C			
- et _ I O I			
a the second sec			
et 01			
AT			
ר אר			
et			
00			
0 X			
L.			
/			
1			
18			
P 78	F 27.05.24	RE-ISSUED FOR DA	GAP DR
	E 20.10.23	RE-ISSUED FOR DA	GAP DR
	E 20.10.23 D 13.09.23	RE-ISSUED FOR DA RE-ISSUED FOR DA	GAP DR GAP DR
	E20.10.23D13.09.23C24.01.23	RE-ISSUED FOR DA RE-ISSUED FOR DA ISSUED FOR DA	GAP DR GAP DR GAP CJA
	E20.10.23D13.09.23C24.01.23B20.01.23	RE-ISSUED FOR DA RE-ISSUED FOR DA ISSUED FOR DA ISSUED FOR INFORMATION	GAPDRGAPDRGAPCJAGAPCJA
	E20.10.23D13.09.23C24.01.23B20.01.23A02.12.22	RE-ISSUED FOR DA RE-ISSUED FOR DA ISSUED FOR DA ISSUED FOR INFORMATION ISSUED FOR INFORMATION	GAPDRGAPDRGAPCJAGAPCJAGAPCJA
	E20.10.23D13.09.23C24.01.23B20.01.23	RE-ISSUED FOR DA RE-ISSUED FOR DA ISSUED FOR DA ISSUED FOR INFORMATION ISSUED FOR INFORMATION Description	GAPDRGAPDRGAPCJAGAPCJAGAPCJADrawnAppr
	E20.10.23D13.09.23C24.01.23B20.01.23A02.12.22	RE-ISSUED FOR DA RE-ISSUED FOR DA ISSUED FOR DA ISSUED FOR INFORMATION ISSUED FOR INFORMATION Description infrastructure & developmen	GAPDRGAPDRGAPCJAGAPCJAGAPCJADrawnApprt consulting
	E20.10.23D13.09.23C24.01.23B20.01.23A02.12.22	RE-ISSUED FOR DA RE-ISSUED FOR DA ISSUED FOR DA ISSUED FOR INFORMATION ISSUED FOR INFORMATION Description infrastructure & developmen Suite 8.01, 56 Clarence Stree	GAPDRGAPDRGAPCJAGAPCJAGAPCJADrawnApprt consulting
	E20.10.23D13.09.23C24.01.23B20.01.23A02.12.22	RE-ISSUED FOR DA RE-ISSUED FOR DA ISSUED FOR DA ISSUED FOR INFORMATION ISSUED FOR INFORMATION Description infrastructure & developmen Suite 8.01, 56 Clarence Stree	GAPDRGAPDRGAPCJAGAPCJAGAPCJADrawnApprt consulting
	E       20.10.23         D       13.09.23         C       24.01.23         B       20.01.23         A       02.12.22         Rev       Date	RE-ISSUED FOR DA RE-ISSUED FOR DA ISSUED FOR DA ISSUED FOR INFORMATION ISSUED FOR INFORMATION Description infrastructure & developmen Suite 8.01, 56 Clarence Stree Sydney, NSW 2000 e admin@idcaus.com w www.idcaus.com	GAPDRGAPDRGAPCJAGAPCJAGAPCJADrawnApprt consulting
	E       20.10.23         D       13.09.23         C       24.01.23         B       20.01.23         A       02.12.22         Rev       Date	RE-ISSUED FOR DA RE-ISSUED FOR DA ISSUED FOR DA ISSUED FOR INFORMATION ISSUED FOR INFORMATION Description infrastructure & developmen Suite 8.01, 56 Clarence Stree	GAPDRGAPDRGAPCJAGAPCJAGAPCJADrawnApprt consulting
	E       20.10.23         D       13.09.23         C       24.01.23         B       20.01.23         A       02.12.22         Rev       Date	RE-ISSUED FOR DA RE-ISSUED FOR DA ISSUED FOR DA ISSUED FOR INFORMATION ISSUED FOR INFORMATION Description infrastructure & developmen Suite 8.01, 56 Clarence Stree Sydney, NSW 2000 e admin@idcaus.com w www.idcaus.com	GAPDRGAPDRGAPCJAGAPCJAGAPCJADrawnApprt consulting
	E 20.10.23 D 13.09.23 C 24.01.23 B 20.01.23 A 02.12.22 Rev Date Oate PROJECT LANDC	RE-ISSUED FOR DA RE-ISSUED FOR DA ISSUED FOR DA ISSUED FOR INFORMATION ISSUED FOR INFORMATION Description infrastructure & development Suite 8.01, 56 Clarence Stree Sydney, NSW 2000 e admin@idcaus.com w www.idcaus.com w www.idcaus.com	GAPDRGAPDRGAPCJAGAPCJADrawnApprApprAppr
	E 20.10.23 D 13.09.23 C 24.01.23 B 20.01.23 A 02.12.22 Rev Date PROJECT LANDC EDMO	RE-ISSUED FOR DA RE-ISSUED FOR DA ISSUED FOR INFORMATION ISSUED FOR INFORMATION Description infrastructure & development Suite 8.01, 56 Clarence Stree Sydney, NSW 2000 e admin@idcaus.com www.idcaus.com COM NDSON PARK PRECINC	GAPDRGAPDRGAPCJAGAPCJADrawnApprApprAppr
	E       20.10.23         D       13.09.23         C       24.01.23         B       20.01.23         A       02.12.22         Rev       Date         Optimization         PROJECT         LANDOC         EDMO       LOT 5	RE-ISSUED FOR DA RE-ISSUED FOR DA ISSUED FOR INFORMATION ISSUED FOR INFORMATION Description infrastructure & developmen Suite 8.01, 56 Clarence Stre Sydney, NSW 2000 e admin@idcaus.com w www.idcaus.com COM NDSON PARK PRECINC DP1272931	GAPDRGAPDRGAPCJAGAPCJADrawnApprApprAppr
	E       20.10.23         D       13.09.23         C       24.01.23         B       20.01.23         A       02.12.22         Rev       Date         Optimization         PROJECT         LANDOC         EDMO       LOT 5	RE-ISSUED FOR DA RE-ISSUED FOR DA ISSUED FOR INFORMATION ISSUED FOR INFORMATION Description infrastructure & development Suite 8.01, 56 Clarence Stree Sydney, NSW 2000 e admin@idcaus.com www.idcaus.com COM NDSON PARK PRECINC	GAPDRGAPDRGAPCJAGAPCJADrawnApprApprAppr
	E       20.10.23         D       13.09.23         C       24.01.23         B       20.01.23         A       02.12.22         Rev       Date         Optimization         PROJECT         LANDOC         EDMO       LOT 5	RE-ISSUED FOR DA RE-ISSUED FOR DA ISSUED FOR INFORMATION ISSUED FOR INFORMATION Description infrastructure & developmen Suite 8.01, 56 Clarence Stre Sydney, NSW 2000 e admin@idcaus.com w www.idcaus.com COM NDSON PARK PRECINC DP1272931	GAPDRGAPDRGAPCJAGAPCJADrawnApprApprAppr
	E 20.10.23 D 13.09.23 C 24.01.23 B 20.01.23 A 02.12.22 Rev Date PROJECT LANDC EDMO LOT 5 CAMPI DRAWING TITLE	RE-ISSUED FOR DA RE-ISSUED FOR DA ISSUED FOR INFORMATION ISSUED FOR INFORMATION Description infrastructure & developmen Suite 8.01, 56 Clarence Stre Sydney, NSW 2000 e admin@idcaus.com w www.idcaus.com COM NDSON PARK PRECINC DP1272931	GAPDRGAPDRGAPCJAGAPCJADrawnApprApprAppr
	E 20.10.23 D 13.09.23 C 24.01.23 B 20.01.23 A 02.12.22 Rev Date PROJECT LANDC EDMO LOT 5 CAMPI DRAWING TITLE	RE-ISSUED FOR DA RE-ISSUED FOR DA ISSUED FOR INFORMATION ISSUED FOR INFORMATION Description Infrastructure & development Suite 8.01, 56 Clarence Strest Sydney, NSW 2000 e admin@idcaus.com www.idcaus.com COM NDSON PARK PRECINCT DP1272931 BELLTOWN ROAD VORKS PLAN	GAPDRGAPDRGAPCJAGAPCJADrawnApprApprAppr
	E 20.10.23 D 13.09.23 C 24.01.23 B 20.01.23 A 02.12.22 Rev Date PROJECT LANDO EDMO LOT 5 CAMPI DRAWING TITLE SITEV	RE-ISSUED FOR DA RE-ISSUED FOR DA ISSUED FOR INFORMATION ISSUED FOR INFORMATION Description Infrastructure & development Suite 8.01, 56 Clarence Strest Sydney, NSW 2000 e admin@idcaus.com www.idcaus.com COM NDSON PARK PRECINCT DP1272931 BELLTOWN ROAD VORKS PLAN	GAPDRGAPDRGAPCJAGAPCJADrawnApprApprAppr
	E 20.10.23 D 13.09.23 C 24.01.23 B 20.01.23 A 02.12.22 Rev Date PROJECT LANDO EDMO LOT 5 CAMPI DRAWING TITLE SITEV	RE-ISSUED FOR DA RE-ISSUED FOR DA ISSUED FOR INFORMATION ISSUED FOR INFORMATION Description Infrastructure & development Suite 8.01, 56 Clarence Strest Sydney, NSW 2000 e admin@idcaus.com www.idcaus.com COM NDSON PARK PRECINCT DP1272931 BELLTOWN ROAD VORKS PLAN	GAPDRGAPDRGAPCJAGAPCJADrawnApprApprAppr
	E 20.10.23 D 13.09.23 C 24.01.23 B 20.01.23 A 02.12.22 Rev Date PROJECT LANDO EDMO LOT 5 CAMPI DRAWING TITLE SITEV SHEET	RE-ISSUED FOR DA RE-ISSUED FOR DA ISSUED FOR INFORMATION ISSUED FOR INFORMATION Description	GAPDRGAPDRGAPCJAGAPCJADrawnApprApprAppr
	E 20.10.23 D 13.09.23 C 24.01.23 B 20.01.23 A 02.12.22 Rev Date PROJECT LANDO EDMO LOT 5 CAMPI DRAWING TITLE SITEV	RE-ISSUED FOR DA RE-ISSUED FOR DA ISSUED FOR INFORMATION ISSUED FOR INFORMATION Description	GAPDRGAPDRGAPCJAGAPCJADrawnApprApprAppr
	E 20.10.23 D 13.09.23 C 24.01.23 B 20.01.23 A 02.12.22 Rev Date PROJECT LANDO EDMO LOT 5 CAMPI DRAWING TITLE SITEV SHEET SCALE 1:25	RE-ISSUED FOR DA RE-ISSUED FOR DA ISSUED FOR INFORMATION ISSUED FOR INFORMATION Description Infrastructure & development Suite 8.01, 56 Clarence Stre Sydney, NSW 2000 e admin@idcaus.com w www.idcaus.com COM NDSON PARK PRECINCT DP1272931 BELLTOWN ROAD CORKS PLAN T 1 O STATUS DA	GAPDRGAPDRGAPCJAGAPCJADrawnApprApprAppr
	E 20.10.23 D 13.09.23 C 24.01.23 B 20.01.23 A 02.12.22 Rev Date PROJECT LANDO EDMO LOT 5 CAMPI DRAWING TITLE SITEV SHEET SCALE 1:25	RE-ISSUED FOR DA RE-ISSUED FOR DA ISSUED FOR INFORMATION ISSUED FOR INFORMATION Description	GAP DR GAP CJA GAP CJA GAP CJA Drawn Appr

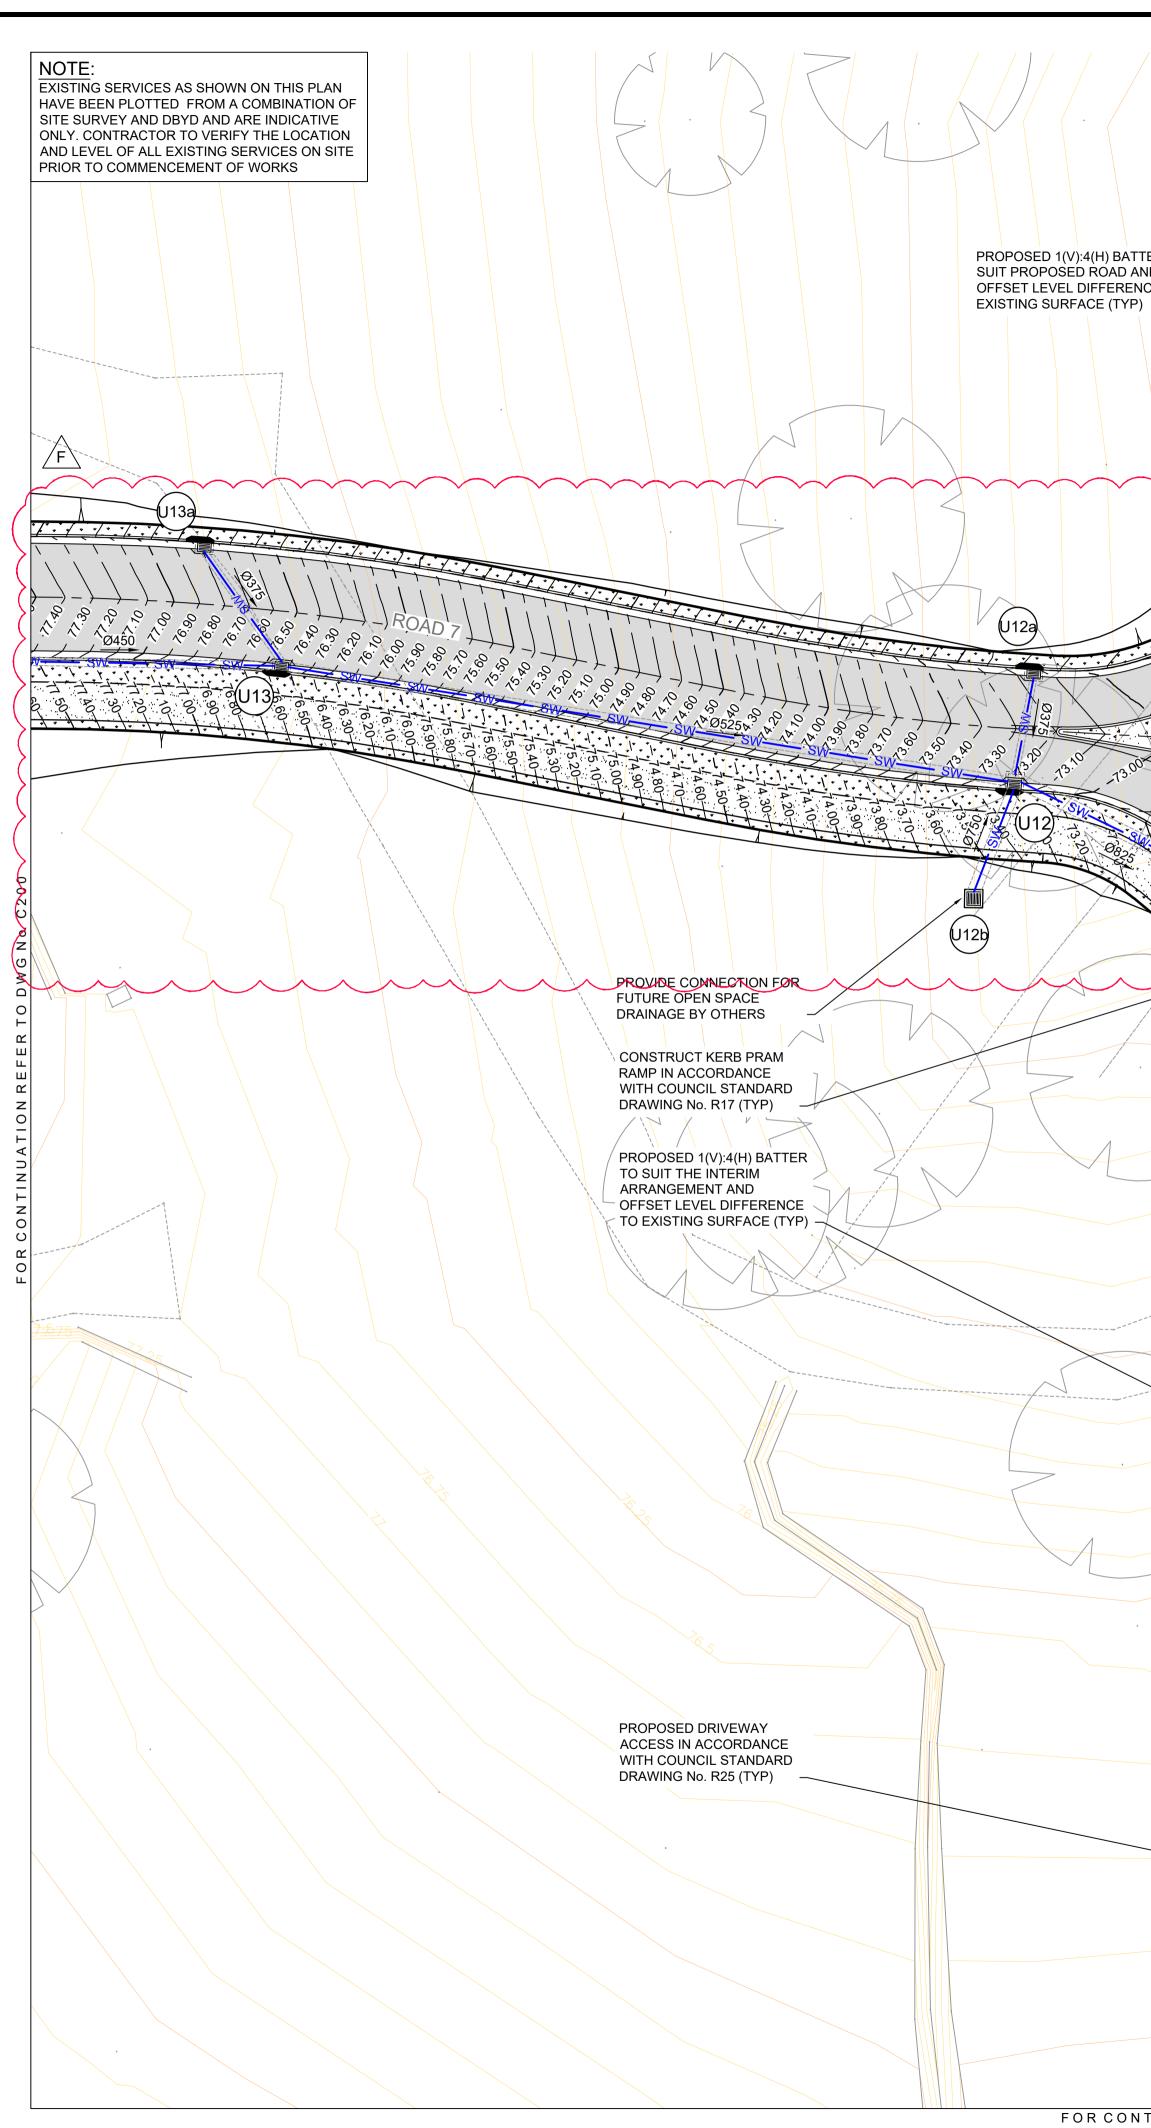



/		/ /	/ / /		FORCONT	INUATION REFE	r to
		SED GABION WALL OR					
TTER TO AND ENCE TO P)	LEVEL I SURFAC	T PROPOSED ROAD AN DIFFERENCE TO EXISTI CE. DETAILS TO BE COI G DETAILED DESIGN PH	ING NFIRMED				
			(U9)		SW-SW-SW- Ø900 ROAD 3	- <u>sw</u> <del>sw</del>	
							11
			0500	-72.40	72.30- 	12.20	
00		72.70	72.70				
		72.80 SN - 72.80	72.80				
5 T3 00-	72.90 0825 SN		73.00				
			73.2073.30	.40			
	73.00 - 1300 + 500	2A		73.50			
. (				73.80 - 73.90 - 74.00 - 74.10 - 74.10 - 74.1			
	2B 13.40 13.50 13.60 13.60	13.00		74.20 74.30 74.30		- (1G) - 	
					Ø225 Ø225 	Ø150	 
	A 100 1013.90	14.10		·74.80 - - ·74.90- ·75.0			
	74.10 730 74.20 74.20 74.30				-75.20		+ -
	× 50. 14.40 × 60. 14.50	-14.50 -14.50 -14.60					
		03351 - 14.80			75.90 76.00		
							· · · ·
•	75.20	57	15.50 15.601 03.37.0 		ROAD 1 - 76.00		
	75.30	-75.40		3B Ø375	3C		
					0319 0319		
			D Ø375				
			80 90 00		76.50		
			20				
			40 8 QV			· · · ·	
N T I N U <i>i</i>	ATION REFER TO DWG No. C	16	60 N N N N N N N N N N N N N N N N N N N				

TO DWG No. C203	LEGEND				
1980					
A					
12.10 12					
72.20					
<h< th=""><th></th><th></th><th></th><th></th><th></th></h<>					
504					
SW-SW-					
Ø150Z					
Ø150					
Ø150	F 27.05.24	RE-ISSUED FOR D		GAP	DR
	E 20.10.23	RE-ISSUED FOR D	A	GAP	DR
Ø150	E 20.10.23 D 13.09.23		A	GAP GAP	DR DR
	E 20.10.23 D 13.09.23	RE-ISSUED FOR D RE-ISSUED FOR D	A	GAP	DR
	E20.10.23D13.09.23C24.01.23	RE-ISSUED FOR D RE-ISSUED FOR D ISSUED FOR DA	A A RMATION	GAP GAP GAP	DR DR CJA
	E20.10.23D13.09.23C24.01.23B20.01.23	RE-ISSUED FOR D RE-ISSUED FOR D ISSUED FOR DA ISSUED FOR INFO	A A RMATION	GAP GAP GAP GAP	DR DR CJA CJA CJA
	E20.10.23D13.09.23C24.01.23B20.01.23A02.12.22	RE-ISSUED FOR D RE-ISSUED FOR D ISSUED FOR DA ISSUED FOR INFO	A A RMATION RMATION	GAP GAP GAP GAP GAP Drawn	DR DR CJA CJA CJA Appr
	E       20.10.23         D       13.09.23         C       24.01.23         B       20.01.23         A       02.12.22         Rev       Date	RE-ISSUED FOR D RE-ISSUED FOR DA ISSUED FOR INFO ISSUED FOR INFO Description	A RMATION RMATION infrastructure & developme Suite 8.01, 56 Clarence St	GAP GAP GAP GAP GAP Drawn	DR DR CJA CJA CJA Appr
	E       20.10.23         D       13.09.23         C       24.01.23         B       20.01.23         A       02.12.22         Rev       Date	RE-ISSUED FOR D RE-ISSUED FOR DA ISSUED FOR INFO ISSUED FOR INFO Description	A RMATION RMATION infrastructure & developme Suite 8.01, 56 Clarence St Sydney, NSW 2000	GAP GAP GAP GAP GAP Drawn	DR DR CJA CJA CJA Appr
	E 20.10.23 D 13.09.23 C 24.01.23 B 20.01.23 A 02.12.22 Rev Date	RE-ISSUED FOR D RE-ISSUED FOR DA ISSUED FOR INFO ISSUED FOR INFO Description	A RMATION RMATION infrastructure & developme Suite 8.01, 56 Clarence St	GAP GAP GAP GAP GAP Drawn	DR DR CJA CJA CJA Appr
	E 20.10.23 D 13.09.23 C 24.01.23 B 20.01.23 A 02.12.22 Rev Date	RE-ISSUED FOR D RE-ISSUED FOR DA ISSUED FOR INFO ISSUED FOR INFO Description	A RMATION RMATION infrastructure & developme Suite 8.01, 56 Clarence St Sydney, NSW 2000 e admin@idcaus.com	GAP GAP GAP GAP GAP Drawn	DR DR CJA CJA CJA Appr
	E 20.10.23 D 13.09.23 C 24.01.23 B 20.01.23 A 02.12.22 Rev Date	RE-ISSUED FOR D RE-ISSUED FOR DA ISSUED FOR INFO ISSUED FOR INFO Description	A RMATION RMATION infrastructure & developme Suite 8.01, 56 Clarence St Sydney, NSW 2000 e admin@idcaus.com	GAP GAP GAP GAP GAP Drawn	DR DR CJA CJA CJA Appr
	E 20.10.23 D 13.09.23 C 24.01.23 B 20.01.23 A 02.12.22 Rev Date Oate PROJECT LANDC	RE-ISSUED FOR D RE-ISSUED FOR DA ISSUED FOR INFO ISSUED FOR INFO Description	A RMATION RMATION infrastructure & developme Suite 8.01, 56 Clarence St Sydney, NSW 2000 e admin@idcaus.com w www.idcaus.com	GAP GAP GAP GAP Drawn	DR DR CJA CJA CJA Appr
	E 20.10.23 D 13.09.23 C 24.01.23 B 20.01.23 A 02.12.22 Rev Date Oate PROJECT LANDC EDMO	RE-ISSUED FOR D RE-ISSUED FOR DA ISSUED FOR INFO ISSUED FOR INFO Description	A RMATION RMATION infrastructure & developme Suite 8.01, 56 Clarence St Sydney, NSW 2000 e admin@idcaus.com w www.idcaus.com	GAP GAP GAP GAP Drawn	DR DR CJA CJA CJA Appr
	E 20.10.23 D 13.09.23 C 24.01.23 B 20.01.23 A 02.12.22 Rev Date PROJECT LANDC EDMOR LOT 5	RE-ISSUED FOR D RE-ISSUED FOR DA ISSUED FOR INFO ISSUED FOR INFO Description	A RMATION RMATION infrastructure & developme Suite 8.01, 56 Clarence St Sydney, NSW 2000 e admin@idcaus.com w www.idcaus.com	GAP GAP GAP GAP Drawn	DR DR CJA CJA CJA Appr
	E 20.10.23 D 13.09.23 C 24.01.23 B 20.01.23 A 02.12.22 Rev Date PROJECT LANDC EDMOR LOT 5	RE-ISSUED FOR D RE-ISSUED FOR DA ISSUED FOR INFO ISSUED FOR INFO Description	A RMATION RMATION infrastructure & developme Suite 8.01, 56 Clarence St Sydney, NSW 2000 e admin@idcaus.com w www.idcaus.com	GAP GAP GAP GAP Drawn	DR DR CJA CJA CJA Appr
	E 20.10.23 D 13.09.23 C 24.01.23 B 20.01.23 A 02.12.22 Rev Date PROJECT LANDC EDMON LOT 5 CAMPE	RE-ISSUED FOR D RE-ISSUED FOR DA ISSUED FOR INFO ISSUED FOR INFO Description	A RMATION RMATION infrastructure & developme Suite 8.01, 56 Clarence St Sydney, NSW 2000 e admin@idcaus.com w www.idcaus.com	GAP GAP GAP GAP Drawn	DR DR CJA CJA CJA Appr
	E 20.10.23 D 13.09.23 C 24.01.23 B 20.01.23 A 02.12.22 Rev Date PROJECT LANDC EDMON LOT 5 CAMPE DRAWING TITLE SITEW	RE-ISSUED FOR D RE-ISSUED FOR DA ISSUED FOR INFO ISSUED FOR INFO Description COM NDSON PA DP127293 SELLTOW ORKS PLA	A RMATION RMATION infrastructure & developme Suite 8.01, 56 Clarence St Sydney, NSW 2000 e admin@idcaus.com w www.idcaus.com	GAP GAP GAP GAP Drawn	DR DR CJA CJA CJA Appr
	E 20.10.23 D 13.09.23 C 24.01.23 B 20.01.23 A 02.12.22 Rev Date PROJECT LANDC EDMON LOT 5 CAMPE	RE-ISSUED FOR D RE-ISSUED FOR DA ISSUED FOR INFO ISSUED FOR INFO Description COM NDSON PA DP127293 SELLTOW ORKS PLA	A RMATION RMATION infrastructure & developme Suite 8.01, 56 Clarence St Sydney, NSW 2000 e admin@idcaus.com w www.idcaus.com	GAP GAP GAP GAP Drawn	DR DR CJA CJA CJA Appr
	E 20.10.23 D 13.09.23 C 24.01.23 B 20.01.23 A 02.12.22 Rev Date PROJECT LANDC EDMON LOT 5 CAMPE DRAWING TITLE SITEW	RE-ISSUED FOR D RE-ISSUED FOR DA ISSUED FOR INFO ISSUED FOR INFO Description COM NDSON PA DP127293 SELLTOW ORKS PLA	A RMATION RMATION infrastructure & developme Suite 8.01, 56 Clarence St Sydney, NSW 2000 e admin@idcaus.com w www.idcaus.com	GAP GAP GAP GAP Drawn	DR DR CJA CJA CJA Appr
	E 20.10.23 D 13.09.23 C 24.01.23 B 20.01.23 A 02.12.22 Rev Date PROJECT LANDC EDMON LOT 5 CAMPE DRAWING TITLE SITEW SHEET	RE-ISSUED FOR D RE-ISSUED FOR DA ISSUED FOR INFO ISSUED FOR INFO Description COM NDSON PA DP127293 SELLTOW ORKS PLA	A RMATION RMATION infrastructure & developme Suite 8.01, 56 Clarence St Sydney, NSW 2000 e admin@idcaus.com w www.idcaus.com	GAP GAP GAP GAP Drawn	DR DR CJA CJA CJA Appr
	E 20.10.23 D 13.09.23 C 24.01.23 B 20.01.23 A 02.12.22 Rev Date PROJECT LANDC EDMON LOT 5 CAMPE DRAWING TITLE SITEW SHEET	RE-ISSUED FOR D RE-ISSUED FOR DA ISSUED FOR INFO ISSUED FOR INFO Description COM SOM SOM SP127293 SELLTOW ORKS PLA 2	A RMATION RMATION infrastructure & developme Suite 8.01, 56 Clarence St Sydney, NSW 2000 e admin@idcaus.com w www.idcaus.com	GAP GAP GAP GAP Drawn	DR DR CJA CJA CJA Appr
	E 20.10.23 D 13.09.23 C 24.01.23 B 20.01.23 A 02.12.22 Rev Date PROJECT LANDC EDMON LOT 5 CAMPE DRAWING TITLE SITEW SHEET SCALE 1:250	RE-ISSUED FOR D RE-ISSUED FOR DA ISSUED FOR INFO ISSUED FOR INFO Description COM NDSON PA SP127293 SELLTOW ORKS PLA 2	A RMATION RMATION infrastructure & developme Suite 8.01, 56 Clarence St Sydney, NSW 2000 e admin@idcaus.com w www.idcaus.com	GAP GAP GAP GAP Drawn	DR DR CJA CJA CJA Appr

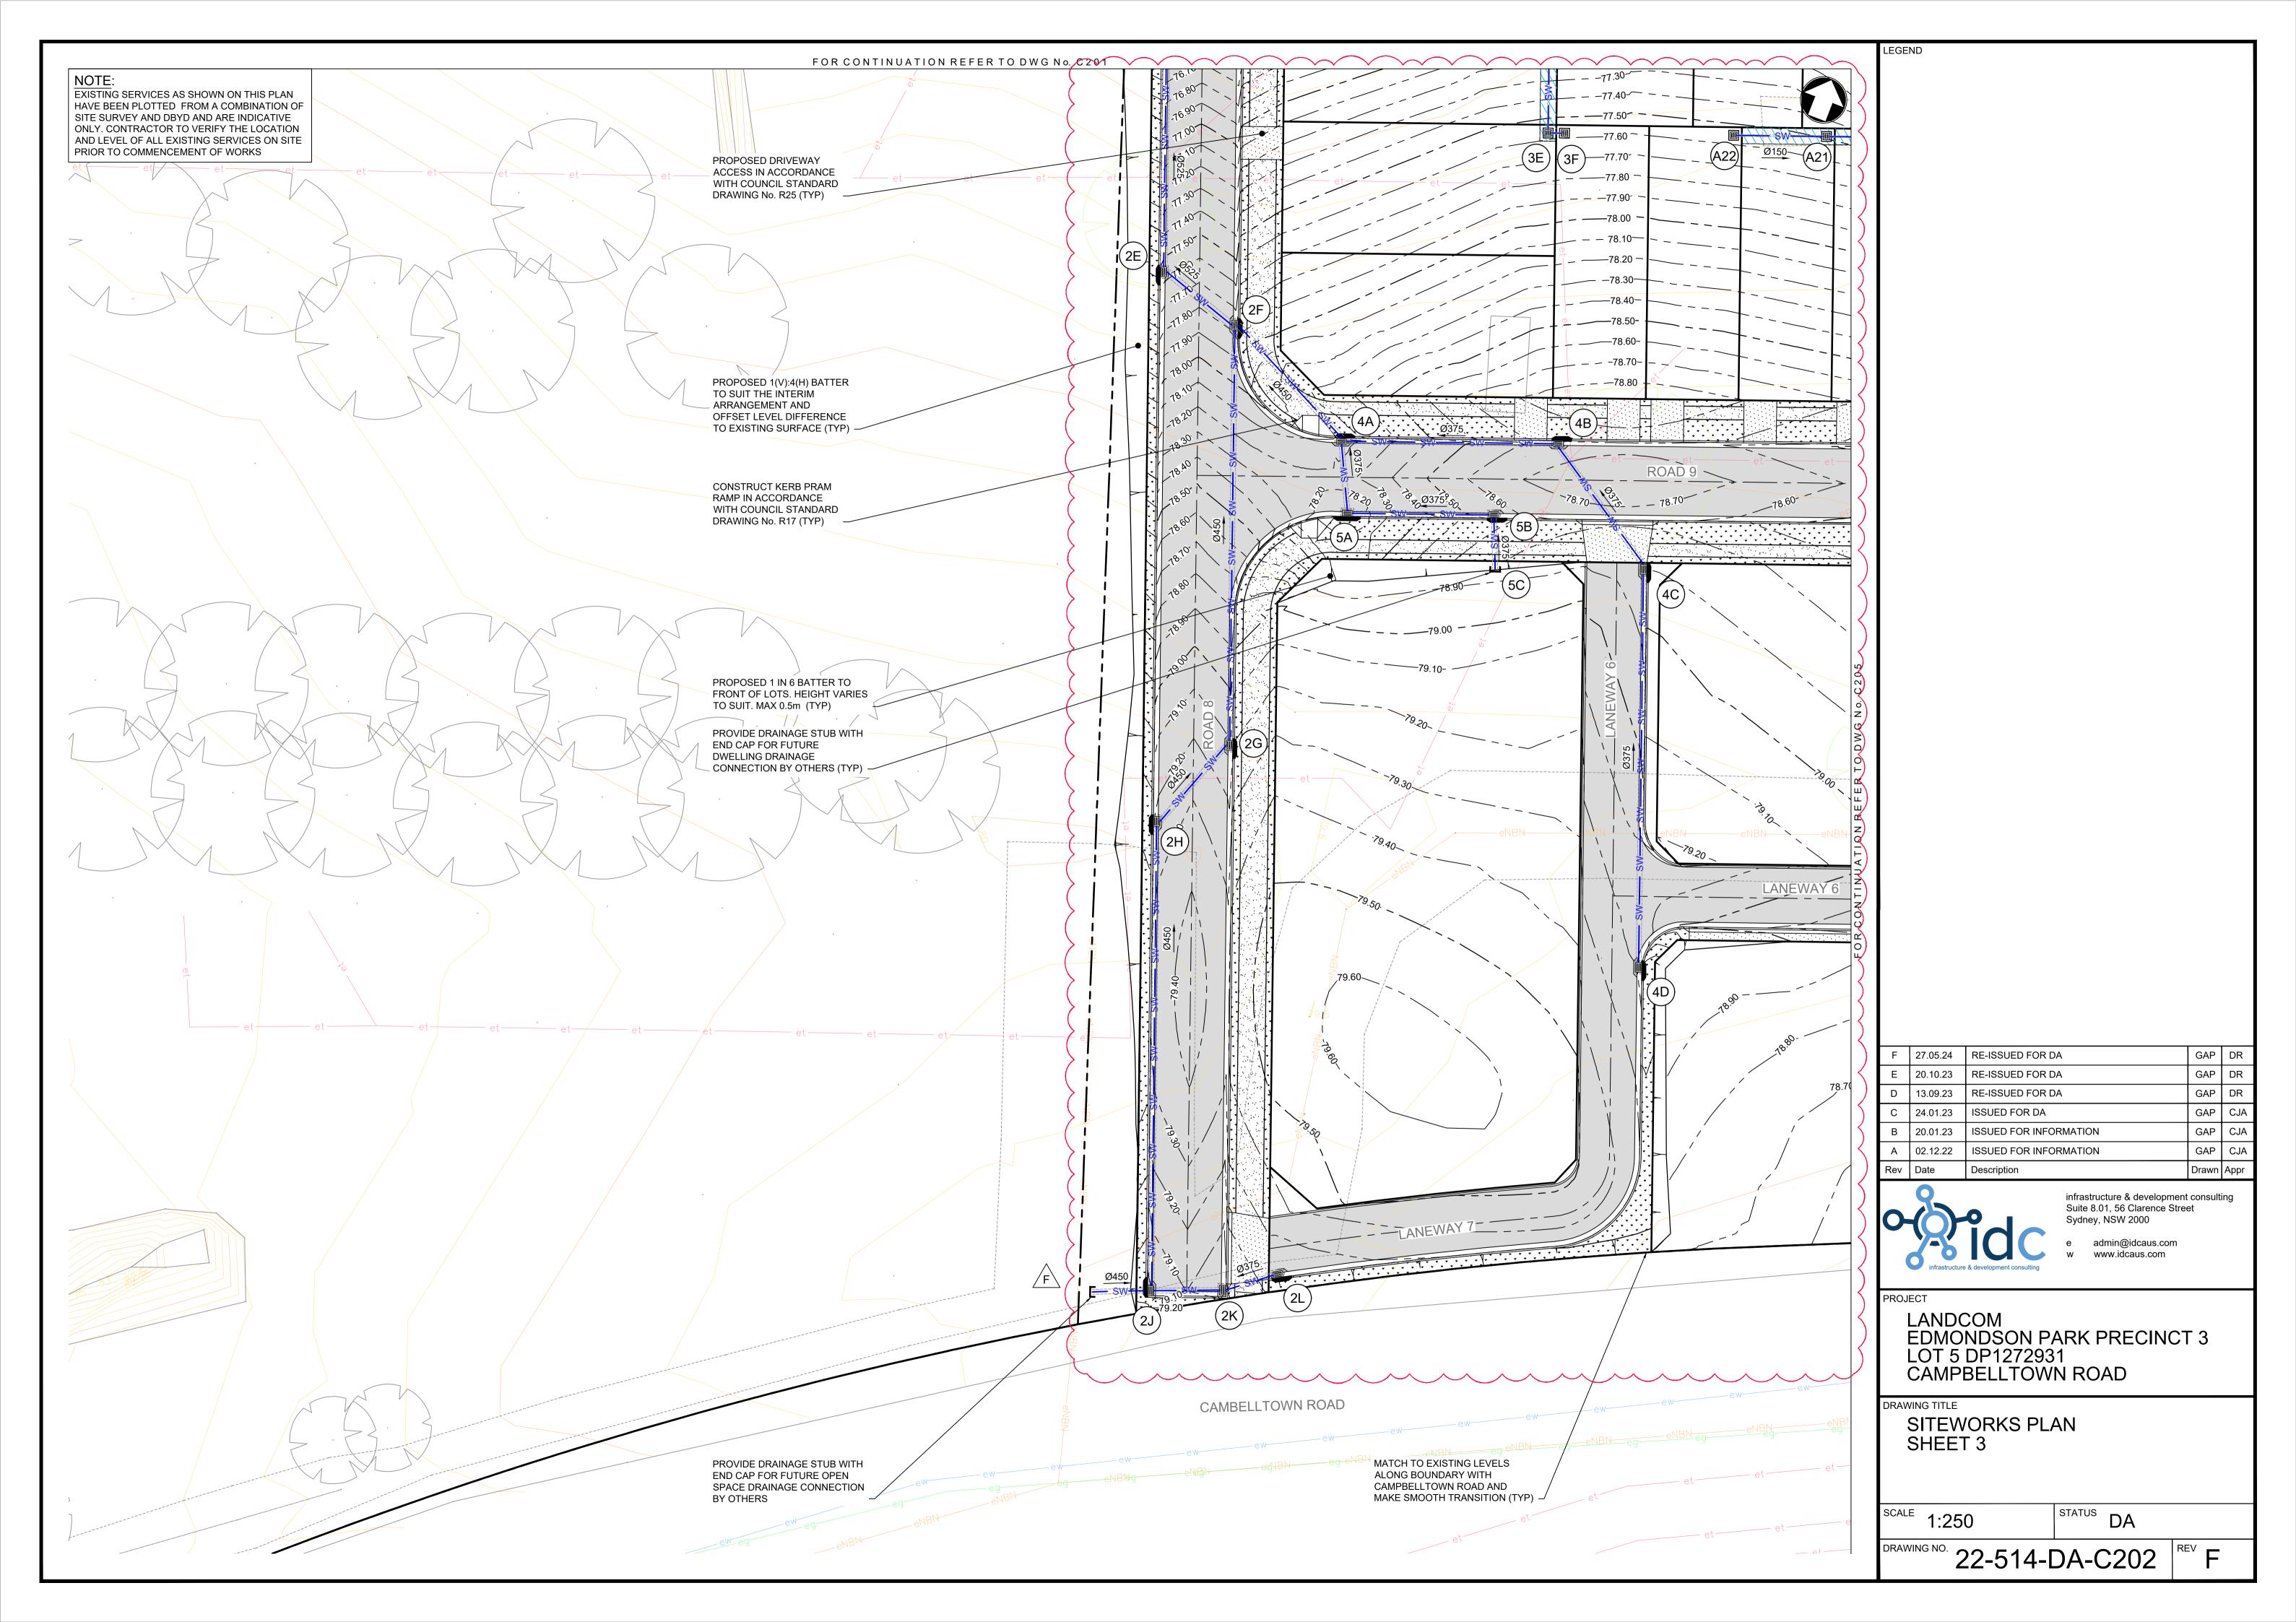


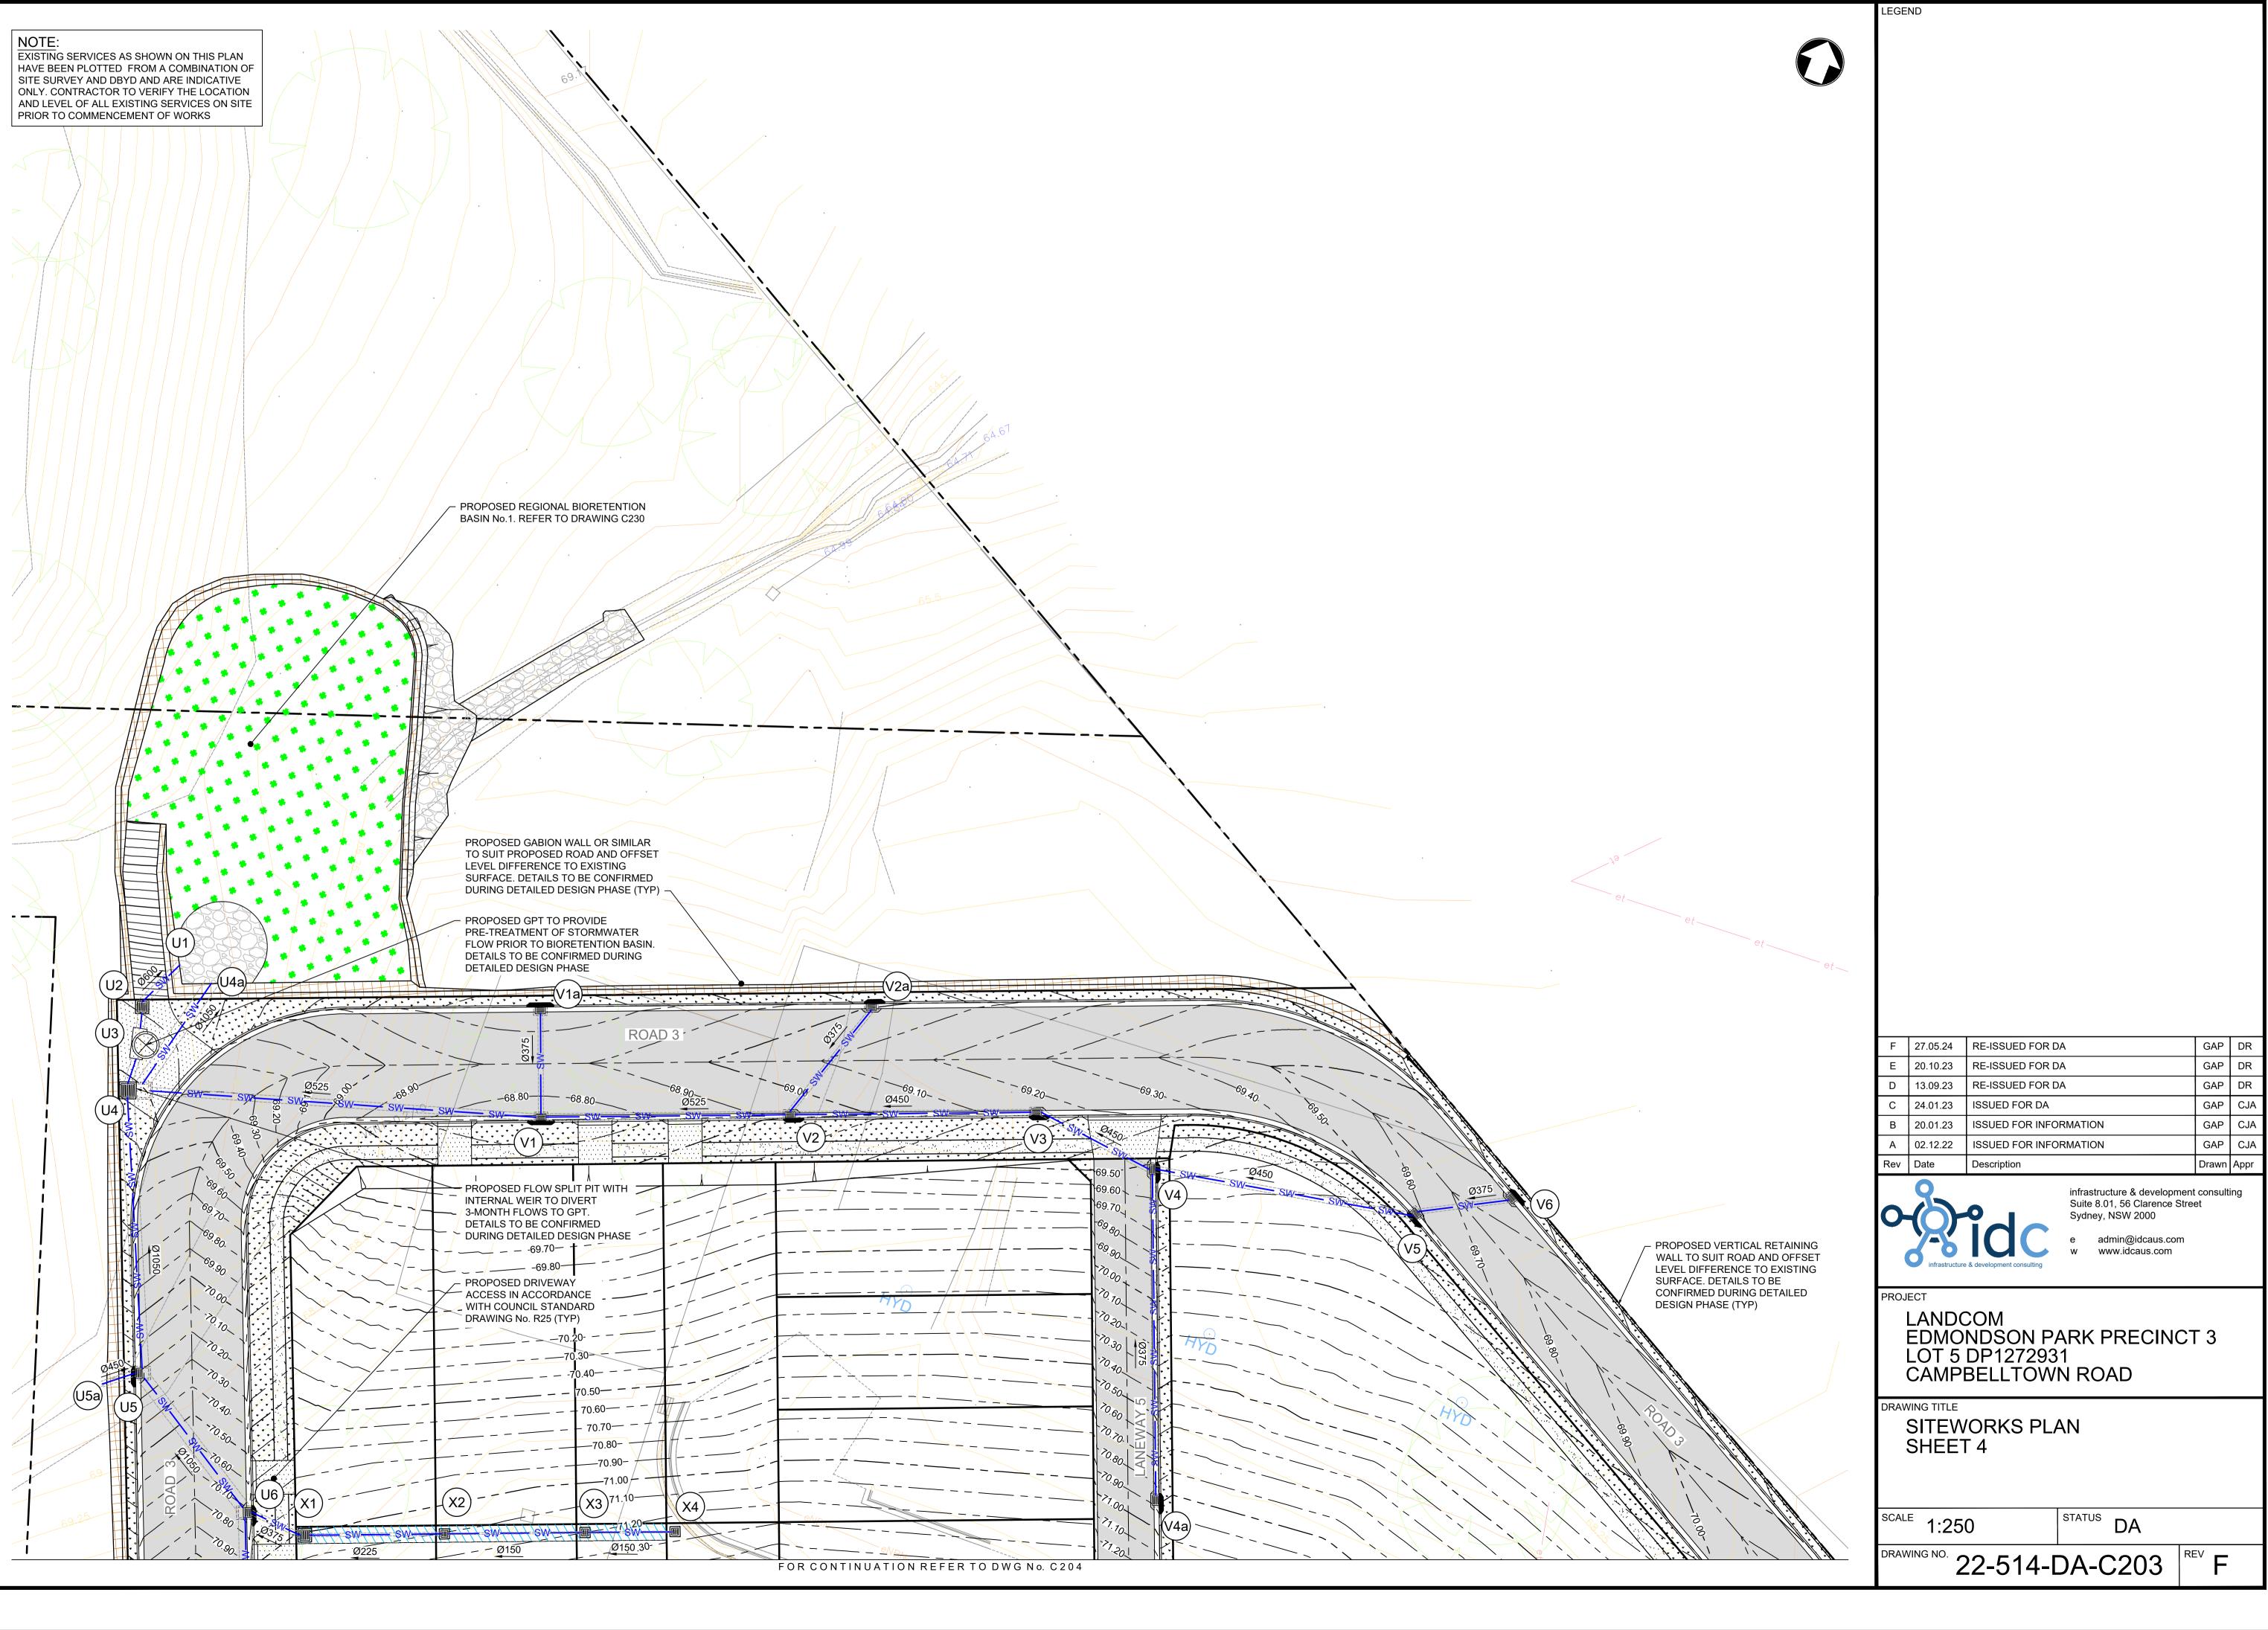

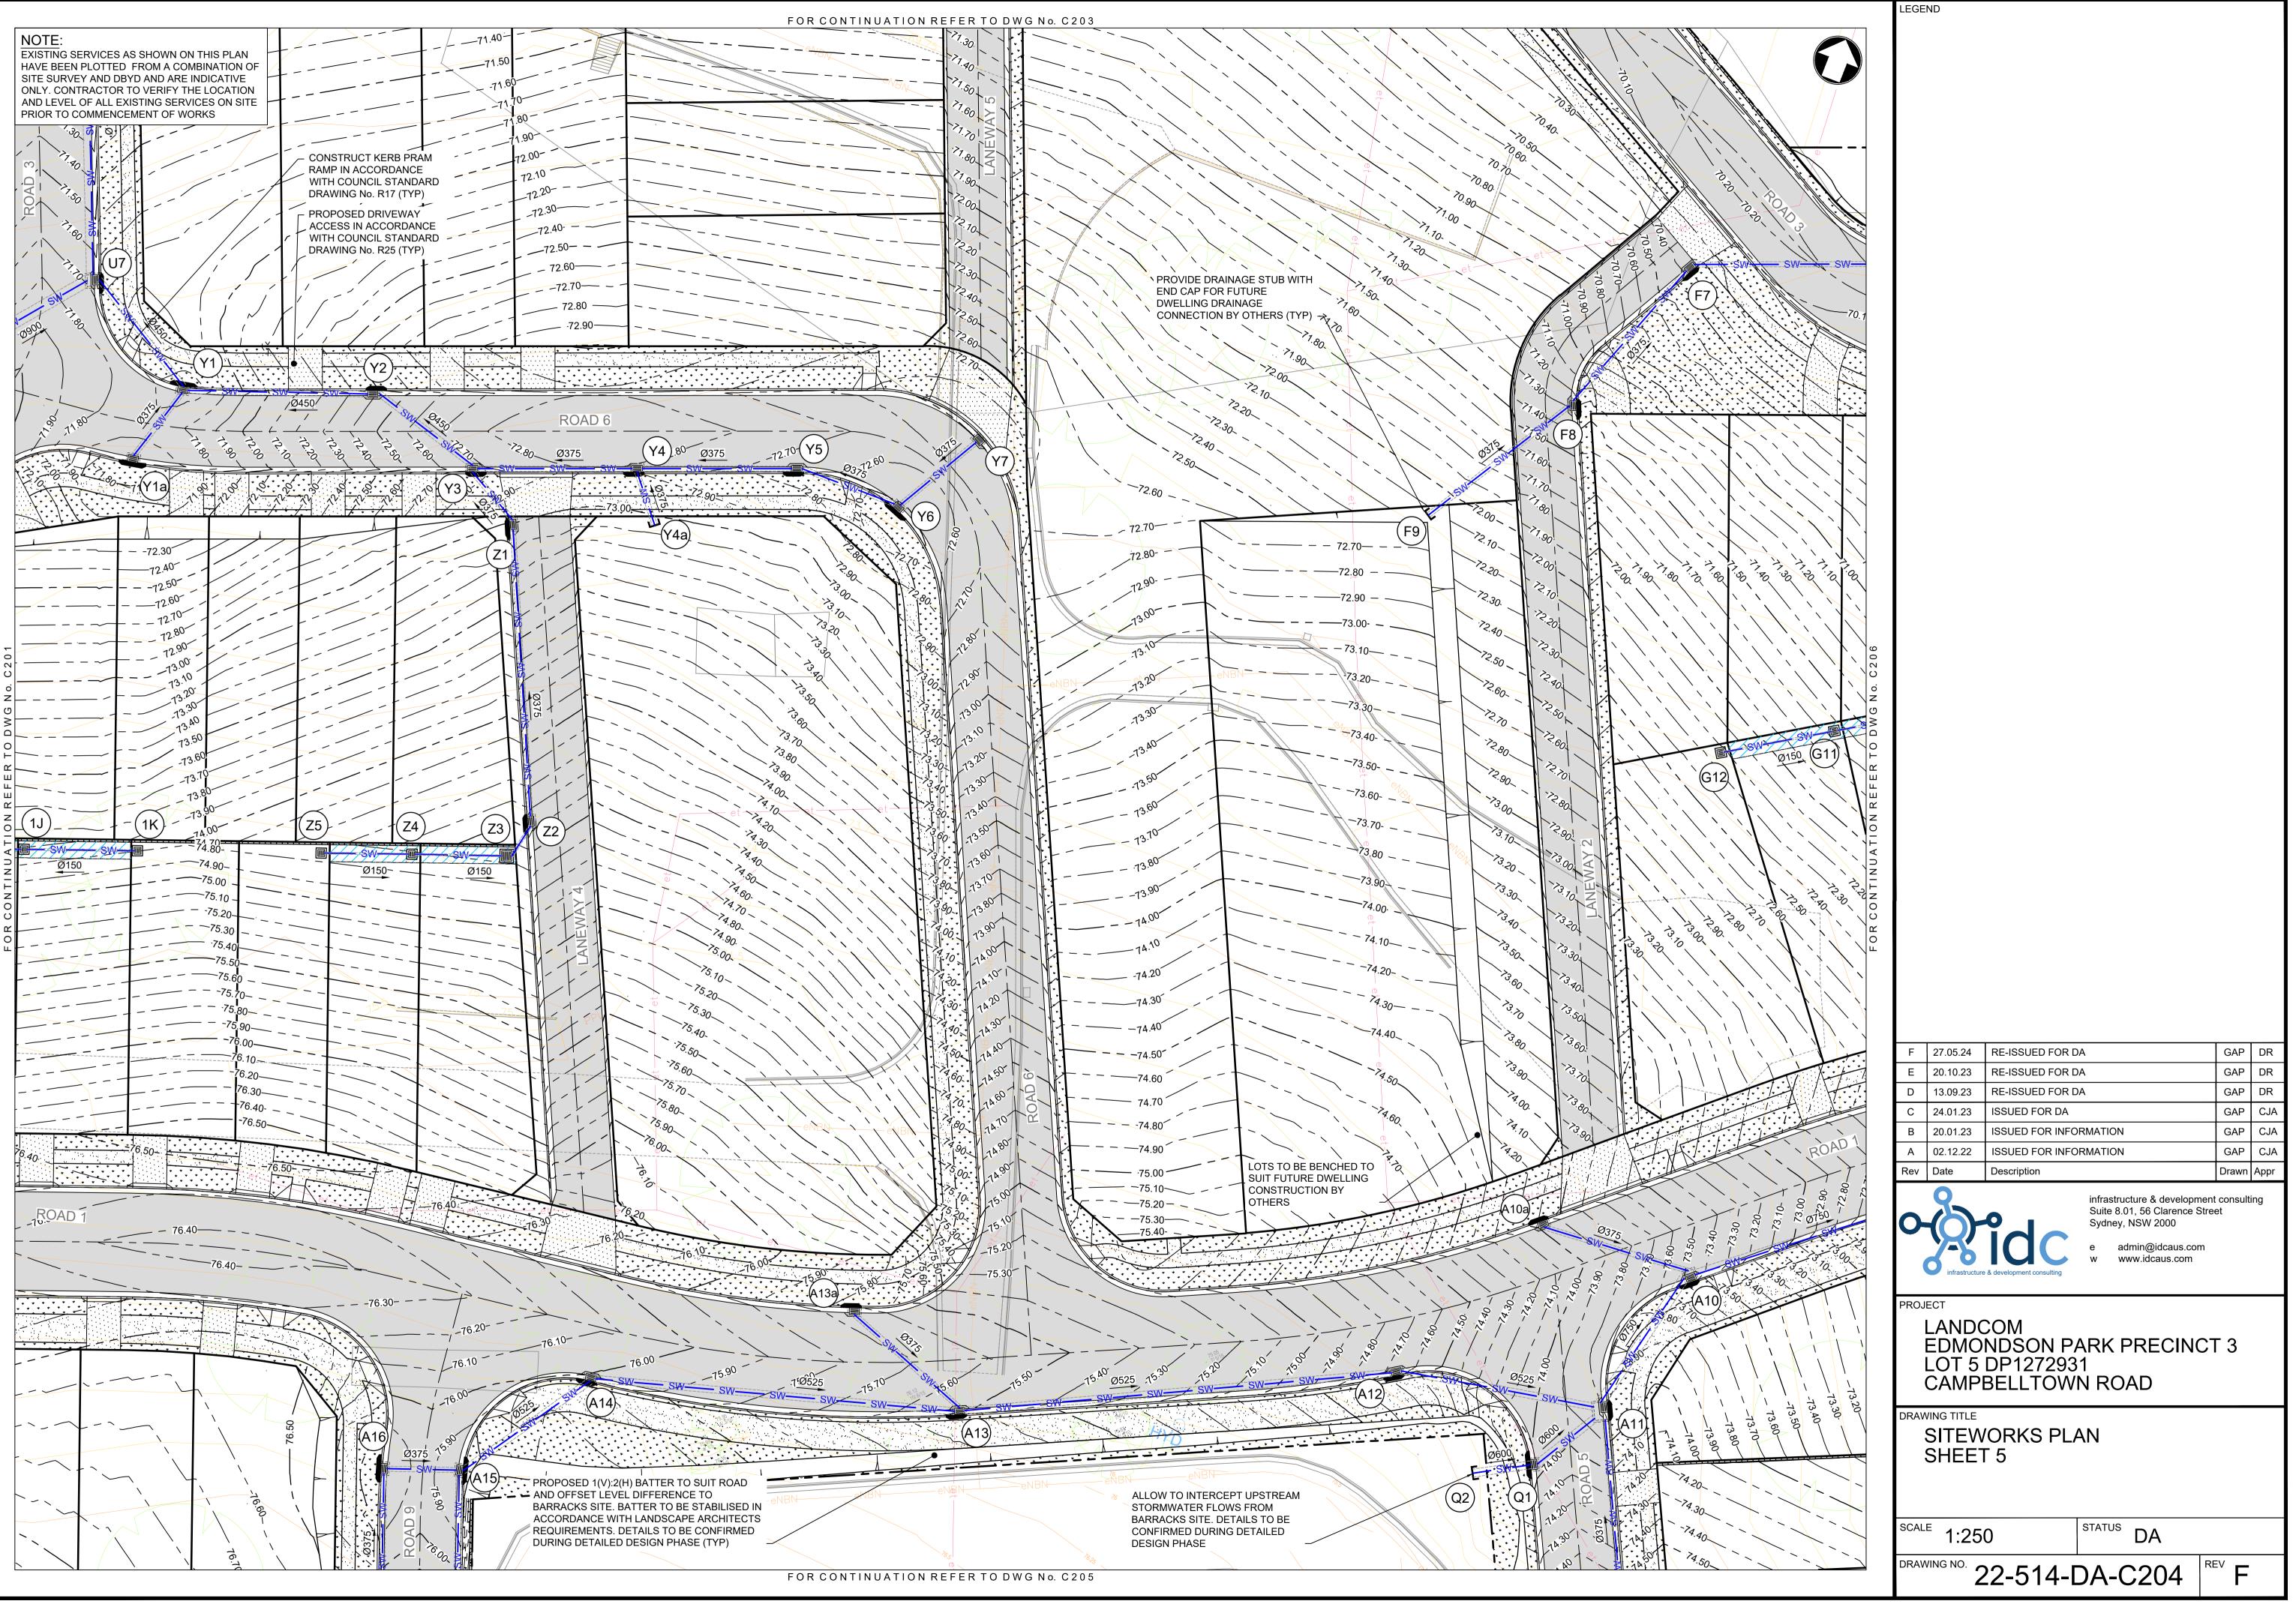


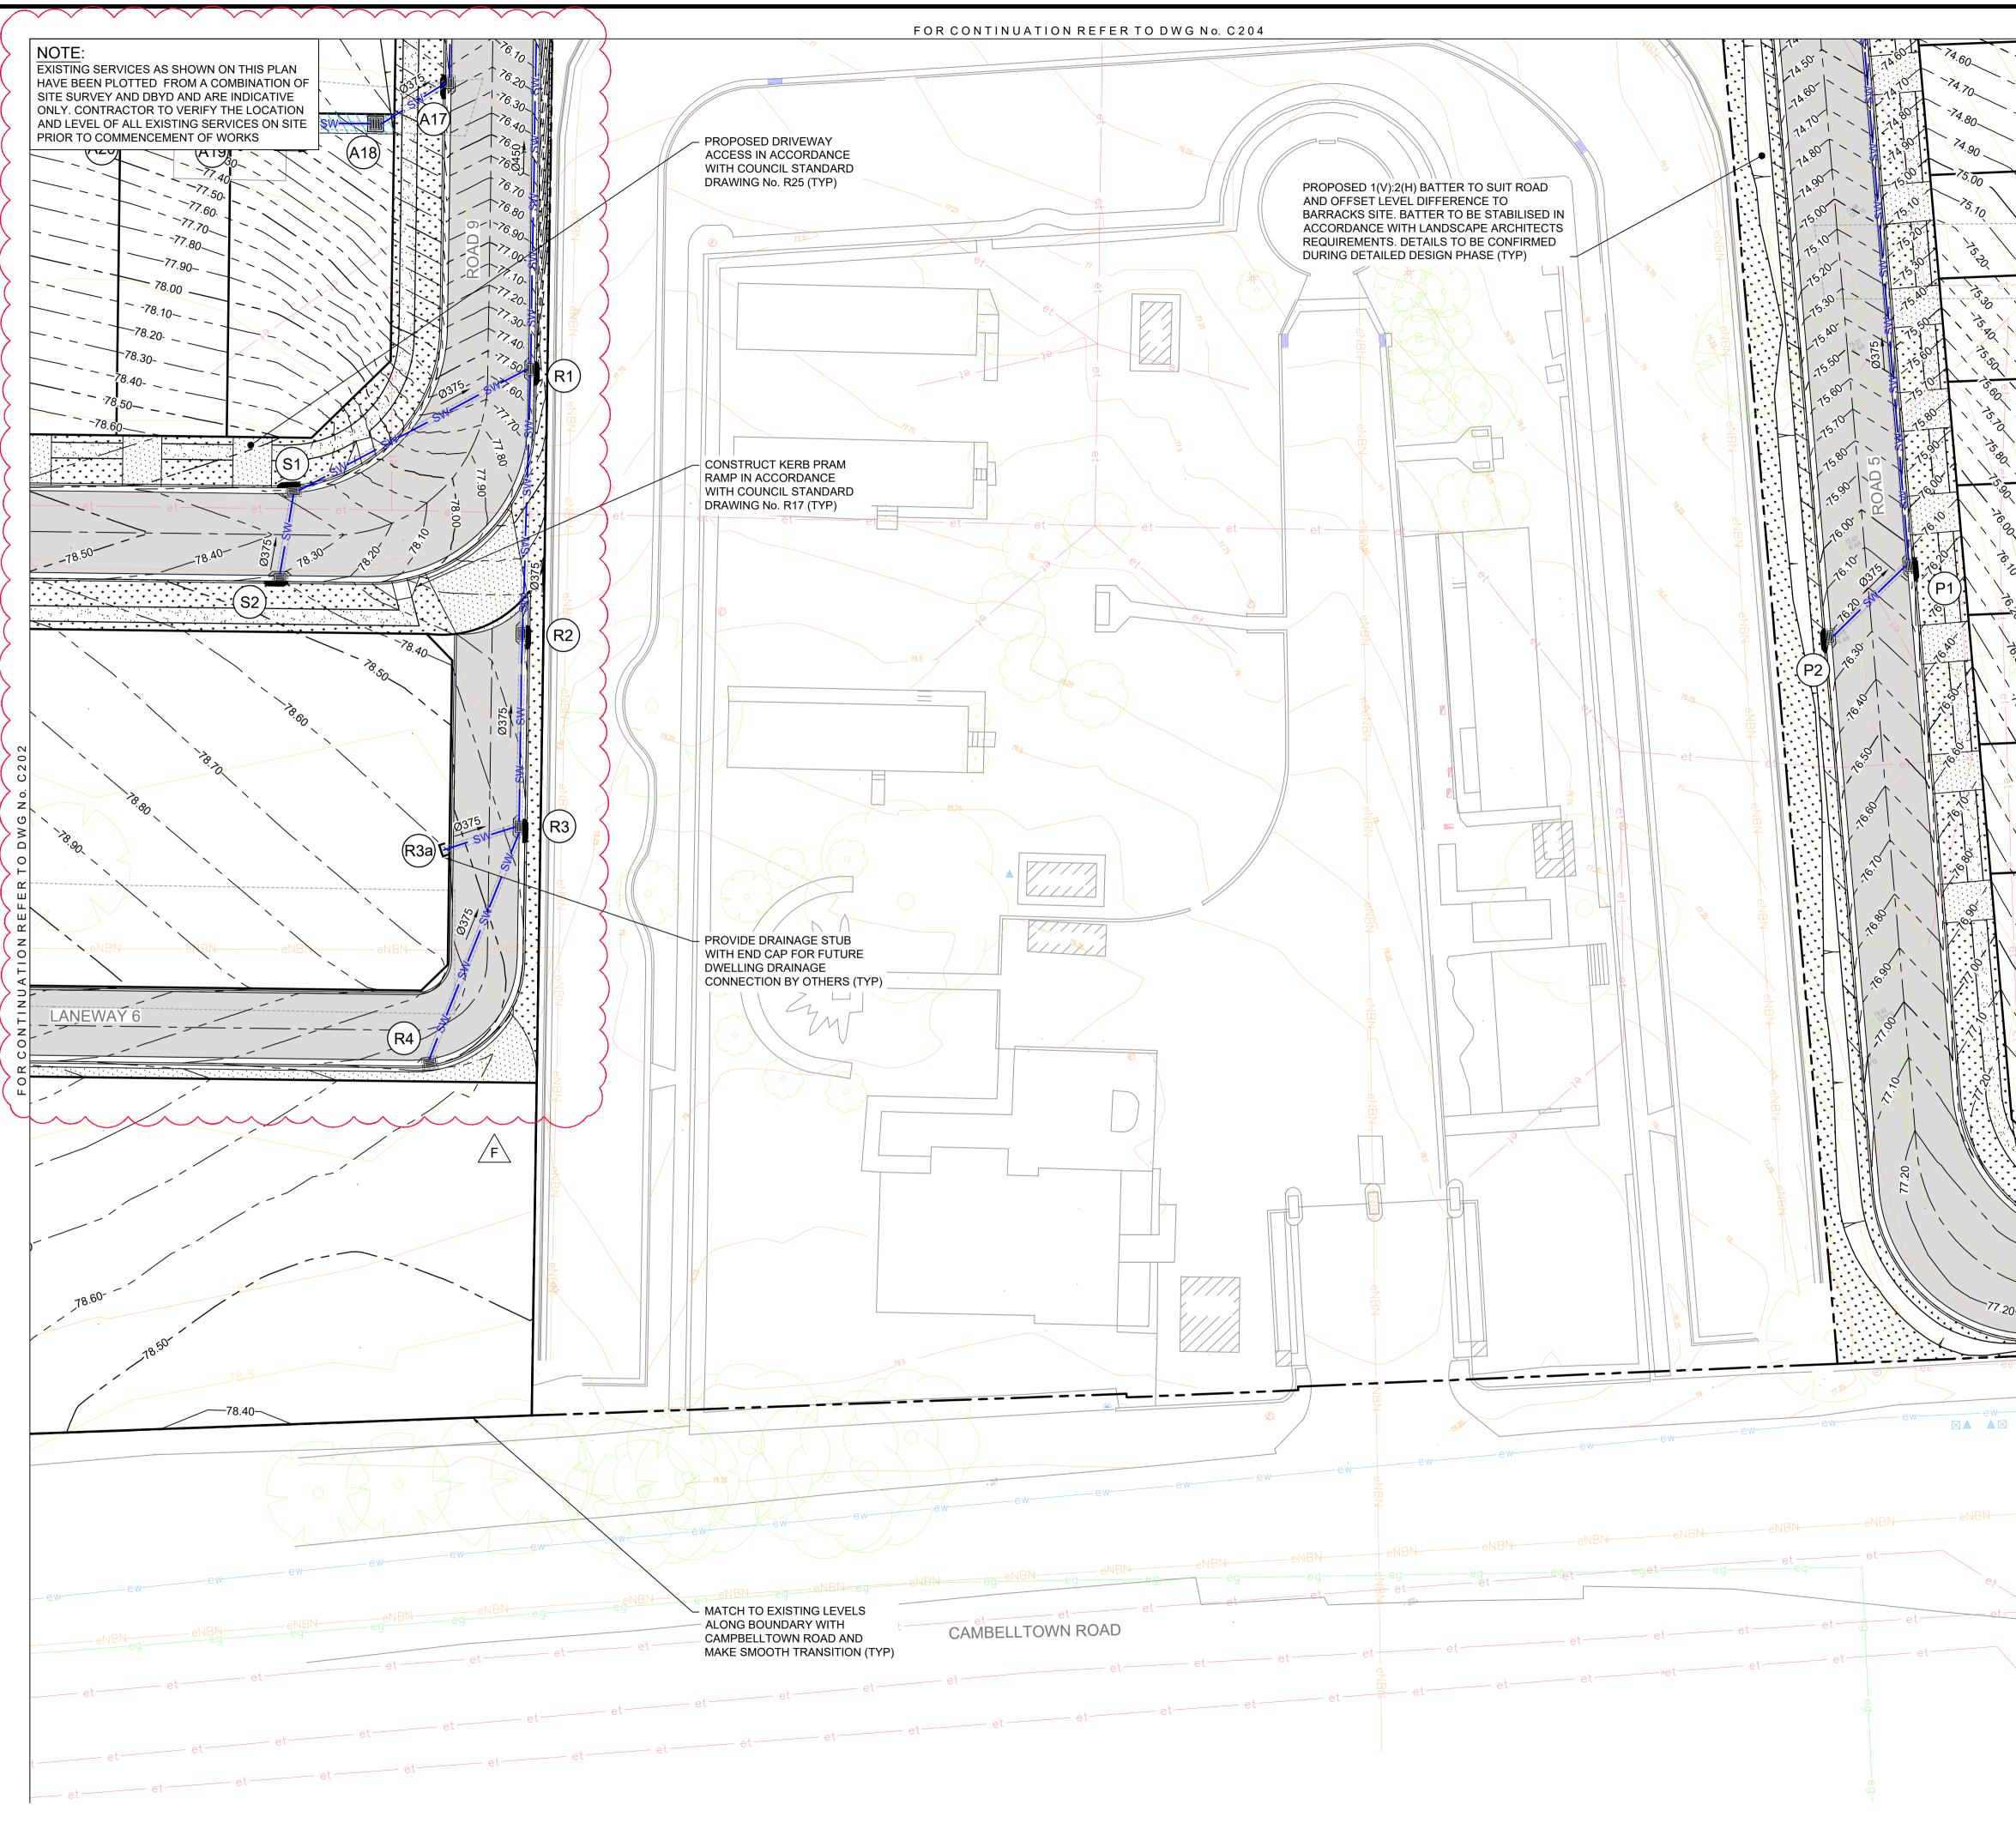


	``,  `, `,						
види         1000         1000         <t< td=""><td></td><td></td><td></td><td></td><td></td><td></td><td></td></t<>							
види         1000         1000         <t< td=""><td></td><td></td><td></td><td></td><td></td><td></td><td></td></t<>							
видинист         ПООТОНИЦИИ           1000000000000000000000000000000000000							
Mill         Mill           0 Mill         Image: Status of the status of t							
MB       MS         MS       MS		C 2 0 7					
Image: Constraint of the second state of the second sta		o Z					
Image: Construction of the second		ТО					
1         1         E F E					
Image: Constraint of the second se	+	z O					
Image: Constraint of the second se	16.98	NUAT					
Image: Constraint of the second se	1, 10,	ONTI					
Image: Constraint of the second state of the second sta		OR C					
F       27.05.24       RE-ISSUED FOR DA       GAP       DR         E       20.10.23       RE-ISSUED FOR DA       GAP       DR         D       13.09.23       RE-ISSUED FOR DA       GAP       DR         C       24.01.23       ISSUED FOR DA       GAP       DR         C       24.01.23       ISSUED FOR DA       GAP       DR         C       24.01.23       ISSUED FOR INFORMATION       GAP       CJA         A       02.12.22       ISSUED FOR INFORMATION       GAP       CJA         A       02.12.22       ISSUED FOR INFORMATION       GAP       CJA         A       02.12.22       ISSUED FOR INFORMATION       GAP       CJA         Rev       Date       Description       Drawn Appr         Infrastructure & development consulting Suite 8.01, 56 Clarence Street Sydney, NSW 2000         ev       admin@idcaus.com       *       *       www.idcaus.com         PROJECT       LANDCOM       EDMONDSON PARK PRECINCT 3       LOT 5 DP1272931       CAMPBELLTOWN ROAD         DRAWING TITLE       SITEWORKS PLAN       SHEET 6       SCALE       11.250       DA	11.20	ш					
F       27.05.24       RE-ISSUED FOR DA       GAP       DR         E       20.10.23       RE-ISSUED FOR DA       GAP       DR         D       13.09.23       RE-ISSUED FOR DA       GAP       DR         C       24.01.23       ISSUED FOR DA       GAP       DR         C       24.01.23       ISSUED FOR DA       GAP       DR         C       24.01.23       ISSUED FOR INFORMATION       GAP       CJA         A       02.12.22       ISSUED FOR INFORMATION       GAP       CJA         A       02.12.22       ISSUED FOR INFORMATION       GAP       CJA         A       02.12.22       ISSUED FOR INFORMATION       GAP       CJA         Rev       Date       Description       Drawn Appr         Infrastructure & development consulting Suite 8.01, 56 Clarence Street Sydney, NSW 2000         ev       admin@idcaus.com       *       *       www.idcaus.com         PROJECT       LANDCOM       EDMONDSON PARK PRECINCT 3       LOT 5 DP1272931       CAMPBELLTOWN ROAD         DRAWING TITLE       SITEWORKS PLAN       SHEET 6       SCALE       11.250       DA							
E       2010.23       RE-ISSUED FOR DA       GAP       DR         D       13.09.23       RE-ISSUED FOR DA       GAP       DR         C       24.01.23       ISSUED FOR DA       GAP       CJA         B       20.01.23       ISSUED FOR INFORMATION       GAP       CJA         A       02.12.22       ISSUED FOR INFORMATION       GAP       CJA         Rev       Date       Description       Drawn Appr         Infrastructure & development consulting Suite 8.01, 56 Clarence Street Sydney, NSW 2000       e       admin@idcaus.com         PROJECT       LANDCOM EDMONDSON PARK PRECINCT 3 LOT 5 DP1272931 CAMPBELLTOWN ROAD       DRAWING TITLE         SITEWORKS PLAN SHEET 6       STATUS       DA							
E       2010.23       RE-ISSUED FOR DA       GAP       DR         D       13.09.23       RE-ISSUED FOR DA       GAP       DR         C       24.01.23       ISSUED FOR DA       GAP       CJA         B       20.01.23       ISSUED FOR INFORMATION       GAP       CJA         A       02.12.22       ISSUED FOR INFORMATION       GAP       CJA         Rev       Date       Description       Drawn Appr         Infrastructure & development consulting Suite 8.01, 56 Clarence Street Sydney, NSW 2000       e       admin@idcaus.com         PROJECT       LANDCOM EDMONDSON PARK PRECINCT 3 LOT 5 DP1272931 CAMPBELLTOWN ROAD       DRAWING TITLE         SITEWORKS PLAN SHEET 6       STATUS       DA				07.05.04			
D       13.09.23       RE-ISSUED FOR DA       GAP       DR         C       24.01.23       ISSUED FOR DA       GAP       CJA         B       20.01.23       ISSUED FOR INFORMATION       GAP       CJA         A       02.12.22       ISSUED FOR INFORMATION       GAP       CJA         Rev       Date       Description       Drawn Appr         Infrastructure & development consulting Suite 8.01, 56 Clarence Street Sydney, NSW 2000       e       admin@idcaus.com         PROJECT       LANDCOM       EDMONDSON PARK PRECINCT 3       OT 5 DP1272931         CAMPBELLTOWN ROAD       DRAWING TITLE       SITEWORKS PLAN         SHEET 6       1:250       STATUS       DA							
B       20.01.23       ISSUED FOR INFORMATION       GAP       CJA         A       02.12.22       ISSUED FOR INFORMATION       GAP       CJA         Rev       Date       Description       Drawn       Appr         Infrastructure & development consulting Suite 8.01, 56 Clarence Street Sydney, NSW 2000       Infrastructure & development consulting Suite 8.01, 56 Clarence Street Sydney, NSW 2000         PROJECT       LANDCOM EDMONDSON PARK PRECINCT 3 LOT 5 DP1272931 CAMPBELLTOWN ROAD         DRAWING TITLE       SITEWORKS PLAN SHEET 6         SCALE       1:250       STATUS         STATUS       DA							
A       02.12.22       ISSUED FOR INFORMATION       GAP       C.JA         Rev       Date       Description       Drawn Appr         Infrastructure & development consulting       Suite 8.01, 56 Clarence Street       Sydney, NSW 2000         e       admin@idcaus.com       www.idcaus.com         PROJECT       LANDCOM       EDMONDSON PARK PRECINCT 3         LOT 5 DP1272931       CAMPBELLTOWN ROAD         DRAWING TITLE       SITEWORKS PLAN         SHEET 6       STATUS			С		ISSUED FOR DA	GAP	CJA
Rev       Date       Description       Drawn       Appr         ew       ew       infrastructure & development consulting Suite 8.01, 56 Clarence Street Sydney, NSW 2000       infrastructure & development consulting Suite 8.01, 56 Clarence Street Sydney, NSW 2000         e       et       et       infrastructure & development consulting         PROJECT       LANDCOM EDMONDSON PARK PRECINCT 3 LOT 5 DP1272931 CAMPBELLTOWN ROAD         DRAWING TITLE       SITEWORKS PLAN SHEET 6         SCALE       1:250       STATUS         DA       DA			В	20.01.23	ISSUED FOR INFORMATION	GAP	
even even et CAMPBELLTOWN ROAD DRAWING TITLE SITEWORKS PLAN SCALE 1:250 STATUS DA SUIte 8.01, 56 Clarence Street Sydney, NSW 2000 e admin@idcaus.com www.idcaus.com www.idcaus.com www.idcaus.com W SUITE SUITE SUITE STATUS DA	ee		Rev				
PROJECT LANDCOM EDMONDSON PARK PRECINCT 3 LOT 5 DP1272931 CAMPBELLTOWN ROAD DRAWING TITLE SITEWORKS PLAN SHEET 6 SCALE 1:250 STATUS DA	ew		0-	Š	Suite 8.01, 56 Clarence Stree	: consulti et	ng
PROJECT LANDCOM EDMONDSON PARK PRECINCT 3 LOT 5 DP1272931 CAMPBELLTOWN ROAD DRAWING TITLE SITEWORKS PLAN SHEET 6 SCALE 1:250 STATUS DA	0 ct						
et et et et et EDMONDSON PARK PRECINCT 3 LOT 5 DP1272931 CAMPBELLTOWN ROAD DRAWING TITLE SITEWORKS PLAN SHEET 6 SCALE 1:250 STATUS DA			PROJ				
et et CAMPBELLTOWN ROAD DRAWING TITLE SITEWORKS PLAN SHEET 6 SCALE 1:250 STATUS DA	• eNBN					ГО	
et     DRAWING TITLE       SITEWORKS PLAN       SHEET 6       SCALE     1:250       STATUS       DRAWING TITLE				LOT 5	DP1272931	13	
SITEWORKS PLAN SHEET 6 SCALE 1:250 STATUS DA	et—						
SCALE 1:250 STATUS DA	et			SITEW			
1:250 DA	°7			SHEEI	6		
1:250 DA							
^{REV} F				1:25	0 DA	-\/	
			DRAW		22-514-DA-C205	F ∎	

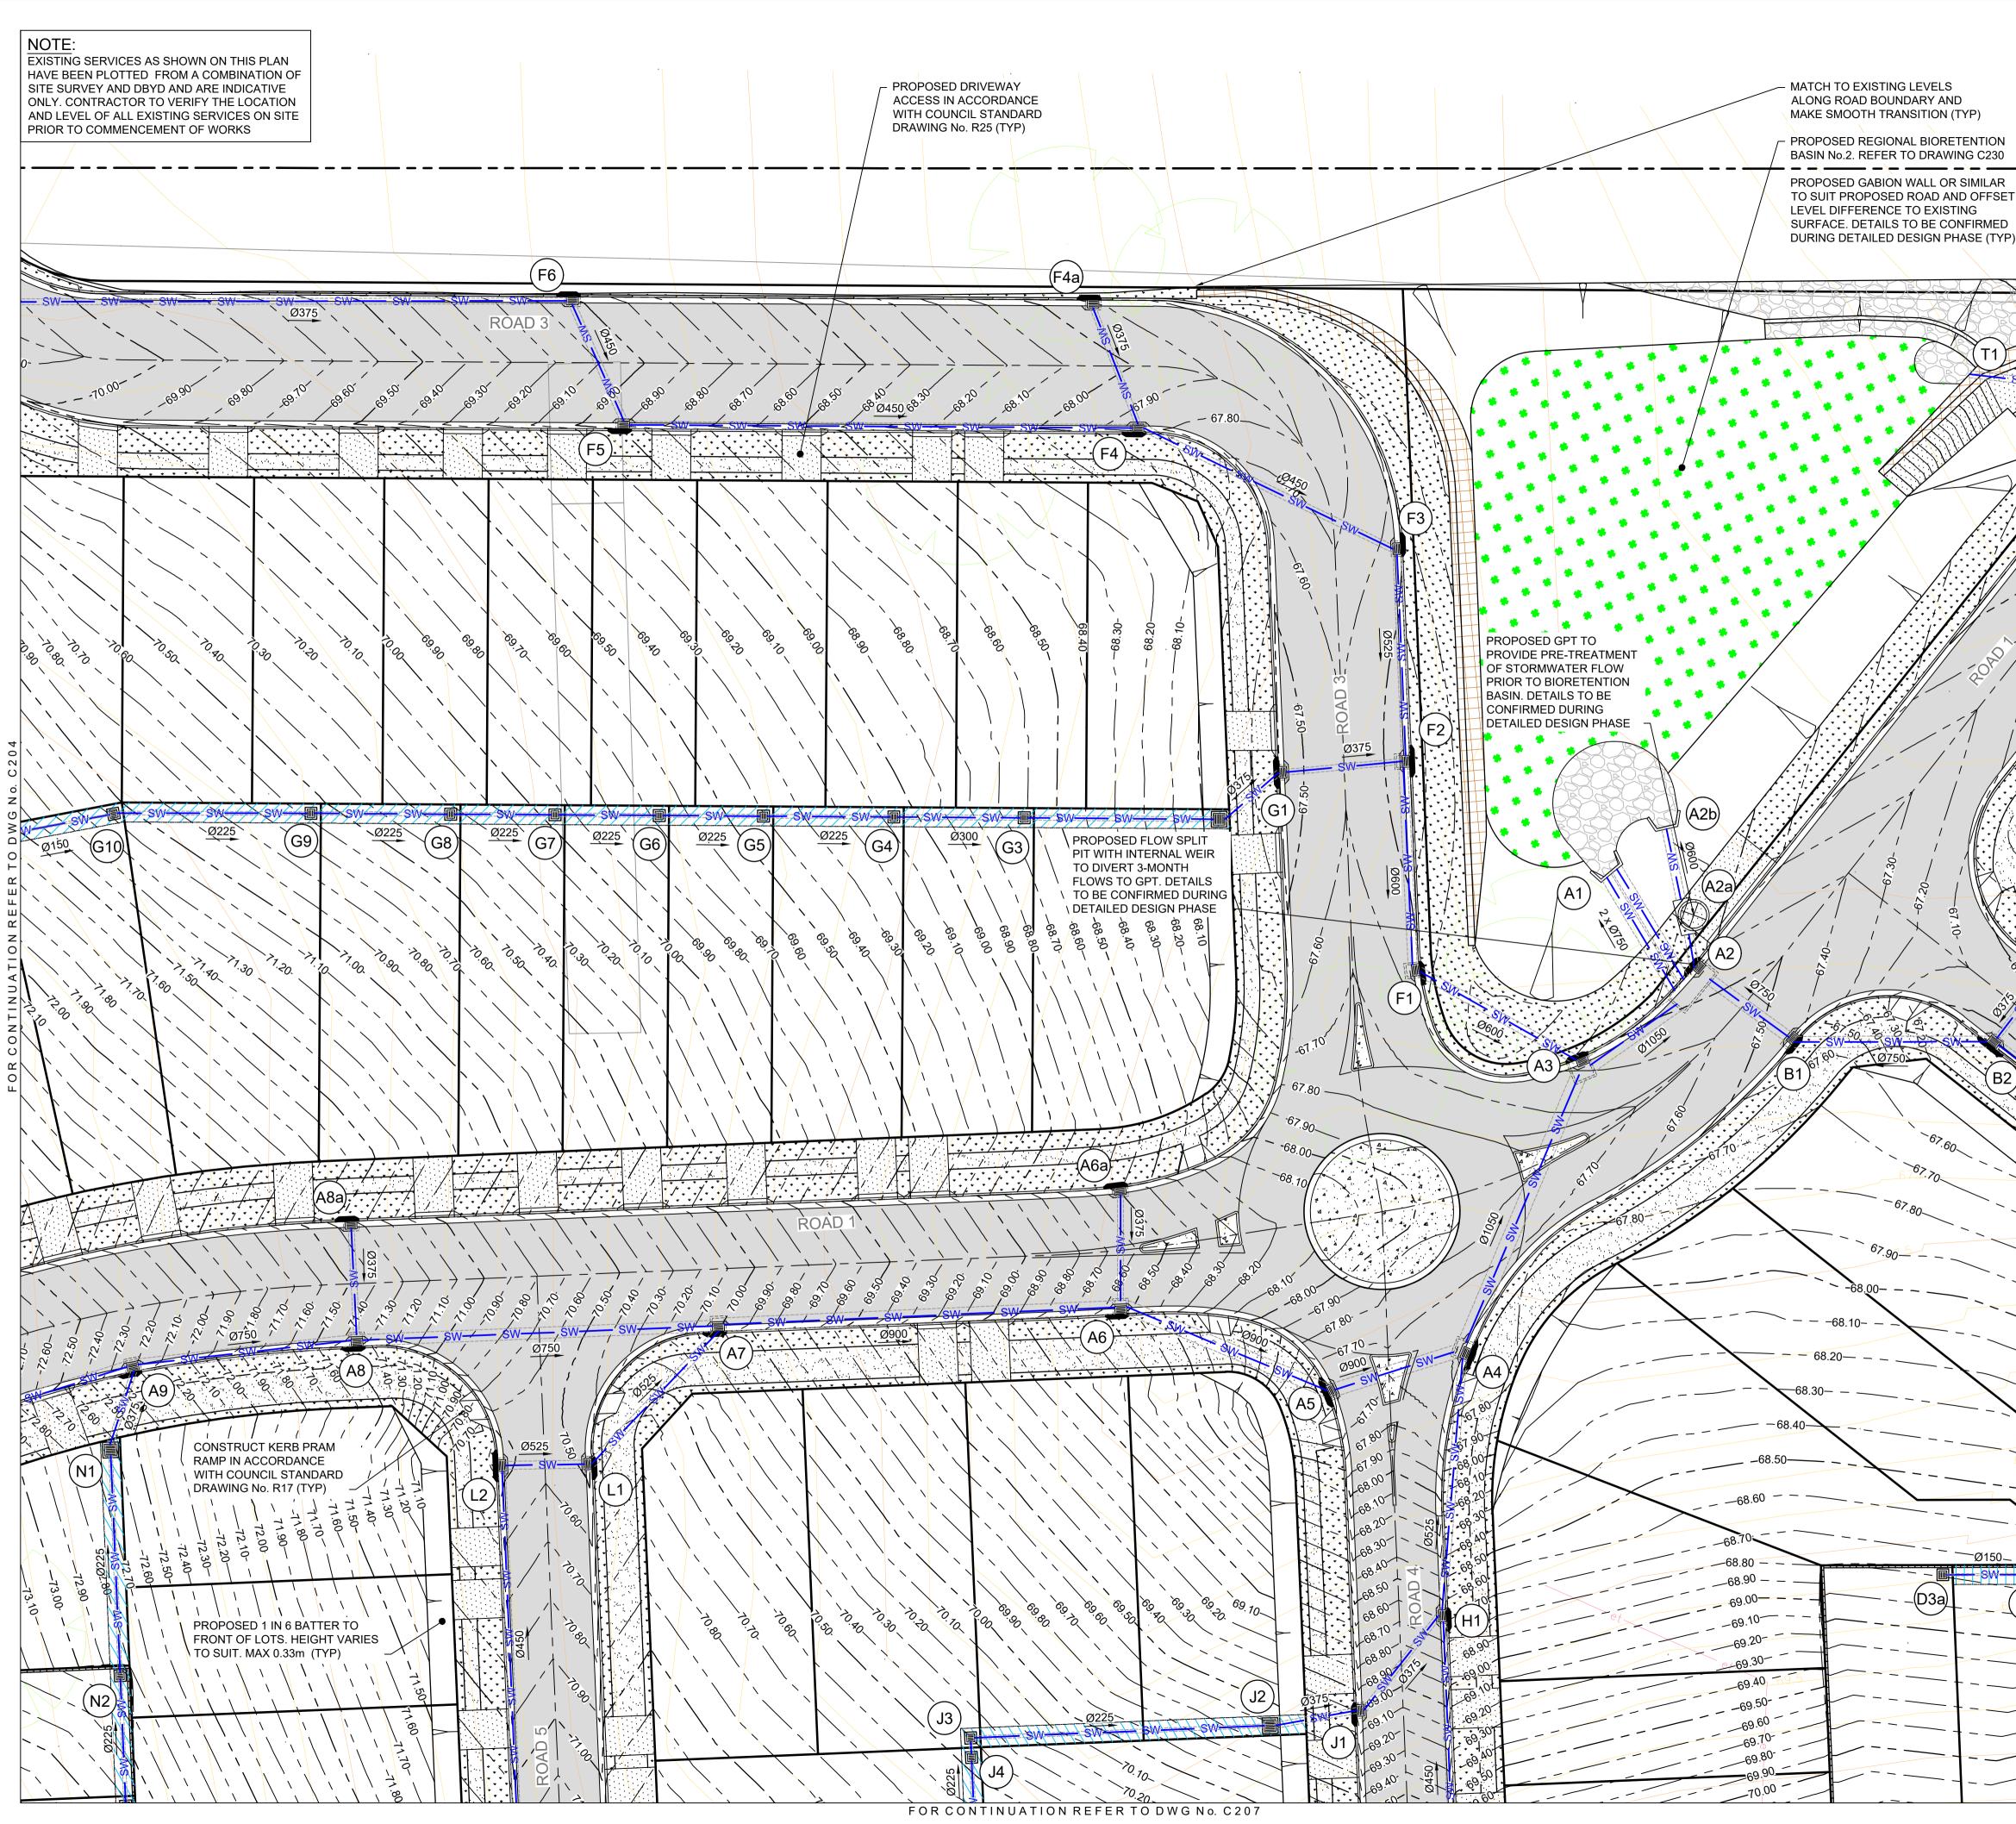


		LEGE	ND			
		1				
		1				
		1				
		1				
TO DELON		1				
$V \sim X \sim 0$		1				
(T2) •		1				
Ø450		1				
		1				
		1				
		1				
		1				
///		1				
		1				
		1				
		1				
		1				
	208	1				
	с	1				
	G N o.	1				
	DWG	1				
	ТО					
	ER					
	ΥEF					
	N R					
(B2a)	ATION					
00 S> 00 1	I N U A					
1030	NTI					
	COL	1				
	FOR	1				
	ш					
6600						
67 20		1				
		1				
		F	27.05.24	RE-ISSUED FOR DA	GAP	DR
$\searrow$		E	20.10.23	RE-ISSUED FOR DA	GAP	DR
		D	13.09.23	RE-ISSUED FOR DA	GAP	DR
		С	24.01.23	ISSUED FOR DA	GAP	CJA
67.75		В	20.01.23	ISSUED FOR INFORMATION	GAP	CJA
		A	02.12.22	ISSUED FOR INFORMATION	GAP	CJA
/68		Rev	Date	Description	Drawn	Appr
- 17		-	2	infrastructure & development Suite 8.01, 56 Clarence Stree	t consulti et	ng
		0	-		01	
Set of				Sydney, NSW 2000 e admin@idcaus.com w www.idcaus.com		
- 1/1/-				e & development consulting		
V///		PROJ		$\sim \sim 10^{-10}$		
(D2)				NDSON PARK PRECINC	ГЗ	
0300 -				DP1272931		
		,	CAMP	BELLTOWN ROAD		
D3) 69.80 (D4)			VING TITLE			
70.00- D4				/ORKS PLAN		
70.10-			SHEE			
70.20-			~			
70.30						
		SCAL	F .	STATUS DA		
70.50		JUAL	[±] 1:25	0 STATUS DA		
70.60		DRAV	VING NO.	22-514-DA-C206		
				22-314-DA-6200		

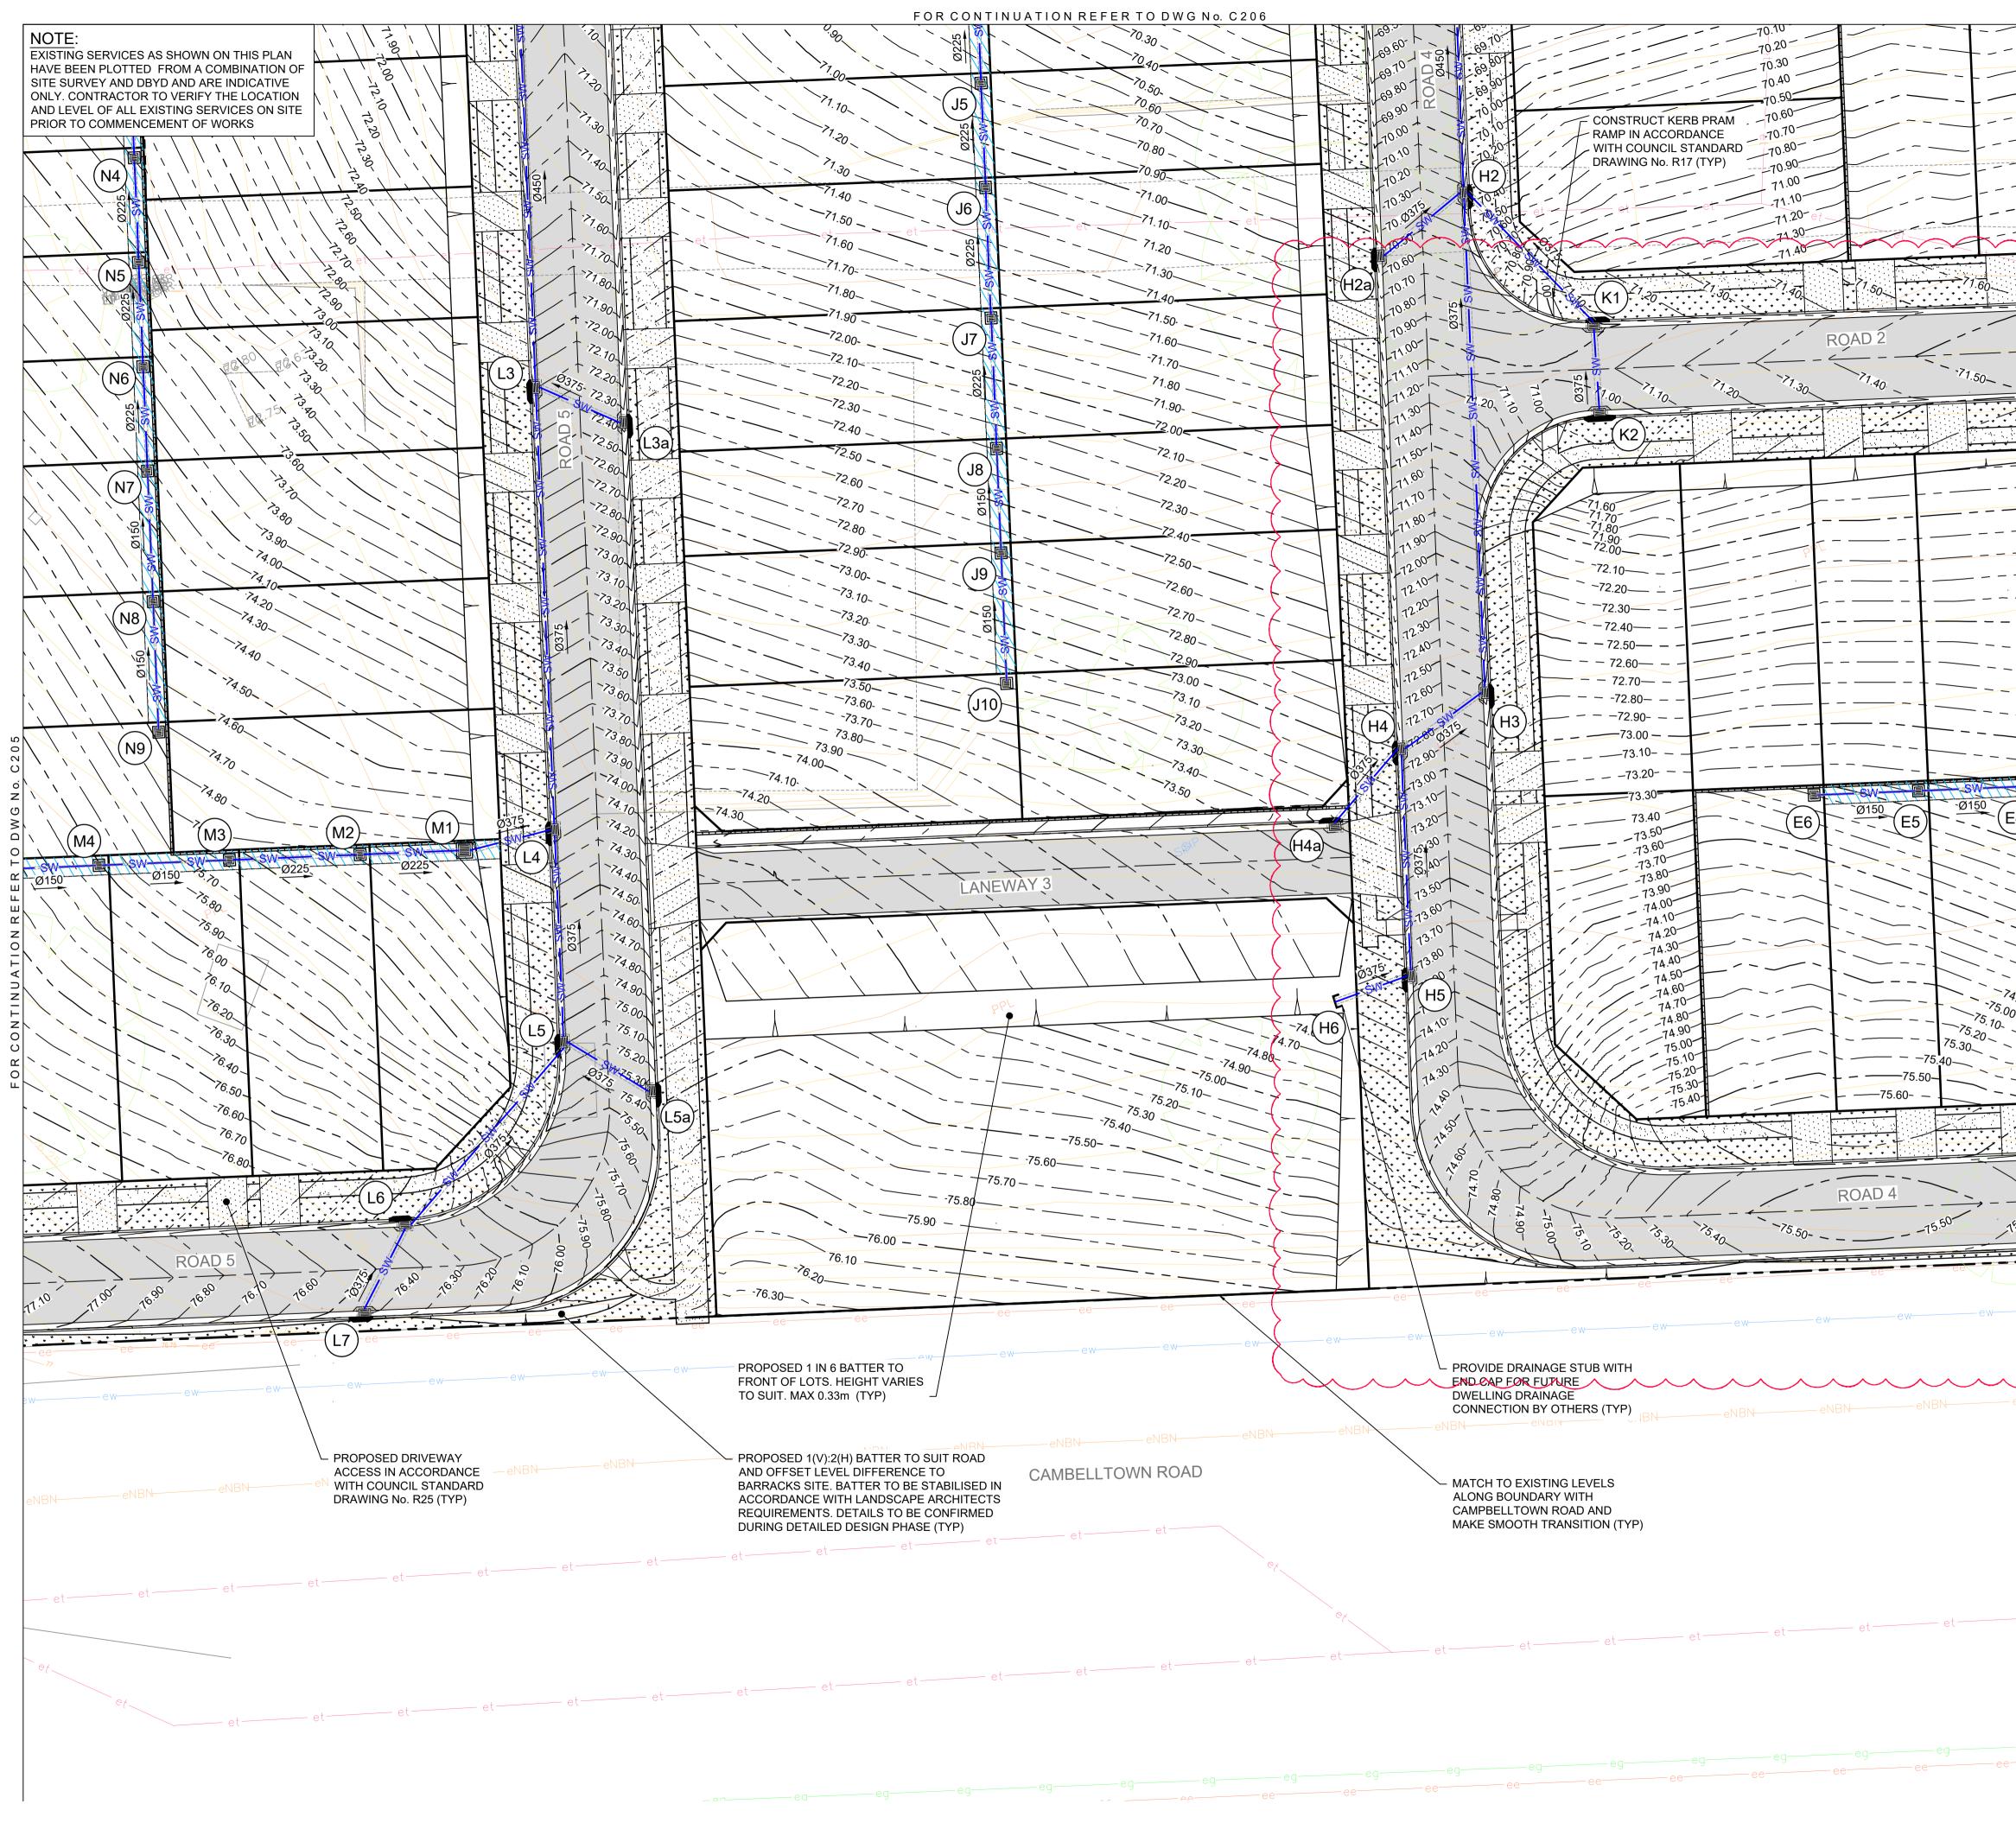

10.70		LEGE	ND			Ĩ
	7					
70.8						
-70.90	-					
	÷					
71.10						
-71.20						
-71.30						
	-					
71.60						
	. /					
	-)					
- +	1 1					
- +						
	<					
	6					
	C 2 0					
	o o					
E1 - 0225 (E3)	z ט <	/				
E4	N D					
74	и Ш					
74.10						
-7, 1.30	Z 🗸					
4.50	TIO					
7.60						
7. 4.70-						
- 74.70- 74.80- 74.90-	INUA					
7. 4.70-	<u>ONTINUA</u>					
- 74.70- 74.80- 74.90-	r continúa					
- 74.70- 74.80- 74.90-	CONTINUA					
- 74.70- 74.80- 74.90-	ORCONTINUA					
- 74.70- 74.80- 74.90-	ORCONTINUA					
- 74.70- 74.80- 74.90-	ORCONTINUA					
	FORCONTINUA					
	FORCONTINUA	F	27.05.24	RE-ISSUED FOR DA	GAP	DR
- 74.70- 74.80- 74.90-	FORCONTINUA	E	20.10.23	RE-ISSUED FOR DA	GAP	DR
	FORCONTINUA	E D	20.10.23 13.09.23	RE-ISSUED FOR DA RE-ISSUED FOR DA	GAP GAP	DR DR
	FORCONTINUA	E D C	20.10.23 13.09.23 24.01.23	RE-ISSUED FOR DA RE-ISSUED FOR DA ISSUED FOR DA	GAP GAP GAP	DR DR CJA
	FORCONTINUA	E D C B	20.10.23 13.09.23 24.01.23 20.01.23	RE-ISSUED FOR DA RE-ISSUED FOR DA ISSUED FOR DA ISSUED FOR INFORMATION	GAP GAP GAP GAP	DR DR CJA CJA
74.80 00 15.40 15.40 15.20 15.20 15.	FORCONTINUA	E D C	20.10.23 13.09.23 24.01.23	RE-ISSUED FOR DA RE-ISSUED FOR DA ISSUED FOR DA ISSUED FOR INFORMATION ISSUED FOR INFORMATION	GAP GAP GAP GAP GAP	DR DR CJA CJA CJA
15.40 15.30 15.20 15. ew ev	FORCONTINUA	E D C B A	20.10.23 13.09.23 24.01.23 20.01.23 02.12.22	RE-ISSUED FOR DARE-ISSUED FOR DAISSUED FOR DAISSUED FOR INFORMATIONISSUED FOR INFORMATIONDescription	GAP GAP GAP GAP GAP Drawn	DR DR CJA CJA CJA Appr
15.40 15.30 15.20 15. ew ev	FORCONTINUA	E D C B A	20.10.23 13.09.23 24.01.23 20.01.23 02.12.22	RE-ISSUED FOR DA RE-ISSUED FOR DA ISSUED FOR DA ISSUED FOR INFORMATION ISSUED FOR INFORMATION Description infrastructure & developmen Suite 8.01, 56 Clarence Stree	GAP GAP GAP GAP GAP Drawn	DR DR CJA CJA CJA Appr
15.40 15.30 15.20 15. ew ev	FORCONTINUA	E D C B A	20.10.23 13.09.23 24.01.23 20.01.23 02.12.22 Date	RE-ISSUED FOR DA RE-ISSUED FOR DA ISSUED FOR DA ISSUED FOR INFORMATION ISSUED FOR INFORMATION Description infrastructure & development Suite 8.01, 56 Clarence Stree Sydney, NSW 2000 e admin@idcaus.com	GAP GAP GAP GAP GAP Drawn	DR DR CJA CJA CJA Appr
15.40 15.30 15.20 15. ew ev	FORCONTINUA	E D C B A Rev	20.10.23 13.09.23 24.01.23 20.01.23 02.12.22 Date	RE-ISSUED FOR DA RE-ISSUED FOR DA ISSUED FOR DA ISSUED FOR INFORMATION ISSUED FOR INFORMATION Description infrastructure & developmen Suite 8.01, 56 Clarence Stree Sydney, NSW 2000 e admin@idcaus.com w www.idcaus.com	GAP GAP GAP GAP GAP Drawn	DR DR CJA CJA CJA Appr
15.40 15.30 15.20 15. ew ev	FORCONTINUA	E D C B A	20.10.23 13.09.23 24.01.23 02.12.22 Date	RE-ISSUED FOR DA         RE-ISSUED FOR DA         ISSUED FOR DA         ISSUED FOR INFORMATION         ISSUED FOR INFORMATION         Description         infrastructure & development suite 8.01, 56 Clarence Stressydney, NSW 2000         e       admin@idcaus.com         www.idcaus.com	GAP GAP GAP GAP GAP Drawn	DR DR CJA CJA CJA Appr
15.40 15.30 15.20 15. ew ev	FORCONTINUA	E D C B A Rev	20.10.23 13.09.23 24.01.23 02.12.22 Date	RE-ISSUED FOR DA         RE-ISSUED FOR DA         ISSUED FOR DA         ISSUED FOR INFORMATION         ISSUED FOR INFORMATION         Description         infrastructure & development Suite 8.01, 56 Clarence Stressydney, NSW 2000         e       admin@idcaus.com         www.idcaus.com         www.idcaus.com	GAP GAP GAP GAP Drawn the consulti	DR DR CJA CJA CJA Appr
15.40 15.30 15.20 15. ew ev	FORCONTINUA	E D C B A Rev	20.10.23 13.09.23 24.01.23 02.12.22 Date	RE-ISSUED FOR DA RE-ISSUED FOR DA ISSUED FOR DA ISSUED FOR INFORMATION ISSUED FOR INFORMATION Description infrastructure & development Suite 8.01, 56 Clarence Stree Sydney, NSW 2000 e admin@idcaus.com www.idcaus.com Www.idcaus.com	GAP GAP GAP GAP Drawn the consulti	DR DR CJA CJA CJA Appr
15.40 15.30 15.20 15. ew ev	FORCONTINUA	E D C B A Rev	20.10.23 13.09.23 24.01.23 02.12.22 Date	RE-ISSUED FOR DA RE-ISSUED FOR DA ISSUED FOR DA ISSUED FOR INFORMATION ISSUED FOR INFORMATION Description infrastructure & development Suite 8.01, 56 Clarence Stree Sydney, NSW 2000 e admin@idcaus.com www.idcaus.com COM NDSON PARK PRECINC	GAP GAP GAP GAP Drawn the consulti	DR DR CJA CJA CJA Appr
15.40 15.30 15.20 15. ew ev	FORCONTINUA	E D C B A Rev	20.10.23 13.09.23 24.01.23 02.12.22 Date	RE-ISSUED FOR DA RE-ISSUED FOR DA ISSUED FOR DA ISSUED FOR INFORMATION ISSUED FOR INFORMATION Description infrastructure & development Suite 8.01, 56 Clarence Stree Sydney, NSW 2000 e admin@idcaus.com www.idcaus.com Www.idcaus.com	GAP GAP GAP GAP Drawn the consulti	DR DR CJA CJA CJA Appr
A BO A BO	FORCONTINUA	E D C B A Rev PROJ	20.10.23 13.09.23 24.01.23 02.12.22 Date ECT LANDO EDMO LOT 5 CAMP	RE-ISSUED FOR DA         RE-ISSUED FOR DA         ISSUED FOR INFORMATION         ISSUED FOR INFORMATION         Description         Image: Construction of the structure in the structure is a development suite 8.01, 56 Clarence Structure, NSW 2000         e admin@idcaus.com         www.idcaus.com         Image: Constructure is a development consulting	GAP GAP GAP GAP Drawn the consulti	DR DR CJA CJA CJA Appr
A BO A BO	FORCONTINUA	E D C B A Rev PROJ	20.10.23 13.09.23 24.01.23 02.12.22 Date ECT LANDO EDMO LOT 5 CAMP	RE-ISSUED FOR DA RE-ISSUED FOR DA ISSUED FOR INFORMATION ISSUED FOR INFORMATION Description Infrastructure & development Suite 8.01, 56 Clarence Strest Sydney, NSW 2000 e admin@idcaus.com www.idcaus.com Www.idcaus.com COM NDSON PARK PRECINCT DP1272931 BELLTOWN ROAD ORKS PLAN	GAP GAP GAP GAP Drawn the consulti	DR DR CJA CJA CJA Appr
A BO A BO	FORCONTINUA	E D C B A Rev PROJ	20.10.23 13.09.23 24.01.23 02.12.22 Date ECT LANDO EDMO LOT 5 CAMP	RE-ISSUED FOR DA RE-ISSUED FOR DA ISSUED FOR INFORMATION ISSUED FOR INFORMATION Description Infrastructure & development Suite 8.01, 56 Clarence Stre Sydney, NSW 2000 e admin@idcaus.com www.idcaus.com W www.idcaus.com COM NDSON PARK PRECINC DP1272931 BELLTOWN ROAD ORKS PLAN 18	GAP GAP GAP GAP Drawn the consulti	DR DR CJA CJA CJA Appr
et et	FORCONTINUA	E D C B A Rev PROJ	20.10.23 13.09.23 24.01.23 02.12.22 Date ECT LANDO EDMO LOT 5 CAMP	RE-ISSUED FOR DA RE-ISSUED FOR DA ISSUED FOR INFORMATION ISSUED FOR INFORMATION Description Infrastructure & development Suite 8.01, 56 Clarence Stre Sydney, NSW 2000 e admin@idcaus.com www.idcaus.com W www.idcaus.com COM NDSON PARK PRECINC DP1272931 BELLTOWN ROAD ORKS PLAN 18	GAP GAP GAP GAP Drawn the consulti	DR DR CJA CJA CJA Appr
eg eg	FORCONTINUA	E D C B A Rev PROJ	20.10.23 13.09.23 24.01.23 02.12.22 Date ECT LANDO EDMO LOT 5 CAMP VING TITLE SITEV SHEE CAMP	RE-ISSUED FOR DA RE-ISSUED FOR DA ISSUED FOR INFORMATION ISSUED FOR INFORMATION Description Infrastructure & development Suite 8.01, 56 Clarence Stre Sydney, NSW 2000 e admin@idcaus.com w www.idcaus.com COM NDSON PARK PRECINCT DP1272931 BELLTOWN ROAD CORKS PLAN T 8 0 STATUS DA	GAP GAP GAP GAP Drawn the consult eet	DR DR CJA CJA CJA Appr
eg eg	FORCONTINUA	E D C B A Rev PROJ	20.10.23 13.09.23 24.01.23 02.12.22 Date ECT LANDO EDMO LOT 5 CAMP VING TITLE SITEV SHEE CAMP	RE-ISSUED FOR DA RE-ISSUED FOR DA ISSUED FOR INFORMATION ISSUED FOR INFORMATION Description	GAP GAP GAP GAP Drawn t consulti	DR DR CJA CJA CJA Appr

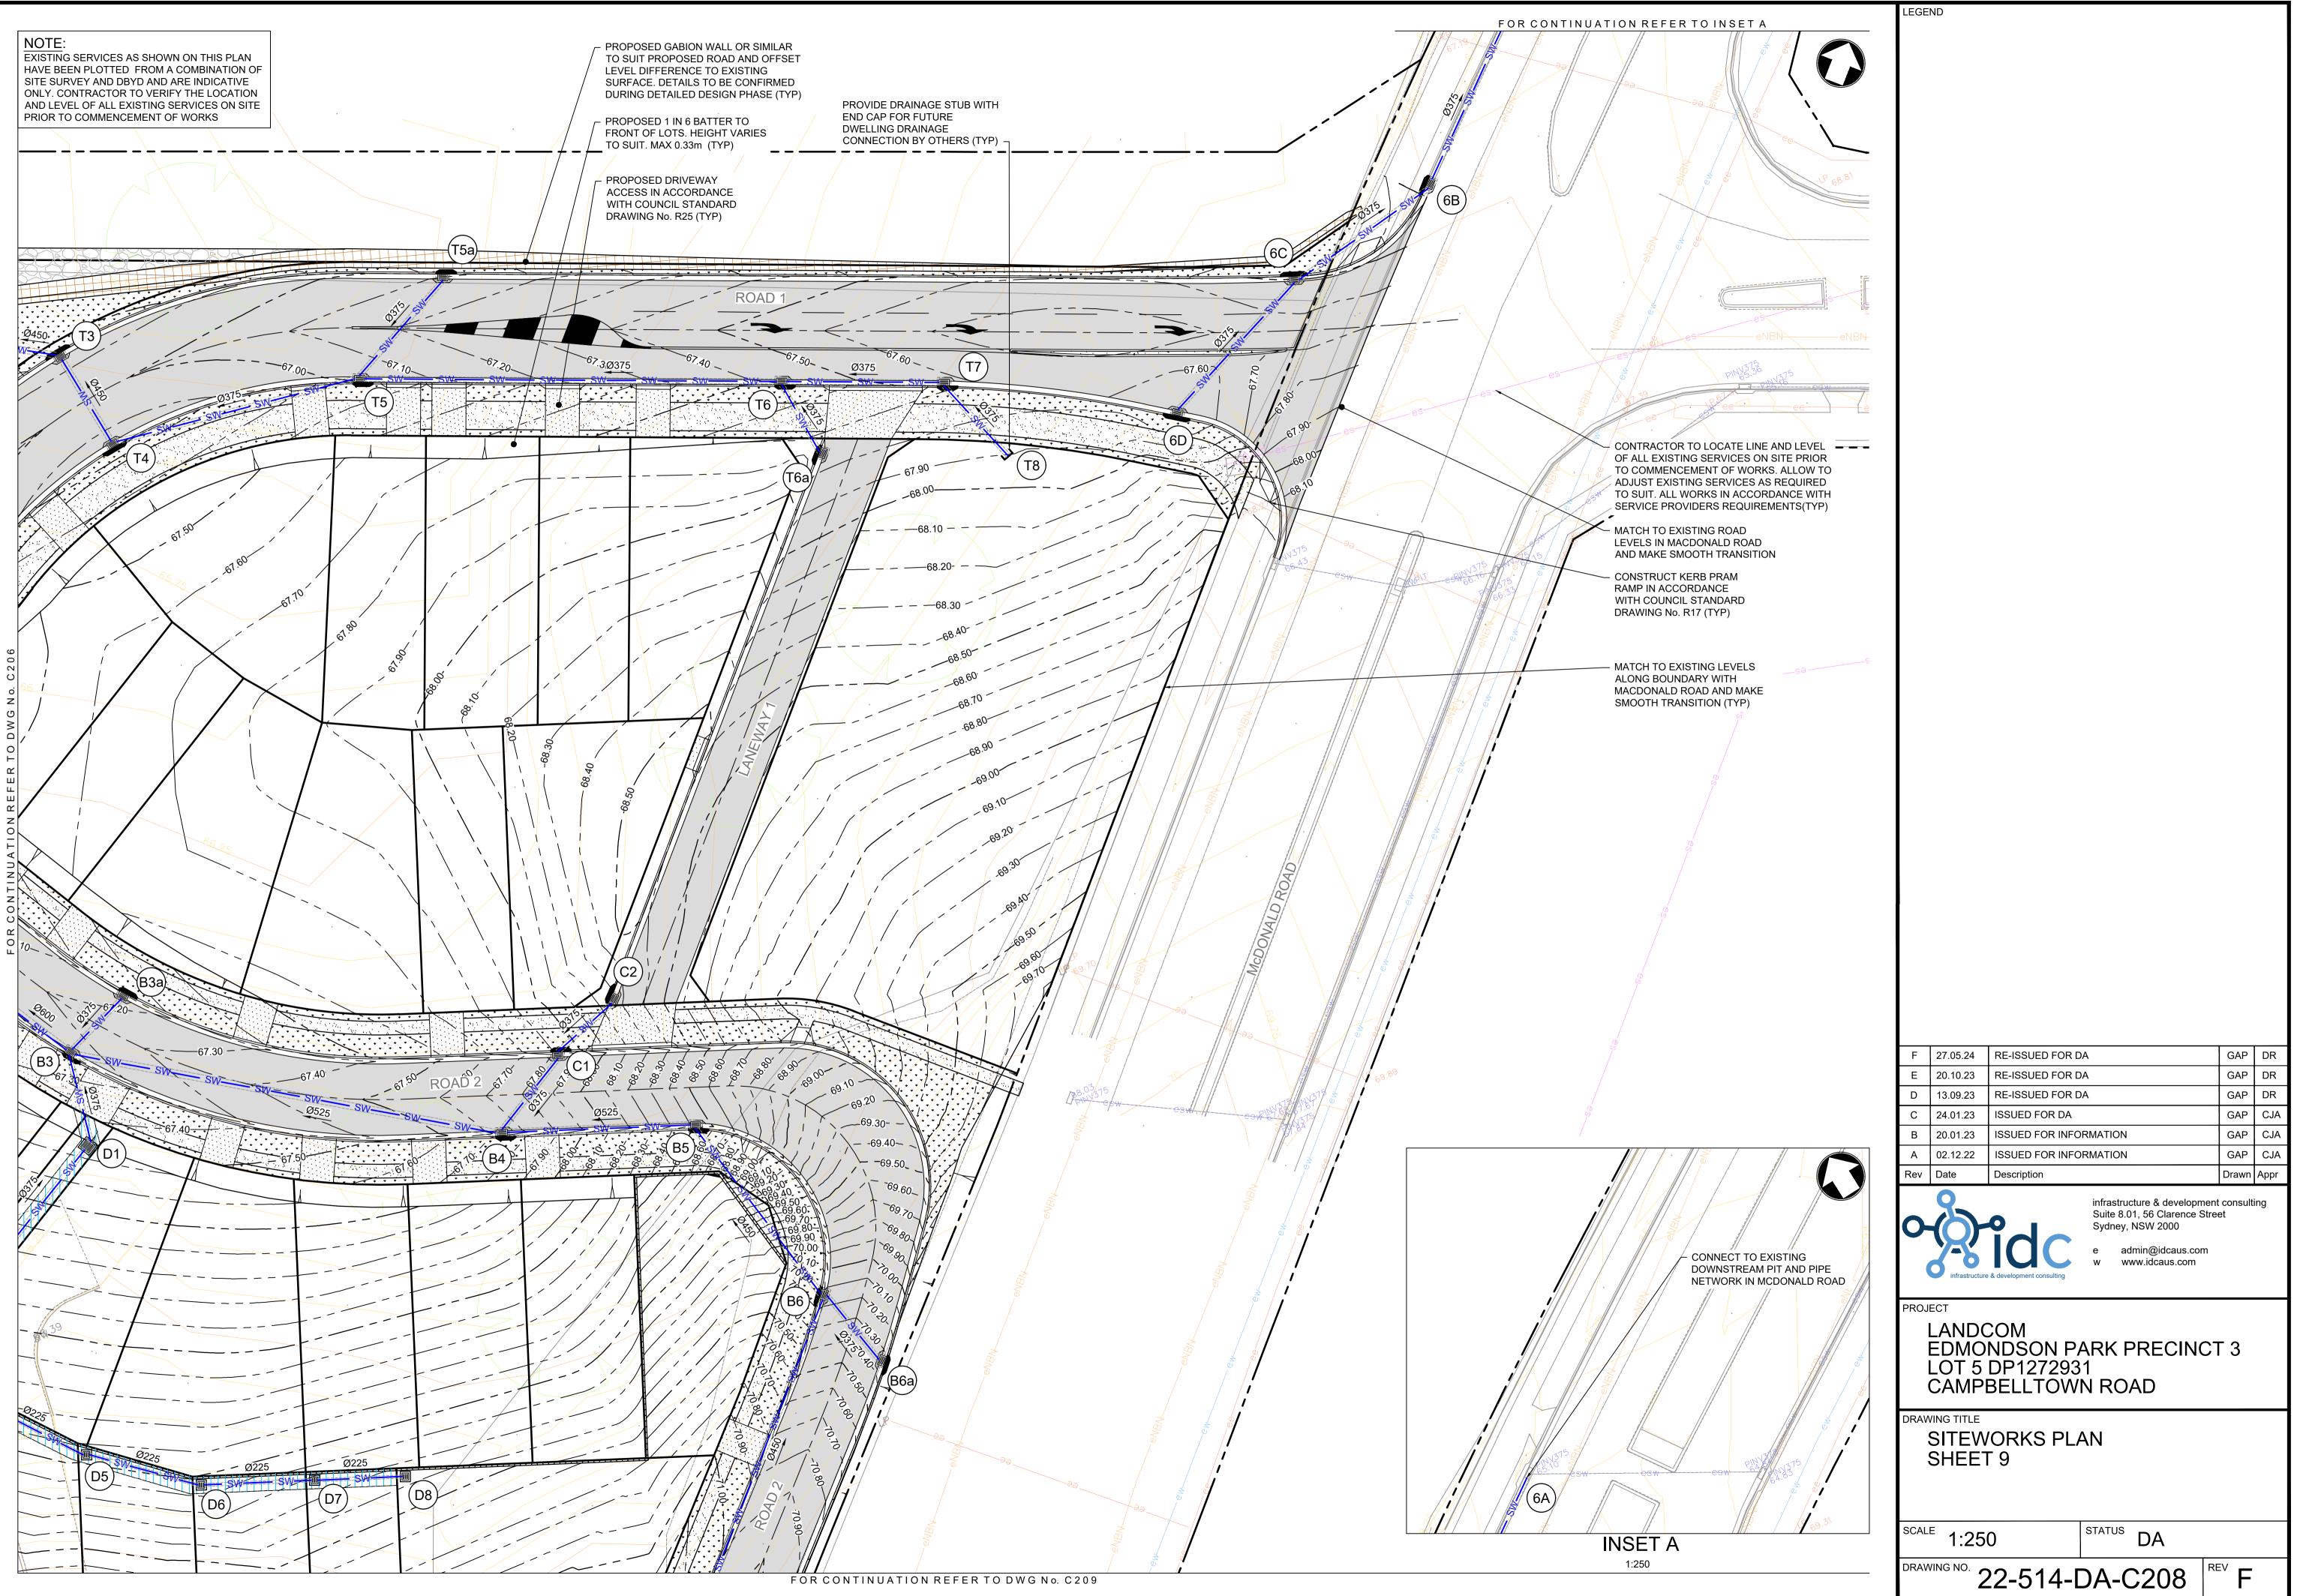

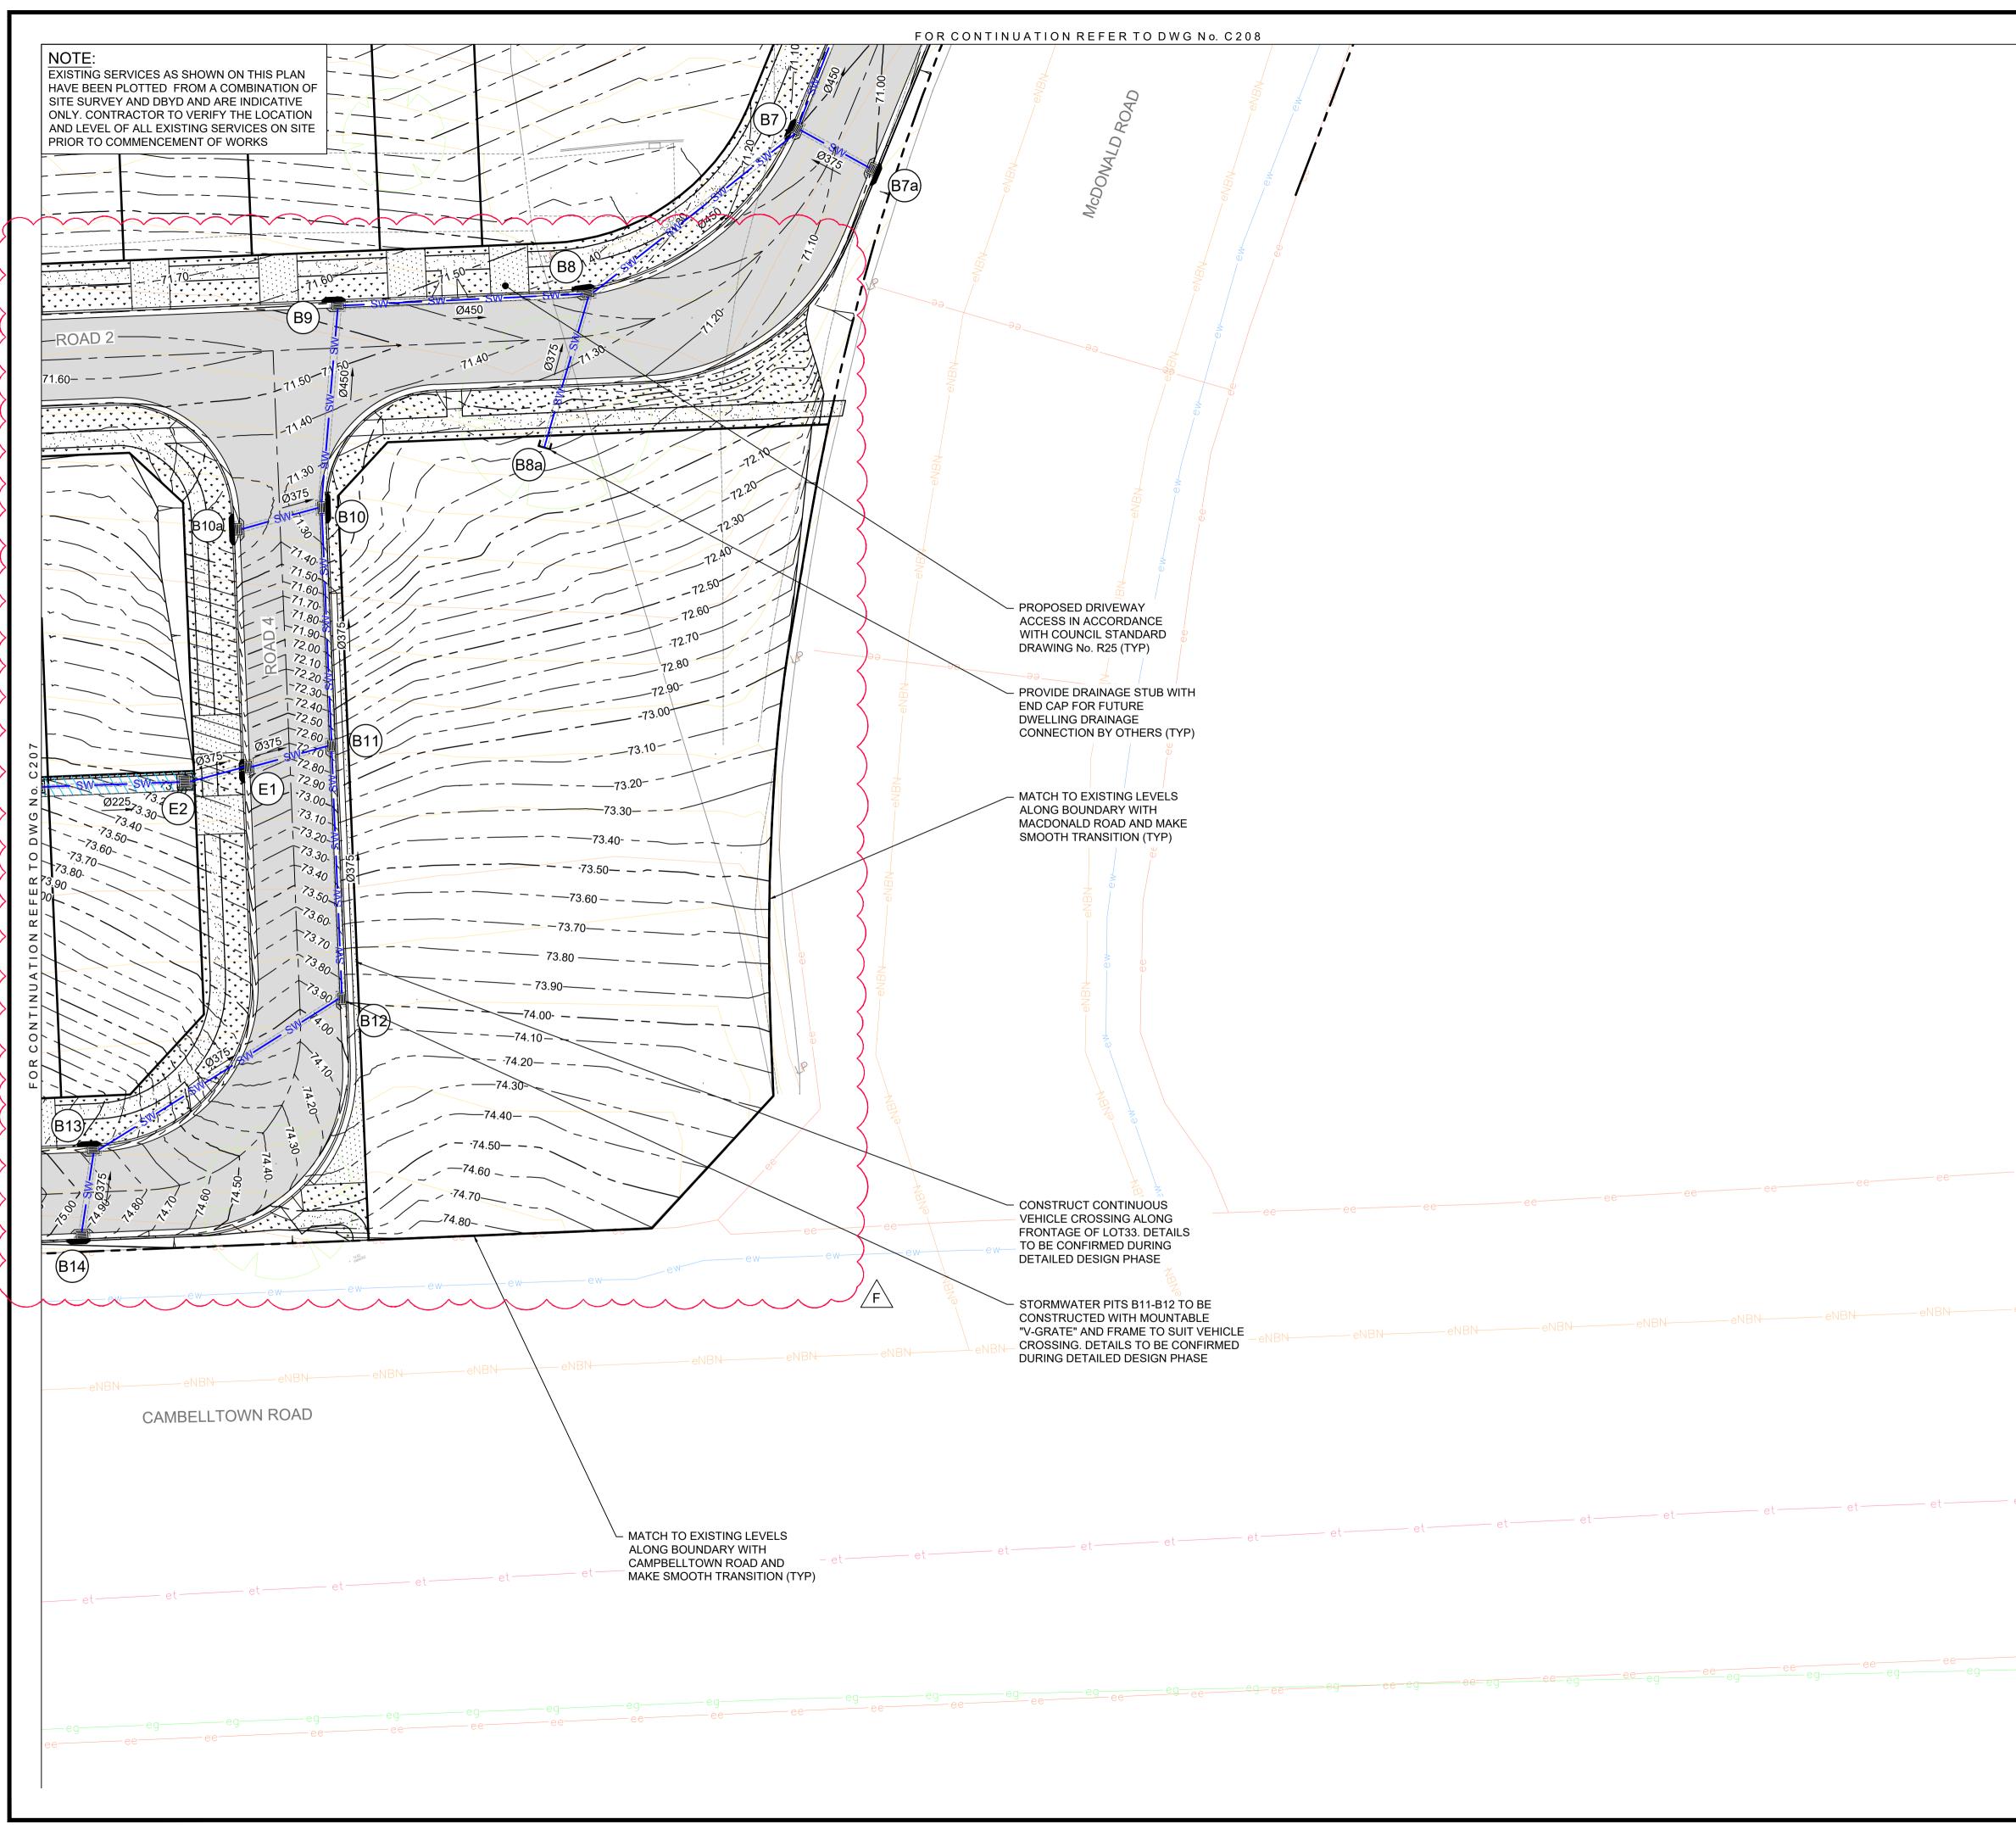

 $\square$ 

 $\Gamma$ 

PROPOSED DRIVEWAY ACCESS IN ACCORDANCE WITH COUNCIL STANDARD DRAWING No. R25 (TYP)

- PROVIDE DRAINAGE STUB WITH END CAP FOR FUTURE DWELLING DRAINAGE CONNECTION BY OTHERS (TYP)

– MATCH TO EXISTING LEVELS ALONG BOUNDARY WITH MACDONALD ROAD AND MAKE SMOOTH TRANSITION (TYP)


CONSTRUCT CONTINUOUS
 VEHICLE CROSSING ALONG
 FRONTAGE OF LOT33. DETAILS
 TO BE CONFIRMED DURING
 DETAILED DESIGN PHASE

- STORMWATER PITS B11-B12 TO BE CONSTRUCTED WITH MOUNTABLE "V-GRATE" AND FRAME TO SUIT VEHICLE CROSSING. DETAILS TO BE CONFIRMED DURING DETAILED DESIGN PHASE


	-ee					
e	00			1		
		F	27.05.24	RE-ISSUED FOR DA	GAP	DR
		E	20.10.23	RE-ISSUED FOR DA	GAP	DR
		D C	13.09.23	RE-ISSUED FOR DA	GAP	DR CJA
		B	24.01.23 20.01.23	ISSUED FOR INFORMATION	GAP GAP	CJA
NBN	— eNBî	A	02.12.22	ISSUED FOR INFORMATION	GAP	CJA
		Rev	Date	Description	Drawn	
		0	infrastructure	infrastructure & developmen Suite 8.01, 56 Clarence Stre Sydney, NSW 2000 e admin@idcaus.com w www.idcaus.com	ıt consulti et	ing
		PROJ	ECT			
t	- et ——			COM		
				NDSON PARK PRECINC	ТЗ	
				DP1272931		
			CAMP	BELLTOWN ROAD		
		DRAV	/ING TITLE			
				ORKS PLAN		
eeeo	ee—		SHEE ⁻	Г 10		
eg						
		SCAL	[⊧] 1:25	0 STATUS DA		
		DRAV	/ING NO.	22-514-DA-C209	EV F	
				22-014-DA-6209		


_____ et _____ et _____ et _____ et _____ et

_____ et ______ et ______ et ______ et ______ et ______

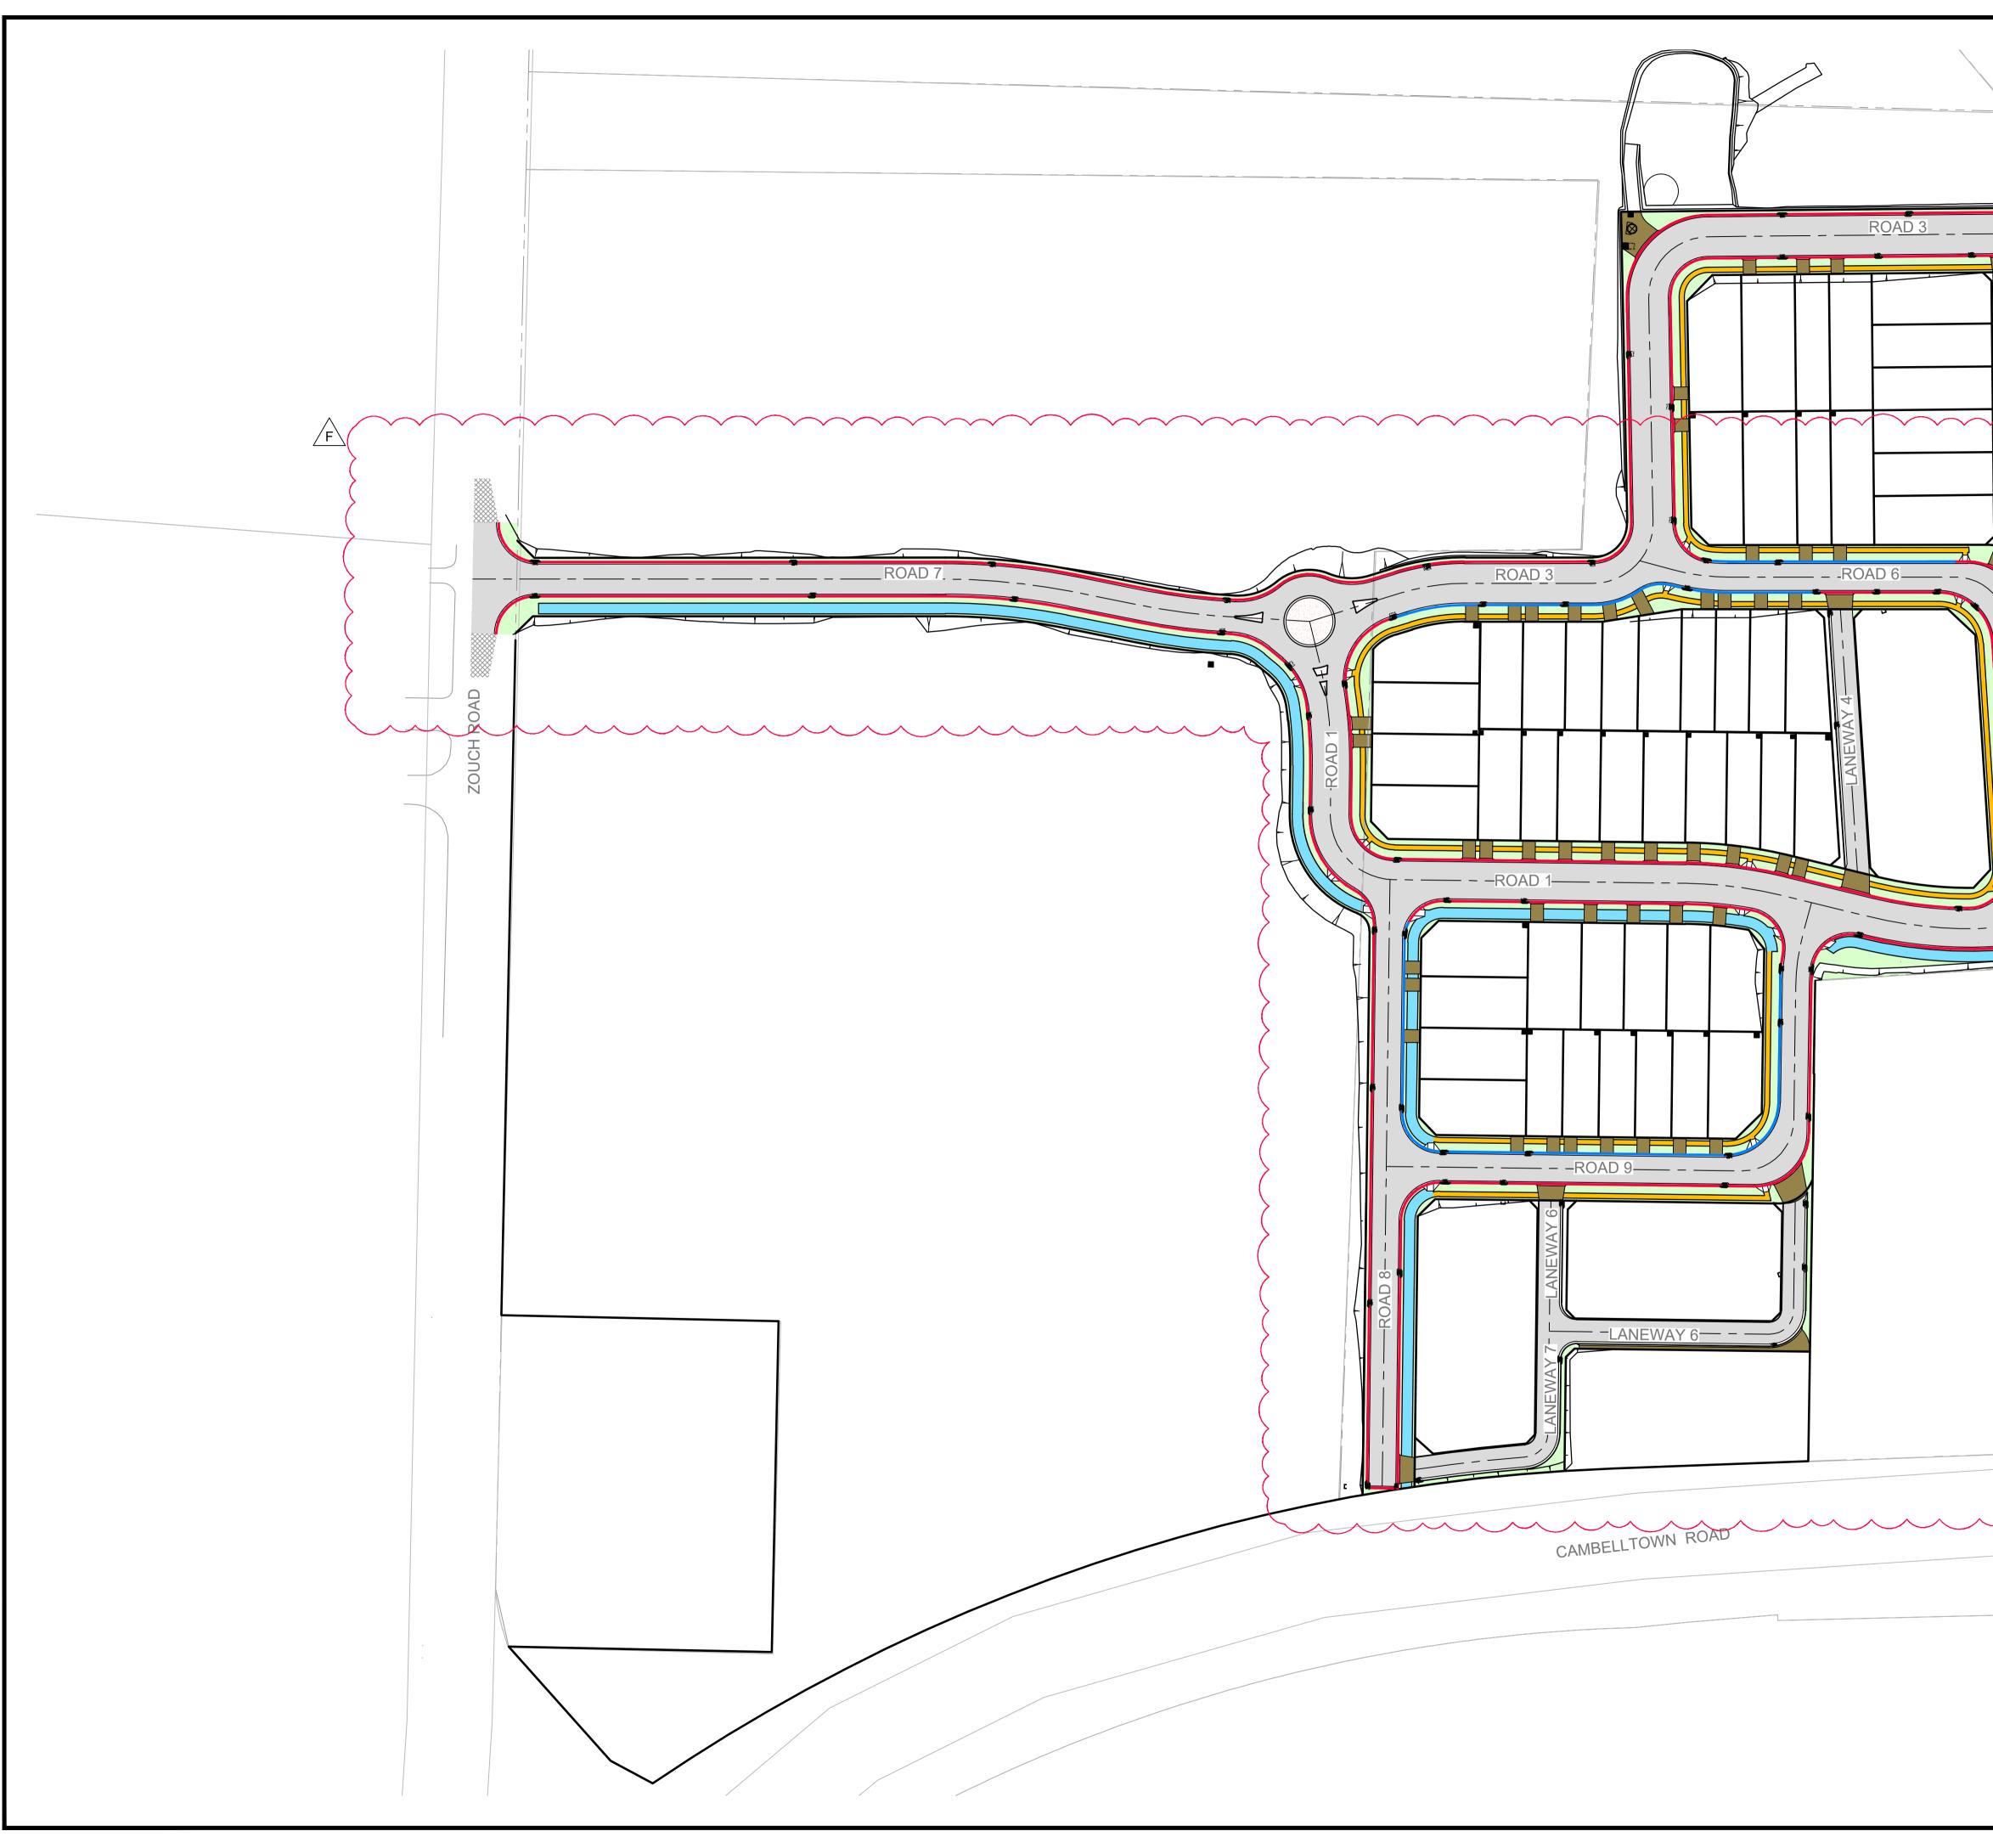


	LEGEND
	LEGEND
	ASPHALTIC CONCRETE PAVEMENT TO BE CONFIRMED BY GEOTECHNICAL ENGINEER DURING DETAILED DESIGN STAGE
	CONCRETE FOOTPATH PAVEMENT IN ACCORDANCE WITH COUNCIL DRAWING No. R23
	CONCRETE SHARED PATH PAVEMENT IN ACCORDANCE WITH COUNCIL DRAWING No. R23
	PROPOSED LANDSCAPING REFER TO SEPARATE LANDSCAPE ARCHITECTS PLAN FOR DETAILS
	PROPOSED OPEN SPACE REFER TO SEPARATE LANDSCAPE ARCHITECTS PLAN FOR DETAILS
	CONCRETE DRIVEWAY PAVEMENT IN ACCORDANCE WITH COUNCIL STANDARD DRAWING No. R25
LAN	CONCRETE ROUNDABOUT PAVEMENT IN ACCORDANCE WITH COUNCIL STANDARD DRAWING No. R18
	PROPOSED KERB AND GUTTER IN ACCORDANCE WITH COUNCIL STANDARD DRAWING No. R2
	PROPOSED ROLL KERB AND GUTTER IN ACCORDANCE WITH COUNCIL STANDARD DRAWING No. R2
	ALL PAVEMENTS ARE INDICATIVE ONLY. TO BE CONFIRMED BY GEOTECHNICAL ENGINEER DURING SUBSEQUENT DETAILED DESIGN STAGE
FOR CONTINUATION REFER TO DWG No. C210	NOTE: DRIVEWAY LOCATIONS FOR LOTS FRONTING ROLL KERB HAVE BEEN SHOWN FOR INFORMATION AND ARE INDICATIVE ONLY. FINAL DRIVEWAY LOCATIONS TO BE CONFIRMED DURING THE SUBSEQUENT INDIVIDUAL DA APPLICATIONS FOR EACH LOT.
	F27.05.24RE-ISSUED FOR DAGAPDRE20.10.23RE-ISSUED FOR DAGAPDRD13.09.23RE-ISSUED FOR DAGAPDRC24.01.23ISSUED FOR DAGAPCJAB20.01.23ISSUED FOR INFORMATIONGAPCJAA02.12.22ISSUED FOR INFORMATIONGAPCJARevDateDescriptionDrawnAppr
	infrastructure & development consulting Suite 8.01, 56 Clarence Street
	Sydney, NSW 2000 e admin@idcaus.com www.idcaus.com
	PROJECT LANDCOM EDMONDSON PARK PRECINCT 3 LOT 5 DP1272931
	CAMPBELLTOWN ROAD
	PAVEMENT PLAN SHEET 1
	SCALE 1:750 STATUS DA

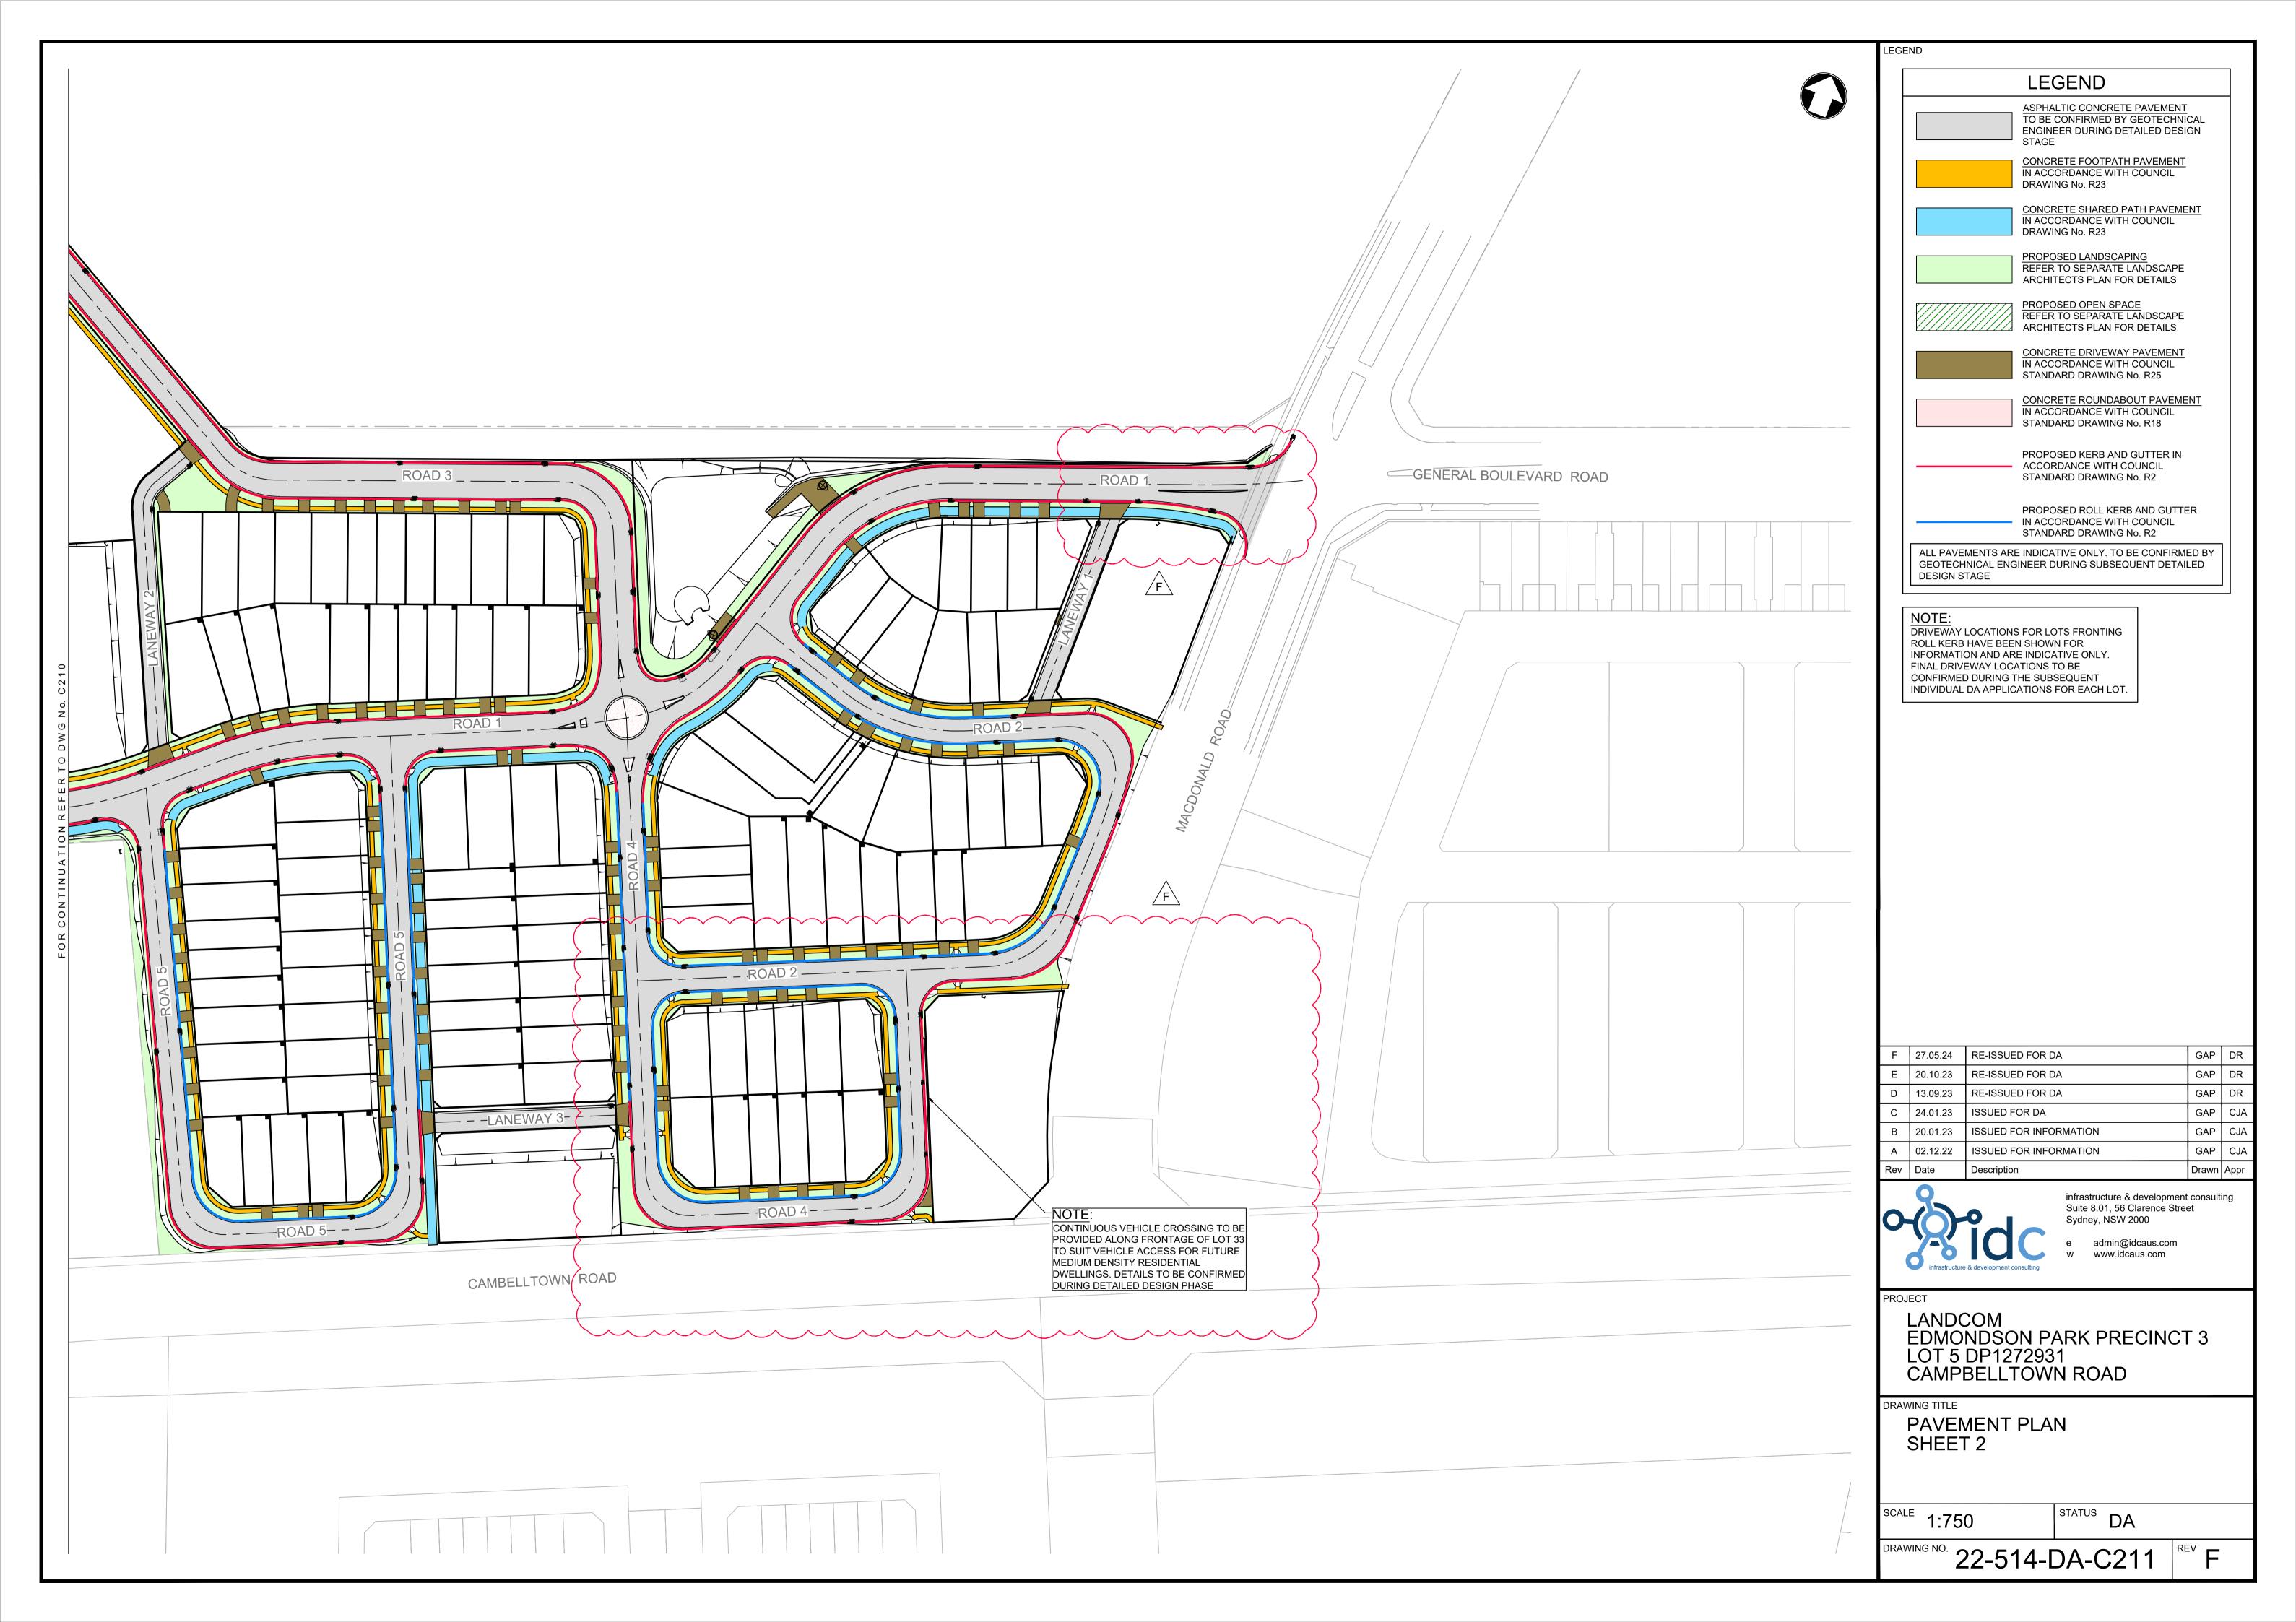


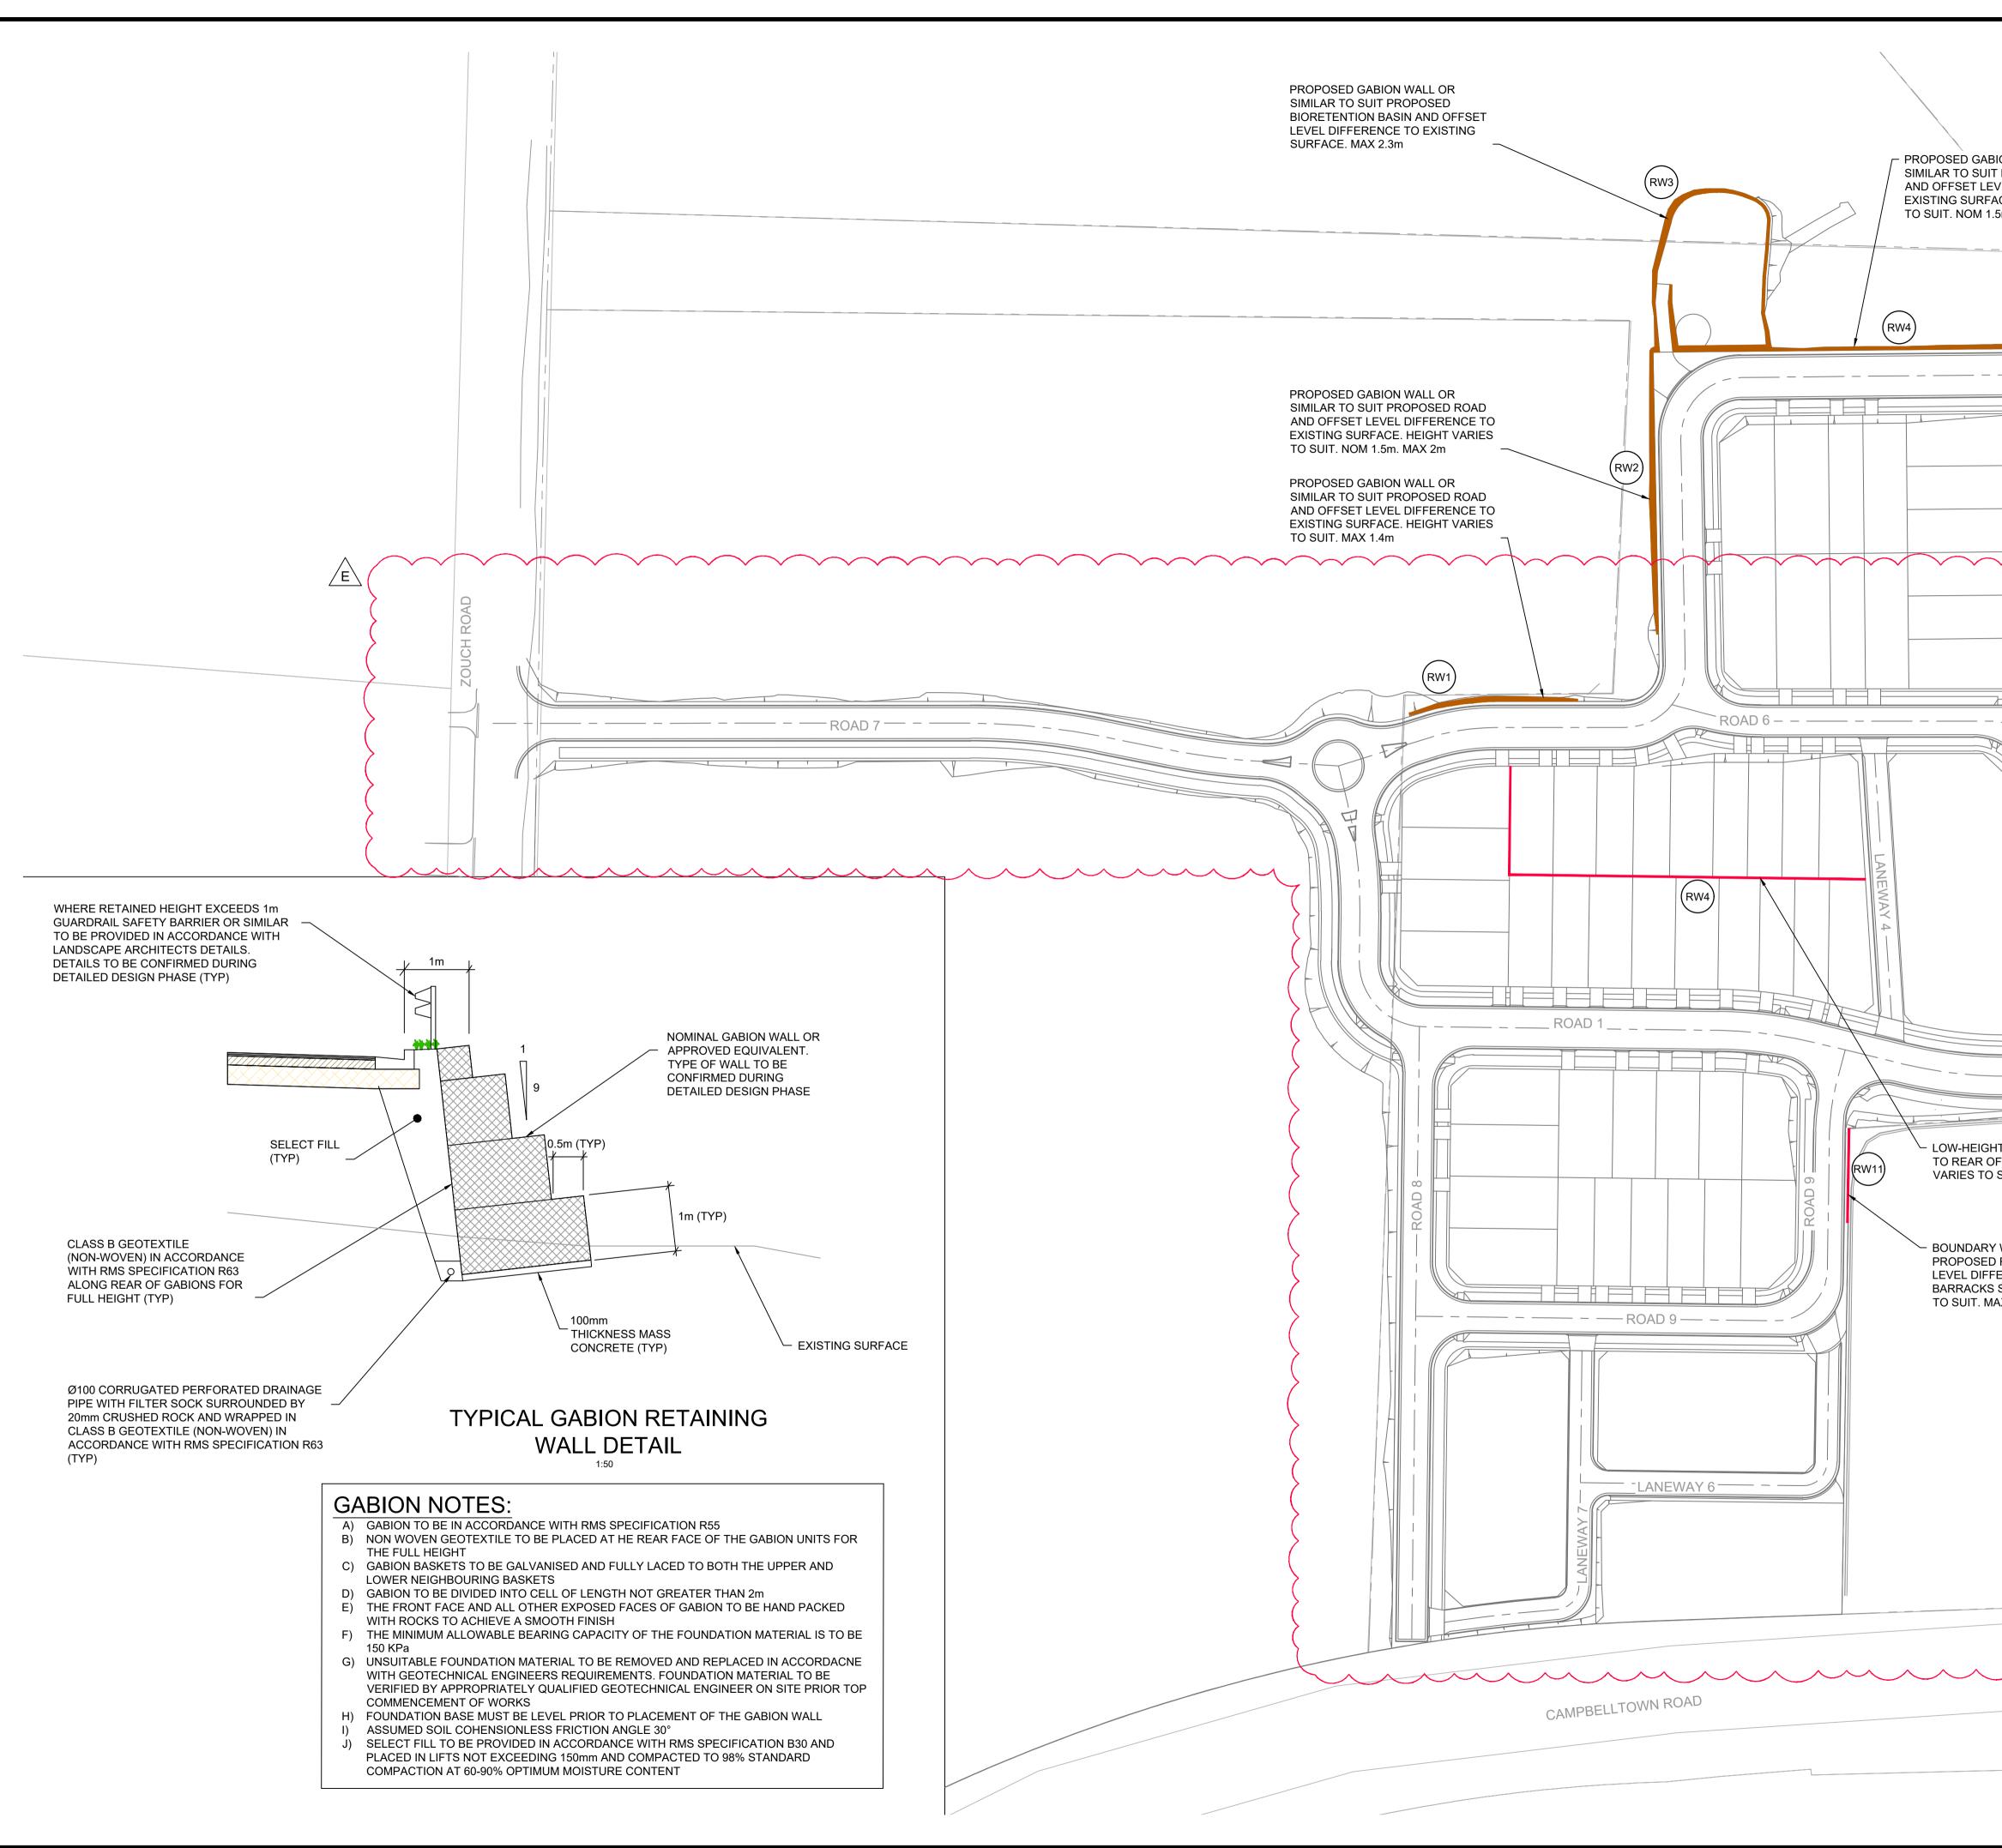


	LEGEND				
		LEG	END		]
	RV	V1) RETAIN	ING WALL NUMBER		
ION WALL OR PROPOSED ROAD VEL DIFFERENCE TO ACE. HEIGHT VARIES 5m. MAX 2m		DETAIL	OSED GABION WALL OR SIMI S TO BE CONFIRMED DURIN ED DESIGN PHASE		
		DETAIL	SED LOT RETAINING WALL. S TO BE CONFIRMED DURIN ED DESIGN PHASE		
		WALL.	DSED VERTICAL BOUNDARY DETAILS TO BE CONFIRMED G DETAILED DESIGN STAGE	)	
G No. C216					
TRETAINING WALL F LOTS. HEIGHT SUIT. MAX 1m					
$\left\{ \right\}$					
WALL TO SUIT ROAD AND OFFSET	E 27.05.24	RE-ISSUED FOR D		GAP	DR
ERENCE TO EXISTING	D 20.10.23 C 13.09.23	RE-ISSUED FOR D		GAP GAP	DR DR
AX 0.8m	B 24.01.23	ISSUED FOR DA		GAP	CJA
2	A 20.01.23 Rev Date	ISSUED FOR INFOR	RMATION	GAP Drawn	CJA
	PROJECT LANDO EDMO LOT 5	<b>Pick</b> e & development consulting		t consult et	
	DRAWING TITLE RETAI SHEE	NING WAL F 1	L PLAN		
	1:75	0	DA	[■] E	

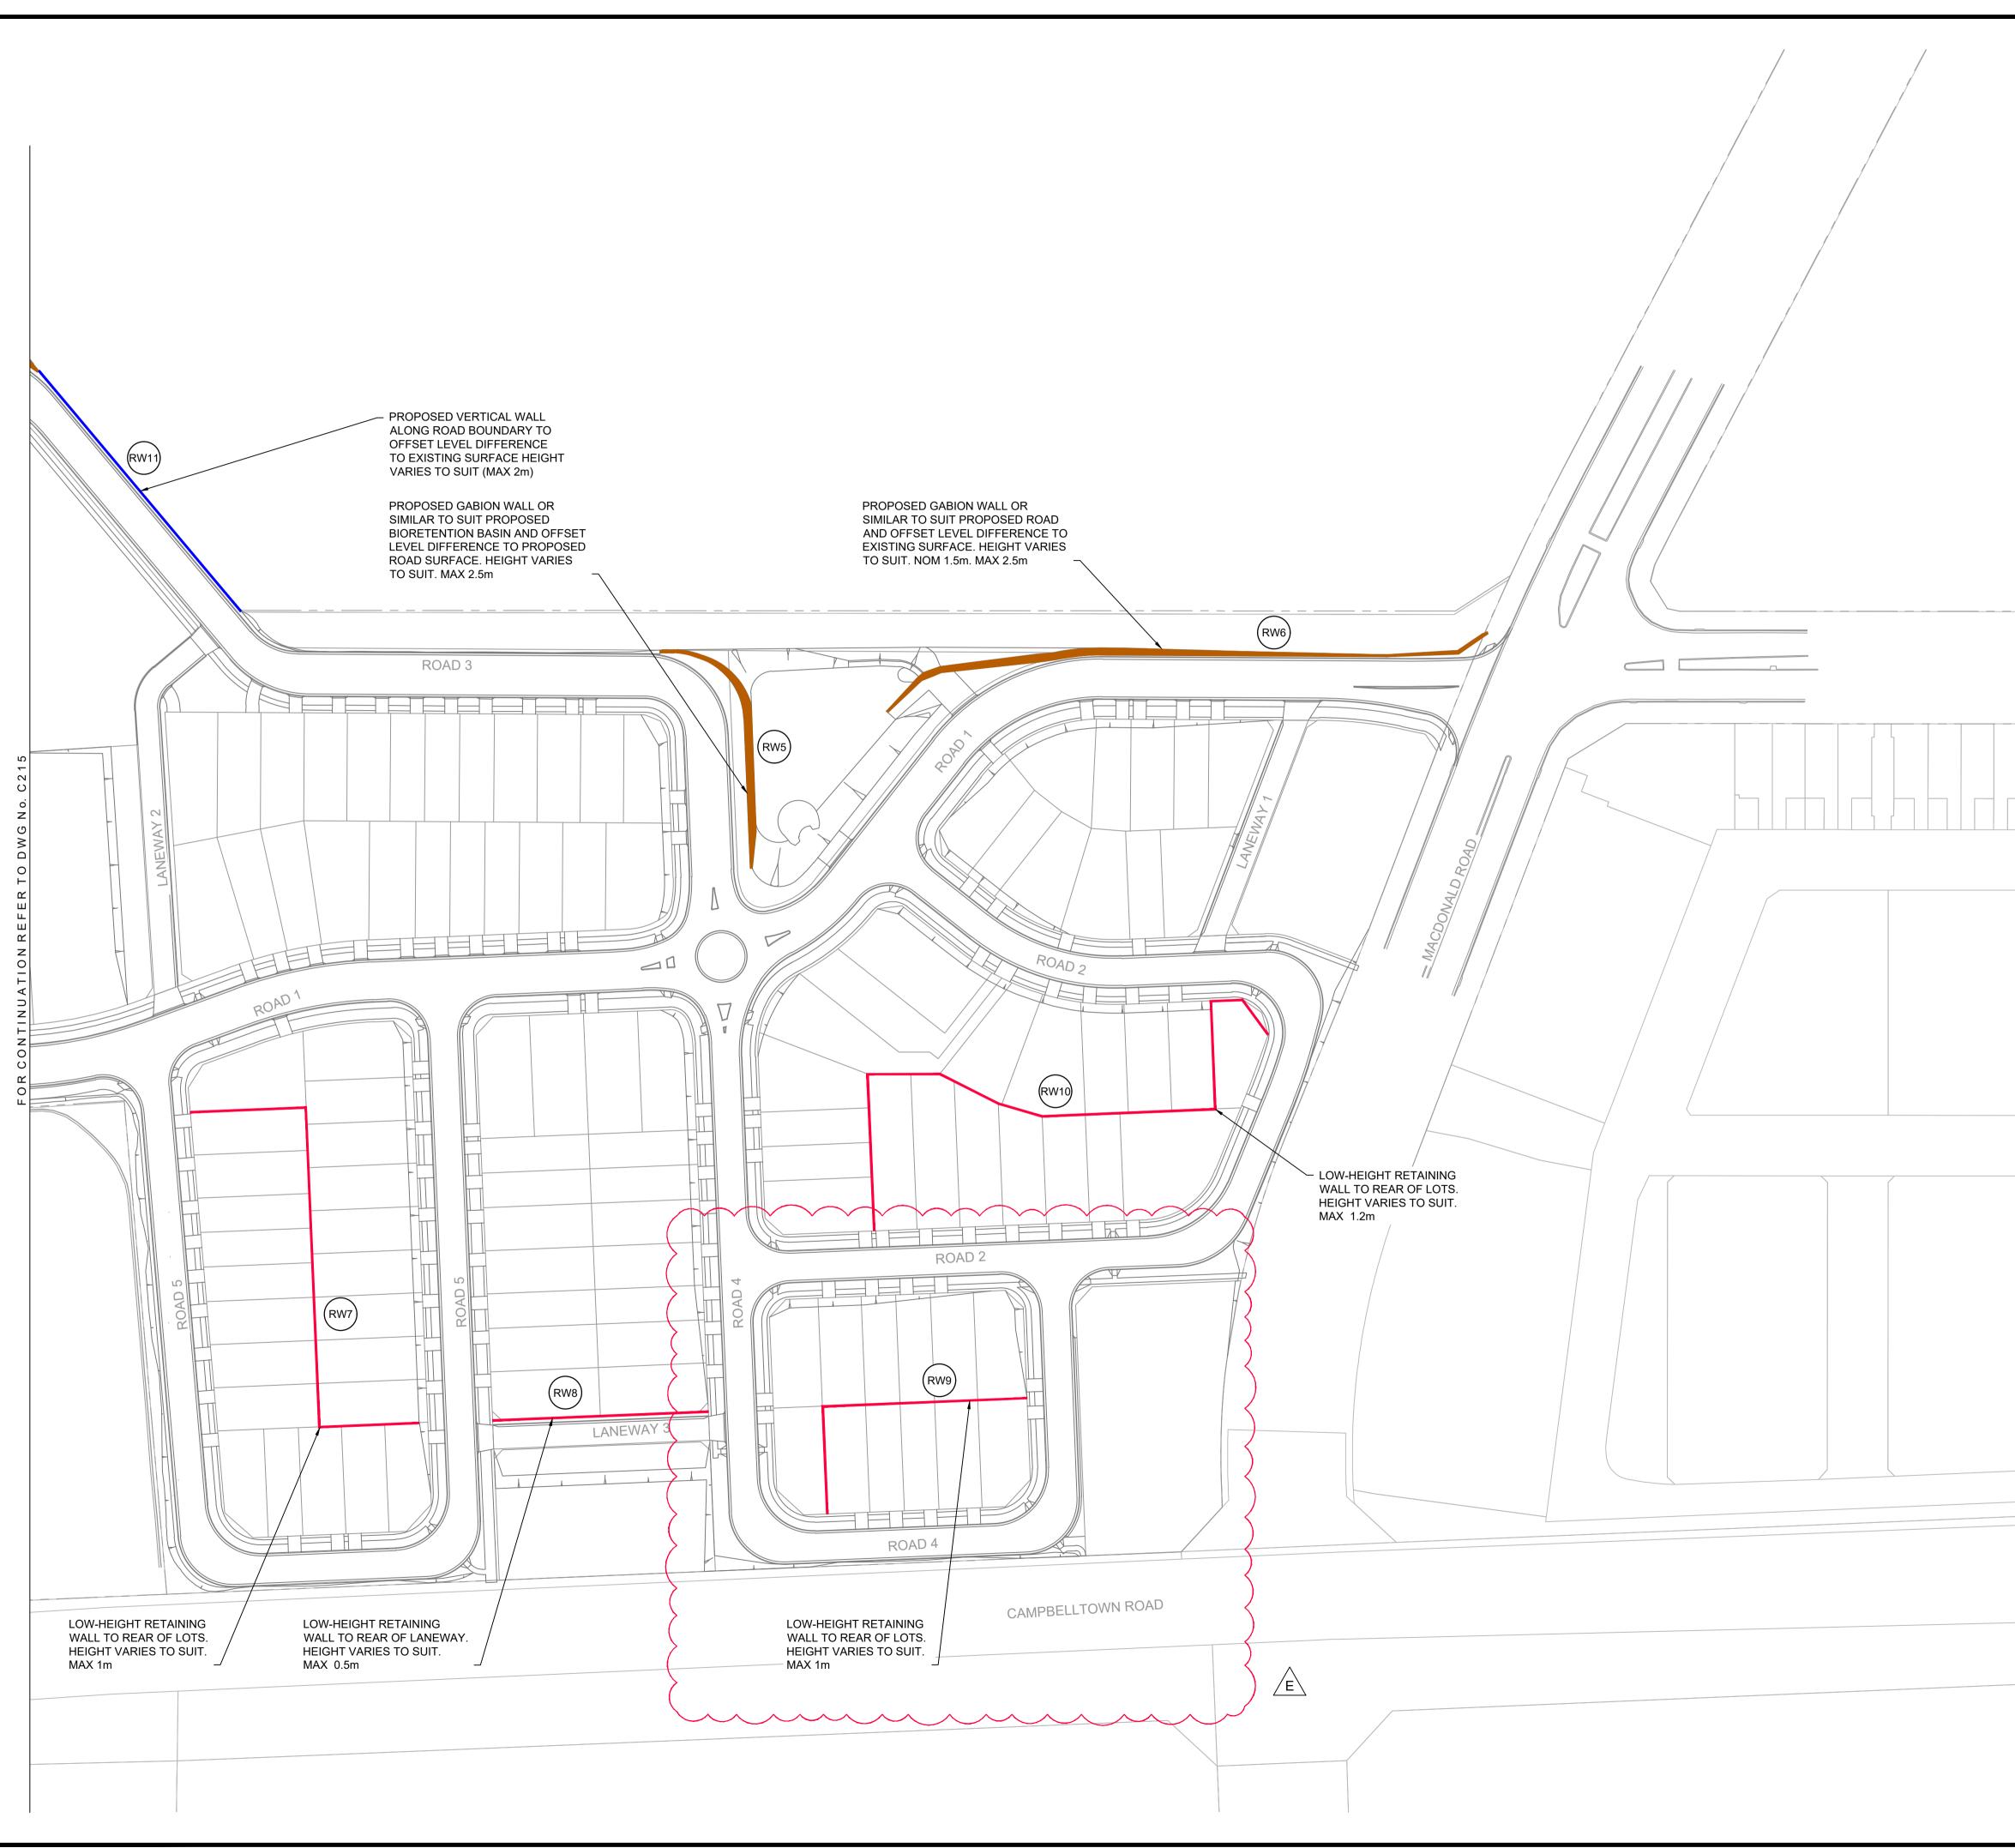



LEGEND				
	LEGEI	ND		]
RV	RETAINING	WALL NUMBER		
	DETAILS TO	) GABION WALL OR S D BE CONFIRMED DU DESIGN PHASE		
	DETAILS TO	) LOT RETAINING WA D BE CONFIRMED DU DESIGN PHASE		
	WALL. DET	) VERTICAL BOUNDA AILS TO BE CONFIRM TAILED DESIGN STA	/IED	
E 27.05.24	RE-ISSUED FOR DA		GAP	DR
D 20.10.23 C 13.09.23	RE-ISSUED FOR DA RE-ISSUED FOR DA		GAP GAP	DR DR
B 24.01.23 A 20.01.23	ISSUED FOR DA	TION	GAP GAP	CJA CJA
Rev Date	Description	rastructure & developm	Drawn nent consulti	
O-()-		ite 8.01, 56 Clarence S dney, NSW 2000 admin@idcaus.con www.idcaus.com		
LOT 5	COM NDSON PAR DP1272931 BELLTOWN F		CT 3	
DRAWING TITLE	NING WALL I			
scale 1:75	0 STA	TUS DA		
	22-514-DA		REV E	

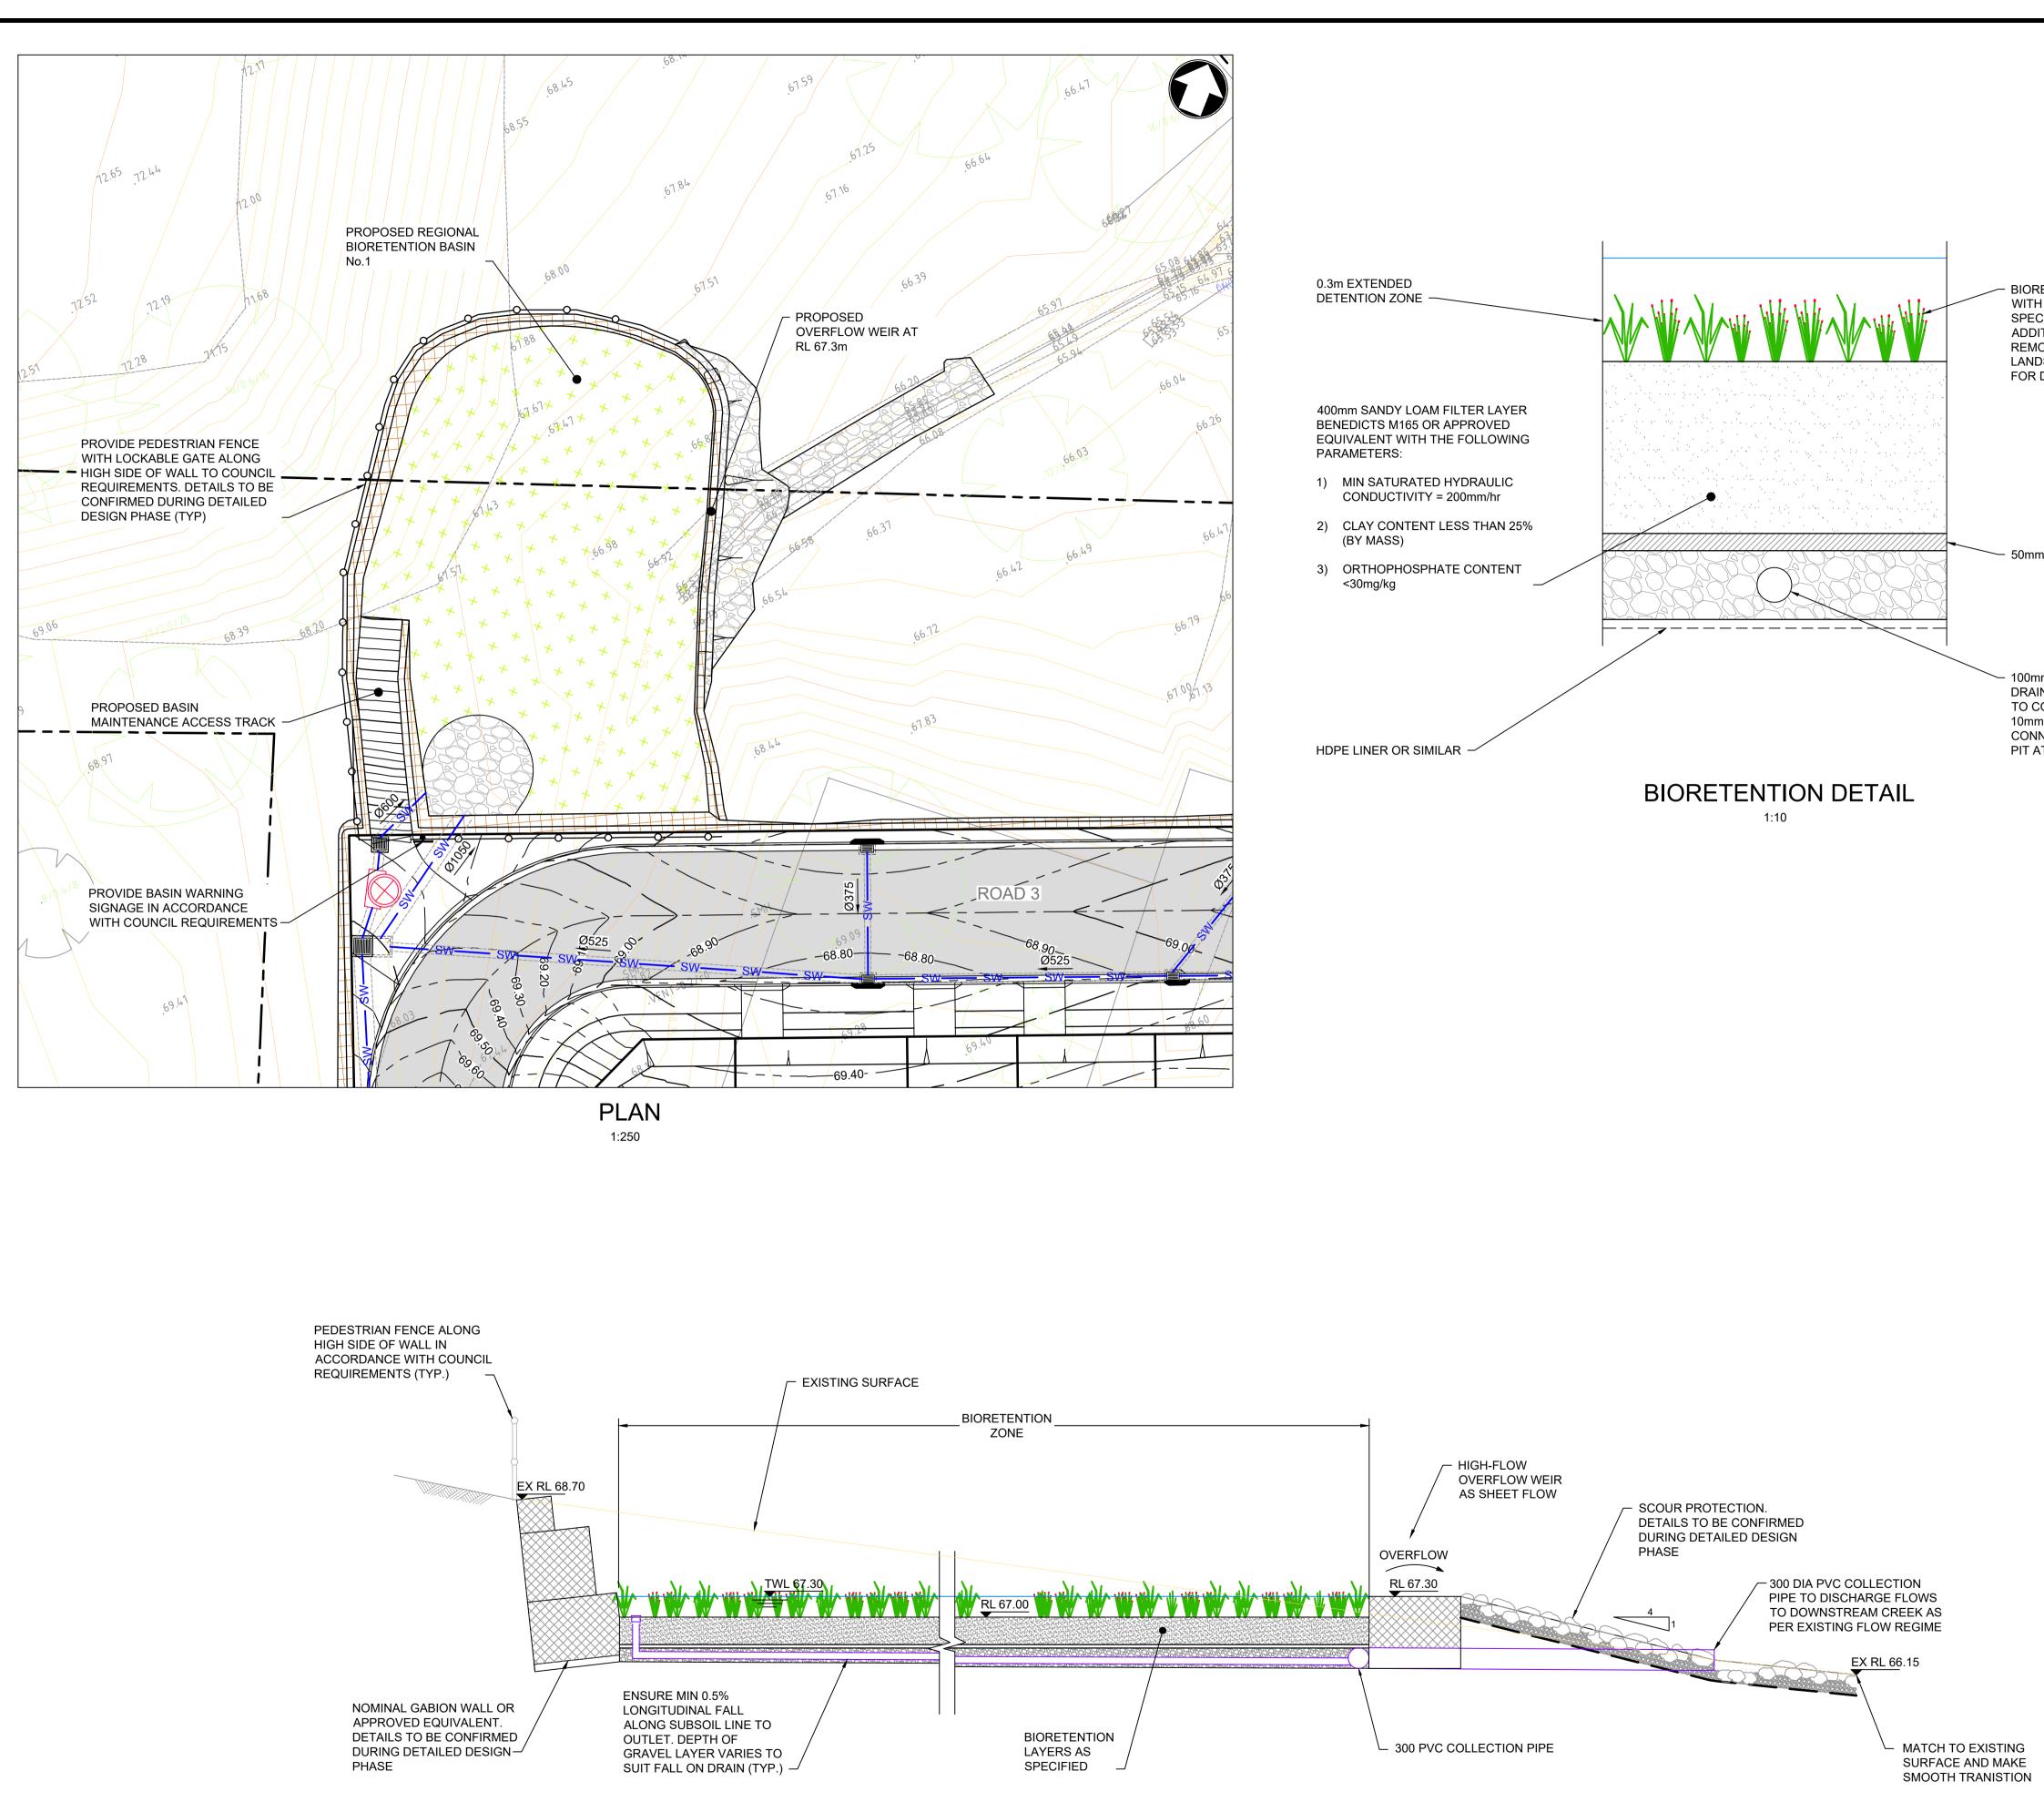


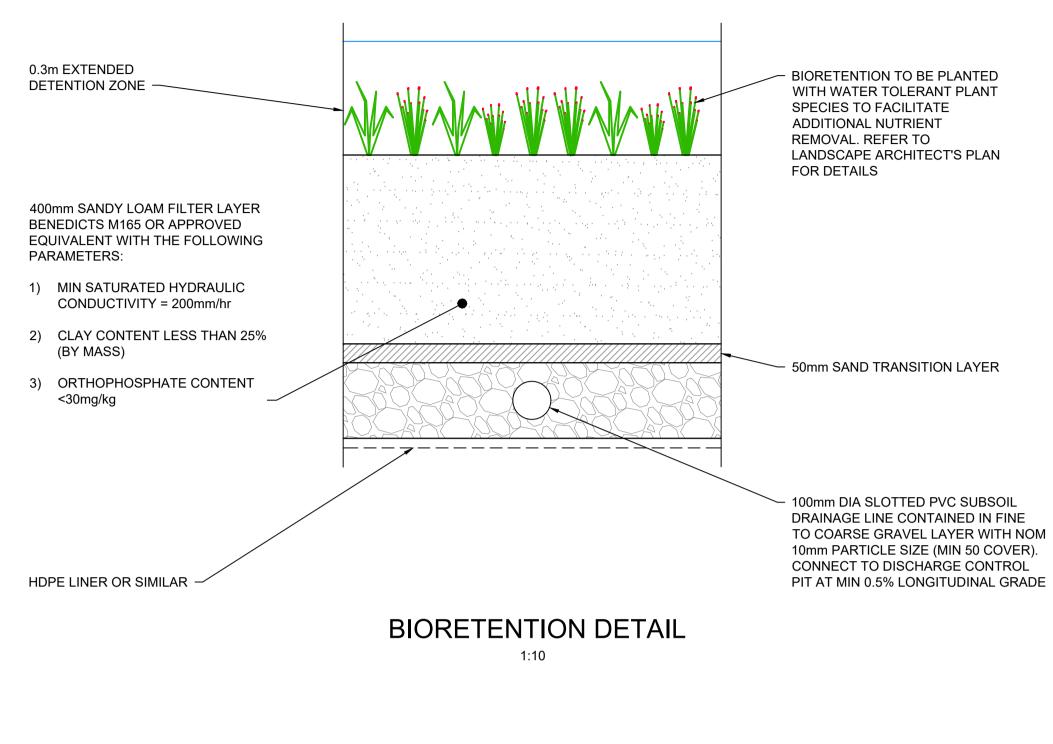



**TYPICAL SECTION - BIORETENTION BASIN No.1** 1:50

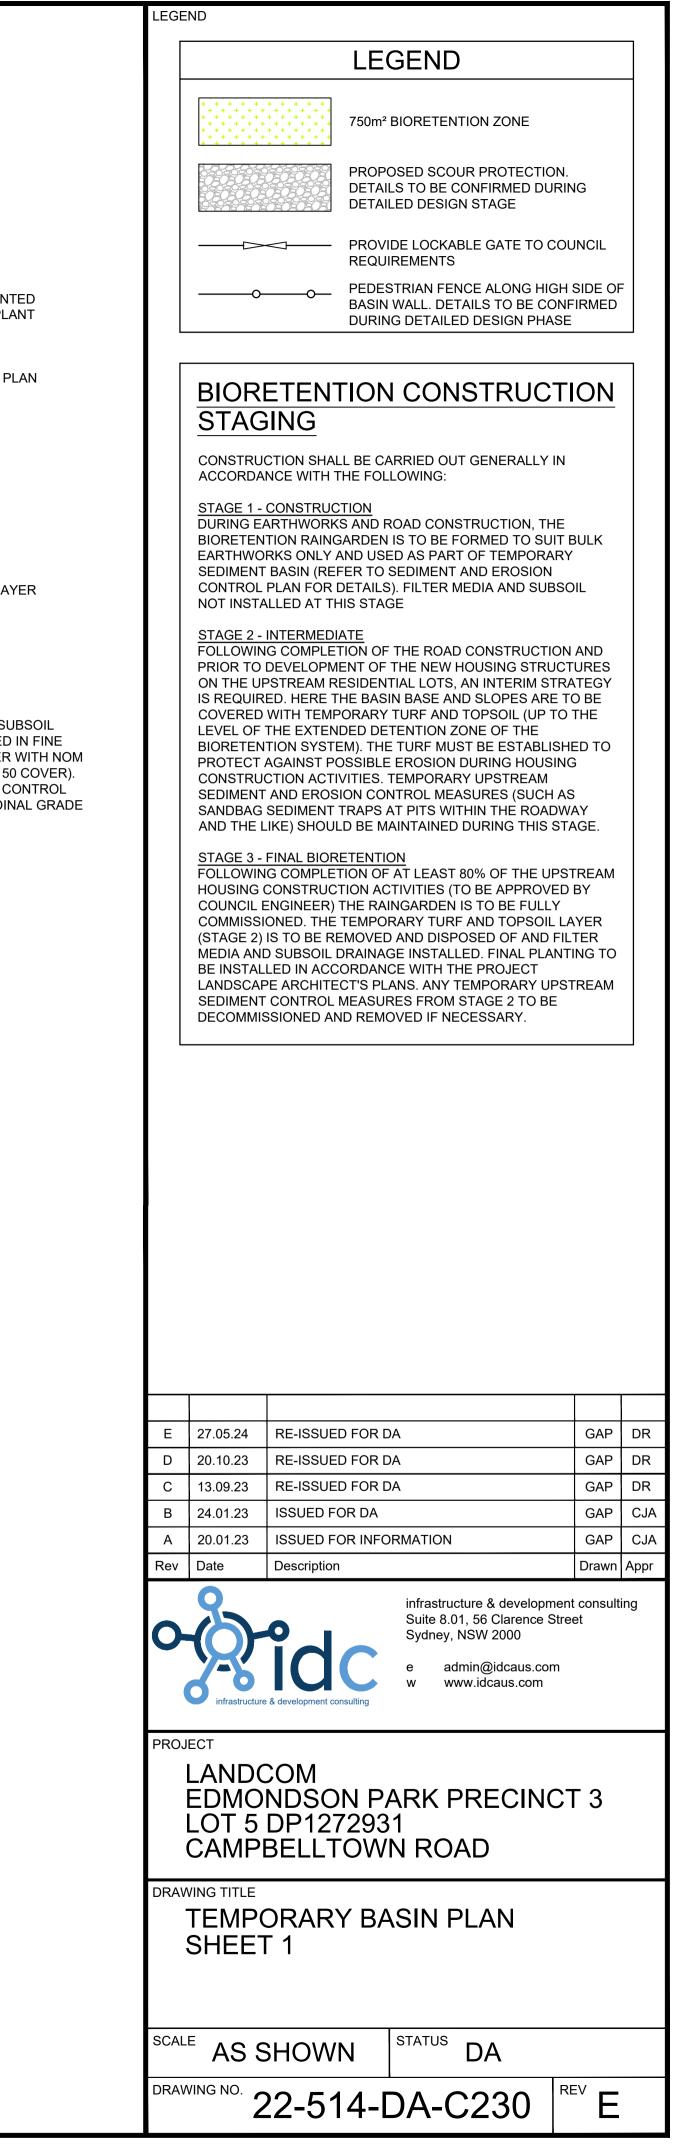

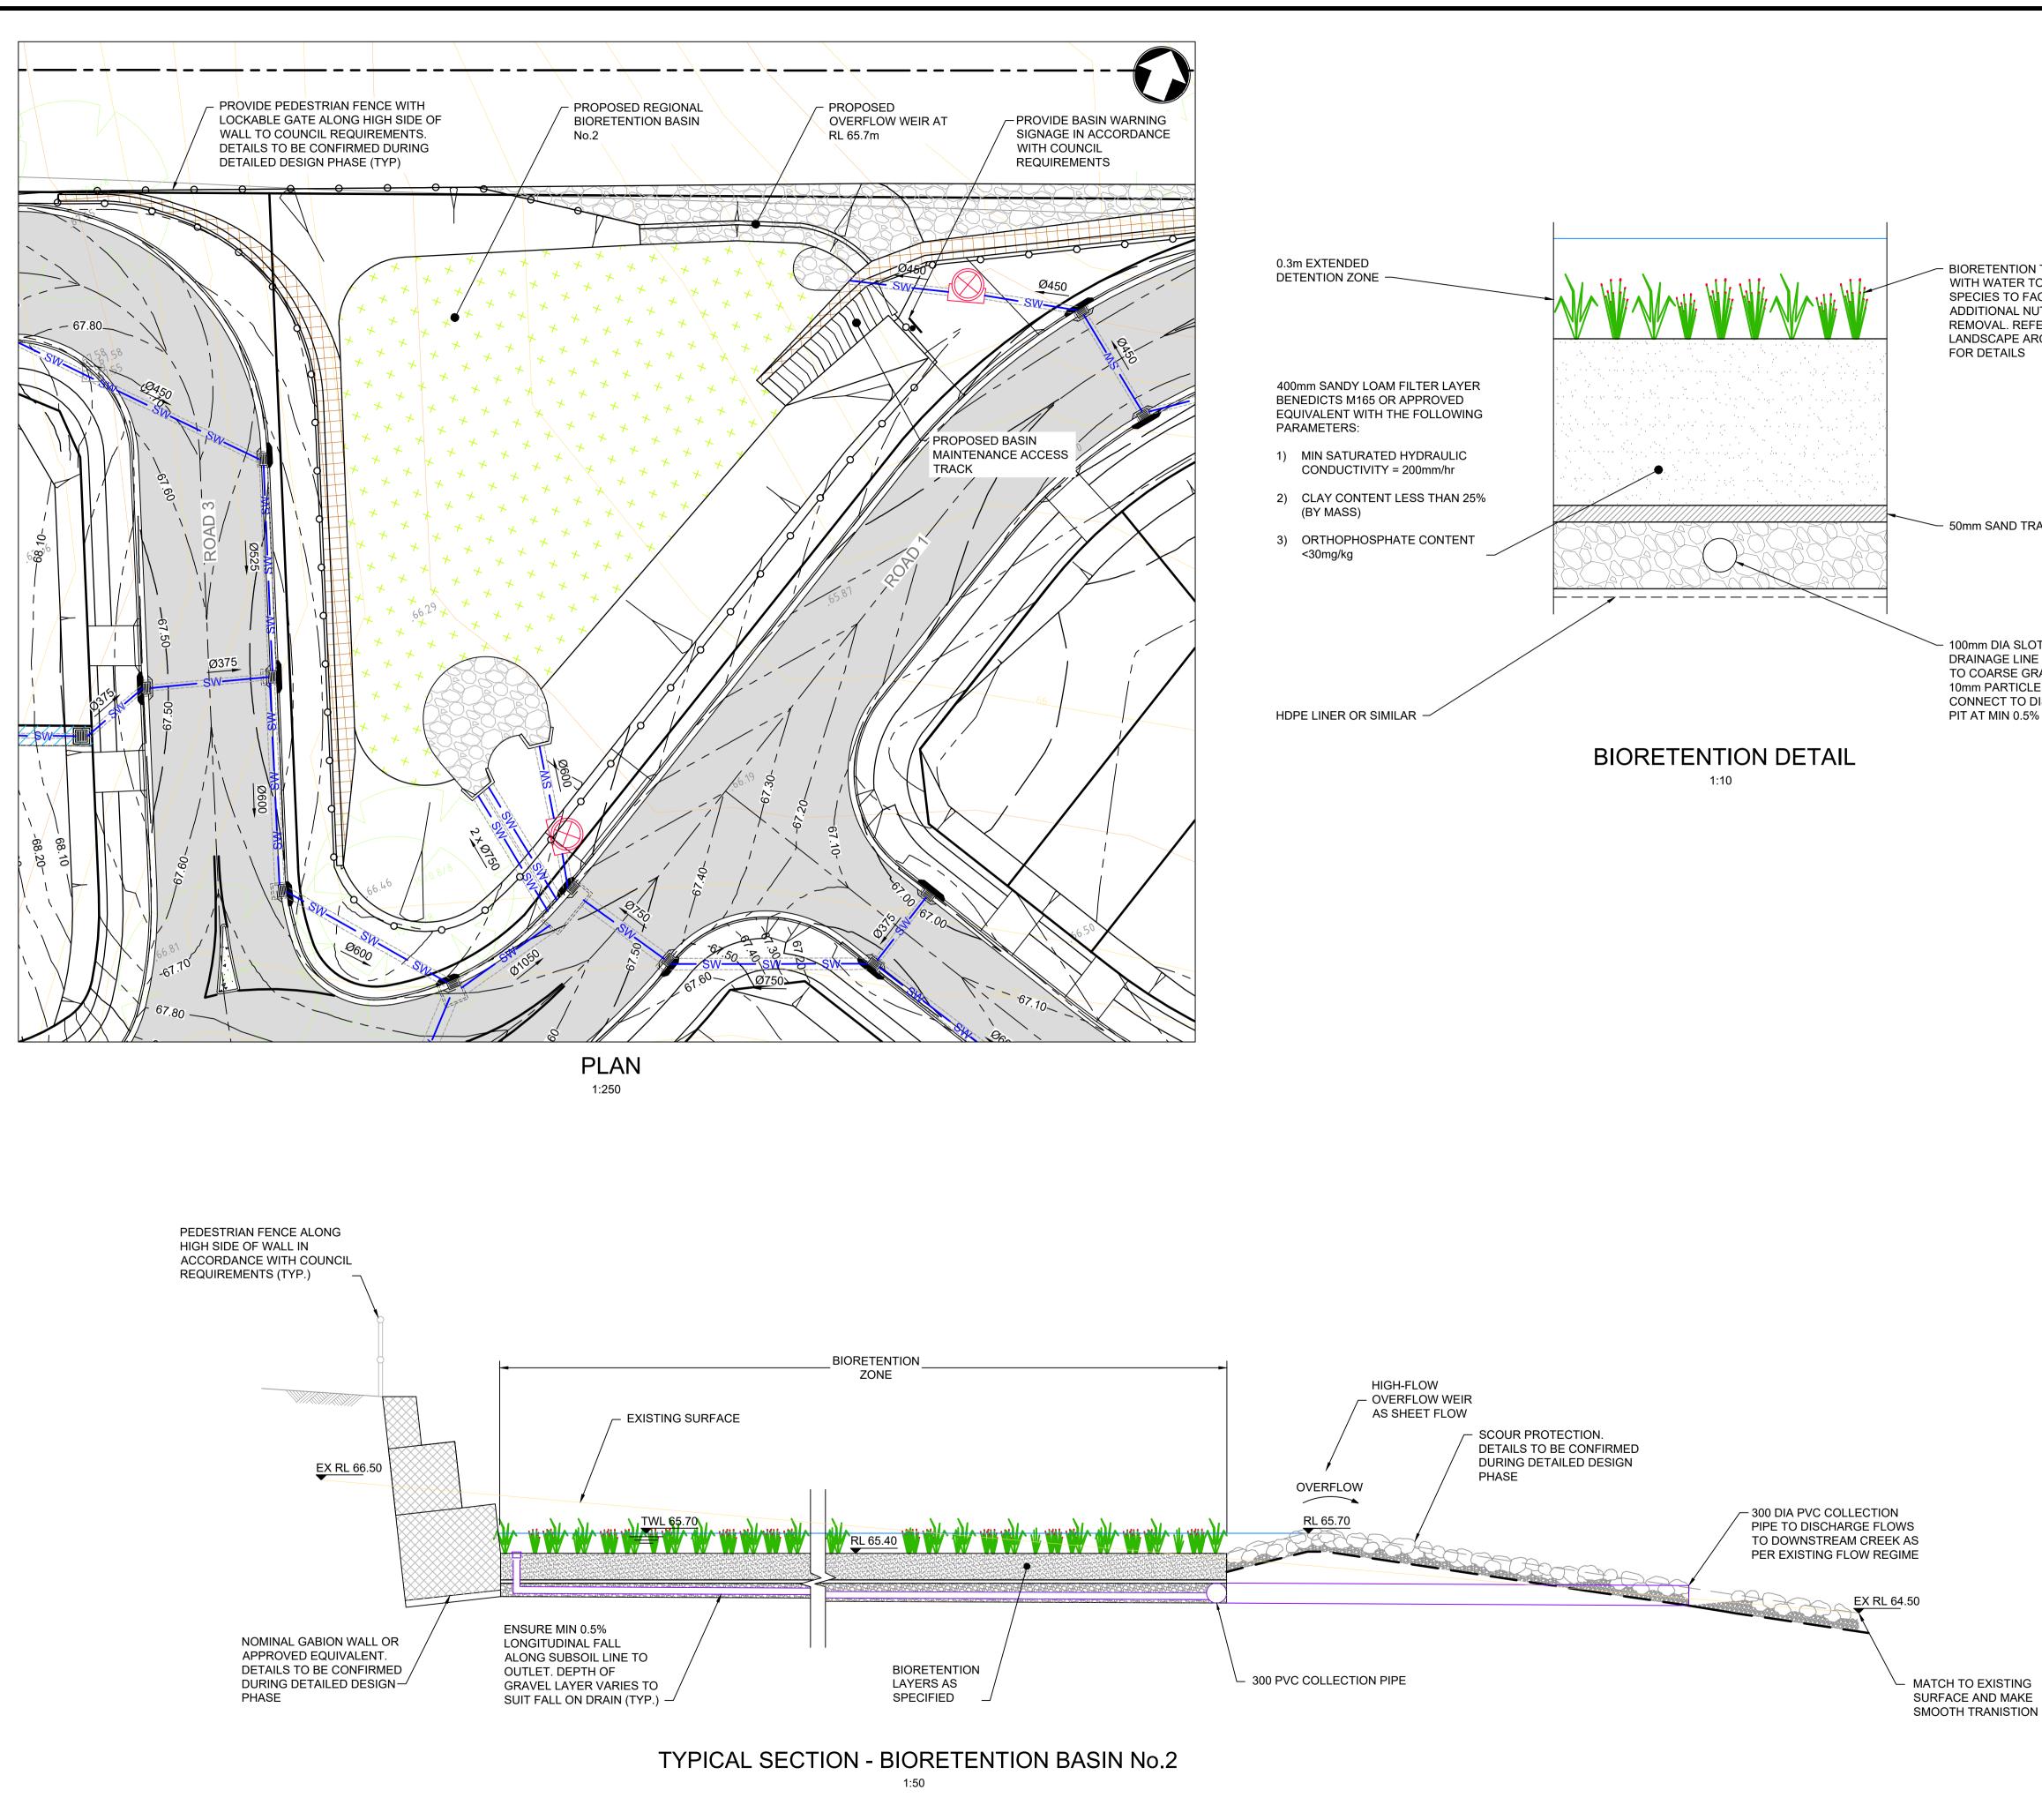

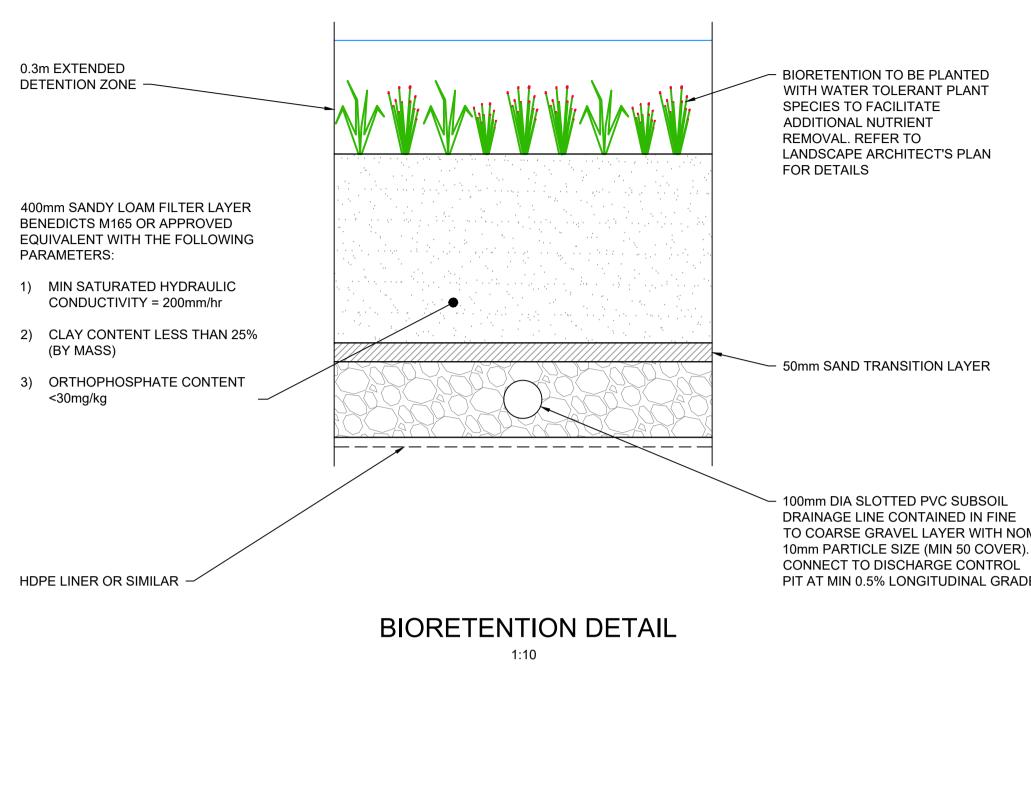

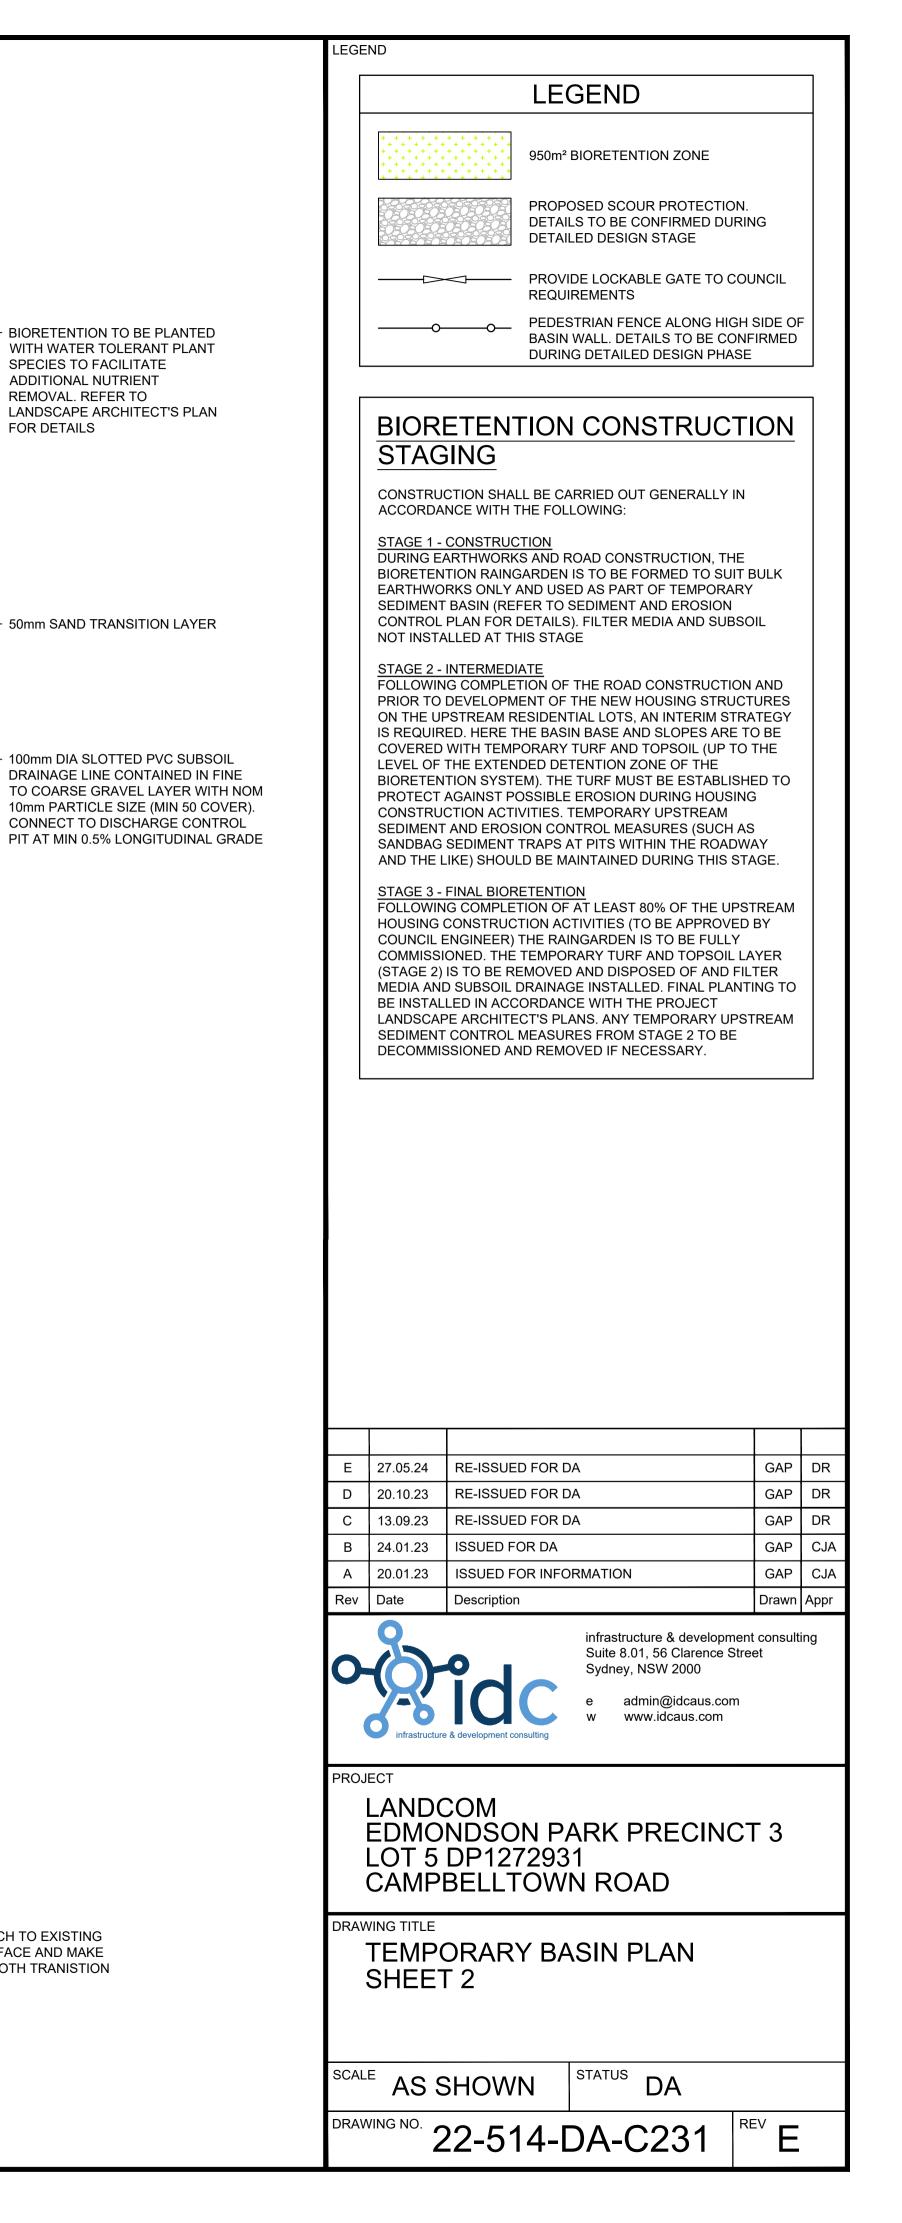

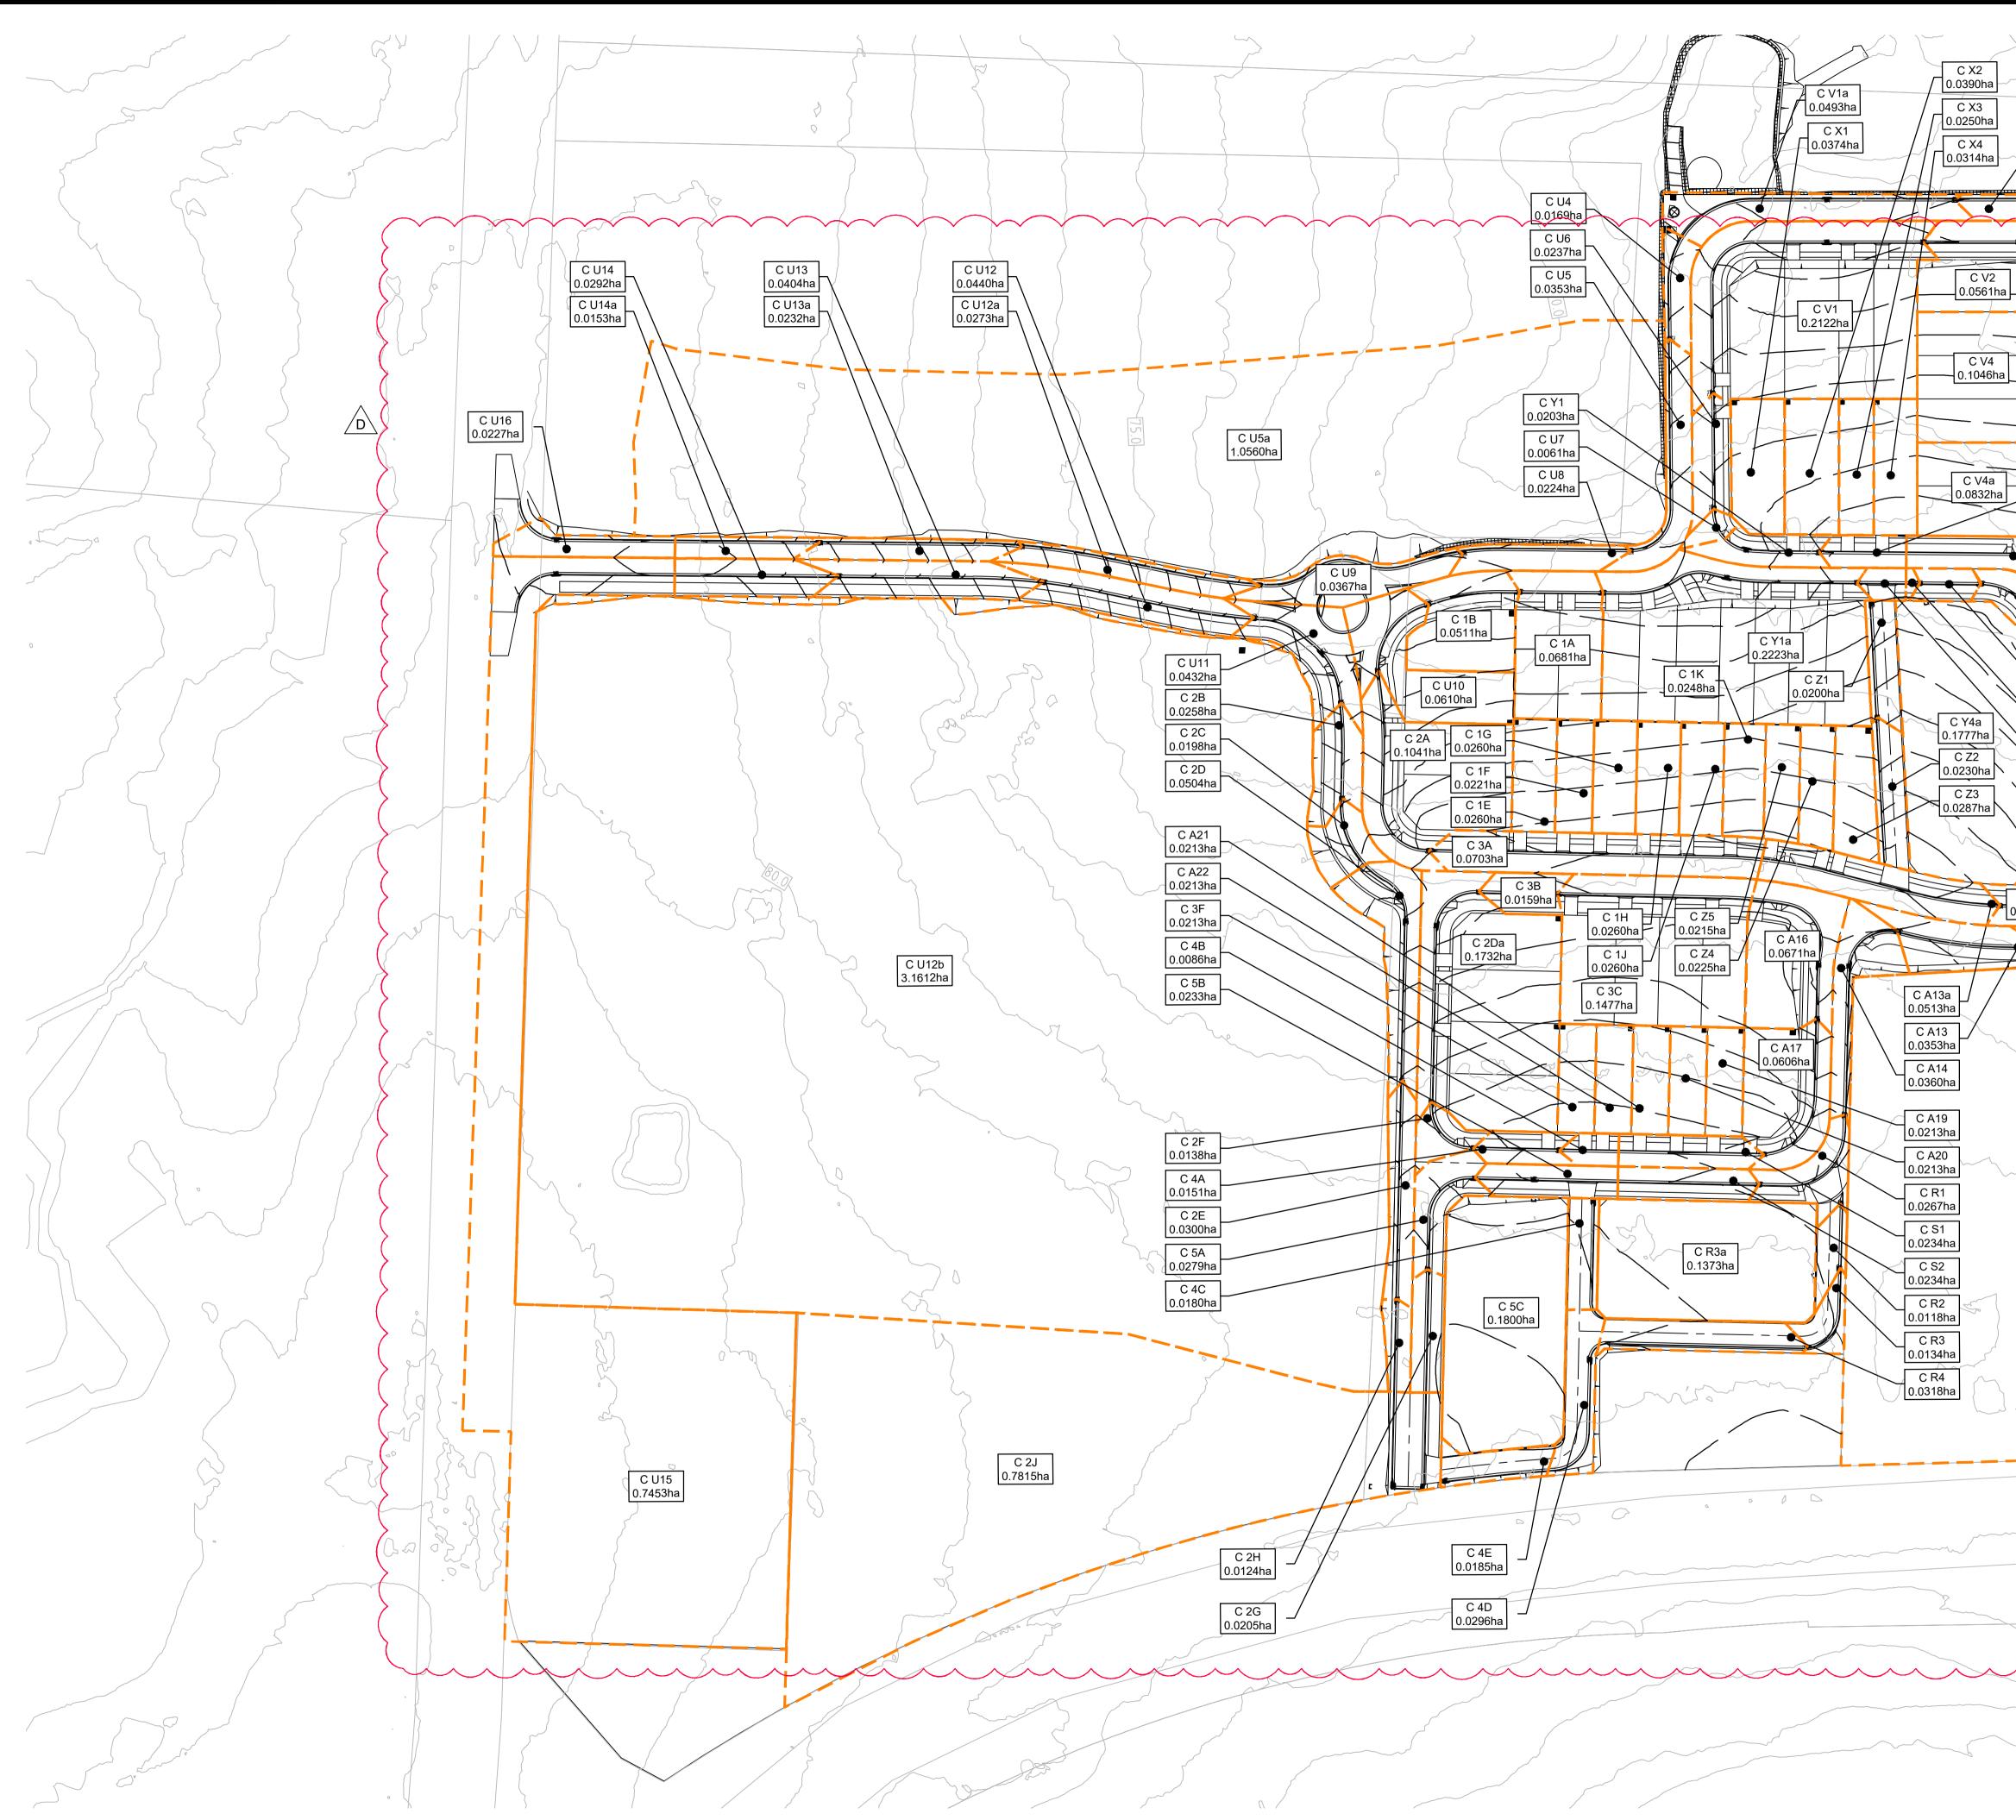

	LEGEND	
	LEGEND	
	DRAINS CATCHMENT BOUNDARY	
C V2a 0.0356ha	C A2 DRAINS CATCHMENT LABEL 0.0257ha CATCHMENT AREA	
C Y3 0.0850ha C Y3 0.0850ha C Y2 0.140ha C Y7 0.1463ha C Y7 0.1463ha C Y7 0.1463ha C Y7 0.1463ha C Y7 0.1463ha C Y7 0.1463ha C Y7 0.1463ha C Y7 0.0016ha C Y3 0.0073ha C Y3 0.0073ha C Y2 0.0104ha C Y3 0.0073ha C Y3 0.0076ha		
C Q2 1.0774ha		
	D 27.05.24 RE-ISSUED FOR DA	GAP DR
	C 20.10.23 RE-ISSUED FOR DA	GAP DR
	B13.09.23RE-ISSUED FOR DAA24.01.23ISSUED FOR DA	GAP DR GAP CJA
	Rev         Date         Description	Drawn Appr
	infrastructure & development Suite 8.01, 56 Clarence Str Sydney, NSW 2000 e admin@idcaus.com www.idcaus.com	reet
	PROJECT LANDCOM EDMONDSON PARK PRECINC LOT 5 DP1272931 CAMPBELLTOWN ROAD	:Т З
	DRAINS CATCHMENT PLAN SHEET 1	
13.0	SCALE 1:750 STATUS DA	
		^{REV} D
		U



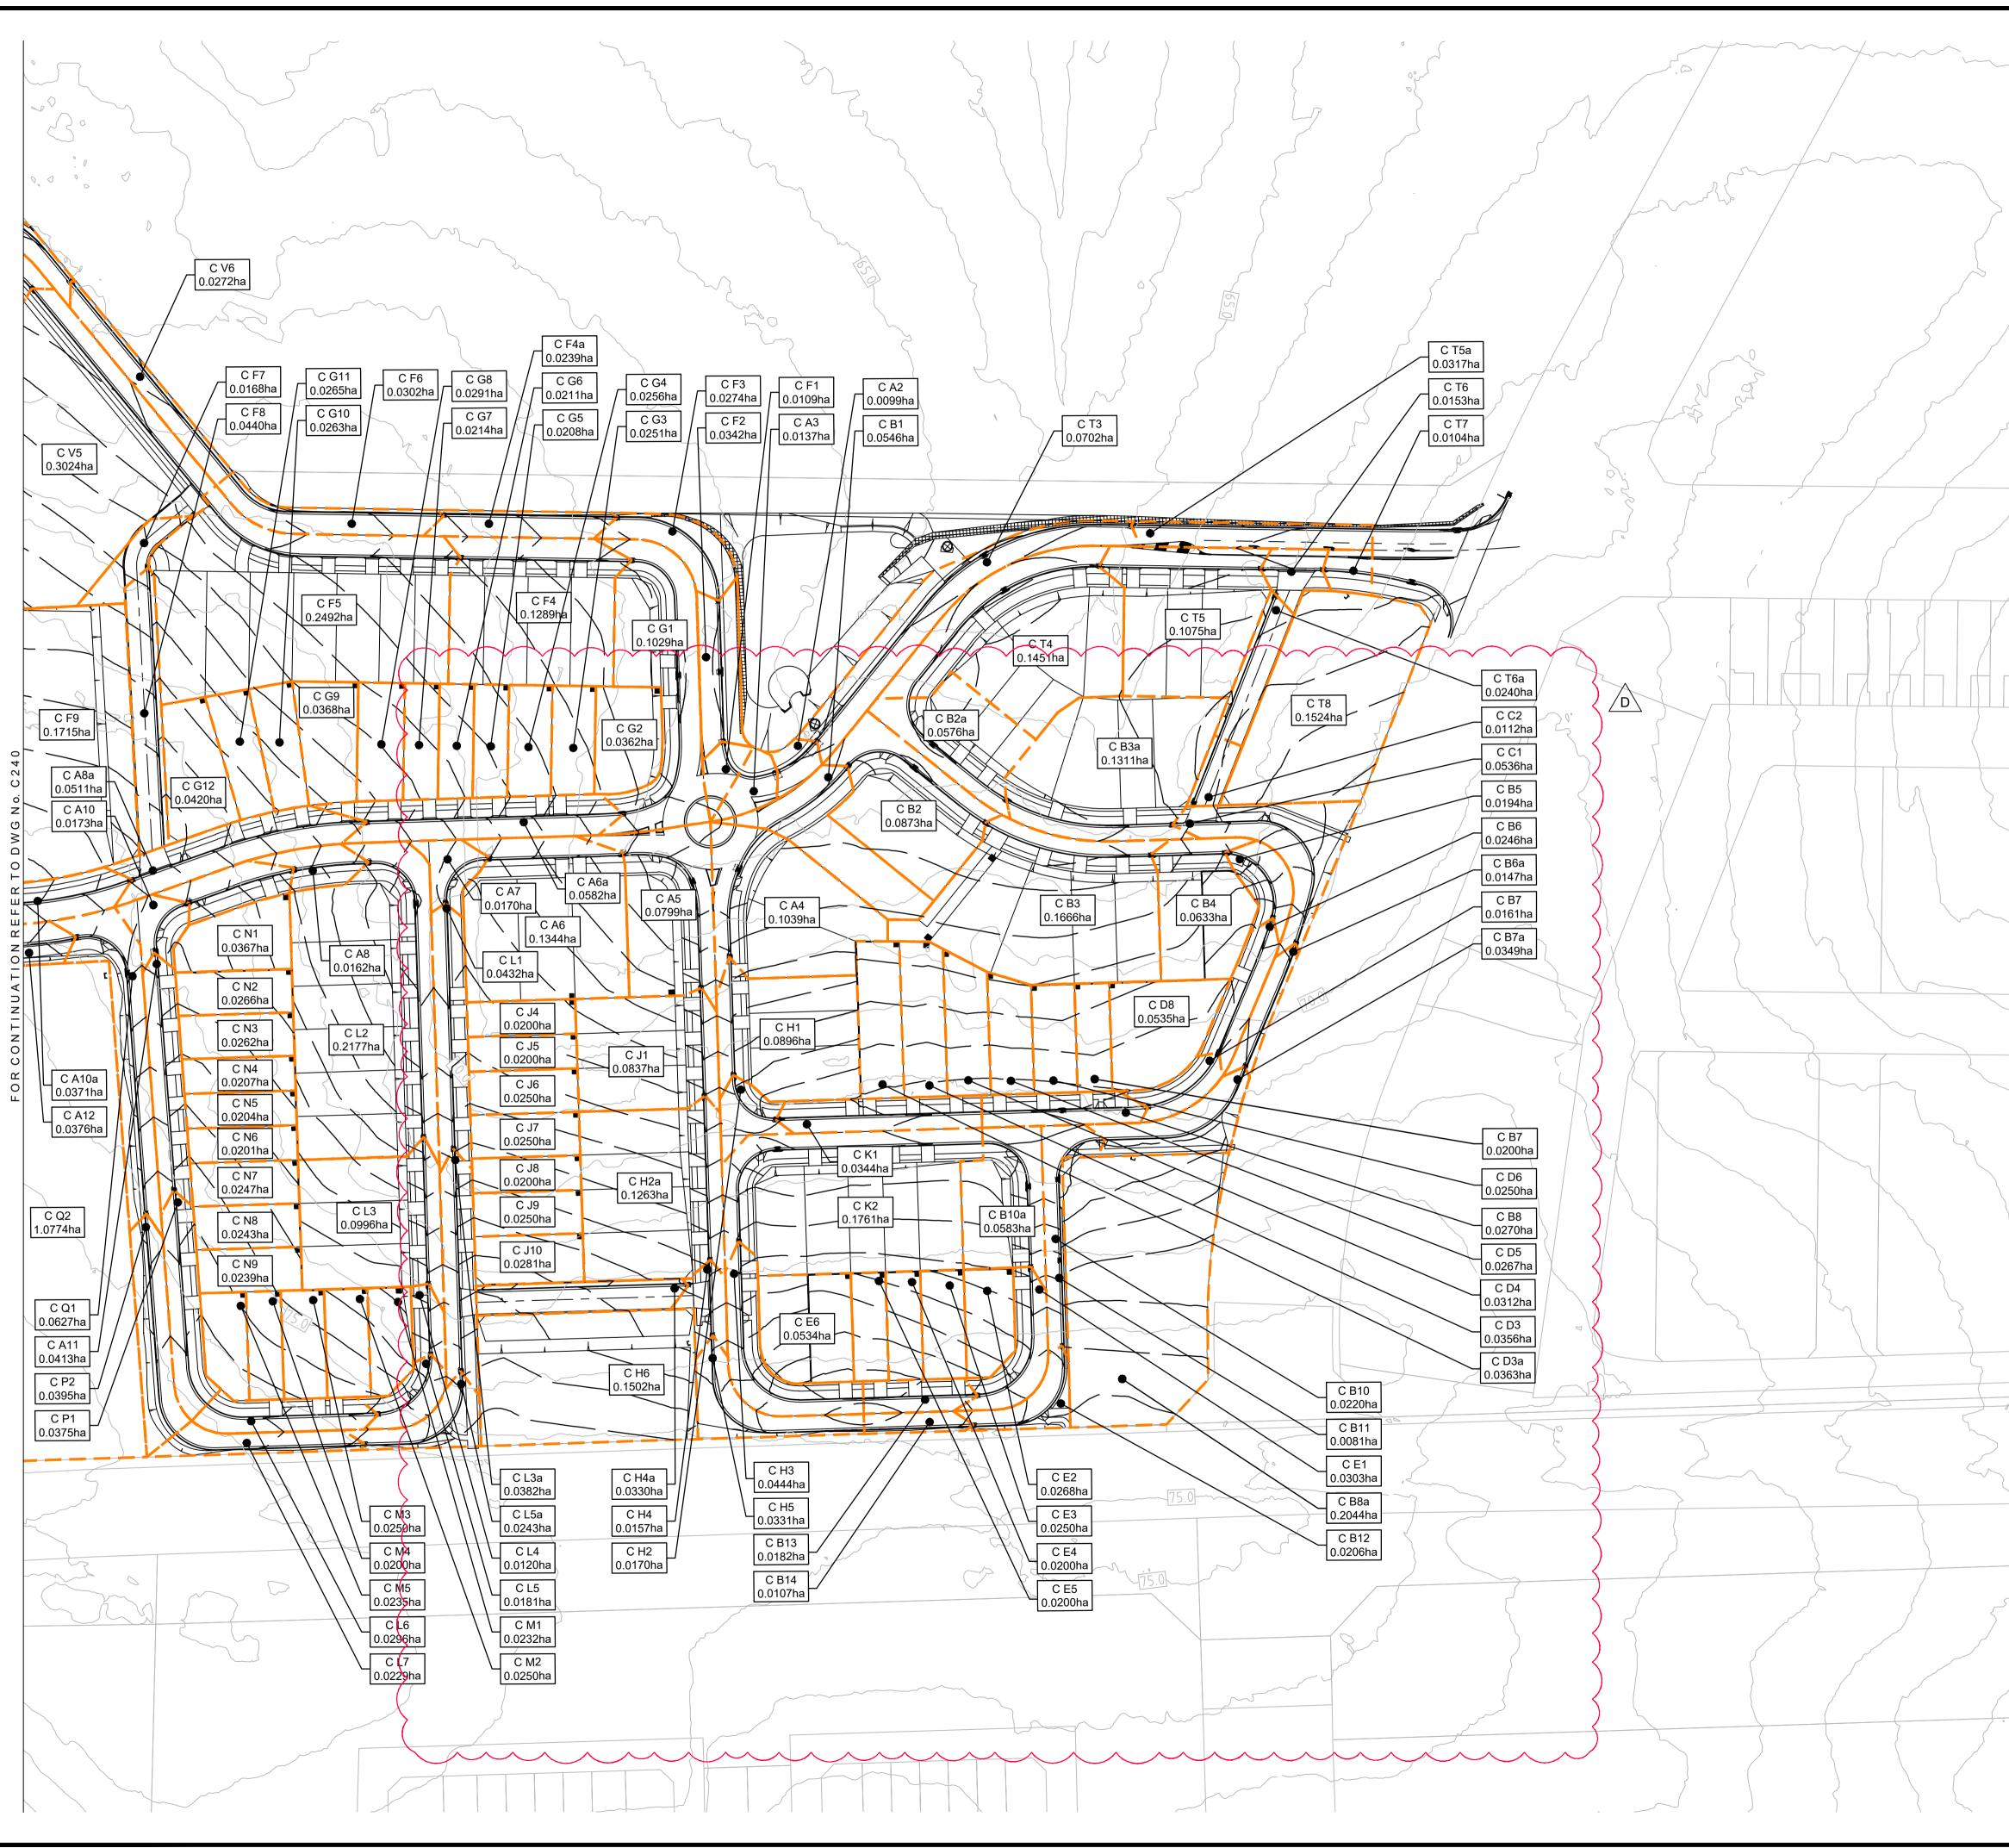



Image: Distance catcher is boundary           C A2 0.0257/ha         DRAINS CATCHMENT LABEL 0.0257/ha           Image: Distance catcher is boundary           Image: Distance catcher is boundary		LEGEND		
DRAINS CATCHMENT BOUNDARY           C A2 0.0257ha         DRAINS CATCHMENT LABEL           0.0257ha         CATCHMENT AREA		LEGEND		]
0.0257ha CATCHMENT AREA			 (	
D         27.05.24         FE-ISSUED FOR DA         GAP         DR.           C         20.10.23         RE-ISSUED FOR DA         GAP         DR.           A         24.01.23         ISSUED FOR DA         GAP         DR.				
C20.10.23RE-ISSUED FOR DAGAPDRB13.09.23RE-ISSUED FOR DAGAPDRA24.01.23ISSUED FOR DAGAPCJA		0.0257ha CATCHMENT AREA		
C20.10.23RE-ISSUED FOR DAGAPDRB13.09.23RE-ISSUED FOR DAGAPDRA24.01.23ISSUED FOR DAGAPCJA				
C20.10.23RE-ISSUED FOR DAGAPDRB13.09.23RE-ISSUED FOR DAGAPDRA24.01.23ISSUED FOR DAGAPCJA	يولى			
C20.10.23RE-ISSUED FOR DAGAPDRB13.09.23RE-ISSUED FOR DAGAPDRA24.01.23ISSUED FOR DAGAPCJA				
C20.10.23RE-ISSUED FOR DAGAPDRB13.09.23RE-ISSUED FOR DAGAPDRA24.01.23ISSUED FOR DAGAPCJA	$\int \int \int $			
C20.10.23RE-ISSUED FOR DAGAPDRB13.09.23RE-ISSUED FOR DAGAPDRA24.01.23ISSUED FOR DAGAPCJA				
C20.10.23RE-ISSUED FOR DAGAPDRB13.09.23RE-ISSUED FOR DAGAPDRA24.01.23ISSUED FOR DAGAPCJA				
C20.10.23RE-ISSUED FOR DAGAPDRB13.09.23RE-ISSUED FOR DAGAPDRA24.01.23ISSUED FOR DAGAPCJA				
C20.10.23RE-ISSUED FOR DAGAPDRB13.09.23RE-ISSUED FOR DAGAPDRA24.01.23ISSUED FOR DAGAPCJA	$\langle \rangle$			
C20.10.23RE-ISSUED FOR DAGAPDRB13.09.23RE-ISSUED FOR DAGAPDRA24.01.23ISSUED FOR DAGAPCJA				
C20.10.23RE-ISSUED FOR DAGAPDRB13.09.23RE-ISSUED FOR DAGAPDRA24.01.23ISSUED FOR DAGAPCJA				
B13.09.23RE-ISSUED FOR DAGAPDRA24.01.23ISSUED FOR DAGAPCJA				
				DR
	T.	e admin@idcaus.com	n	
Sydney, NSW 2000 e admin@idcaus.com	0	w www.idcaus.com		
e admin@idcaus.com www.idcaus.com				
PROJECT		EDMONDSON PARK PRECING LOT 5 DP1272931	CT 3	
PROJECT LANDCOM EDMONDSON PARK PRECINCT 3 LOT 5 DP1272931		DRAWING TITLE		$\neg$
PROJECT LANDCOM EDMONDSON PARK PRECINCT 3 LOT 5 DP1272931 CAMPBELLTOWN ROAD DRAWING TITLE		DRAINS CATCHMENT PLAN SHEET 2		
PROJECT LANDCOM EDMONDSON PARK PRECINCT 3 LOT 5 DP1272931 CAMPBELLTOWN ROAD DRAWING TITLE DRAINS CATCHMENT PLAN		SCALE 1.750 STATUS DA		
PROJECT LANDCOM EDMONDSON PARK PRECINCT 3 LOT 5 DP1272931 CAMPBELLTOWN ROAD DRAWING TITLE DRAINS CATCHMENT PLAN SHEET 2				
PROJECT LANDCOM EDMONDSON PARK PRECINCT 3 LOT 5 DP1272931 CAMPBELLTOWN ROAD DRAWING TITLE DRAINS CATCHMENT PLAN SHEET 2 SCALE 1:750 STATUS DA		DRAWING NO. 22-514-DA-C241	U	

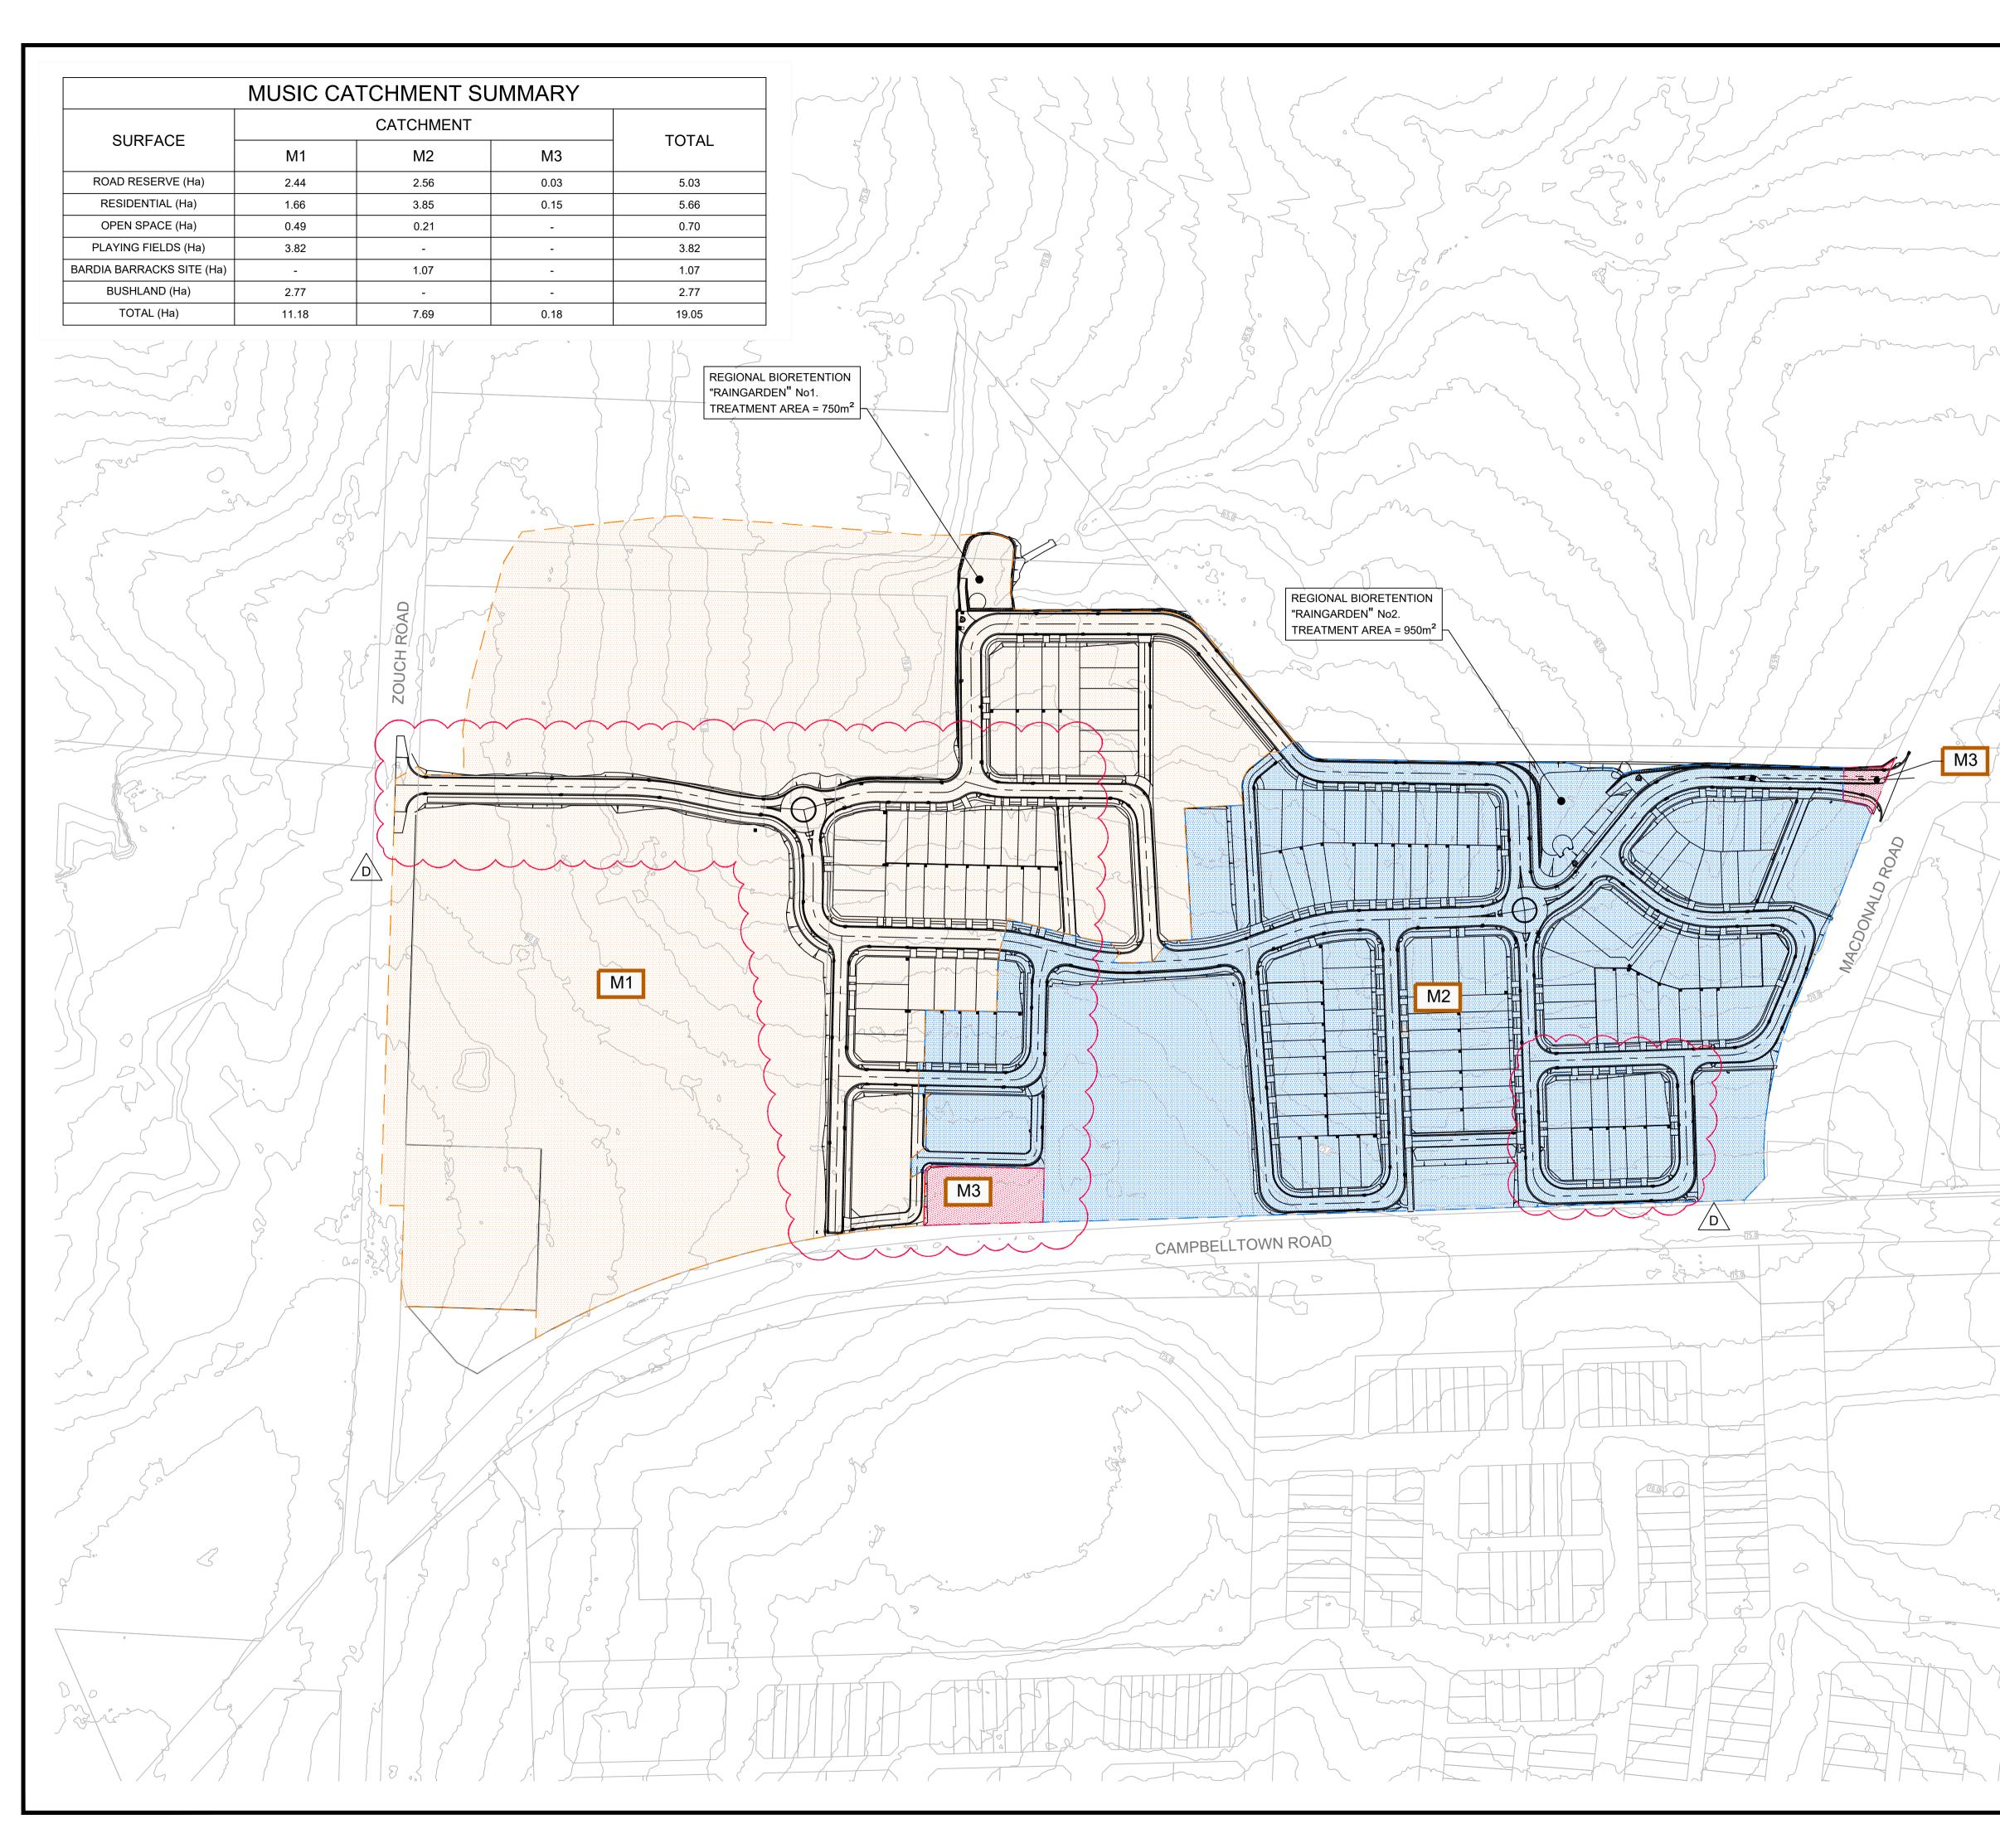


	LEGE	IND				
	ſ			LEGEND		
		MAX\	WELLS (	CRESCENT CATCHMEN	IT	
in the			M1	MUSIC SUB-CATCHMENT M1 (W CATCHMENT) DRAINING TO RE	GIONAL	
lo man			v12	BIORETENTION "RAINGARDEN" MUSIC SUB-CATCHMENT M2 (E CATCHEMNT) DRAINING TO RE	ASTERN	
° · · · ·				BIORETENTION "RAINGARDEN"	No. 2	
		N	VI3	MUSIC SUB-CATCHMENT M3 BY RAINGARDENS AND DISCHARG DIRECTLY TO MACDONALD RO CAMBELLTOWN ROAD	ING	
m						
for						
from						
_						
		1				
~~~~~~~~~~~~~~~~~~~~~~~~~~~~~~~~~~~~~~~						
	D	27.05.24		D FOR DA	GAP	DR
	C B	20.10.23 13.09.23	_	D FOR DA	GAP GAP	DR DR
	A	24.01.23	ISSUED F		GAP	CJA
	Rev	Date	Description	1	Drawn	Appr
		Q		infrastructure & developn		ing
\langle			-0	Suite 8.01, 56 Clarence S Sydney, NSW 2000	Street	
			ĩd	e admin@idcaus.com	n	
			re & development co			
	PRO					
			UUM NIDer	N PARK PRECIN	ст з	
		LOT 5	DP12	72931 OWN ROAD	515	
	DRAV	VING TITLE				
		MUSI	CAT(CHMENT PLAN		
	SCAL	^E 1:15	500	STATUS DA		
	DRAV	WING NO.	22-5 [^]	14-DA-C245		

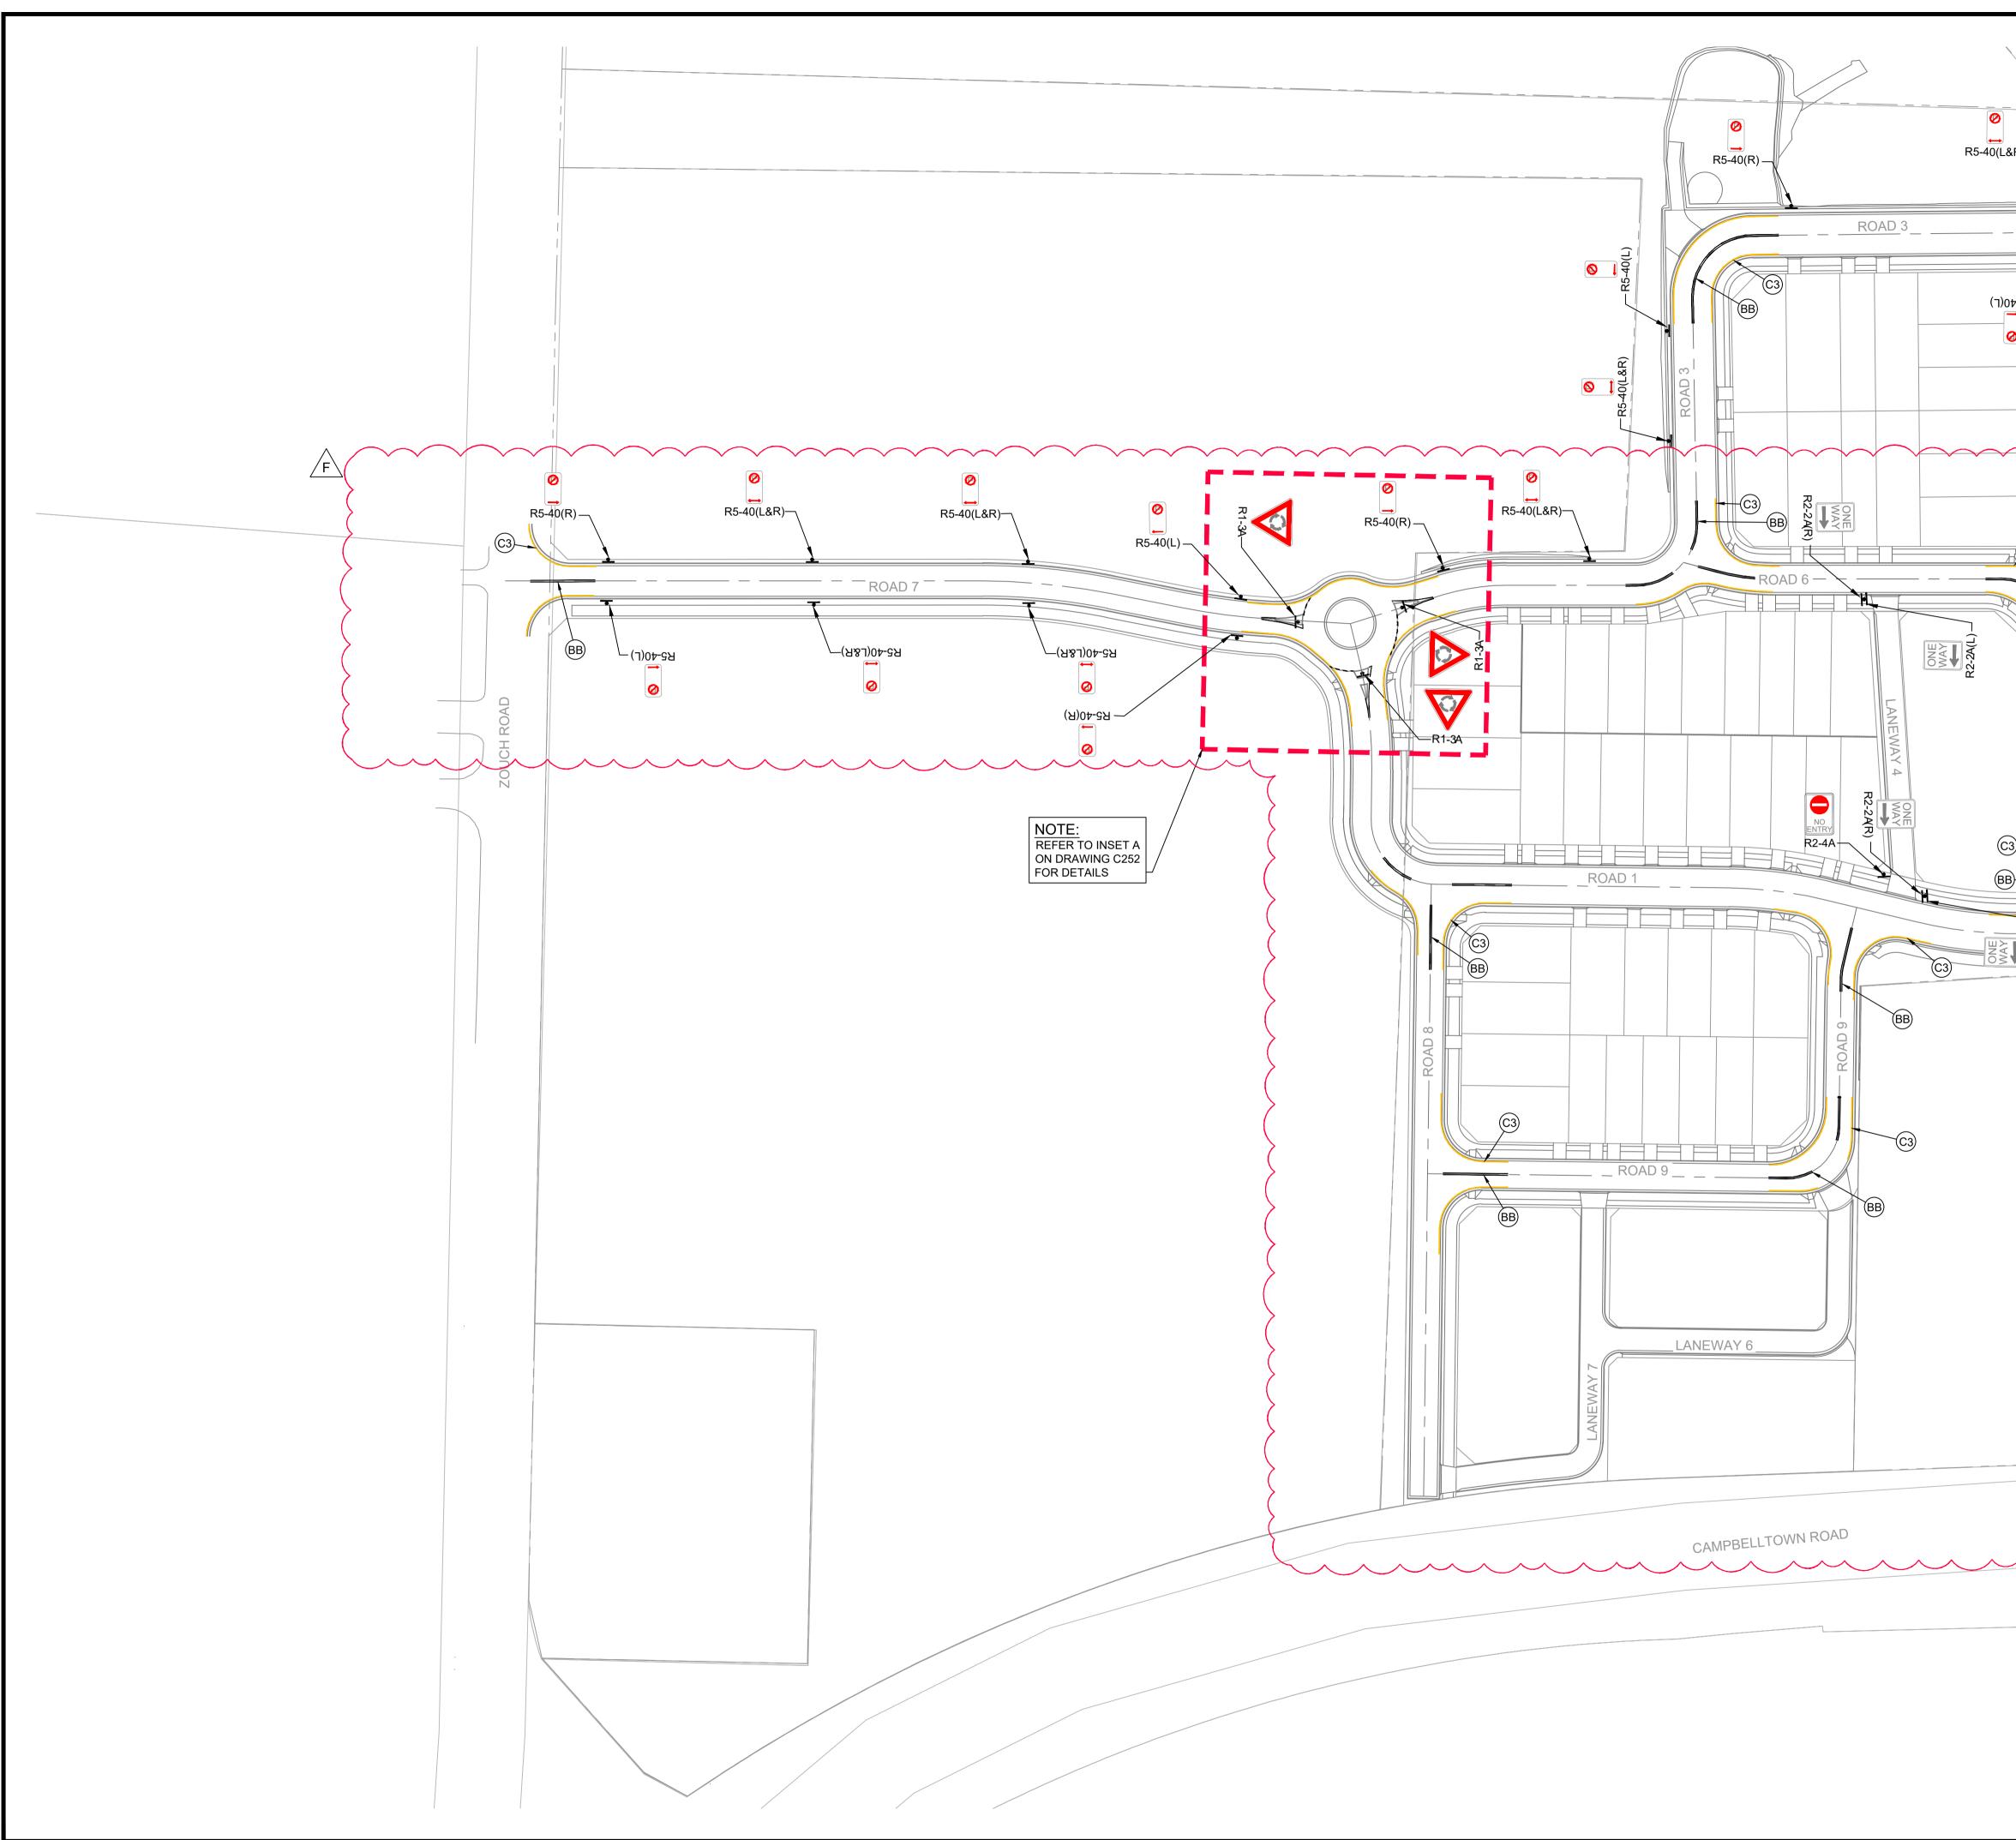


	LEGEND	
	LEGEND	
	ALL SIGNPOSTING TO BE IN ACCORDANCE WITH CURRENT	RMS
	REGULATORY SIGNS MANUAL AND AS1742.2	
_&R)	_ TB _ HOLDING LINES	
BB	BB DOUBLE BARRIER LINE	
	C3 "NO STOPPING" YELLOW EDGE LINE	
ыстанования и на	R5-400(R)	
	NO PARKING SIGNAGE R5-40(R)	
ANEWAY 5	ROUNDABOUT SIGNAGE R1-34	
	NO ENTRY SIGNAGE	
	ONE-WAY TRAFFIC SIGNAGE	
BB	R2-2A(R) NOTE:	
	DETAILS SHOWN ON THIS PLAN ARE INDICATIVE ONLY AN SUBJECT TO LTC APPROVAL	D
R		
A		
21		
C 2		
O		
LON R		
R2-		
L NO		
R C C		
2		
$\langle $		
λ	F 27.05.24 RE-ISSUED FOR DA	GAP DR
$\langle $	E 20.10.23 RE-ISSUED FOR DA	GAP DR
)	D 13.09.23 RE-ISSUED FOR DA	GAP DR
$\langle $	C24.01.23ISSUED FOR DAB20.01.23ISSUED FOR INFORMATION	GAP CJA GAP CJA
$\langle $	A 02.12.22 ISSUED FOR INFORMATION	GAP CJA GAP CJA
$\langle \rangle$	Rev Date Description	Drawn Appr
$\langle \rangle$		
)	infrastructure & developme Suite 8.01, 56 Clarence Str	
	Sydney, NSW 2000	
$\langle \rangle$	e admin@idcaus.com www.idcaus.com	
	infrastructure & development consulting	
\langle	PROJECT	
	LANDCOM	
	EDMONDSON PARK PRECINC	т з
~~~~	LOT 5 DP1272931	
	CAMPBELLTOWN ROAD	
	DRAWING TITLE SIGNAGE AND LINEMARKING	ΡΙΔΝΙ
	SHEET 1	
	SCALE A TEO STATUS DA	
	1:750 STATUS DA	
I		
	DRAWING NO. 22-514-DA-C250	

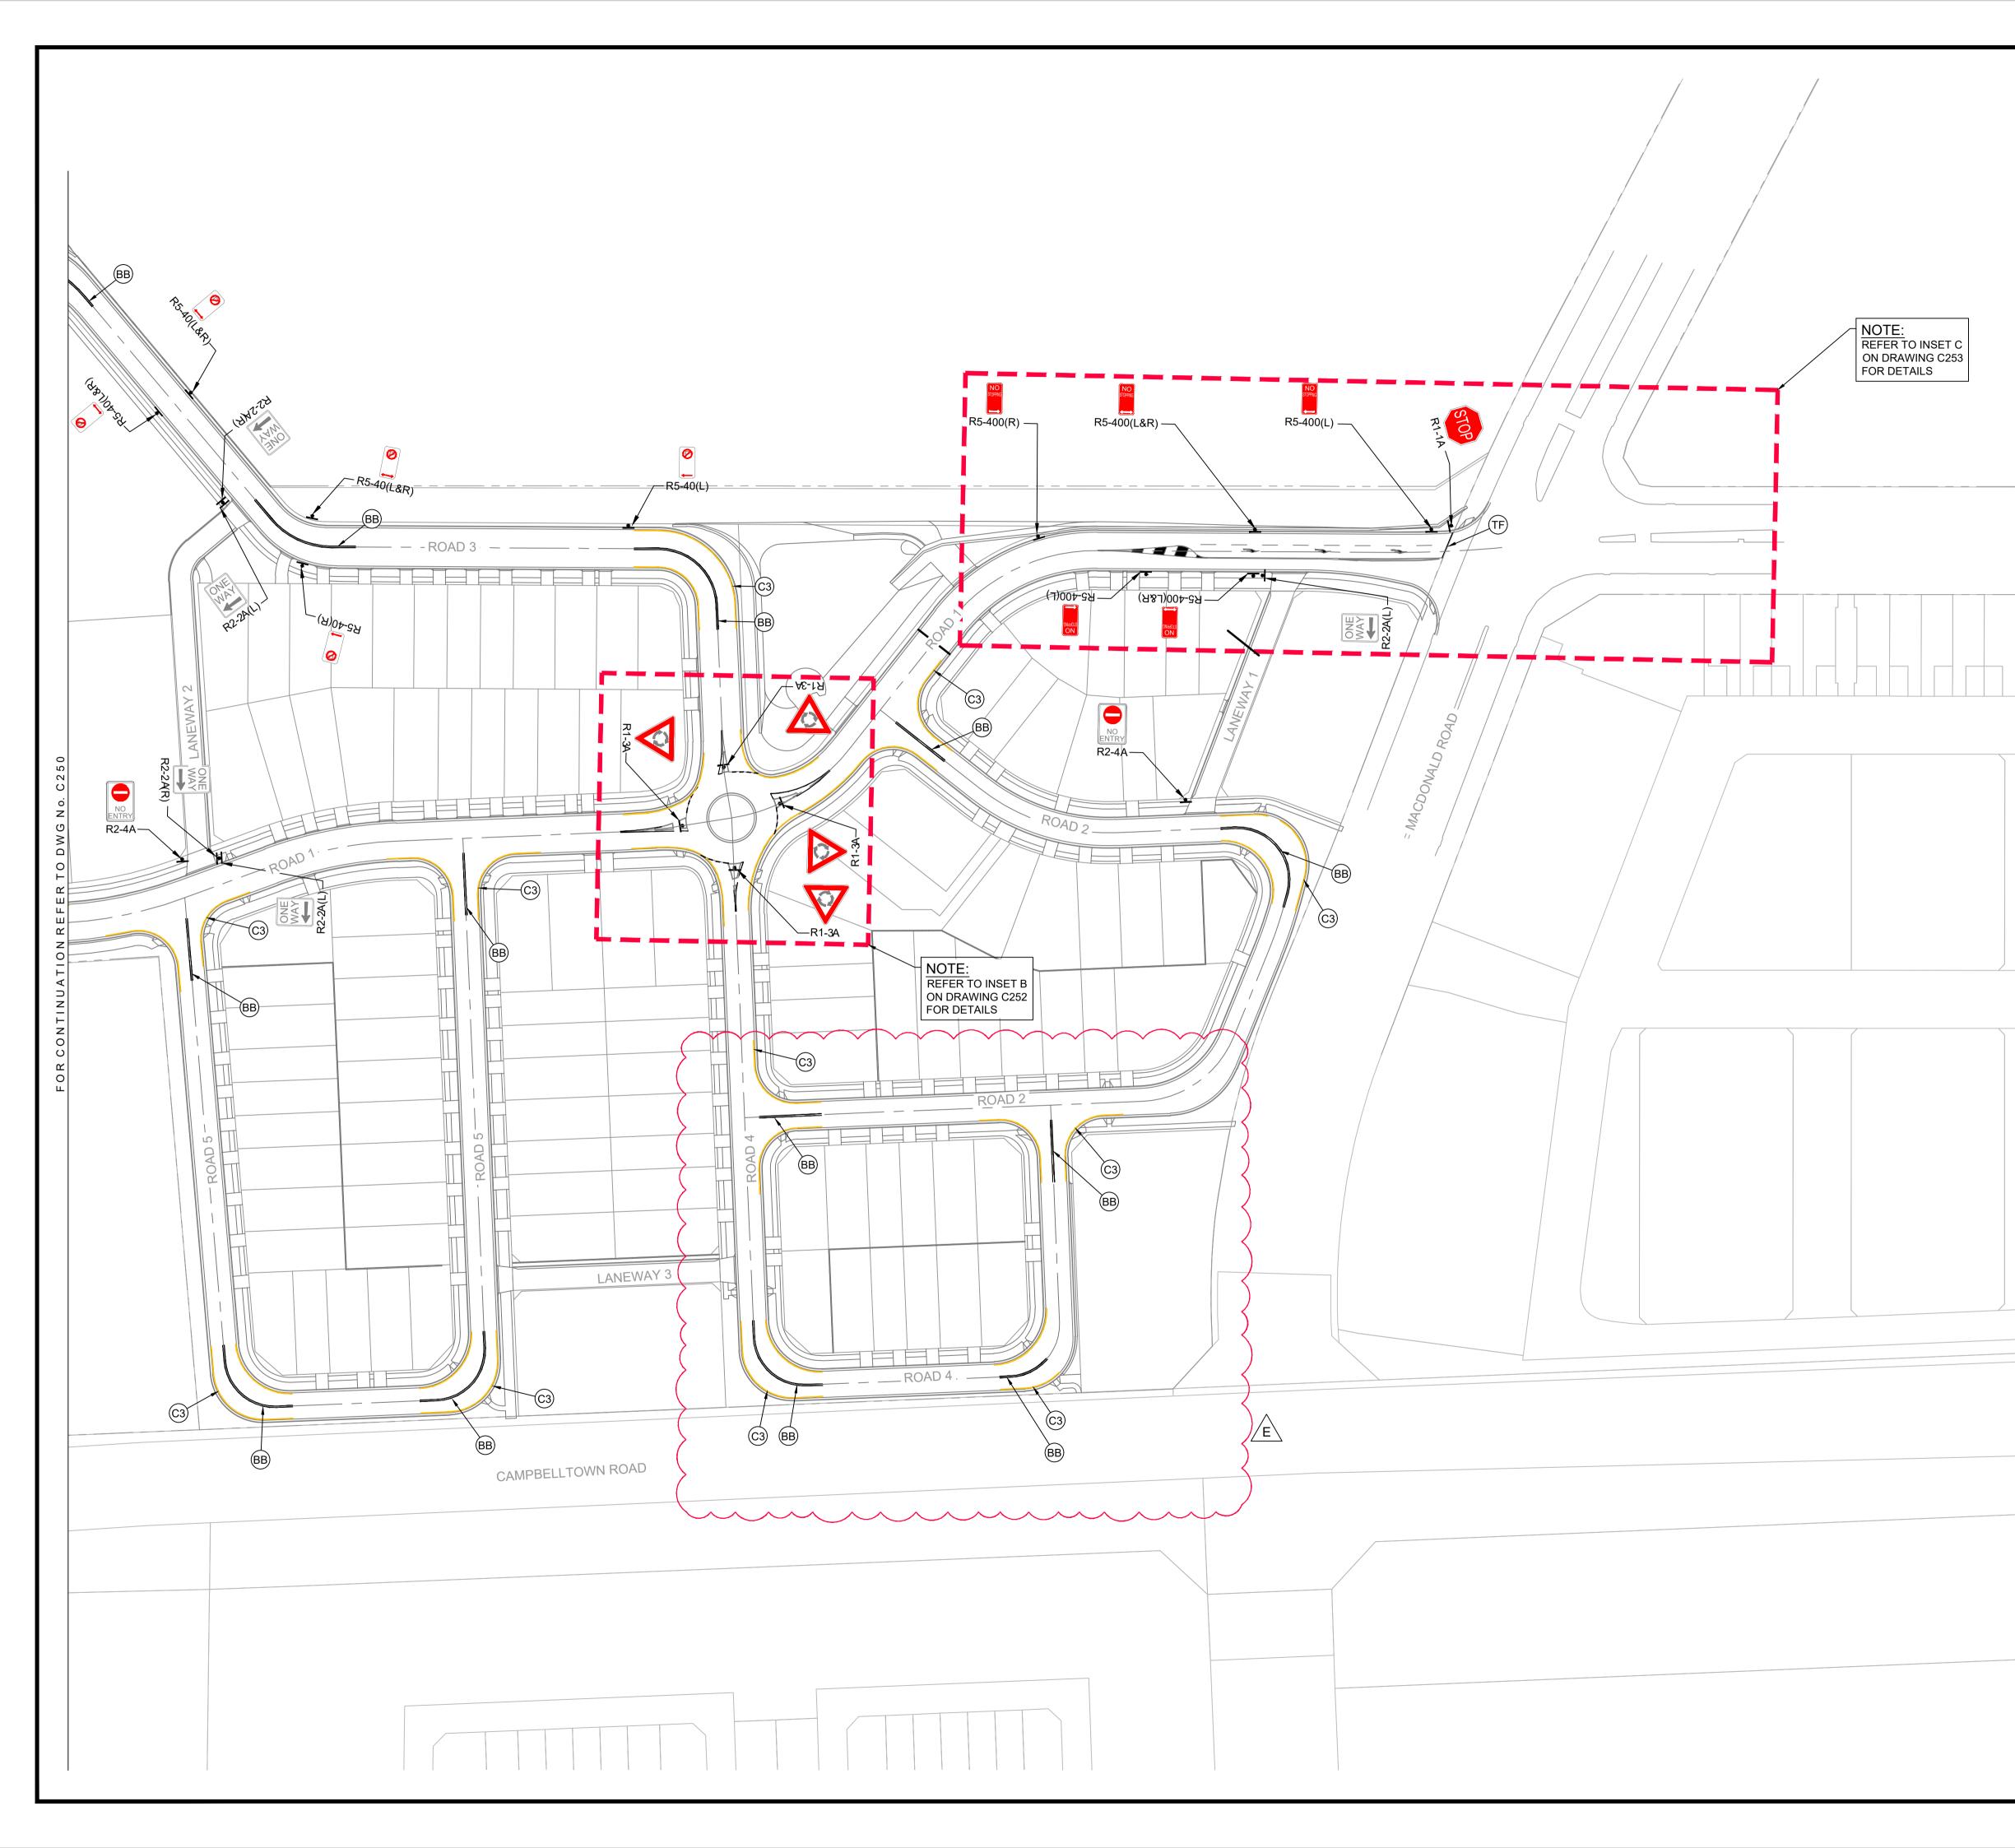

L	EGEND		
	LEGEND		]
	ALL SIGNPOSTING TO BE IN ACCORDANCE WITH CURRENT REGULATORY SIGNS MANUAL AND AS1742.2	RMS	-
	_ TB _ HOLDING LINES		
	BB DOUBLE BARRIER LINE		
	C3 "NO STOPPING" YELLOW EDGE LINE		
	TF STOP LINE		
	NO STOPPING SIGNAGE R5-400(R)		
	NO PARKING SIGNAGE R5-40(R)		
	ROUNDABOUT SIGNAGE		
	NO ENTRY SIGNAGE		
	ONE-WAY TRAFFIC SIGNAGE R2-2A(R)		
	STOP SIGN R1-1A		
	NOTE: DETAILS SHOWN ON THIS PLAN ARE INDICATIVE ONLY AN	D	
	SUBJECT TO LTC APPROVAL		
		1	
	F 27.05.24 RE-ISSUED FOR DA	GAP	DR
	E 20.10.23 RE-ISSUED FOR DA	GAP	DR
	D 13.09.23 RE-ISSUED FOR DA	GAP	DR
	C 24.01.23 ISSUED FOR DA	GAP	CJA
	B 20.01.23 ISSUED FOR INFORMATION	GAP	CJA
	A 02.12.22 ISSUED FOR INFORMATION	GAP	CJA
F	Rev Date Description	Drawn	Appr
	infrastructure & developmer	it consult	ing
	Suite 8.01, 56 Clarence Stre		•
	Sydney, NSW 2000 e admin@idcaus.com w www.idcaus.com		
	e admin@idcaus.com w www.idcaus.com		
	infrastructure & development consulting		
F	PROJECT		
	LANDCOM		
	EDMONDSON PARK PRECINC	13	
I	LOT 5 DP1272931		
I	CAMPBELLTOWN ROAD		
ŀ			
		י א ורם	<b>\</b> 1
	SIGNAGE AND LINEMARKING	PLA	N
	SHEET 2		
Ę	SCALE 1:750 STATUS DA		
Ľ	DRAWING NO. 22-514-DA-C251	EV F	
		-	

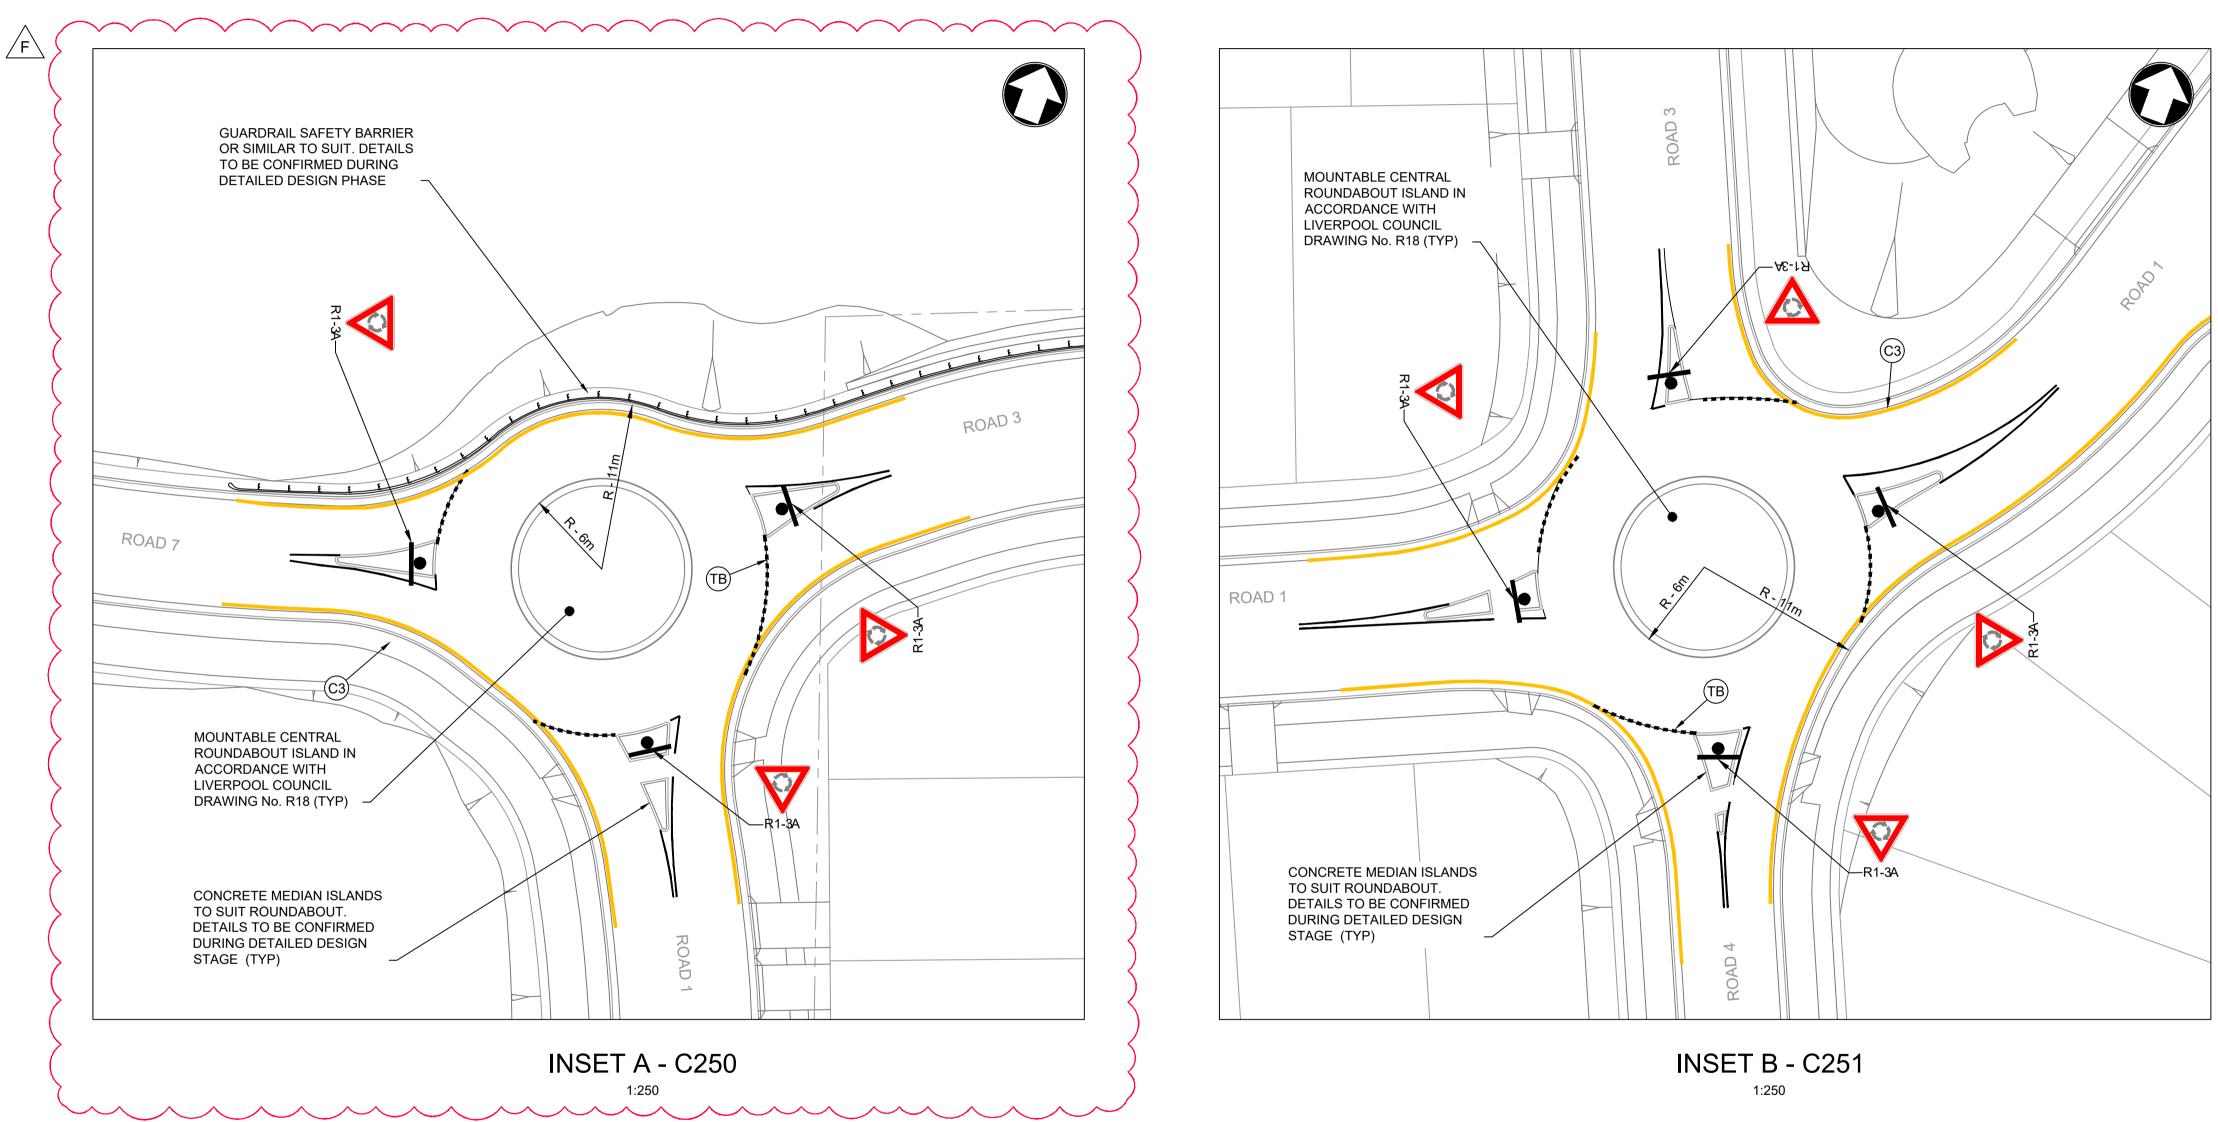

	LEGE	ND			
					1
-					
			STING TO BE IN ACCORDANCE WITH CURRENT   Y SIGNS MANUAL AND AS1742.2	RMS	
		ТВ			
		_ 10	HOLDING LINES		
		C3	"NO STOPPING" YELLOW EDGE LINE		
		TF	STOPPING LINE		
		R1-34	ROUNDABOUT SIGNAGE		
			OWN ON THIS PLAN ARE INDICATIVE ONLY AND D LTC APPROVAL	)	
	-	07.05.0			
	F	27.05.24	RE-ISSUED FOR DA	GAP	DR
	F	27.05.24 20.10.23	RE-ISSUED FOR DA RE-ISSUED FOR DA	GAP GAP	DR DR
	Е	20.10.23	RE-ISSUED FOR DA	GAP	DR
	E	20.10.23 13.09.23	RE-ISSUED FOR DA RE-ISSUED FOR DA	GAP GAP	DR DR
	E D C	20.10.23 13.09.23 24.01.23	RE-ISSUED FOR DA RE-ISSUED FOR DA ISSUED FOR DA	GAP GAP GAP	DR DR CJA
	E D C B	20.10.23 13.09.23 24.01.23 20.01.23	RE-ISSUED FOR DA RE-ISSUED FOR DA ISSUED FOR DA ISSUED FOR INFORMATION ISSUED FOR INFORMATION	GAP GAP GAP GAP GAP	DR DR CJA CJA CJA
	E D C B A	20.10.23 13.09.23 24.01.23 20.01.23 02.12.22	RE-ISSUED FOR DA RE-ISSUED FOR DA ISSUED FOR DA ISSUED FOR INFORMATION ISSUED FOR INFORMATION Description	GAP GAP GAP GAP GAP Drawn	DR DR CJA CJA CJA Appr
	E D C B A	20.10.23 13.09.23 24.01.23 20.01.23 02.12.22	RE-ISSUED FOR DA RE-ISSUED FOR DA ISSUED FOR DA ISSUED FOR INFORMATION ISSUED FOR INFORMATION Description infrastructure & developmen	GAP GAP GAP GAP GAP Drawn	DR DR CJA CJA CJA Appr
	E D C B A	20.10.23 13.09.23 24.01.23 20.01.23 02.12.22	RE-ISSUED FOR DA RE-ISSUED FOR DA ISSUED FOR DA ISSUED FOR INFORMATION ISSUED FOR INFORMATION Description infrastructure & developmen Suite 8.01, 56 Clarence Stre Sydney, NSW 2000	GAP GAP GAP GAP GAP Drawn	DR DR CJA CJA CJA Appr
	E D C B A	20.10.23 13.09.23 24.01.23 20.01.23 02.12.22	RE-ISSUED FOR DA RE-ISSUED FOR DA ISSUED FOR DA ISSUED FOR INFORMATION ISSUED FOR INFORMATION Description infrastructure & developmen Suite 8.01, 56 Clarence Stre Sydney, NSW 2000	GAP GAP GAP GAP GAP Drawn	DR DR CJA CJA CJA Appr
	E D C B A	20.10.23 13.09.23 24.01.23 20.01.23 02.12.22 Date	RE-ISSUED FOR DA RE-ISSUED FOR DA ISSUED FOR DA ISSUED FOR INFORMATION ISSUED FOR INFORMATION Description infrastructure & developmen Suite 8.01, 56 Clarence Stres Sydney, NSW 2000 e admin@idcaus.com w www.idcaus.com	GAP GAP GAP GAP GAP Drawn	DR DR CJA CJA CJA Appr
	E D C B A	20.10.23 13.09.23 24.01.23 20.01.23 02.12.22 Date	RE-ISSUED FOR DA RE-ISSUED FOR DA ISSUED FOR DA ISSUED FOR INFORMATION ISSUED FOR INFORMATION Description infrastructure & developmen Suite 8.01, 56 Clarence Stre Sydney, NSW 2000 e admin@idcaus.com	GAP GAP GAP GAP GAP Drawn	DR DR CJA CJA CJA Appr
	E D B A Rev	20.10.23 13.09.23 24.01.23 20.01.23 02.12.22 Date	RE-ISSUED FOR DA RE-ISSUED FOR DA ISSUED FOR DA ISSUED FOR INFORMATION ISSUED FOR INFORMATION Description infrastructure & developmen Suite 8.01, 56 Clarence Stres Sydney, NSW 2000 e admin@idcaus.com w www.idcaus.com	GAP GAP GAP GAP GAP Drawn	DR DR CJA CJA CJA Appr
	E D C B A	20.10.23 13.09.23 24.01.23 20.01.23 02.12.22 Date	RE-ISSUED FOR DA RE-ISSUED FOR DA ISSUED FOR DA ISSUED FOR INFORMATION ISSUED FOR INFORMATION Description infrastructure & developmen Suite 8.01, 56 Clarence Stres Sydney, NSW 2000 e admin@idcaus.com w www.idcaus.com	GAP GAP GAP GAP GAP Drawn	DR DR CJA CJA CJA Appr
	E D C B A Rev	20.10.23 13.09.23 24.01.23 02.12.22 Date	RE-ISSUED FOR DA         RE-ISSUED FOR DA         ISSUED FOR DA         ISSUED FOR INFORMATION         ISSUED FOR INFORMATION         Description         infrastructure & developmen         Suite 8.01, 56 Clarence Stres         Sydney, NSW 2000         e       admin@idcaus.com         www.idcaus.com         SOMM	GAP GAP GAP GAP Drawn	DR DR CJA CJA CJA Appr
	E D A Rev	20.10.23 13.09.23 24.01.23 02.12.22 Date	RE-ISSUED FOR DA RE-ISSUED FOR DA ISSUED FOR INFORMATION ISSUED FOR INFORMATION Description infrastructure & developmen Suite 8.01, 56 Clarence Stre Sydney, NSW 2000 e admin@idcaus.com w www.idcaus.com COM NDSON PARK PRECINC	GAP GAP GAP GAP Drawn	DR DR CJA CJA CJA Appr
	E D A Rev	20.10.23 13.09.23 24.01.23 02.12.22 Date Date	RE-ISSUED FOR DA RE-ISSUED FOR DA ISSUED FOR DA ISSUED FOR INFORMATION ISSUED FOR INFORMATION Description infrastructure & developmen Suite 8.01, 56 Clarence Stre Sydney, NSW 2000 e admin@idcaus.com w www.idcaus.com W www.idcaus.com	GAP GAP GAP GAP Drawn	DR DR CJA CJA CJA Appr
	E D A Rev	20.10.23 13.09.23 24.01.23 02.12.22 Date Date	RE-ISSUED FOR DA RE-ISSUED FOR DA ISSUED FOR INFORMATION ISSUED FOR INFORMATION Description infrastructure & developmen Suite 8.01, 56 Clarence Stre Sydney, NSW 2000 e admin@idcaus.com w www.idcaus.com COM NDSON PARK PRECINC	GAP GAP GAP GAP Drawn	DR DR CJA CJA CJA Appr
	E D A Rev	20.10.23 13.09.23 24.01.23 02.12.22 Date Date	RE-ISSUED FOR DA RE-ISSUED FOR DA ISSUED FOR DA ISSUED FOR INFORMATION ISSUED FOR INFORMATION Description infrastructure & developmen Suite 8.01, 56 Clarence Stre Sydney, NSW 2000 e admin@idcaus.com w www.idcaus.com W www.idcaus.com	GAP GAP GAP GAP Drawn	DR DR CJA CJA CJA Appr
	E D C B A Rev PROJ	20.10.23 13.09.23 24.01.23 02.12.22 Date Date VING TITLE	RE-ISSUED FOR DA RE-ISSUED FOR DA ISSUED FOR INFORMATION ISSUED FOR INFORMATION Description Infrastructure & developmen Suite 8.01, 56 Clarence Stre Sydney, NSW 2000 e admin@idcaus.com w www.idcaus.com COM NDSON PARK PRECINCT DP1272931 BELLTOWN ROAD	GAP GAP GAP GAP Drawn the consulti	DR CJA CJA Appr ng
	E D C B A Rev PROJ	20.10.23 13.09.23 24.01.23 02.12.22 Date Date LANDCEDMOLOT 5 CAMPI	RE-ISSUED FOR DA RE-ISSUED FOR DA ISSUED FOR INFORMATION ISSUED FOR INFORMATION Description Infrastructure & developmen Suite 8.01, 56 Clarence Stre Sydney, NSW 2000 e admin@idcaus.com w www.idcaus.com COM NDSON PARK PRECINCT DP1272931 BELLTOWN ROAD GE AND LINEMARKING F	GAP GAP GAP GAP Drawn the consulti	DR CJA CJA Appr ng
	E D C B A Rev PROJ	20.10.23 13.09.23 24.01.23 02.12.22 Date Date VING TITLE	RE-ISSUED FOR DA RE-ISSUED FOR DA ISSUED FOR INFORMATION ISSUED FOR INFORMATION Description Infrastructure & developmen Suite 8.01, 56 Clarence Stre Sydney, NSW 2000 e admin@idcaus.com w www.idcaus.com COM NDSON PARK PRECINCT DP1272931 BELLTOWN ROAD GE AND LINEMARKING F	GAP GAP GAP GAP Drawn the consulti	DR CJA CJA Appr ng
	E D C B A Rev PROJ	20.10.23 13.09.23 24.01.23 02.12.22 Date Date LANDCEDMOLOT 5 CAMPI	RE-ISSUED FOR DA RE-ISSUED FOR DA ISSUED FOR INFORMATION ISSUED FOR INFORMATION Description Infrastructure & developmen Suite 8.01, 56 Clarence Stre Sydney, NSW 2000 e admin@idcaus.com w www.idcaus.com COM NDSON PARK PRECINCT DP1272931 BELLTOWN ROAD GE AND LINEMARKING F	GAP GAP GAP GAP Drawn the consulti	DR CJA CJA Appr ng
	E D C B A Rev PROJ	20.10.23 13.09.23 24.01.23 02.12.22 Date Date LANDCEDMOLOT 5 CAMPI	RE-ISSUED FOR DA RE-ISSUED FOR DA ISSUED FOR INFORMATION ISSUED FOR INFORMATION Description Infrastructure & developmen Suite 8.01, 56 Clarence Stre Sydney, NSW 2000 e admin@idcaus.com w www.idcaus.com COM NDSON PARK PRECINCT DP1272931 BELLTOWN ROAD GE AND LINEMARKING F	GAP GAP GAP GAP Drawn the consulti	DR CJA CJA Appr ng
	E D C B A Rev PROJ	20.10.23 13.09.23 24.01.23 02.12.22 Date Date LANDC EDMO LOT 5 CAMPI VING TITLE SIGNA SHEET	RE-ISSUED FOR DA RE-ISSUED FOR DA ISSUED FOR INFORMATION ISSUED FOR INFORMATION Description	GAP GAP GAP GAP Drawn the consulti	DR CJA CJA Appr ng
	E D C B A Rev	20.10.23 13.09.23 24.01.23 02.12.22 Date Date LANDC EDMO LOT 5 CAMPI	RE-ISSUED FOR DA RE-ISSUED FOR DA ISSUED FOR INFORMATION ISSUED FOR INFORMATION Description	GAP GAP GAP GAP Drawn the consulti	DR CJA CJA Appr ng
	E D A Rev PROJ	20.10.23 13.09.23 24.01.23 02.12.22 Date Date LANDC EDMO LOT 5 CAMPI VING TITLE SIGNA SHEET	RE-ISSUED FOR DA RE-ISSUED FOR DA ISSUED FOR INFORMATION ISSUED FOR INFORMATION Description	GAP GAP GAP GAP Drawn the consulti	DR CJA CJA Appr ng
	E D A Rev PROJ	20.10.23 13.09.23 24.01.23 02.12.22 Date Date LANDC EDMO LOT 5 CAMPI VING TITLE SIGNA SHEET	RE-ISSUED FOR DA RE-ISSUED FOR DA ISSUED FOR INFORMATION ISSUED FOR INFORMATION Description	GAP GAP GAP GAP Drawn t consultitet	DR CJA CJA Appr ng

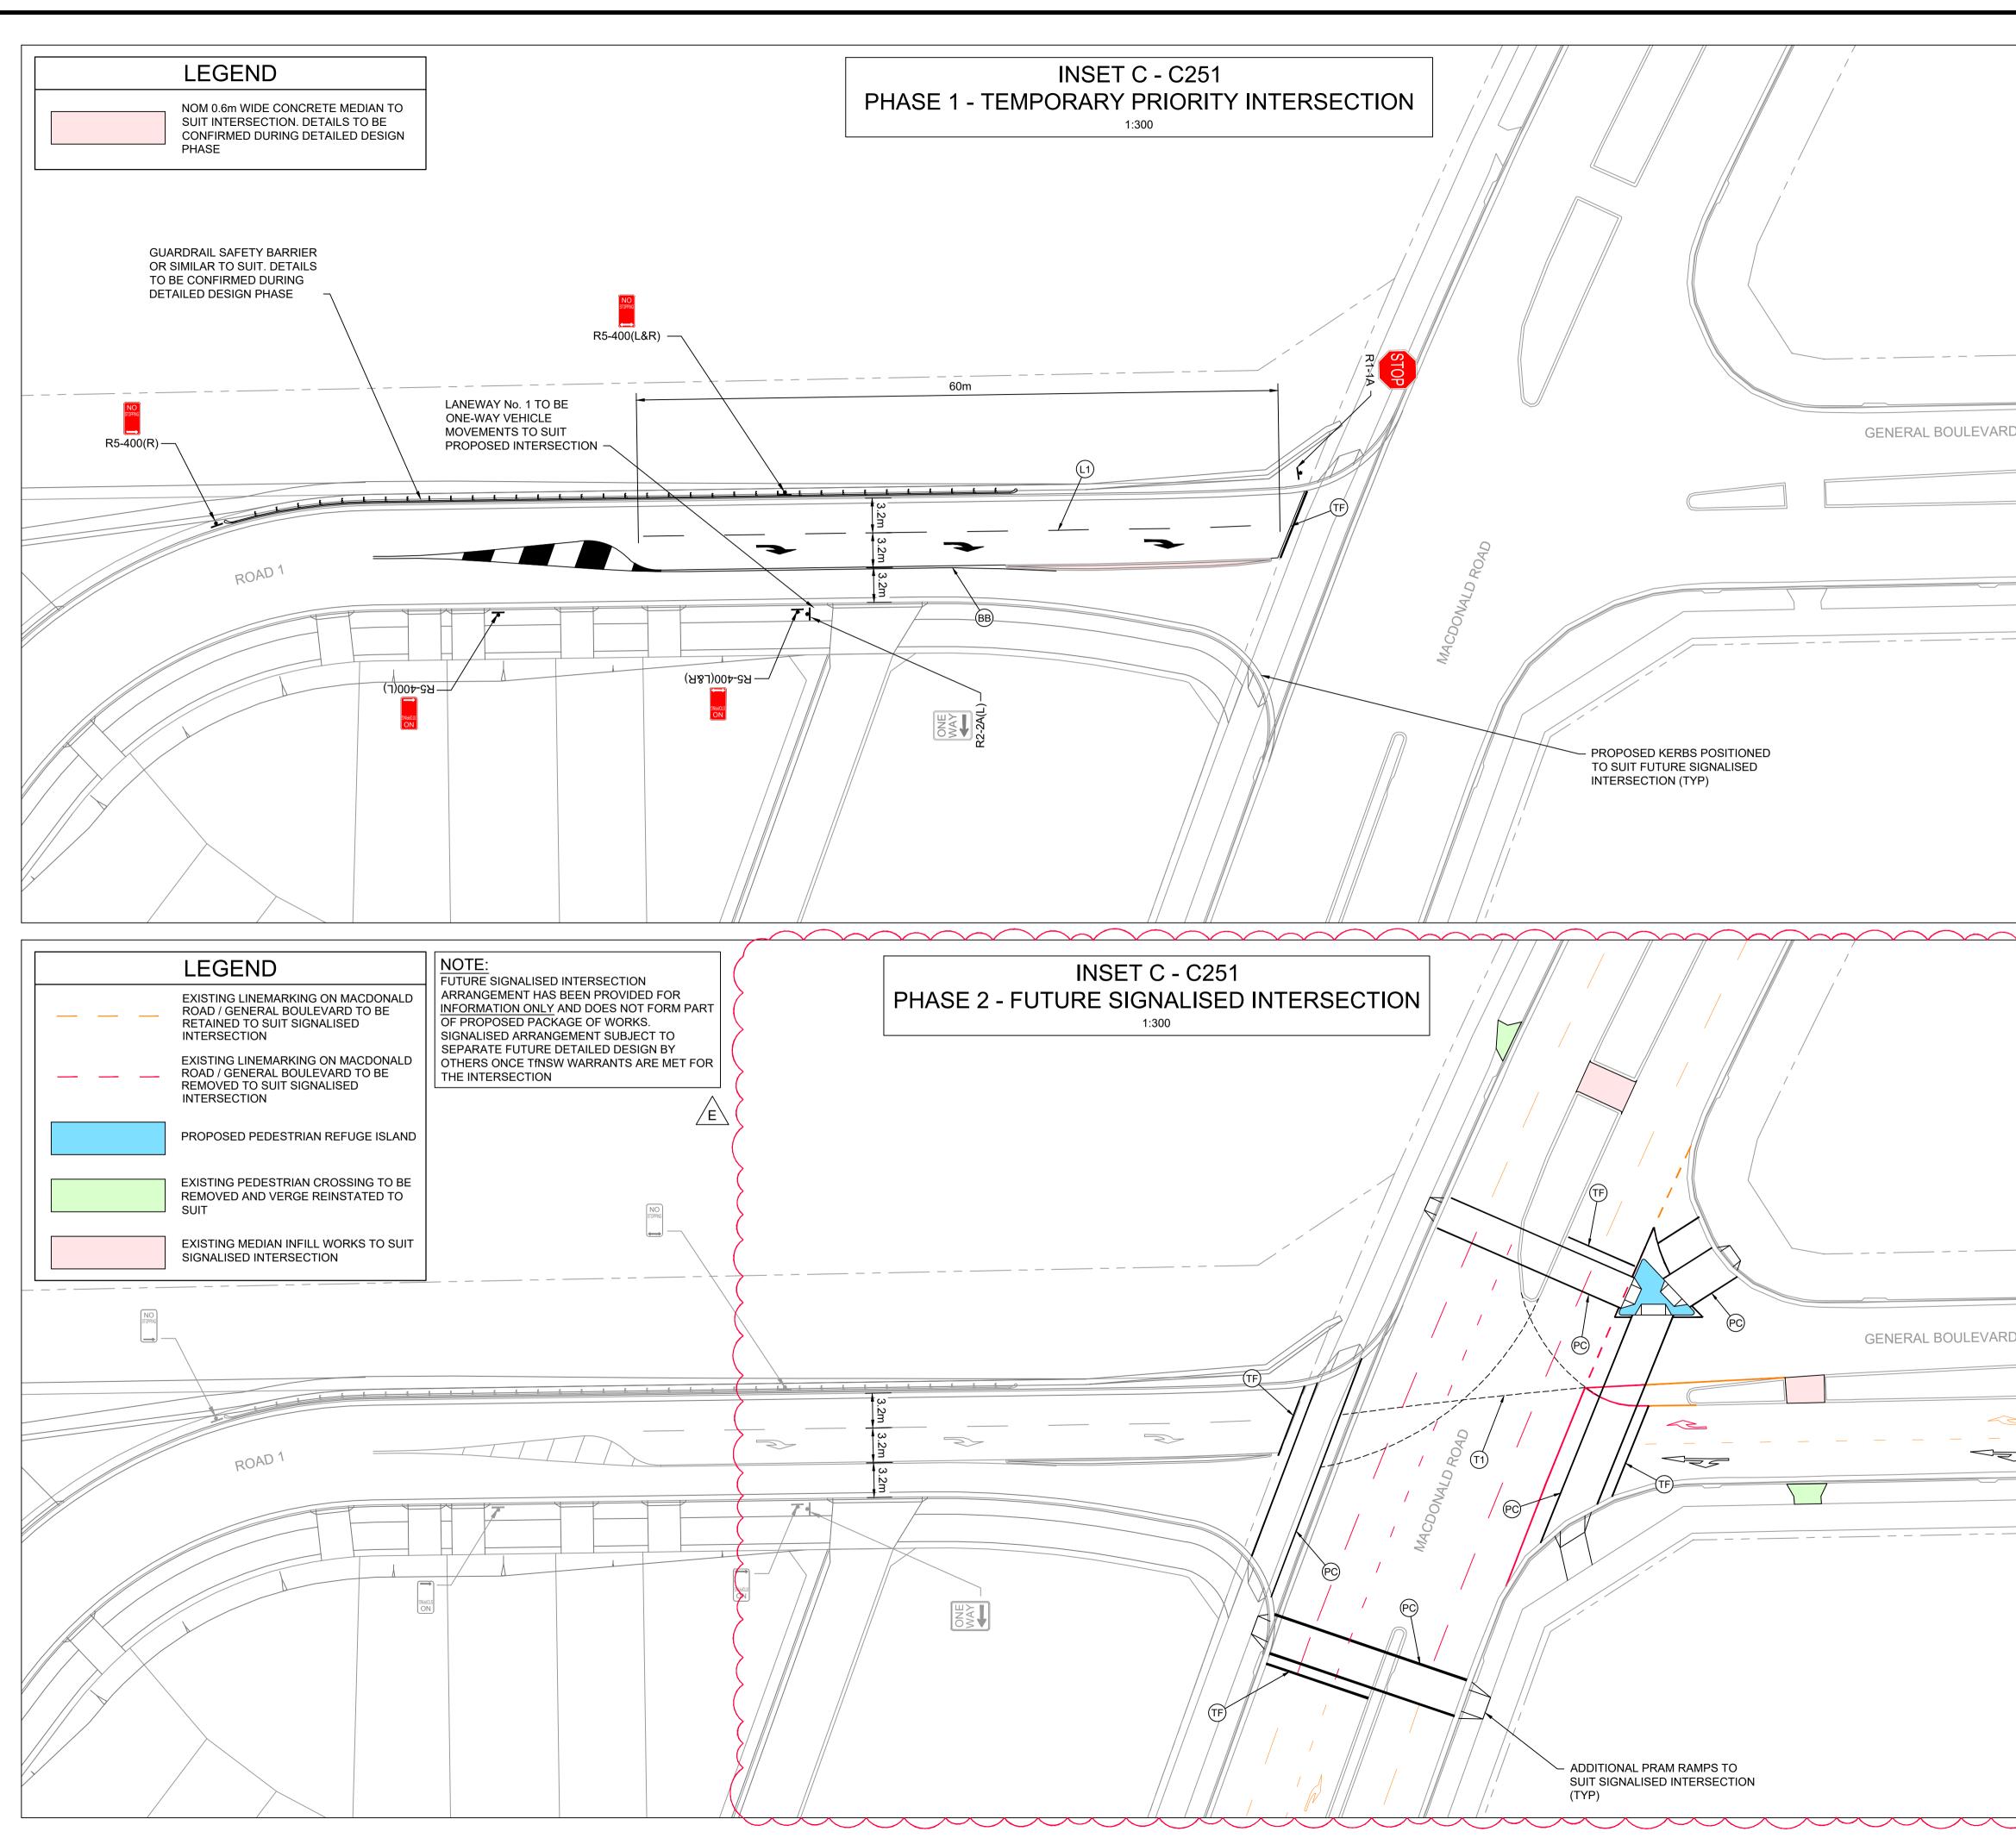

		LEGEND STING TO BE IN ACCORDANCE WITH CURRENT R	
		Y SIGNS MANUAL AND AS1742.2	
	<u></u>	DOUBLE BARRIER LINE	
	^{L1} _	LANE LINE	
	TF	STOPPING LINE	
	<u></u>		
	PC	PEDESTRIAN CROSSING	
	STOP R1-1A	STOP SIGN	
D	R5-400(I	NO STOPPING SIGNAGE R)	
	R2-24(F	UNE-WAY TRAFFIC SIGNAGE	
	NOTE: DETAILS SH	OWN ON THIS PLAN ARE INDICATIVE ONLY AND	
2			
$\mathbf{r}$			
K			
K			
S			
	C 27.05.24	RE-ISSUED FOR DA	GAP DR
D	B 20.10.23 A 13.09.23	RE-ISSUED FOR DA RE-ISSUED FOR DA	GAP DR GAP DR
D	Rev Date	Description	Drawn Appr
	9	infrastructure & development	consulting
	0-0)-	Suite 8.01, 56 Clarence Stree Sydney, NSW 2000	<u>؛</u> ۲
		Suite 8.01, 50 Clarence Stree Sydney, NSW 2000 e admin@idcaus.com & development consulting	
K	PROJECT		
	LANDO		
K	LOT 5	NDSON PARK PRECINCT DP1272931	3
R		BELLTOWN ROAD	
	DRAWING TITLE SIGNA SHEET	GE AND LINEMARKING F 74	'LAN
K			
K	SCALE 1:750	O STATUS DA	
		22-514-DA-C253	° C
			-

