
NEW CHILDCARE CENTRE AT PROPOSED LOT 141, 1 Freshwater








SHEET	SHEET NAME	REVISION ID	ISSUE DATE
A0	COVER PAGE	03	18/03/2025 3:35 PM
A1	LICENSING PLAN	03	18/03/2025 3:35 PM
A2	SITE & ROOF PLAN	03	18/03/2025 3:35 PM
A3	BASEMENT FLOOR PLAN	03	18/03/2025 3:35 PM
A4	GROUND FLOOR PLAN	03	18/03/2025 3:35 PM
A5	CPTED & EGRESS DIAGRAM	03	18/03/2025 3:35 PM
A6	SECTIONS	03	18/03/2025 3:35 PM
A7	ELEVATIONS	03	18/03/2025 3:35 PM
A8	WET AREA KITCHEN	03	18/03/2025 3:35 PM
A9	WET AREA BATHROOMS	03	18/03/2025 3:35 PM
A10	FENCE DETAILS	03	18/03/2025 3:35 PM
A11	SHADOWS SUMMER 9AM	01	18/03/2025 3:35 PM
A12	SHADOWS SUMMER 10AM	01	18/03/2025 3:35 PM
A13	SHADOWS SUMMER 11AM	01	18/03/2025 3:35 PM
A14	SHADOWS SUMMER 12PM	01	18/03/2025 3:35 PM
A15	SHADOWS SUMMER 1PM	01	18/03/2025 3:35 PM
A16	SHADOWS SUMMER 2PM	01	18/03/2025 3:35 PM
A17	SHADOWS SUMMER 3PM	01	18/03/2025 3:35 PM
A18	SHADOWS WINTER 9AM	01	18/03/2025 3:35 PM
A19	SHADOWS WINTER 10AM	01	18/03/2025 3:35 PM
A20	SHADOWS WINTER 11AM	01	18/03/2025 3:35 PM
A21	SHADOWS WINTER 12PM	01	18/03/2025 3:35 PM
A22	SHADOWS WINTER 1PM	01	18/03/2025 3:35 PM
A23	SHADOWS WINTER 2PM	01	18/03/2025 3:35 PM
A24	SHADOWS WINTER 3PM	01	18/03/2025 3:35 PM


FUTURO EARLY LEARNING

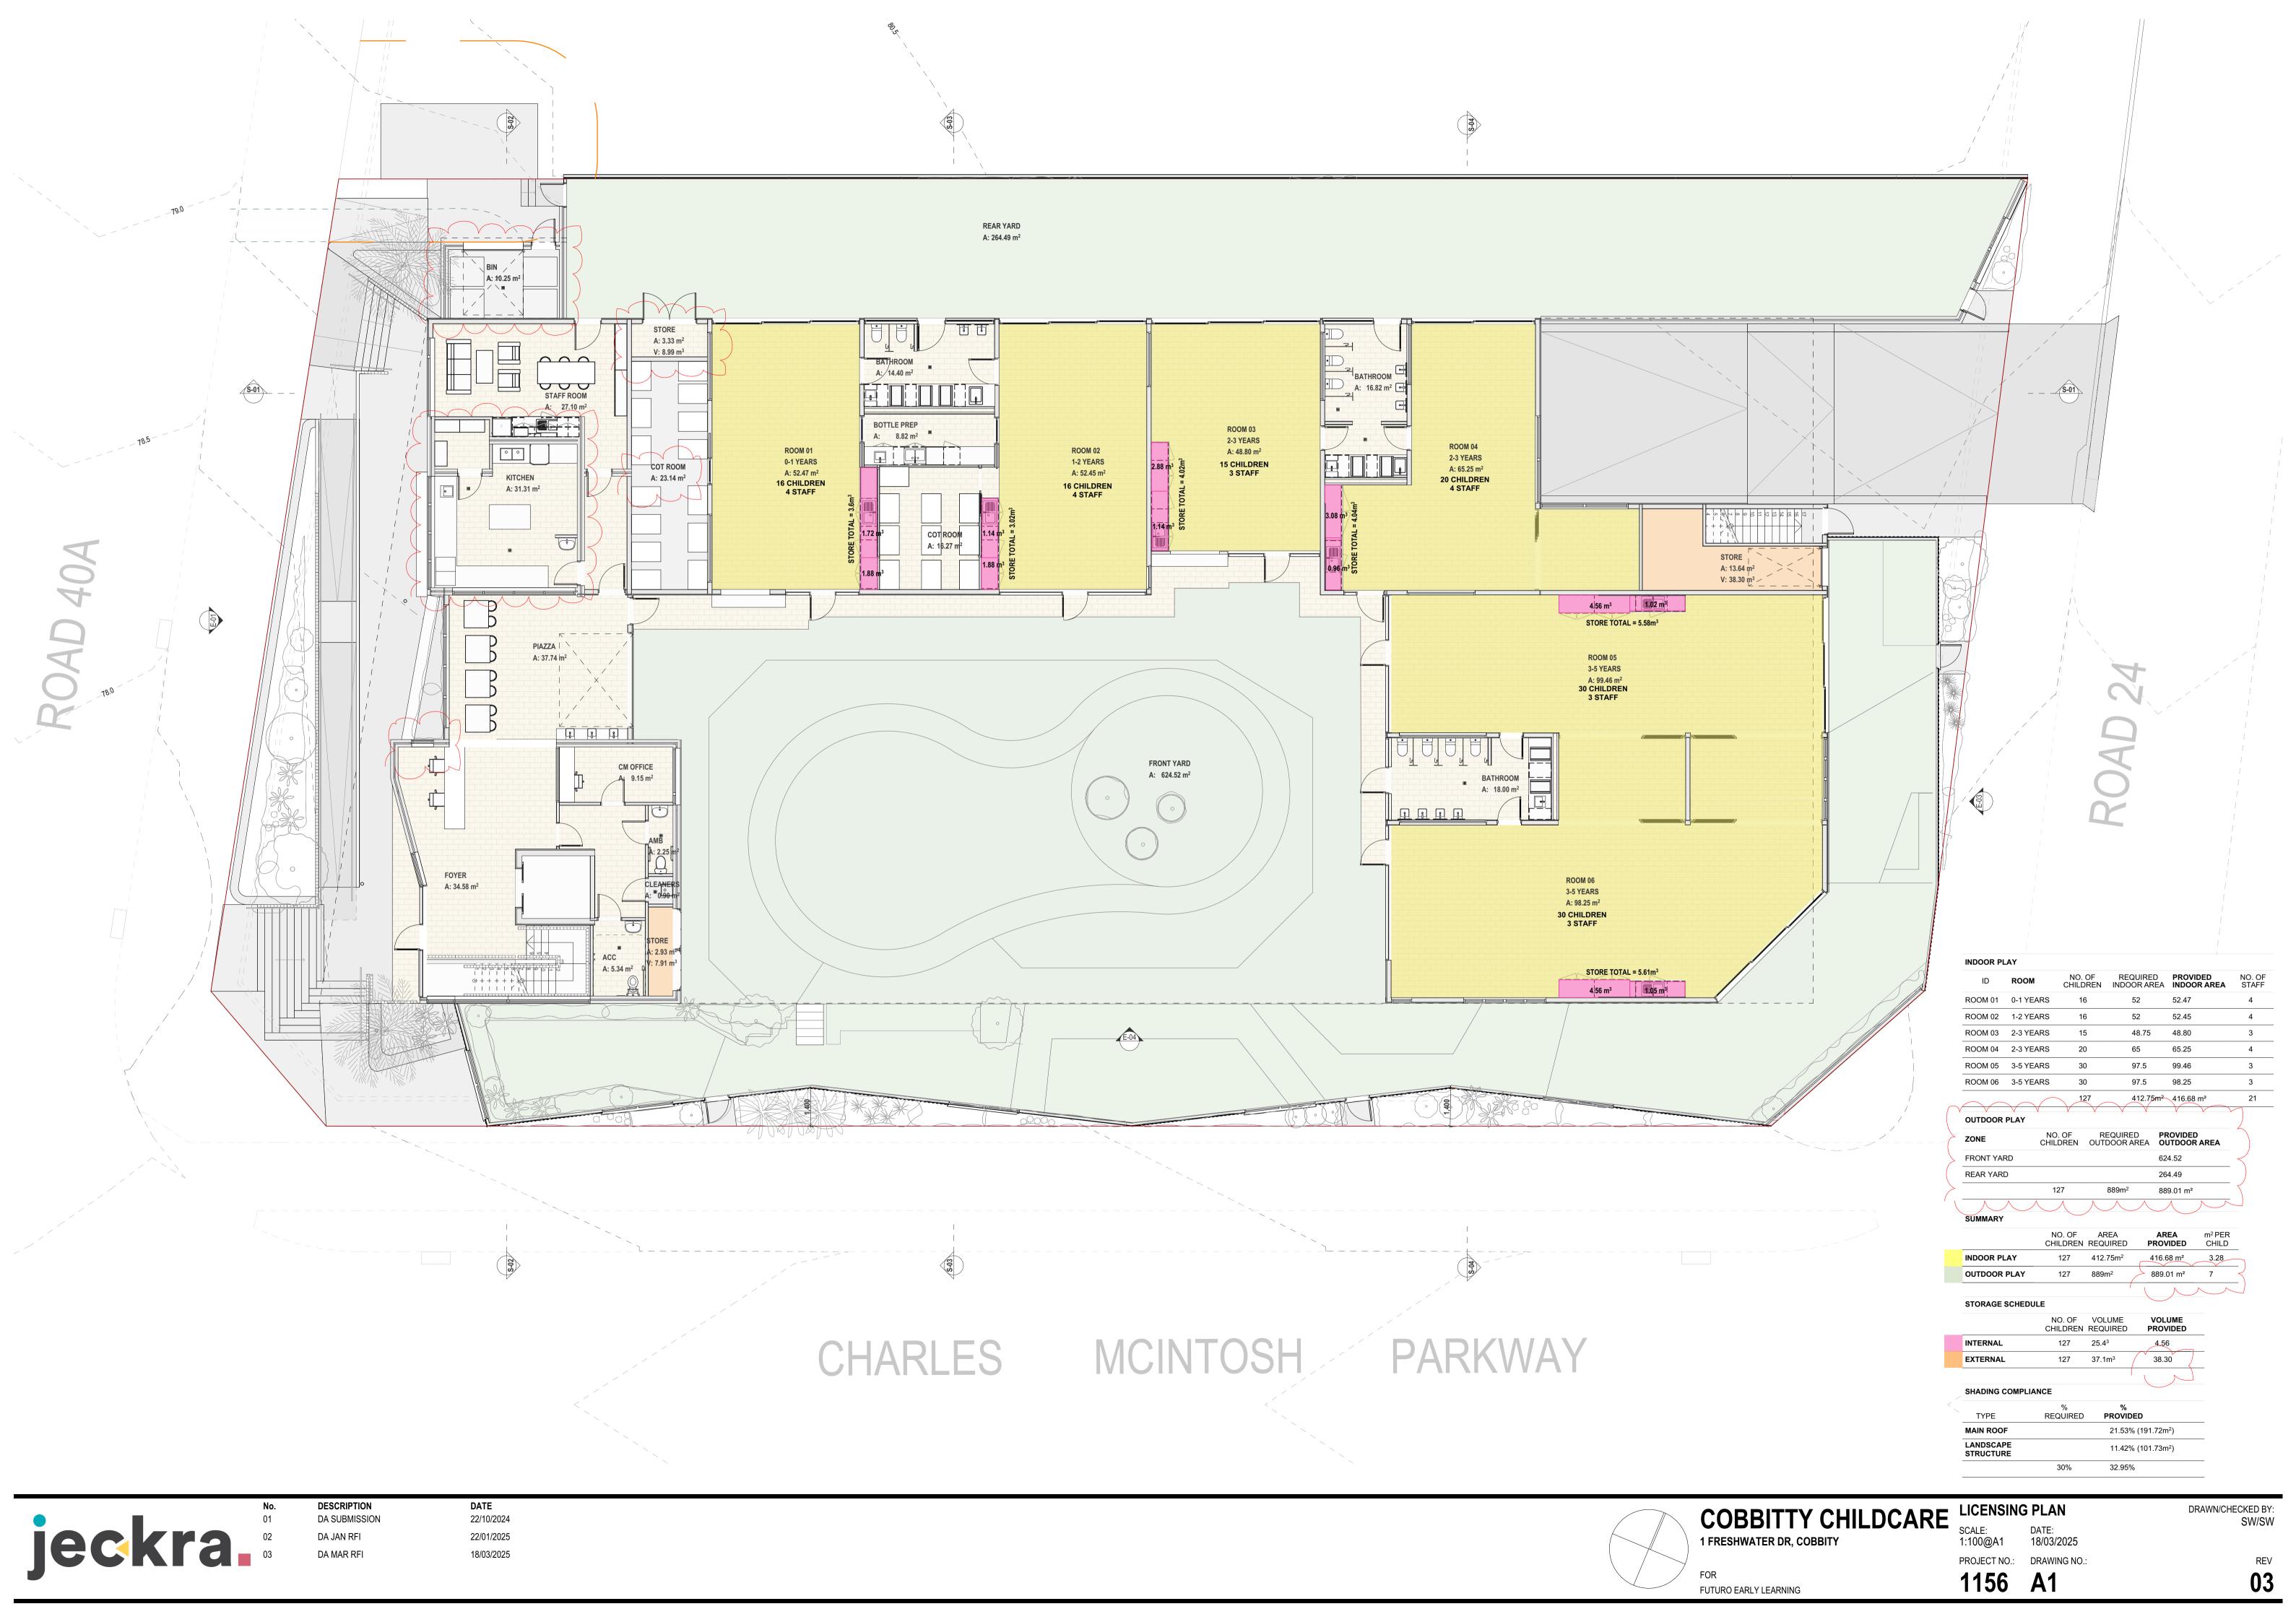


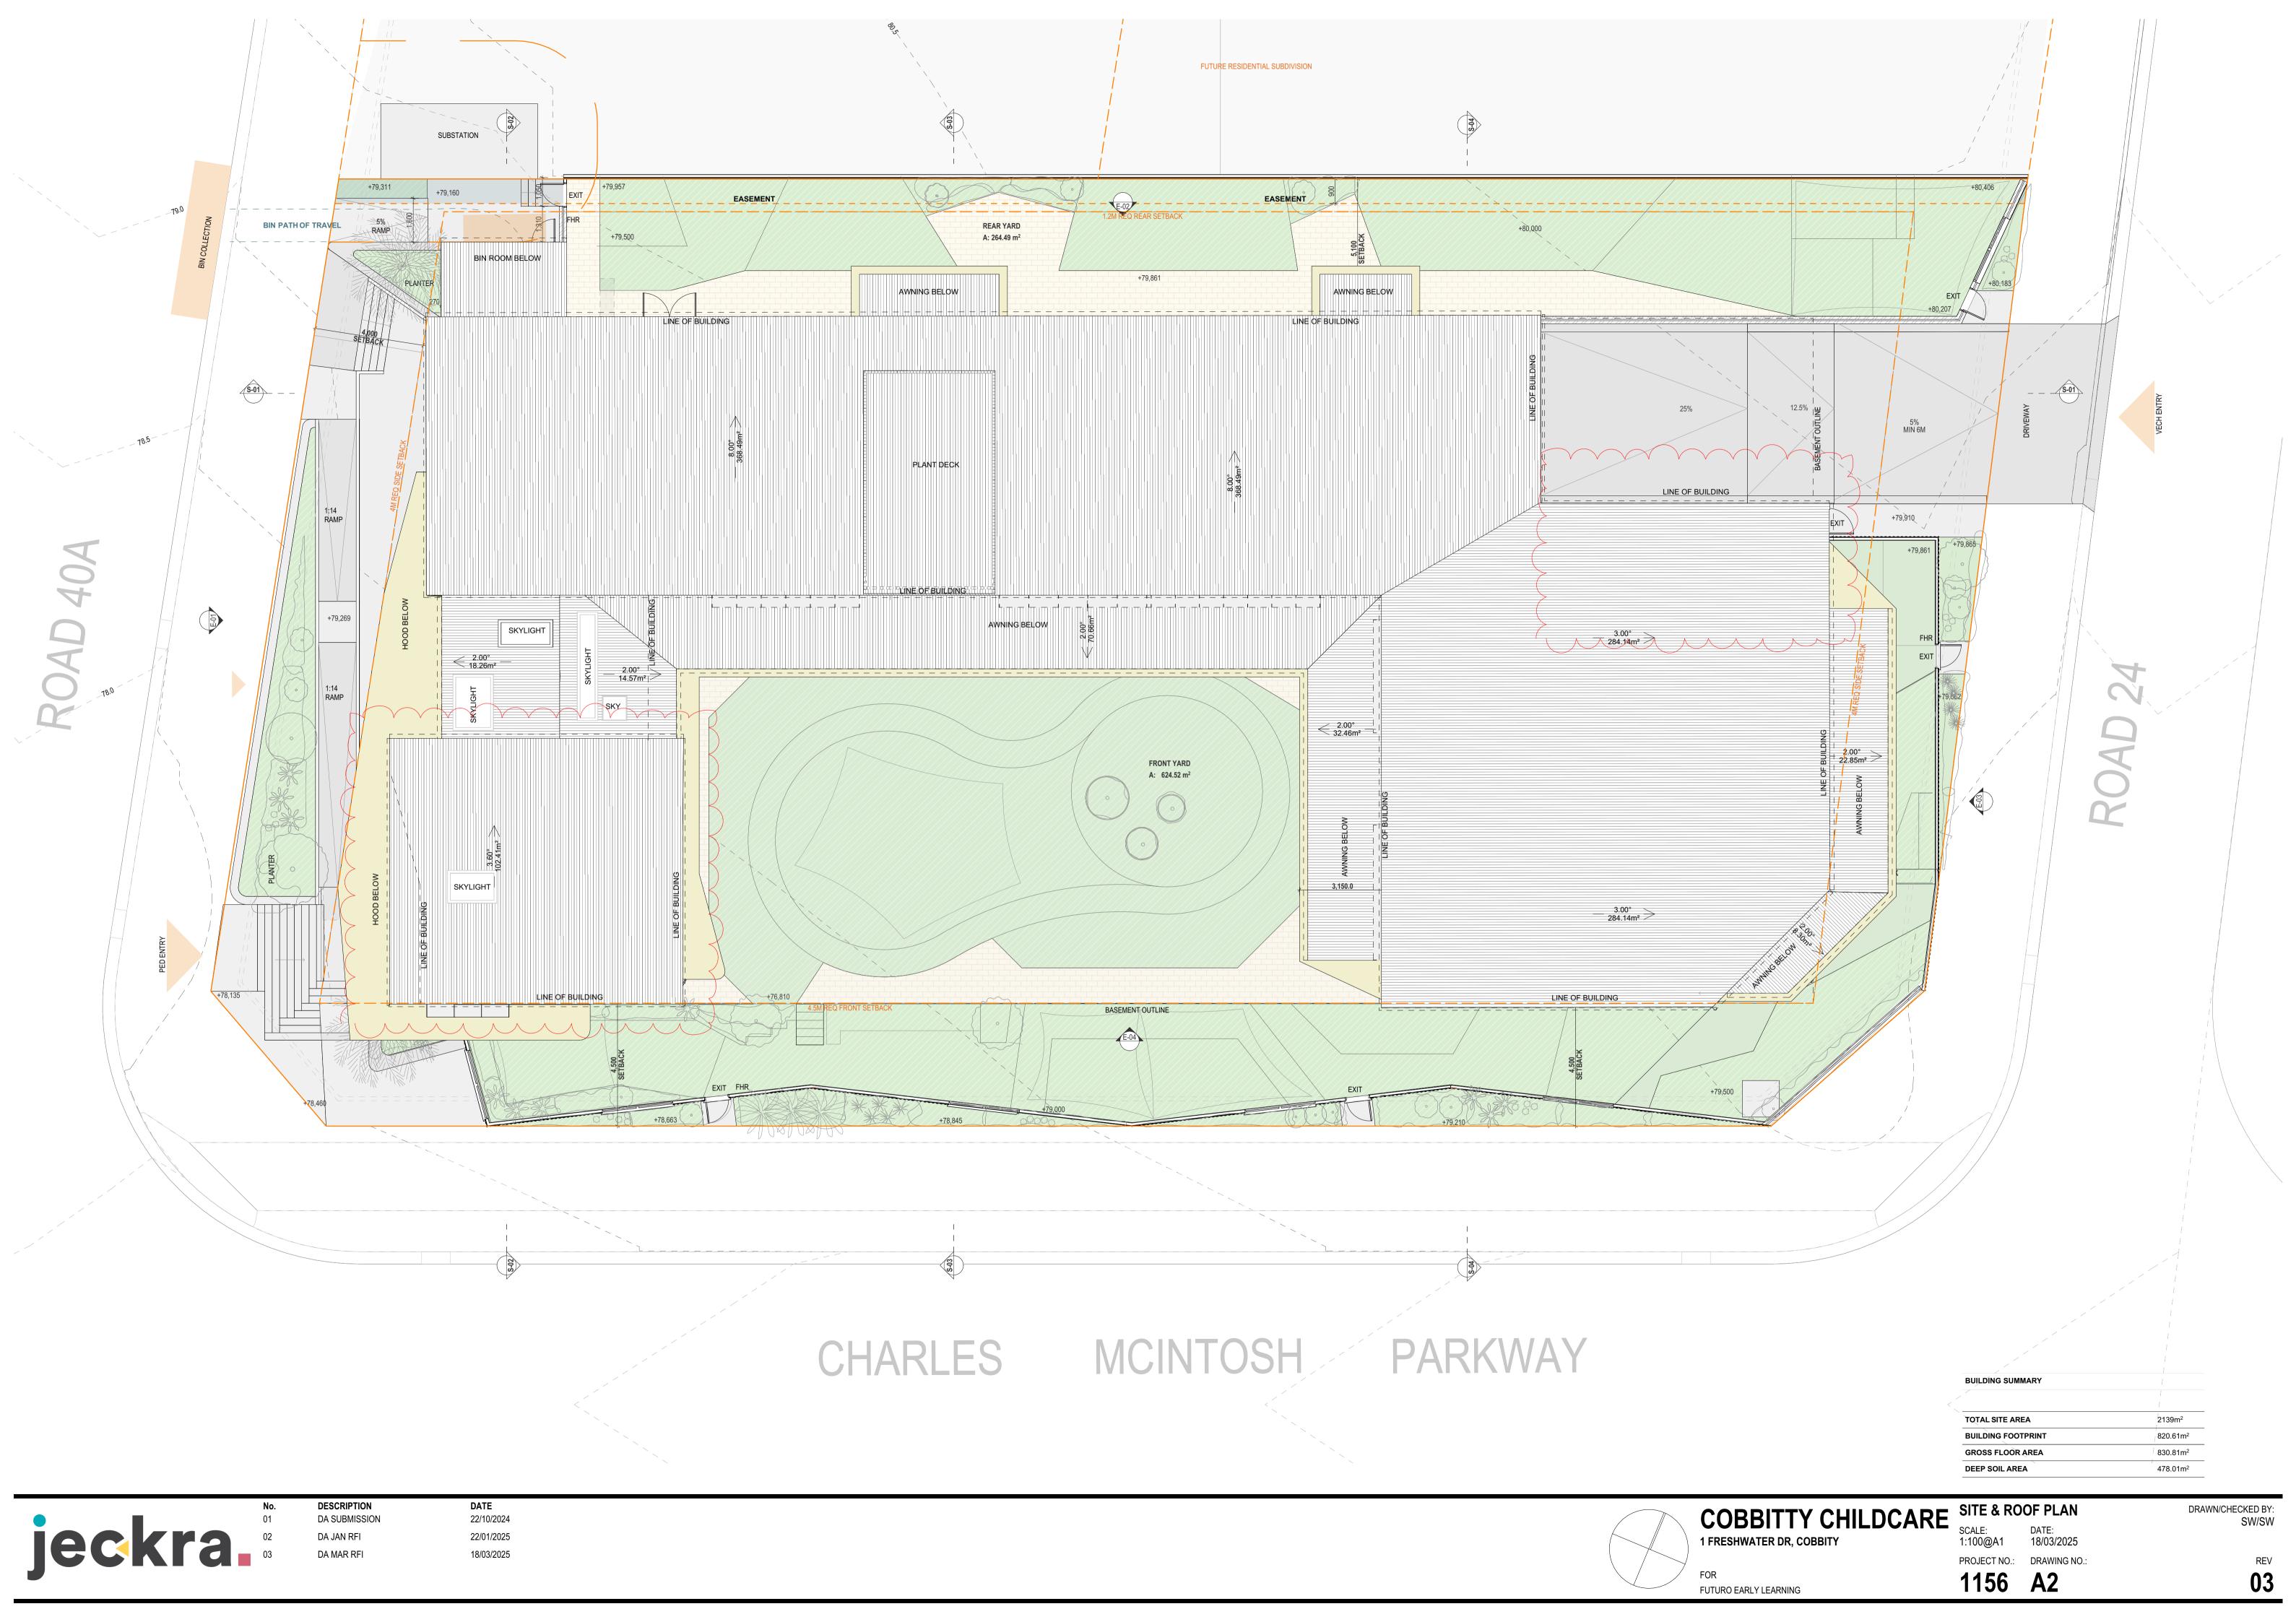

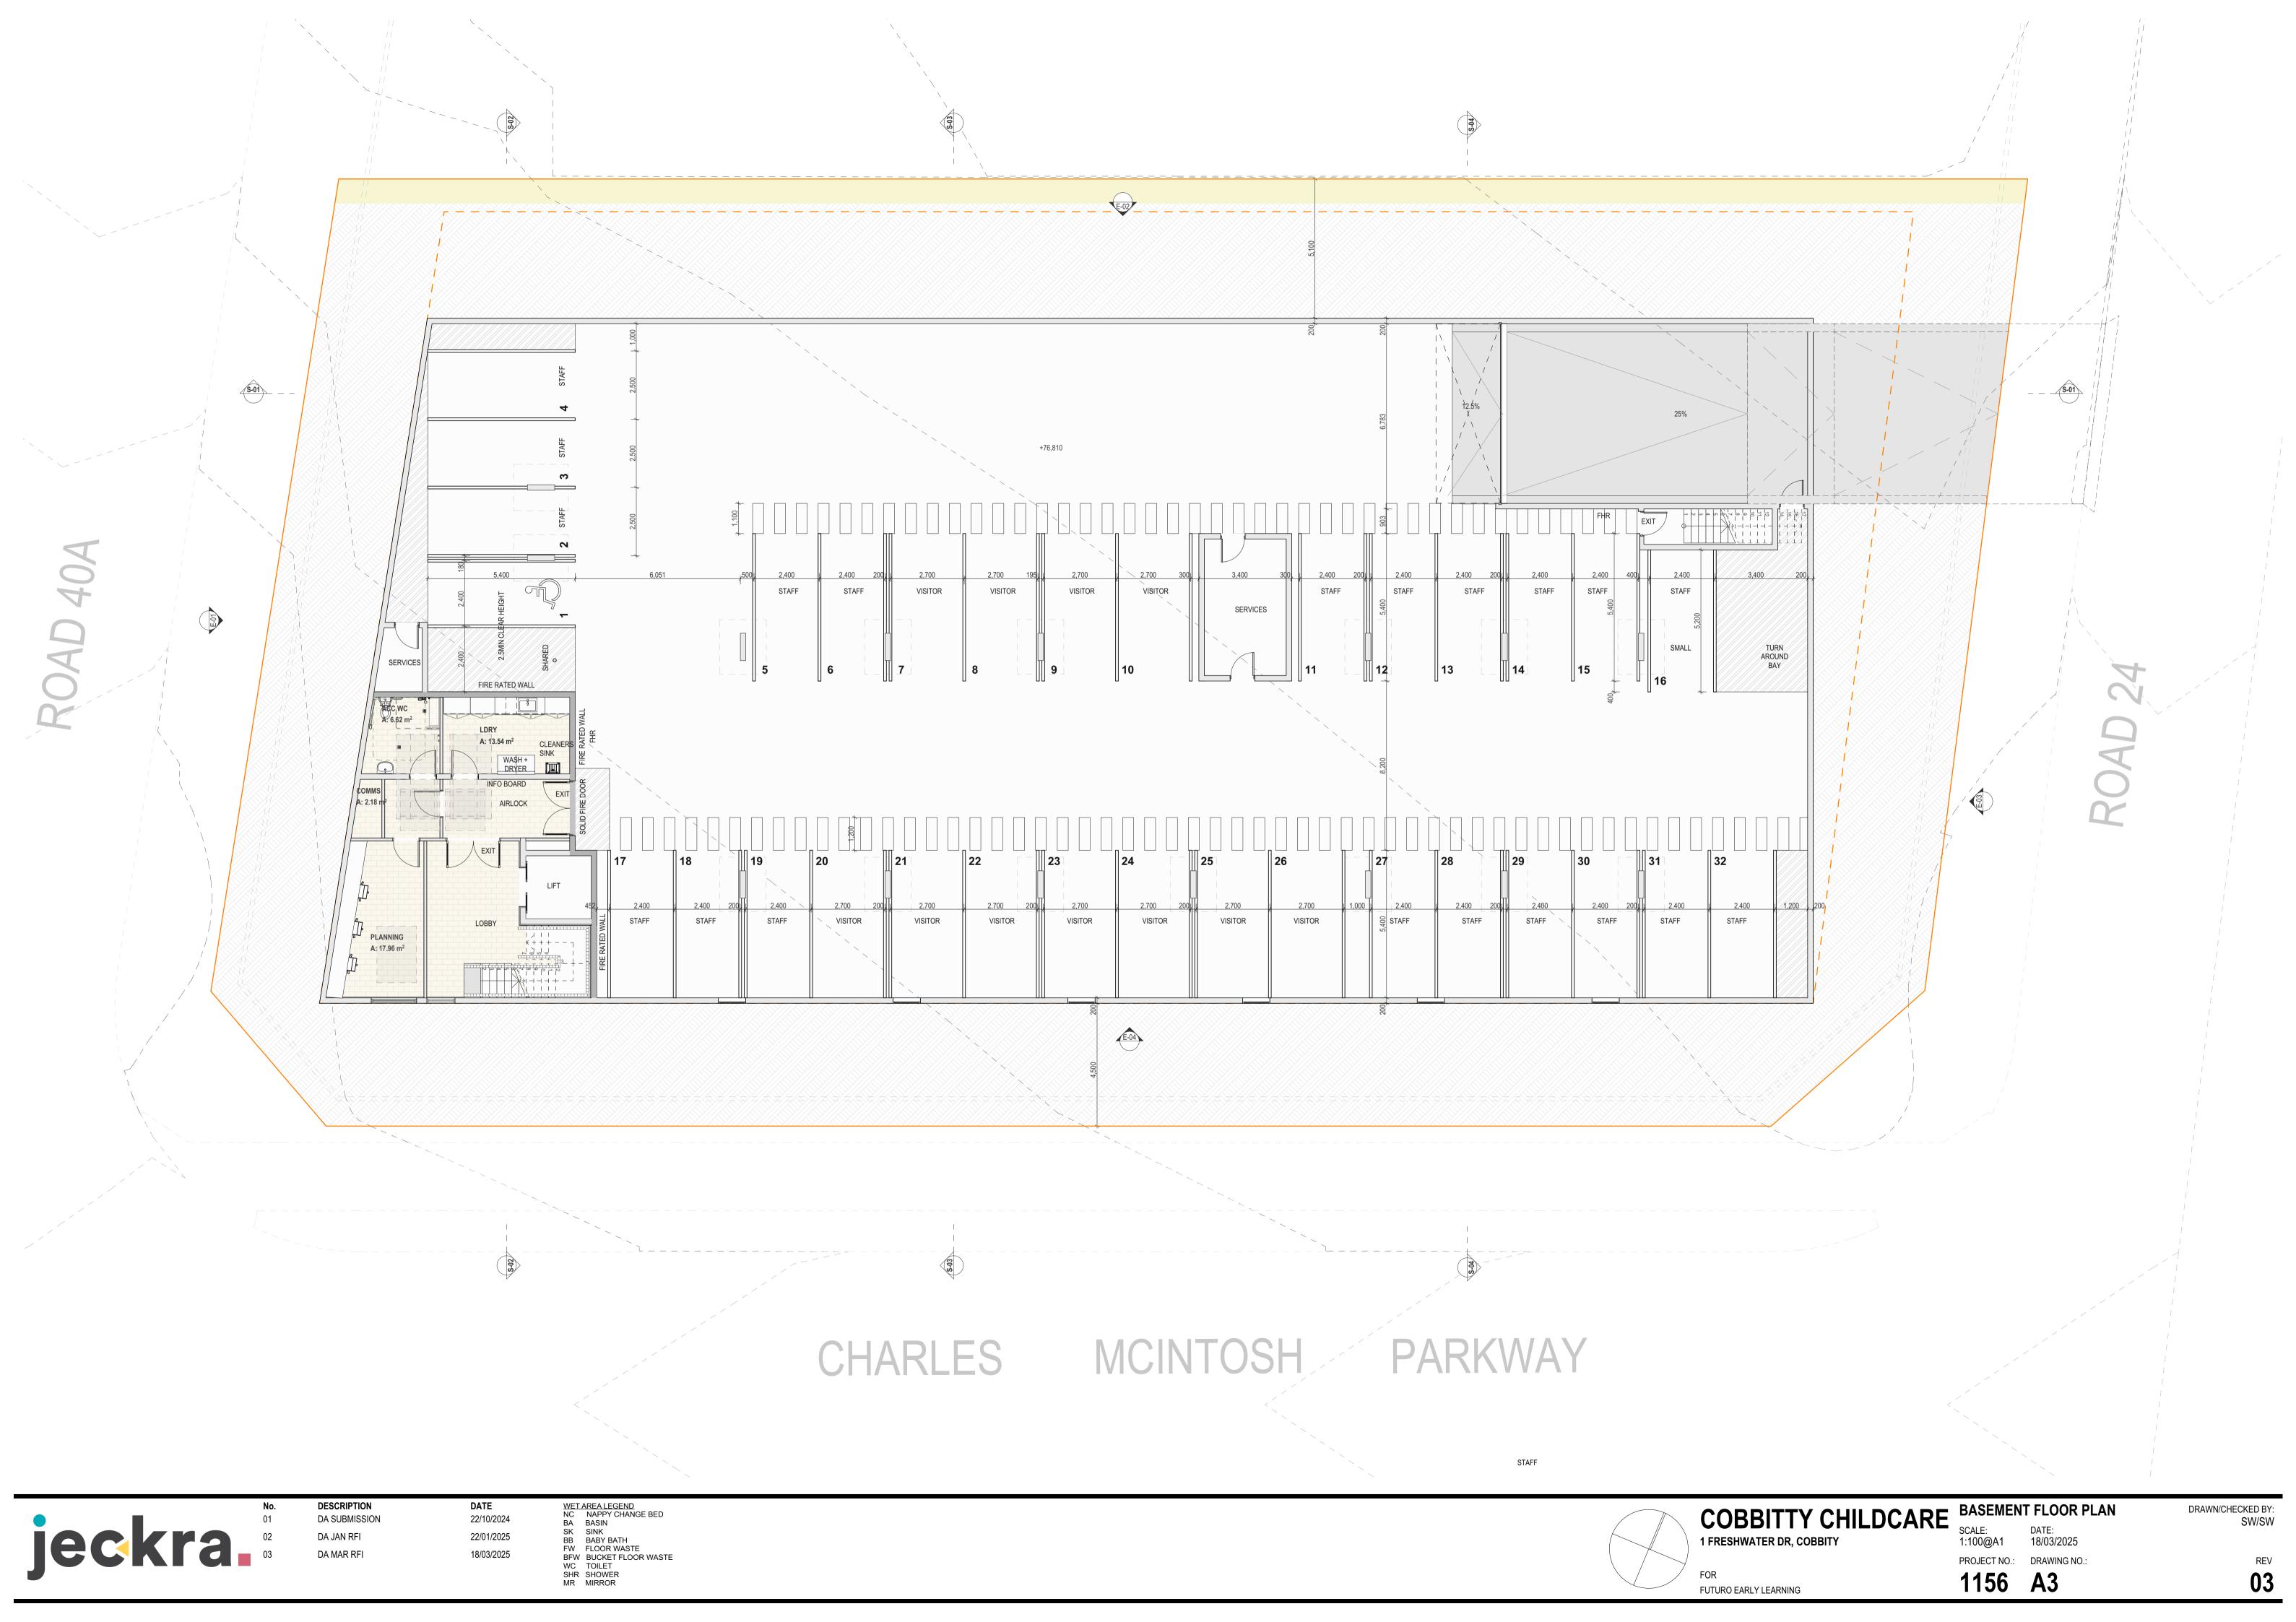

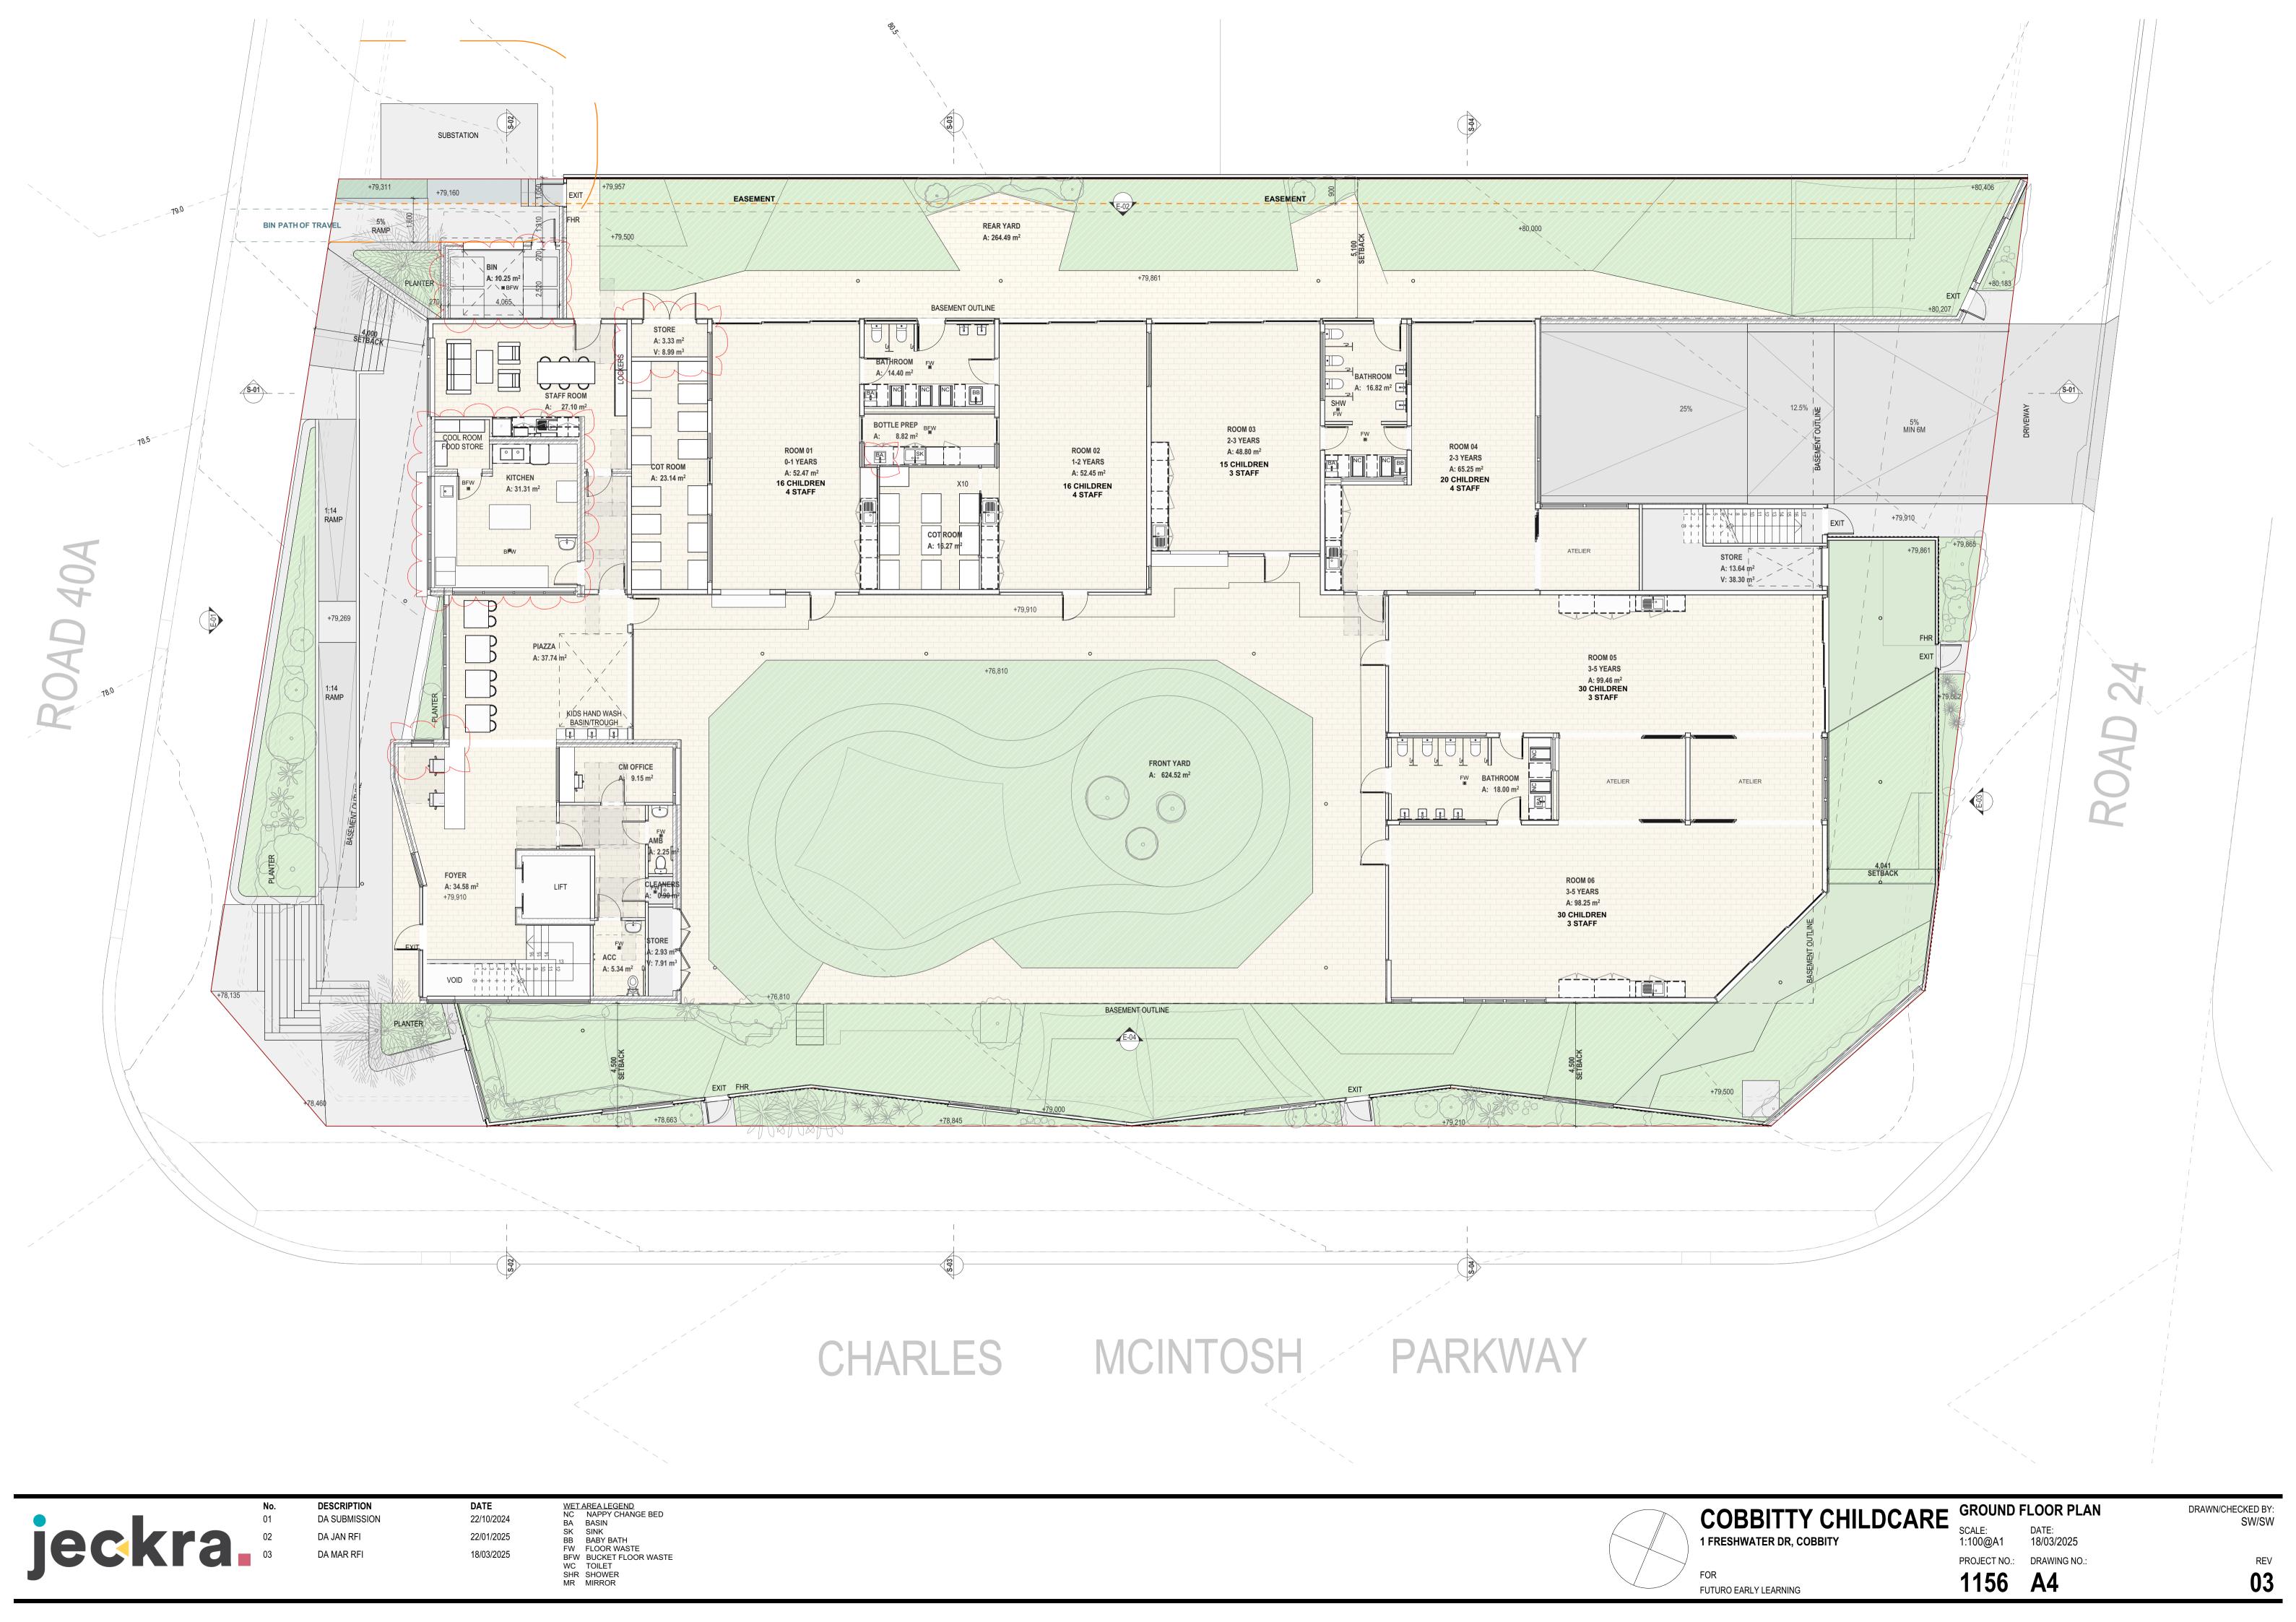

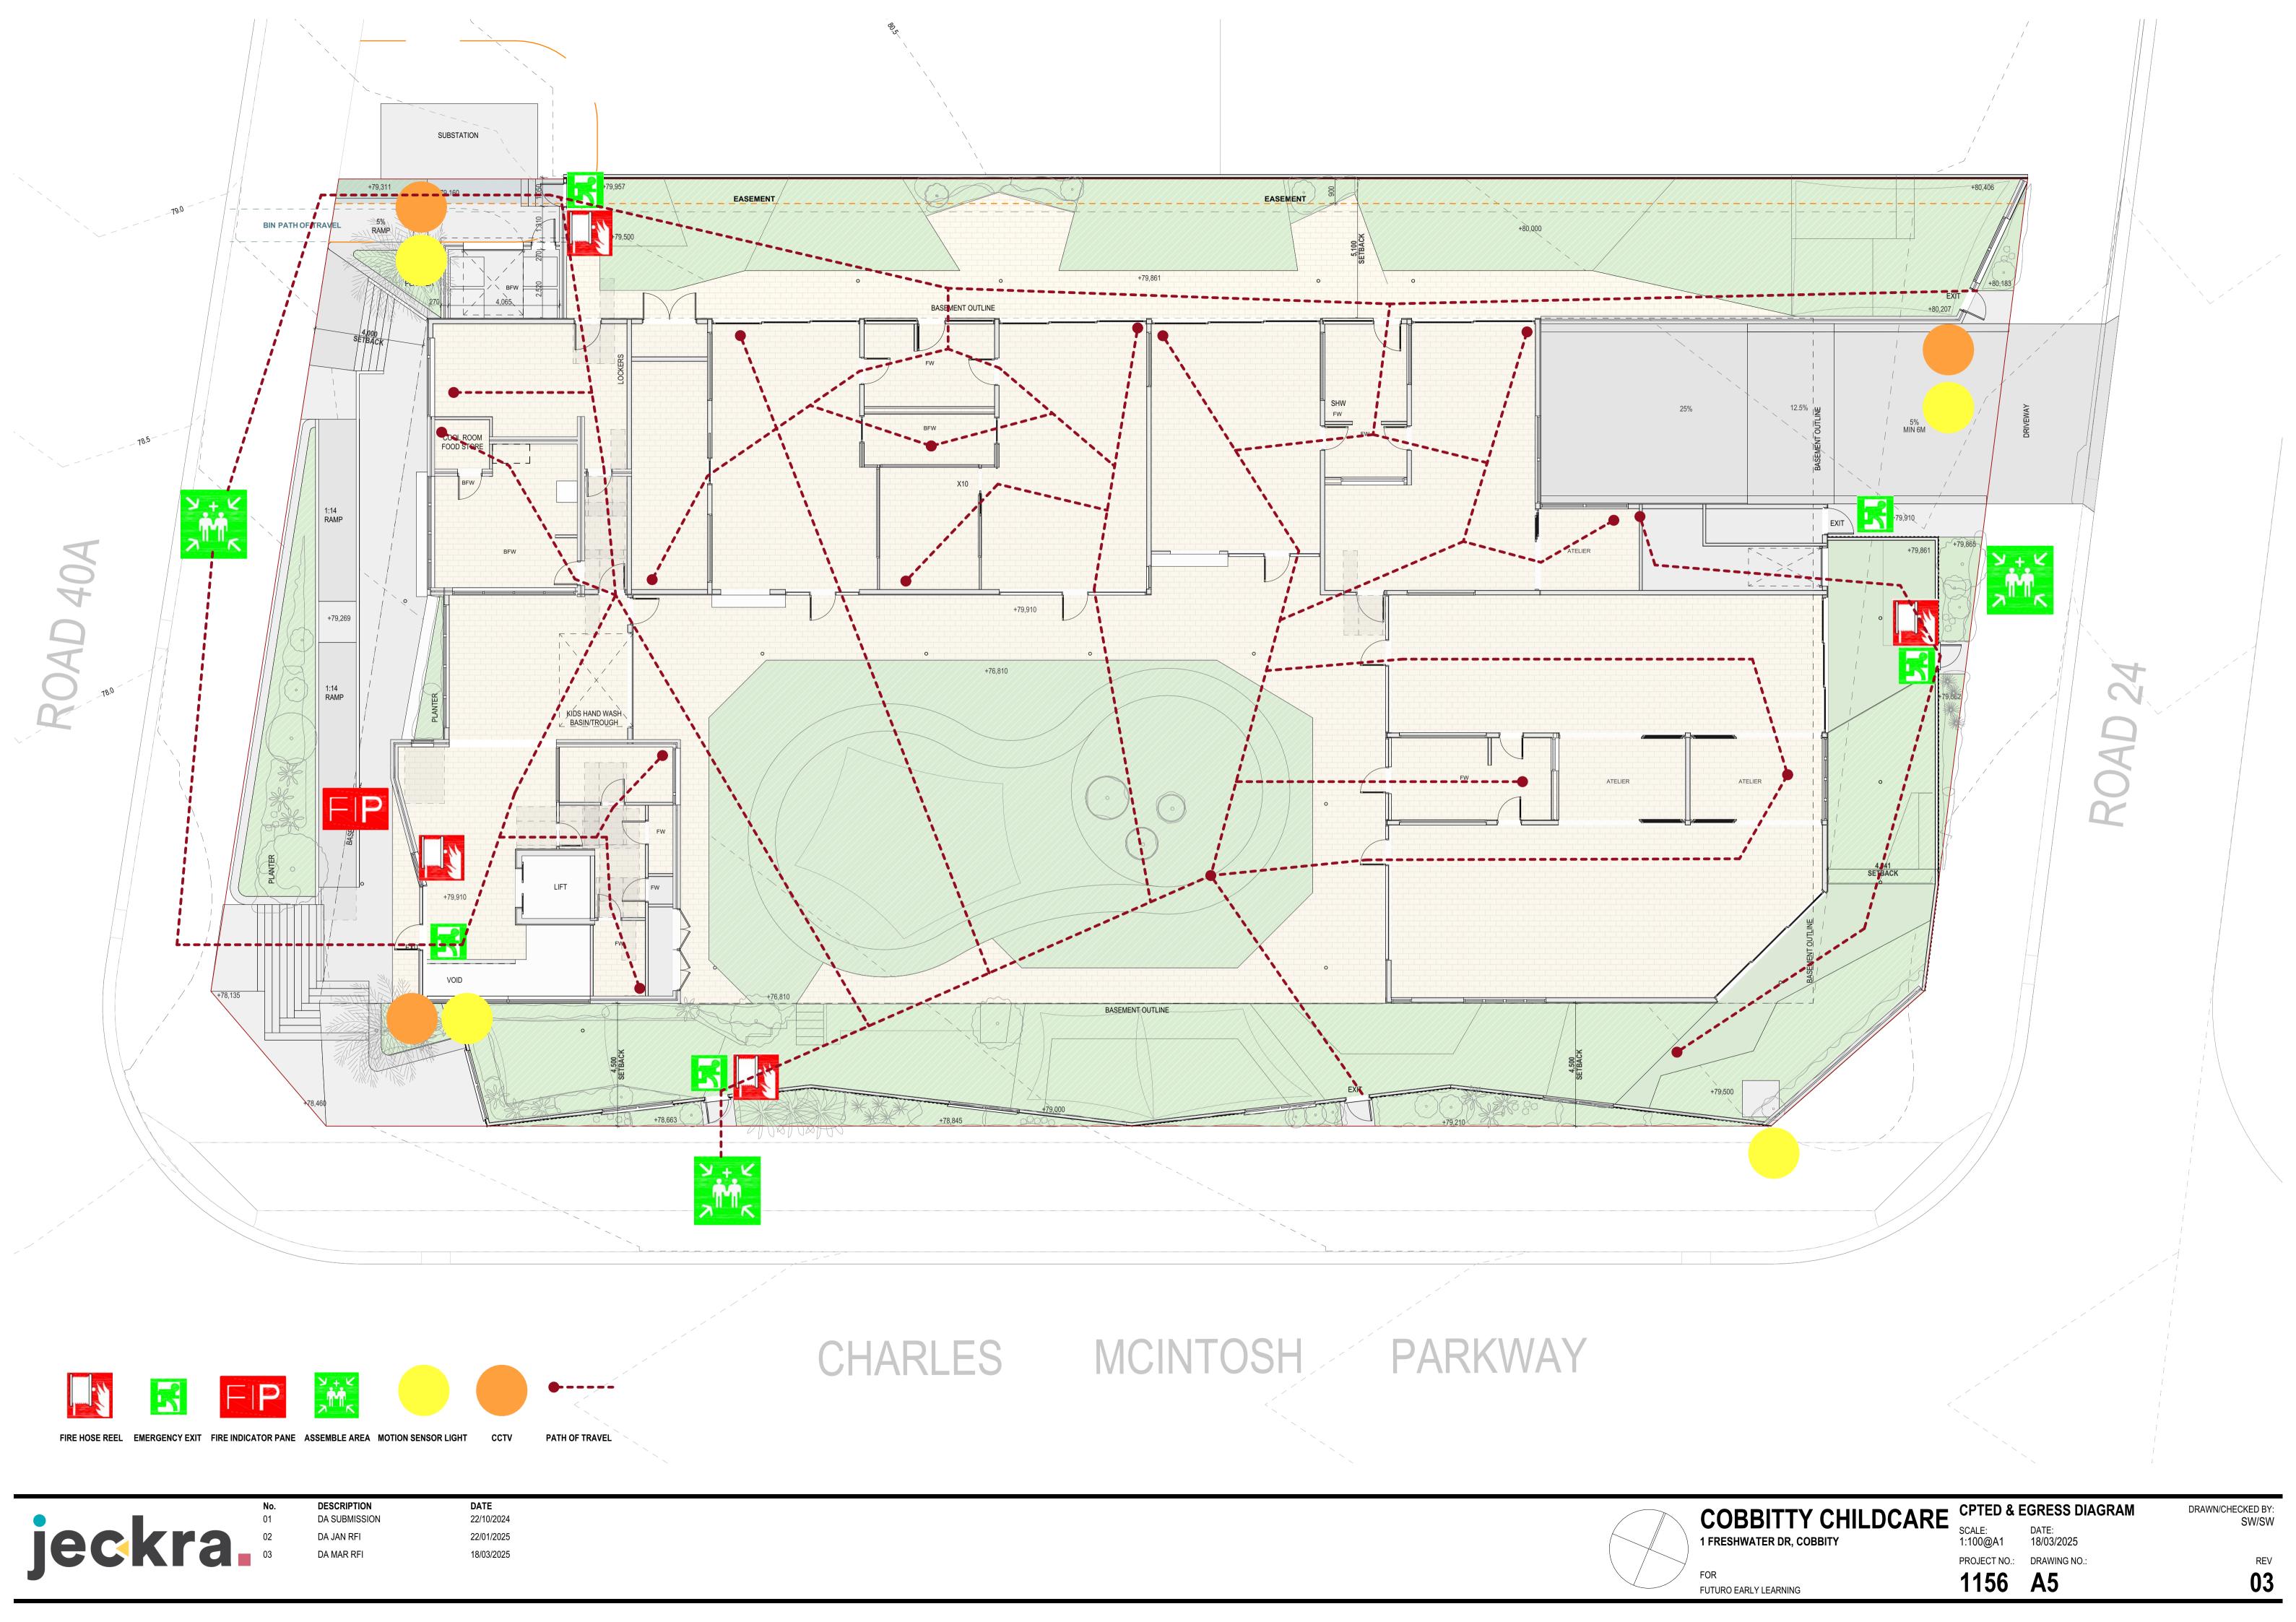

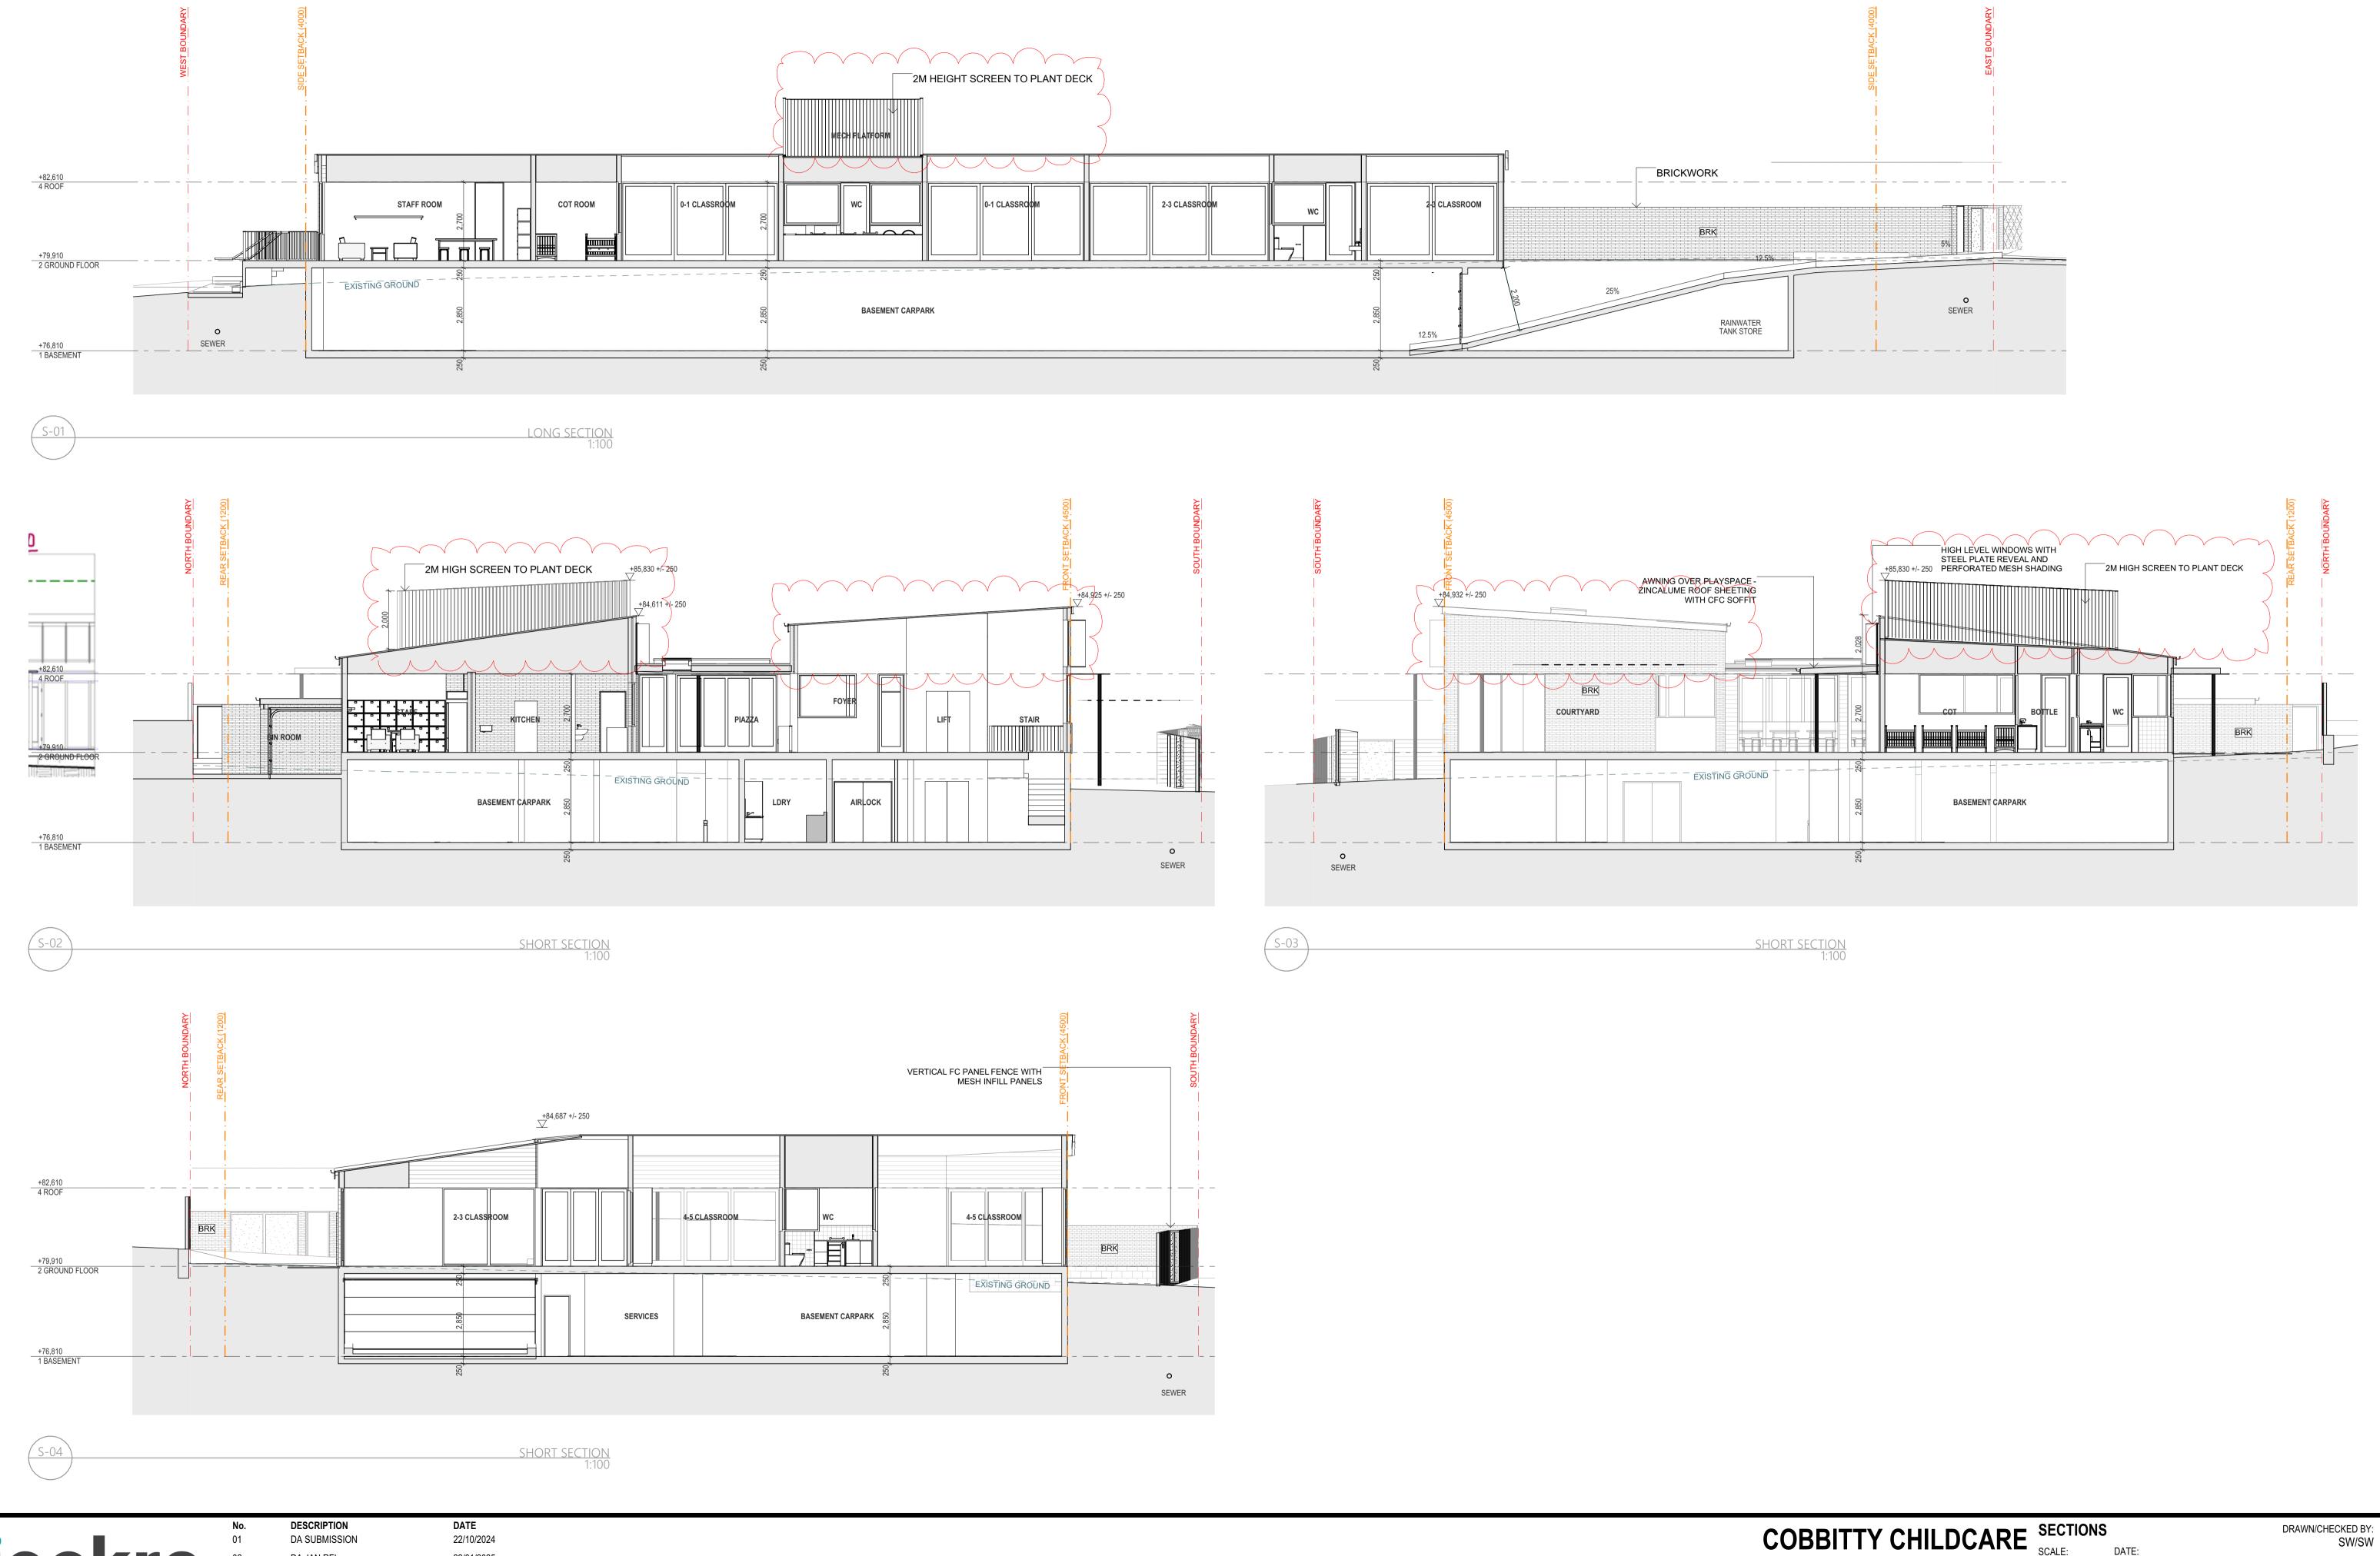


22/01/2025 18/03/2025 1 FRESHWATER DR, COBBITY FOR

FUTURO EARLY LEARNING

SCALE: DATE: 1:100@A1 18/03/2025 PROJECT NO.: DRAWING NO.: 1156 A6

03

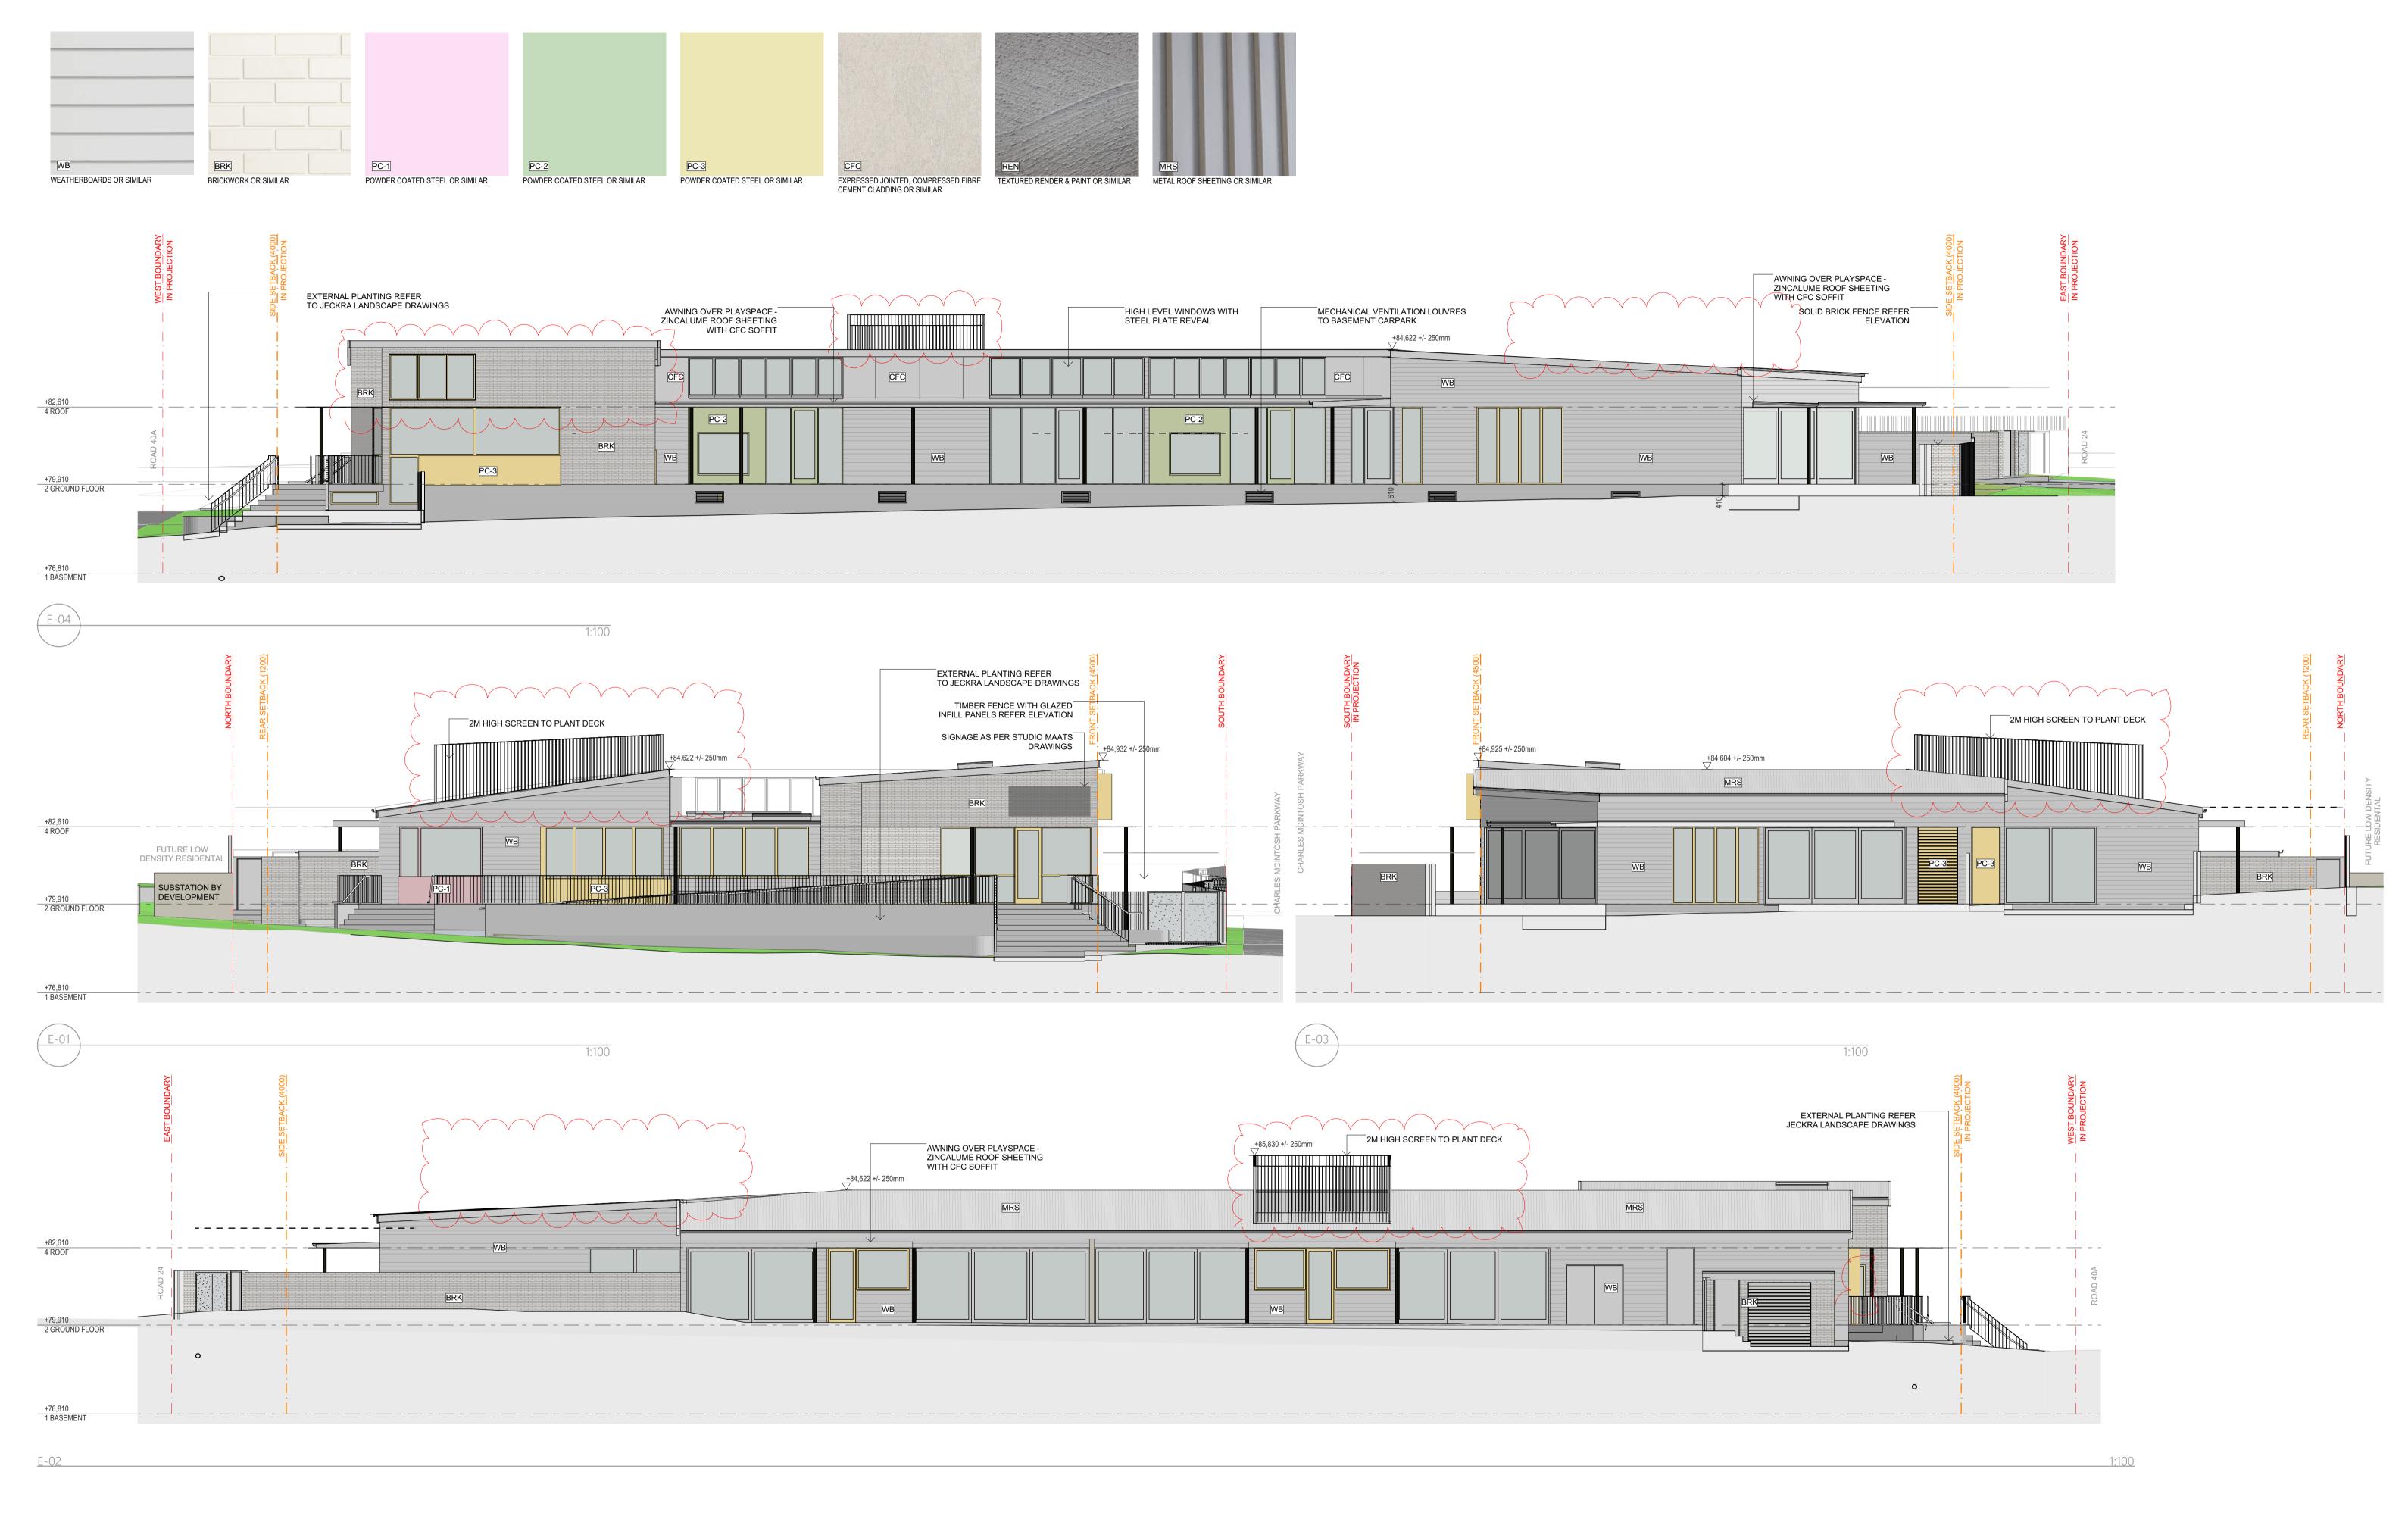



DESCRIPTIONDATEDA SUBMISSION22/10/2024DA JAN RFI22/01/2025DA MAR RFI18/03/2025

COBBITTY CHILDCARE

1 FRESHWATER DR, COBBITY

PROJECT NO.: DRA

FOR

FUTURO EARLY LEARNING

 ELEVATIONS
 DRAWN/CHECKED BY: SW/SW

 SCALE: 1:100@A1
 DATE: 18/03/2025

 PROJECT NO.: DRAWING NO.: REV
 Table 1


 1156
 A7







DESCRIPTION DA SUBMISSION 22/10/2024 22/01/2025

WET AREA LEGEND NC NAPPY CHANGE BED BA BASIN
SK SINK
BB BABY BATH
FW FLOOR WASTE
BFW BUCKET FLOOR WASTE WC TOILET SHR SHOWER MR MIRROR

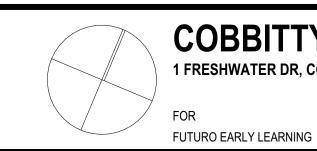


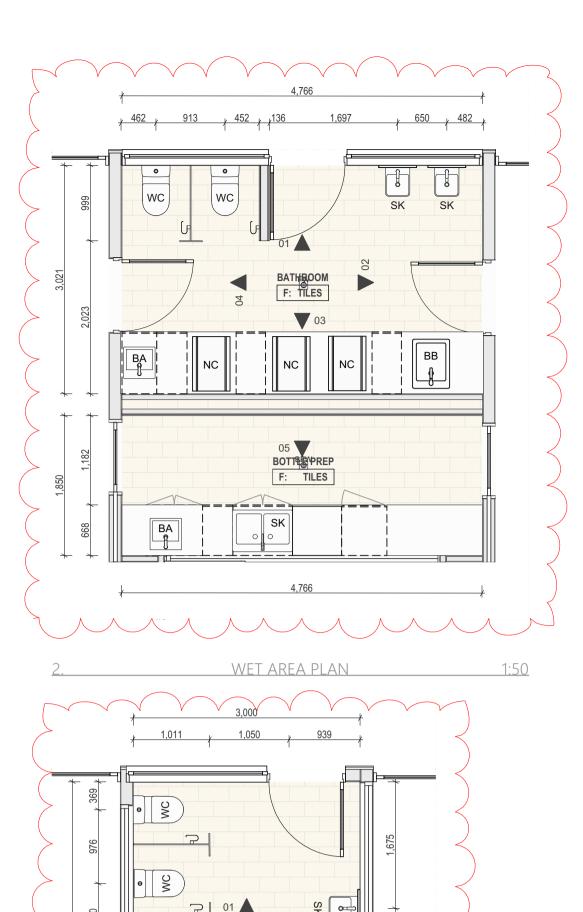



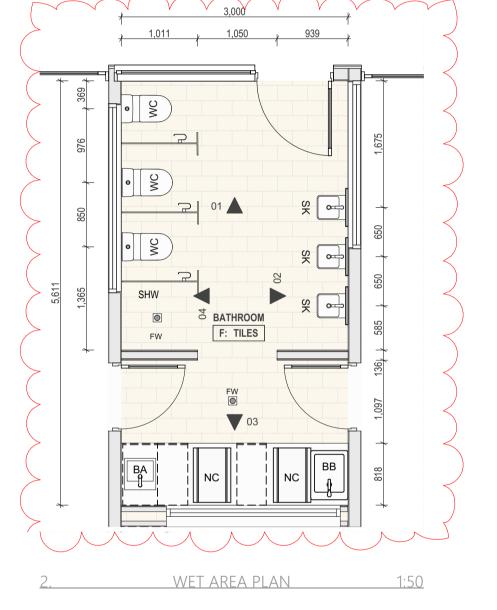




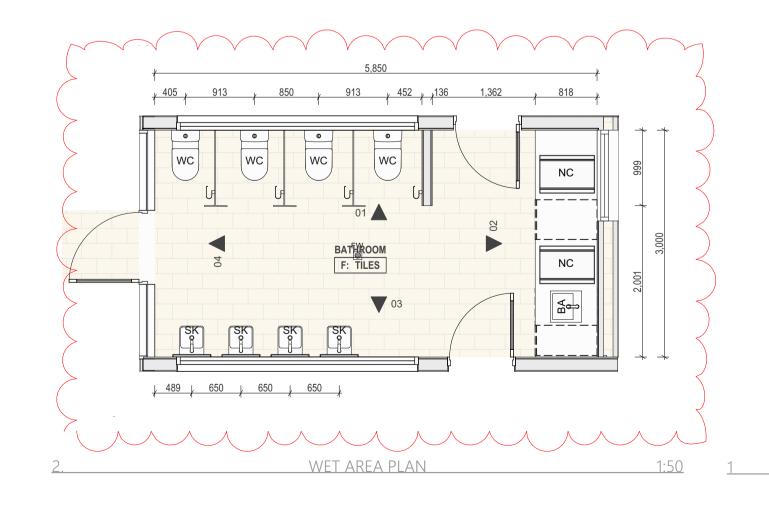






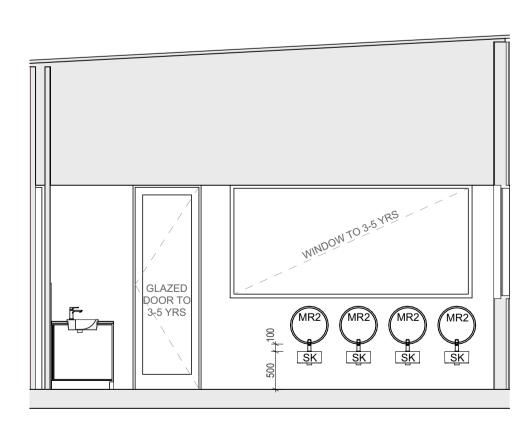


WC 4-5

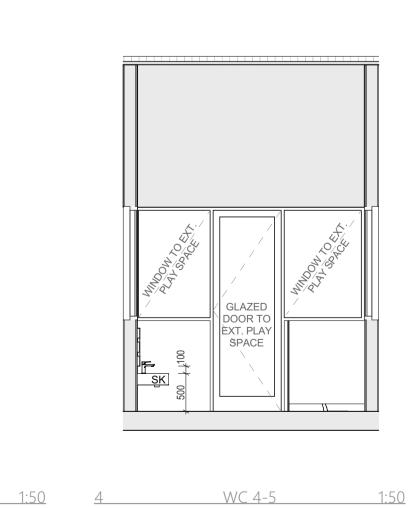

DESCRIPTION DA SUBMISSION 22/10/2024 22/01/2025

WET AREA LEGEND NC NAPPY CHANGE BED BA BASIN
SK SINK
BB BABY BATH
FW FLOOR WASTE
BFW BUCKET FLOOR WASTE WC TOILET SHR SHOWER MR MIRROR

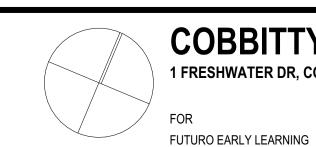

COBBITTY CHILDCARE WET AREA BATHROOMS
SCALE. DATE. 1 FRESHWATER DR, COBBITY

SCALE: DATE: 1:50@A1 18/03/2025 PROJECT NO.: DRAWING NO.: 1156 A9

DRAWN/CHECKED BY: SW/SW 03




+79,910 2 GROUND FLOOR +76,810 1 BASEMENT	VERTICAL CLADDING WITH WESH TRELLIS TO 1800 HIGH	MESH SCREEN BRICKWORK
F-06	EASTERN FENCE ELEVATION 1:100	
	BRICKNIORIX SET BACK O 1.8M LIGHTWEIGHT FENCE 1.8M LIGHTWEIGHT FENCE	1.8M LIGHTWEIGHT FENCE ON RETAINING WALL SMERCE RECKNOCK RECKNO
2.	EASTERN FENCE PLAN 1:100	







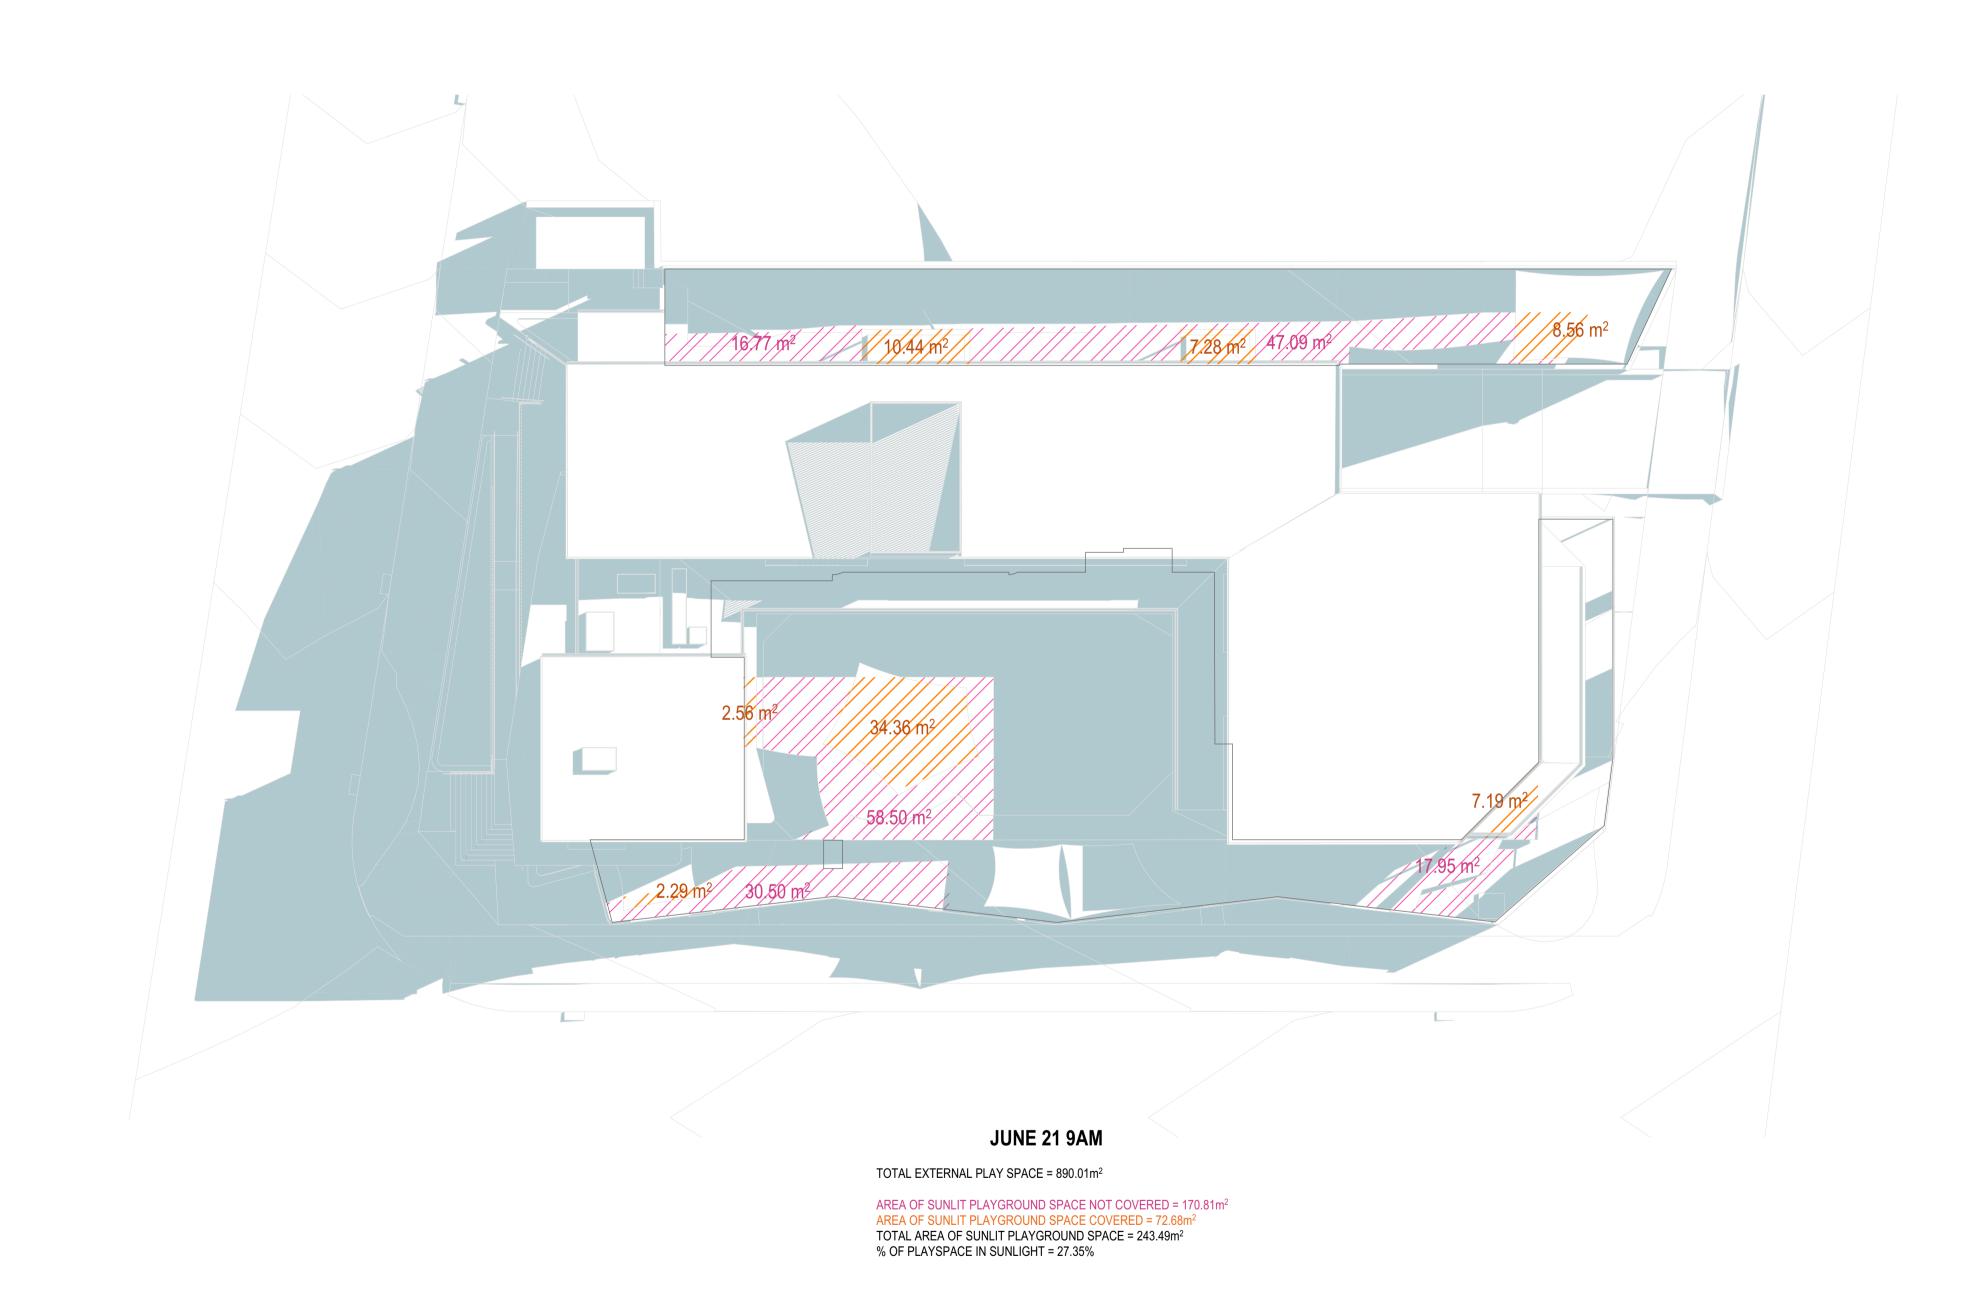

jeckra.

DRAWN/CHECKED BY:


SW/SW

DESCRIPTION







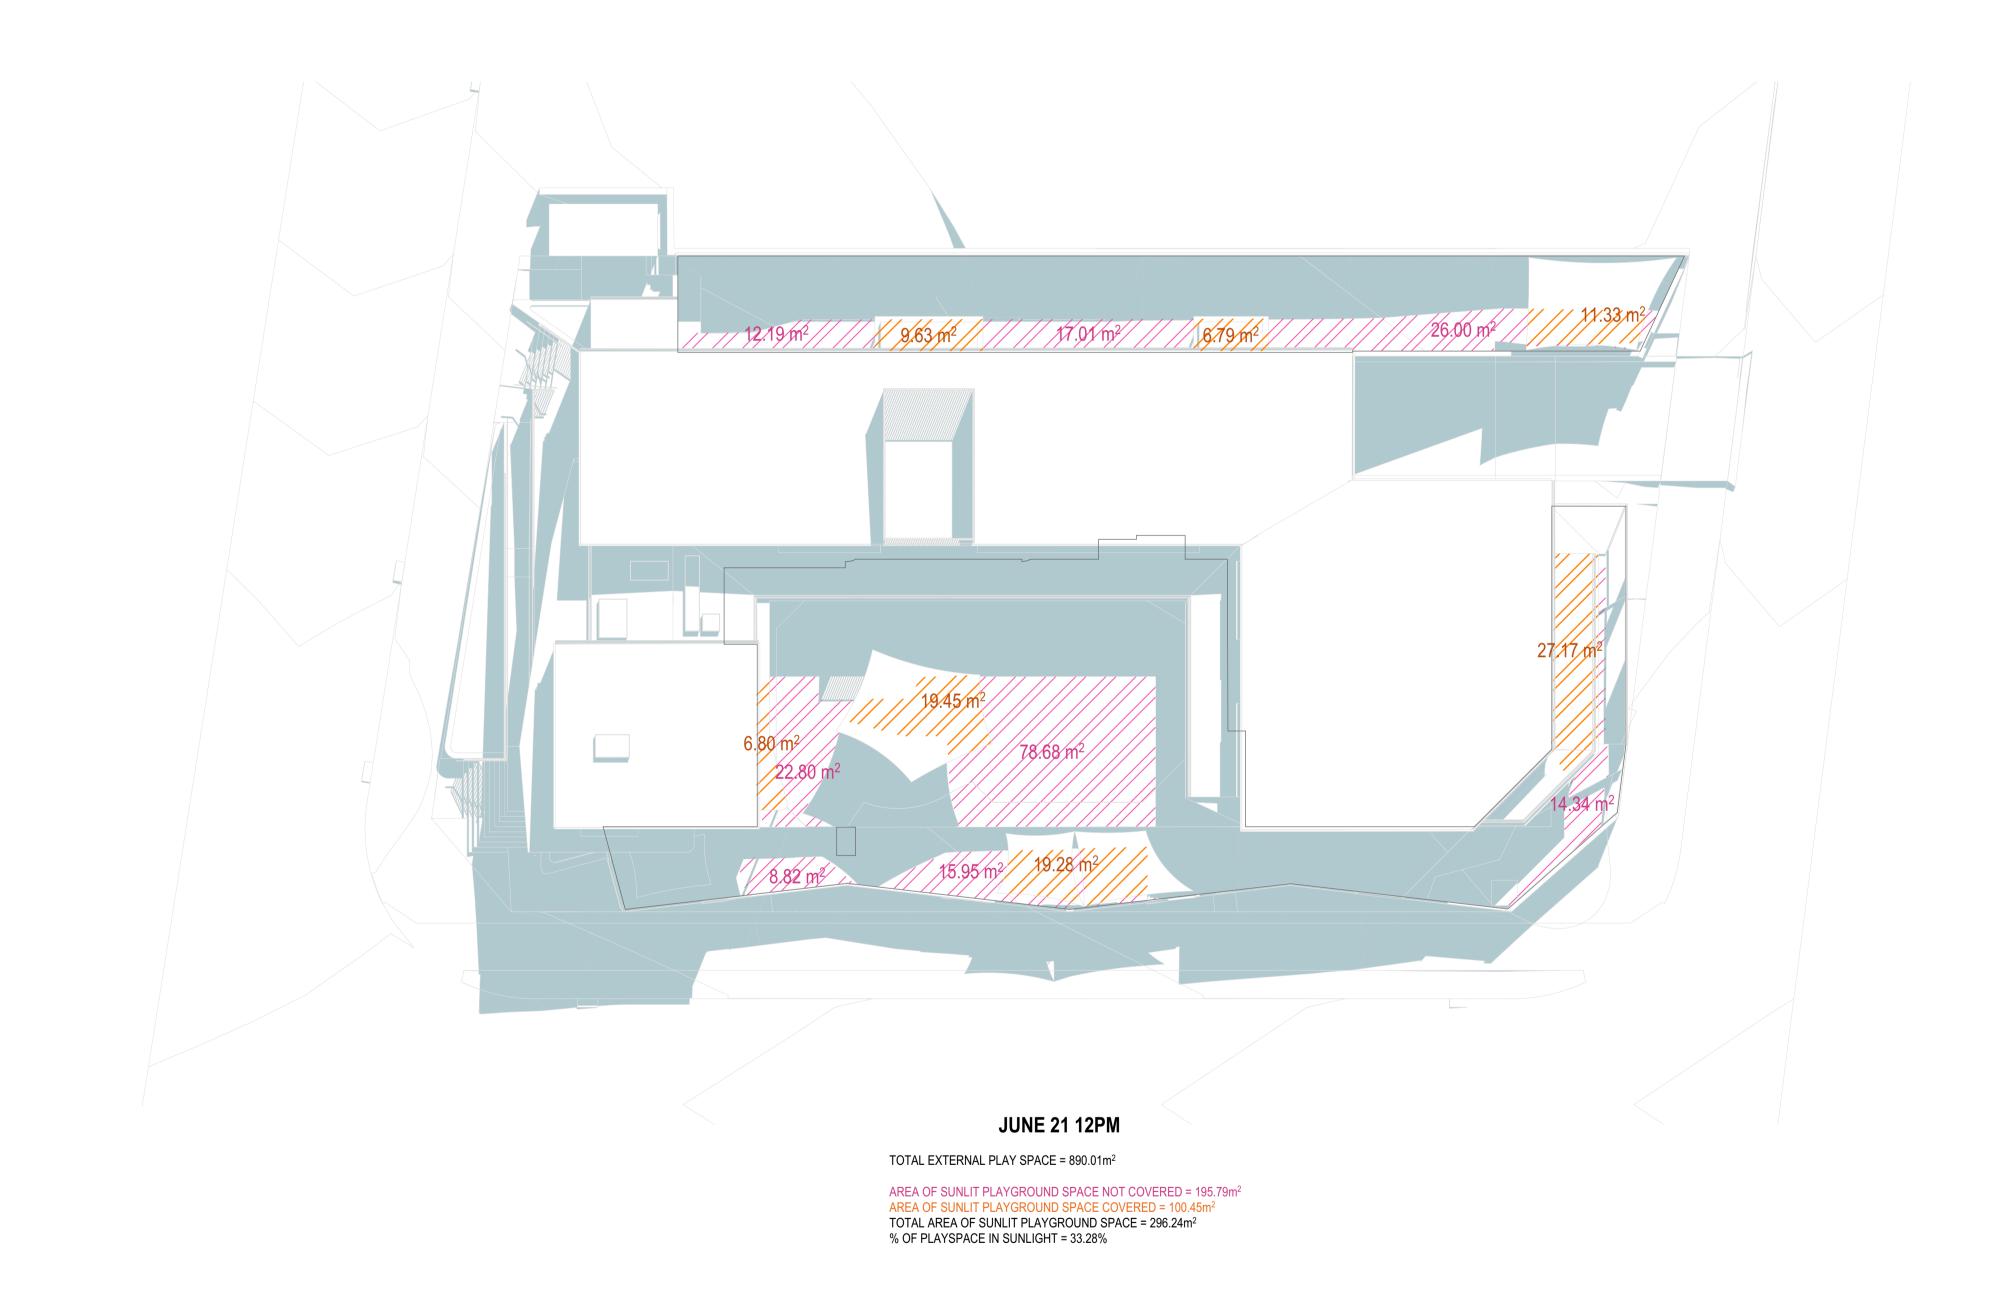













jeckra.





JECKRA PTY LTD UNIT 6, 58 HARBOUR STREET MOSMAN NSW 2088

PROJECT	DRAWING	DATE
COBBITTY CHILDCARE	PLAYSCAPES REFERENCE	18.03.25
PROJECT ADDRESS	DRAWING NUMBER	SCALE @ A1
1 FRESHWATER DRIVE COBBITTY NSW 2570	LA2410 - 01 - REV01	1:100

PLANTING SCHEDULE

. 2,					
BOTANICAL NAME	COMMON NAME	MATURE HEIGHT	QTY	SIZE	STAKE
Banksia serrata (squat)	Old Man Banksia	16m	5	200L	Yes
Blechnum 'Silver Lady'	Fishbone Waterfern	1.2m	5	200mm	No
Doryanthes excelsa	Gymea Lily	1-3m	12	200mm	No
Hibbertia scandens	Guinea Flower	Climber	178	200mm	No
Lomandra 'Katrinus'	Mat Rush	.7m	0	300mm	No
Pandorea jasminoides (light pink)	Bower Vine	Climber	193	200mm	No
Olea europaea	European Olive	8-15m	1	500L	Yes
Rosmarinus officinalis Prostratus	Creeping Rosemary	.5m	12	200mm	No
Syzygium floribundum	Weeping Lilly Pilly	10-30m	41	100-200L	Yes
Tristaniopsis laurina	Water Gum	4.6–9.1m	9	200-450L	Yes
Pennisetum alopecuroides	Chinese Fountain Grass	.7m	36	200-300mm	No
Aloe striata	Coral aloe	.9m	9	300mm	No
Rhapis excelsa	Broadleaf lady palm	3-5m	12	300-400mm	Yes
Lophostemon confertus	Brush Box	10-15m	2	450L	Yes
Blechnym / / / /	Silver Lady ~	1.2my ~ ~ ~	~8~V-	200mm	~ Nov~
Pandorea pandorana	Golden Showers	Climber	32	200mm	No
~	-	Total	~ \ 552 \	_~_/_/	
		Total Native	525		
		Total Native %	95%		

GENERAL NOTES

Plant graphics are indicative sizes only. Do not scale from drawings. All dimensions in mm unless otherwise stated. Figure dimensions shall take precedence

Contractors must verify all dimensions before commencing work.

Work Compliance

All works shall be carried out in accordance with the NCC, relevant Australian Standards and Local Government Regulations.

Site Preparation

All existing plants marked for retention shall be protected for the duration of works. Remove from site all perennial weeds and rubbish before commencing landscape works.

Soil Cultivation and Placement

Thoroughly cultivate all subsoil to a minimum depth of 200mm prior to planting. Supply and install quality garden soil mix to all planting beds to a minimum depth of 300mm prior to planting.

Supply and install a 75mm layer of hardwood horticultural grade mulch to all planting beds set down 25mm from adjacent paving or garden edge.

Failed and/or defective plants to be replaced by landscaper for a 3-month period following completion of work. Further maintenance during and after this period should include watering, weeding, fertilising, pest and disease control, pruning and hedging, reinstatement of mulch and keeping the site neat and


GENERAL PLANTING NOTES

The Contractor will be responsible for maintenance during a three-month period maintenance following planting. This includes watering, mowing, weeding, fertilising, pest and disease control, reseeding, staking and tying, replanting, cultivating, pruning, aerating and top dressing.

The Contractor should only select plants that are vigorous, well established, of good form and consistent with species or variety, not soft or forced, free from disease and insect pests, with large healthy root systems and no evidence of having been restricted in growth or damaged.

The Contractor should install 'root barriers' or equivalent to manufacturers specifications to protect nearby structures and services.

Note Install temporary drip irrigation system under mulch in tree protection zones and water on allotted days.

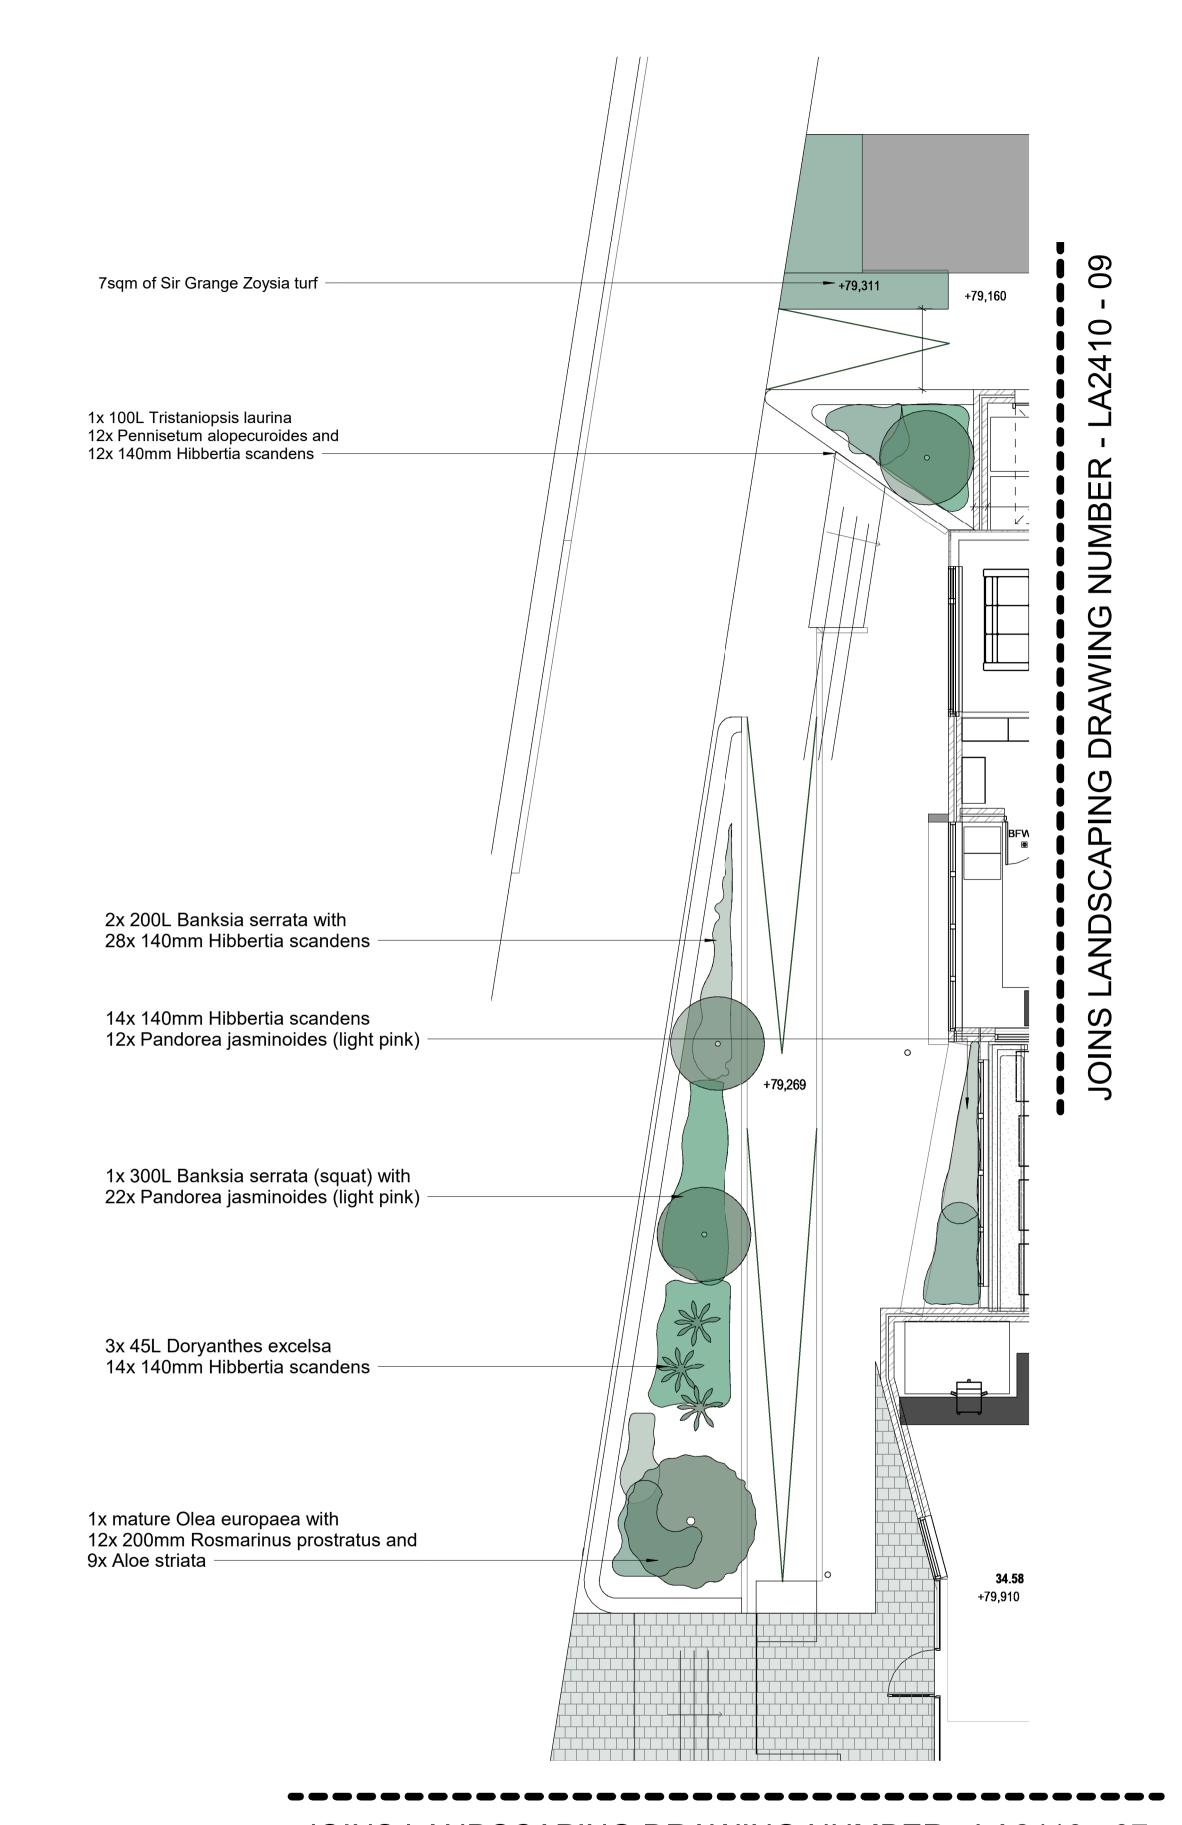

JOINS LANDSCAPING DRAWING NUMBER - LA2410 - 07



JECKRA PTY LTD UNIT 6, 58 HARBOUR STREET MOSMAN NSW 2088

PROJECT COBBITTY CHILDCARE	DRAWING PLANTING PLAN WEST	DATE 18.03.25
PROJECT ADDRESS 1 FRESHWATER DRIVE COBBITTY NSW 2570	DRAWING NUMBER LA2410 - 06 - REV02	SCALE @ A1 1:75

MATURE HEIGHT SIZE **COMMON NAME** STAKE **BOTANICAL NAME** Old Man Banksia 200L Banksia serrata (squat) 1.2m Fishbone Waterfern 200mm Blechnum 'Silver Lady' 1-3m Gymea Lily 200mm Doryanthes excelsa Climber Guinea Flower 200mm Hibbertia scandens Mat Rush 300mm Lomandra 'Katrinus' **Bower Vine** Climber 193 Pandorea jasminoides (light pink) 200mm European Olive 8-15m 500L Olea europaea Rosmarinus officinalis Prostratus Creeping Rosemary 200mm Syzygium floribundum 10-30m 41 100-200L Weeping Lilly Pilly 4.6-9.1m 200-450L Water Gum Tristaniopsis laurina Chinese Fountain Grass 200-300mm Pennisetum alopecuroides Coral aloe 300mm Aloe striata Broadleaf lady palm 3-5m 300-400mm Rhapis excelsa Lophostemon confertus **Brush Box** 10-15m 450L Silver Lady Blechnum Golden Showers Climber 200mm Pandorea pandorana

Total Native

Total Native %

525

95%

GENERAL NOTES

Plant graphics are indicative sizes only. Do not scale from drawings. All dimensions in mm unless otherwise stated. Figure dimensions shall take precedence

Contractors must verify all dimensions before commencing work.

Work Compliance

All works shall be carried out in accordance with the NCC, relevant Australian Standards and Local Government Regulations.

Site Preparation

Yes

No

No

Yes

No

Yes

Yes

No

No

Yes

Yes

All existing plants marked for retention shall be protected for the duration of works. Remove from site all perennial weeds and rubbish before commencing landscape works.

Soil Cultivation and Placement

Thoroughly cultivate all subsoil to a minimum depth of 200mm prior to planting. Supply and install quality garden soil mix to all planting beds to a minimum depth of 300mm prior to planting.

Supply and install a 75mm layer of hardwood horticultural grade mulch to all planting beds set down 25mm from adjacent paving or garden edge.

Failed and/or defective plants to be replaced by landscaper for a 3-month period following completion of work. Further maintenance during and after this period should include watering, weeding, fertilising, pest and disease control, pruning and hedging, reinstatement of mulch and keeping the site neat and


GENERAL PLANTING NOTES

The Contractor will be responsible for maintenance during a three-month period maintenance following planting. This includes watering, mowing, weeding, fertilising, pest and disease control, reseeding, staking and tying, replanting, cultivating, pruning, aerating and top dressing.

The Contractor should only select plants that are vigorous, well established, of good form and consistent with species or variety, not soft or forced, free from disease and insect pests, with large healthy root systems and no evidence of having been restricted in growth or damaged.

The Contractor should install 'root barriers' or equivalent to manufacturers specifications to protect nearby structures and services.

Note Install temporary drip irrigation system under mulch in tree protection zones and water on allotted days.

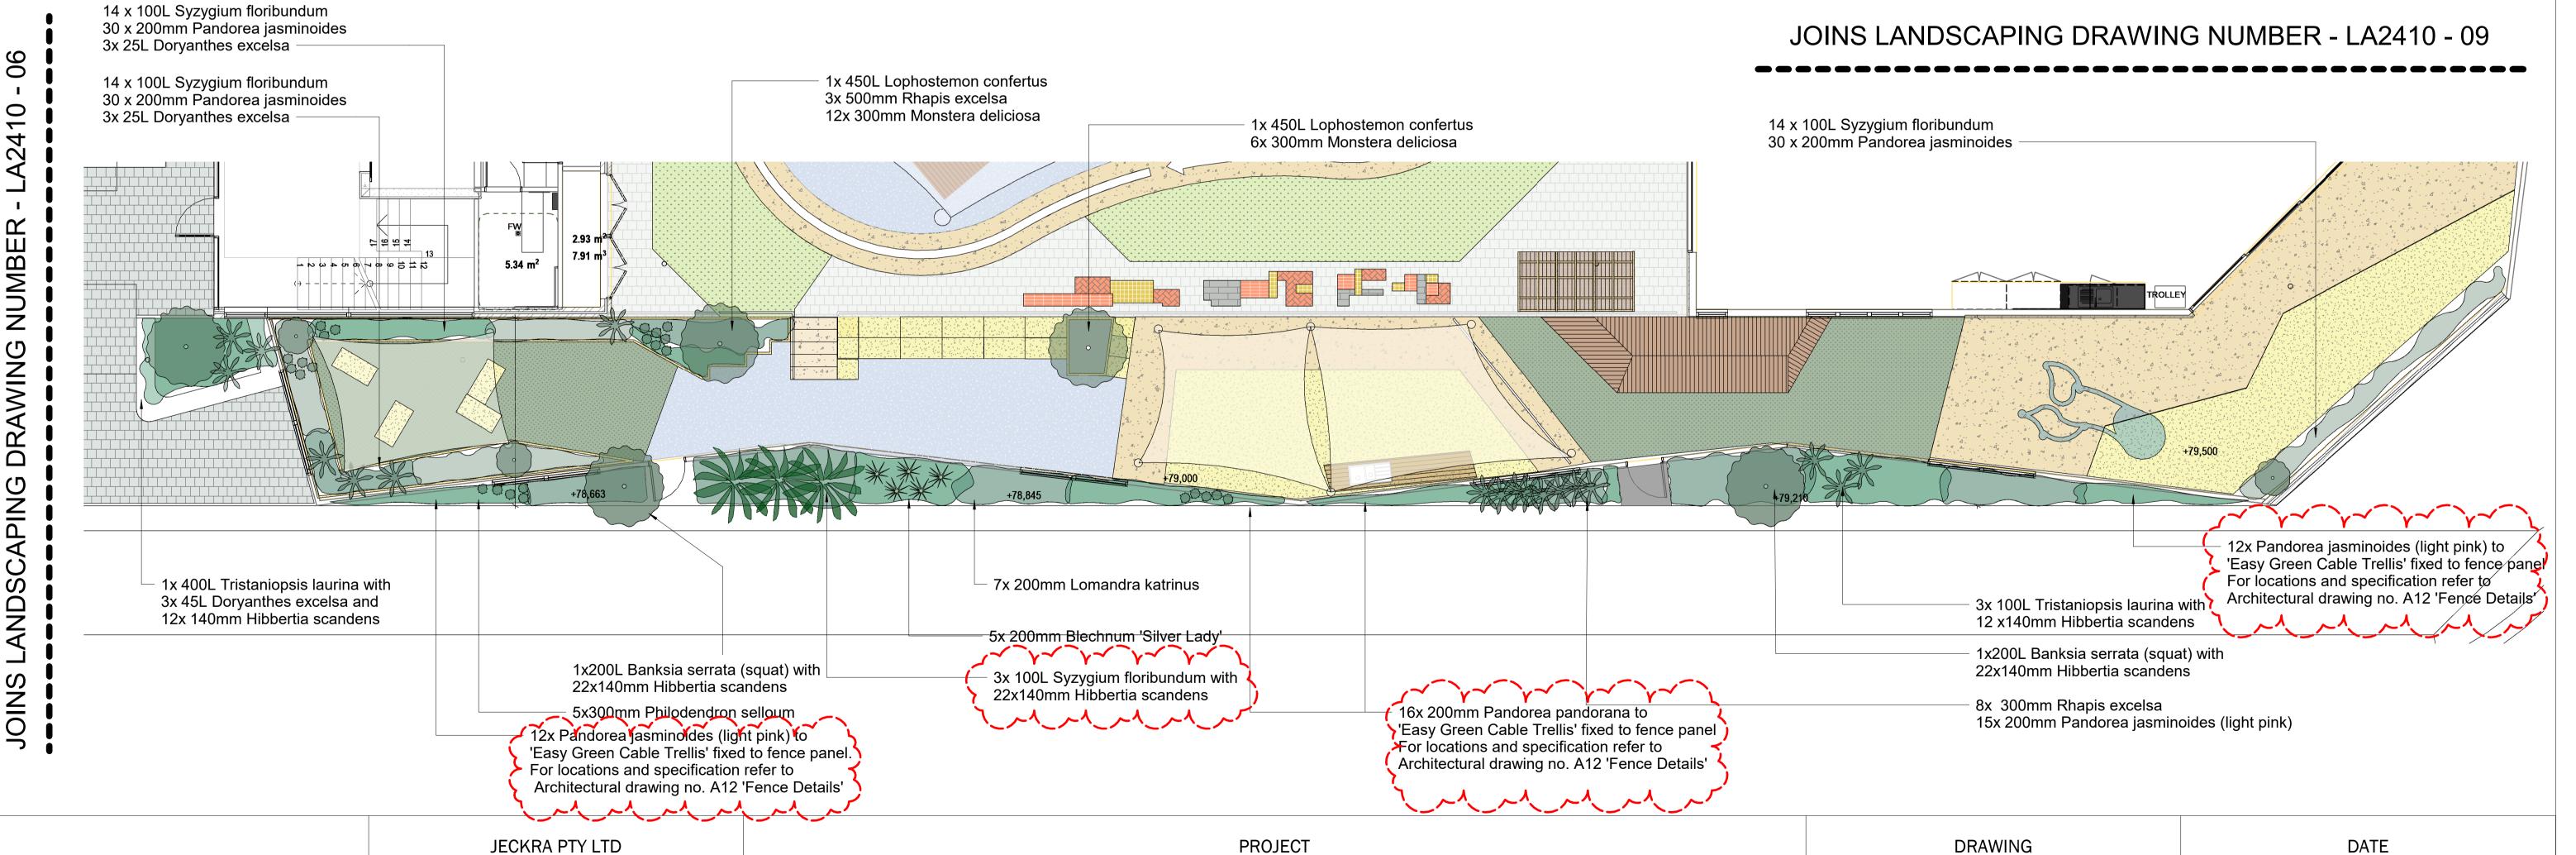



PLANTING SCHEDULE

0

410

NUMBER

DRAWING

LAND

JECKRA PTY LTD UNIT 6, 58 HARBOUR STREET MOSMAN NSW 2088 T 02 9539 8835 info@jeckra.com.au

www.jeckra.com.au

18.03.25 **COBBITTY CHILDCARE** PLANTING PLAN SOUTH SCALE @ A1 PROJECT ADDRESS DRAWING NUMBER 1 FRESHWATER DRIVE COBBITTY NSW 2570 LA2410 - 07 - REV02 1:75

PLANTING SCHEDULE

BOTANICAL NAME	COMMON NAME	MATURE HEIGHT	QTY	SIZE	STAKE
Banksia serrata (squat)	Old Man Banksia	16m	5	200L	Yes
Blechnum 'Silver Lady'	Fishbone Waterfern	1.2m	5	200mm	No
Doryanthes excelsa	Gymea Lily	1-3m	12	200mm	No
Hibbertia scandens	Guinea Flower	Climber	178	200mm	No
Lomandra 'Katrinus'	Mat Rush	.7m	0	300mm	No
Pandorea jasminoides (light pink)	Bower Vine	Climber	193	200mm	No
Olea europaea	European Olive	8-15m	1	500L	Yes
Rosmarinus officinalis Prostratus	Creeping Rosemary	.5m	12	200mm	No
Syzygium floribundum	Weeping Lilly Pilly	10-30m	41	100-200L	Yes
Tristaniopsis laurina	Water Gum	4.6–9.1m	9	200-450L	Yes
Pennisetum alopecuroides	Chinese Fountain Grass	.7m	36	200-300mm	No
Aloe striata	Coral aloe	.9m	9	300mm	No
Rhapis excelsa	Broadleaf lady palm	3-5m	12	300-400mm	Yes
Lophostemon confertus	Brush Box	10-15m	2	450L	Yes
Blechnym / / /	Silver Lady	1.2my	~~~~~~~~~~~~~~~~~~~~~~~~~~~~~~~~~~~~~~	200pm	~~\no _v ~
Pandorea pandorana	Golden Showers	Climber	32	200mm	No
~~~~	~	_rôtal\~\	~ \ 552 \	_~^~	~_\
		Total Native	525		
		Total Native %	95%		

GENERAL NOTES

Drawing Interpretation

Plant graphics are indicative sizes only. Do not scale from drawings. All dimensions in mm unless otherwise stated. Figure dimensions shall take precedence

Contractors must verify all dimensions before commencing work.

Work Compliance

All works shall be carried out in accordance with the NCC, relevant Australian Standards and Local Government Regulations.

Site Preparation

All existing plants marked for retention shall be protected for the duration of works. Remove from site all perennial weeds and rubbish before commencing

Soil Cultivation and Placement

Thoroughly cultivate all subsoil to a minimum depth of 200mm prior to planting. Supply and install quality garden soil mix to all planting beds to a minimum depth of 300mm prior to planting.

Supply and install a 75mm layer of hardwood horticultural grade mulch to all planting beds set down 25mm from adjacent paving or garden edge.

Failed and/or defective plants to be replaced by landscaper for a 3-month period following completion of work. Further maintenance during and after this period should include watering, weeding, fertilising, pest and disease control, pruning and hedging, reinstatement of mulch and keeping the site neat and


GENERAL PLANTING NOTES

The Contractor will be responsible for maintenance during a three-month period maintenance following planting. This includes watering, mowing, weeding, fertilising, pest and disease control, reseeding, staking and tying, replanting, cultivating, pruning, aerating and top dressing.

The Contractor should only select plants that are vigorous, well established, of good form and consistent with species or variety, not soft or forced, free from disease and insect pests, with large healthy root systems and no evidence of having been restricted in growth or damaged.

The Contractor should install 'root barriers' or equivalent to manufacturers specifications to protect nearby structures and services.

Note Install temporary drip irrigation system under mulch in tree protection zones and water on allotted days.

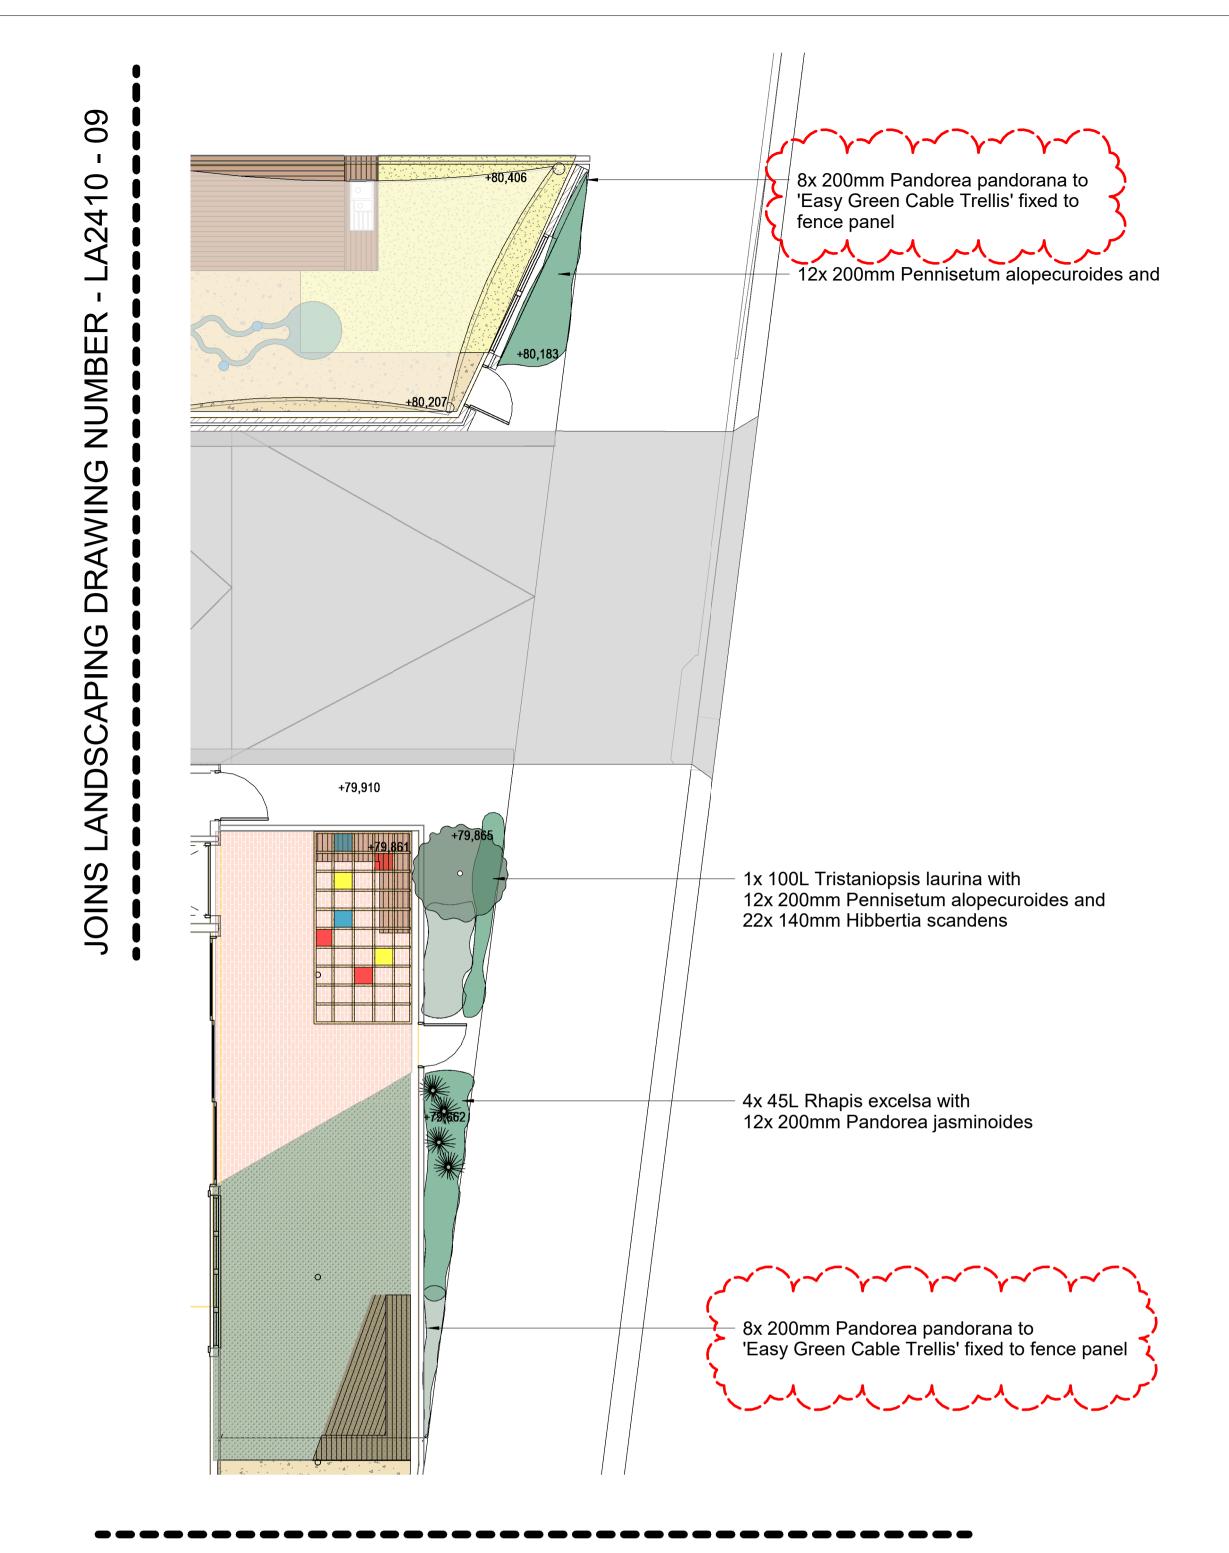


JOINS LANDSCAPING DRAWING NUMBER - LA2410 - 07



JECKRA PTY LTD UNIT 6, 58 HARBOUR STREET MOSMAN NSW 2088

PROJECT COBBITTY CHILDCARE	DRAWING PLANTING PLAN EAST	DATE 18.03.25
PROJECT ADDRESS 1 FRESHWATER DRIVE COBBITTY NSW 2570	DRAWING NUMBER LA2410 - 08 - REV02	SCALE @ A1 1:75

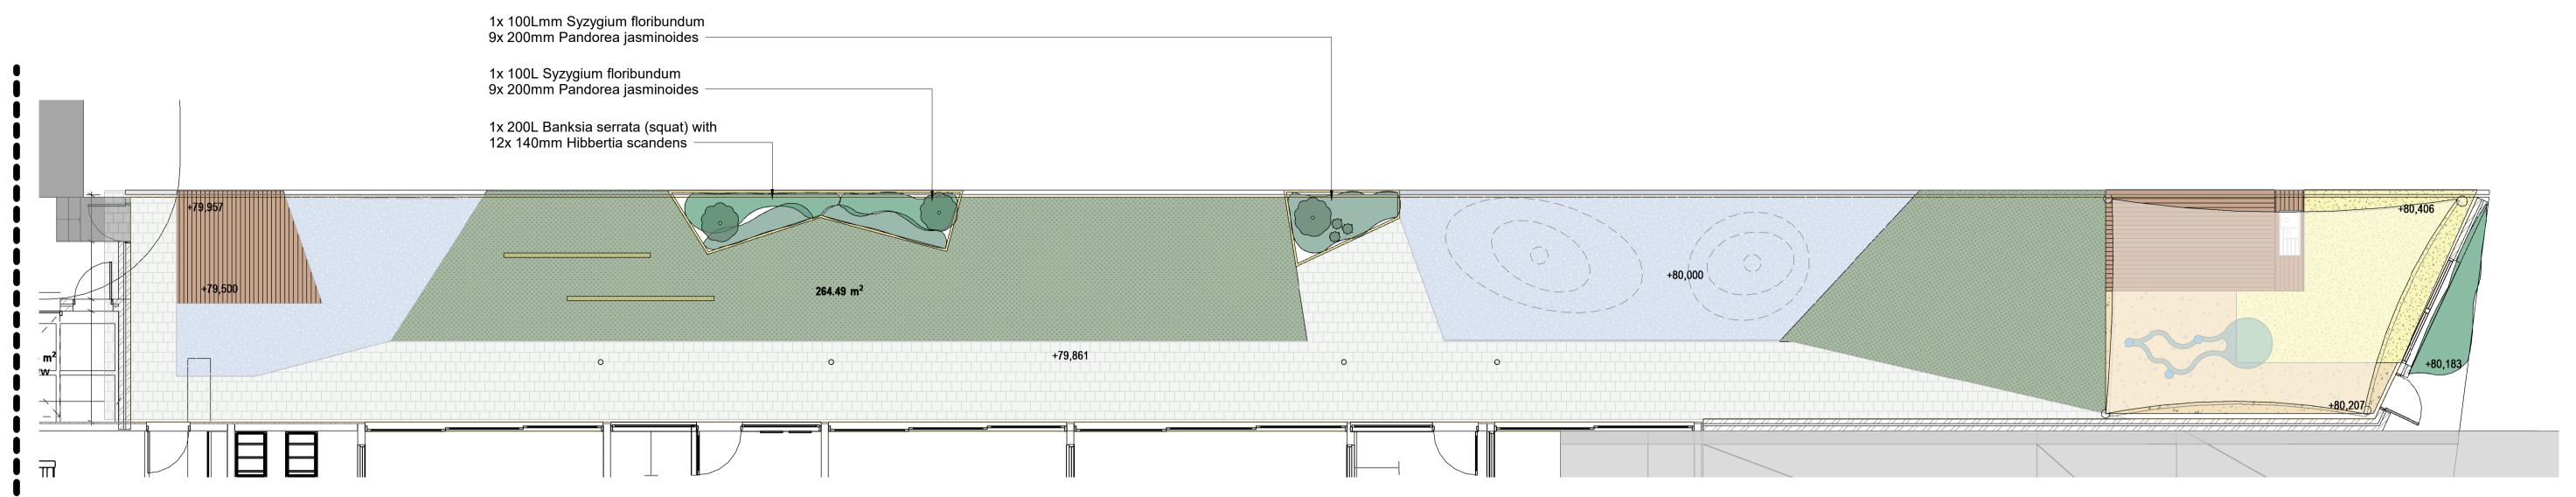

JOINS LANDSCAPING DRAWING NUMBER - LA2410 - 08

PLANTING SCHEDULE

BOTANICAL NAME	COMMON NAME	MATURE HEIGHT	QTY	SIZE	STAKE
Banksia serrata (squat)	Old Man Banksia	16m	5	200L	Yes
Blechnum 'Silver Lady'	Fishbone Waterfern	1.2m	5	200mm	No
Doryanthes excelsa	Gymea Lily	1-3m	12	200mm	No
Hibbertia scandens	Guinea Flower	Climber	178	200mm	No
Lomandra 'Katrinus'	Mat Rush	.7m	0	300mm	No
Pandorea jasminoides (light pink)	Bower Vine	Climber	193	200mm	No
Olea europaea	European Olive	8-15m	1	500L	Yes
Rosmarinus officinalis Prostratus	Creeping Rosemary	.5m	12	200mm	No
Syzygium floribundum	Weeping Lilly Pilly	10-30m	41	100-200L	Yes
Tristaniopsis laurina	Water Gum	4.6–9.1m	9	200-450L	Yes
Pennisetum alopecuroides	Chinese Fountain Grass	.7m	36	200-300mm	No
Aloe striata	Coral aloe	.9m	9	300mm	No
Rhapis excelsa	Broadleaf lady palm	3-5m	12	300-400mm	Yes
Lophostemon confertus	Brush Box	10-15m	2	450L	Yes
-Blechnum	Silver Lady ~	1.2my -	~~~~~~~~~~~~~~~~~~~~~~~~~~~~~~~~~~~~~~	200pm	~~Nov~~
Pandorea pandorana	Golden Showers	Climber	32	200mm	No
	-	Pôtal \ ~ \	~ \ 552~ \	_~_~/	~~~~
		Total Native	525		

GENERAL NOTES

Plant graphics are indicative sizes only. Do not scale from drawings. All dimensions in mm unless otherwise stated. Figure dimensions shall take precedence

Contractors must verify all dimensions before commencing work.

Work Compliance

All works shall be carried out in accordance with the NCC, relevant Australian Standards and Local Government Regulations.

All existing plants marked for retention shall be protected for the duration of works. Remove from site all perennial weeds and rubbish before commencing landscape works.

Soil Cultivation and Placement

Thoroughly cultivate all subsoil to a minimum depth of 200mm prior to planting. Supply and install quality garden soil mix to all planting beds to a minimum depth of 300mm prior to planting.

Mulching

Supply and install a 75mm layer of hardwood horticultural grade mulch to all planting beds set down 25mm from adjacent paving or garden edge.

Maintenance

Failed and/or defective plants to be replaced by landscaper for a 3-month period following completion of work. Further maintenance during and after this period should include watering, weeding, fertilising, pest and disease control, pruning and hedging, reinstatement of mulch and keeping the site neat and

GENERAL PLANTING NOTES

The Contractor will be responsible for maintenance during a three-month period maintenance following planting. This includes watering, mowing, weeding, fertilising, pest and disease control, reseeding, staking and tying, replanting, cultivating, pruning, aerating and top dressing.

The Contractor should only select plants that are vigorous, well established, of good form and consistent with species or variety, not soft or forced, free from disease and insect pests, with large healthy root systems and no evidence of having been restricted in growth or damaged.

The Contractor should install 'root barriers' or equivalent to manufacturers specifications to protect nearby structures and services.

Note Install temporary drip irrigation system under mulch in tree protection zones and water on allotted days.



JECKRA PTY LTD UNIT 6, 58 HARBOUR STREET MOSMAN NSW 2088

Total Native %

PROJECT COBBITTY CHILDCARE	DRAWING PLANTING PLAN NORTH	DATE 18.03.25
PROJECT ADDRESS 1 FRESHWATER DRIVE COBBITTY NSW 2570	DRAWING NUMBER LA2410 - 09 - REV02	SCALE @ A1 1:75



SOFT FALL RUBBER - BLUE



COOL PLUS YARN SYNTHETIC TURF WITH SOFT FALL UNDERLAY





FEATURE COLOURED CONCRETE



SANDPIT SAND



TIMBER DECKING



FEATURE CONCRETE PAVER




FEATURE BRICK PAVER



SANDSTONE LOG




GARDEN EDGING

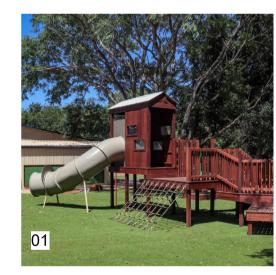








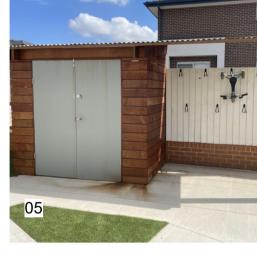




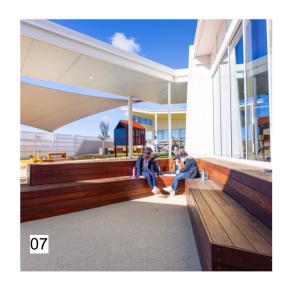





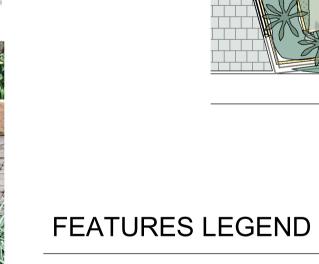





- 01. CLIMBING FORT WITH SLIPPERY SLIDE AND CLIMBING NET
- 02. WHICKING PLANTER BEDS WITH VEGGIE GARDEN
- 03. BIKE TRACK WITH PAINTED LINE MARKING
- 04. SENSORY PAVING INFILLS 05. TRIKE PARKING BAY
- 06. YARNING CIRCLE 07. AUDITORIUM FOR DRAMA PRESENTATIONS
- 08. MUD KITCHEN FOR SAND PLAY
- 09. SENSORY PLANTING
- 10. DIVIDING POOL FENCE WITH GATE

THE OUTDOOR PLAY AREAS OF THIS DEVELOPMENT HAVE BEEN DESIGNED TO COMPLY WITH PART 1 - GENERAL REQUIREMENTS AND PART 2 - DESIGN CONSTRUCTION - SAFETY ASPECTS; AS/NZS 4422 - PLAYGROUND SURFACING - SPECIFICATIONS, REQUIREMENTS AND TEST METHODS; AND AS/NZS 472 - PLAYGROUNDS AND PLAYGROUND EQUIPMENT

03

NUMBER

DRAWING

ANDSCAPING


NOC



JECKRA PTY LTD UNIT 6, 58 HARBOUR STREET MOSMAN NSW 2088

PROJECT COBBITTY CHILDCARE	DRAWING CENTRAL YARD	DATE 18.03.25
PROJECT ADDRESS 1 FRESHWATER DRIVE COBBITTY NSW 2570	DRAWING NUMBER LA2410 - 02 - REV02	SCALE @ A1 1:75

MATERIALS LEGEND

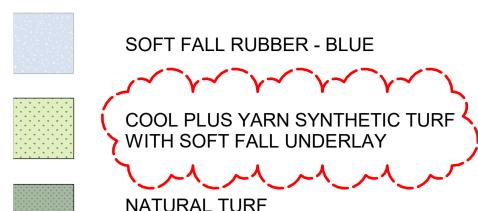

NATURAL TURF

FEATURE COLOURED CONCRETE

SANDPIT SAND


TIMBER DECKING


FEATURE CONCRETE PAVER


FEATURE BRICK PAVER

SANDSTONE LOG


GARDEN EDGING

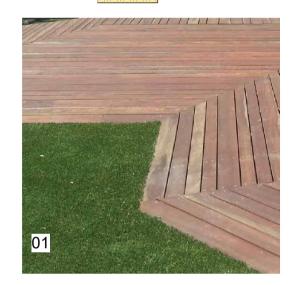

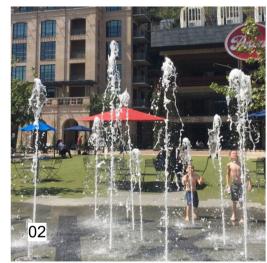

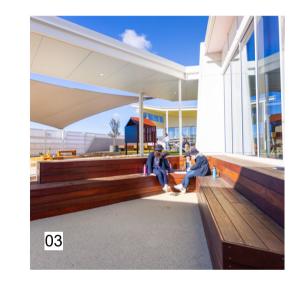



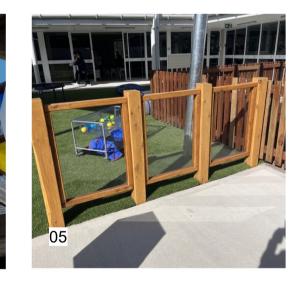








02

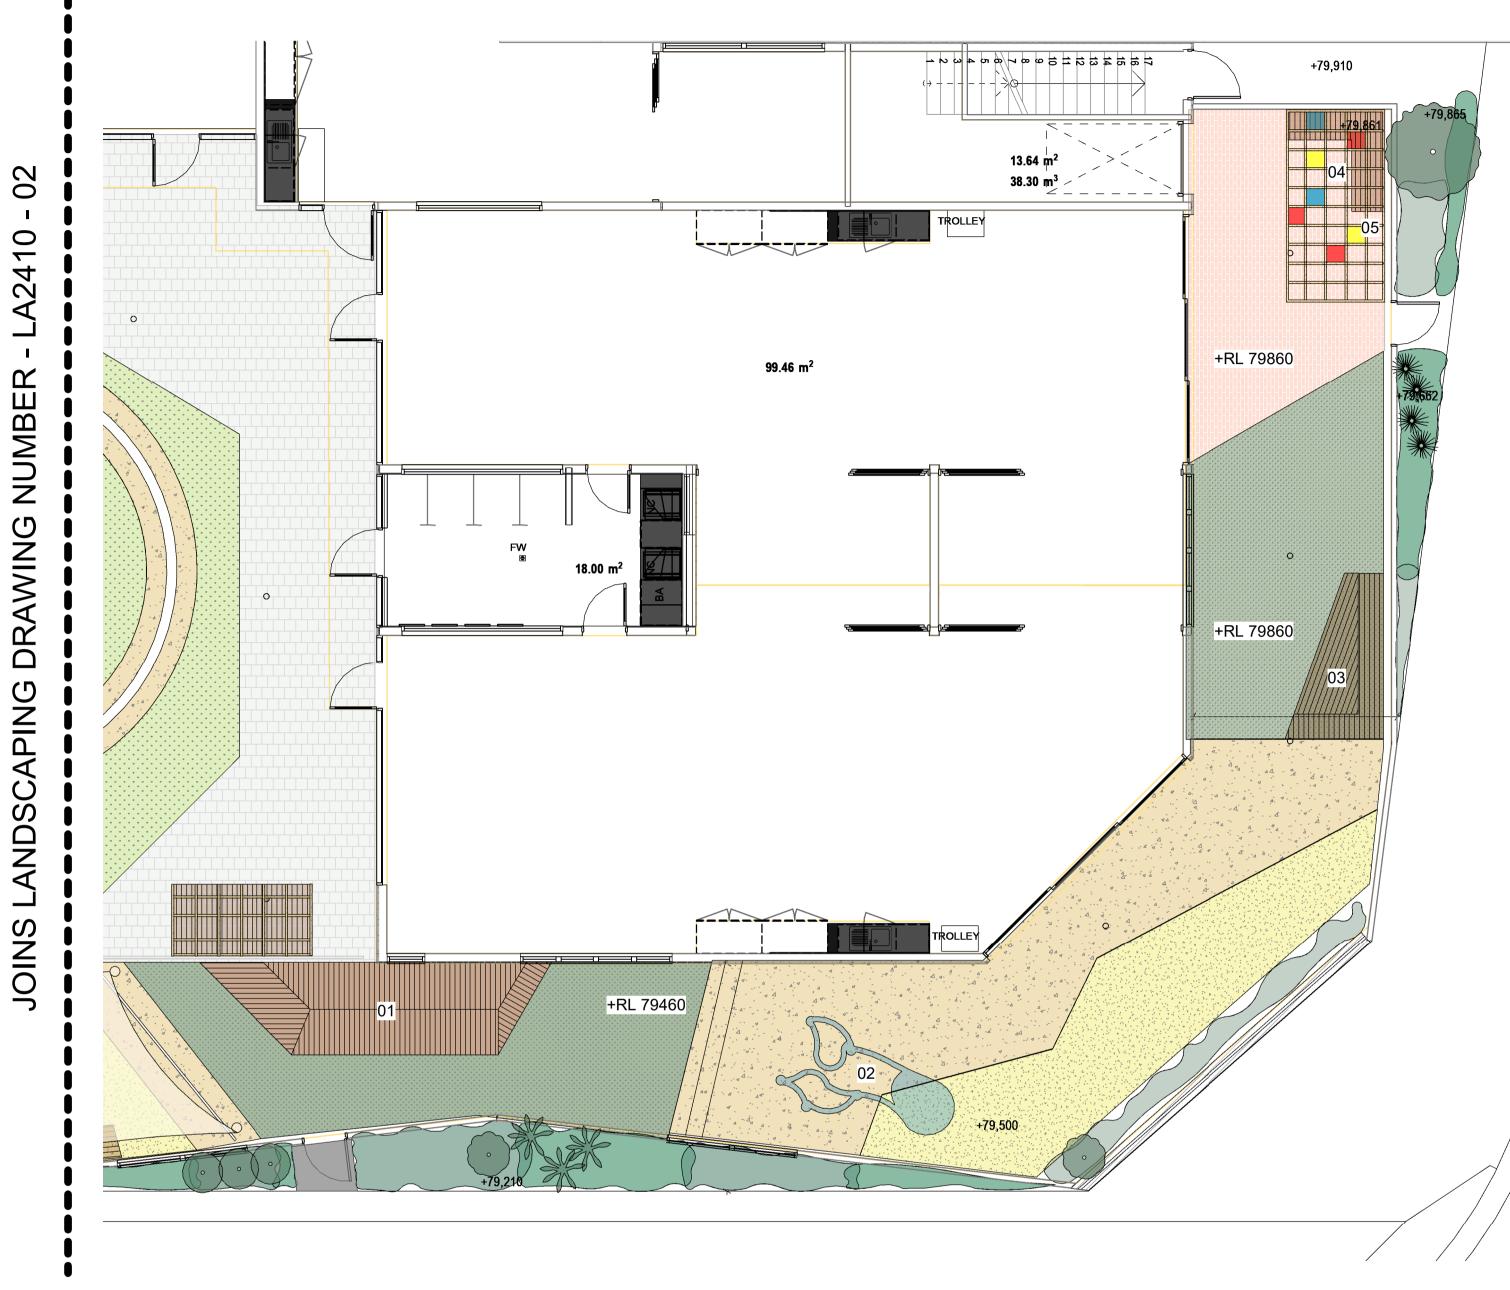

FEATURES LEGEND

01. SLOPED DECKED PLATFORMS 02. WATER PLAY

03. DECKED AMPITHEATRE
04. PERGOLA OVER WITH PERSPEX INFILLS

05. ART EASEL WALL 06. MUD KITCHEN


07. SENSORY PLANTING

THE OUTDOOR PLAY AREAS OF THIS DEVELOPMENT HAVE BEEN DESIGNED TO COMPLY WITH PART 1 - GENERAL REQUIREMENTS AND PART 2 - DESIGN CONSTRUCTION - SAFETY ASPECTS; AS/NZS 4422 - PLAYGROUND SURFACING - SPECIFICATIONS, REQUIREMENTS AND TEST METHODS; AND AS/NZS 472 - PLAYGROUNDS AND PLAYGROUND EQUIPMENT





JECKRA PTY LTD UNIT 6, 58 HARBOUR STREET MOSMAN NSW 2088

PROJECT COBBITTY CHILDCARE	DRAWING KINDER YARD	DATE 18.03.25
PROJECT ADDRESS 1 FRESHWATER DRIVE COBBITTY NSW 2570	DRAWING NUMBER LA2410 - 03 - REV02	SCALE @ A1 1:75

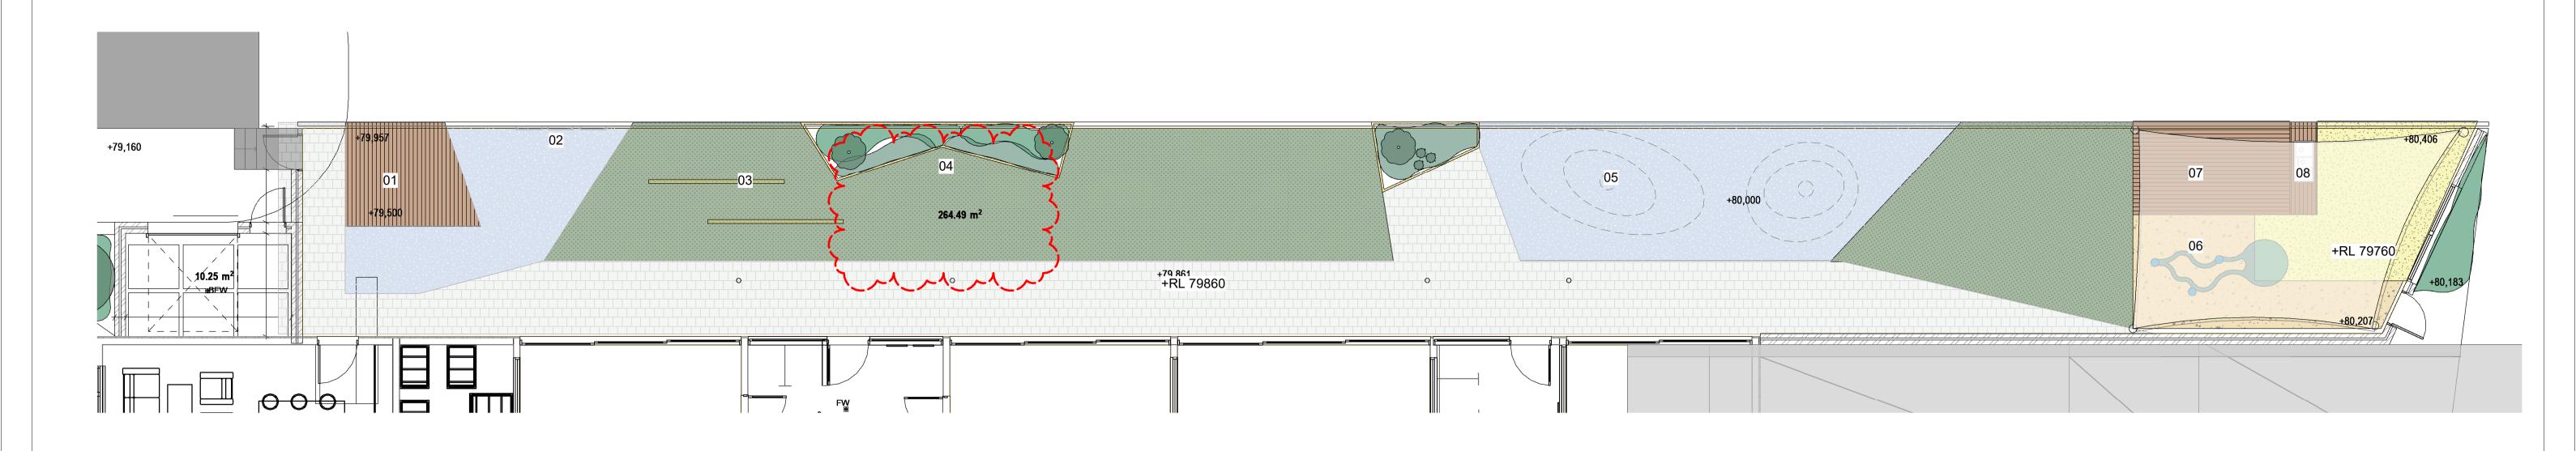

MATERIALS LEGEND

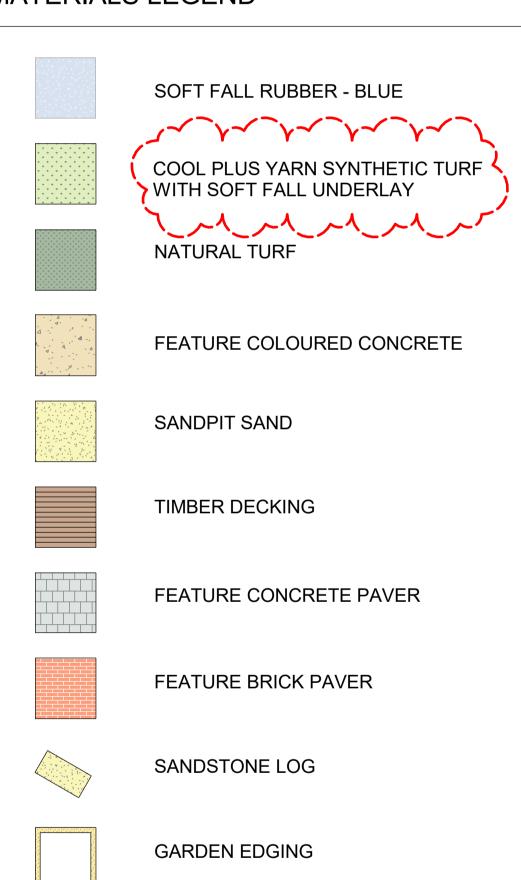

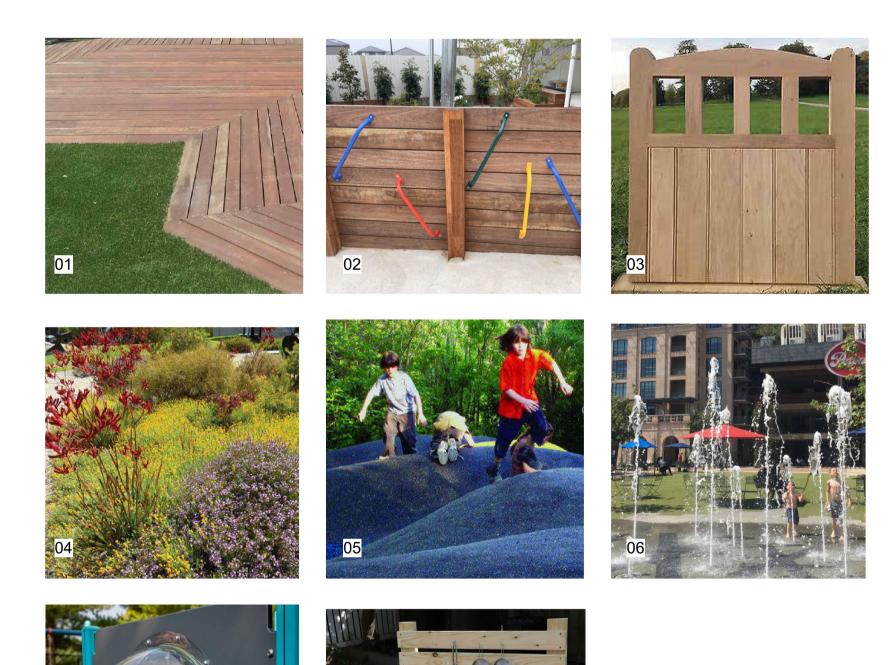

FEATURES LEGEND


- 01. SLOPED DECKED PLATFORMS
- 02. HANDLES FIXED TO WALL FOR BALANCE PRACTICE
- 03. SMALL TIMBER FENCES FOR BALANCE PRECTICE
 04. SENSORY PLANTING
 05. SMALL RUBBER MOUNDS
- 06. WATER PLAY
- 07. SMALL PLATFORM WITH BUBBLE PANEL
- 08. MUD KITCHEN

THE OUTDOOR PLAY AREAS OF THIS DEVELOPMENT HAVE BEEN DESIGNED TO COMPLY WITH PART 1 - GENERAL REQUIREMENTS AND PART 2 - DESIGN CONSTRUCTION - SAFETY ASPECTS; AS/NZS 4422 - PLAYGROUND SURFACING - SPECIFICATIONS, REQUIREMENTS AND TEST METHODS; AND AS/NZS 472 - PLAYGROUNDS AND PLAYGROUND EQUIPMENT




JECKRA PTY LTD UNIT 6, 58 HARBOUR STREET MOSMAN NSW 2088


PROJECT COBBITTY CHILDCARE	DRAWING NURSERY YARD	DATE 18.03.25
PROJECT ADDRESS 1 FRESHWATER DRIVE COBBITTY NSW 2570	DRAWING NUMBER LA2410 - 04 - REV02	SCALE @ A1 1:75

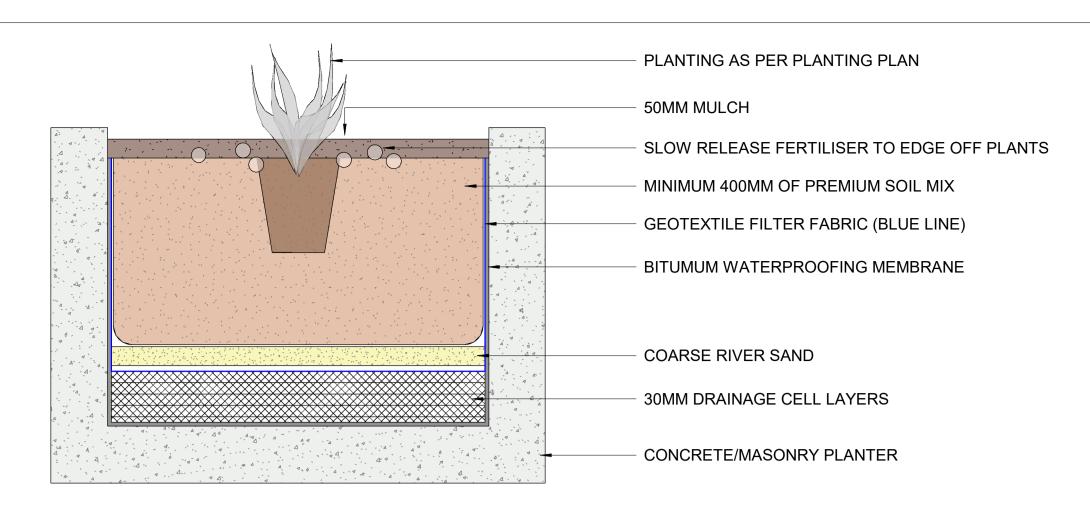


PLANTER DETAIL

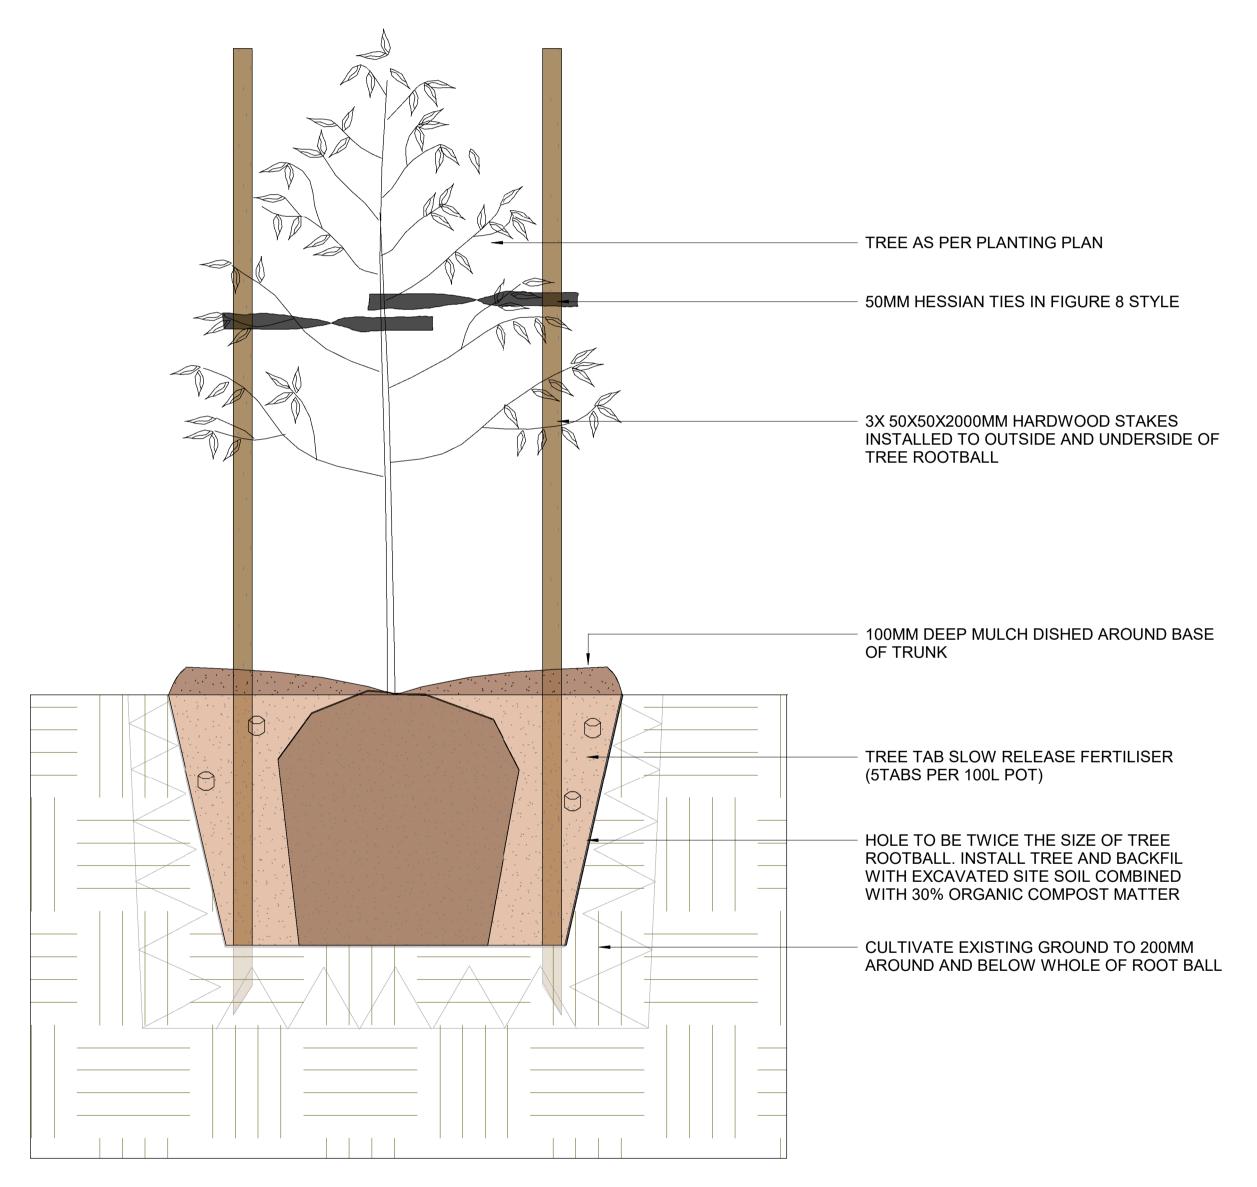

STAKED TREE IN GROUND DETAIL

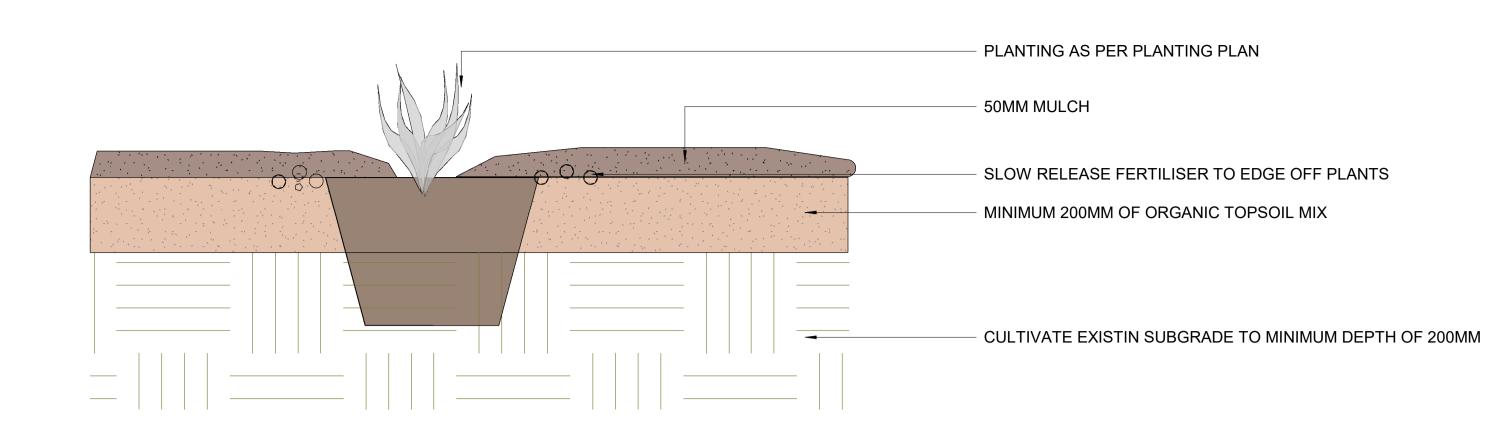

SHRUB IN GROUND DETAIL

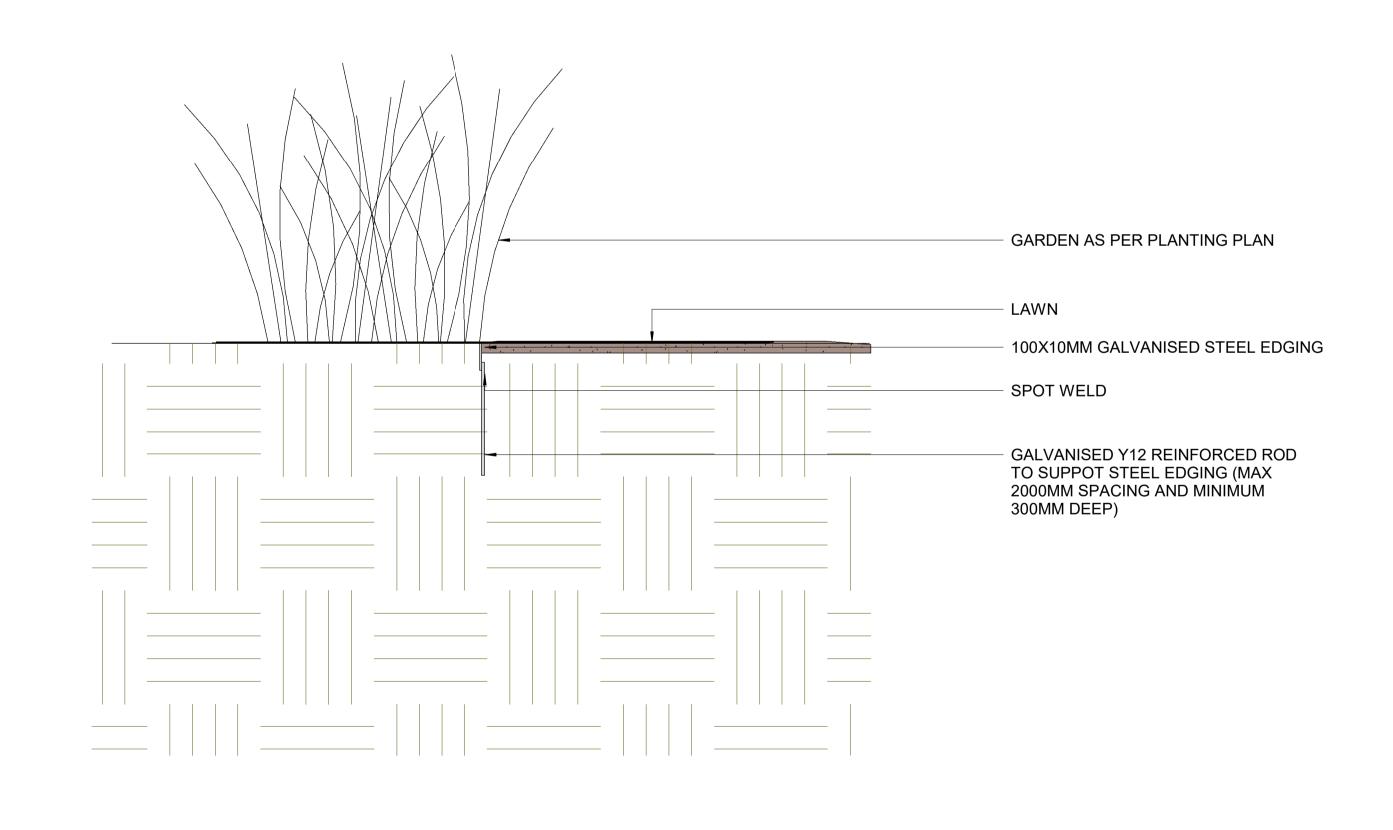


STEEL EDGING DETAIL



JECKRA PTY LTD UNIT 6, 58 HARBOUR STREET MOSMAN NSW 2088

PROJECT	DRAWING	DATE
COBBITTY CHILDCARE	PLANTING DETAILS	18.03.25
PROJECT ADDRESS	DRAWING NUMBER	SCALE @ A1
1 FRESHWATER DRIVE COBBITTY NSW 2570	LA2410 - 10 - REV01	1:10

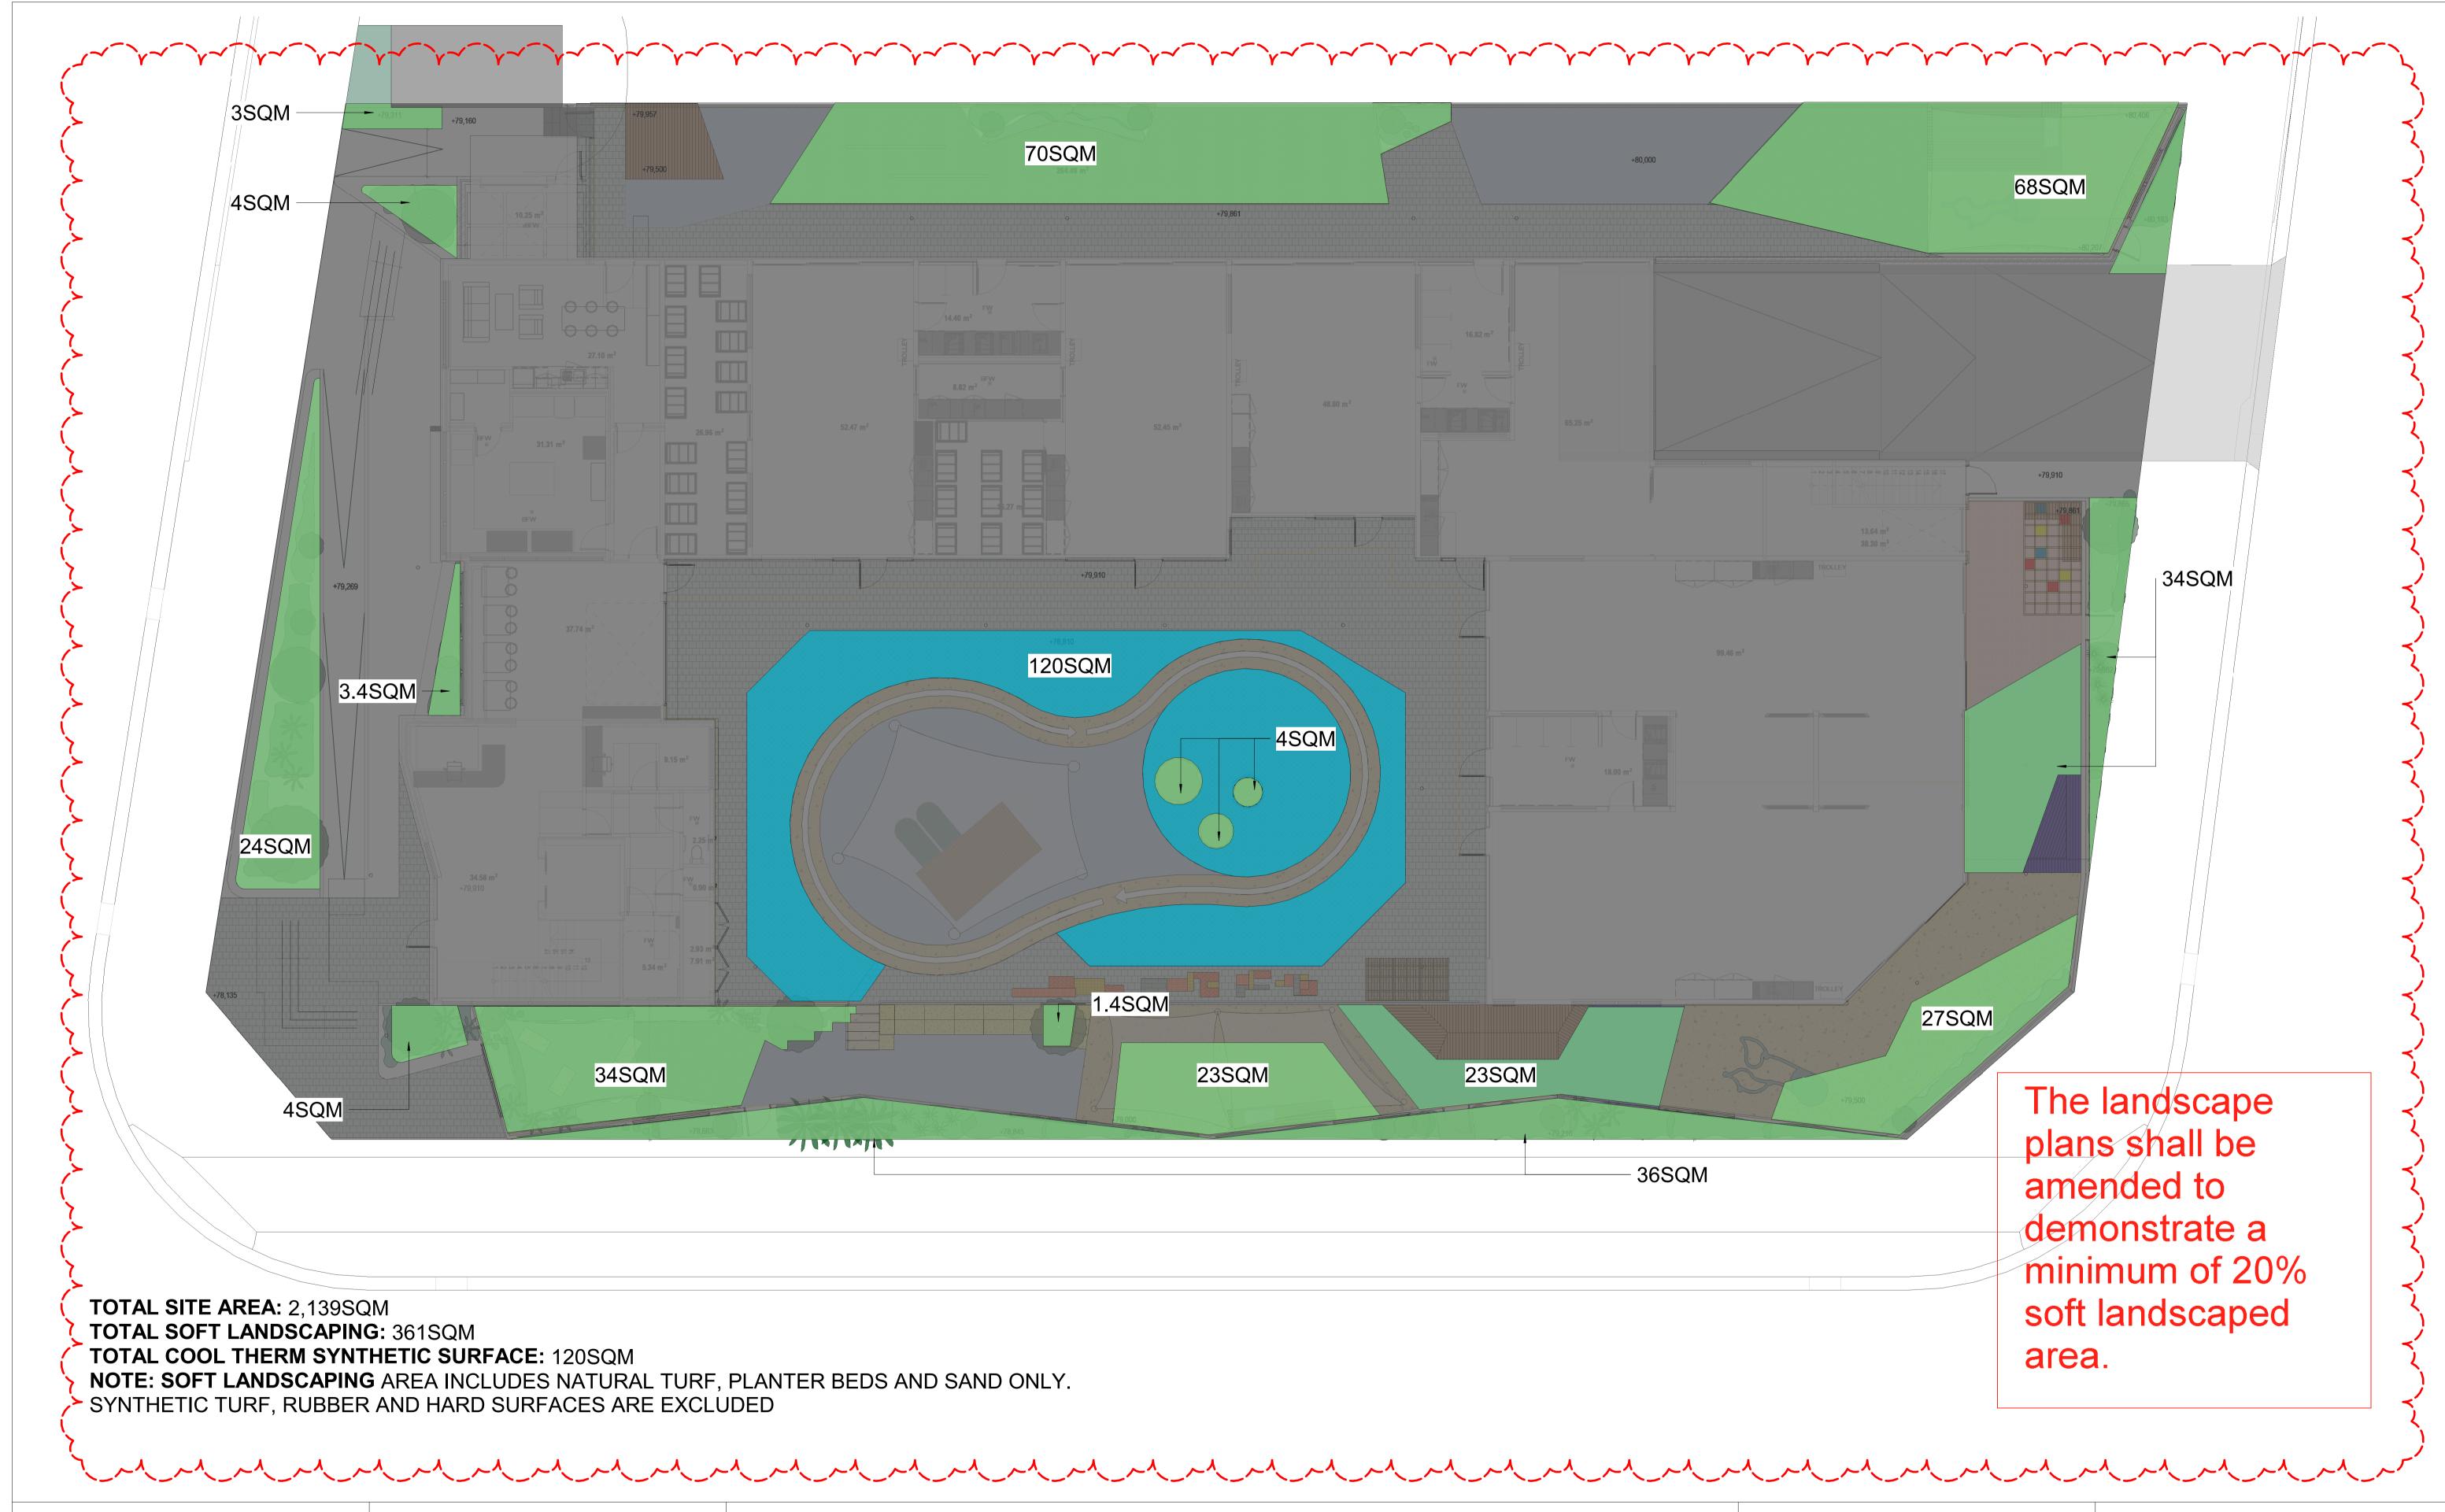




JECKRA PTY LTD UNIT 6, 58 HARBOUR STREET MOSMAN NSW 2088

PROJECT	DRAWING	DATE
COBBITTY CHILDCARE	SOFT LANDSCAPING PLAN	18.03.25
PROJECT ADDRESS	DRAWING NUMBER	SCALE @ A1
1 FRESHWATER DRIVE COBBITTY NSW 2570	LA2410 - 12 - REVO	1:100

Brand palette

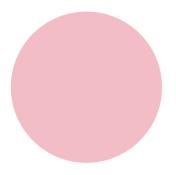


Futuro Pink

PMS 495 C C2 M31 Y10 K0 Dulux Feather Boa S02G1




Futuro Coral

PMS 163 C C0 M47 Y59 K0 Dulux Hibiscus Delight S07H5

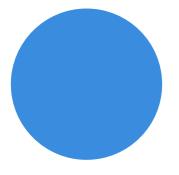


Futuro Blue

PMS 279 C C72 M37 Y0 K0 Dulux Window Blue SB8E3

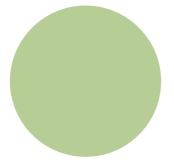


Futuro Green

PMS 578 C C31 M7 Y51 K0 Dulux Sour Apple S20F4

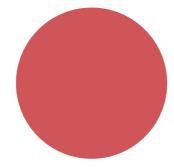


Futuro Red

PMS 7418 C C14 M81 Y61 K1

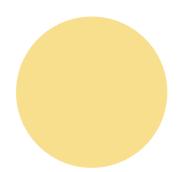


Futuro Yellow

PMS 1205 C C3 M10 Y53 K0 Dulux Oxford Terrace NZ10E6 Dulux Swedish Yellow S16H4

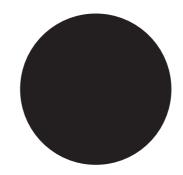


Black

PMS Black U C20 M20 Y20 K100 Dulux Black

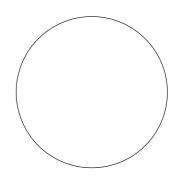


White

PMS White C0 M0 Y0 K0 Dulux Vivid White

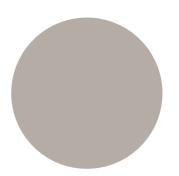

BOH Warm grey


PMS Warm Grey 4C C31 M28 Y32 KO Dulux Ancient Ruin

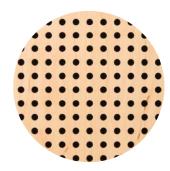

Hoop pine & Perforated Veneer colour


Timber colour spectrum

Statutory & Operational palette

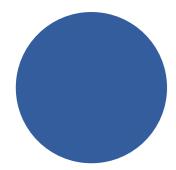

Access Blue

PMS 7684C C87 M68 Y9 K1

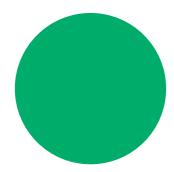


Exit Green

PMS 3405C C100 M0 Y83 K0 Dulux G12 Holly1



Hazard Yellow

PMS 122U C0 M29 Y100 K0 Dulux PMS123U

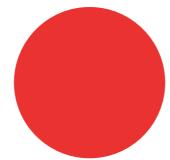

Fire Red **Danger Red**

PMS 485C C0 M95 Y100 K0 Dulux Red Clown P05H8





Written dimensions take precedence over scaled dimensions. Contractors shall verify all critical dimensions on site prior to commencement of work. Reproduction of the whole or part of this document constitutes an infringement of copyright. This information ideas and concepts contained in this document are confidential. The recipient(s) of this document is prohibited from disclosing such information, ideas and concepts to any person without prior written consent of Studio MAAT.

Studio MAAT studiomaat.com.au

Joanna Mackenzie 0421 669 671 ioanna@studiomaat.com.au Bridget Atkinson 0423 170 481 bridget@studiomaat.com.au As shown at A3

Issue Issue for DA

Revisions A 23.10.24 Issue for DA B 23.01.25 Issue for DA

NOT FOR CONSTRUCTION

Project no. JEK2411

Drawing

Palette

Futuro

Date 21.10.24

Project

Cobbitty

Signtype

Drawn/Checked Drawing number JEK2411-GEN-003 BA/JM






02 ReferencePin-fixed, halo-lit letters



03 3D Road 40A

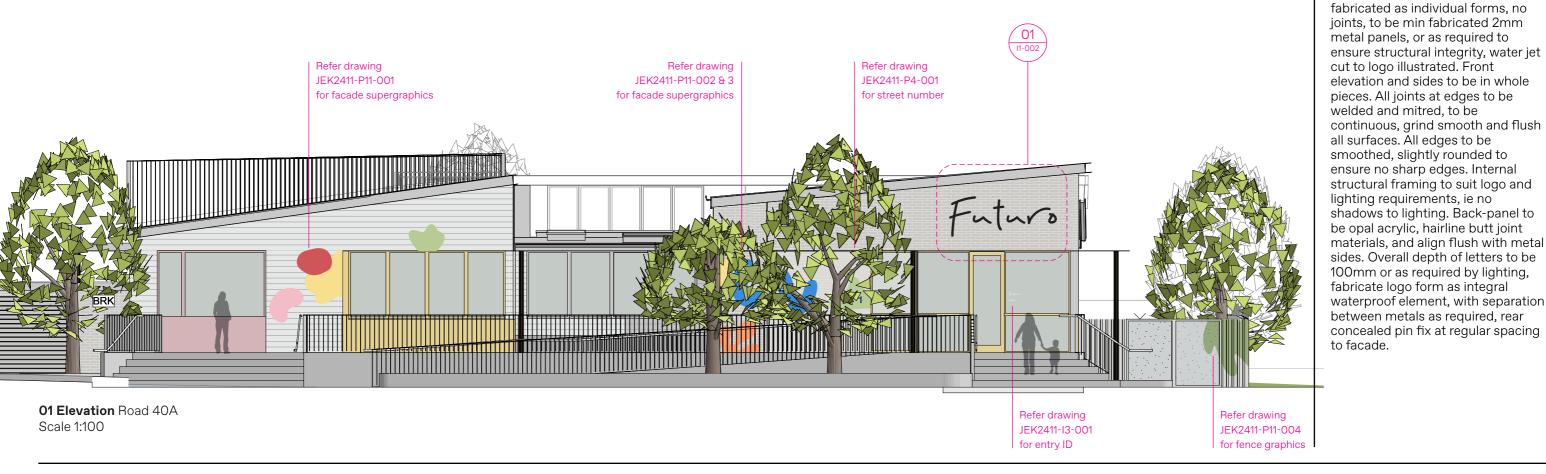

M >

▼ T

Written dimensions take precedence over scaled dimensions. Contractors shall verify all critical dimensions on site prior to commencement of work. Reproduction of the whole or part of this document constitutes an infringement of copyright. This information ideas and concepts contained in this document are confidential. The recipient(s) of this document is prohibited from disclosing such information, ideas and concepts to any person without prior written consent of Studio MAAT.

Studio MAAT studiomaat.com.au

Joanna Mackenzie 0421 669 671 joanna@studiomaat.com.au Bridget Atkinson 0423 170 481 bridget@studiomaat.com.au As shown at A3

Issue Issue for DA Revisions
A 23.10.24 Issue for DA
B 23.01.25 Issue for DA

NOT FOR CONSTRUCTION

Project no. JEK2411

Drawing

Primary

Building ID

Date **21.10.24**

Project

Futuro

Cobbitty

BA/JM
Signtype

Drawn/Checked Drawi BA/JM JEI

Drawing number
JEK2411-I1-001

Revision **B**

NOTES GENERAL

conditions.
MATERIALITY

match.

FABRICATION

The sign is located on the building facade visible to vehicular & pedestrian traffic, illustrating the destination name for day and night-time viewing. The sign/logo is located in an external environment, as such all materials, fabrication and fixing to suit expected

'Futuro' to be fabricated metal internal framing pinned off wall, clad by painted fabricated letters,

soft even glow onto the facade. All

metal elements to be painted to

Shopdrawings are to be prepared by an approved Chartered

Professional Engineer specialising in Structural Engineering, on the


drawings/calculations, will be borne

Signage Contractors behalf.

The cost of these structural

by the signage contractor.
'Futuro' letter elements to be

with recessed/concealed continuous LED halo lighting, & opal acrylic back-panel, to provide a

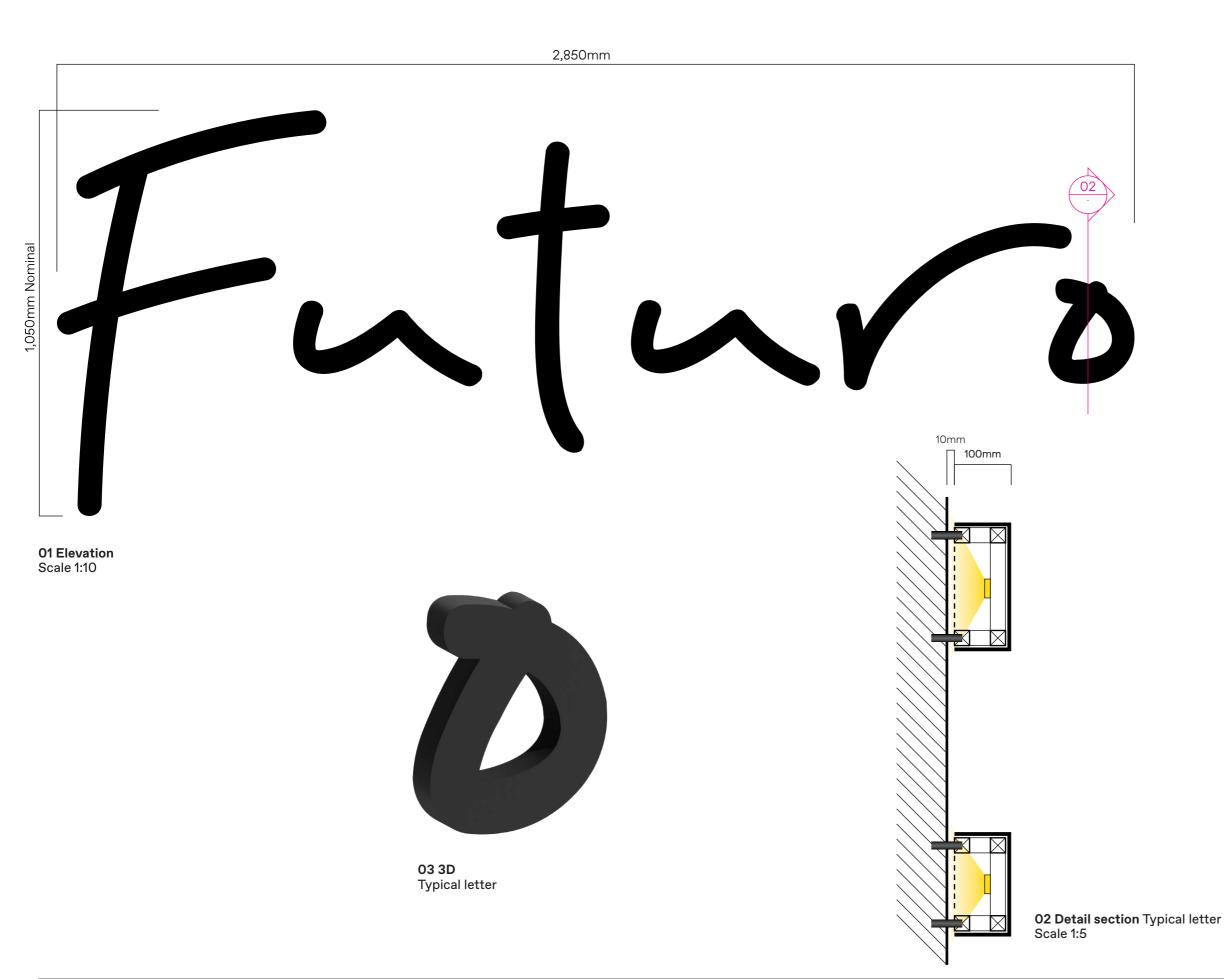

NOTES (cont.)

All individual fabricated letters should be fabricated in one piece. Radius all edges 3mm. Setout via pre-spaced and electronically cut vinyl film. Ensure all corners/edges are sharp and true to the artwork. Ensure cut edges are not overheated and are cut slowly to achieve a clean cut.

FIXING

'Futuro' to be fixed via painted metal pins fixed to facade and internal frame spaced off to create halo lighting. Conduit concealed within individual pin fixings and logo and via painted individual conduits through facade penetration. Distance off facade as required for halo lighting with good spread of light onto surface. Logo width as indicated, to be developed in shopdrawing phase.

FINISHES/COLOUR To be DULUX 2-pak paint external grade paint system. Colour: Black

For colour specification refer Graphic standards

Anti-graffiti satin finish 25% gloss level to all exposed surfaces

ILLUMINATION

Bright warm white LED units located within logo form, to create rear halo lighting through white acrylic backing. Light output to be even across logo form, no hot spots to create an even glow around form. To have dimmer control to adjust light output and be linked to building operating systems to allow timer control/switch off.

All power/control systems to be run through rear. LED transformers etc to be housed internally in an accessible space. To be determined during shopdrawing phase with client.

LOCATING PRINCIPLES As noted on elevation and setout notes.

GRAPHICS

Fabricated metal & acrylic logo, true to supplied artwork, halo lit, with painted non-illuminated acrylic letters.

CONTENT As noted.

 $M \rightarrow$

dimensions. Contractors shall verify all critical dimensions on site prior to commencement of work. Reproduction ▼ T of the whole or part of this document constitutes an infringement of copyright. This information ideas and concepts contained in this document are confidential. The recipient(s) of this document is prohibited from disclosing such information, ideas and concepts to any

Written dimensions take precedence over scaled

person without prior written consent of Studio MAAT.

Studio MAAT studiomaat com au

Joanna Mackenzie 0421 669 671 joanna@studiomaat.com.au Bridget Atkinson 0423 170 481 bridget@studiomaat.com.au As shown at A3

Issue Issue for DA

Revisions A 23.10.24 Issue for DA B 23.01.25 Issue for DA

NOT FOR CONSTRUCTION

Project no. JEK2411

Primary

Building ID

Date 21.10.24 Drawing

Project Futuro Cobbitty Drawn/Checked BA/JM

Signtype


1.1

Drawing number JEK2411-I1-002



03 Reference Pin-fixed, halo-lit letters


Illumination of the proposed signage is not permitted and must be removed from the signage plans.

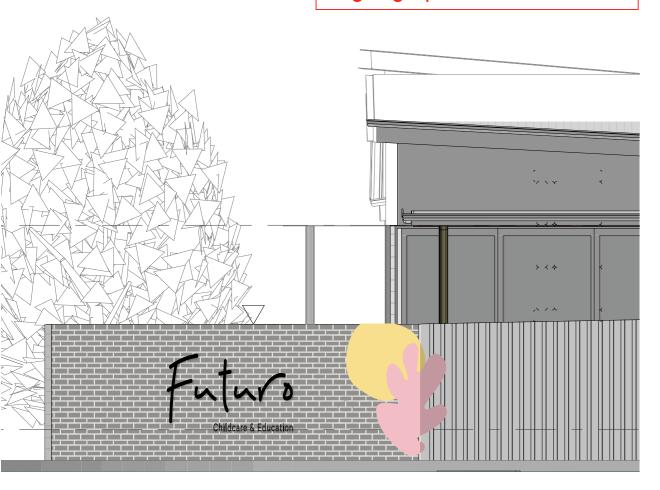

01 Part elevation Road 24 Scale 1:50



Corner Charles MacIntosh Parkway & Road 24

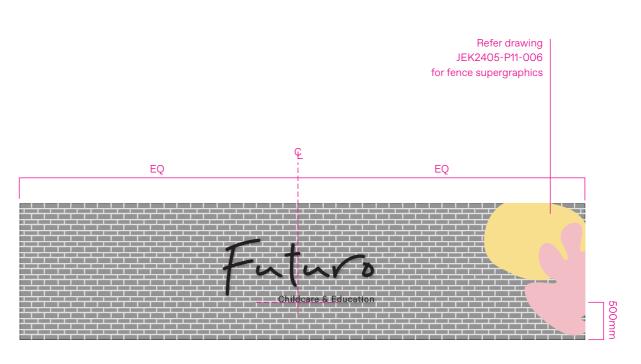

02 Detail elevation Chamfered fence section Corner Road 24 & Charles MacIntosh Parkway Scale 1:50

NOTES

GENERAL

The sign is located at low level on a masonry wall, illustrating the destination name for day and night-time viewing. The sign/logo is located in an external public environment accessible to the public from the adjacent ground level, as such all materials, fabrication and fixing to suit expected conditions.

MATERIALITY

'Futuro' to be fabricated metal painted letters with internal framing pinned off facade, with recessed/concealed continuous LED halo lighting, & 20mm white acrylic back-panel, to provide a soft even glow onto the facade. All metal elements to be painted to match

'Childcare & Education' to be 4mm painted solid acrylic sheet laser cut letters conceal pin & adhesive fix to the masonry wall.

FABRICATION

Shopdrawings are to be prepared by an approved Chartered Professional Engineer specialising in Structural Engineering, on the Signage Contractors behalf.

The cost of these structural drawings/calculations, will be borne by the signage contractor.

'Futuro' letter elements to be fabricated as individual forms, no joints, to be min fabricated 2mm metal panels, or as required to ensure structural integrity, water jet cut to logo illustrated. Front elevation and sides to be in whole pieces. All joints at edges to be welded and mitred, to be continuous, grind smooth and flush all surfaces. All edges to be smoothed, slightly rounded to ensure no sharp edges. Internal structural framing to suit logo and lighting requirements, ie no shadows to lighting. Back-panel to be 20mm white acrylic, hairline butt joint materials, and align flush with metal sides. Overall depth of letters to be 40mm or as required by lighting, fabricate logo form as integral waterproof element, with separation between metals as required, rear concealed pin fix at regular spacing to

'Childcare & Education' text to be 4mm solid acrylic sheet laser cut letters.

All edges to be smoothed, slightly rounded to ensure no sharp edges.

▼ T

Written dimensions take precedence over scaled dimensions. Contractors shall verify all critical dimensions on site prior to commencement of work. Reproduction of the whole or part of this document constitutes an infringement of copyright. This information ideas and concepts contained in this document are confidential. The recipient(s) of this document is prohibited from disclosing such information, ideas and concepts to any person without prior written consent of Studio MAAT.

Studio MAAT studiomaat com au

Joanna Mackenzie 0421 669 671 ioanna@studiomaat.com.au Bridget Atkinson 0423 170 481 bridget@studiomaat.com.au As shown at A3

Issue for DA

Revisions

A 23.10.24 Issue for DA B 23.01.25 Issue for DA

NOT FOR CONSTRUCTION

Project no. JEK2411

Drawing

Fence

Secondary

Building ID

21.10.24

Project

Futuro

Cobbitty

Drawn/Checked BA/JM


Signtype


1.2.1

Drawing number **JEK2411-I21-001**






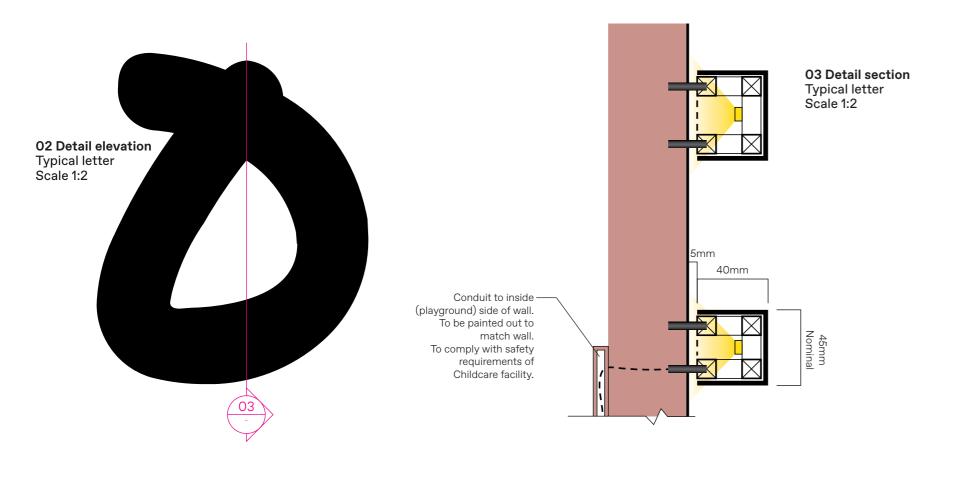

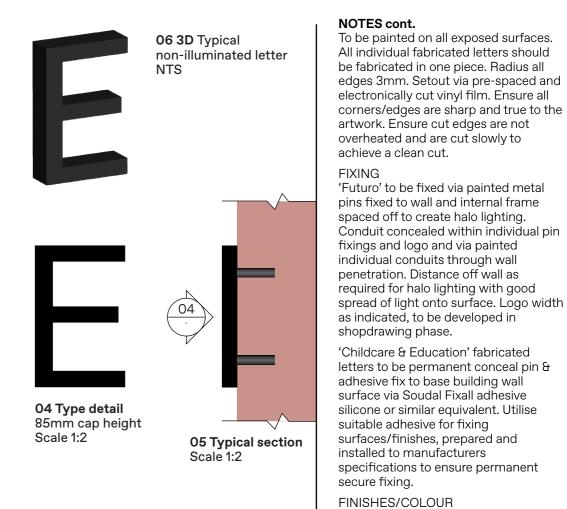



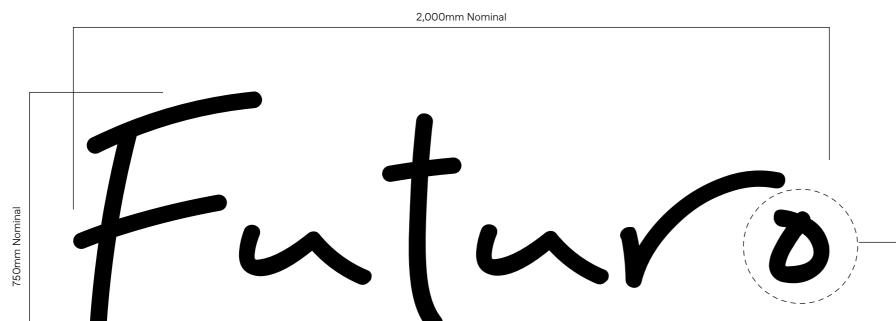

Childcare & Education

M >▼ T

Written dimensions take precedence over scaled dimensions. Contractors shall verify all critical dimensions on site prior to commencement of work. Reproduction of the whole or part of this document constitutes an infringement of copyright. This information ideas and concepts contained in this document are confidential. The recipient(s) of this document is prohibited from disclosing such information, ideas and concepts to any person without prior written consent of Studio MAAT.

01 Elevation

NTS

Studio MAAT studiomaat com au

Joanna Mackenzie 0421 669 671 ioanna@studiomaat.com.au Bridget Atkinson 0423 170 481 bridget@studiomaat.com.au Scale As shown at A3

Issue Issue for DA

Revisions

A 23.10.24 Issue for DA B 23.01.25 Issue for DA

NOT FOR CONSTRUCTION

Project no. JEK2411

> Drawing Secondary **Building ID** Typical detail

Date 21.10.24

Project Futuro Cobbitty Drawn/Checked BA/JM

Signtype

1.2.1

Drawing number **JEK2411-I21-002**

To be DULUX 2-pak paint external grade

Anti-graffiti satin finish 25% gloss level

Bright warm white LED units located within logo form, to create rear halo lighting through white acrylic backing. Light output to be even across logo form, no hot spots to create an even glow around form. To have dimmer control to adjust light output and be linked to building operating systems to

allow timer control/switch off.

All power/control systems to be run through rear. LED transformers etc to be housed internally in an adjacent accessible space. To be determined on

Similar to as noted on elevation. To be

confirmed onsite with client & architect.

Halo-lit fabricated metal & acrylic logo,

& painted non-illuminated acrylic letters.

paint system. Colour to be Black

ILLUMINATION


site with client.


GRAPHICS

LOCATING PRINCIPLES

to all exposed surfaces



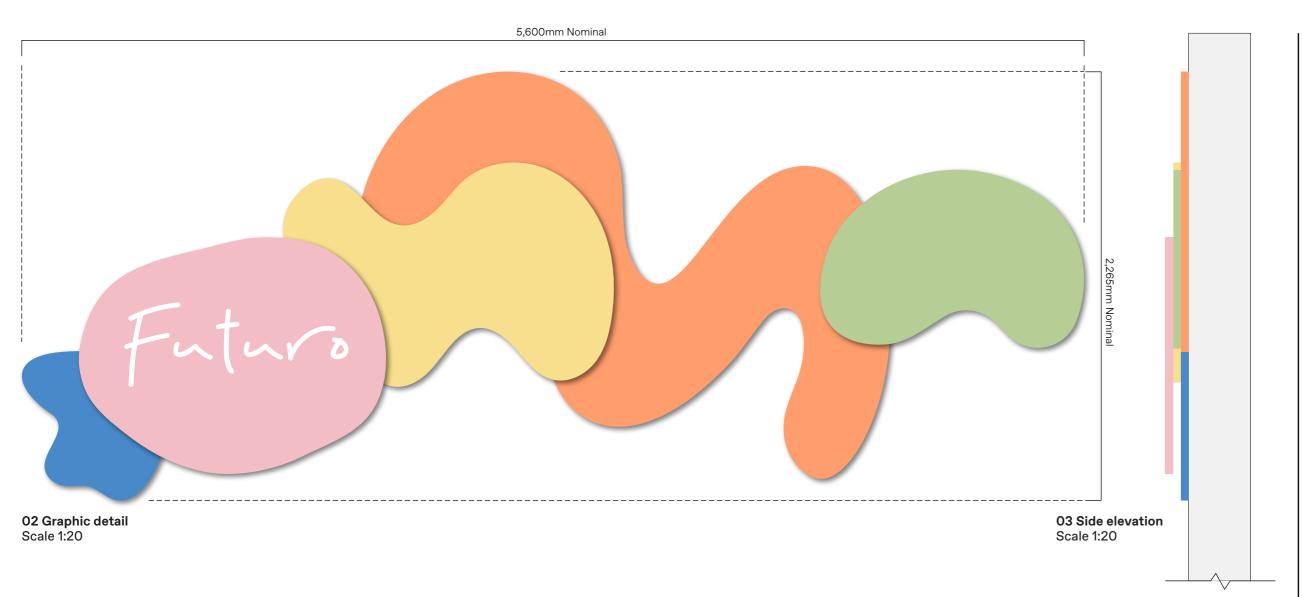

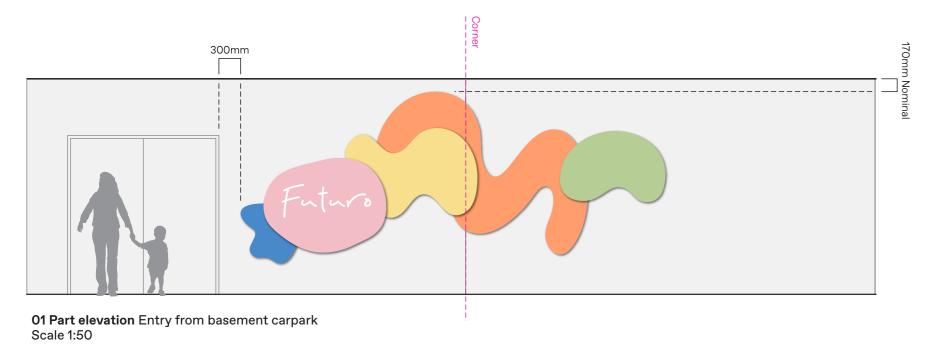

Notes

GENERAL

The signs/graphics are located in an external public environment exposed to wind & rain, as such all materials, fabrication and fixing to suit expected conditions.

MATERIALITY

2mm painted fabricated Aluminium or material thickness to ensure flat evan panel, over entire form. To be satin finish.

FABRICATION

Fabricated sign form. All edges to be smoothed slightly rounded to ensure no sharp edges. Minimum joints as required. All joints to be neatly welded, to be continuous, grind smooth and flush all surfaces. To be painted on all exposed surfaces.

FIXING

Signform to be permanent conceal fix to base building shiplap wall. Signform to be tight to outer edge of shiplap, provide standoff or pin fixing to ensure flat even fixing to cladding. Utilise suitable adhesive & mechanical fixings to suit surface, prepared and installed to manufacturers specifications. Ensure secure permanent fixing of panel to wall.

FINISHES/COLOUR As illustrated. For colour specification refer Graphic standards

To be two pack polyurethane, external grade paint system. Anti-graffiti satin finish 25% gloss level to all exposed surfaces.

LOCATING PRINCIPLES As noted on elevation and setout

Final setout to be reviewed and agreed on site with client.

▼ T

Written dimensions take precedence over scaled dimensions. Contractors shall verify all critical dimensions on site prior to commencement of work. Reproduction of the whole or part of this document constitutes an infringement of copyright. This information ideas and concepts contained in this document are confidential. The recipient(s) of this document is prohibited from disclosing such information, ideas and concepts to any person without prior written consent of Studio MAAT.

Studio MAAT studiomaat.com.au

Joanna Mackenzie 0421 669 671 ioanna@studiomaat.com.au Bridget Atkinson 0423 170 481 bridget@studiomaat.com.au As shown at A3

Issue Issue for DA

Revisions

A 23.01.25 Issue for DA

NOT FOR CONSTRUCTION

Project no. JEK2411

Drawing

Carpark internal

Secondary **Building ID** Date 21.10.24

Project

Futuro

Cobbitty

BA/JM Signtype

1.2.2

Drawing number **JEK2411-I22-001** Drawn/Checked

> Revision Α







Contact 1300 388 876

02 Detail Indicative messaging Scale 1:5

NOTES

GENERAL

The signs/graphics are located at the entry to the facility to confirm the name of destination at the primary entry to the facility; and to provide operational information to visitors, including contact details.

The signs/graphics s are located in a public environment, as such all materials, fabrication and fixing to suit expected conditions.

MATERIALITY

To be external grade cast vinyl solid colour film, Premium Cast Avery self-adhesive vinyl installed to manufacturers specifications. To be satin finish.

FABRICATION

Pre-spaced and electronically cut vinyl film. Sign content to be weeded out of vinyl. Ensure all corners/edges are sharp and true to the artwork.

Ensure cut edges are not overheated and are cut slowly to achieve a clean

FINISHES/COLOUR

To be White, Colour as illustrated

For colour specification refer Graphic standards

GRAPHICS

All lettering/forms shall be sharp and true to the selected typeface.

LOCATING PRINCIPLES

To be applied to outside face of glazing to ensure content is legible/read from outside.

As noted on elevation and setout

Final setout to be reviewed and agreed on site with client.

CONTENT

As documented

Written dimensions take precedence over scaled dimensions. Contractors shall verify all critical dimensions on site prior to commencement of work. Reproduction ▼ T of the whole or part of this document constitutes an infringement of copyright. This information ideas and concepts contained in this document are confidential. The recipient(s) of this document is prohibited from disclosing such information, ideas and concepts to any

person without prior written consent of Studio MAAT.

Studio MAAT studiomaat com au

Joanna Mackenzie 0421 669 671 joanna@studiomaat.com.au Bridget Atkinson 0423 170 481 bridget@studiomaat.com.au As shown at A3

Issue Issue for DA

Revisions

A 23.10.24 Issue for DA B 23.01.25 Issue for DA

NOT FOR CONSTRUCTION

Project no. JEK2411

Entry

Drawing

Project Facility ID, Futuro Cobbitty

Date

21.10.24

Drawn/Checked BA/JM

Signtype

1.3


I.3

0.3.1

Drawing number


JEK2411-I3-001



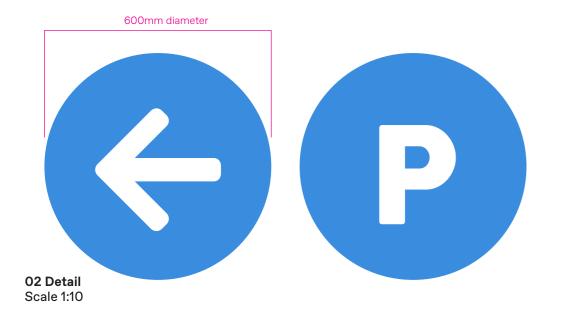



03 Montage Road 24

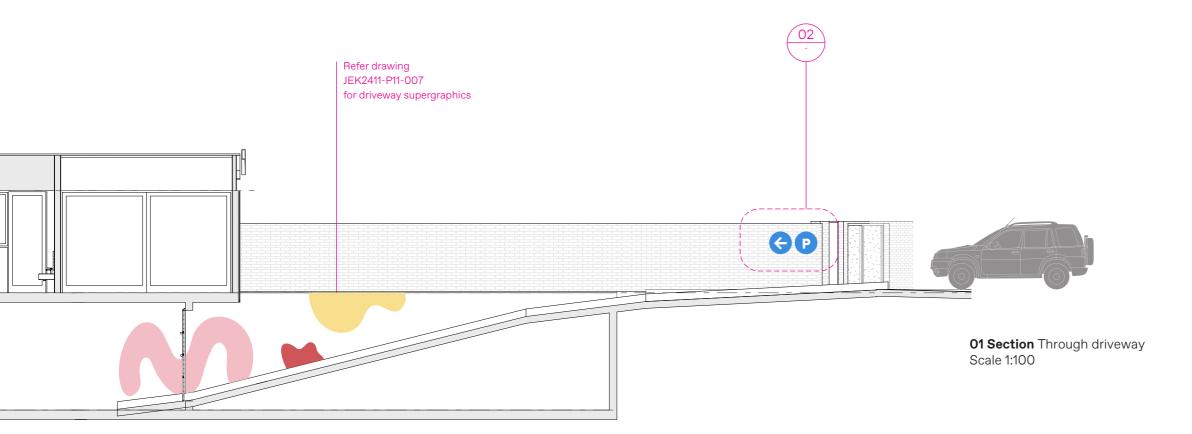

NOTES

GENERAL

The signs/graphics are located to provide directional information to arriving visitors, confirming the entry to the facilities carpark. The signs/graphics are located in an external public environment, as such all materials, fabrication and fixing to suit expected conditions.

MATERIALITY

Graphic to be by hand signwriting direct to masonsry driveway walls using external grade paint system.

FABRICATION

Prepare driveway walls, preparing and finishing to ensure permanent adhesion of graphics.

FINISHES/COLOUR To be DULUX 2-pak paint external grade paint system

Text and graphics to be as per artwork

For colour specification refer Graphic standards

Anti-graffiti satin finish 25% gloss level to all exposed surfaces

GRAPHICS

Signwriting by hand

LOCATING PRINCIPLES As illustrated on elevation, confirm final setout on site with client.

CONTENT

As documented

 $M \rightarrow$ ▼ T

Written dimensions take precedence over scaled dimensions. Contractors shall verify all critical dimensions on site prior to commencement of work. Reproduction of the whole or part of this document constitutes an infringement of copyright. This information ideas and concepts contained in this document are confidential. The recipient(s) of this document is prohibited from disclosing such information, ideas and concepts to any person without prior written consent of Studio MAAT.

Studio MAAT studiomaat.com.au

Joanna Mackenzie 0421 669 671 ioanna@studiomaat.com.au Bridget Atkinson 0423 170 481 bridget@studiomaat.com.au

Scale As shown at A3

Issue Issue for DA

Revisions

A 23.10.24 Issue for DA B 23.01.25 Issue for DA

NOT FOR CONSTRUCTION

Project no. JEK2411

Drawing

Vehicular

Directional

Date 21.10.24

Project

Futuro

Cobbitty

Drawn/Checked BA/JM


Signtype


0.5.2

Drawing number JEK2411-O52-001

В



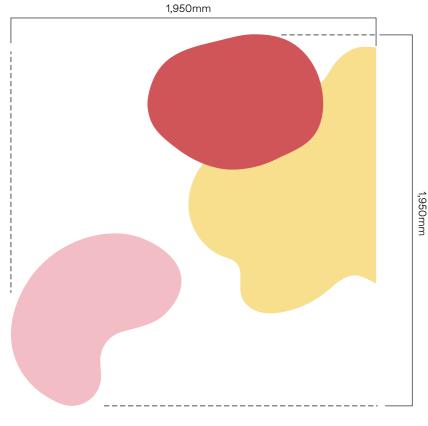

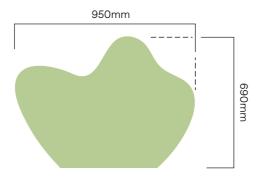

02 Graphic details Scale 1:20



01 Part elevation Road 40A

Scale 1:50



▼ T

Written dimensions take precedence over scaled dimensions. Contractors shall verify all critical dimensions on site prior to commencement of work. Reproduction of the whole or part of this document constitutes an infringement of copyright. This information ideas and concepts contained in this document are confidential. The recipient(s) of this document is prohibited from disclosing such information, ideas and concepts to any person without prior written consent of Studio MAAT.

Studio MAAT studiomaat com au

Joanna Mackenzie 0421 669 671 joanna@studiomaat.com.au Bridget Atkinson 0423 170 481 bridget@studiomaat.com.au As shown at A3

Issue Issue for DA

Revisions A 23.10.24 Issue for DA B 23.01.25 Issue for DA

Project no. JEK2411

Drawing

Facade

Supergraphics:

Date 21.10.24

Project

Futuro

Cobbitty

Drawn/Checked BA/JM

P.1.1

Drawing number

JEK2411-P11-001

Revision

Notes **GENERAL**

The signs/graphics are located in an external public environment exposed to wind & rain, as such all materials, fabrication and fixing to

2mm painted fabricated Aluminium or material thickness to ensure flat even panel, over entire form. To be

Fabricated flat sign form. All edges

to be smoothed slightly rounded to

ensure no sharp edges. All joints to be neatly welded, to be continuous, grind smooth and flush all surfaces. To be painted on all exposed surfaces. To align along straight edge of window frame, 2mm off set to allow expansion & contration of frame, where aligned to the horizontal/vertical window frame.

Signform to be permanent conceal fix to base building shiplap wall. Signform to be tight to outer edge of shiplap, provide standoff or pin fixing to ensure flat even fixing to cladding. Utilise suitable adhesive & mechanical fixings to suit surface,

prepared and installed to manufacturers specifications. Ensure secure permanent fixing of

To be two pack polyurethane, external grade paint system. Anti-graffiti satin finish 25% gloss level to all exposed surfaces. LOCATING PRINCIPLES

As noted on elevation and setout

Final setout to be reviewed and agreed on site with client.

panel to wall.

standards

FINISHES/COLOUR As illustrated. For colour specification refer Graphic

suit expected conditions.

MATERIALITY

satin finish. **FABRICATION**

FIXING



Signtype

В

02 Montage Entry - view from ramp





NOTES

GENERAL

Painted graphics are applied directly to the brick wall at the pedestrian entry. The graphics are located in a public environment, as such all materials, fabrication and fixing to suit expected conditions.

MATERIALITY

Graphic shape to be by hand signwriting direct to wall & ground surface, using external grade paint system. Prepare wall & ground plane, apply white undercoat to ensure solid colour, preparing and finishing to ensure permanent adhesion of graphics.

FABRICATION

Prepare wall & ground, preparing and finishing to ensure permanent adhesion of graphics.

FINISHES/COLOUR

To be DULUX 2-pak paint external grade paint system. Paint system to suit location, ie wall & ground. Ground paint system to have non-slip clear coat over all painted surfaces.

Graphics to be as per artwork

For colour specification refer Graphic standards

Anti-graffiti satin finish 25% gloss level to all exposed surfaces on wall.

Ground paint system to have non-slip, ie trafficable, clear coat over all painted surfaces.

GRAPHICS

Signwriting by hand

Scale 1:50

Refer drawing JEK2411-P4-001 for street address

for facade ID

Refer drawing JEK2411-I3-001 for entry ID

for fence supergraphics

 $M \rightarrow$

▼ T

Written dimensions take precedence over scaled dimensions. Contractors shall verify all critical dimensions on site prior to commencement of work. Reproduction of the whole or part of this document constitutes an infringement of copyright. This information ideas and concepts contained in this document are confidential. The recipient(s) of this document is prohibited from disclosing such information, ideas and concepts to any person without prior written consent of Studio MAAT.

Studio MAAT studiomaat com au

Joanna Mackenzie 0421 669 671 joanna@studiomaat.com.au Bridget Atkinson 0423 170 481 bridget@studiomaat.com.au As shown at A3

Issue Issue for DA

Revisions

A 23.10.24 Issue for DA B 23.01.25 Issue for DA

NOT FOR CONSTRUCTION

Project no. JEK2411

Drawing

Entry

Supergraphics:

Date 21.10.24

Project

Futuro


Cobbitty

BA/JM

Signtype


P.1.1

Drawn/Checked Drawing number JEK2411-P11-002

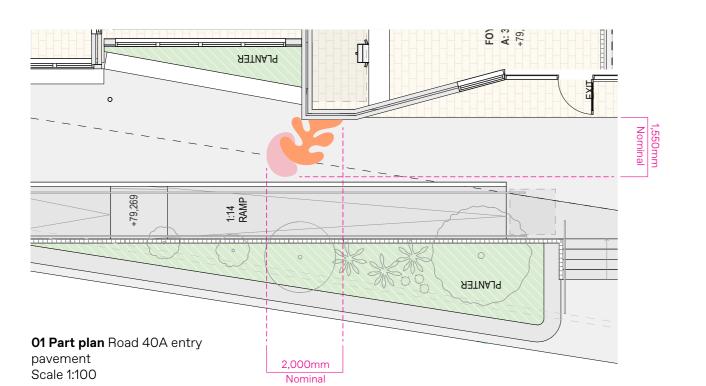

NOTES

Refer drawing JEK2411-P11-002

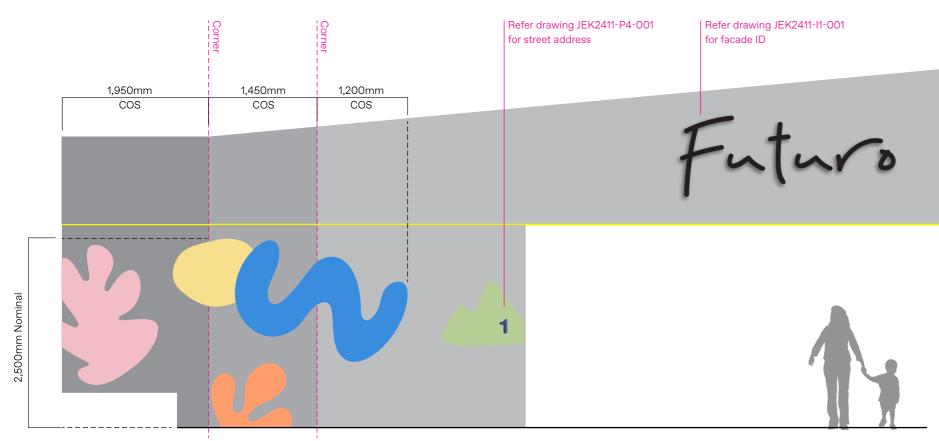

02 Unfolded elevation Graphic detail

Scale 1:50





Written dimensions take precedence over scaled dimensions. Contractors shall verify all critical dimensions on site prior to commencement of work. Reproduction of the whole or part of this document constitutes an infringement of copyright. This information ideas and concepts contained in this document are confidential. The recipient(s) of this document is prohibited from disclosing such information, ideas and concepts to any person without prior written consent of Studio MAAT.

Studio MAAT studiomaat.com.au

Joanna Mackenzie 0421 669 671 joanna@studiomaat.com.au Bridget Atkinson 0423 170 481 bridget@studiomaat.com.au Scale As shown at A3

Issue Issue for DA Revisions
A 23.10.24 Issue for DA
B 23.01.25 Issue for DA

NOT FOR CONSTRUCTION

Project no. JEK2411

Supergraphics:

Drawing

Entry

21.10.24 Project

Futuro

Cobbitty

Date

BA/JM Signtype

P.1.1

Drawn/Checked Drawing number
BA/JM JEK2411-P11-003

Revision **B**



NOTES

GENER.

The graphics are applied directly to the timber & glazing fence to the boundary, creating a colourful and engaging feature to the vehicular & pedestrian journey around the site. The graphics are located in a public environment, as such all materials, fabrication and fixing to suit expected conditions.

TIMBER FENCE

MATERIALITY

Graphic pattern to be by hand signwriting direct to wall surface, using external grade paint system.

FABRICATION

Prepare timber wall, preparing and finishing to ensure permanent adhesion of graphics.

FINISHES/COLOUR

Paint to be DULUX 2-pak paint external grade paint system.
Graphics to be as per artwork
For colour specification refer Graphic standards. Anti-graffiti satin finish
25% gloss level to all exposed surfaces

GRAPHICS

Signwriting by hand

GLAZED FENCE

MATERIALITY

To be digital print direct to external grade self adhesive ultra clear vinyl installed to manufacturers specifications. To match brand colour, refer Graphic standards.

To be satin.

Vinyl to be applied to inside face of glazing.

FABRICATION

Electronically cut self adhesive vinyl film. Ensure all corners/edges are sharp and true to the artwork. Ensure cut edges are not overheated and are cut slowly to achieve a clean cut.

GRAPHICS

Digital print direct to vinyl as illustrated on elevation and noted in documentation. Ensure ink application is solid, no see through. Double hit of colours if required to ensure intensity and solid colour, no banding. All forms shall be sharp and true to the artwork.

LOCATING PRINCIPLES

As noted on elevation, to inside face of glazing.



Drawing number



Written dimensions take precedence over scaled dimensions. Contractors shall verify all critical dimensions on site prior to commencement of work. Reproduction of the whole or part of this document constitutes an infringement of copyright. This information ideas and concepts contained in this document are confidential. The recipient(s) of this document is prohibited from disclosing such information, ideas and concepts to any person without prior written consent of Studio MAAT.

Studio MAAT studiomaat.com.au

Joanna Mackenzie 0421 669 671 joanna@studiomaat.com.au Bridget Atkinson 0423 170 481 bridget@studiomaat.com.au Scale
As shown at A3

Issue Issue for DA Revisions

A 23.10.24 Issue for DA B 23.01.25 Issue for DA

NOT FOR CONSTRUCTION

Project no. JEK2411

Drawing

Fence

Supergraphics:

21.10.24

Project

Futuro

Cobbitty

Date

BA/JM Signtype


Drawn/Checked BA/JM

P.1.1

/IM


JEK2411-P11-004

Revision **B**

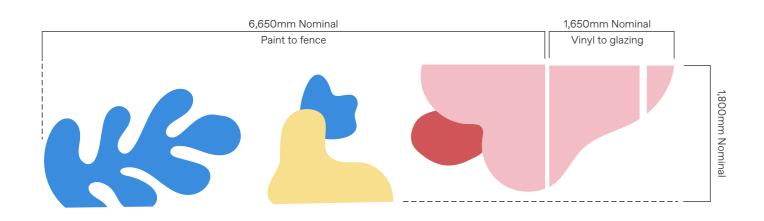

02 Graphic details

Scale 1:50

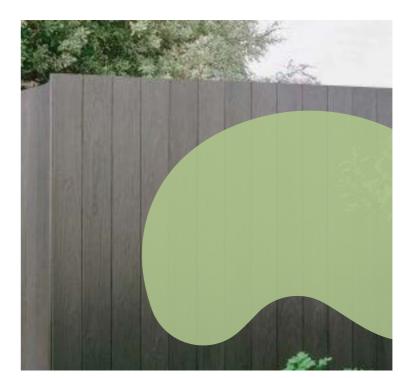

03 Montage Indicative graphic to timber fence



01 Part elevation Charles MacIntosh Parkway Scale 1:50



Written dimensions take precedence over scaled dimensions. Contractors shall verify all critical dimensions on site prior to commencement of work. Reproduction of the whole or part of this document constitutes an infringement of copyright. This information ideas and concepts contained in this document are confidential. The recipient(s) of this document is prohibited from disclosing such information, ideas and concepts to any person without prior written consent of Studio MAAT.

Studio MAAT studiomaat com au

Joanna Mackenzie 0421 669 671 joanna@studiomaat.com.au Bridget Atkinson 0423 170 481 bridget@studiomaat.com.au As shown at A3

Issue Issue for DA

Revisions A 23.10.24 Issue for DA B 23.01.25 Issue for DA

NOT FOR CONSTRUCTION

Project no. JEK2411

Drawing Supergraphics: Fence

Date 21.10.24

Project

Futuro

Cobbitty

Drawn/Checked BA/JM Signtype

P.1.1

Drawing number

JEK2411-P11-005

Revision В

The graphics are applied directly to the timber & glazing fence to the boundary, creating a colourful and engaging feature to the vehicular & pedestrian journey around the site. The graphics are located in a public environment, as such all materials, fabrication and fixing to suit expected

TIMBER FENCE

MATERIALITY

conditions.

NOTES

GENERAL

Graphic pattern to be by hand signwriting direct to wall surface, using external grade paint system.

FABRICATION

Prepare timber wall, preparing and finishing to ensure permanent adhesion of graphics.

FINISHES/COLOUR

Paint to be DULUX 2-pak paint external grade paint system. Graphics to be as per artwork For colour specification refer Graphic standards. Anti-graffiti satin finish 25% gloss level to all exposed surfaces

GRAPHICS Signwriting by hand

GLAZED FENCE

MATERIALITY

To be digital print direct to external grade self adhesive ultra clear vinyl installed to manufacturers specifications. To match brand colour, refer Graphic standards. To be satin.

Vinyl to be applied to inside face of glazing.

FABRICATION

Electronically cut self adhesive vinyl film. Ensure all corners/edges are sharp and true to the artwork.


Ensure cut edges are not overheated and are cut slowly to achieve a clean cut.


GRAPHICS

Digital print direct to vinyl as illustrated on elevation and noted in documentation. Ensure ink application is solid, no see through. Double hit of colours if required to ensure intensity and solid colour, no banding. All forms shall be sharp and true to the artwork.

LOCATING PRINCIPLES

As noted on elevation, to inside face of glazing.

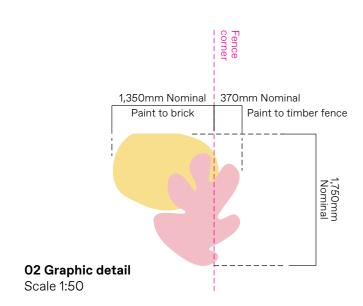

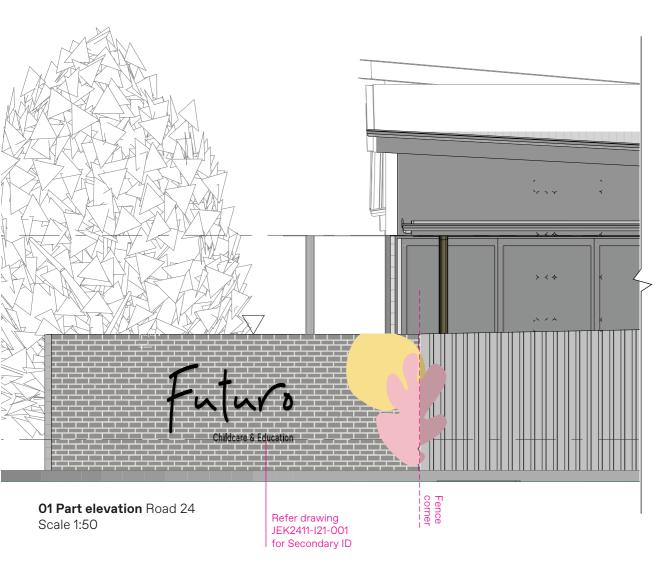



03 3D Corner Charles MacIntosh Parkway & Road 24

NOTES

GENERAL

The graphics are applied directly to the timber & brick fence to the boundary, creating a colourful and engaging feature to the vehicular & pedestrian journey around the site. The graphics are located in a public environment, as such all materials, fabrication and fixing to suit expected conditions.

MATERIALITY

Graphic pattern to be by hand signwriting direct to wall surface, using external grade paint system.

FABRICATION

Prepare wall, preparing and finishing to ensure permanent adhesion of graphics.

FINISHES/COLOUR

To be DULUX 2-pak paint external grade paint system

Text and graphics to be as per artwork

For colour specification refer Graphic standards

Anti-graffiti satin finish 25% gloss level to all exposed surfaces

GRAPHICS

Signwriting by hand



▼ T

Written dimensions take precedence over scaled dimensions. Contractors shall verify all critical dimensions on site prior to commencement of work. Reproduction of the whole or part of this document constitutes an infringement of copyright. This information ideas and concepts contained in this document are confidential. The recipient(s) of this document is prohibited from disclosing such information, ideas and concepts to any person without prior written consent of Studio MAAT.

Studio MAAT studiomaat.com.au

Joanna Mackenzie 0421 669 671 ioanna@studiomaat.com.au Bridget Atkinson 0423 170 481 bridget@studiomaat.com.au As shown at A3

Issue Issue for DA

Revisions

A 23.10.24 Issue for DA B 23.01.25 Issue for DA

NOT FOR CONSTRUCTION

Project no. JEK2411

Drawing

Fence

Supergraphics:

Date 21.10.24

Project

Futuro

Cobbitty

Drawn/Checked BA/JM


Signtype


P.1.1

Drawing number

JEK2411-P11-006

Revision В

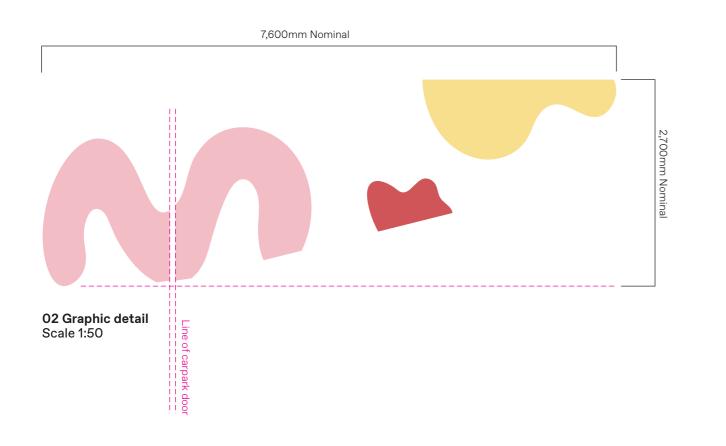

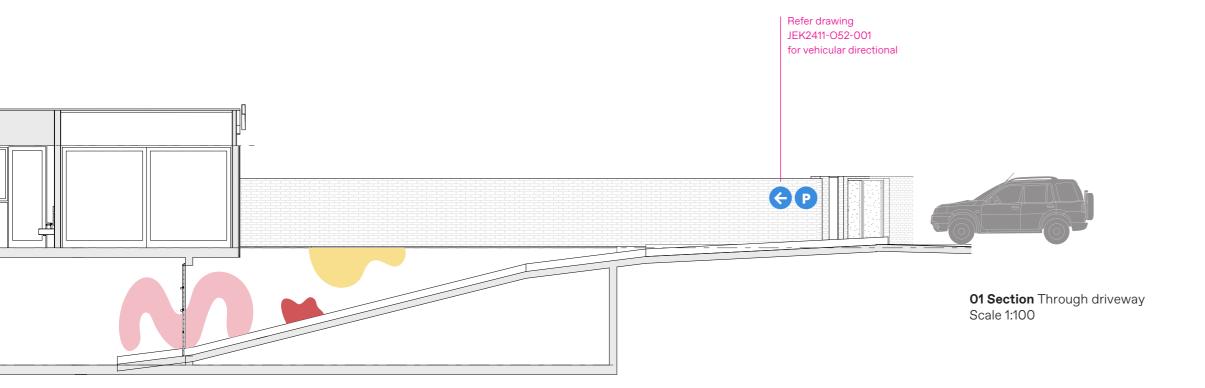

Notes

GENERAL

The signs/graphics are located in an external public environment exposed to wind & rain, as such all materials, fabrication and fixing to suit expected conditions.

MATERIALITY

2mm painted fabricated Aluminium or material thickness to ensure flat evan panel, over entire form. To be satin finish.

FABRICATION

Fabricated sign form, all edges to be smoothed slightly rounded to ensure no sharp edges. All joints to be neatly welded, to be continuous, grind smooth and flush all surfaces. To be painted on all exposed surfaces.

FIXING

Signform to be permanent conceal fix to base building driveway wall. Utilise suitable adhesive & mechanical fixings to suit surface, prepared and installed to manufacturers specifications. Ensure secure permanent fixing of panel to wall.

FINISHES/COLOUR As illustrated. For colour specification refer Graphic standards

To be two pack polyurethane, external grade paint system. Anti-graffiti satin finish 25% gloss level to all exposed surfaces.

LOCATING PRINCIPLES As noted on elevation and setout

Final setout to be reviewed and agreed on site with client.

 $M \rightarrow$ ▼ T

Written dimensions take precedence over scaled dimensions. Contractors shall verify all critical dimensions on site prior to commencement of work. Reproduction of the whole or part of this document constitutes an infringement of copyright. This information ideas and concepts contained in this document are confidential. The recipient(s) of this document is prohibited from disclosing such information, ideas and concepts to any person without prior written consent of Studio MAAT.

Studio MAAT studiomaat.com.au

Joanna Mackenzie 0421 669 671 ioanna@studiomaat.com.au Bridget Atkinson 0423 170 481 bridget@studiomaat.com.au As shown at A3

Issue Issue for DA

Revisions

A 23.10.24 Issue for DA B 23.01.25 Issue for DA

NOT FOR CONSTRUCTION

Project no. JEK2411

Drawing

Driveway

Supergraphics:

Date 21.10.24

Project

Futuro

Cobbitty

BA/JM

Signtype

P.1.1

Drawn/Checked

Drawing number

JEK2411-P11-007

Revision В



01 Section Through Carpark & driveway Scale 1:200

02 Graphic detail

Scale 1:50

 $M \rightarrow$ ▼ T

Written dimensions take precedence over scaled dimensions. Contractors shall verify all critical dimensions on site prior to commencement of work. Reproduction of the whole or part of this document constitutes an infringement of copyright. This information ideas and concepts contained in this document are confidential. The recipient(s) of this document is prohibited from disclosing such information, ideas and concepts to any person without prior written consent of Studio MAAT.

Studio MAAT studiomaat com au

Joanna Mackenzie 0421 669 671 joanna@studiomaat.com.au Bridget Atkinson 0423 170 481 bridget@studiomaat.com.au As shown at A3

Issue Issue for DA

Revisions A 23.01.25 Issue for DA

Project no. JEK2411

Drawing

Carpark

Supergraphics:

Date 21.10.24

BA/JM

Drawing number

Notes

GENERAL

MATERIALITY

satin finish. **FABRICATION**

surfaces.

FIXING

panel to wall.

standards

FINISHES/COLOUR As illustrated. For colour specification refer Graphic

The signs/graphics are located in an external public environment exposed to wind & rain, as such all materials, fabrication and fixing to

2mm painted fabricated Aluminium or material thickness to ensure flat evan panel, over entire form. To be

Fabricated sign form, all edges to be smoothed slightly rounded to ensure no sharp edges. All joints to be neatly welded, to be continuous, grind smooth and flush all surfaces. To be painted on all exposed

Signform to be permanent conceal fix to base building driveway wall. Utilise suitable adhesive &

mechanical fixings to suit surface,

prepared and installed to manufacturers specifications. Ensure secure permanent fixing of

To be two pack polyurethane, external grade paint system. Anti-graffiti satin finish 25% gloss level to all exposed surfaces.

As noted on elevation and setout

Final setout to be reviewed and agreed on site with client.

LOCATING PRINCIPLES

suit expected conditions.

JEK2411-P11-008

Revision Α

NOT FOR CONSTRUCTION

Project Futuro

Cobbitty


Signtype P.1.1

Drawn/Checked

Notes

Refer drawing JEK2411-P13-001 for similar



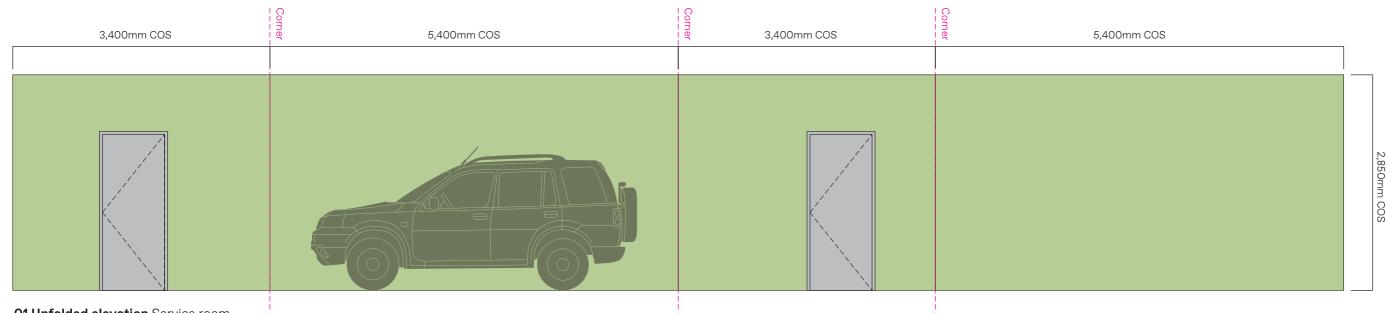

01 Unfolded elevation Service room

Scale 1:50



∢ T

Written dimensions take precedence over scaled dimensions. Contractors shall verify all critical dimensions on site prior to commencement of work. Reproduction of the whole or part of this document constitutes an infringement of copyright. This information ideas and concepts contained in this document are confidential. The recipient(s) of this document is prohibited from disclosing such information, ideas and concepts to any person without prior written consent of Studio MAAT.

Studio MAAT studiomaat.com.au

Joanna Mackenzie 0421 669 671 joanna@studiomaat.com.au Bridget Atkinson 0423 170 481 bridget@studiomaat.com.au Scale As shown at A3

Issue Issue for DA

Revisions A 23.01.25 Issue for DA

NOT FOR CONSTRUCTION

Project no. JEK2411

Drawing

Supergraphics:

Services room

21.10.24 Project

Futuro

Cobbitty

Date

BA/JM Signtype


P.1.1

Drawn/Checked

Drawing number **JEK2411-P11-009**

Revision Α



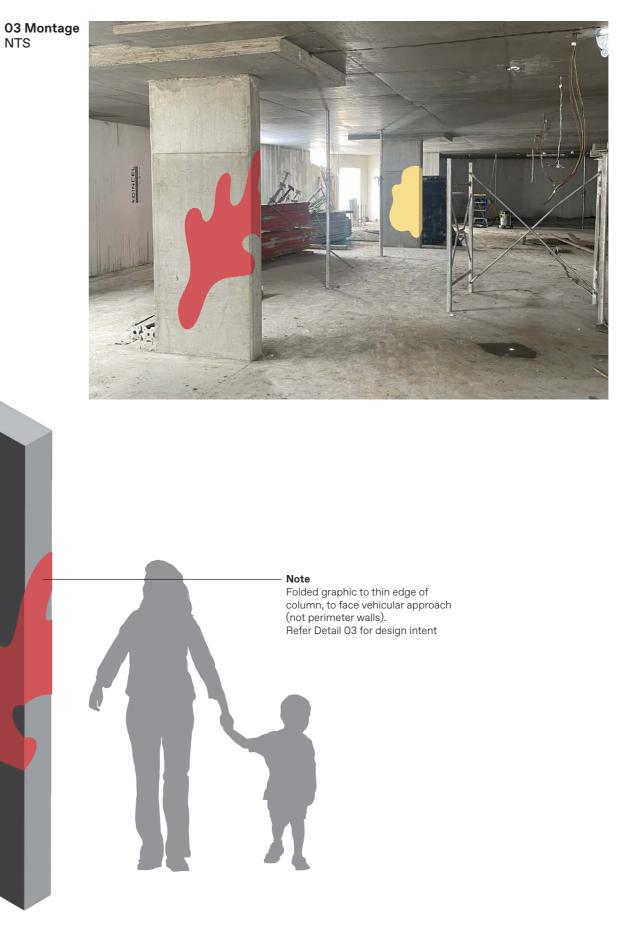

Notes

GENERAL

The signs/graphics are located in a covered carpark public environment, as such all materials, fabrication and fixing to suit expected conditions.

MATERIALITY

Graphics to be mask & spray painted with DULUX 2-pak external grade paint system, or similar appropriate for location

FINISHES/COLOUR As illustrated

For colour specification refer Graphic standards

To be two pack polyurethane, external grade paint system. Anti-graffiti satin clear coat spray finish 25% gloss level to all exposed surfaces.

GRAPHICS

Graphic to be mask & spray via vinyl cut template and spray painted directly to wall surface.

Typical carpark column Scale 1:20

01 Unfolded elevation



Written dimensions take precedence over scaled dimensions. Contractors shall verify all critical dimensions on site prior to commencement of work. Reproduction of the whole or part of this document constitutes an infringement of copyright. This information ideas and concepts contained in this document are confidential. The recipient(s) of this document is prohibited from disclosing such information, ideas and concepts to any person without prior written consent of Studio MAAT.

Studio MAAT studiomaat.com.au

Joanna Mackenzie 0421 669 671 joanna@studiomaat.com.au Bridget Atkinson 0423 170 481 bridget@studiomaat.com.au As shown at A3

Issue Issue for DA

02 3D

NTS

Revisions A 23.01.25 Issue for DA

NOT FOR CONSTRUCTION

NTS

Project no. JEK2411

> Drawing Carpark Columns

Date 21.10.24

Futuro

Cobbitty

Project

Drawn/Checked BA/JM Signtype


P.1.3

Drawing number **JEK2411-P13-001**

Α





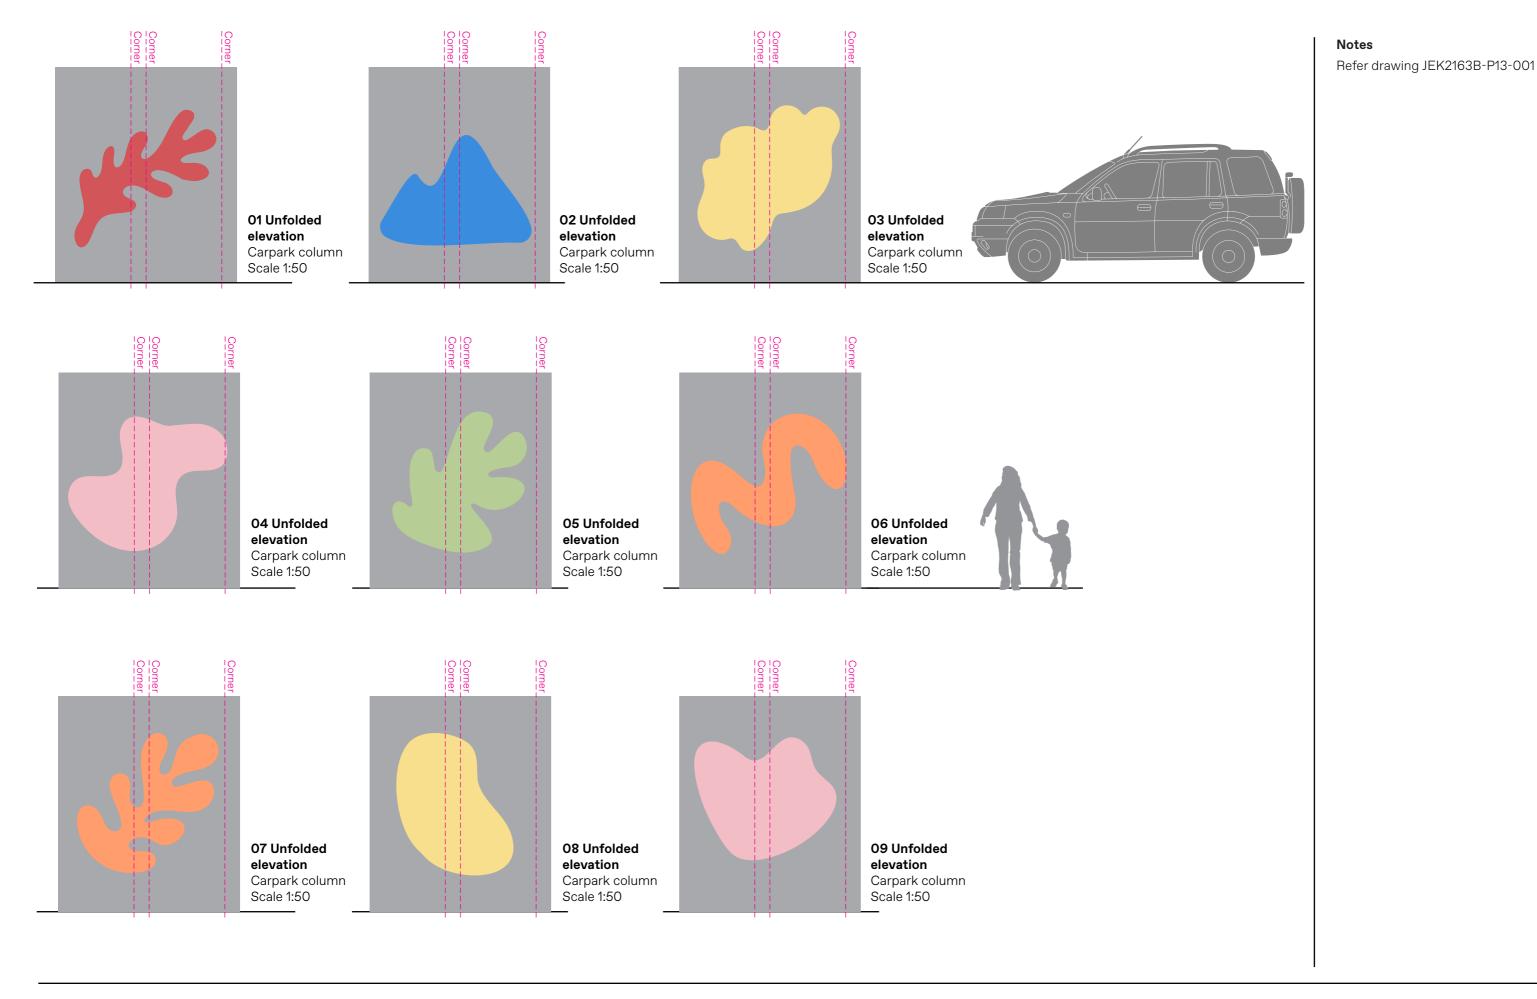



Written dimensions take precedence over scaled dimensions. Contractors shall verify all critical dimensions on site prior to commencement of work. Reproduction of the whole or part of this document constitutes an infringement of copyright. This information ideas and concepts contained in this document are confidential. The recipient(s) of this document is prohibited from disclosing such information, ideas and concepts to any person without prior written consent of Studio MAAT.

Studio MAAT studiomaat.com.au

Joanna Mackenzie 0421 669 671 joanna@studiomaat.com.au Bridget Atkinson 0423 170 481 bridget@studiomaat.com.au Scale
As shown at A3

Issue for DA

Revisions A 23.01.25 Issue for DA

NOT FOR CONSTRUCTION

Project no. JEK2411

Drawing Carpark

Columns

Date **21.10.24**

Project Futuro

Cobbitty

Drawn/Checked BA/JM

Signtype P.1.3

Drawing number **JEK2411-P13-002**

Revision






03 Reference Green brand shape to be paint direct to brick. Street number pin-fixed.



04 Reference

Street number supplied by client. Colour: Ink. Refer https://mudaustralia.com/shop/numbers-large-1/ for install instructions

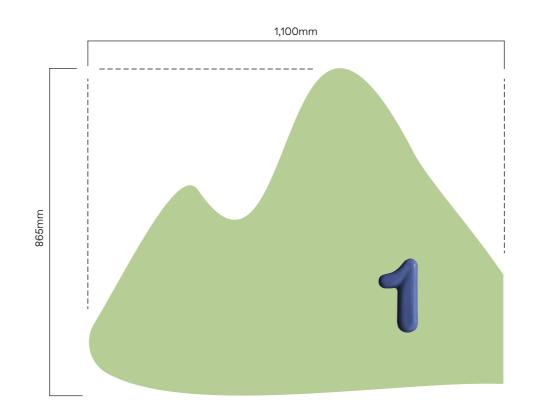

To be DULUX 2-pak paint external grade paint system

Graphics to be as per artwork

Prepare wall, preparing and finishing to ensure permanent

For colour specification refer Graphic standards

Anti-graffiti satin finish 25% gloss level to all exposed surfaces

GRAPHICS Signwriting by hand

NUMBERS

NOTES GENERAL

specified.

MATERIALITY

The Address painted graphic is applied directly to the brick wall at the pedestrian entry, top of stairs & ramp. The graphics are located in a public environment, as such all materials, fabrication and fixing to suit expected conditions. With off-the-shelf numbers fixed as

Graphic shape to be by hand signwriting direct to wall surface,

using external grade paint system.

Prepare wall, apply white undercoat

and finishing to ensure permanent

to ensure solid colour, preparing

adhesion of graphics.

adhesion of graphics. FINISHES/COLOUR

FABRICATION

Number (1) to be supplied by client. Signage Contractor to fix supplied number mount to painted brick wall with a 13mm standoff, in location as illustrated. Refer https://mudaustralia.com/shop/nu mbers-large-1/

Utilise specified wall plugs and screws to achieve 13mm standoff.



▼ T

Written dimensions take precedence over scaled dimensions. Contractors shall verify all critical dimensions on site prior to commencement of work. Reproduction of the whole or part of this document constitutes an infringement of copyright. This information ideas and concepts contained in this document are confidential. The recipient(s) of this document is prohibited from disclosing such information, ideas and concepts to any person without prior written consent of Studio MAAT.

Studio MAAT studiomaat com au

Joanna Mackenzie 0421 669 671 joanna@studiomaat.com.au Bridget Atkinson 0423 170 481 bridget@studiomaat.com.au As shown at A3

Issue Issue for DA

Revisions

A 23.10.24 Issue for DA B 23.01.25 Issue for DA

NOT FOR CONSTRUCTION

Project no. JEK2411

Drawing

Street

number

Date

21.10.24 Project

Futuro

Cobbitty

BA/JM

Signtype

P.4


Drawn/Checked

Drawing number

JEK2411-P4-001

Revision В



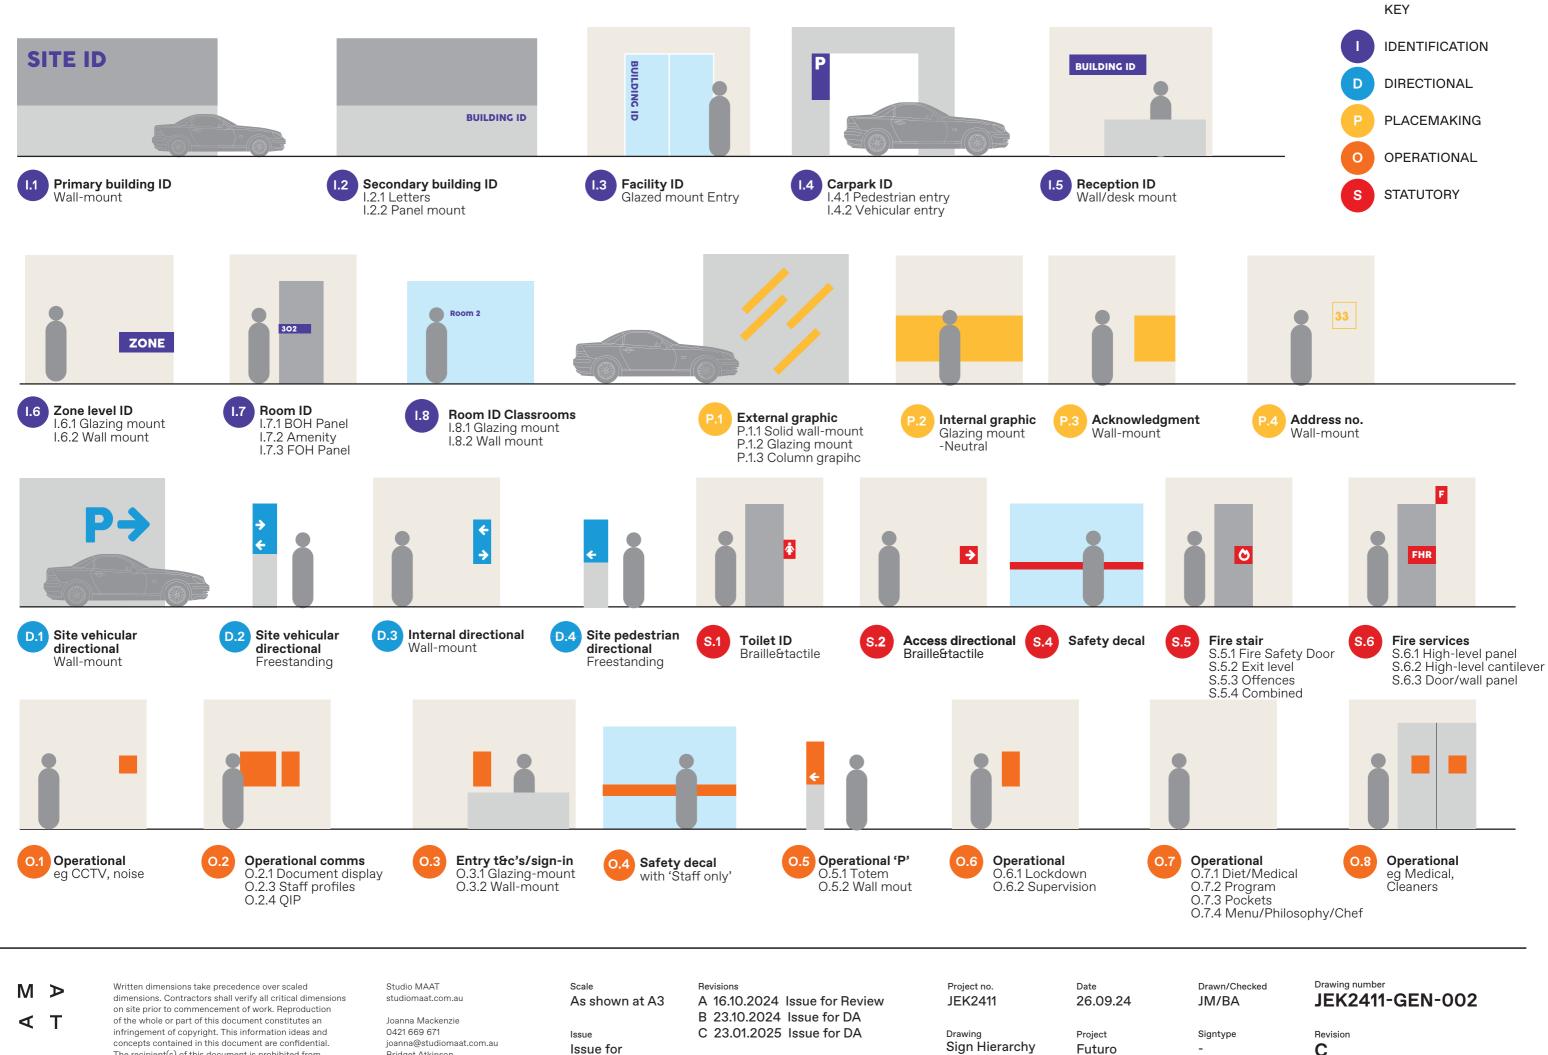


The recipient(s) of this document is prohibited from disclosing such information, ideas and concepts to any person without prior written consent of Studio MAAT.

Bridget Atkinson 0423 170 481 bridget@studiomaat.com.au

Issue for DA

Cobbitty

C

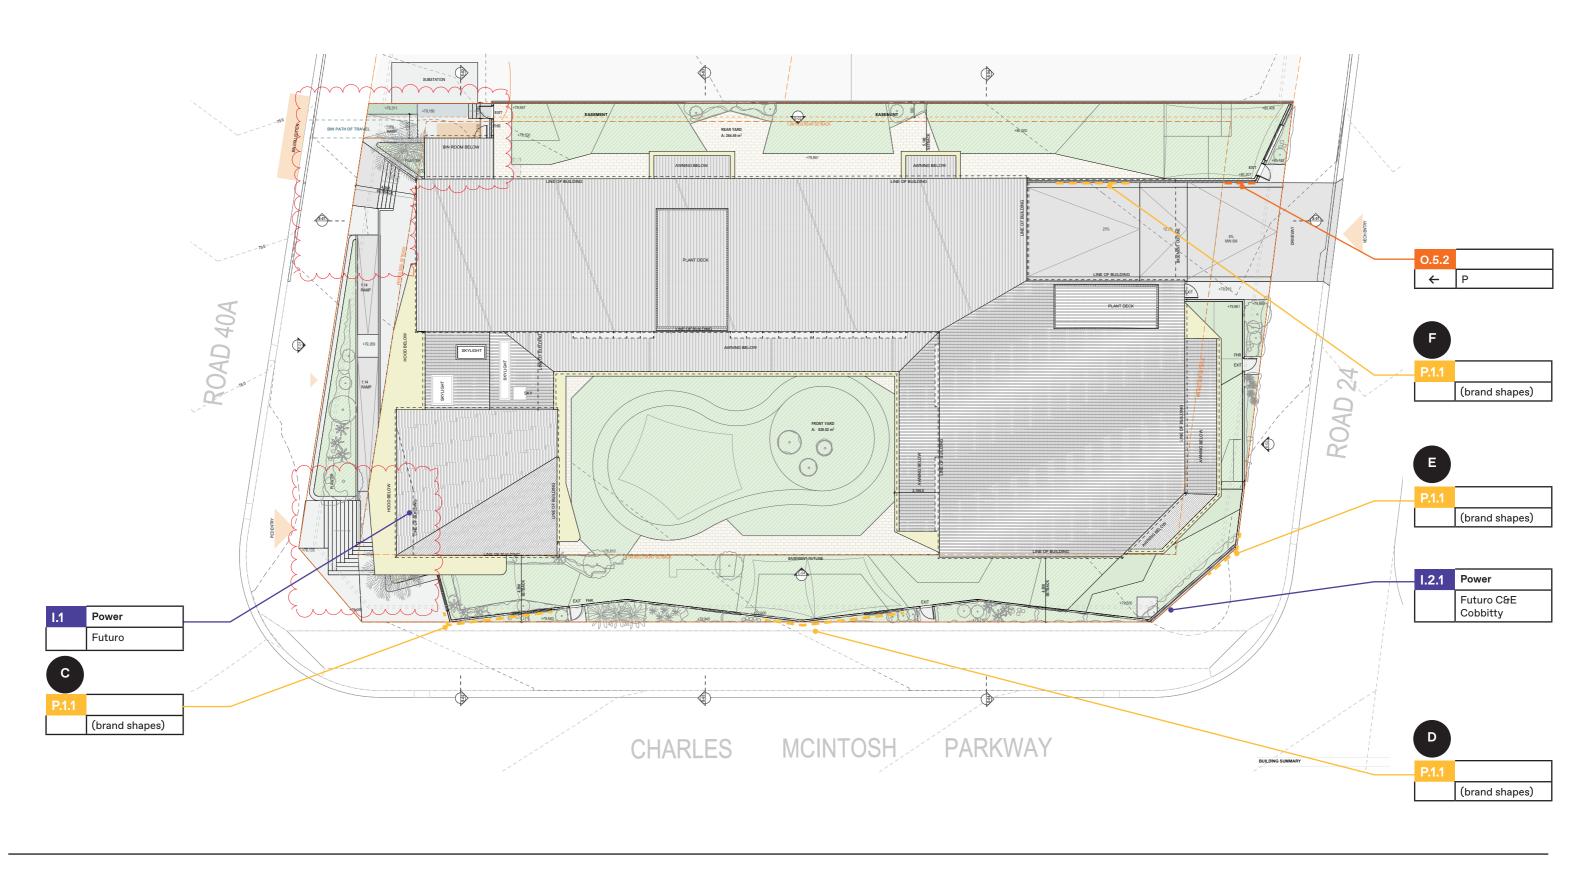

M >

∢ T

Written dimensions take precedence over scaled dimensions. Contractors shall verify all critical dimensions on site prior to commencement of work. Reproduction of the whole or part of this document constitutes an infringement of copyright. This information ideas and concepts contained in this document are confidential. The recipient(s) of this document is prohibited from disclosing such information, ideas and concepts to any person without prior written consent of Studio MAAT.

Studio MAAT studiomaat.com.au

Joanna Mackenzie 0421 669 671 joanna@studiomaat.com.au Bridget Atkinson 0423 170 481 bridget@studiomaat.com.au Scale As shown at A3

Issue for DA

Revisions
A 16.10.2024 Issue for Review
B 23.10.2024 Issue for DA
C 23.01.2025 Issue for DA

Project no. JEK2411

Drawing

Site Plan

Date 26.09.24

Project

Futuro


Cobbitty

Drawn/Checked JM/BA Signtype

Drawing number
JEK2411-MPN-001

Revision **C**



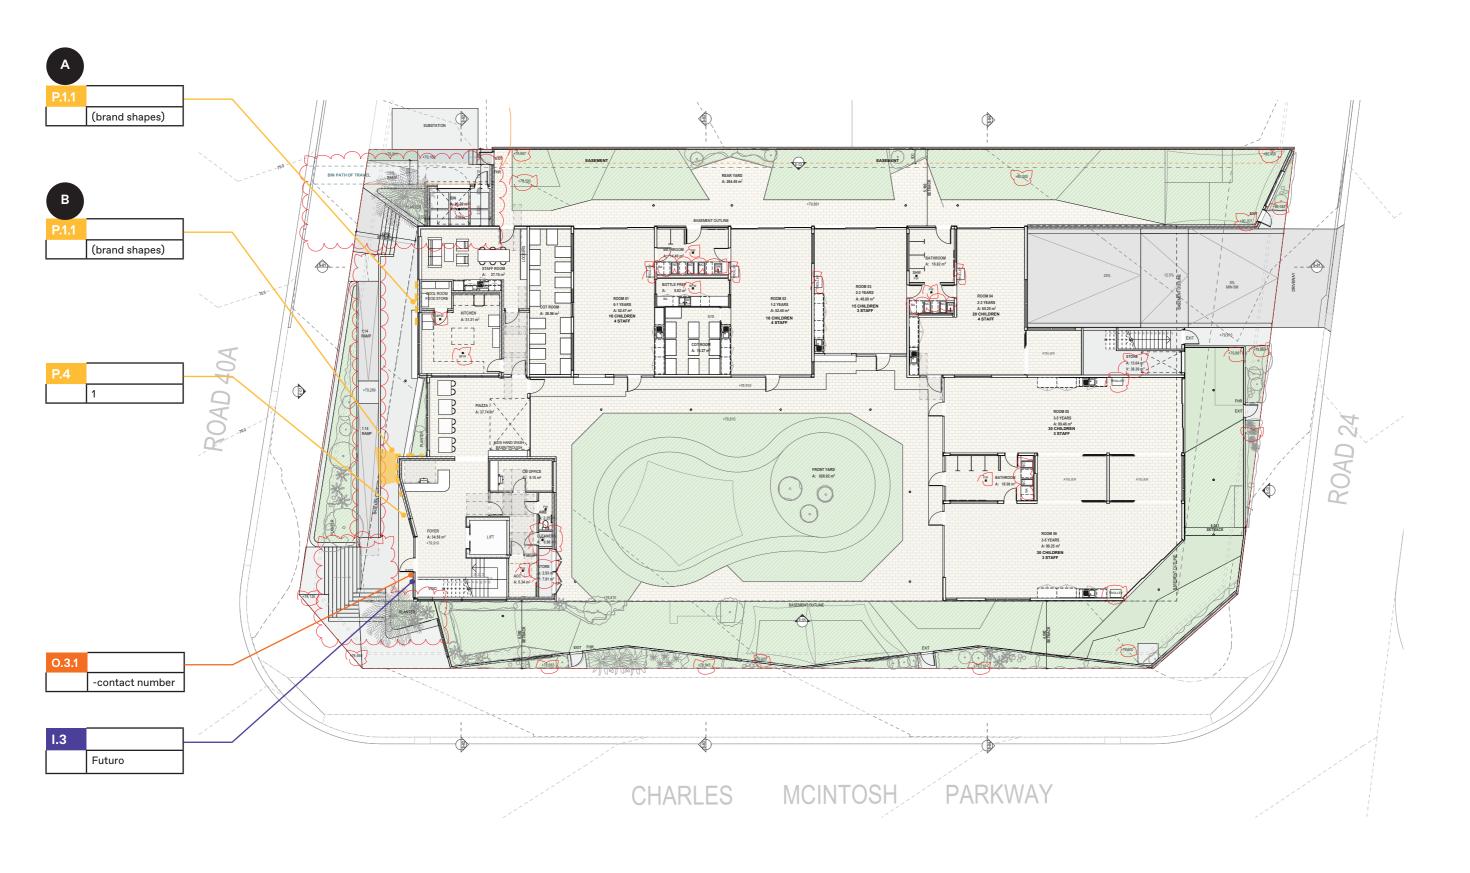



▼ T

Written dimensions take precedence over scaled dimensions. Contractors shall verify all critical dimensions on site prior to commencement of work. Reproduction of the whole or part of this document constitutes an infringement of copyright. This information ideas and concepts contained in this document are confidential. The recipient(s) of this document is prohibited from disclosing such information, ideas and concepts to any person without prior written consent of Studio MAAT.

Studio MAAT studiomaat.com.au

Joanna Mackenzie 0421 669 671 joanna@studiomaat.com.au Bridget Atkinson 0423 170 481 bridget@studiomaat.com.au

Scale As shown at A3

Issue Issue for DA

Revisions

A 16.10.2024 Issue for Review B 23.10.2024 Issue for DA C 23.01.2025 Issue for DA

Project no. JEK2411

Drawing

Ground

Date 26.09.24

Project

Futuro

Cobbitty


Drawn/Checked JM/BA

Signtype

Drawing number JEK2411-MPN-002

> Revision C



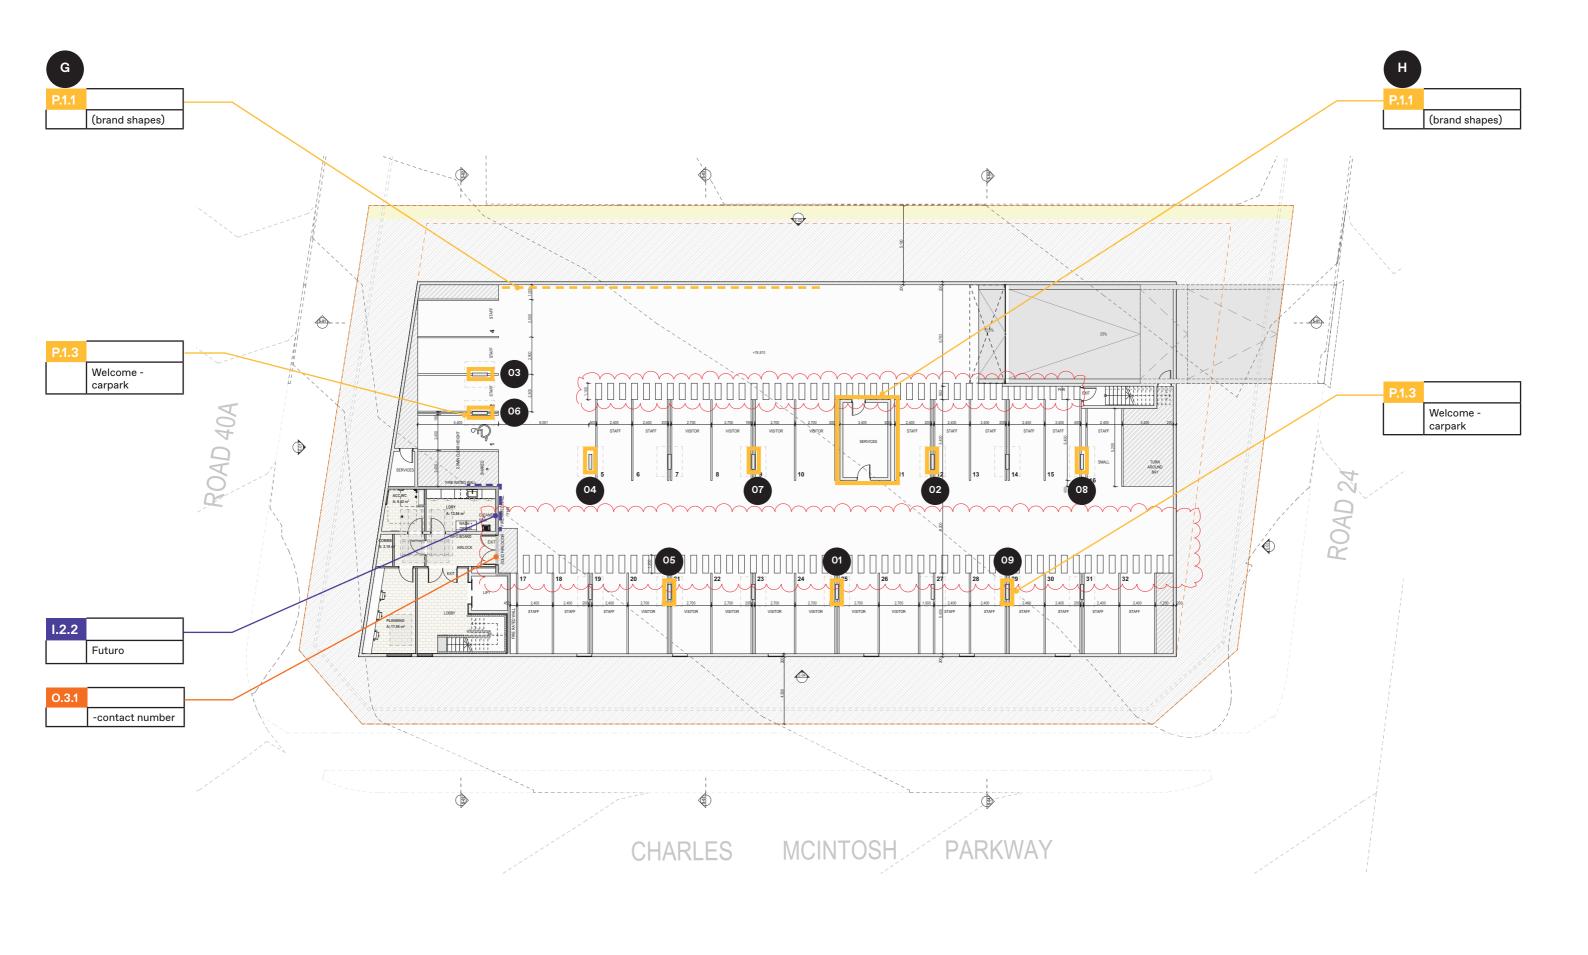



▼ T

Written dimensions take precedence over scaled dimensions. Contractors shall verify all critical dimensions on site prior to commencement of work. Reproduction of the whole or part of this document constitutes an infringement of copyright. This information ideas and concepts contained in this document are confidential. The recipient(s) of this document is prohibited from disclosing such information, ideas and concepts to any person without prior written consent of Studio MAAT.

Studio MAAT studiomaat.com.au

Joanna Mackenzie 0421 669 671 joanna@studiomaat.com.au Bridget Atkinson 0423 170 481 bridget@studiomaat.com.au

Scale As shown at A3

Issue

DA

Revisions A 23.01.2025 Issue for DA

Issue for

Project no. JEK2411

Drawing

Basement

26.09.24

Project Futuro

Cobbitty

Date

JM/BA


Signtype

Drawn/Checked

Drawing number JEK2411-MPN-003

Revision Α



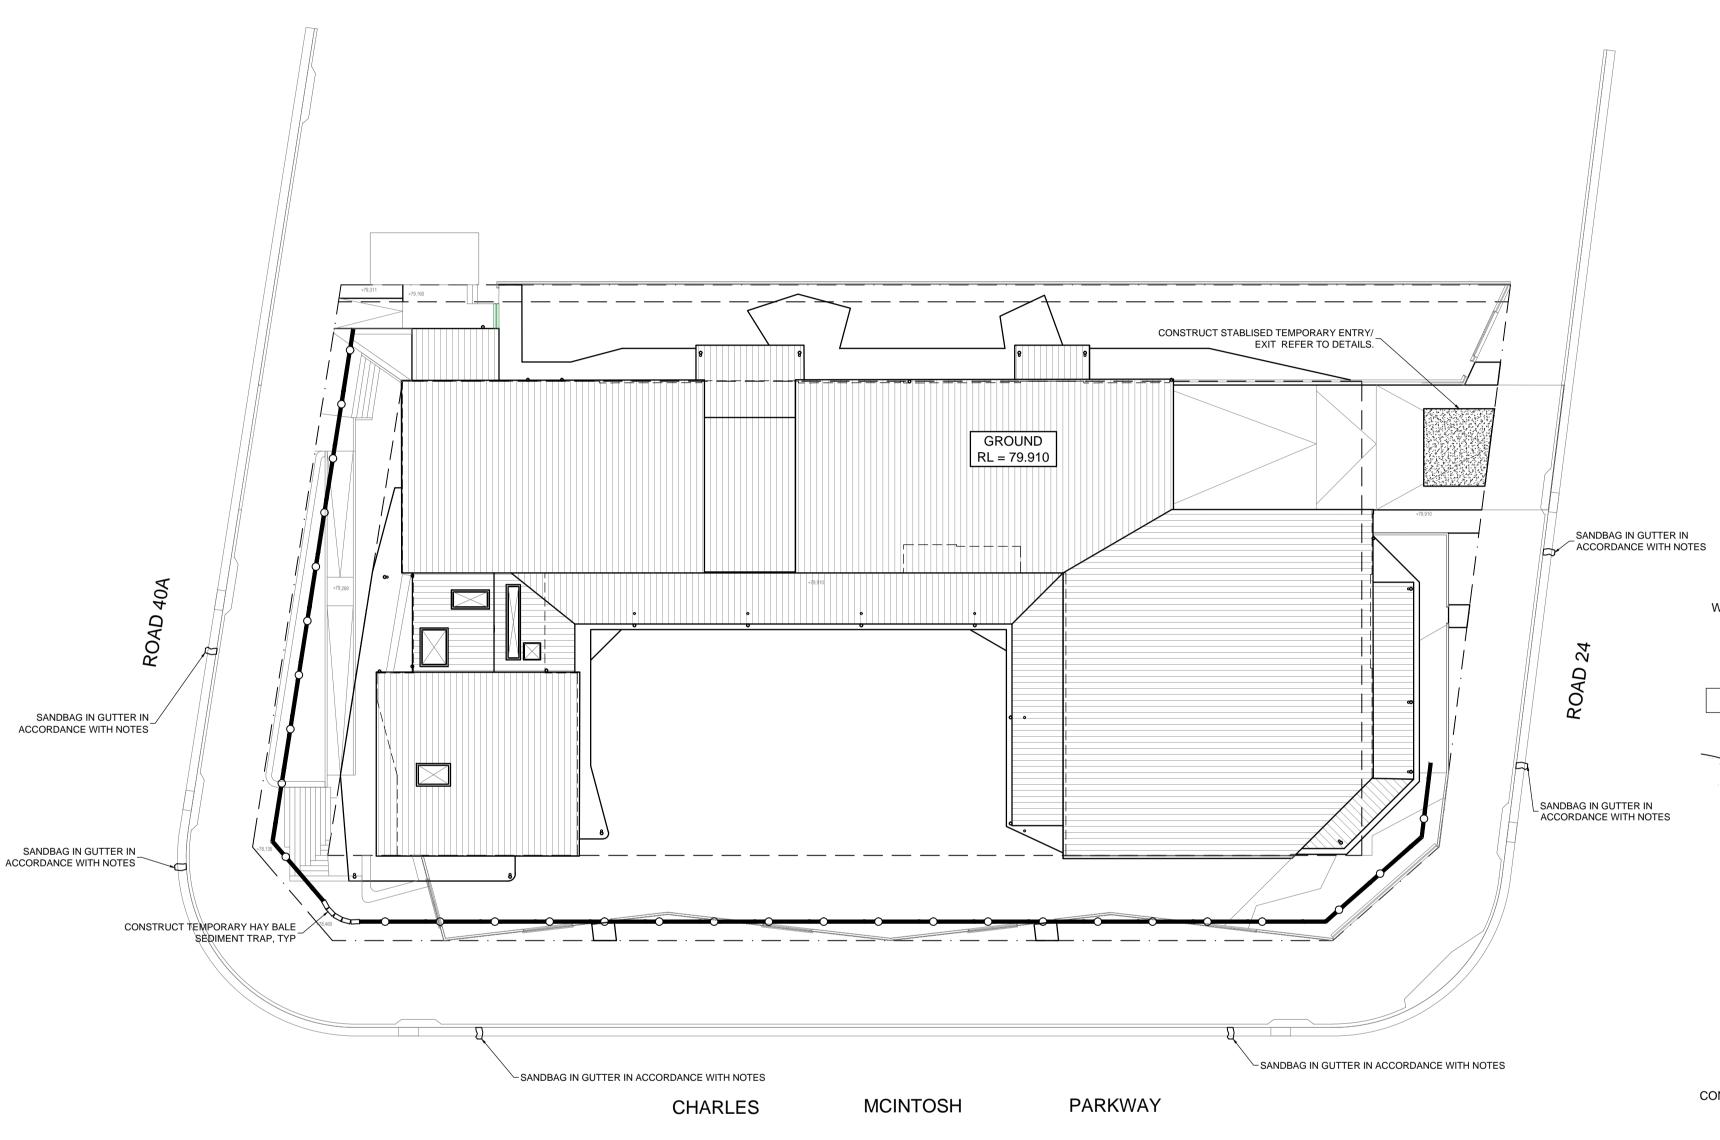

SEDIMENT & EROSION CONTROL PLAN

- DENOTES SEDIMENT FENCE

COMMENCEMENT OF WORKS

THE CONTRACTOR SHALL ENSURE THAT NO SPOIL OR FILL ENCROACHES UPON ADJACENT AREAS FOR THE DURATION OF WORKS.

THE CONTRACTOR SHALL ENSURE THAT KERB INLETS AND DRAINS RECEIVING STORMWATER SHALL BE PROTECTED AT ALL TIMES DURING DEVELOPMENT. KERB INLET SEDIMENT TRAPS SHALL BE INSTALLED ALONG THE IMMEDIATE VICINITY ALONG THE STREET FRONTAGE.


SEDIMENT FENCING SHALL BE SECURED BY POST (WHERE METAL STAR PICKETS ARE USED PLASTIC SAFETY CAPS SHALL BE USED) AT 2000 INTERVALS WITH GEOTEXTILE FABRIC EMBEDDED 200 IN SOIL.

ALL TOPSOIL STRIPPED FORM THE SITE AND STOCKPILED DOES NOT INTERFERE WITH DRAINAGE LINES AND STORMWATER INLETS AND WILL BE SUITABLY COVERED WITH AN IMPERVIOUS MEMBRANE MATERIAL AND SCREENED BY SEDIMENT FENCING.

SEDIMENT TRAP

1000 x 1000 WIDE 500 DEEP PIT, LOCATED AT THE LOWEST POINT TO THE TRAP


WASHOUT AREA TO BE 1800 x 1800 ALLOCATED FOR THE WASHING OF TOOL &

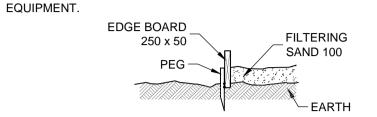


SEDIMENT FENCE

PROVIDE 'SEDIMENT FENCE ON DOWN SLOPE BOUNDARY AS SHOWN ON PLAN.

FABRIC TO BE BURIED BELOW GROUND AT LOWER EDGE.

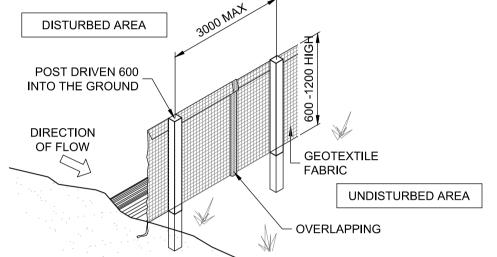


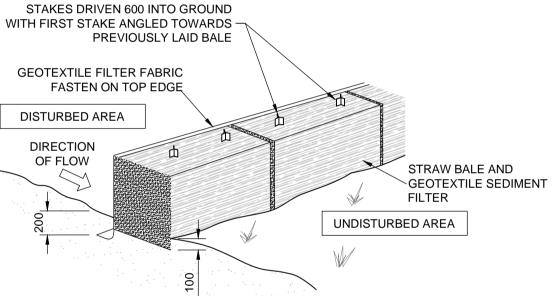

DRAINAGE AREA 0.5 HA. MAX. SLOPE GRADIENT 1:2 MAX. SLOPE LENGTH 50m.

TEMPORARY CONSTRUCTION ENTRY/EXIT


VEHICLE ACCESS TO THE BUILDING SITE SHOULD BE RESTRICTED TO A SINGLE POINT SO AS TO REDUCE THE AMOUNT OF SOIL DEPOSITED ON THE STREET PAVEMENT.

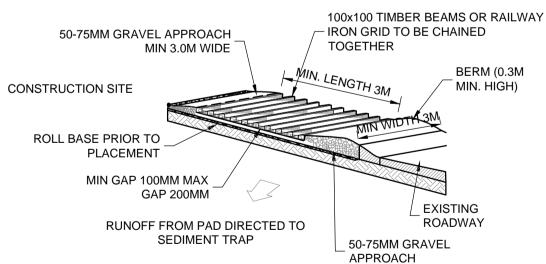

BUILDING MATERIAL STOCKPILE


ALL STOCKPILES OF BUILDING MATERIAL SUCH AS SAND AND SOIL MUST BE PROTECTED TO PREVENT SCOUR AND EROSION.

THEY SHOULD NEVER BE PLACED IN THE STREET GUTTER WHERE THEY WILL WASH AWAY WITH THE FIRST RAINSTORM.

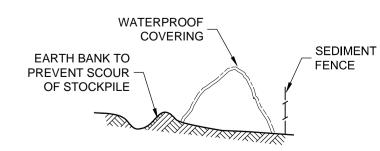

SANDBAG KERB SEDIMENT TRAP

IN CERTAIN CIRCUMSTANCES EXTRA SEDIMENT TRAPPING MAY BE

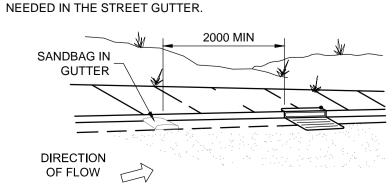

GENERAL NOTES

THESE DRAWINGS SHALL BE READ IN CONJUNCTION WITH OTHER CONSULTANTS' DRAWINGS AND SPECIFICATIONS AND WITH OTHER SUCH WRITTEN INSTRUCTIONS AS MAY BE ISSUED DURING THE COURSE OF THE CONTRACT. ANY DISCREPANCY SHALL BE REFERRED TO THE ENGINEER BEFORE PROCEEDING WITH THE WORK.

ALL DIMENSIONS ARE IN MILLIMETRES & ALL LEVELS ARE IN METRES, UNO (UNLESS NOTED OTHERWISE). NO DIMENSION SHALL BE OBTAINED BY SCALING THE DRAWINGS.

ALL LEVELS AND SETTING OUT DIMENSIONS SHOWN ON THE DRAWINGS SHALL BE CHECKED ON SITE PRIOR TO THE COMMENCEMENT OF THE WORK.

DURING EXCAVATION WORK THE STRUCTURE SHALL BE MAINTAINED IN A

STABLE AND NO PART SHALL BE OVERSTRESSED. ALL WORK IS TO BE UNDERTAKEN IN ACCORDANCE WITH THE DETAILS SHOWN

EXISTING SERVICES WHERE SHOWN HAVE BEEN PLOTTED FROM SUPPLIED DATA AND SUCH THEIR ACCURACY CAN NOT BE GUARANTEED. IT IS THE RESPONSIBILITY OF THE CONTRACTOR TO ESTABLISH THE LEVEL OF ALL

ALL SERVICE TRENCHES UNDER VEHICULAR PAVEMENTS SHALL BE BACK FILLED IN ACCORDANCE WITH THE REQUIREMENTS OF THE LOCAL COUNCIL.

ALL TRENCH BACK FILL MATERIAL SHALL BE COMPACTED TO THE SAME DENSITY AS THE ADJACENT MATERIAL.

EXISTING SERVICES PRIOR TO THE COMMENCEMENT OF WORK.

ON COMPLETION OF STORMWATER INSTALLATION. ALL DISTURBED AREAS MUST BE RESTORED TO ORIGINAL CONDITION, INCLUDING KERBS, FOOTPATHS, CONCRETE AREAS, GRAVEL AND GRASSED AREAS AND ROAD PAVEMENTS, UNLESS DIRECTED OTHERWISE.

CONTRACTOR TO OBTAIN ALL AUTHORITY APPROVALS UNLESS DIRECTED OTHERWISE.

STORMWATER DRAINAGE

THE ENGINEER FOR APPROVAL.

WIDE X 150 DEEP.

ON THE DRAWINGS & THE SPECIFICATION.

THE STORMWATER DRAINAGE DESIGN HAS BEEN CARRIED OUT IN ACCORDANCE

AS/NZS 3500.3 - 1990 "STORMWATER DRAINAGE" & AS/NZS 3500.3.2-1998 "STORMWATER DRAINAGE - ACCEPTABLE SOLUTIONS".

ANY VARIATIONS TO THE NOMINATED LEVELS SHALL BE REFERRED TO

ENGINEER IMMEDIATELY. ANY VARIATIONS TO SPECIFIED PRODUCTS OR DETAILS SHALL BE REFERRED TO

DOWN PIPES SHALL BE A MINIMUM OF DN100 SW GRADE uPVC OR 100 X 100 COLORBOND OR ZINCALUME STEEL, UNO.

BOX COLORBOND OR ZINCALUME STEEL. GUTTERS SHALL BE A MINIMUM OF 450

EAVES GUTTERS SHALL BE A MINIMUM OF 125 WIDE X 100 DEEP (OR OF EQUIVALENT AREA) COLORBOND OR ZINCALUME STEEL.

SUBSOIL DRAINAGE SHALL BE PROVIDED TO ALL RETAINING WALLS & EMBANKMENTS, WITH THE LINES FEEDING INTO THE STORMWATER DRAINAGE

SEDIMENT AND EROSION CONTROL NOTES

SEDIMENT AND EROSION CONTROL SHALL BE EFFECTIVELY MAINTAINED AT ALL TIMES DURING THE COURSE OF CONSTRUCTION AND SHALL NOT BE REMOVED UNTIL THE SITE HAS BEEN STABILISED OR LANDSCAPED TO THE SUPERINTENDENT'S SATISFACTION

A SINGLE ALL WEATHER ACCESS WAY WILL BE PROVIDED AT THE FRONT OF THE PROPERTY CONSISTING OF 50-75 AGGREGATE OR SIMILAR MATERIAL AT A MINIMUM THICKNESS OF 150 LAID OVER NEEDLE-PUNCHED GEOTEXTILE FABRIC AND CONSTRUCTED PRIOR TO COMMENCEMENT OF WORKS.

SOIL CONSERVATION NOTE

PRIOR TO COMMENCEMENT OF CONSTRUCTION PROVIDE 'SEDIMENT FENCE,' 'SEDIMENT TRAP' AND WASHOUT AREA TO ENSURE THE CAPTURE OF WATER BORNE MATERIAL GENERATED FROM THE SITE.

MAINTAIN THE ABOVE DURING THE COURSE OF CONSTRUCTION, AND CLEAR THE 'SEDIMENT TRAP AFTER EACH STORM.

NOTE: DO NOT SCALE OFF DRAWINGS. REFER TO ARCHITECTURAL PLANS. VERIFY DIMENSIONS ON SITE

_				
_				
	В	20.03.25	REVISED TO SUIT ARCHITECTURALS	B.D.C.
	Α	25.10.24	ISSUED FOR APPROVAL	F.I.
	P1	16.10.24	ISSUED FOR COORDINATION	S.R.
	REV	DATE	DESCRIPTION	BY

COPYRIGHT All rights reserved.

These drawings, plans and specifications and the copyright are the property of Engineering Studio and must not be used, reproduced or copied wholly or in part without the written permission of Engineering Studio.





Email: info@engineeringstudio.com.au | Suite 215-216, 25-27 Solent Cct, Web: www.engineeringstudio.com.au Norwest NSW 2153

PROPOSED CHILDCARE CENTRE LOT 141, 1 FRESHWATER DRIVE, COBBITTY **FOR JECKRA**

SEDIMENT & EROSION CONTROL PLAN

JOB NUMBER:	DWG NUMBER:	ORIGINAL SIZE:
240520	C01.01	A1
DESIGNED BY: S.R.	DATE: OCTOBER 2024	
DRAWN BY: S.S.	SCALE: 1:200 U.N.O.	

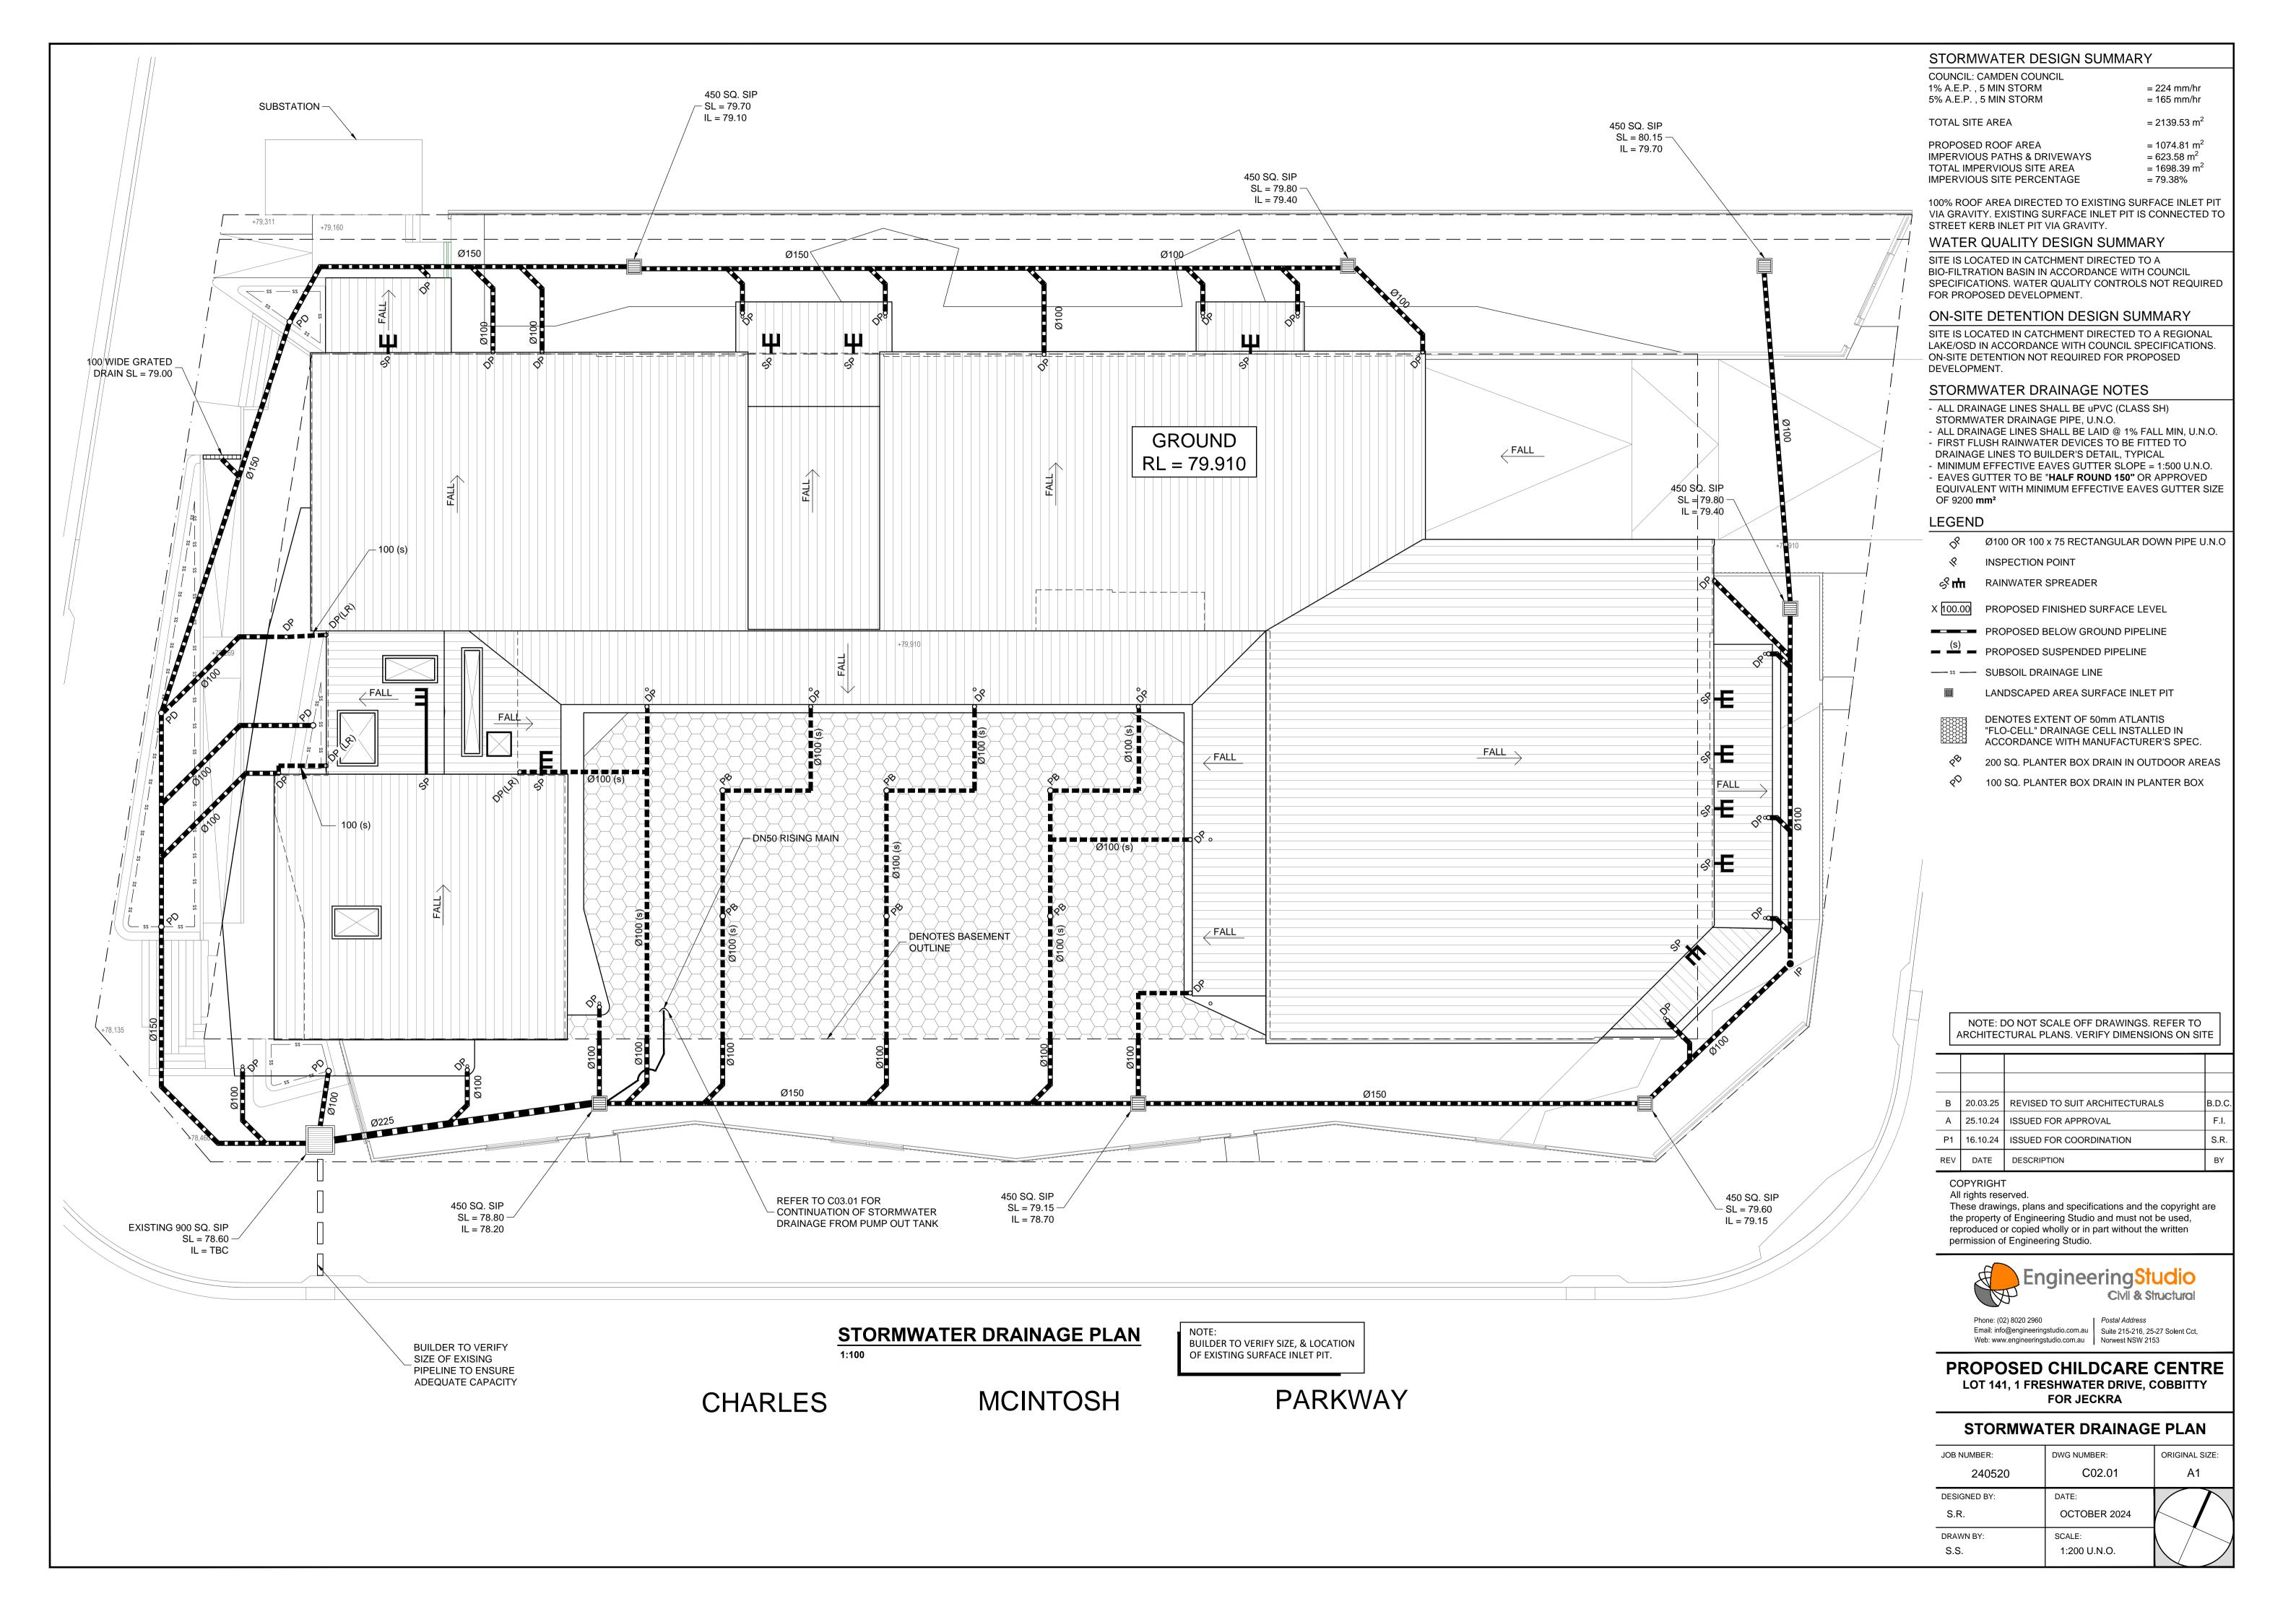

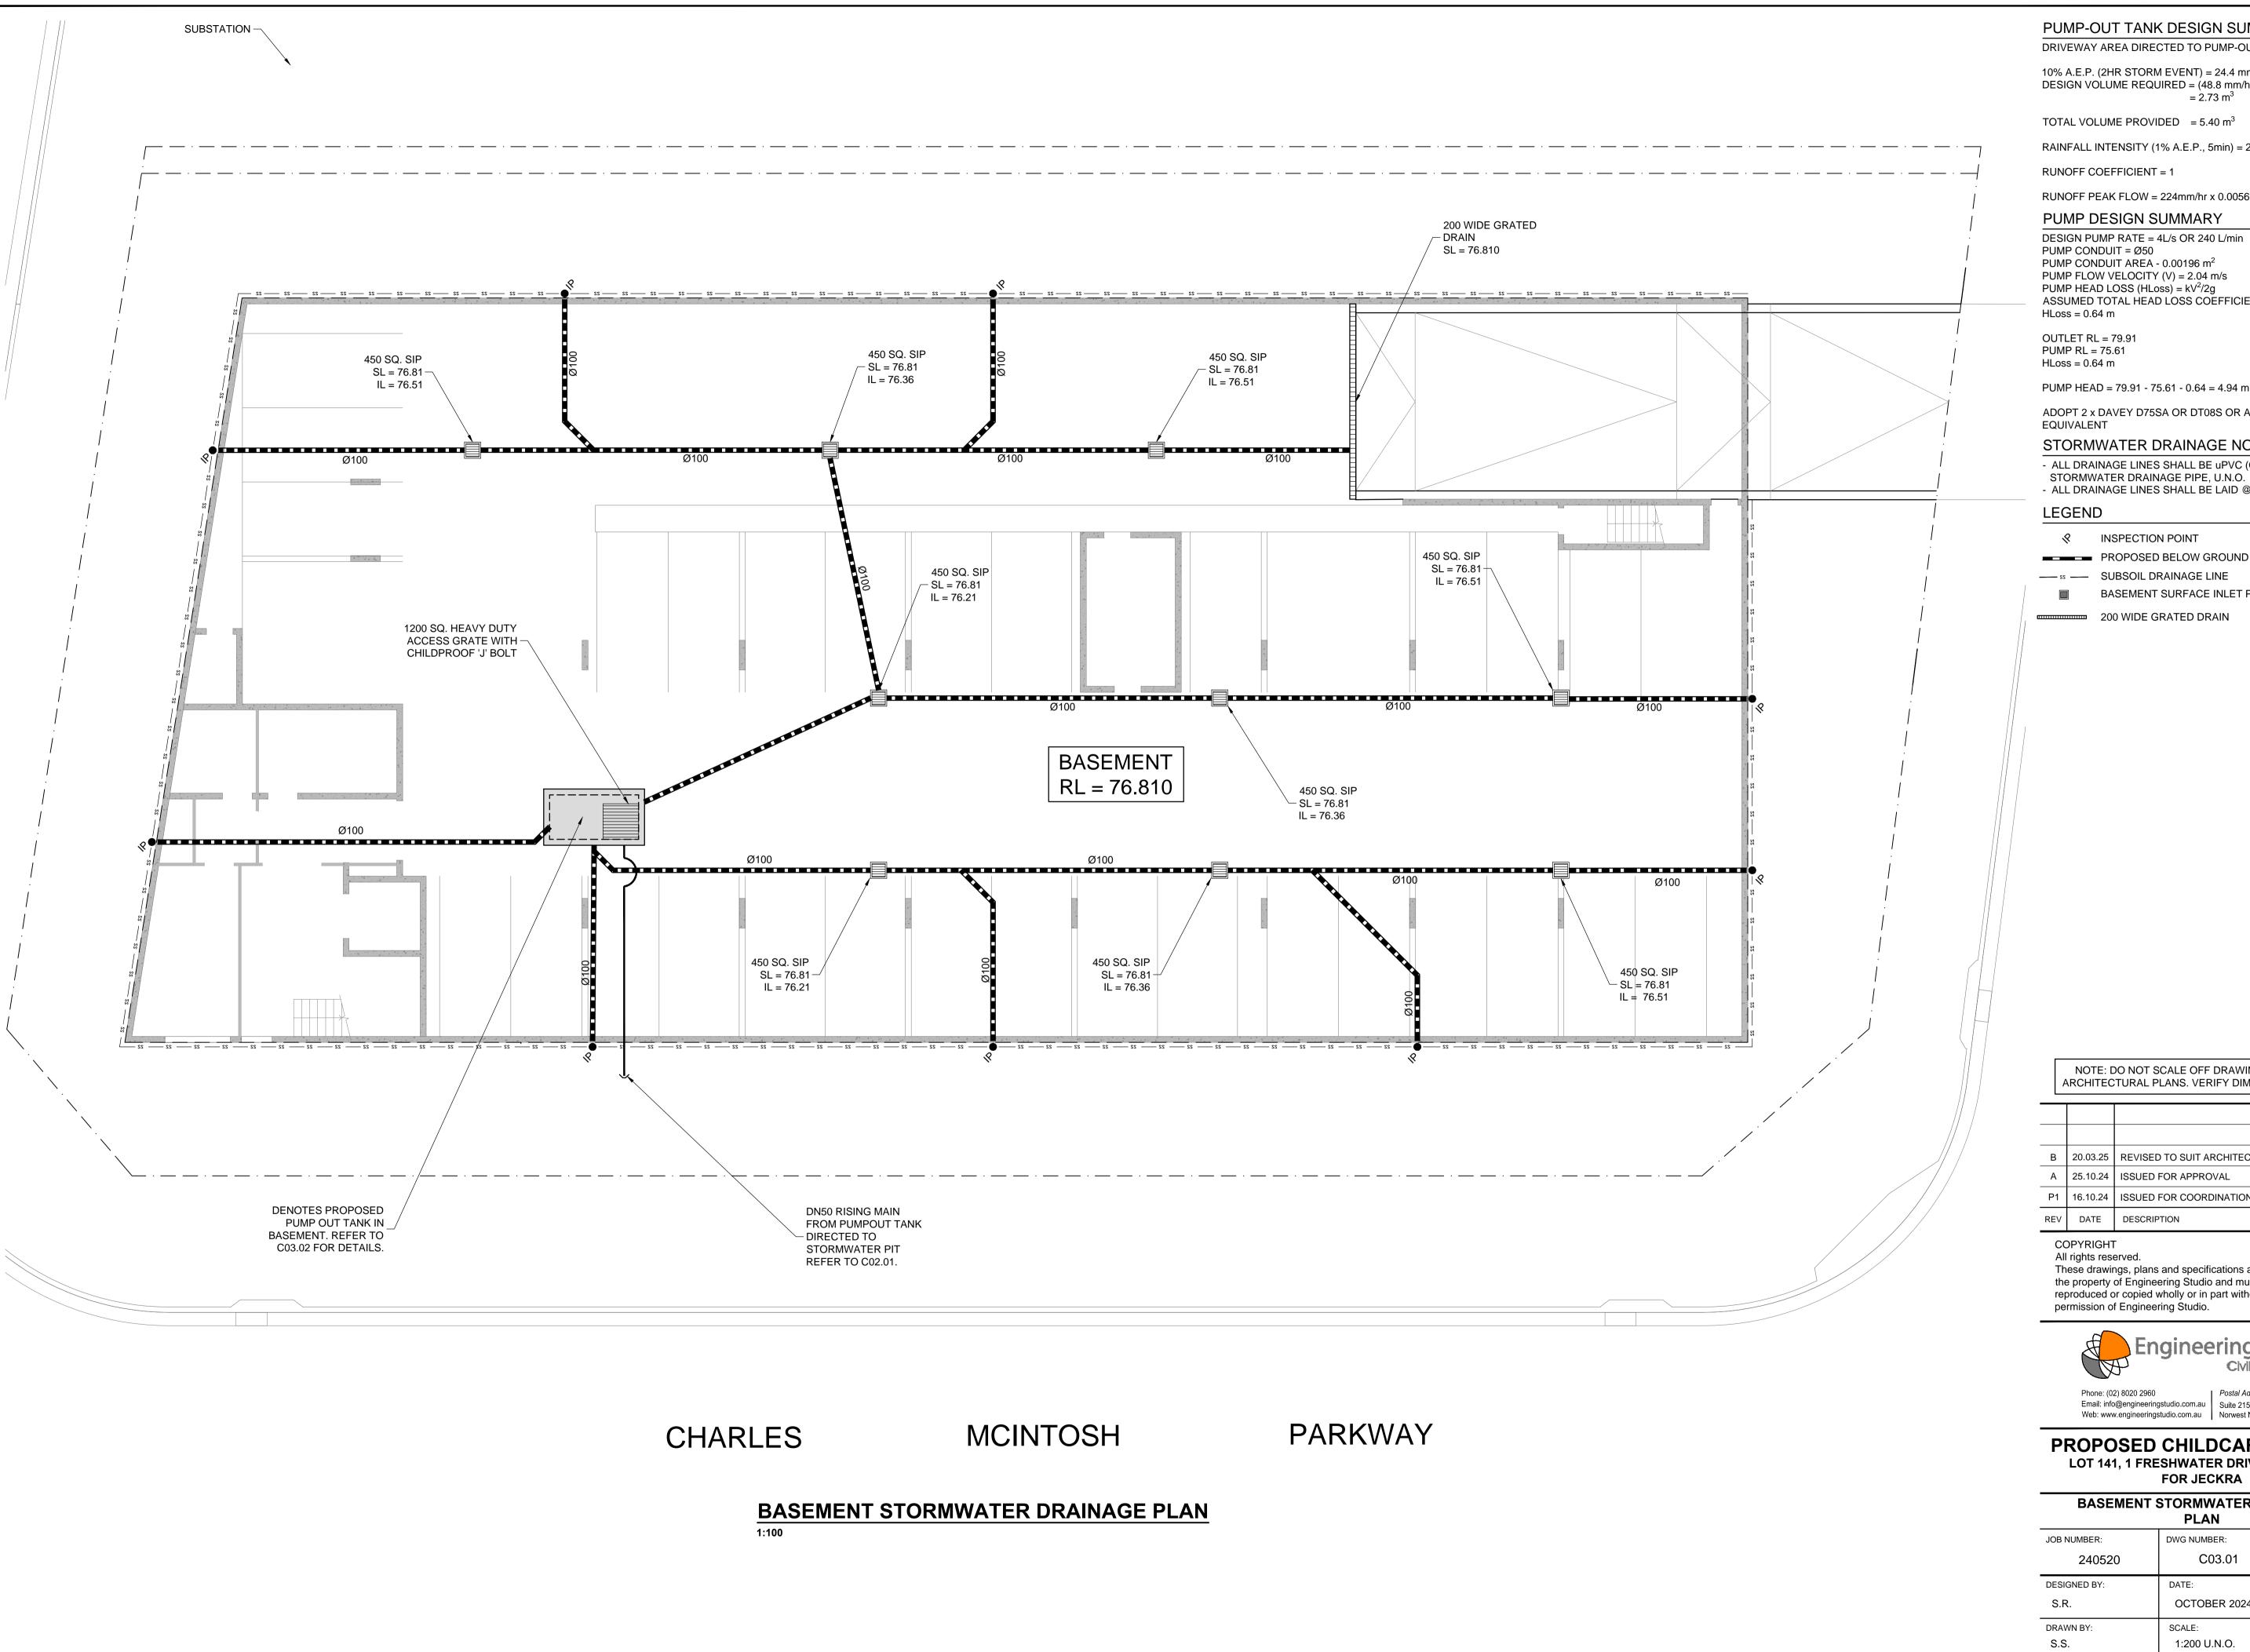

PUMP-OUT TANK DESIGN SUMMARY

DRIVEWAY AREA DIRECTED TO PUMP-OUT TANK = 56.0 m²

10% A.E.P. (2HR STORM EVENT) = 24.4 mm/hr x 2 = 48.8 mm/hr DESIGN VOLUME REQUIRED = $(48.8 \text{ mm/hr x } 56\text{m}^2) / 1000$ $= 2.73 \text{ m}^3$

TOTAL VOLUME PROVIDED = 5.40 m³

RAINFALL INTENSITY (1% A.E.P., 5min) = 224mm/hr

RUNOFF COEFFICIENT = 1

RUNOFF PEAK FLOW = 224mm/hr x 0.0056 / 360 = 3.5 L/s

PUMP DESIGN SUMMARY

PUMP CONDUIT AREA - 0.00196 m² PUMP FLOW VELOCITY (V) = 2.04 m/s PUMP HEAD LOSS (HLoss) = $kV^2/2g$ ASSUMED TOTAL HEAD LOSS COEFFICIENT, k = 3

OUTLET RL = 79.91PUMP RL = 75.61

PUMP HEAD = 79.91 - 75.61 - 0.64 = 4.94 m

ADOPT 2 x DAVEY D75SA OR DT08S OR APPROVED

STORMWATER DRAINAGE NOTES

- ALL DRAINAGE LINES SHALL BE uPVC (CLASS SH)

STORMWATER DRAINAGE PIPE, U.N.O. - ALL DRAINAGE LINES SHALL BE LAID @ 1% FALL MIN, U.N.O.

INSPECTION POINT

PROPOSED BELOW GROUND PIPELINE

BASEMENT SURFACE INLET PIT

200 WIDE GRATED DRAIN

NOTE: DO NOT SCALE OFF DRAWINGS. REFER TO ARCHITECTURAL PLANS. VERIFY DIMENSIONS ON SITE

•					
	В	20.03.25	REVISED TO SUIT ARCHITECTURALS	B.D.C	
	Α	25.10.24	ISSUED FOR APPROVAL	F.I.	
	P1	16.10.24	ISSUED FOR COORDINATION	S.R.	
	REV	DATE	DESCRIPTION	BY	

COPYRIGHT

All rights reserved.

These drawings, plans and specifications and the copyright are the property of Engineering Studio and must not be used, reproduced or copied wholly or in part without the written permission of Engineering Studio.




Email: info@engineeringstudio.com.au
Web: www.engineeringstudio.com.au
Norwest NSW 2153

PROPOSED CHILDCARE CENTRE LOT 141, 1 FRESHWATER DRIVE, COBBITTY

FOR JECKRA BASEMENT STORMWATER DRAINAGE

JOB NUMBER:	DWG NUMBER:	ORIGINAL SIZE:
240520	C03.01	A1
DESIGNED BY:	DATE:	
S.R.	OCTOBER 2024	
DRAWN BY:	SCALE:	
S.S.	1:200 U.N.O.	N / /

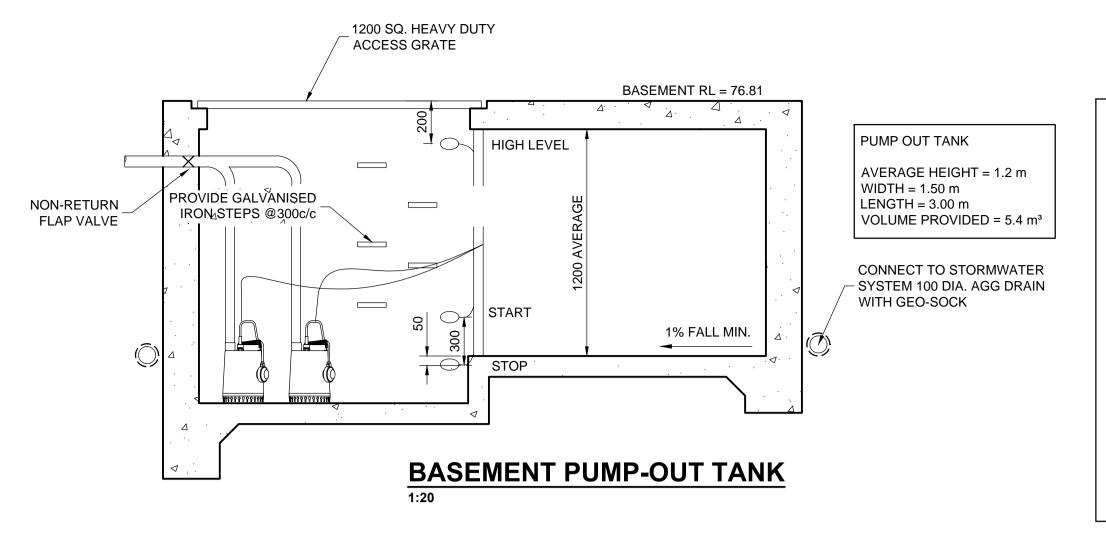


STANDARD PUMP OUT DESIGN NOTES THE PUMP OUT SYSTEM SHALL BE DESIGNED TO BE OPERATED IN THE FOLLOWING MANNER:-

> THE PUMPS SHALL BE PROGRAMMED TO WORK ALTERNATIVELY SO AS TO ALLOW BOTH PUMPS TO HAVE AN EQUAL OPERATION LOAD AND PUMP LIFE.


> A LOW LEVEL FLOAT SHALL BE PROVIDED TO ENSURE THAT THE MINIMUM REQUIRED WATER LEVEL IS MAINTAINED WITHIN THE SUMP AREA OF THE BELOW GROUND TANK. IN THIS REGARD THIS FLOAT WILL FUNCTION AS AN OFF SWITCH FOR THE PUMPS.

> A SECOND FLOAT SHALL BE PROVIDED AT A HIGHER LEVEL, APPROXIMATELY 300mm ABOVE THE MINIMUM WATER LEVEL, WHEREBY ONE OF THE PUMPS WILL OPERATE AND DRAIN THE TANK TO THE LEVEL OF THE LOW-LEVEL FLOAT.


> A THIRD FLOAT SHALL BE PROVIDED AT A HIGH LEVEL, WHICH IS APPROXIMATELY THE ROOF LEVEL OF THE BELOW GROUND TANK. THIS FLOAT SHOULD START THE OTHER PUMP THAT IS NOT OPERATING AND ACTIVATE THE ALARM.

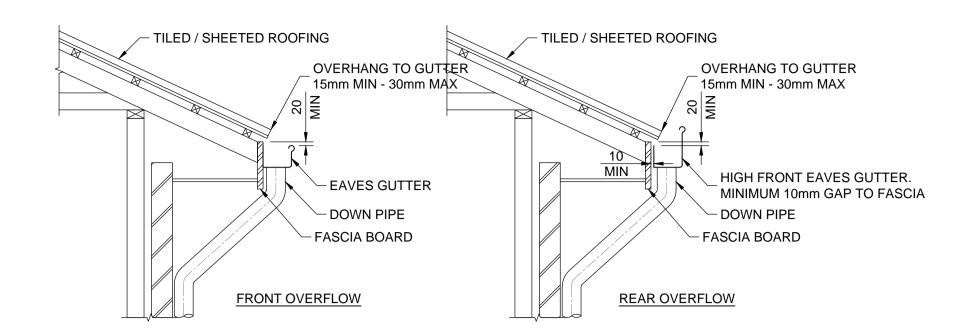


TYPICAL EAVES GUTTER DETAIL

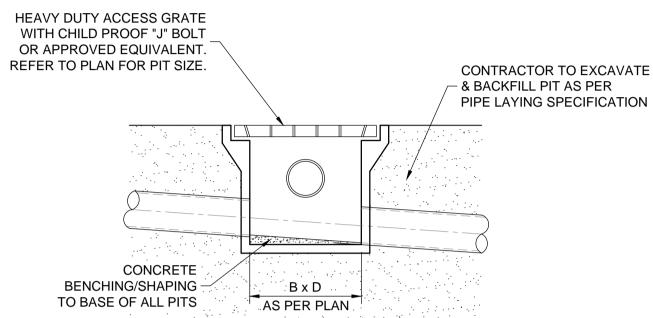



BASEMENT SURFACE INLET PIT DETAIL

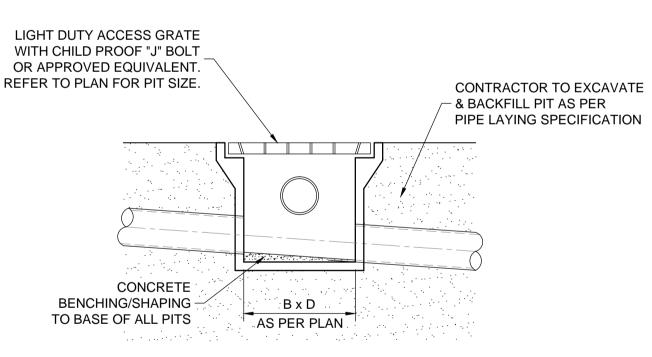


LANDSCAPE AREAS SURFACE INLET PIT DETAIL

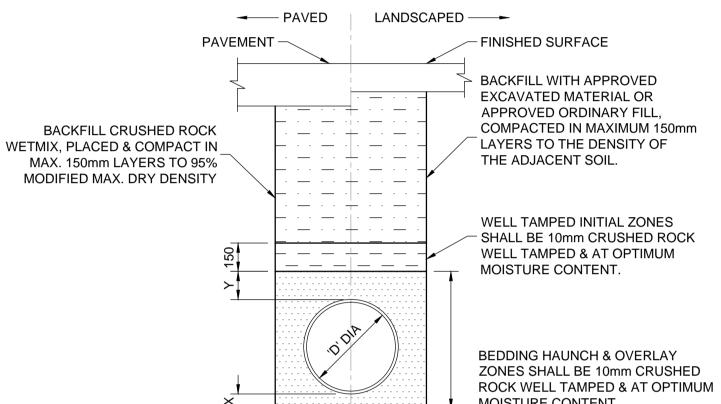

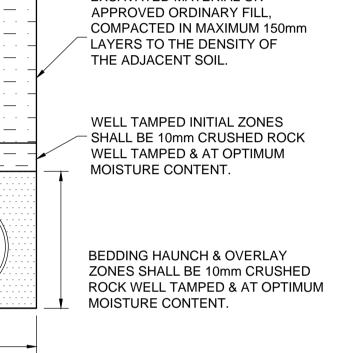

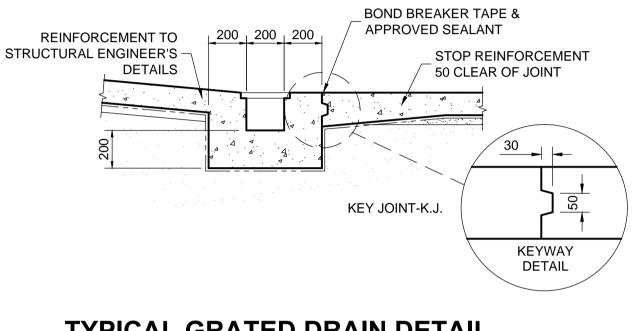




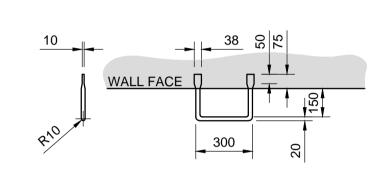


1. FIRST RUNG 150mm DOWN FROM TOP, THEN SPACED AT 300 CENTRES.

2. STEP IRON MATERIAL, 20m DIAMETER MILD STEEL, HEAVY GALVANISED.


STEP IRONS FOR DRAINAGE PITS

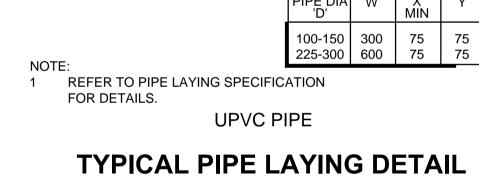


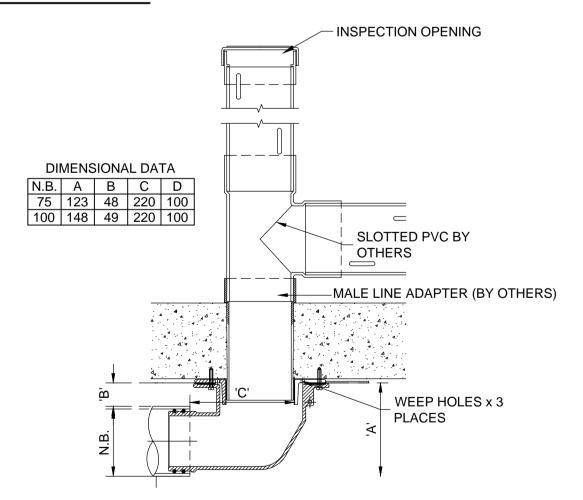

TYPICAL 100 SQ. PLANTER BOX DRAIN 'PD'

SPECIFICATION CODE: C100/90 A 100mm SIDE OUTLET

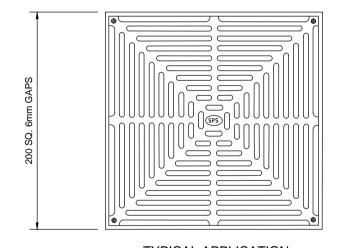

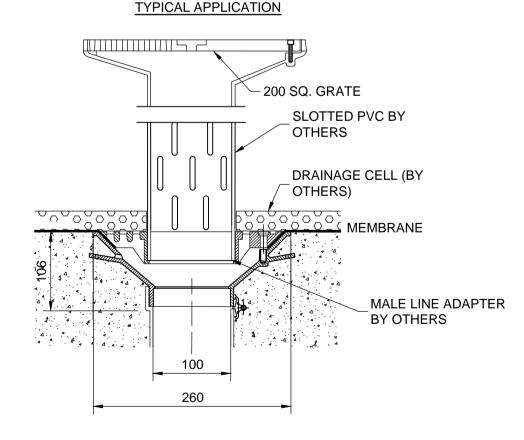

TYPICAL PLANTER BOX 'PB' DRAIN

1:5

SPECIFICATION CODE:

TIA100PB (100MM CI BODY WITH PLANTER BOX ADAPTER) TIA150PB (150MM CI BODY WITH PLANTER BOX ADAPTER)

NOTE: DO NOT SCALE OFF DRAWINGS. REFER TO ARCHITECTURAL PLANS. VERIFY DIMENSIONS ON SITE B 20.03.25 REVISED TO SUIT ARCHITECTURALS A 25.10.24 ISSUED FOR APPROVAL

COPYRIGHT

REV DATE

All rights reserved. These drawings, plans and specifications and the copyright are the property of Engineering Studio and must not be used,

reproduced or copied wholly or in part without the written permission of Engineering Studio.

P1 | 16.10.24 | ISSUED FOR COORDINATION

DESCRIPTION



Email: info@engineeringstudio.com.au Suite 215-216, 25-27 Solent Cct,

Web: www.engineeringstudio.com.au Norwest NSW 2153

PROPOSED CHILDCARE CENTRE **LOT 141, 1 FRESHWATER DRIVE, COBBITTY FOR JECKRA**

STORMWATER DETAILS SHEET

JOB NUMBER:	DWG NUMBER:	ORIGINAL SIZE:
240520	C03.02	A1
DESIGNED BY: S.R.	DATE: OCTOBER 2024	
DRAWN BY: S.S.	SCALE: 1:20 U.N.O.	

