

ADJOINS SHEET 19

SCOPE  
PROJECT  
OUTSIDE



ADJOINS SHEET 27



THIS PLAN IS INTENDED FOR DESIGN PURPOSES ONLY. IT DOES NOT REPLACE PLANS ISSUED BY UTILITY PROVIDERS THROUGH THE "DIAL BEFORE YOU DIG" SERVICE. CONTRACTORS ARE REMINDED OF THEIR OWN "DUTY OF CARE" & SHOULD CONDUCT THEIR OWN "DIAL BEFORE YOU DIG" PRIOR TO EXCAVATION/CONSTRUCTION.


\*\*\*\* WARNING: SERVICE PROVIDERS MAY SHARE CONDUITS &/OR TRENCHES AT THIS LOCATION \*\*\*\*

\*\*\*\* WARNING: UNKNOWN SERVICES MAY EXIST THAT COULD NOT BE ELECTRONICALLY DETECTED. SERVICE PROVIDER DIAGRAMS MAY NOT DEPICT ALL ASSETS WITHIN THEIR NETWORK \*\*\*\*

\*\*\*\* WARNING: SINGLE LINES MAY REPRESENT MULTIPLE CONDUITS, PIPES &/OR CABLES AT THIS LOCATION \*\*\*\*

#### UTILITY POSITIONING CLASSIFICATION

- A – VALIDATED, MEASURED DIRECTLY TO UTILITY (QL-A)
- B – TRACED, ELECTRONIC DETECTION OF UTILITY (QL-B)
- C – ALIGNED, TO UTILITY SURFACE FEATURES (QL-C)
- D – INDICATIVE, AS PER DIAGRAMS/FEATURES (QL-D)

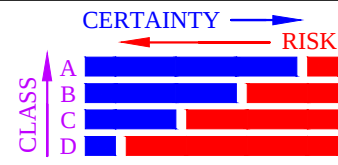

DENOTES EXTENT OF INVESTIGATION AREA.




INVESTIGATION ISSUE, SEE COMMENTS ON SHEET.

FOR SCHEDULE OF AMENDMENTS SEE SHEET 1 TABLE

SCALE 1:200

@A2

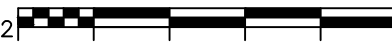

ALL DISTANCES IN METRES

CLIENT: – APIAN GROUP

LOCATERS REFERENCE:  
140623

ADJOINS SHEET 32

#### IMPORTANT REMINDER:

UTILITIES INDICATED AS CLASS "B", "C" & "D" MAY BE INACCURATE IN BOTH VERTICAL & HORIZONTAL ALIGNMENTS.

UTILITY LINES PLOTTED ARE INTERPOLATED BETWEEN POINTS THAT HAVE BEEN GENERATED DURING THE UTILITY INVESTIGATION PROCESS. THE UPC IS SPECIFIC TO THE POINT AT WHICH IT IS INSERTED ON A LINE AND IS NOT A CLASSIFICATION OF THE LINE ITSELF.



Add us to your contacts

Prepared By:



locating - surveying - consulting

www.locaters.com.au

THIS PLAN MUST BE READ IN CONJUNCTION WITH SHEET 1 AND SHEET 2 FOR ADDITIONAL NOTES, WARNINGS & LEGEND.

CLIENT REGISTRATION No: N/A

#### SUB-SURFACE UTILITY INFORMATION


PLAN SHOWING UNDERGROUND UTILITIES AS INVESTIGATED & SURVEYED OVER  
WYONG HOSPITAL  
KANWAL

DATUM: A.H.D

SCALE: 1:200 @ A2

SHEET 26 OF 45

ISSUE: F

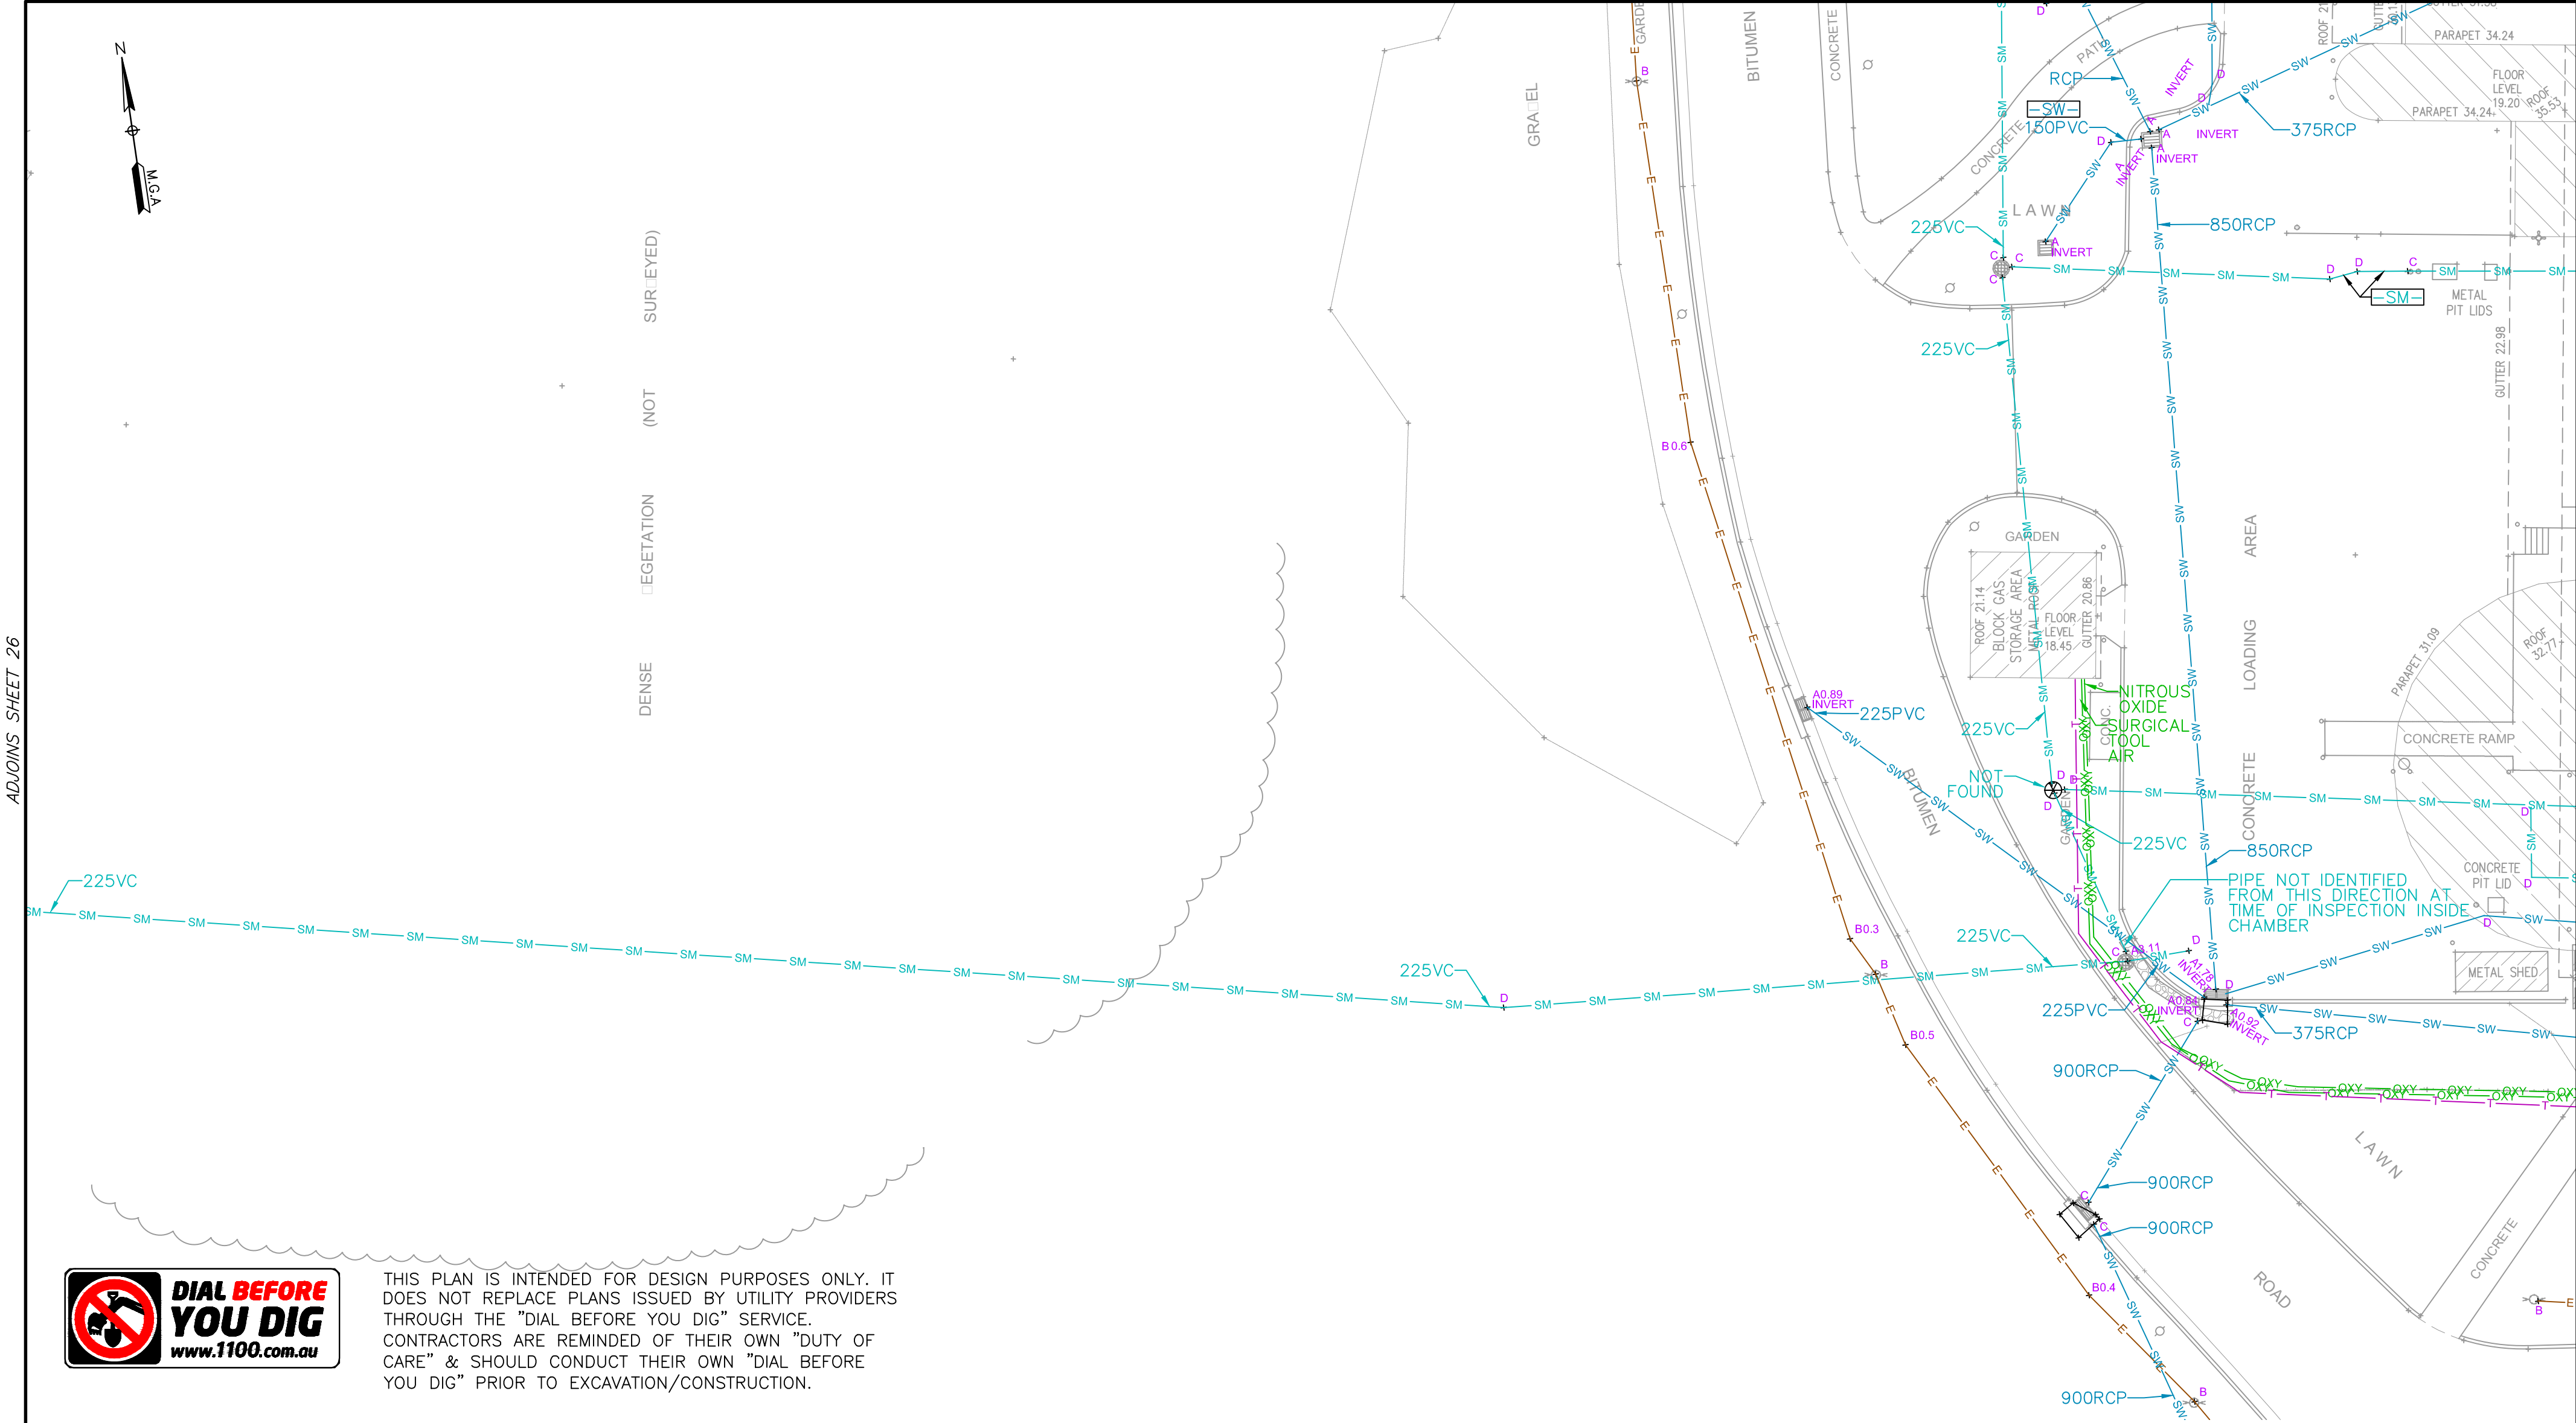

THIS PLAN IS INTENDED FOR DESIGN PURPOSES ONLY. IT DOES NOT REPLACE PLANS ISSUED BY UTILITY PROVIDERS THROUGH THE "DIAL BEFORE YOU DIG" SERVICE. CONTRACTORS ARE REMINDED OF THEIR OWN "DUTY OF CARE" & SHOULD CONDUCT THEIR OWN "DIAL BEFORE YOU DIG" PRIOR TO EXCAVATION/CONSTRUCTION.

\*\*\*\* WARNING: SERVICE PROVIDERS MAY SHARE CONDUITS &/OR TRENCHES AT THIS LOCATION \*\*\*\*

\*\*\*\* WARNING: UNKNOWN SERVICES MAY EXIST THAT COULD NOT BE ELECTRONICALLY DETECTED. SERVICE PROVIDER DIAGRAMS MAY NOT DEPICT ALL ASSETS WITHIN THEIR NETWORK \*\*\*\*

\*\*\*\* WARNING: SINGLE LINES MAY REPRESENT MULTIPLE CONDUITS, PIPES &/OR CABLES AT THIS LOCATION \*\*\*\*

| UTILITY POSITIONING CLASSIFICATION |                                                | CERTAINTY |           |
|------------------------------------|------------------------------------------------|-----------|-----------|

DENOTES EXTENT OF INVESTIGATION AREA.

INVESTIGATION ISSUE, SEE COMMENTS ON SHEET.

|                                              |                            |
|----------------------------------------------|----------------------------|
| FOR SCHEDULE OF AMENDMENTS SEE SHEET 1 TABLE |                            |
| SCALE 1:200                                  | ALL DISTANCES IN METRES    |
| CLIENT: - APPIAN GROUP                       | LOCATERS REFERENCE: 140623 |

**IMPORTANT REMINDER:**

UTILITIES INDICATED AS CLASS "B","C"&"D" MAY BE INACCURATE IN BOTH VERTICAL & HORIZONTAL ALIGNMENTS.

UTILITY LINES PLOTTED ARE INTERPOLATED BETWEEN POINTS THAT HAVE BEEN GENERATED DURING THE UTILITY INVESTIGATION PROCESS. THE UPC IS SPECIFIC TO THE POINT AT WHICH IT IS INSERTED ON A LINE AND IS NOT A CLASSIFICATION OF THE LINE ITSELF.





Prepared By:

**Locaters**  
UTILITY SURVEYS  
locating - surveying - consulting  
[www.locaters.com.au](http://www.locaters.com.au)

THIS PLAN MUST BE READ IN CONJUNCTION WITH SHEET 1 AND SHEET 2 FOR ADDITIONAL NOTES, WARNINGS & LEGEND.

|                                                                                          |                   |                |          |
|------------------------------------------------------------------------------------------|-------------------|----------------|----------|
| CLIENT REGISTRATION No: N/A                                                              |                   |                |          |
| SUB-SURFACE UTILITY INFORMATION                                                          |                   |                |          |
| PLAN SHOWING UNDERGROUND UTILITIES AS INVESTIGATED & SURVEYED OVER WYONG HOSPITAL KANWAL |                   |                |          |
| DATUM: A.H.D                                                                             | SCALE: 1:200 @ A2 | SHEET 27 OF 45 | ISSUE: F |

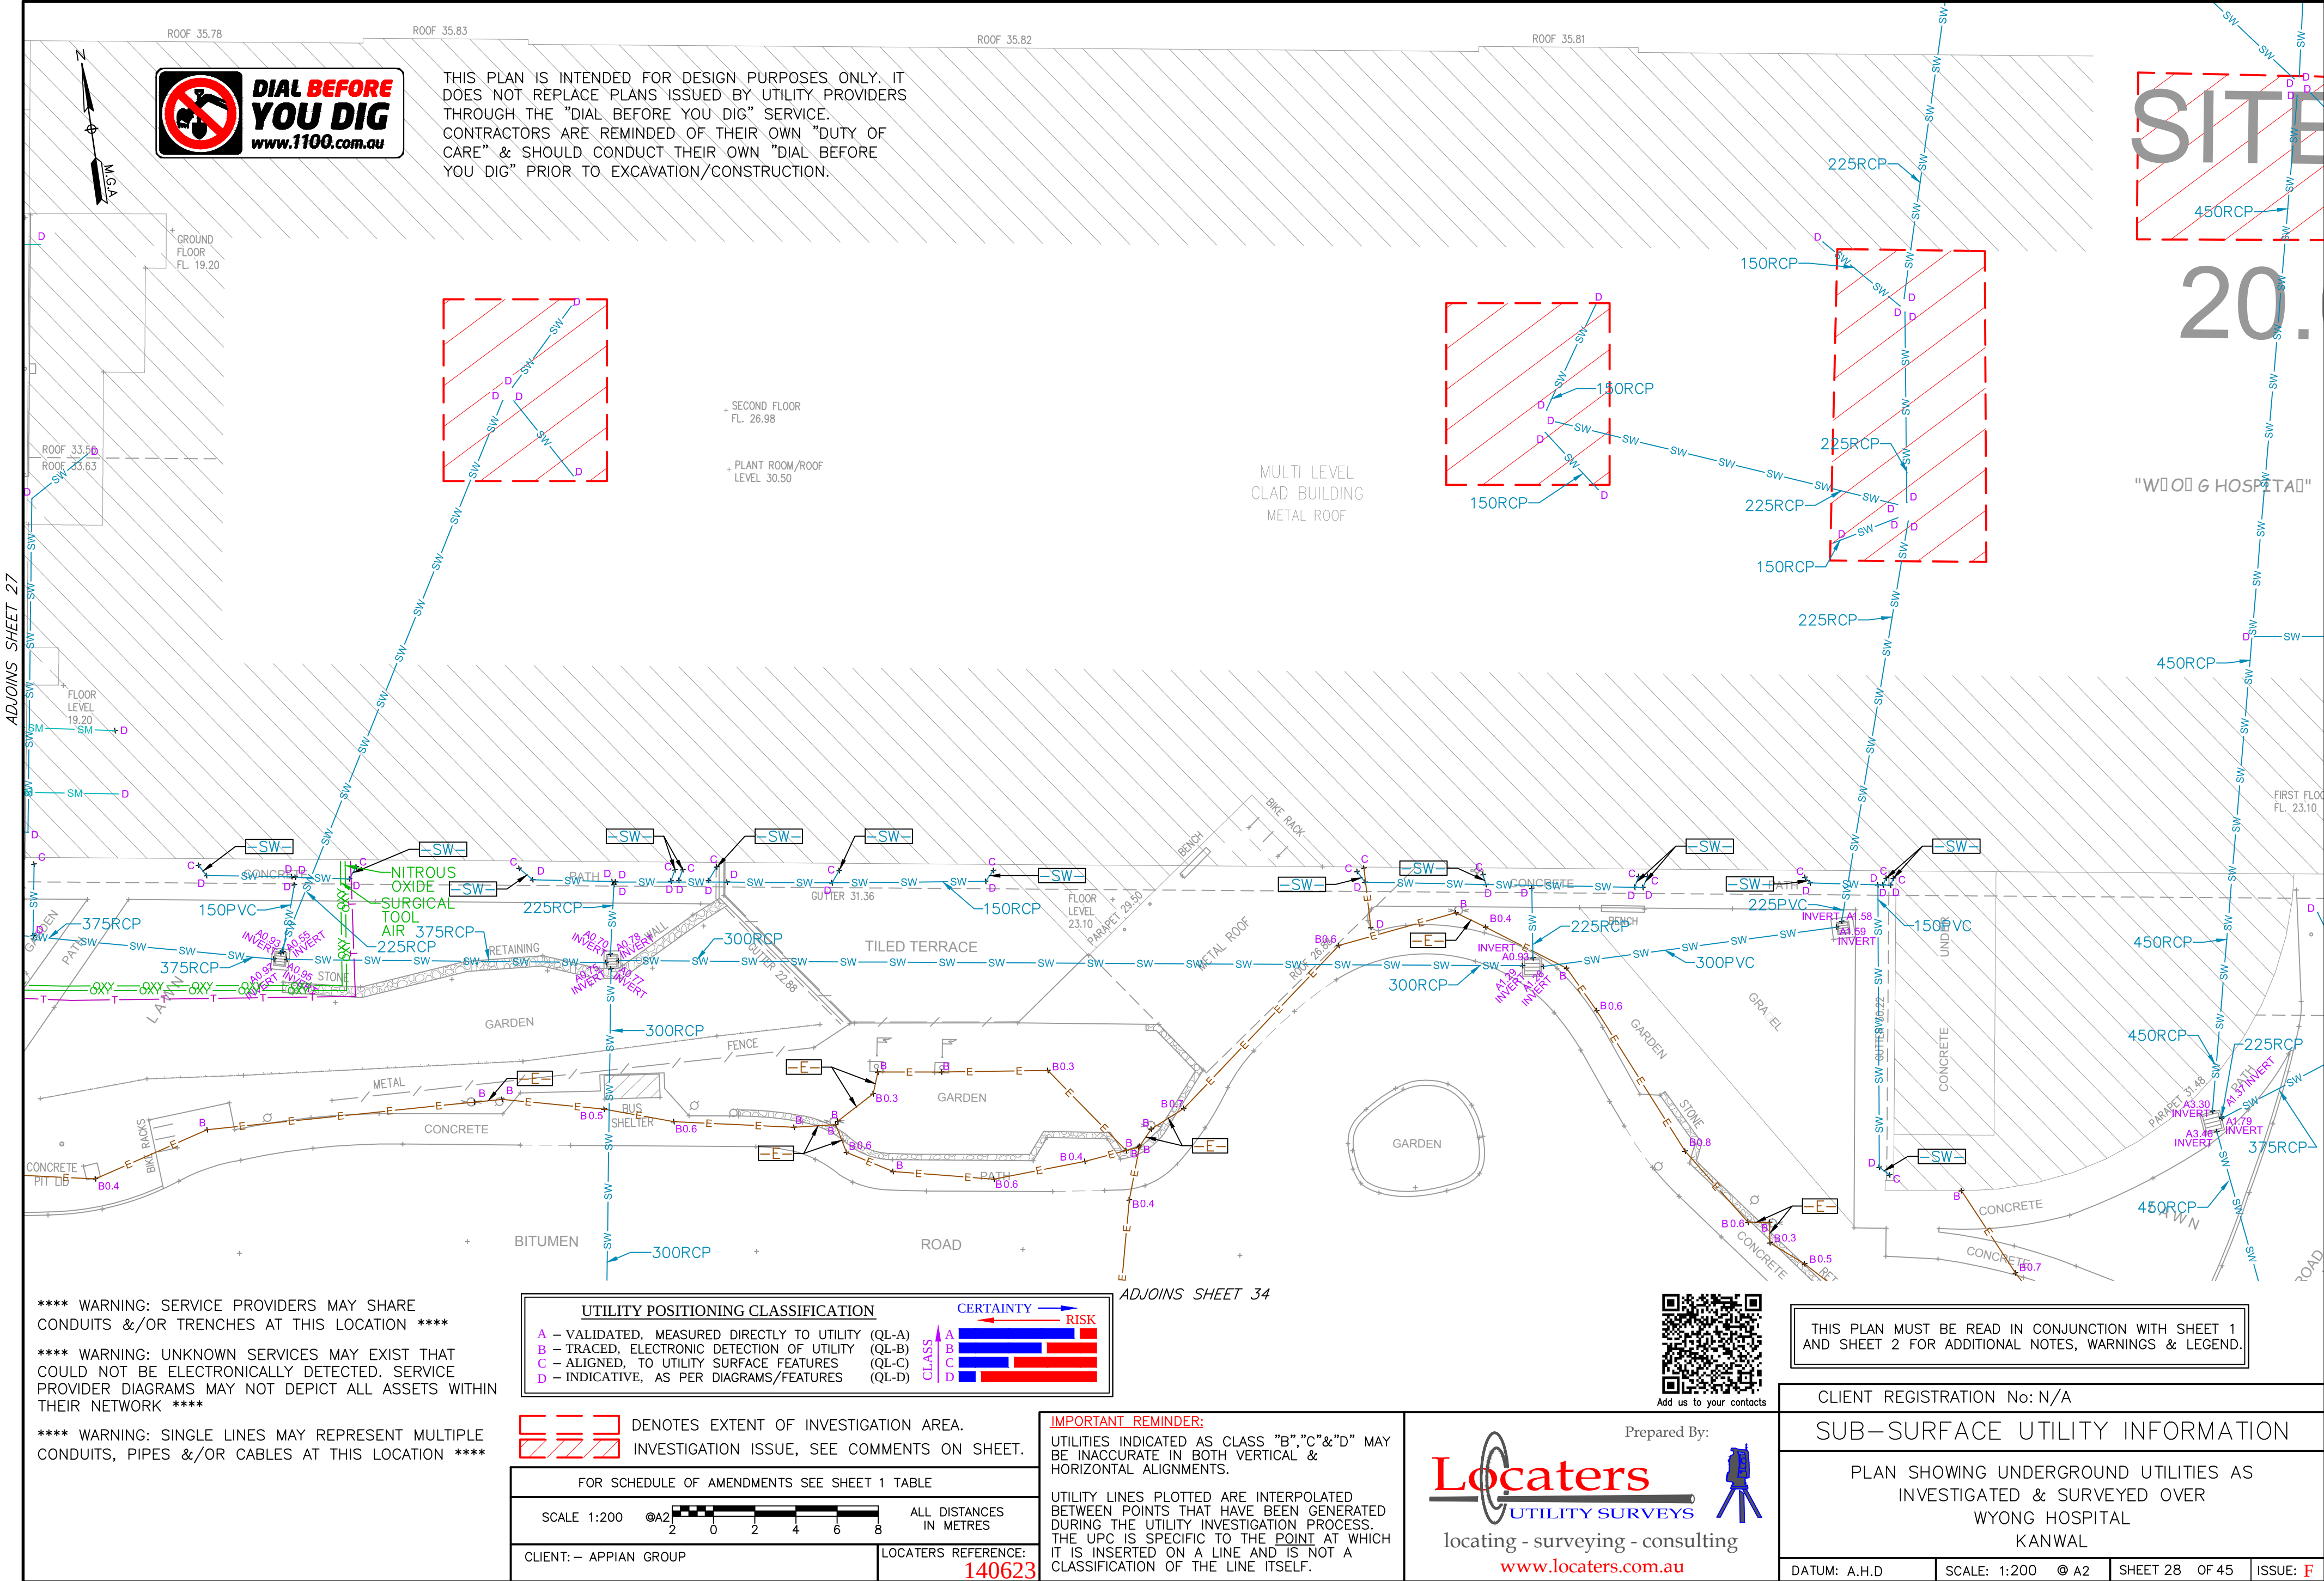

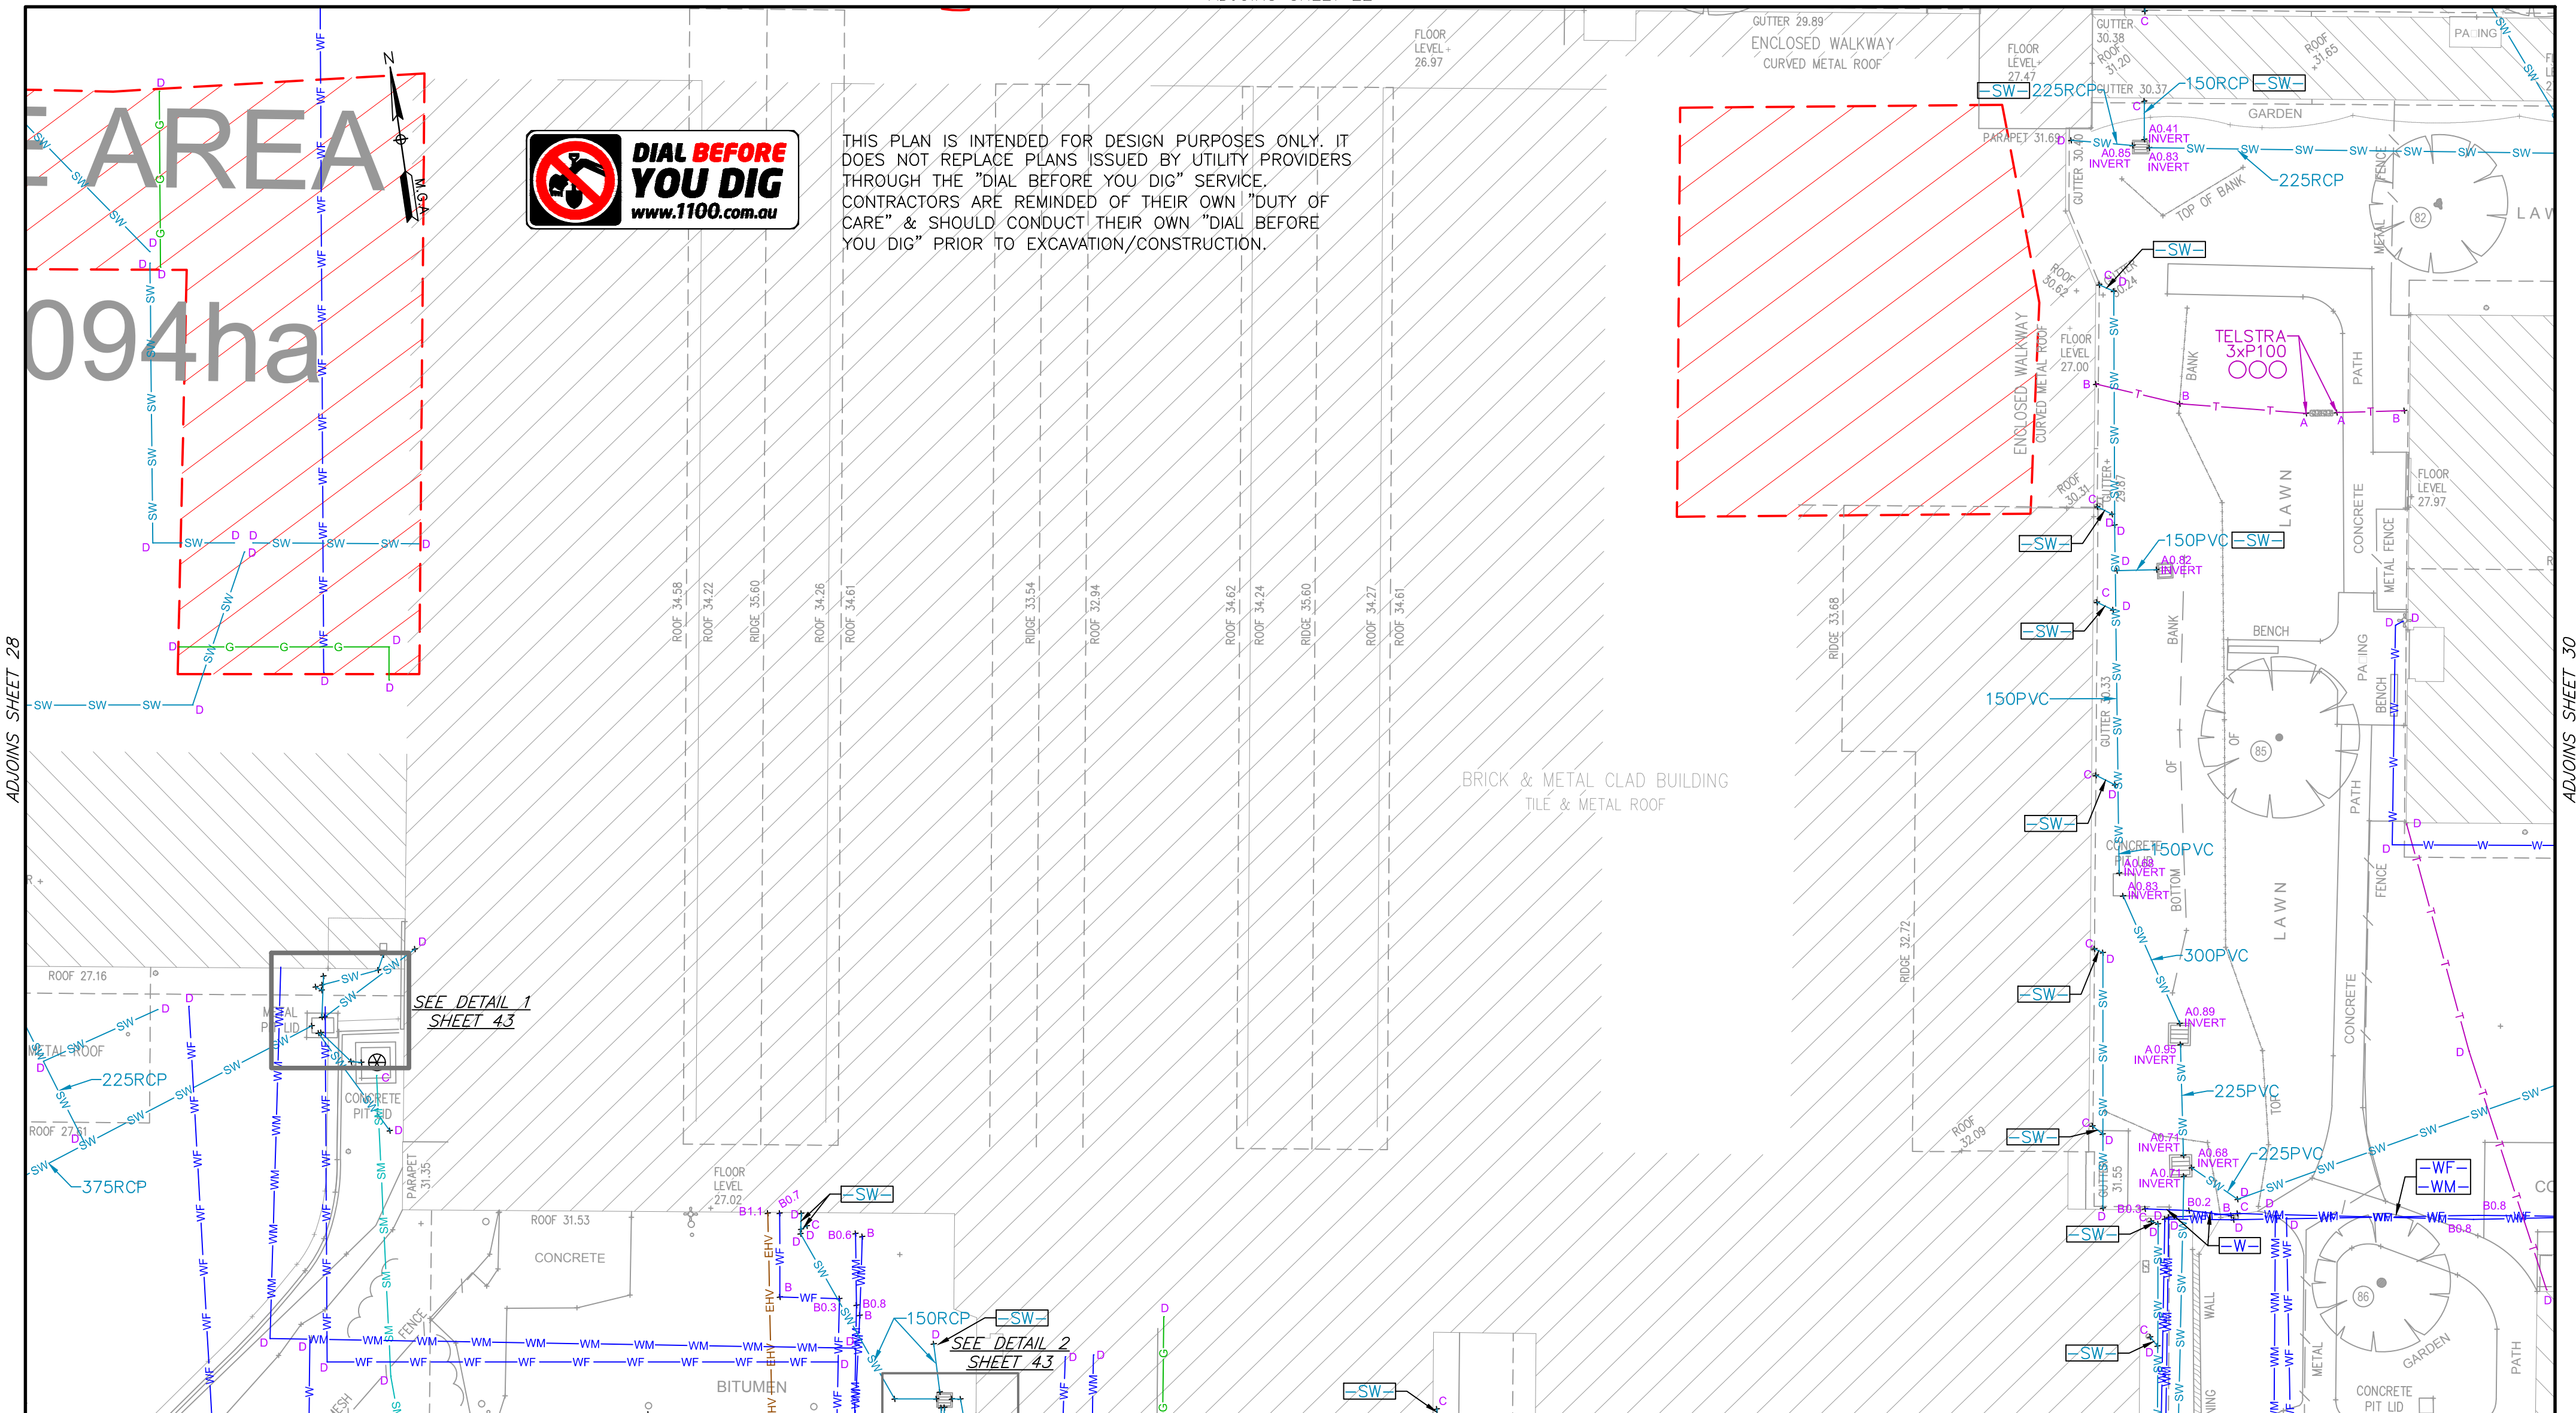

\*\*\*\* WARNING: SINGLE LINES MAY REPRESENT MULTIPLE  
CONDUITS, PIPES &/OR CABLES AT THIS LOCATION \*\*\*\*

| UTILITY POSITIONING CLASSIFICATION |                                                  | CERTAINTY → | ← RISK |
|------------------------------------|--------------------------------------------------|-------------|--------|
| A                                  | - VALIDATED, MEASURED DIRECTLY TO UTILITY (QL-A) |             |        |
| B                                  | - TRACED, ELECTRONIC DETECTION OF UTILITY (QL-B) |             |        |
| C                                  | - ALIGNED, TO UTILITY SURFACE FEATURES (QL-C)    |             |        |
| D                                  | - INDICATIVE, AS PER DIAGRAMS/FEATURES (QL-D)    |             |        |

 DENOTES EXTENT OF INVESTIGATION AREA.  
 INVESTIGATION ISSUE, SEE COMMENTS ON SHEET.

|                                              |                                                                                      |
|----------------------------------------------|--------------------------------------------------------------------------------------|
| FOR SCHEDULE OF AMENDMENTS SEE SHEET 1 TABLE |                                                                                      |
| SCALE 1:200                                  |  |
| CLIENT: - APIIAN GROUP                       | LOCATER'S REFERENCE:<br><span style="color: red;">140623</span>                      |

UTILITY LINES PLOTTED ARE INTERPOLATED  
BETWEEN POINTS THAT HAVE BEEN GENERATED  
DURING THE UTILITY INVESTIGATION PROCESS.  
THE UPC IS SPECIFIC TO THE POINT AT WHICH  
IT IS INSERTED ON A LINE AND IS NOT A  
CLASSIFICATION OF THE LINE ITSELF.



Add us to your contacts


THIS PLAN MUST BE READ IN CONJUNCTION WITH SHEET 1  
AND SHEET 2 FOR ADDITIONAL NOTES, WARNINGS & LEGEND.

CLIENT REGISTRATION No: N/A

SUB-SURFACE UTILITY INFORMATION

PLAN SHOWING UNDERGROUND UTILITIES AS  
INVESTIGATED & SURVEYED OVER  
WYONG HOSPITAL  
KANWAL

|              |                   |                |                 |
|--------------|-------------------|----------------|-----------------|
| DATUM: A.H.D | SCALE: 1:200 @ A2 | SHEET 29 OF 45 | ISSUE: <b>F</b> |
|--------------|-------------------|----------------|-----------------|

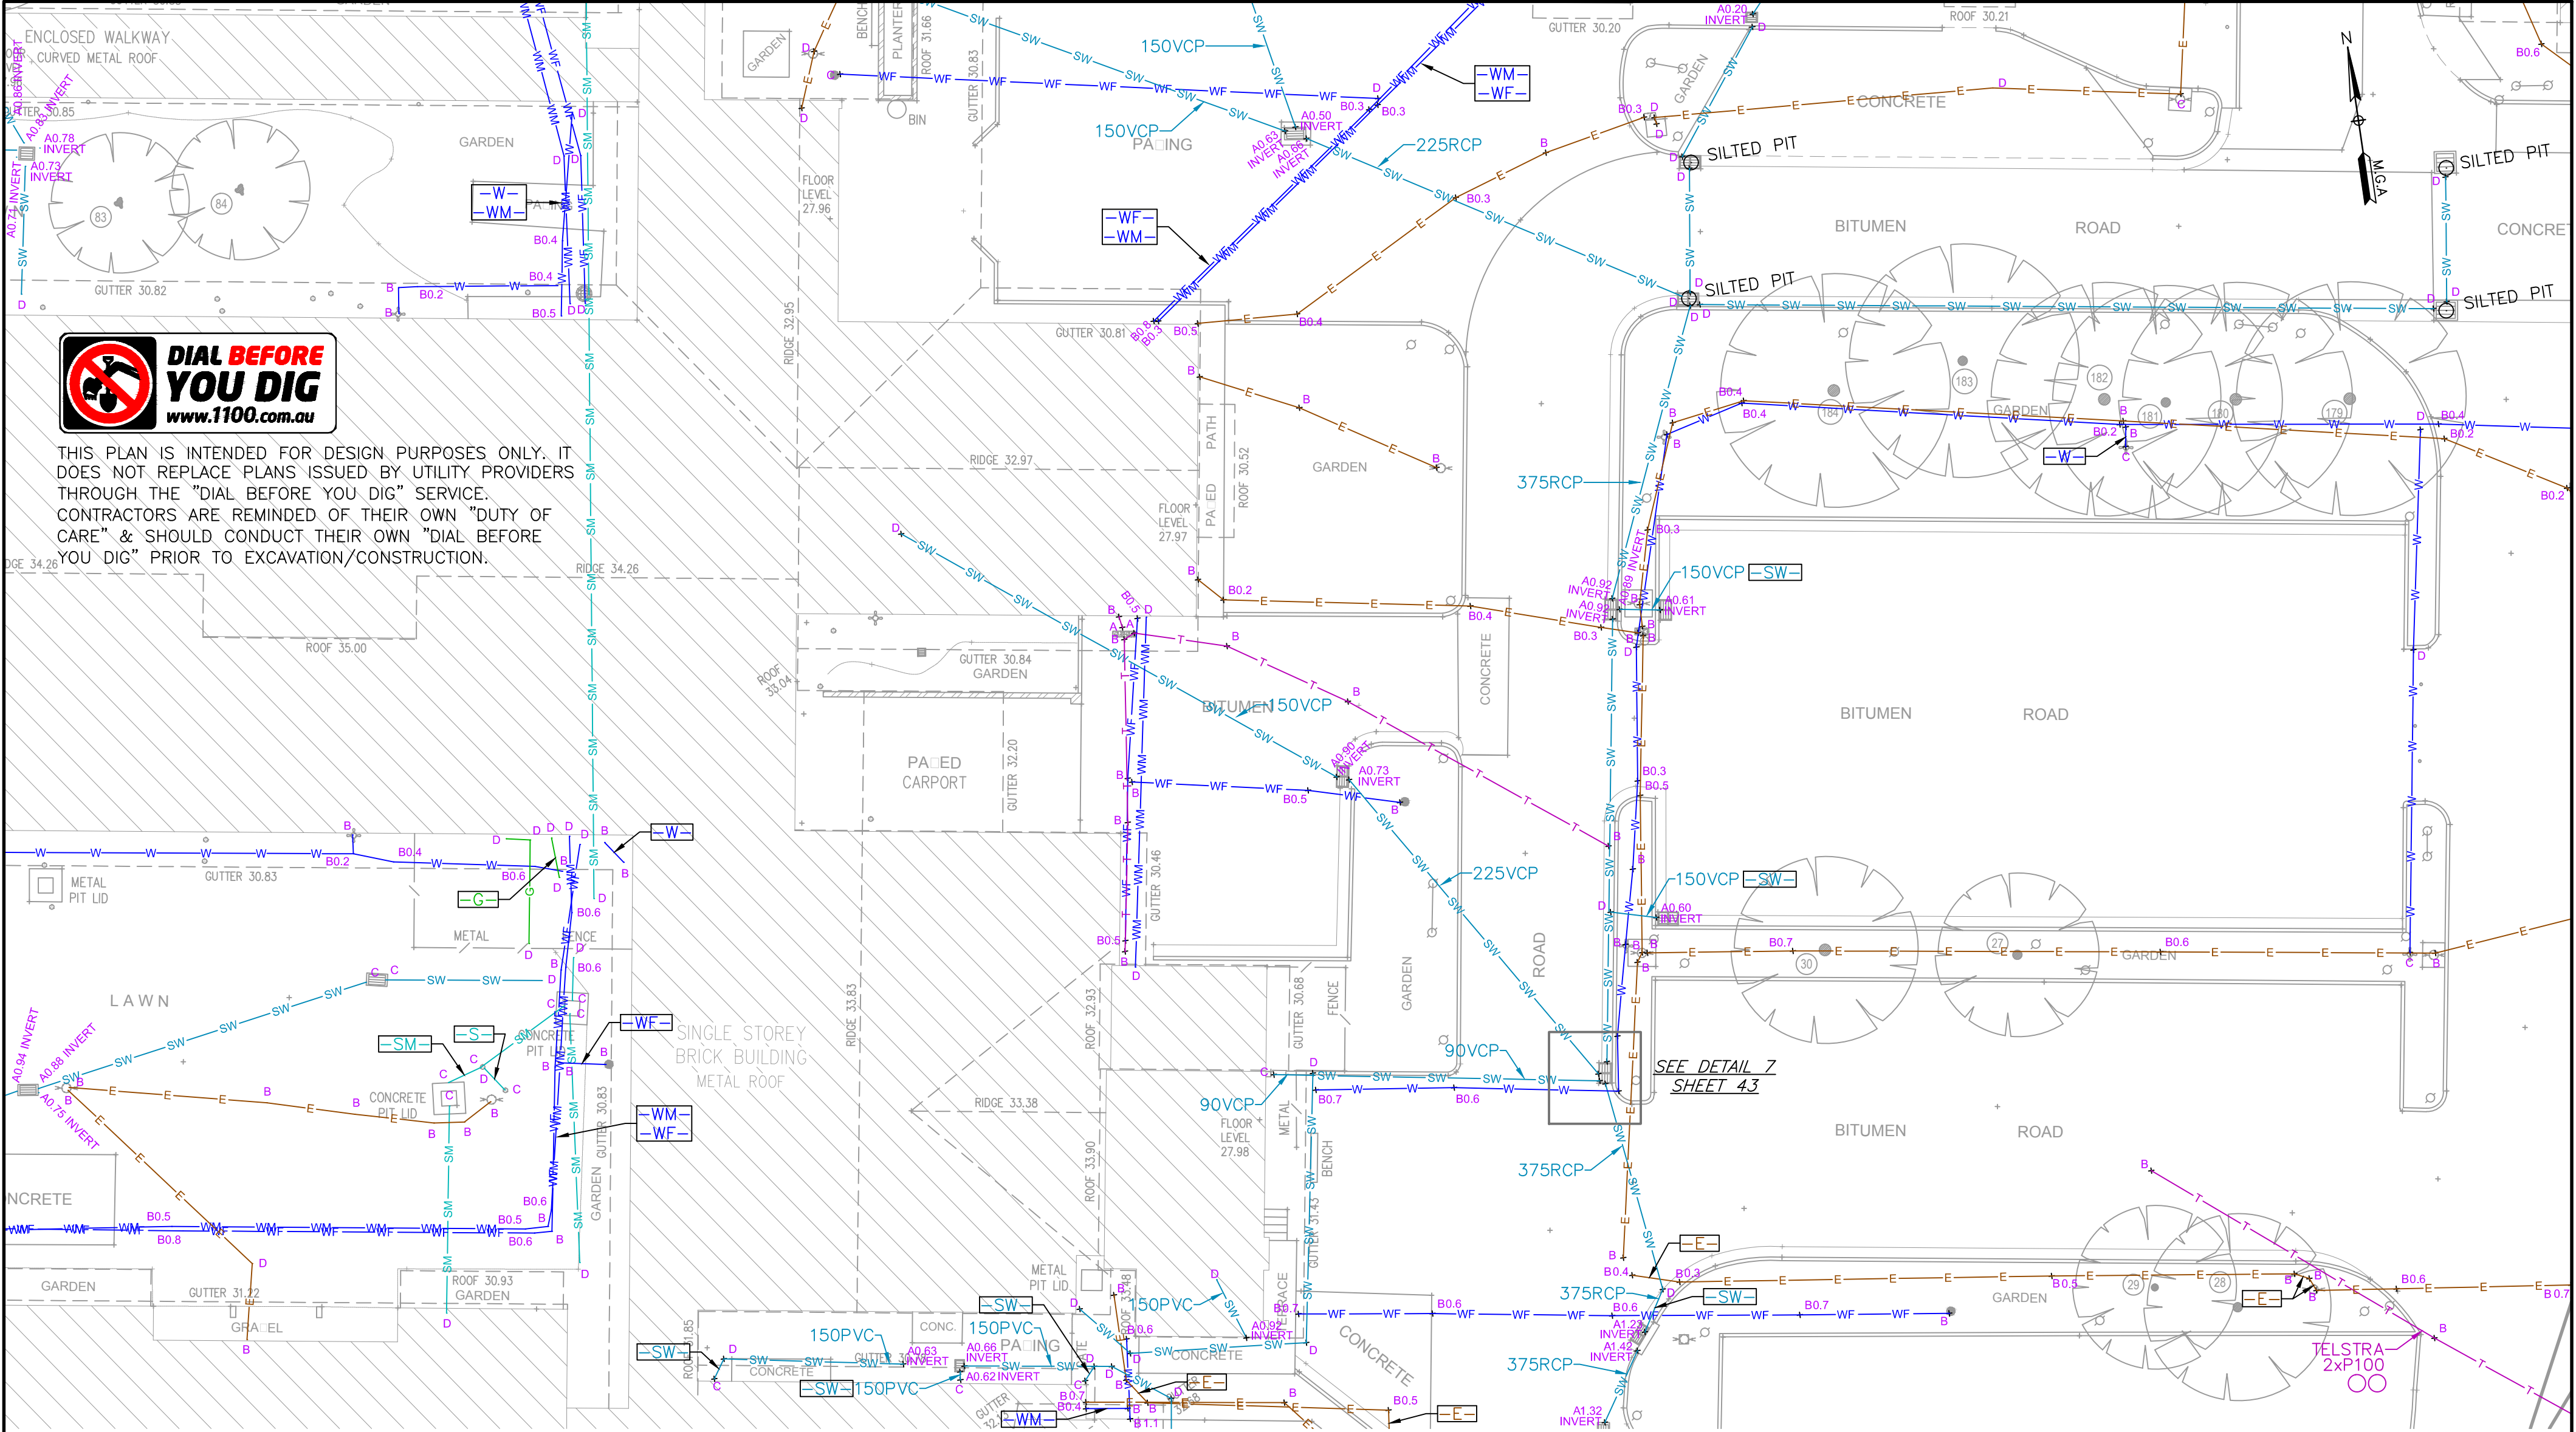

\*\*\*\* WARNING: SERVICE PROVIDERS MAY SHARE CONDUITS &/OR TRENCHES AT THIS LOCATION \*\*\*\*

\*\*\*\* WARNING: UNKNOWN SERVICES MAY EXIST THAT COULD NOT BE ELECTRONICALLY DETECTED. SERVICE PROVIDER DIAGRAMS MAY NOT DEPICT ALL ASSETS WITHIN THEIR NETWORK \*\*\*\*

\*\*\*\* WARNING: SINGLE LINES MAY REPRESENT MULTIPLE CONDUITS, PIPES &/OR CABLES AT THIS LOCATION \*\*\*\*

| UTILITY POSITIONING CLASSIFICATION |                                                | CERTAINTY | RISK      |
|------------------------------------|------------------------------------------------|-----------|-----------|
| A                                  | VALIDATED, MEASURED DIRECTLY TO UTILITY (QL-A) | High      | Low       |
| B                                  | TRACED, ELECTRONIC DETECTION OF UTILITY (QL-B) | Medium    | Medium    |
| C                                  | ALIGNED, TO UTILITY SURFACE FEATURES (QL-C)    | Low       | High      |
| D                                  | INDICATIVE, AS PER DIAGRAMS/FEATURES (QL-D)    | Very Low  | Very High |

 DENOTES EXTENT OF INVESTIGATION AREA.  
INVESTIGATION ISSUE, SEE COMMENTS ON SHEET.

FOR SCHEDULE OF AMENDMENTS SEE SHEET 1 TABLE

SCALE 1:200  ALL DISTANCES IN METRES

CLIENT: - APPIAN GROUP


LOCATORS REFERENCE: 140623

**IMPORTANT REMINDER:**

UTILITIES INDICATED AS CLASS "B", "C" & "D" MAY BE INACCURATE IN BOTH VERTICAL & HORIZONTAL ALIGNMENTS.


UTILITY LINES PLOTTED ARE INTERPOLATED BETWEEN POINTS THAT HAVE BEEN GENERATED DURING THE UTILITY INVESTIGATION PROCESS. THE UPC IS SPECIFIC TO THE POINT AT WHICH IT IS INSERTED ON A LINE AND IS NOT A CLASSIFICATION OF THE LINE ITSELF.

**Locaters**  
UTILITY SURVEYS  
locating - surveying - consulting  
[www.locaters.com.au](http://www.locaters.com.au)

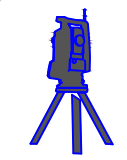Prepared By: 

THIS PLAN MUST BE READ IN CONJUNCTION WITH SHEET 1 AND SHEET 2 FOR ADDITIONAL NOTES, WARNINGS & LEGEND.

|                                                                                          |                   |                |          |
|------------------------------------------------------------------------------------------|-------------------|----------------|----------|
| CLIENT REGISTRATION No: N/A                                                              |                   |                |          |
| SUB-SURFACE UTILITY INFORMATION                                                          |                   |                |          |
| PLAN SHOWING UNDERGROUND UTILITIES AS INVESTIGATED & SURVEYED OVER WYONG HOSPITAL KANWAL |                   |                |          |
| DATUM: A.H.D                                                                             | SCALE: 1:200 @ A2 | SHEET 30 OF 45 | ISSUE: F |

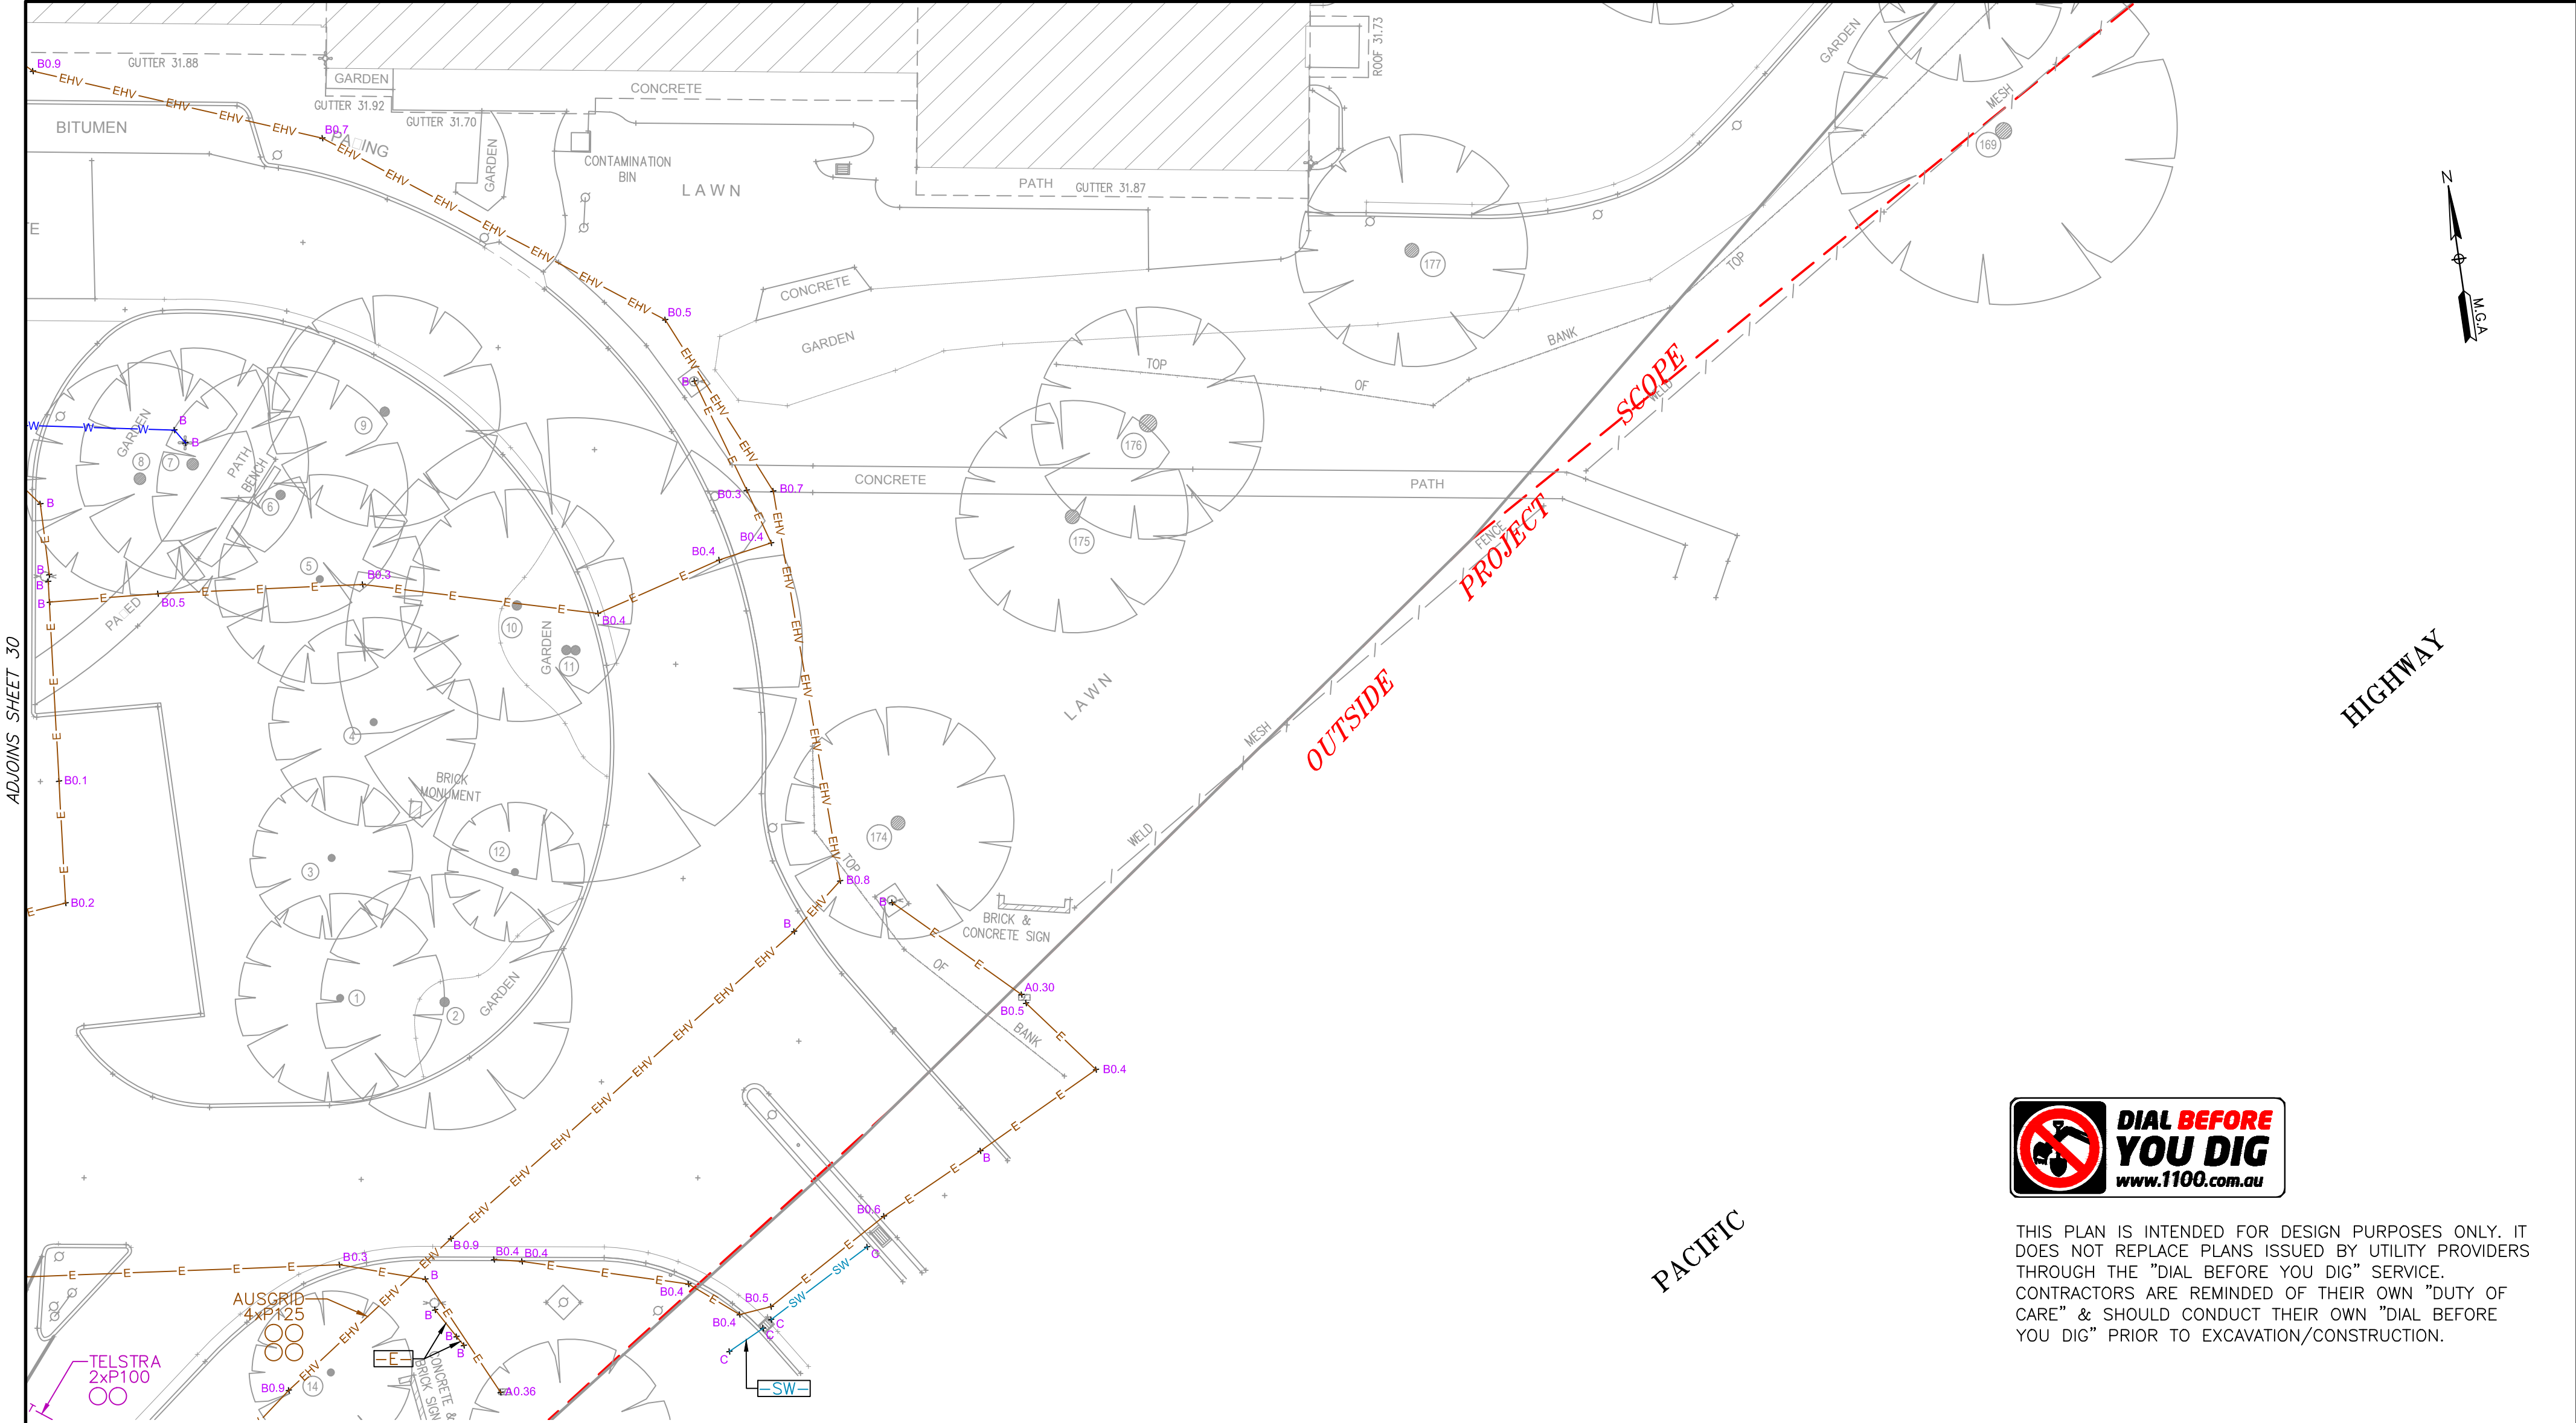

ADJOINS SHEET 30

HIGHWAY

PACIFIC



THIS PLAN IS INTENDED FOR DESIGN PURPOSES ONLY. IT DOES NOT REPLACE PLANS ISSUED BY UTILITY PROVIDERS THROUGH THE "DIAL BEFORE YOU DIG" SERVICE. CONTRACTORS ARE REMINDED OF THEIR OWN "DUTY OF CARE" & SHOULD CONDUCT THEIR OWN "DIAL BEFORE YOU DIG" PRIOR TO EXCAVATION/CONSTRUCTION.

\*\*\*\* WARNING: SERVICE PROVIDERS MAY SHARE CONDUITS &/OR TRENCHES AT THIS LOCATION \*\*\*\*

\*\*\*\* WARNING: UNKNOWN SERVICES MAY EXIST THAT COULD NOT BE ELECTRONICALLY DETECTED. SERVICE PROVIDER DIAGRAMS MAY NOT DEPICT ALL ASSETS WITHIN THEIR NETWORK \*\*\*\*

\*\*\*\* WARNING: SINGLE LINES MAY REPRESENT MULTIPLE CONDUITS, PIPES &/OR CABLES AT THIS LOCATION \*\*\*\*

| UTILITY POSITIONING CLASSIFICATION |                                                | CERTAINTY — RISK |                                     |
|------------------------------------|------------------------------------------------|------------------|-------------------------------------|
| A                                  | VALIDATED, MEASURED DIRECTLY TO UTILITY (QL-A) | A                | High Certainty / Low Risk           |
| B                                  | TRACED, ELECTRONIC DETECTION OF UTILITY (QL-B) | B                | Medium Certainty / Medium Risk      |
| C                                  | ALIGNED, TO UTILITY SURFACE FEATURES (QL-C)    | C                | Low Certainty / High Risk           |
| D                                  | INDICATIVE, AS PER DIAGRAMS/FEATURES (QL-D)    | D                | Very Low Certainty / Very High Risk |

[[[ DENOTES EXTENT OF INVESTIGATION AREA.  
[[[ INVESTIGATION ISSUE, SEE COMMENTS ON SHEET.

| FOR SCHEDULE OF AMENDMENTS SEE SHEET 1 TABLE |                            |
|----------------------------------------------|----------------------------|
| SCALE 1:200                                  | ALL DISTANCES IN METRES    |
| CLIENT: — APPIAN GROUP                       | LOCATORS REFERENCE: 140623 |

**IMPORTANT REMINDER:**  
UTILITIES INDICATED AS CLASS "B","C"&"D" MAY BE INACCURATE IN BOTH VERTICAL & HORIZONTAL ALIGNMENTS.  
UTILITY LINES PLOTTED ARE INTERPOLATED BETWEEN POINTS THAT HAVE BEEN GENERATED DURING THE UTILITY INVESTIGATION PROCESS. THE UPC IS SPECIFIC TO THE POINT AT WHICH IT IS INSERTED ON A LINE AND IS NOT A CLASSIFICATION OF THE LINE ITSELF.



Add us to your contacts

Prepared By:

**Locators**  
UTILITY SURVEYS  
locating - surveying - consulting  
[www.locators.com.au](http://www.locators.com.au)

THIS PLAN MUST BE READ IN CONJUNCTION WITH SHEET 1 AND SHEET 2 FOR ADDITIONAL NOTES, WARNINGS & LEGEND.

|                                                                                          |                   |                |          |
|------------------------------------------------------------------------------------------|-------------------|----------------|----------|
| CLIENT REGISTRATION No: N/A                                                              |                   |                |          |
| SUB—SURFACE UTILITY INFORMATION                                                          |                   |                |          |
| PLAN SHOWING UNDERGROUND UTILITIES AS INVESTIGATED & SURVEYED OVER WYONG HOSPITAL KANWAL |                   |                |          |
| DATUM: A.H.D                                                                             | SCALE: 1:200 © A2 | SHEET 31 OF 45 | ISSUE: F |



SCOPE  
PROJECT  
OUTSIDE

\*\*\*\* WARNING: SERVICE PROVIDERS MAY SHARE CONDUITS &/OR TRENCHES AT THIS LOCATION \*\*\*\*

\*\*\*\* WARNING: UNKNOWN SERVICES MAY EXIST THAT COULD NOT BE ELECTRONICALLY DETECTED. SERVICE PROVIDER DIAGRAMS MAY NOT DEPICT ALL ASSETS WITHIN THEIR NETWORK \*\*\*\*

\*\*\*\* WARNING: SINGLE LINES MAY REPRESENT MULTIPLE CONDUITS, PIPES &/OR CABLES AT THIS LOCATION \*\*\*\*

UTILITY POSITIONING CLASSIFICATION

A

B

C

D

– VALIDATED, MEASURED DIRECTLY TO UTILITY (QL-A)

– TRACED, ELECTRONIC DETECTION OF UTILITY (QL-B)

– ALIGNED, TO UTILITY SURFACE FEATURES (QL-C)

– INDICATIVE, AS PER DIAGRAMS/FEATURES (QL-D)

CERTAINTY

RISK

A

B

C

D

DENOTES EXTENT OF INVESTIGATION AREA.

INVESTIGATION ISSUE, SEE COMMENTS ON SHEET.

FOR SCHEDULE OF AMENDMENTS SEE SHEET 1 TABLE

SCALE 1:200

ALL DISTANCES IN METRES

CLIENT: – APPIAN GROUP

LOCATERS REFERENCE: 140623

IMPORTANT REMINDER:

UTILITIES INDICATED AS CLASS "B","C"&"D" MAY BE INACCURATE IN BOTH VERTICAL & HORIZONTAL ALIGNMENTS.

UTILITY LINES PLOTTED ARE INTERPOLATED BETWEEN POINTS THAT HAVE BEEN GENERATED DURING THE UTILITY INVESTIGATION PROCESS. THE UPC IS SPECIFIC TO THE POINT AT WHICH IT IS INSERTED ON A LINE AND IS NOT A CLASSIFICATION OF THE LINE ITSELF.

ADJOINS SHEET 38



THIS PLAN IS INTENDED FOR DESIGN PURPOSES ONLY. IT DOES NOT REPLACE PLANS ISSUED BY UTILITY PROVIDERS THROUGH THE "DIAL BEFORE YOU DIG" SERVICE. CONTRACTORS ARE REMINDED OF THEIR OWN "DUTY OF CARE" & SHOULD CONDUCT THEIR OWN "DIAL BEFORE YOU DIG" PRIOR TO EXCAVATION/CONSTRUCTION.



Add us to your contacts

THIS PLAN MUST BE READ IN CONJUNCTION WITH SHEET 1 AND SHEET 2 FOR ADDITIONAL NOTES, WARNINGS & LEGEND.

CLIENT REGISTRATION No: N/A

SUB–SURFACE UTILITY INFORMATION

PLAN SHOWING UNDERGROUND UTILITIES AS INVESTIGATED & SURVEYED OVER  
WYONG HOSPITAL  
KANWAL

DATUM: A.H.D | SCALE: 1:200 @ A2 | SHEET 32 OF 45 | ISSUE: F


Locaters

UTILITY SURVEYS

Prepared By:

locating - surveying - consulting

www.locaters.com.au

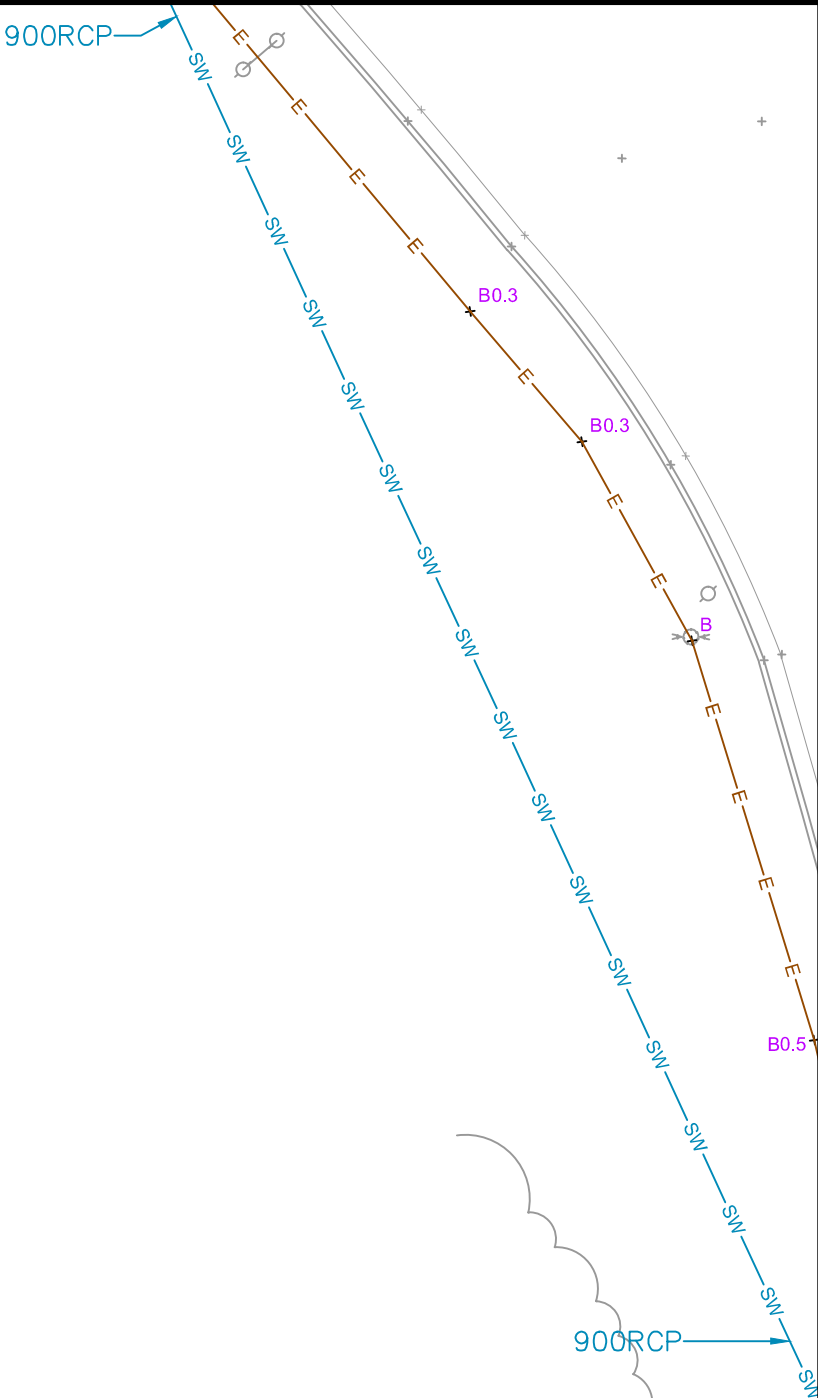

THIS PLAN IS INTENDED FOR DESIGN PURPOSES ONLY. IT DOES NOT REPLACE PLANS ISSUED BY UTILITY PROVIDERS THROUGH THE "DIAL BEFORE YOU DIG" SERVICE. CONTRACTORS ARE REMINDED OF THEIR OWN "DUTY OF CARE" & SHOULD CONDUCT THEIR OWN "DIAL BEFORE YOU DIG" PRIOR TO EXCAVATION/CONSTRUCTION.

\*\*\*\* WARNING: SERVICE PROVIDERS MAY SHARE CONDUITS &/OR TRENCHES AT THIS LOCATION \*\*\*\*

\*\*\*\* WARNING: UNKNOWN SERVICES MAY EXIST THAT COULD NOT BE ELECTRONICALLY DETECTED. SERVICE PROVIDER DIAGRAMS MAY NOT DEPICT ALL ASSETS WITHIN THEIR NETWORK \*\*\*\*

\*\*\*\* WARNING: SINGLE LINES MAY REPRESENT MULTIPLE CONDUITS, PIPES &/OR CABLES AT THIS LOCATION \*\*\*\*

| UTILITY POSITIONING CLASSIFICATION |                                                | CERTAINTY → RISK |          |
|------------------------------------|------------------------------------------------|------------------|----------|
| A                                  | VALIDATED, MEASURED DIRECTLY TO UTILITY (QL-A) | A                | High     |
| B                                  | TRACED, ELECTRONIC DETECTION OF UTILITY (QL-B) | B                | Medium   |
| C                                  | ALIGNED, TO UTILITY SURFACE FEATURES (QL-C)    | C                | Low      |
| D                                  | INDICATIVE, AS PER DIAGRAMS/FEATURES (QL-D)    | D                | Very Low |

[[[ DENOTES EXTENT OF INVESTIGATION AREA.  
[[[ INVESTIGATION ISSUE, SEE COMMENTS ON SHEET.

| FOR SCHEDULE OF AMENDMENTS SEE SHEET 1 TABLE |                            |
|----------------------------------------------|----------------------------|
| SCALE 1:200 @A2                              | ALL DISTANCES IN METRES    |
| CLIENT: – APPIAN GROUP                       | LOCATERS REFERENCE: 140623 |


**IMPORTANT REMINDER:**  
UTILITIES INDICATED AS CLASS "B","C"&"D" MAY BE INACCURATE IN BOTH VERTICAL & HORIZONTAL ALIGNMENTS.  
UTILITY LINES PLOTTED ARE INTERPOLATED BETWEEN POINTS THAT HAVE BEEN GENERATED DURING THE UTILITY INVESTIGATION PROCESS. THE UPC IS SPECIFIC TO THE POINT AT WHICH IT IS INSERTED ON A LINE AND IS NOT A CLASSIFICATION OF THE LINE ITSELF.



Prepared By:

locating - surveying - consulting

www.locaters.com.au

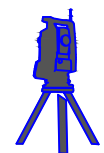




Add us to your contacts

THIS PLAN MUST BE READ IN CONJUNCTION WITH SHEET 1 AND SHEET 2 FOR ADDITIONAL NOTES, WARNINGS & LEGEND.

|                                                                                          |                   |                |          |
|------------------------------------------------------------------------------------------|-------------------|----------------|----------|
| CLIENT REGISTRATION No: N/A                                                              |                   |                |          |
| SUB–SURFACE UTILITY INFORMATION                                                          |                   |                |          |
| PLAN SHOWING UNDERGROUND UTILITIES AS INVESTIGATED & SURVEYED OVER WYONG HOSPITAL KANWAL |                   |                |          |
| DATUM: A.H.D                                                                             | SCALE: 1:200 @ A2 | SHEET 33 OF 45 | ISSUE: F |

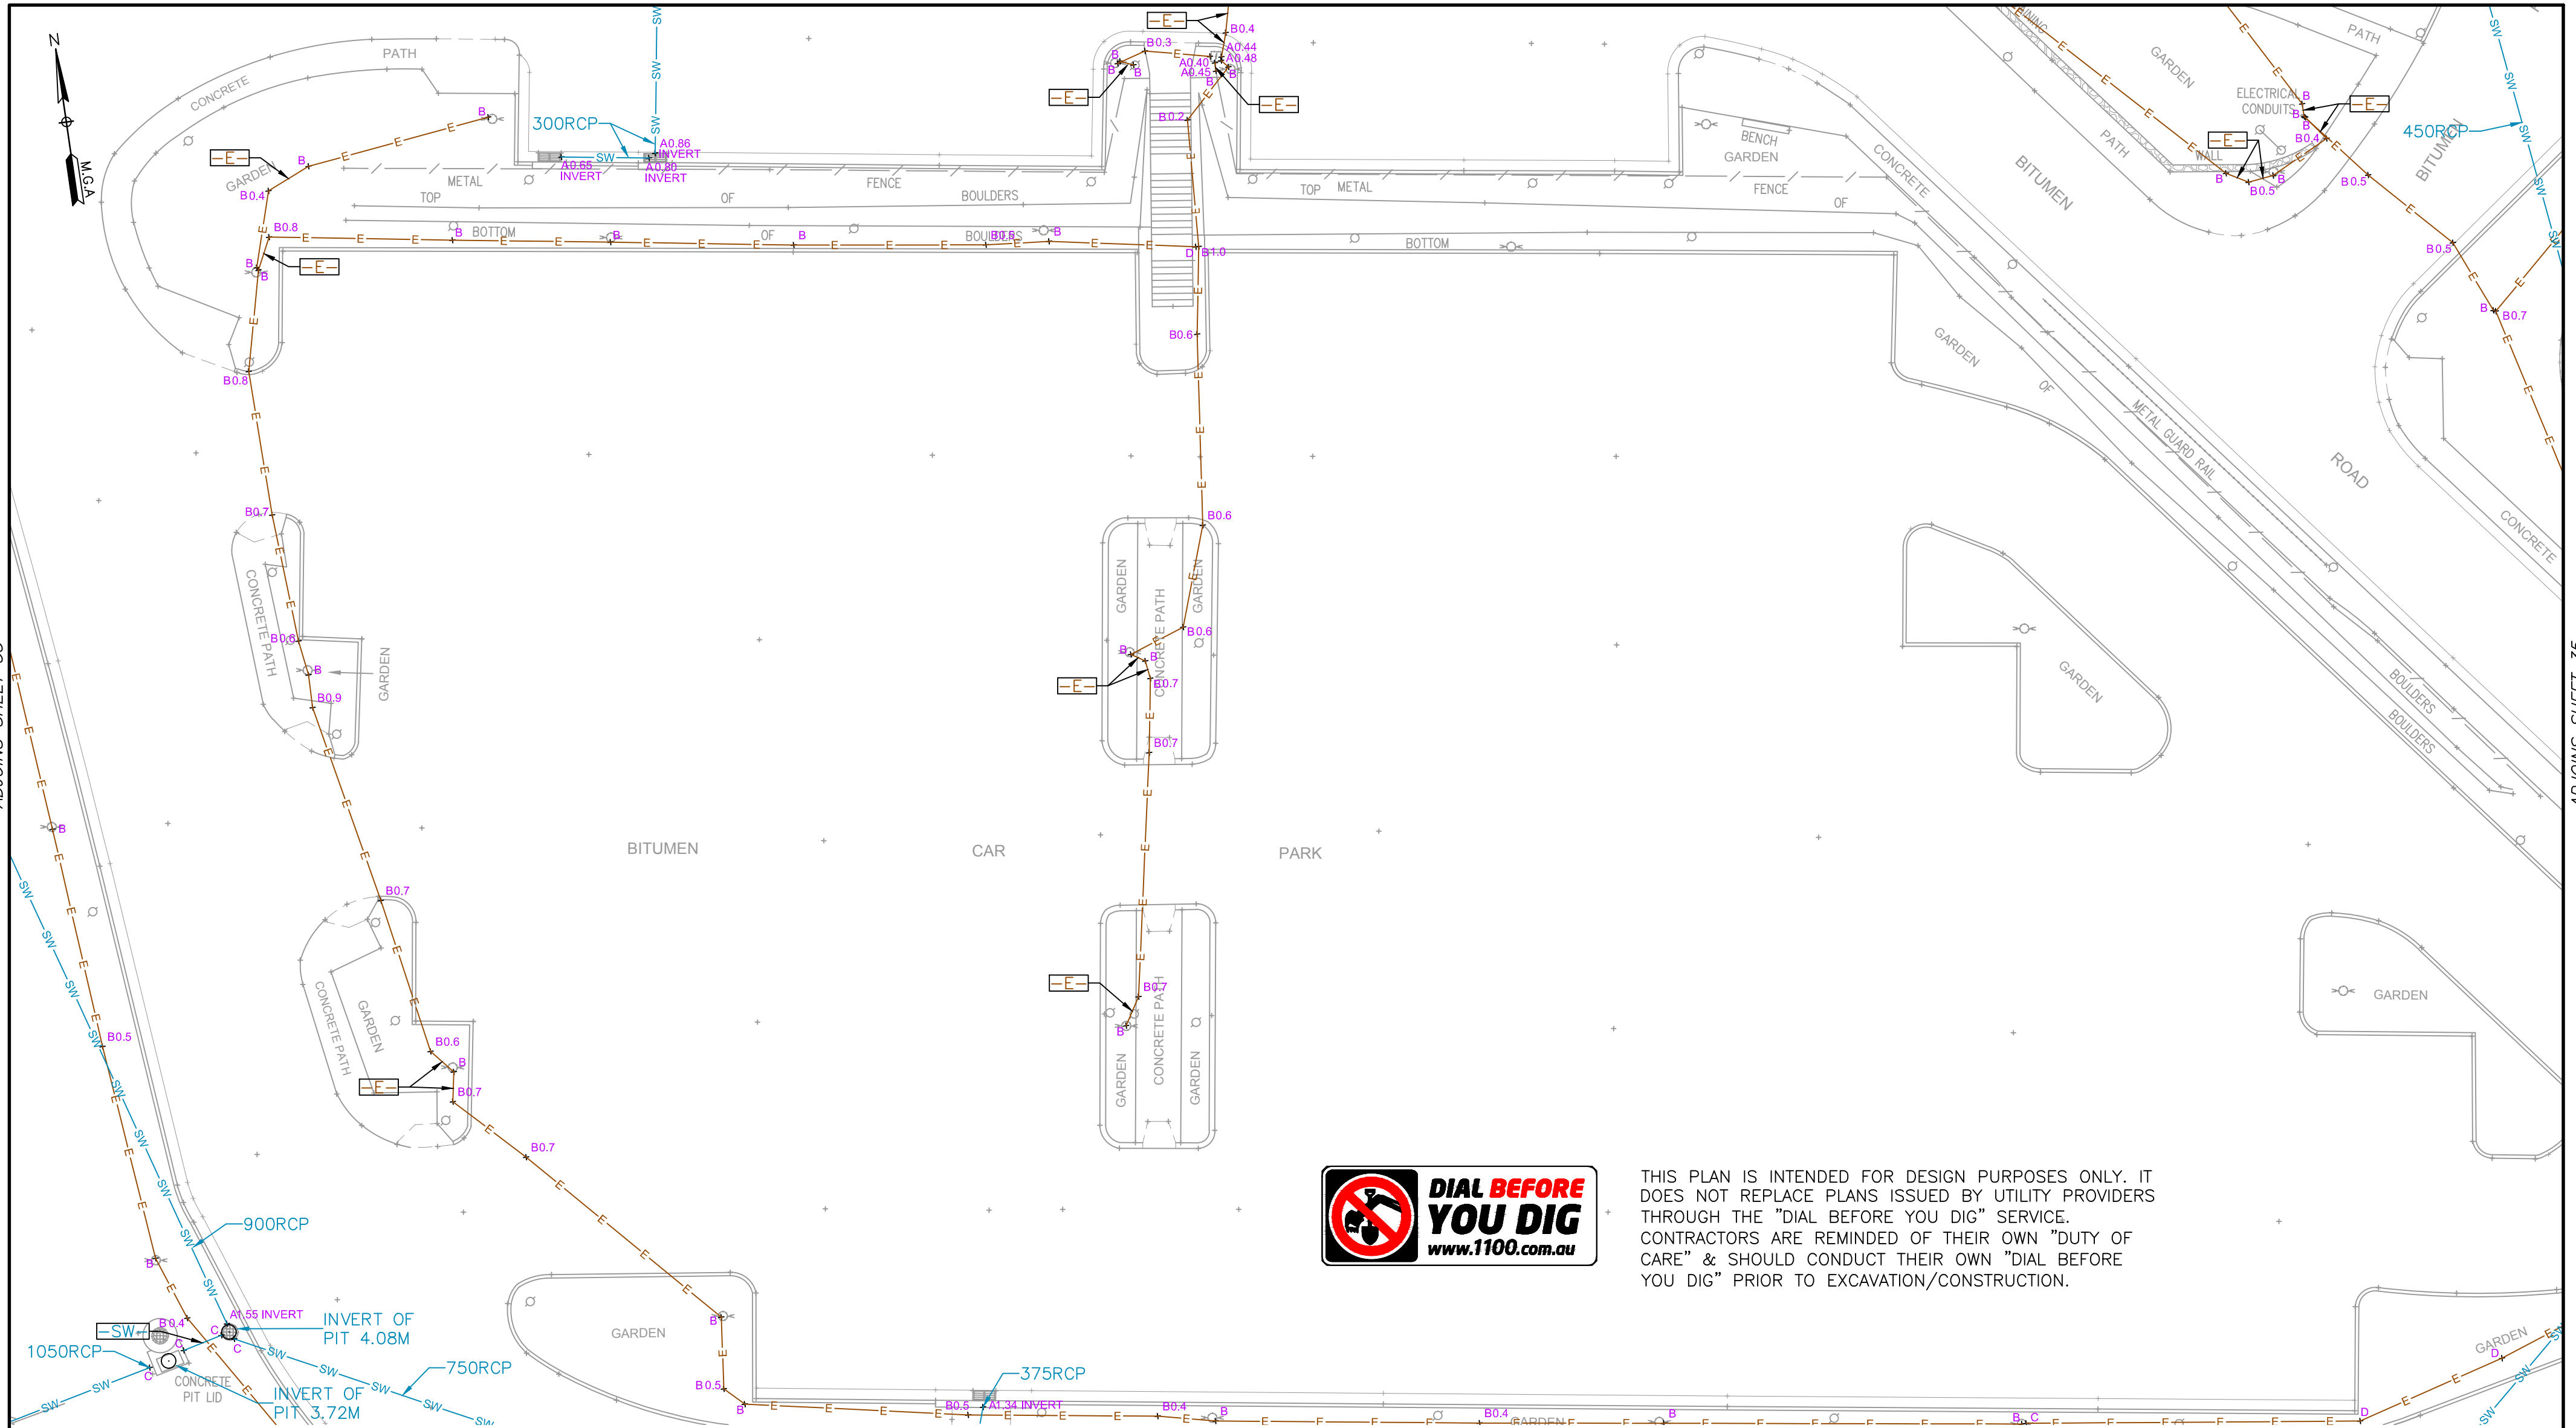


THIS PLAN IS INTENDED FOR DESIGN PURPOSES ONLY. IT DOES NOT REPLACE PLANS ISSUED BY UTILITY PROVIDERS THROUGH THE "DIAL BEFORE YOU DIG" SERVICE. CONTRACTORS ARE REMINDED OF THEIR OWN "DUTY OF CARE" & SHOULD CONDUCT THEIR OWN "DIAL BEFORE YOU DIG" PRIOR TO EXCAVATION/CONSTRUCTION.

\*\*\*\* WARNING: SERVICE PROVIDERS MAY SHARE CONDUITS &/OR TRENCHES AT THIS LOCATION \*\*\*\*

\*\*\*\* WARNING: UNKNOWN SERVICES MAY EXIST THAT COULD NOT BE ELECTRONICALLY DETECTED. SERVICE PROVIDER DIAGRAMS MAY NOT DEPICT ALL ASSETS WITHIN THEIR NETWORK \*\*\*\*

\*\*\*\* WARNING: SINGLE LINES MAY REPRESENT MULTIPLE CONDUITS, PIPES &/OR CABLES AT THIS LOCATION \*\*\*\*

| UTILITY POSITIONING CLASSIFICATION |                                                | CERTAINTY → RISK |          |
|------------------------------------|------------------------------------------------|------------------|----------|
| A                                  | VALIDATED, MEASURED DIRECTLY TO UTILITY (QL-A) | A                | High     |
| B                                  | TRACED, ELECTRONIC DETECTION OF UTILITY (QL-B) | B                | Medium   |
| C                                  | ALIGNED, TO UTILITY SURFACE FEATURES (QL-C)    | C                | Low      |
| D                                  | INDICATIVE, AS PER DIAGRAMS/FEATURES (QL-D)    | D                | Very Low |

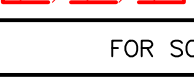 DENOTES EXTENT OF INVESTIGATION AREA.  
 INVESTIGATION ISSUE, SEE COMMENTS ON SHEET.

FOR SCHEDULE OF AMENDMENTS SEE SHEET 1 TABLE

SCALE 1:200  ALL DISTANCES IN METRES

CLIENT: - APPIAN GROUP


LOCATERS REFERENCE: 140623

**IMPORTANT REMINDER:**

UTILITIES INDICATED AS CLASS "B","C"&"D" MAY BE INACCURATE IN BOTH VERTICAL & HORIZONTAL ALIGNMENTS.

UTILITY LINES PLOTTED ARE INTERPOLATED BETWEEN POINTS THAT HAVE BEEN GENERATED DURING THE UTILITY INVESTIGATION PROCESS. THE UPC IS SPECIFIC TO THE POINT AT WHICH IT IS INSERTED ON A LINE AND IS NOT A CLASSIFICATION OF THE LINE ITSELF.

**Locaters**  
UTILITY SURVEYS  
locating - surveying - consulting  
[www.locaters.com.au](http://www.locaters.com.au)

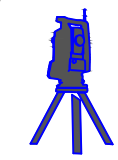
Prepared By: 



Add us to your contacts

THIS PLAN MUST BE READ IN CONJUNCTION WITH SHEET 1 AND SHEET 2 FOR ADDITIONAL NOTES, WARNINGS & LEGEND.

|                                                                                          |                   |                |          |
|------------------------------------------------------------------------------------------|-------------------|----------------|----------|
| CLIENT REGISTRATION No: N/A                                                              |                   |                |          |
| SUB-SURFACE UTILITY INFORMATION                                                          |                   |                |          |
| PLAN SHOWING UNDERGROUND UTILITIES AS INVESTIGATED & SURVEYED OVER WYONG HOSPITAL KANWAL |                   |                |          |
| DATUM: A.H.D                                                                             | SCALE: 1:200 © A2 | SHEET 34 OF 45 | ISSUE: F |

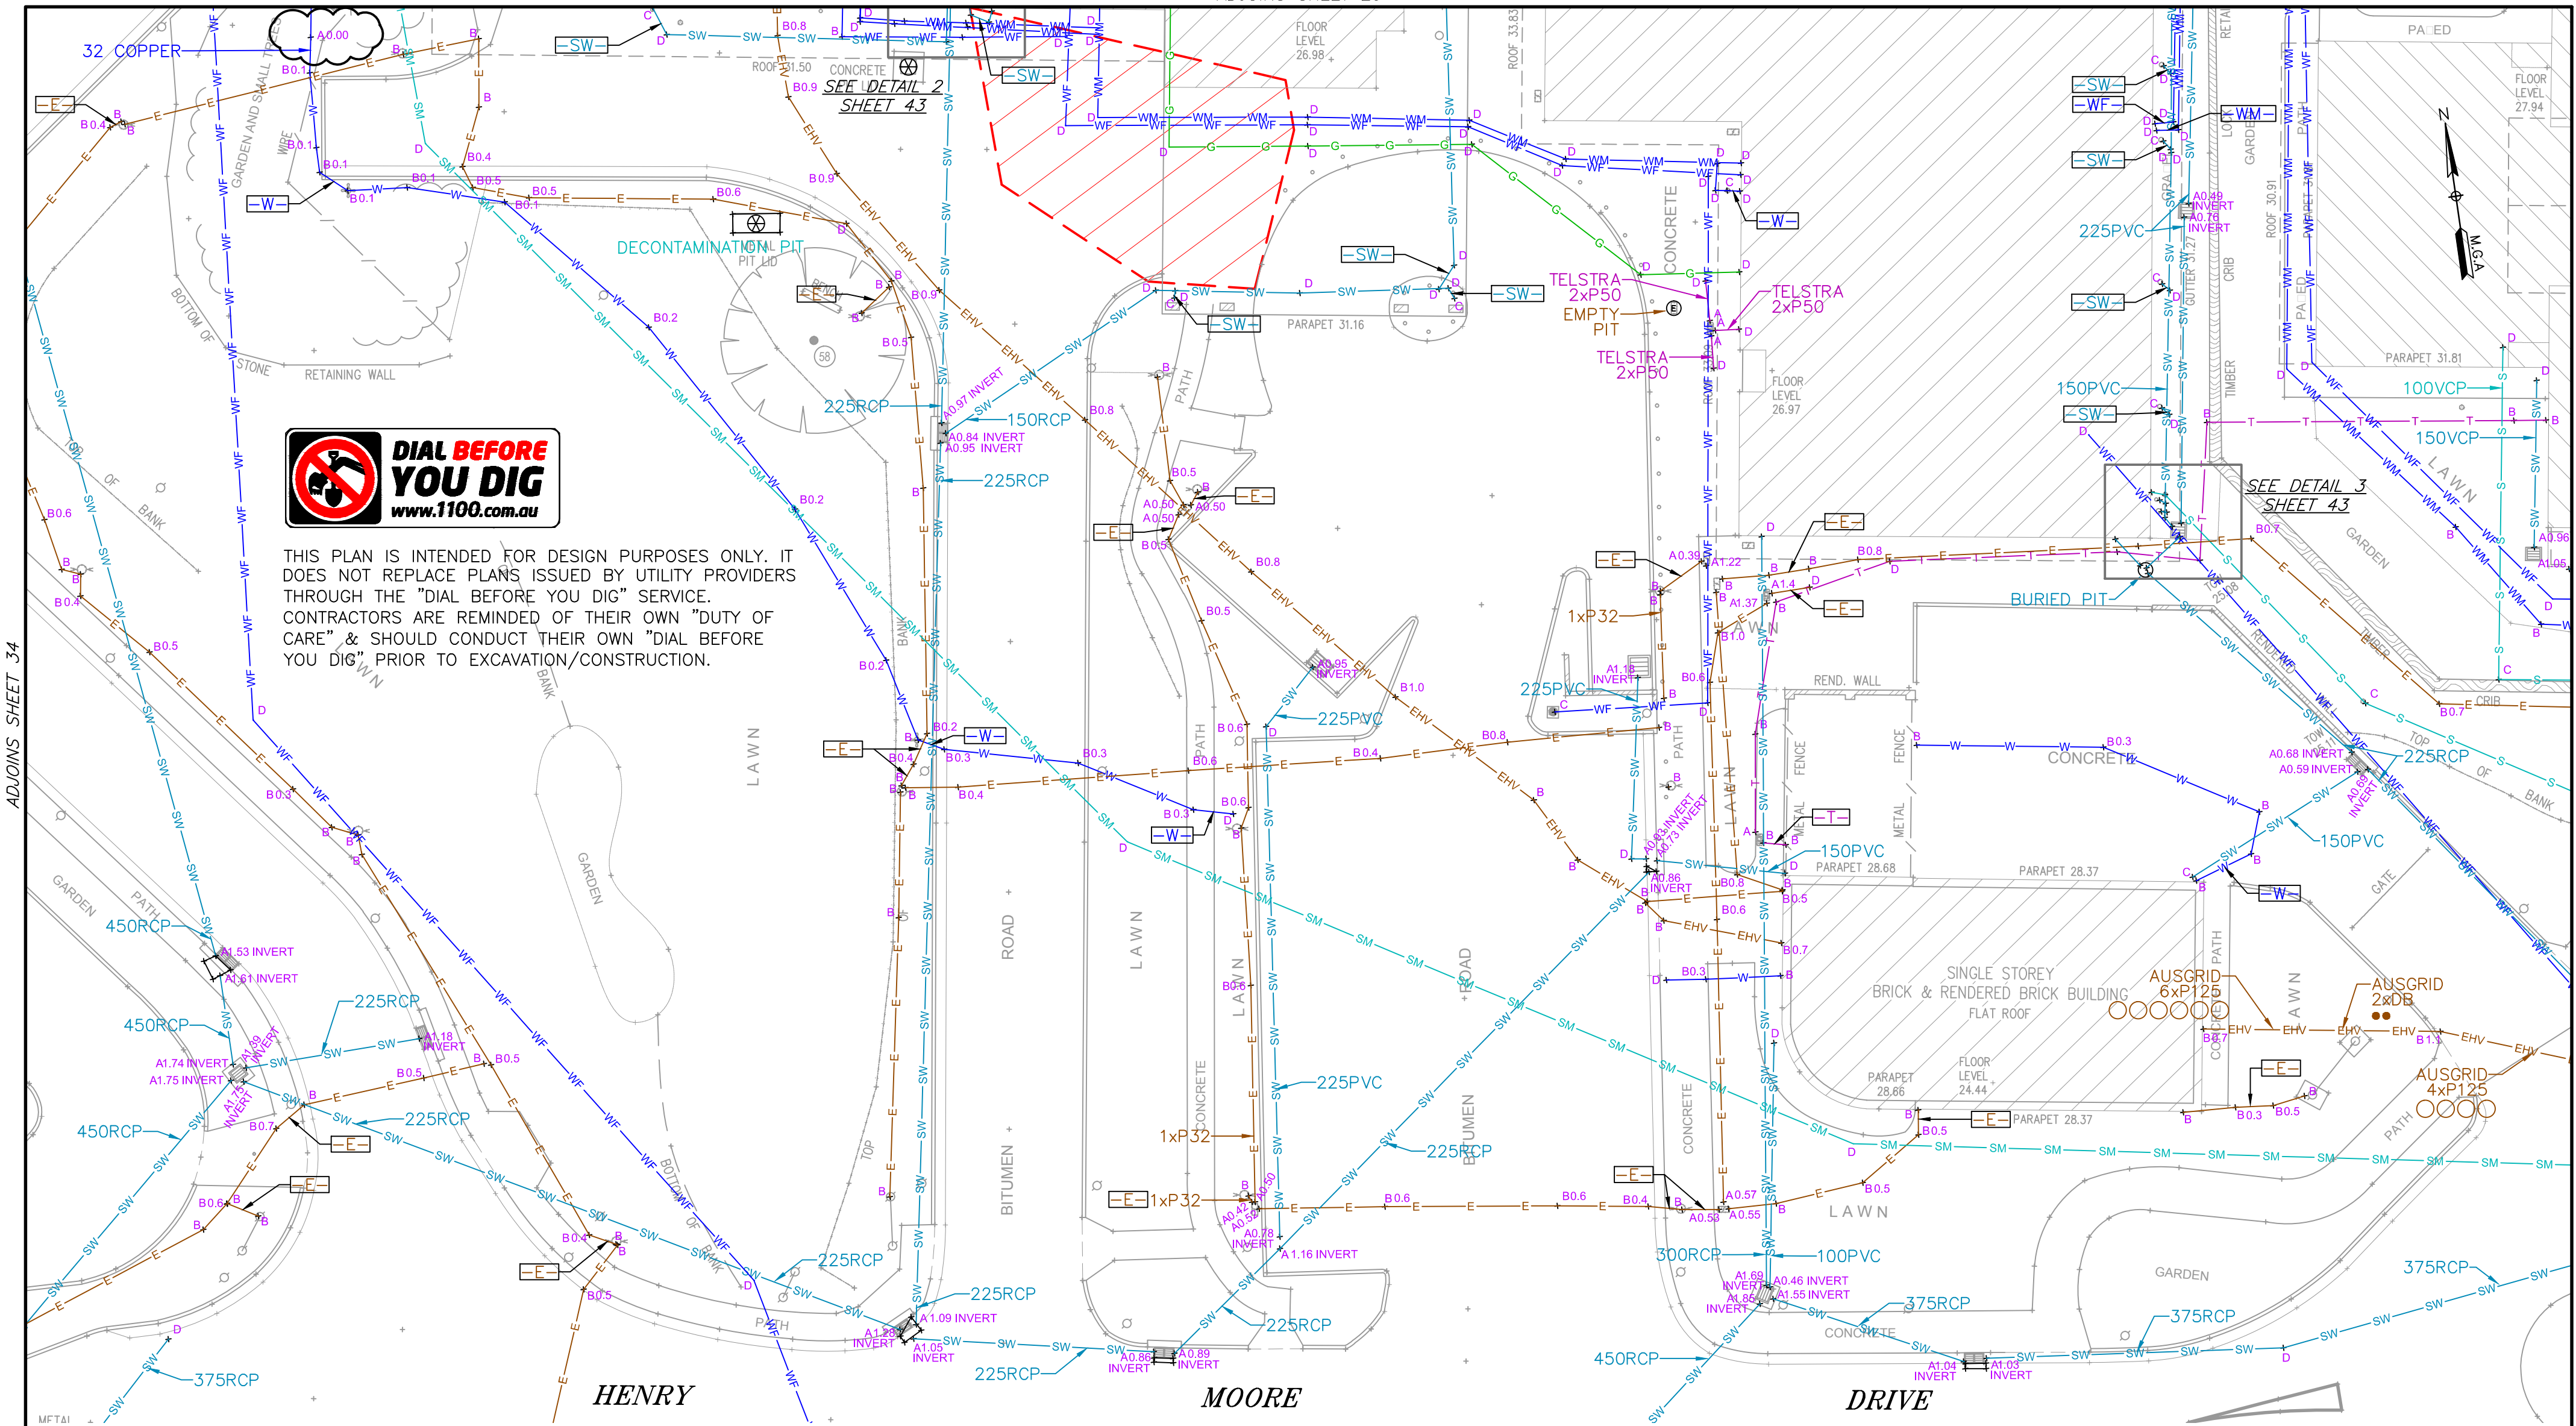

THIS PLAN IS INTENDED FOR DESIGN PURPOSES ONLY. IT DOES NOT REPLACE PLANS ISSUED BY UTILITY PROVIDERS THROUGH THE "DIAL BEFORE YOU DIG" SERVICE. CONTRACTORS ARE REMINDED OF THEIR OWN "DUTY OF CARE" & SHOULD CONDUCT THEIR OWN "DIAL BEFORE YOU DIG" PRIOR TO EXCAVATION/CONSTRUCTION.

\*\*\*\* WARNING: SERVICE PROVIDERS MAY SHARE CONDUITS &/OR TRENCHES AT THIS LOCATION \*\*\*\*

\*\*\*\* WARNING: UNKNOWN SERVICES MAY EXIST THAT COULD NOT BE ELECTRONICALLY DETECTED. SERVICE PROVIDER DIAGRAMS MAY NOT DEPICT ALL ASSETS WITHIN THEIR NETWORK \*\*\*\*

\*\*\*\* WARNING: SINGLE LINES MAY REPRESENT MULTIPLE CONDUITS, PIPES &/OR CABLES AT THIS LOCATION \*\*\*\*

| UTILITY POSITIONING CLASSIFICATION |                                                | CERTAINTY → RISK |                                     |
|------------------------------------|------------------------------------------------|------------------|-------------------------------------|
| A                                  | VALIDATED, MEASURED DIRECTLY TO UTILITY (QL-A) | CLASS A          | High Certainty / Low Risk           |
| B                                  | TRACED, ELECTRONIC DETECTION OF UTILITY (QL-B) | CLASS B          | Medium Certainty / Medium Risk      |
| C                                  | ALIGNED, TO UTILITY SURFACE FEATURES (QL-C)    | CLASS C          | Low Certainty / High Risk           |
| D                                  | INDICATIVE, AS PER DIAGRAMS/FEATURES (QL-D)    | CLASS D          | Very Low Certainty / Very High Risk |

[[[ DENOTES EXTENT OF INVESTIGATION AREA.  
[[[ INVESTIGATION ISSUE, SEE COMMENTS ON SHEET.

FOR SCHEDULE OF AMENDMENTS SEE SHEET 1 TABLE

SCALE 1:200 ALL DISTANCES IN METRES

CLIENT: - APPIAN GROUP

LOCATORS REFERENCE: 140623

**IMPORTANT REMINDER:**  
UTILITIES INDICATED AS CLASS "B","C"&"D" MAY BE INACCURATE IN BOTH VERTICAL & HORIZONTAL ALIGNMENTS.

UTILITY LINES PLOTTED ARE INTERPOLATED BETWEEN POINTS THAT HAVE BEEN GENERATED DURING THE UTILITY INVESTIGATION PROCESS. THE UPC IS SPECIFIC TO THE POINT AT WHICH IT IS INSERTED ON A LINE AND IS NOT A CLASSIFICATION OF THE LINE ITSELF.

ADJOINS SHEET 41

DRIVE




Prepared By:

**Locaters**  
UTILITY SURVEYS  
locating - surveying - consulting  
www.locaters.com.au

THIS PLAN MUST BE READ IN CONJUNCTION WITH SHEET 1 AND SHEET 2 FOR ADDITIONAL NOTES, WARNINGS & LEGEND.

|                                                                                          |                   |                |          |
|------------------------------------------------------------------------------------------|-------------------|----------------|----------|
| CLIENT REGISTRATION No: N/A                                                              |                   |                |          |
| SUB-SURFACE UTILITY INFORMATION                                                          |                   |                |          |
| PLAN SHOWING UNDERGROUND UTILITIES AS INVESTIGATED & SURVEYED OVER WYONG HOSPITAL KANWAL |                   |                |          |
| DATUM: A.H.D                                                                             | SCALE: 1:200 @ A2 | SHEET 35 OF 45 | ISSUE: F |

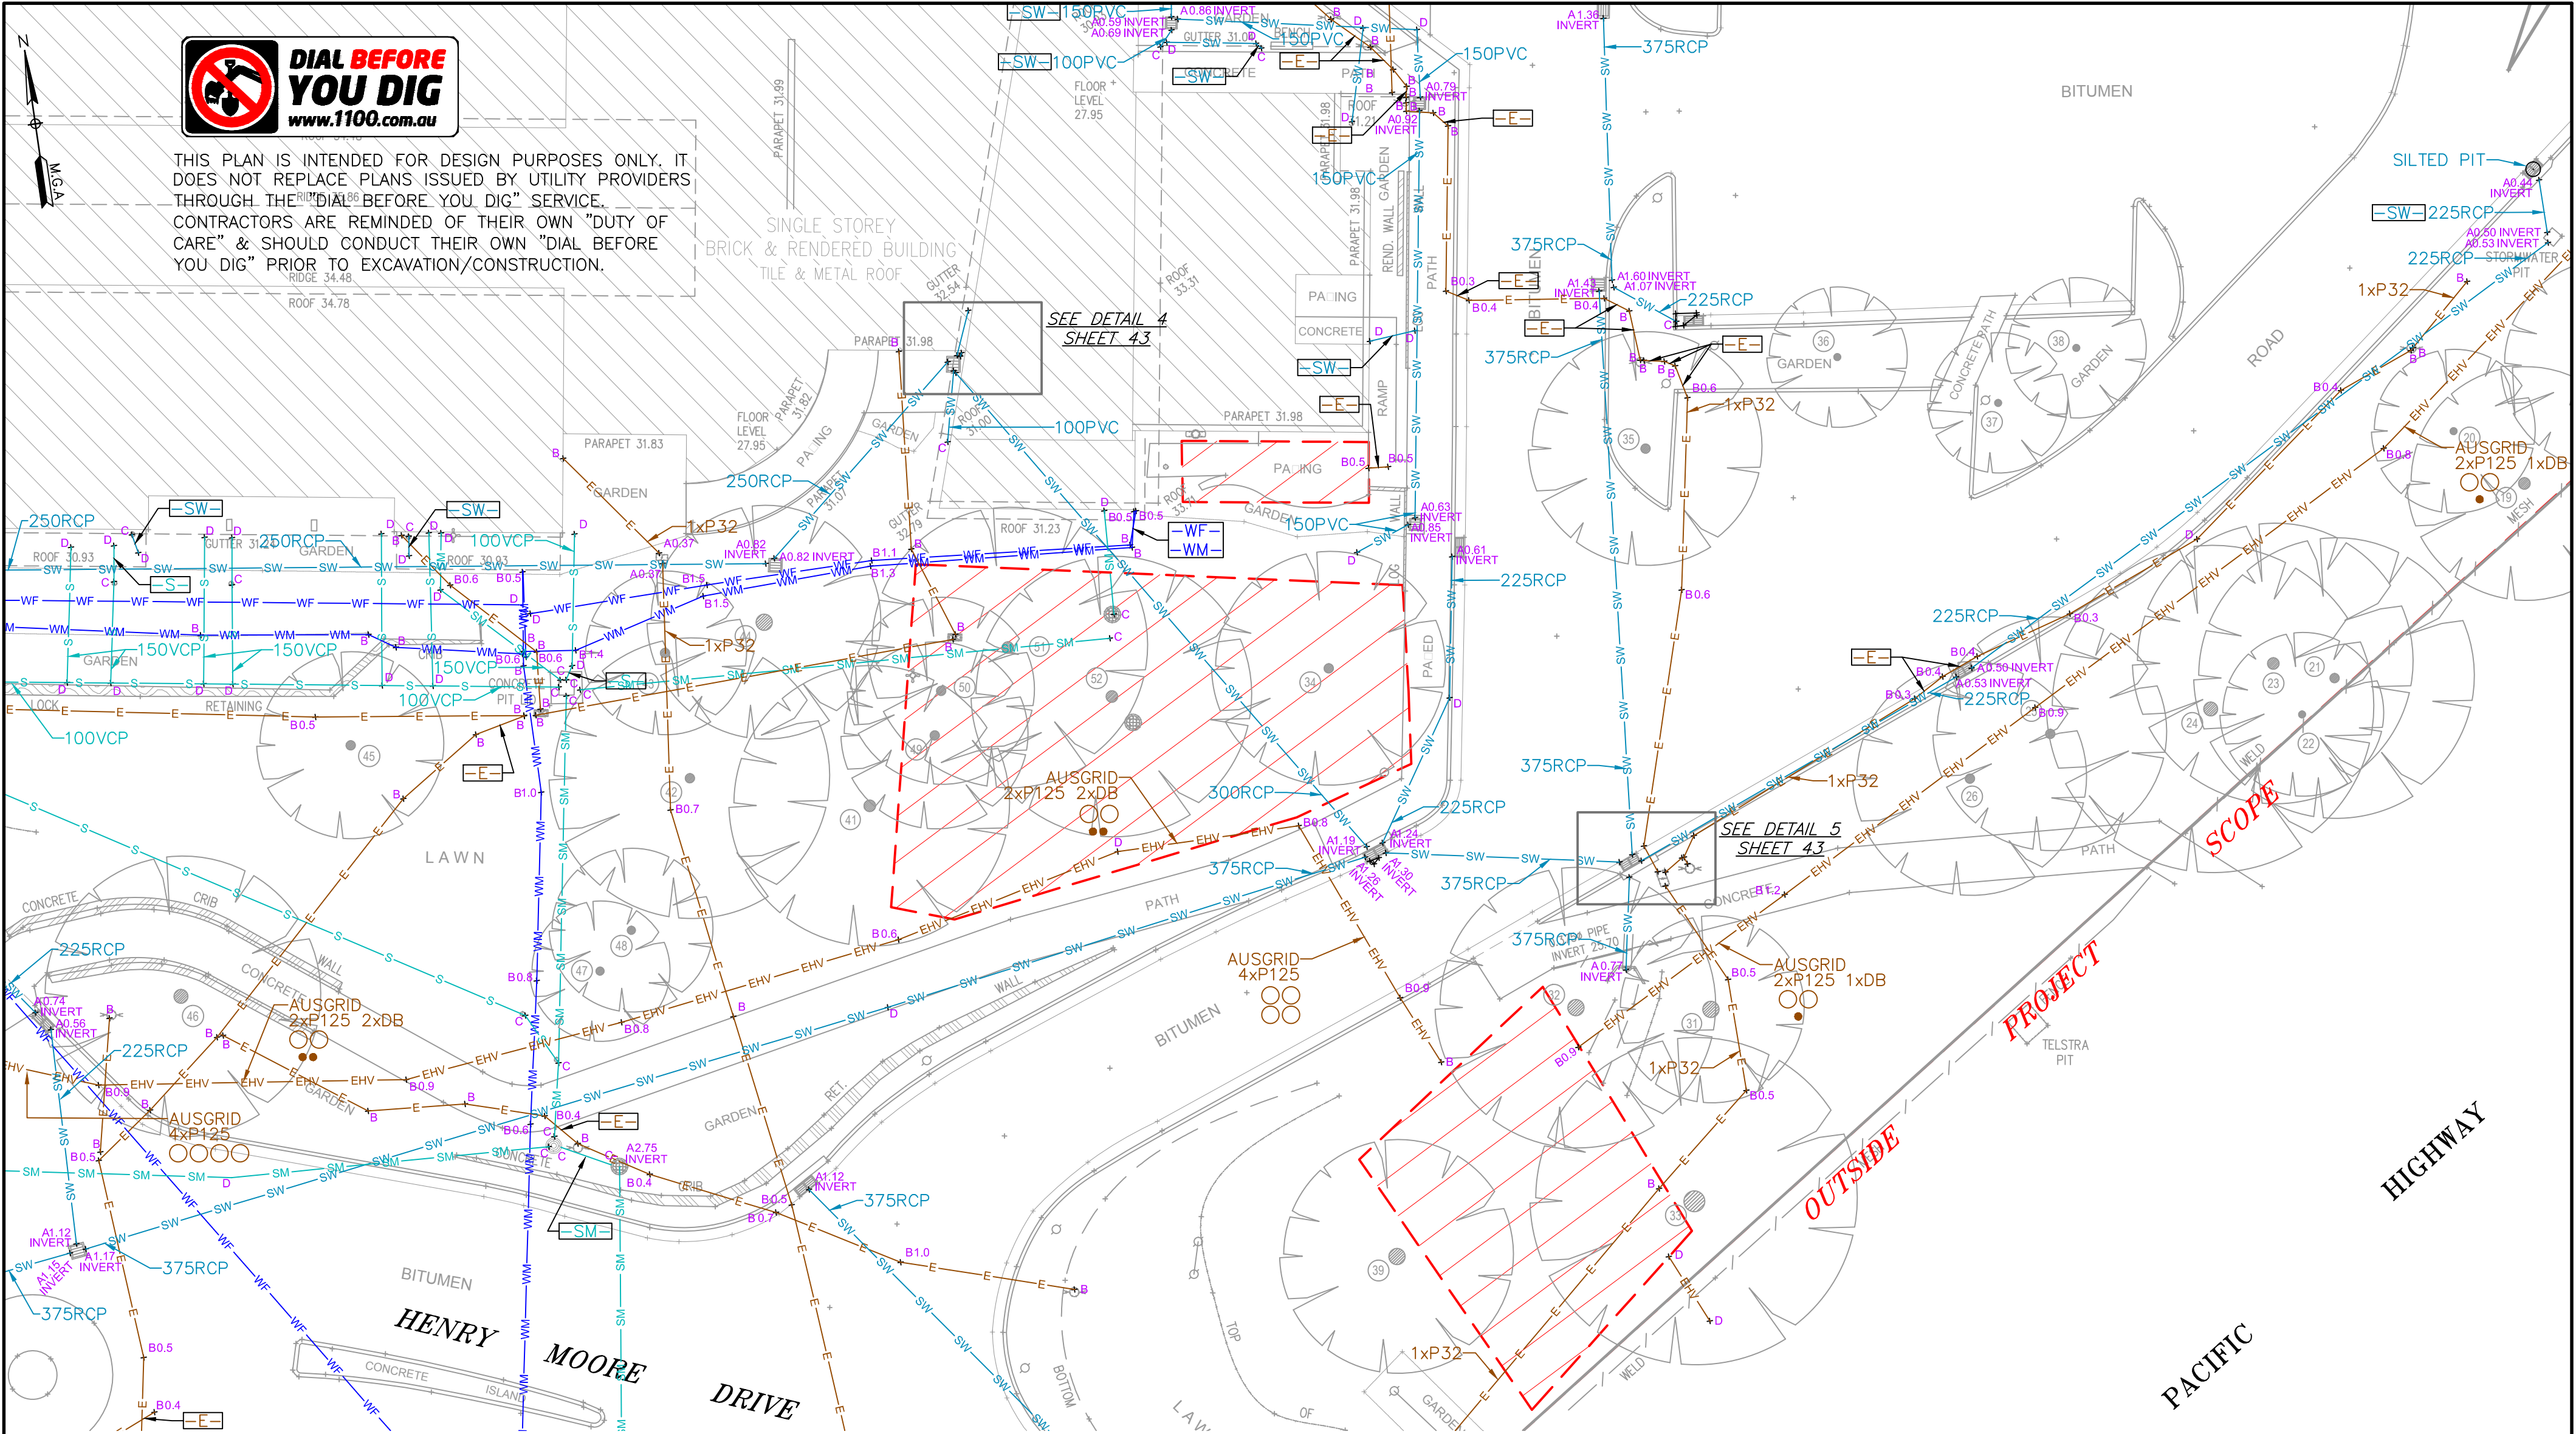

\*\*\*\* WARNING: SERVICE PROVIDERS MAY SHARE CONDUITS &/OR TRENCHES AT THIS LOCATION \*\*\*\*

\*\*\*\* WARNING: UNKNOWN SERVICES MAY EXIST THAT COULD NOT BE ELECTRONICALLY DETECTED. SERVICE PROVIDER DIAGRAMS MAY NOT DEPICT ALL ASSETS WITHIN THEIR NETWORK \*\*\*\*

\*\*\*\* WARNING: SINGLE LINES MAY REPRESENT MULTIPLE CONDUITS, PIPES &/OR CABLES AT THIS LOCATION \*\*\*\*

| UTILITY POSITIONING CLASSIFICATION |                                                | CERTAINTY → RISK |          |
|------------------------------------|------------------------------------------------|------------------|----------|
| A                                  | VALIDATED, MEASURED DIRECTLY TO UTILITY (QL-A) | A                | High     |
| B                                  | TRACED, ELECTRONIC DETECTION OF UTILITY (QL-B) | B                | Medium   |
| C                                  | ALIGNED, TO UTILITY SURFACE FEATURES (QL-C)    | C                | Low      |
| D                                  | INDICATIVE, AS PER DIAGRAMS/FEATURES (QL-D)    | D                | Very Low |

[[[ DENOTES EXTENT OF INVESTIGATION AREA.

[[[ INVESTIGATION ISSUE, SEE COMMENTS ON SHEET.

FOR SCHEDULE OF AMENDMENTS SEE SHEET 1 TABLE

SCALE 1:200 ALL DISTANCES IN METRES

CLIENT: - APPIAN GROUP LOCATORS REFERENCE: 140623

**IMPORTANT REMINDER:**

UTILITIES INDICATED AS CLASS "B","C"&"D" MAY BE INACCURATE IN BOTH VERTICAL & HORIZONTAL ALIGNMENTS.

UTILITY LINES PLOTTED ARE INTERPOLATED BETWEEN POINTS THAT HAVE BEEN GENERATED DURING THE UTILITY INVESTIGATION PROCESS. THE UPC IS SPECIFIC TO THE POINT AT WHICH IT IS INSERTED ON A LINE AND IS NOT A CLASSIFICATION OF THE LINE ITSELF.


Prepared By:

**Locaters**  
UTILITY SURVEYS

locating - surveying - consulting  
[www.locaters.com.au](http://www.locaters.com.au)

Add us to your contacts

|   |                   |                |          |
|---|-------------------|----------------|----------|
| THIS PLAN MUST BE READ IN CONJUNCTION WITH SHEET 1 AND SHEET 2 FOR ADDITIONAL NOTES, WARNINGS & LEGEND. |                   |                |          |
| CLIENT REGISTRATION No: N/A                                                                             |                   |                |          |
| SUB-SURFACE UTILITY INFORMATION                                                                         |                   |                |          |
| PLAN SHOWING UNDERGROUND UTILITIES AS INVESTIGATED & SURVEYED OVER WYONG HOSPITAL KANWAL                |                   |                |          |
| DATUM: A.H.D                                                                                            | SCALE: 1:200 © A2 | SHEET 36 OF 45 | ISSUE: F |

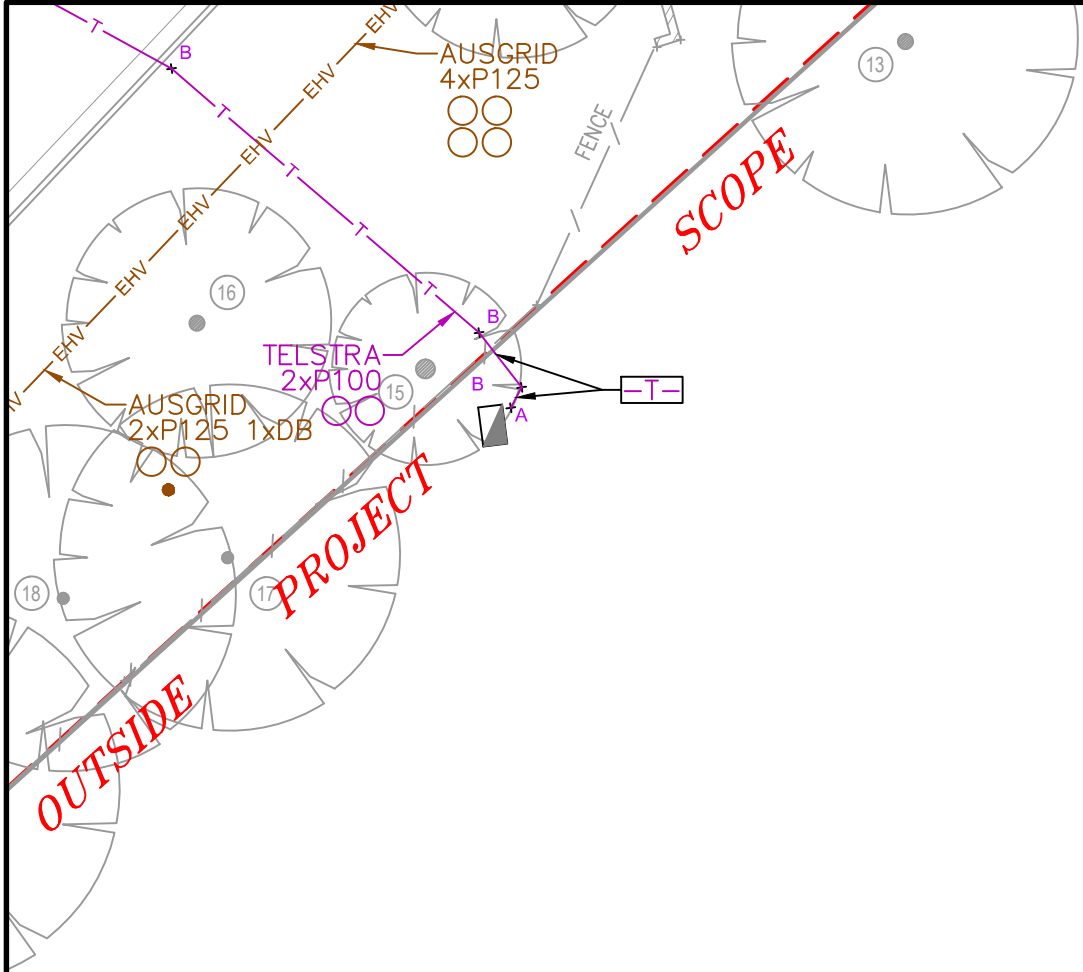

THIS PLAN IS INTENDED FOR DESIGN PURPOSES ONLY. IT DOES NOT REPLACE PLANS ISSUED BY UTILITY PROVIDERS THROUGH THE "DIAL BEFORE YOU DIG" SERVICE. CONTRACTORS ARE REMINDED OF THEIR OWN "DUTY OF CARE" & SHOULD CONDUCT THEIR OWN "DIAL BEFORE YOU DIG" PRIOR TO EXCAVATION/CONSTRUCTION.

\*\*\*\* WARNING: SERVICE PROVIDERS MAY SHARE CONDUITS &/OR TRENCHES AT THIS LOCATION \*\*\*\*

\*\*\*\* WARNING: UNKNOWN SERVICES MAY EXIST THAT COULD NOT BE ELECTRONICALLY DETECTED. SERVICE PROVIDER DIAGRAMS MAY NOT DEPICT ALL ASSETS WITHIN THEIR NETWORK \*\*\*\*

\*\*\*\* WARNING: SINGLE LINES MAY REPRESENT MULTIPLE CONDUITS, PIPES &/OR CABLES AT THIS LOCATION \*\*\*\*

| UTILITY POSITIONING CLASSIFICATION |                                                | CERTAINTY → RISK |                                    |
|------------------------------------|------------------------------------------------|------------------|------------------------------------|
| A                                  | VALIDATED, MEASURED DIRECTLY TO UTILITY (QL-A) | A                | High Certainty, Low Risk           |
| B                                  | TRACED, ELECTRONIC DETECTION OF UTILITY (QL-B) | B                | Medium Certainty, Medium Risk      |
| C                                  | ALIGNED, TO UTILITY SURFACE FEATURES (QL-C)    | C                | Low Certainty, High Risk           |
| D                                  | INDICATIVE, AS PER DIAGRAMS/FEATURES (QL-D)    | D                | Very Low Certainty, Very High Risk |


 DENOTES EXTENT OF INVESTIGATION AREA.  
 INVESTIGATION ISSUE, SEE COMMENTS ON SHEET.

|                                                                                      |                            |
|--------------------------------------------------------------------------------------|----------------------------|
| FOR SCHEDULE OF AMENDMENTS SEE SHEET 1 TABLE                                         |                            |
| SCALE 1:200 @A2                                                                      | ALL DISTANCES IN METRES    |
|  |                            |
| CLIENT: – APPIAN GROUP                                                               | LOCATERS REFERENCE: 140623 |

**IMPORTANT REMINDER:**  
 UTILITIES INDICATED AS CLASS "B","C"&"D" MAY BE INACCURATE IN BOTH VERTICAL & HORIZONTAL ALIGNMENTS.

UTILITY LINES PLOTTED ARE INTERPOLATED BETWEEN POINTS THAT HAVE BEEN GENERATED DURING THE UTILITY INVESTIGATION PROCESS. THE UPC IS SPECIFIC TO THE POINT AT WHICH IT IS INSERTED ON A LINE AND IS NOT A CLASSIFICATION OF THE LINE ITSELF.

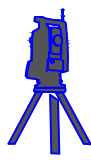

Prepared By: 

locating - surveying - consulting

[www.locaters.com.au](http://www.locaters.com.au)



Add us to your contacts

THIS PLAN MUST BE READ IN CONJUNCTION WITH SHEET 1 AND SHEET 2 FOR ADDITIONAL NOTES, WARNINGS & LEGEND.

|                                                                                          |                   |                |          |
|------------------------------------------------------------------------------------------|-------------------|----------------|----------|
| CLIENT REGISTRATION No: N/A                                                              |                   |                |          |
| SUB–SURFACE UTILITY INFORMATION                                                          |                   |                |          |
| PLAN SHOWING UNDERGROUND UTILITIES AS INVESTIGATED & SURVEYED OVER WYONG HOSPITAL KANWAL |                   |                |          |
| DATUM: A.H.D                                                                             | SCALE: 1:200 @ A2 | SHEET 37 OF 45 | ISSUE: F |

SCOPE  
PROJECT  
OUTSIDE



OUTSIDEPROJECTSCOPE

ADJOINS SHEET 39



THIS PLAN IS INTENDED FOR DESIGN PURPOSES ONLY. IT DOES NOT REPLACE PLANS ISSUED BY UTILITY PROVIDERS THROUGH THE "DIAL BEFORE YOU DIG" SERVICE. CONTRACTORS ARE REMINDED OF THEIR OWN "DUTY OF CARE" & SHOULD CONDUCT THEIR OWN "DIAL BEFORE YOU DIG" PRIOR TO EXCAVATION/CONSTRUCTION.

\*\*\*\* WARNING: SERVICE PROVIDERS MAY SHARE CONDUITS &/OR TRENCHES AT THIS LOCATION \*\*\*\*

\*\*\*\* WARNING: UNKNOWN SERVICES MAY EXIST THAT COULD NOT BE ELECTRONICALLY DETECTED. SERVICE PROVIDER DIAGRAMS MAY NOT DEPICT ALL ASSETS WITHIN THEIR NETWORK \*\*\*\*

\*\*\*\* WARNING: SINGLE LINES MAY REPRESENT MULTIPLE CONDUITS, PIPES &/OR CABLES AT THIS LOCATION \*\*\*\*

UTILITY POSITIONING CLASSIFICATION

A

B

C

D

VALIDATED, MEASURED DIRECTLY TO UTILITY (QL-A)

TRACED, ELECTRONIC DETECTION OF UTILITY (QL-B)

ALIGNED, TO UTILITY SURFACE FEATURES (QL-C)

INDICATIVE, AS PER DIAGRAMS/FEATURES (QL-D)

CERTAINTY

RISK

A

B

C

D

DENOTES EXTENT OF INVESTIGATION AREA.  
 INVESTIGATION ISSUE, SEE COMMENTS ON SHEET.

|                                              |                         |
|----------------------------------------------|-------------------------|
| FOR SCHEDULE OF AMENDMENTS SEE SHEET 1 TABLE |                         |
| SCALE 1:200 @A2                              | ALL DISTANCES IN METRES |
| CLIENT: – APPIAN GROUP                       |                         |
| LOCATERS REFERENCE: 140623                   |                         |

**IMPORTANT REMINDER:**  
UTILITIES INDICATED AS CLASS "B","C"&"D" MAY BE INACCURATE IN BOTH VERTICAL & HORIZONTAL ALIGNMENTS.  
UTILITY LINES PLOTTED ARE INTERPOLATED BETWEEN POINTS THAT HAVE BEEN GENERATED DURING THE UTILITY INVESTIGATION PROCESS. THE UPC IS SPECIFIC TO THE POINT AT WHICH IT IS INSERTED ON A LINE AND IS NOT A CLASSIFICATION OF THE LINE ITSELF.



Add us to your contacts

THIS PLAN MUST BE READ IN CONJUNCTION WITH SHEET 1 AND SHEET 2 FOR ADDITIONAL NOTES, WARNINGS & LEGEND.

CLIENT REGISTRATION No: N/A  
SUB–SURFACE UTILITY INFORMATION

PLAN SHOWING UNDERGROUND UTILITIES AS INVESTIGATED & SURVEYED OVER  
WYONG HOSPITAL  
KANWAL

DATUM: A.H.D | SCALE: 1:200 @ A2 | SHEET 38 OF 45 | ISSUE: F

Prepared By:

Locaters

UTILITY SURVEYS

locating - surveying - consulting

www.locaters.com.au

INVERT  
12.41  
CONCRETE  
HEAVY



DENSE

OUTSIDE PROJECT SCOPE



THIS PLAN IS INTENDED FOR DESIGN PURPOSES ONLY. IT DOES NOT REPLACE PLANS ISSUED BY UTILITY PROVIDERS THROUGH THE "DIAL BEFORE YOU DIG" SERVICE. CONTRACTORS ARE REMINDED OF THEIR OWN "DUTY OF CARE" & SHOULD CONDUCT THEIR OWN "DIAL BEFORE YOU DIG" PRIOR TO EXCAVATION/CONSTRUCTION.

\*\*\*\* WARNING: SERVICE PROVIDERS MAY SHARE CONDUITS &/OR TRENCHES AT THIS LOCATION \*\*\*\*

\*\*\*\* WARNING: UNKNOWN SERVICES MAY EXIST THAT COULD NOT BE ELECTRONICALLY DETECTED. SERVICE PROVIDER DIAGRAMS MAY NOT DEPICT ALL ASSETS WITHIN THEIR NETWORK \*\*\*\*

\*\*\*\* WARNING: SINGLE LINES MAY REPRESENT MULTIPLE CONDUITS, PIPES &/OR CABLES AT THIS LOCATION \*\*\*\*

UTILITY POSITIONING CLASSIFICATION

A

B

C

D

VALIDATED, MEASURED DIRECTLY TO UTILITY (QL-A)

TRACED, ELECTRONIC DETECTION OF UTILITY (QL-B)

ALIGNED, TO UTILITY SURFACE FEATURES (QL-C)

INDICATIVE, AS PER DIAGRAMS/FEATURES (QL-D)

CERTAINITY

RISK

A

B

C

D

DENOTES EXTENT OF INVESTIGATION AREA.  
 INVESTIGATION ISSUE, SEE COMMENTS ON SHEET.

|                                              |                         |
|----------------------------------------------|-------------------------|
| FOR SCHEDULE OF AMENDMENTS SEE SHEET 1 TABLE |                         |
| SCALE 1:200 @A2                              | ALL DISTANCES IN METRES |
| CLIENT: – APPIAN GROUP                       |                         |
| LOCATERS REFERENCE: 140623                   |                         |

**IMPORTANT REMINDER:**  
UTILITIES INDICATED AS CLASS "B","C"&"D" MAY BE INACCURATE IN BOTH VERTICAL & HORIZONTAL ALIGNMENTS.  
UTILITY LINES PLOTTED ARE INTERPOLATED BETWEEN POINTS THAT HAVE BEEN GENERATED DURING THE UTILITY INVESTIGATION PROCESS. THE UPC IS SPECIFIC TO THE POINT AT WHICH IT IS INSERTED ON A LINE AND IS NOT A CLASSIFICATION OF THE LINE ITSELF.



Add us to your contacts

THIS PLAN MUST BE READ IN CONJUNCTION WITH SHEET 1 AND SHEET 2 FOR ADDITIONAL NOTES, WARNINGS & LEGEND.

CLIENT REGISTRATION No: N/A

SUB–SURFACE UTILITY INFORMATION

PLAN SHOWING UNDERGROUND UTILITIES AS INVESTIGATED & SURVEYED OVER  
WYONG HOSPITAL  
KANWAL



DATUM: A.H.D | SCALE: 1:200 @ A2 | SHEET 39 OF 45 | ISSUE: F


Prepared By:

UTILITY SURVEYS

locating - surveying - consulting

www.locaters.com.au

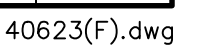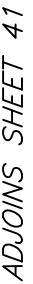

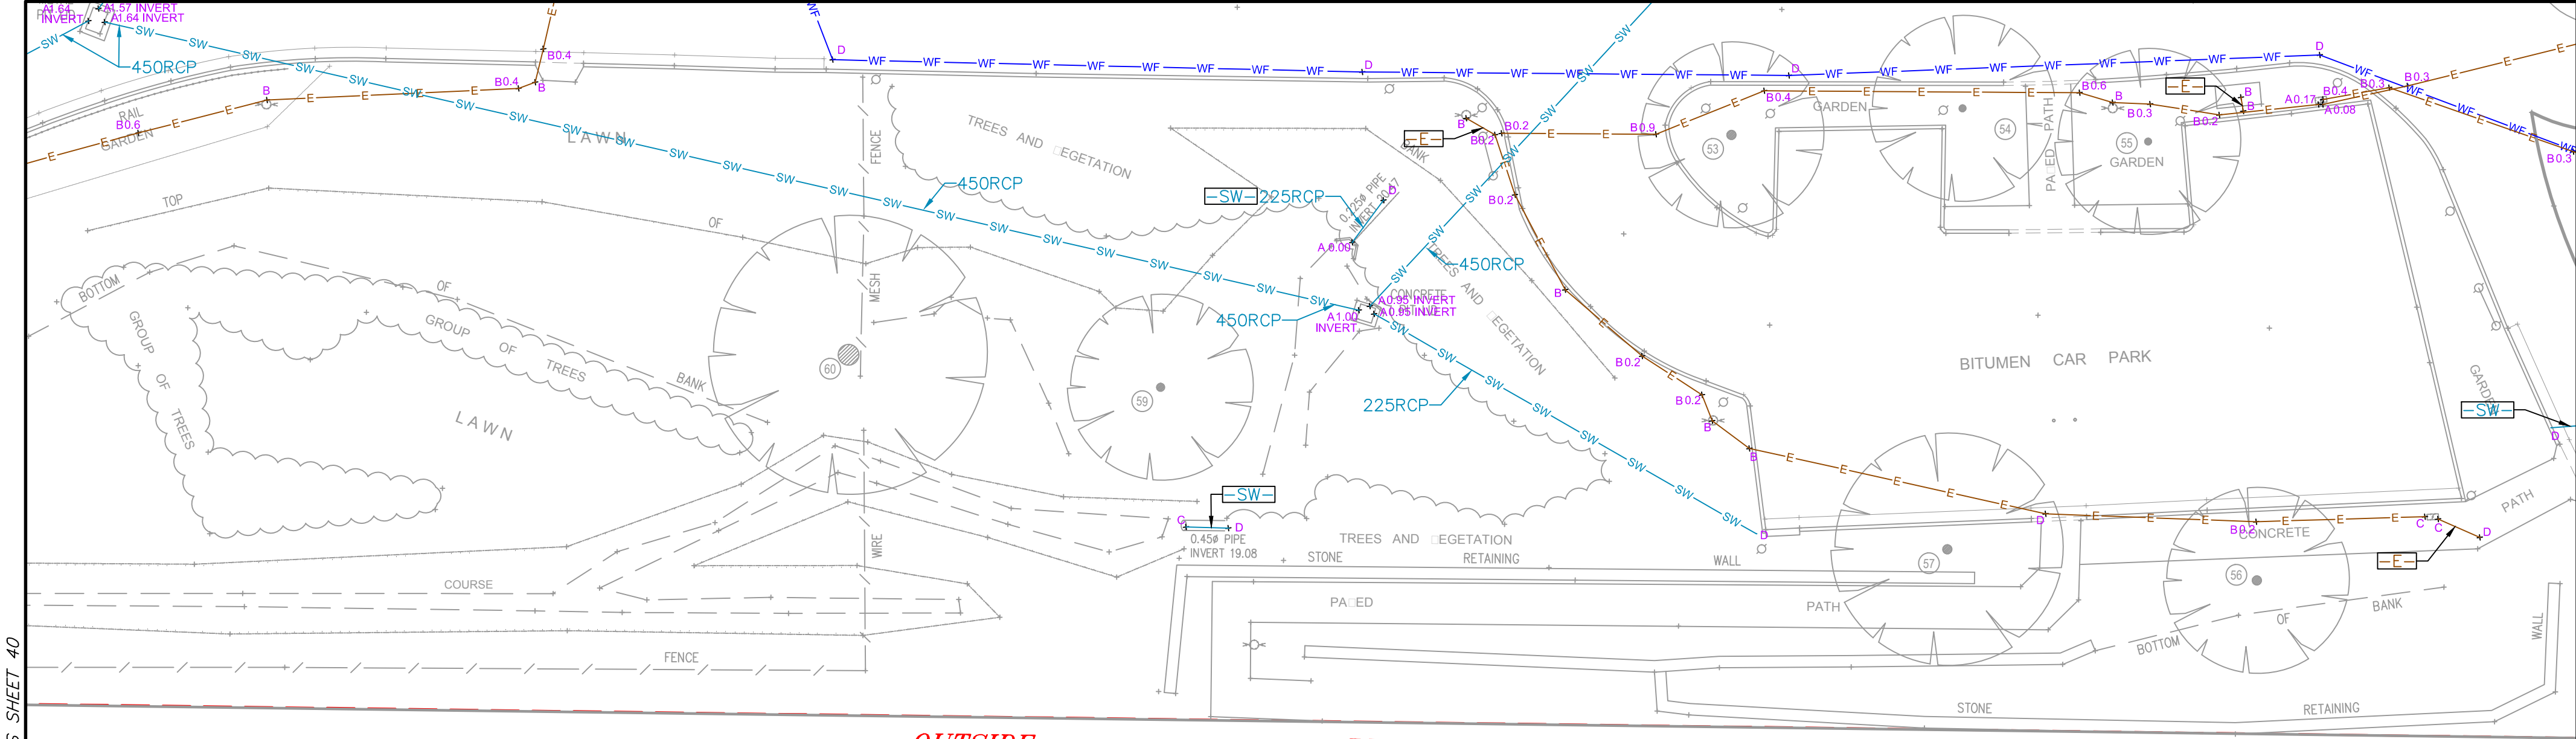

OUTSIDE PROJECT SCOPE



THIS PLAN IS INTENDED FOR DESIGN PURPOSES ONLY. IT DOES NOT REPLACE PLANS ISSUED BY UTILITY PROVIDERS THROUGH THE "DIAL BEFORE YOU DIG" SERVICE. CONTRACTORS ARE REMINDED OF THEIR OWN "DUTY OF CARE" & SHOULD CONDUCT THEIR OWN "DIAL BEFORE YOU DIG" PRIOR TO EXCAVATION/CONSTRUCTION.

\*\*\*\* WARNING: SERVICE PROVIDERS MAY SHARE CONDUITS &/OR TRENCHES AT THIS LOCATION \*\*\*\*

\*\*\*\* WARNING: UNKNOWN SERVICES MAY EXIST THAT COULD NOT BE ELECTRONICALLY DETECTED. SERVICE PROVIDER DIAGRAMS MAY NOT DEPICT ALL ASSETS WITHIN THEIR NETWORK \*\*\*\*

\*\*\*\* WARNING: SINGLE LINES MAY REPRESENT MULTIPLE CONDUITS, PIPES &/OR CABLES AT THIS LOCATION \*\*\*\*

| UTILITY POSITIONING CLASSIFICATION |                                                |       |           |
|------------------------------------|------------------------------------------------|-------|-----------|
| A                                  | VALIDATED, MEASURED DIRECTLY TO UTILITY (QL-A) | CLASS | CERTAINTY |
| B                                  | TRACED, ELECTRONIC DETECTION OF UTILITY (QL-B) |       | RISK      |
| C                                  | ALIGNED, TO UTILITY SURFACE FEATURES (QL-C)    |       |           |
| D                                  | INDICATIVE, AS PER DIAGRAMS/FEATURES (QL-D)    |       |           |

 DENOTES EXTENT OF INVESTIGATION AREA.  
 INVESTIGATION ISSUE, SEE COMMENTS ON SHEET.

| FOR SCHEDULE OF AMENDMENTS SEE SHEET 1 TABLE |                            |
|----------------------------------------------|----------------------------|
| SCALE 1:200                                  | ALL DISTANCES IN METRES    |
| CLIENT: - APPIAN GROUP                       | LOCATORS REFERENCE: 140623 |


**IMPORTANT REMINDER:**  
UTILITIES INDICATED AS CLASS "B","C"&"D" MAY BE INACCURATE IN BOTH VERTICAL & HORIZONTAL ALIGNMENTS.

UTILITY LINES PLOTTED ARE INTERPOLATED BETWEEN POINTS THAT HAVE BEEN GENERATED DURING THE UTILITY INVESTIGATION PROCESS. THE UPC IS SPECIFIC TO THE POINT AT WHICH IT IS INSERTED ON A LINE AND IS NOT A CLASSIFICATION OF THE LINE ITSELF.



Add us to your contacts

Prepared By:

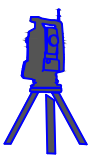


locating - surveying - consulting

www.locaters.com.au

THIS PLAN MUST BE READ IN CONJUNCTION WITH SHEET 1 AND SHEET 2 FOR ADDITIONAL NOTES, WARNINGS & LEGEND.

|                                                                                          |                   |                |          |
|------------------------------------------------------------------------------------------|-------------------|----------------|----------|
| CLIENT REGISTRATION No: N/A                                                              |                   |                |          |
| SUB-SURFACE UTILITY INFORMATION                                                          |                   |                |          |
| PLAN SHOWING UNDERGROUND UTILITIES AS INVESTIGATED & SURVEYED OVER WYONG HOSPITAL KANWAL |                   |                |          |
| DATUM: A.H.D                                                                             | SCALE: 1:200 @ A2 | SHEET 41 OF 45 | ISSUE: F |

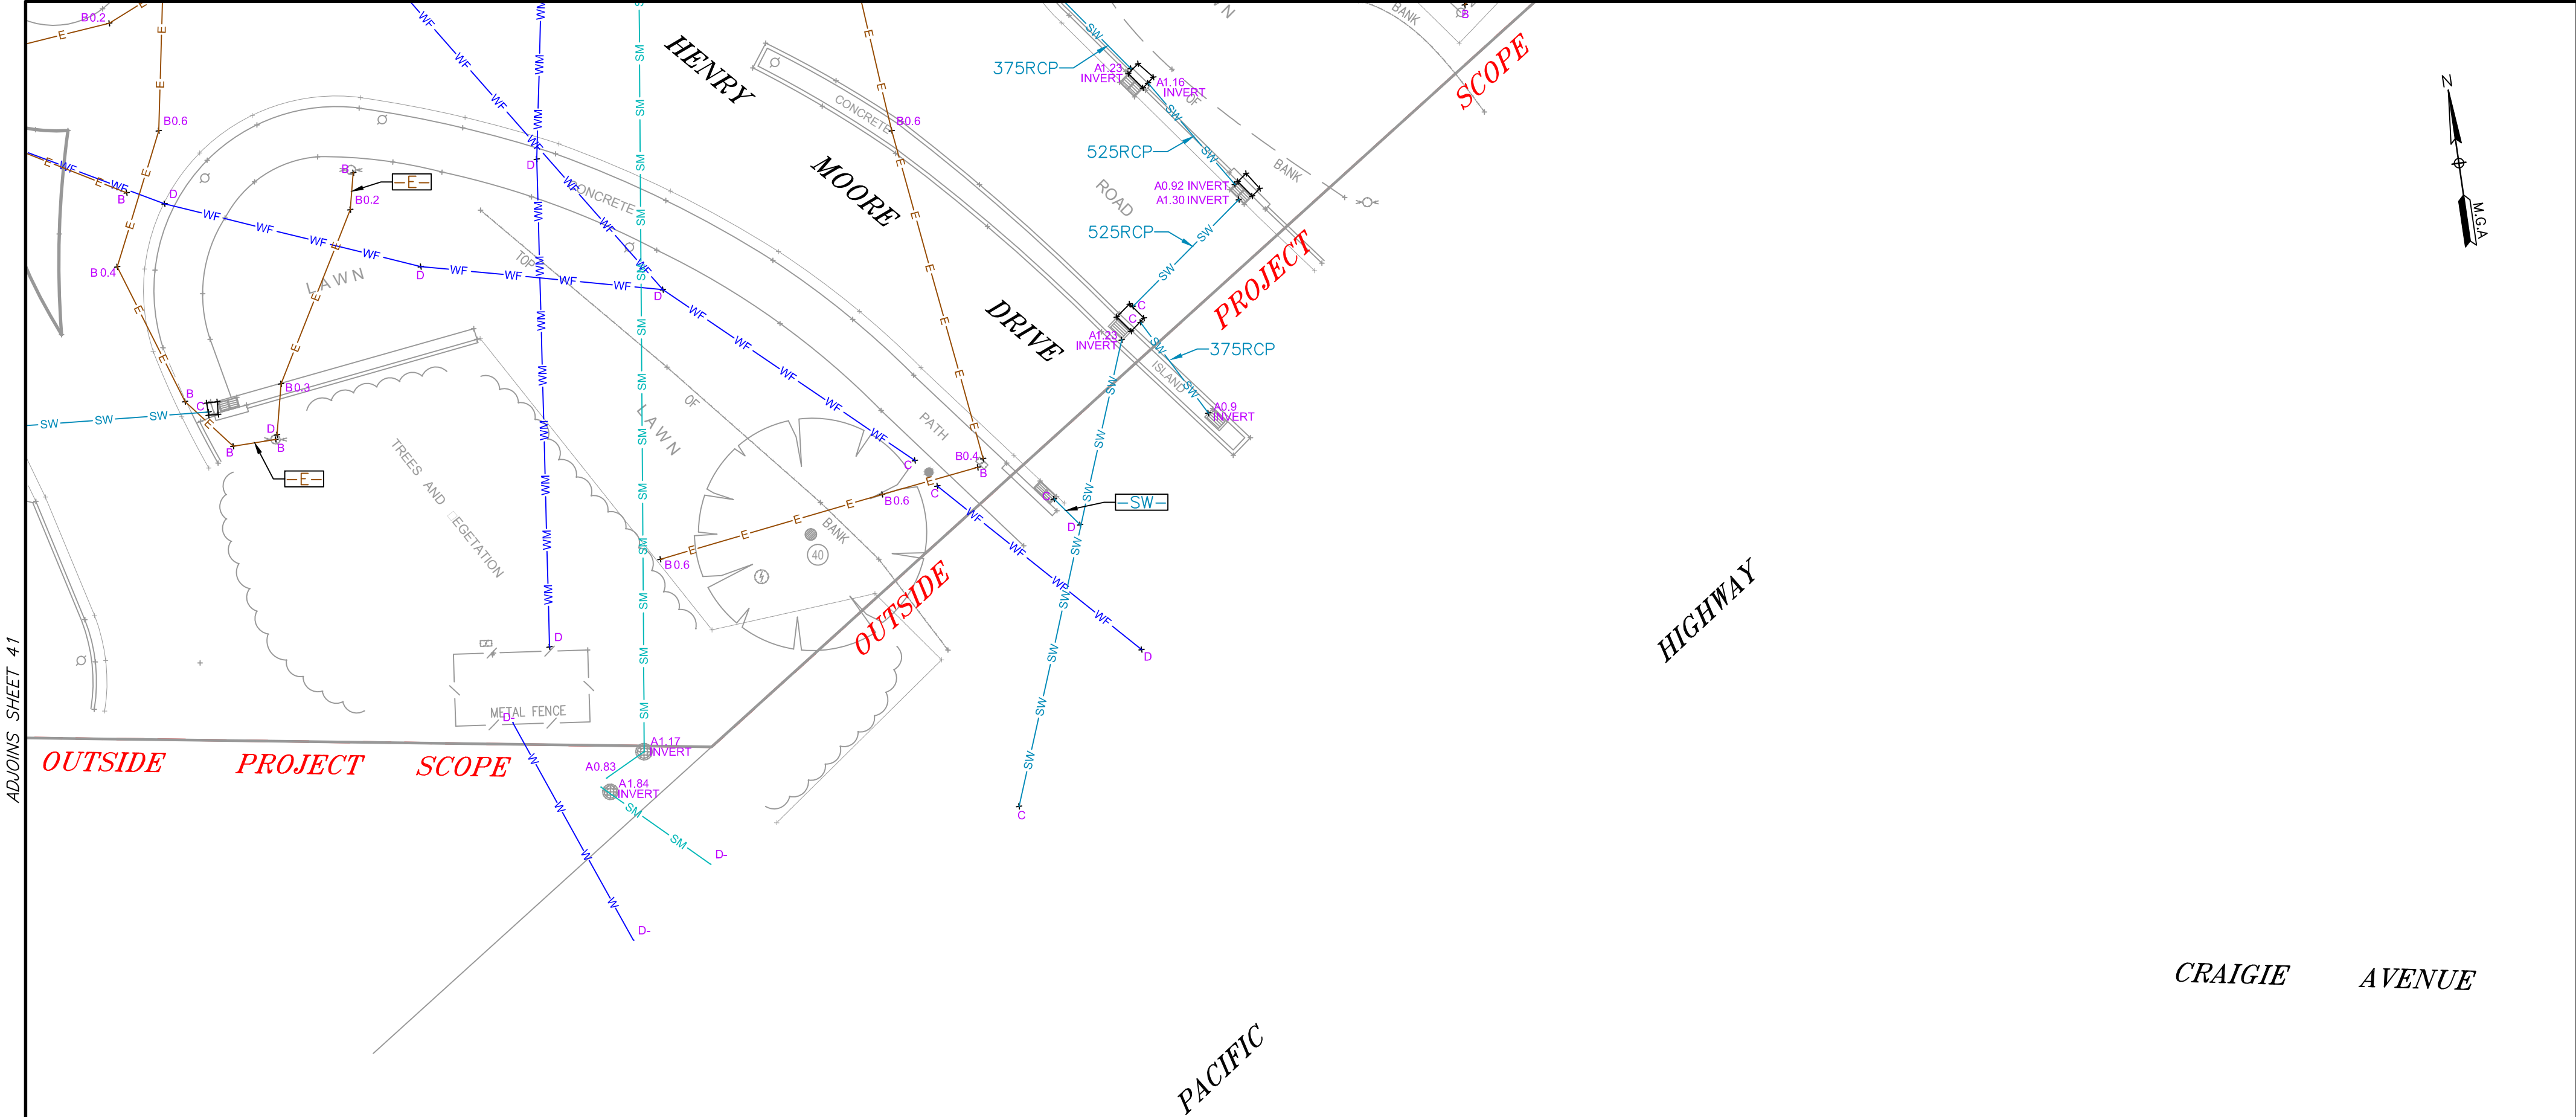

THIS PLAN IS INTENDED FOR DESIGN PURPOSES ONLY. IT DOES NOT REPLACE PLANS ISSUED BY UTILITY PROVIDERS THROUGH THE "DIAL BEFORE YOU DIG" SERVICE. CONTRACTORS ARE REMINDED OF THEIR OWN "DUTY OF CARE" & SHOULD CONDUCT THEIR OWN "DIAL BEFORE YOU DIG" PRIOR TO EXCAVATION/CONSTRUCTION.

\*\*\*\* WARNING: SERVICE PROVIDERS MAY SHARE CONDUITS &/OR TRENCHES AT THIS LOCATION \*\*\*\*

\*\*\*\* WARNING: UNKNOWN SERVICES MAY EXIST THAT COULD NOT BE ELECTRONICALLY DETECTED. SERVICE PROVIDER DIAGRAMS MAY NOT DEPICT ALL ASSETS WITHIN THEIR NETWORK \*\*\*\*

\*\*\*\* WARNING: SINGLE LINES MAY REPRESENT MULTIPLE CONDUITS, PIPES &/OR CABLES AT THIS LOCATION \*\*\*\*

| UTILITY POSITIONING CLASSIFICATION |                                                |           |      |
|------------------------------------|------------------------------------------------|-----------|------|
| A                                  | VALIDATED, MEASURED DIRECTLY TO UTILITY (QL-A) | CERTAINTY | RISK |
| B                                  | TRACED, ELECTRONIC DETECTION OF UTILITY (QL-B) |           |      |
| C                                  | ALIGNED, TO UTILITY SURFACE FEATURES (QL-C)    |           |      |
| D                                  | INDICATIVE, AS PER DIAGRAMS/FEATURES (QL-D)    |           |      |

DENOTES EXTENT OF INVESTIGATION AREA.  
 INVESTIGATION ISSUE, SEE COMMENTS ON SHEET.

| FOR SCHEDULE OF AMENDMENTS SEE SHEET 1 TABLE |                            |
|----------------------------------------------|----------------------------|
| SCALE 1:200                                  | ALL DISTANCES IN METRES    |
| CLIENT: - APPIAN GROUP                       | LOCATORS REFERENCE: 140623 |

**IMPORTANT REMINDER:**  
UTILITIES INDICATED AS CLASS "B","C"&"D" MAY BE INACCURATE IN BOTH VERTICAL & HORIZONTAL ALIGNMENTS.  
UTILITY LINES PLOTTED ARE INTERPOLATED BETWEEN POINTS THAT HAVE BEEN GENERATED DURING THE UTILITY INVESTIGATION PROCESS. THE UPC IS SPECIFIC TO THE POINT AT WHICH IT IS INSERTED ON A LINE AND IS NOT A CLASSIFICATION OF THE LINE ITSELF.










Prepared By:

locating - surveying - consulting  
[www.locaters.com.au](http://www.locaters.com.au)

THIS PLAN MUST BE READ IN CONJUNCTION WITH SHEET 1 AND SHEET 2 FOR ADDITIONAL NOTES, WARNINGS & LEGEND.

|                                                                                          |                   |                |          |
|------------------------------------------------------------------------------------------|-------------------|----------------|----------|
| CLIENT REGISTRATION No: N/A                                                              |                   |                |          |
| SUB-SURFACE UTILITY INFORMATION                                                          |                   |                |          |
| PLAN SHOWING UNDERGROUND UTILITIES AS INVESTIGATED & SURVEYED OVER WYONG HOSPITAL KANWAL |                   |                |          |
| DATUM: A.H.D                                                                             | SCALE: 1:200 © A2 | SHEET 42 OF 45 | ISSUE: F |

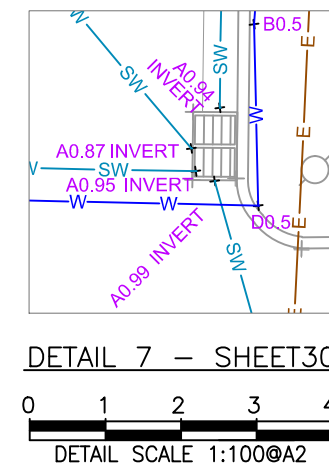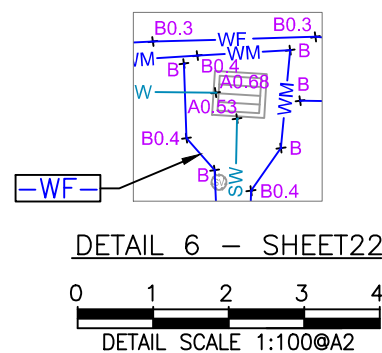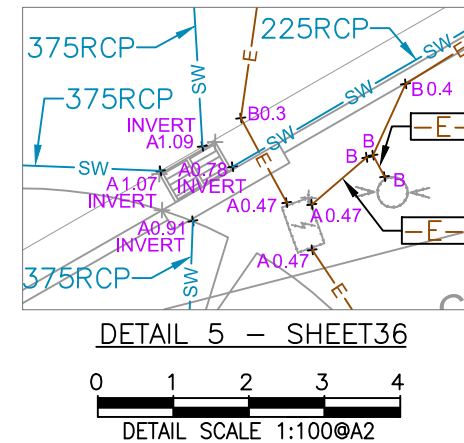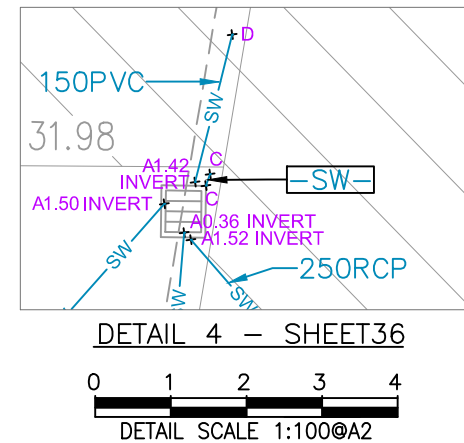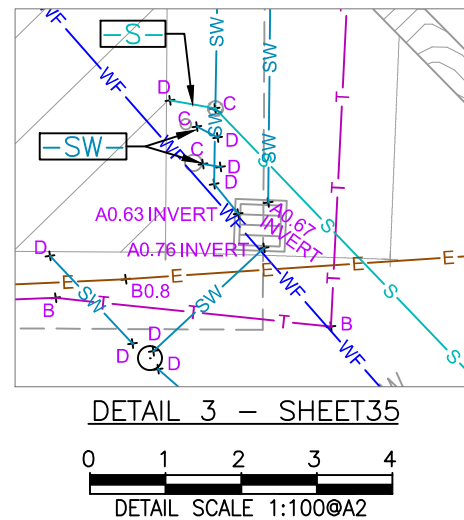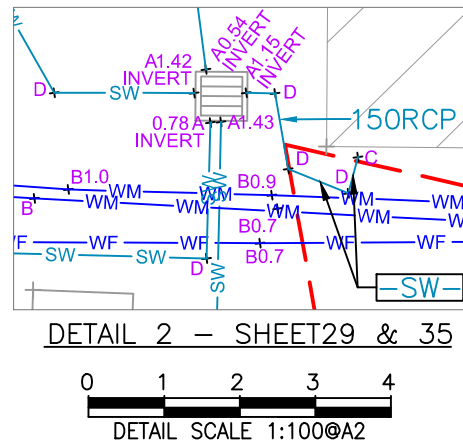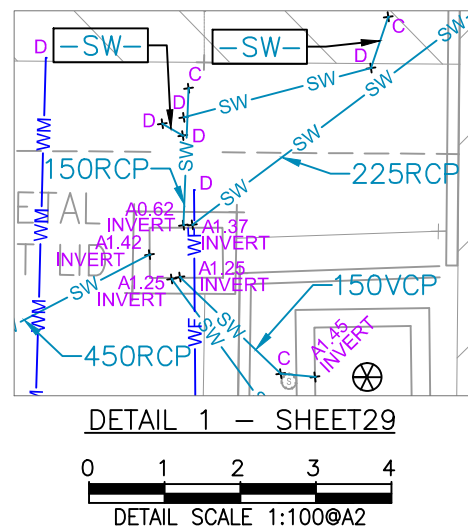

THIS PLAN IS INTENDED FOR DESIGN PURPOSES ONLY. IT DOES NOT REPLACE PLANS ISSUED BY UTILITY PROVIDERS THROUGH THE "DIAL BEFORE YOU DIG" SERVICE. CONTRACTORS ARE REMINDED OF THEIR OWN "DUTY OF CARE" & SHOULD CONDUCT THEIR OWN "DIAL BEFORE YOU DIG" PRIOR TO EXCAVATION/CONSTRUCTION.

\*\*\*\* WARNING: SERVICE PROVIDERS MAY SHARE CONDUITS &/OR TRENCHES AT THIS LOCATION \*\*\*\*

\*\*\*\* WARNING: UNKNOWN SERVICES MAY EXIST THAT COULD NOT BE ELECTRONICALLY DETECTED. SERVICE PROVIDER DIAGRAMS MAY NOT DEPICT ALL ASSETS WITHIN THEIR NETWORK \*\*\*\*

\*\*\*\* WARNING: SINGLE LINES MAY REPRESENT MULTIPLE CONDUITS, PIPES &/OR CABLES AT THIS LOCATION \*\*\*\*

| UTILITY POSITIONING CLASSIFICATION |                                                |
|------------------------------------|------------------------------------------------|
| A                                  | VALIDATED, MEASURED DIRECTLY TO UTILITY (QL-A) |
| B                                  | TRACED, ELECTRONIC DETECTION OF UTILITY (QL-B) |
| C                                  | ALIGNED, TO UTILITY SURFACE FEATURES (QL-C)    |
| D                                  | INDICATIVE, AS PER DIAGRAMS/FEATURES (QL-D)    |

[[[ DENOTES EXTENT OF INVESTIGATION AREA.  
[[[ INVESTIGATION ISSUE, SEE COMMENTS ON SHEET.

|                                              |                            |
|----------------------------------------------|----------------------------|
| FOR SCHEDULE OF AMENDMENTS SEE SHEET 1 TABLE |                            |
| CLIENT: - APPIAN GROUP                       | LOCATERS REFERENCE: 140623 |

**IMPORTANT REMINDER:**  
UTILITIES INDICATED AS CLASS "B","C"&"D" MAY BE INACCURATE IN BOTH VERTICAL & HORIZONTAL ALIGNMENTS.  
UTILITY LINES PLOTTED ARE INTERPOLATED BETWEEN POINTS THAT HAVE BEEN GENERATED DURING THE UTILITY INVESTIGATION PROCESS. THE UPC IS SPECIFIC TO THE POINT AT WHICH IT IS INSERTED ON A LINE AND IS NOT A CLASSIFICATION OF THE LINE ITSELF.





Add us to your contacts

THIS PLAN MUST BE READ IN CONJUNCTION WITH SHEET 1 AND SHEET 2 FOR ADDITIONAL NOTES, WARNINGS & LEGEND.

|                                                                                          |                   |                |          |
|------------------------------------------------------------------------------------------|-------------------|----------------|----------|
| CLIENT REGISTRATION No: N/A                                                              |                   |                |          |
| SUB-SURFACE UTILITY INFORMATION                                                          |                   |                |          |
| PLAN SHOWING UNDERGROUND UTILITIES AS INVESTIGATED & SURVEYED OVER WYONG HOSPITAL KANWAL |                   |                |          |
| DATUM: A.H.D                                                                             | SCALE: 1:100 @ A2 | SHEET 43 OF 45 | ISSUE: F |

Prepared By:  
**Locaters**  
UTILITY SURVEYS  
locating - surveying - consulting  
www.locaters.com.au

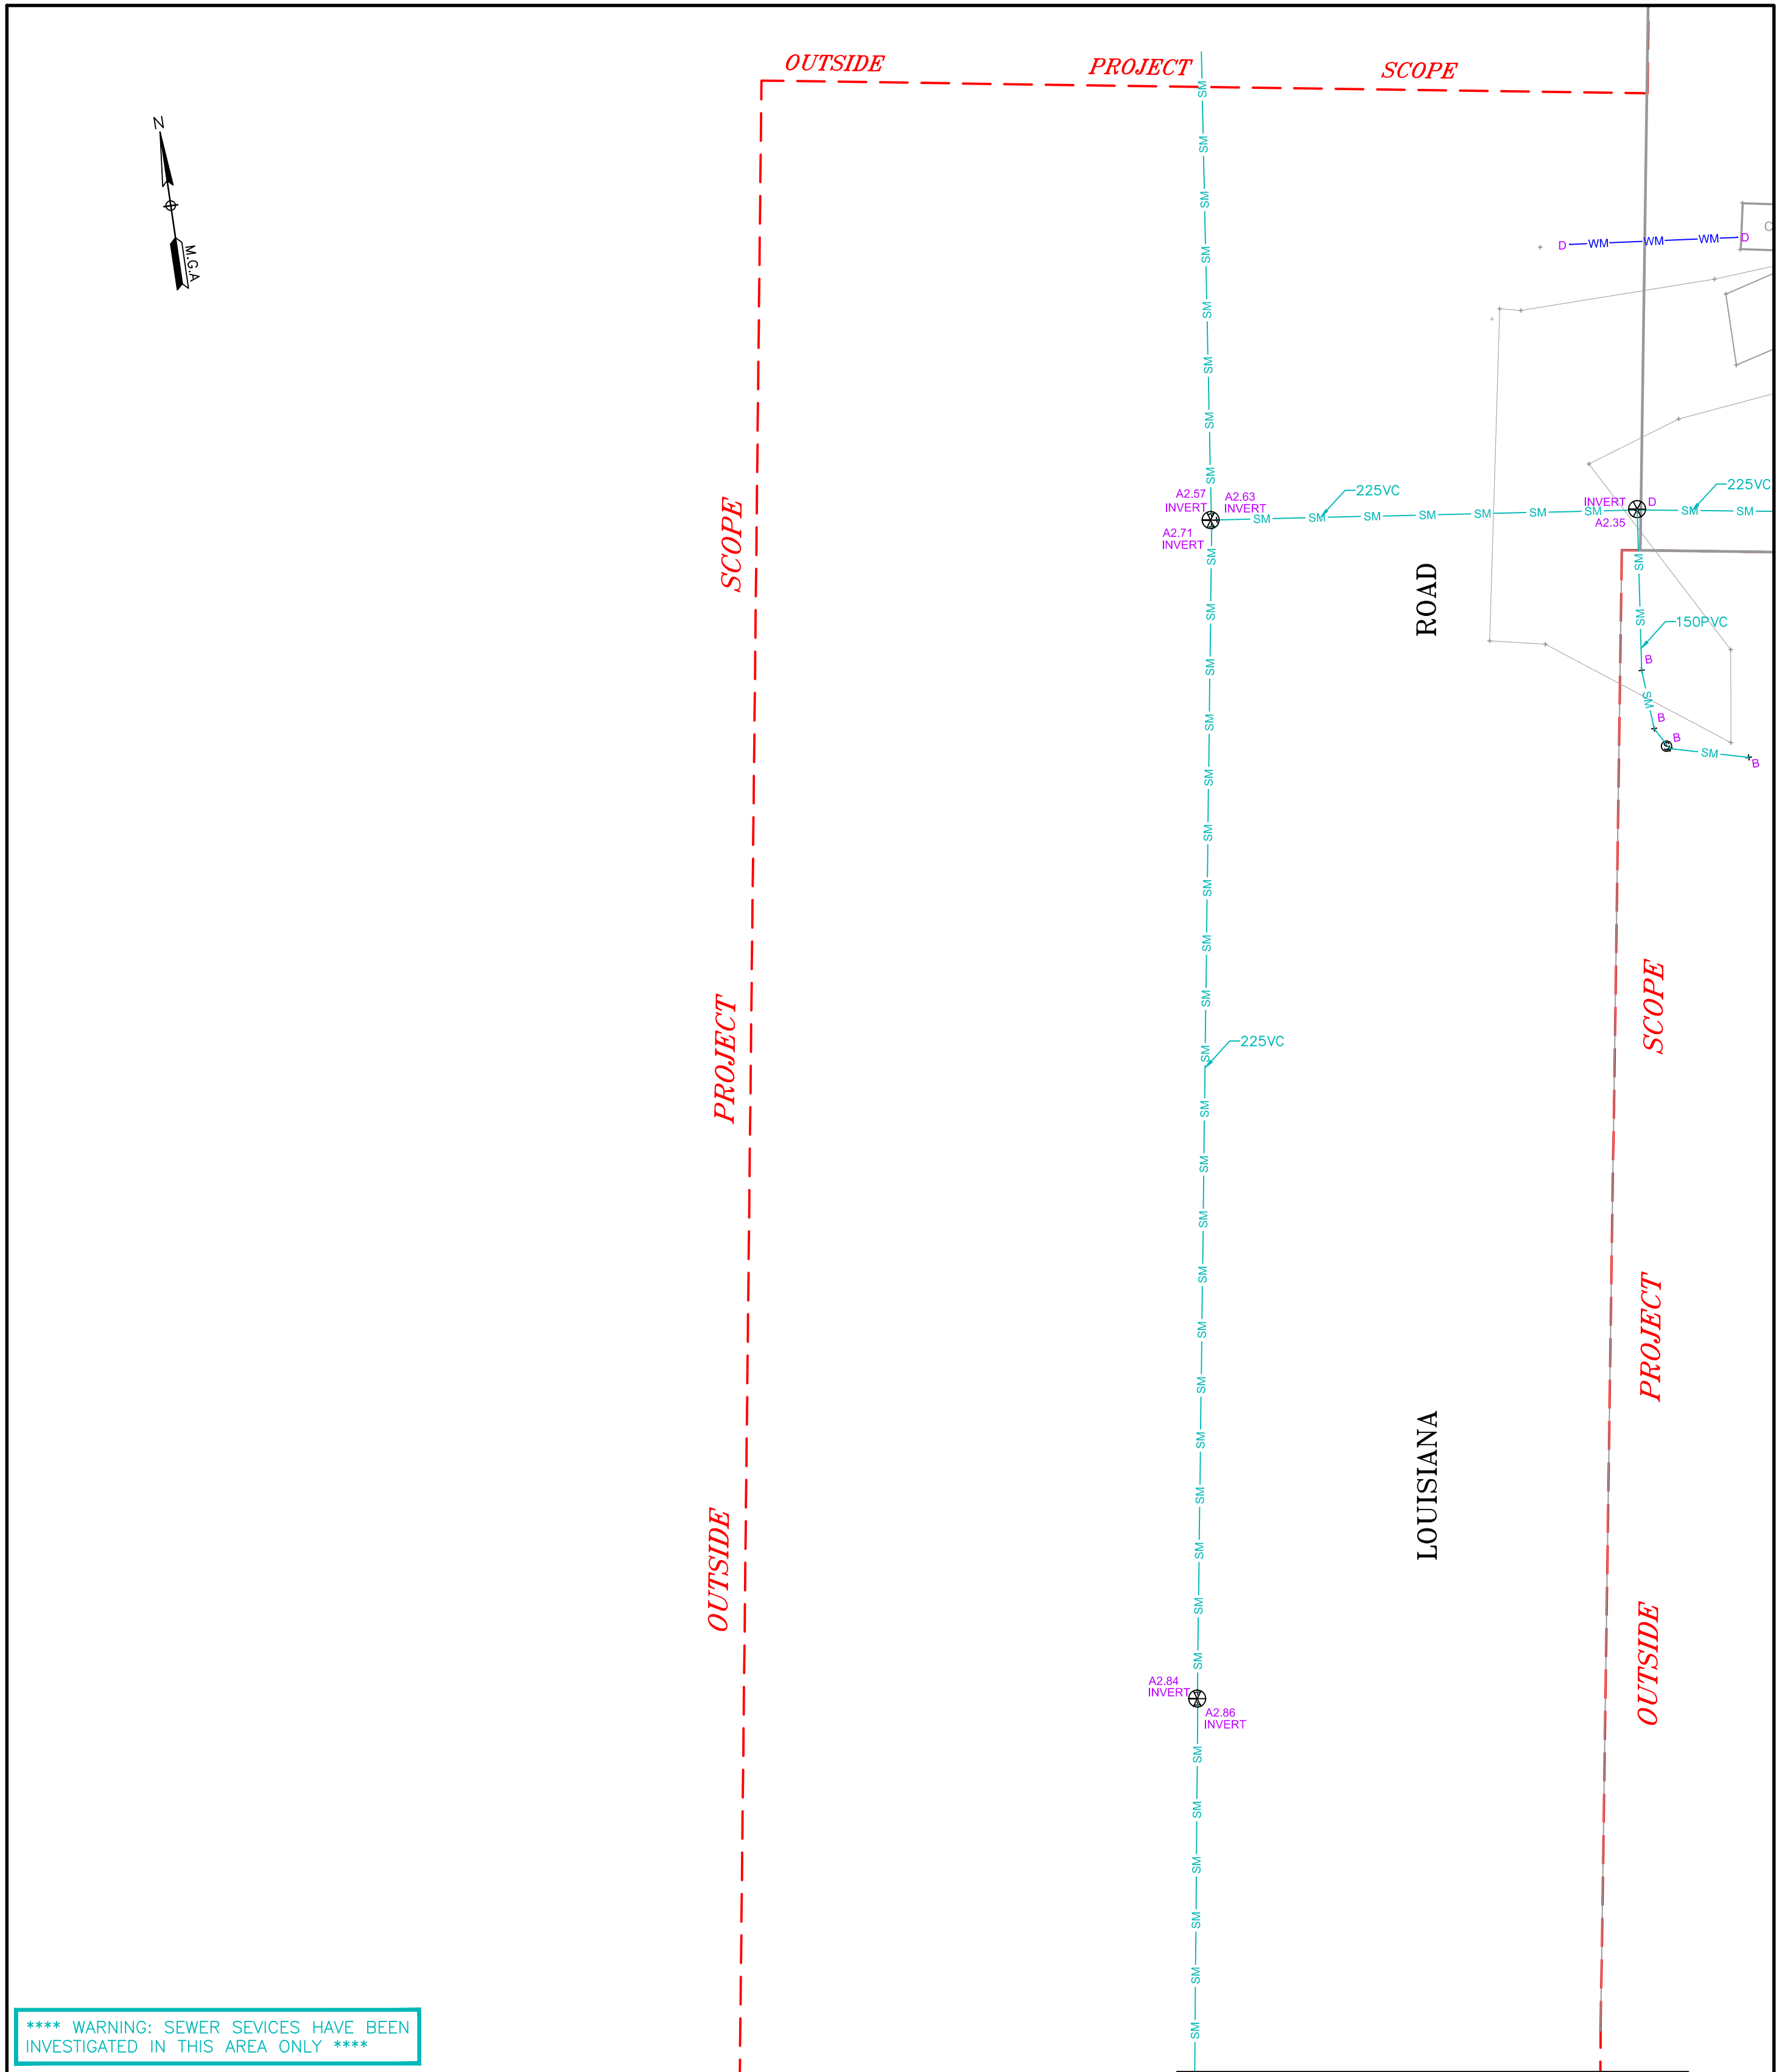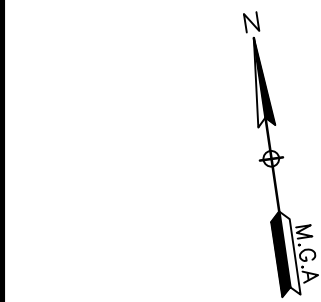

\*\*\*\* WARNING: SEWER SERVICES HAVE BEEN INVESTIGATED IN THIS AREA ONLY \*\*\*\*



\*\*\*\* WARNING: SERVICE PROVIDERS MAY SHARE CONDUITS &/OR TRENCHES AT THIS LOCATION \*\*\*\*

\*\*\*\* WARNING: UNKNOWN SERVICES MAY EXIST THAT COULD NOT BE ELECTRONICALLY DETECTED. SERVICE PROVIDER DIAGRAMS MAY NOT DEPICT ALL ASSETS WITHIN THEIR NETWORK \*\*\*\*

\*\*\*\* WARNING: SINGLE LINES MAY REPRESENT MULTIPLE CONDUITS, PIPES &/OR CABLES AT THIS LOCATION \*\*\*\*

THIS PLAN IS INTENDED FOR DESIGN PURPOSES ONLY. IT DOES NOT REPLACE PLANS ISSUED BY UTILITY PROVIDERS THROUGH THE "DIAL BEFORE YOU DIG" SERVICE. CONTRACTORS ARE REMINDED OF THEIR OWN "DUTY OF CARE" & SHOULD CONDUCT THEIR OWN "DIAL BEFORE YOU DIG" PRIOR TO EXCAVATION/CONSTRUCTION.

ADJOINS SHEET 45

| UTILITY POSITIONING CLASSIFICATION |                                                |
|------------------------------------|------------------------------------------------|
| A                                  | VALIDATED, MEASURED DIRECTLY TO UTILITY (QL-A) |
| B                                  | TRACED, ELECTRONIC DETECTION OF UTILITY (QL-B) |
| C                                  | ALIGNED, TO UTILITY SURFACE FEATURES (QL-C)    |
| D                                  | INDICATIVE, AS PER DIAGRAMS/FEATURES (QL-D)    |

**IMPORTANT REMINDER:**

UTILITIES INDICATED AS CLASS "B","C"&"D" MAY BE INACCURATE IN BOTH VERTICAL & HORIZONTAL ALIGNMENTS.


UTILITY LINES PLOTTED ARE INTERPOLATED BETWEEN POINTS THAT HAVE BEEN GENERATED DURING THE UTILITY INVESTIGATION PROCESS. THE UPC IS SPECIFIC TO THE POINT AT WHICH IT IS INSERTED ON A LINE AND IS NOT A CLASSIFICATION OF THE LINE ITSELF.



locating - surveying - consulting

[www.locaters.com.au](http://www.locaters.com.au)


Prepared By:

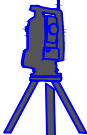




Add us to your contacts


THIS PLAN MUST BE READ IN CONJUNCTION WITH SHEET 1 AND SHEET 2 FOR ADDITIONAL NOTES, WARNINGS & LEGEND.

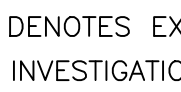 DENOTES EXTENT OF INVESTIGATION AREA.  
 INVESTIGATION ISSUE, SEE COMMENTS ON SHEET.
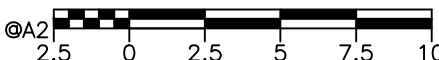
|                                                                                                   |              |                                                                                       |                                      |
|---------------------------------------------------------------------------------------------------|--------------|---------------------------------------------------------------------------------------|--------------------------------------|
| FOR SCHEDULE OF AMENDMENTS SEE SHEET 1 TABLE                                                      |              |                                                                                       |                                      |
| SCALE 1:250                                                                                       |              |  | ALL DISTANCES<br>IN METRES           |
| CLIENT: – APPIAN GROUP                                                                            |              |                                                                                       | LOCATORS REFERENCE:<br><b>140623</b> |
| CLIENT REGISTRATION No: N/A                                                                       |              |                                                                                       |                                      |
| SUB–SURFACE UTILITY INFORMATION                                                                   |              |                                                                                       |                                      |
| PLAN SHOWING UNDERGROUND UTILITIES AS<br>INVESTIGATED & SURVEYED OVER<br>WYONG HOSPITAL<br>KANWAL |              |                                                                                       |                                      |
| DATUM: A.H.D                                                                                      | SCALE: 1:250 | © A2                                                                                  | SHEET 44 OF 45                       |
|                                                                                                   |              |                                                                                       | ISSUE: <b>F</b>                      |

ADJOINS SHEET 17

Locaters General Template - Revision 17.0

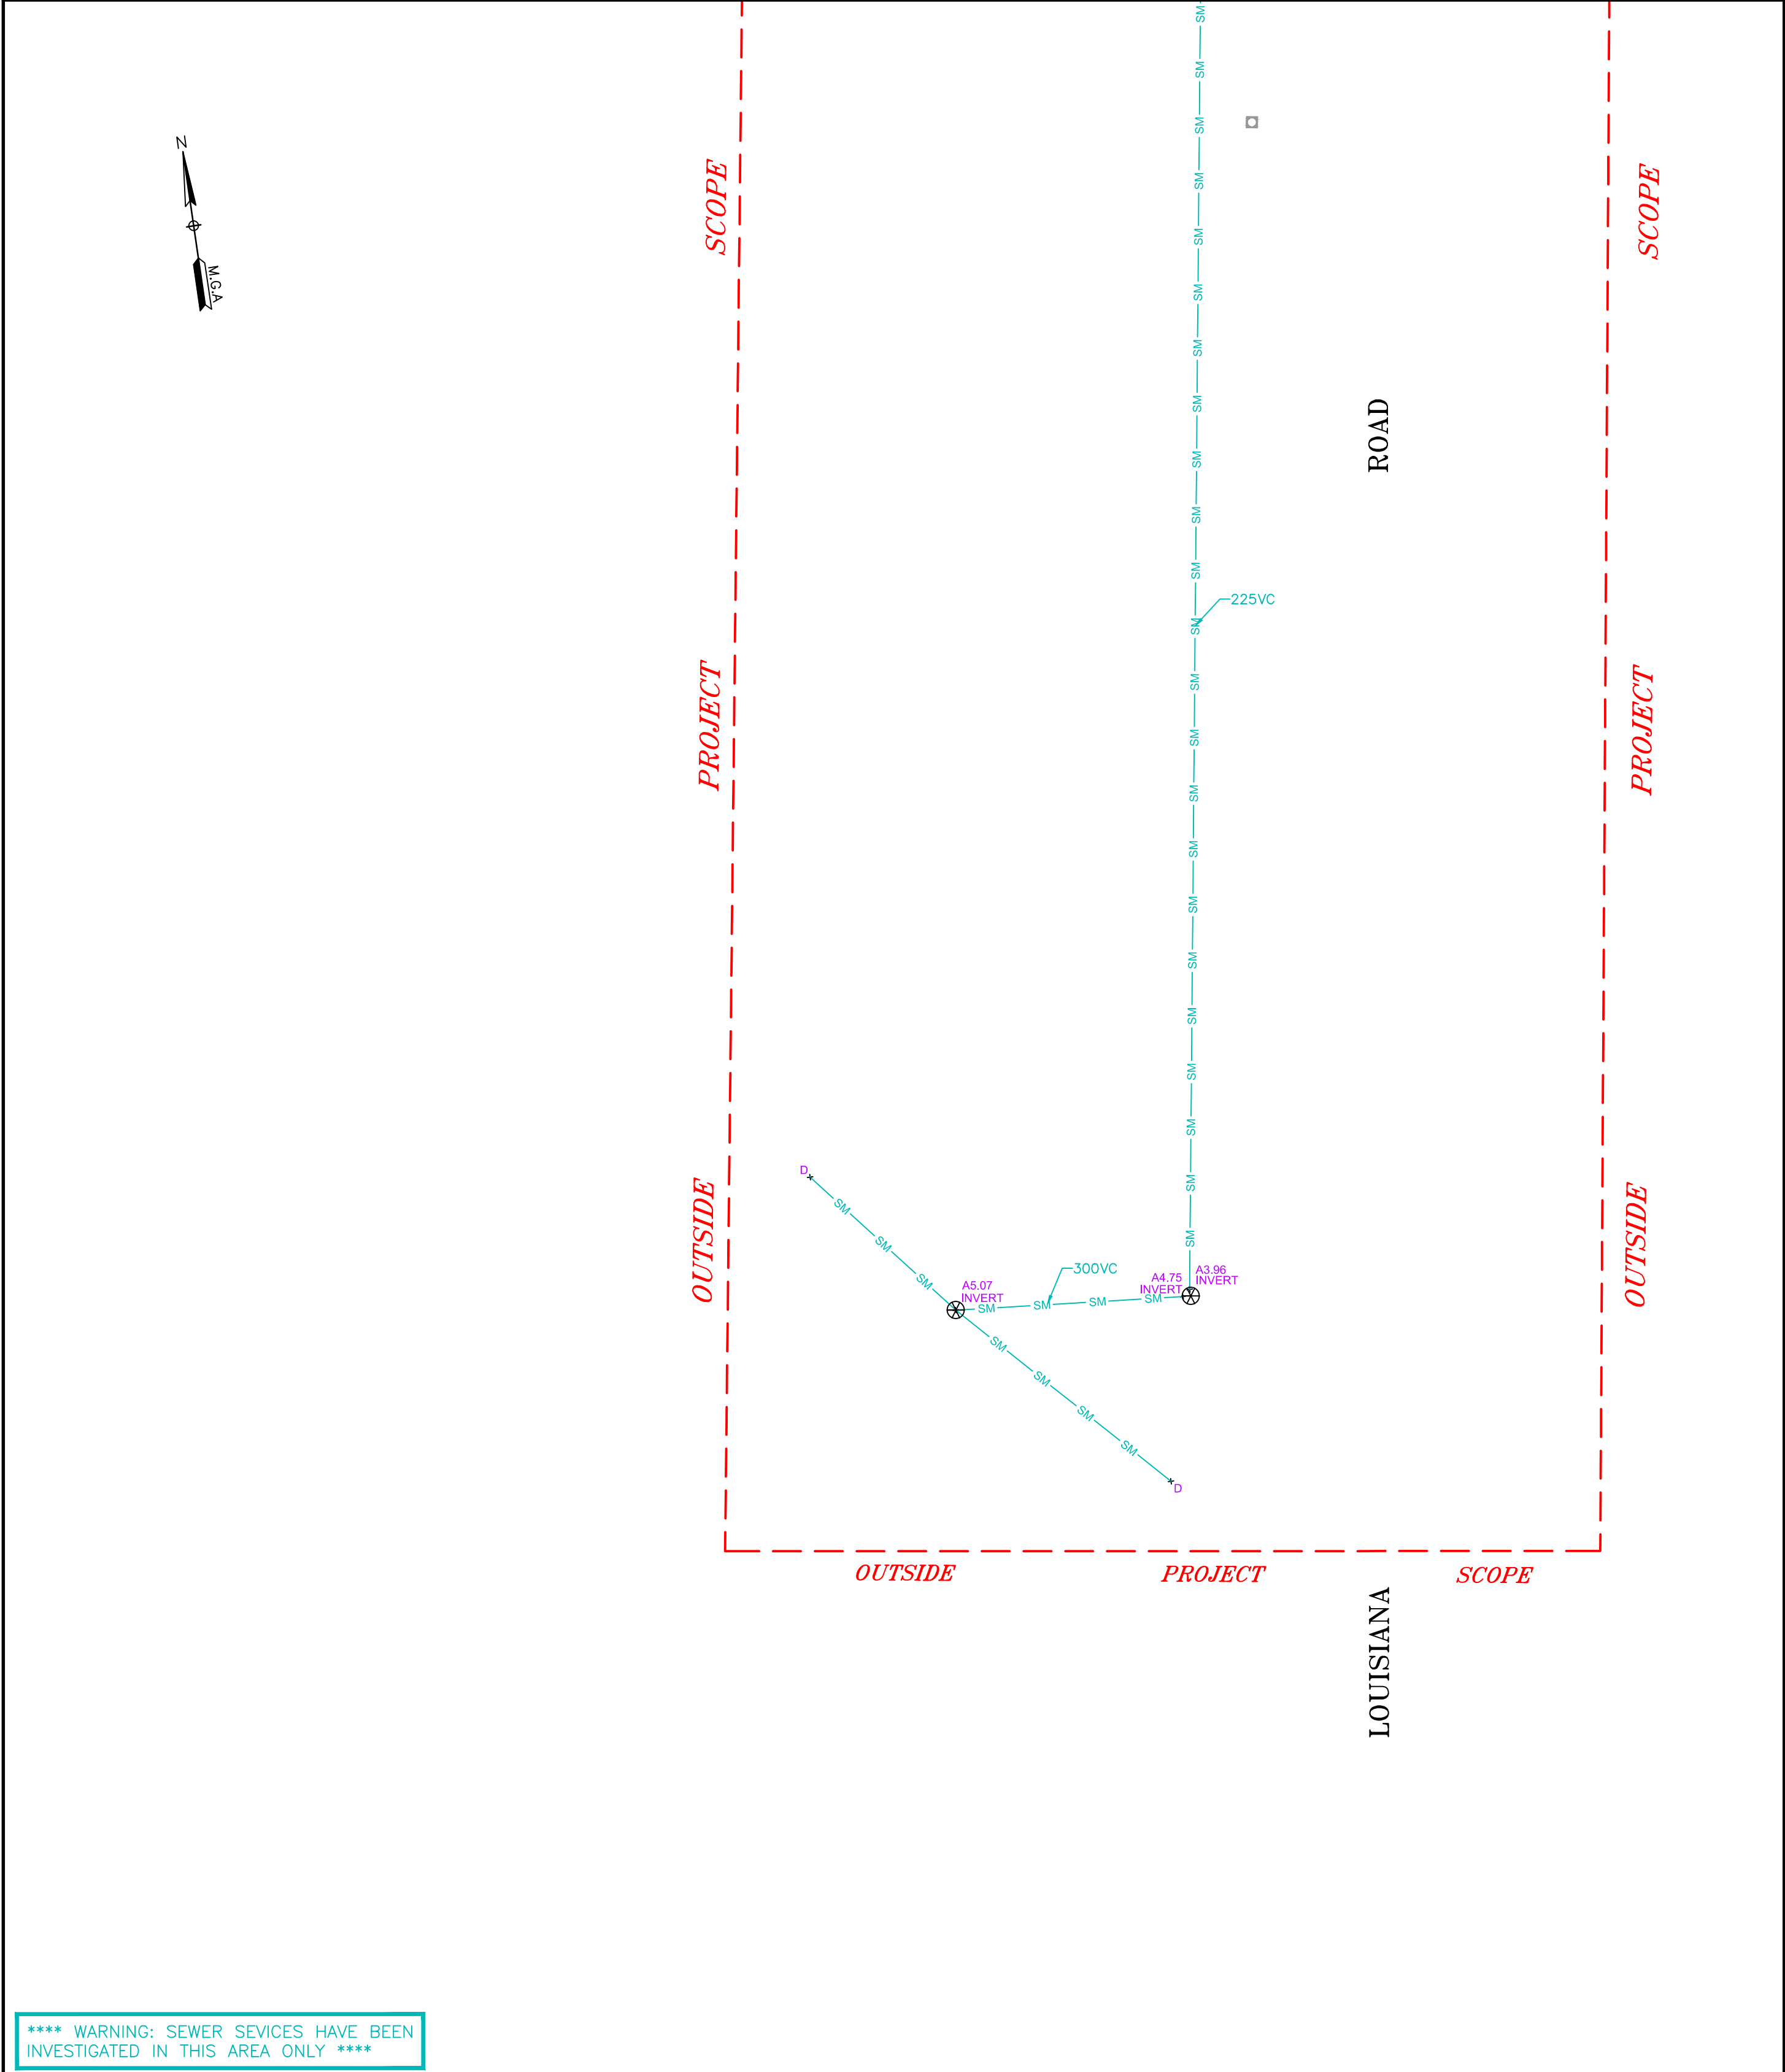

\*\*\*\* WARNING: SEWER SERVICES HAVE BEEN INVESTIGATED IN THIS AREA ONLY \*\*\*\*



THIS PLAN IS INTENDED FOR DESIGN PURPOSES ONLY. IT DOES NOT REPLACE PLANS ISSUED BY UTILITY PROVIDERS THROUGH THE "DIAL BEFORE YOU DIG" SERVICE. CONTRACTORS ARE REMINDED OF THEIR OWN "DUTY OF CARE" & SHOULD CONDUCT THEIR OWN "DIAL BEFORE YOU DIG" PRIOR TO EXCAVATION/CONSTRUCTION.

\*\*\*\* WARNING: SERVICE PROVIDERS MAY SHARE CONDUITS &/OR TRENCHES AT THIS LOCATION \*\*\*\*

\*\*\*\* WARNING: UNKNOWN SERVICES MAY EXIST THAT COULD NOT BE ELECTRONICALLY DETECTED. SERVICE PROVIDER DIAGRAMS MAY NOT DEPICT ALL ASSETS WITHIN THEIR NETWORK \*\*\*\*

\*\*\*\* WARNING: SINGLE LINES MAY REPRESENT MULTIPLE CONDUITS, PIPES &/OR CABLES AT THIS LOCATION \*\*\*\*

UTILITY POSITIONING CLASSIFICATION

A

B

C

D

VALIDATED, MEASURED DIRECTLY TO UTILITY (QL-A)

TRACED, ELECTRONIC DETECTION OF UTILITY (QL-B)

ALIGNED, TO UTILITY SURFACE FEATURES (QL-C)

INDICATIVE, AS PER DIAGRAMS/FEATURES (QL-D)

CERTAINTY

RISK

**IMPORTANT REMINDER:**

UTILITIES INDICATED AS CLASS "B","C"&"D" MAY BE INACCURATE IN BOTH VERTICAL & HORIZONTAL ALIGNMENTS.

UTILITY LINES PLOTTED ARE INTERPOLATED BETWEEN POINTS THAT HAVE BEEN GENERATED DURING THE UTILITY INVESTIGATION PROCESS. THE UPC IS SPECIFIC TO THE POINT AT WHICH IT IS INSERTED ON A LINE AND IS NOT A CLASSIFICATION OF THE LINE ITSELF.

Locaters

UTILITY SURVEYS

locating - surveying - consulting


www.locaters.com.au


Prepared By:



THIS PLAN MUST BE READ IN CONJUNCTION WITH SHEET 1 AND SHEET 2 FOR ADDITIONAL NOTES, WARNINGS & LEGEND.

DENOTES EXTENT OF INVESTIGATION AREA.  
 INVESTIGATION ISSUE, SEE COMMENTS ON SHEET.
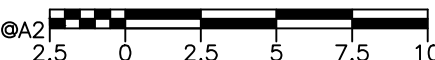
|                                                                                                   |  |                                                                                       |                                      |                            |  |                 |  |
|---------------------------------------------------------------------------------------------------|--|---------------------------------------------------------------------------------------|--------------------------------------|----------------------------|--|-----------------|--|
| FOR SCHEDULE OF AMENDMENTS SEE SHEET 1 TABLE                                                      |  |                                                                                       |                                      |                            |  |                 |  |
| SCALE 1:250                                                                                       |  |  |                                      | ALL DISTANCES<br>IN METRES |  |                 |  |
| CLIENT: – APPIAN GROUP                                                                            |  |                                                                                       | LOCATORS REFERENCE:<br><b>140623</b> |                            |  |                 |  |
| CLIENT REGISTRATION No: N/A                                                                       |  |                                                                                       |                                      |                            |  |                 |  |
| SUB–SURFACE UTILITY INFORMATION                                                                   |  |                                                                                       |                                      |                            |  |                 |  |
| PLAN SHOWING UNDERGROUND UTILITIES AS<br>INVESTIGATED & SURVEYED OVER<br>WYONG HOSPITAL<br>KANWAL |  |                                                                                       |                                      |                            |  |                 |  |
| DATUM: A.H.D                                                                                      |  | SCALE: 1:250 @ A2                                                                     |                                      | SHEET 45 OF 45             |  | ISSUE: <b>F</b> |  |

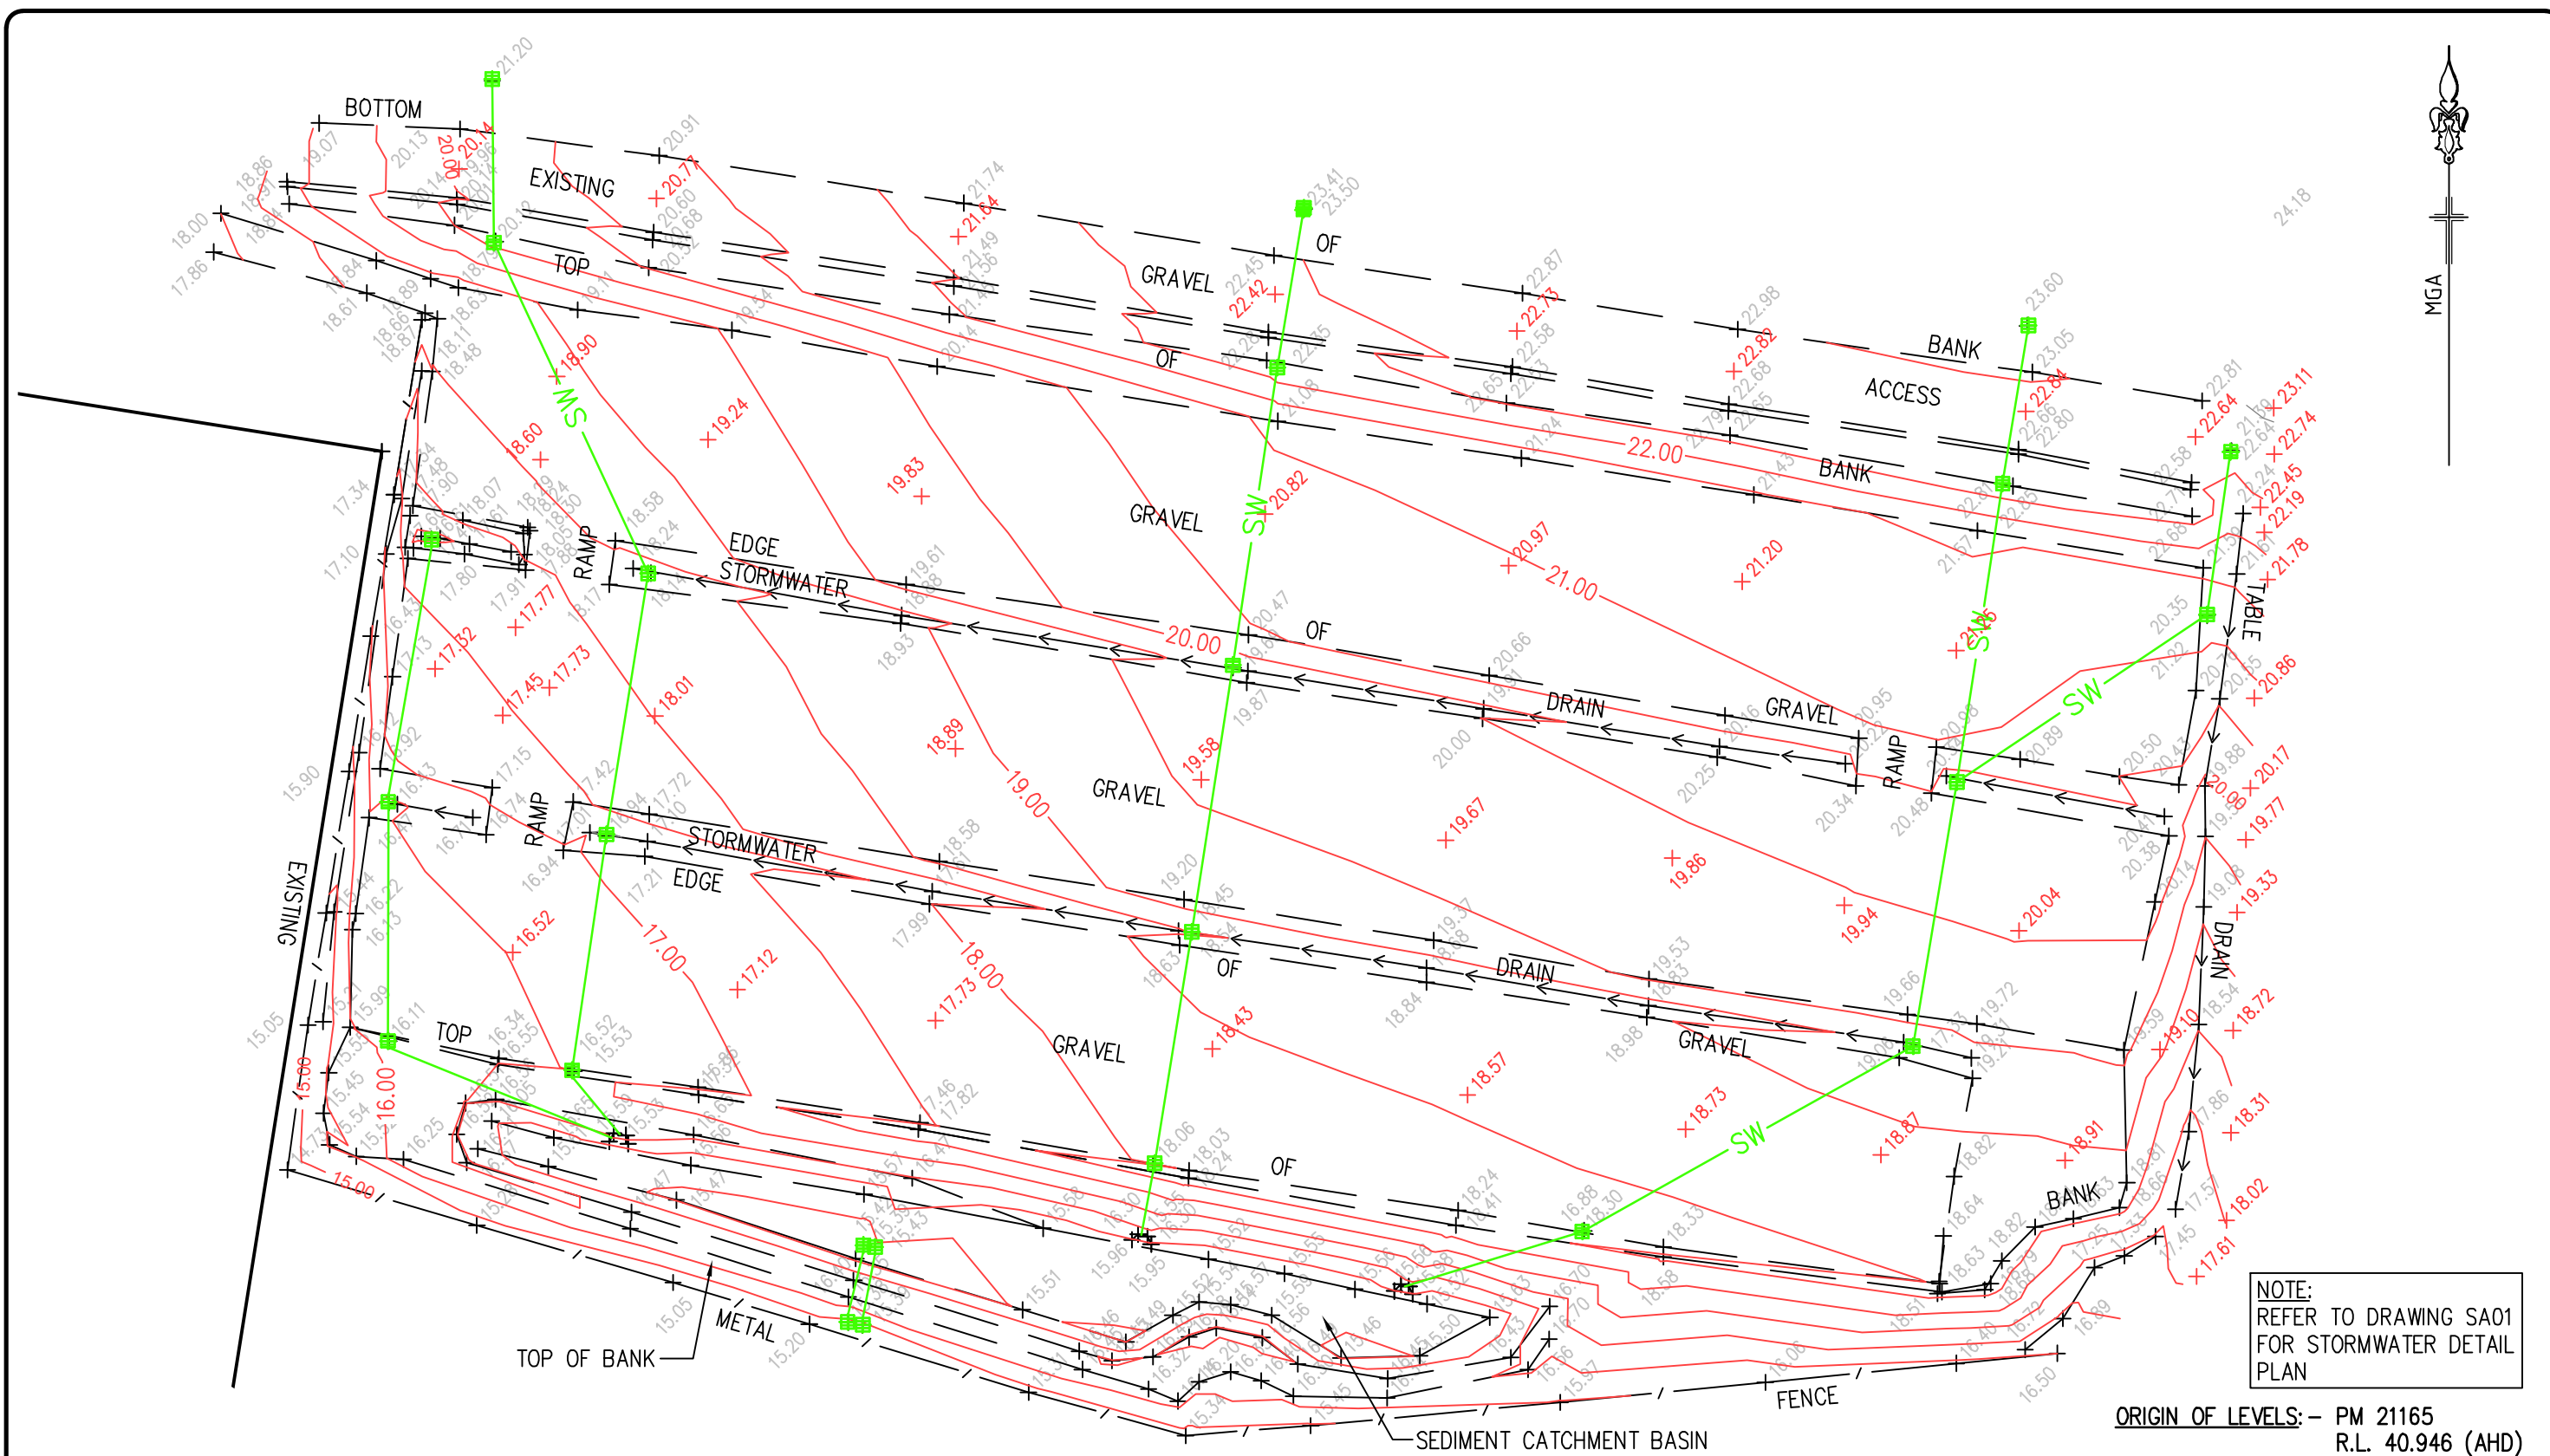

NOTE:  
REFER TO DRAWING SA01  
FOR STORMWATER DETAIL  
PLAN

ORIGIN OF LEVELS: - PM 21165  
R.L. 40.946 (AHD)

|         |                  |          |
|---------|------------------|----------|
|         |                  |          |
|         |                  |          |
| A       | ISSUED TO CLIENT | 20.09.18 |
| REV No. | REMARKS          | DATE     |
|         | AMENDMENTS       |          |


CLIENT:  
  
PROJECT COORDINATION  
(AUSTRALIA) Pty Ltd  
PO BOX 595  
UNDERRA  
NSW 2526



TREHY INGOLD NEATE  
LAND DEVELOPMENT  
SURVEYING  
PLANNING  
CIVIL DESIGN  
STRATA CERTIFICATION  
Phone: (02) 4351 2233  
Email: admin@tinsurvey.com.au  
www.tinsurvey.com.au



DRAWING TITLE  
  
WORK AS EXECUTED  
SOUTH CARPARK  
(AS SURVEYED 13.09.18)  
LOT 1, DP 1147734  
WYONG

|                                               |          |                         |                    |
|-----------------------------------------------|----------|-------------------------|--------------------|
| DATE:                                         | 13.09.18 | SCALE:                  | 1:500 @A3          |
| SURVEY:                                       | M.C.     | DATUM:                  | AHD                |
| F.BOOK:                                       | COMP     | INSTRUCTION :           | 15                 |
| DRAWN:                                        | M.W.     | CAD FILE:               | 22604WAEAA         |
| CHECKED:                                      | D.S.     | No. in SET:             | 1 of 1             |
| D. SMITH 19.09.18<br>REGISTERED SURVEYOR DATE |          | PROJECT NUMBER<br>22604 | DRAWING No<br>SA01 |
|                                               |          |                         | REVISION<br>A      |

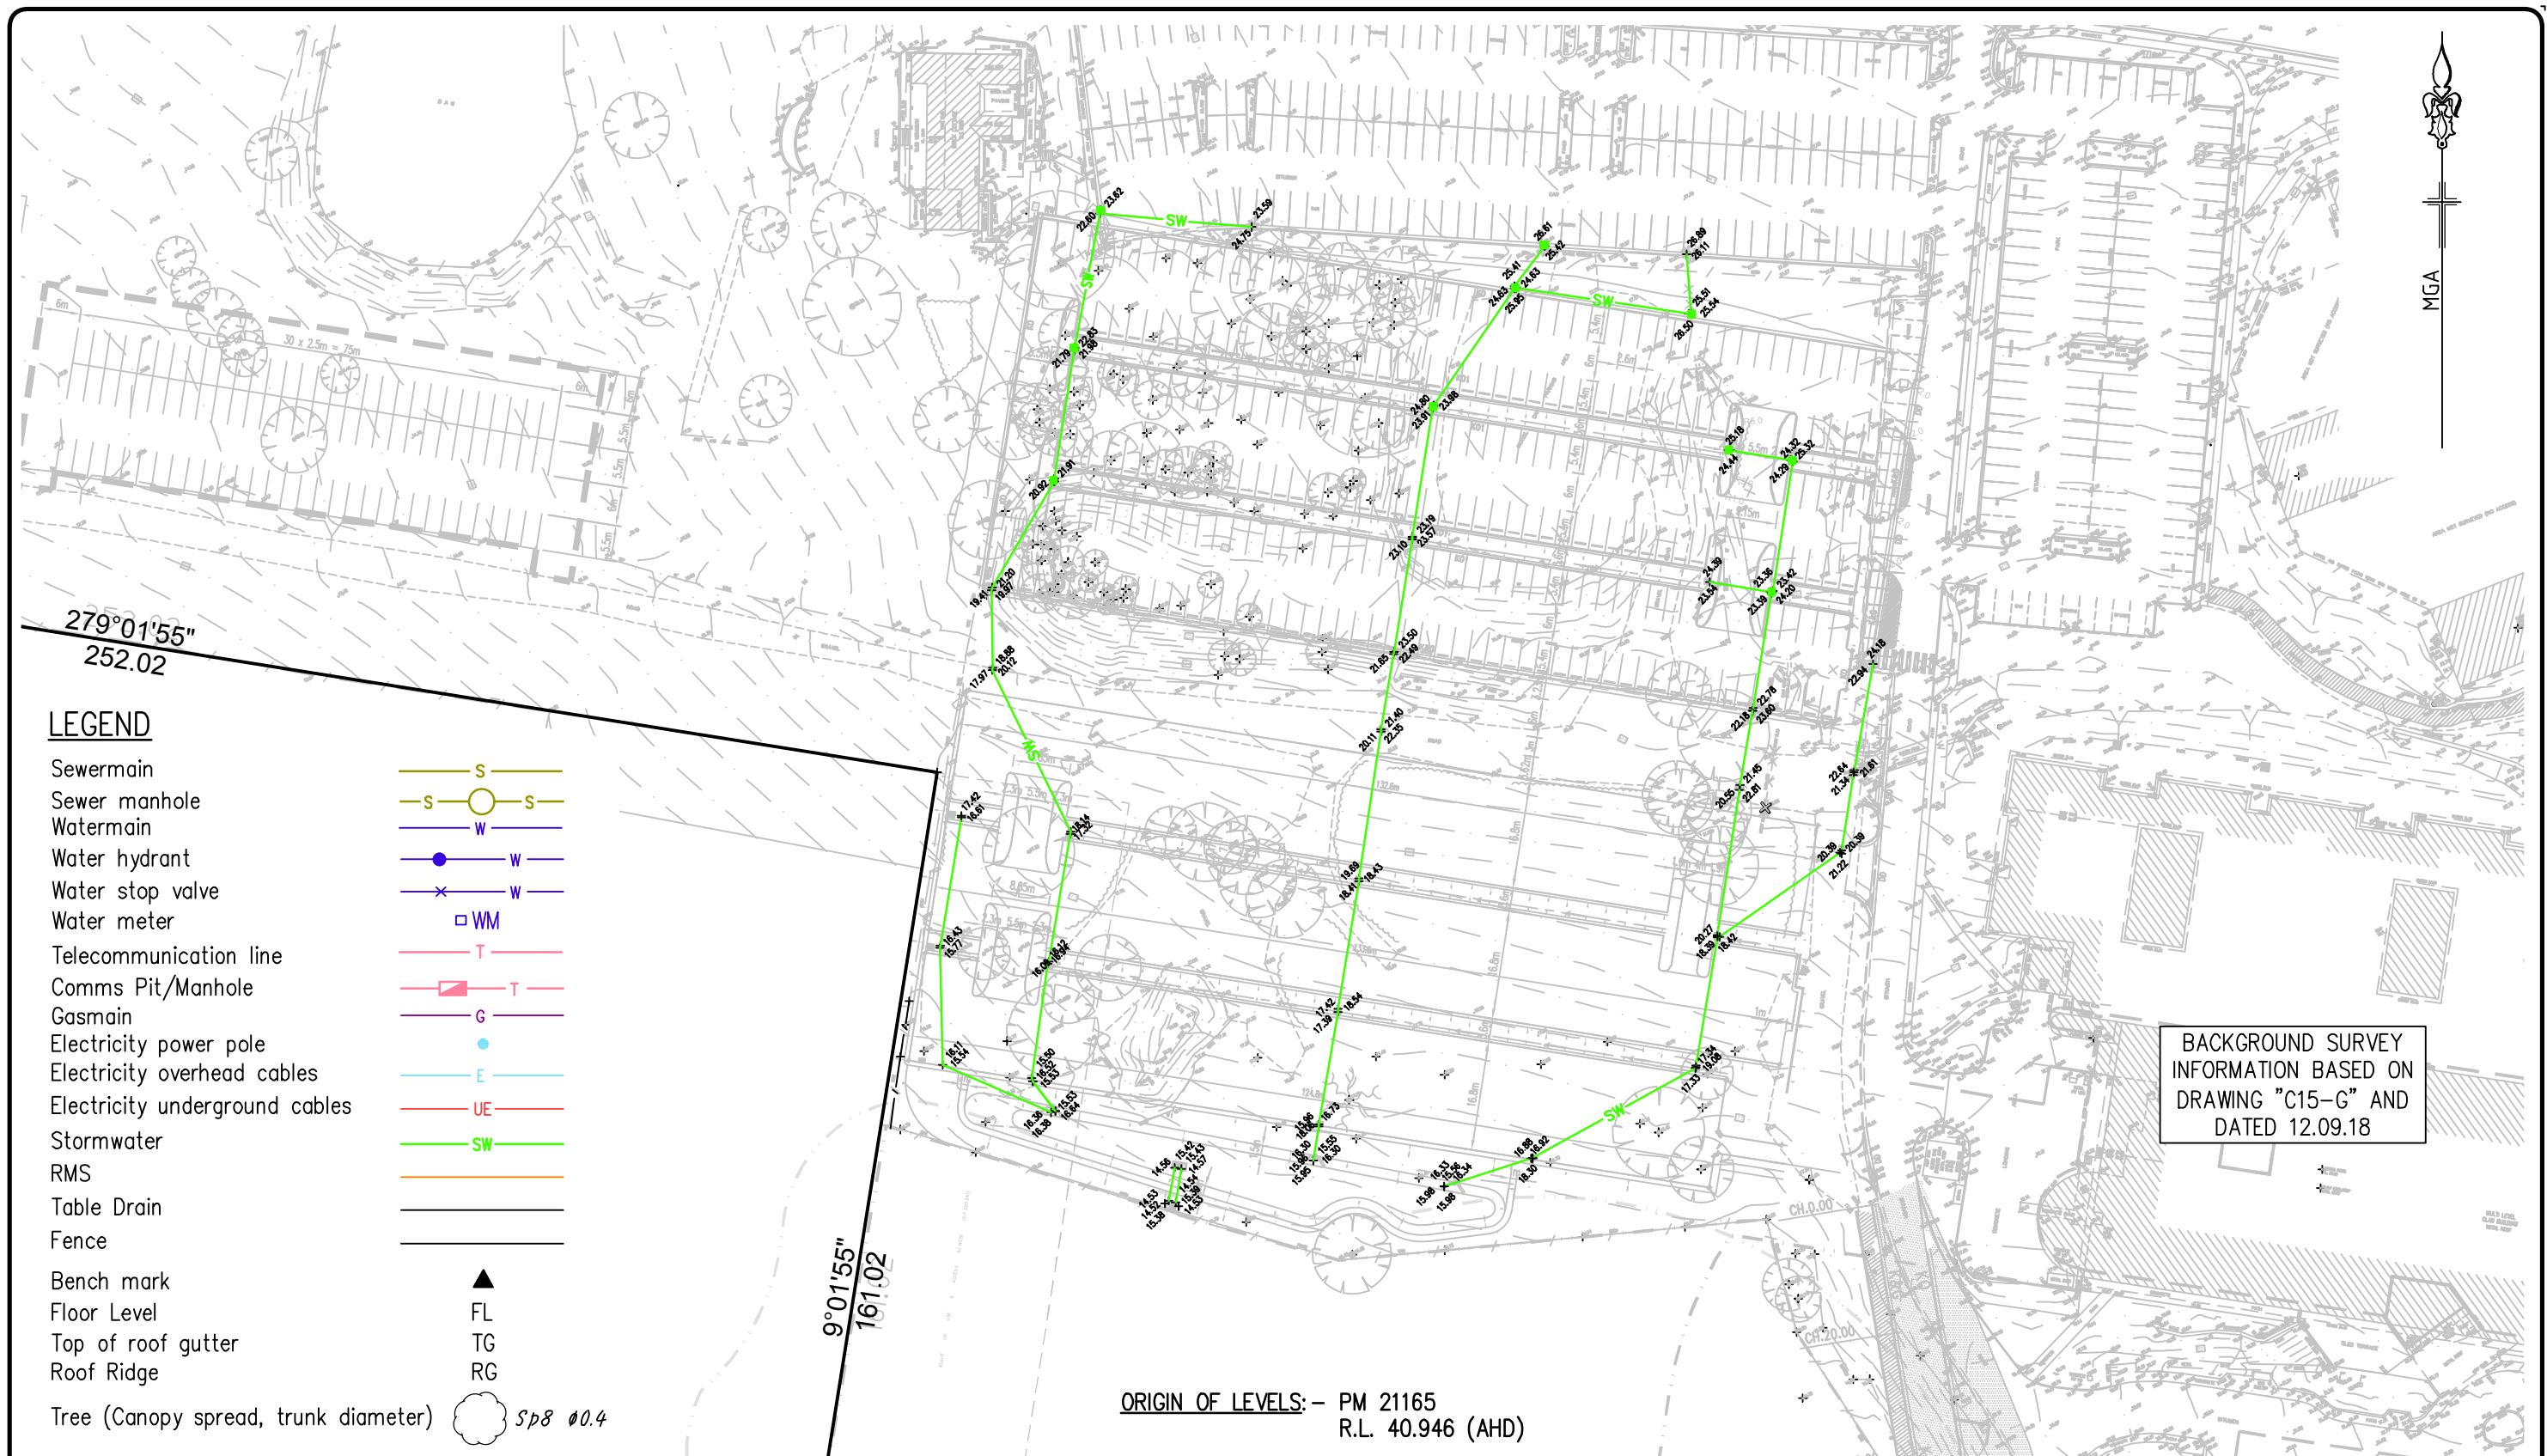

LEGEND

- Sewermain
- Sewer manhole
- Watermain
- Water hydrant
- Water stop valve
- Water meter
- Telecommunication line
- Comms Pit/Manhole
- Gasmain
- Electricity power pole
- Electricity overhead cables
- Electricity underground cables
- Stormwater
- RMS
- Table Drain
- Fence
- Bench mark
- Floor Level
- Top of roof gutter
- Roof Ridge
- Tree (Canopy spread, trunk diameter)

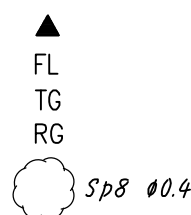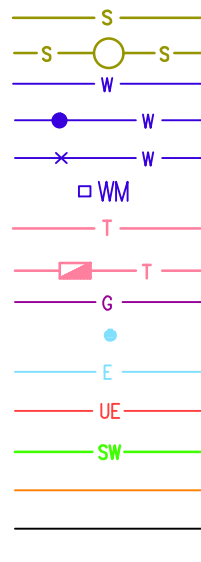

ORIGIN OF LEVELS: - PM 21165  
R.L. 40.946 (AHD)

BACKGROUND SURVEY  
INFORMATION BASED ON  
DRAWING "C15-G" AND  
DATED 12.09.18

|         |                  |          |
|---------|------------------|----------|
|         |                  |          |
|         |                  |          |
| B       | ISSUED TO CLIENT | 20.09.18 |
| A       | ISSUED TO CLIENT | 19.09.18 |
| REV No. | REMARKS          | DATE     |
|         | AMENDMENTS       |          |

CLIENT:  
  
PROJECT COORDINATION  
(AUSTRALIA) Pty Ltd  
PO BOX 595  
UNDERRA  
NSW 2526



TREHY INGOLD NEATE  
LAND DEVELOPMENT  
SURVEYING  
PLANNING  
CIVIL DESIGN  
STRATA CERTIFICATION  
Phone: (02) 4351 2233  
Email: admin@tinsurvey.com.au  
www.tinsurvey.com.au

DRAWING TITLE  
  
WORK AS EXECUTED  
SOUTH CARPARK  
STORMWATER PLAN  
(AS SURVEYED 13.09.18)  
LOT 1, DP 1147734, WYONG

|                                               |          |                         |                    |
|-----------------------------------------------|----------|-------------------------|--------------------|
| DATE:                                         | 13.09.18 | SCALE:                  | 1:1000 @A3         |
| SURVEY:                                       | M.C.     | DATUM:                  | AHD                |
| F.BOOK:                                       | COMP     | INSTRUCTION :           | 15                 |
| DRAWN:                                        | M.W.     | CAD FILE:               | 22604WAEB          |
| CHECKED:                                      | D.S.     | No. in SET:             | 1 of 2             |
| D. SMITH 19.09.18<br>REGISTERED SURVEYOR DATE |          | PROJECT NUMBER<br>22604 | DRAWING No<br>SA01 |
|                                               |          |                         | REVISION<br>B      |



LEGEND

- Sewermain
  - Sewer manhole
  - Watermain
  - Water hydrant
  - Water stop valve
  - Water meter
  - Telecommunication line
  - Comms Pit/Manhole
  - Gasmain
  - Electricity power pole
  - Electricity overhead cables
  - Electricity underground cables
  - Stormwater
  - RMS
  - Table Drain
  - Fence
  - Bench mark
  - Floor Level
  - Top of roof gutter
  - Roof Ridge
  - Tree (Canopy spread, trunk diameter)
- FL  
TG  
RG
- Sp8 Ø0.4

NOTE:  
REFER TO DRAWING SA01  
FOR STORMWATER DETAIL  
PLAN

BACKGROUND SURVEY  
INFORMATION BASED ON  
DRAWING "C15-G" AND  
DATED 12.09.18

ORIGIN OF LEVELS: - PM 21165  
R.L. 40.946 (AHD)

|         |                  |          |
|---------|------------------|----------|
|         |                  |          |
|         |                  |          |
| B       | ISSUED TO CLIENT | 20.09.18 |
| A       | ISSUED TO CLIENT | 19.09.18 |
| REV No. | REMARKS          | DATE     |
|         | AMENDMENTS       |          |

CLIENT:

PROJECT COORDINATION  
(AUSTRALIA) Pty Ltd  
PO BOX 595  
UNDERRA  
NSW 2526




TREHY INGOLD NEATE  
LAND DEVELOPMENT  
SURVEYING  
PLANNING  
CIVIL DESIGN  
STRATA CERTIFICATION  
Phone: (02) 4351 2233  
Email: admin@tinsurvey.com.au  
www.tinsurvey.com.au

DRAWING TITLE

WORK AS EXECUTED  
SOUTH CARPARK  
(AS SURVEYED 13.09.18)  
LOT 1, DP 1147734  
WYONG

|                                               |          |                         |                    |
|-----------------------------------------------|----------|-------------------------|--------------------|
| DATE:                                         | 13.09.18 | SCALE:                  | 1:1000 @A3         |
| SURVEY:                                       | M.C.     | DATUM:                  | AHD                |
| F.BOOK:                                       | COMP     | INSTRUCTION :           | 15                 |
| DRAWN:                                        | M.W.     | CAD FILE:               | 22604WAEB          |
| CHECKED:                                      | D.S.     | No. in SET:             | 2 of 2             |
| D. SMITH 19.09.18<br>REGISTERED SURVEYOR DATE |          | PROJECT NUMBER<br>22604 | DRAWING No<br>SA02 |
|                                               |          |                         | REVISION<br>B      |

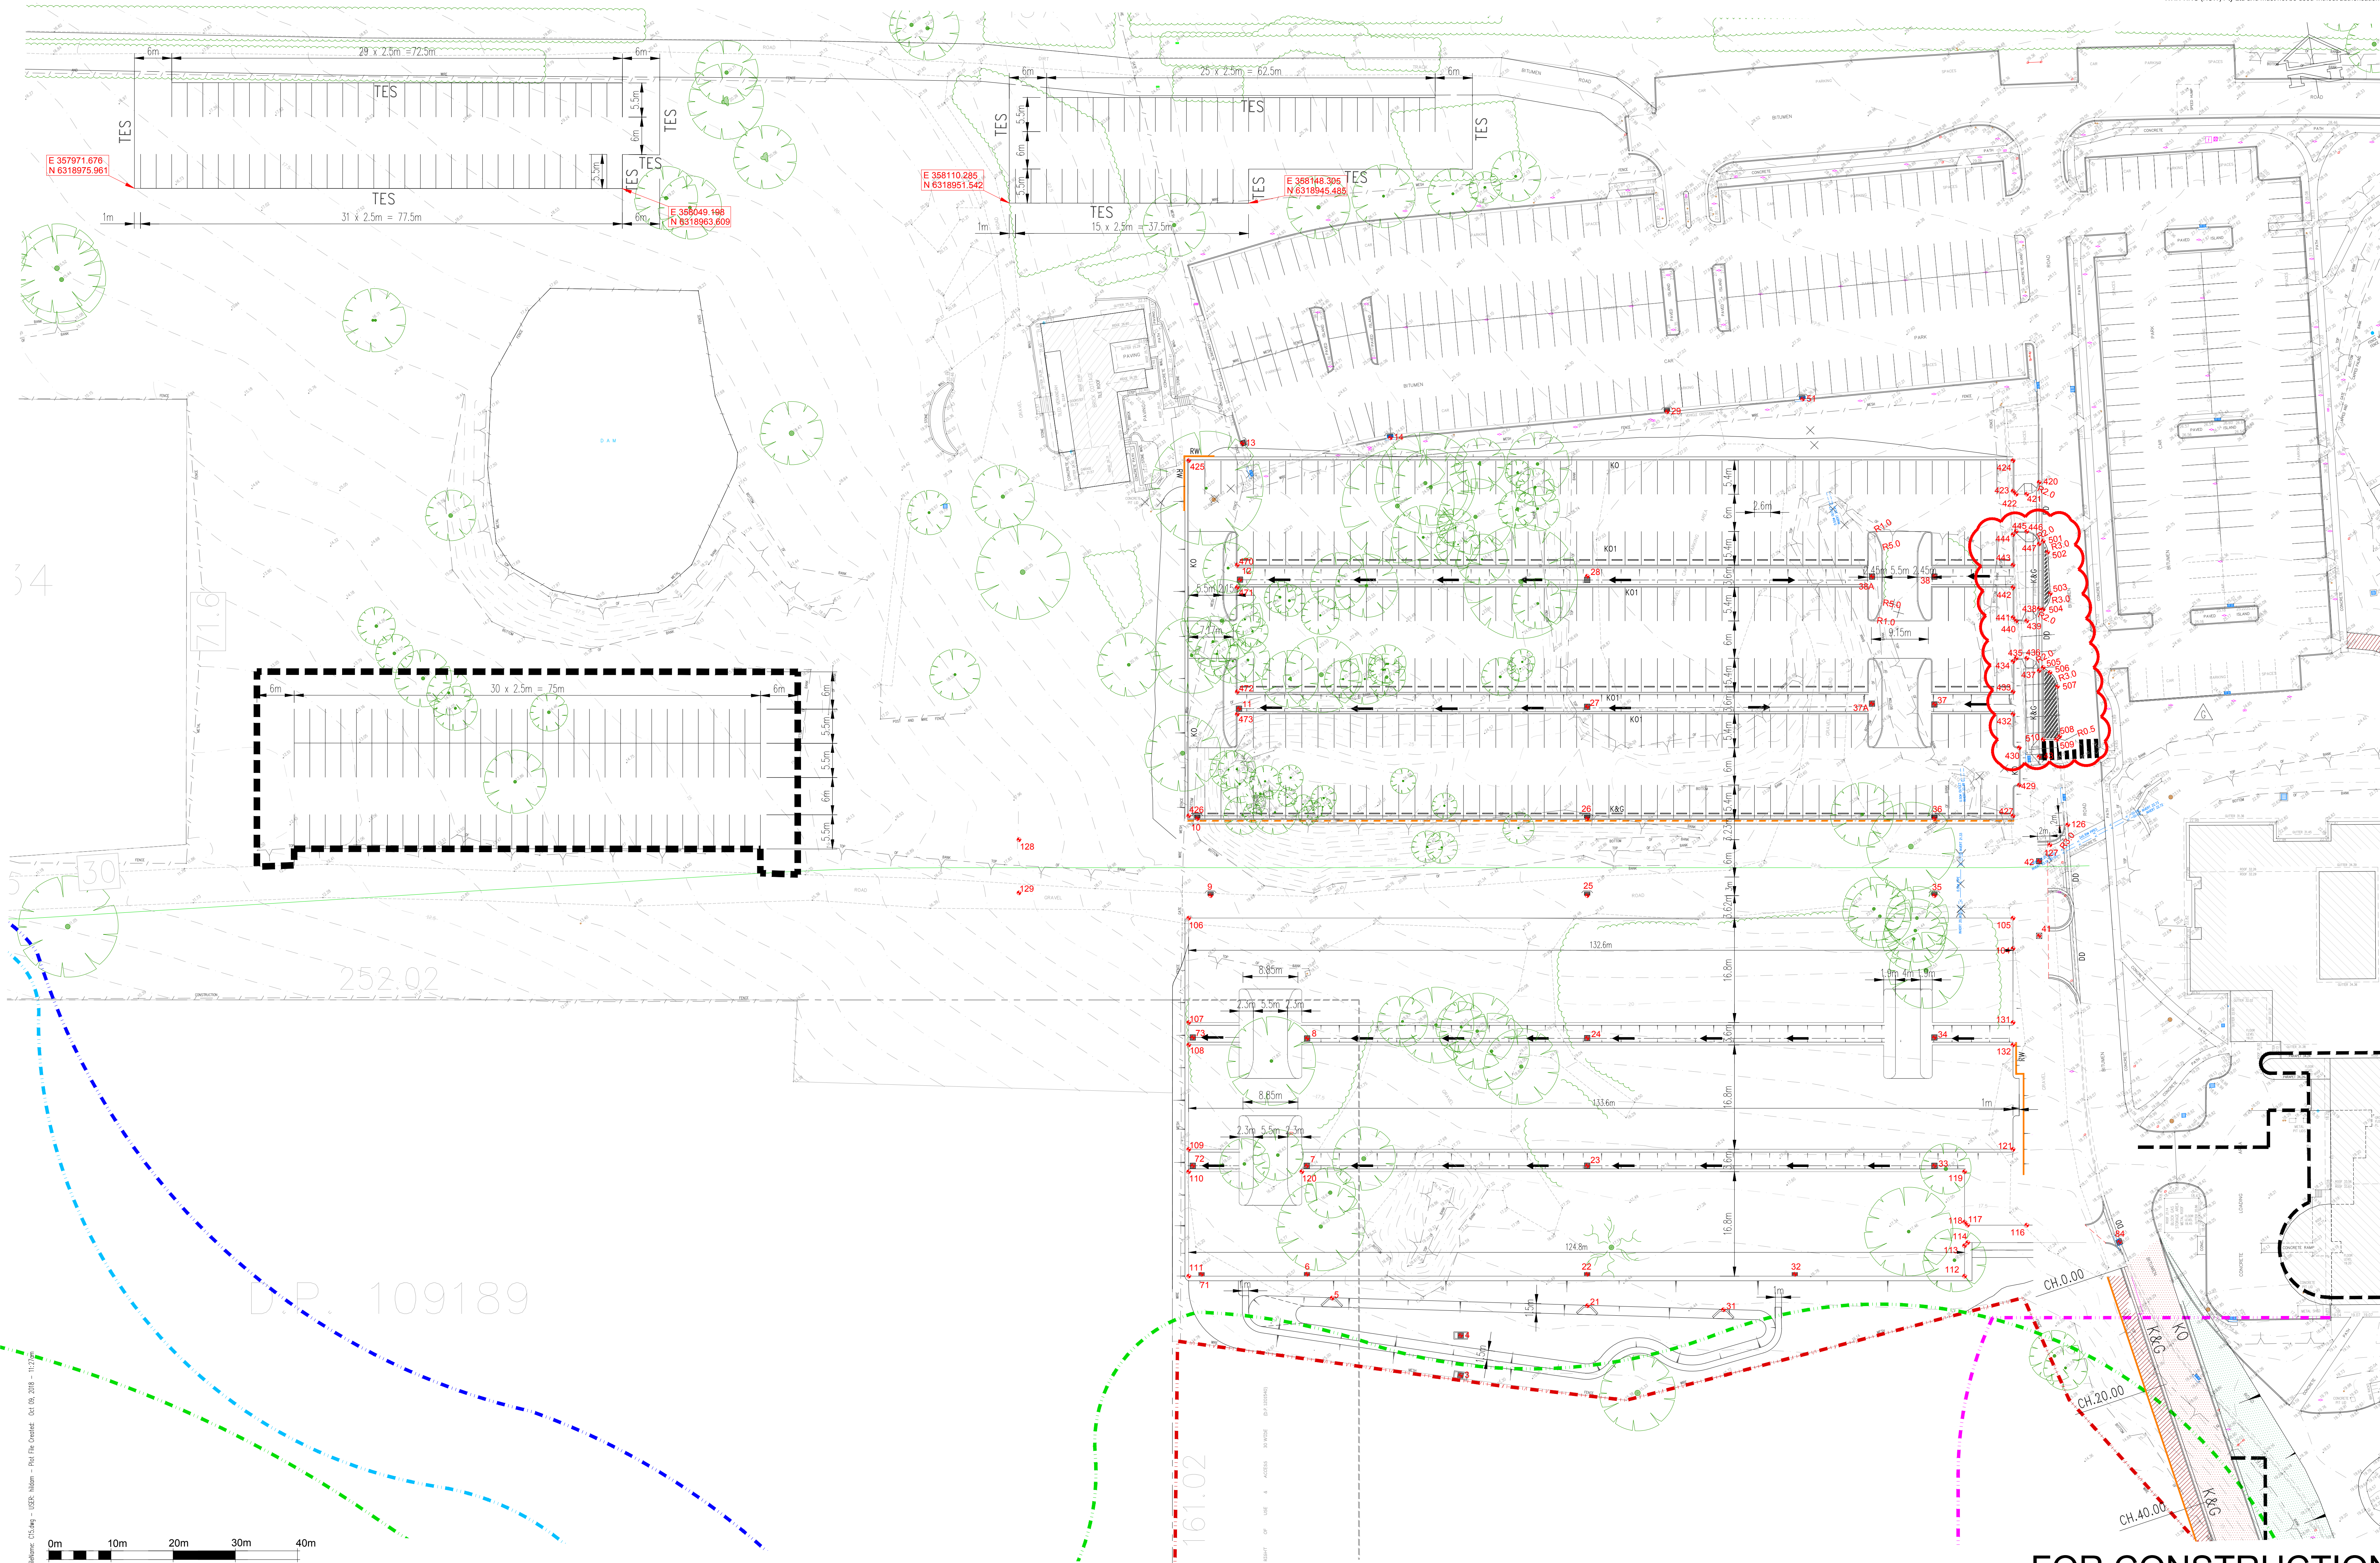

Tracked: 05/09/2018 - 05/09/2018 - Plot File Created: Oct 09, 2018 - 11:27am

0m 10m 20m 30m 40m  
SCALE 1:400 @ B1

|     |                        |     |       |          |     |                                            |     |       |          |
|-----|------------------------|-----|-------|----------|-----|--------------------------------------------|-----|-------|----------|
| F   | UPDATED AS CLOUDED     | SB  | WW    | 05.06.18 |     |                                            |     |       |          |
| E   | UPDATED AS CLOUDED     | SB  | WW    | 06.03.18 |     |                                            |     |       |          |
| D   | UPDATED AS CLOUDED     | SB  | WW    | 27.02.18 |     |                                            |     |       |          |
| C   | UPDATED AS CLOUDED     | SB  | WW    | 23.02.18 |     |                                            |     |       |          |
| B   | ISSUE FOR CONSTRUCTION | SB  | WW    | 12.12.17 | H   | LINEMARKING SETOUT ADDED                   | SB  | HM    | 09.10.18 |
| A   | ISSUE FOR CONSTRUCTION | SB  | WW    | 22.11.17 | G   | SETOUT UPDATED TO REFLECT KERB ADJUSTMENTS | SB  | AS    | 12.09.18 |
| Rev | Description            | Eng | Draft | Date     | Rev | Description                                | Eng | Draft | Date     |



Project  
WYONG ENABLING WORKS,  
WYONG HOSPITAL

Sheet Subject  
SETOUT PLAN SHEET 1

Scale: B1  
1:400  
Drawn  
WW  
Authorised  
SB  
Job No  
161183  
Drawing No  
C15  
Revision  
H  
Plot File Created: Oct 09, 2018 - 11:27am