


110 Wharf Road, West Ryde NSW 2114

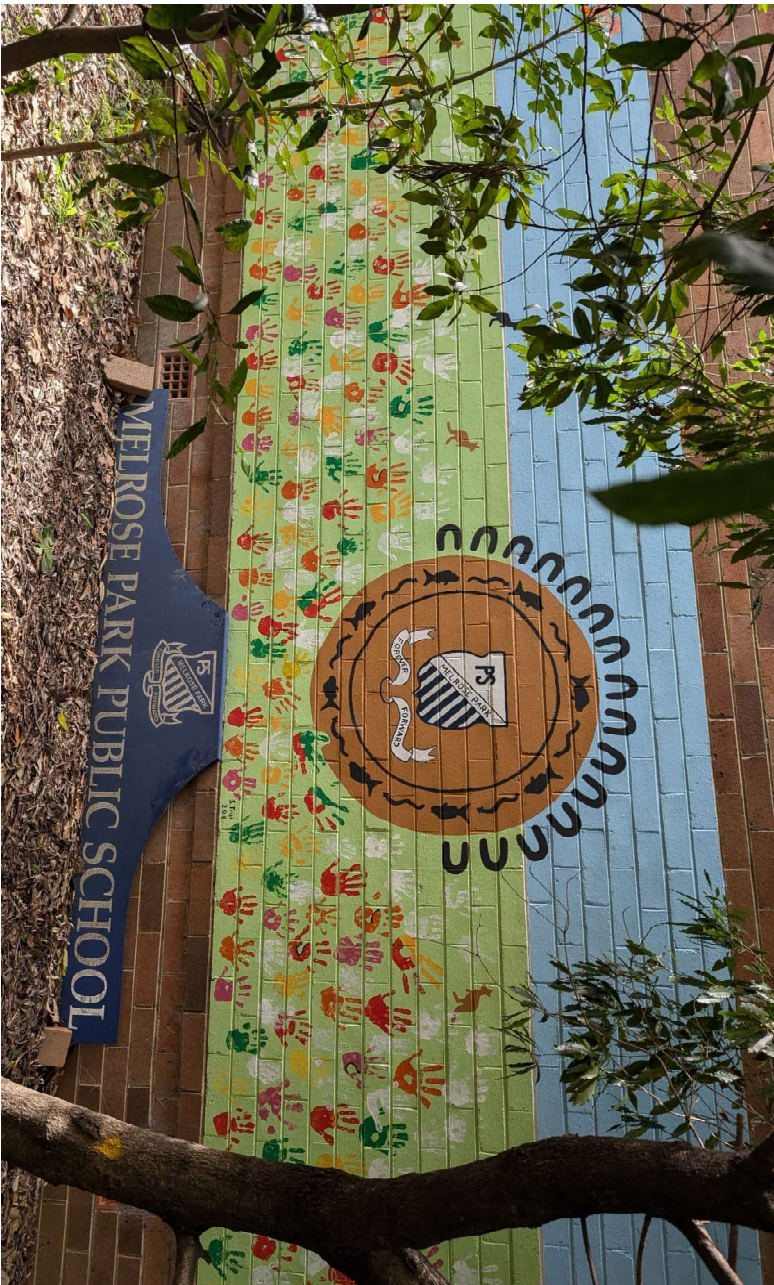

NOTE:

1. AS THE FIRE ENGINEERING REPORT IS IN DEVELOPMENT AT THE TIME OF THESE DOCUMENTS, THE POTENTIAL REQUIREMENTS ARE NOT INCORPORATED NOR SHOWN IN THE DOCUMENTS.
2. THE PUBLIC DOMAIN WORKS HAVE NOT BEEN RESOLVED.

NOTE:


- THE DOCUMENTS INCORPORATE SPECIALIST INPUT TO THE EXTENT THAT WAS AVAILABLE AT 19 DECEMBER 2024.
- IN PARTICULAR, FIRE ENGINEERING AND BCA/DDA ADVICE IS PRELIMINARY AND INFORMAL ONLY.
- THE PLANT AREAS AS DETERMINED BY THE PATTERN BOOK ARE UNRESOLVED.

This document is prepared by PTW solely for the information of, and based on requests and instructions received from, PTW's client in relation to the relevant activity (as defined under s 5.1 of the *Environmental Planning and Assessment Act 1979* (NSW) (Act)). Any other person using or relying upon this document does so entirely at their own risk.

If PTW's client is the 'proponent' and 'determining authority' (or 'nominated determining authority') under s 5.1 of the Act then the client acknowledges that:

1. it is solely responsible for:
 - a. any determination or assessment in relation to any environmental factor or consideration affecting the relevant activity; and
 - b. undertaking or not undertaking any activity for any reason, including due to such determination or assessment;

2. PTV's advice herein is provided strictly in accordance with the relevant PTV contract and utilising the standard of skill, care and diligence to be expected of an experienced architect providing similar advice in relation a similar development or activity;
3. PTV's advice may not of itself allow PTV's client to properly or fully comply with its environmental determination or assessment obligations, and PTV's client may need to and will obtain the advice of other professional advisers as may be required in order to so comply; and
4. any modification or mitigation measure advised or proposed by PTV in connection with any detrimental effect by, or to eliminate or reduce the detrimental effects of, the activity on the environment (including critical habitat, or threatened species, populations or ecological communities, or their habitats) is made solely in our capacity as your architect, and is not intended to supplant or replace any advice that you have obtained or should obtain from other professional advisers.

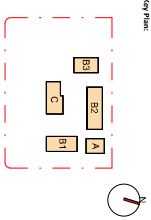

Drawing Disclaimer:
Do not scale from drawings.
Verify all dimensions on site before commencing work.
Copying or reproduction of this drawing is strictly prohibited without the
consent of PTW Architects

PRV's responsibility for any critical building element is strictly limited that provided for by our relevant scope of Services. Others, including suitably qualified experts as may be required or as is appropriate, carry responsibility for any checking of or other work associated with any design, materials selection, construction or installation of any cladding, facade or external building element.

[illegible]

Consultant

Client
SINSW


Architect
PTW Architects
Gadigal Country
Level 11, 88 Phillip Street
Sydney NSW 2000 Australia
T +61 2 9232 5877
ptw.com.au

Responsible Architect
Triffie Thomas & Walker P/L

Project PA030586
MELROSE PARK PUBLIC SCHOOL
110 Wharf Road, Melrose Park NSW 2114

| Title |
|--------------|
| 00 - GENERAL |
| COVER SHEET |

| Drawing Number | Revision |
|----------------------------|----------|
| MPPS-PTW-ZZ-XX-DR-A-000001 | T1 |

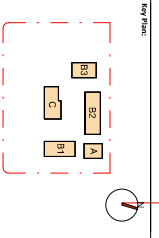

- REF ISSUE AFTER V&M
01. SCREEN NEAR BLOCK B2 COVES CUTBACK
 02. AC PLANT FOR BLOCK B2 MOVED TO LOO
 03. BLOCK B2 - SHADING ON NORTHERN FACADE REVISED.
 04. MULTIPLE LANDSCAPING CHANGES



Consultant:

Client:





Title:
02 - SITE PLAN
SITE PLAN - PROPOSED GROUND FLOOR

Drawing Number:
MPPS-PTW-ZZ-GF-DR-A-020004
Revision:
13


Scale:
1:400 A1
Date:
10/10/2025

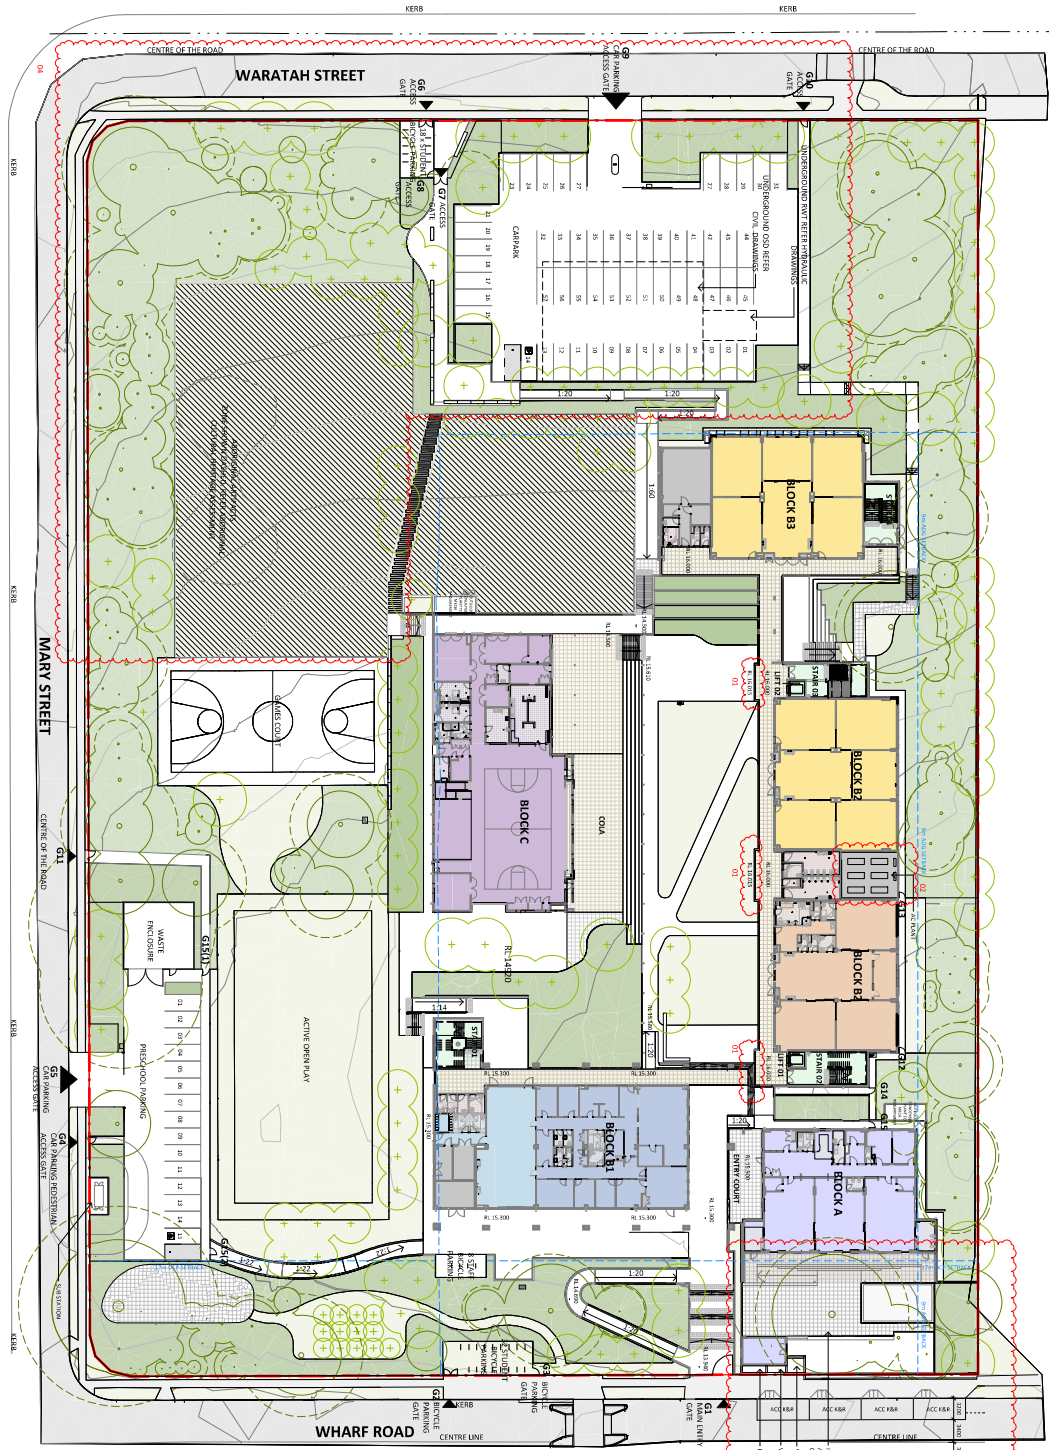

1 SITE PLAN - PROPOSED GF
1 : 400 @A1

Notes:
The detail resolution shown on the Landscape plans has not yet been incorporated into the Architectural floor plans and other consultants' documentation. Refer to the Landscape drawings for details of retaining walls, outdoor steps, terraces and paths.

FOR WRITTEN ENDORSEMENT
TO PROCEED
SIGN, STAMP
AND DATE: NOT RECEIVED BY PTW 17/10/2025

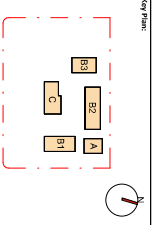

- REF. ISSUE AFTER VM
- 01. SCREEN NEAR BLOCK B2 CORERS CUTBACK
 - 02. AC PLANT FOR BLOCK B2 MOVED TO L00
 - 03. BLOCK B2 - SHADING ON NORTHERN FACADE REVERSED
 - 04. MULTIPLE LANDSCAPING CHANGES

Drawing Discipline:


Notes:

PTW is responsible for any general building element is strictly limited to the building element. 


Consultant:

Client:




Title:
02 - SITE PLAN
SITE PLAN - PROPOSED - LEVEL 1

Drawing Number:
MPPS-PTW-ZZ-L1-DR-A-020005
Revision:
13

Scale:
1:400 @ A1
Date:
17/10/2025

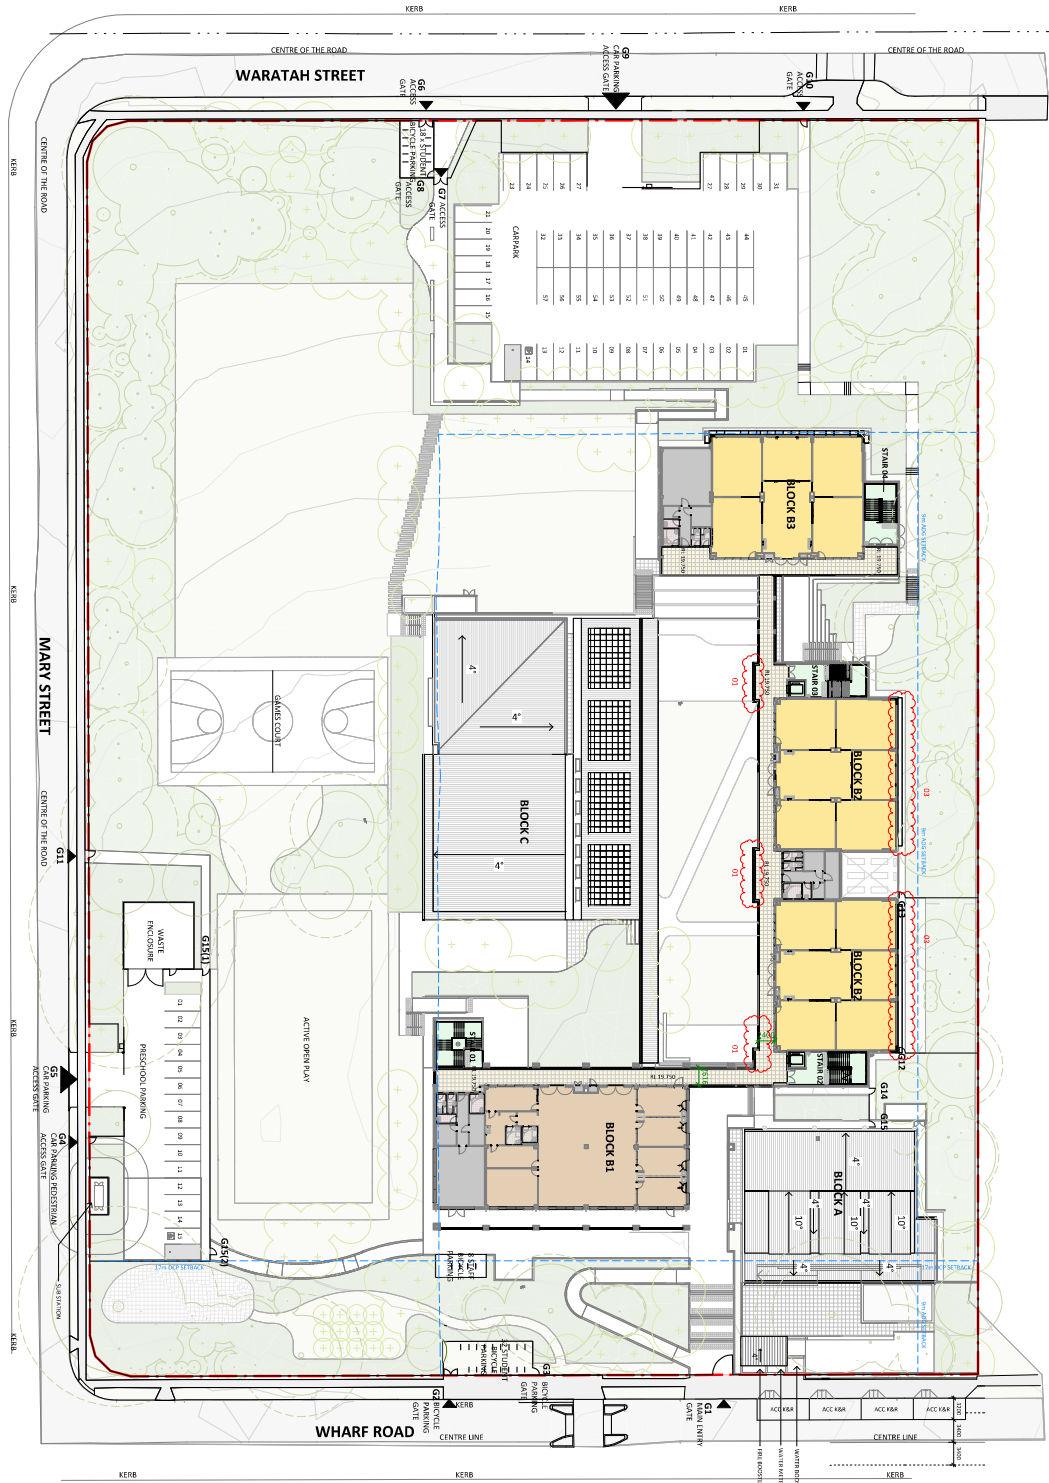


1 SITE PLAN - PROPOSED - L1
1 : 400 @ A1

Notes:
The detail resolution shown on the landscape plans has not been incorporated into the Architectural floor plans and other consultants' documentation. Refer to the Landscape drawings for details of retaining walls, outdoor steps, terraces and paths.

FOR WRITTEN ENDORSEMENT
TO PROCEED
SIGN STAMP
AND DATE: NOT RECEIVED BY PTW 17/10/2025

- LEGEND
- ▲ ALTERNATES
 - EXTERNAL WALKWAY
 - GLS
 - LIBRARY HUB
 - MOVEMENT
 - SERVICES
 - EXISTING TREE
 - TREE PROTECTION
 - SINK (TPO)
 - NEW TREE PLANTING

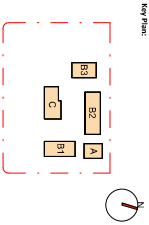

- REF ISSUE AFTER VM
- 01 SCREEN NEAR BLOCK B2 CORRS CUTBACK
 - 02 AC PLANT FOR BLOCK B2 MOVED TO 100
 - 03 BLOCK B2 - SHADING ON NORTHERN FACADE REVISED
 - 04 MULTIPLE LANDSCAPING CHANGES



Notes:



Consultant:

Client:


Architect:
PTW Architects

Melrose Park Public School
110 Wharf Road, Melrose Park NSW 2114

Title:
02 - SITE PLAN
SITE PLAN - PROPOSED - LEVEL 2

Drawing Number:
MPPS-PTW-ZZ-L2-DR-A-020006
Revision:
13

Scale:
1:400 A1
Date:
17/10/2025

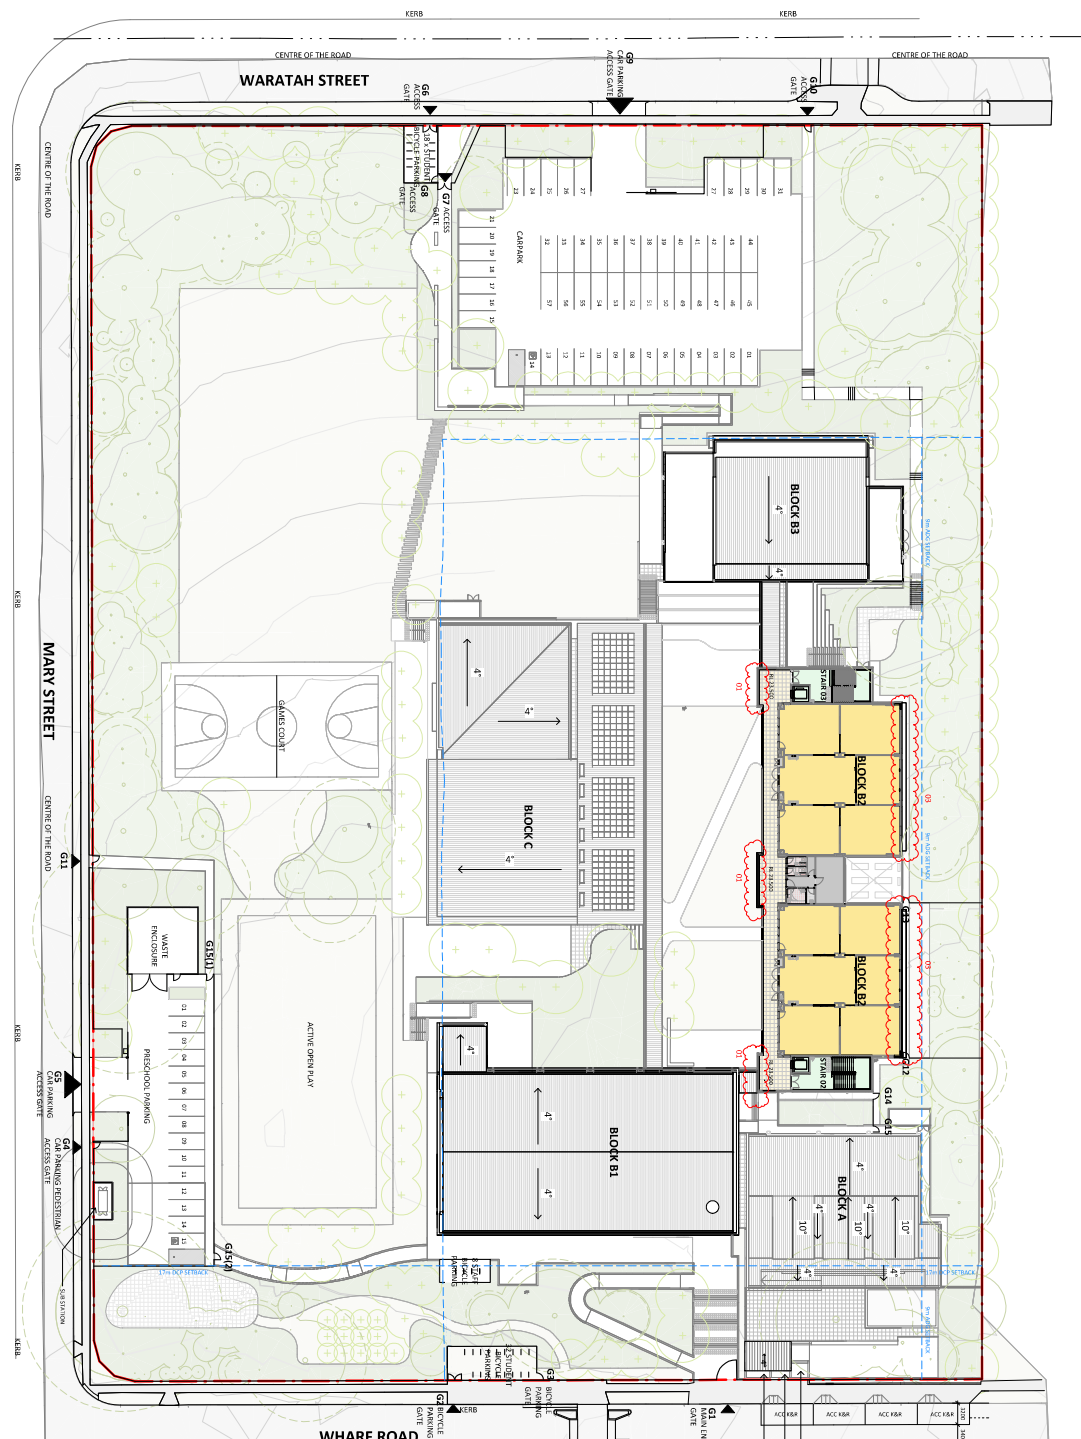

1 SITE PLAN - PROPOSED - L2
1 : 400 @A1

Notes:

The detail resolution shown on the landscape plans has not yet been incorporated into the Architectural floor plans and other consultants' documentation. Refer to the Landscape drawings for details of retaining walls, outdoor steps, terraces and paths.

FOR WRITTEN ENDORSEMENT TO PROCEED

Stamp: NOT RECEIVED BY PTW 17/10/2025

- LEGEND
- ▲ ALTERNITIES
 - EXTERNAL WALLWAY
 - GLS
 - MOVEMENT
 - SERVICES
 - EXISTING TREE
 - PLANT PROTECTION




fascade or external building element.

Consultant

ASNSW



110 Wharf Road, Melrose Park NSW 2114

SITE PLAN - PROPOSED LOWER GROUND

MPPS-P1W-22-LG-DK-A-U20003 13

ISSUED FOR TENDER

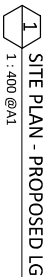

Notes:
The detail resolution shown on the landscape plans has not yet been incorporated into the Architectural floor plans and other consultants' documentation. Refer to the landscape drawings for details of retaining walls, outdoor steps, terraces and paths.

**FOR WRITTEN ENDORSEMENT
TO PROCEED**

AMENITIES

EXTERNAL WALKWAY


MOVEMENT

100

NO WORK TO EXHIBIT

TREE PROTECTION

NEW TREE PLANTING

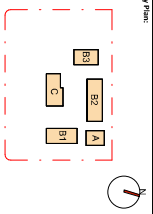


responsibility for any external building element is strictly limited to that provided for by our relevant scope of Services. Others, including suitably qualified experts as may be required or as is appropriate, carry responsibility for any checking of or other work associated with any design, materials selection, construction or installation of any cladding, facade or external building element.

[illegible]

Consultant

Client
SINSW

Architect
PTW Architects
Gadigal Country
Level 11, 88 Phillip Street
Sydney NSW 2000 Australia
T +61 2 9232 5877
ptw.com.au

MELROSE PARK PUBLIC SCHOOL
110 Wharf Road, Melrose Park NSW 2114

SITE PLAN - PROPOSED - ROOF LEVEL

MPPS-PTW-ZZ-RF-DR-A-020007 T3

Status







Title:
02 - SITE PLAN
SITE PLAN - OVERALL EXISTING

Drawing Number:
MPPS-PTW-ZZ-DR-A-020001
Revision: 13


Scale:
1:400 @A1
24/05/2025 7:43:37 PM

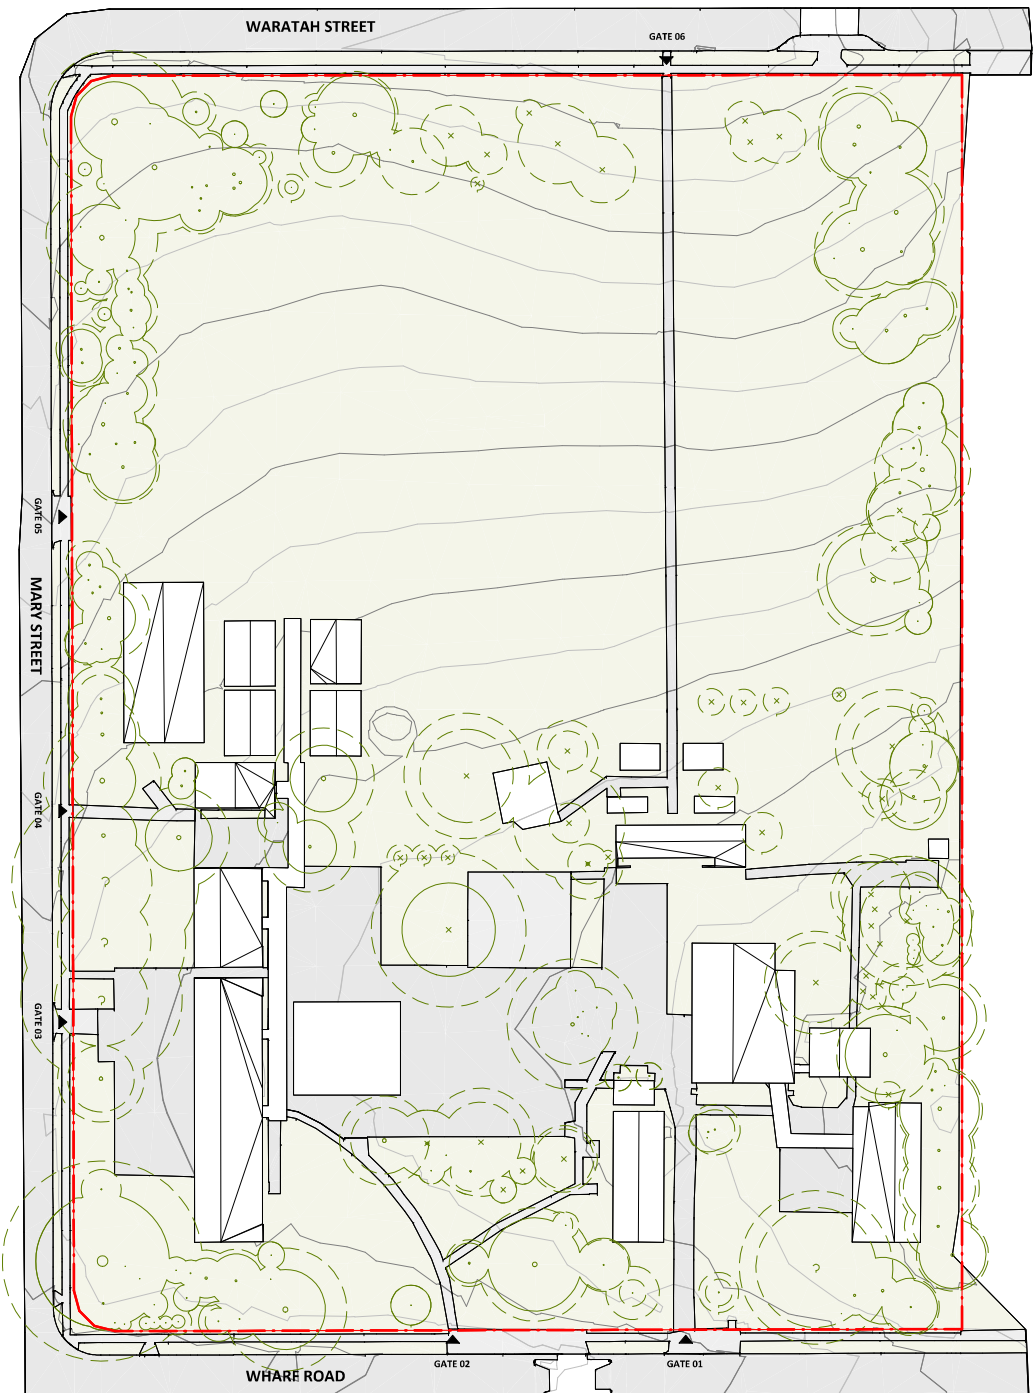

1 SITE PLAN - OVERALL EXISTING
1 : 400 @A1

LEGEND
EXISTING TITLE
TREE PROTECTION
ZONE (PTW)

**FOR WRITTEN ENDORSEMENT
TO PROCEED**
SIGN, STAMP
AND DATE: NOT RECEIVED BY PTW 17/01/2025

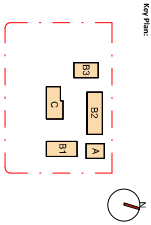

Drawing Disclaimer:
This is a scale drawing.
While it is intended to be used for reference, it is not to be used for construction without the consent of PTW Architects.

Notes:
PTW is responsible for any material building element is strictly limited to the information provided in this drawing. PTW, its staff, and its subcontractors, including its consultants, are not responsible for any building or other work associated with any building or external building element, or installation of any building.

Consultant

Client
SCHOOL

Architect
PTW Architects
PTW.COM.AU

Project: 24030502
Melrose Park Public School



Title
02 - SITE PLANS
SITE PLAN - OVERALL DEMOLITION

Drawing Number
MPPS-PTW-ZZ-DR-A-020002
Revision
13

Scale
1:1000 A1

24/03/2025 7:43:42 PM

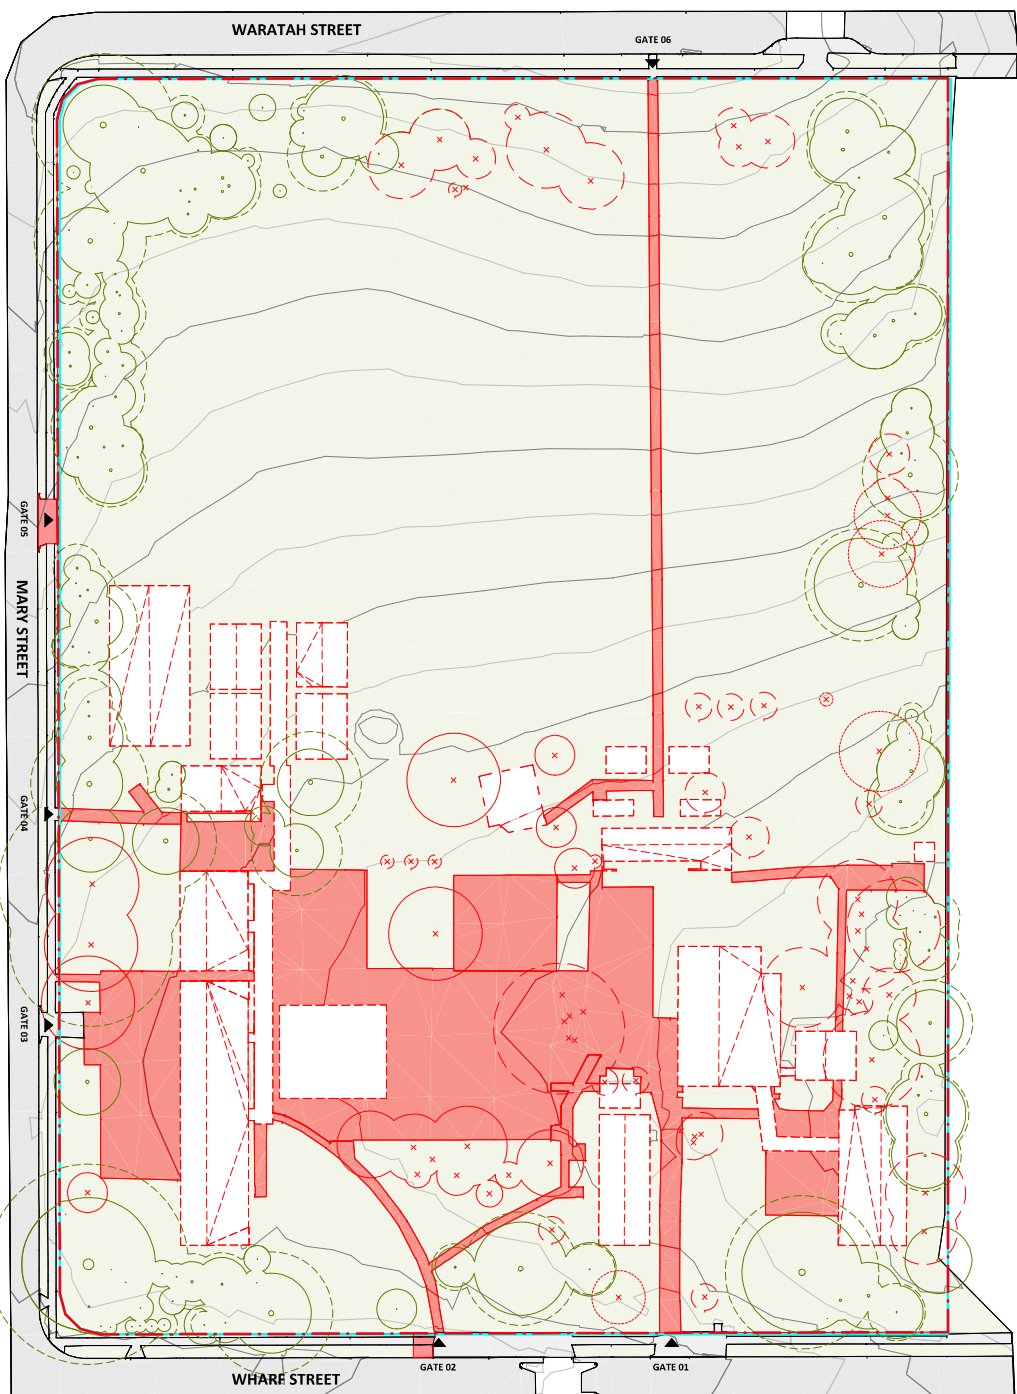

2 SITE PLAN - OVERALL DEMOLITION
1: 400 @A1

- NOTES:
- EXISTING FENCE/GATES TO SITE BOUNDARY TO BE REMOVED
 - EXTENT OF EXISTING PITS, INGROUND SERVICES NOT SHOWN. REFER TO CONSULTANTS' DRAWINGS FOR LOCATION AND EXTENT OF REMOVAL/RELOCATION
 - REFER ALSO TO SURVEY DRAWINGS FOR LOCATION OF ALL EXISTING SERVICES, PITS AND THE LIKE
 - THIS DRAWING DOES NOT INDICATE PROJECT/CONSTRUCTION STAGING


- LEGEND
- SITE BOUNDARY
 - EXISTING BUILDINGS TO BE DEMOLISHED
 - PITS AND INGROUND SERVICES TO BE DEMOLISHED
 - EXISTING TREE
 - TREE REMOVAL
 - TREE PROTECTION ZONE (TPZ)
 - NEW TREE PLANTING





PTW's responsibility for any external building element is strictly limited to that provided for by our relevant scope of Services. Others, including suitably qualified experts as may be required or as is appropriate, carry responsibility for any checking or other work associated with any design, material selection, construction or installation of any cladding, facade or external building element.

SERVICES

1:500 @A1

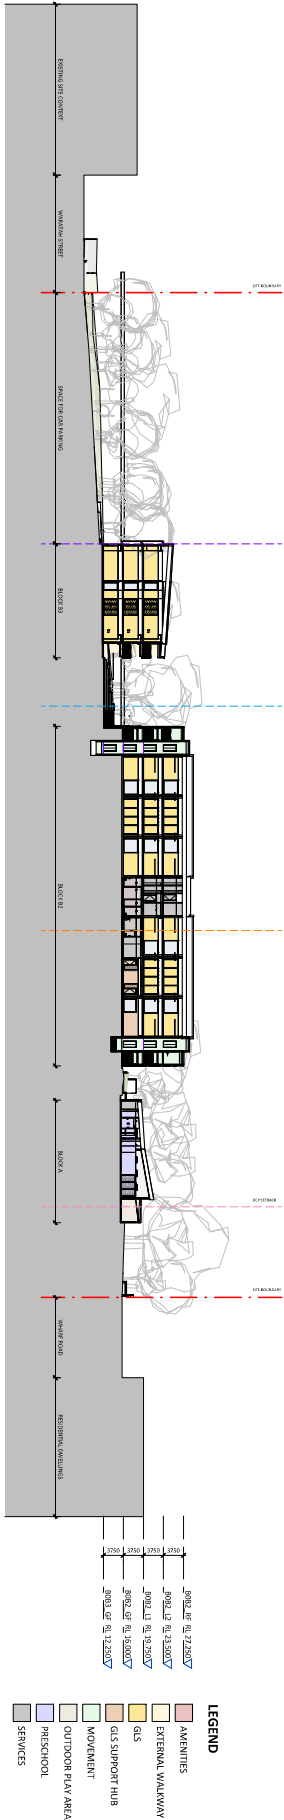

1 : 500 @A1

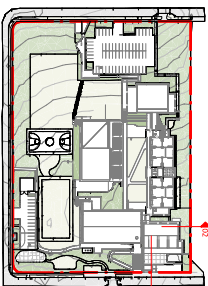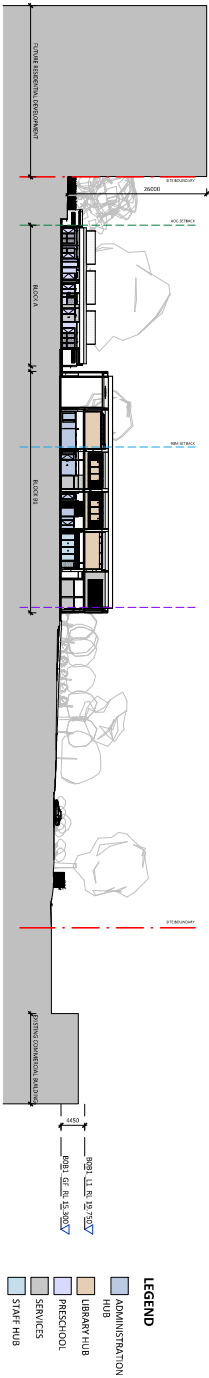

Architect
PTW Architects
Gadigal Country
Level 11, 88 Phillip Street
Sydney NSW 2000 Australia
T +61 2 9232 5877

Project PA020586
MELROSE PARK PUBLIC SCHOOL
120 Wharf Road, Melrose Park NSW 2114


PTW


Title

03 - SITE WORKS

03 - SITE WORKS - SITE SECTIONS

MPPS-PTW-ZZ-ZZ-DR-A-030030 T2

ISSUED FOR TENDER

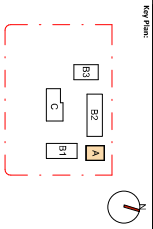

Drawings Disclaimer:


Consultant:

Client:

Architect:
PTW Architects
PTW.COM.AU

MELORE PARK PUBLIC SCHOOL

Title:
10 - GENERAL ARRANGEMENT PLANS
GA - BLOCK A - GF

Revision:
MPPS-PTW-B00A-GF-DR-A-100101 12

Scale:
1:100 FOR TENDER


FOR WRITTEN ENDORSEMENT
TO PROCEED
SIGN, STAMP
AND DATE: NOT RECEIVED BY PTW 17/10/2025


LEGEND WALL LIN
RL - / 60/60
RL 60/60/60
RL 120/120/20
NOTE: LUTHERAN
CHURCH PERFORMANCE
SOLUTION REQUIRED

FOR CONTINUATION REFER TO 1 / MPPS-PTW-B0B1-GF-DR-A-100201

FOR CONTINUATION REFER TO 1 / MPPS-PTW-B0B2-GF-DR-A-100301

1 GA - BLOCK A - GF
1:100 @A1

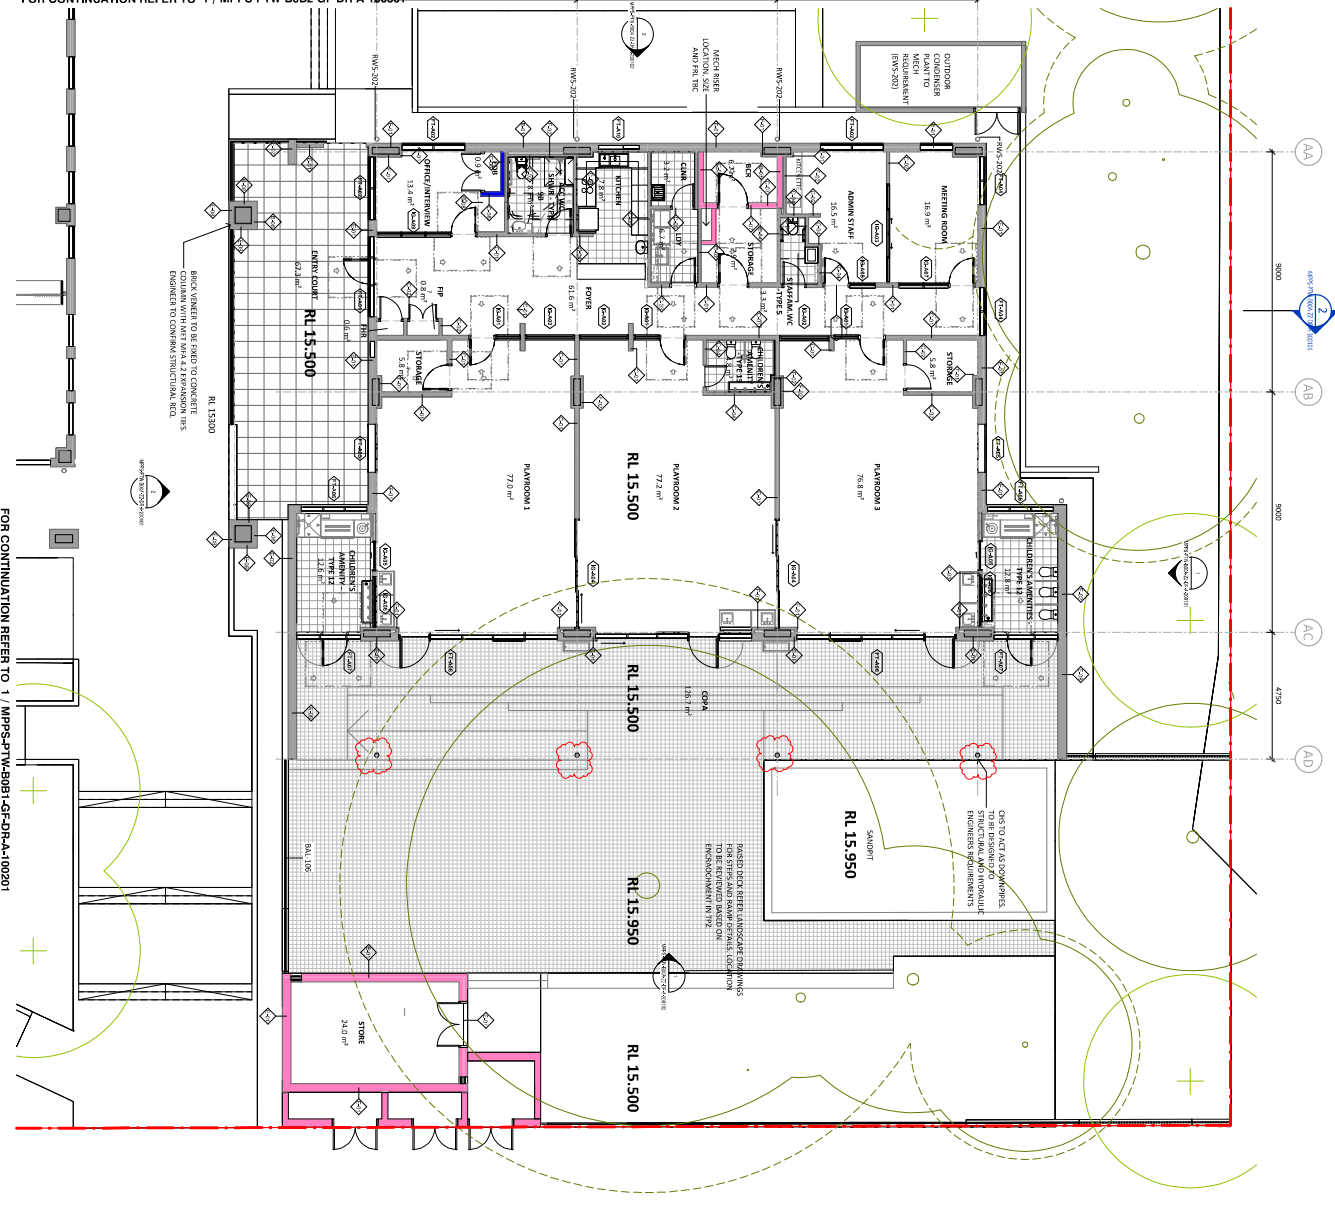

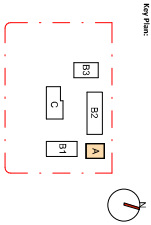

Drawing Disclaimer:
This is a preliminary drawing. It is not to be used for construction or any other purpose without the consent of PTW Architects.

Notes:
PTW's responsibility for any material building element is strictly limited to that provided by the user. PTW does not accept any liability for any damage or loss resulting from the use of this drawing or any other work associated with it, whether in whole or in part, or for any reason.

Consultant:

Client:
SINSA

Architect:
PTW Architects
Level 1, 88 Third Street
Sydney NSW 1501
T: 61 2 9232 5877
PTW.com.au

Project: 24235556
MELROSE PARK PUBLIC SCHOOL

Title:
10. GENERAL ARRANGEMENT PLANS
GA - BLOCK A - ROOF


Drawing Number:
MPPS-PTW-B00A-RF-DR-A-100102 12

Scale:
1:100 FOR TENDER

Date:
24/03/2025 7:44:16 PM

| LEGEND WALL LIN. | NOTE: VENTILATING SOLUTION REQUIRED |
|------------------|-------------------------------------|
| RL - / 60/60 | |
| RL 60/60/60 | |
| RL 120/120/120 | |


FOR WRITTEN ENDORSEMENT
TO PROCEED
SIGN STAMP
AND DATE: NOT RECEIVED BY PTW 17/01/2025

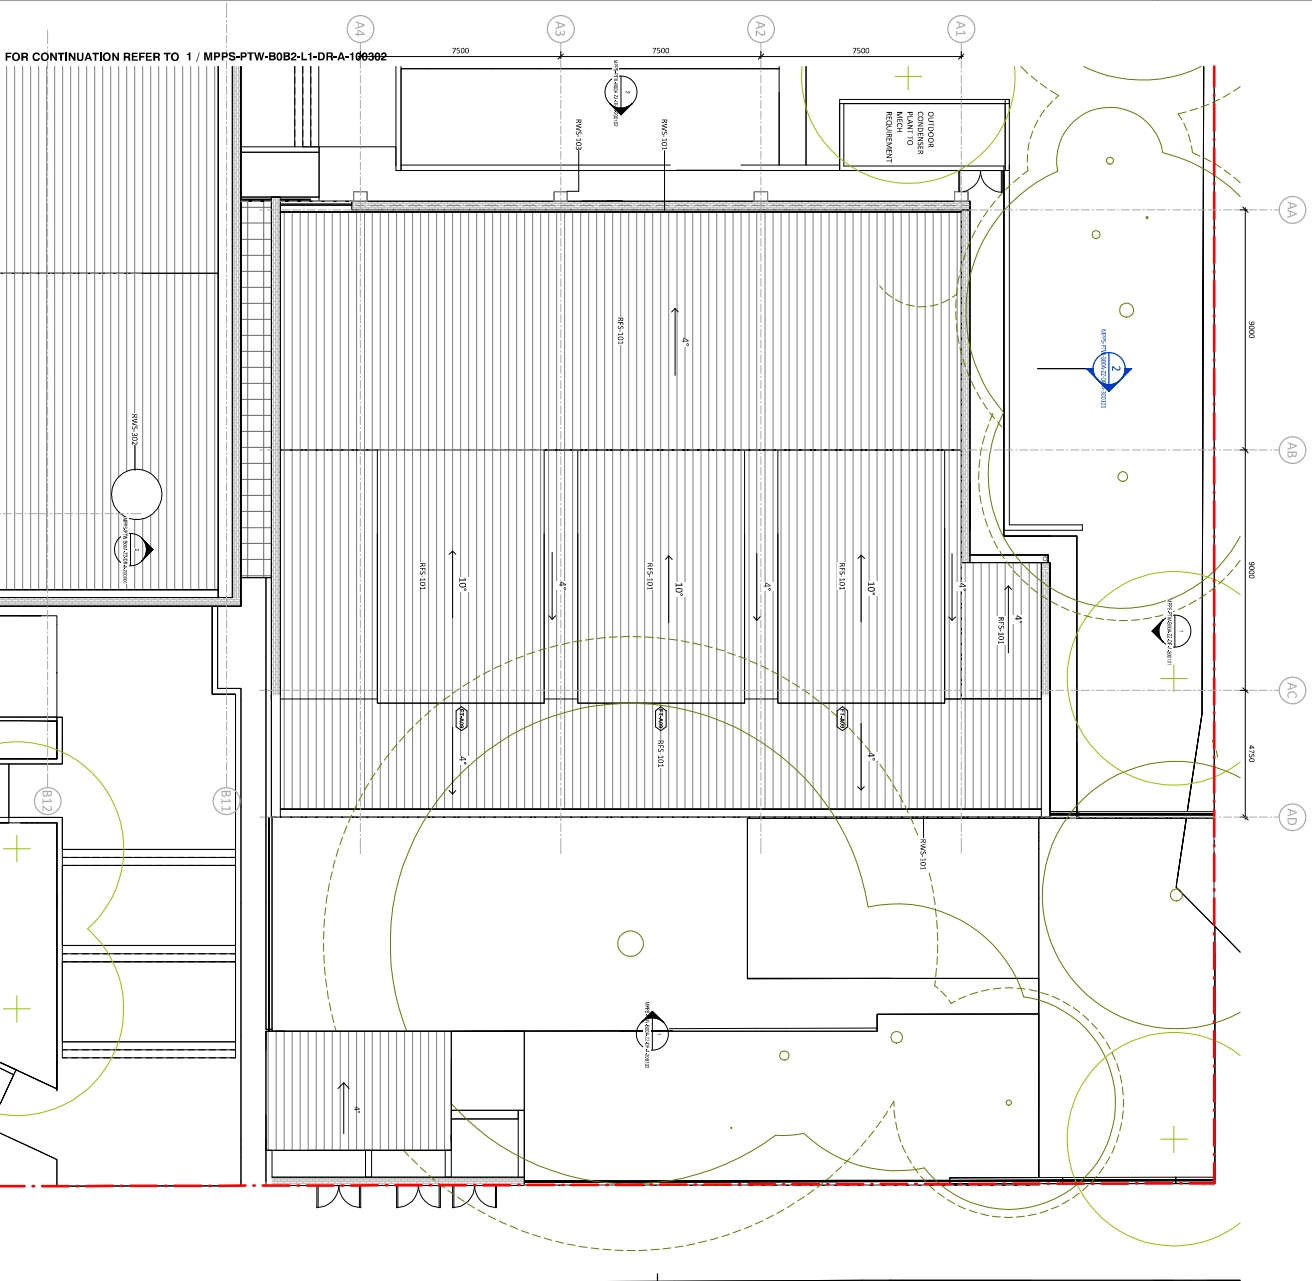

FOR CONTINUATION REFER TO 1 / MPPS-PTW-B0B2-L1-DR-A-100902

FOR CONTINUATION REFER TO 1 / MPPS-PTW-B0B1-RF-DR-A-100203

GA - BLOCK A - ROOF
1:100 @A1

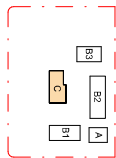

Drawing Disclaimer:
This is a drawing for information only and does not constitute a contract. The client is responsible for ensuring the drawing is used in accordance with the contract of PTW Architects.

Notes:
PTW is responsible for any potential building element is strictly limited to the information provided in this drawing. PTW is not responsible for any building element or other work associated with any building or external building element.

Consultant

Client
SHELV

Architect
PTW Architects
PTW.COM.AU

Project: 242335555
Melrose Park Public School


Title
GA - BLOCK C - ROOF

Drawing Number
MPPS-PTW-B00C-RF-DR-A-100502 12

Scale
1:100 FOR TENDER


FOR CONTINUATION REFER TO 1 / MPPS-PTW-B0B3-GF-DR-A-100502

FOR CONTINUATION REFER TO 1 / MPPS-PTW-B0B3-GF-DR-A-100402

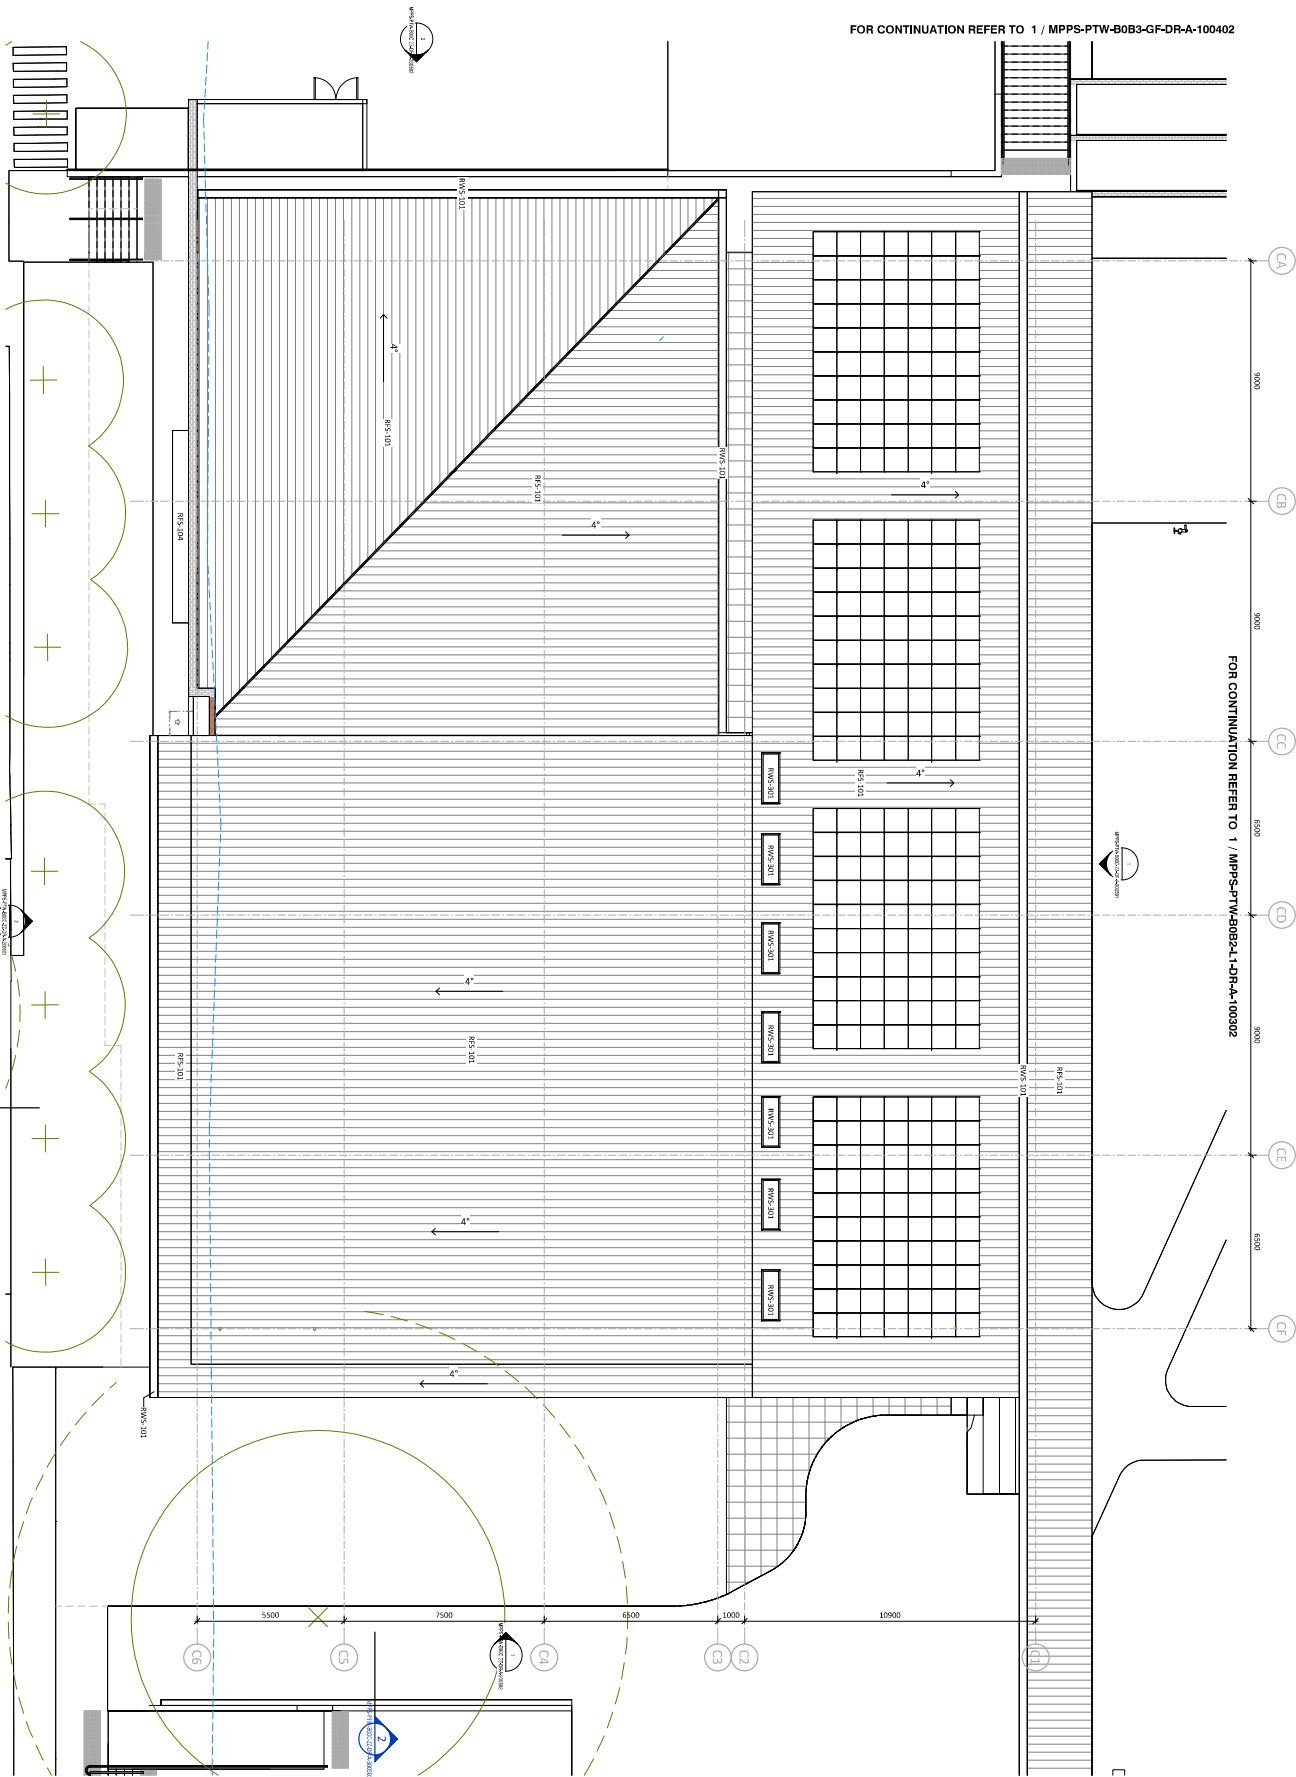

1 GA - BLOCK C - RF
1:100 @A1



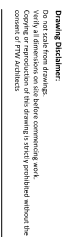

firm's responsibility for any external building element is strictly limited to that provided for by our relevant scope of Services. Others, including suitably qualified experts as may be required or as is appropriate, carry responsibility for any checking of or other work associated with any design, materials selection, construction or installation of any cladding, facade or external building element.

[illegible]

Consultant

Client
SINSW

Architect:
PTW Architects
Gadigal Country
Level 11, 88 Phillip Street
Sydney NSW 2000 Australia
T +61 2 9232 5877
ptw.com.au

MELROSE PARK PUBLIC SCHOOL
110 Wharf Road, Melrose Park NSW 2114

10 - GENERAL ARRANGEMENT PLANS

| Drawing Number | Revision |
|------------------------------|----------|
| MPPS-PTW-B0B1-GF-DR-A-100201 | T2 |


Status

**FOR WRITTEN ENDORSEMENT
TO PROCEED**


**SIGN, STAMP
AND DATE: NOT RECEIVED BY PTW 17/01/2025**

| LEGEND WALL PRL | |
|---|-----------------|
| | PRL - /60/60 |
| | PRL 60/60/60 |
| | PRL 120/120/120 |

NOTE: EXCLUDING GLAZING, PERFORMANCE SOLUTION REQUIRED

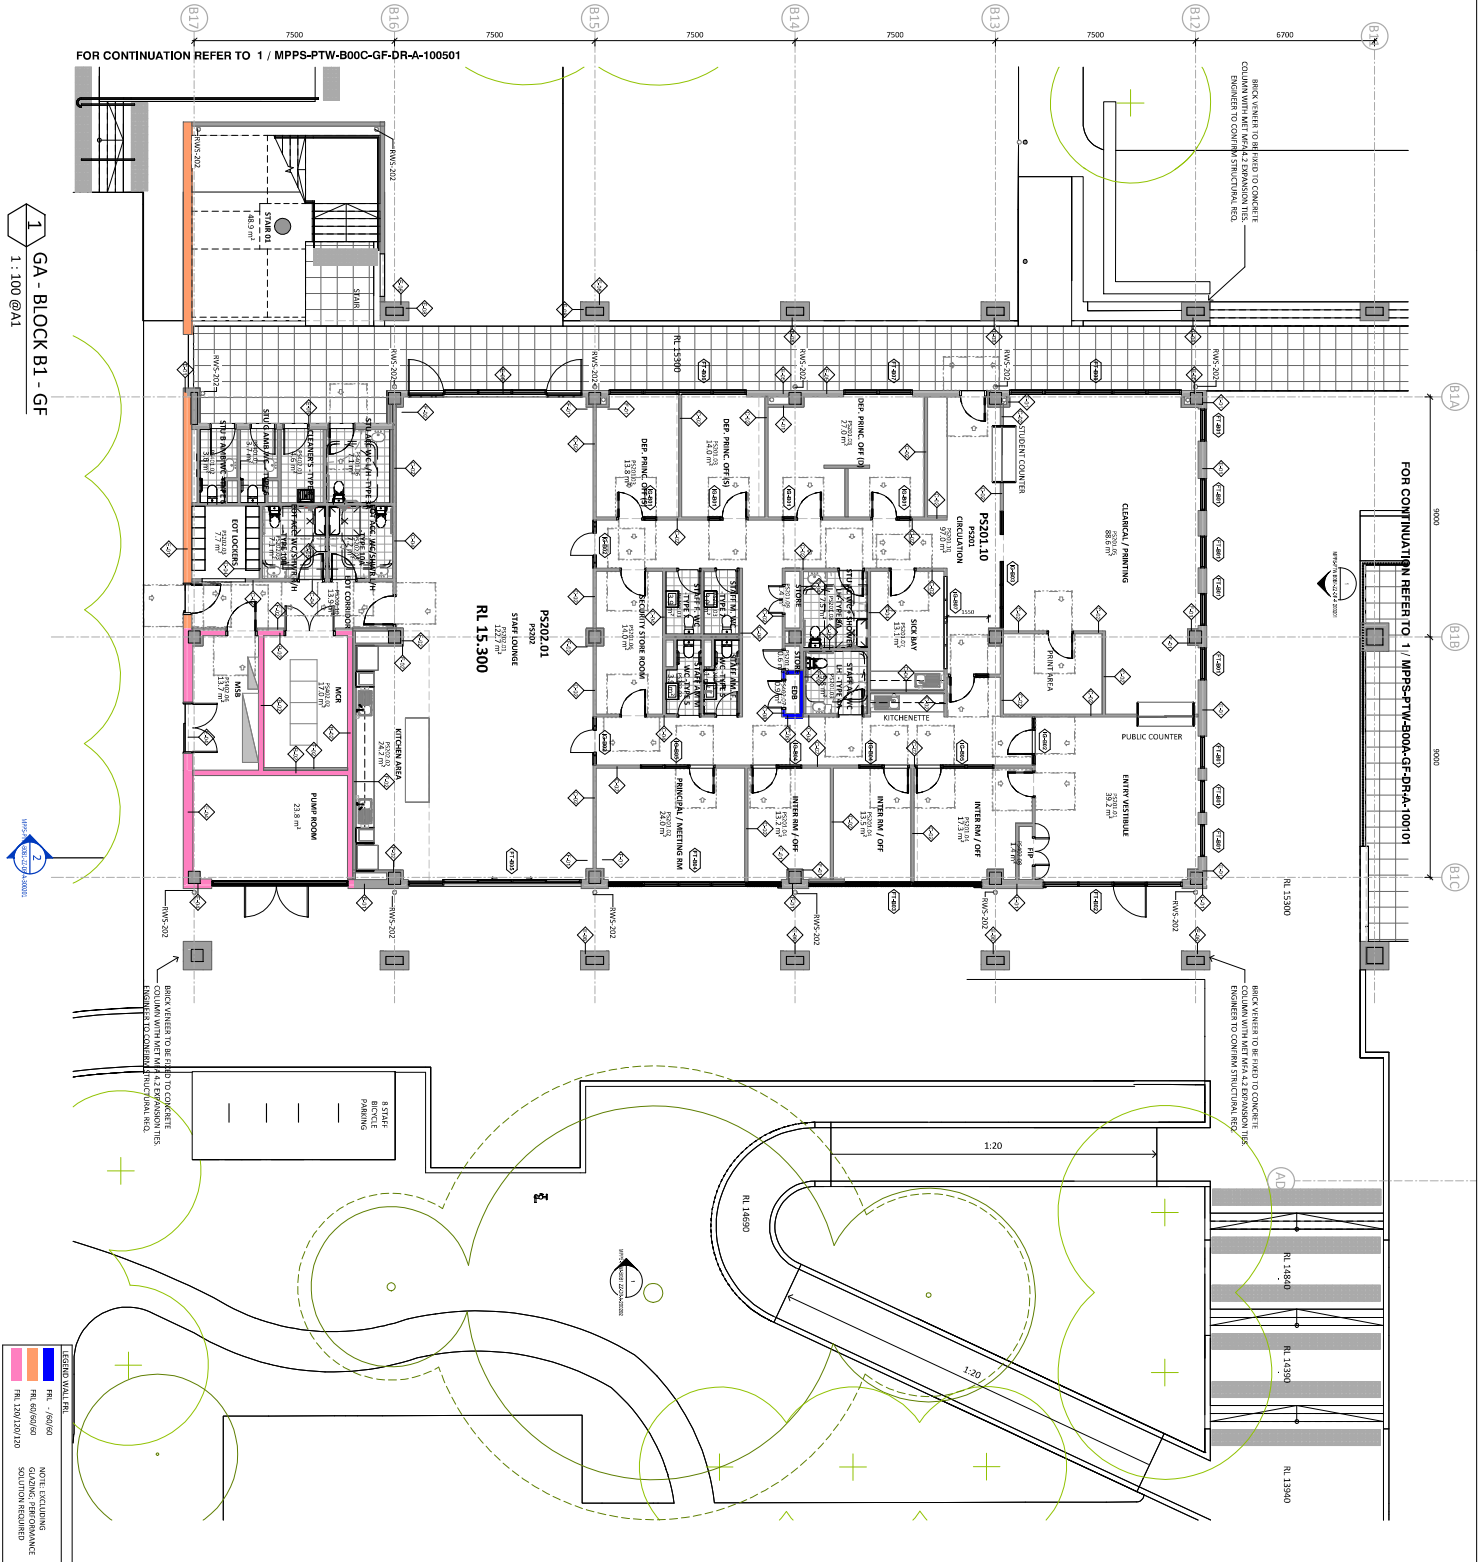

GA - BLOCK B1 - GF
1 : 100 @A1

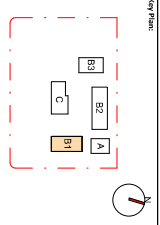

Drawing Disclaimer:


Consultant:

Client:


Architect:
PTW Architects


Title:
10 - GENERAL ARRANGEMENT PLANS
GA - BLOCK B1 - L1


Drawing Number:
MPPS-PTW-B008-L1-DR-A-100002
Revision:
12

Scale:
1:100 A1
1:100 A1

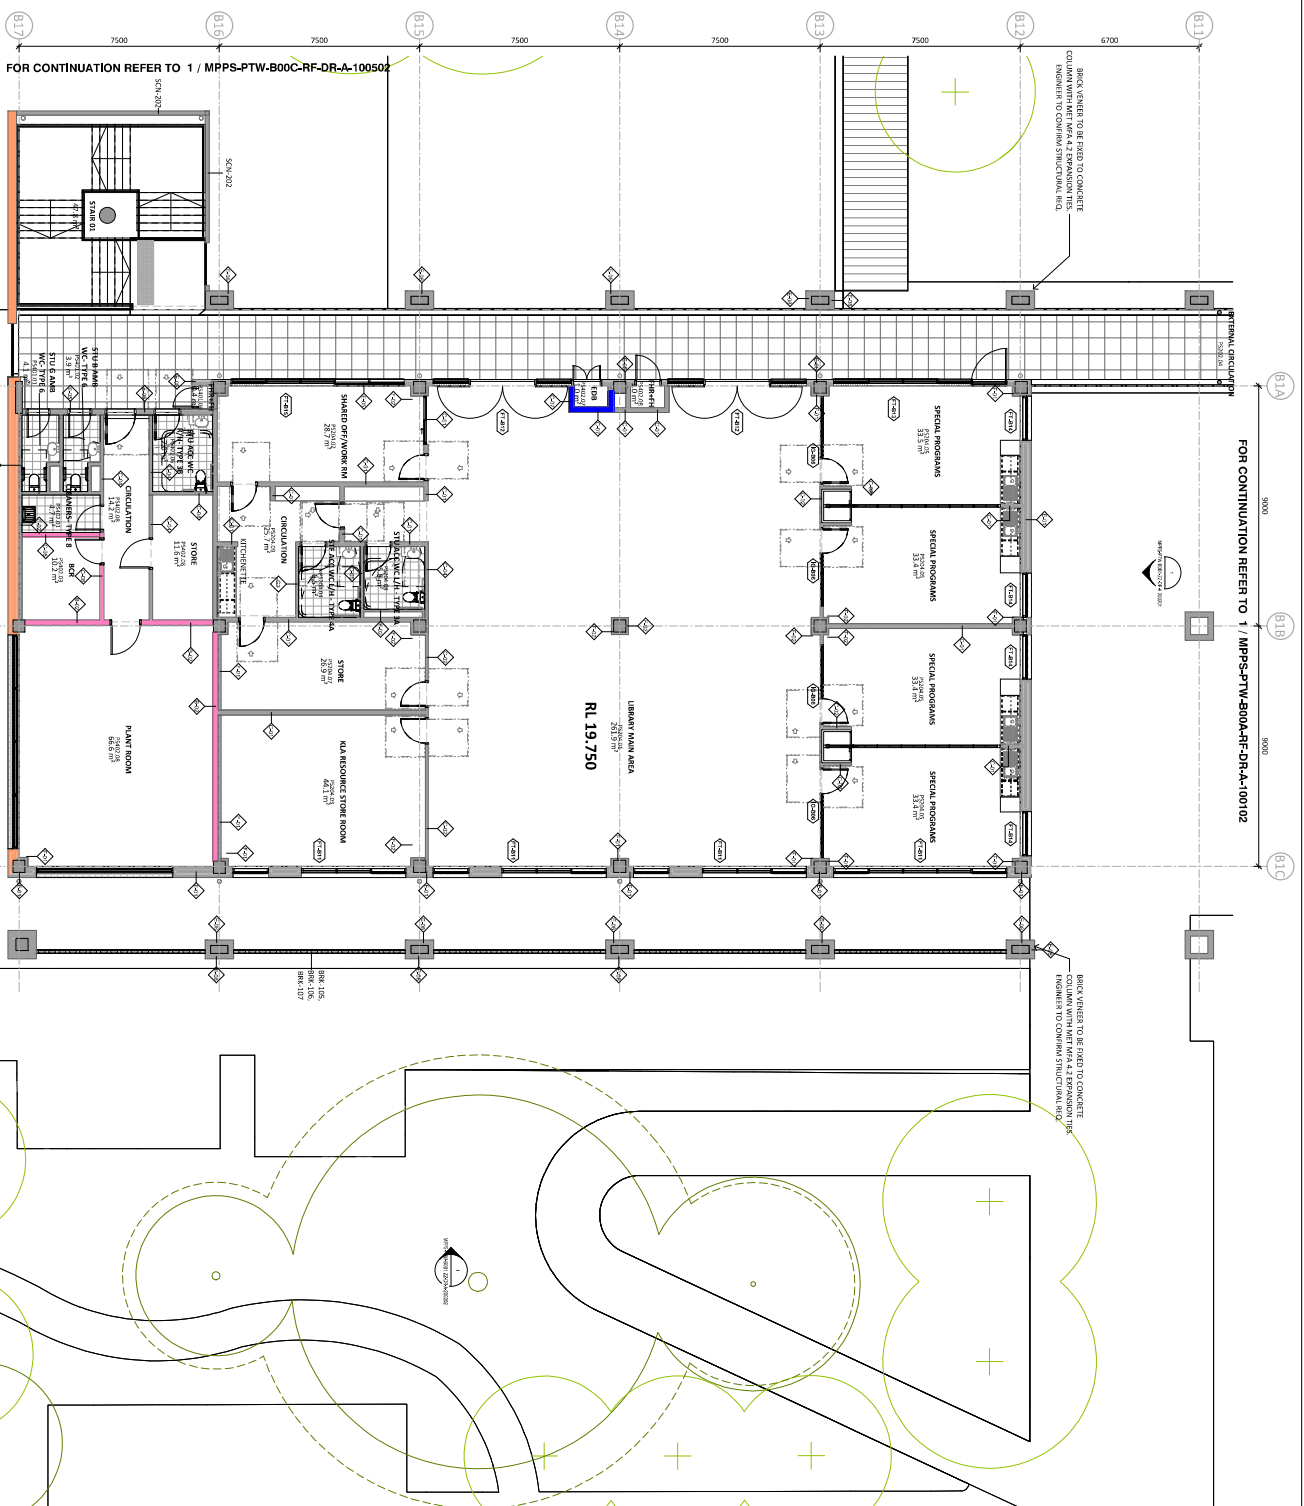

GA - BLOCK B1 - L1
1:100 @ A1

FOR WRITTEN ENDORSEMENT
TO PROCEED
SIGN STAMP
AND DATE: NOT RECEIVED BY PTW 17/01/2025

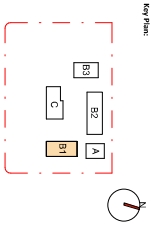

Drawing Disclaimer:




PTW Architects


Title:
10 - GENERAL ARRANGEMENT PLANS
GA - BLOCK B1 - ROOF

Drawing Number:
MPPS-PTW-B0081-RF-DR-A-100203 12
Scale:
1:100 A1
Status:
NOT FOR TENDER

PTW


FOR WRITTEN ENDORSEMENT
TO PROCEED

SEAL STAMP
AND DATE: NOT RECEIVED BY PTW 17/01/2025



1
1:100 @ A1

GA - BLOCK B1 - ROOF

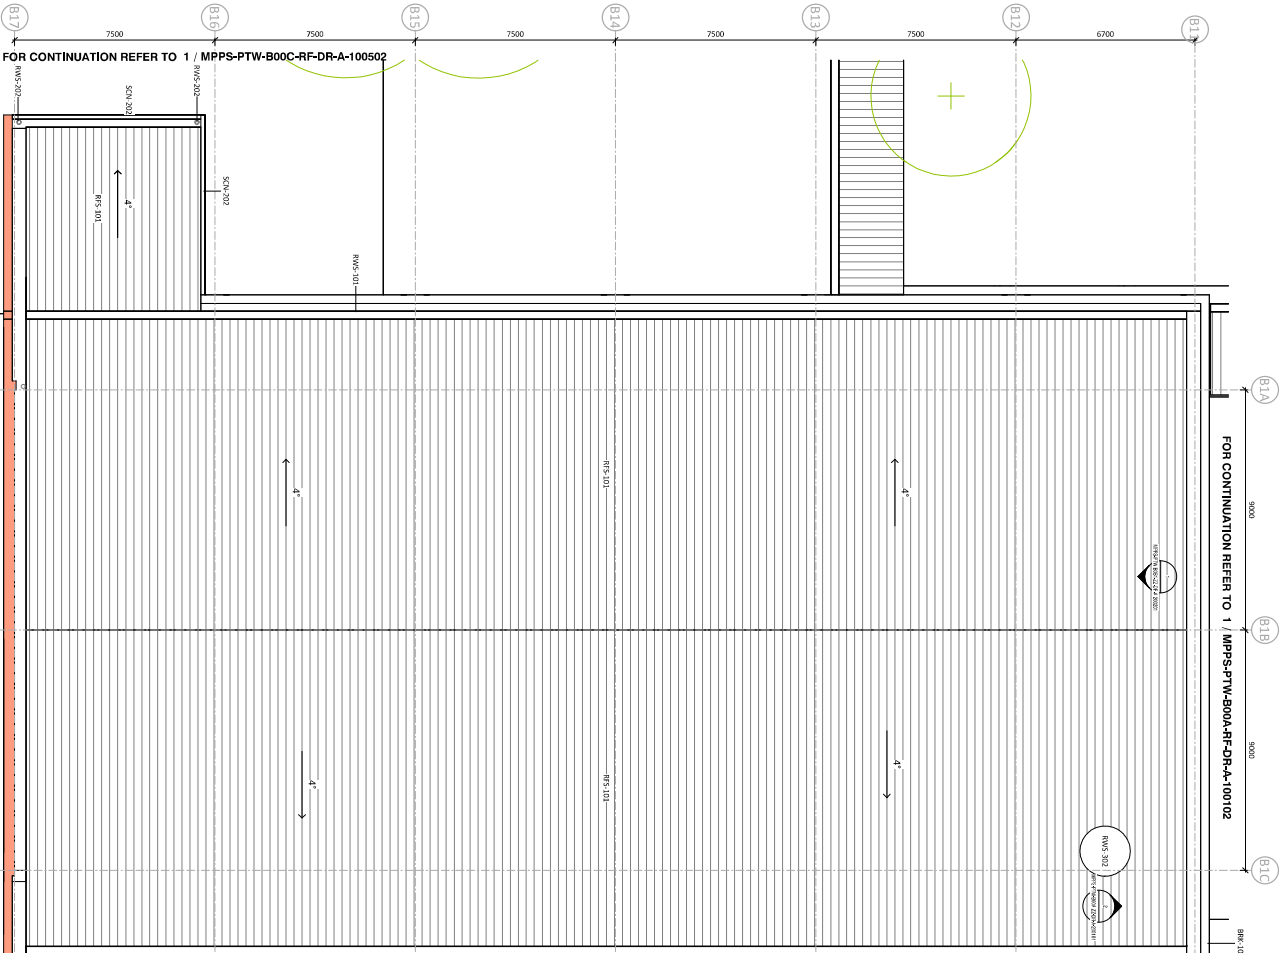

FOR CONTINUATION REFER TO 1 / MPPS-PTW-B00C-RF-DR-A-100502

FOR CONTINUATION REFER TO 1 / MPPS-PTW-B00A-RF-DR-A-100102

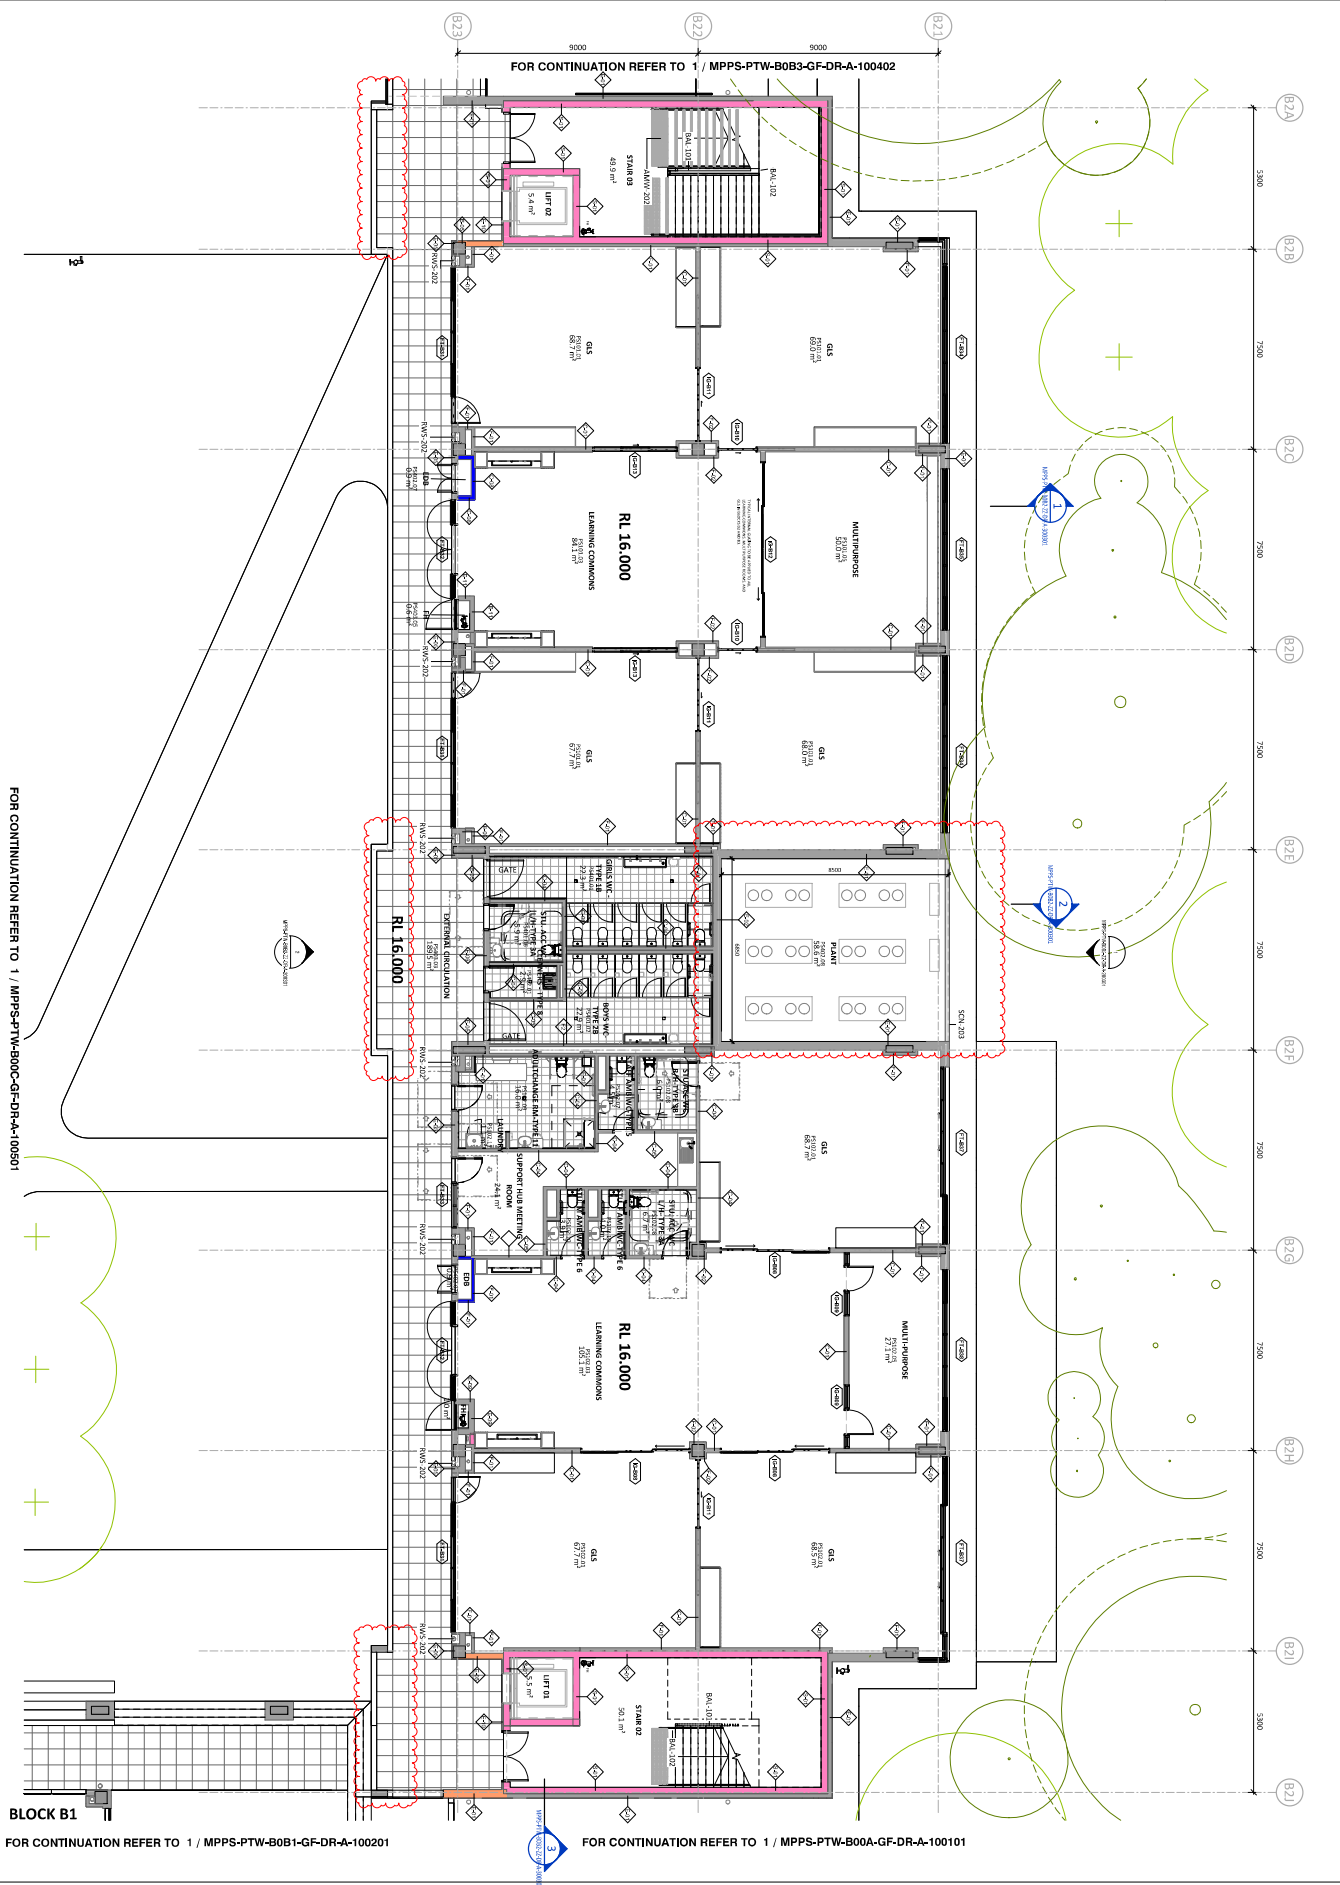


responsibility for any external building element is strictly limited to that provided for by our relevant scope of Services. Others, including suitably qualified experts as may be required or as is appropriate, carry responsibility for any checking of or other work associated with any design, materials selection, construction or installation of any cladding, facade or external building element.

| | | | | |
|-----|------------------------|----|----|----------|
PTW

TOOL

| Drawing Number | Revision |
|------------------------------|----------|
| MPPS-PTW-B0B2-GF-DR-A-100301 | T2 |

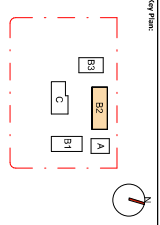

Drawing Disclaimers:


Client:




Title:
10 - GENERAL ARRANGEMENT PLANS
GA - BLOCK B2 - L1

Revision:
MPPS-PTW-B082-L1-DR-A-100302 12


Scale:
1:100 A1

Sheet:
12 OF 12 SHEETS

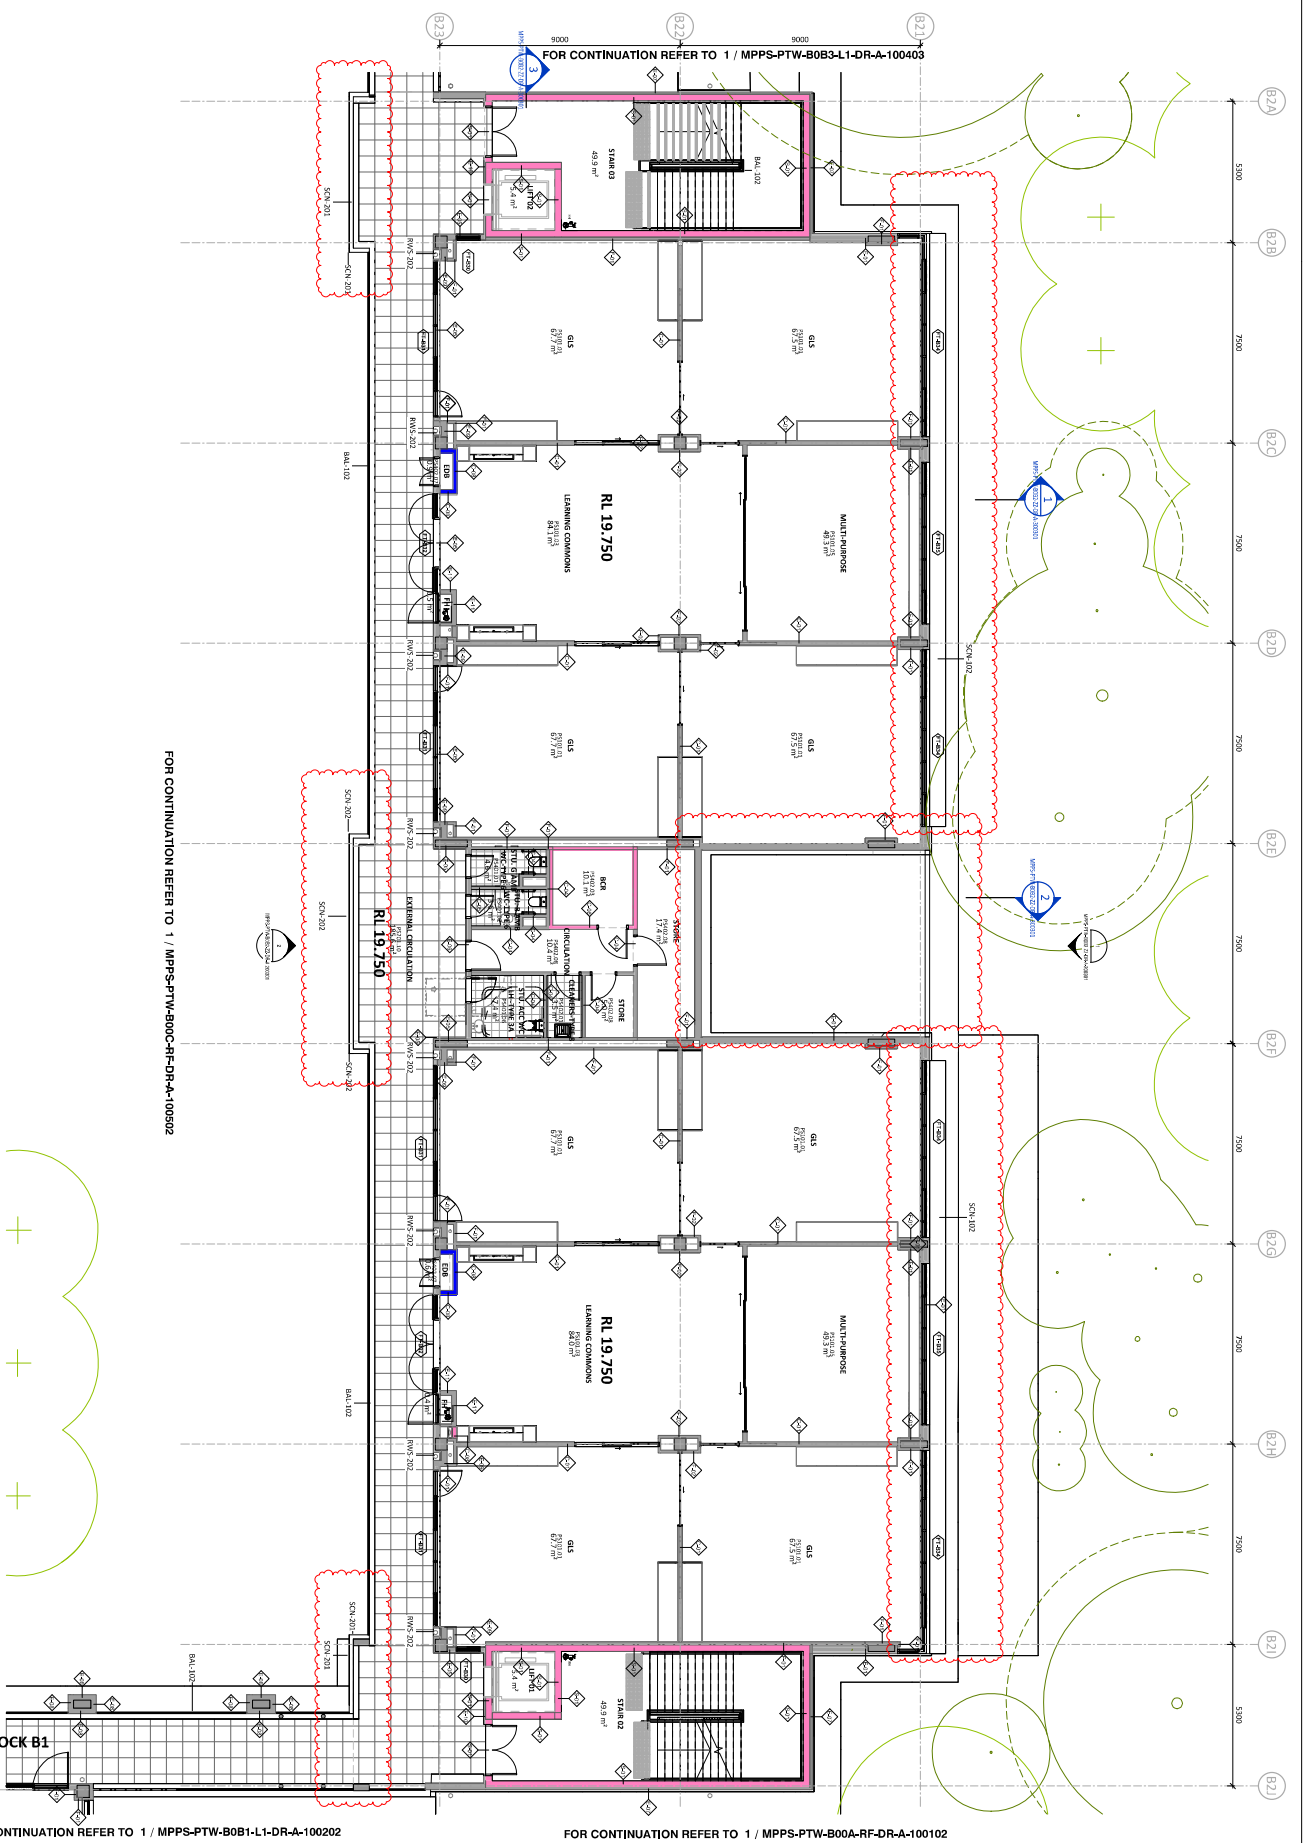

GA - BLOCK B2 - L1
1:100 @A1

FOR WRITTEN ENDORSEMENT TO PROCEED
SIGN STAMP
AND DATE: NOT RECEIVED BY PTW 17/01/2025

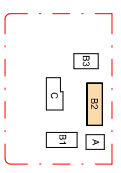

prw's responsibility for any external building element is strictly limited to that provided for by our relevant scope of Services. Others, including suitably qualified experts as may be required or as is appropriate, carry responsibility for any checking of or other work associated with any design, materials selection, construction or installation of any cladding, facade or external building element.

[illegible]

Consultant

Client
SINSW

Architect
PTW Architects
Gadigal Country
Level 11, 88 Phillip Street
Sydney NSW 2000 Australia
T +61 2 9232 5877
ptw.com.au

MELROSE PARK PUBLIC SCHOOL
110 Wharf Road, Melrose Park NSW 2114

10 - GENERAL ARRANGEMENT PLANS
GA - BLOCK B2 - L2

| Drawing Number | Revision |
|------------------------------|----------|
| MPPS-PTW-B0B2-L2-DR-A-100303 | T2 |

STATUS
ISSUED FOR TENDER

FOR CONTINUATION REFER TO 1 / MPPS-PTW-B00A-RF-DR-A-100102

FOR CONTINUATION REFER TO 1 / MPPS-PTW-B00C-RF-DR-A-100502


**FOR WRITTEN ENDORSEMENT
TO PROCEED**


AND DATE: NOT RECEIVED BY PTW 17/01/2025

| LEGGED WALL FRI | |
|---|------------------|
| | FRI. - /60/60 |
| | FRI. 60/60/60 |
| | FRI. 120/120/120 |

NOTE: EXCLUDING GLAZING, PERFORMANCE SOLUTION REQUIRED

GA - BLOCK B2 - L2
1:100 @A1

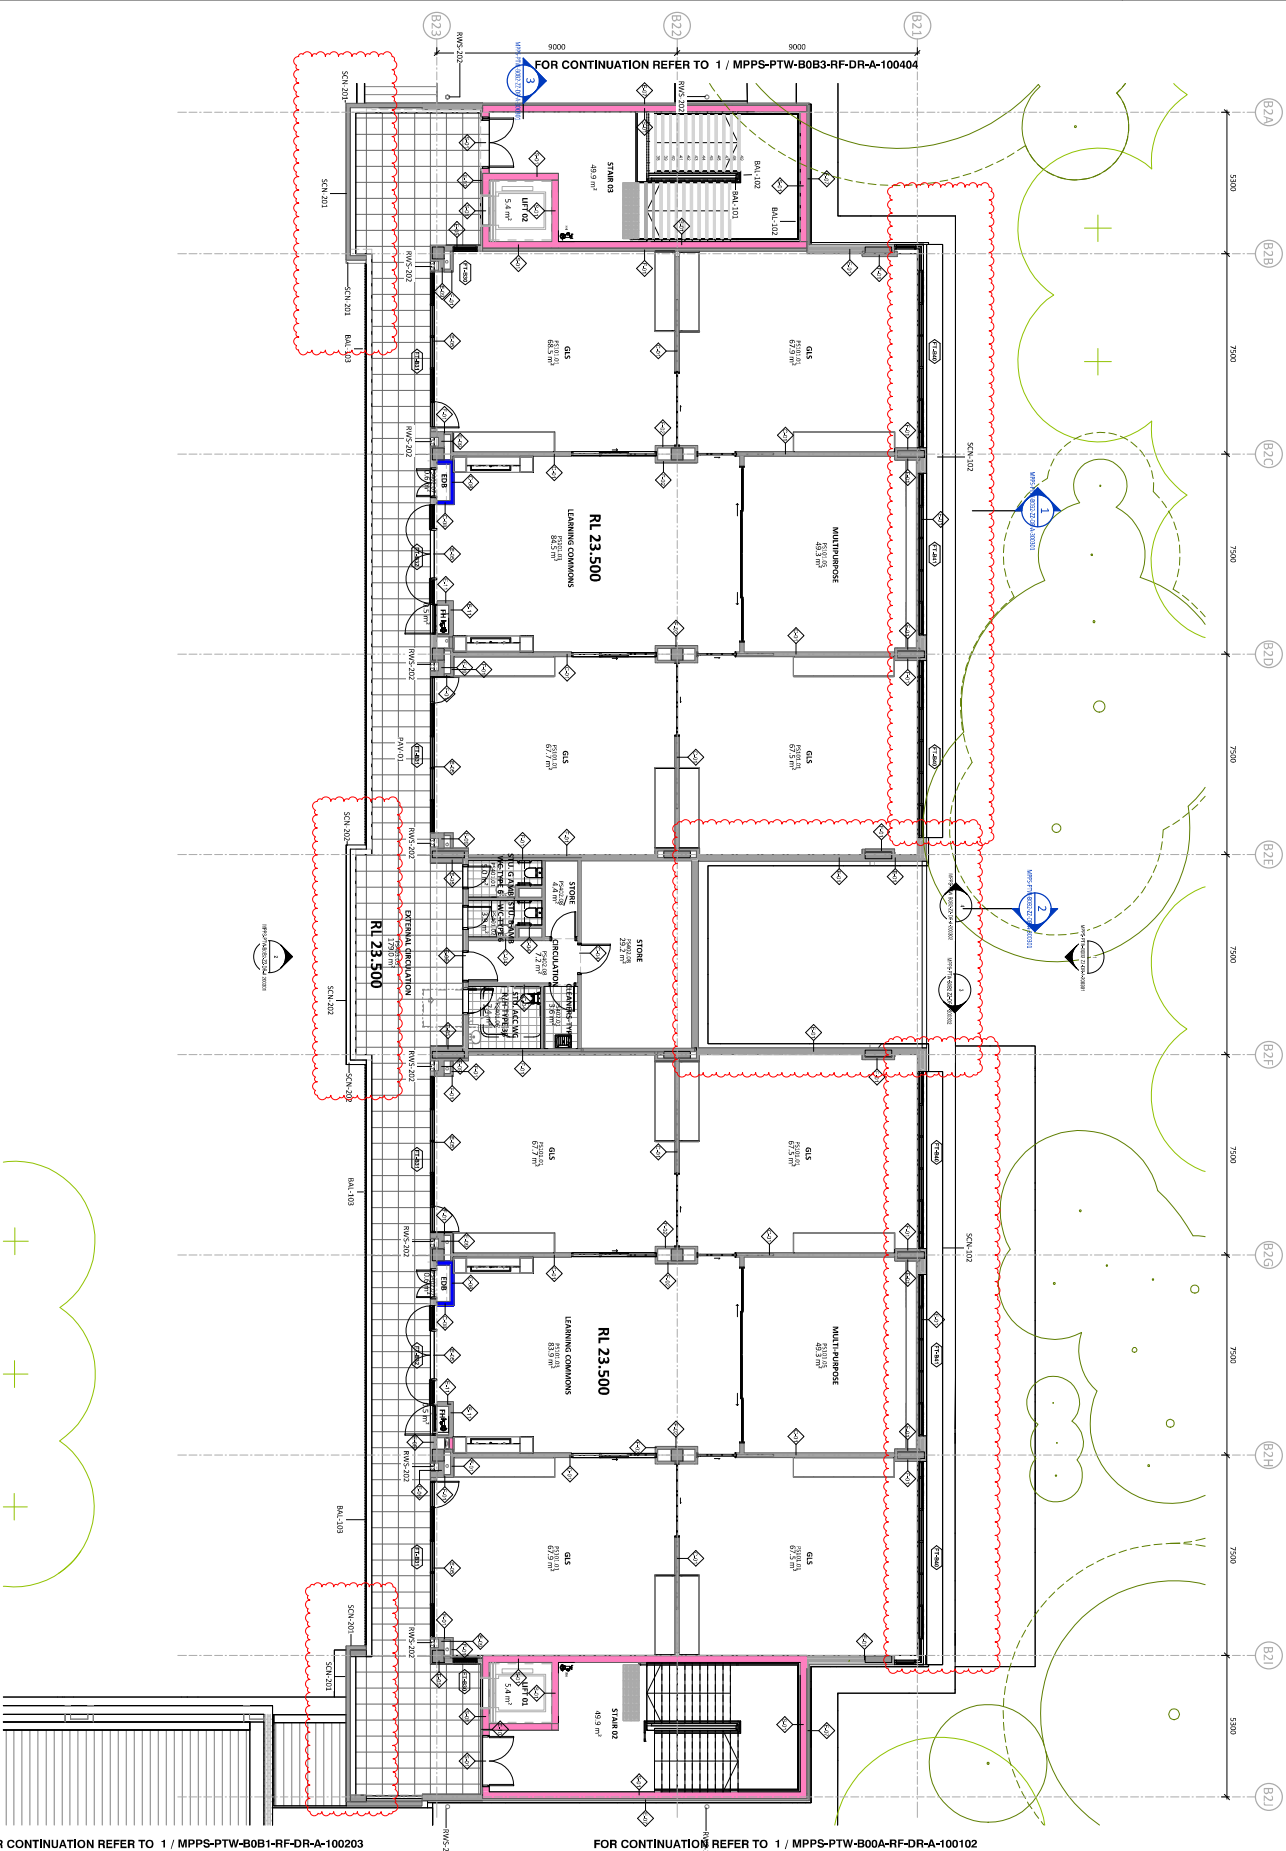

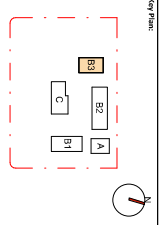

Drawing Disclaimers:


Consultant:

Client:

Architect:
PTW Architects


Title:
10 GENERAL ARRANGEMENT PLANS
GA - BLOCK B3 - L1

Drawing Number:
MPPS-PTW-B083-L1-DR-A-100403 12

Scale:
1:100 A1
1:100 A1

FOR CONTINUATION REFER TO 1 / MPPS-PTW-B00C-RF-DR-A-100502


FOR CONTINUATION REFER TO 1 / MPPS-PTW-B082-L1-DR-A-100302

GA - BLOCK B3 - L1
1:100 @A1

LEGEND WALL FIN.
NOTE: LITING PERFORMANCE REQUIRED
SOLUTION REQUIRED

FOR WRITTEN ENDORSEMENT
TO PROCEED
SIGN: STAMP
AND DATE: NOT RECEIVED BY PTW 17/01/2025

GA - BLOCK B3 - RF
1 : 100

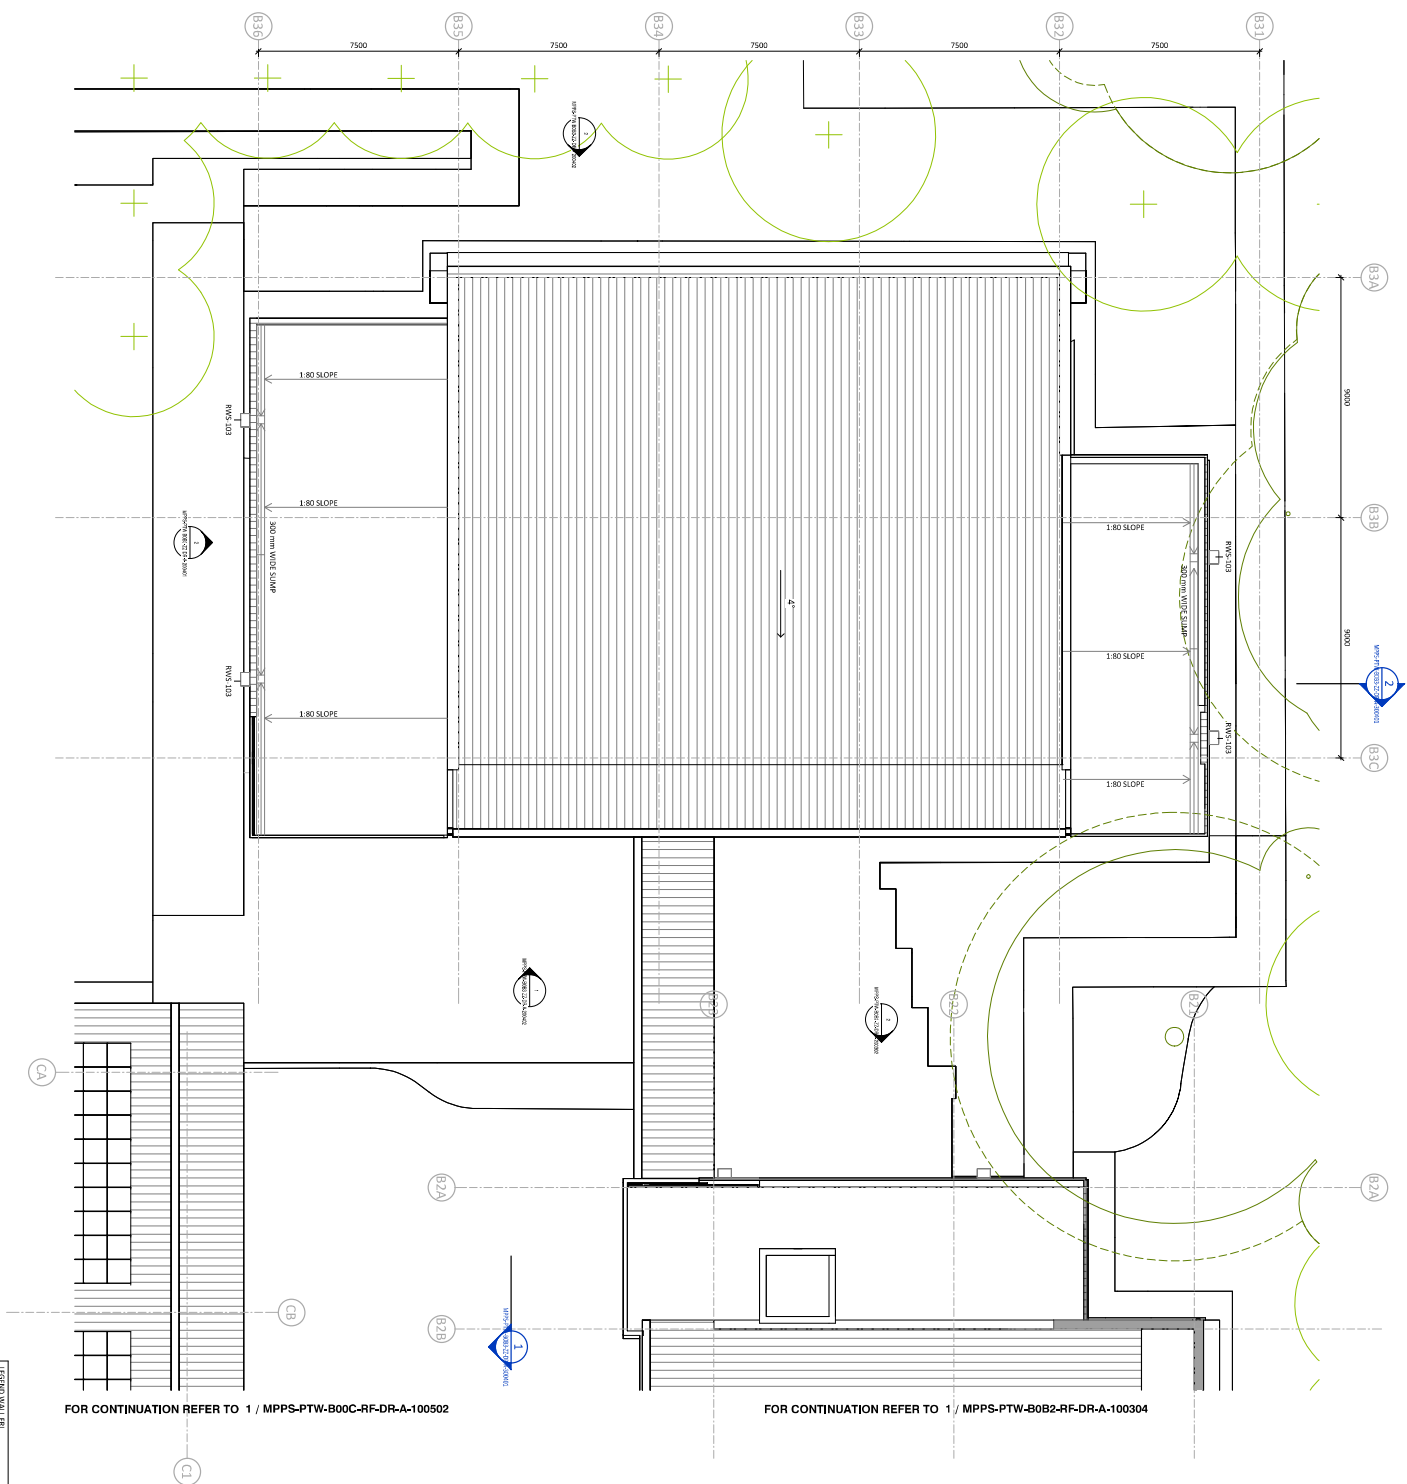


FOR CONTINUATION REFER TO 1 / MPPS-PTW-B00C-RF-DR-A-100502

FOR CONTINUATION REFER TO 1 / MPPS-PTW-B0B2-RF-DR-A-100304

LEGEND WALL FRI

| | |
|-----------------|--|
| FRI - /60/60 | NOTE: EXCLUDING GLAZING; PERFORMAN SOLUTION REQUIRED |
| FRI 60/60/60 | |
| FRI 120/120/120 | |

**FOR WRITTEN ENDORSEMENT
TO PROCEED**

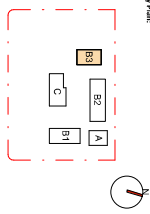

Drawing Disclaimer:
Do not scale from drawings.
Verify all dimensions on site before commencing work.
Copying or reproduction of this drawing is strictly prohibited without the
consent of PTW Architects

Note: PRW's responsibility for any external building element is strictly limited to that provided for by our relevant scope of Services. Others, including suitably qualified experts as may be required or as is appropriate, carry responsibility for any checking of or other work associated with any design, materials selection, construction or installation of any cladding, facade or external building element.


Consultant

Client
SINSW

PTW

ADVERTISING
PTW Architects
Gadigal Country
Level 11, 88 Phillip Street
Sydney NSW 2000 Australia
T +61 2 9322 5877

ptw.com.au

Project: PAD305386
MELROSE PARK PUBLIC SCHOOL
110 Wharf Road, Melrose Park NSW 2114



PTW

10 - GENERAL ARRANGEMENT PLANS
GA - BLOCK B3 - ROOF

| | | | | |
|-----|-----|-----|-----|-------|
| 0 m | 1 m | 2 m | 5 m | 7.5 m |
|-----|-----|-----|-----|-------|



Note: PTW responsibility for any external building element is strictly limited to that provided for by our relevant scope of Services. Others, including suitably qualified experts as may be required or as is appropriate, carry responsibility for any checking or other work associated with any design, materials selection, construction or installation of any cladding, facade or external building element.

| Item | Account Name | By | Date | Chq. | Cash |
|------|--------------|----|------|------|------|
| 1 | | | | | |
| 2 | | | | | |
Consultant

| | |
|--------|-------|
| Client | SINSW |
|--------|-------|

PTW Architects
PTW Architects
Gadigal Country
Level 11, 88 Phillip Street
Sydney NSW 2000 Australia
T +61 2 9232 5877
ptw.com.au

MELROSE PARK PUBLIC SCHOOL
110 Wharf Road, Melrose Park NSW 2114

20 - ELEVATIONS
ELEVATIONS - BLOCK A - SHEET 1


| Drawing Number | Revision |
|------------------------------|----------|
| MPPS-PTW-B00A-ZZ-DR-A-200101 | T2 |

Status

Allow for vertical secondary steel columns within the glazing modules to allow for support of the shading system.


**FOR WRITTEN ENDORSEMENT
TO PROCEED**

**SIGN, STAMP
AND DATE: NOT RECEIVED BY PTW 17/01/2025**

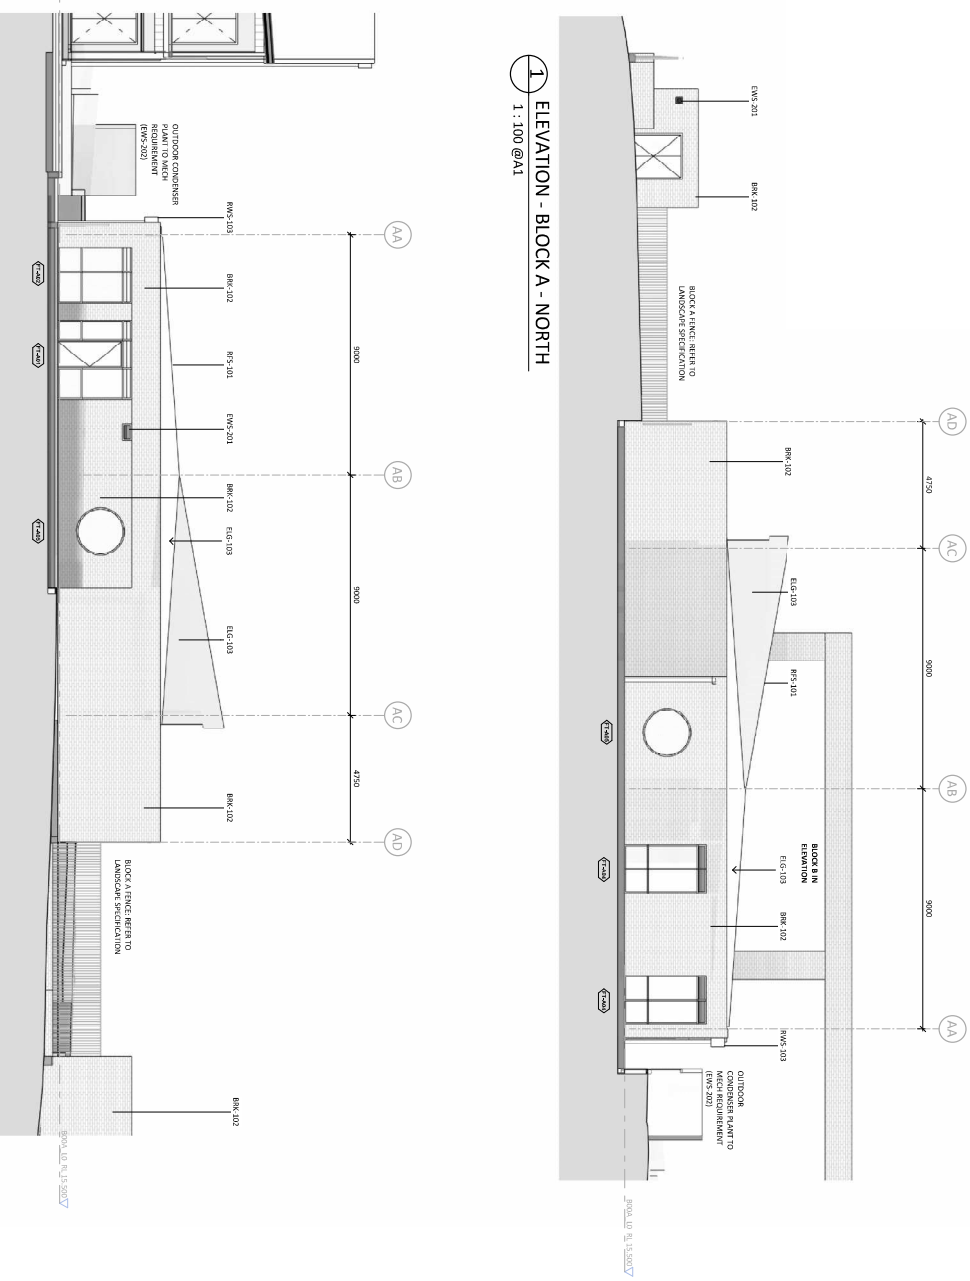

1
ELEVATION - BLOCK A - NORTH
1:100 @A1

2
ELEVATION - BLOCK A - SOUTH
1 : 100 @A1

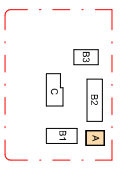

Verify all dimensions on site before commencing work.
Copying or reproduction of this drawing is strictly prohibited without the
consent of PTW Architects

that provided for by our relevant scope of Services. Others, including suitably qualified experts as may be required or as is appropriate, carry responsibility for any checking of or other work associated with any design, material selection, construction or installation of any cladding, facade or external building element.

[illegible]

ConsultantClient
SINSW


PTW
Architects
PTW Architects
Gadigal Country
Level 11, 88 Phillip Street
Sydney NSW 2000 Australia
T +61 2 9232 5877
ptw.com.au

MELROSE PARK PUBLIC SCHOOL
110 Wharf Road, Melrose Park NSW 2114


ELEVATIONS - BLOCK A - SHEET 2

MPPS-PTW-B00A-ZZ-DR-A-200102 T2

ISSUED FOR TENURE

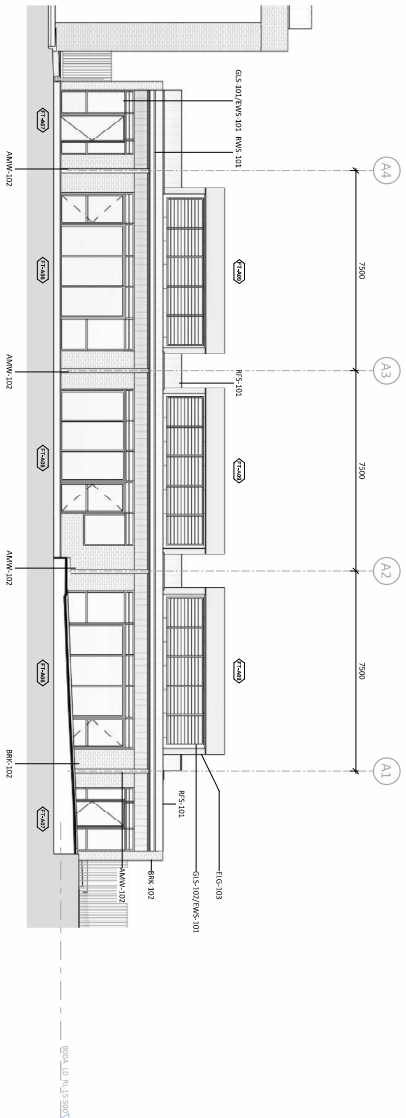

1
ELEVATION - BLOCK A - EAST
1 : 100 @A1

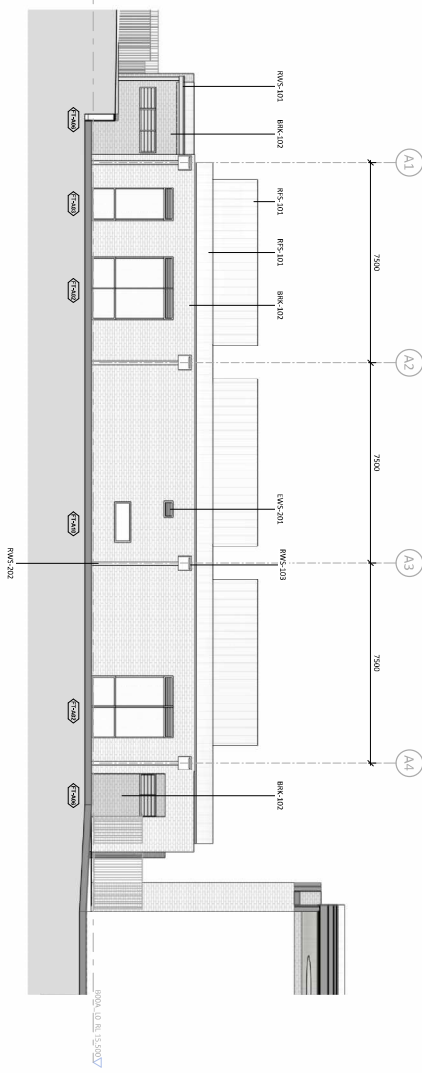


2 ELEVATION - BLOCK A - WEST
1:100 @A1

Note:
Allow for vertical secondary steel columns within the glazing modules to allow for support of the shading system.

**FOR WRITTEN ENDORSEMENT
TO PROCEED**

SIGN, STAMP
AND DATE: NOT RECEIVED BY PTW 17/01/2025

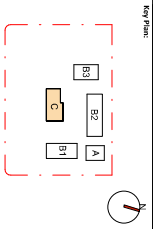

Drawing Disclaimers:



Consultant:

Client:



Architect:
PTW Architects


Title:
20 - ELEVATIONS
ELEVATIONS - BLOCK C - SHEET 1

Drawing Number:
MPPS-PTW-B00C-ZZ-DR-A-200501 12


Scale:
1:100 @A1

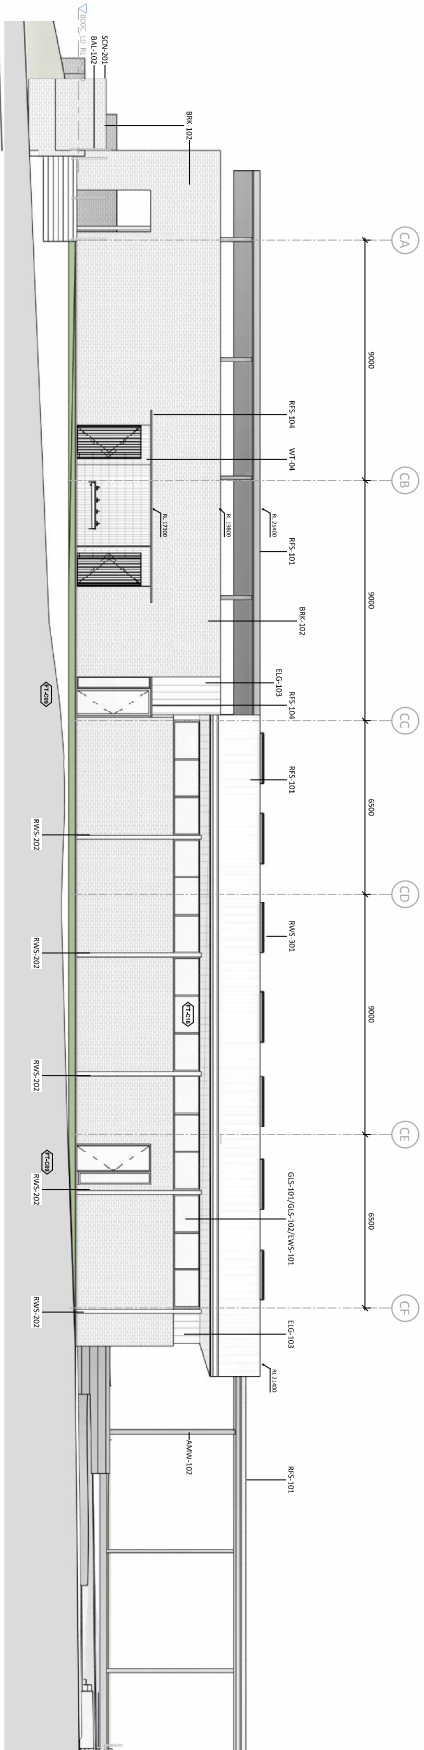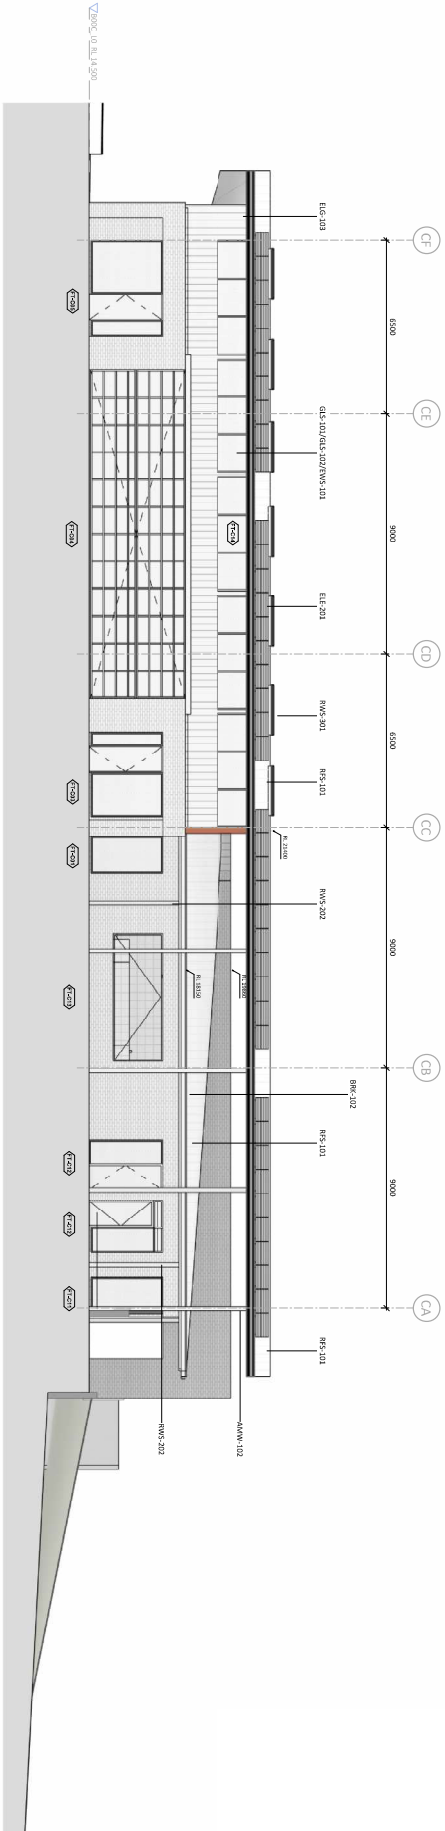

Note:
Allow for vertical secondary steel columns within the glazing modules to allow for support of the shading system.

FOR WRITTEN ENDORSEMENT TO PROCEED

Stamp and Date: NOT RECEIVED BY PTW 17/01/2025

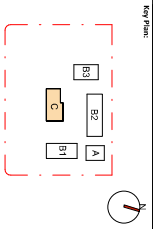

Drawing Disclaimer:



Consultant:

Client:


Architect:
PTW Architects



Title:
20 - ELEVATIONS
ELEVATIONS - BLOCK C - SHEET 2

Drawing Number:
MPPS-PTW-B00C-ZZ-DR-A-200502 12

Scale:
1:100 @A1

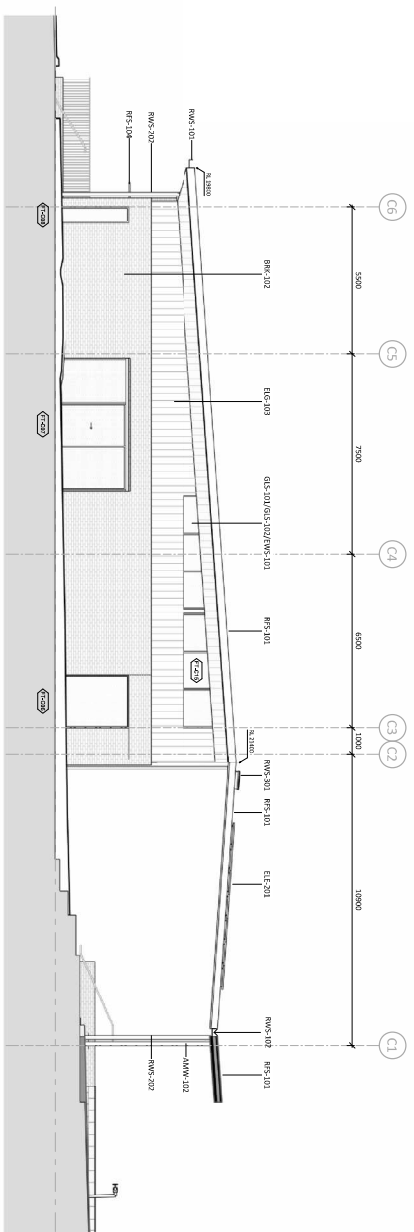

1 ELEVATION - BLOCK C - EAST
1 : 100 @A1

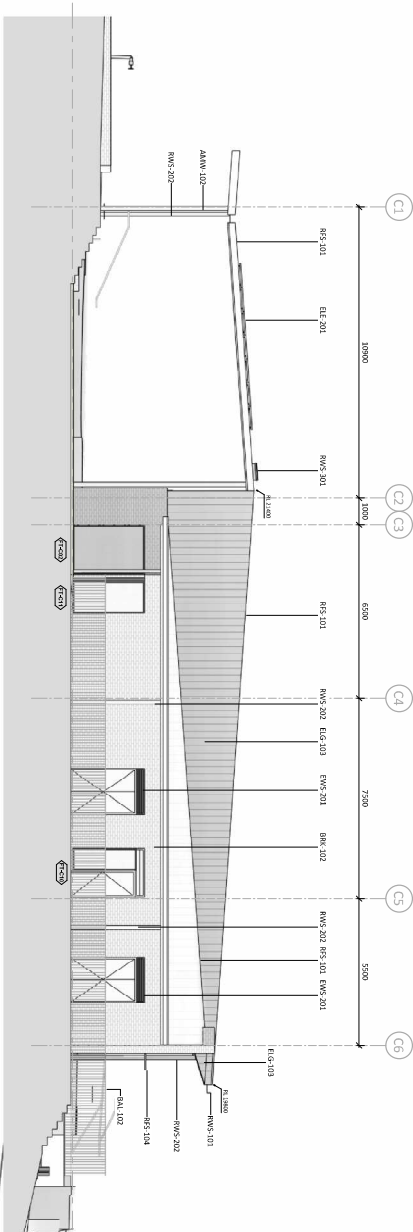


2 ELEVATION - BLOCK C - WEST
1 : 100 @A1

Note:
Allow for vertical secondary steel columns within the glazing modules to allow for support of the shading system.

FOR WRITTEN ENDORSEMENT
TO PROCEED

STAMP
AND DATE: NOT RECEIVED BY PTW 17/01/2025

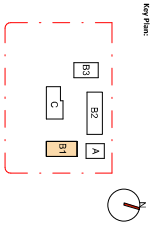

Drawing Disclaimer:




Consultant:

Client:





2025 ELEVATIONS

ELEVATIONS - BLOCK B1 - SHEET 1


Drawing Number:
MPPS-PTW-B081-ZZ-DR-A-200011 12

Scale:
1:100 @ A1

Sheet:
12 OF 12

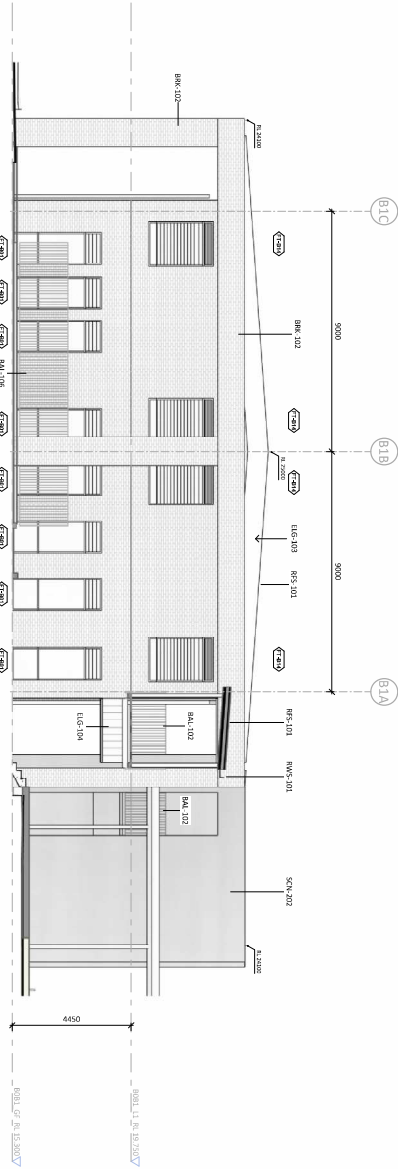

1 ELEVATION - BLOCK B1 - NORTH
1:100 @A1

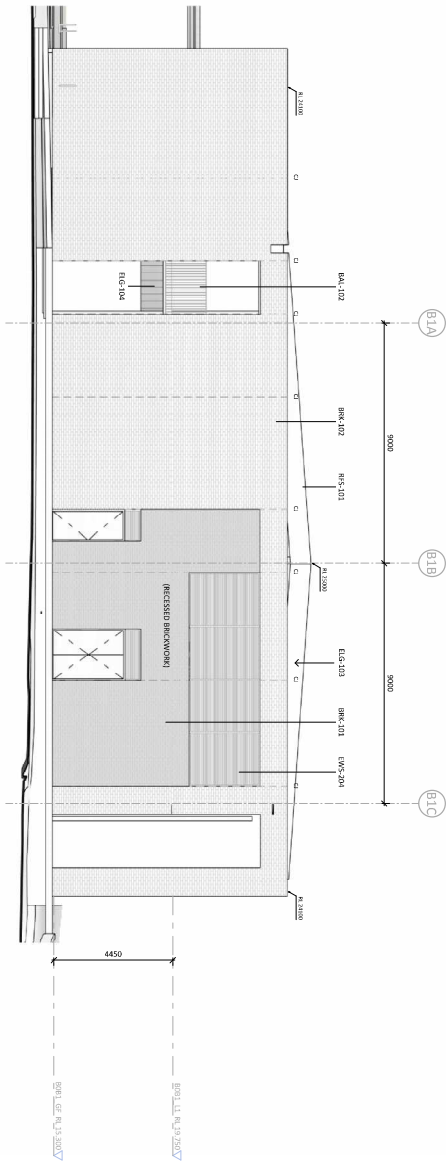


2 ELEVATION - BLOCK B1 - SOUTH
1:100 @A1

Note:
Allow for vertical secondary steel columns within the glazing modules to allow for support of the shading system.

FOR WRITTEN ENDORSEMENT
TO PROCEED

SCALE STAMP
AND DATE: NOT RECEIVED BY PTW 17/01/2025

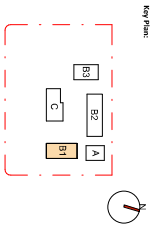

Drawing Disclaimer:


Consultant:

Client:

PTW.COM.AU



Title:
20 - ELEVATIONS

ELEVATIONS - BLOCK B1 - SHEET 2



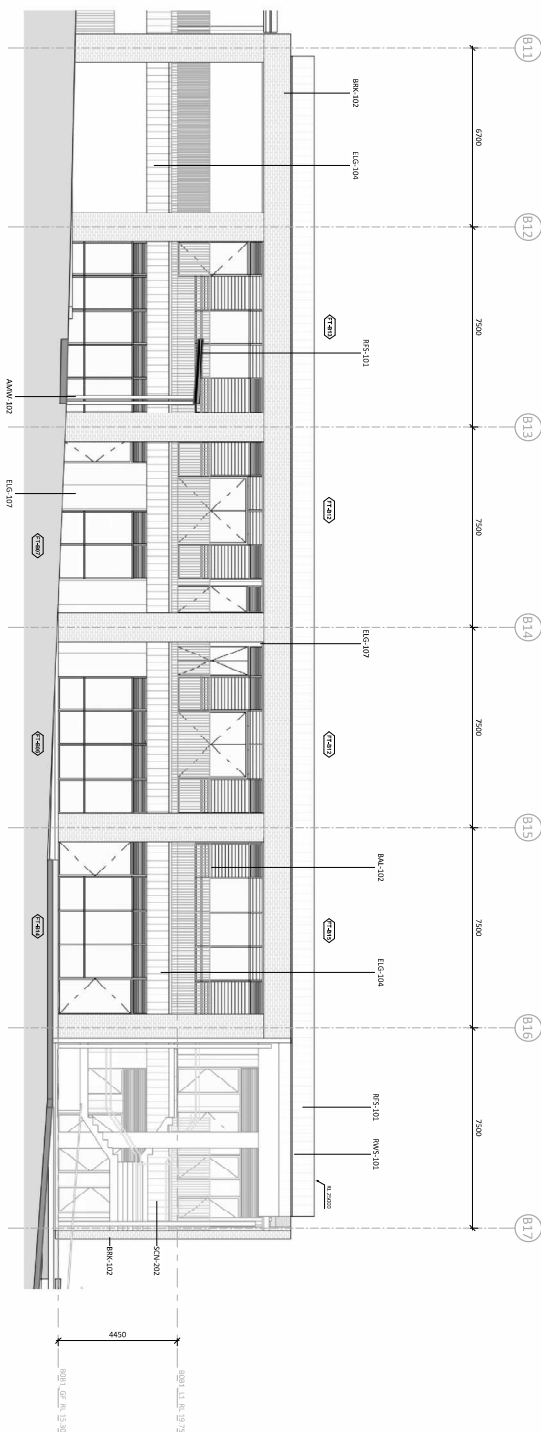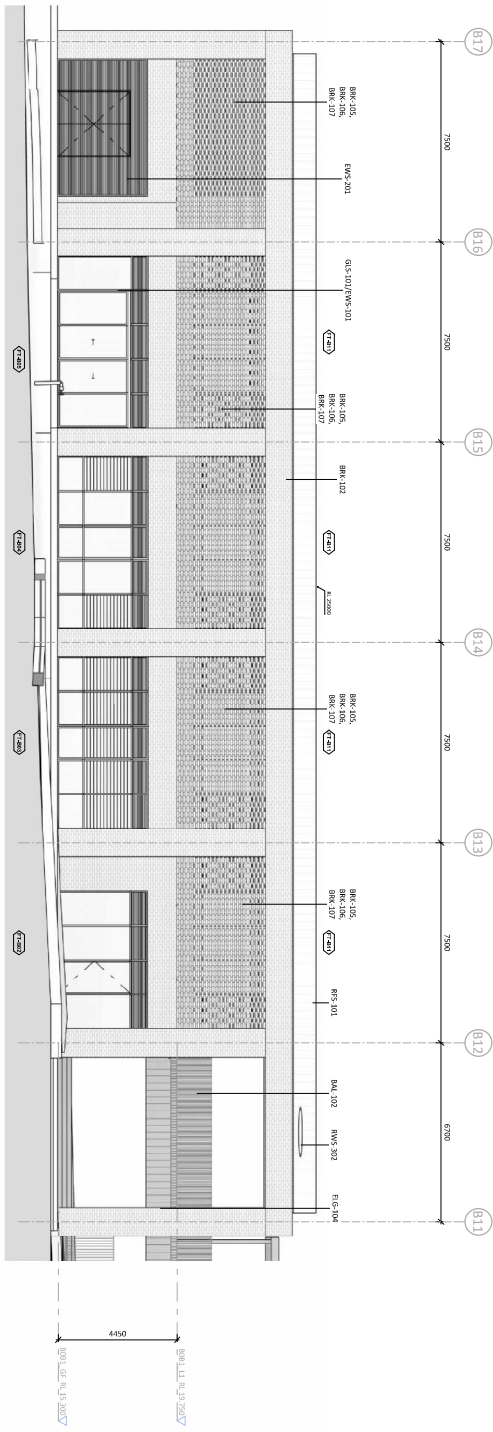

Note:
Allow for vertical secondary steel columns within the glazing modules to allow for support of the shading system.

FOR WRITTEN ENDORSEMENT TO PROCEED

STAMP AND DATE: NOT RECEIVED BY PTW 17/01/2025

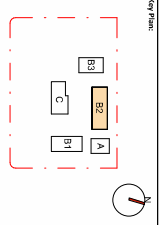

Drawing Disclaimer:
This drawing is for information only and does not constitute a contract. It is not to be used for construction without the consent of PTW Architects.

Notes:
1. PTW is responsible for any material building element is strictly limited to this project. It is not responsible for any other building element, including responsibility for any building or other work associated with any building or external building element.


Consultant:



Client:
SHEV
SHEV


Architect:
PTW Architects
Level 1, 88 Prince Street
Sydney NSW 2000
T: 61 2 9232 5877
PTW.COM.AU

MEIROSE PARK PUBLIC SCHOOL

20 ELEVATIONS:
ELEVATIONS - BLOCK B2 - SHEET 1

FOR WRITTEN ENDORSEMENT
TO PROCEED
SIGN, STAMP
AND DATE: NOT RECEIVED BY PTW 17/01/2025

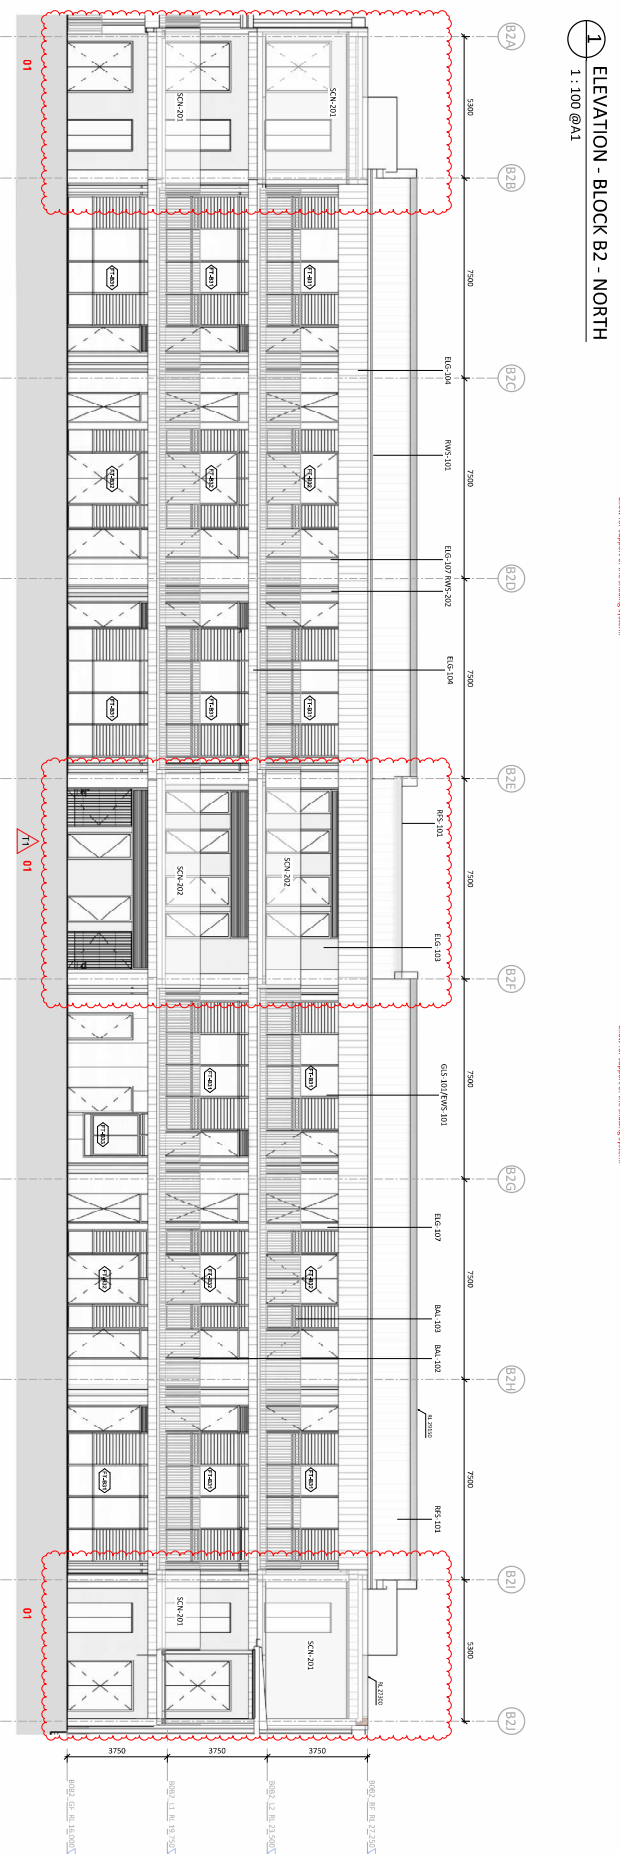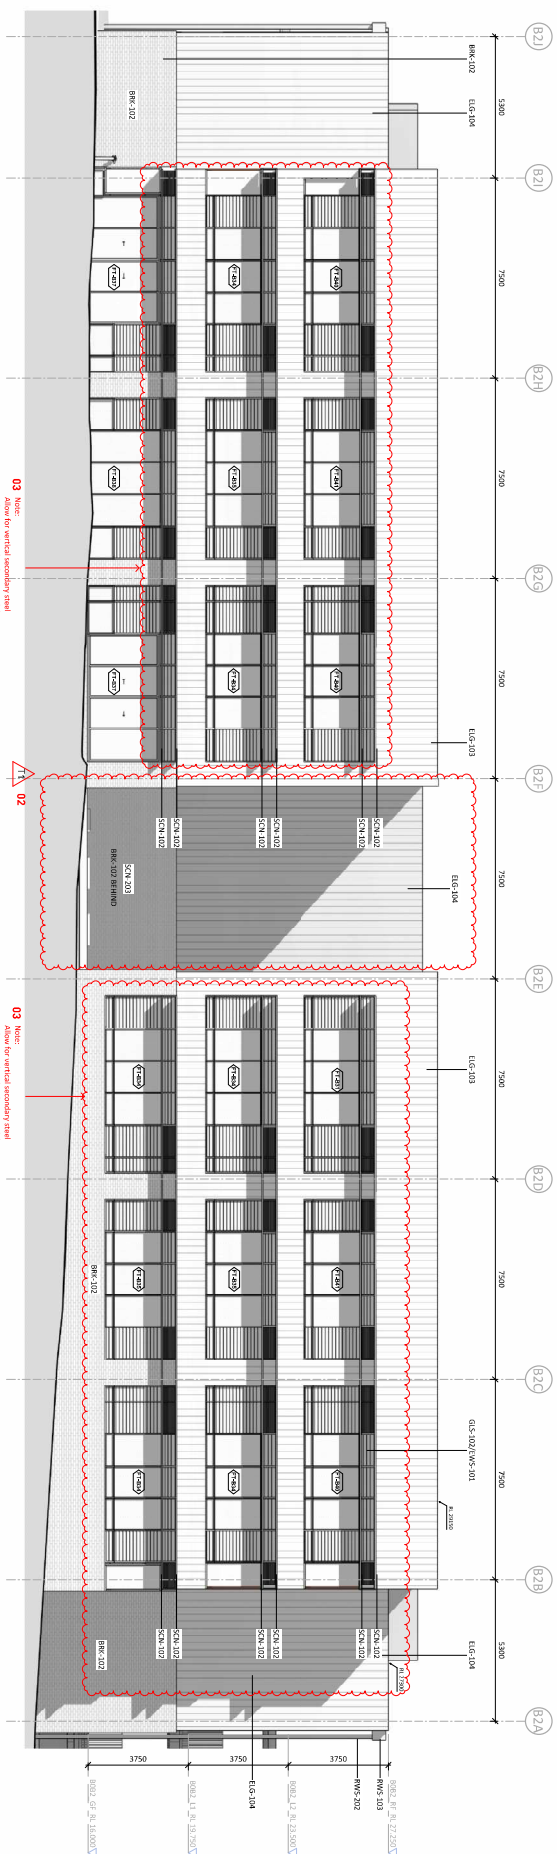

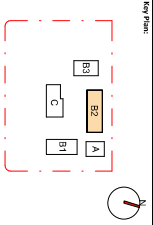

Drawing Disclaimer:
This set of drawings is for information only and does not constitute a contract. The client is responsible for ensuring that the drawings are used in accordance with the contract of PTW Architects.

Notes:
PTW is responsible for any potential building element is strictly limited to that provided by the client. PTW does not accept any liability for any building element or any other work associated with any building element.



| NO. | REVISION | DATE | BY | CHKD | APPD |
|-----|-------------------|------------|-----|------|------|
| 01 | ISSUED FOR PERMIT | 15/01/2025 | PTW | PTW | PTW |
| 02 | ISSUED FOR PERMIT | 15/01/2025 | PTW | PTW | PTW |
Consultant:
PTW Architects
PTW.COM.AU

Client:
Melrose Park Public School

Architect:
PTW Architects
PTW.COM.AU


Project:
Melrose Park Public School

Title:
20 ELEVATIONS
ELEVATIONS - BLOCK B2 - SHEET 2

Scale:
1:100 @A1


Revision:
MPPS-PTW-B089-ZZ-DR-A-200802 12

Sheet:
20 of 20

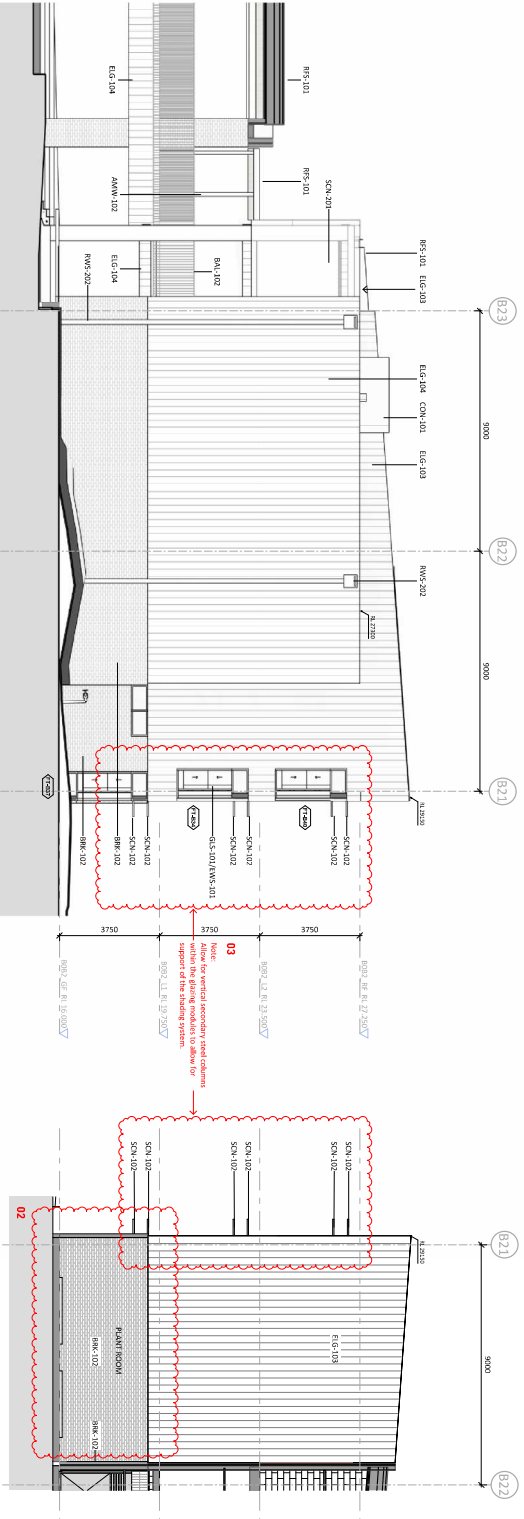


1 ELEVATION - BLOCK B2 - EAST
1:100 @A1

3 ELEVATION - BLOCK B2 COLA - EAST
1:100 @A1

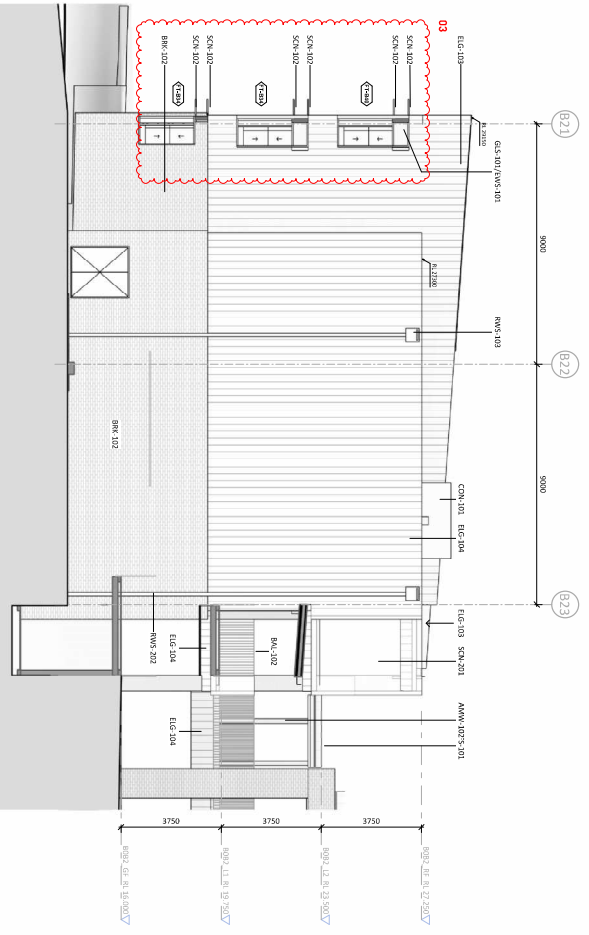


2 ELEVATION - BLOCK B2 - WEST
1:100 @A1

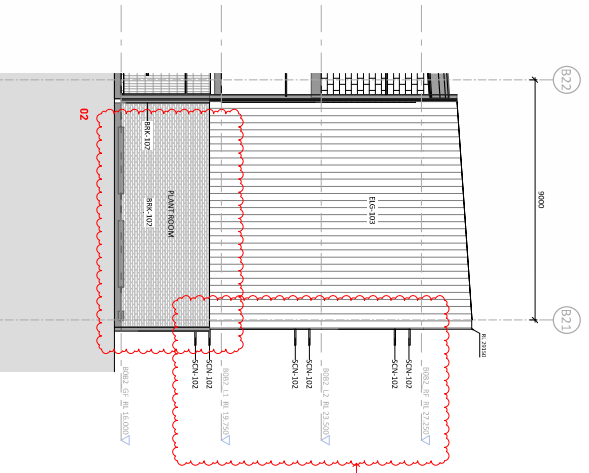

4 ELEVATION - BLOCK B2 COLA - WEST
1:100 @A1

REF ISSUE AFTER V&M
01 SCREEN NEAR BLOCK B2 CORRS CUTBACK
02 AC PLANT FOR BLOCK B2 MOVED TO 100
03 BLOCK B2 - SHADING ON MOTHERN
04 MULTIPLE LANDSCAPING CHANGES

**FOR WRITTEN ENDORSEMENT
TO PROCEED**
SIGN STAMP
AND DATE: NOT RECEIVED BY PTW 17/01/2025

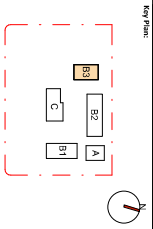

Drawing Disclaimer:

Notes:


| Rev | Description | Date | By | Check |
|-----|-------------------------|------------|-----|-------|
| 1 | Issue for client review | 14/01/2025 | PTW | PTW |
| 2 | Issue for client review | 14/01/2025 | PTW | PTW |
Consultant:
PTW Architects

Client:
Metrose Park Public School



Architect:
PTW Architects
Level 1, 88 Third Street
Sydney NSW 2000
T: +61 2 9232 5877
PTW.COM.AU

Project:
Metrose Park Public School

Title:
ELEVATIONS - BLOCK B3 - SHEET 1

Drawing Number:
MPPS-PTW-B083-ZZ-DR-A-200401 12


Scale:
1:100 @ A1

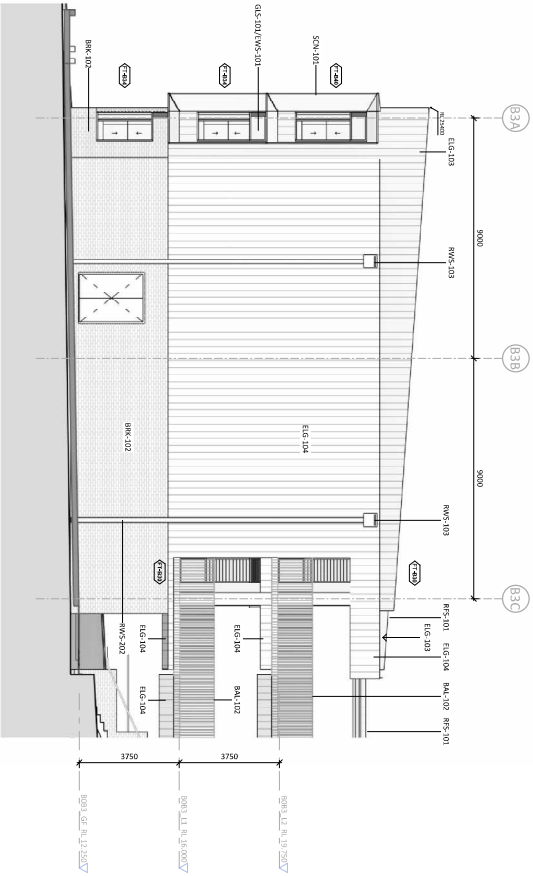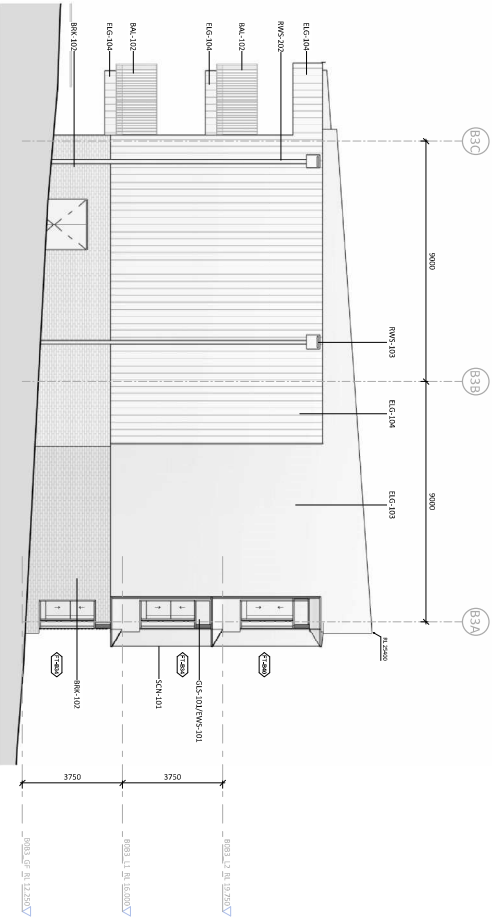

Note:
Allow for vertical secondary steel columns within the glazing modules to allow for support of the shading system.

FOR WRITTEN ENDORSEMENT TO PROCEED

STAMP
AND DATE: NOT RECEIVED BY PTW 17/01/2025

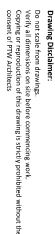

Note: PRW's responsibility for any external building element is strictly limited to that provided for by our relevant scope of Services. Others, including suitably qualified experts as may be required or as is appropriate, carry responsibility for any checking of or other work associated with any design, materials selection, construction or installation of any cladding, facade or external building element.

[illegible]

Consultant

Client
SINSW

PTW
Architects
PTW Architects
Gadigal Country
Level 11, 88 Phillip Street
Sydney NSW 2000 Australia
T +61 2 9232 5877
ptw.com.au

Project PA030586
MELROSE PARK PUBLIC SCHOOL
110 Wharf Road, Melrose Park NSW 2114

Index

ELEVATIONS - BLOCK B3 - SHEET 2


MPPS-PTW-B0B3-ZZ-DR-A-200402 T2

Status


Note:
Allow for vertical secondary steel columns within the glazing modules to allow for support of the shading system.

**FOR WRITTEN ENDORSEMENT
TO PROCEED**

**SIGN, STAMP
AND DATE: NOT RECEIVED BY PTW 17/01/2025**

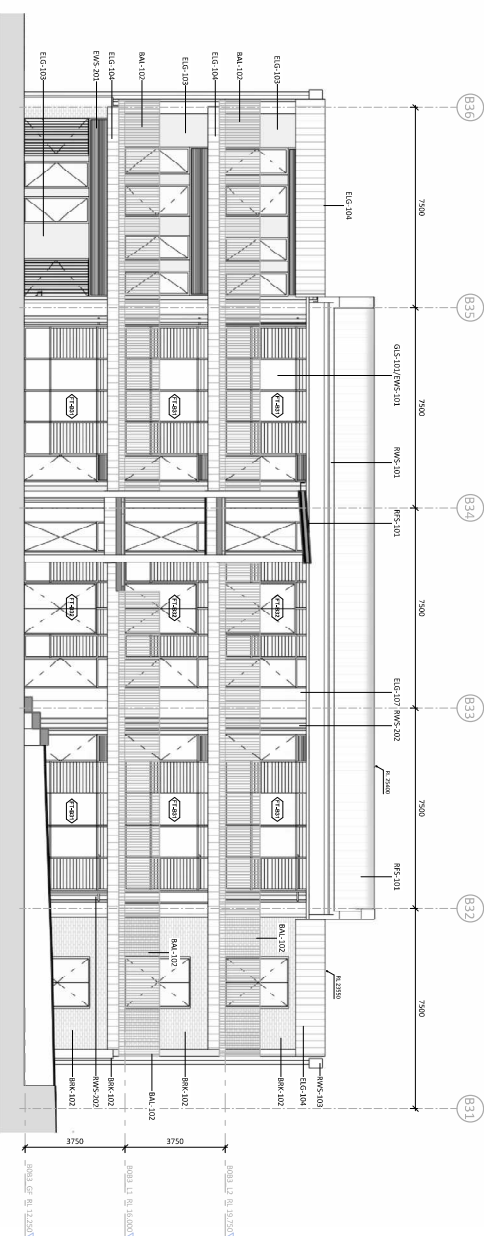


1 ELEVATION - BLOCK B3 - EAST
1 : 100 @A1

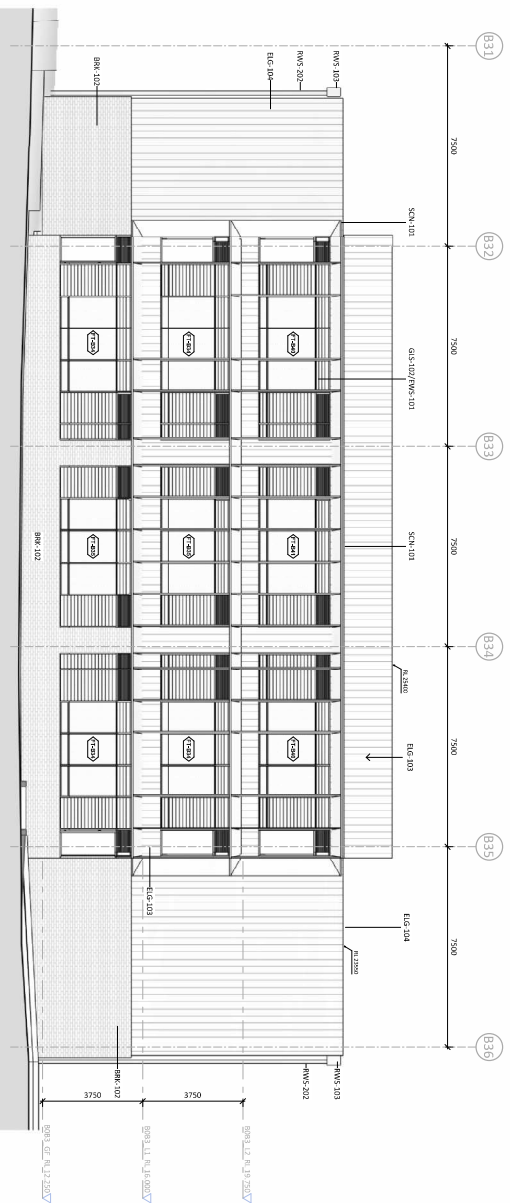

2 ELEVATION - BLOCK B3 - WEST
1 : 100 @A1

REF. ISSUE AFTER VM
01. SCREEN NEAR BLOCK B2 CORES CUTBACK
02. AC PLANT FOR BLOCK B2 MOVED TO 100
03. BLOCK B2 - SHADING ON NORTHERN
FACADE REVISED.
04. MULTIPLE LANDSCAPING CHANGES

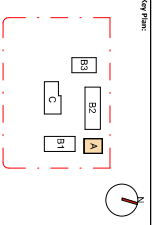

Drawing Discipline:

Verify all dimensions on site before commencing work.
Verify all dimensions on drawings and drawings to site by the professional without the
consent of PTW Architects.

Notes:

PTW's responsibility for any material building element is strictly limited to
that provided by the user (client) of the drawings. PTW, including
its staff, is not responsible for any building element or any other work associated with any
building or site work, including but not limited to, the design, construction, or installation of any building,
structure or external building element.

| NO. | REVISION | DATE | BY | CHKD |
|-----|-------------------|------------|-----|------|
| 01 | ISSUED FOR PERMIT | 14/01/2025 | PTW | PTW |
| 02 | ISSUED FOR PERMIT | 14/01/2025 | PTW | PTW |
Consultant:

Client:
SHEV



Architect:
PTW Architects
Gardiner Country
Level 1.08 Third Street
Sydney NSW 2000 Australia
T +61 2 9232 5877
PTW.COM.AU

Project: 24235556
MELORE PARK PUBLIC SCHOOL

Title:
SECTIONS - BLOCK A - SHEET 1

Drawing Number:
MPPS-PTW-B00A-ZZ-DR-A-300101 12

Scale:
1:100 @ A1

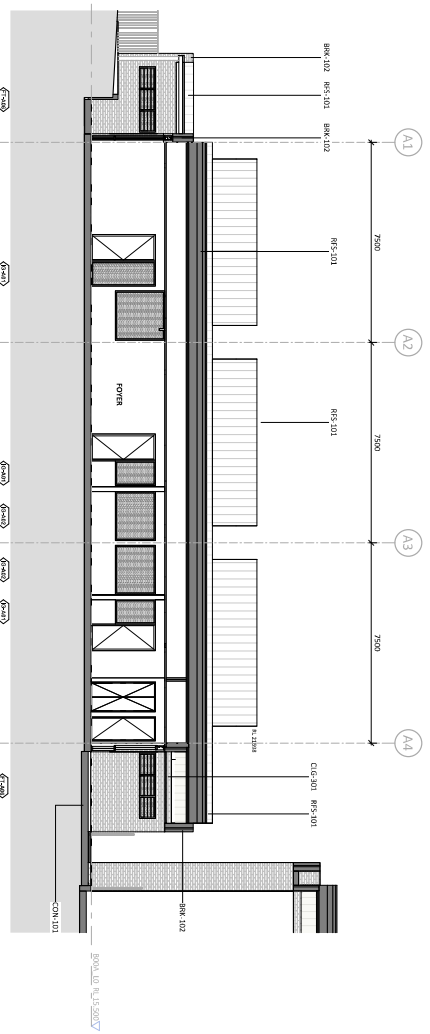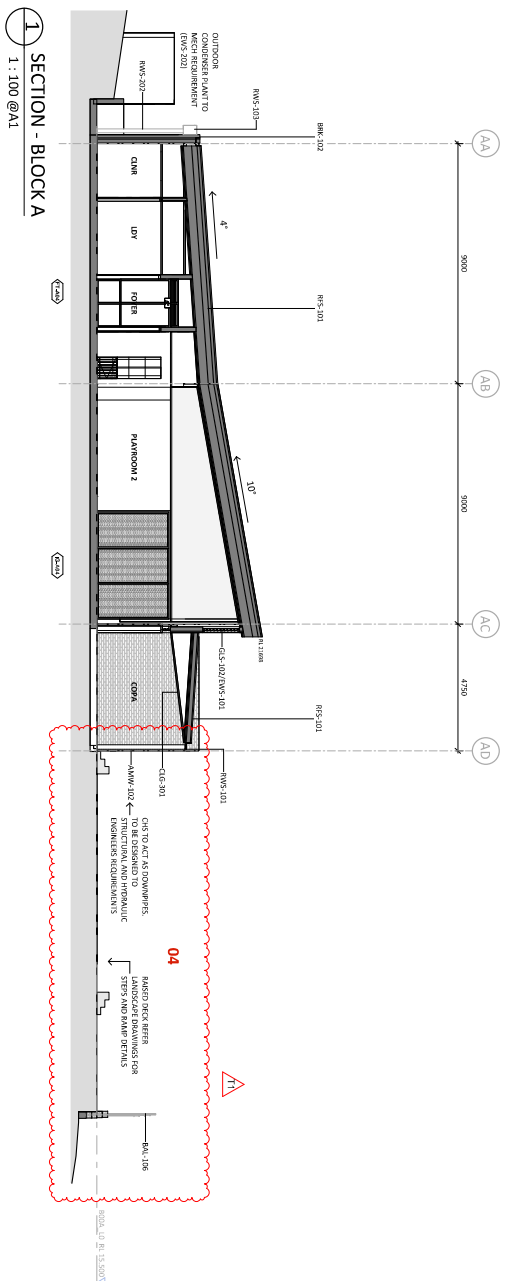

SECTION - BLOCK A
1:100 @A1

FOR WRITTEN ENDORSEMENT
TO PROCEED

STAMP
AND DATE: NOT RECEIVED BY PTW 17/01/2025



Verify all dimensions on site before commencing work.
Copying or reproduction of this drawing is strictly prohibited without the
consent of PTW Architects

Note:

PTW's responsibility for any external building element is strictly limited to that provided for by our relevant scope of Services. Others, including suitably qualified experts as may be required or as is appropriate, carry responsibility for any checking of or other work associated with any design, materials selection, construction or installation of any cladding, facade or external building element.


Consultant

Client
SINSW

Architect:
PTW Architects
Gadigal Country
Level 11, 88 Phillip Street
Sydney NSW 2000 Australia
T +61 2 9232 5877

Project: PA020586
MELROSE PARK PUBLIC SCHOOL
120 Wharf Road, Melrose Park NSW 2114


PTW


30 - SECTIONS
SECTIONS - BLOCK A - SHEET 2


MPPS-PTW-800A-ZZ-DR-A-300102 T2

ISSUED FOR TENDER

**FOR WRITTEN ENDORSEMENT
TO PROCEED**

SIGN, STAMP
AND DATE: NOT RECEIVED BY PTW 17/01/2023

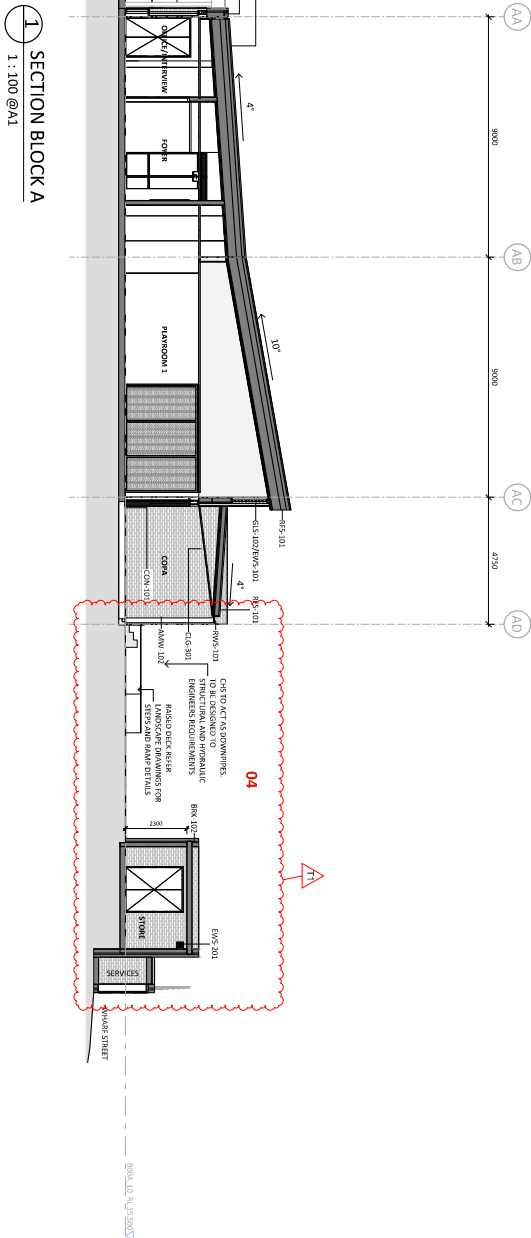

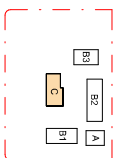

Verify all dimensions on site before commencing work.
Copying or reproduction of this drawing is strictly prohibited without the
consent of PTW Architects

that is responsible for any external building element is strictly limited to that provided for by the relevant scope of Services. Others, including suitably qualified experts as may be required or as is appropriate, carry responsibility for any checking of or other work associated with any design, materials selection, construction or installation of any cladding, facade or external building element.

[illegible]

*CMAA - Registered Architect

WASNIS

PTW
Architect
PTW Architects
Gadigal Country
Level 11, 88 Phillip Street
Sydney NSW 2000 Australia
T +61 2 9232 5877
ptw.com.au

MELROSE PARK PUBLIC SCHOOL
110 Wharf Road, Melrose Park NSW 2114


30 - SECTIONS
SECTIONS - BLOCK C - SHEET 1

MPPS-PTW-B00C-ZZ-DR-A-300501 T2


STATUS
ISSUED FOR TENDER

**FOR WRITTEN ENDORSEMENT
TO PROCEED**


SIGN, STAMP
AND DATE: NOT RECEIVED BY PTW 17/01/2025

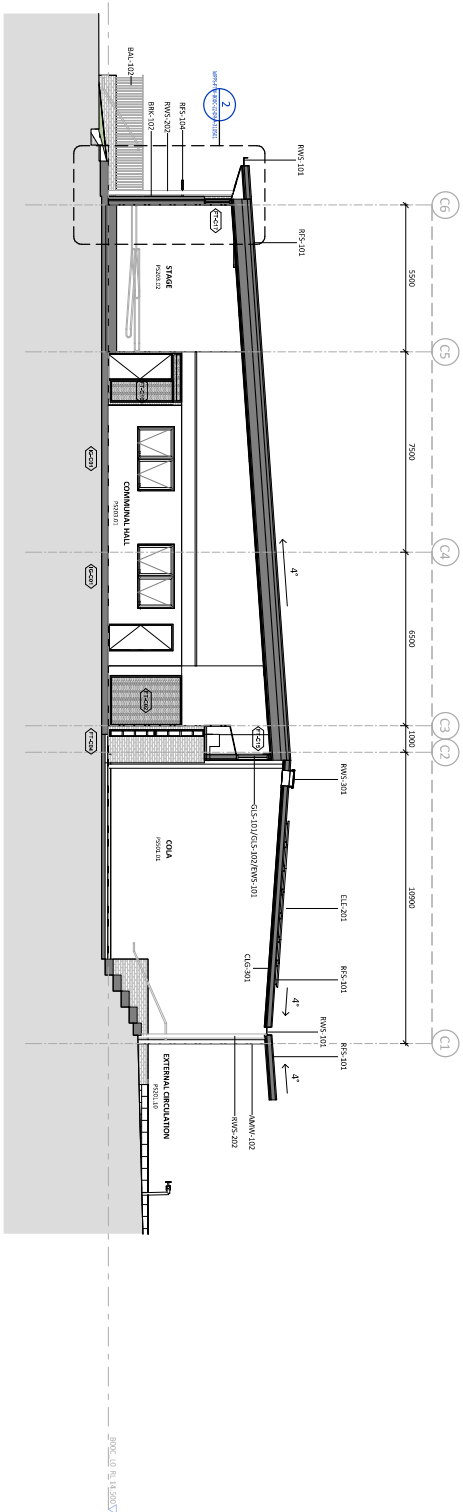


SECTION 1 - BLOCK C
1 : 100 @A1

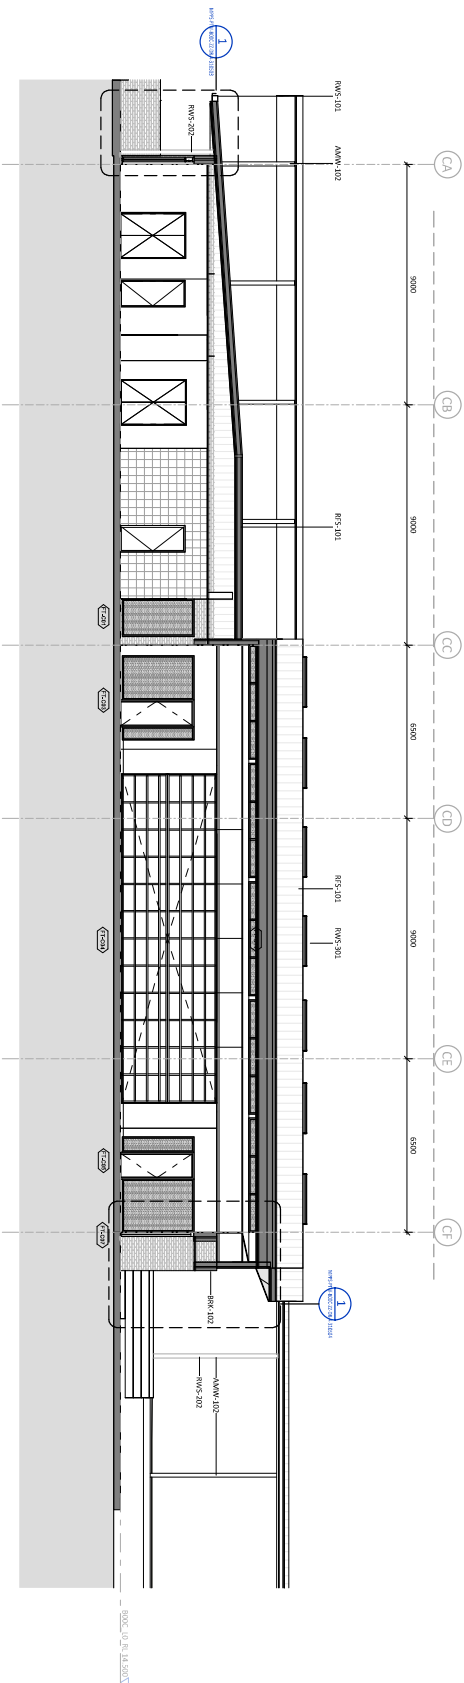

SECTION 2 - BLOCK C
2
1:100 @A1

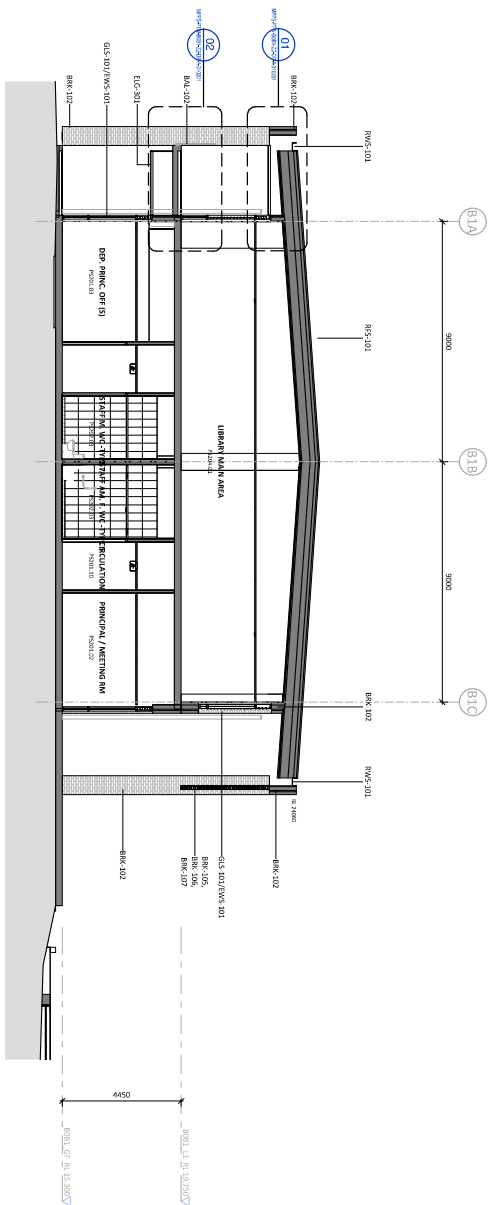

SECTION - BLOCK B1
1 : 100 @A1

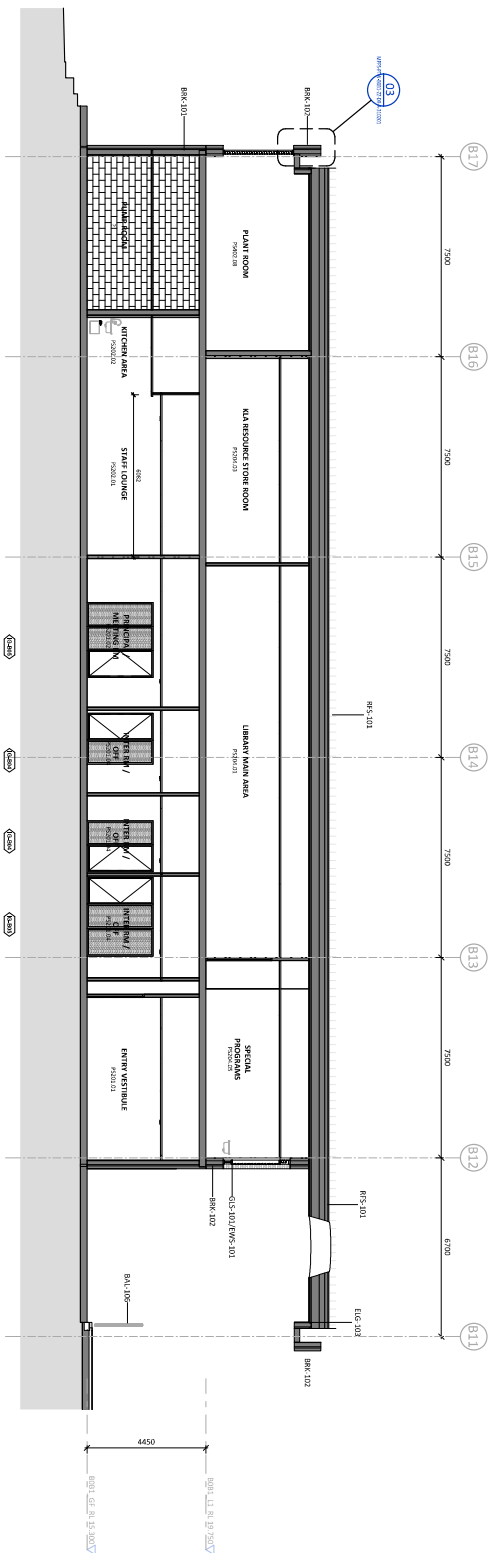

SECTION - BLOCK B1
2
1 : 100 @A1

**FOR WRITTEN ENDORSEMENT
TO PROCEED**

SIGN, STAMP
AND DATE: NOT RECEIVED BY PTW 17/01/2025

[illegible]

Consultant

Client
SINSA

Architect
PTW Architects
Gadigal Country
Level 11, 88 Phillip Street
Sydney NSW 2000 Australia
T +61 2 9232 5877
ptw.com.au




PTW


MELROSE PARK PUBLIC SCHOOL
110 Wharf Road, Melrose Park NSW 2114

30 - SECTIONS
SECTIONS - BLOCK B1 - SHEET 1


30 - SECTIONS
SECTIONS - BLOCK B1 - SHEET 1

MPPS-PTW-B0B1-ZZ-DR-A-300201 T2


Status

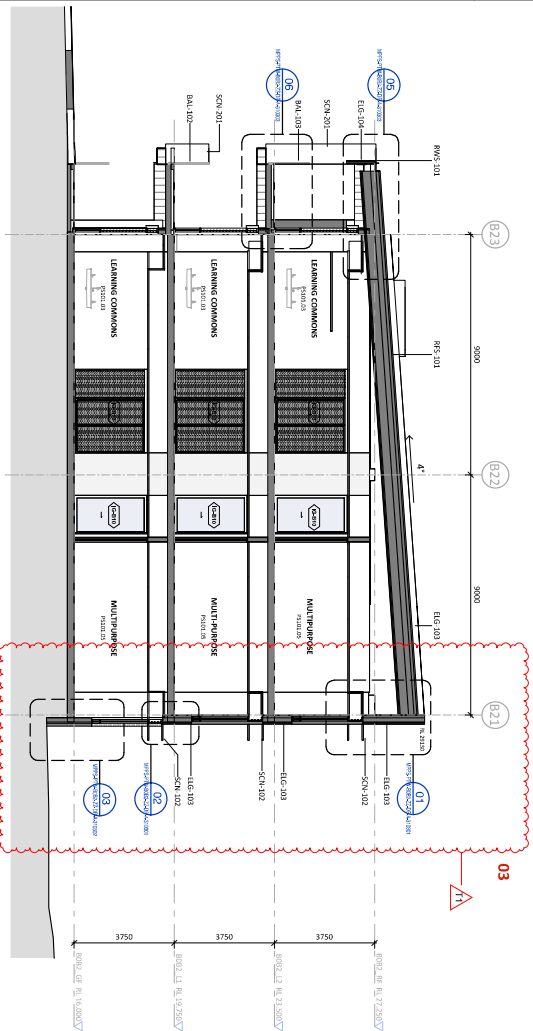

1 SECTION 01 - BLOCK B2
1 : 100 @A1

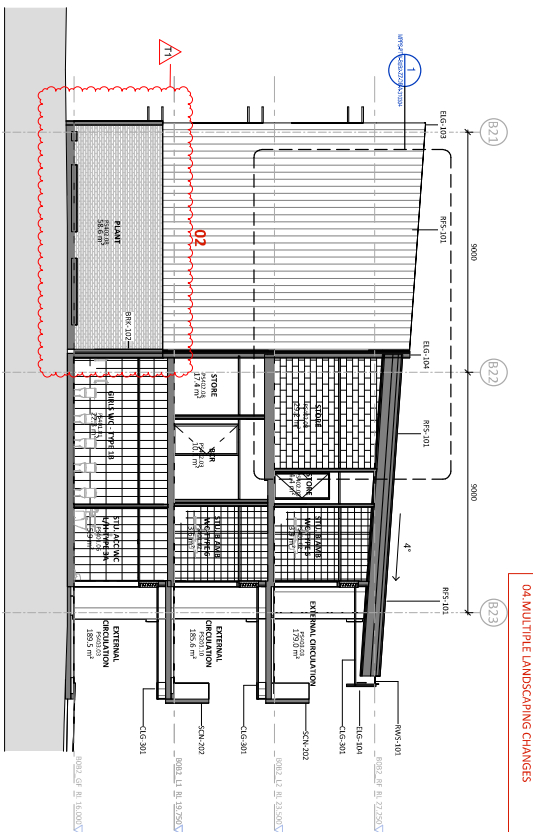


2 SECTION 02 - BLOCK B2
1 : 100 @A1

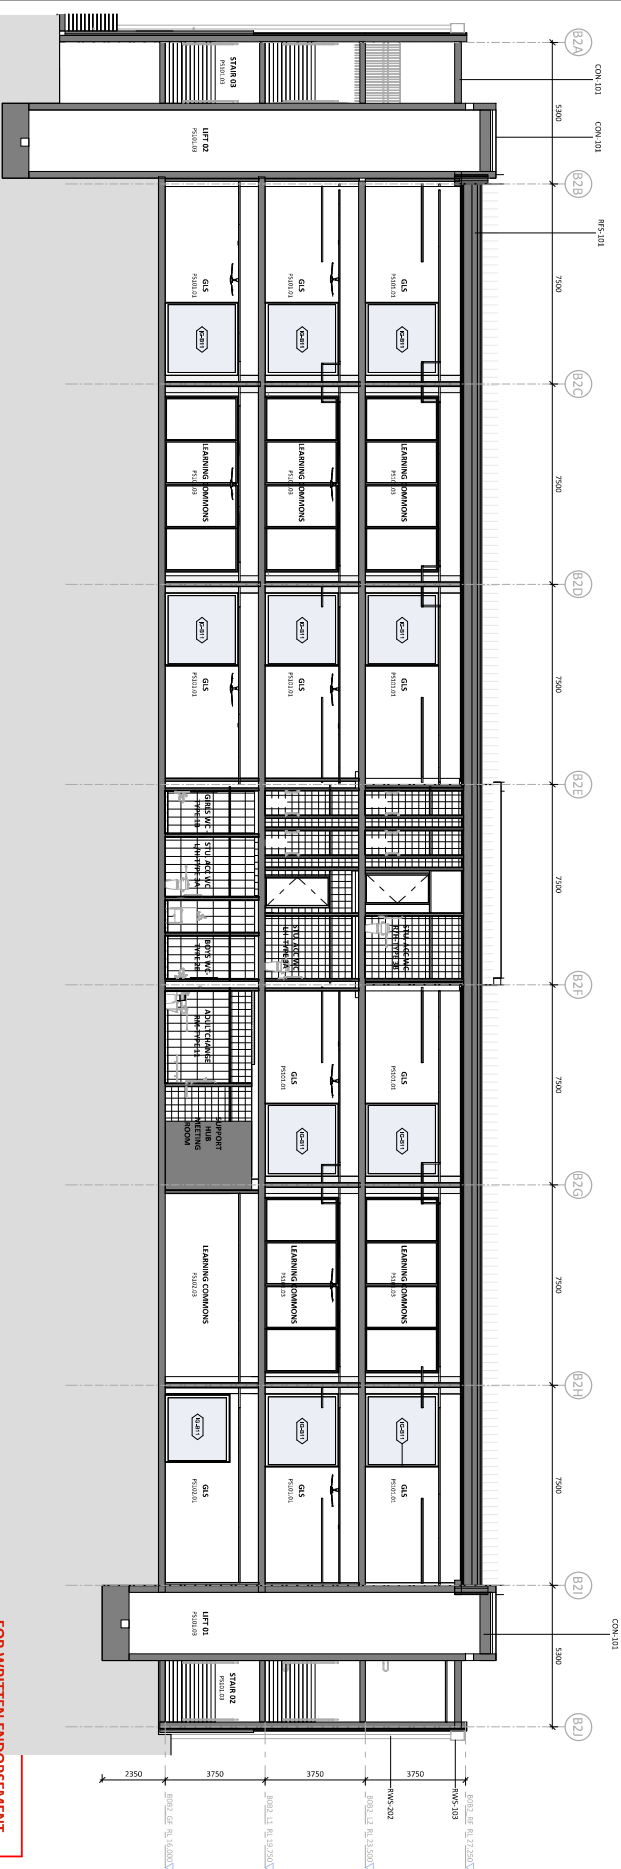

3 SECTION 03 - BLOCK B2
1 : 100 @A1

- REF ISSUE AFTER VM
- 01. SCREEN NEAR BLOCK B2 CORES CUTBACK
 - 02. AC PLANT FOR BLOCK B2 MOVED TO 100
 - 03. BLOCK B2 - SHADING ON NORTHERN FACADE REVISED
 - 04. MULTIPLE LANDSCAPING CHANGES

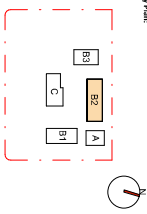

Drawing Discipline:

View of dimensions on and before commencing work.

Notes:


| NO. | REVISION | DATE | BY | CHK | APP |
|-----|-------------------|------------|-----|-----|-----|
| 01 | ISSUED FOR PERMIT | 10/01/2025 | PTW | NC | NC |
| 02 | ISSUED FOR PERMIT | 10/01/2025 | PTW | NC | NC |
Consultant:

Client:
MPPS
MPPS-PTW-8082-ZZ-DR-A-300301


Architect:



30 SECTIONS
SECTIONS - BLOCK B2 - SHEET 1

Drawing Number:
MPPS-PTW-8082-ZZ-DR-A-300301 12


Scale:
1:100 A1

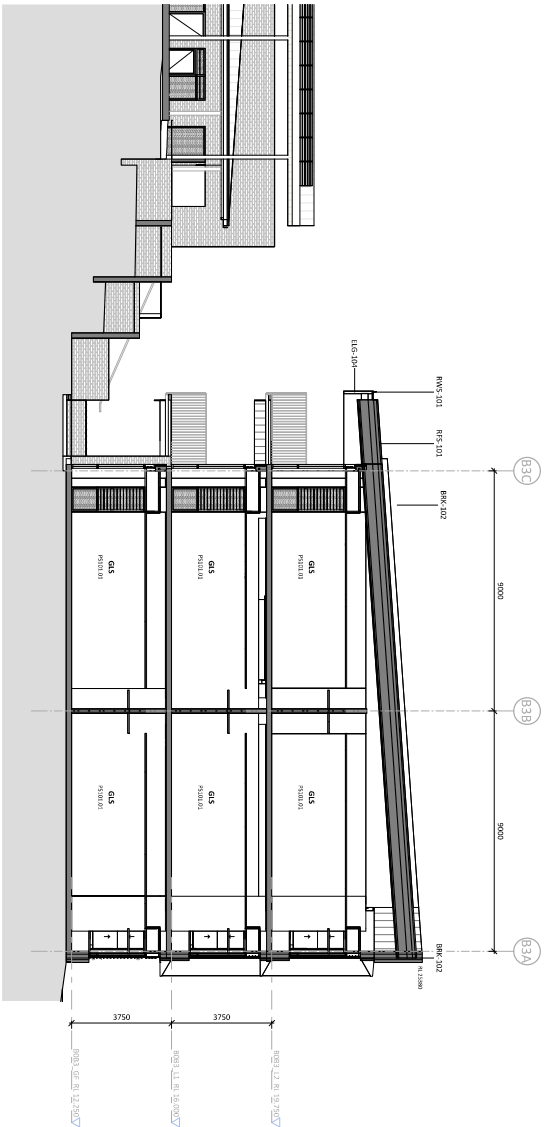

1 SECTION - BLOCK B3
1 : 100 @A1

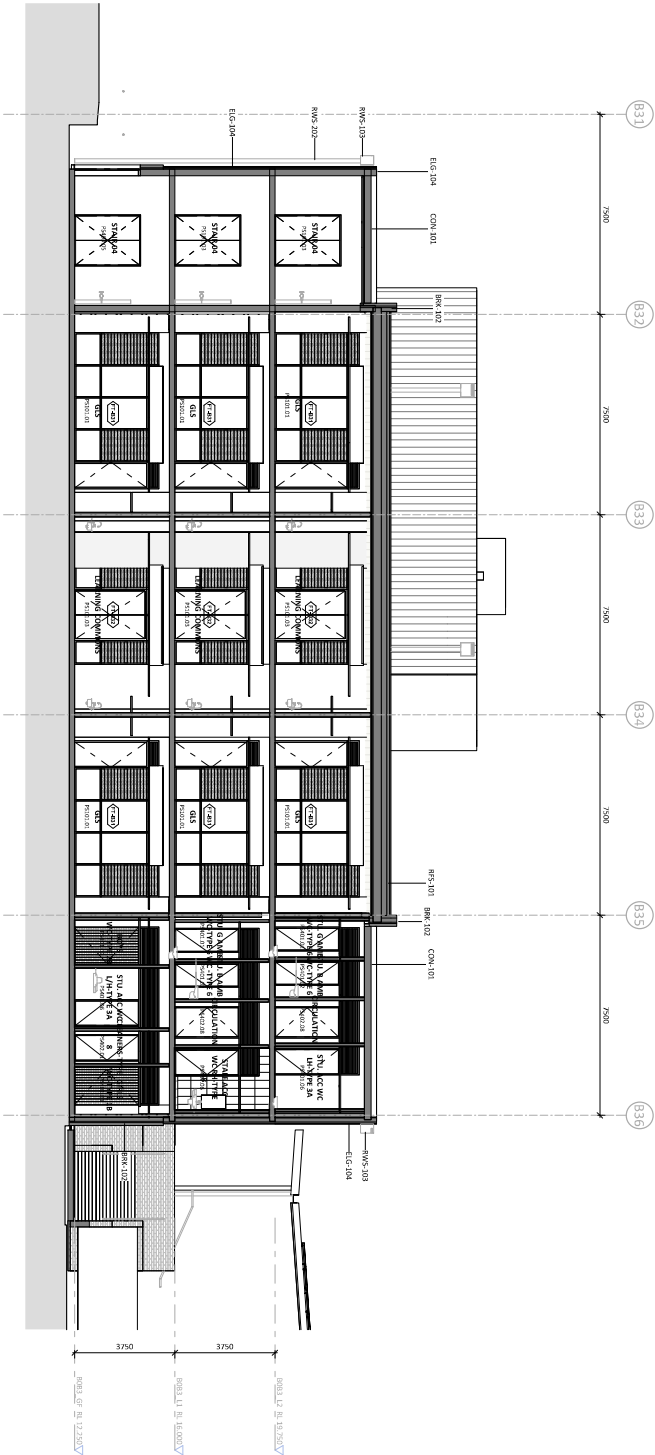

2 SECTION - BLOCK B3
1 : 100 @A1

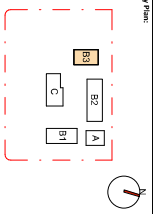

Drawing Disclaimer:


| Revisions | | Revised By | | Revised Date | |
|-----------|------------------------|------------|------------|--------------|--|
| 1 | Issue for construction | PTW | 2024/03/25 | | |
| 2 | Issue for construction | PTW | 2024/03/25 | | |
Client: SMOY


Architect: PTW Architects
Level 1, 88 Prince Street
Sydney NSW 2000
T: 61 2 9232 5877
PTW.COM.AU

Project: 2423/2024
Melrose Park Public School
110 Wharf Road, Melrose Park NSW 2114


Title: SECTIONS - BLOCK B3 - SHEET 1
Drawing Number: MPPS-PTW-8083-ZZ-DR-A-300401
Revision: 12

FOR WRITTEN ENDORSEMENT
TO PROCEED
SIGN, STAMP
AND DATE: NOT RECEIVED BY PTW 17/01/2025


Scale: 1:100
Date: 24/03/2025 7:49:00 PM

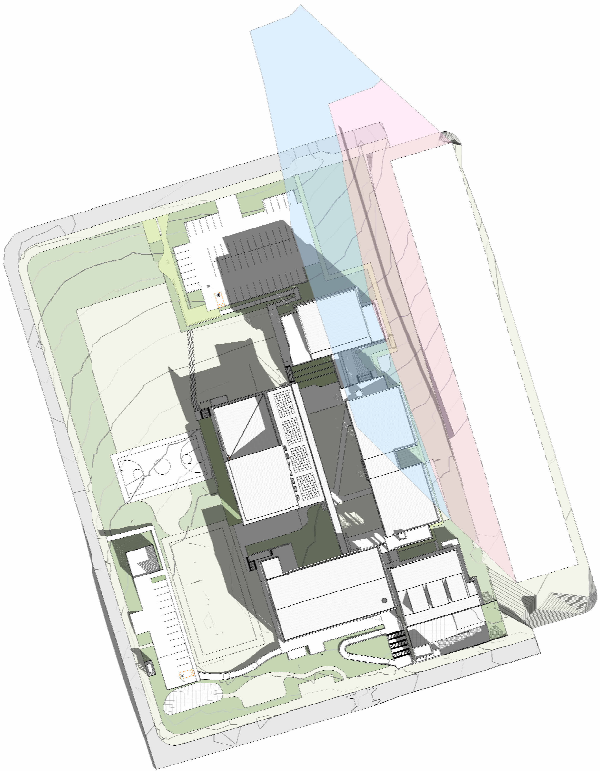

1 SITE PLAN - SHADOW DIAGRAMS - 21 JUN 9 AM

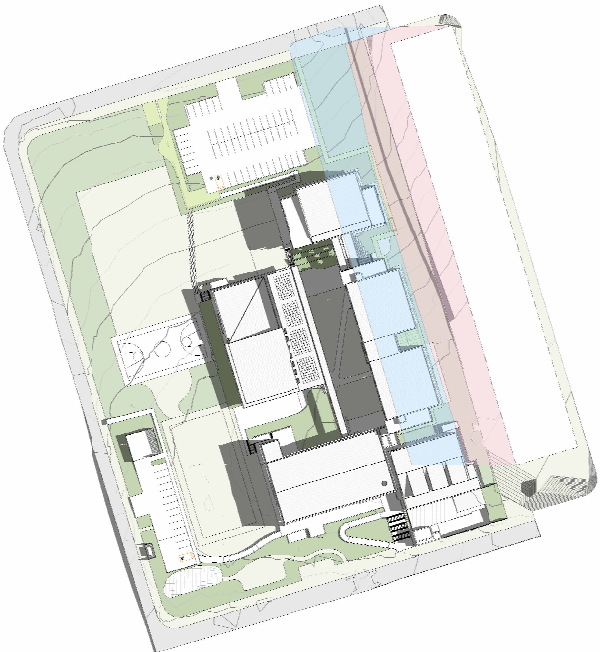

2 SITE PLAN - SHADOW DIAGRAMS - 21 JUN 12 PM

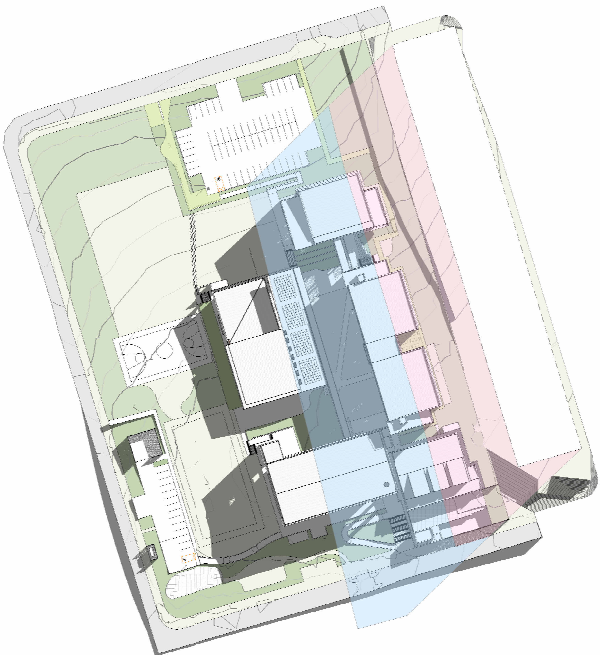


3 SITE PLAN - SHADOW DIAGRAMS - 21 JUN 3 PM

LEGEND

HEIGHT BLANKET ON
ADJOINING PROPERTY

SHADOW CREATED BY
12M HEIGHT BLANKET

SHADOW CREATED BY
26M HEIGHT BLANKET

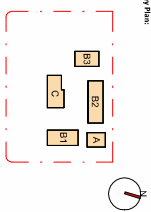

Disclaimer


| NO. | REVISION | DATE | BY | CHKD. | APPD. |
|-----|-------------------|----------|----|-------|-------|
| 1 | ISSUED FOR TENDER | 17/03/24 | | | |
| 2 | FOR INFORMATION | 17/03/24 | | | |
| 3 | FOR INFORMATION | 17/03/24 | | | |
Client
SINSA

Consultant

Architect
PTW Architects
Level 1, 88-90, Sydney Street
Sydney NSW 2000 Australia
T 612 9232 5877
ptw.com.au

Project 24030502
Melrose Park Public School
110 Wharf Road, Melrose Park NSW 2174

PTW

Title
95 - SHADOW DIAGRAMS
SHADOW DIAGRAMS - JUN - SHEET 1

Drawing Number
MPPS-PTW-ZZ-XX-DR-A-930001

Revision
T0

Scale
1:1,000 (A4)

Sheet
10 of 10


Author
SINSA FOR TENDER



1 SITE PLAN - SHADOW DIAGRAMS - 21 DEC 9AM



2 SITE PLAN - SHADOW DIAGRAMS - 21 DEC 12PM

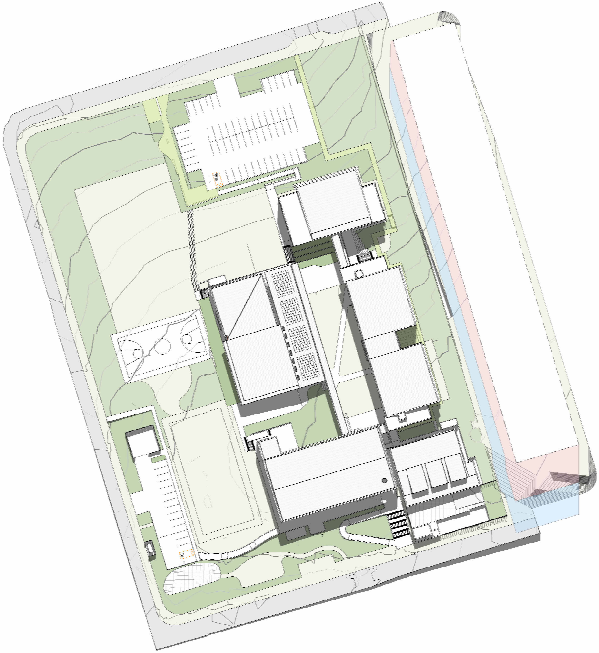


3 SITE PLAN - SHADOW DIAGRAMS - 21 DEC 3PM

LEGEND

- HEIGHT BLANKET ON ADJOINING PROPERTY
- SHADOW CREATED BY 12M HEIGHT BLANKET
- SHADOW CREATED BY 26M HEIGHT BLANKET

FOR WRITTEN ENDORSEMENT
TO PROCEED

SEAL STAMP
AND DATE: NOT RECEIVED BY PTW 17/01/2025

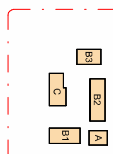

Drawing Disclaimer:



| NO. | DESCRIPTION | DATE | BY | CHKD. | APP'D. |
|-----|-------------------|----------|-----|-------|--------|
| 1 | ISSUED FOR TENDER | 21/12/24 | PTW | PTW | PTW |
| 2 | REVISION | 21/12/24 | PTW | PTW | PTW |
| 3 | REVISION | 21/12/24 | PTW | PTW | PTW |
Consultant

Client
SISNV

Architect
PTW Architects
Level 1, 88-90 Street
Sydney NSW 2000 Australia
T +61 2 9232 5877
ptw.com.au

Project 24030502
MELORE PARK PUBLIC SCHOOL

Title
95 - SHADOW DIAGRAMS
SHADOW DIAGRAMS - DEC - SHEET 2

Drawing Number
MPPS-PTW-ZZ-XK-DR-A-930002
Revision
TO

Scale
1:1000 (A1)
1:500 (A2)
1:250 (A3)
1:125 (A4)