

SURVEY INFORMATION

- DATE OF SURVEY: 28/11/2022 – 02/02/2023
- THE SURVEY IS ON GROUND CO-ORDINATES.
 - THE ORIGIN OF CO-ORDINATES IS SSM 45994 MGA CO-ORDINATES E 368921.526 N 6374350.406 (GDA 2020) (ZONE 56)
 - SOURCE OF CO-ORDINATES: SCIMS
 - DATE 09/12/2022
- ALL REDUCED LEVELS ARE ON AUSTRALIAN HEIGHT DATUM (A.H.D)
 - ORIGIN OF LEVELS SSM 45994. RL20.624
 - SOURCE OF REDUCED LEVELS: SCIMS
 - DATE OF REDUCED LEVELS 09/12/2022
- CONTOUR INTERVAL IS 0.2m.
- MGA AND ISG CO-ORDINATE SYSTEMS ARE BASED ON A MATHEMATICAL EARTH MODEL AND SUBJECT TO VARIABLE SCALE FACTORS. DISTANCES CALCULATED FROM CO-ORDINATES MAY VARY SIGNIFICANTLY FROM GROUND MEASUREMENTS. IF FURTHER CLARIFICATION IS REQUIRED CONTACT MONTEATH AND POWYS.

IMPORTANT NOTES

- THIS SURVEY IS A PARTIAL SURVEY OF MAITLAND HOSPITAL AND SURROUNDS. SEE NOTES ON PLAN – SOME AREAS ARE SHOWN AS LIMITED ACCURACY DUE TO RESTRICTED ACCESS AND THICK VEGETATION. STRUCTURES AND SERVICES MAY EXIST IN THESE AREAS THAT WERE NOT LOCATED.
- THE BOUNDARIES SHOWN IN RED ON THIS PLAN ARE BASED ON OUR FIELD SURVEY. TO FORMALISE THESE DIMENSIONS, WE WOULD RECOMMEND THE PREPARATION OF A REDEFINITION PLAN, SUITABLE FOR LODGEMENT AND REGISTRATION WITH NSW LAND REGISTRY SERVICES.
- THE BOUNDARIES SHOWN IN BLUE ON THIS PLAN ARE BASED ON INFORMATION DERIVED FROM NSW SPATIAL SERVICES– DIGITAL CADASTRAL DATABASE (DCDB). NO FIELD SURVEY HAS BEEN UNDERTAKEN TO DETERMINE THE ACCURACY OF THE BOUNDARIES AS SHOWN.
- THIS PLAN SHOULD NOT BE USED FOR BUILDING WORKS CLOSE TO OR ON THE BOUNDARY, OR TO PROSCRIBED SET-BACKS WITHOUT FURTHER SURVEY INVESTIGATION.
- CRITICAL LEVELS (E.G. FLOOR LEVELS) AND CRITICAL LOCATIONS (E.G. STRUCTURES) THAT HAVE NOT BEEN SHOWN MUST BE VERIFIED BY FURTHER SURVEY PRIOR TO FINAL DESIGN.
- NO EXCAVATIONS HAVE BEEN MADE TO DETERMINE THE EXTENT TO WHICH ANY SUBJECT WALLS, FOUNDATIONS OR FOOTINGS MAY ENCROACH UPON ADJOINING LAND.
- NO EXCAVATIONS HAVE BEEN MADE TO DETERMINE THE EXTENT TO WHICH ANY ADJOINING WALLS, FOUNDATIONS OR FOOTINGS MAY ENCROACH UPON SUBJECT LAND.
- CONTOURS SHOWN DEPICT THE TOPOGRAPHY. CONTOURS DO NOT REPRESENT THE EXACT LEVEL AT ANY PARTICULAR POINT, EXCEPT AT SPOT LEVELS SHOWN.
- THIS PLAN MUST REMAIN UNALTERED AS ISSUED BY MONTEATH & POWYS. ALTERING ANY PART OF THIS PLAN DESTROYS THE INTEGRITY OF THE PLAN. ANY REVISIONS REQUESTED MUST BE ISSUED BY MONTEATH & POWYS.
- THESE NOTES ARE AN INTEGRAL PART OF THIS PLAN. REPRODUCTION OF THIS PLAN OR OF ANY PART OF THIS PLAN, WITHOUT THESE NOTES BEING INCLUDED IN FULL, WILL RENDER THE INFORMATION SHOWN ON SUCH REPRODUCTION INVALID AND NOT SUITABLE FOR USE.

LEGEND

225ø PVC	PIPE DIAMETER & PVC PIPE TYPE
300ø EW	PIPE DIAMETER & EARTHENWARE PIPE TYPE
300ø CONC	PIPE DIAMETER & CONCRETE PIPE TYPE
X.XX	DEPTH FROM SURFACE LEVEL SERVICE
X.XX	LEVEL ON OVERHEAD POWERLINES
UTL	UNABLE TO LIFT
CL	CONTINUATION UNKNOWN

LINE TYPES

	DRAIN PIPE
	DISH DRAIN
	OVERHEAD ELECTRICITY CABLE
	FENCING
	RETAINING WALL
	EDGE OF CONCRETE
	TOP OF BANK
	TOE OF BANK
	CENTRELINE OF BITUMEN
	EDGE OF BITUMEN
	EDGE OF GRAVEL
	SUBJECT CADASTRAL BOUNDARY
	DCDB CADASTRAL BOUNDARY (NOT ACCURATE)
	EXTENT OF LIMITED ACCURACY SURVEY

	ARROW STRAIGHT AND LEFT
	ARROW STRAIGHT AND RIGHT
	ARROW LEFT TURN
	ARROW RIGHT TURN
	ARROW STRAIGHT AHEAD
	ROAD SEPARATION LINE
	PEDESTRIAN CROSSING ZIG ZAG
	PEDESTRIAN CROSSING SIGNALS
	LANE DIVIDER
	GIVEAWAY TURN MARKING
	DRAGON TEETH MARKINGS
	CENTRE LINE MARKING
	DOUBLE BARRIER MARKING
	CONTINUITY LINE
	CLEAR WAY
	CHEVRON MARKING
	BARRIER AND SEPARATION MARKING
	PEDESTRIAN CROSSING MARKING

SYMBOLLOGY

	INV-/OBVERT LEVEL
	STORM WATER MAN HOLE
	DRAINAGE PIT
	ELECTRICAL PIT
	ELECTRICAL POWER POLE W/LIGHT
	LIGHT POLE
	ELECTRICAL CABLE MARKER
	ELECTRICAL PILLAR
	STAY POLE
	WATER METER
	WATER HYDRANT
	STOP VALVE
	WATER TAP
	WATER PIT
	TELSTRA PIT
	COMMUNICATION CABLE MARKER
	COMMUNICATION PIT
	COMMUNICATION PILLAR
	SECURITY CAMERA
	SEWER MAN HOLE
	SEWER PIT
	SEWER INSPECTION POINT
	SEWER VENT
	GAS METER
	GAS PIPE MARKER
	GAS PIT
	DOWN PIPE
	COLUMN
	MAIL BOX
	FLOOR LEVEL
	ROAD SIGN
	TRAFFIC LIGHT
	TRAFFIC LIGHT CONTROL BOX
	BOLLARD
	CLOTHES LINE
	DISABLED LINE MARKING
	BIKE LANE MARKING

IMPORTANT SERVICE NOTES

- THE EXTENT OF THE SERVICES LOCATING SCOPE IS LIMITED AND DOES NOT COVER THE FULL SITE. SERVICES INTERNAL TO THE BUILDING HAVE NOT BEEN LOCATED IN THIS SURVEY.
- THE POSITION OF SERVICES LOCATED BY ACCREDITED SERVICES CONTRACTOR USING CONDUCTIVE TRACING TECHNIQUES ARE RECORDED ON THIS PLAN. IN THE CAD MODEL INFORMATION BY THE SERVICE LOCATOR IS FOUND ON LAYER NAMES WITH THE PREFIX "SERVICES". MONTEATH & POWYS ARE UNABLE TO VERIFY THE ACCURACY OF THESE LOCATIONS AND ADVISE THE REQUIREMENT FOR POSITIVE IDENTIFICATION PRIOR TO EXCAVATION OR CONSTRUCTION IN THEIR VICINITY.
- THIS PLAN SHOWS A REPRESENTATION OF THE DWG MODEL. THIS MODEL SHOULD BE VIEWED IN A CAD ENVIRONMENT TO INTERPRET THE INFORMATION.
- THIS PLAN HAS BEEN DRAWN TO SCALE, AND ANY REPRODUCTION OF THIS PLAN MUST BE DRAWN IN COLOUR AND AT THIS SCALE TO ENSURE THAT ALL RELEVANT NOTES AND ENHANCEMENTS ARE SHOWN.
- THE SERVICES SHOWN IN THIS PLAN HAVE POINT CROSSES WITH ATTRIBUTES. THE ATTRIBUTES CONTAIN INFORMATION RELATED TO THE SERVICE BEING LOCATED. IF USING AUTOCAD, THESE ATTRIBUTES CAN BE TURNED ON OR OFF USING THE ATTIDSP COMMAND. ALSO CLICKING ON THE POINT CROSS AND VIEWING THE PROPERTIES OF THAT POINT CROSS WILL LIST THE ATTRIBUTES.
- SUBTERRANEAN UTILITIES SHOWN ON THIS PLAN ARE CURRENT AT THE TIME OF SURVEY ONLY.
- NOT ALL SERVICE INFORMATION MAY BE SHOWN DUE TO UNAVAILABILITY OF SERVICE PLANS OR CURRENT INFORMATION.
- UNLESS OTHERWISE NOTED, DEPTHS INDICATED FOR SERVICES LOCATED BY GPR METHODS ARE TO TOP OF SERVICE. FOR SERVICES LOCATED BY ELECTROMAGNETIC METHOD DEPTHS ARE TO CENTRE OF SERVICES. EXCEPTIONS TO THIS ARE SEWER AND STORMWATER WHICH DEPTHS ARE TO INVERT OF SERVICE. ANY DEPTHS OF SERVICES FROM INDUCTIVE TRACING WHICH ARE INDICATED ON THIS PLAN ARE INDICATIVE ONLY AND SHOULD BE VERIFIED BY POT HOLING IF CRITICAL TO DESIGN. SEE "SERVICES INFORMATION" NOTES ABOUT CLASS LABELLING.
- ADDITIONAL SUBTERRANEAN UTILITIES MAY EXIST WHICH WERE UNABLE TO BE IDENTIFIED AND/OR TRACED AT THE TIME OF SURVEY. REDUNDANT UTILITIES MAY BE PRESENT ON SITE WHICH ARE UNABLE TO BE TRACED. POSITIVE IDENTIFICATION IS REQUIRED PRIOR TO ANY EXCAVATION OR DESIGN.
- PVC AND POLYPIPPES MAY EXIST. IF TRACE WIRES ARE NOT PRESENT THESE UTILITIES ARE UNABLE TO BE TRACED.
- WATER MAIN AND FIRE WATER SERVICES UTILITIES WERE UNABLE TO BE TRACED THE FULL EXTENT. EXTERNAL WAE DATA HAS BEEN USED TO INDICATE THE PRESENCE OF THESE UTILITIES. MONTEATH & POWYS ARE UNABLE TO VERIFY THE ACCURACY OF THESE LOCATIONS. THESE UTILITIES ARE SHOWN AS CLASS D QUALITY – SEE "SERVICES INFORMATION" NOTES ABOUT CLASS LABELLING.
- THIS PLAN SHOULD NOT BE USED FOR EXCAVATION PURPOSES.
- INDEPENDENT ENQUIRIES FOR UP-TO-DATE SERVICE LOCATIONS THROUGH THE RELEVANT AUTHORITIES MUST BE UNDERTAKEN PRIOR TO COMMENCEMENT OF ANY WORKS/EXCAVATION. EXACT SERVICE POSITIONS SHOULD BE ESTABLISHED BY APPROPRIATE MEANS. WE RECOMMEND PROFESSIONAL SERVICE LOCATORS.

SERVICES INFORMATION


SUBSURFACE UTILITY INFORMATION (SUI) AS5488. CLASS LABELLING OF UTILITY INFORMATION IS BASED ON A CLASSIFICATION CODE WHICH ALLOWS THE USER OF THIS INFORMATION TO UNDERSTAND CLEARLY HOW THE INFORMATION WAS COLLECTED AND THEN PLACE AN APPROPRIATE AMOUNT OF RELIANCE ON IT. PROJECT RISKS RELATED TO UNDERGROUND UTILITIES CAN THEN BE PROPERLY MANAGED.

QL-A: INFORMATION IS THE HIGHEST POSSIBLE LEVEL OF ACCURACY AND IS OBTAINED BY EXPOSING THE UNDERGROUND UTILITY USING A NON-DESTRUCTIVE EXCAVATION (POT HOLING) TECHNIQUE. THE VERTICAL INFORMATION FOR THIS LOCATING METHOD IS TO THE TOP OR SHALLOWEST PART OF THE LOCATED SERVICE. THE 3D LOCATION IS RECORDED BY SURVEY AS AN X, Y, Z COORDINATE.


QL-B: INFORMATION IS COLLECTED BY DESIGNATING THE HORIZONTAL AND VERTICAL LOCATION OF UNDERGROUND UTILITIES BY USING ELECTROMAGNETIC PIPE AND CABLE LOCATORS, SONDES OR FLEXI-TRACE, GROUND PENETRATING RADAR AND ACOUSTIC PULSE EQUIPMENT. THIS IS THE MOST COMMON FORM OF UTILITY LOCATING AND ALTHOUGH AN X, Y AND Z AXIS CAN BE ESTABLISHED IT IS NOT ALWAYS ENTIRELY ACCURATE DUE TO DIFFERING ELECTROMAGNETIC FIELDS, SOIL CONDITIONS AND MULTIPLE BANKS OF CABLES AFFECTING THE LOCATING SIGNAL.

QL-C: INFORMATION IS COLLECTED BY CORRELATING THE SURVEY OF VISIBLE UTILITY SURFACE FEATURES SUCH AS MARKER PLATES OR WATER HYDRANTS AND ACQUIRED BEFORE-YOU-DIG-AUSTRALIA PLANS TO "DRAW" A STRING WHICH SHOWS THE APPROXIMATE POSITION OF SERVICES. THIS METHOD DOES NOT USUALLY SHOW MULTIPLE BANKS OF CABLES AND DOES NOT ALWAYS SHOW THREE DIMENSIONAL INFORMATION. ELECTRONICALLY TRACED LOCATE MARKS WITH POOR SCRATCHY SIGNALS ARE REPRESENTED AS QL-C.


QL-D: INFORMATION IS THE MOST BASIC LEVEL OF UTILITY LOCATIONS USING ONLY INFORMATION BASED ON EXISTING BEFORE-YOU-DIG-AUSTRALIA PLANS AND BY MEASURING BOUNDARY OFFSETS ETC. THIS METHOD OF UTILITY LOCATIONS SHOULD ALWAYS BE TREATED AS AN INDICATION OF THE PRESENCE OF A SERVICE ONLY AND SHOULD NOT BE USED FOR DESIGN. GPR SCANS ARE ALSO REPRESENTED AS QL-D AS THE GPR IMAGE CANNOT BE CONFIRMED TO IT'S ORIGIN POINT. DEPTHS ON GPR SCAN MUST BE TREATED AS INDICATIVE ONLY.

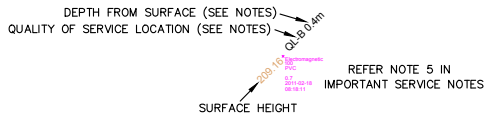TYPICAL SERVICE LOCATED POINT

REVISIONS	
-----------	--	--	

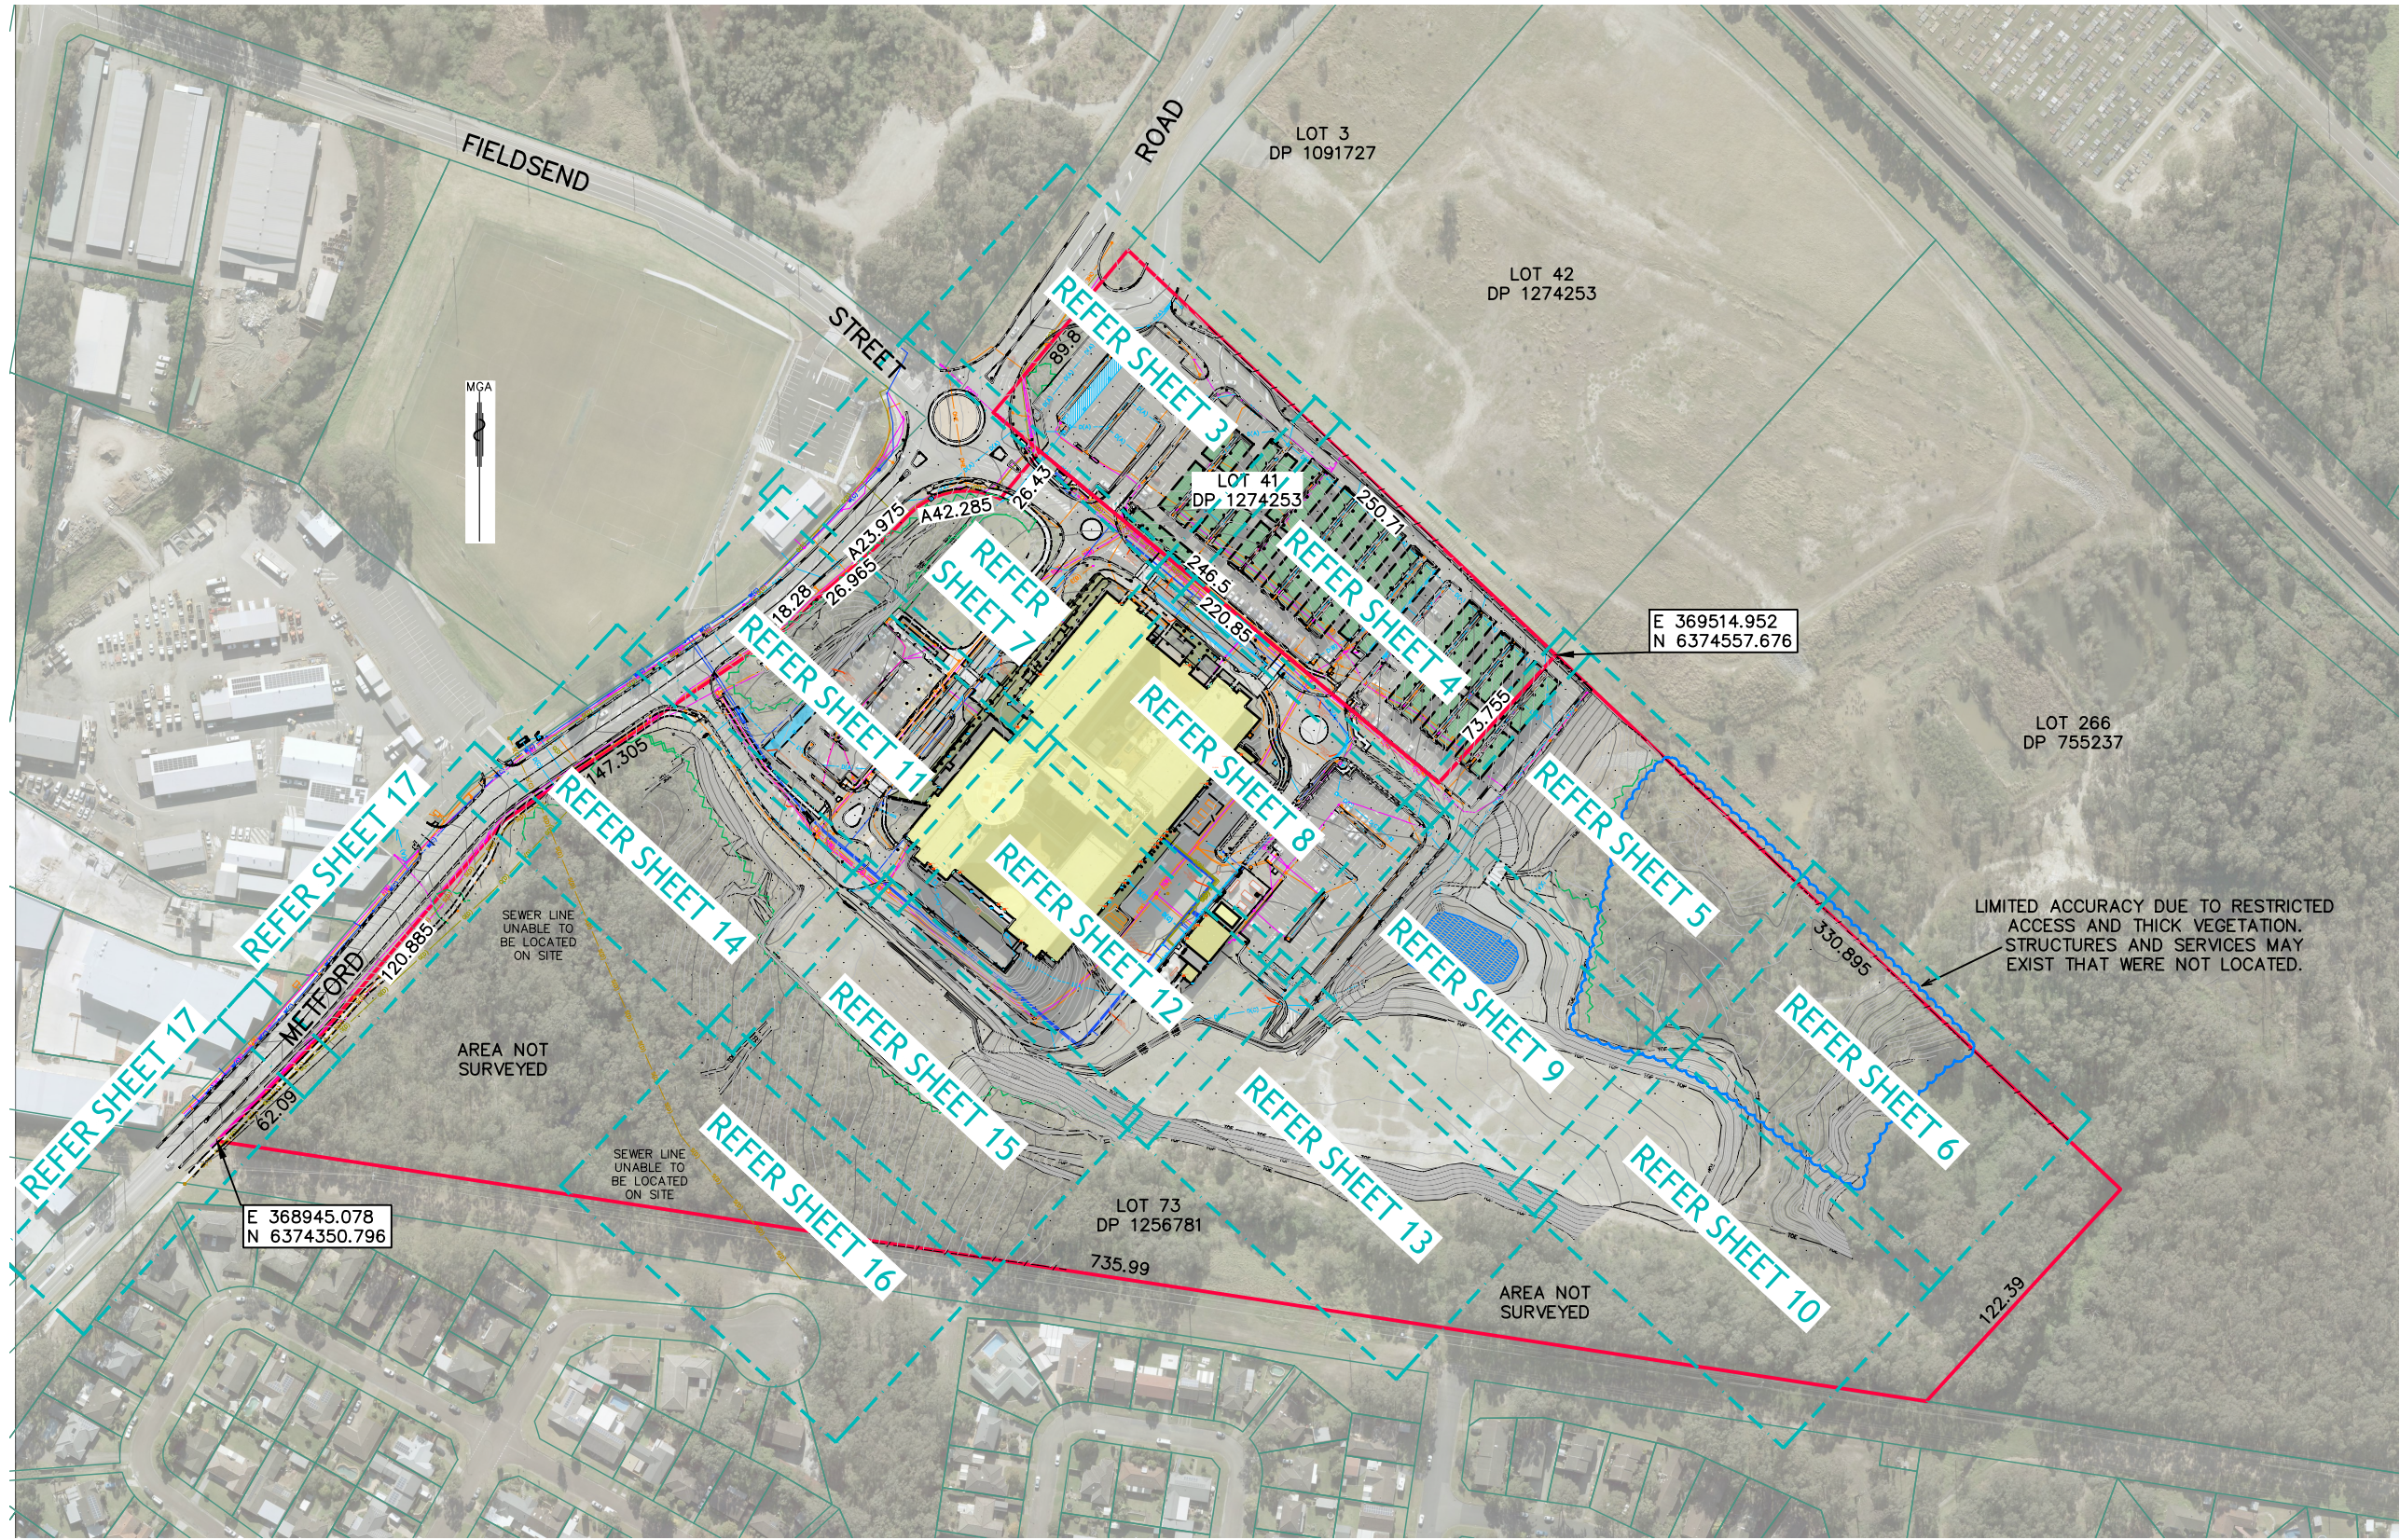

LIMITED ACCURACY DUE TO RESTRICTED ACCESS AND THICK VEGETATION. STRUCTURES AND SERVICES MAY EXIST THAT WERE NOT LOCATED.

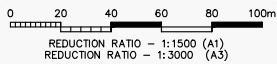

No	REVISION	SVY	DFT	CHK	DATE
1	ISSUE TO CLIENT	M&P	MAK	BJB	21/02/23


COPYRIGHT NOTICE
THIS DOCUMENT REMAINS THE PROPERTY OF
MONTEATH & POWYS PTY LTD. ©

CONDITIONS OF USE.
THIS DOCUMENT MAY ONLY BE USED BY THE CLIENT
FOR THE PURPOSE FOR WHICH IT WAS COMMISSIONED.
USE OF THE DOCUMENT FOR ANY OTHER PURPOSE
IS NOT PERMITTED UNLESS PRIOR WRITTEN APPROVAL
HAS BEEN OBTAINED FROM MONTEATH & POWYS PTY LTD.




PLANNING PROJECT MANAGEMENT SURVEYING 3D SPATIAL

monteathpowys.com.au
P (02) 4926 1388

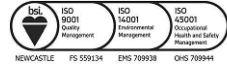

NEWCASTLE SYDNEY GUNNEDAH MUSWELLBROOK

Surveyed	Drafted	Checked	Client	
M&P	MAK	MR	CBRE - MAITLAND MENTAL & COMMUNITY HEALTH	
REGISTERED SURVEYOR			Title	
@A1 : 1:1500 @A3 : 1:3000			DETAIL SURVEY OF LOT 73 DP 1256781 & LOT 41 DP 1274253 MAITLAND HOSPITAL & SURROUNDS METFORD ROAD, METFORD	
DO NOT SCALE			CAD File: 220347B_01	Ref No: 22/0347
			Date: 09/01/2023	

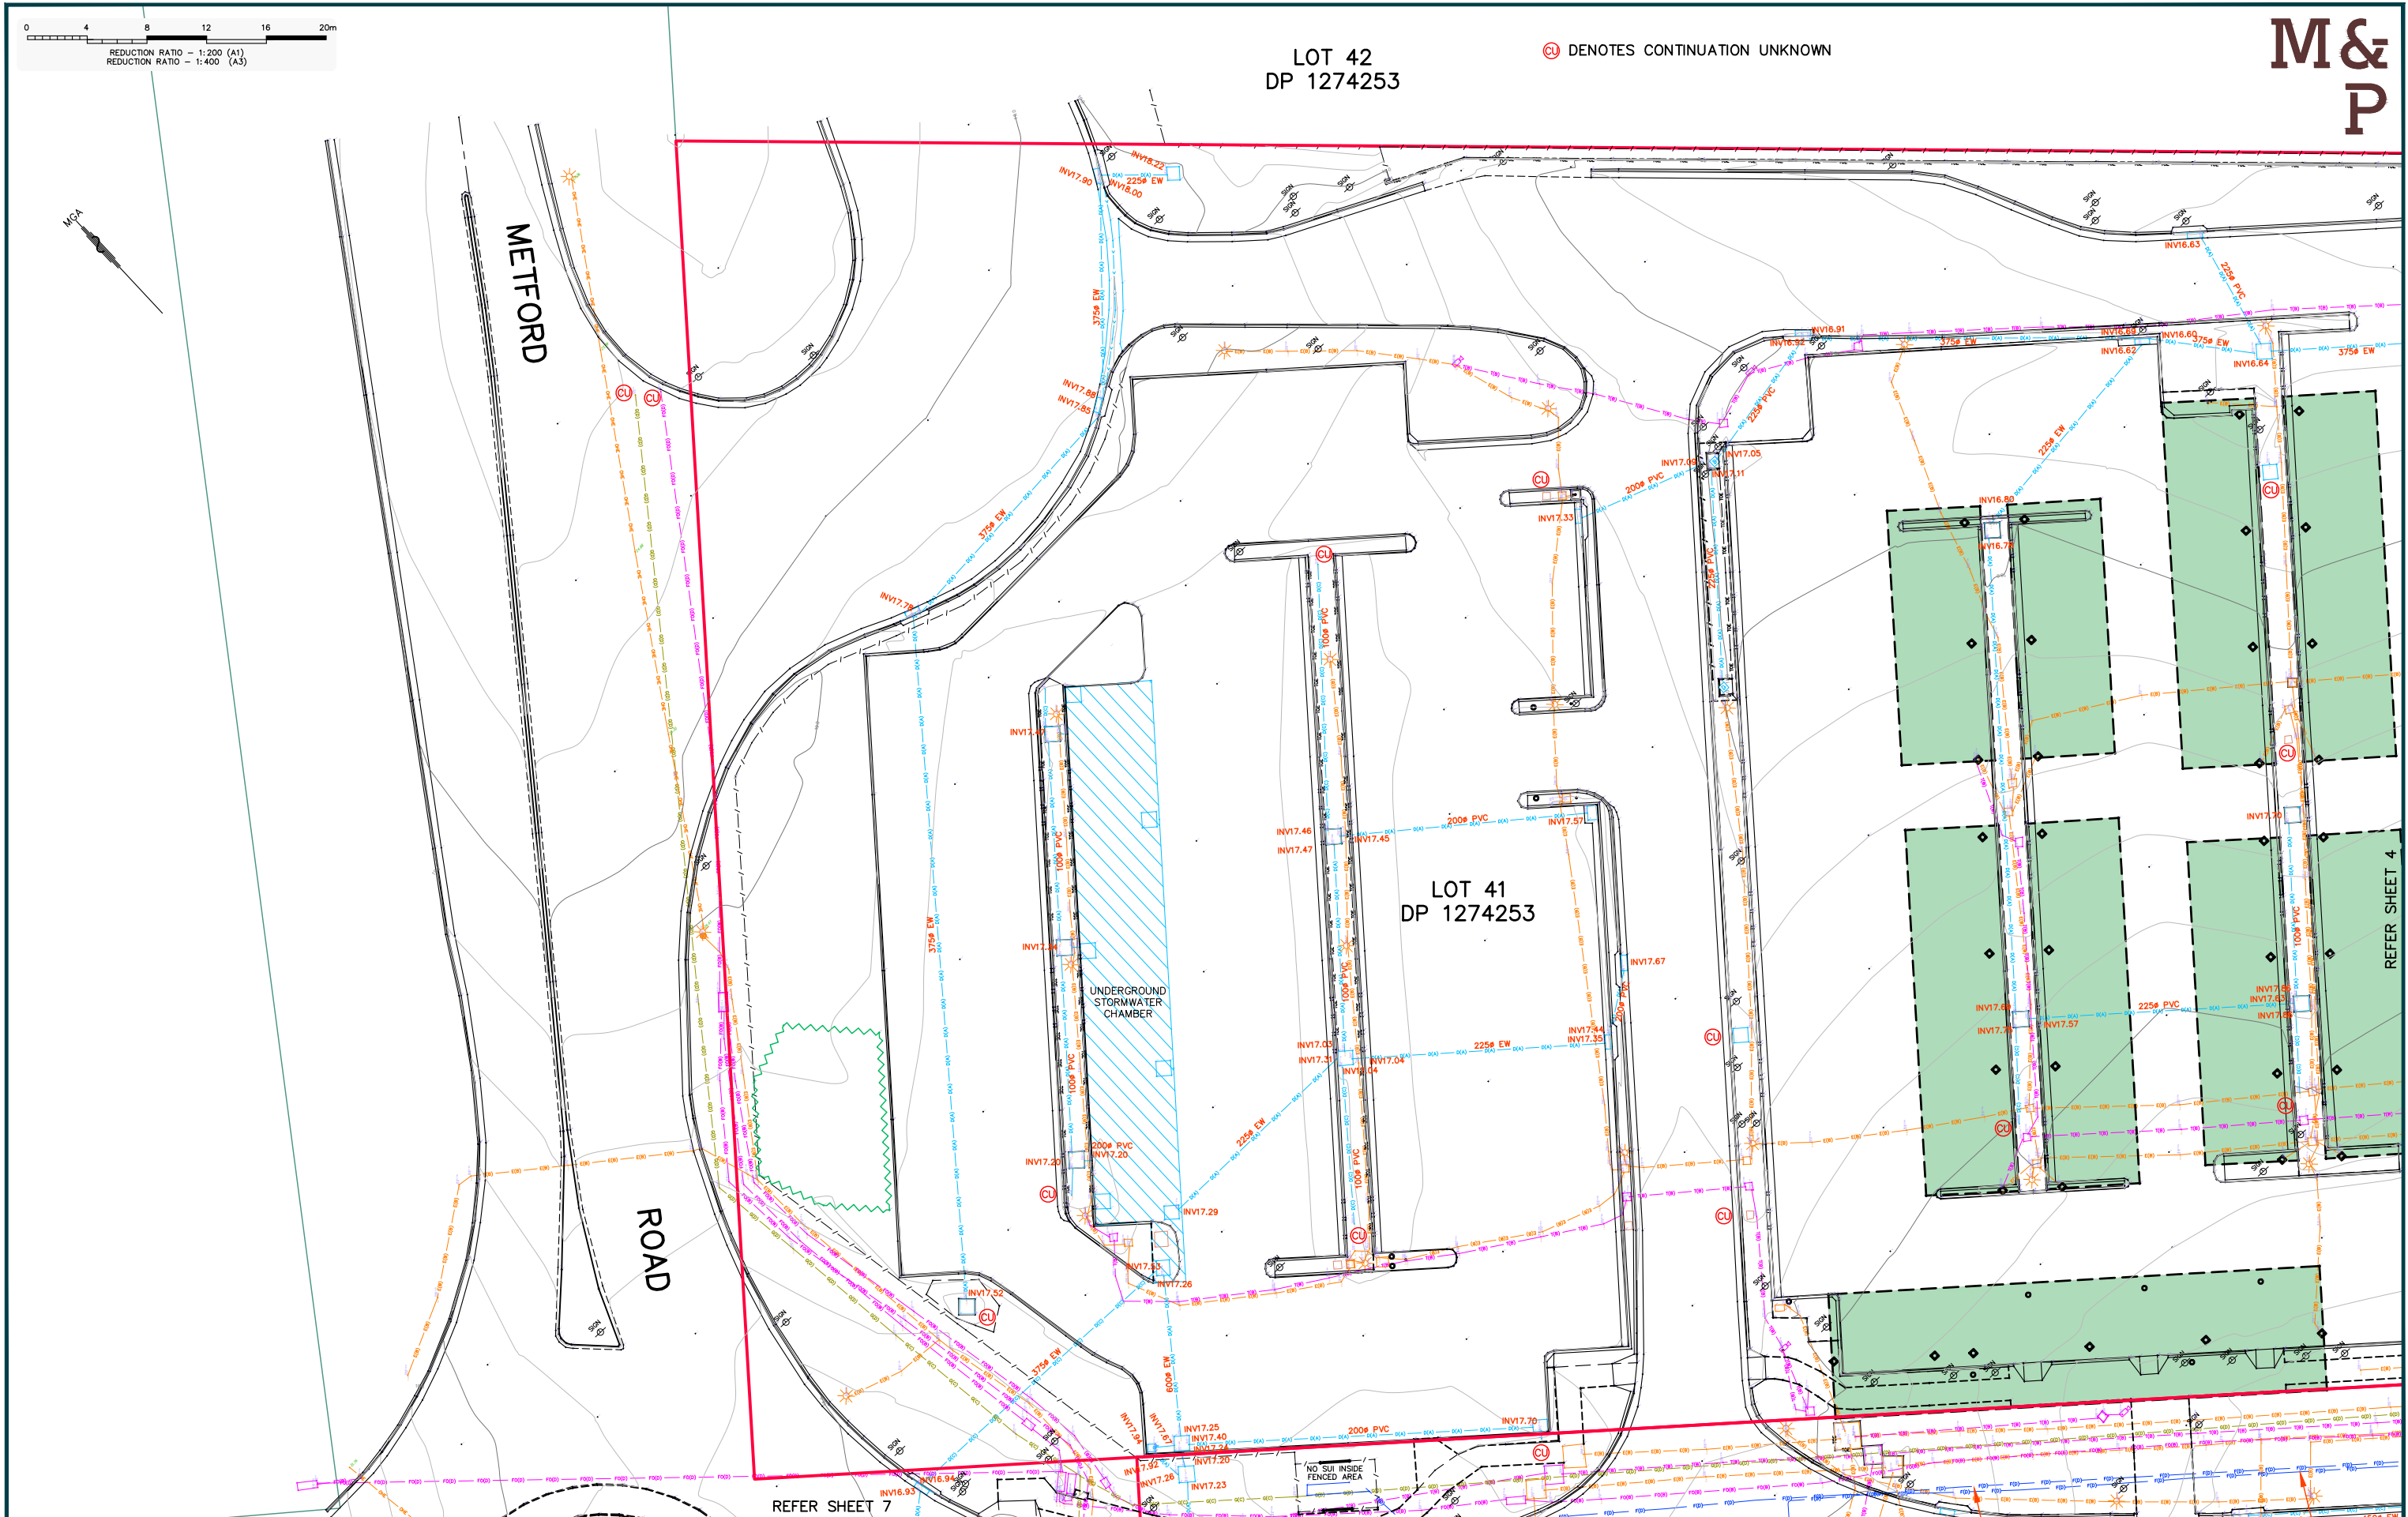


REVISIONS	
-----------	--	--	

Ⓢ DENOTES CONTINUATION UNKNOWN

LOT 42
DP 1274253

LOT 41
DP 1274253

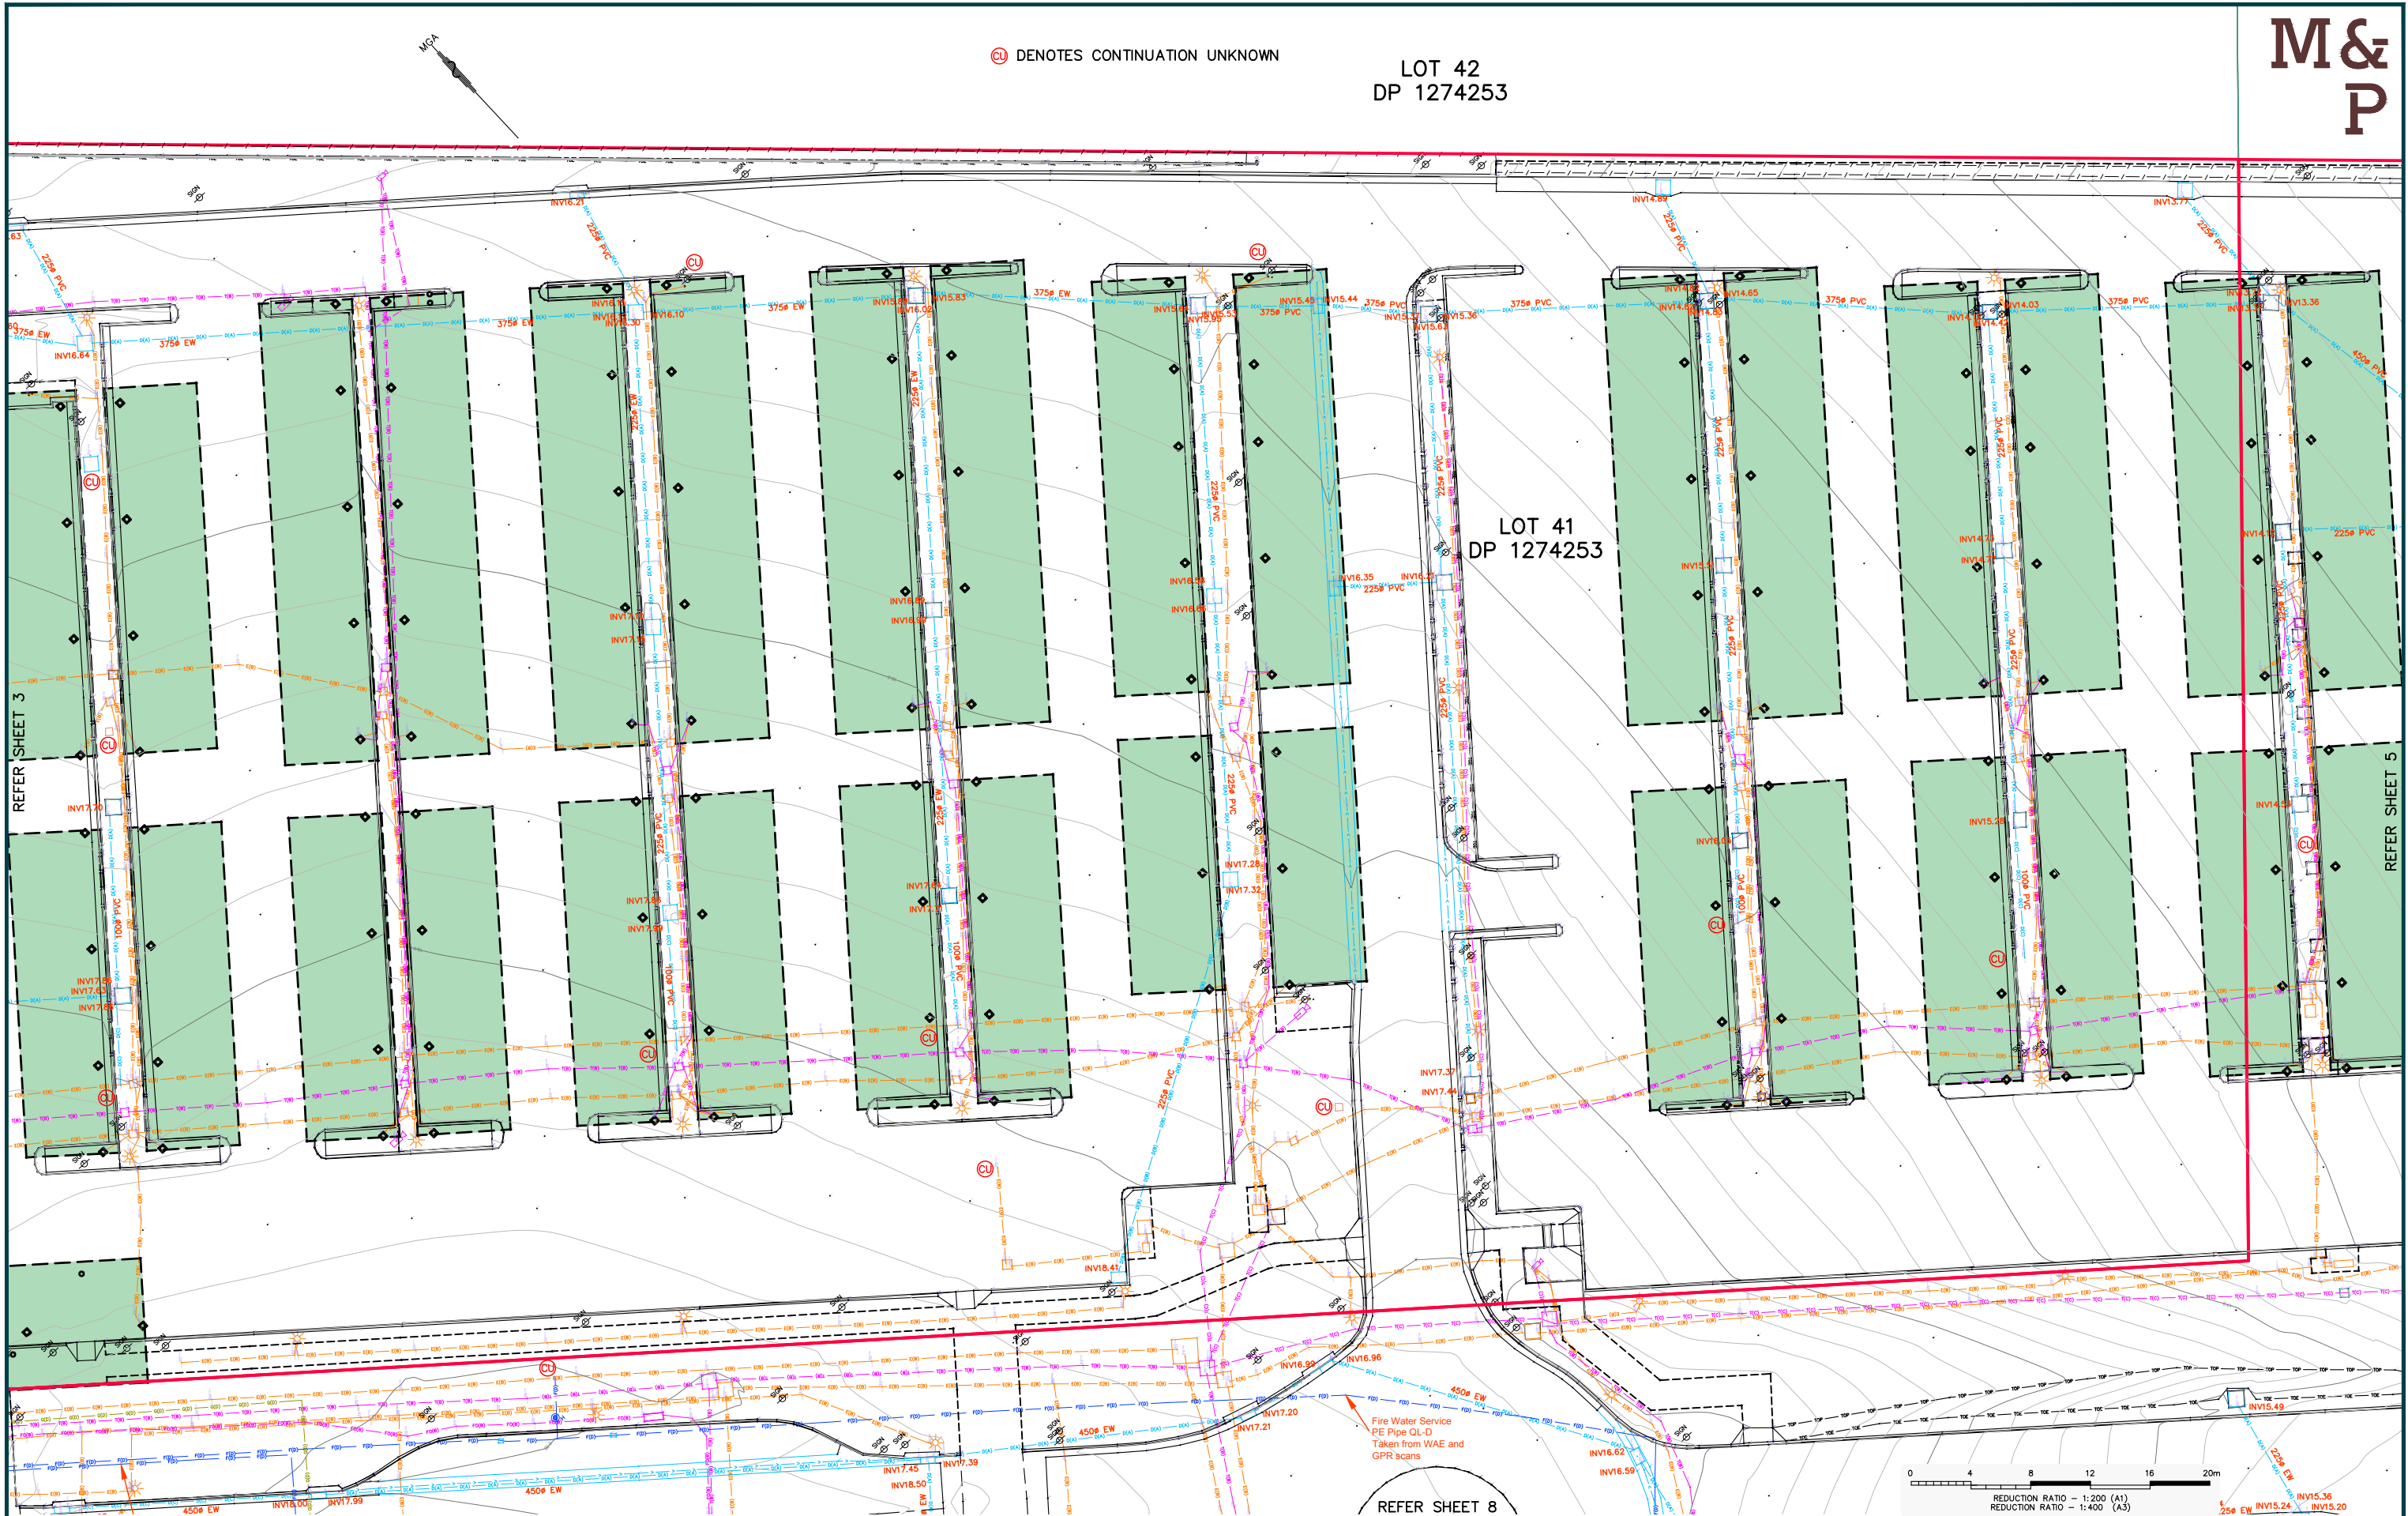

REVISIONS	No	REVISION	SVY	DFT	CHK	DATE
	1	ISSUE TO CLIENT	M&P	MAK	BJB	21/02/23

COPYRIGHT NOTICE
THIS DOCUMENT REMAINS THE PROPERTY OF MONTEATH & POWYS PTY LTD. Ⓢ

CONDITIONS OF USE.
THIS DOCUMENT MAY ONLY BE USED BY THE CLIENT FOR THE PURPOSE FOR WHICH IT WAS COMMISSIONED. USE OF THE DOCUMENT FOR ANY OTHER PURPOSE IS NOT PERMITTED UNLESS PRIOR WRITTEN APPROVAL HAS BEEN OBTAINED FROM MONTEATH & POWYS PTY LTD.




PLANNING PROJECT MANAGEMENT SURVEYING 3D SPATIAL

monteathpowys.com.au
P (02) 4926 1388

NEWCASTLE SYDNEY GUNNDAH MUSWELLBROOK

Surveyed M&P	Drafted MAK	Checked MR	Client CBRE - MAITLAND MENTAL & COMMUNITY HEALTH	Sheet No. 4 / 17
REGISTERED SURVEYOR @A1 : 1:200 @A3 : 1:400			Title DETAIL SURVEY OF LOT 73 DP 1256781 & LOT 41 DP 1274253 MAITLAND HOSPITAL & SURROUNDS METFORD ROAD, METFORD	Revision 1
DO NOT SCALE			CAD File: 220347B_01	Date: 09/01/2023

LOT 266
DP 755237

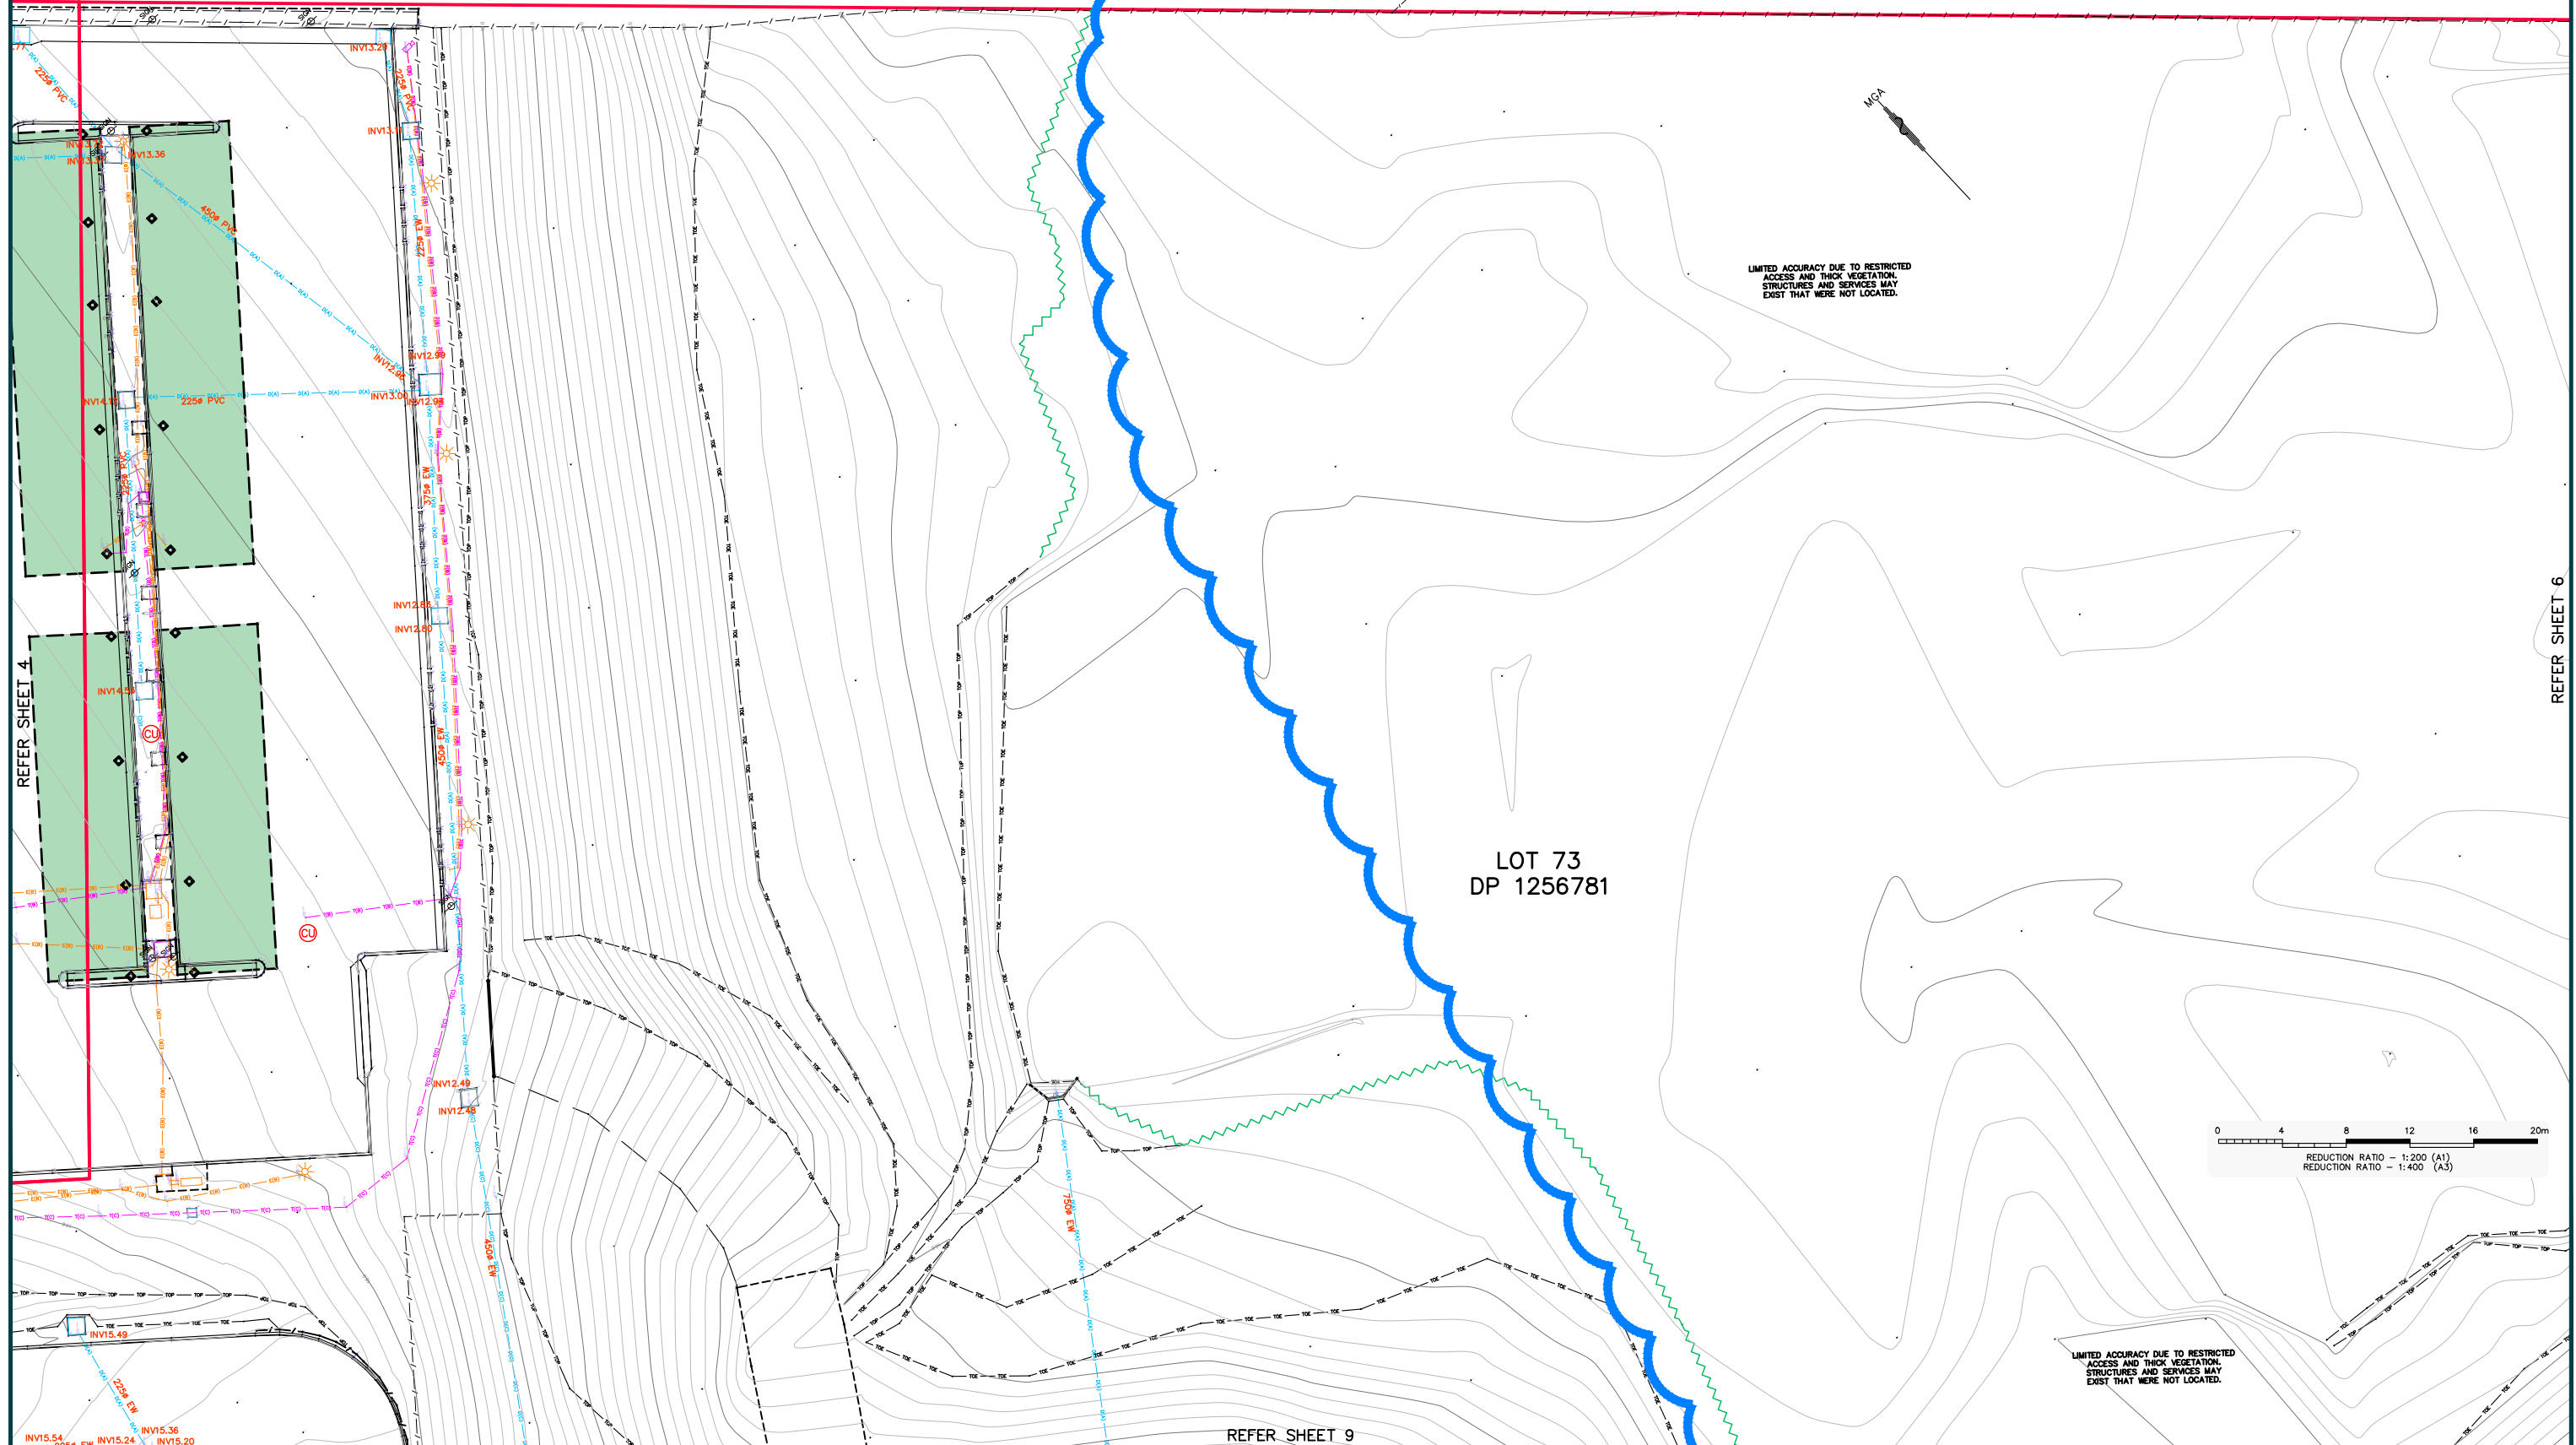

REFER SHEET 6

					COPYRIGHT NOTICE THIS DOCUMENT REMAINS THE PROPERTY OF MONTEATH & POWYS PTY LTD.
					CONDITIONS OF USE. THIS DOCUMENT MAY ONLY BE USED BY THE CLIENT FOR THE PURPOSE FOR WHICH IT WAS COMMISSIONED. USE OF THE DOCUMENT FOR ANY OTHER PURPOSE IS NOT PERMITTED UNLESS PRIOR WRITTEN APPROVAL HAS BEEN OBTAINED FROM MONTEATH & POWYS PTY LTD.
1	ISSUE TO CLIENT	M&P	MAK	BJB	21/02/23
No	REVISION	SVY	DFT	CHK	DATE

monteathpowys.com.au
P (02) 4926 1388

NEWCASTLE SYDNEY GUNNDAH MUSWELLBROOK


PLANNING PROJECT MANAGEMENT SURVEYING 3D SPATIAL

NEWCASTLE PS 55913H DMS 79993H CHS 79994H

Surveyed M&P	Drafted MAK	Checked MR	Client CBRE - MAITLAND MENTAL & COMMUNITY HEALTH	Sheet No. 5 / 17
			Title DETAIL SURVEY OF LOT 73 DP 1256781 & LOT 41 DP 1274253 MAITLAND HOSPITAL & SURROUNDINGS METT福德 ROAD, METTFORD	Revision 1
REGISTERED SURVEYOR @A1 : 1:200 @A3 : 1:400			Original Size A1	
DO NOT SCALE			CAD File: 220347B_01 Ref No: 22/0347 Date: 09/01/2023	

LOT 266
DP 755237


LIMITED ACCURACY DUE TO RESTRICTED
ACCESS AND THICK VEGETATION.
STRUCTURES AND SERVICES MAY
EXIST THAT WERE NOT LOCATED.

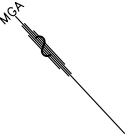

LOT 73
DP 1256781

AREA NOT SURVEYED

LIMITED ACCURACY DUE TO RESTRICTED
ACCESS AND THICK VEGETATION.
STRUCTURES AND SERVICES MAY
EXIST THAT WERE NOT LOCATED.

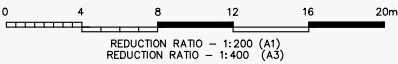

REFER SHEET 5

REFER SHEET 10

No	REVISION	SVY	DFT	CHK	DATE
1	ISSUE TO CLIENT	M&P	MAK	BJB	21/02/23

COPYRIGHT NOTICE
THIS DOCUMENT REMAINS THE PROPERTY OF
MONTEATH & POWYS PTY LTD. ©

CONDITIONS OF USE.
THIS DOCUMENT MAY ONLY BE USED BY THE CLIENT
FOR THE PURPOSE FOR WHICH IT WAS COMMISSIONED.
USE OF THE DOCUMENT FOR ANY OTHER PURPOSE
IS NOT PERMITTED UNLESS PRIOR WRITTEN APPROVAL
HAS BEEN OBTAINED FROM MONTEATH & POWYS PTY LTD.




PLANNING PROJECT MANAGEMENT SURVEYING 3D SPATIAL

monteathpowys.com.au
P (02) 4926 1388




NEWCASTLE SYDNEY GUNNEDAH MUSWELLBROOK


Surveyed M&P	Drafted MAK	Checked MR	Client CBRE - MAITLAND MENTAL & COMMUNITY HEALTH	Sheet No. 6 / 17
REGISTERED SURVEYOR @A1 : 1:200 @A3 : 1:400			Title DETAIL SURVEY OF LOT 73 DP 1256781 & LOT 41 DP 1274253 MAITLAND HOSPITAL & SURROUNDS METFORD ROAD, METFORD	Revision 1
DO NOT SCALE			CAD File: 220347B_01	Date: 09/01/2023

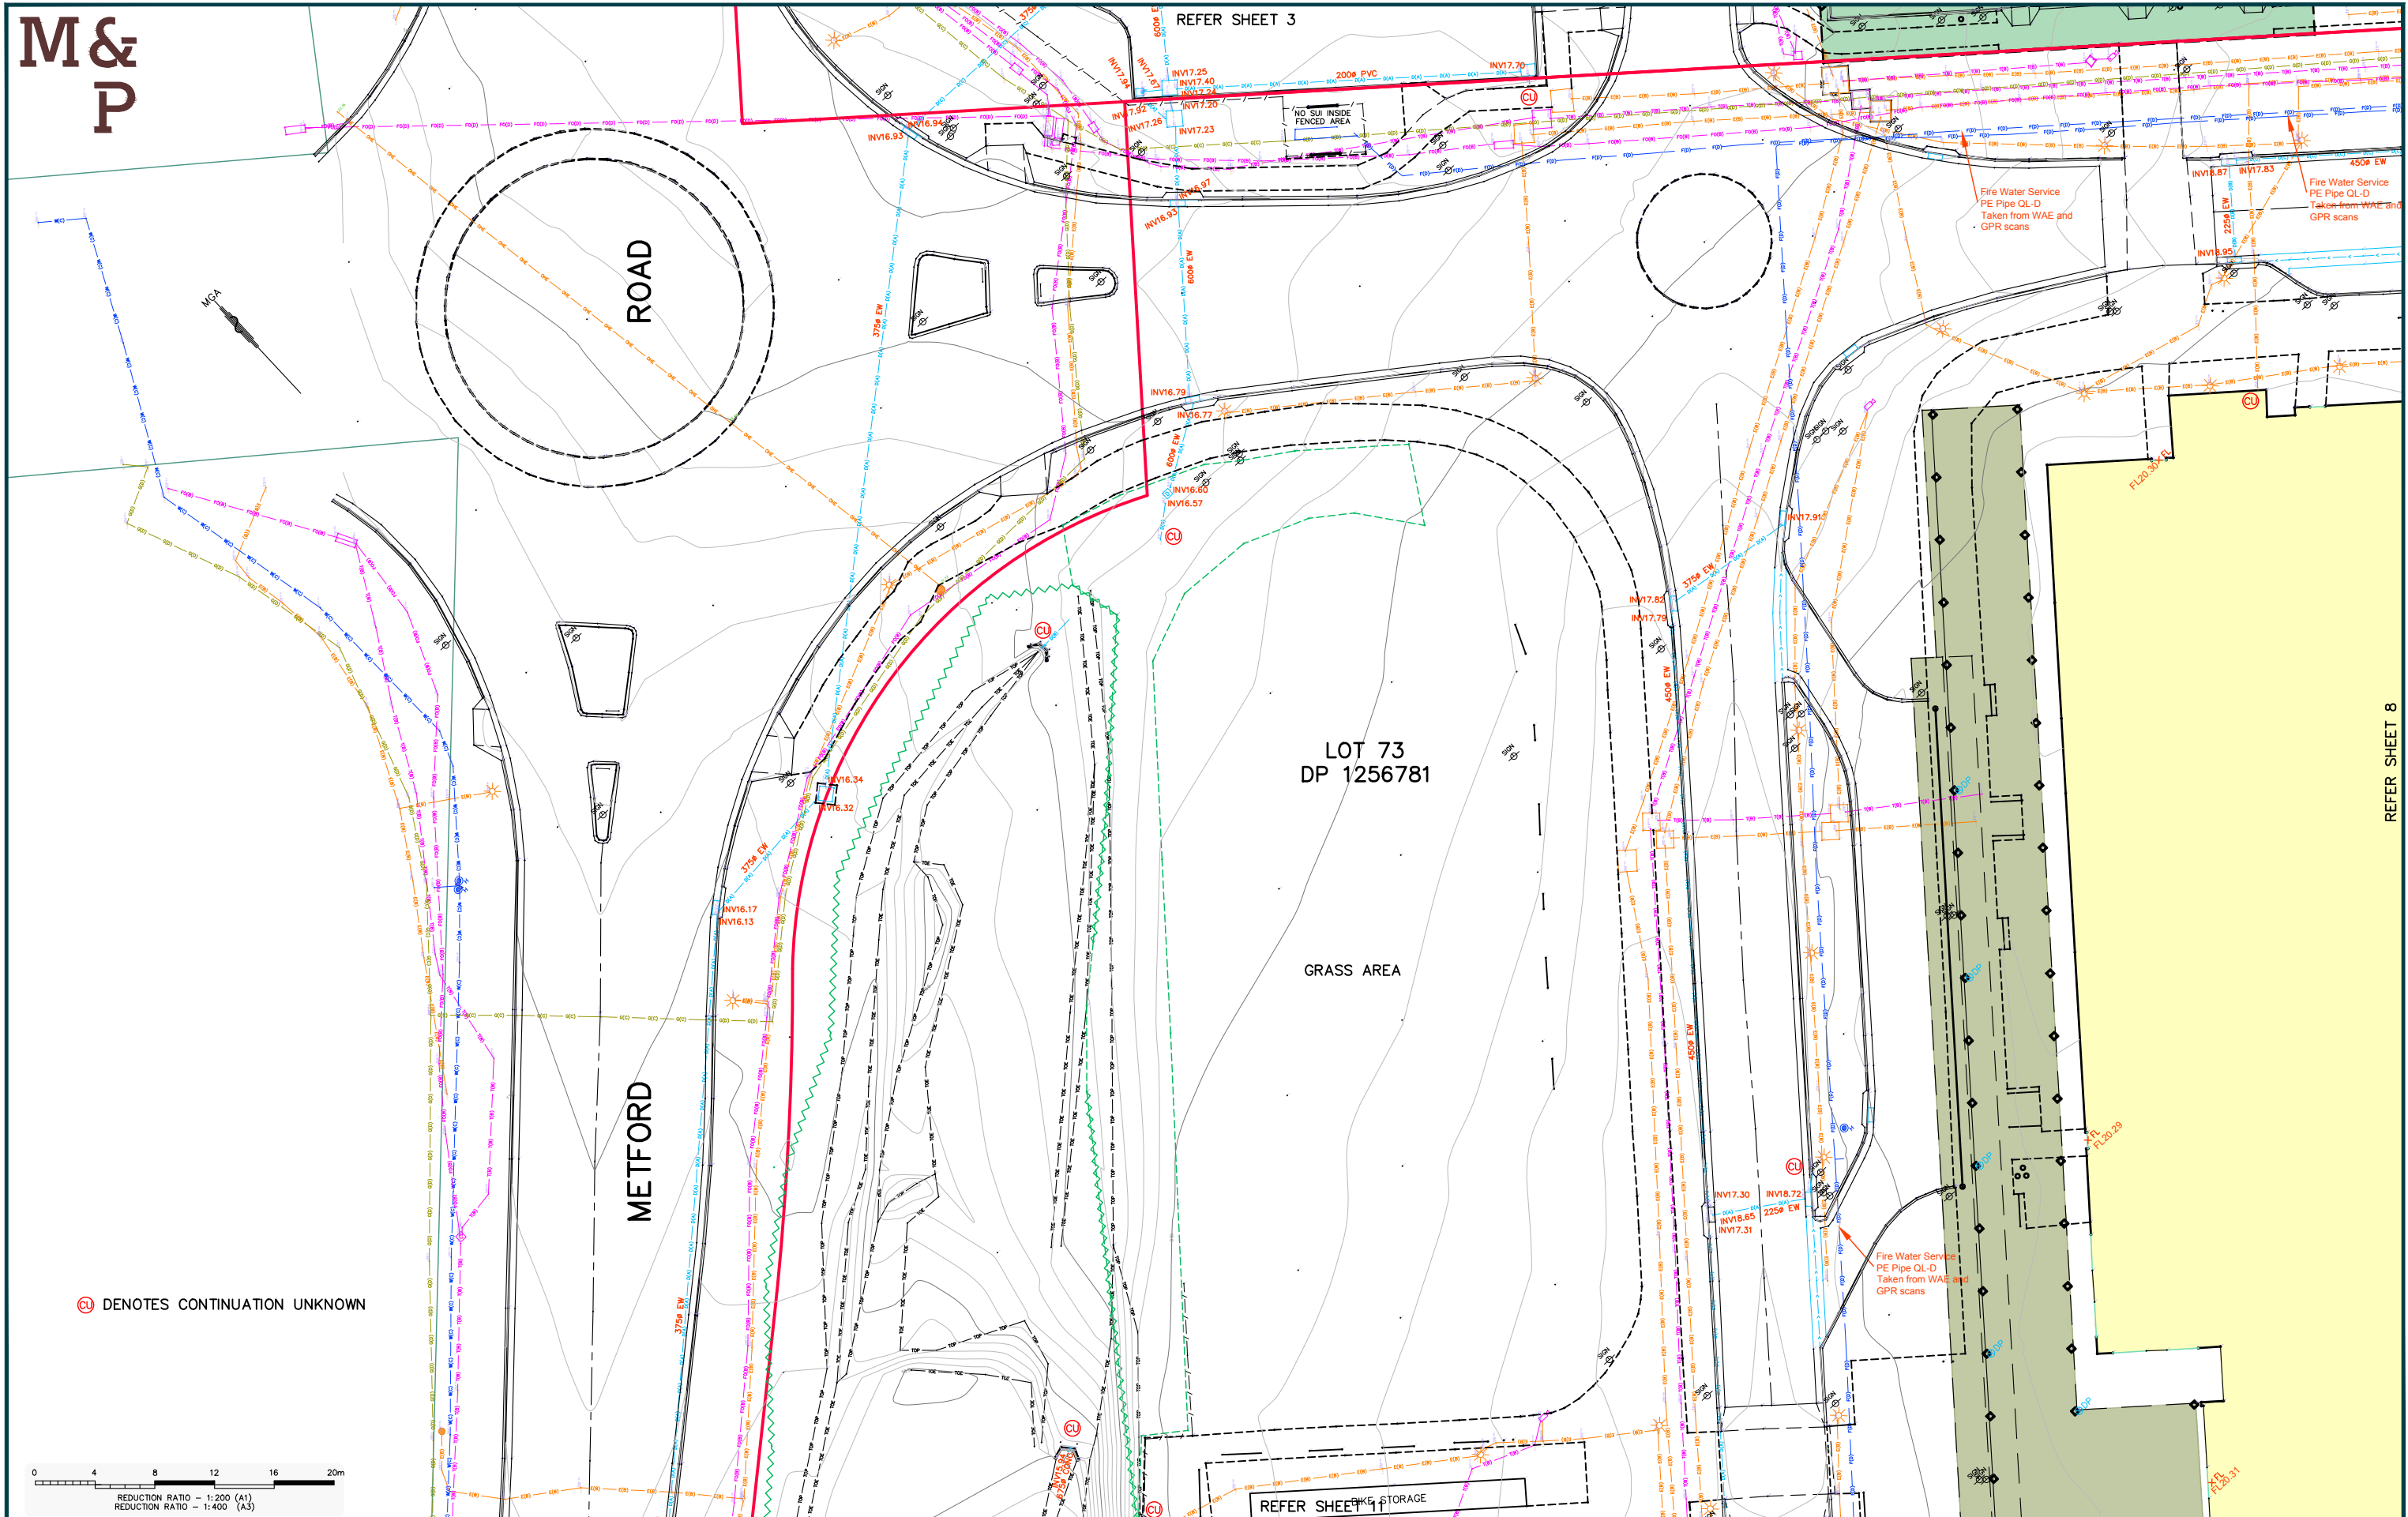


REVISIONS	
-----------	--	--	

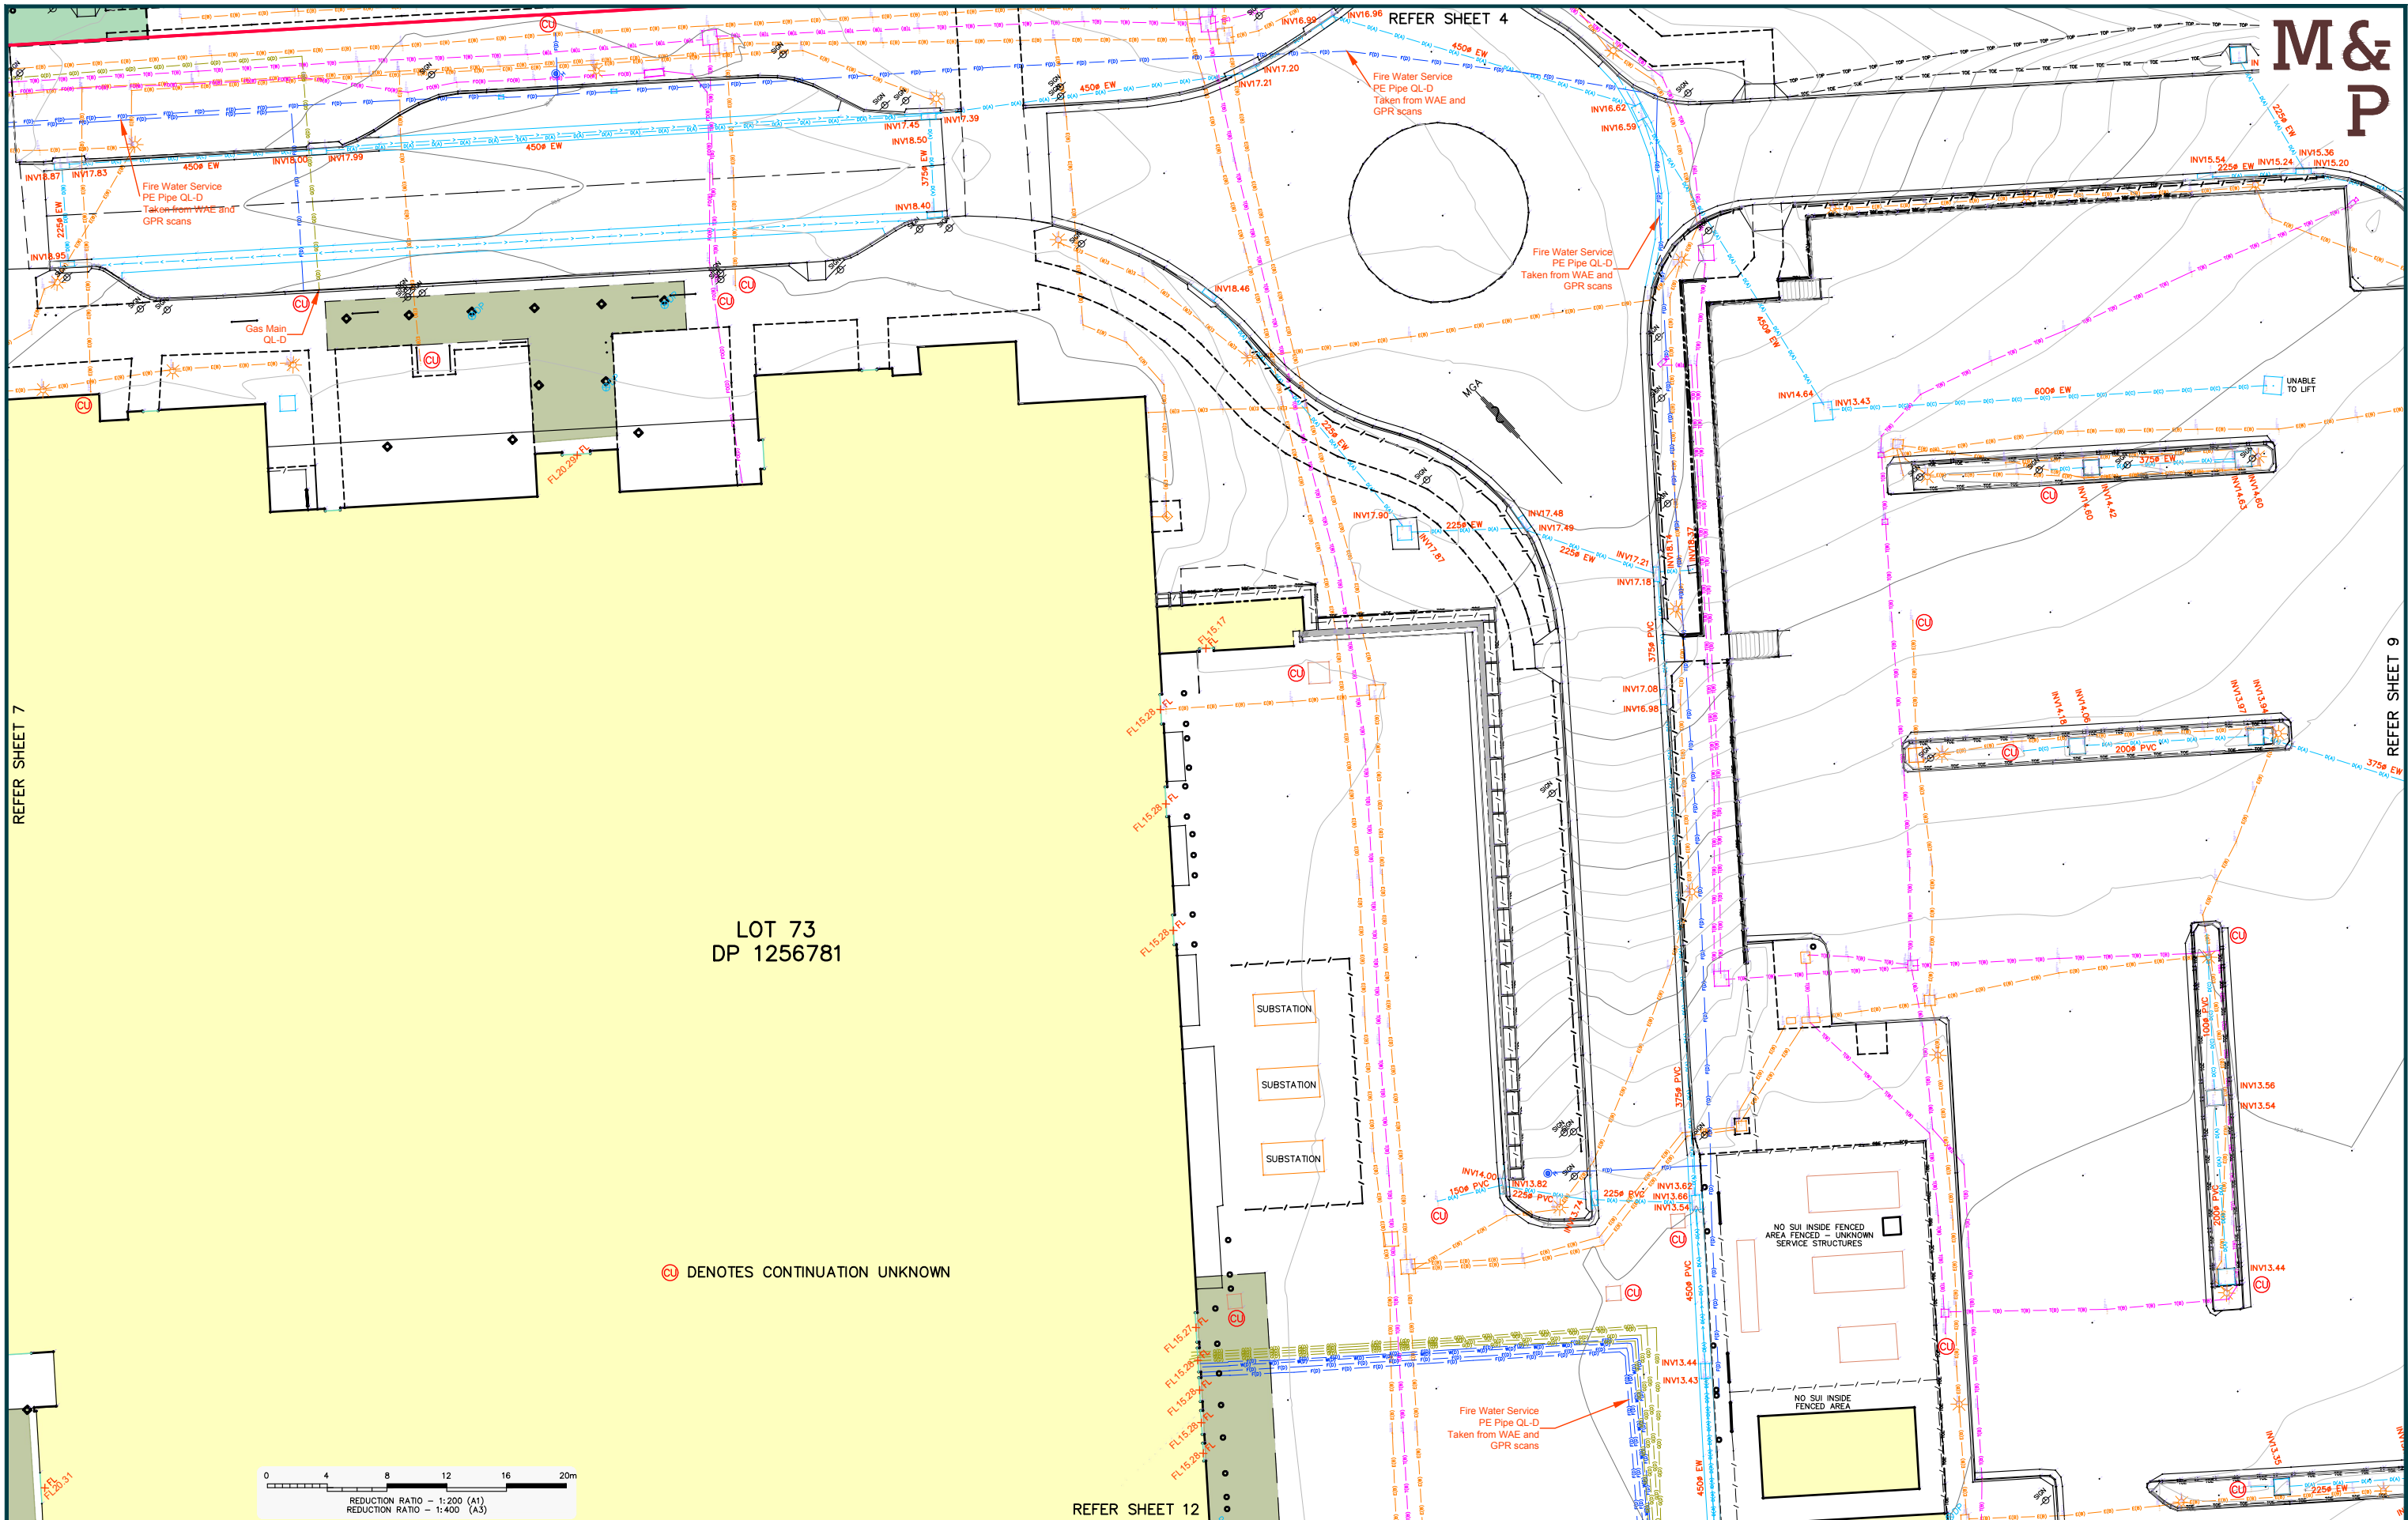

REVISIONS	
-----------	--	--	

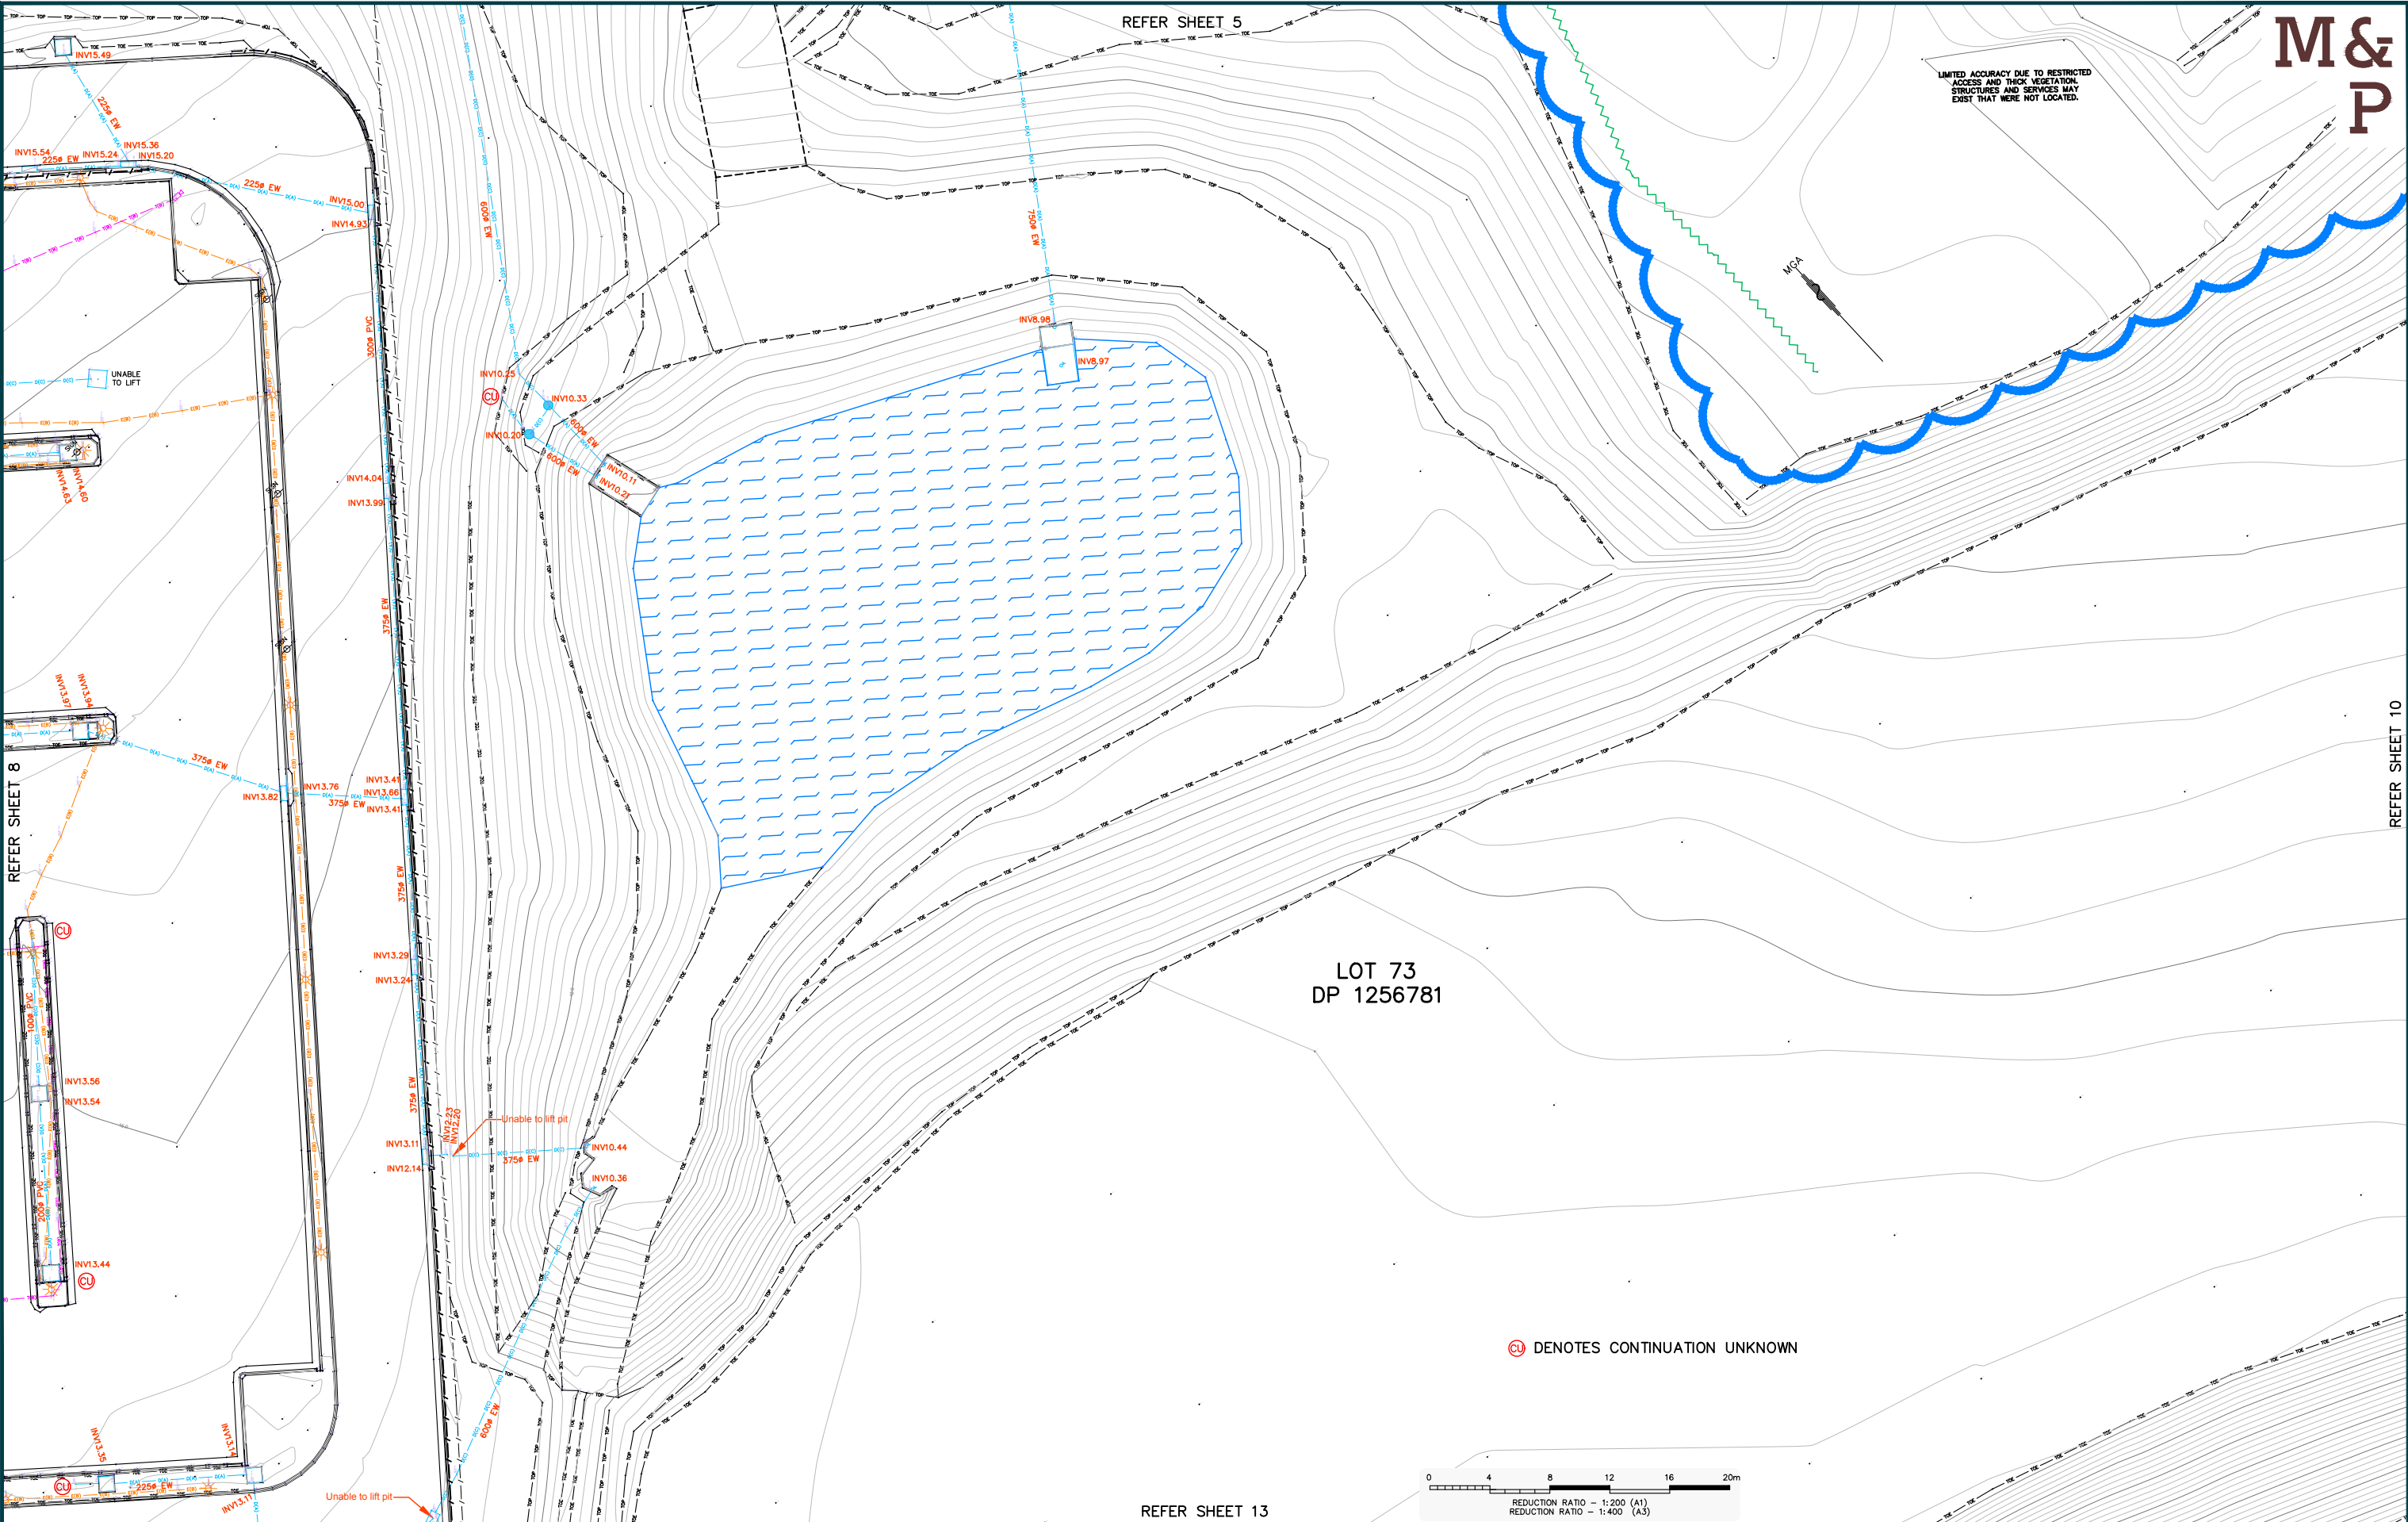

REVISIONS	
-----------	--	--	

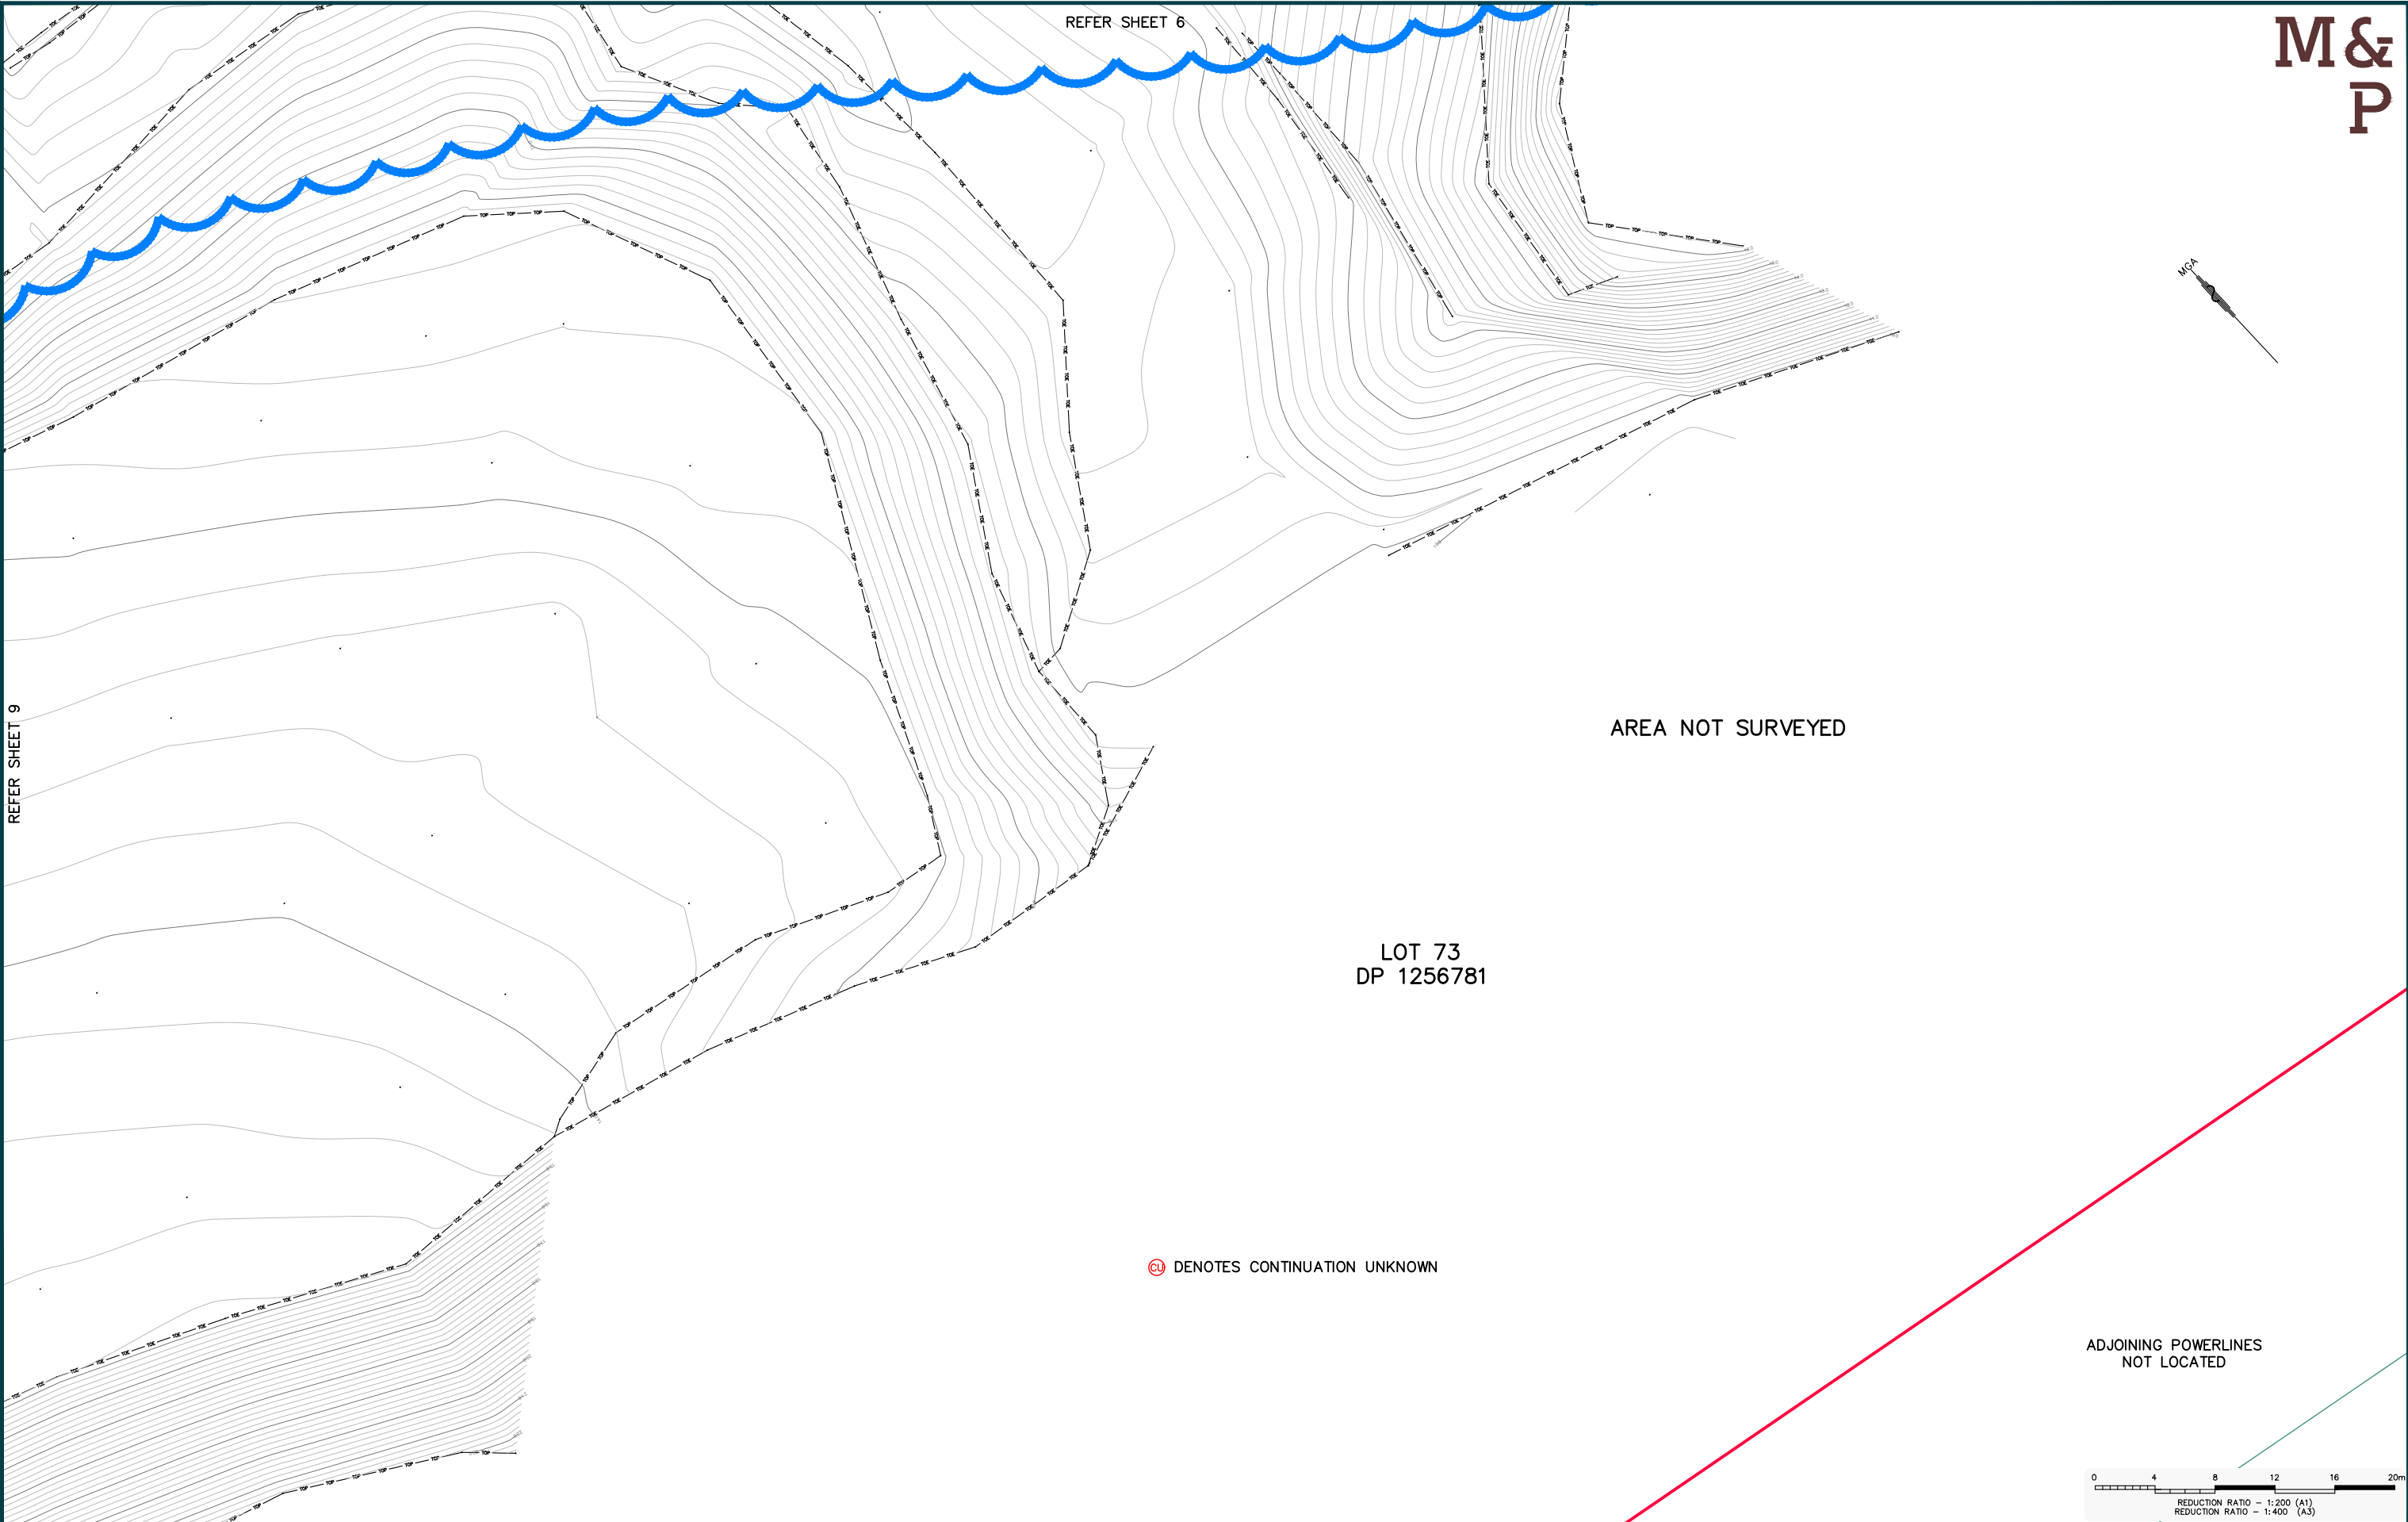

REVISIONS																																																																																																																																																																																																																																																																																																																																																																																																																																																																																																																																																																																																																																																																																																																																																																																																																																																																																																																																																																																																																																																																																																																																																																																																																																																																																																																																																																																																																			</
-----------	--	--	----

M&P



0 4 8 12 16 20m
REDUCTION RATIO - 1:200 (A1)
REDUCTION RATIO - 1:400 (A3)

CL DENOTES CONTINUATION UNKNOWN

REFER SHEET 7

BIKE STORAGE

LOT 73
DP 1256781

METFORD ROAD

REFER SHEET 14

REFER SHEET 12

REVISIONS		No	REVISION	SVY	DFT	CHK	DATE
		1	ISSUE TO CLIENT	M&P	MAK	BJB	21/02/23


COPYRIGHT NOTICE
THIS DOCUMENT REMAINS THE PROPERTY OF
MONTEATH & POWYS PTY LTD. ©

CONDITIONS OF USE.
THIS DOCUMENT MAY ONLY BE USED BY THE CLIENT
FOR THE PURPOSE FOR WHICH IT WAS COMMISSIONED.
USE OF THE DOCUMENT FOR ANY OTHER PURPOSE
IS NOT PERMITTED UNLESS PRIOR WRITTEN APPROVAL
HAS BEEN OBTAINED FROM MONTEATH & POWYS PTY LTD.

M&P
Monteath
& Powys

PLANNING PROJECT MANAGEMENT SURVEYING 3D SPATIAL

monteathpowys.com.au
P (02) 4926 1388

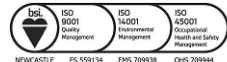

NEWCASTLE SYDNEY GUNNDAH MUSWELLBROOK

Surveyed	Drafted	Checked	Client		Sheet No.
M&P	MAK	MR	CBRE - MAITLAND MENTAL & COMMUNITY HEALTH		11/17
REGISTERED SURVEYOR			Title		Revision
Original Size			DETAIL SURVEY OF LOT 73 DP 1256781 & LOT 41 DP 1274253 MAITLAND HOSPITAL & SURROUNDS METFORD ROAD, METFORD		1
DO NOT SCALE			CAD File: 220347B_01	Ref No: 22/0347	Date: 09/01/2023

LOT 73
DP 1256781

REFER SHEET 8

Fire Water Service
PE Pipe QL-D
Taken from WAE and
GPR scansFire Water Service
PE Pipe QL-D
Taken from WAE and
GPR scansWater Main
PE Pipe QL-D
Taken from WAE and GPR

CL DENOTES CONTINUATION UNKNOWN


0 4 8 12 16 20m
REDUCTION RATIO - 1:200 (A1)
REDUCTION RATIO - 1:400 (A3)

REFER SHEET 15


REVISIONS				
No	REVISION	SVY	DFT	CHK
1	ISSUE TO CLIENT	M&P	MAK	BJB
				21/02/23

COPYRIGHT NOTICE THIS DOCUMENT REMAINS THE PROPERTY OF MONTEATH & POWYS PTY LTD. ©				
CONDITIONS OF USE THIS DOCUMENT MAY ONLY BE USED BY THE CLIENT FOR THE PURPOSE FOR WHICH IT WAS COMMISSIONED. USE OF THE DOCUMENT FOR ANY OTHER PURPOSE IS NOT PERMITTED UNLESS PRIOR WRITTEN APPROVAL HAS BEEN OBTAINED FROM MONTEATH & POWYS PTY LTD.				


Surveyed M&P	Drafted MAK	Checked MR	Client CBRE - MAITLAND MENTAL & COMMUNITY HEALTH	Sheet No. 12 / 17
REGISTERED SURVEYOR @A1 : 1:200 @A3 : 1:400			Title DETAIL SURVEY OF LOT 73 DP 1256781 & LOT 41 DP 1274253 MAITLAND HOSPITAL & SURROUNDS METFORD ROAD, METFORD	Revision 1
DO NOT SCALE			CAD File: 220347B_01	Date: 09/01/2023

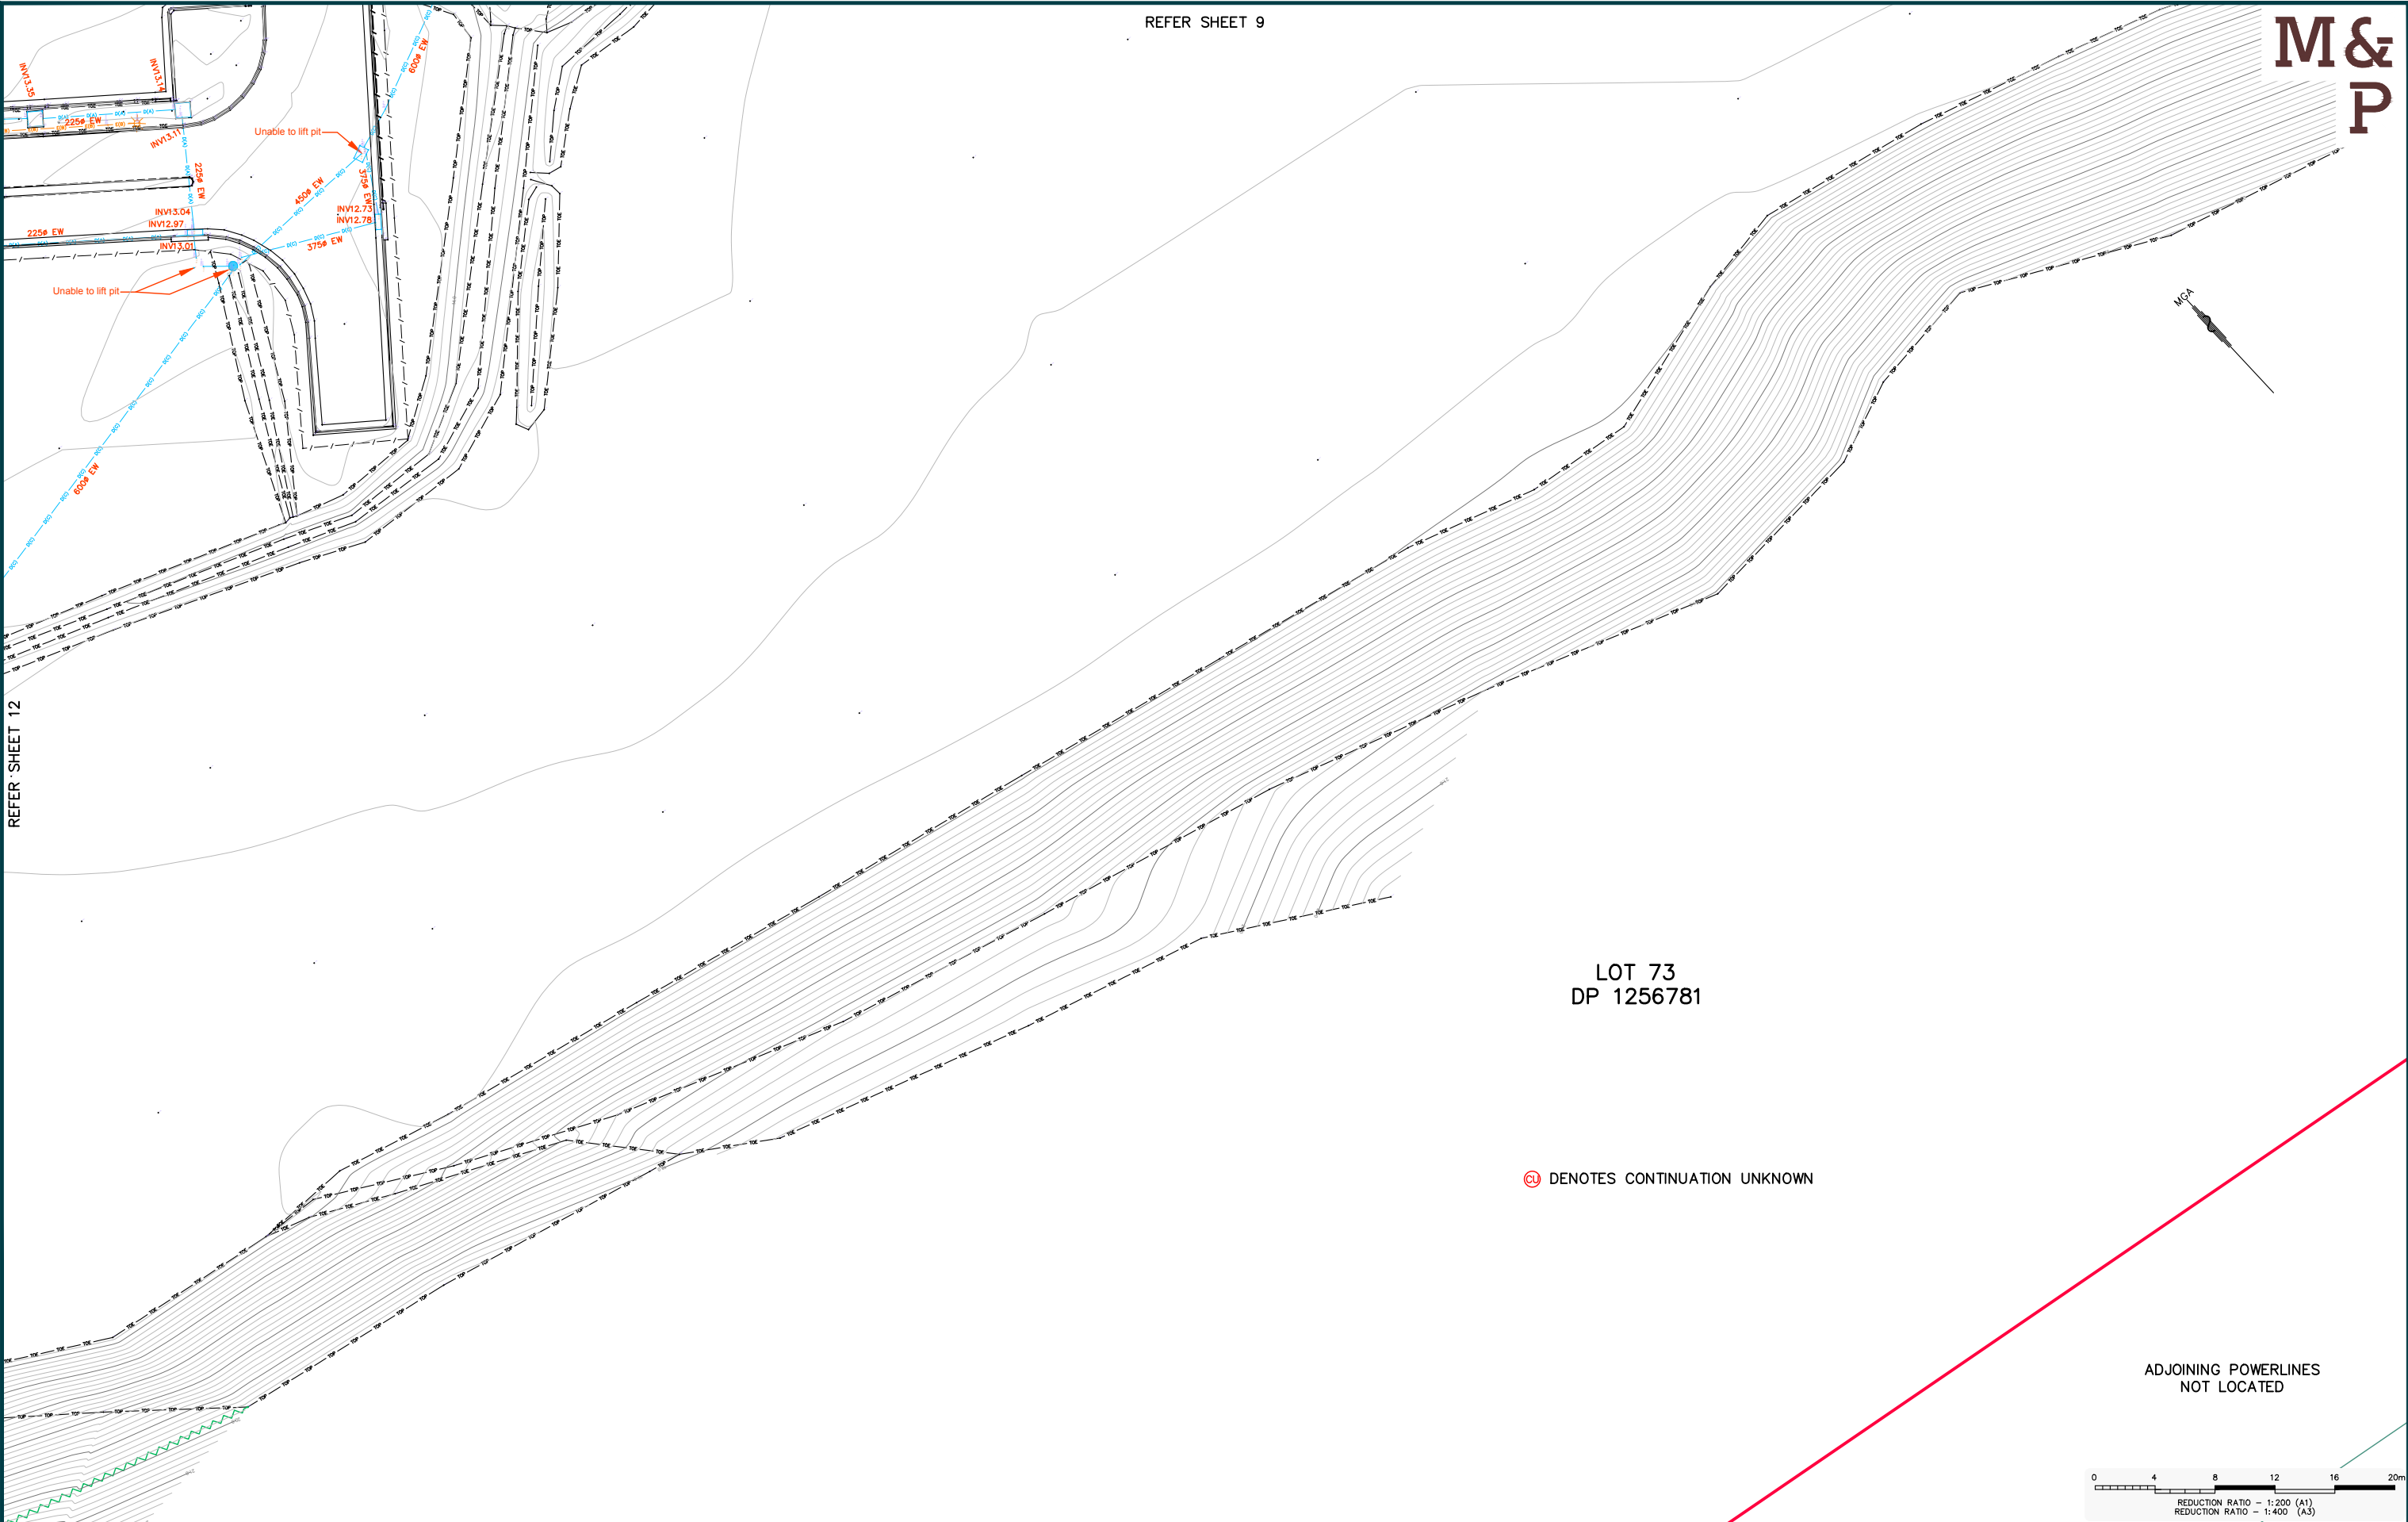

REVISIONS	
-----------	--	--	

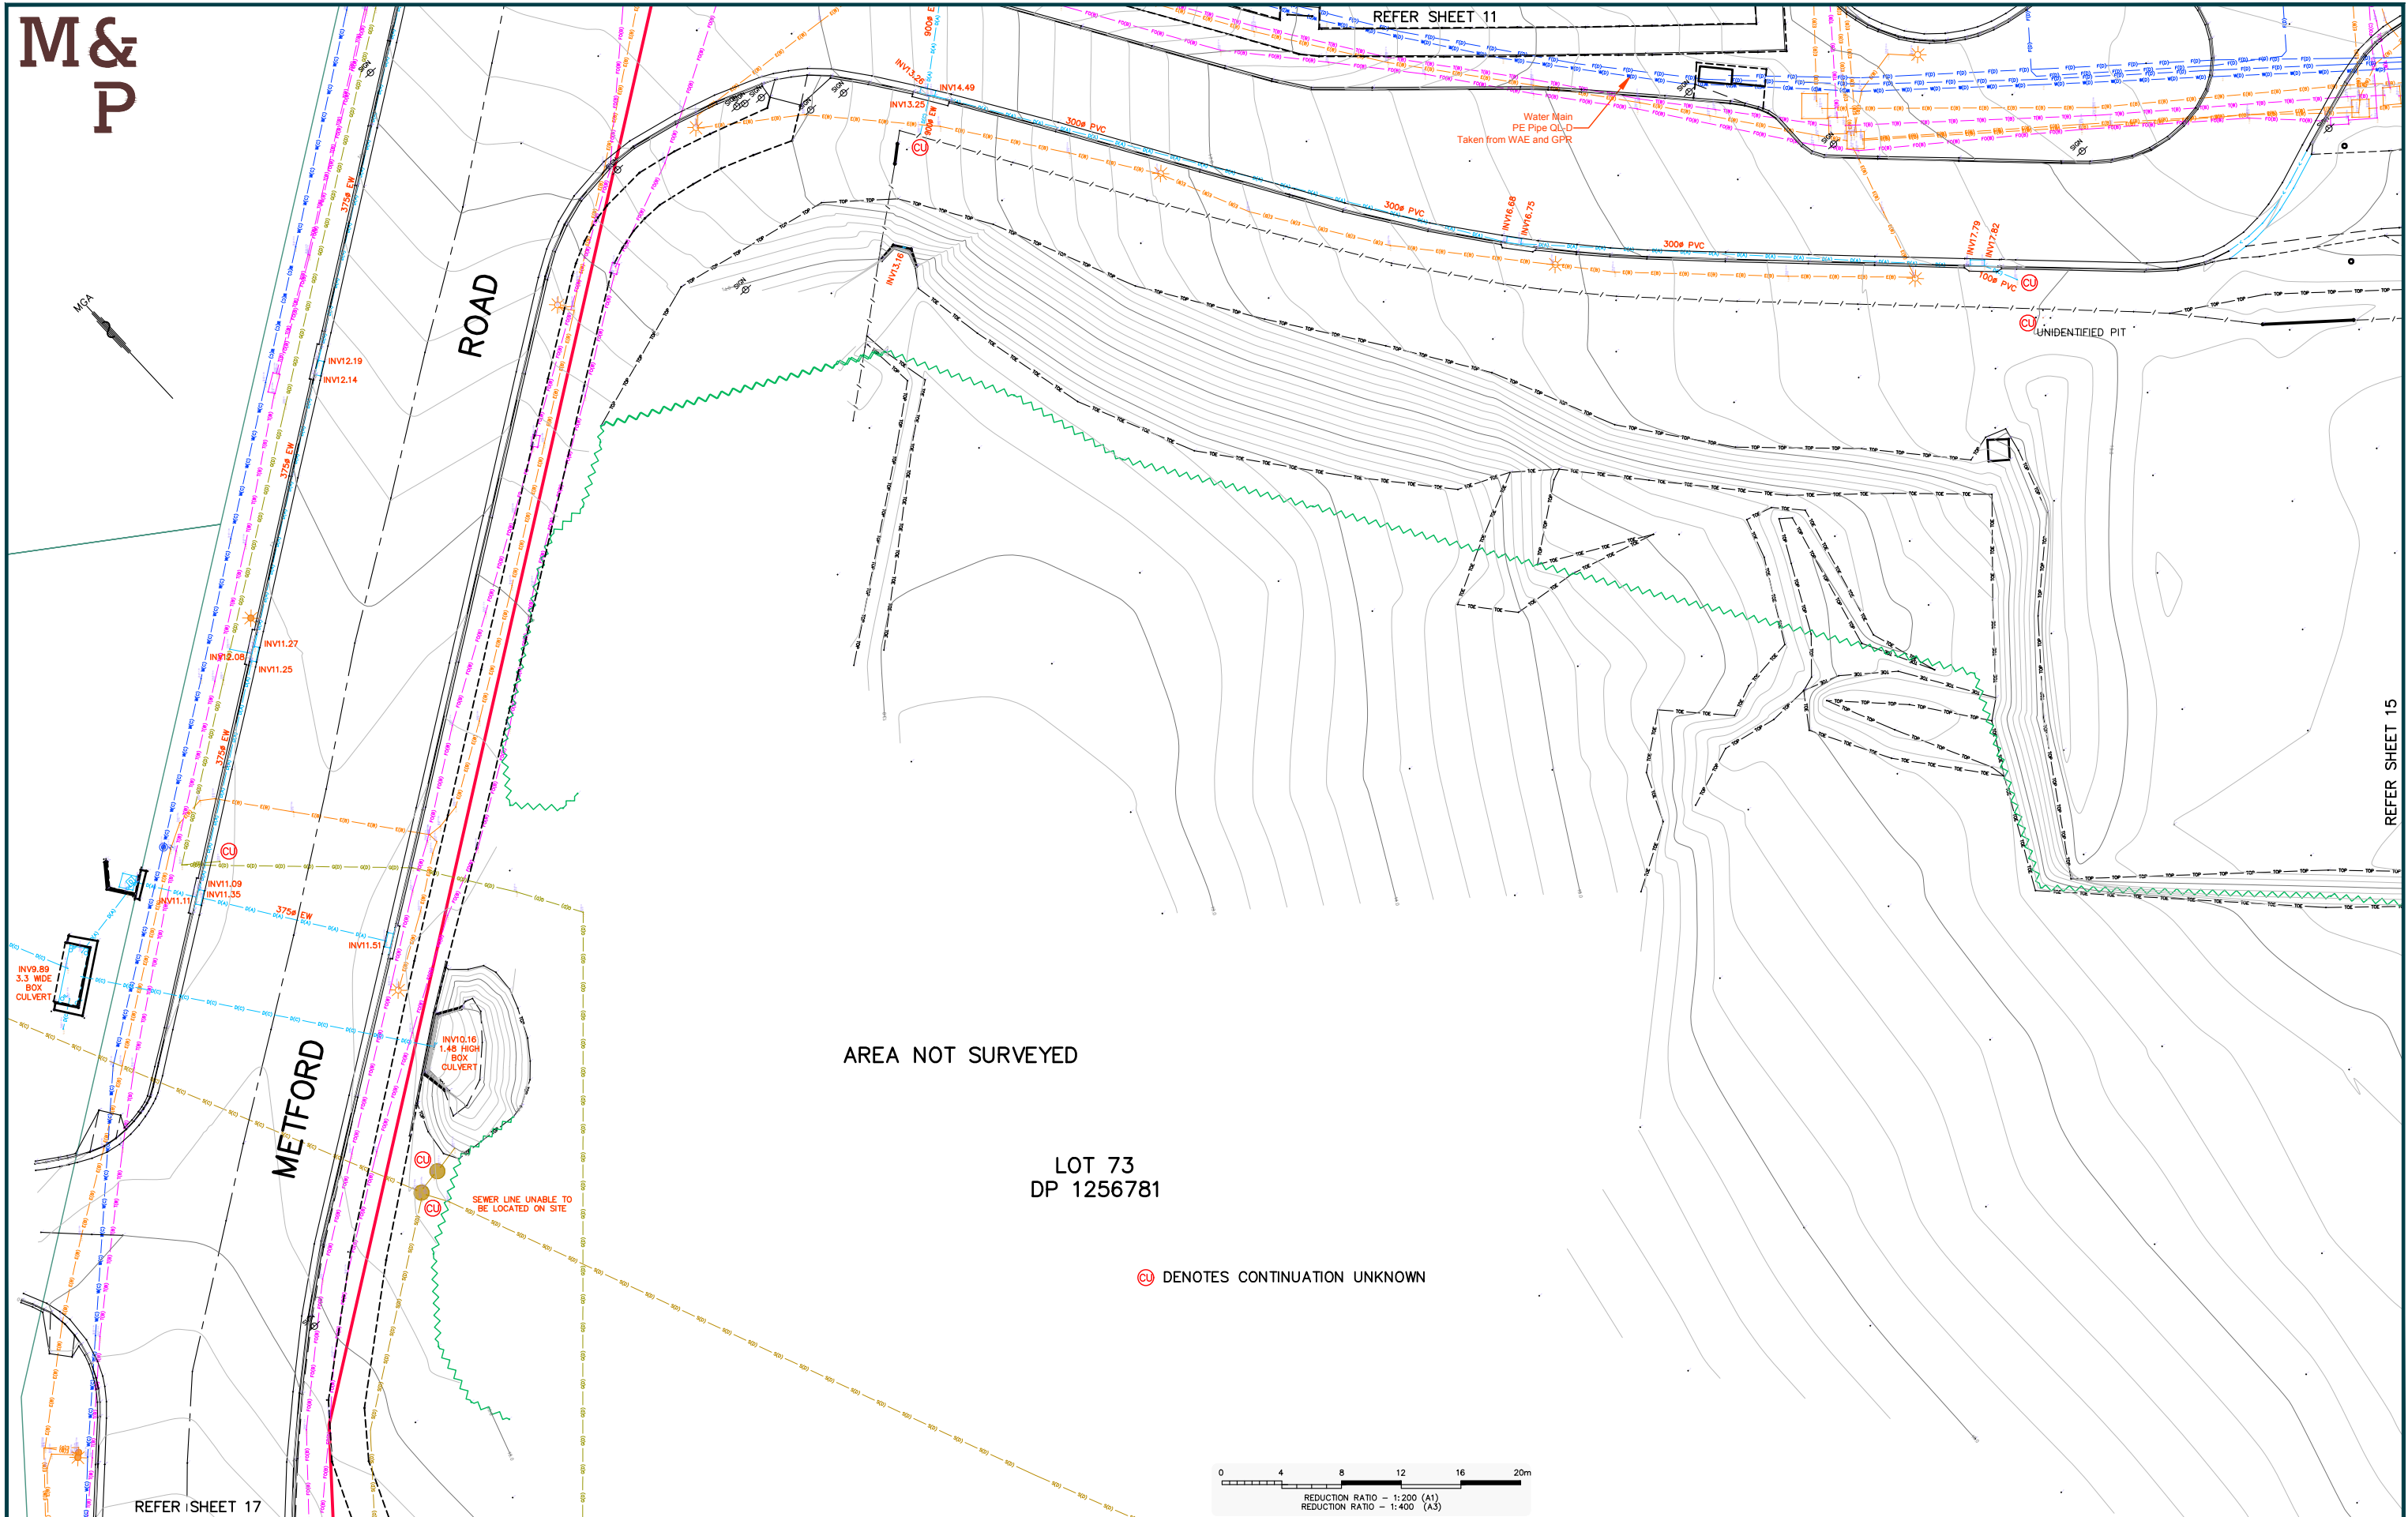

REVISIONS	
-----------	--	--	

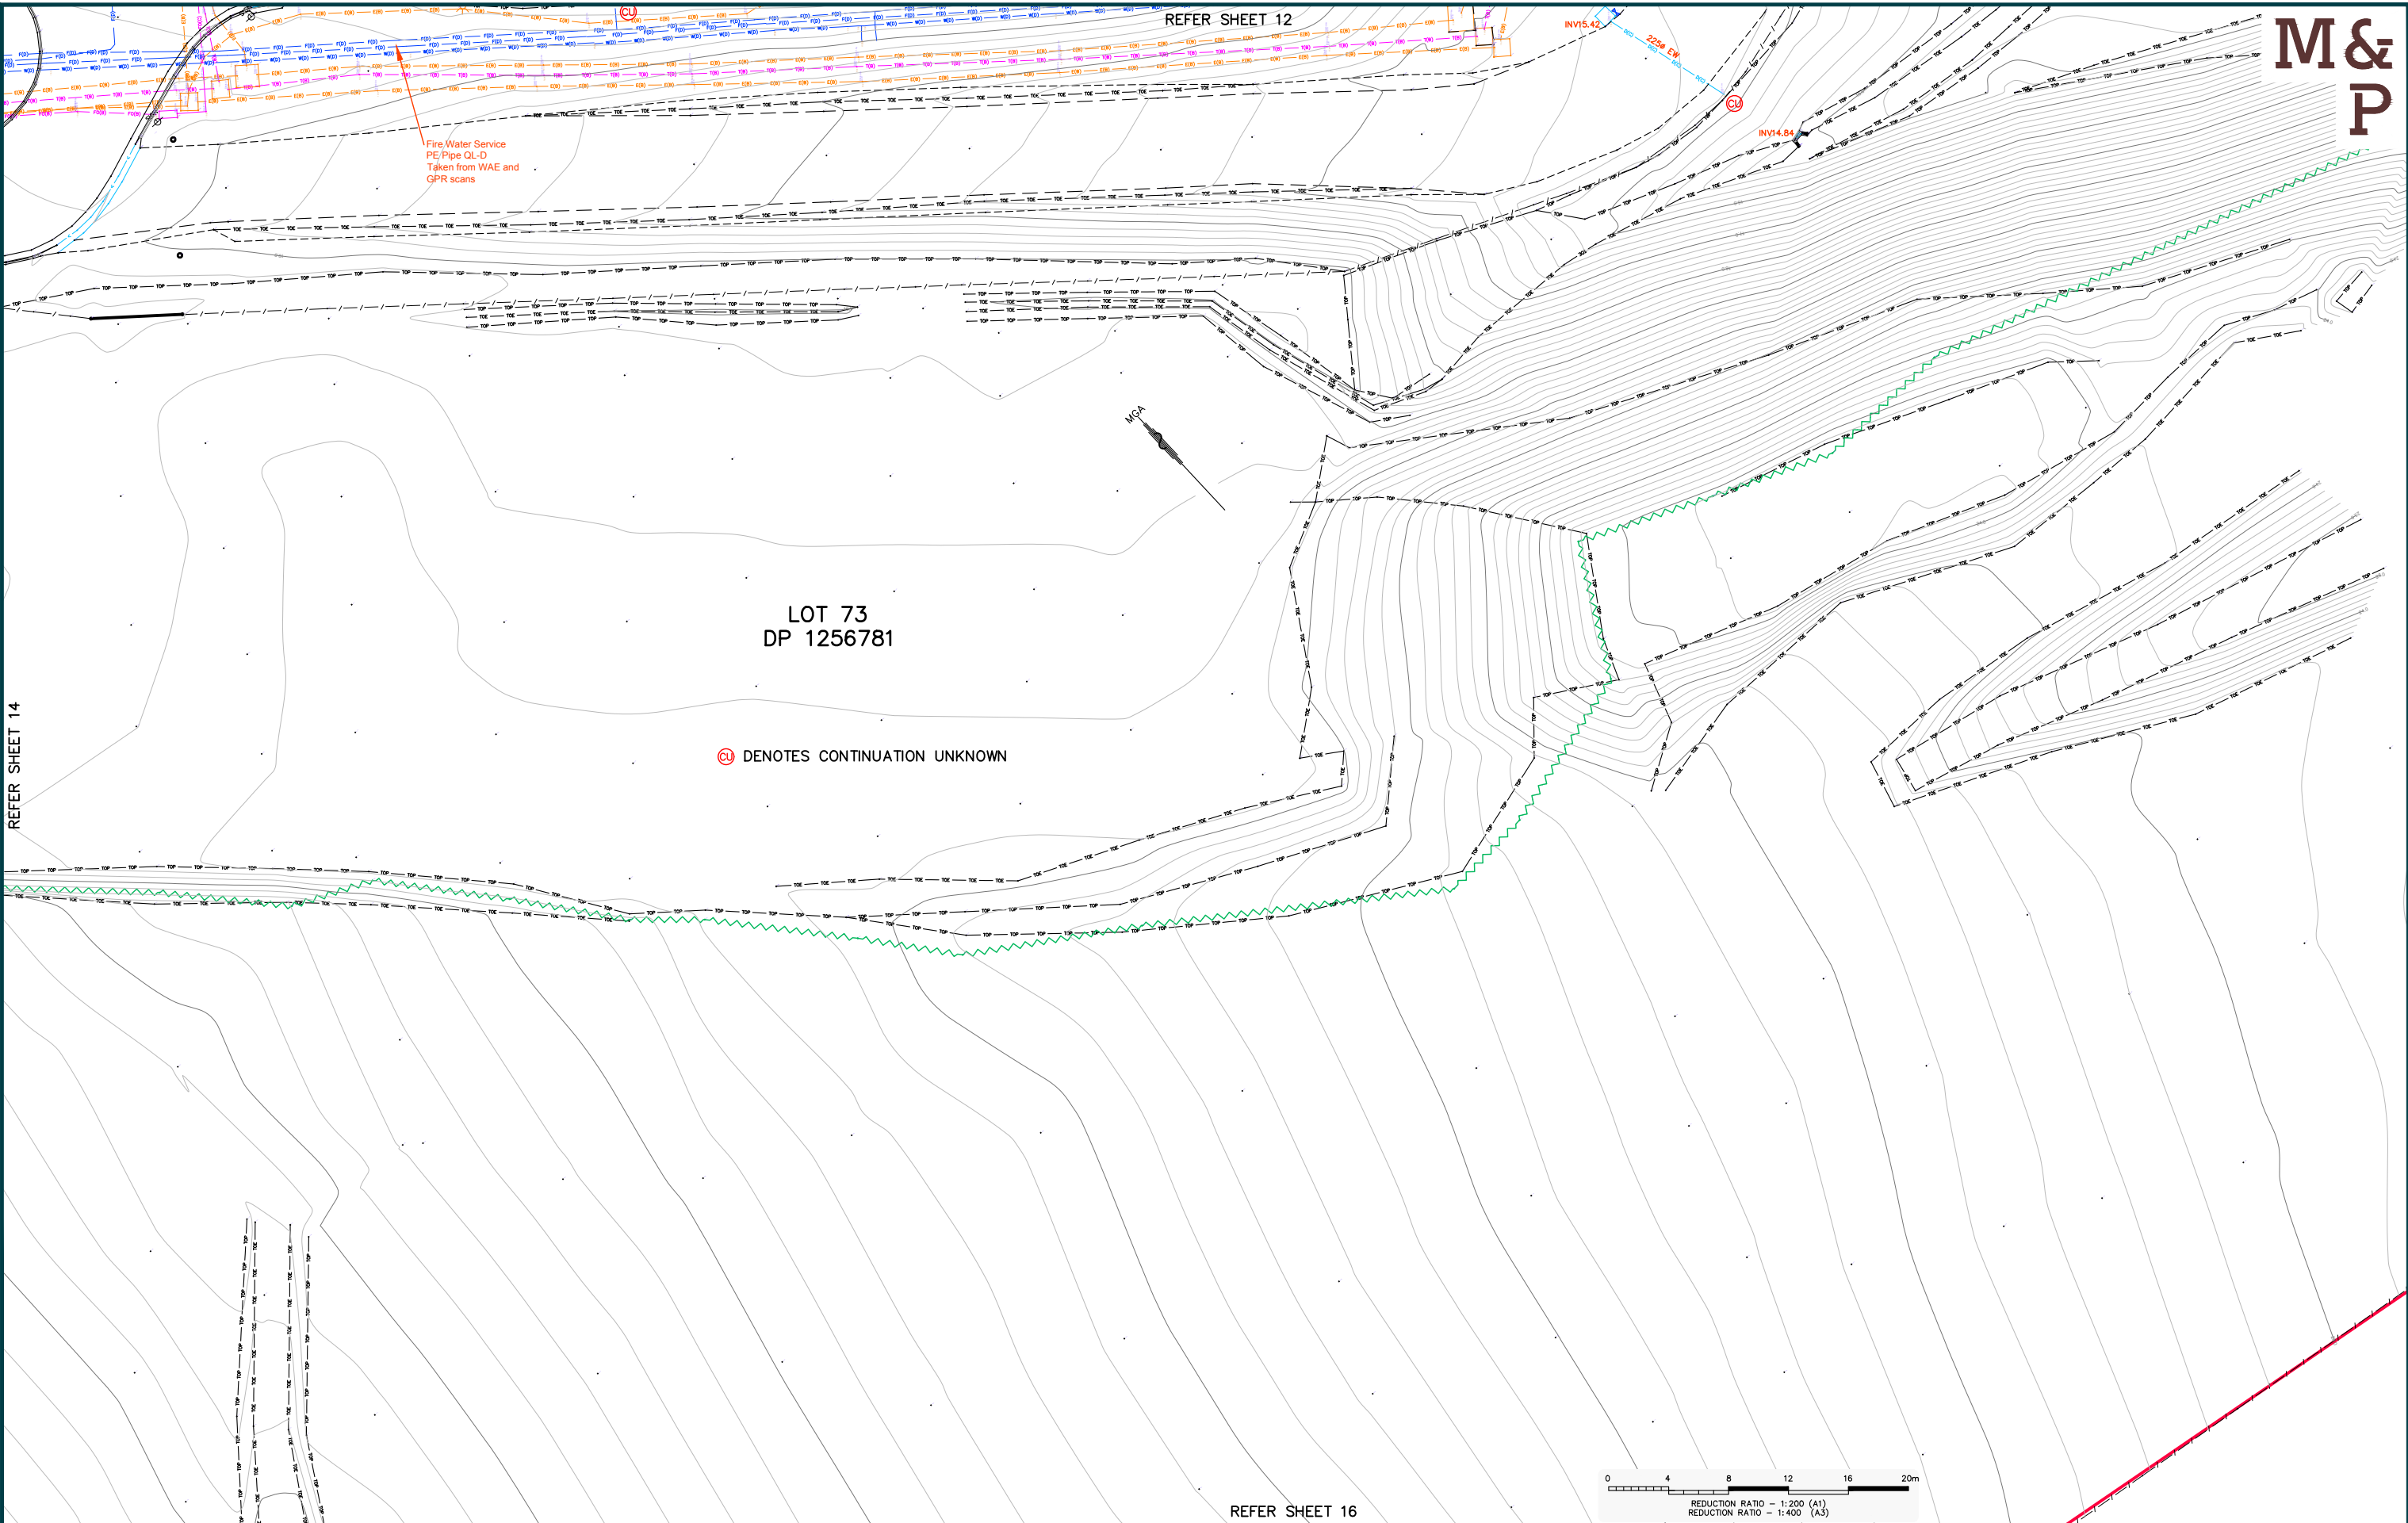

REFER SHEET 14

M&P

LOT 73
DP 1256781

C DENOTES CONTINUATION UNKNOWN

REFER SHEET 16

REVISIONS				
No	REVISION	SVY	DFT	CHK
1	ISSUE TO CLIENT	M&P	MAK	BJB
				21/02/23

COPYRIGHT NOTICE
THIS DOCUMENT REMAINS THE PROPERTY OF
MONTEATH & POWYS PTY LTD. ©

CONDITIONS OF USE.
THIS DOCUMENT MAY ONLY BE USED BY THE CLIENT
FOR THE PURPOSE FOR WHICH IT WAS COMMISSIONED.
USE OF THE DOCUMENT FOR ANY OTHER PURPOSE
IS NOT PERMITTED UNLESS PRIOR WRITTEN APPROVAL
HAS BEEN OBTAINED FROM MONTEATH & POWYS PTY LTD.



PLANNING PROJECT MANAGEMENT SURVEYING 3D SPATIAL

monteathpowys.com.au
P (02) 4926 1388

NEWCASTLE SYDNEY GUNNEDAH MUSWELLBROOK



Surveyed M&P	Drafted MAK	Checked MR	Client CBRE - MAITLAND MENTAL & COMMUNITY HEALTH	Sheet No. 15 / 17
REGISTERED SURVEYOR @A1 : 1:200 @A3 : 1:400			Title DETAIL SURVEY OF LOT 73 DP 1256781 & LOT 41 DP 1274253 MAITLAND HOSPITAL & SURROUNDS METFORD ROAD, METFORD	Revision 1
DO NOT SCALE			CAD File: 220347B_01	Date: 09/01/2023

M&P




A diagram of a needle labeled 'MGA' at the top. The needle has a long, thin shaft and a wider, textured hub in the middle. The tip is pointed.

ADJOINING POWERLINES
NOT LOCATED

CU DENOTES CONTINUATION UNKNOWN

TENNYSON STREET

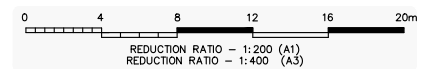[illegible]

CU DENOTES CONTINUATION UNKNOWN

METFORD ROAD

LOT 1
DP 1271463

LOT 73
DP 1256781

ADJOINING POWERLINES
NOT LOCATED

AREA NOT SURVEYED

0 4 8 12 16 20m
REDUCTION RATIO - 1:200 (A1)
REDUCTION RATIO - 1:400 (A3)

REFER ABOVE

REVISIONS						COPYRIGHT NOTICE THIS DOCUMENT REMAINS THE PROPERTY OF MONTEATH & POWYS PTY LTD.
						CONDITIONS OF USE. THIS DOCUMENT MAY ONLY BE USED BY THE CLIENT FOR THE PURPOSE FOR WHICH IT WAS COMMISSIONED. USE OF THE DOCUMENT FOR ANY OTHER PURPOSE IS NOT PERMITTED UNLESS PRIOR WRITTEN APPROVAL HAS BEEN OBTAINED FROM MONTEATH & POWYS PTY LTD.
	1	ISSUE TO CLIENT	M&P	MAK	BJB	21/02/23
	No	REVISION	SVY	DFT	CHK	DATE

PLANNING PROJECT MANAGEMENT SURVEYING 3D SPATIAL

monteathpowys.com.au

P (02) 4926 1388

NEWCASTLE SYDNEY GUNNDAH MUSWELLBROOK

Surveyed M&P	Drafted MAK	Checked MR	Client CBRE - MAITLAND MENTAL & COMMUNITY HEALTH
			Title DETAIL SURVEY OF LOT 73 DP 1256781 & LOT 41 DP 1274253
REGISTERED SURVEYOR			MAITLAND HOSPITAL & SURROUNDS
@A1 : 1:200 @A3 : 1:400			METFORD ROAD, METFORD
DO NOT SCALE			Original Size
			A1
CAD File: 220347B_01		Ref No: 22/0347	Date: 09/01/2023

Sheet No.
17 / 17
 Revision
1