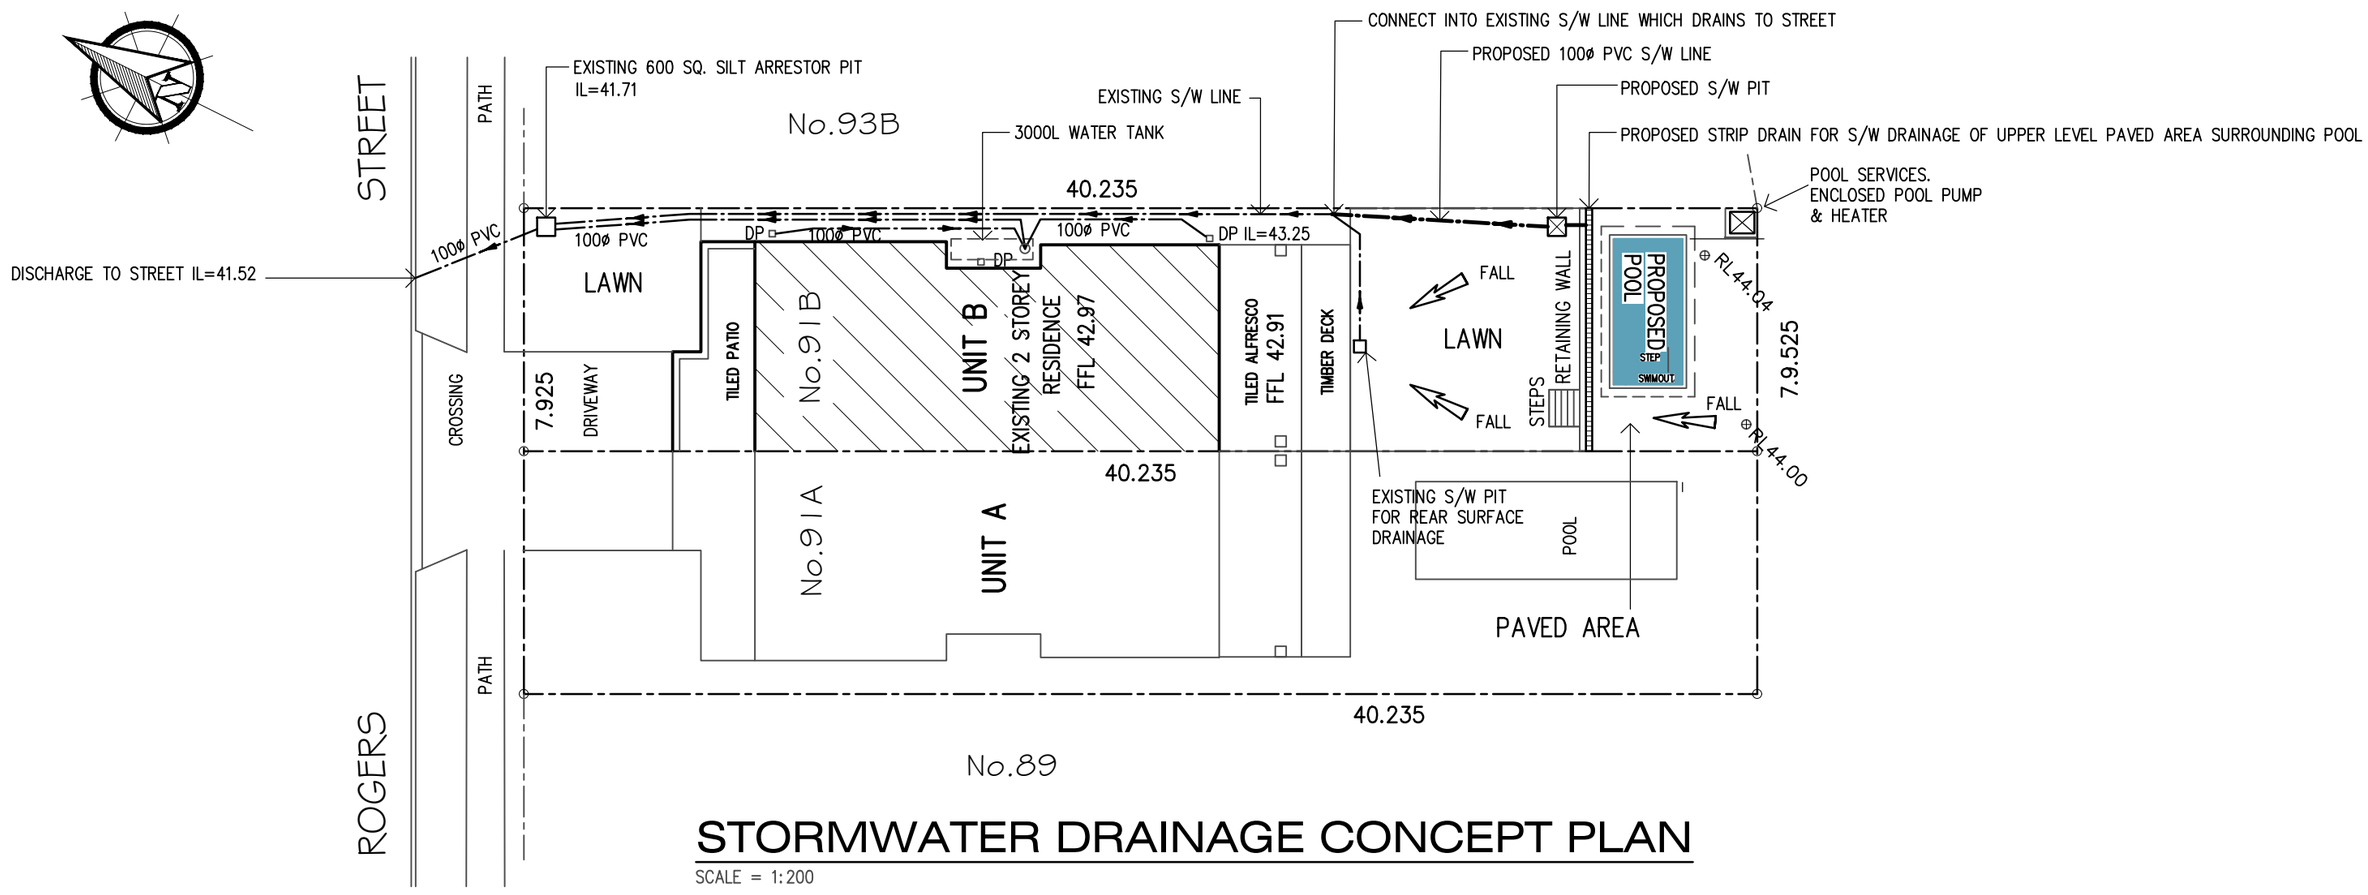

STORMWATER DRAINAGE CONCEPT PLAN

SCALE = 1:200

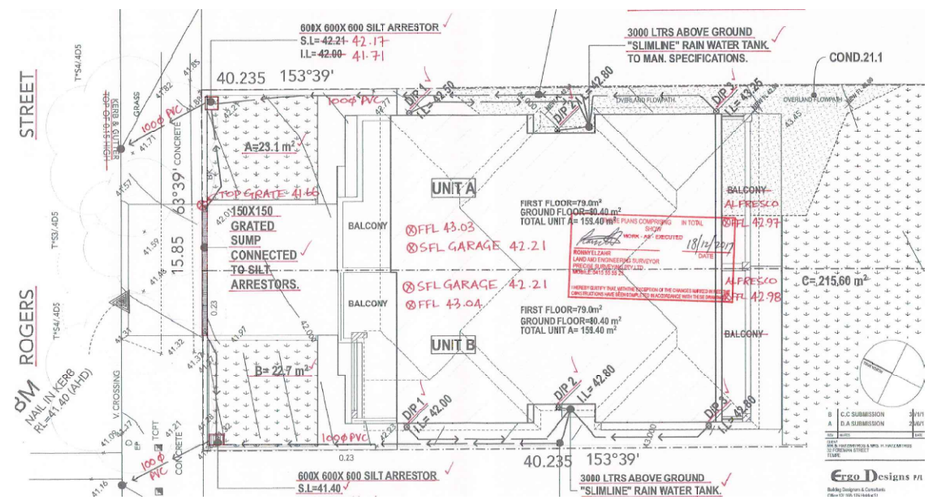

EXISTING STORMWATER DRAINAGE FROM ROOF

EXTRACTED FROM APPROVED PLAN SHOWING AS CONSTRUCTED LEVELS 18/12/2017

REVISIONS		
ISSUE	DATE	DESCRIPTION

© COPYRIGHT COMPUDRAFT PTY. LTD. NO PART OF THIS WORK MAY BE REPRODUCED OR COPIED IN ANY FORM OR BY ANY MEANS WITHOUT THE WRITTEN PERMISSION OF COMPUDRAFT PTY. LIMITED.

FIGURED DIMENSIONS TO BE USED IN PREFERENCE TO SCALING OF DRAWINGS. CONTRACTOR TO VERIFY ALL DIMENSIONS ON SITE & REPORT ANY DISCREPANCY TO THE PRINCIPAL OR HIS DELEGATE BEFORE PROCEEDING WITH THE WORK.

BUILDER

Compudraft Pty Ltd
A.B.N. 59 769 783 493
UNIT 18, 7 ANELLA AVENUE CASTLE HILL NSW 2154
PH (02) 8850-0911 FAX (02) 8850-3511
EMAIL: info compudraft.com.au WEB: www.compudraft.com.au

SCALE	1:200
DATE	19-8-2022
DRAWN	J.H.

PROPOSED SWIMMING POOL AT
91B ROGERS STREET KINGSGROVE
FOR Mr. BILL HATZIMITROS

STORMWATER DRAINAGE CONCEPT PLAN

JOB NUMBER 1156-8

DRAWING NUMBER 6