



fernway
engineering

ABN 38 475 511 899

11 January 2024

Ray Ramadan
RM Designers

RE: Car Parking Review, 33 Russell Street, Greenacre NSW

Fernway Engineering has been engaged by the Applicant to assess the car parking design arrangements for the proposed domestic dwelling at the above address. This letter addresses Council's Request for Information relating to parking design matters.

This assessment pertains to the set of architectural plans prepared by RM Designers, overlayed in **Attachment A**, and the following regulatory design instruments:

- AS2890, Part 1, 3 and 6.

This review and certification process has been undertaken by an industry-recognised traffic engineering professional, the undersigned.



Transportation engineering
and planning.

1300 651 258
info@fernway.net.au
www.fernway.net.au

CBD Melbourne
805/220 Collins St
Melbourne VIC 3000

CBD Sydney
903/50 Clarence St
Sydney NSW 2000

Information Responses

[5] The driveway width will need to be minimum 5.8m according to AS2890.1 2.4 Figure 2.2

The driveway has been widened to 5.8m to meet the Councils request.

[6] Turn table is prohibited within the Council DCP Chapter 3.2 Parking -37.

The turn table has been removed and the parking area has been redesigned accordingly.

[7] Please ensure that vehicles can enter and exit in a front facing manner and provide swept paths generated by a reputable traffic engineer.

A swept path analysis has been undertaken in accordance with the swept path methodology requirements of AS2890.1, Appendix B. This analysis demonstrates that the design vehicle (B85) is able to accomplish the following:

- May access/depart each space in an efficient 3-point manoeuvre
- May access and depart the site in a forward direction
- Maintains a 300mm safety clearance throughout each manoeuvre.

The swept path analysis has been included in **Appendix A (TR-001 & TR-002)**.

[8] Ramp section indicates the first transition calculates to be 17%. Please redesign to comply with AS2890.1 or otherwise demonstrate that no scraping will occur.

The driveway ramp has been modified slightly to minimise the initial changes in gradient to below 12.5%, albeit with 1.5m transition lengths. A scraping test has been carried out as per the methodology AS2890.1, Appendix C. This demonstrates that a B99 vehicle can enter and exit the site without scraping conflicts, thus meeting AS2890 performance requirements for ramp gradients.

The scraping test has been provided in **Appendix A (TR003)**.

Conclusion

Fernway Engineering has reviewed Council's Request for further information. We trust that the information herein addresses these requests to Council's satisfaction.

Should you require any further information, please contact the undersigned.

Yours sincerely,



Christopher J. Saunders
Principal Transport Engineer

Fernway Engineering Pty Ltd

BE (Civil), RPEQ (#24648), MIEAust, M.AITPM

M: 0435 695 866 **E:** chris.saunders@fernway.net.au

APPENDIX A – SWEPT PATH ANALYSIS & GROUND CLEARANCE TEST

PEDESTRIAN SIGHT SPAY:
KEEP ALL FEATURES BELOW 900mm
HEIGHT WITHIN SPLAYS



PEDESTRIAN SIGHT SPAY:
KEEP ALL FEATURES BELOW 900mm
HEIGHT WITHIN SPLAYS



1. THE COPYRIGHT OF THIS DRAWING IS VESTED IN FERNWAY
ENGINEERING AND
IT MAY NOT BE REPRODUCED IN WHOLE OR PART OR USED FOR THE
MANUFACTURE OF ANY ARTICLE WITHOUT THE EXPRESS PERMISSION
OF
THE COPYRIGHT HOLDERS.
2. WORK TO FIGURED DIMENSIONS ONLY.
3. THIS DRAWING IS TO BE READ IN CONJUNCTION WITH ALL
RELEVANT
ARCHITECT'S, SERVICE ENGINEER'S AND FERNWAY ENGINEERING
DRAWINGS
AND SPECIFICATIONS.



	mm
Width	: 1870
Track	: 1770
Lock to Lock Time	: 6.0
Steering Angle	: 34.1




REV:	DESCRIPTION:	BY:	DATE:
STATUS:			



CLIENT:
RM Designers


SITE:
33 Russell St, Greenacre NSW

TITLE:
Swept Path Analysis


SCALE AT A3: 1:200	DATE: 12.1.2024	DRAWN: CS	CHECKED: SP
PROJECT NO: 024-080	DRAWING NO: TR-001		REVISION: B

ENTRY

PEDESTRIAN SIGHT SPPLAY:
KEEP ALL FEATURES BELOW 900mm
HEIGHT WITHIN SPLAYS

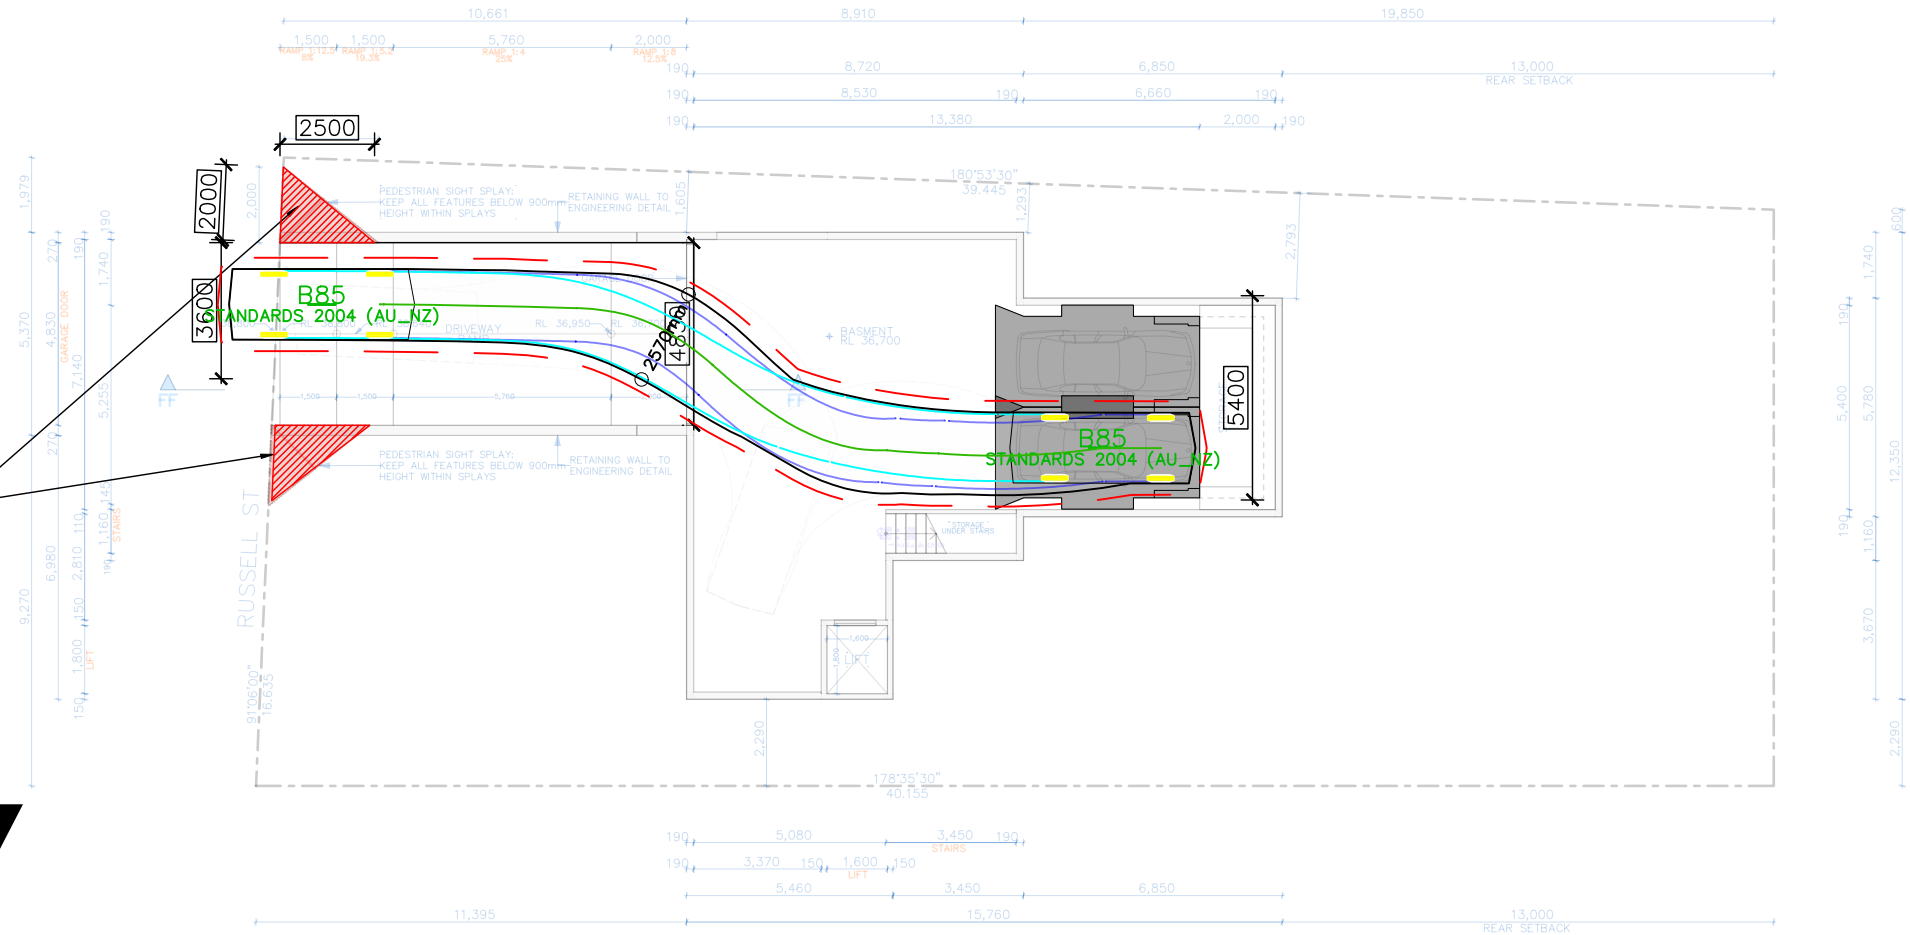


PEDESTRIAN SIGHT SPPLAY:
KEEP ALL FEATURES BELOW 900mm
HEIGHT WITHIN SPLAYS

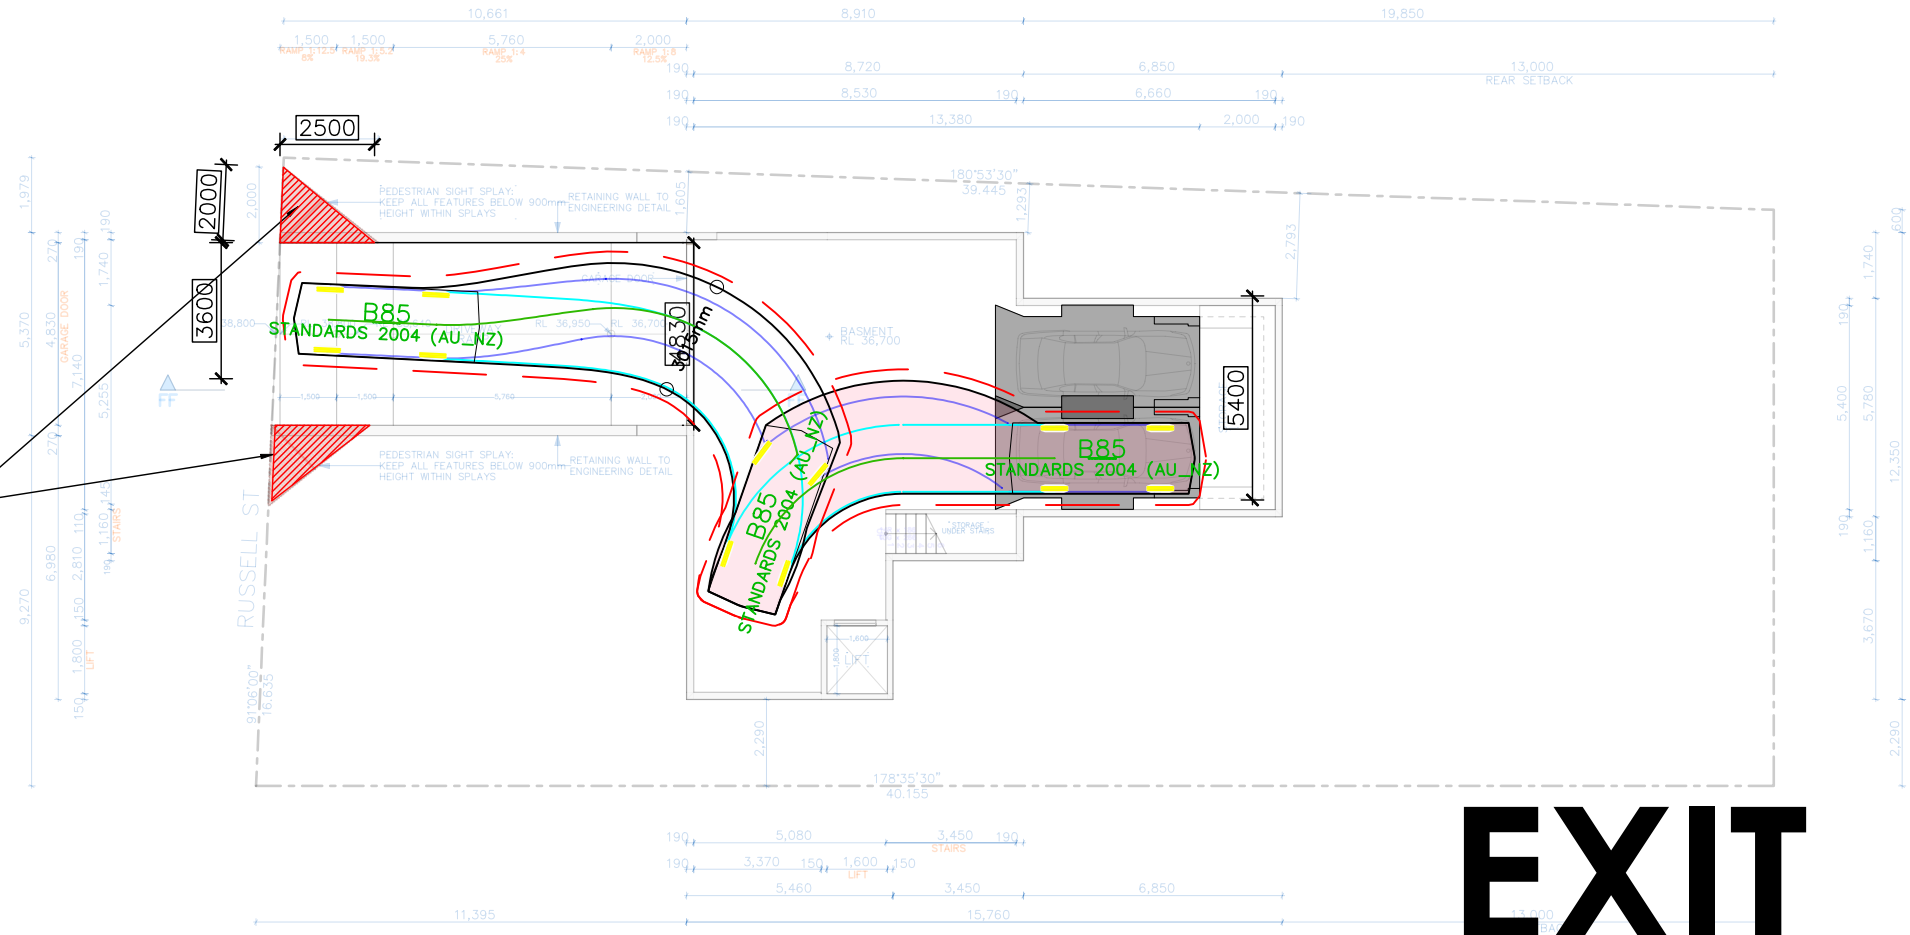

EXIT

Notes:


1. THE COPYRIGHT OF THIS DRAWING IS VESTED IN FERNWAY ENGINEERING AND IT MAY NOT BE REPRODUCED IN WHOLE OR PART OR USED FOR THE MANUFACTURE OF ANY ARTICLE WITHOUT THE EXPRESS PERMISSION OF THE COPYRIGHT HOLDERS.
2. WORK TO FIGURED DIMENSIONS ONLY.
3. THIS DRAWING IS TO BE READ IN CONJUNCTION WITH ALL RELEVANT ARCHITECT'S, SERVICE ENGINEER'S AND FERNWAY ENGINEERING DRAWINGS AND SPECIFICATIONS.

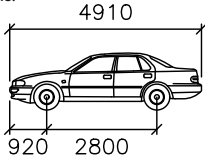


B85

Width : 1870
Track : 1770
Lock to Lock Time : 6.0
Steering Angle : 34.1

FORWARDS

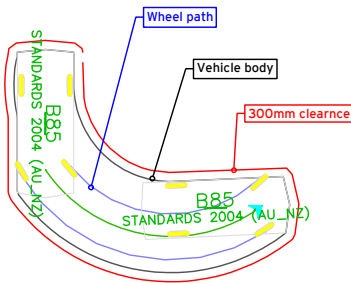

REVERSE

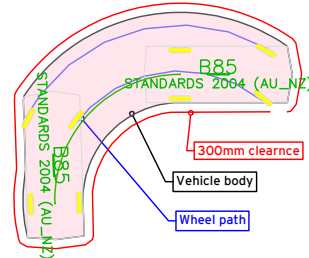

REV:	DESCRIPTION:	BY:	DATE:
STATUS:			



CLIENT:
RM Designers

SITE:
33 Russell St, Greenacre NSW


TITLE:
Swept Path Analysis

SCALE AT A3: 1:200	DATE: 12.1.2024	DRAWN: CS	CHECKED: SP
PROJECT NO: 024-080	DRAWING NO: TR-002	REVISION: B	

B99

Width : 1940 mm
Track : 1840 mm
Lock to Lock Time : 6.0
Steering Angle : 33.9


ENTRY

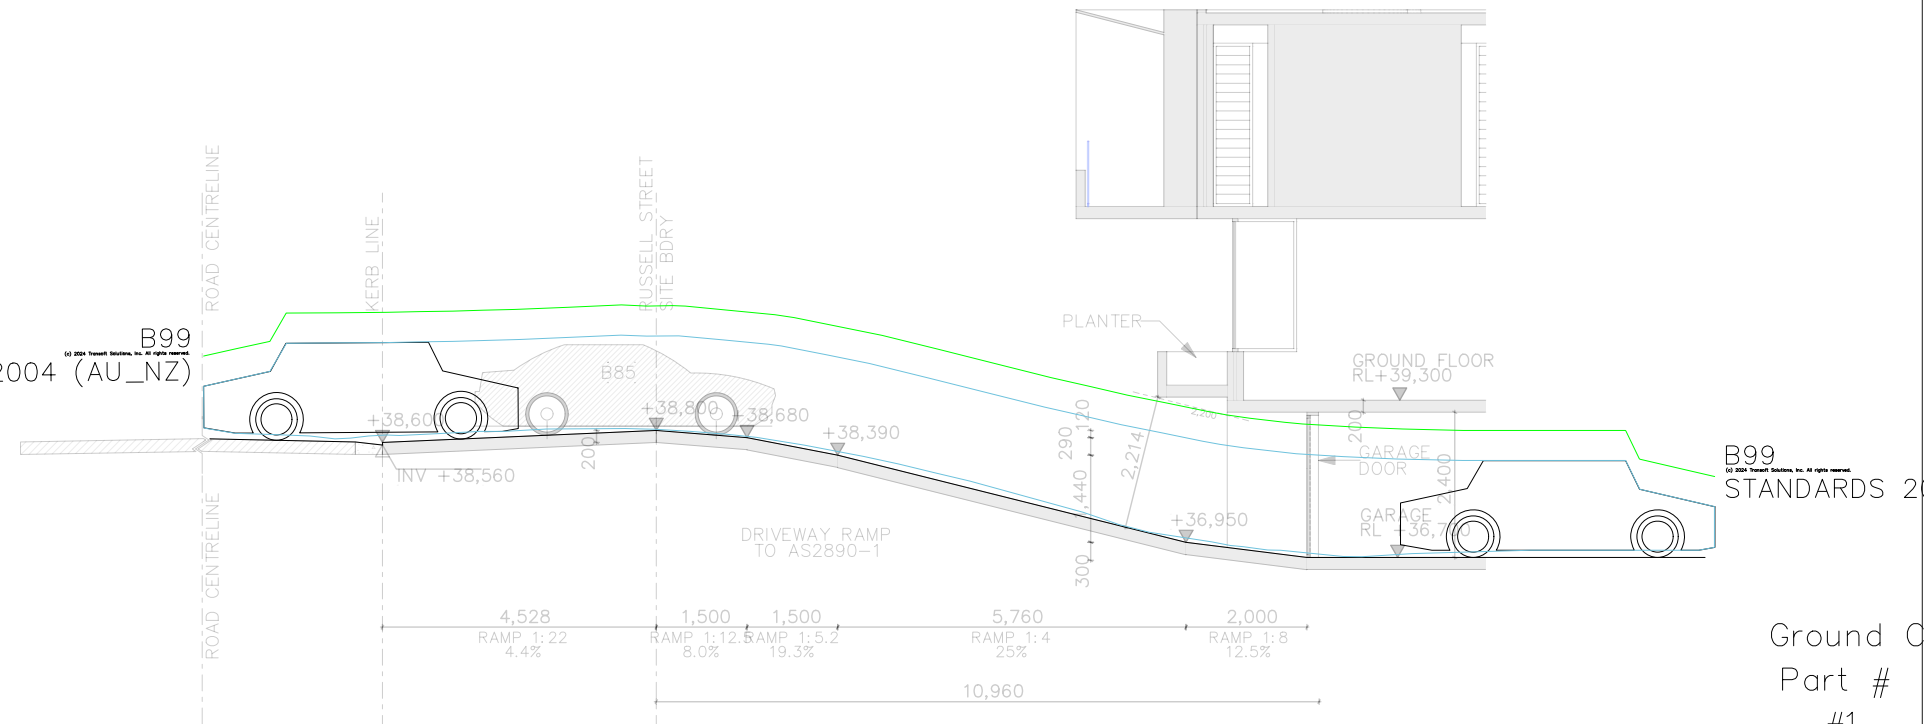


Ground C
Part #
#1

Notes:
1. THE COPYRIGHT OF THIS DRAWING IS VESTED IN FERNWAY ENGINEERING AND IT MAY NOT BE REPRODUCED IN WHOLE OR PART OR USED FOR THE MANUFACTURE OF ANY ARTICLE WITHOUT THE EXPRESS PERMISSION OF THE COPYRIGHT HOLDERS.
2. WORK TO FIGURED DIMENSIONS ONLY.
3. THIS DRAWING IS TO BE READ IN CONJUNCTION WITH ALL RELEVANT ARCHITECT'S, SERVICE ENGINEER'S AND FERNWAY ENGINEERING DRAWINGS AND SPECIFICATIONS.

FORWARDS

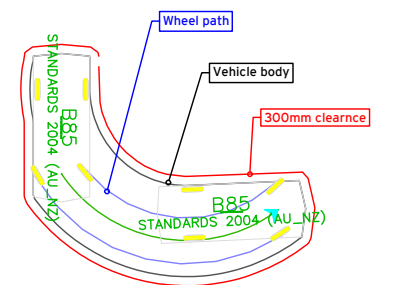

REVERSE

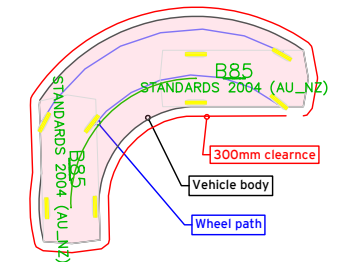

REV:	DESCRIPTION:	BY:	DATE:
STATUS:			



CLIENT:
RM Designers

SITE:
33 Russell St, Greenacre NSW


TITLE:
Ground Clearance Analysis

SCALE AT A3: 1:200	DATE: 12.1.2024	DRAWN: CS	CHECKED: SP
PROJECT NO: 024-080	DRAWING NO: TR-003	REVISION: B	

B99

Width : 1940 mm
Track : 1840 mm
Lock to Lock Time : 6.0
Steering Angle : 33.9

EXIT

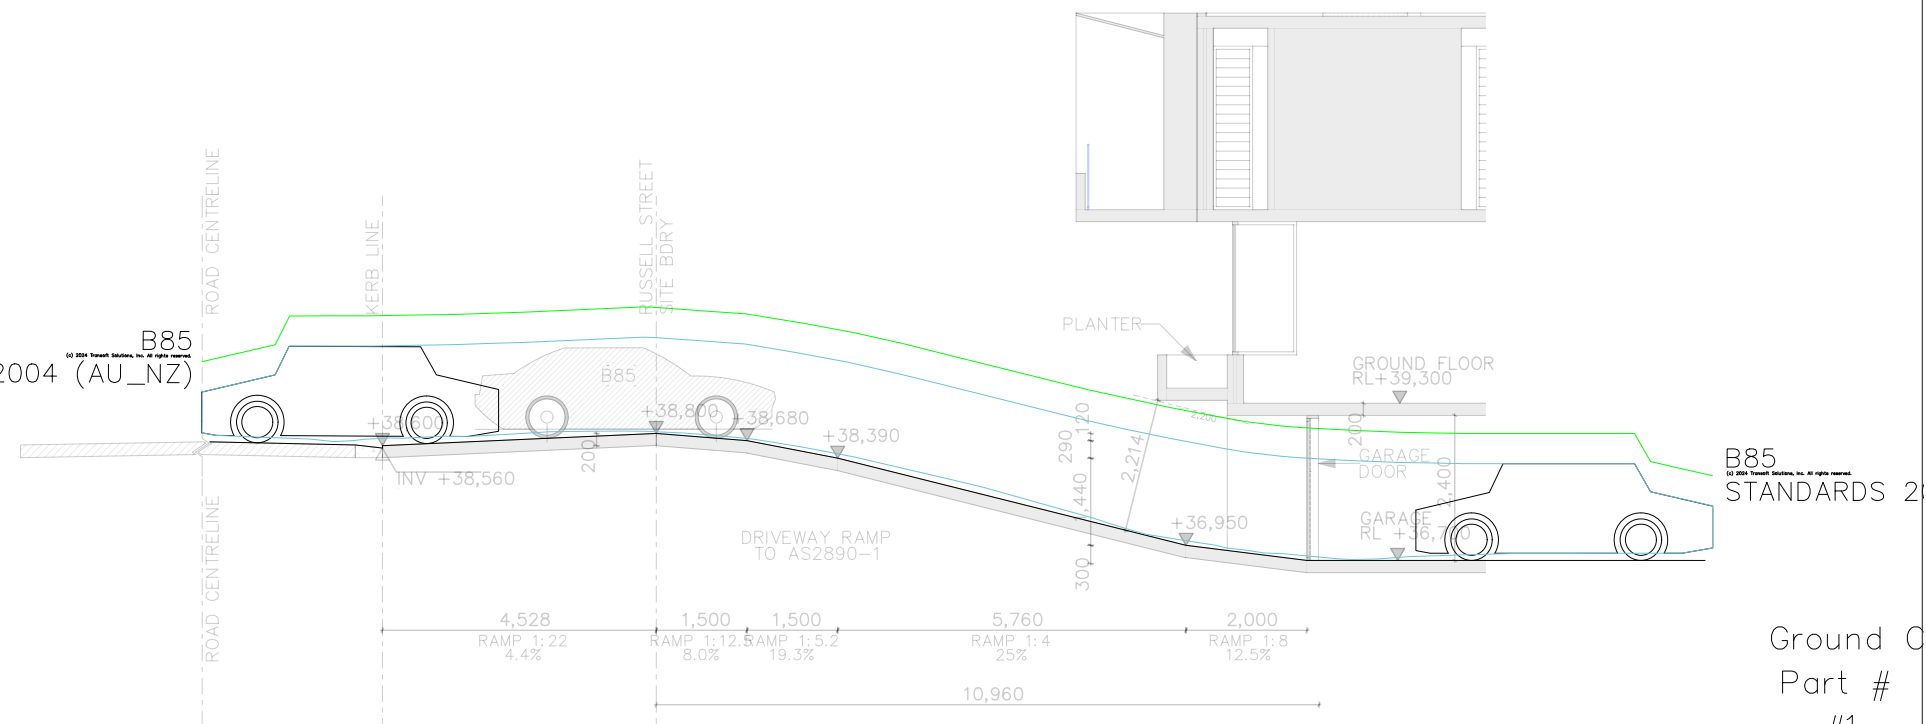

Ground C
Part #
#1