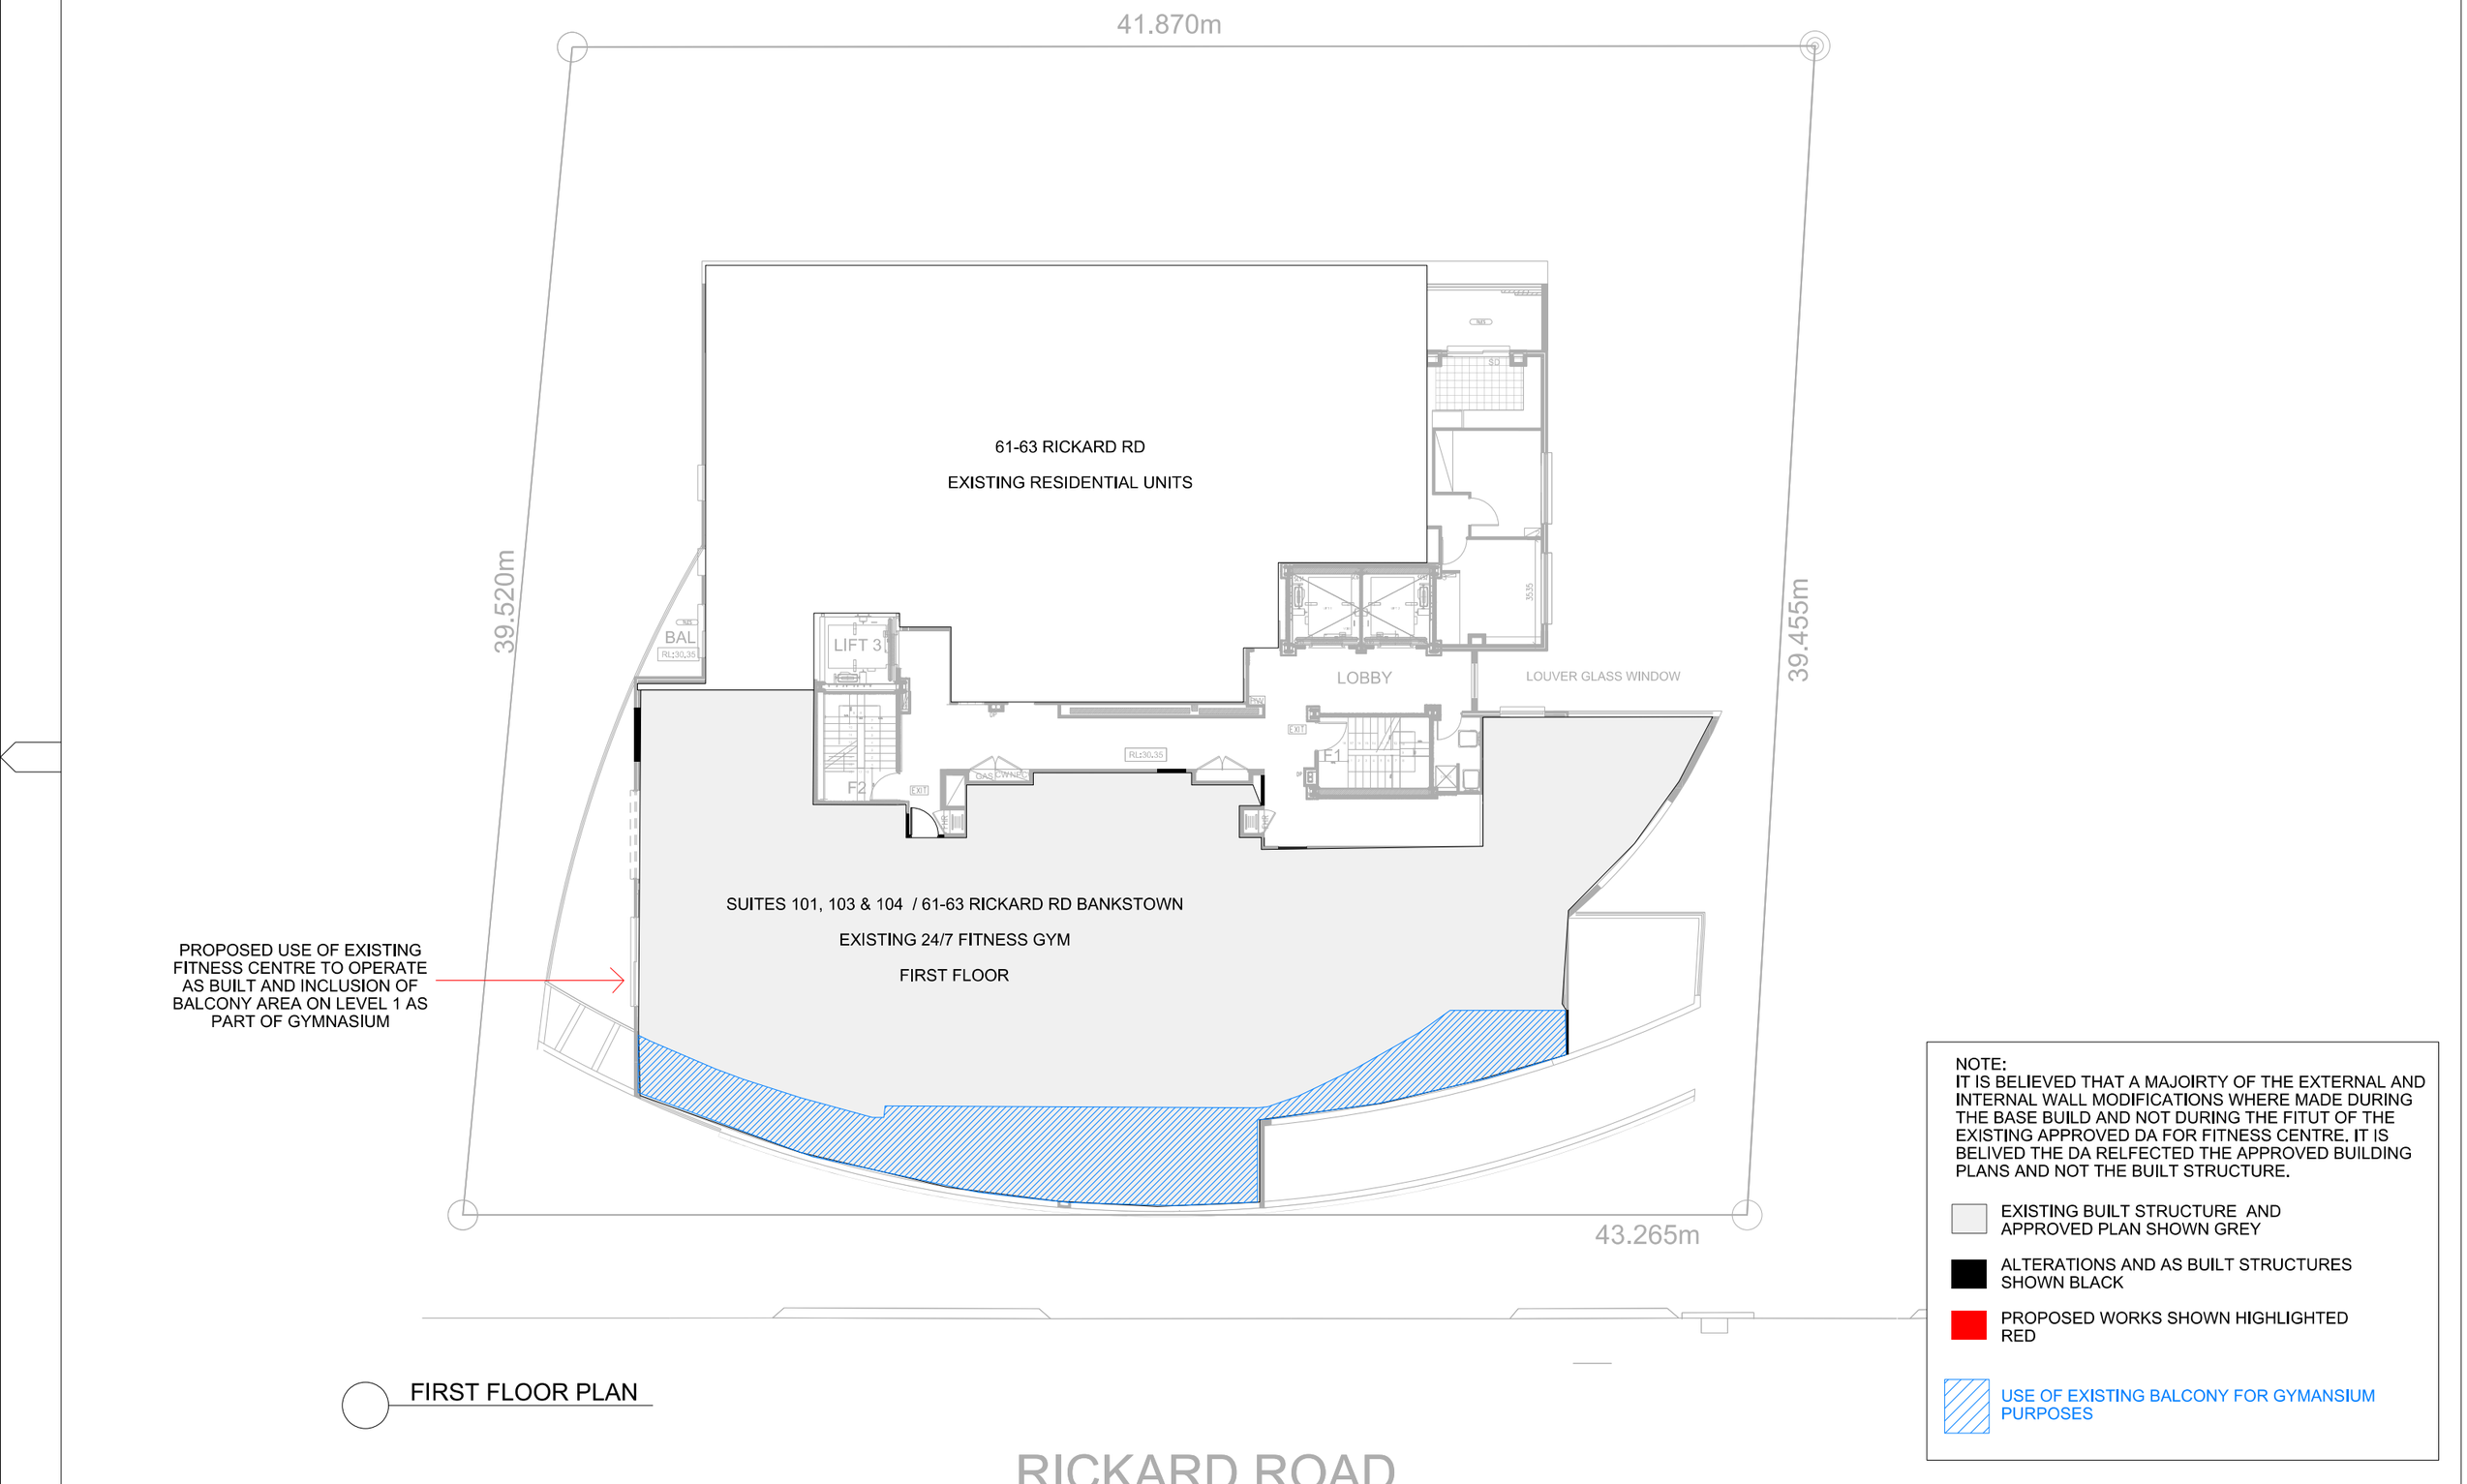

NOTE:
IT IS BELIEVED THAT A MAJOIRTY OF THE EXTERNAL AND INTERNAL WALL MODIFICATIONS WHERE MADE DURING THE BASE BUILD AND NOT DURING THE FITUT OF THE EXISTING APPROVED DA FOR FITNESS CENTRE. IT IS BELIVED THE DA RELFECTED THE APPROVED BUILDING PLANS AND NOT THE BUILT STRUCTURE.

- EXISTING BUILT STRUCTURE AND APPROVED PLAN SHOWN GREY
- ALTERATIONS AND AS BUILT STRUCTURES SHOWN BLACK
- PROPOSED WORKS SHOWN HIGHLIGHTED RED
- USE OF EXISTING BALCONY FOR GYMANSIUM PURPOSES

FIRST FLOOR PLAN

Revisions			
No	Date	Description	App'd
A	22.08.202	ISSUED FOR DA APPROVAL	RE

elkaddesign
inspiration to creation

Do not scale drawings. Use figured dimensions only.
Check & verify levels and dimensions on site prior to the commencement of any work, the preparation of shop drawings or the fabrication of components.
This drawing is the copyright of ELKAD GROUP PTY LTD and is protected under the Copyright Act 1968. Do not alter, reproduce or transmitt in any form, or by any means without the express permission of ELKAD GROUP PTY LTD.

30sqm

DEVELOPMENT APPLICATION

37sqm

0m 1 2 3 4

Project	Drawing Title	Scale	Issue
EXISTING 24/7 FITNESS GYM	DA00.01 NOTIFICATION PLAN FIRST FLOOR PLAN	NTS	A