

634-638 HIGH STREET &  
87-89 UNION ROAD, PENRITH  
STAGE 01 DA



HIGH STREET PENRITH - STAGE 01 DA SUBMISSION

SHEET	NAME	SCALE	Current Revision
AR-1-0001	COVER PAGE & CONTENTS PAGE	N/A	86
AR-1-0100	SITE LOCATION PLAN	1:5000	86
AR-1-0101	EXISTING SITE PLAN	1:500	86
AR-1-0102	STAGING PLAN - NEW BOUNDARY	1:500	86
AR-1-0102A	STAGING PLAN - CONSTRUCTION STAGING DIAGRAM - PLAN	1:500	86
AR-1-0102B	STAGING PLAN - CONSTRUCTION STAGING DIAGRAM - SECTION	1:200	86
AR-1-0103	SITE ANALYSIS	1:500	86
AR-1-0104	CONTEXT ELEVATION - UNION ROAD	1:300	86
AR-1-0105	CONTEXT ELEVATION - HIGH STREET	1:300	86
AR-1-0106	POTENTIAL FUTURE DEVELOPMENT	1:500	86
AR-1-1007	GA FLOOR PLAN - BASEMENT 03	1:200	86
AR-1-1008	GA FLOOR PLAN - BASEMENT 02	1:200	86
AR-1-1009	GA FLOOR PLAN - BASEMENT 01	1:200	86
AR-1-1010	GA FLOOR PLAN - GROUND FLOOR	1:200	86
AR-1-1011	GA FLOOR PLAN - LEVEL 01	1:200	86
AR-1-1012	GA FLOOR PLAN - LEVEL 02	1:200	86
AR-1-1014	GA FLOOR PLAN - LEVEL 03	1:200	86
AR-1-1015	GA FLOOR PLAN - LEVEL 04	1:200	86
AR-1-1016	GA FLOOR PLAN - LEVEL 05	1:200	86
AR-1-1018	GA FLOOR PLAN - LEVEL 06-07	1:200	86
AR-1-1019	GA FLOOR PLAN - LEVEL 08	1:200	86
AR-1-1020	GA FLOOR PLAN - LEVEL 09 - 10	1:200	86
AR-1-1022	GA FLOOR PLAN - LEVEL 11	1:200	86
AR-1-1023	GA FLOOR PLAN - LEVEL 12	1:200	86
AR-1-1024	GA FLOOR PLAN - LEVEL 13	1:200	86
AR-1-1025	GA FLOOR PLAN - LEVEL 14	1:200	86
AR-1-1026	GA FLOOR PLAN - LEVEL 15 - 28	1:200	86
AR-1-1027	GA FLOOR PLAN - LEVEL 29	1:200	86
AR-1-1028	GA FLOOR PLAN - LEVEL 30	1:200	86
AR-1-1029	GA FLOOR PLAN - LEVEL 31	1:200	86
AR-1-1030	GA FLOOR PLAN - LEVEL 32	1:200	86
AR-1-1032	GA FLOOR PLAN - LEVEL 33	1:200	86
AR-1-1033	GA FLOOR PLAN - LEVEL 34	1:200	86
AR-1-1034	GA FLOOR PLAN - LEVEL 35	1:200	86
AR-1-1038	GA FLOOR PLAN - ROOF	1:200	86
AR-1-1101	LIVEABLE UNITS	1:50	86
AR-1-1102	ADAPTABLE UNITS - BUILDING 01	1:50	86
AR-1-1103	ADAPTABLE UNITS - BUILDING 02	1:50	86
AR-1-5000	NORTH & SOUTH ELEVATION	1:250	86
AR-1-5001	EAST ELEVATION	1:250	86
AR-1-5002	WEST ELEVATION	1:250	86
AR-1-5004	NORTH & SOUTH PODIUM ELEVATIONS	1:250	86
AR-1-5010	SITE LINK ELEVATIONS	1:100	86
AR-1-5100	SECTION A-A	1:250	86
AR-1-5201	PODIUM FACADE DETAILS	1:50	86
AR-1-5202	BUILDING 02 - FACADE DETAILS	1:50	86
AR-1-5203	EXTERNAL FINISHES BOARD	1:50	86
AR-1-8010	GFA CALCULATIONS - SHEET 01	1:450	86
AR-1-8011	GFA CALCULATIONS - SHEET 02	1:450	86
AR-1-8012	GFA CALCULATIONS - SHEET 03	1:450	86
AR-1-8030	COMMUNAL OPEN SPACE AREA	1:200	86
AR-1-8031	DEEP SOIL AREA	1:200	86
AR-1-8040	CROSS VENTILATION ANALYSIS - UP TO LEVEL 08	1:500	86
AR-1-8050	SOLAR ANALYSIS - SHEET 01	1:500	86
AR-1-8051	SOLAR ANALYSIS - SHEET 02	1:500	86
AR-1-8052	SOLAR VIEWS - SHEET 01	1:700	86
AR-1-8053	SOLAR VIEWS - SHEET 02	1:700	86
AR-1-8060	SHADOW ANALYSIS - 21 JUNE - 9am & 10am	1:1000	86
AR-1-8062	SHADOW ANALYSIS - 21 JUNE - 11am & 12pm	1:1000	86
AR-1-8064	SHADOW ANALYSIS - 21 JUNE - 1pm & 2pm	1:1000	86
AR-1-8066	SHADOW ANALYSIS - 21 JUNE - 3pm	1:1000	86
AR-1-9000	ARTIST IMPRESSION - SHEET 01	N/A	86
AR-1-9001	ARTIST IMPRESSION - SHEET 02	N/A	86
AR-1-9002	ARTIST IMPRESSION - SHEET 03	N/A	86
AR-1-9003	ARTIST IMPRESSION - SHEET 04	N/A	86
AR-1-9004	ARTIST IMPRESSION - SHEET 01	N/A	86
AR-1-9005	ARTIST IMPRESSION - SHEET 06	N/A	86
AR-1-9030	ADG COMPLIANCE PLAN - BLDG 1 TYPICAL PLAN	1:50	86
AR-1-9031	ADG COMPLIANCE PLAN - BLDG 2 TYPICAL PLAN	1:50	86

69

CHANGE SUMMARY

- a. Podium - reduction in the scale of the podium from 5 storeys to 4 storeys in the middle section and 2 storeys at the northern and southern ends; decrease in the number of car parking spaces provided within the podium; increased 'sleeving' of car parking provided in the podium with apartments; and enhanced articulation
- b. Basement - increased basement car parking from 1 to 3 levels
- c. Ground level - enhanced activation of the ground floor through relocation of the through site pedestrian link, redistributing and enlarging commercial floorspace, providing stepped sitting edges to the western colonnade facing John Tipping Grove, and increased landscaping.
- d. Levels 1 to 3 – increased activation and connection to ground level through additional apartments and enhanced design of communal open space area.
- e. Towers - reduction in the height of Tower 2 from 37 to 35 storeys, reduction in height of Tower 1 from 14 storeys to 13 storeys, and redesign to increase building articulation.

In accepting and utilising this document the recipient agrees that SJB Architecture (NSW) Pty. Ltd. ACN 081 094 724 T/A SJB Architects, retain all common law, statutory law and other rights including copyright and intellectual property rights. The recipient agrees not to use this document for any purpose other than its intended use; to waive all claims against SJB Architects resulting from unauthorised changes; or to reuse the document on other projects without the prior written consent of SJB Architects. Under no circumstances shall transfer of this document be deemed a sale. SJB Architects makes no warranties of fitness for any purpose. The Builder/Contractor shall verify job dimensions prior to any work commencing. Use figured dimensions only. Do not scale drawings.

Nominated Architects: Adam Haddow-7188 | John Pradel-7004

FOR APPROVAL

Rev	Date	Revision
66	24.01.2020	PRELIMINARY ISSUE
81	28.02.2020	DRAFT DA ISSUE
83	04.03.2020	ISSUED FOR DA
85	07.05.2021	ISSUED FOR DA
86	04.10.2021	ISSUED FOR LEC

Structural Engineer	ROBERT BIRD GROUP
Mechanical / Hydraulic Engineer	JHA CONSULTING ENGINEERS
Electrical Engineer	JHA CONSULTING ENGINEERS
Fire Engineer	OLSSON FIRE & RISK
Access Consultant	ACCESSIBLE BUILDING SOLUTIONS
Basix	EMF GRIFFITHS
Building Key	

Client



Project

HIGH ST DEVELOPMENT

634-638 HIGH ST & 87-89  
UNION RD, PENRITH

Drawing Name

COVER PAGE & CONTENTS  
PAGE

Date	Scale	Sheet Size
04.10.2021	1 : 1	@ A1

Drawn	Chk.
GT	MG

Job No.	Drawing No.	Revision
6111	AR-1-0001	/86

SJB Architects  
Level 2  
490 Crown Street  
Surry Hills NSW  
2010 Australia  
T 61 2 9380 9911  
F 61 2 9380 9922  
www.sjb.com.au







In accepting and utilising this document the recipient agrees that SJB Architecture (NSW) Pty. Ltd. ACN 081 094 724 T/A SJB Architects, retain all common law, statutory law and other rights including copyright and intellectual property rights. The recipient agrees not to use this document for any purpose other than its intended use, to waive all claims against SJB Architects resulting from unauthorised changes; or to reuse the document on other projects without the prior written consent of SJB Architects. Under no circumstances shall transfer of this document be deemed a sale. SJB Architects makes no warranties of fitness for any purpose. The Builder/Contractor shall verify job dimensions prior to any work commencing. Use figured dimensions only. Do not scale drawings.

Nominated Architects: Adam Haddow-7188 | John Pradel-7004

FOR APPROVAL

Rev	Date	Revision
66	24.01.2020	PRELIMINARY ISSUE
81	28.02.2020	DRAFT DA ISSUE
83	04.03.2020	ISSUED FOR DA
85	07.05.2021	ISSUED FOR DA
86	04.10.2021	ISSUED FOR LEC

Structural Engineer  
ROBERT BIRD GROUP

Mechanical / Hydraulic Engineer  
JHA CONSULTING ENGINEERS

Electrical Engineer  
JHA CONSULTING ENGINEERS

Fire Engineer  
OLSSON FIRE & RISK

Access Consultant  
ACCESSIBLE BUILDING SOLUTIONS

Basix  
EMF GRIFFITHS

Building Key

Site Boundary (TOGA Owned)


Client



Project  
HIGH ST DEVELOPMENT

634-638 HIGH ST & 87-89  
UNION RD, PENRITH

Drawing Name  
SITE LOCATION PLAN

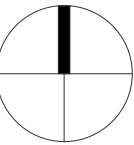

Date	Scale	Sheet Size
04.10.2021	As indicated	@ A1


Drawn	Chk.
GT	MG

Job No.	Drawing No.	Revision
6111	AR-1-0100	/86

SJB Architects  
Level 2  
490 Crown Street  
Surry Hills NSW  
2010 Australia  
T 61 2 9380 9911  
F 61 2 9380 9922  
www.sjb.com.au





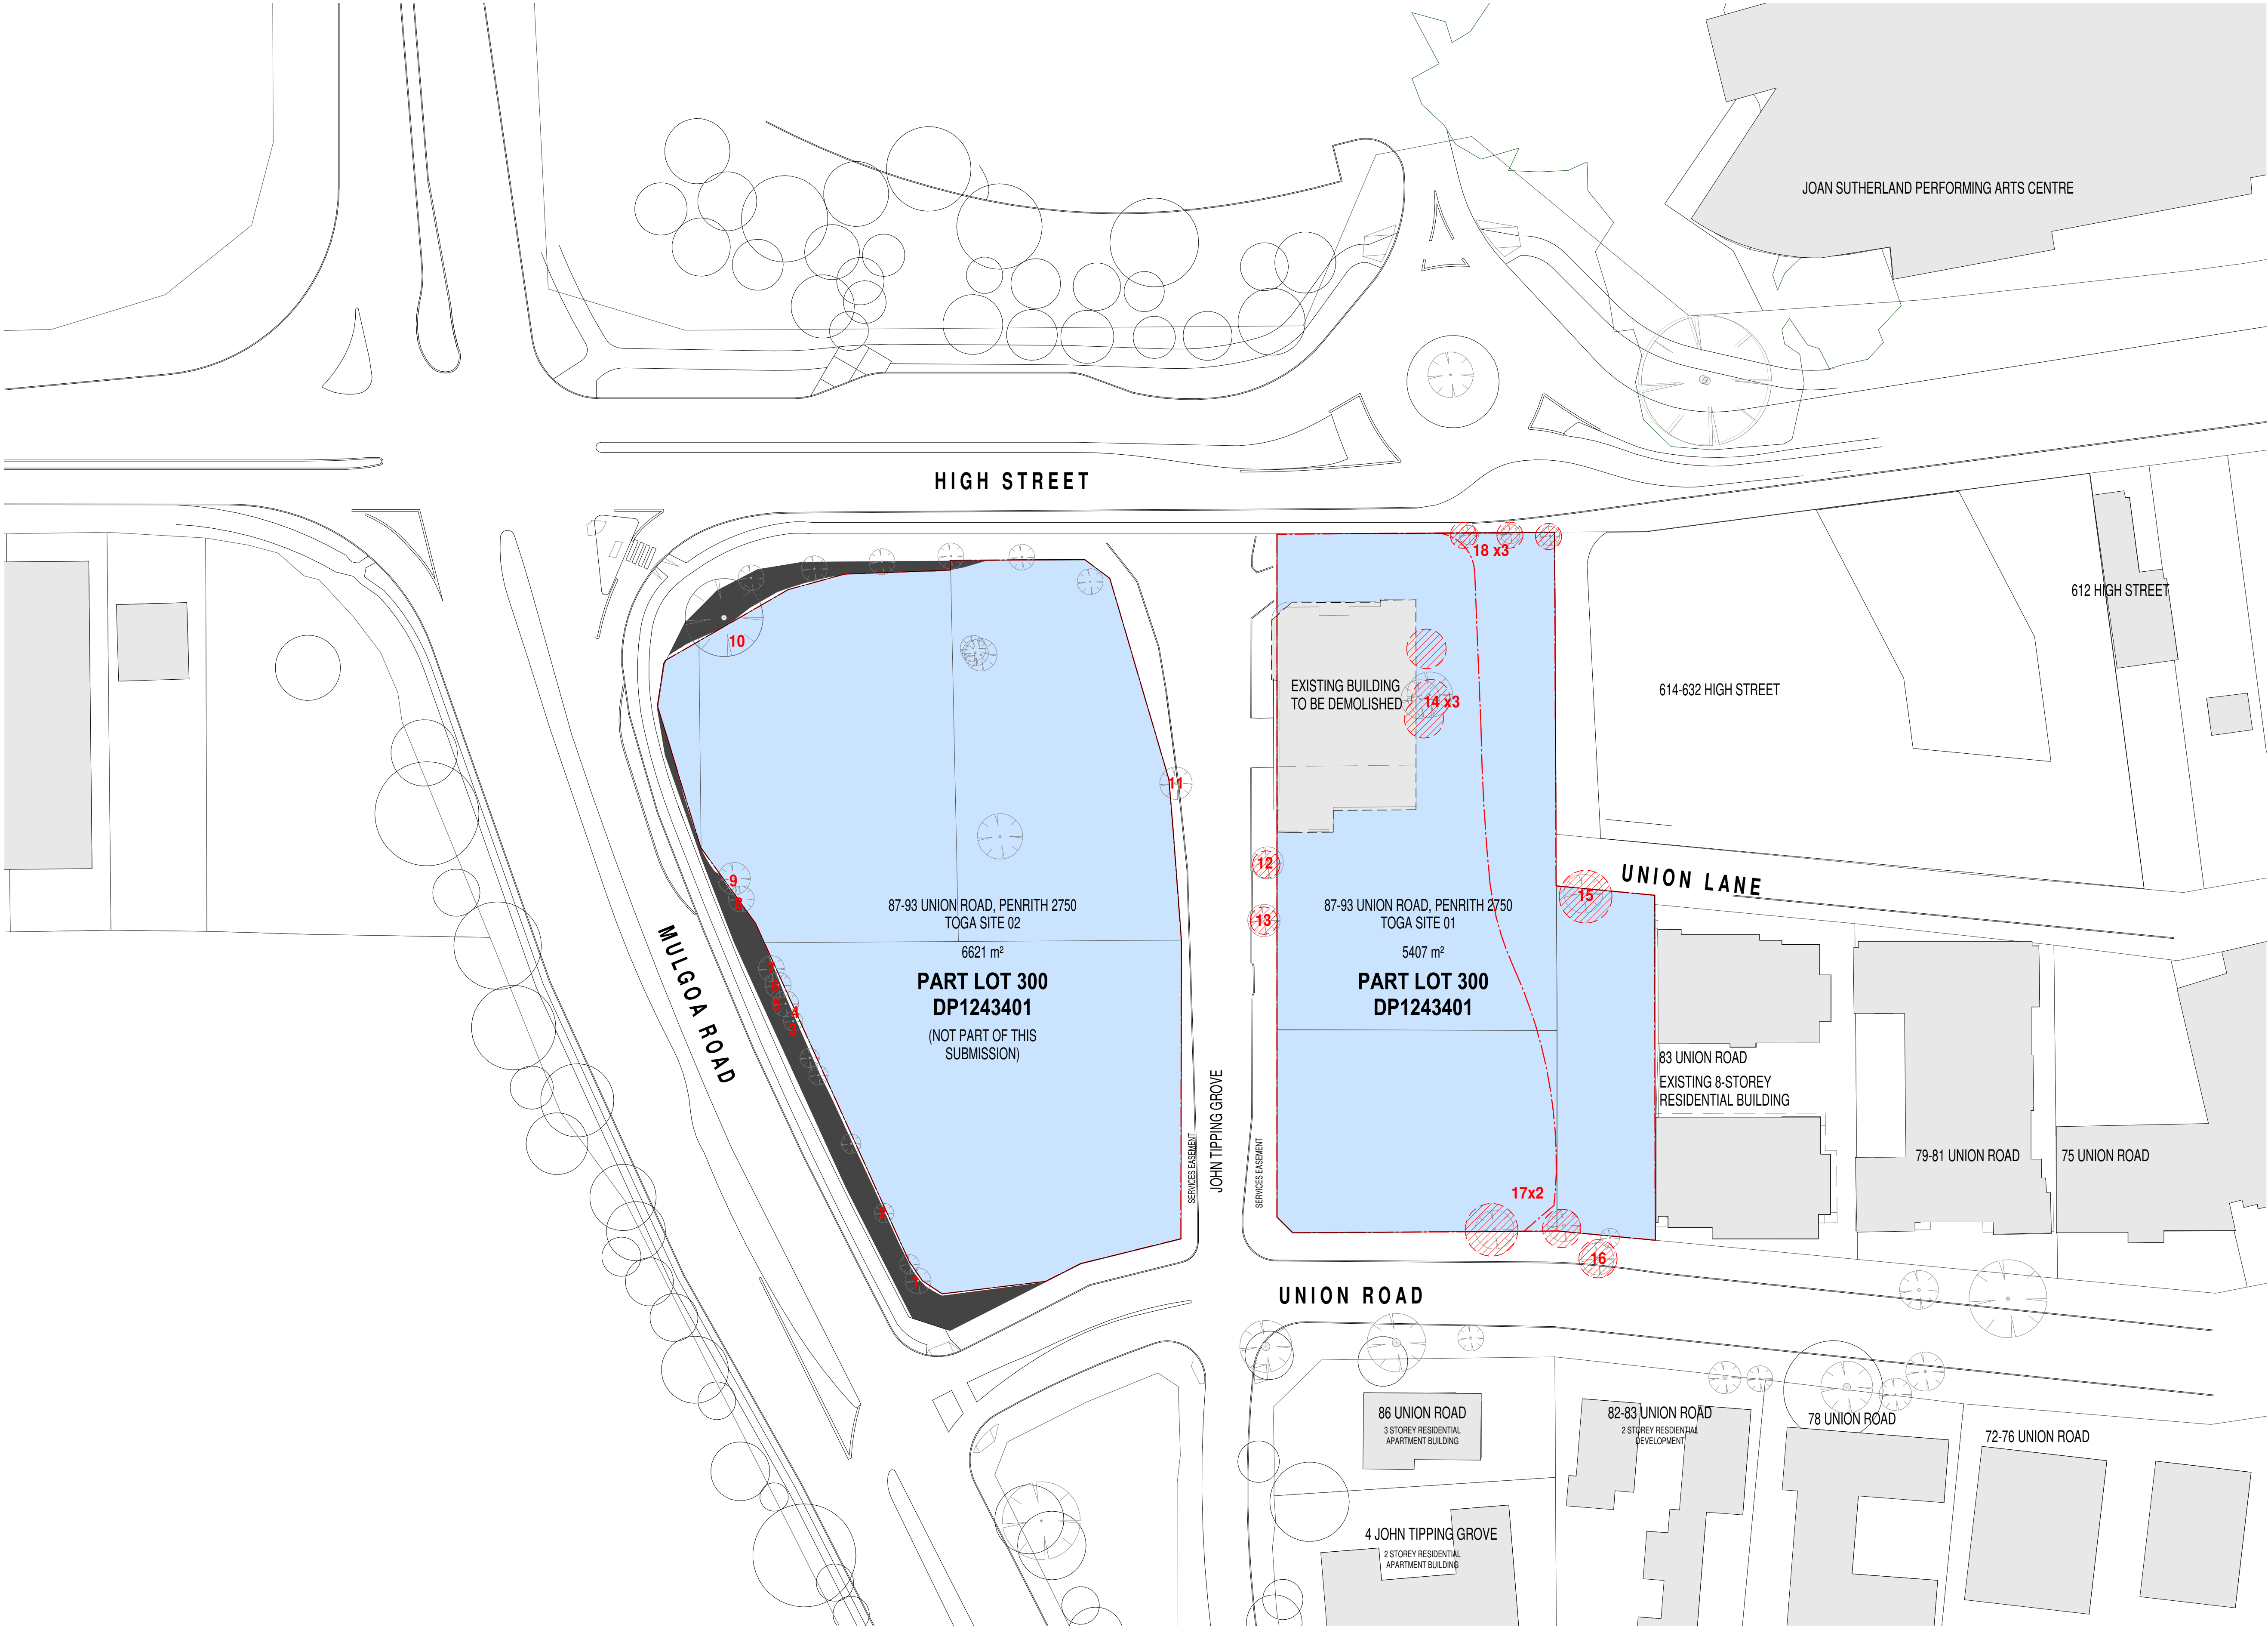

In accepting and utilising this document the recipient agrees that SJB Architecture (NSW) Pty. Ltd. ACN 081 094 724 T/A SJB Architects, retain all common law, statutory law and other rights including copyright and intellectual property rights. The recipient agrees not to use this document for any purpose other than its intended use; to waive all claims against SJB Architects resulting from unauthorised changes; or to reuse the document on other projects without the prior written consent of SJB Architects. Under no circumstances shall transfer of this document be deemed a sale. SJB Architects makes no warranties of fitness for any purpose. The Builder/Contractor shall verify job dimensions prior to any work commencing. Use figured dimensions only. Do not scale drawings.

Nominated Architects: Adam Haddow-7188 | John Pradel-7004

**FOR APPROVAL**

Rev	Date	Revision
66	24.01.2020	PRELIMINARY ISSUE
81	28.02.2020	DRAFT DA ISSUE
83	04.03.2020	ISSUED FOR DA
85	07.05.2021	ISSUED FOR DA
86	04.10.2021	ISSUED FOR LEC

Structural Engineer  
**ROBERT BIRD GROUP**

Mechanical / Hydraulic Engineer  
**JHA CONSULTING ENGINEERS**






Electrical Engineer  
**JHA CONSULTING ENGINEERS**

Fire Engineer  
**OLSSON FIRE & RISK**

Access Consultant  
**ACCESSIBLE BUILDING SOLUTIONS**

Basix  
**EMF GRIFFITHS**

Building Key

-  Site Area
-  Existing Buildings
-  Site Boundary (TOGA Owned)
-  Trees to be removed
-  (Numbered trees, refer to Arborist report for details)


Client



Project  
**HIGH ST DEVELOPMENT**

**634-638 HIGH ST & 87-89 UNION RD, PENRITH**

Drawing Name  
**EXISTING SITE PLAN**

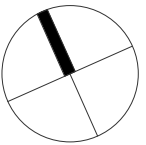

Date  
**04.10.2021**

Scale  
**1 : 500**

Sheet Size  
**@ A1**

Drawn  
**GT**

Chk.  
**MG**

Job No.  
**6111**

Drawing No.  
**AR-1-0101**

Revision  
**/86**

**SJB Architects**  
Level 2  
490 Crown Street  
Surry Hills NSW  
2010 Australia  
T 61 2 9380 9911  
F 61 2 9380 9922  
www.sjb.com.au







In accepting and utilising this document the recipient agrees that SJB Architects (NSW) Pty. Ltd. ACN 081 094 724 T/A SJB Architects, retain all common law, statutory law and other rights including copyright and intellectual property rights. The recipient agrees not to use this document for any purpose other than its intended use; to waive all claims against SJB Architects resulting from unauthorised changes; or to reuse the document on other projects without the prior written consent of SJB Architects. Under no circumstances shall transfer of this document be deemed a sale. SJB Architects makes no warranties of fitness for any purpose. The Builder/Contractor shall verify job dimensions prior to any work commencing. Use figured dimensions only. Do not scale drawings.

Nominated Architects: Adam Haddow-7188 | John Pradel-7004

FOR APPROVAL

Rev	Date	Revision
66	24.01.2020	PRELIMINARY ISSUE
81	28.02.2020	DRAFT DA ISSUE
83	04.03.2020	ISSUED FOR DA
85	07.05.2021	ISSUED FOR DA
86	04.10.2021	ISSUED FOR LEC

Structural Engineer	ROBERT BIRD GROUP
Mechanical / Hydraulic Engineer	JHA CONSULTING ENGINEERS
Electrical Engineer	JHA CONSULTING ENGINEERS
Fire Engineer	OLSSON FIRE & RISK
Access Consultant	ACCESSIBLE BUILDING SOLUTIONS
Basix	EMF GRIFFITHS
Building Key	

- Developable Footprint
- Existing Buildings
- John Tipping Grove
- New Road Allocation
- Site Boundary (TOGA Owned)
- TPZ - Existing Trees to be retained
- Trees to be removed

Client




Project

HIGH ST DEVELOPMENT

634-638 HIGH ST & 87-89 UNION RD, PENRITH

Drawing Name

STAGING PLAN - NEW BOUNDARY

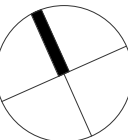


Date	Scale	Sheet Size
04.10.2021	1 : 500	@ A1

Drawn	Chk.
GT	MG

Job No.	Drawing No.	Revision
6111	AR-1-0102	/86



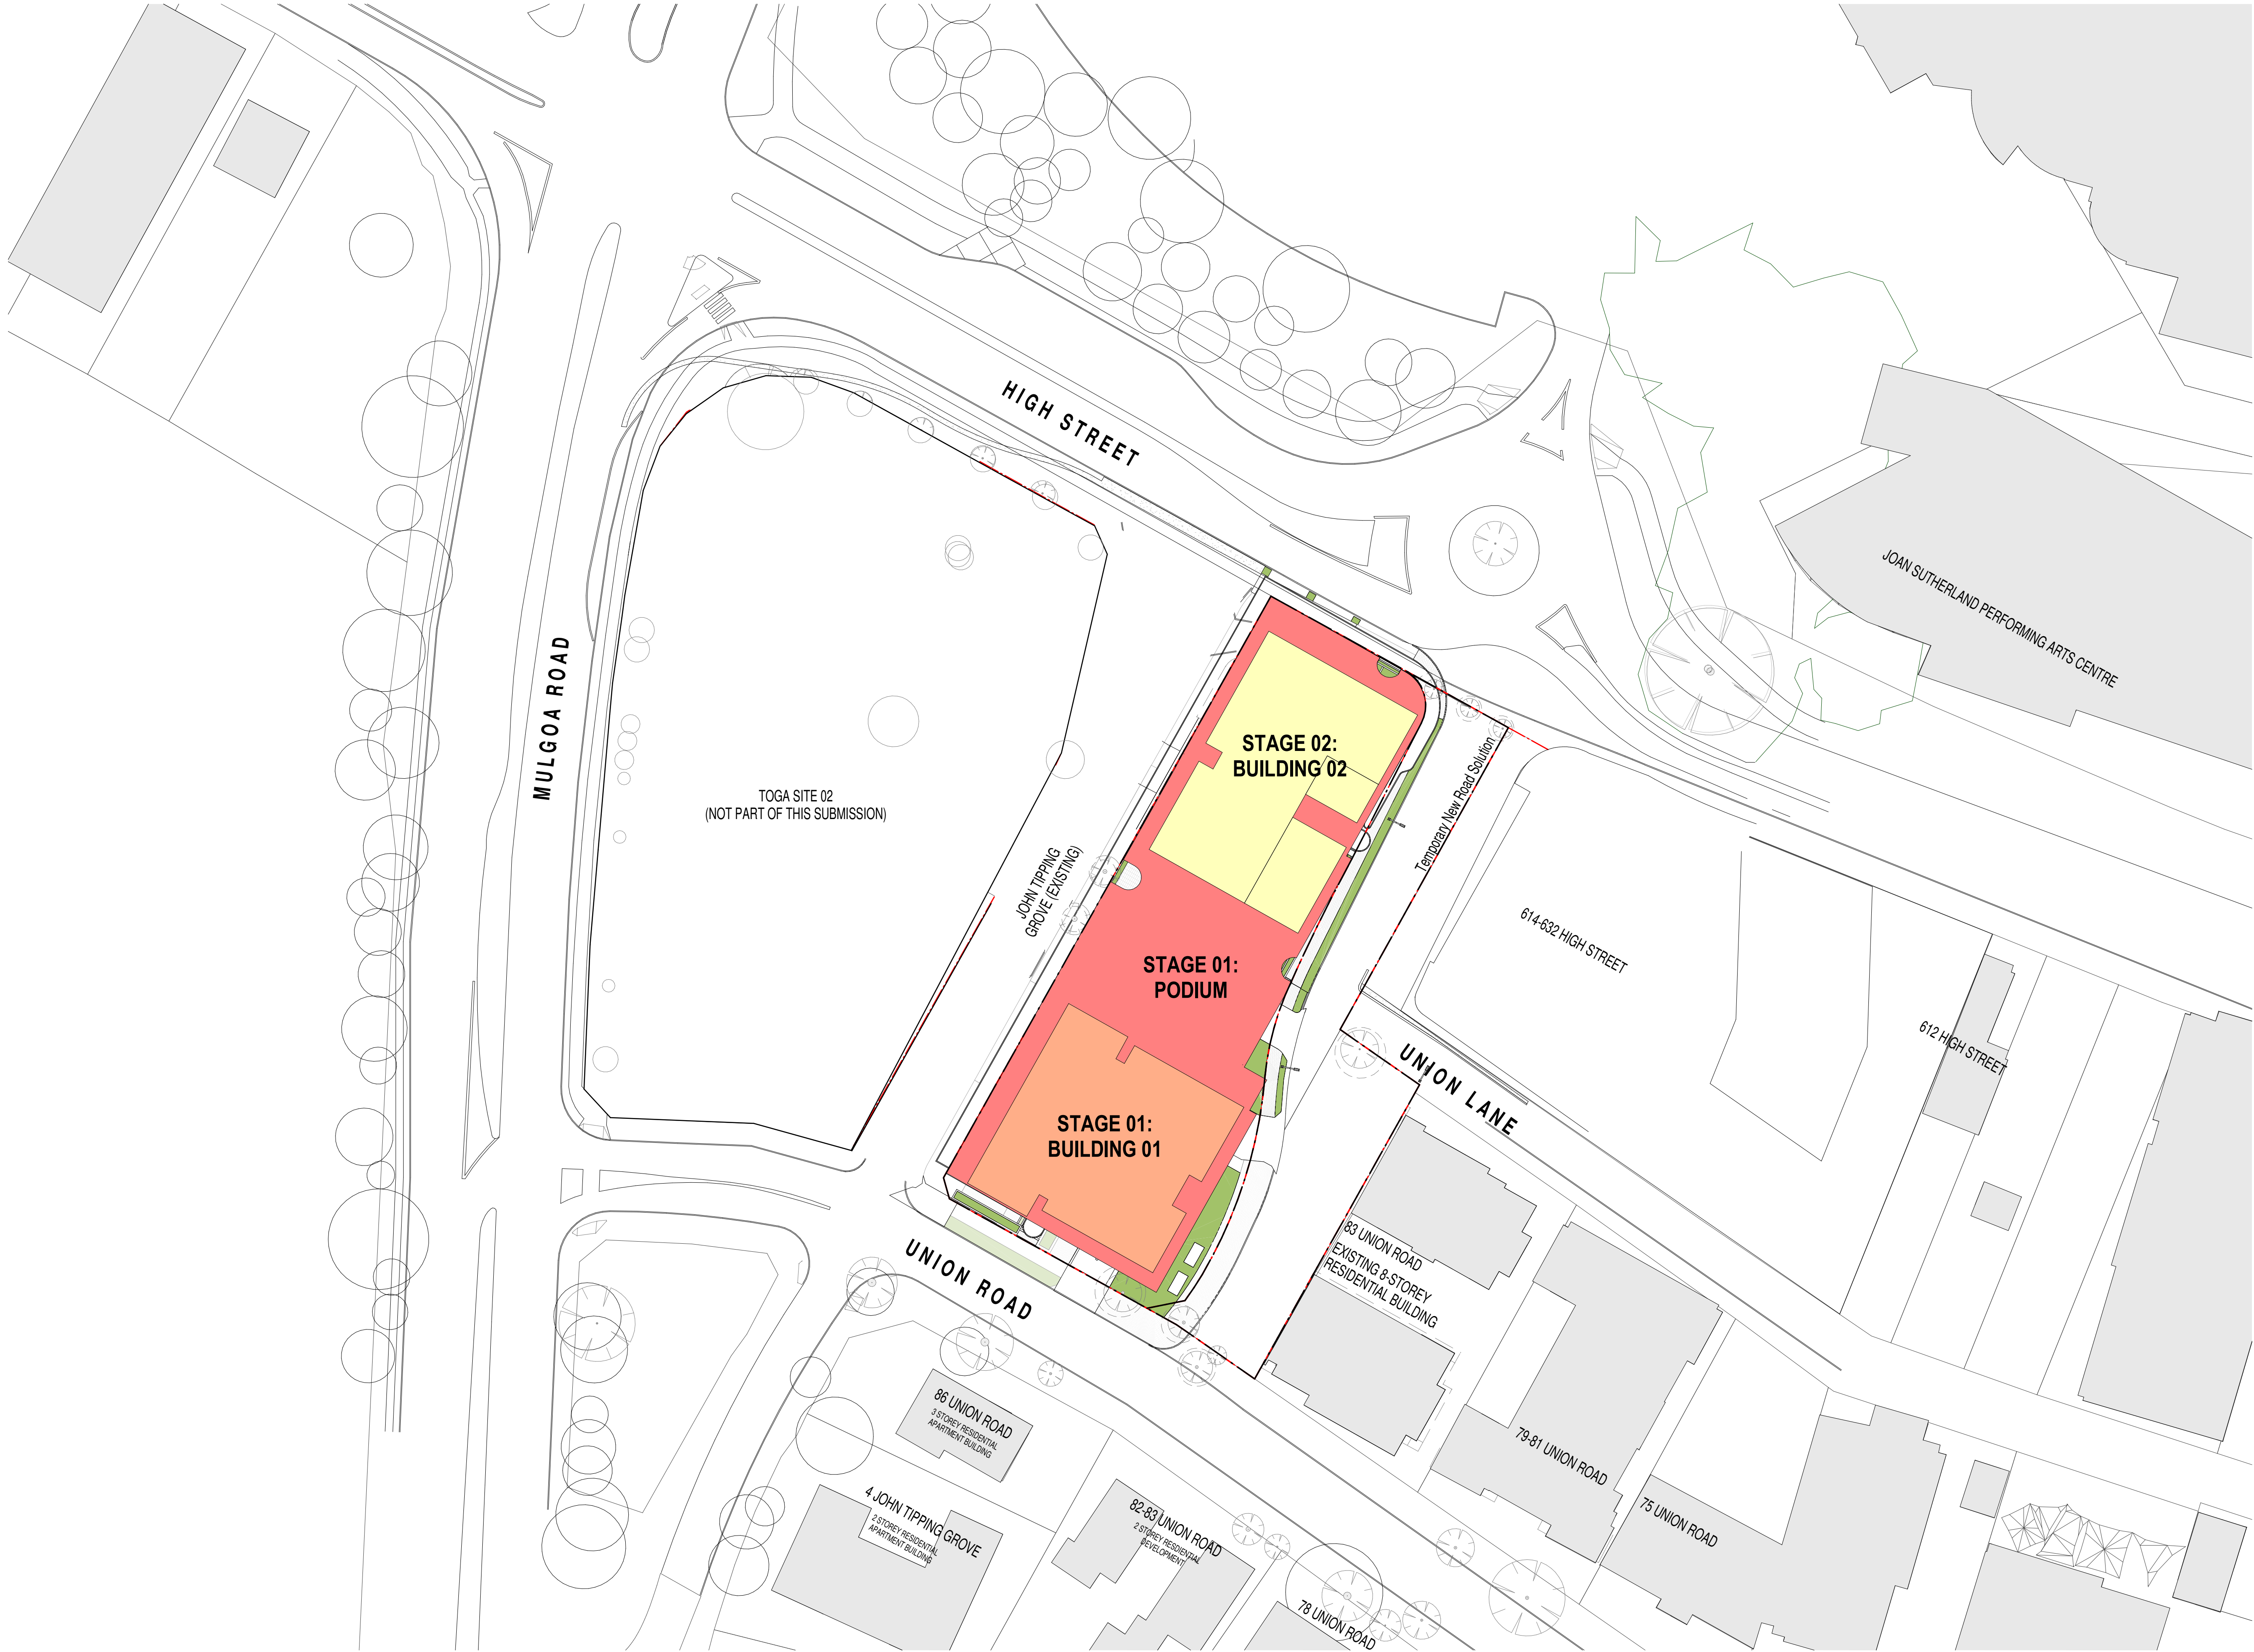

In accepting and utilising this document the recipient agrees that SJB Architects (NSW) Pty. Ltd. ACN 081 094 724 T/A SJB Architects, retain all common law, statutory law and other rights including copyright and intellectual property rights. The recipient agrees not to use this document for any purpose other than its intended use, to waive all claims against SJB Architects resulting from unauthorised changes; or to reuse the document on other projects without the prior written consent of SJB Architects. Under no circumstances shall transfer of this document be deemed a sale. SJB Architects makes no warranties of fitness for any purpose. The Builder/Contractor shall verify job dimensions prior to any work commencing. Use figured dimensions only. Do not scale drawings.

Nominated Architects: Adam Haddow-7188 | John Pradel-7004

FOR APPROVAL

Rev	Date	Revision
66	24.01.2020	PRELIMINARY ISSUE
81	28.02.2020	DRAFT DA ISSUE
83	04.03.2020	ISSUED FOR DA
85	07.05.2021	ISSUED FOR DA
86	04.10.2021	ISSUED FOR LEC

Structural Engineer	ROBERT BIRD GROUP
Mechanical / Hydraulic Engineer	JHA CONSULTING ENGINEERS
Electrical Engineer	JHA CONSULTING ENGINEERS
Fire Engineer	OLSSON FIRE & RISK
Access Consultant	ACCESSIBLE BUILDING SOLUTIONS
Basix	EMF GRIFFITHS
Building Key	

Client




Project

HIGH ST DEVELOPMENT

634-638 HIGH ST & 87-89 UNION RD, PENRITH

Drawing Name


STAGING PLAN - CONSTRUCTION  
STAGING DIAGRAM - PLAN

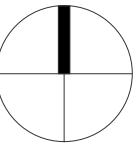

Date	Scale	Sheet Size
04.10.2021	1 : 500	@ A1

Drawn	Chk.
GT	MG

Job No.	Drawing No.	Revision
6111	AR-1-0102A86	

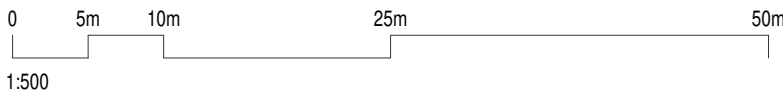



In accepting and utilising this document the recipient agrees that SJB Architecture (NSW) Pty. Ltd. ACN 081 094 724 T/A SJB Architects, retain all common law, statutory law and other rights including copyright and intellectual property rights. The recipient agrees not to use this document for any purpose other than its intended use; to waive all claims against SJB Architects resulting from unauthorised changes; or to reuse the document on other projects without the prior written consent of SJB Architects. Under no circumstances shall transfer of this document be deemed a sale. SJB Architects makes no warranties of fitness for any purpose. The Builder/Contractor shall verify job dimensions prior to any work commencing. Use figured dimensions only. Do not scale drawings.

Nominated Architects: Adam Haddow-7188 | John Pradel-7004

FOR APPROVAL

Rev	Date	Revision
66	24.01.2020	PRELIMINARY ISSUE
81	28.02.2020	DRAFT DA ISSUE
83	04.03.2020	ISSUED FOR DA
85	07.05.2021	ISSUED FOR DA
86	04.10.2021	ISSUED FOR LEC

Structural Engineer

ROBERT BIRD GROUP

Mechanical / Hydraulic Engineer

JHA CONSULTING ENGINEERS

Electrical Engineer

JHA CONSULTING ENGINEERS

Fire Engineer

OLSSON FIRE & RISK


Access Consultant

ACCESSIBLE BUILDING SOLUTIONS

Basix

EMF GRIFFITHS

Building Key

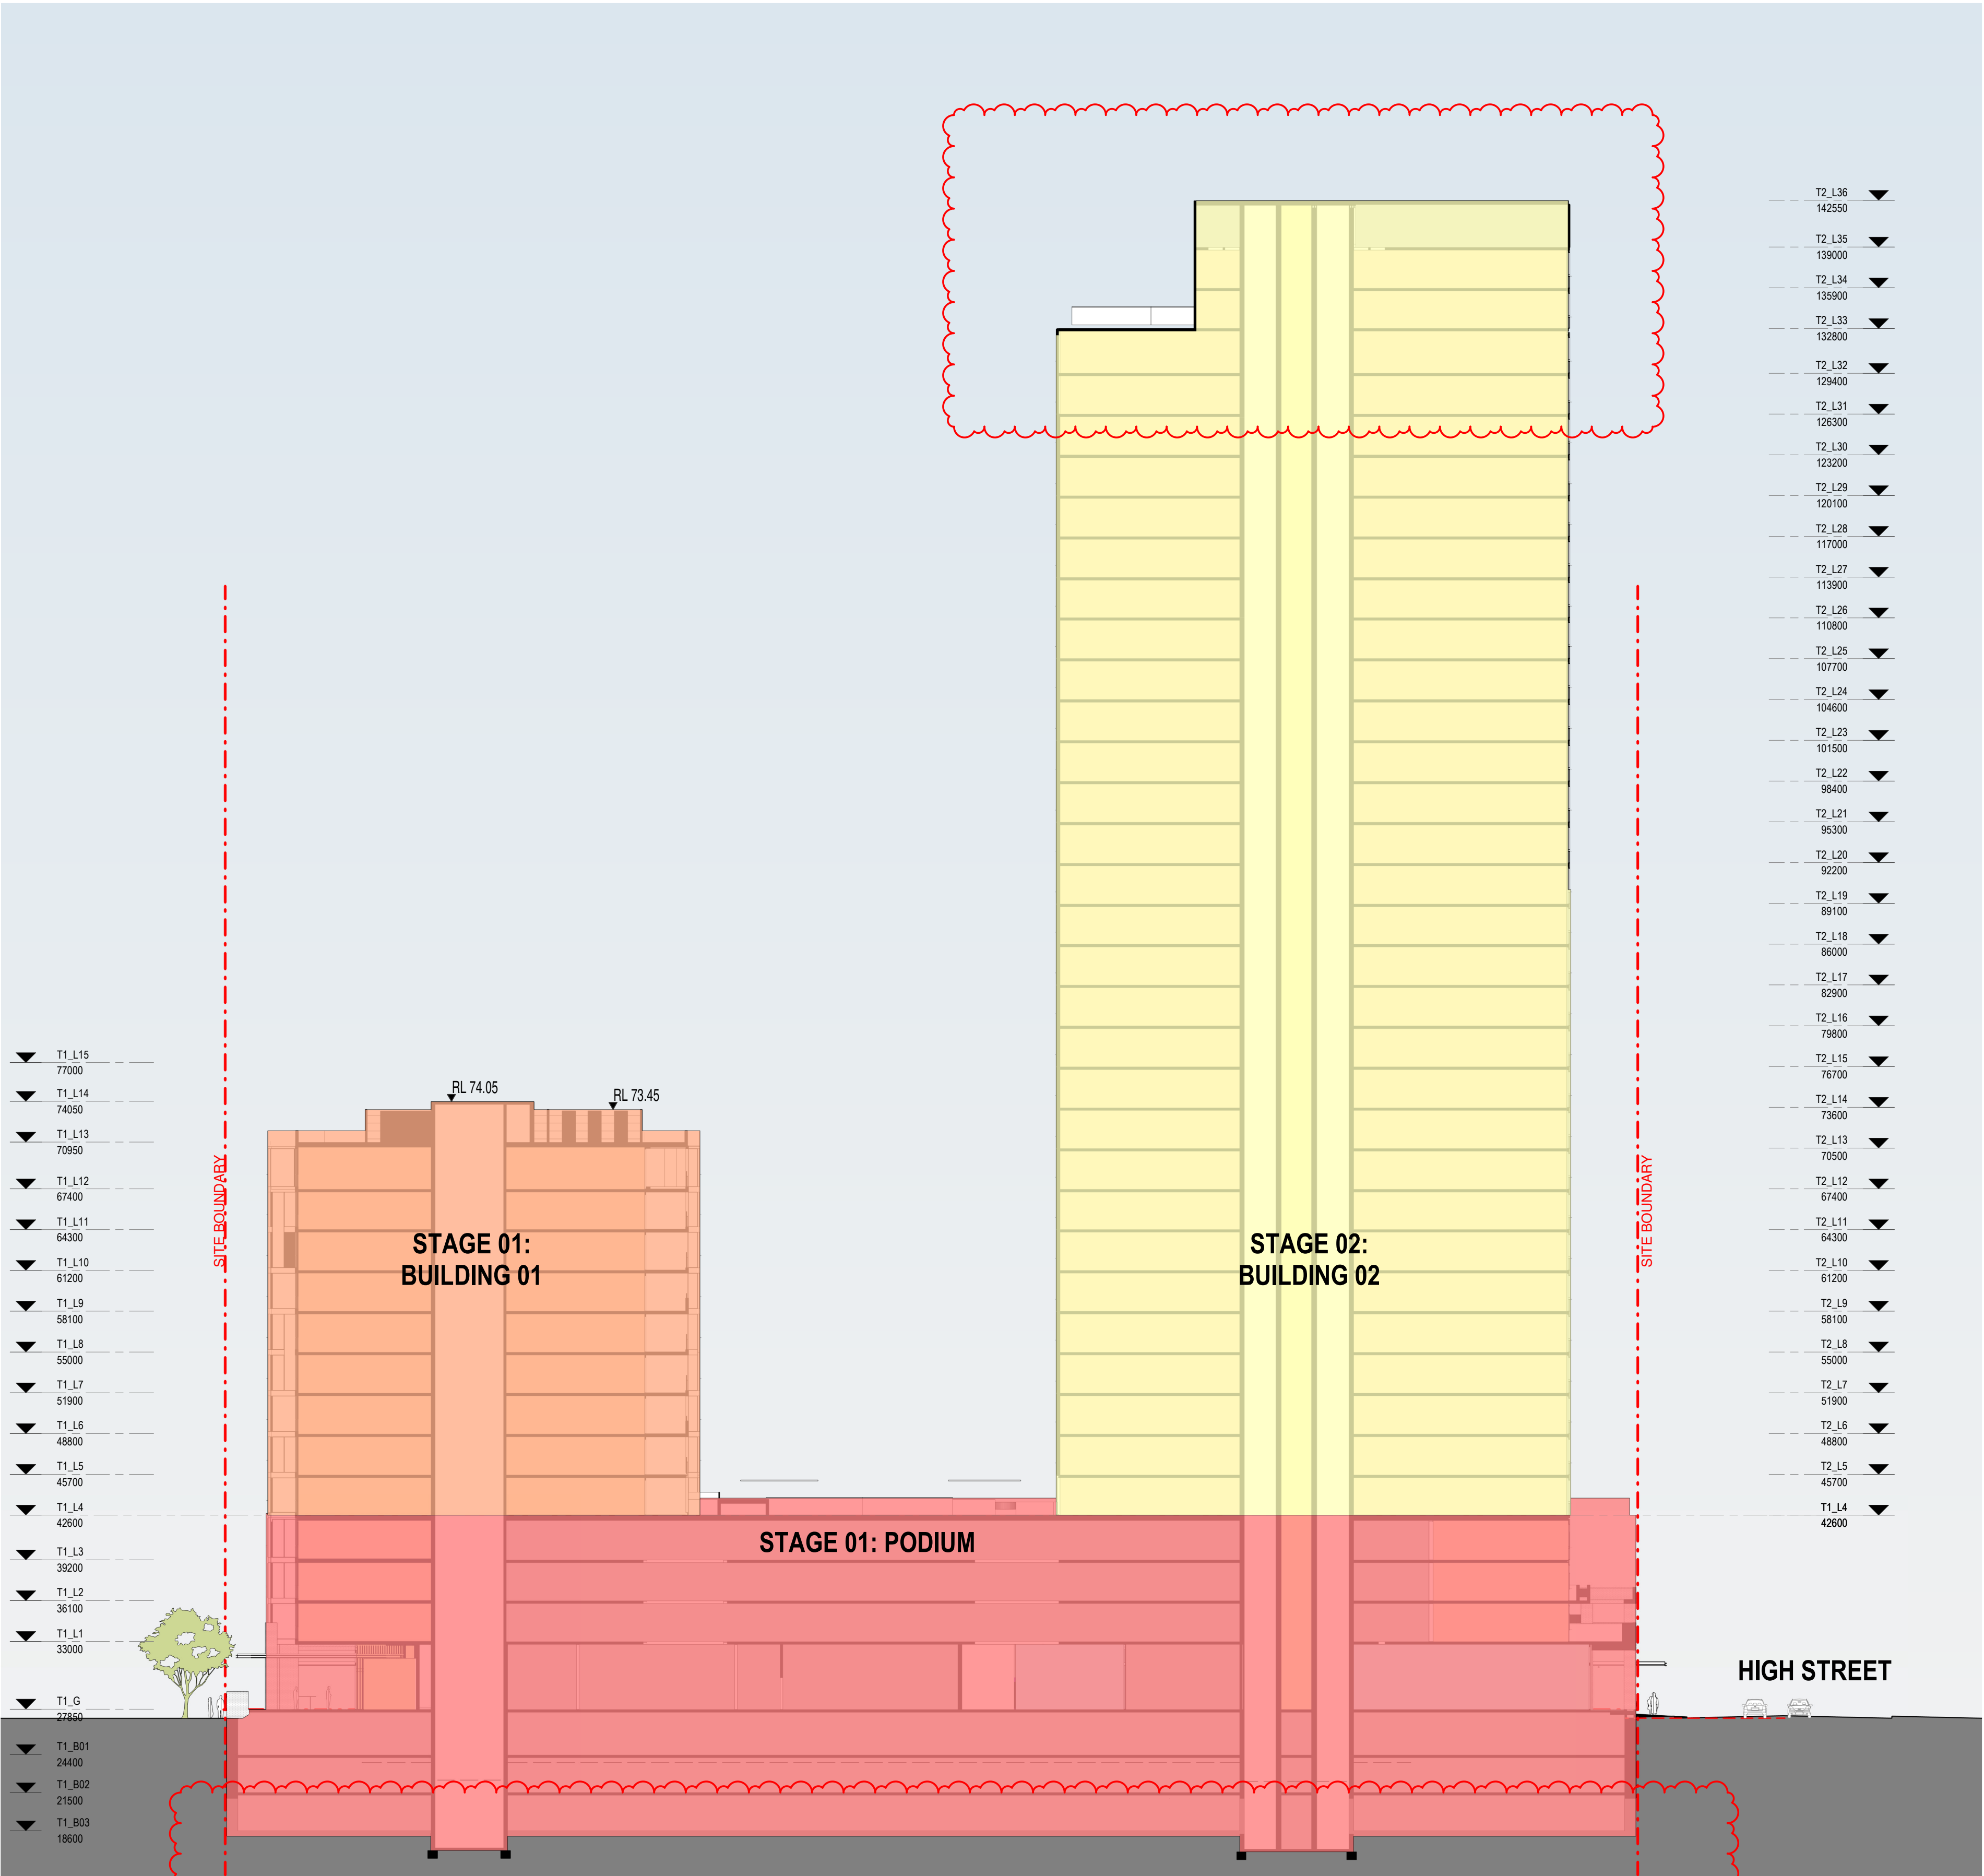

Client



Project

HIGH ST DEVELOPMENT

634-638 HIGH ST & 87-89  
UNION RD, PENRITH

Drawing Name

STAGING PLAN - CONSTRUCTION  
STAGING DIAGRAM - SECTION

Date 04.10.2021 Scale 1 : 300 Sheet Size @ A1

Drawn Chk.


GT MG

Job No. 6111 Drawing No. AR-1-0102B86 Revision

SJB Architects  
Level 2  
490 Crown Street  
Surry Hills NSW  
2010 Australia  
T 61 2 9380 9911  
F 61 2 9380 9922  
www.sjb.com.au





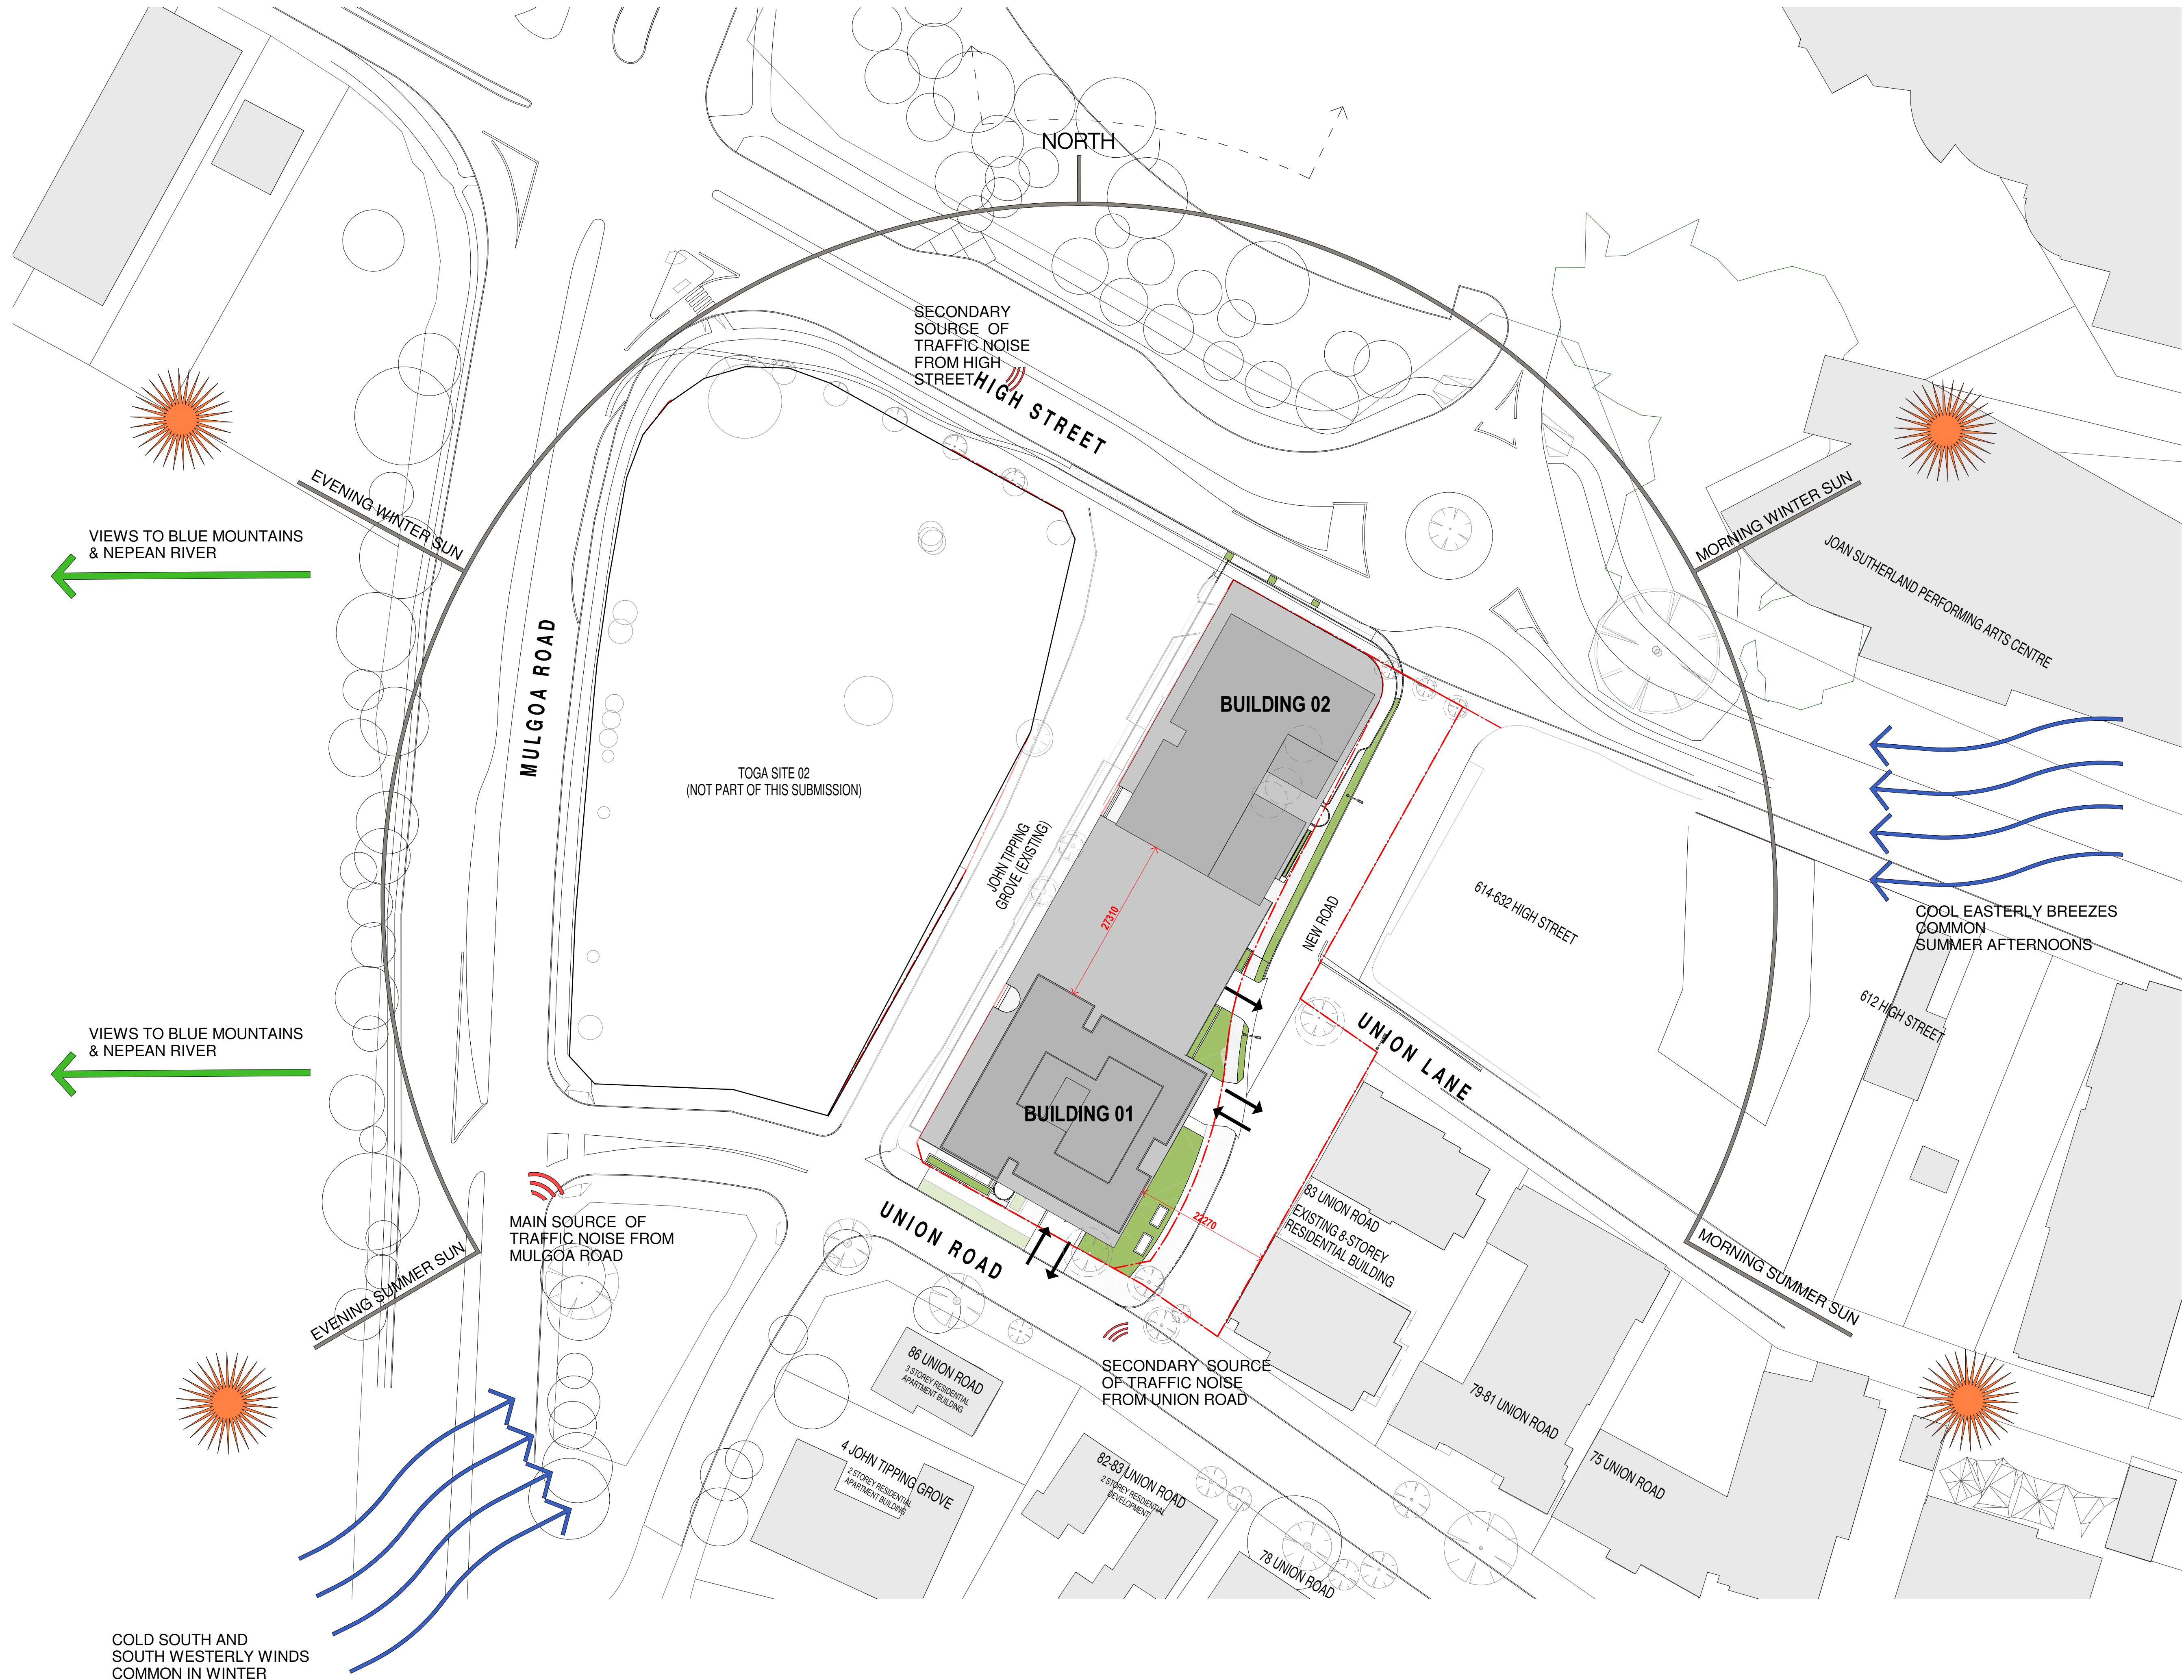

In accepting and utilising this document the recipient agrees that SJB Architecture (NSW) Pty. Ltd. ACN 081 094 724 T/A SJB Architects, retain all common law, statutory law and other rights including copyright and intellectual property rights. The recipient agrees not to use this document for any purpose other than its intended use; to waive all claims against SJB Architects resulting from unauthorised changes; or to reuse the document on other projects without the prior written consent of SJB Architects. Under no circumstances shall transfer of this document be deemed a sale. SJB Architects makes no warranties of fitness for any purpose. The Builder/Contractor shall verify job dimensions prior to any work commencing. Use figured dimensions only. Do not scale drawings.

Nominated Architects: Adam Haddow-7188 | John Pradel-7004

FOR APPROVAL

Rev	Date	Revision
66	24.01.2020	PRELIMINARY ISSUE
81	28.02.2020	DRAFT DA ISSUE
83	04.03.2020	ISSUED FOR DA
85	07.05.2021	ISSUED FOR DA
86	04.10.2021	ISSUED FOR LEC

Structural Engineer

ROBERT BIRD GROUP

Mechanical / Hydraulic Engineer

JHA CONSULTING ENGINEERS

Electrical Engineer

JHA CONSULTING ENGINEERS

Fire Engineer

OLSSON FIRE & RISK

Access Consultant

ACCESSIBLE BUILDING SOLUTIONS

Basix

EMF GRIFFITHS

Building Key

Existing Trees

Existing Trees - To be removed

Existing Buildings

Site Boundary (TOGA Owned)

Prevailing Winds

Views

Client

TOGA

Project

HIGH ST DEVELOPMENT

634-638 HIGH ST & 87-89 UNION RD, PENRITH

Drawing Name

SITE ANALYSIS

Date

04.10.2021

Scale

1 : 500

Sheet Size

@ A1

Drawn

SD

Chk.

NH

Job No.

6111

Drawing No.

AR-1-0103

Revision

/86

SJB Architects

Level 2

490 Crown Street

Surry Hills NSW

2010 Australia

T 61 2 9380 9911

F 61 2 9380 9922

www.sjb.com.au

SJB



In accepting and utilising this document the recipient agrees that SJB Architecture (NSW) Pty. Ltd. ACN 081 094 724 T/A SJB Architects, retain all common law, statutory law and other rights including copyright and intellectual property rights. The recipient agrees not to use this document for any purpose other than its intended use; to waive all claims against SJB Architects resulting from unauthorised changes; or to reuse the document on other projects without the prior written consent of SJB Architects. Under no circumstances shall transfer of this document be deemed a sale. SJB Architects makes no warranties of fitness for any purpose. The Builder/Contractor shall verify job dimensions prior to any work commencing. Use figured dimensions only. Do not scale drawings.

Nominated Architects: Adam Haddow-7188 | John Pradel-7004

FOR APPROVAL

Rev	Date	Revision
66	24.01.2020	PRELIMINARY ISSUE
81	28.02.2020	DRAFT DA ISSUE
83	04.03.2020	ISSUED FOR DA
85	07.05.2021	ISSUED FOR DA
86	04.10.2021	ISSUED FOR LEC

Structural Engineer	ROBERT BIRD GROUP
Mechanical / Hydraulic Engineer	JHA CONSULTING ENGINEERS
Electrical Engineer	JHA CONSULTING ENGINEERS
Fire Engineer	OLSSON FIRE & RISK
Access Consultant	ACCESSIBLE BUILDING SOLUTIONS
Basix	EMF GRIFFITHS
Building Key	

Client



Project

HIGH ST DEVELOPMENT

634-638 HIGH ST & 87-89 UNION RD, PENRITH

Drawing Name


CONTEXT ELEVATION - UNION ROAD

Date	Scale	Sheet Size
04.10.2021	1 : 300	@ A1


Drawn	Chk.
SD	NH

Job No.	Drawing No.	Revision
6111	AR-1-0104	/86


SJB Architects  
Level 2  
490 Crown Street  
Surry Hills NSW  
2010 Australia  
T 61 2 9380 9911  
F 61 2 9380 9922  
www.sjb.com.au

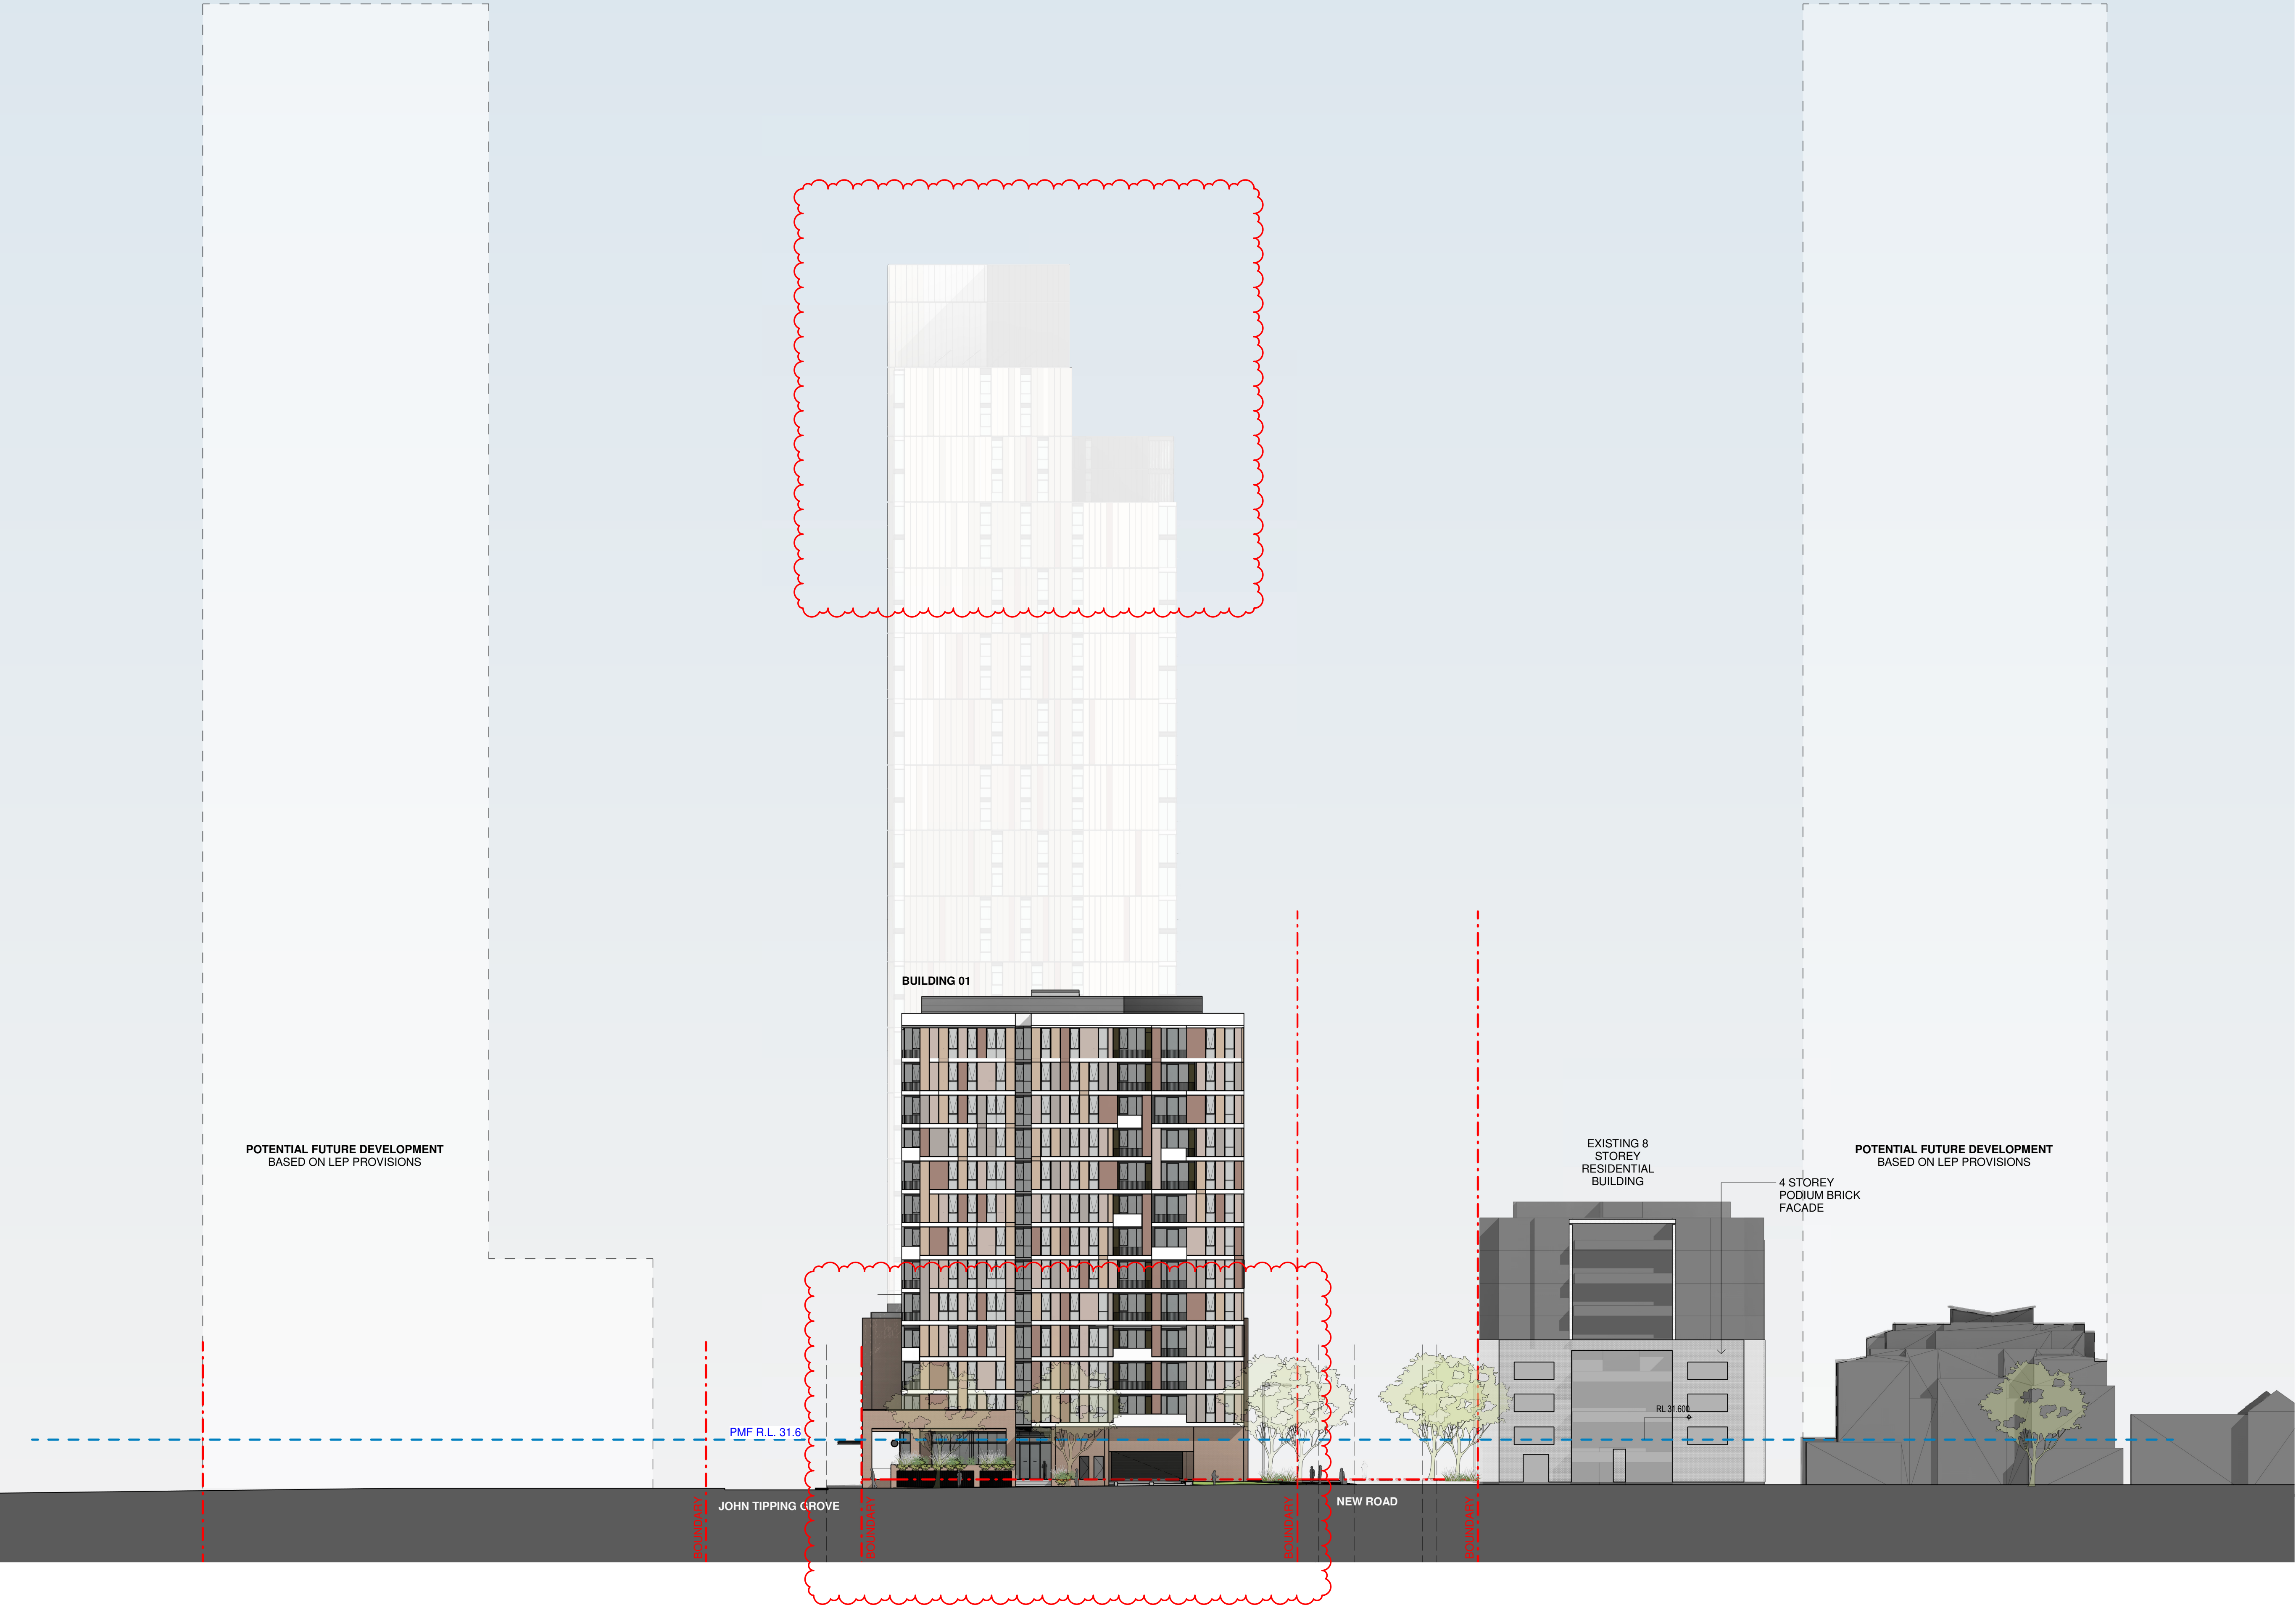



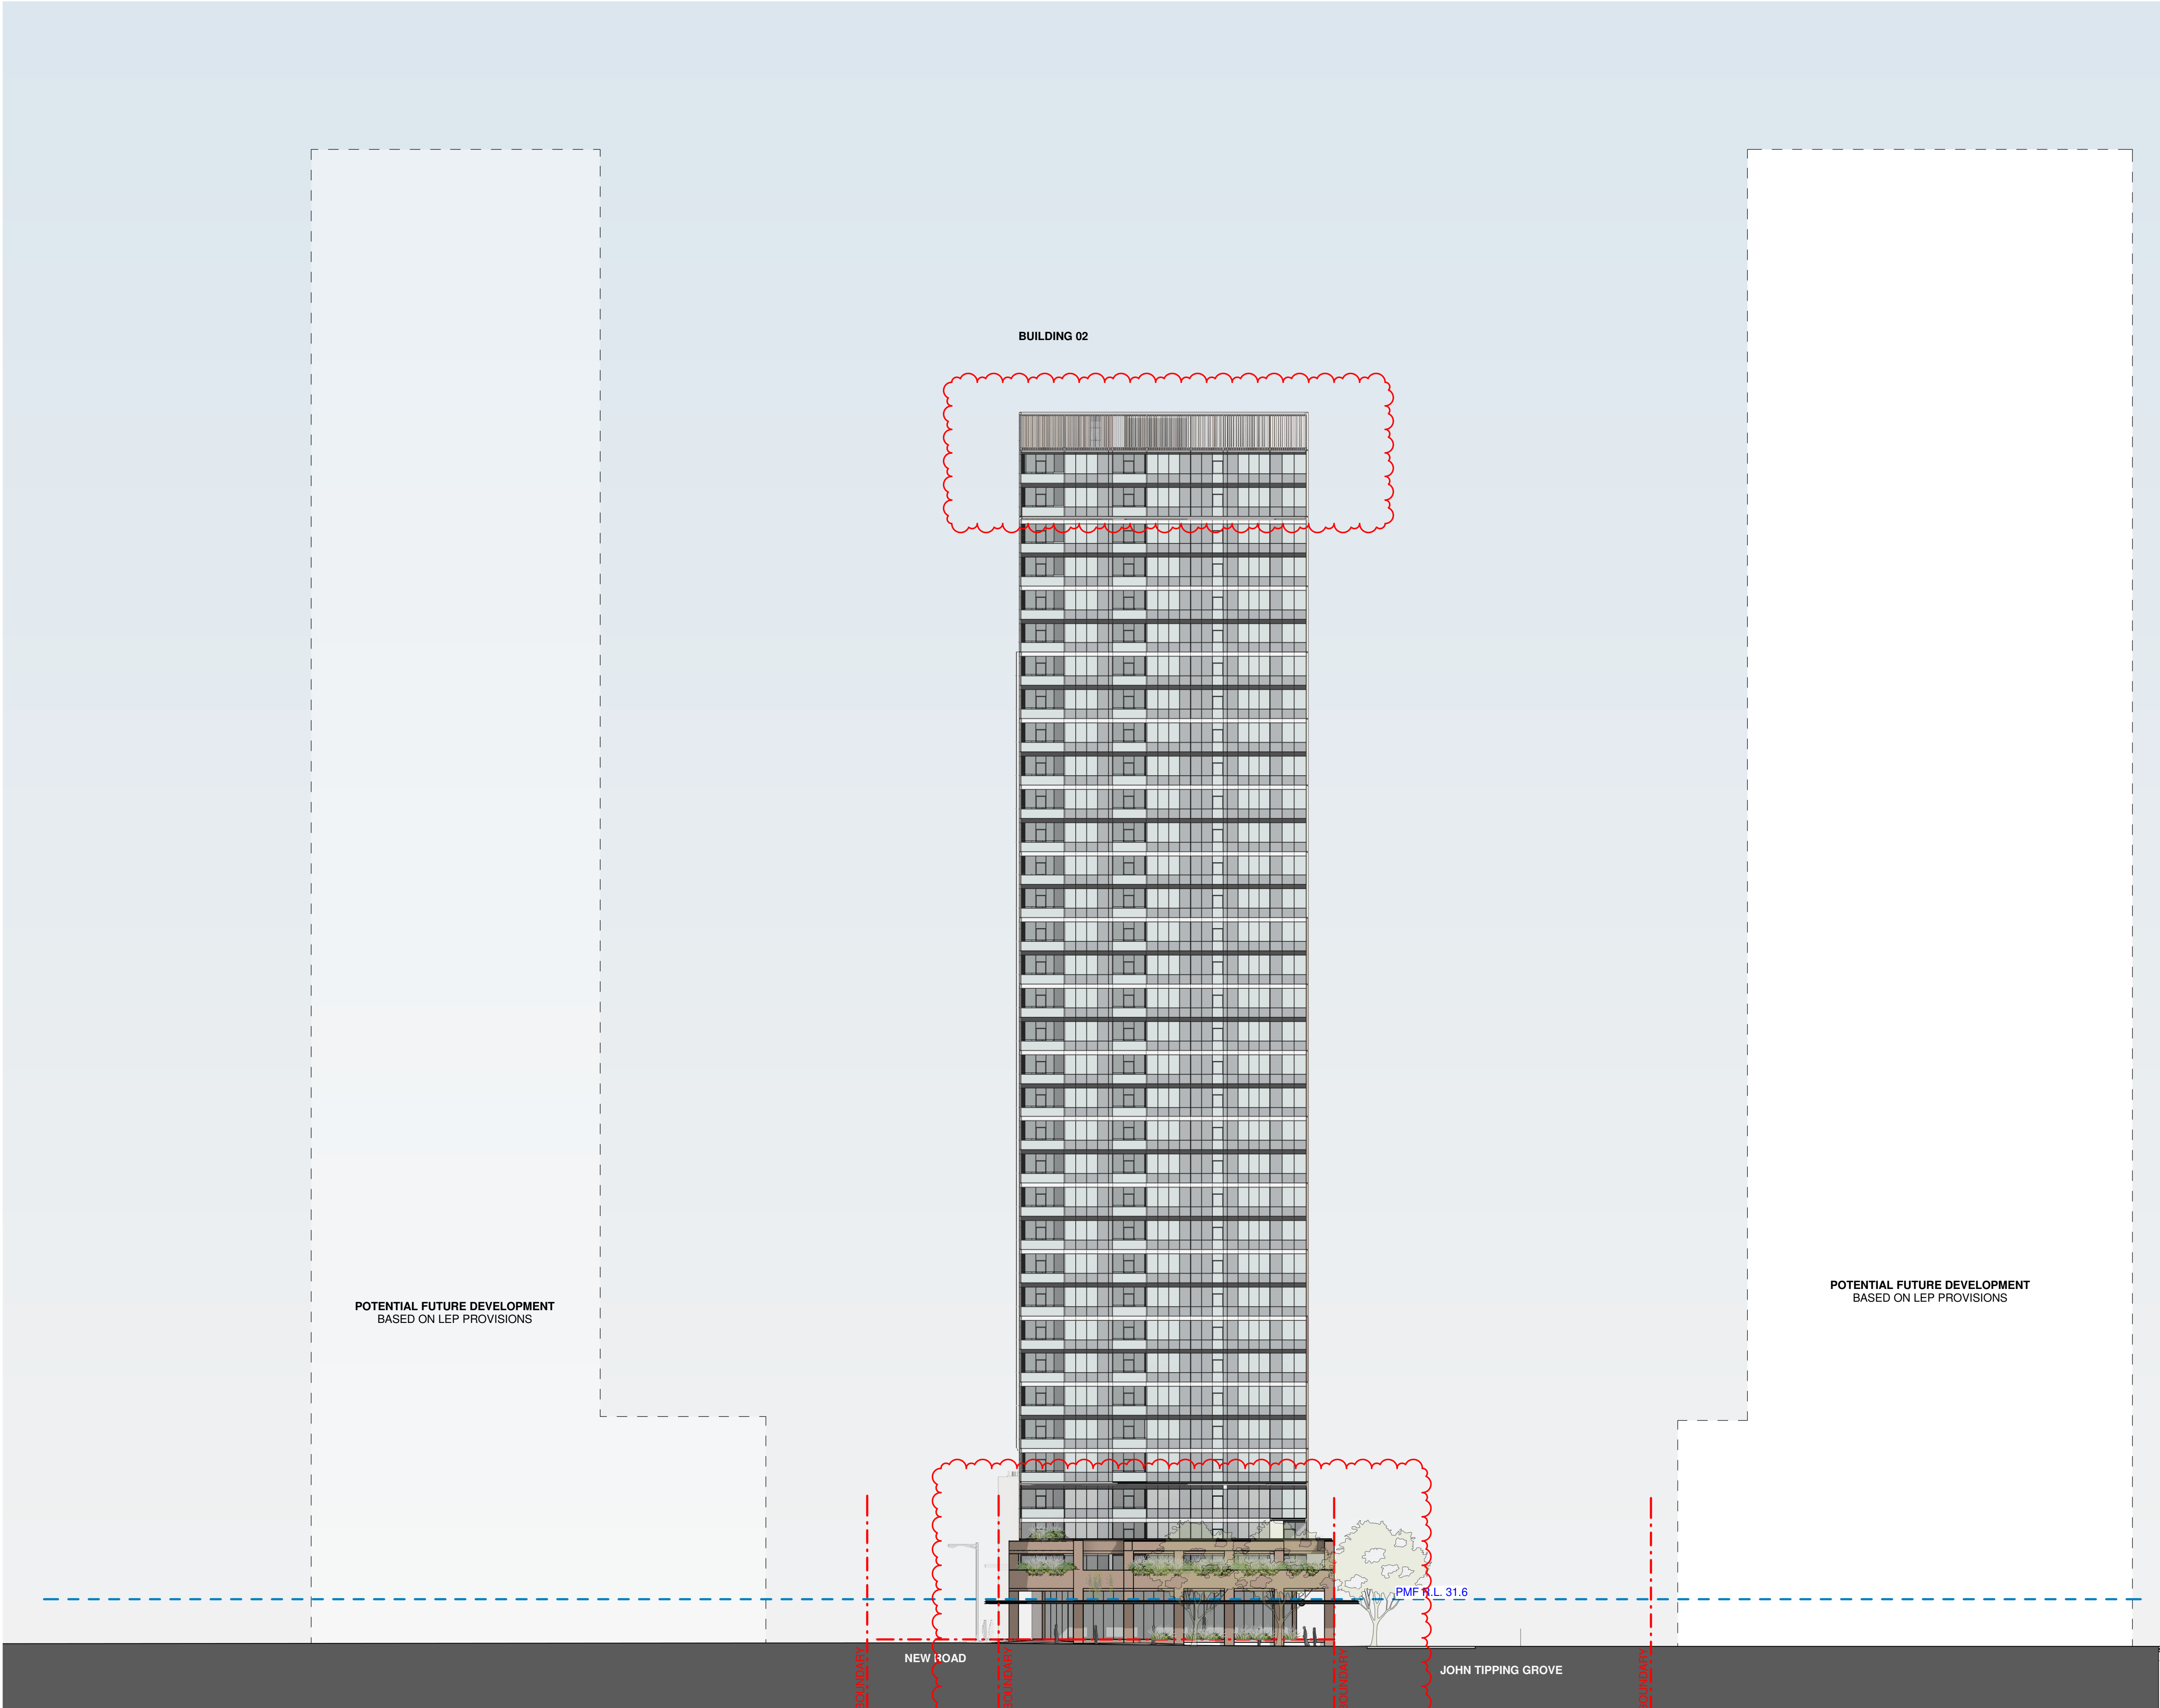

01 NORTH ELEVATION - CONTEXT  
1 : 300@A1

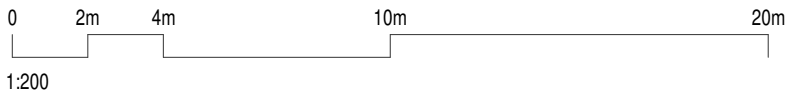

In accepting and utilising this document the recipient agrees that SJB Architecture (NSW) Pty. Ltd. ACN 081 094 724 T/A SJB Architects, retain all common law, statutory law and other rights including copyright and intellectual property rights. The recipient agrees not to use this document for any purpose other than its intended use, to waive all claims against SJB Architects resulting from unauthorised changes; or to reuse the document on other projects without the prior written consent of SJB Architects. Under no circumstances shall transfer of this document be deemed a sale. SJB Architects makes no warranties of fitness for any purpose. The Builder/Contractor shall verify job dimensions prior to any work commencing. Use figured dimensions only. Do not scale drawings.

Nominated Architects: Adam Haddow-7188 | John Pradel-7004

FOR APPROVAL

Rev	Date	Revision
66	24.01.2020	PRELIMINARY ISSUE
81	28.02.2020	DRAFT DA ISSUE
83	04.03.2020	ISSUED FOR DA
85	07.05.2021	ISSUED FOR DA
86	04.10.2021	ISSUED FOR LEC

Structural Engineer	ROBERT BIRD GROUP
Mechanical / Hydraulic Engineer	JHA CONSULTING ENGINEERS
Electrical Engineer	JHA CONSULTING ENGINEERS
Fire Engineer	OLSSON FIRE & RISK
Access Consultant	ACCESSIBLE BUILDING SOLUTIONS
Basix	EMF GRIFFITHS
Building Key	

Client



Project

HIGH ST DEVELOPMENT

634-638 HIGH ST & 87-89  
UNION RD, PENRITH

Drawing Name

CONTEXT ELEVATION - HIGH  
STREET

Date	Scale	Sheet Size
04.10.2021	1 : 300	@ A1


Drawn	Chk.
CC	MG

Job No.	Drawing No.	Revision
6111	AR-1-0105	/86

SJB Architects  
Level 2  
490 Crown Street  
Surry Hills NSW  
2010 Australia  
T 61 2 9380 9911  
F 61 2 9380 9922  
www.sjb.com.au





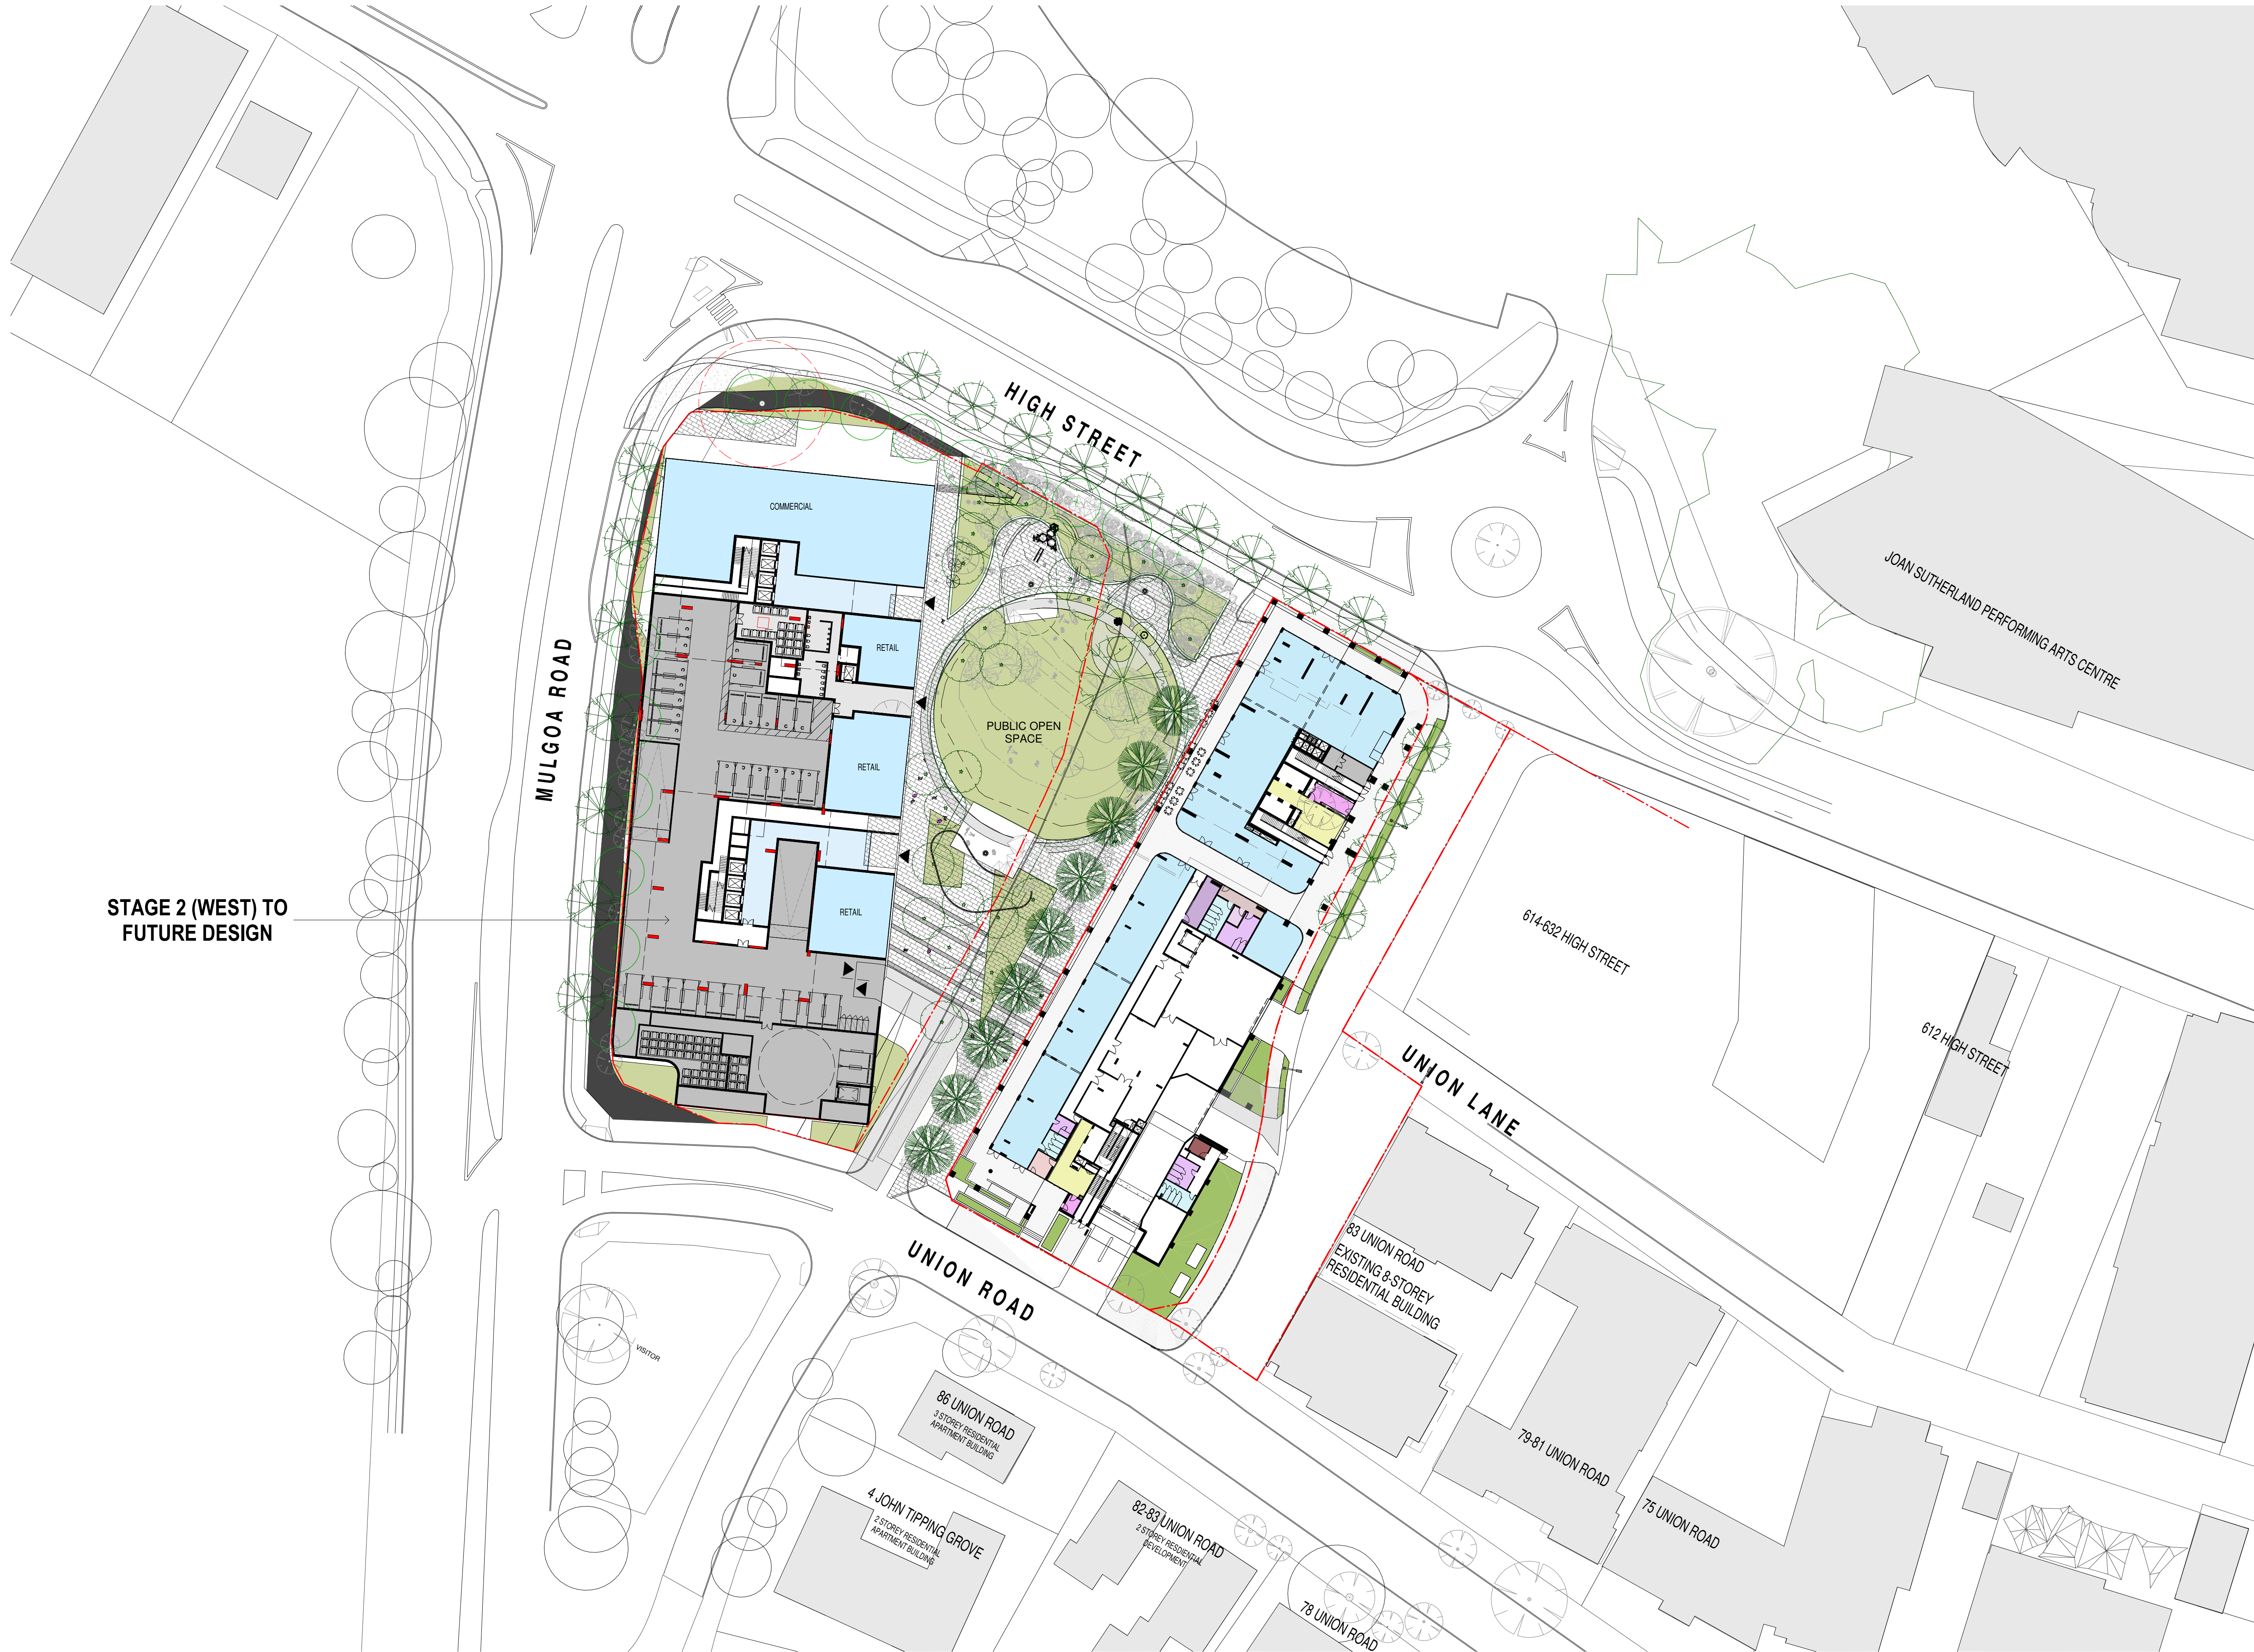

In accepting and utilising this document the recipient agrees that SJB Architecture (NSW) Pty. Ltd. ACN 081 094 724 T/A SJB Architects, retain all common law, statutory law and other rights including copyright and intellectual property rights. The recipient agrees not to use this document for any purpose other than its intended use, to waive all claims against SJB Architects resulting from unauthorised changes; or to reuse the document on other projects without the prior written consent of SJB Architects. Under no circumstances shall transfer of this document be deemed a sale. SJB Architects makes no warranties of fitness for any purpose. The Builder/Contractor shall verify job dimensions prior to any work commencing. Use figured dimensions only. Do not scale drawings.

Nominated Architects: Adam Haddow-7188 | John Pradel-7004

FOR APPROVAL

Rev	Date	Revision
85	07.05.2021	ISSUED FOR DA
86	04.10.2021	ISSUED FOR LEC

Structural Engineer	ROBERT BIRD GROUP
Mechanical / Hydraulic Engineer	JHA CONSULTING ENGINEERS
Electrical Engineer	JHA CONSULTING ENGINEERS
Fire Engineer	OLSSON FIRE & RISK
Access Consultant	ACCESSIBLE BUILDING SOLUTIONS
Basix	EMF GRIFFITHS
Building Key	


Client



Project  
HIGH ST DEVELOPMENT

634-638 HIGH ST & 87-89 UNION RD, PENRITH

Drawing Name  
POTENTIAL FUTURE DEVELOPMENT

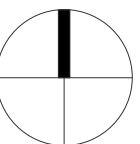

Date	Scale	Sheet Size
04.10.2021	1 : 500	@ A1

Drawn	Chk.
TM	NH

Job No.	Drawing No.	Revision
6111	AR-1-0106	/86



In accepting and utilising this document the recipient agrees that SJB Architects (NSW) Pty. Ltd. ACN 081 094 724 T/A SJB Architects, retain all common law, statutory law and other rights including copyright and intellectual property rights. The recipient agrees not to use this document for any purpose other than its intended use, to waive all claims against SJB Architects resulting from unauthorised changes; or to reuse the document on other projects without the prior written consent of SJB Architects. Under no circumstances shall transfer of this document be deemed a sale. SJB Architects makes no warranties of fitness for any purpose. The Builder/Contractor shall verify job dimensions prior to any work commencing. Use figured dimensions only. Do not scale drawings.

Nominated Architects: Adam Haddow-7188 | John Pradel-7004

FOR APPROVAL

Rev	Date	Revision
86	04.10.2021	ISSUED FOR LEC

Structural Engineer

ROBERT BIRD GROUP

Mechanical / Hydraulic Engineer

JHA CONSULTING ENGINEERS

Electrical Engineer

JHA CONSULTING ENGINEERS

Fire Engineer

OLSSON FIRE & RISK

Access Consultant

ACCESSIBLE BUILDING SOLUTIONS

Basix

EMF GRIFFITHS

Building Key

- Residential Parking
- Visitor Parking
- Commercial Parking
- Service Parking
- Accessible Parking

Client




Project

HIGH ST DEVELOPMENT

634-638 HIGH ST & 87-89  
UNION RD, PENRITH

Drawing Name

1000 OVERALL PLANS  
GA FLOOR PLAN - BASEMENT 03

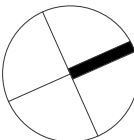


Date	Scale	Sheet Size
04.10.2021	1 : 200	@ A1

Drawn	Chk.
TM	NH

Job No.	Drawing No.	Revision
6111	AR-1-1007	/86

SJB Architects  
Level 2  
490 Crown Street  
Surry Hills NSW  
2010 Australia  
T 61 2 9380 9911  
F 61 2 9380 9922  
www.sjb.com.au

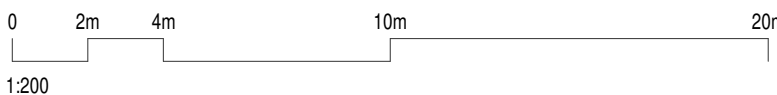





In accepting and utilising this document the recipient agrees that SJB Architecture (NSW) Pty. Ltd. ACN 081 094 724 T/A SJB Architects, retain all common law, statutory law and other rights including copyright and intellectual property rights. The recipient agrees not to use this document for any purpose other than its intended use, to waive all claims against SJB Architects resulting from unauthorised changes; or to reuse the document on other projects without the prior written consent of SJB Architects. Under no circumstances shall transfer of this document be deemed a sale. SJB Architects makes no warranties of fitness for any purpose. The Builder/Contractor shall verify job dimensions prior to any work commencing. Use figured dimensions only. Do not scale drawings.

Nominated Architects: Adam Haddow-7188 | John Pradel-7004

FOR APPROVAL

Rev	Date	Revision
85	07.05.2021	ISSUED FOR DA
86	04.10.2021	ISSUED FOR LEC

Structural Engineer  
ROBERT BIRD GROUP

Mechanical / Hydraulic Engineer  
JHA CONSULTING ENGINEERS

Electrical Engineer  
JHA CONSULTING ENGINEERS

Fire Engineer  
OLSSON FIRE & RISK

Access Consultant  
ACCESSIBLE BUILDING SOLUTIONS

Basix  
EMF GRIFFITHS

Building Key

- Residential Parking
- Visitor Parking
- Commercial Parking
- Service Parking
- Accessible Parking


Client



Project  
HIGH ST DEVELOPMENT

634-638 HIGH ST & 87-89  
UNION RD, PENRITH

Drawing Name  
1000 OVERALL PLANS  
GA FLOOR PLAN - BASEMENT 02

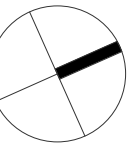


Date	Scale	Sheet Size
04.10.2021	1 : 200	@ A1

Drawn	Chk.
TM	NH

Job No.	Drawing No.	Revision
6111	AR-1-1008	/86

SJB Architects  
Level 2  
490 Crown Street  
Surry Hills NSW  
2010 Australia  
T 61 2 9380 9911  
F 61 2 9380 9922  
www.sjb.com.au

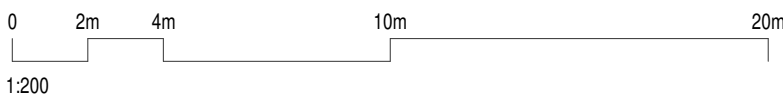



TOGA SITE 2

In accepting and utilising this document the recipient agrees that SJB Architects (NSW) Pty. Ltd. ACN 081 094 724 T/A SJB Architects, retain all common law, statutory law and other rights including copyright and intellectual property rights. The recipient agrees not to use this document for any purpose other than its intended use, to waive all claims against SJB Architects resulting from unauthorised changes; or to reuse the document on other projects without the prior written consent of SJB Architects. Under no circumstances shall transfer of this document be deemed a sale. SJB Architects makes no warranties of fitness for any purpose. The Builder/Contractor shall verify job dimensions prior to any work commencing. Use figured dimensions only. Do not scale drawings.

Nominated Architects: Adam Haddow-7188 | John Pradel-7004

FOR APPROVAL

Rev	Date	Revision
66	24.01.2020	PRELIMINARY ISSUE
70	06.02.2020	PRE DA ISSUE
72	13.02.2020	TRAFFIC COORDINATION
75	20.02.2020	TRAFFIC COORDINATION
76	20.02.2020	ISSUED FOR BASIC COORDINATION
77	21.02.2020	ISSUED FOR TRAFFIC COORDINATION
81	28.02.2020	DRAFT DA ISSUE
82	03.03.2020	ISSUED FOR COORDINATION
83	04.03.2020	ISSUED FOR DA
85	07.05.2021	ISSUED FOR DA
86	04.10.2021	ISSUED FOR LEC

Structural Engineer  
ROBERT BIRD GROUP

Mechanical / Hydraulic Engineer  
JHA CONSULTING ENGINEERS

Electrical Engineer  
JHA CONSULTING ENGINEERS

Fire Engineer  
OLSSON FIRE & RISK

Access Consultant  
ACCESSIBLE BUILDING SOLUTIONS

Basix  
EMF GRIFFITHS

Building Key

- Residential Parking
- Visitor Parking
- Commercial Parking
- Service Parking
- Accessible Parking

Client



Project  
HIGH ST DEVELOPMENT

634-638 HIGH ST & 87-89  
UNION RD, PENRITH

Drawing Name

1000 OVERALL PLANS  
GA FLOOR PLAN - BASEMENT 01

Date  
04.10.2021

Scale  
1 : 200

Sheet Size  
@ A1

Drawn  
GT

Chk.  
MG

Job No.  
6111

Drawing No.  
AR-1-1009

Revision  
/86

SJB Architects  
Level 2  
490 Crown Street  
Surry Hills NSW  
2010 Australia  
T 61 2 9380 9911  
F 61 2 9380 9922  
www.sjb.com.au




Parking Provided

Parking summary	Provided
Visitor	51
Commercial	10
Service	9
Carwash	2
Subtotal	72
Motorcycle spaces	24
Residential	
Single spaces	297
Tandems	37
Subtotal	334
Total Parking Provided	406

Control  
RMS  
DCP  
DCP  
DCP


Parking Provided	Level	Car spaces Provided	Single	Tandems
Basement 03		105	93	12
Basement 02		104	92	12
Basement 01		85	83	2
Ground			0	
P1		30	27	3
P2		41	37	4
P3		41	37	4
Total		406	369	37

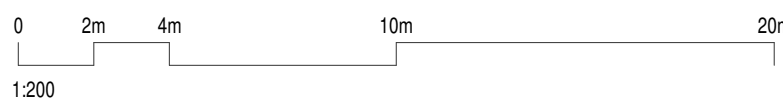



TOGA SITE 2


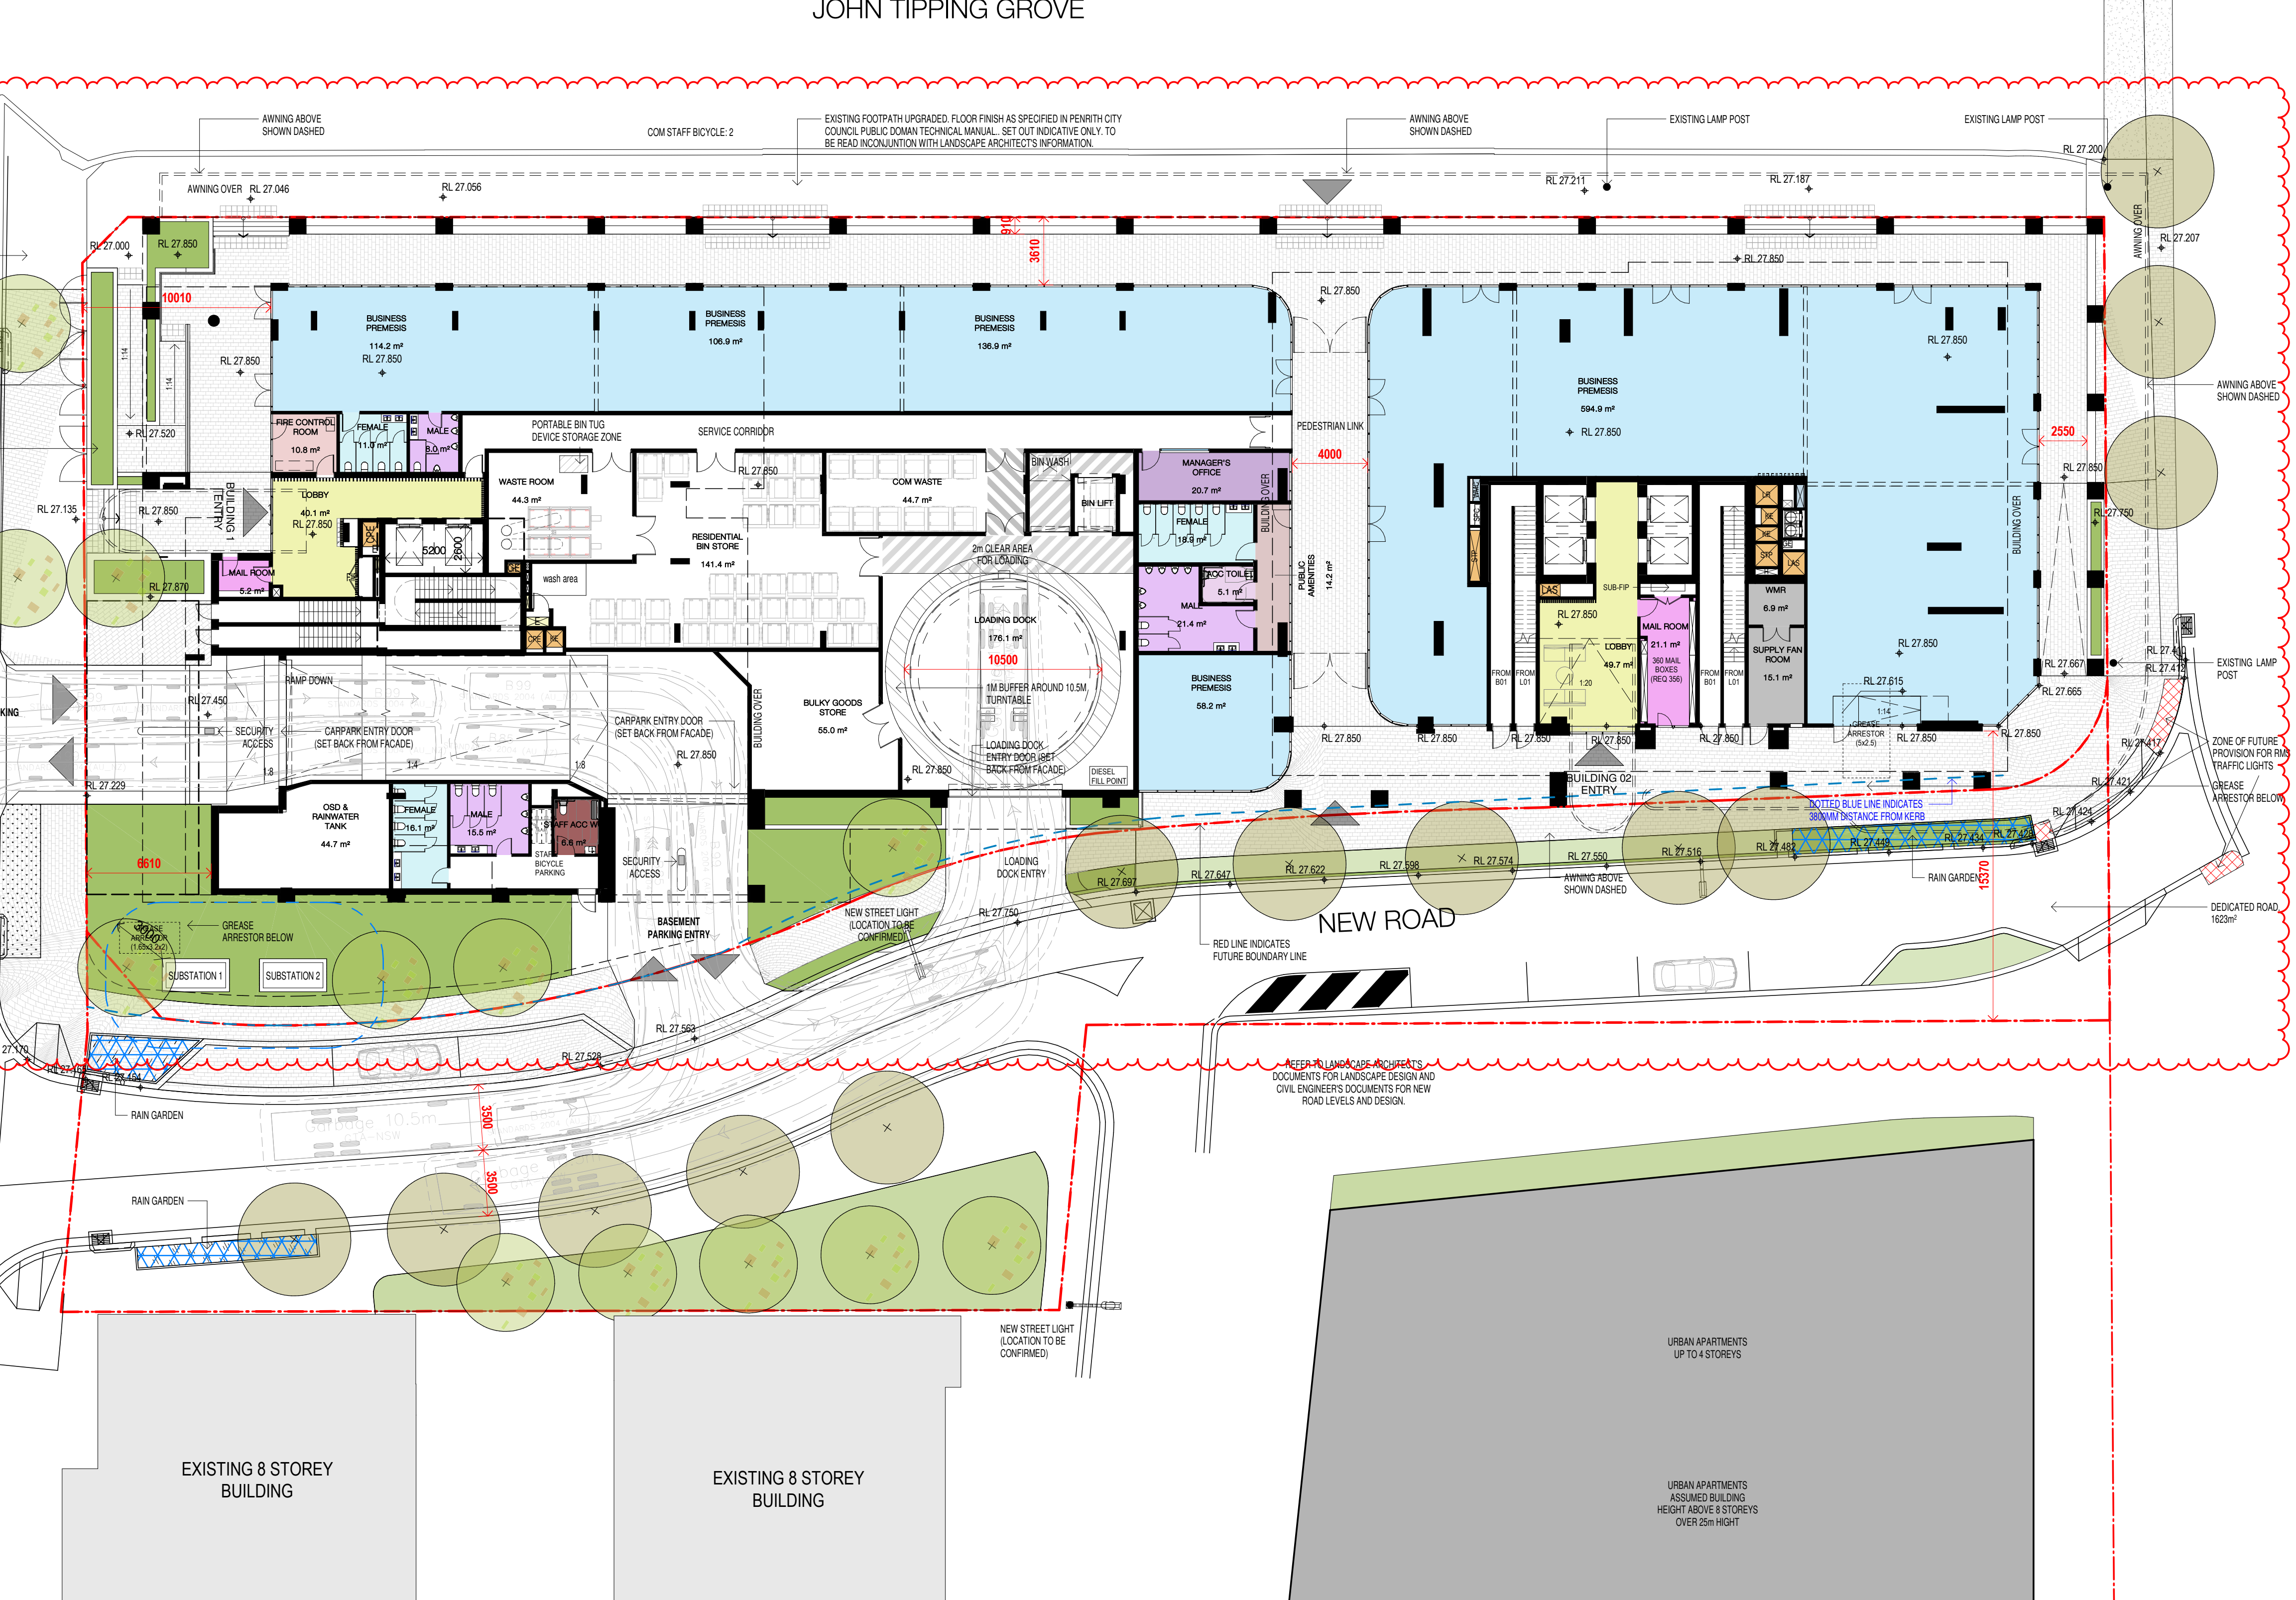

Nominated Architects: Adam Haddow-7188 | John Pradel-7004

**FOR APPROVAL**

Rev	Date	Revision
66	24.01.2020	PRELIMINARY ISSUE
68	04.02.2020	PRELIMINARY ISSUE
70	06.02.2020	PRE DA ISSUE
72	13.02.2020	TRAFFIC COORDINATION
75	20.02.2020	TRAFFIC COORDINATION
76	20.02.2020	ISSUED FOR BASIC COORDINATION
81	28.02.2020	DRAFT DA ISSUE
83	04.03.2020	ISSUED FOR DA
85	07.05.2021	ISSUED FOR DA
86	04.10.2021	ISSUED FOR LEC

Electrical Engineer


**Fire Engineer**

Access Consultant


### Building Key



1000 OVERALL PLANS

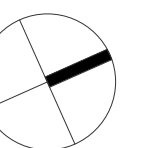

---

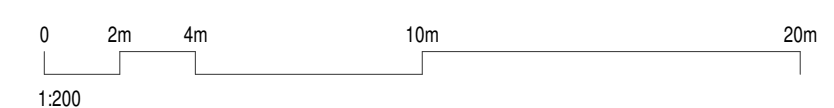



STAGE 2-  
FUTURE DEVELOPMENT

In accepting and utilising this document the recipient agrees that SJB Architects (NSW) Pty Ltd. ACN 081 094 724 T/A SJB Architects, retain all common law, statutory law and other rights including copyright and intellectual property rights. The recipient agrees not to use this document for any purpose other than its intended use; to waive all claims against SJB Architects resulting from unauthorised changes; or to reuse the document on other projects without the prior written consent of SJB Architects. Under no circumstances shall transfer of this document be deemed a sale. SJB Architects makes no warranties of fitness for any purpose. The Builder/Contractor shall verify job dimensions prior to any work commencing. Use figured dimensions only. Do not scale drawings.

Nominated Architects: Adam Haddow-7188 | John Pradel-7004

FOR APPROVAL

Rev	Date	Revision
66	24.01.2020	PRELIMINARY ISSUE
69	06.02.2020	PRELIMINARY ISSUE - LANDSCAPE UPDATES
70	06.02.2020	PRE DA ISSUE
72	13.02.2020	TRAFFIC COORDINATION
75	20.02.2020	TRAFFIC COORDINATION
76	20.02.2020	ISSUED FOR BASIC COORDINATION
81	28.02.2020	DRAFT DA ISSUE
83	04.03.2020	ISSUED FOR DA
85	07.05.2021	ISSUED FOR DA
86	04.10.2021	ISSUED FOR LEC

Structural Engineer  
ROBERT BIRD GROUP

Mechanical / Hydraulic Engineer  
JHA CONSULTING ENGINEERS

Electrical Engineer  
JHA CONSULTING ENGINEERS

Fire Engineer  
OLSSON FIRE & RISK

Access Consultant  
ACCESSIBLE BUILDING SOLUTIONS

Basix  
EMF GRIFFITHS

Building Key	
	Residential Parking
	Visitor Parking
	Commercial Parking
	Service Parking
	Accessible Parking

Client



Project  
HIGH ST DEVELOPMENT

634-638 HIGH ST & 87-89  
UNION RD, PENRITH

Drawing Name  
1000 OVERALL PLANS  
GA FLOOR PLAN - LEVEL 01

Date  
04.10.2021

Scale  
1 : 200

Sheet Size  
@ A1

Drawn  
GT


Chk.  
MG

Job No.  
6111

Drawing No.  
AR-1-1011

Revision  
/86

SJB Architects  
Level 2  
490 Crown Street  
Surry Hills NSW  
2010 Australia  
T 61 2 9380 9911  
F 61 2 9380 9922  
www.sjb.com.au

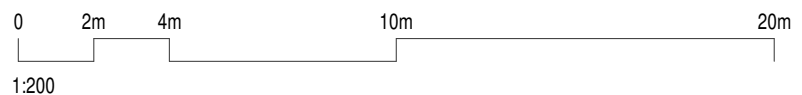



STAGE 2-  
FUTURE DEVELOPMENT

In accepting and utilising this document the recipient agrees that SJB Architects (NSW) Pty. Ltd. ACN 081 094 724 T/A SJB Architects, retain all common law, statutory law and other rights including copyright and intellectual property rights. The recipient agrees not to use this document for any purpose other than its intended use; to waive all claims against SJB Architects resulting from unauthorised changes; or to reuse the document on other projects without the prior written consent of SJB Architects. Under no circumstances shall transfer of this document be deemed a sale. SJB Architects makes no warranties of fitness for any purpose. The Builder/Contractor shall verify job dimensions prior to any work commencing. Use figured dimensions only. Do not scale drawings.

Nominated Architects: Adam Haddow-7188 | John Pradel-7004

FOR APPROVAL

Rev	Date	Revision
66	24.01.2020	PRELIMINARY ISSUE
69	06.02.2020	PRELIMINARY ISSUE - LANDSCAPE UPDATES
70	06.02.2020	PRE DA ISSUE
72	13.02.2020	TRAFFIC COORDINATION
75	20.02.2020	TRAFFIC COORDINATION
76	20.02.2020	ISSUED FOR BASIC COORDINATION
81	28.02.2020	DRAFT DA ISSUE
83	04.03.2021	ISSUED FOR DA
85	07.05.2021	ISSUED FOR DA
86	04.10.2021	ISSUED FOR LEC

Structural Engineer  
ROBERT BIRD GROUP

Mechanical / Hydraulic Engineer  
JHA CONSULTING ENGINEERS

Electrical Engineer  
JHA CONSULTING ENGINEERS

Fire Engineer  
OLSSON FIRE & RISK

Access Consultant  
ACCESSIBLE BUILDING SOLUTIONS

Basix  
EMF GRIFFITHS

Building Key

- Residential Parking
- Visitor Parking
- Commercial Parking
- Service Parking
- Accessible Parking

Client



Project  
HIGH ST DEVELOPMENT

634-638 HIGH ST & 87-89  
UNION RD, PENRITH

Drawing Name

1000 OVERALL PLANS  
GA FLOOR PLAN - LEVEL 02

Date  
04.10.2021

Scale  
1 : 200

Sheet Size  
@ A1

Drawn  
GT


Chk.  
MG

Job No.  
6111

Drawing No.  
AR-1-1012

Revision  
/86

SJB Architects  
Level 2  
490 Crown Street  
Surry Hills NSW  
2010 Australia  
T 61 2 9380 9911  
F 61 2 9380 9922  
www.sjb.com.au

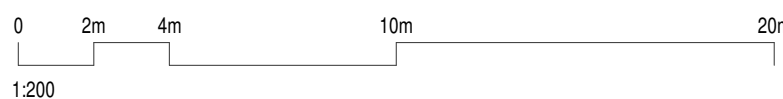



STAGE 2-  
FUTURE DEVELOPMENT

In accepting and utilising this document the recipient agrees that SJB Architects (NSW) Pty. Ltd. ACN 081 094 724 T/A SJB Architects, retain all common law, statutory law and other rights including copyright and intellectual property rights. The recipient agrees not to use this document for any purpose other than its intended use; to waive all claims against SJB Architects resulting from unauthorised changes; or to reuse the document on other projects without the prior written consent of SJB Architects. Under no circumstances shall transfer of this document be deemed a sale. SJB Architects makes no warranties of fitness for any purpose. The Builder/Contractor shall verify job dimensions prior to any work commencing. Use figured dimensions only. Do not scale drawings.

Nominated Architects: Adam Haddow-7188 | John Pradel-7004

FOR APPROVAL

Rev	Date	Revision
66	24.01.2020	PRELIMINARY ISSUE
69	06.02.2020	PRELIMINARY ISSUE - LANDSCAPE UPDATES
70	06.02.2020	PRE DA ISSUE
72	13.02.2020	TRAFFIC COORDINATION
75	20.02.2020	TRAFFIC COORDINATION
76	20.02.2020	ISSUED FOR BASIC COORDINATION
81	28.02.2020	DRAFT DA ISSUE
83	04.03.2020	ISSUED FOR DA
85	07.05.2021	ISSUED FOR DA
86	04.10.2021	ISSUED FOR LEC

Structural Engineer  
ROBERT BIRD GROUP

Mechanical / Hydraulic Engineer  
JHA CONSULTING ENGINEERS

Electrical Engineer  
JHA CONSULTING ENGINEERS

Fire Engineer  
OLSSON FIRE & RISK

Access Consultant  
ACCESSIBLE BUILDING SOLUTIONS

Basix  
EMF GRIFFITHS

Building Key

- Residential Parking
- Visitor Parking
- Commercial Parking
- Service Parking
- Accessible Parking

Client



Project  
HIGH ST DEVELOPMENT

634-638 HIGH ST & 87-89  
UNION RD, PENRITH

Drawing Name

1000 OVERALL PLANS  
GA FLOOR PLAN - LEVEL 03

Date  
04.10.2021

Scale  
1 : 200

Sheet Size  
@ A1

Drawn  
GT


Chk.  
MG

Job No.  
6111

Drawing No.  
AR-1-1014

Revision  
/86

SJB Architects  
Level 2  
490 Crown Street  
Surry Hills NSW  
2010 Australia  
T 61 2 9380 9911  
F 61 2 9380 9922  
www.sjb.com.au

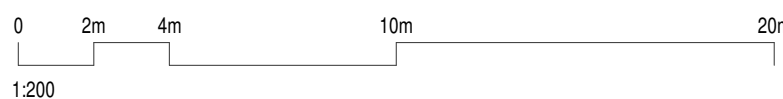



STAGE 2-  
FUTURE DEVELOPMENT

In accepting and utilising this document the recipient agrees that SJB Architects (NSW) Pty. Ltd. ACN 081 094 724 T/A SJB Architects, retain all common law, statutory law and other rights including copyright and intellectual property rights. The recipient agrees not to use this document for any purpose other than its intended use; to waive all claims against SJB Architects resulting from unauthorised changes; or to reuse the document on other projects without the prior written consent of SJB Architects. Under no circumstances shall transfer of this document be deemed a sale. SJB Architects makes no warranties of fitness for any purpose. The Builder/Contractor shall verify job dimensions prior to any work commencing. Use figured dimensions only. Do not scale drawings.

Nominated Architects: Adam Haddow-7188 | John Pradel-7004

FOR APPROVAL

Rev	Date	Revision
66	24.01.2020	PRELIMINARY ISSUE
69	06.02.2020	PRELIMINARY ISSUE - LANDSCAPE UPDATES
70	06.02.2020	PRE DA ISSUE
76	20.02.2020	ISSUED FOR BASIX COORDINATION
78	26.02.2020	ISSUED FOR LANDSCAPE COORDINATION
80	27.02.2020	ISSUED FOR LANDSCAPE COORDINATION
81	28.02.2020	DRAFT DA ISSUE
83	04.03.2020	ISSUED FOR DA
85	07.05.2021	ISSUED FOR DA
86	04.10.2021	ISSUED FOR LEC

Structural Engineer

ROBERT BIRD GROUP

Mechanical / Hydraulic Engineer

JHA CONSULTING ENGINEERS

Electrical Engineer

JHA CONSULTING ENGINEERS

Fire Engineer

OLSSON FIRE & RISK

Access Consultant

ACCESSIBLE BUILDING SOLUTIONS

Basix

EMF GRIFFITHS

Building Key

- 1B S - STORAGE
- 1B + ST
- 2B/2BTH
- 2B
- 2B + ST/M
- 3B
- 1800mm PRIVACY SCREENS

Client



Project

HIGH ST DEVELOPMENT

634-638 HIGH ST & 87-89  
UNION RD, PENRITH

Drawing Name

1000 OVERALL PLANS  
GA FLOOR PLAN - LEVEL 04

Date 04.10.2021 Scale 1 : 200 Sheet Size @ A1


Drawn Chk.

GT MG

Job No. Drawing No. Revision

6111 AR-1-1015 /86

SJB Architects  
Level 2  
490 Crown Street  
Surry Hills NSW  
2010 Australia  
T 61 2 9380 9911  
F 61 2 9380 9922  
www.sjb.com.au

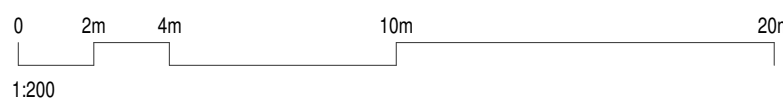



STAGE 2-  
FUTURE DEVELOPMENT

In accepting and utilising this document the recipient agrees that SJB Architects (NSW) Pty. Ltd. ACN 081 094 724 T/A SJB Architects, retain all common law, statutory law and other rights including copyright and intellectual property rights. The recipient agrees not to use this document for any purpose other than its intended use; to waive all claims against SJB Architects resulting from unauthorised changes; or to reuse the document on other projects without the prior written consent of SJB Architects. Under no circumstances shall transfer of this document be deemed a sale. SJB Architects makes no warranties of fitness for any purpose. The Builder/Contractor shall verify job dimensions prior to any work commencing. Use figured dimensions only. Do not scale drawings.

Nominated Architects: Adam Haddow-7188 | John Pradel-7004

FOR APPROVAL

Rev	Date	Revision
66	24.01.2020	PRELIMINARY ISSUE
70	06.02.2020	PRE DA ISSUE
76	20.02.2020	ISSUED FOR BASIX COORDINATION
81	28.02.2020	DRAFT DA ISSUE
83	04.03.2020	ISSUED FOR DA
85	07.05.2021	ISSUED FOR DA
86	04.10.2021	ISSUED FOR LEC

Structural Engineer  
ROBERT BIRD GROUP

Mechanical / Hydraulic Engineer  
JHA CONSULTING ENGINEERS

Electrical Engineer  
JHA CONSULTING ENGINEERS

Fire Engineer  
OLSSON FIRE & RISK

Access Consultant  
ACCESSIBLE BUILDING SOLUTIONS

Basix  
EMF GRIFFITHS

Building Key

- 1B S - STORAGE
- 1B + ST
- 2B/2BTH
- 2B
- 2B + ST/M
- 3B
- 1800mm PRIVACY SCREENS

Client



Project  
HIGH ST DEVELOPMENT

634-638 HIGH ST & 87-89  
UNION RD, PENRITH

Drawing Name

1000 OVERALL PLANS  
GA FLOOR PLAN - LEVEL 05

Date Scale Sheet Size  
04.10.2021 1 : 200 @ A1


Drawn Chk.

GT MG

Job No. Drawing No. Revision

6111 AR-1-1016 /86

SJB Architects  
Level 2  
490 Crown Street  
Surry Hills NSW  
2010 Australia  
T 61 2 9380 9911  
F 61 2 9380 9922  
www.sjb.com.au

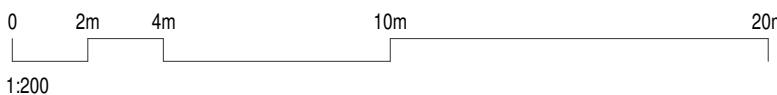



STAGE 2-  
FUTURE DEVELOPMENT

In accepting and utilising this document the recipient agrees that SJB Architects (NSW) Pty. Ltd. ACN 081 094 724 T/A SJB Architects, retain all common law, statutory law and other rights including copyright and intellectual property rights. The recipient agrees not to use this document for any purpose other than its intended use; to waive all claims against SJB Architects resulting from unauthorised changes; or to reuse the document on other projects without the prior written consent of SJB Architects. Under no circumstances shall transfer of this document be deemed a sale. SJB Architects makes no warranties of fitness for any purpose. The Builder/Contractor shall verify job dimensions prior to any work commencing. Use figured dimensions only. Do not scale drawings.

Nominated Architects: Adam Haddow-7188 | John Pradel-7004

FOR APPROVAL

Rev	Date	Revision
66	24.01.2020	PRELIMINARY ISSUE
70	06.02.2020	PRE DA ISSUE
76	20.02.2020	ISSUED FOR BASIX COORDINATION
81	28.02.2020	DRAFT DA ISSUE
83	04.03.2020	ISSUED FOR DA
85	07.05.2021	ISSUED FOR DA
86	04.10.2021	ISSUED FOR LEC

Structural Engineer  
ROBERT BIRD GROUP

Mechanical / Hydraulic Engineer  
JHA CONSULTING ENGINEERS

Electrical Engineer  
JHA CONSULTING ENGINEERS

Fire Engineer  
OLSSON FIRE & RISK

Access Consultant  
ACCESSIBLE BUILDING SOLUTIONS

Basix  
EMF GRIFFITHS

Building Key

- 1B 1B
- 1B + ST 1B + ST
- 2B/2BTH 2B/2BTH
- 2B 2B
- 2B + ST/M 2B + ST/M
- 3B 3B
- 1800mm PRIVACY SCREENS 1800mm PRIVACY SCREENS
- S - STORAGE S - STORAGE

Client



Project  
HIGH ST DEVELOPMENT

634-638 HIGH ST & 87-89  
UNION RD, PENRITH

Drawing Name

1000 OVERALL PLANS  
GA FLOOR PLAN - LEVEL 06-07

Date 04.10.2021 Scale 1 : 200 Sheet Size @ A1


Drawn Chk.

GT MG

Job No. Drawing No. Revision

6111 AR-1-1018 /86

SJB Architects  
Level 2  
490 Crown Street  
Surry Hills NSW  
2010 Australia  
T 61 2 9380 9911  
F 61 2 9380 9922  
www.sjb.com.au

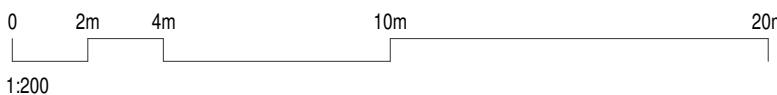



STAGE 2-  
FUTURE DEVELOPMENT

In accepting and utilising this document the recipient agrees that SJB Architects (NSW) Pty. Ltd. ACN 081 094 724 T/A SJB Architects, retain all common law, statutory law and other rights including copyright and intellectual property rights. The recipient agrees not to use this document for any purpose other than its intended use; to waive all claims against SJB Architects resulting from unauthorised changes; or to reuse the document on other projects without the prior written consent of SJB Architects. Under no circumstances shall transfer of this document be deemed a sale. SJB Architects makes no warranties of fitness for any purpose. The Builder/Contractor shall verify job dimensions prior to any work commencing. Use figured dimensions only. Do not scale drawings.

Nominated Architects: Adam Haddow-7188 | John Pradel-7004

FOR APPROVAL

Rev	Date	Revision
66	24.01.2020	PRELIMINARY ISSUE
70	06.02.2020	PRE DA ISSUE
76	20.02.2020	ISSUED FOR BASIX COORDINATION
81	28.02.2020	DRAFT DA ISSUE
83	04.03.2020	ISSUED FOR DA
85	07.05.2021	ISSUED FOR DA
86	04.10.2021	ISSUED FOR LEC

Structural Engineer  
ROBERT BIRD GROUP

Mechanical / Hydraulic Engineer  
JHA CONSULTING ENGINEERS

Electrical Engineer  
JHA CONSULTING ENGINEERS

Fire Engineer  
OLSSON FIRE & RISK

Access Consultant  
ACCESSIBLE BUILDING SOLUTIONS

Basix  
EMF GRIFFITHS

Building Key

- 1B S - STORAGE
- 1B + ST
- 2B/2BTH
- 2B
- 2B + ST/M
- 3B
- 1800mm PRIVACY SCREENS

Client



Project  
HIGH ST DEVELOPMENT

634-638 HIGH ST & 87-89  
UNION RD, PENRITH

Drawing Name

1000 OVERALL PLANS  
GA FLOOR PLAN - LEVEL 08

Date 04.10.2021 Scale 1 : 200 Sheet Size @ A1


Drawn Chk.

GT MG

Job No. Drawing No. Revision

6111 AR-1-1019 /86

SJB Architects  
Level 2  
490 Crown Street  
Surry Hills NSW  
2010 Australia  
T 61 2 9380 9911  
F 61 2 9380 9922  
www.sjb.com.au

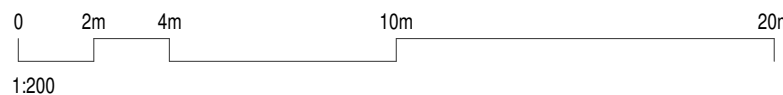



STAGE 2-  
FUTURE DEVELOPMENT

In accepting and utilising this document the recipient agrees that SJB Architects (NSW) Pty. Ltd. ACN 081 094 724 T/A SJB Architects, retain all common law, statutory law and other rights including copyright and intellectual property rights. The recipient agrees not to use this document for any purpose other than its intended use; to waive all claims against SJB Architects resulting from unauthorised changes; or to reuse the document on other projects without the prior written consent of SJB Architects. Under no circumstances shall transfer of this document be deemed a sale. SJB Architects makes no warranties of fitness for any purpose. The Builder/Contractor shall verify job dimensions prior to any work commencing. Use figured dimensions only. Do not scale drawings.

Nominated Architects: Adam Haddow-7188 | John Pradel-7004

FOR APPROVAL

Rev	Date	Revision
66	24.01.2020	PRELIMINARY ISSUE
70	06.02.2020	PRE DA ISSUE
76	20.02.2020	ISSUED FOR BASIX COORDINATION
81	28.02.2020	DRAFT DA ISSUE
83	04.03.2020	ISSUED FOR DA
85	07.05.2021	ISSUED FOR DA
86	04.10.2021	ISSUED FOR LEC

Structural Engineer  
ROBERT BIRD GROUP

Mechanical / Hydraulic Engineer  
JHA CONSULTING ENGINEERS

Electrical Engineer  
JHA CONSULTING ENGINEERS

Fire Engineer  
OLSSON FIRE & RISK

Access Consultant  
ACCESSIBLE BUILDING SOLUTIONS

Basix  
EMF GRIFFITHS

Building Key

- 1B S - STORAGE
- 1B + ST
- 2B/2BTH
- 2B
- 2B + ST/M
- 3B
- 1800mm PRIVACY SCREENS

Client



Project  
HIGH ST DEVELOPMENT

634-638 HIGH ST & 87-89  
UNION RD, PENRITH

Drawing Name


1000 OVERALL PLANS  
GA FLOOR PLAN - LEVEL 09 - 10

Date Scale Sheet Size  
04.10.2021 1 : 200 @ A1

Drawn Chk.  
SC MG

Job No. Drawing No. Revision  
6111 AR-1-1020 /86

SJB Architects  
Level 2  
490 Crown Street  
Surry Hills NSW  
2010 Australia  
T 61 2 9380 9911  
F 61 2 9380 9922  
www.sjb.com.au

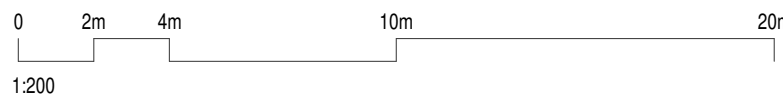



STAGE 2-  
FUTURE DEVELOPMENT

In accepting and utilising this document the recipient agrees that SJB Architects (NSW) Pty. Ltd. ACN 081 094 724 T/A SJB Architects, retain all common law, statutory law and other rights including copyright and intellectual property rights. The recipient agrees not to use this document for any purpose other than its intended use; to waive all claims against SJB Architects resulting from unauthorised changes; or to reuse the document on other projects without the prior written consent of SJB Architects. Under no circumstances shall transfer of this document be deemed a sale. SJB Architects makes no warranties of fitness for any purpose. The Builder/Contractor shall verify job dimensions prior to any work commencing. Use figured dimensions only. Do not scale drawings.

Nominated Architects: Adam Haddow-7188 | John Pradel-7004

FOR APPROVAL

Rev	Date	Revision
66	24.01.2020	PRELIMINARY ISSUE
70	06.02.2020	PRE DA ISSUE
76	20.02.2020	ISSUED FOR BASIX COORDINATION
81	28.02.2020	DRAFT DA ISSUE
83	04.03.2020	ISSUED FOR DA
85	07.05.2021	ISSUED FOR DA
86	04.10.2021	ISSUED FOR LEC

Structural Engineer	ROBERT BIRD GROUP
Mechanical / Hydraulic Engineer	JHA CONSULTING ENGINEERS
Electrical Engineer	JHA CONSULTING ENGINEERS
Fire Engineer	OLSSON FIRE & RISK
Access Consultant	ACCESSIBLE BUILDING SOLUTIONS
Basix	EMF GRIFFITHS

Building Key

1B	S - STORAGE
1B + ST	
2B/2BTH	
2B	
2B + ST/M	
3B	
1800mm PRIVACY SCREENS	

Client




Project

HIGH ST DEVELOPMENT

634-638 HIGH ST & 87-89  
UNION RD, PENRITH

Drawing Name

1000 OVERALL PLANS  
GA FLOOR PLAN - LEVEL 11

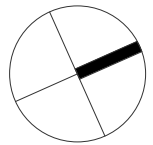

Date	Scale	Sheet Size
04.10.2021	1 : 200	@ A1

Drawn	Chk.
SC	MG

Job No.	Drawing No.	Revision
6111	AR-1-1022	/86

**SJB Architects**  
Level 2  
490 Crown Street  
Surry Hills NSW  
2010 Australia  
T 61 2 9380 9911  
F 61 2 9380 9922  
www.sjb.com.au





STAGE 2-  
FUTURE DEVELOPMENT

In accepting and utilising this document the recipient agrees that SJB Architects (NSW) Pty. Ltd. ACN 081 094 724 T/A SJB Architects, retain all common law, statutory law and other rights including copyright and intellectual property rights. The recipient agrees not to use this document for any purpose other than its intended use; to waive all claims against SJB Architects resulting from unauthorised changes; or to reuse the document on other projects without the prior written consent of SJB Architects. Under no circumstances shall transfer of this document be deemed a sale. SJB Architects makes no warranties of fitness for any purpose. The Builder/Contractor shall verify job dimensions prior to any work commencing. Use figured dimensions only. Do not scale drawings.

Nominated Architects: Adam Haddow-7188 | John Pradel-7004

FOR APPROVAL

Rev	Date	Revision
66	24.01.2020	PRELIMINARY ISSUE
70	06.02.2020	PRE DA ISSUE
76	20.02.2020	ISSUED FOR BASIX COORDINATION
81	28.02.2020	DRAFT DA ISSUE
83	04.03.2020	ISSUED FOR DA
85	07.05.2021	ISSUED FOR DA
86	04.10.2021	ISSUED FOR LEC

Structural Engineer	ROBERT BIRD GROUP
Mechanical / Hydraulic Engineer	JHA CONSULTING ENGINEERS
Electrical Engineer	JHA CONSULTING ENGINEERS
Fire Engineer	OLSSON FIRE & RISK
Access Consultant	ACCESSIBLE BUILDING SOLUTIONS
Basix	EMF GRIFFITHS

Building Key

1B	S - STORAGE
1B + ST	
2B/2BTH	
2B	
2B + ST/M	
3B	
1800mm PRIVACY SCREENS	

Client




Project

HIGH ST DEVELOPMENT

634-638 HIGH ST & 87-89  
UNION RD, PENRITH

Drawing Name

1000 OVERALL PLANS  
GA FLOOR PLAN - LEVEL 12

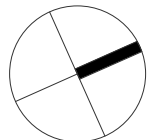


Date	Scale	Sheet Size
04.10.2021	1 : 200	@ A1

Drawn	Chk.
GT	MG

Job No. Drawing No. Revision

6111 AR-1-1023 /86

**SJB Architects**  
Level 2  
490 Crown Street  
Surry Hills NSW  
2010 Australia  
T 61 2 9380 9911  
F 61 2 9380 9922  
www.sjb.com.au

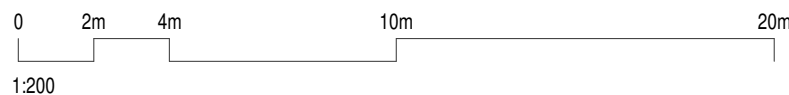



STAGE 2-  
FUTURE DEVELOPMENT

In accepting and utilising this document the recipient agrees that SJB Architects (NSW) Pty. Ltd. ACN 081 094 724 T/A SJB Architects, retain all common law, statutory law and other rights including copyright and intellectual property rights. The recipient agrees not to use this document for any purpose other than its intended use; to waive all claims against SJB Architects resulting from unauthorised changes; or to reuse the document on other projects without the prior written consent of SJB Architects. Under no circumstances shall transfer of this document be deemed a sale. SJB Architects makes no warranties of fitness for any purpose. The Builder/Contractor shall verify job dimensions prior to any work commencing. Use figured dimensions only. Do not scale drawings.

Nominated Architects: Adam Haddow-7188 | John Pradel-7004

FOR APPROVAL

Rev	Date	Revision
66	24.01.2020	PRELIMINARY ISSUE
70	06.02.2020	PRE DA ISSUE
76	20.02.2020	ISSUED FOR BASIX COORDINATION
81	28.02.2020	DRAFT DA ISSUE
83	04.03.2020	ISSUED FOR DA
85	07.05.2021	ISSUED FOR DA
86	04.10.2021	ISSUED FOR LEC

Structural Engineer  
ROBERT BIRD GROUP

Mechanical / Hydraulic Engineer  
JHA CONSULTING ENGINEERS

Electrical Engineer  
JHA CONSULTING ENGINEERS

Fire Engineer  
OLSSON FIRE & RISK

Access Consultant  
ACCESSIBLE BUILDING SOLUTIONS

Basix  
EMF GRIFFITHS

Building Key

- 1B S - STORAGE
- 1B + ST
- 2B/2BTH
- 2B
- 2B + ST/M
- 3B
- 1800mm PRIVACY SCREENS

Client




Project  
HIGH ST DEVELOPMENT

634-638 HIGH ST & 87-89  
UNION RD, PENRITH

Drawing Name

1000 OVERALL PLANS  
GA FLOOR PLAN - LEVEL 13

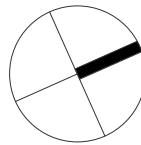


Date	Scale	Sheet Size
04.10.2021	1 : 200	@ A1

Drawn	Chk.
GT	MG

Job No.	Drawing No.	Revision
6111	AR-1-1024	/86

SJB Architects  
Level 2  
490 Crown Street  
Surry Hills NSW  
2010 Australia  
T 61 2 9380 9911  
F 61 2 9380 9922  
www.sjb.com.au

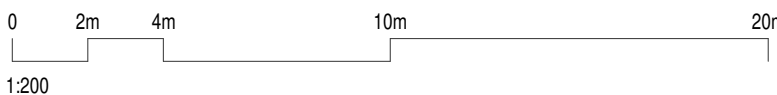



STAGE 2-  
FUTURE DEVELOPMENT

In accepting and utilising this document the recipient agrees that SJB Architects (NSW) Pty. Ltd. ACN 081 094 724 T/A SJB Architects, retain all common law, statutory law and other rights including copyright and intellectual property rights. The recipient agrees not to use this document for any purpose other than its intended use; to waive all claims against SJB Architects resulting from unauthorised changes; or to reuse the document on other projects without the prior written consent of SJB Architects. Under no circumstances shall transfer of this document be deemed a sale. SJB Architects makes no warranties of fitness for any purpose. The Builder/Contractor shall verify job dimensions prior to any work commencing. Use figured dimensions only. Do not scale drawings.

Nominated Architects: Adam Haddow-7188 | John Pradel-7004

FOR APPROVAL

Rev	Date	Revision
66	24.01.2020	PRELIMINARY ISSUE
70	06.02.2020	PRE DA ISSUE
76	20.02.2020	ISSUED FOR BASIX COORDINATION
81	28.02.2020	DRAFT DA ISSUE
83	04.03.2020	ISSUED FOR DA
85	07.05.2021	ISSUED FOR DA
86	04.10.2021	ISSUED FOR LEC

Structural Engineer  
ROBERT BIRD GROUP

Mechanical / Hydraulic Engineer  
JHA CONSULTING ENGINEERS

Electrical Engineer  
JHA CONSULTING ENGINEERS

Fire Engineer  
OLSSON FIRE & RISK

Access Consultant  
ACCESSIBLE BUILDING SOLUTIONS

Basix  
EMF GRIFFITHS

Building Key

- 1B S - STORAGE
- 1B + ST
- 2B/2BTH
- 2B
- 2B + ST/M
- 3B
- 1800mm PRIVACY SCREENS


Client



Project  
HIGH ST DEVELOPMENT

634-638 HIGH ST & 87-89  
UNION RD, PENRITH

Drawing Name  
1000 OVERALL PLANS  
GA FLOOR PLAN - LEVEL 14

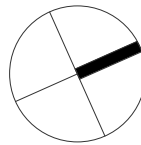


Date	Scale	Sheet Size
04.10.2021	1 : 200	@ A1

Drawn	Chk.
GT	MG

Job No.	Drawing No.	Revision
6111	AR-1-1025	/86

SJB Architects  
Level 2  
490 Crown Street  
Surry Hills NSW  
2010 Australia  
T 61 2 9380 9911  
F 61 2 9380 9922  
www.sjb.com.au

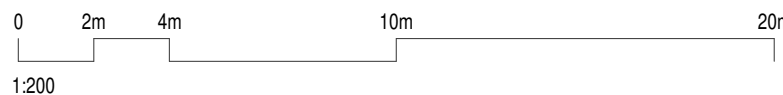



STAGE 2-  
FUTURE DEVELOPMENT

In accepting and utilising this document the recipient agrees that SJB Architecture (NSW) Pty. Ltd. ACN 081 094 724 T/A SJB Architects, retain all common law, statutory law and other rights including copyright and intellectual property rights. The recipient agrees not to use this document for any purpose other than its intended use; to waive all claims against SJB Architects resulting from unauthorised changes; or to reuse the document on other projects without the prior written consent of SJB Architects. Under no circumstances shall transfer of this document be deemed a sale. SJB Architects makes no warranties of fitness for any purpose. The Builder/Contractor shall verify job dimensions prior to any work commencing. Use figured dimensions only. Do not scale drawings.

Nominated Architects: Adam Haddow-7188 | John Pradel-7004

FOR APPROVAL

Rev	Date	Revision
66	24.01.2020	PRELIMINARY ISSUE
70	06.02.2020	PRE DA ISSUE
76	20.02.2020	ISSUED FOR BASIX COORDINATION
81	28.02.2020	DRAFT DA ISSUE
83	04.03.2020	ISSUED FOR DA
85	07.05.2021	ISSUED FOR DA
86	04.10.2021	ISSUED FOR LEC

Structural Engineer

ROBERT BIRD GROUP

Mechanical / Hydraulic Engineer

JHA CONSULTING ENGINEERS

Electrical Engineer

JHA CONSULTING ENGINEERS

Fire Engineer

OLSSON FIRE & RISK

Access Consultant

ACCESSIBLE BUILDING SOLUTIONS

Basix

EMF GRIFFITHS

Building Key

- 1B S - STORAGE
- 1B + ST
- 2B/2BTH
- 2B
- 2B + ST/M
- 3B
- 1800mm PRIVACY SCREENS

Client




Project

HIGH ST DEVELOPMENT

634-638 HIGH ST & 87-89  
UNION RD, PENRITH

Drawing Name

1000 OVERALL PLANS  
GA FLOOR PLAN - LEVEL 15 - 28

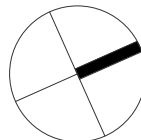


Date	Scale	Sheet Size
04.10.2021	1 : 200	@ A1

Drawn	Chk.
GT	MG

Job No.	Drawing No.	Revision
6111	AR-1-1026	/86

SJB Architects  
Level 2  
490 Crown Street  
Surry Hills NSW  
2010 Australia  
T 61 2 9380 9911  
F 61 2 9380 9922  
www.sjb.com.au

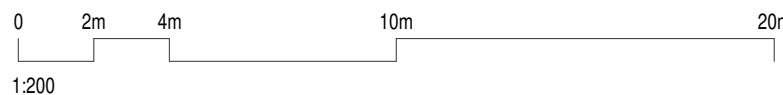



In accepting and utilising this document the recipient agrees that SJB Architecture (NSW) Pty. Ltd. ACN 081 094 724 T/A SJB Architects, retain all common law, statutory law and other rights including copyright and intellectual property rights. The recipient agrees not to use this document for any purpose other than its intended use; to waive all claims against SJB Architects resulting from unauthorised changes; or to reuse the document on other projects without the prior written consent of SJB Architects. Under no circumstances shall transfer of this document be deemed a sale. SJB Architects makes no warranties of fitness for any purpose. The Builder/Contractor shall verify job dimensions prior to any work commencing. Use figured dimensions only. Do not scale drawings.

Nominated Architects: Adam Haddow-7188 | John Pradel-7004

FOR APPROVAL

Rev Date Revision

86 04.10.2021 ISSUED FOR LEC

Structural Engineer

ROBERT BIRD GROUP

Mechanical / Hydraulic Engineer

JHA CONSULTING ENGINEERS

Electrical Engineer

JHA CONSULTING ENGINEERS

Fire Engineer

OLSSON FIRE & RISK

Access Consultant

ACCESSIBLE BUILDING SOLUTIONS

Basix

EMF GRIFFITHS

Building Key

- 1B

1B + ST

2B/2BTH

2B

2B + ST/M

3B

1800mm PRIVACY SCREENS
- S - STORAGE

Client




Project

HIGH ST DEVELOPMENT

634-638 HIGH ST & 87-89  
UNION RD, PENRITH

Drawing Name

1000 OVERALL PLANS  
GA FLOOR PLAN - LEVEL 29

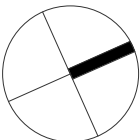

Date Scale Sheet Size  
04.10.2021 1 : 200 @ A1


Drawn Chk.

TM NH

Job No. Drawing No. Revision

6111 AR-1-1027 /86

SJB Architects  
Level 2  
490 Crown Street  
Surry Hills NSW  
2010 Australia  
T 61 2 9380 9911  
F 61 2 9380 9922  
www.sjb.com.au

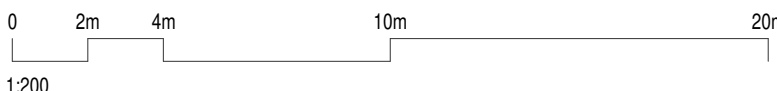




In accepting and utilising this document the recipient agrees that SJB Architecture (NSW) Pty. Ltd. ACN 081 094 724 T/A SJB Architects, retain all common law, statutory law and other rights including copyright and intellectual property rights. The recipient agrees not to use this document for any purpose other than its intended use; to waive all claims against SJB Architects resulting from unauthorised changes; or to reuse the document on other projects without the prior written consent of SJB Architects. Under no circumstances shall transfer of this document be deemed a sale. SJB Architects makes no warranties of fitness for any purpose. The Builder/Contractor shall verify job dimensions prior to any work commencing. Use figured dimensions only. Do not scale drawings.

Nominated Architects: Adam Haddow-7188 | John Pradel-7004

FOR APPROVAL

Rev	Date	Revision
86	04.10.2021	ISSUED FOR LEC

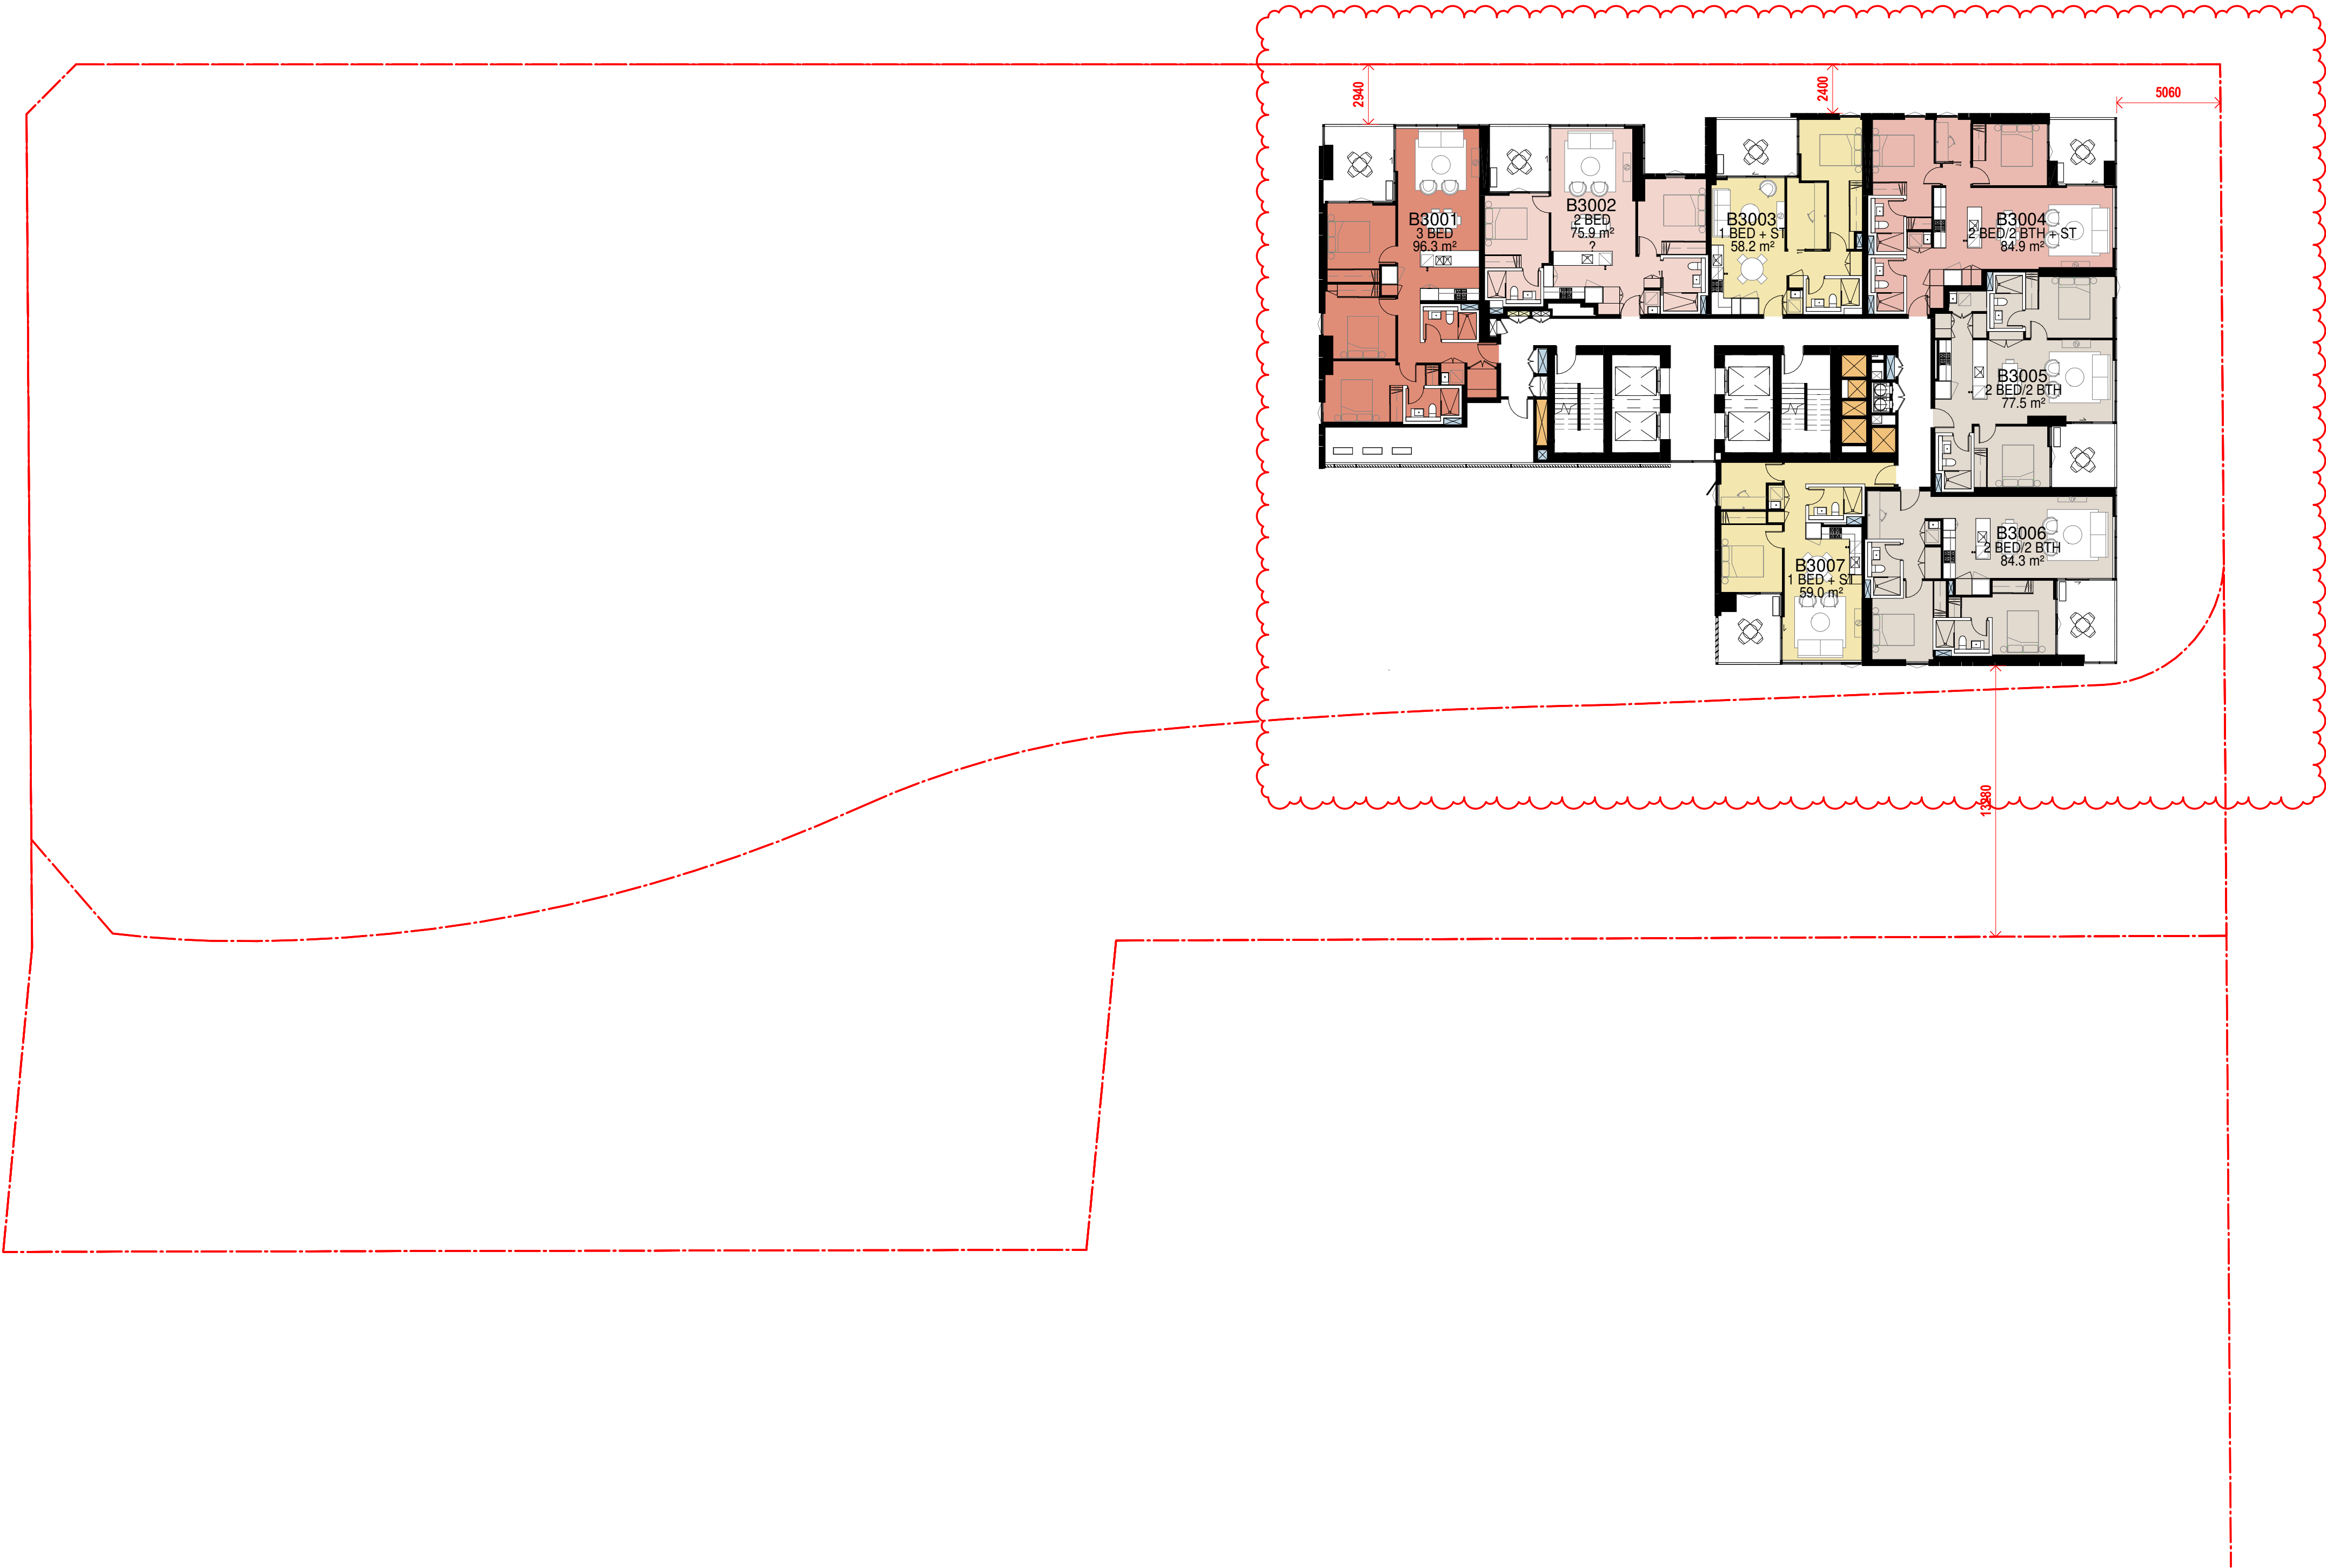

Structural Engineer
ROBERT BIRD GROUP
Mechanical / Hydraulic Engineer
JHA CONSULTING ENGINEERS
Electrical Engineer
JHA CONSULTING ENGINEERS
Fire Engineer
OLSSON FIRE & RISK
Access Consultant
ACCESSIBLE BUILDING SOLUTIONS
Basix
EMF GRIFFITHS
Building Key

1B	S - STORAGE
1B + ST	
2B/2BTH	
2B	
2B + ST/M	
3B	
1800mm PRIVACY SCREENS	

Client




Project

HIGH ST DEVELOPMENT

634-638 HIGH ST & 87-89  
UNION RD, PENRITH

Drawing Name


1000 OVERALL PLANS  
GA FLOOR PLAN - LEVEL 30

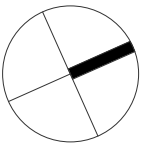

Date	Scale	Sheet Size
04.10.2021	1 : 200	@ A1

Drawn	Chk.
TM	NH

Job No.	Drawing No.	Revision
6111	AR-1-1028	/86

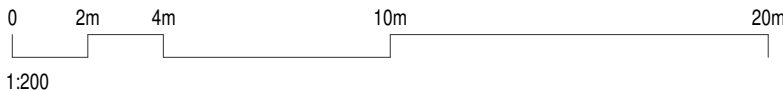



In accepting and utilising this document the recipient agrees that SJB Architecture (NSW) Pty. Ltd. ACN 081 094 724 T/A SJB Architects, retain all common law, statutory law and other rights including copyright and intellectual property rights. The recipient agrees not to use this document for any purpose other than its intended use; to waive all claims against SJB Architects resulting from unauthorised changes; or to reuse the document on other projects without the prior written consent of SJB Architects. Under no circumstances shall transfer of this document be deemed a sale. SJB Architects makes no warranties of fitness for any purpose. The Builder/Contractor shall verify job dimensions prior to any work commencing. Use figured dimensions only. Do not scale drawings.

Nominated Architects: Adam Haddow-7188 | John Pradel-7004

FOR APPROVAL

Rev Date Revision

86 04.10.2021 ISSUED FOR LEC

Structural Engineer

ROBERT BIRD GROUP

Mechanical / Hydraulic Engineer

JHA CONSULTING ENGINEERS

Electrical Engineer

JHA CONSULTING ENGINEERS

Fire Engineer

OLSSON FIRE & RISK

Access Consultant

ACCESSIBLE BUILDING SOLUTIONS

Basix

EMF GRIFFITHS

Building Key

Client




Project

HIGH ST DEVELOPMENT

634-638 HIGH ST & 87-89  
UNION RD, PENRITH

Drawing Name

GA FLOOR PLAN - LEVEL 31

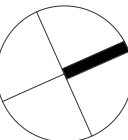

Date 04.10.2021 Scale 1 : 200 Sheet Size @ A1


Drawn Chk.

TM NH

Job No. Drawing No. Revision

6111 AR-1-1029 /86

SJB Architects  
Level 2  
490 Crown Street  
Surry Hills NSW  
2010 Australia  
T 61 2 9380 9911  
F 61 2 9380 9922  
www.sjb.com.au

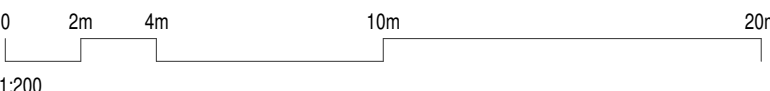



In accepting and utilising this document the recipient agrees that SJB Architecture (NSW) Pty. Ltd. ACN 081 094 724 T/A SJB Architects, retain all common law, statutory law and other rights including copyright and intellectual property rights. The recipient agrees not to use this document for any purpose other than its intended use; to waive all claims against SJB Architects resulting from unauthorised changes; or to reuse the document on other projects without the prior written consent of SJB Architects. Under no circumstances shall transfer of this document be deemed a sale. SJB Architects makes no warranties of fitness for any purpose. The Builder/Contractor shall verify job dimensions prior to any work commencing. Use figured dimensions only. Do not scale drawings.

Nominated Architects: Adam Haddow-7188 | John Pradel-7004

FOR APPROVAL

Rev	Date	Revision
86	04.10.2021	ISSUED FOR LEC

Structural Engineer
ROBERT BIRD GROUP
Mechanical / Hydraulic Engineer
JHA CONSULTING ENGINEERS
Electrical Engineer
JHA CONSULTING ENGINEERS
Fire Engineer
OLSSON FIRE & RISK
Access Consultant
ACCESSIBLE BUILDING SOLUTIONS
Basix
EMF GRIFFITHS
Building Key

Client




Project

HIGH ST DEVELOPMENT

634-638 HIGH ST & 87-89 UNION RD, PENRITH

Drawing Name

GA FLOOR PLAN - LEVEL 32

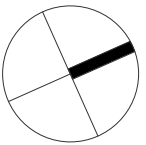


Date	Scale	Sheet Size
04.10.2021	1 : 200	@ A1

Drawn	Chk.
TM	NH

Job No.	Drawing No.	Revision
6111	AR-1-1030	/86

SJB Architects  
Level 2  
490 Crown Street  
Surry Hills NSW  
2010 Australia  
T 61 2 9380 9911  
F 61 2 9380 9922  
www.sjb.com.au

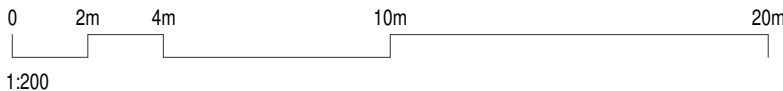



STAGE 2-  
FUTURE DEVELOPMENT

In accepting and utilising this document the recipient agrees that SJB Architecture (NSW) Pty. Ltd. ACN 081 094 724 T/A SJB Architects, retain all common law, statutory law and other rights including copyright and intellectual property rights. The recipient agrees not to use this document for any purpose other than its intended use; to waive all claims against SJB Architects resulting from unauthorised changes; or to reuse the document on other projects without the prior written consent of SJB Architects. Under no circumstances shall transfer of this document be deemed a sale. SJB Architects makes no warranties of fitness for any purpose. The Builder/Contractor shall verify job dimensions prior to any work commencing. Use figured dimensions only. Do not scale drawings.

Nominated Architects: Adam Haddow-7188 | John Pradel-7004

FOR APPROVAL

Rev	Date	Revision
66	24.01.2020	PRELIMINARY ISSUE
70	06.02.2020	PRE DA ISSUE
74	17.02.2020	LANDSCAPE COORDINATION L34
76	20.02.2020	ISSUED FOR BASIX COORDINATION
78	26.02.2020	ISSUED FOR LANDSCAPE COORDINATION
81	28.02.2020	DRAFT DA ISSUE
83	04.03.2020	ISSUED FOR DA
85	07.05.2021	ISSUED FOR DA
86	04.10.2021	ISSUED FOR LEC

Structural Engineer

ROBERT BIRD GROUP

Mechanical / Hydraulic Engineer

JHA CONSULTING ENGINEERS

Electrical Engineer

JHA CONSULTING ENGINEERS

Fire Engineer

OLSSON FIRE & RISK

Access Consultant

ACCESSIBLE BUILDING SOLUTIONS

Basix

EMF GRIFFITHS

Building Key

- 1B

1B + ST

2B/2BTH

2B

2B + ST/M

3B

1800mm PRIVACY SCREENS
- S - STORAGE

Client




Project

HIGH ST DEVELOPMENT

634-638 HIGH ST & 87-89  
UNION RD, PENRITH

Drawing Name

1000 OVERALL PLANS  
GA FLOOR PLAN - LEVEL 33

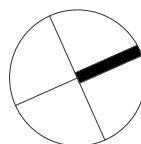

Date	Scale	Sheet Size
04.10.2021	1 : 200	@ A1


Drawn Chk.

GT MG

Job No. Drawing No. Revision


6111 AR-1-1032 /86

SJB Architects  
Level 2  
490 Crown Street  
Surry Hills NSW  
2010 Australia  
T 61 2 9380 9911  
F 61 2 9380 9922  
www.sjb.com.au

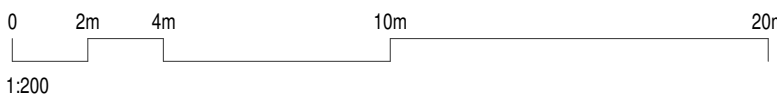



STAGE 2-  
FUTURE DEVELOPMENT

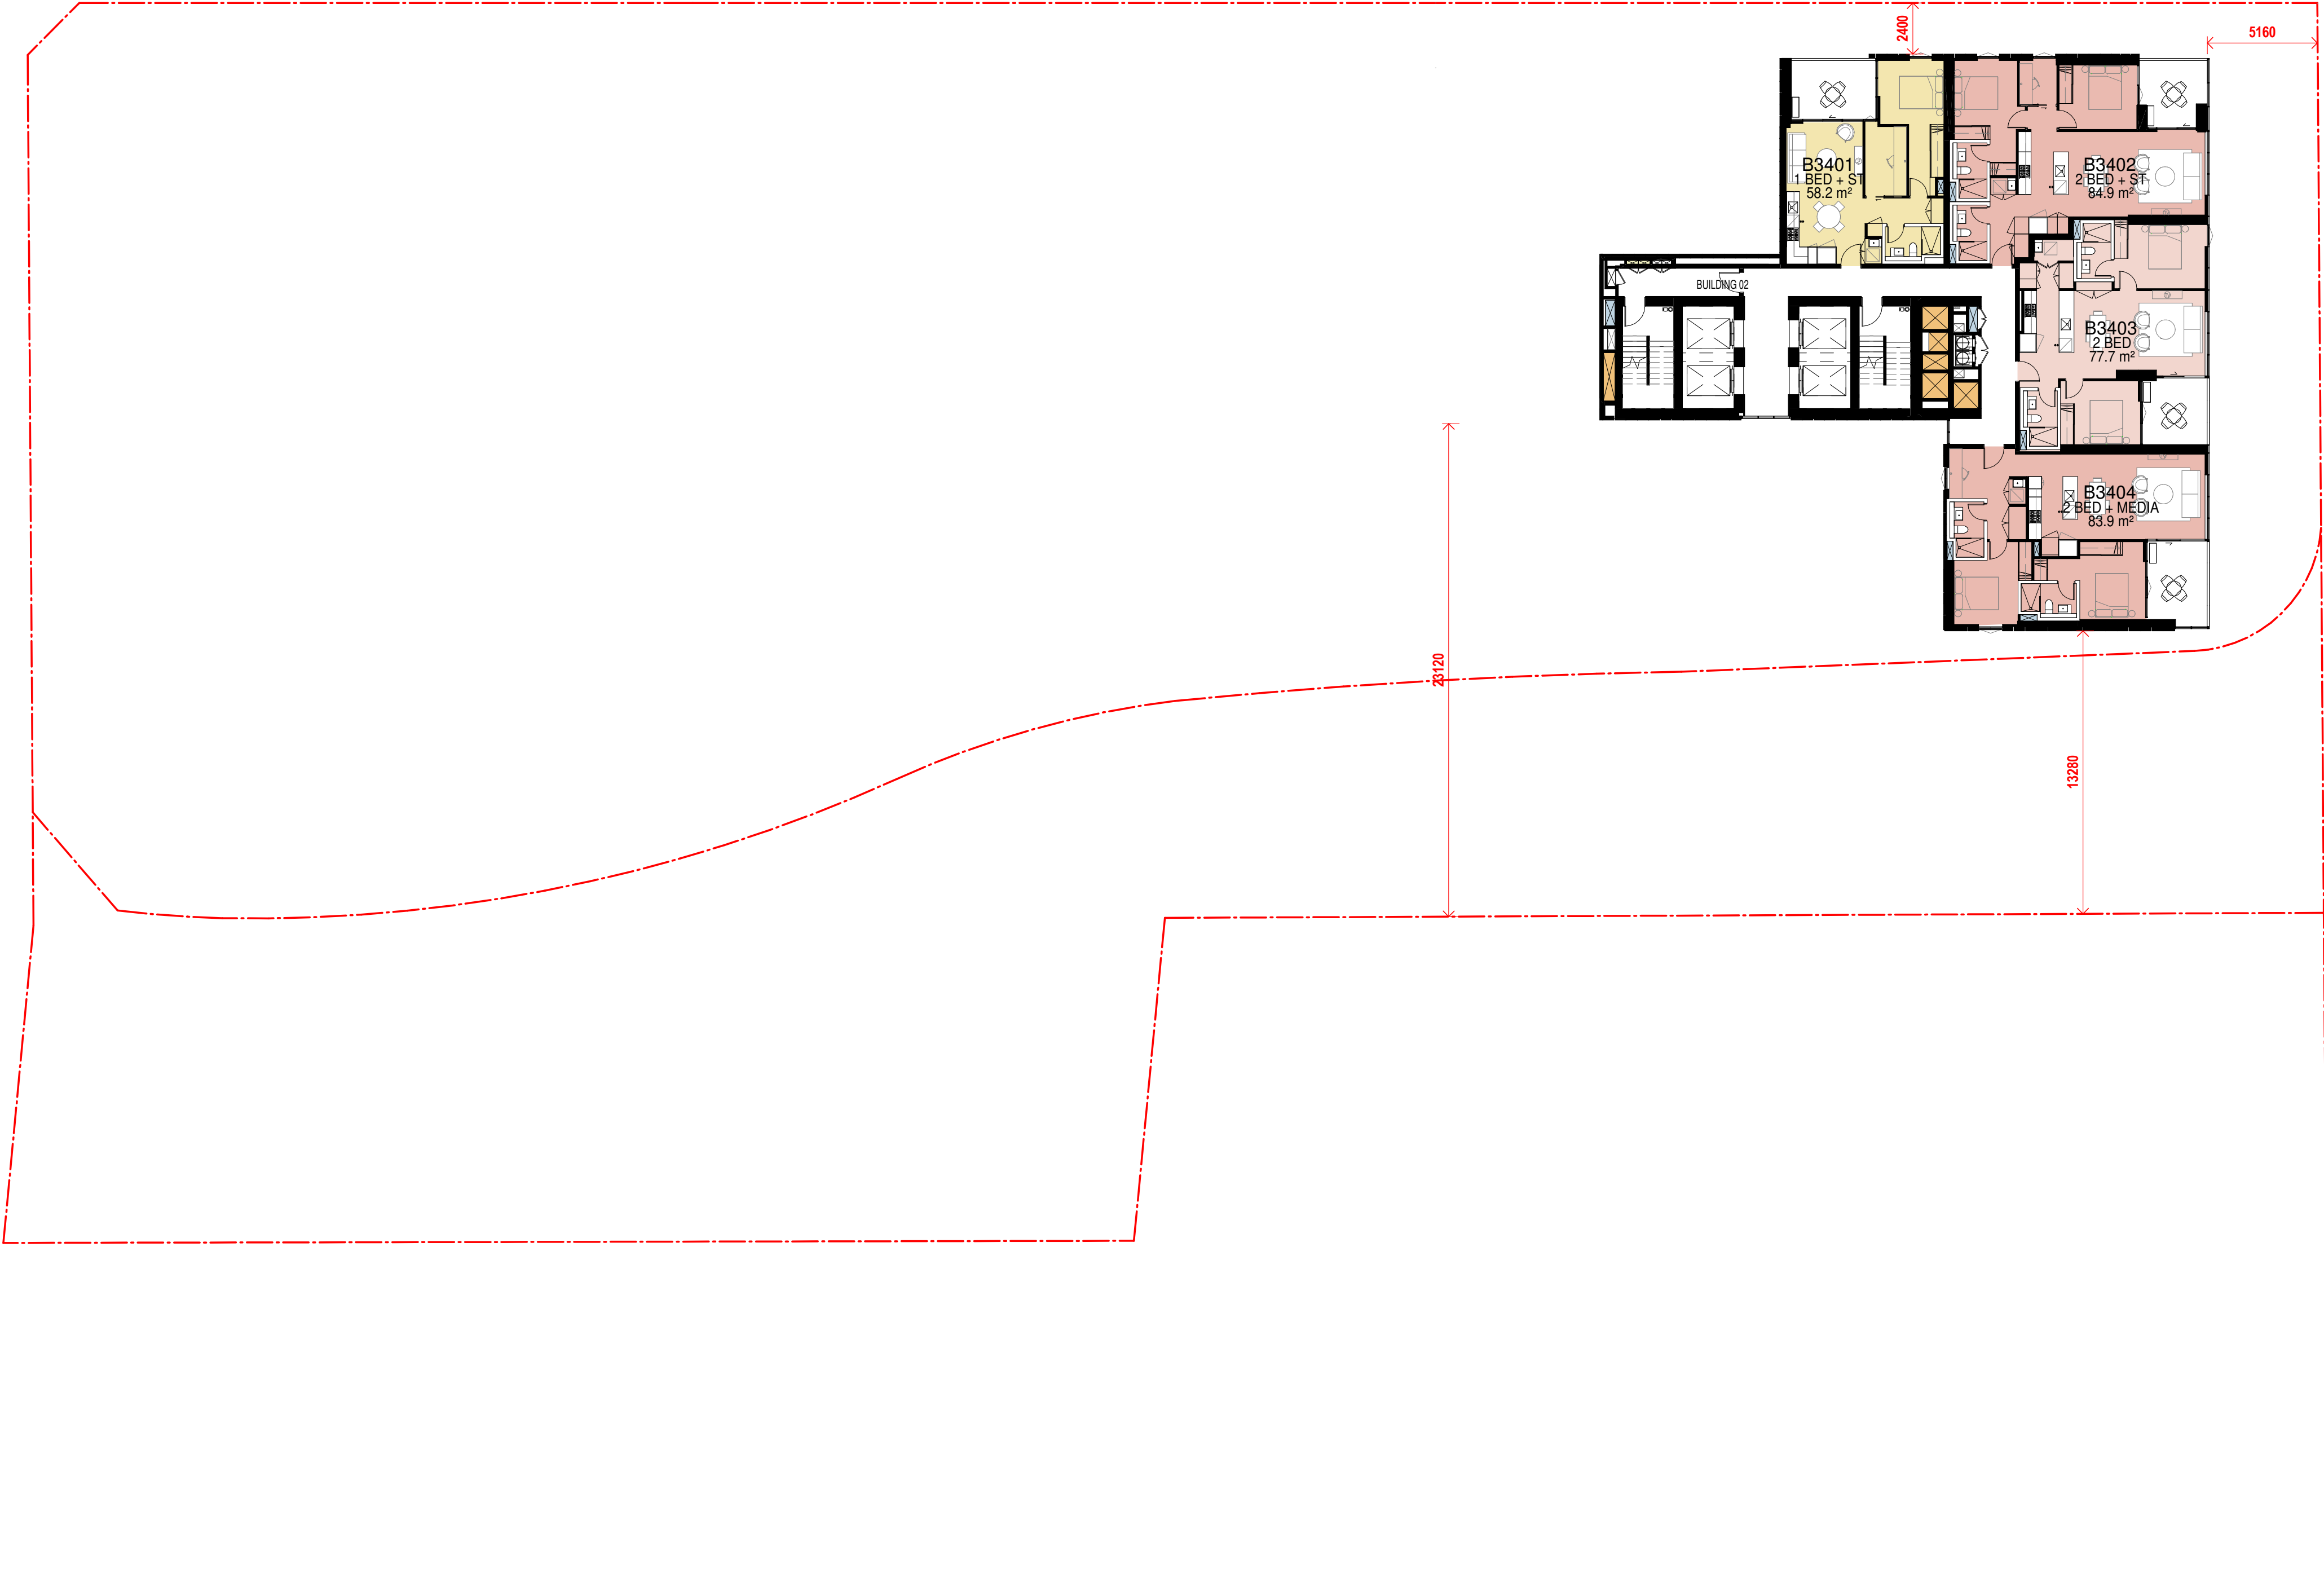

In accepting and utilising this document the recipient agrees that SJB Architecture (NSW) Pty. Ltd. ACN 081 094 724 T/A SJB Architects, retain all common law, statutory law and other rights including copyright and intellectual property rights. The recipient agrees not to use this document for any purpose other than its intended use; to waive all claims against SJB Architects resulting from unauthorised changes; or to reuse the document on other projects without the prior written consent of SJB Architects. Under no circumstances shall transfer of this document be deemed a sale. SJB Architects makes no warranties of fitness for any purpose. The Builder/Contractor shall verify job dimensions prior to any work commencing. Use figured dimensions only. Do not scale drawings.

Nominated Architects: Adam Haddow-7188 | John Pradel-7004

FOR APPROVAL

Rev	Date	Revision
76	20.02.2020	ISSUED FOR BASIX COORDINATION
81	28.02.2020	DRAFT DA ISSUE
83	04.03.2020	ISSUED FOR DA
85	07.05.2021	ISSUED FOR DA
86	04.10.2021	ISSUED FOR LEC

Structural Engineer  
ROBERT BIRD GROUP

Mechanical / Hydraulic Engineer  
JHA CONSULTING ENGINEERS

Electrical Engineer  
JHA CONSULTING ENGINEERS

Fire Engineer  
OLSSON FIRE & RISK

Access Consultant  
ACCESSIBLE BUILDING SOLUTIONS

Basix  
EMF GRIFFITHS


Building Key		
	1B	S - STORAGE
	1B + ST	
	2B/2BTH	
	2B	
	2B + ST/M	
	3B	
	1800mm PRIVACY SCREENS	



Project  
HIGH ST DEVELOPMENT

634-638 HIGH ST & 87-89  
UNION RD, PENRITH

Drawing Name  
1000 OVERALL PLANS  
GA FLOOR PLAN - LEVEL 34

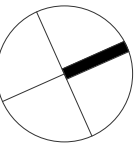


Date	Scale	Sheet Size
04.10.2021	1 : 200	@ A1


Drawn	Chk.
SC	MG

Job No.	Drawing No.	Revision
6111	AR-1-1033	/86

**SJB Architects**  
Level 2  
490 Crown Street  
Surry Hills NSW  
2010 Australia  
T 61 2 9380 9911  
F 61 2 9380 9922  
www.sjb.com.au

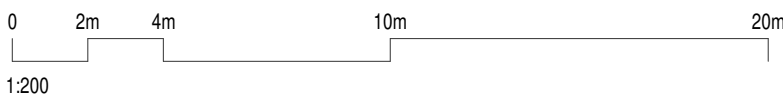



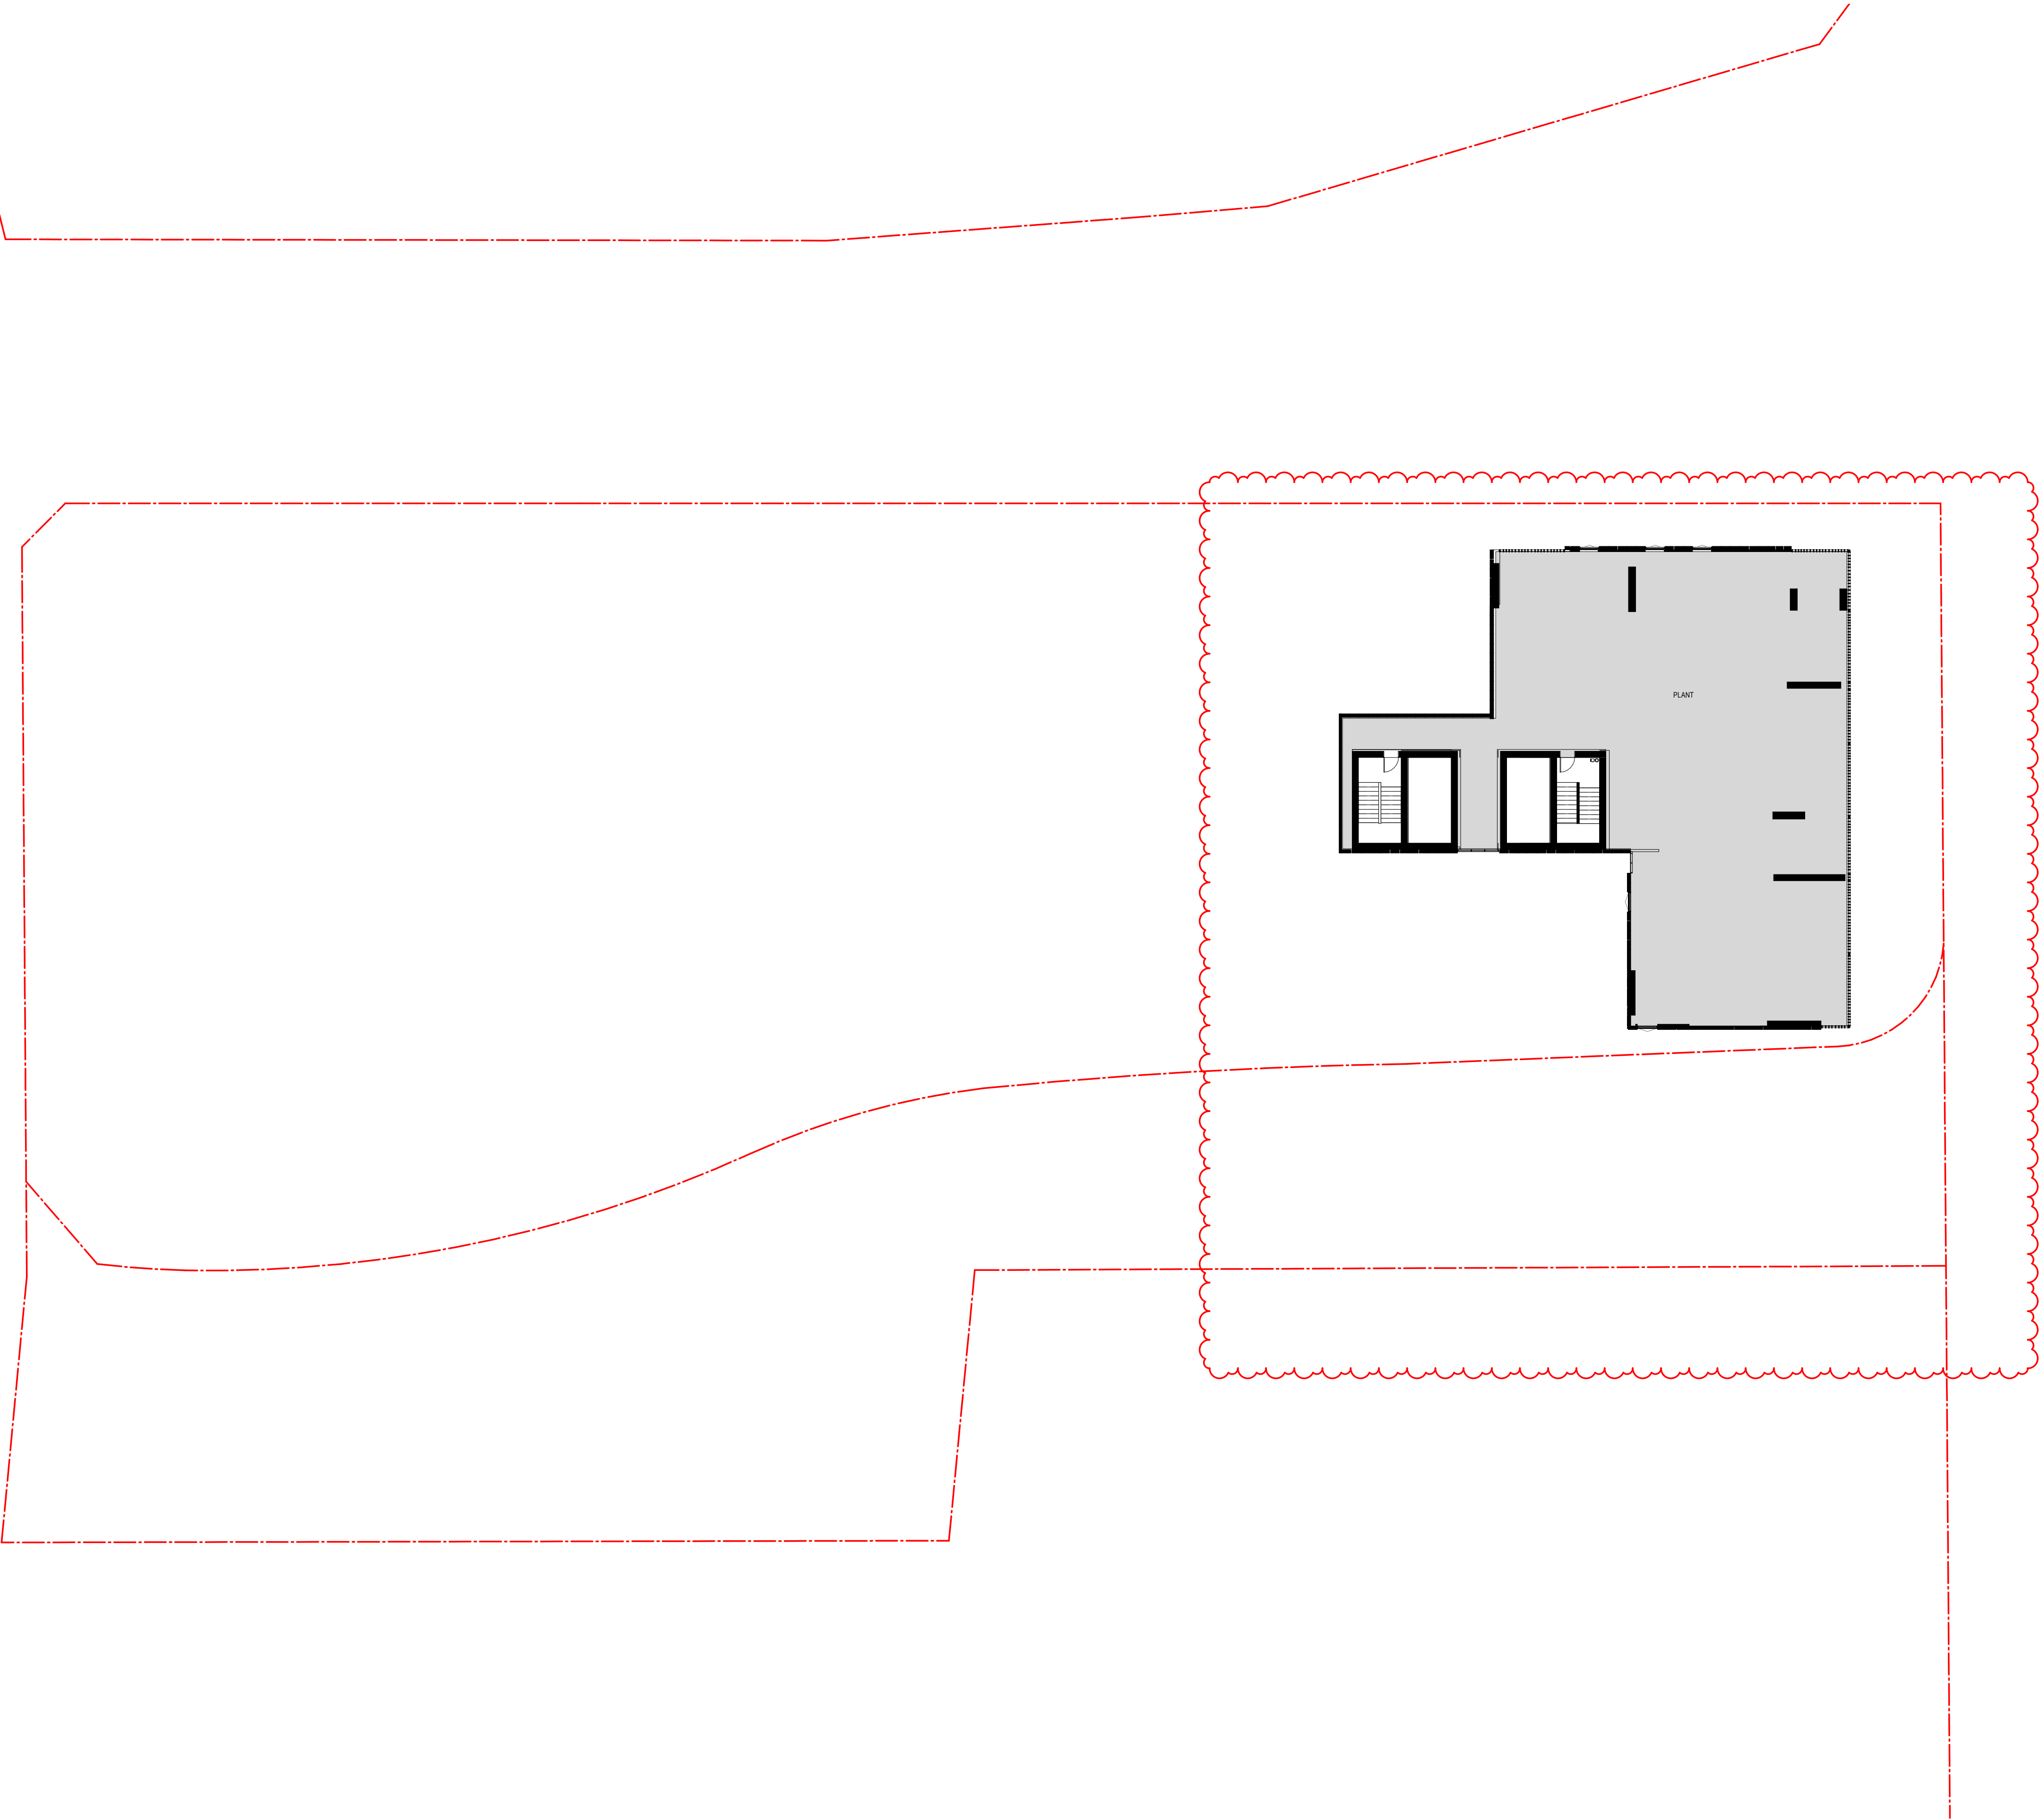

In accepting and utilising this document the recipient agrees that SJB Architecture (NSW) Pty. Ltd. ACN 081 094 724 T/A SJB Architects, retain all common law, statutory law and other rights including copyright and intellectual property rights. The recipient agrees not to use this document for any purpose other than its intended use; to waive all claims against SJB Architects resulting from unauthorised changes; or to reuse the document on other projects without the prior written consent of SJB Architects. Under no circumstances shall transfer of this document be deemed a sale. SJB Architects makes no warranties of fitness for any purpose. The Builder/Contractor shall verify job dimensions prior to any work commencing. Use figured dimensions only. Do not scale drawings.

Nominated Architects: Adam Haddow-7188 | John Pradel-7004

FOR APPROVAL

Rev	Date	Revision
85	07.05.2021	ISSUED FOR DA
86	04.10.2021	ISSUED FOR LEC

Structural Engineer

ROBERT BIRD GROUP

Mechanical / Hydraulic Engineer

JHA CONSULTING ENGINEERS

Electrical Engineer

JHA CONSULTING ENGINEERS

Fire Engineer

OLSSON FIRE & RISK

Access Consultant

ACCESSIBLE BUILDING SOLUTIONS

Basix

EMF GRIFFITHS

Building Key

- 1B S - STORAGE
- 1B + ST
- 2B/2BTH
- 2B
- 2B + ST/M
- 3B
- 1800mm PRIVACY SCREENS

Client




Project

HIGH ST DEVELOPMENT

634-638 HIGH ST & 87-89  
UNION RD, PENRITH

Drawing Name

1000 OVERALL PLANS  
GA FLOOR PLAN - LEVEL 35

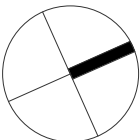

Date	Scale	Sheet Size
04.10.2021	1 : 200	@ A1


Drawn Chk.

TM NH



Job No. Drawing No. Revision

6111 AR-1-1034 /86

SJB Architects  
Level 2  
490 Crown Street  
Surry Hills NSW  
2010 Australia  
T 61 2 9380 9911  
F 61 2 9380 9922  
www.sjb.com.au

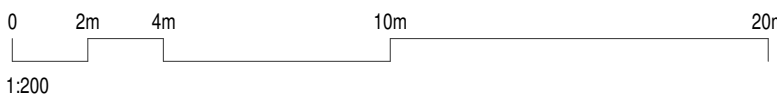



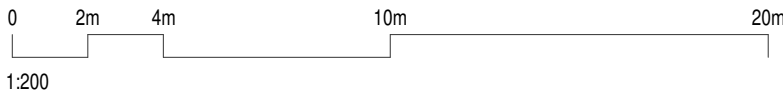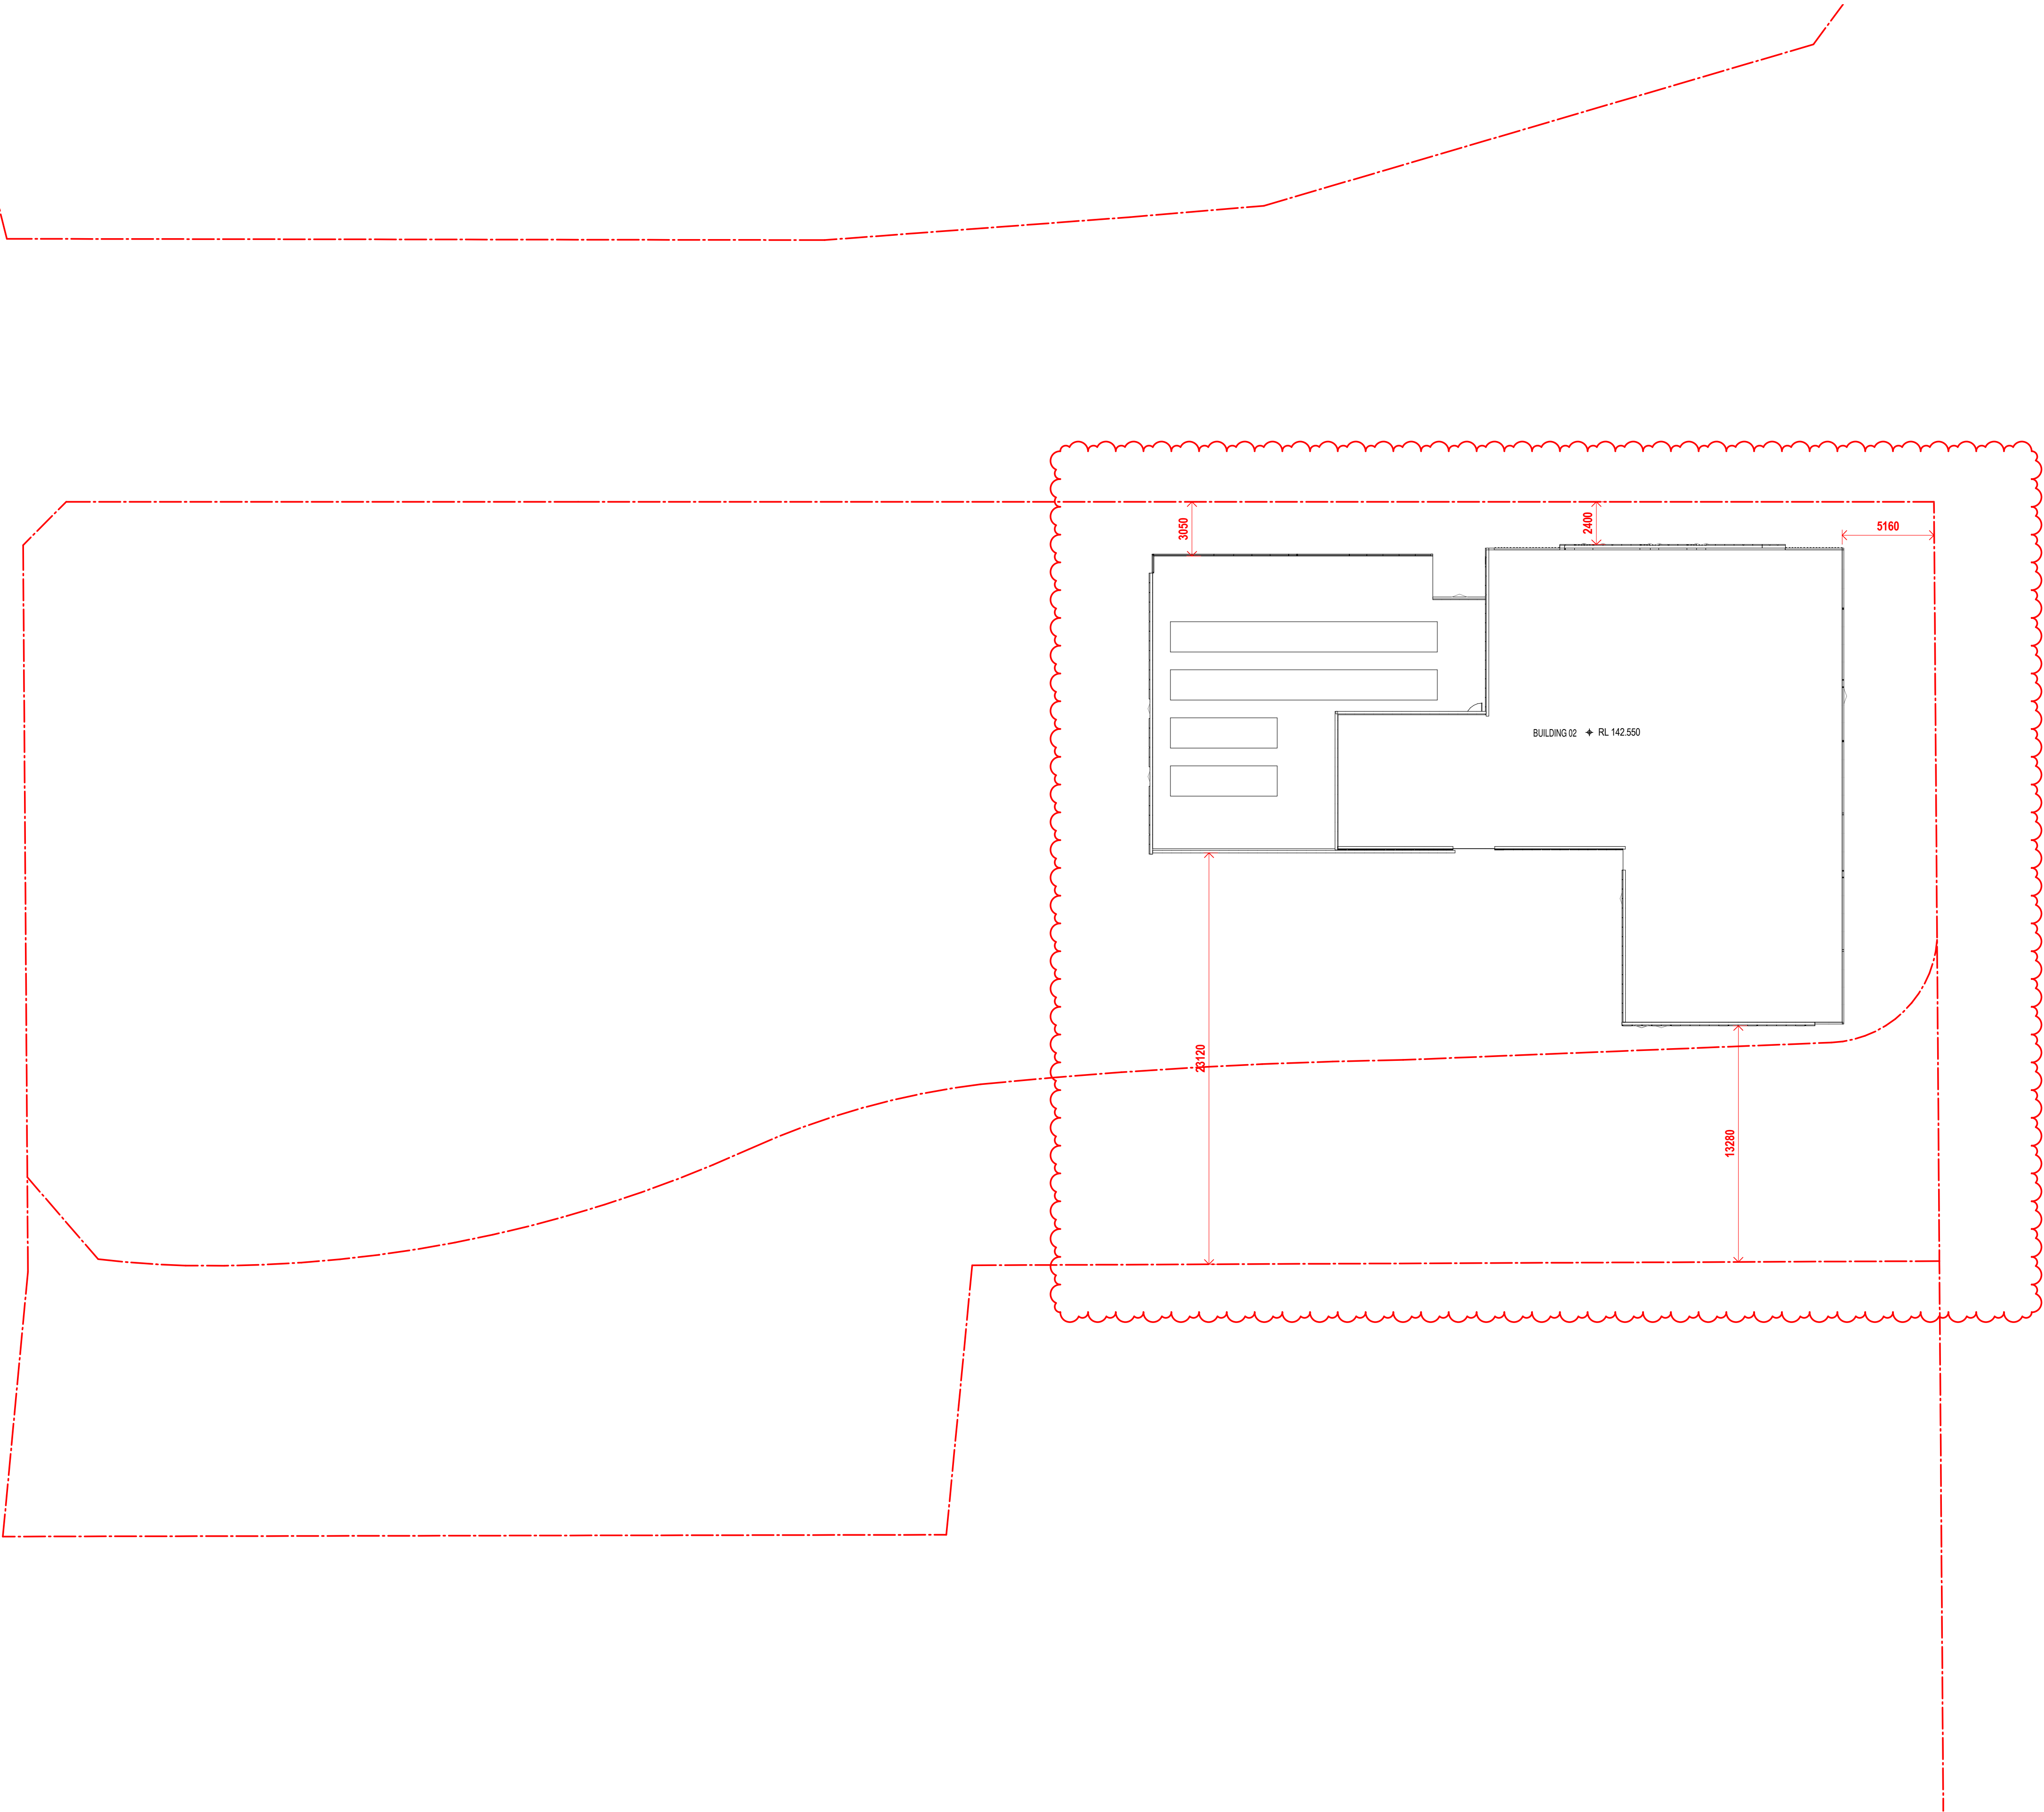

In accepting and utilising this document the recipient agrees that SJB Architecture (NSW) Pty. Ltd. ACN 081 094 724 T/A SJB Architects, retain all common law, statutory law and other rights including copyright and intellectual property rights. The recipient agrees not to use this document for any purpose other than its intended use; to waive all claims against SJB Architects resulting from unauthorised changes; or to reuse the document on other projects without the prior written consent of SJB Architects. Under no circumstances shall transfer of this document be deemed a sale. SJB Architects makes no warranties of fitness for any purpose. The Builder/Contractor shall verify job dimensions prior to any work commencing. Use figured dimensions only. Do not scale drawings.

Nominated Architects: Adam Haddow-7188 | John Pradel-7004

FOR APPROVAL

Rev	Date	Revision
66	24.01.2020	PRELIMINARY ISSUE
70	06.02.2020	PRE DA ISSUE
76	20.02.2020	ISSUED FOR BASIX COORDINATION
81	28.02.2020	DRAFT DA ISSUE
82	03.03.2020	ISSUED FOR COORDINATION
83	04.03.2020	ISSUED FOR DA
85	07.05.2021	ISSUED FOR DA
86	04.10.2021	ISSUED FOR LEC

Structural Engineer  
ROBERT BIRD GROUP

Mechanical / Hydraulic Engineer  
JHA CONSULTING ENGINEERS

Electrical Engineer  
JHA CONSULTING ENGINEERS

Fire Engineer  
OLSSON FIRE & RISK

Access Consultant  
ACCESSIBLE BUILDING SOLUTIONS

Basix  
EMF GRIFFITHS

Building Key


Client



Project  
HIGH ST DEVELOPMENT

634-638 HIGH ST & 87-89  
UNION RD, PENRITH

Drawing Name  
1000 OVERALL PLANS  
GA FLOOR PLAN - ROOF

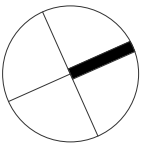

Date	Scale	Sheet Size
04.10.2021	1 : 200	@ A1


Drawn	Chk.
GT	MG

Job No.	Drawing No.	Revision
6111	AR-1-1038	/86


SJB Architects  
Level 2  
490 Crown Street  
Surry Hills NSW  
2010 Australia  
T 61 2 9380 9911  
F 61 2 9380 9922  
www.sjb.com.au





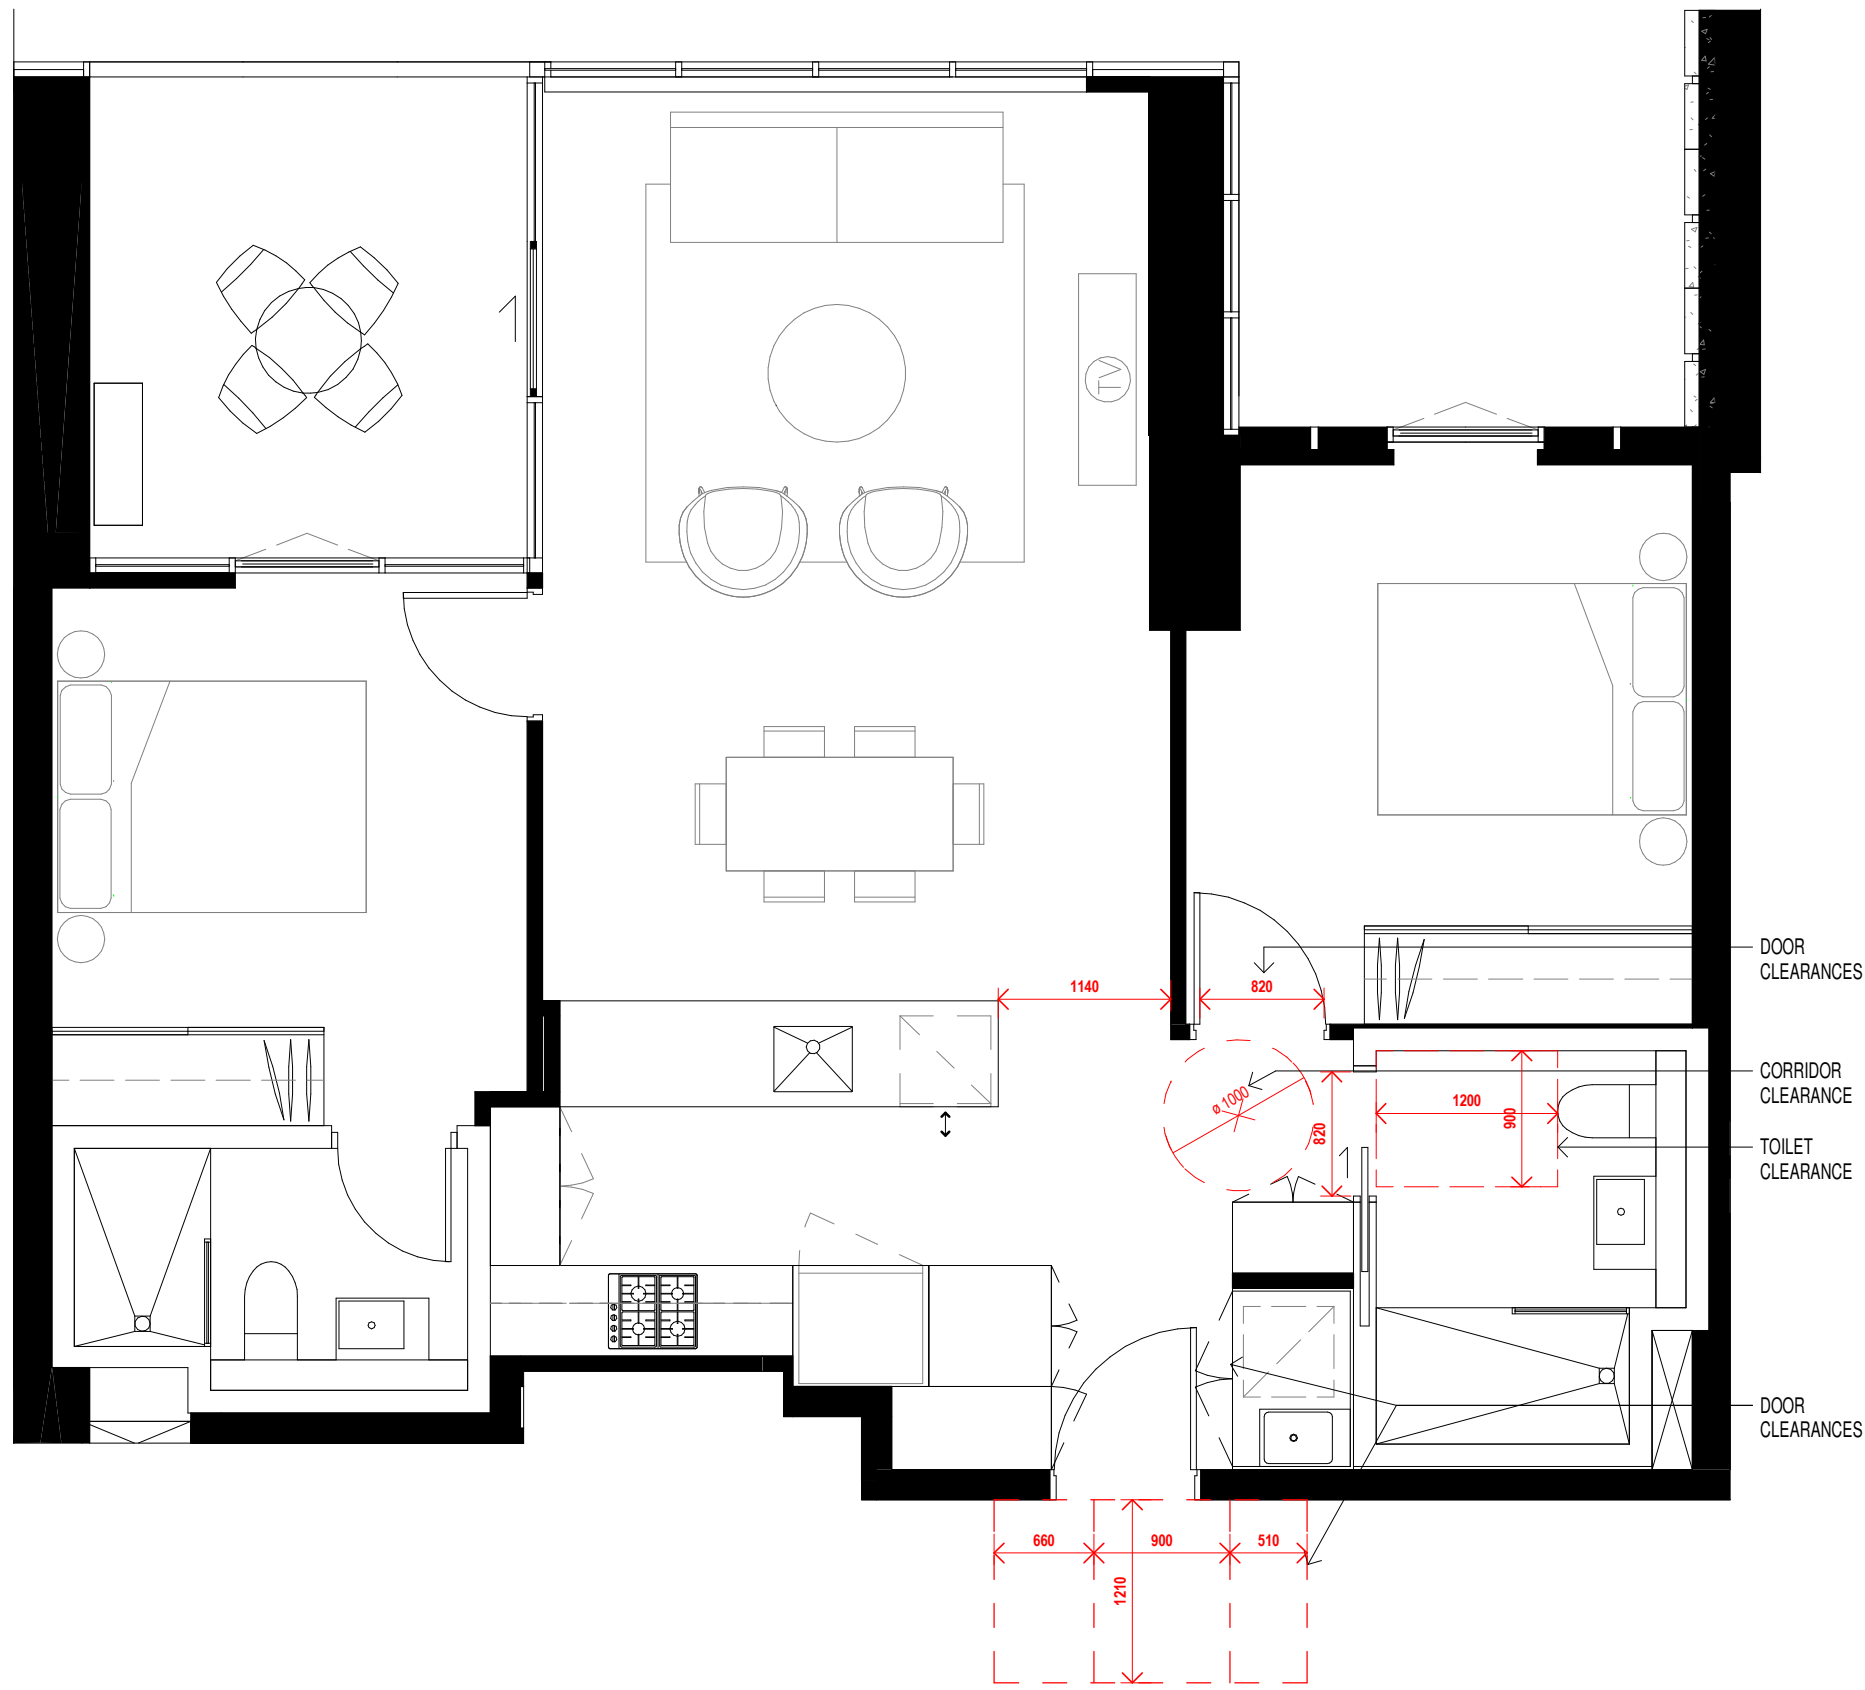

01 **LIVEABLE - APARTMENT B1104**  
AR-1-0102B 1 : 50@A1

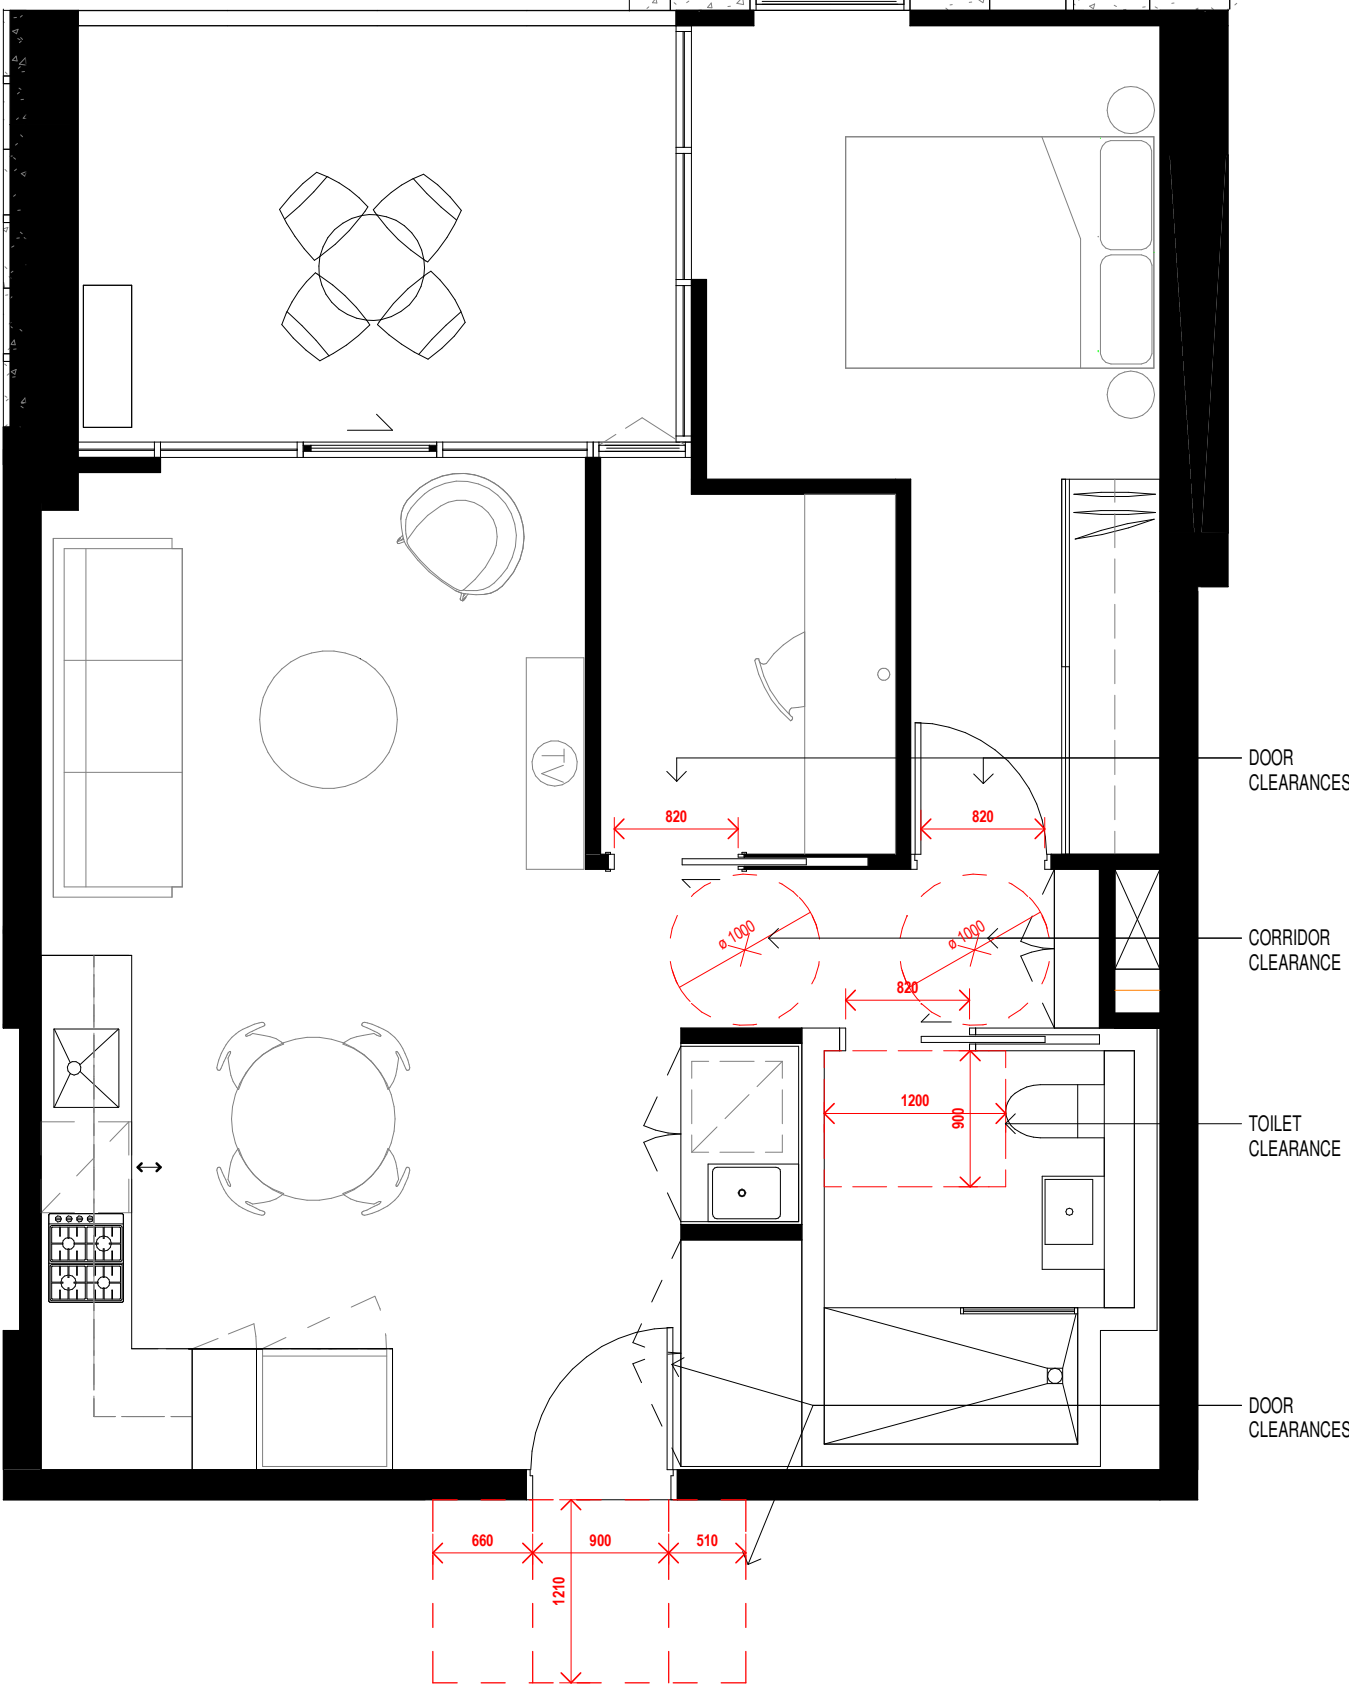

02 **LIVEABLE - APARTMENT B1105**  
AR-1-0102B 1 : 50@A1

In accepting and utilising this document the recipient agrees that SJB Architecture (NSW) Pty. Ltd. ACN 081 094 724 T/A SJB Architects, retain all common law, statutory law and other rights including copyright and intellectual property rights. The recipient agrees not to use this document for any purpose other than its intended use; to waive all claims against SJB Architects resulting from unauthorised changes; or to reuse the document on other projects without the prior written consent of SJB Architects. Under no circumstances shall transfer of this document be deemed a sale. SJB Architects makes no warranties of fitness for any purpose. The Builder/Contractor shall verify job dimensions prior to any work commencing. Use figured dimensions only. Do not scale drawings.

Nominated Architects: Adam Haddow-7188 | John Pradel-7004

**FOR APPROVAL**

Rev	Date	Revision
66	24.01.2020	PRELIMINARY ISSUE
81	28.02.2020	DRAFT DA ISSUE
83	04.03.2020	ISSUED FOR DA
85	07.05.2021	ISSUED FOR DA
86	04.10.2021	ISSUED FOR LEC

Structural Engineer	ROBERT BIRD GROUP
Mechanical / Hydraulic Engineer	JHA CONSULTING ENGINEERS
Electrical Engineer	JHA CONSULTING ENGINEERS
Fire Engineer	OLSSON FIRE & RISK
Access Consultant	ACCESSIBLE BUILDING SOLUTIONS
Basix	EMF GRIFFITHS
Building Key	

Client



Project

HIGH ST DEVELOPMENT

634-638 HIGH ST & 87-89 UNION RD, PENRITH

Drawing Name

LIVEABLE UNITS

Date Scale Sheet Size  
04.10.2021 1 : 50 @ A1

Drawn Chk.  
GT MG

Job No. Drawing No. Revision  
6111 AR-1-1101 /86

**SJB Architects**  
Level 2  
490 Crown Street  
Surry Hills NSW  
2010 Australia  
T 61 2 9380 9911  
F 61 2 9380 9922  
www.sjb.com.au




**SUMMARY**


TOTAL NO. OF APARTMENTS	357
TOTAL NO. OF LIVEABLE APARTMENTS	36
% OF ADAPTABLE APARTMENTS REQUIRED	10%
% OF ADAPTABLE APARTMENTS	10%

LIVEABLE SCHEDULE - BUILDING 02	
LEVEL	APARTMENT NO.
T1_L1	B101
T1_L2	B201
T1_L3	B301
T1_L3	B302
T1_L4	B403
T2_L5	B505
T2_L6	B605
T2_L7	B705
T2_L8	B804
T2_L8	B805
T2_L9	B904
T2_L9	B905
T2_L10	B1004
T2_L10	B1005
T2_L11	B1104
T2_L11	B1105
T2_L12	B1204
T2_L12	B1205
T2_L13	B1304
T2_L14	B1404
T2_L15	B1504
T2_L16	B1604
T2_L17	B1704
T2_L18	B1804
T2_L19	B1904
T2_L20	B2004
T2_L21	B2104
T2_L22	B2204
T2_L23	B2304
T2_L24	B2404
T2_L25	B2504
T2_L26	B2604
T2_L27	B2704
T2_L28	B2804
T2_L29	B2902
T2_L31	B3103
TOTAL LIVEABLE APTS: 36	




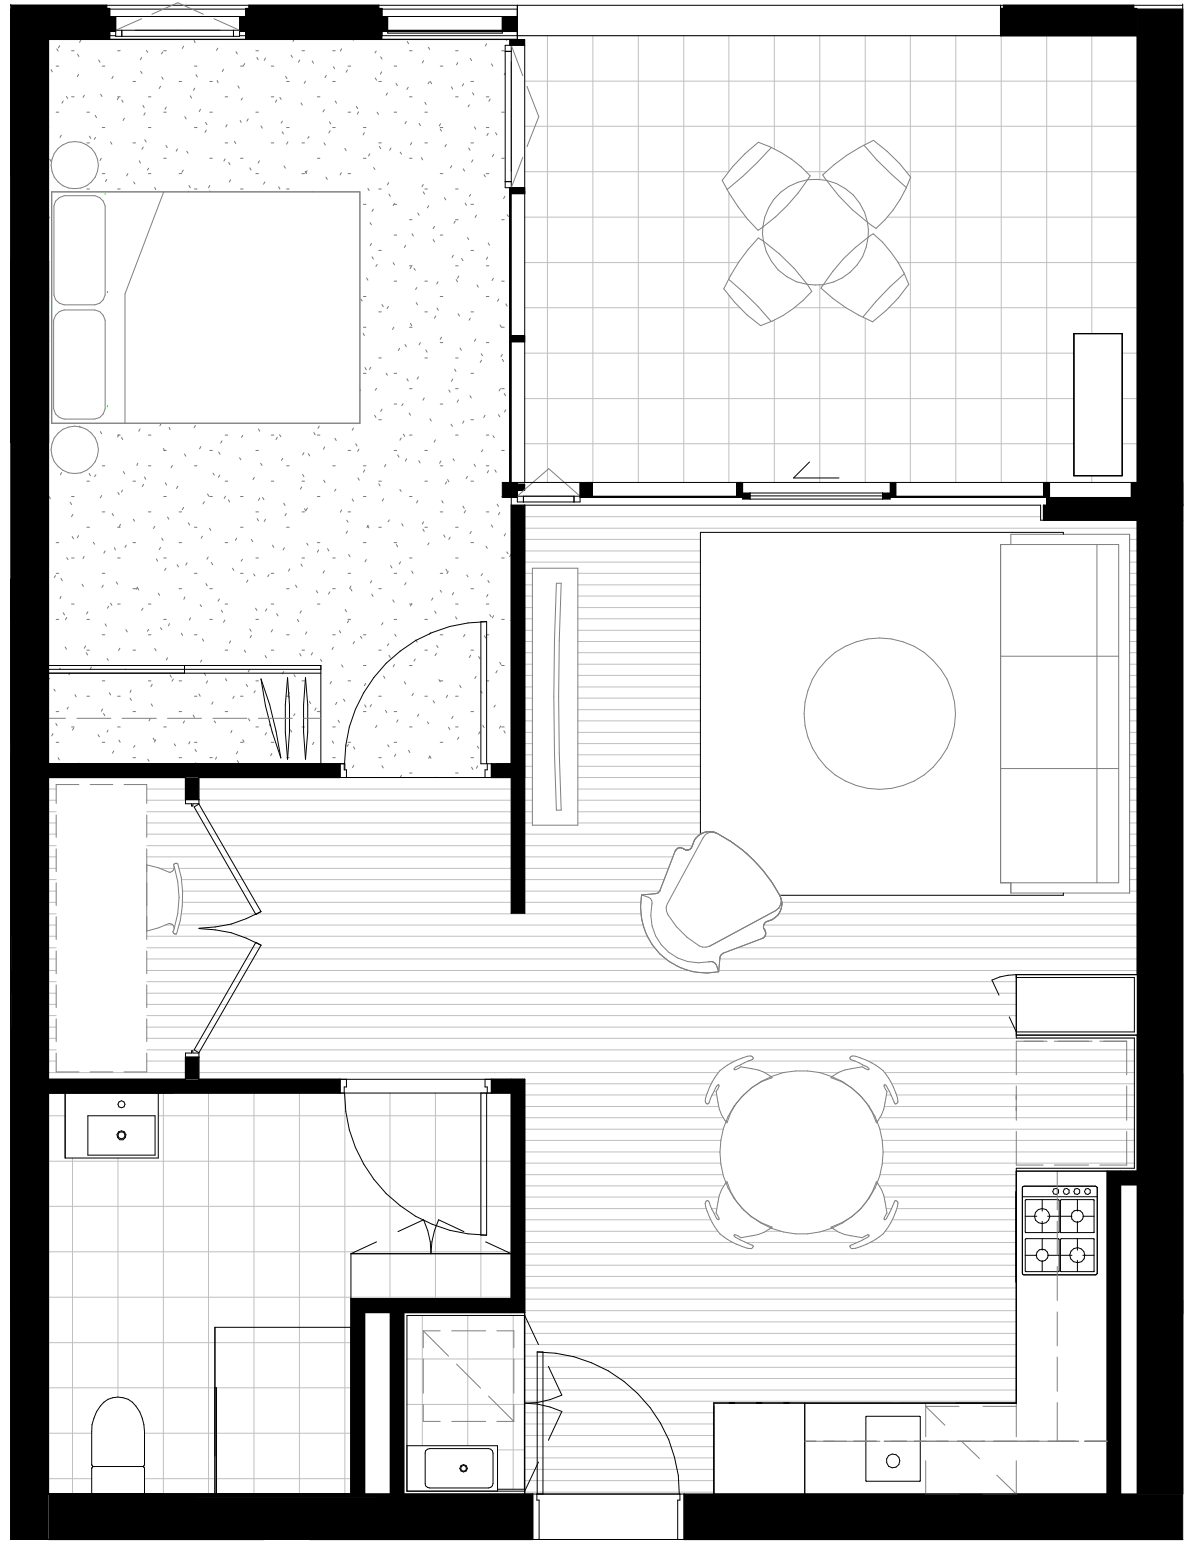

01 PRE-ADAPTABLE - APARTMENT A1104  
AR-1-0102B 1: 50@A1

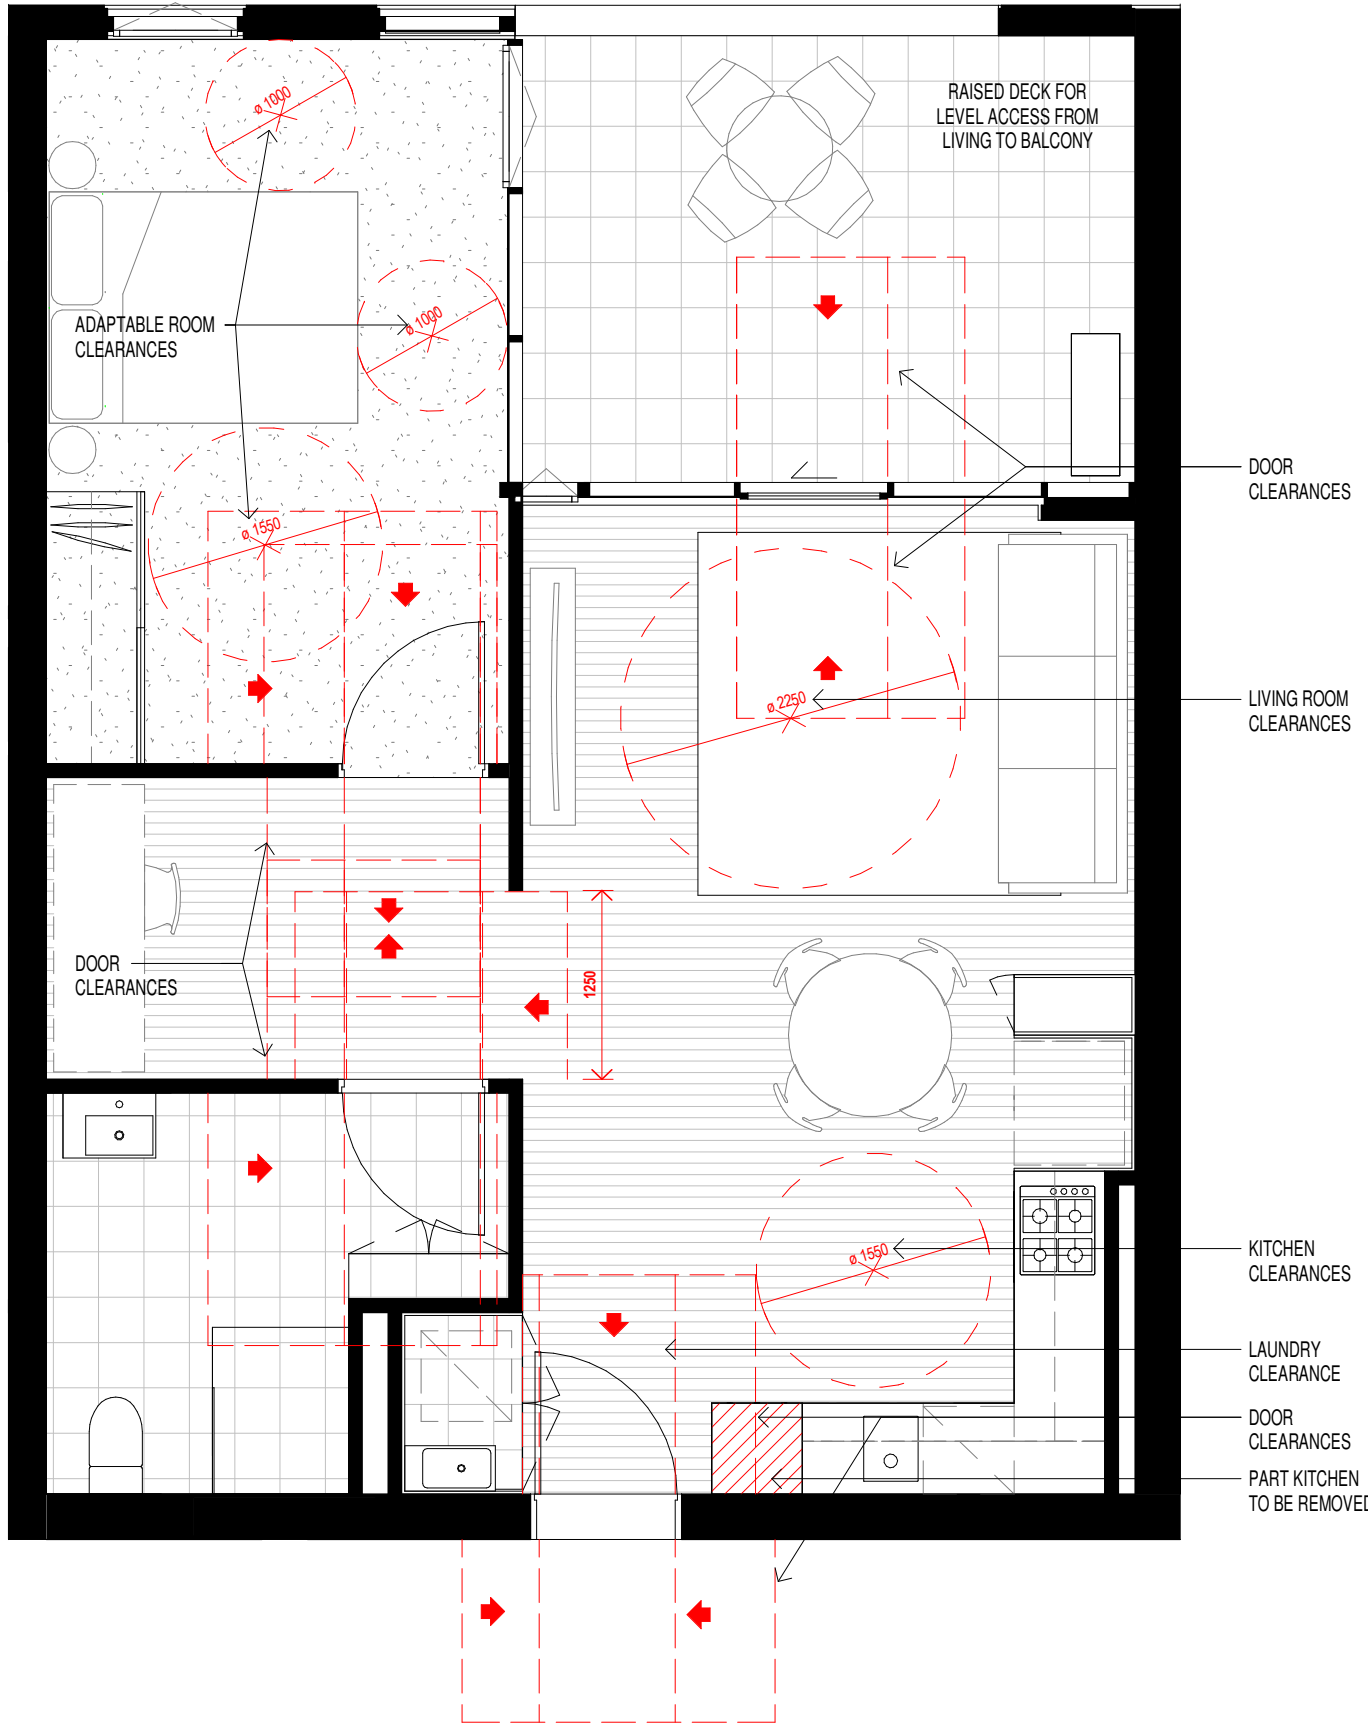

02 POST-ADAPTABLE - APARTMENT A1104  
AR-1-0102B 1: 50@A1

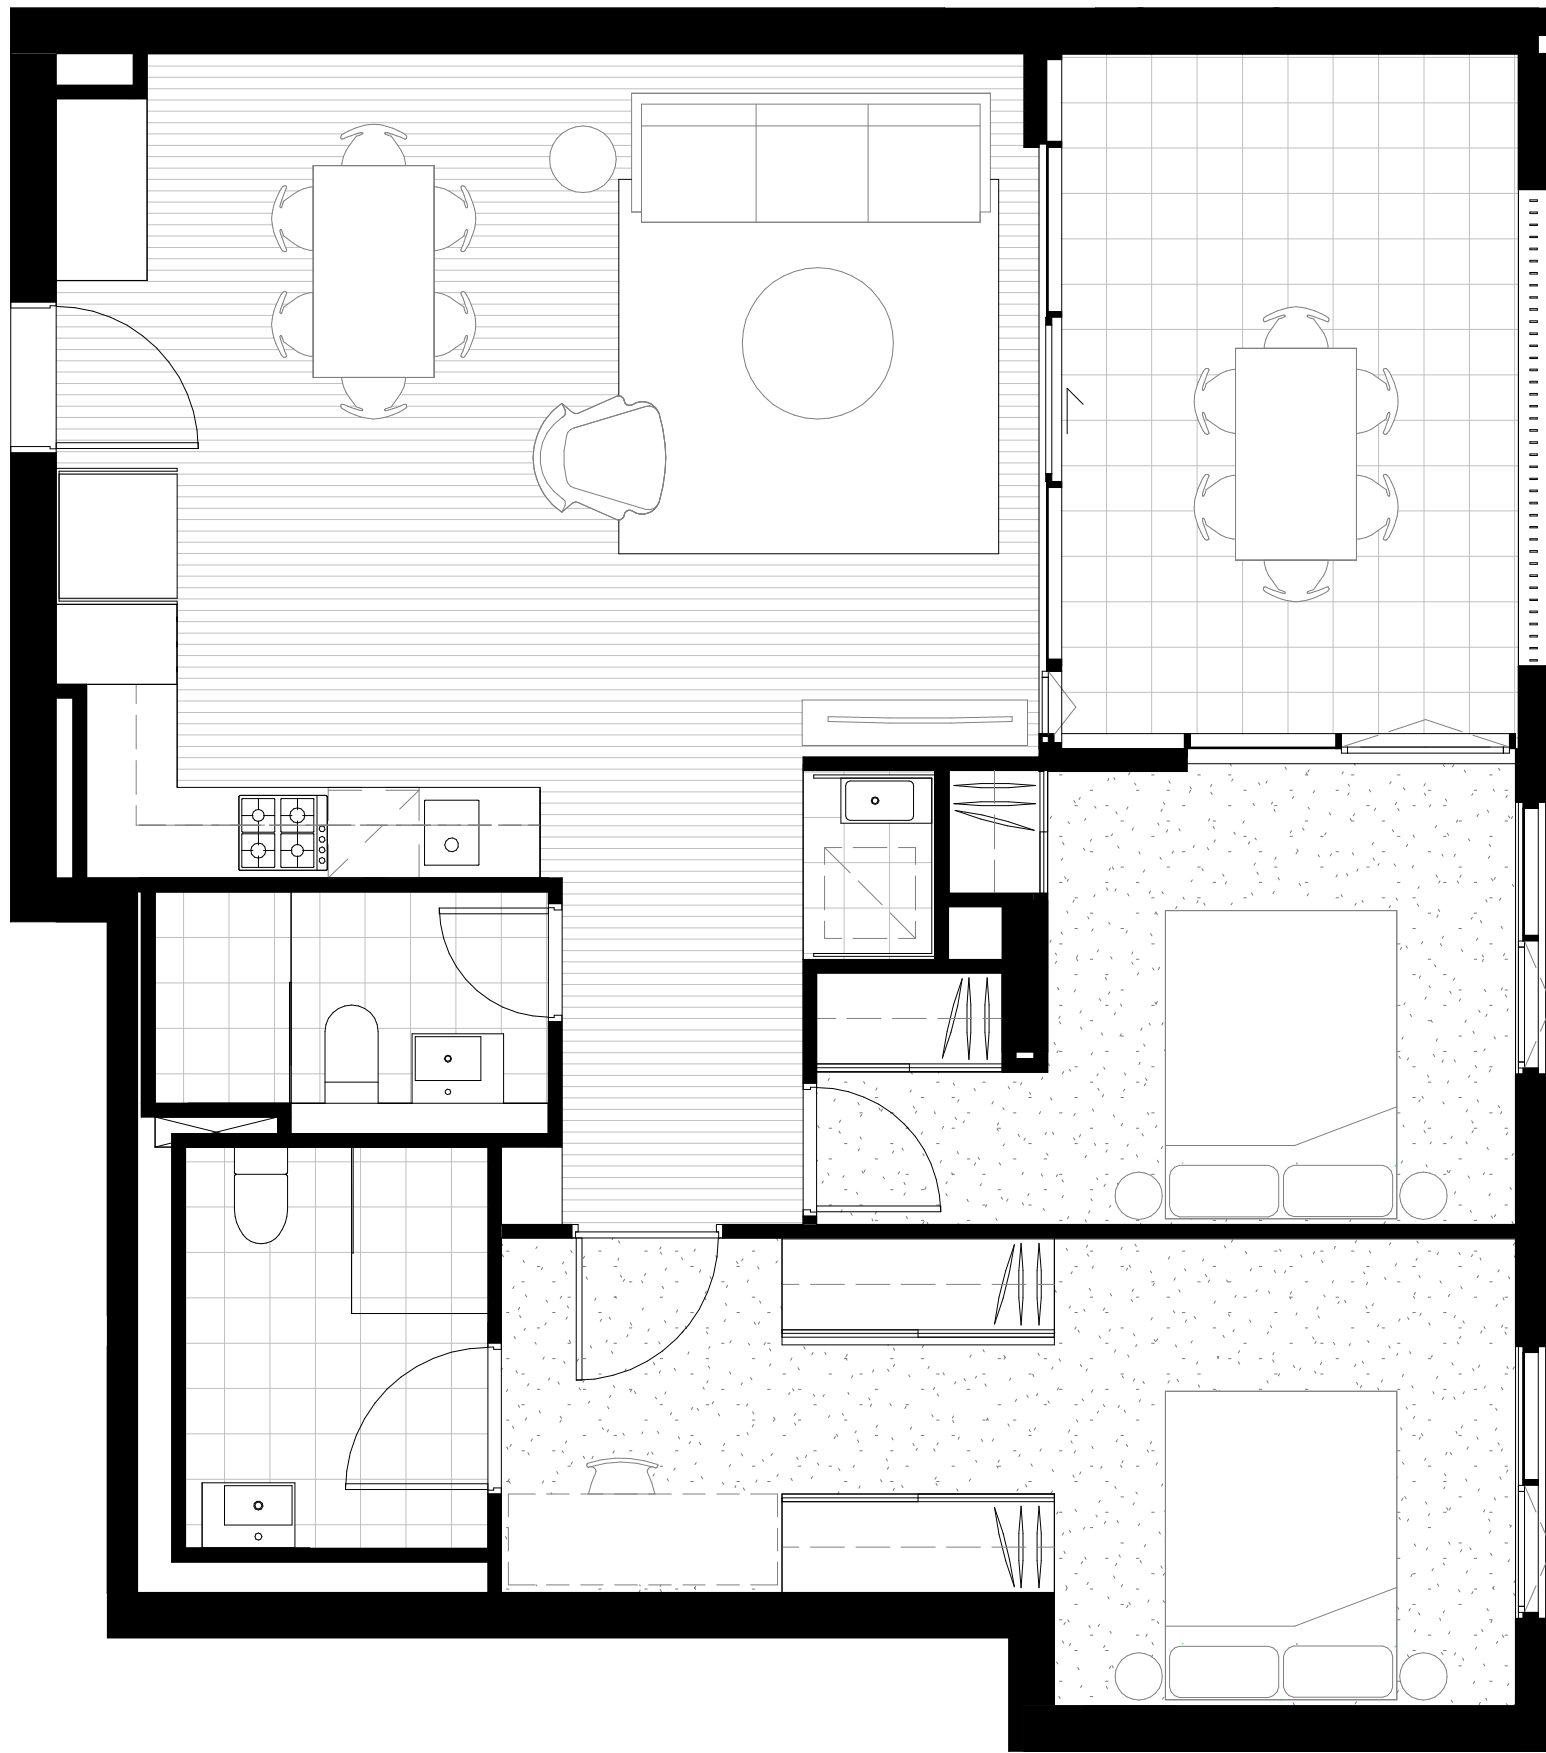

03 PRE-ADAPTABLE - APARTMENT A1107  
AR-1-0102B 1: 50@A1



04 POST-ADAPTABLE - APARTMENT A1107  
AR-1-0102B 1: 50@A1

ADAPTABLE SCHEDULE - BUILDING 01	
LEVEL	APARTMENT NO.
T1_L5	A507
T1_L5	A504
T1_L6	A607
T1_L6	A604
T1_L7	A707
T1_L8	A807
T1_L9	A907
T1_L10	A1007
T1_L11	A1107
T1_L11	A1104
T1_L12	A1207
TOTAL ADAPTABLE APTS: 11	

#### SUMMARY

TOTAL NO. OF APARTMENTS	357
TOTAL NO. OF ADAPTABLE APARTMENTS	35
% OF ADAPTABLE APARTMENTS REQUIRED	10%
% OF ADAPTABLE APARTMENTS	10%

ADAPTABLE SCHEDULE - BUILDING 02	
LEVEL	APARTMENT NO.
T2_L5	B501
T2_L6	B601
T2_L7	B701
T2_L8	B801
T2_L9	B901
T2_L10	B1001
T2_L11	B1101
T2_L12	B1201
T2_L13	B1301
T2_L14	B1401
T2_L15	B1501
T2_L16	B1601
T2_L17	B1701
T2_L18	B1801
T2_L19	B1901
T2_L20	B2001
T2_L21	B2101
T2_L22	B2201
T2_L23	B2301
T2_L24	B2401
T2_L25	B2501
T2_L26	B2601
T2_L27	B2701
T2_L28	B2801
TOTAL ADAPTABLE APTS: 24	

In accepting and utilising this document the recipient agrees that SJB Architecture (NSW) Pty. Ltd. ACN 081 094 724 T/A SJB Architects, retain all common law, statutory law and other rights including copyright and intellectual property rights. The recipient agrees not to use this document for any purpose other than its intended use, to waive all claims against SJB Architects resulting from unauthorised changes, or to reuse the document on other projects without the prior written consent of SJB Architects. Under no circumstances shall transfer of this document be deemed a sale. SJB Architects makes no warranties of fitness for any purpose. The Builder/Contractor shall verify job dimensions prior to any work commencing. Use figured dimensions only. Do not scale drawings.

Nominated Architects: Adam Haddow-7188 | John Pradel-7004

#### FOR APPROVAL

Rev	Date	Revision
66	24.01.2020	PRELIMINARY ISSUE
67	31.01.2020	PRELIMINARY ISSUE
73	17.02.2020	ADAPTABLE APARTMENTS COORDINATION
81	28.02.2020	DRAFT DA ISSUE
83	04.03.2020	ISSUED FOR DA
85	07.05.2021	ISSUED FOR DA
86	04.10.2021	ISSUED FOR LEC

Structural Engineer  
ROBERT BIRD GROUP

Mechanical / Hydraulic Engineer  
JHA CONSULTING ENGINEERS

Electrical Engineer  
JHA CONSULTING ENGINEERS

Fire Engineer  
OLSSON FIRE & RISK

Access Consultant  
ACCESSIBLE BUILDING SOLUTIONS

Basix  
EMF GRIFFITHS

Building Key

Client



Project  
HIGH ST DEVELOPMENT

634-638 HIGH ST & 87-89  
UNION RD, PENRITH

Drawing Name  
ADAPTABLE UNITS - BUILDING 01

Date  
04.10.2021

Scale  
1 : 50

Sheet Size  
@ A1

Drawn  
GT

Chk.  
MG

Job No.  
6111


Drawing No.  
AR-1-1102

Revision  
/86


SJB Architects  
Level 2  
490 Crown Street  
Surry Hills NSW  
2010 Australia  
T 61 2 9380 9911  
F 61 2 9380 9922  
www.sjb.com.au





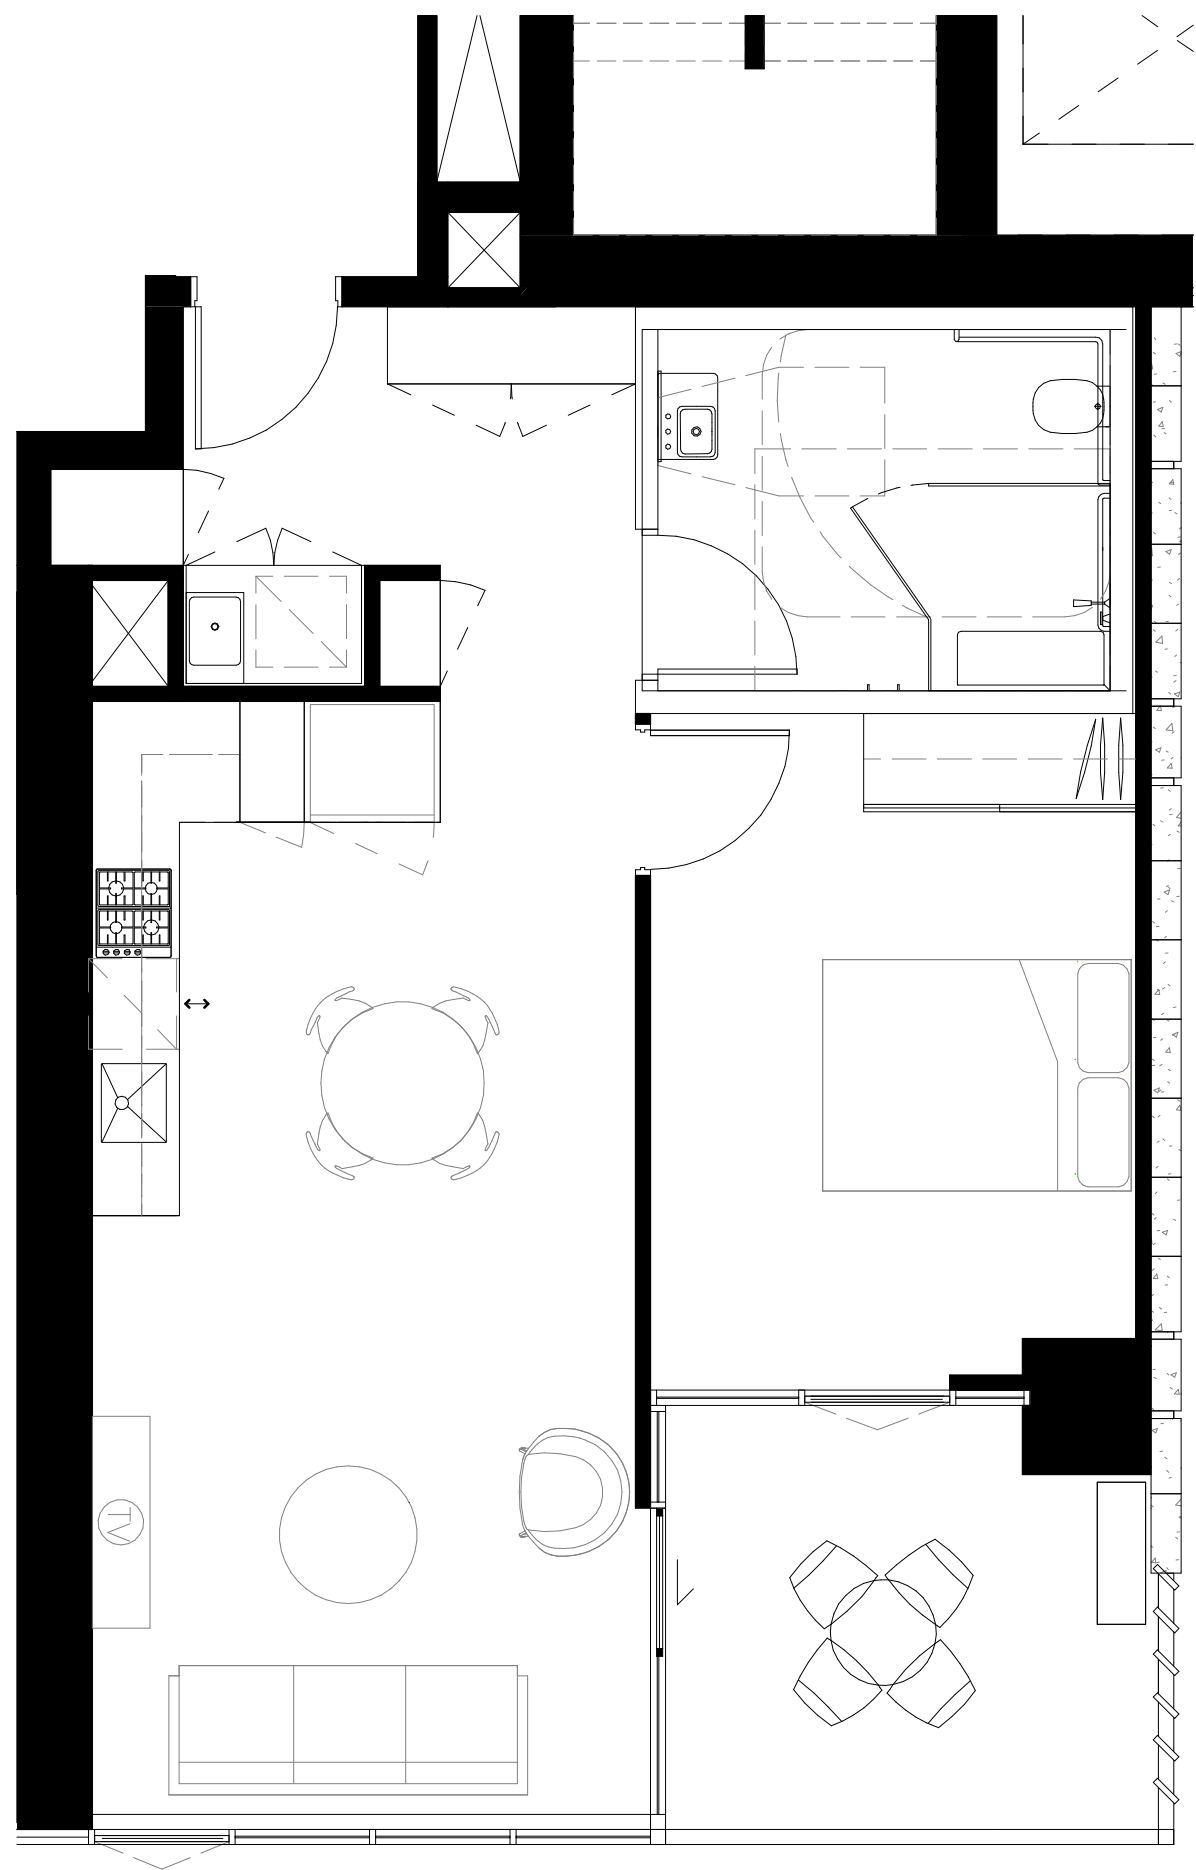

**01 PRE-ADAPTABLE - APARTMENT B1101**  
AR-1-0102B 1 : 50@A1

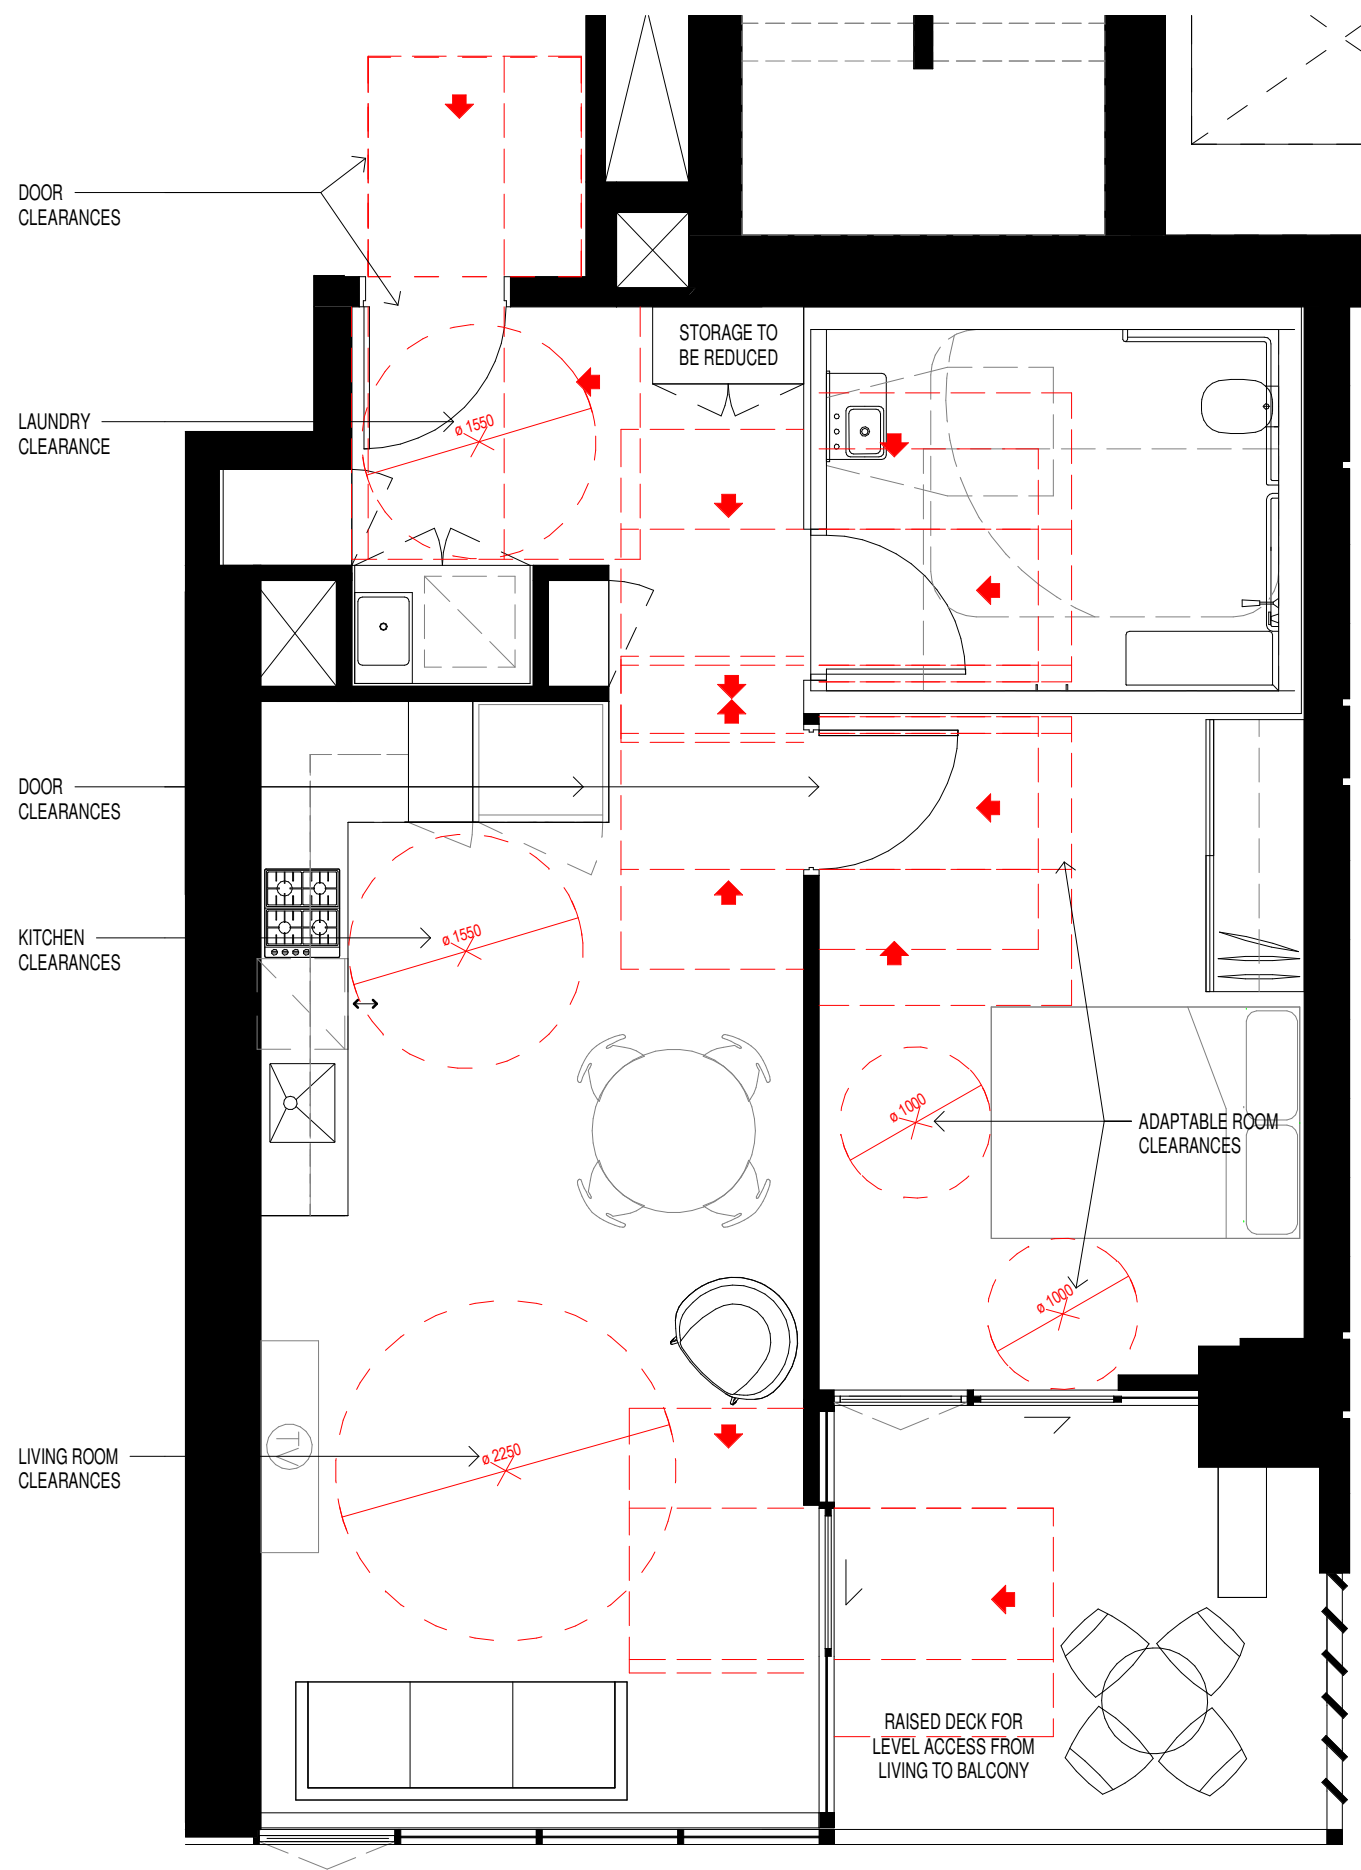

**02 POST-ADAPTABLE - APARTMENT B1101**  
AR-1-0102B 1 : 50@A1

In accepting and utilising this document the recipient agrees that SJB Architecture (NSW) Pty. Ltd. ACN 081 094 724 T/A SJB Architects, retain all common law, statutory law and other rights including copyright and intellectual property rights. The recipient agrees not to use this document for any purpose other than its intended use; to waive all claims against SJB Architects resulting from unauthorised changes; or to reuse the document on other projects without the prior written consent of SJB Architects. Under no circumstances shall transfer of this document be deemed a sale. SJB Architects makes no warranties of fitness for any purpose. The Builder/Contractor shall verify job dimensions prior to any work commencing. Use figured dimensions only. Do not scale drawings.

Nominated Architects: Adam Haddow-7188 | John Pradel-7004

**FOR APPROVAL**

Rev	Date	Revision
73	17.02.2020	ADAPTABLE APARTMENTS COORDINATION
81	28.02.2020	DRAFT DA ISSUE
83	04.03.2020	ISSUED FOR DA
85	07.05.2021	ISSUED FOR DA
86	04.10.2021	ISSUED FOR LEC


Structural Engineer	ROBERT BIRD GROUP
Mechanical / Hydraulic Engineer	JHA CONSULTING ENGINEERS
Electrical Engineer	JHA CONSULTING ENGINEERS
Fire Engineer	OLSSON FIRE & RISK
Access Consultant	ACCESSIBLE BUILDING SOLUTIONS
Basix	EMF GRIFFITHS
Building Key	



**Project**  
HIGH ST DEVELOPMENT

634-638 HIGH ST & 87-89  
UNION RD, PENRITH

**Drawing Name**  
ADAPTABLE UNITS - BUILDING 02

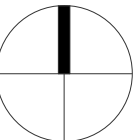


**Date** 04.10.2021 **Scale** 1 : 50 **Sheet Size** @ A1


**Drawn** GT **Chk.** MG

**Job No.** 6111 **Drawing No.** AR-1-1103 **Revision** /86


**SJB Architects**  
Level 2  
490 Crown Street  
Surry Hills NSW  
2010 Australia  
T 61 2 9380 9911  
F 61 2 9380 9922  
www.sjb.com.au

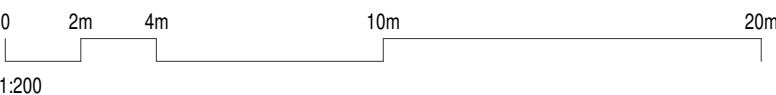




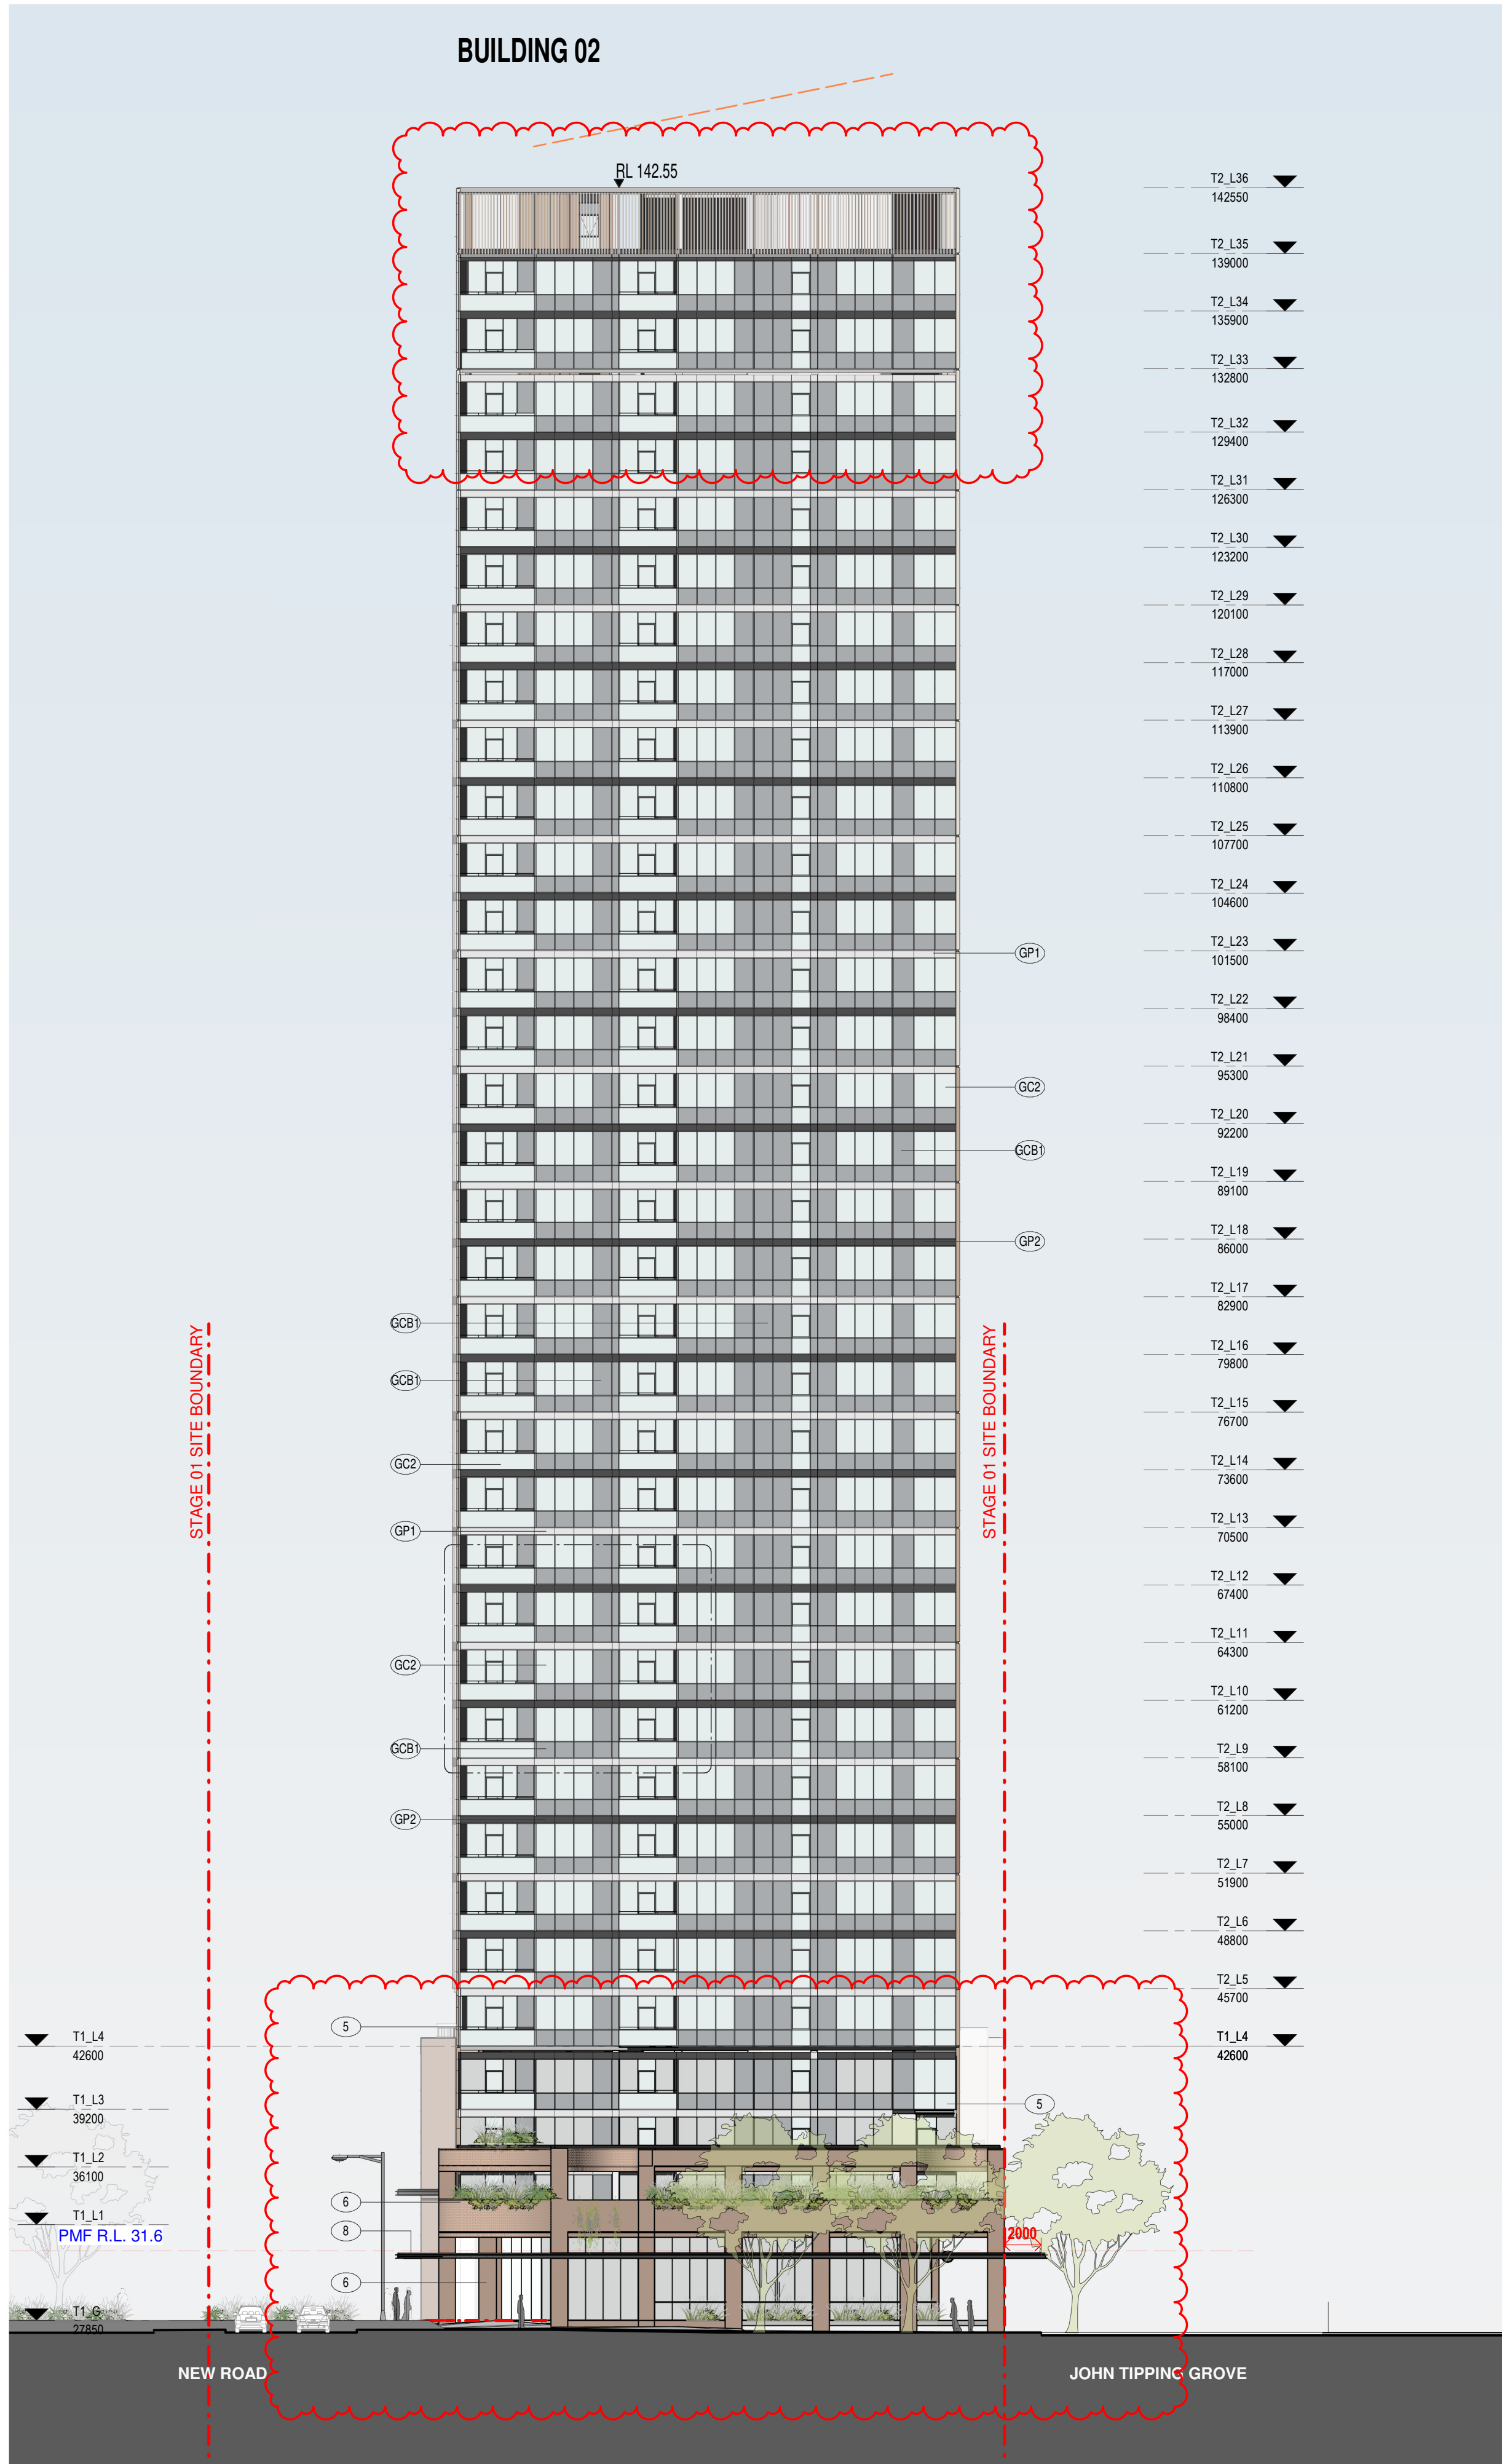

01 NORTH ELEVATION  
1 : 250@A1

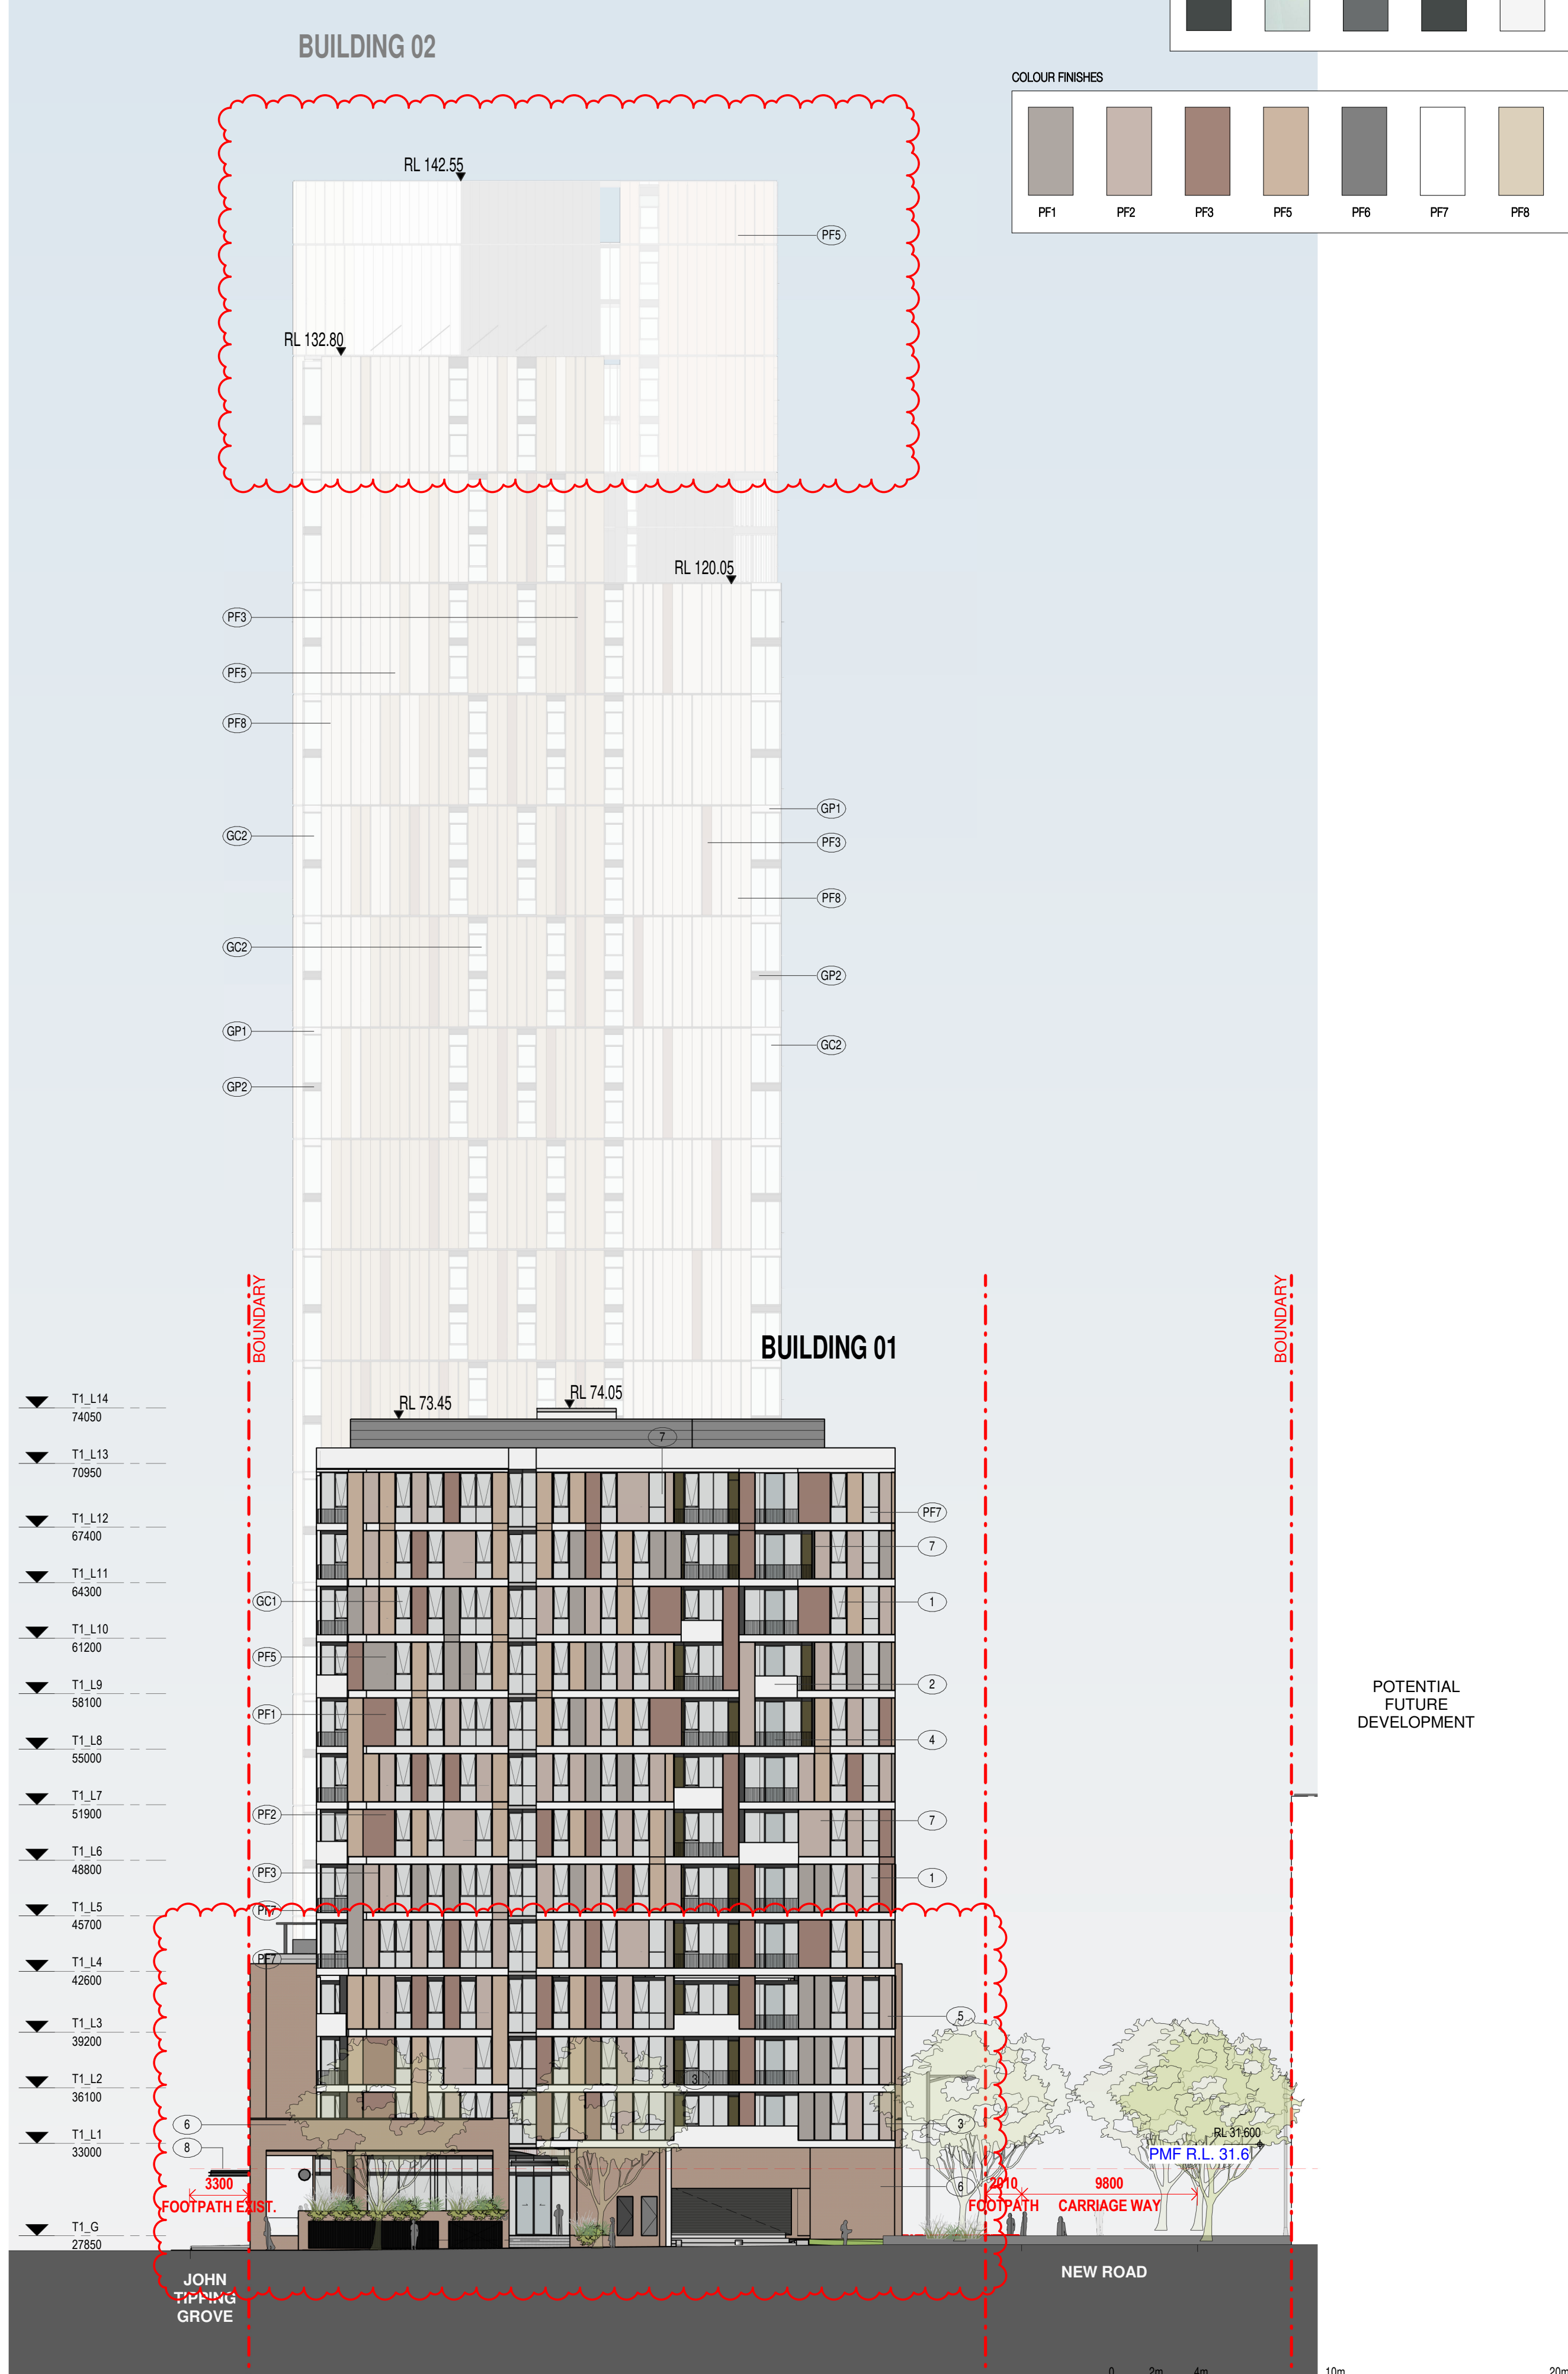

02 SOUTH ELEVATION  
1 : 250@A1

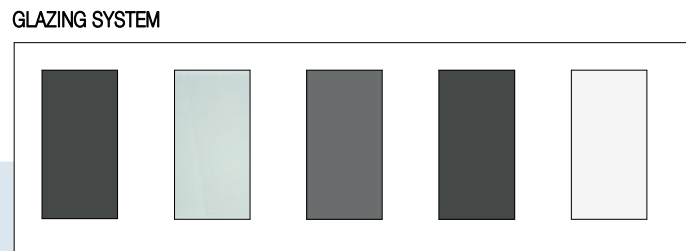

In accepting and utilising this document the recipient agrees that SJB Architecture (NSW) Pty. Ltd. ACN 081 094 724 T/A SJB Architects, retain all common law, statutory law and other rights including copyright and intellectual property rights. The recipient agrees not to use this document for any purpose other than its intended use; to waive all claims against SJB Architects resulting from unauthorised changes; or to reuse the document on other projects without the prior written consent of SJB Architects. Under no circumstances shall transfer of this document be deemed a sale. SJB Architects makes no warranties of fitness for any purpose. The Builder/Contractor shall verify job dimensions prior to any work commencing. Use figured dimensions only. Do not scale drawings.

Nominated Architects: Adam Haddow-7188 | John Pradel-7004

**FOR APPROVAL**

Rev	Date	Revision
66	24.01.2020	PRELIMINARY ISSUE
70	06.02.2020	PRE DA ISSUE
76	20.02.2020	ISSUED FOR BASIX COORDINATION
81	28.02.2020	DRAFT DA ISSUE
83	04.03.2020	ISSUED FOR DA
85	07.05.2021	ISSUED FOR DA
86	04.10.2021	ISSUED FOR LEC

Structural Engineer  
**ROBERT BIRD GROUP**

Mechanical / Hydraulic Engineer  
**JHA CONSULTING ENGINEERS**

Electrical Engineer  
**JHA CONSULTING ENGINEERS**

Fire Engineer  
**OLSSON FIRE & RISK**

Access Consultant  
**ACCESSIBLE BUILDING SOLUTIONS**

Basix  
**EMF GRIFFITHS**

Building Key

Client



Project  
**HIGH ST DEVELOPMENT**

**634-638 HIGH ST & 87-89 UNION RD, PENRITH**

Drawing Name  
**NORTH & SOUTH ELEVATION**

Date  
**04.10.2021**

Scale  
**As indicated**

Sheet Size  
**@ A1**

Drawn  
**GT**

Chk.  
**MG**

Job No.  
**6111**

Drawing No.  
**AR-1-5000**

Revision  
**/86**

**SJB Architects**  
Level 2  
490 Crown Street  
Surry Hills NSW  
2010 Australia  
T 61 2 9380 9911  
F 61 2 9380 9922  
www.sjb.com.au












BUILDING 02

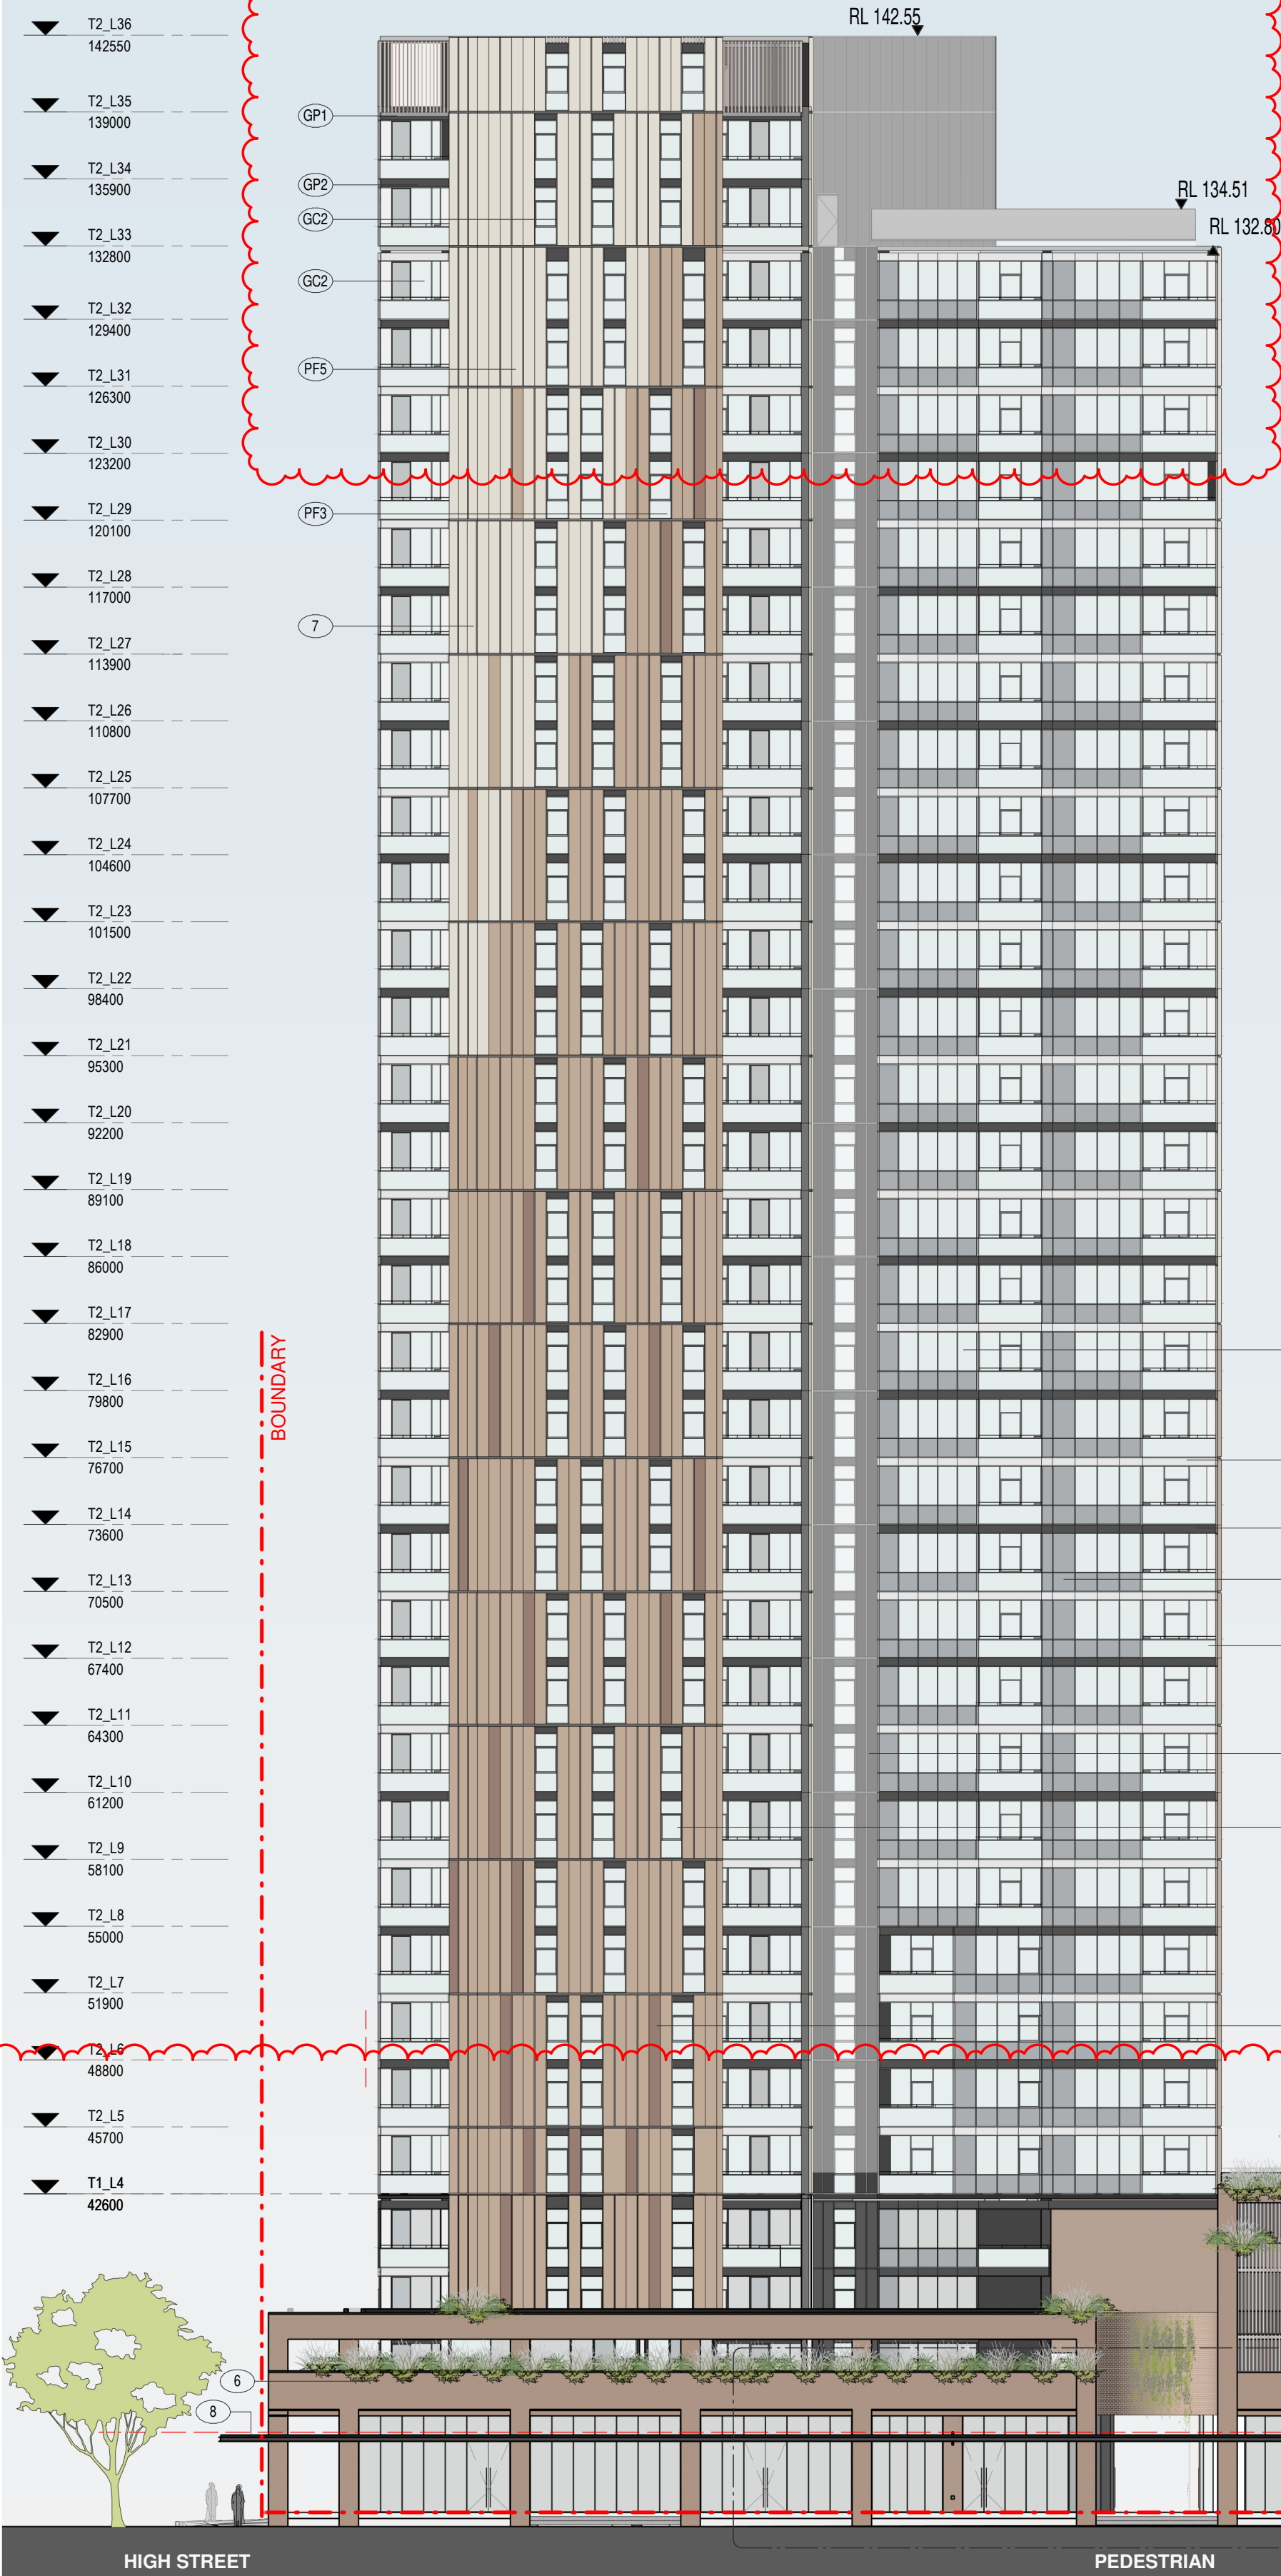




GLAZING SYSTEM

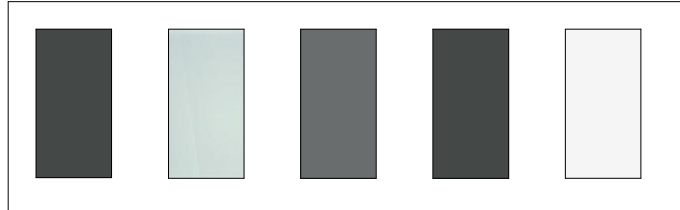

COLOUR FINISHES

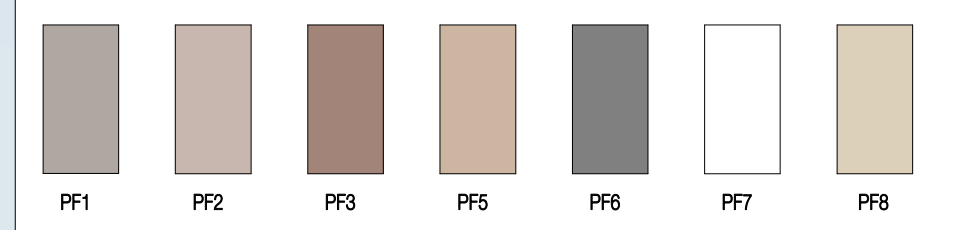

BUILDING 01

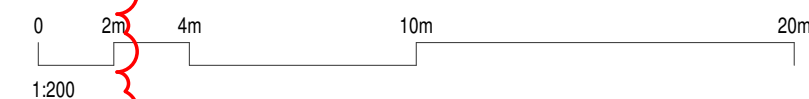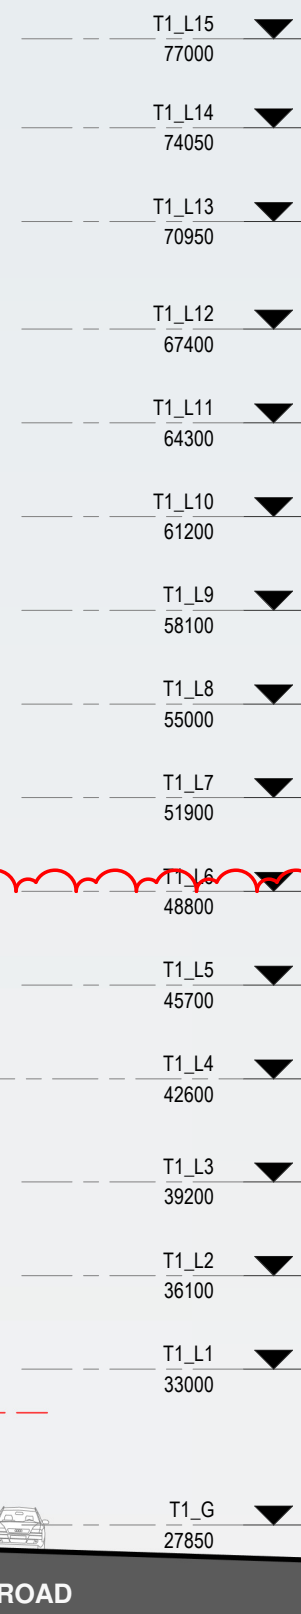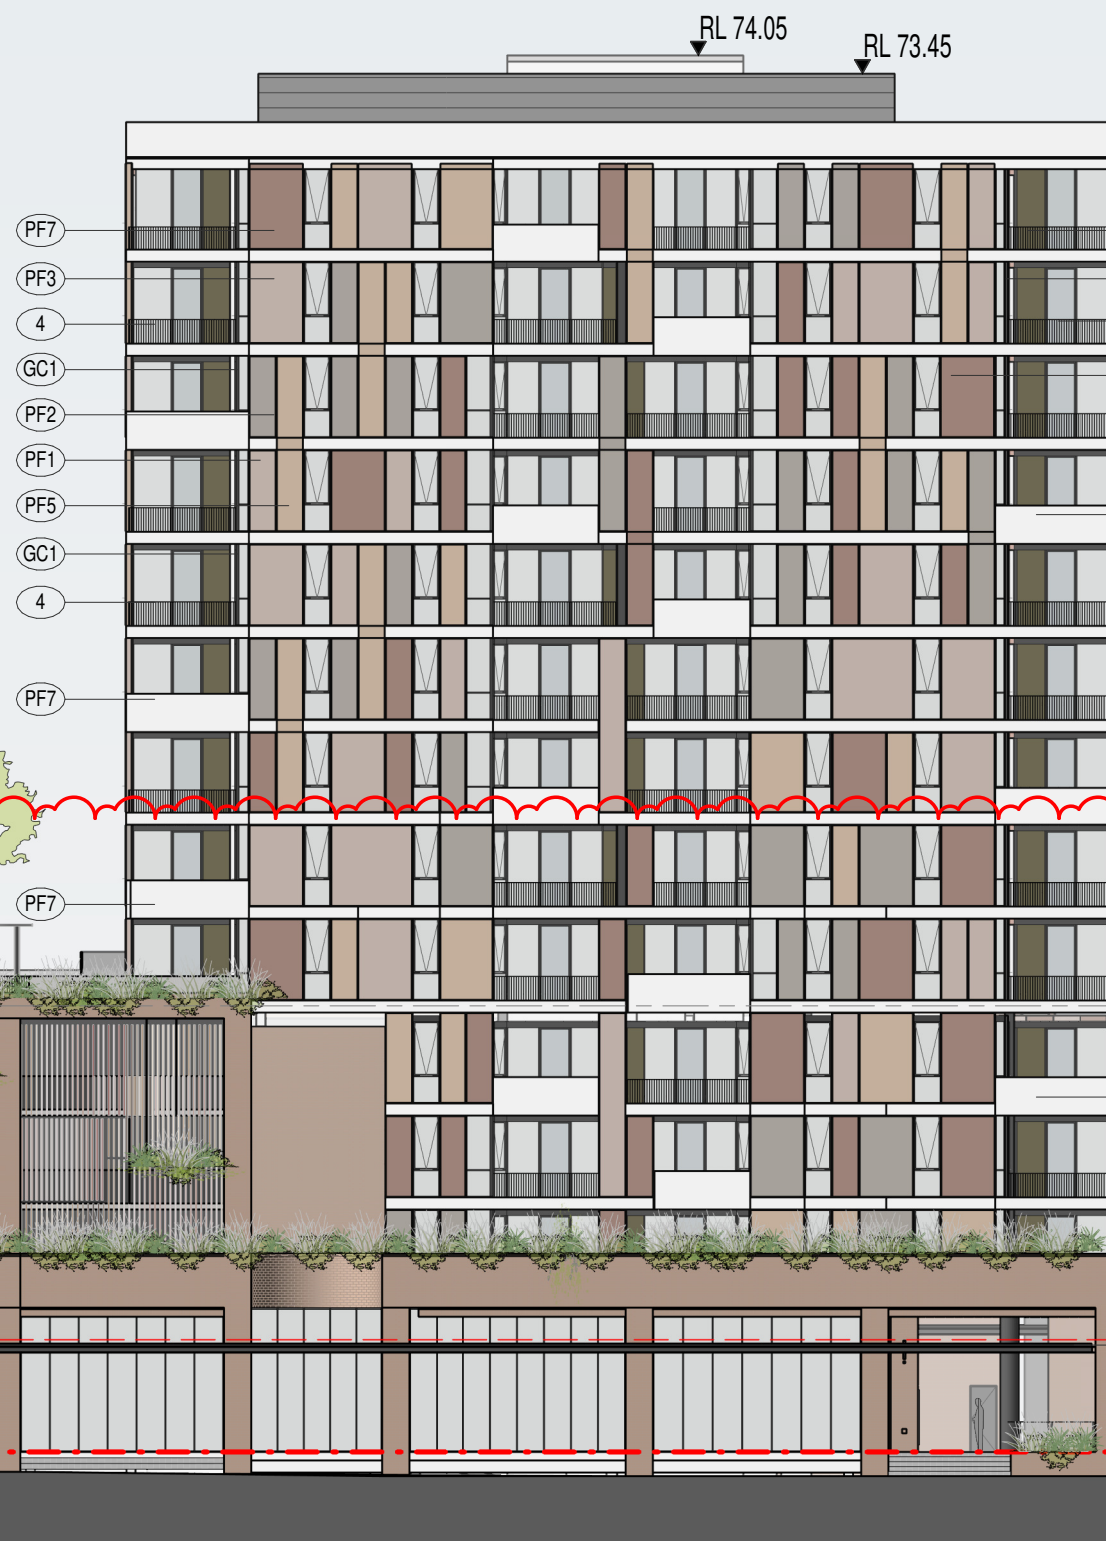

In accepting and utilising this document the recipient agrees that SJB Architecture (NSW) Pty. Ltd. ACN 081 094 724 T/A SJB Architects, retain all common law, statutory law and other rights including copyright and intellectual property rights. The recipient agrees not to use this document for any purpose other than its intended use; to waive all claims against SJB Architects resulting from unauthorised changes; or to reuse the document on other projects without the prior written consent of SJB Architects. Under no circumstances shall transfer of this document be deemed a sale. SJB Architects makes no warranties of fitness for any purpose. The Builder/Contractor shall verify job dimensions prior to any work commencing. Use figured dimensions only. Do not scale drawings.

Nominated Architects: Adam Haddow-7188 | John Pradel-7004

FOR APPROVAL

Rev	Date	Revision
66	24.01.2020	PRELIMINARY ISSUE
70	06.02.2020	PRE DA ISSUE
76	20.02.2020	ISSUED FOR BASIX COORDINATION
81	28.02.2020	DRAFT DA ISSUE
83	04.03.2020	ISSUED FOR DA
85	07.05.2021	ISSUED FOR DA
86	04.10.2021	ISSUED FOR LEC

Structural Engineer  
ROBERT BIRD GROUP

Mechanical / Hydraulic Engineer  
JHA CONSULTING ENGINEERS

Electrical Engineer  
JHA CONSULTING ENGINEERS

Fire Engineer  
OLSSON FIRE & RISK

Access Consultant  
ACCESSIBLE BUILDING SOLUTIONS

Basix  
EMF GRIFFITHS

Building Key

Client



Project  
HIGH ST DEVELOPMENT

634-638 HIGH ST & 87-89  
UNION RD, PENRITH

Drawing Name

WEST ELEVATION

Date  
04.10.2021

Scale  
As indicated

Sheet Size  
@ A1

Drawn  
GT

Chk.  
MG

Job No.  
6111



Drawing No.  
AR-1-5002

Revision  
/86

SJB Architects  
Level 2  
490 Crown Street  
Surry Hills NSW  
2010 Australia  
T 61 2 9380 9911  
F 61 2 9380 9922  
www.sjb.com.au





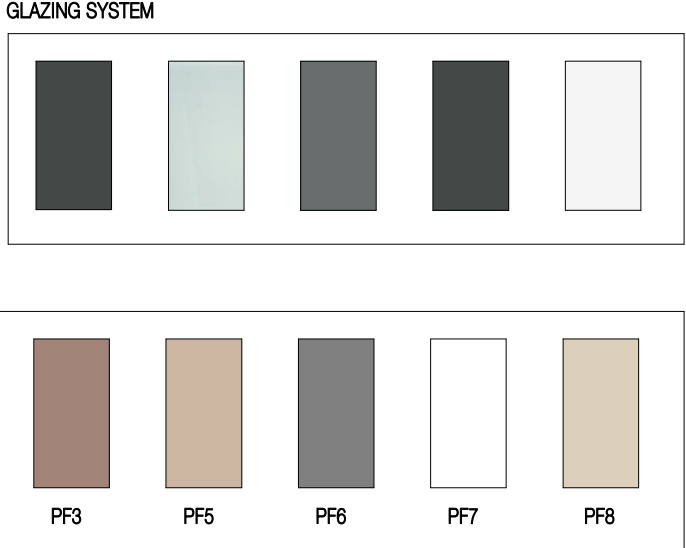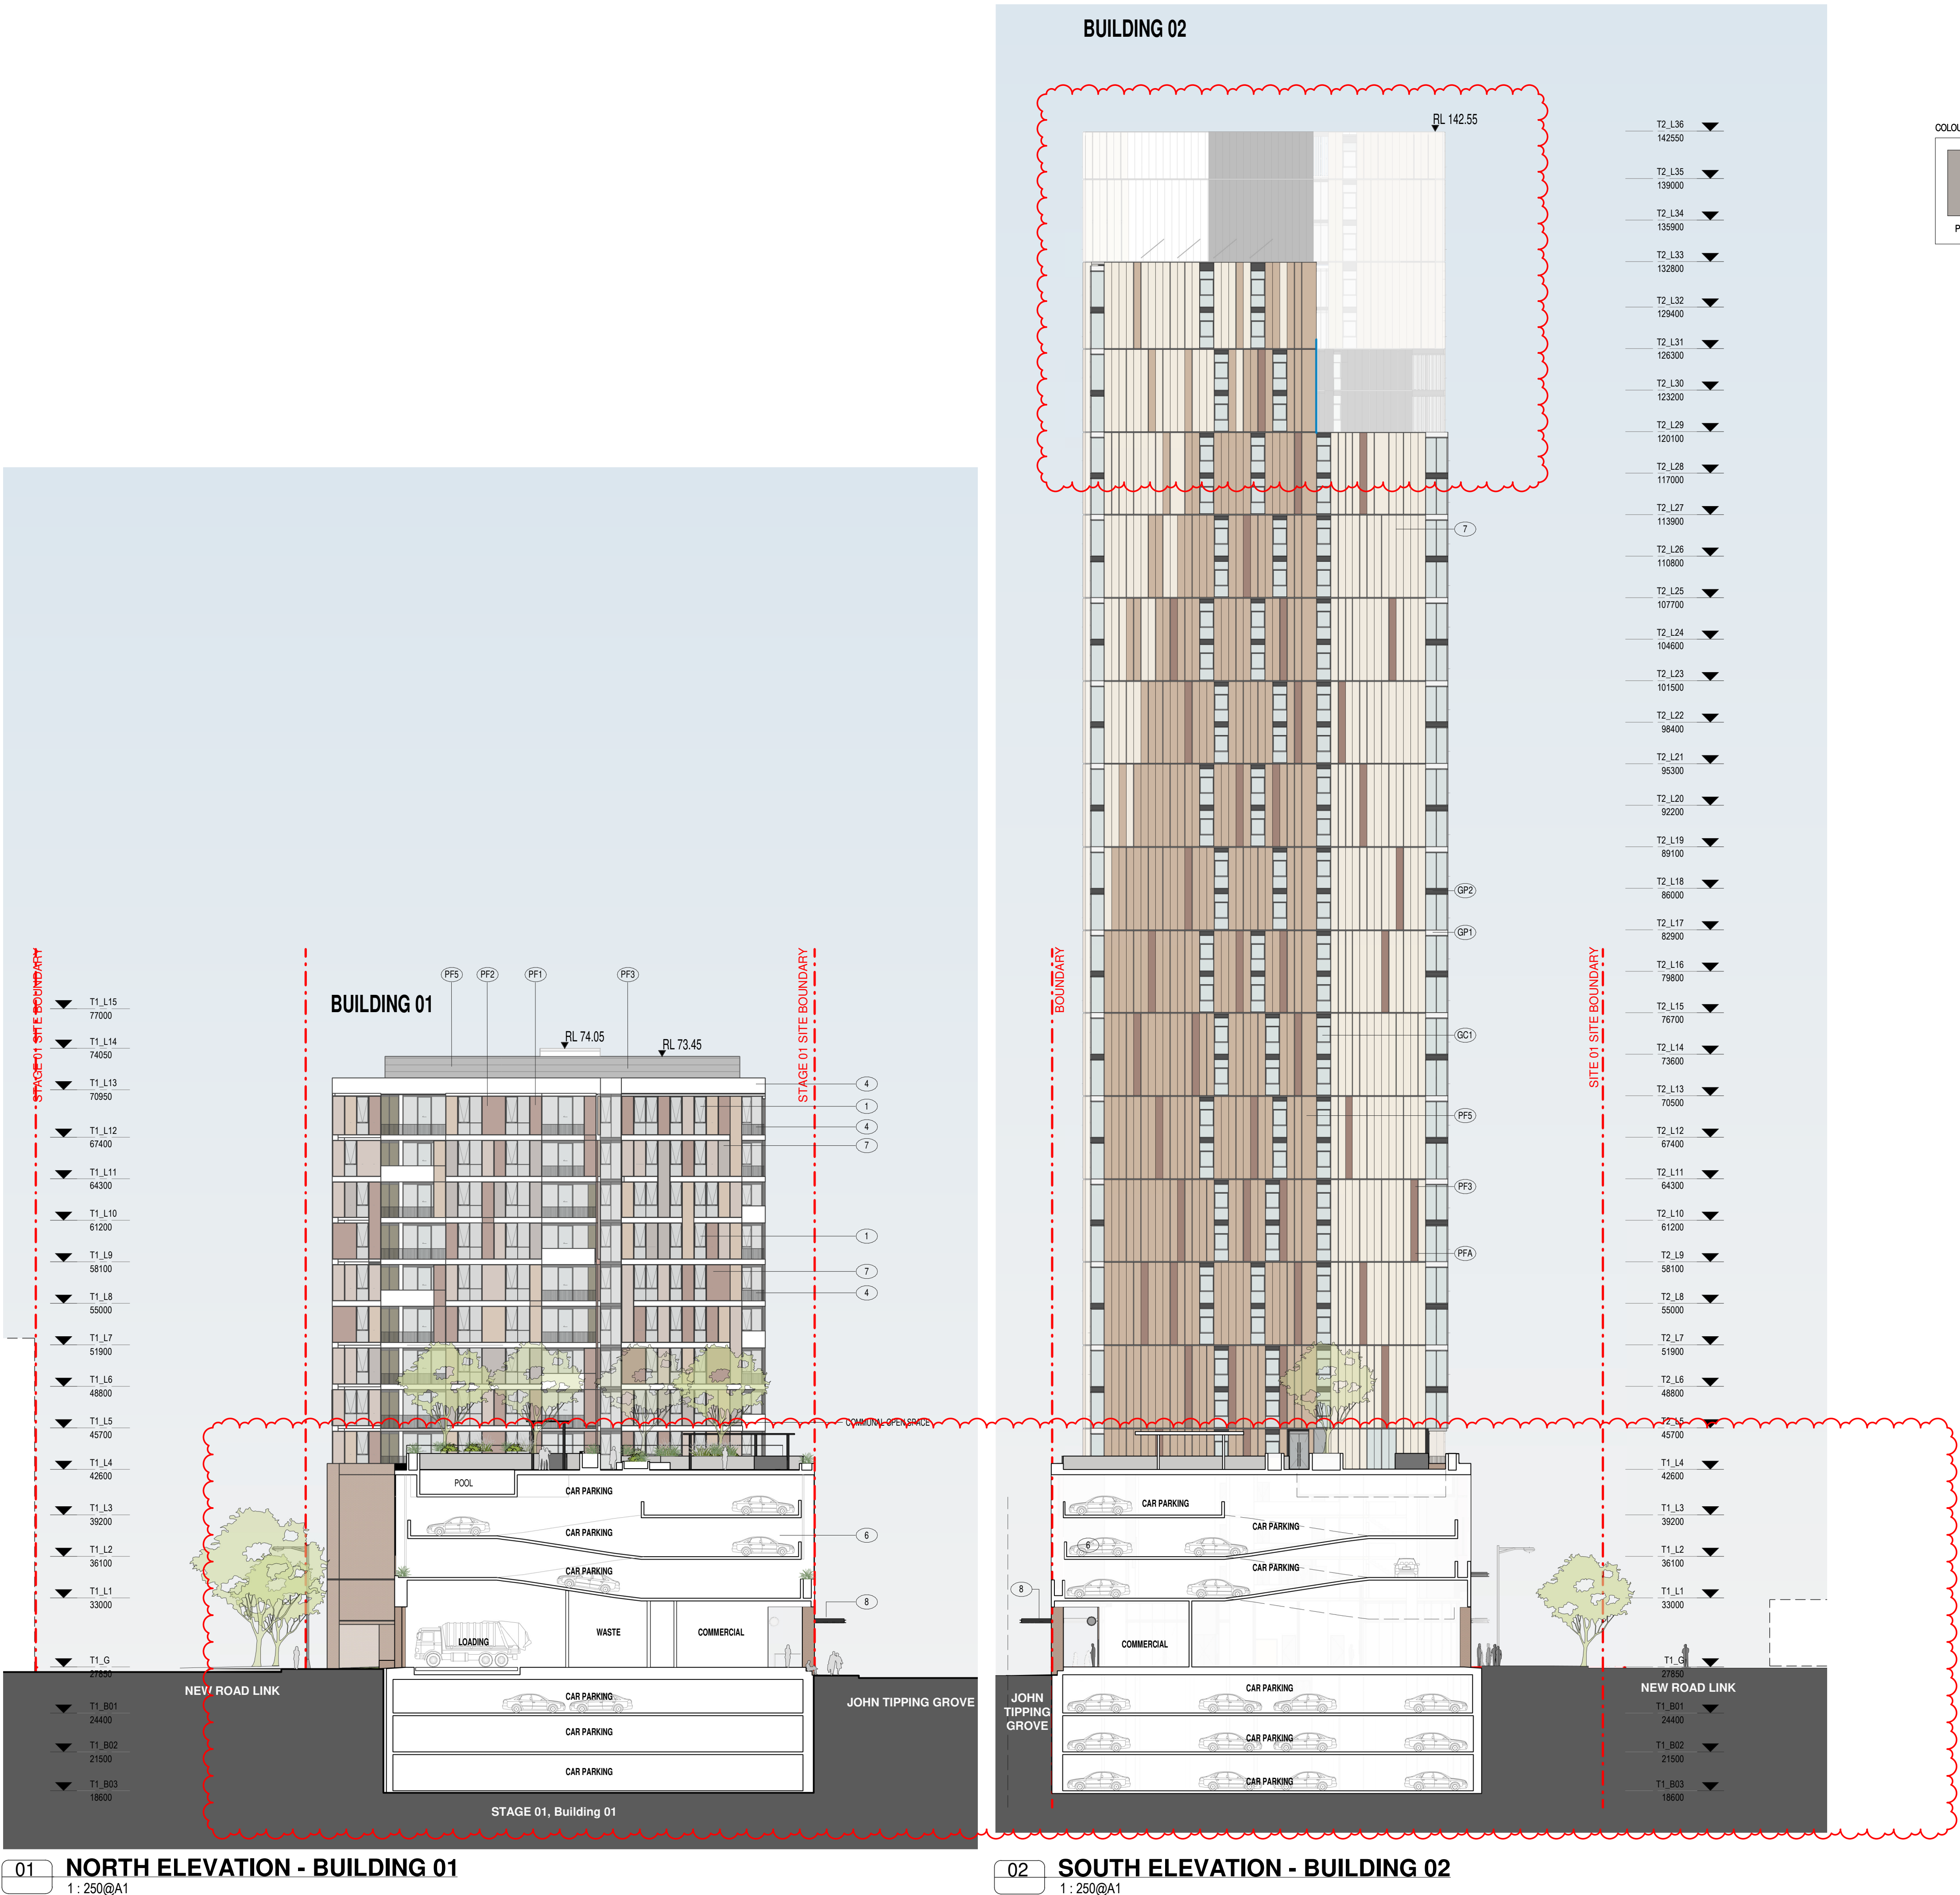

In accepting and utilising this document the recipient agrees that SJB Architecture (NSW) Pty. Ltd. ACN 081 994 724 T/A SJB Architects, retain all common law, statutory law and other rights including copyright and intellectual property rights. The recipient agrees not to use this document for any purpose other than its intended use, to waive all claims against SJB Architects resulting from unauthorised changes; or to reuse the document on other projects without the prior written consent of SJB Architects. Under no circumstances shall transfer of this document be deemed a sale. SJB Architects makes no warranties of fitness for any purpose. The Builder/Contractor shall verify job dimensions prior to any work commencing. Use figured dimensions only. Do not scale drawings.

Nominated Architects: Adam Haddow-7188 | John Pradel-7004

**FOR APPROVAL**

Rev	Date	Revision
66	24.01.2020	PRELIMINARY ISSUE
70	06.02.2020	PRE DA ISSUE
78	26.02.2020	ISSUED FOR LANDSCAPE COORDINATION
81	28.02.2020	DRAFT DA ISSUE
83	04.03.2020	ISSUED FOR DA
85	07.05.2021	ISSUED FOR DA
86	04.10.2021	ISSUED FOR LEC

Structural Engineer  
**ROBERT BIRD GROUP**

Mechanical / Hydraulic Engineer  
**JHA CONSULTING ENGINEERS**

Electrical Engineer  
**JHA CONSULTING ENGINEERS**

Fire Engineer  
**OLSSON FIRE & RISK**

Access Consultant  
**ACCESSIBLE BUILDING SOLUTIONS**

Basix  
**EMF GRIFFITHS**

Building Key

Client

**TOGA**

Project

**HIGH ST DEVELOPMENT**

634-638 HIGH ST & 87-89 UNION RD, PENRITH

Drawing Name

**NORTH & SOUTH PODIUM ELEVATIONS**

Date: 04.10.2021 Scale: As indicated Sheet Size: @ A1

Drawn: GT Chk: MG

Job No.: 6111 Drawing No.: AR-1-5004 Revision: /86

SJB Architects  
Level 2  
490 Crown Street  
Surry Hills NSW  
2010 Australia  
T 61 2 9380 9911  
F 61 2 9380 9922  
www.sjb.com.au

**SJB**



In accepting and utilising this document the recipient agrees that SJB Architecture (NSW) Pty. Ltd. ACN 081 094 724 T/A SJB Architects, retain all common law, statutory law and other rights including copyright and intellectual property rights. The recipient agrees not to use this document for any purpose other than its intended use, to waive all claims against SJB Architects resulting from unauthorised changes, or to reuse the document on other projects without the prior written consent of SJB Architects. Under no circumstances shall transfer of this document be deemed a sale. SJB Architects makes no warranties of fitness for any purpose. The Builder/Contractor shall verify job dimensions prior to any work commencing. Use figured dimensions only. Do not scale drawings.

Nominated Architects: Adam Haddow-7188 | John Pradel-7004

FOR APPROVAL

Rev	Date	Revision
66	24.01.2020	PRELIMINARY ISSUE
81	28.02.2020	DRAFT DA ISSUE
83	04.03.2020	ISSUED FOR DA
85	07.05.2021	ISSUED FOR DA
86	04.10.2021	ISSUED FOR LEC

Structural Engineer

ROBERT BIRD GROUP

Mechanical / Hydraulic Engineer

JHA CONSULTING ENGINEERS

Electrical Engineer

JHA CONSULTING ENGINEERS

Fire Engineer

OLSSON FIRE & RISK

Access Consultant

ACCESSIBLE BUILDING SOLUTIONS


Basix

EMF GRIFFITHS


Building Key



01 SITE LINK - GROUND FLOOR  
1 : 100@A1

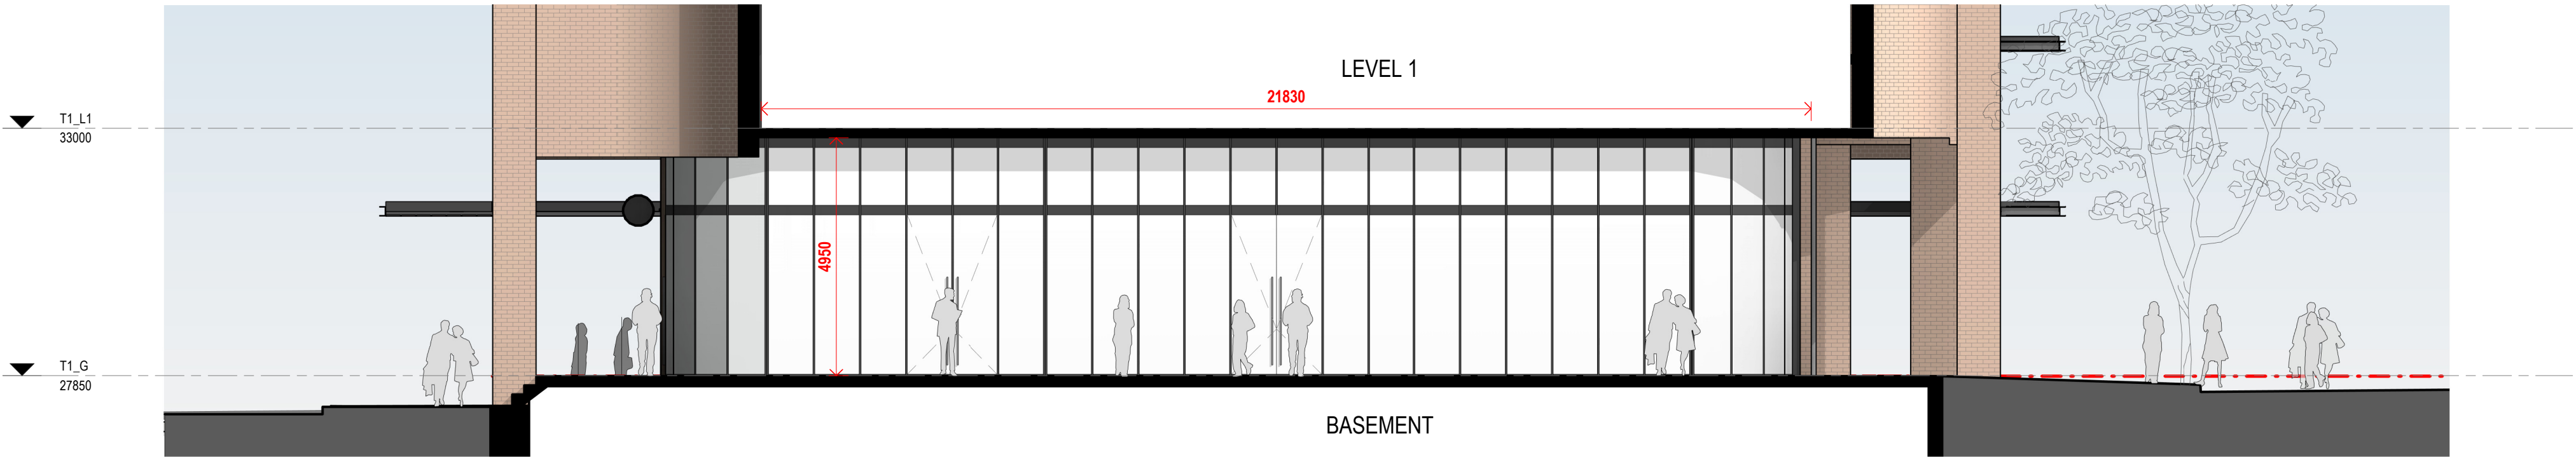

02 SITE LINK - SOUTH ELEVATION  
AR-1-5010 1 : 100@A1

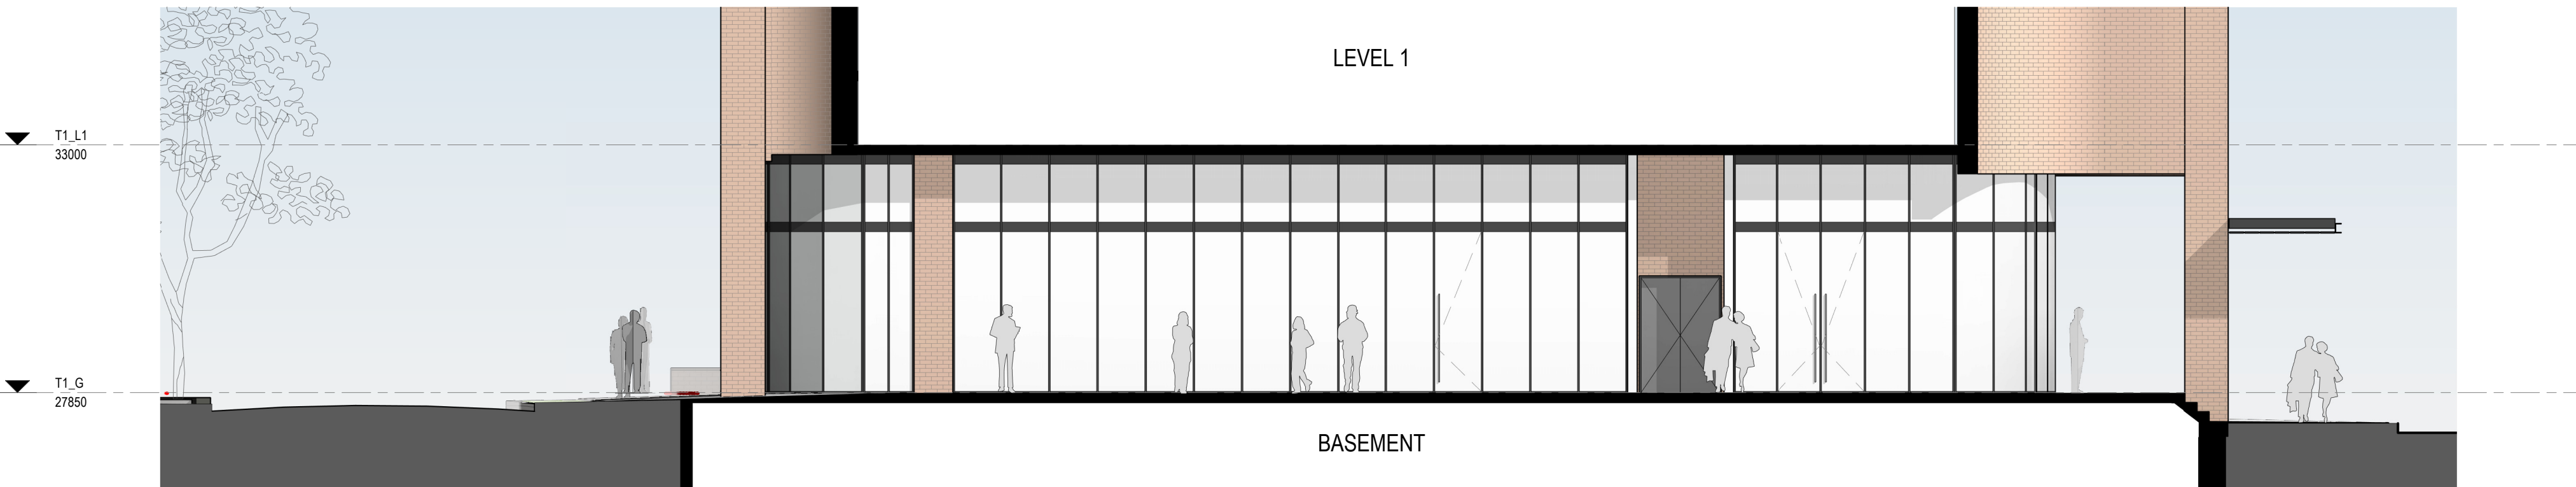

03 SITE LINK - NORTH ELEVATION  
AR-1-5010 1 : 100@A1



Client

Project

HIGH ST DEVELOPMENT

634-638 HIGH ST & 87-89  
UNION RD, PENRITH

Drawing Name

SITE LINK ELEVATIONS

Date 04.10.2021 Scale 1 : 100 Sheet Size @ A1


Drawn GT Chk. MG

Job No. 6111 Drawing No. AR-1-5010 /86 Revision

SJB Architects  
Level 2  
490 Crown Street  
Surry Hills NSW  
2010 Australia  
T 61 2 9380 9911  
F 61 2 9380 9922  
www.sjb.com.au





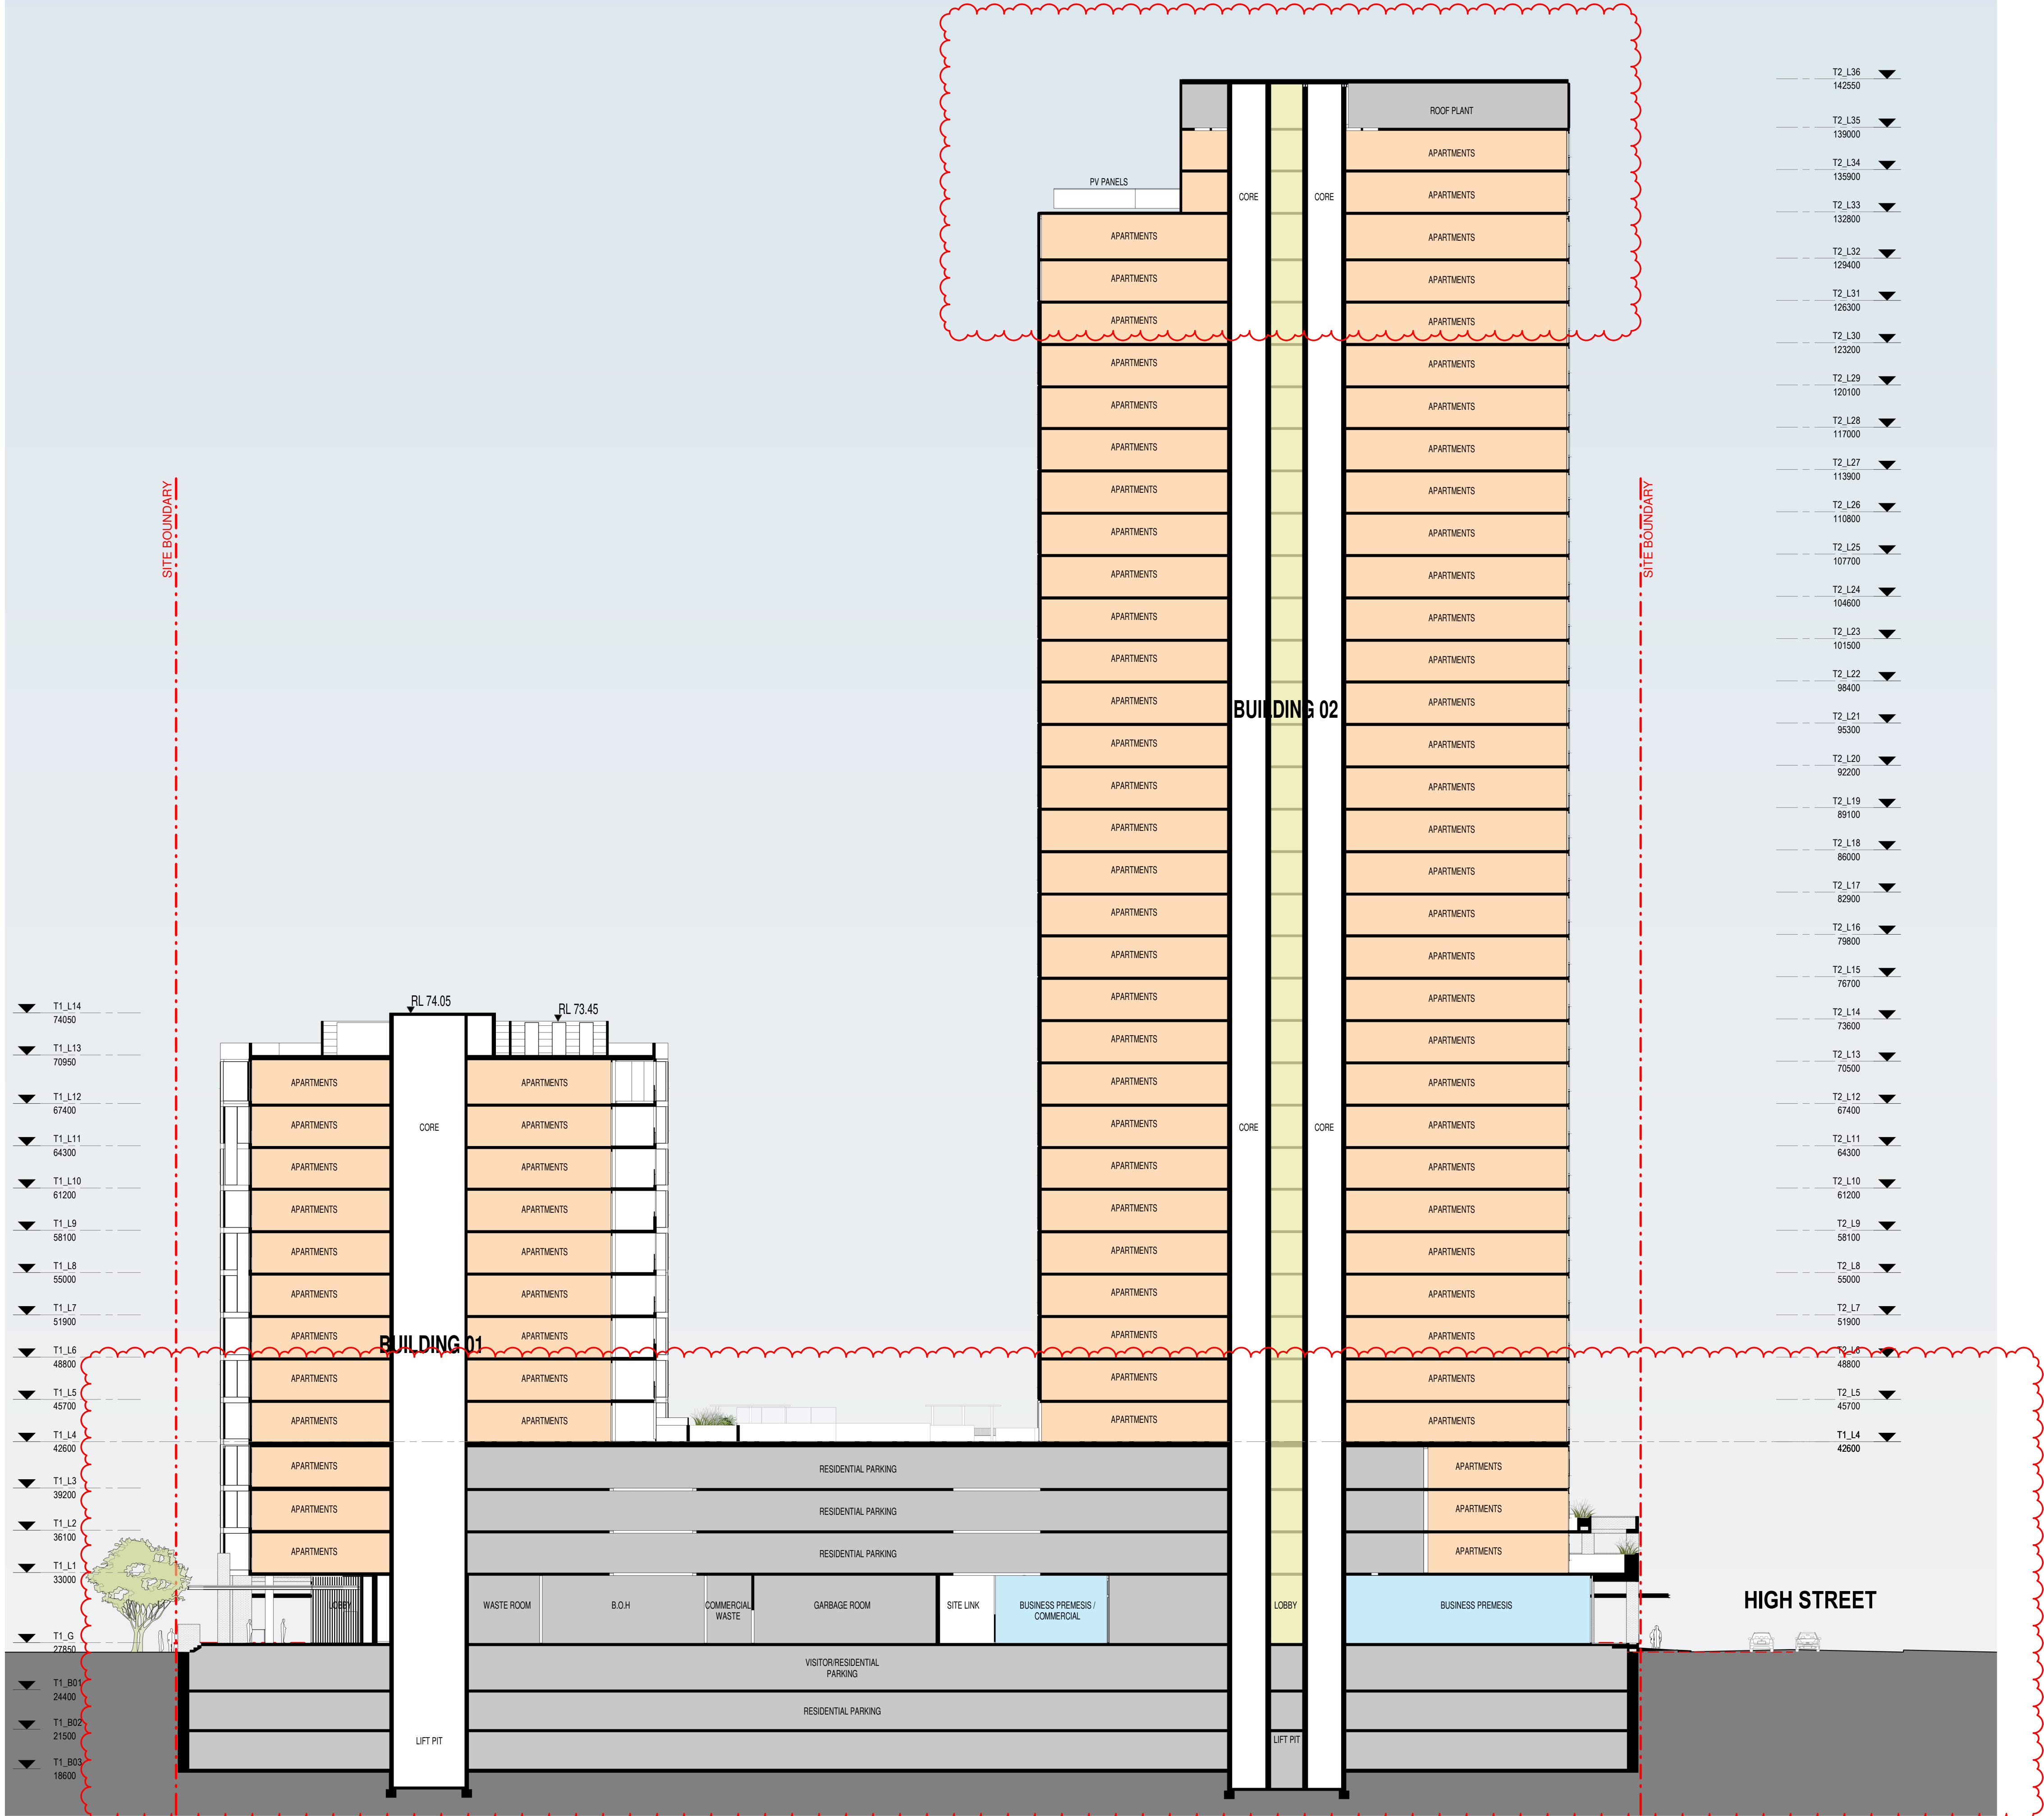

In accepting and utilising this document the recipient agrees that SJB Architecture (NSW) Pty. Ltd. ACN 081 094 724 T/A SJB Architects, retain all common law, statutory law and other rights including copyright and intellectual property rights. The recipient agrees not to use this document for any purpose other than its intended use, to waive all claims against SJB Architects resulting from unauthorised changes; or to reuse the document on other projects without the prior written consent of SJB Architects. Under no circumstances shall transfer of this document be deemed a sale. SJB Architects makes no warranties of fitness for any purpose. The Builder/Contractor shall verify job dimensions prior to any work commencing. Use figured dimensions only. Do not scale drawings.

Nominated Architects: Adam Haddow-7188 | John Pradel-7004

### FOR APPROVAL

Rev	Date	Revision
66	24.01.2020	PRELIMINARY ISSUE
81	28.02.2020	DRAFT DA ISSUE
83	04.03.2020	ISSUED FOR DA
85	07.05.2021	ISSUED FOR DA
86	04.10.2021	ISSUED FOR LEC

Structural Engineer

ROBERT BIRD GROUP

Mechanical / Hydraulic Engineer

JHA CONSULTING ENGINEERS

Electrical Engineer

JHA CONSULTING ENGINEERS

Fire Engineer

OLSSON FIRE & RISK

Access Consultant

ACCESSIBLE BUILDING SOLUTIONS

Basix

EMF GRIFFITHS

Building Key

Client



Project

HIGH ST DEVELOPMENT

634-638 HIGH ST & 87-89  
UNION RD, PENRITH

Drawing Name

SECTION A-A

Date 04.10.2021 Scale 1 : 250 Sheet Size @ A1


Drawn GT Chk. MG

Job No. 6111 Drawing No. AR-1-5100 /86 Revision

SJB Architects  
Level 2  
490 Crown Street  
Surry Hills NSW  
2010 Australia  
T 61 2 9380 9911  
F 61 2 9380 9922  
www.sjb.com.au





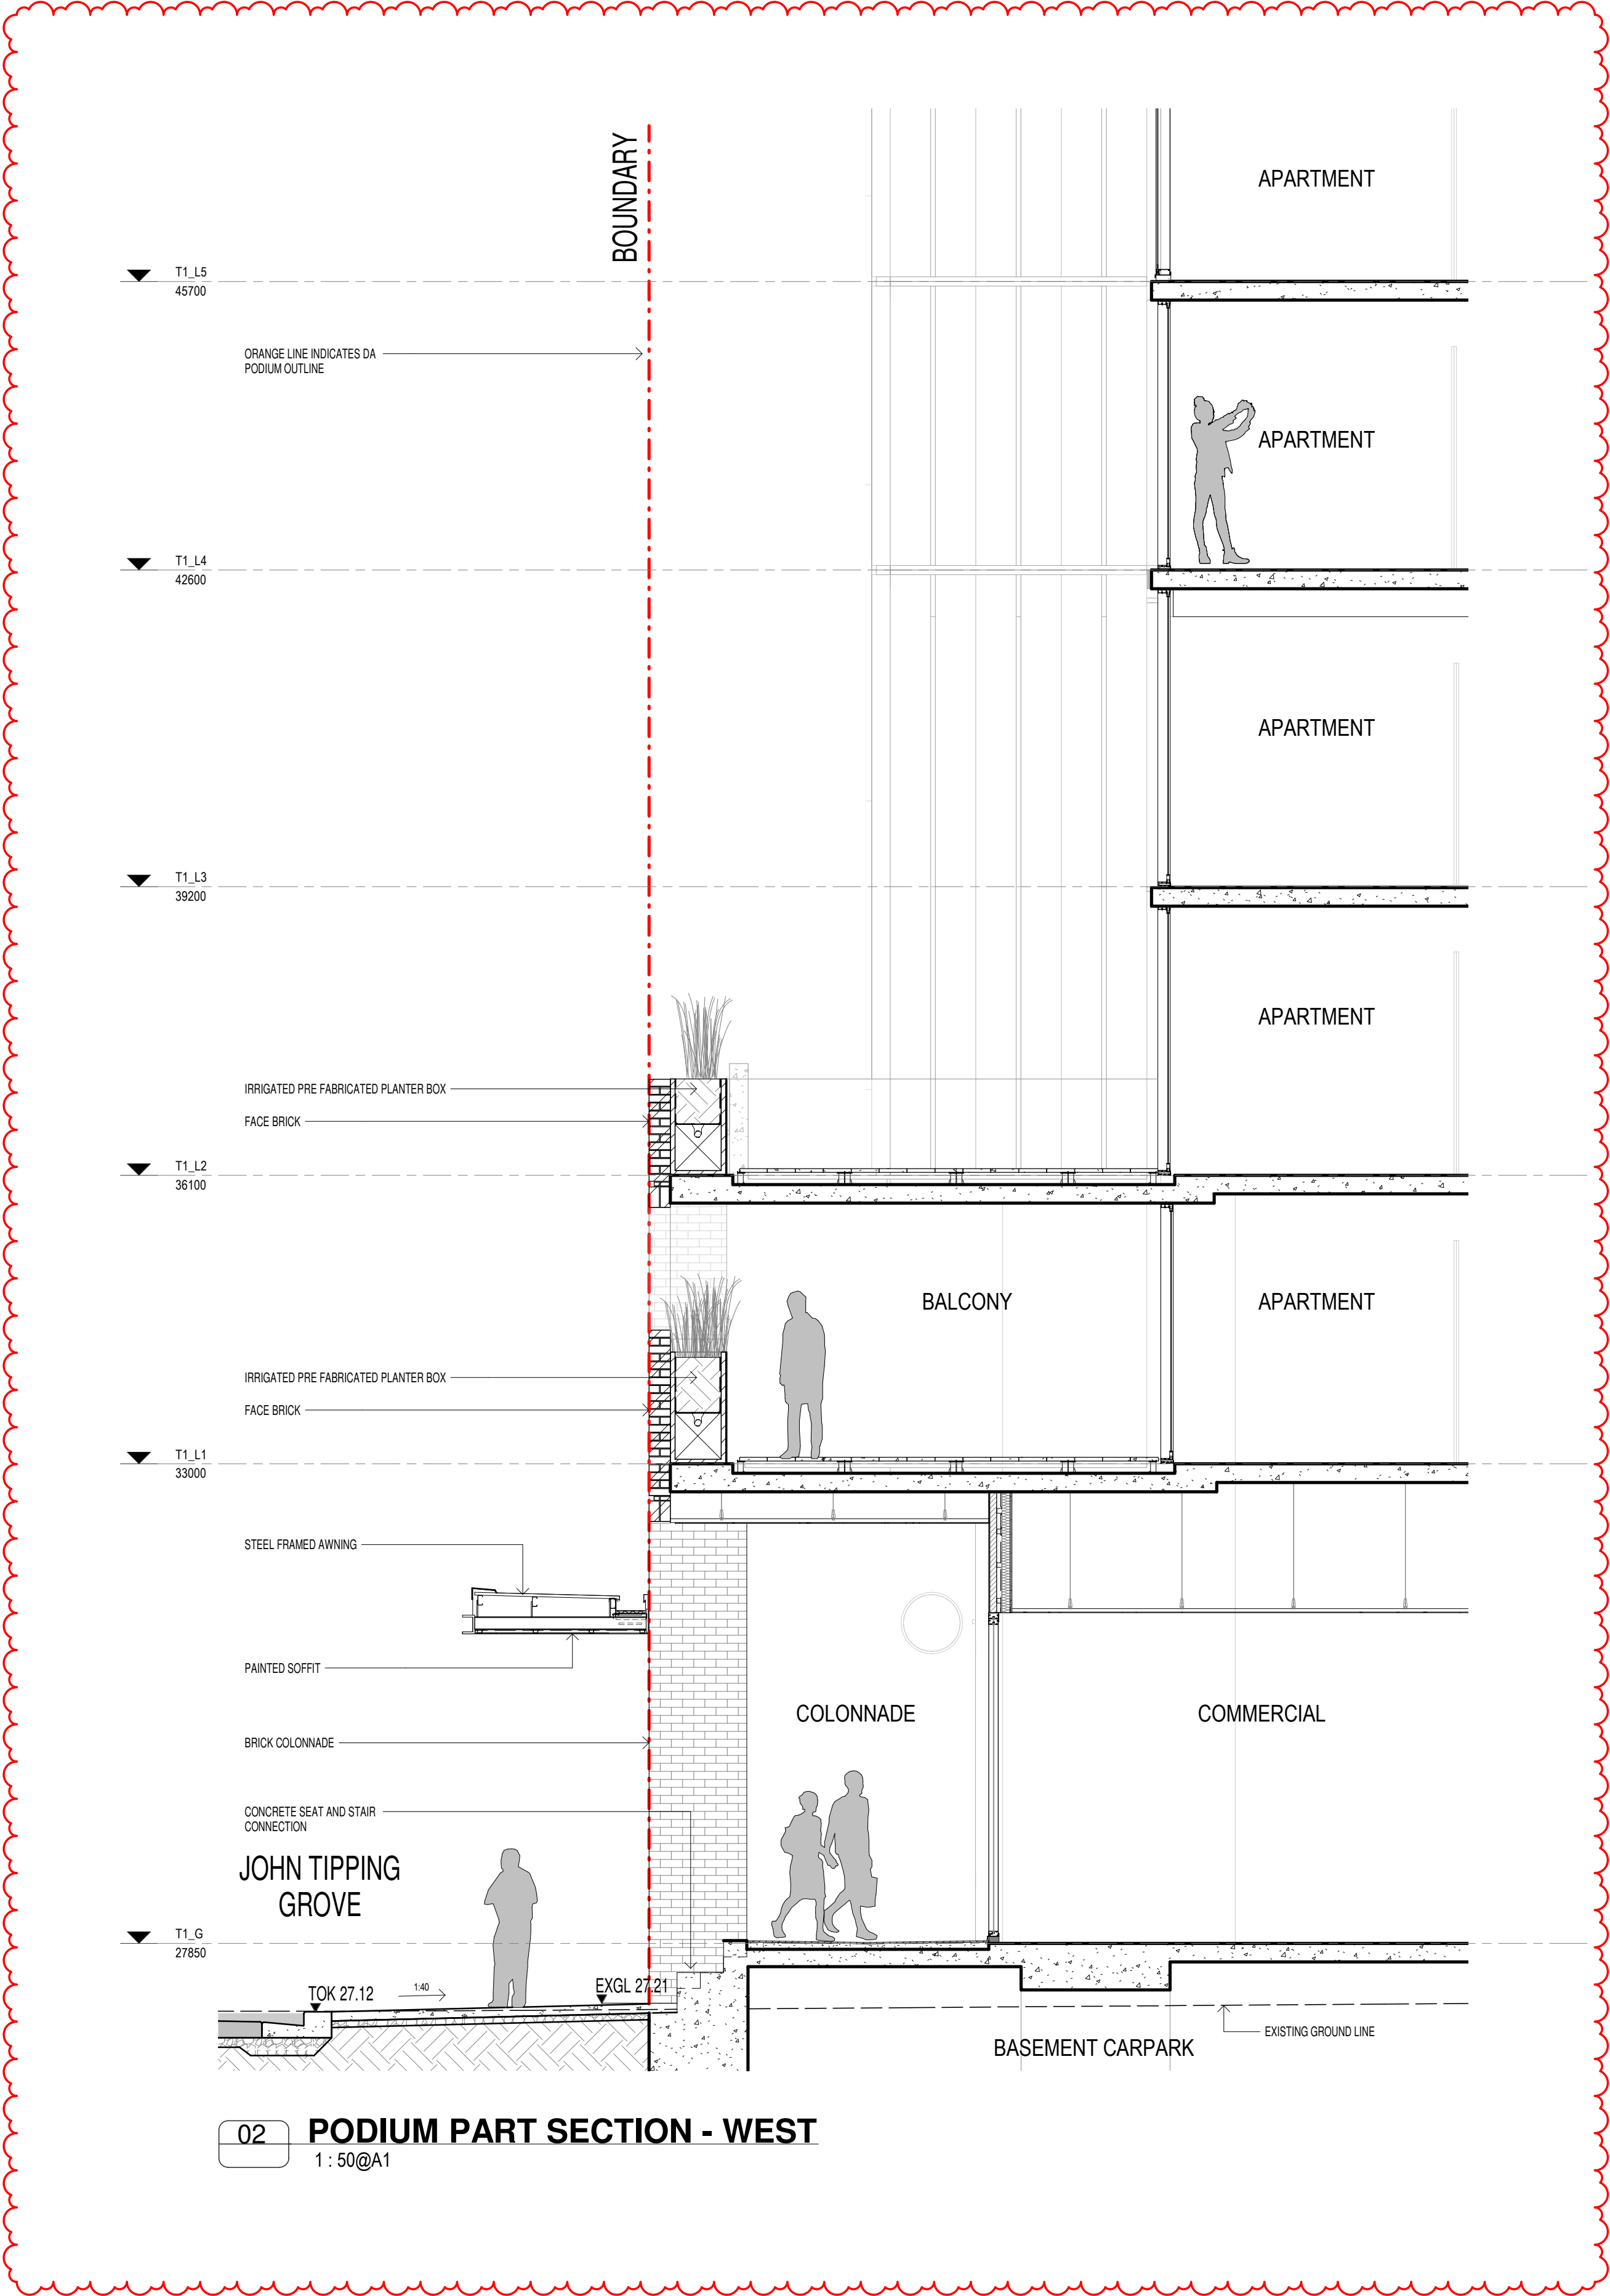

In accepting and utilising this document the recipient agrees that SJB Architecture (NSW) Pty. Ltd. ACN 081 094 724 T/A SJB Architects, retain all common law, statutory law and other rights including copyright and intellectual property rights. The recipient agrees not to use this document for any purpose other than its intended use, to waive all claims against SJB Architects resulting from unauthorised changes; or to reuse the document on other projects without the prior written consent of SJB Architects. Under no circumstances shall transfer of this document be deemed a sale. SJB Architects makes no warranties of fitness for any purpose. The Builder/Contractor shall verify job dimensions prior to any work commencing. Use figured dimensions only. Do not scale drawings.

Nominated Architects: Adam Haddow-7188 | John Pradel-7004

FOR APPROVAL

Rev	Date	Revision
79	27.02.2020	ISSUED FOR LANDSCAPE COORDINATION
81	28.02.2020	DRAFT DA ISSUE
83	04.03.2020	ISSUED FOR DA
85	07.05.2021	ISSUED FOR DA
86	04.10.2021	ISSUED FOR LEC

Structural Engineer  
ROBERT BIRD GROUP

Mechanical / Hydraulic Engineer  
JHA CONSULTING ENGINEERS

Electrical Engineer  
JHA CONSULTING ENGINEERS

Fire Engineer  
OLSSON FIRE & RISK

Access Consultant  
ACCESSIBLE BUILDING SOLUTIONS

Basix  
EMF GRIFFITHS

Building Key

Client



Project  
HIGH ST DEVELOPMENT

634-638 HIGH ST & 87-89  
UNION RD, PENRITH

Drawing Name

PODIUM FACADE DETAILS

Date  
04.10.2021

Scale  
1 : 50

Sheet Size  
@ A1

Drawn  
GT

Chk.  
MG

Job No.  
6111

Drawing No.  
AR-1-5201

Revision  
/86


SJB Architects  
Level 2  
490 Crown Street  
Surry Hills NSW  
2010 Australia  
T 61 2 9380 9911  
F 61 2 9380 9922  
www.sjb.com.au










01 NORTH ELEVATION - TYPICAL GLASS FACADE DETAIL  
AR-1-5000 1: 50@A1

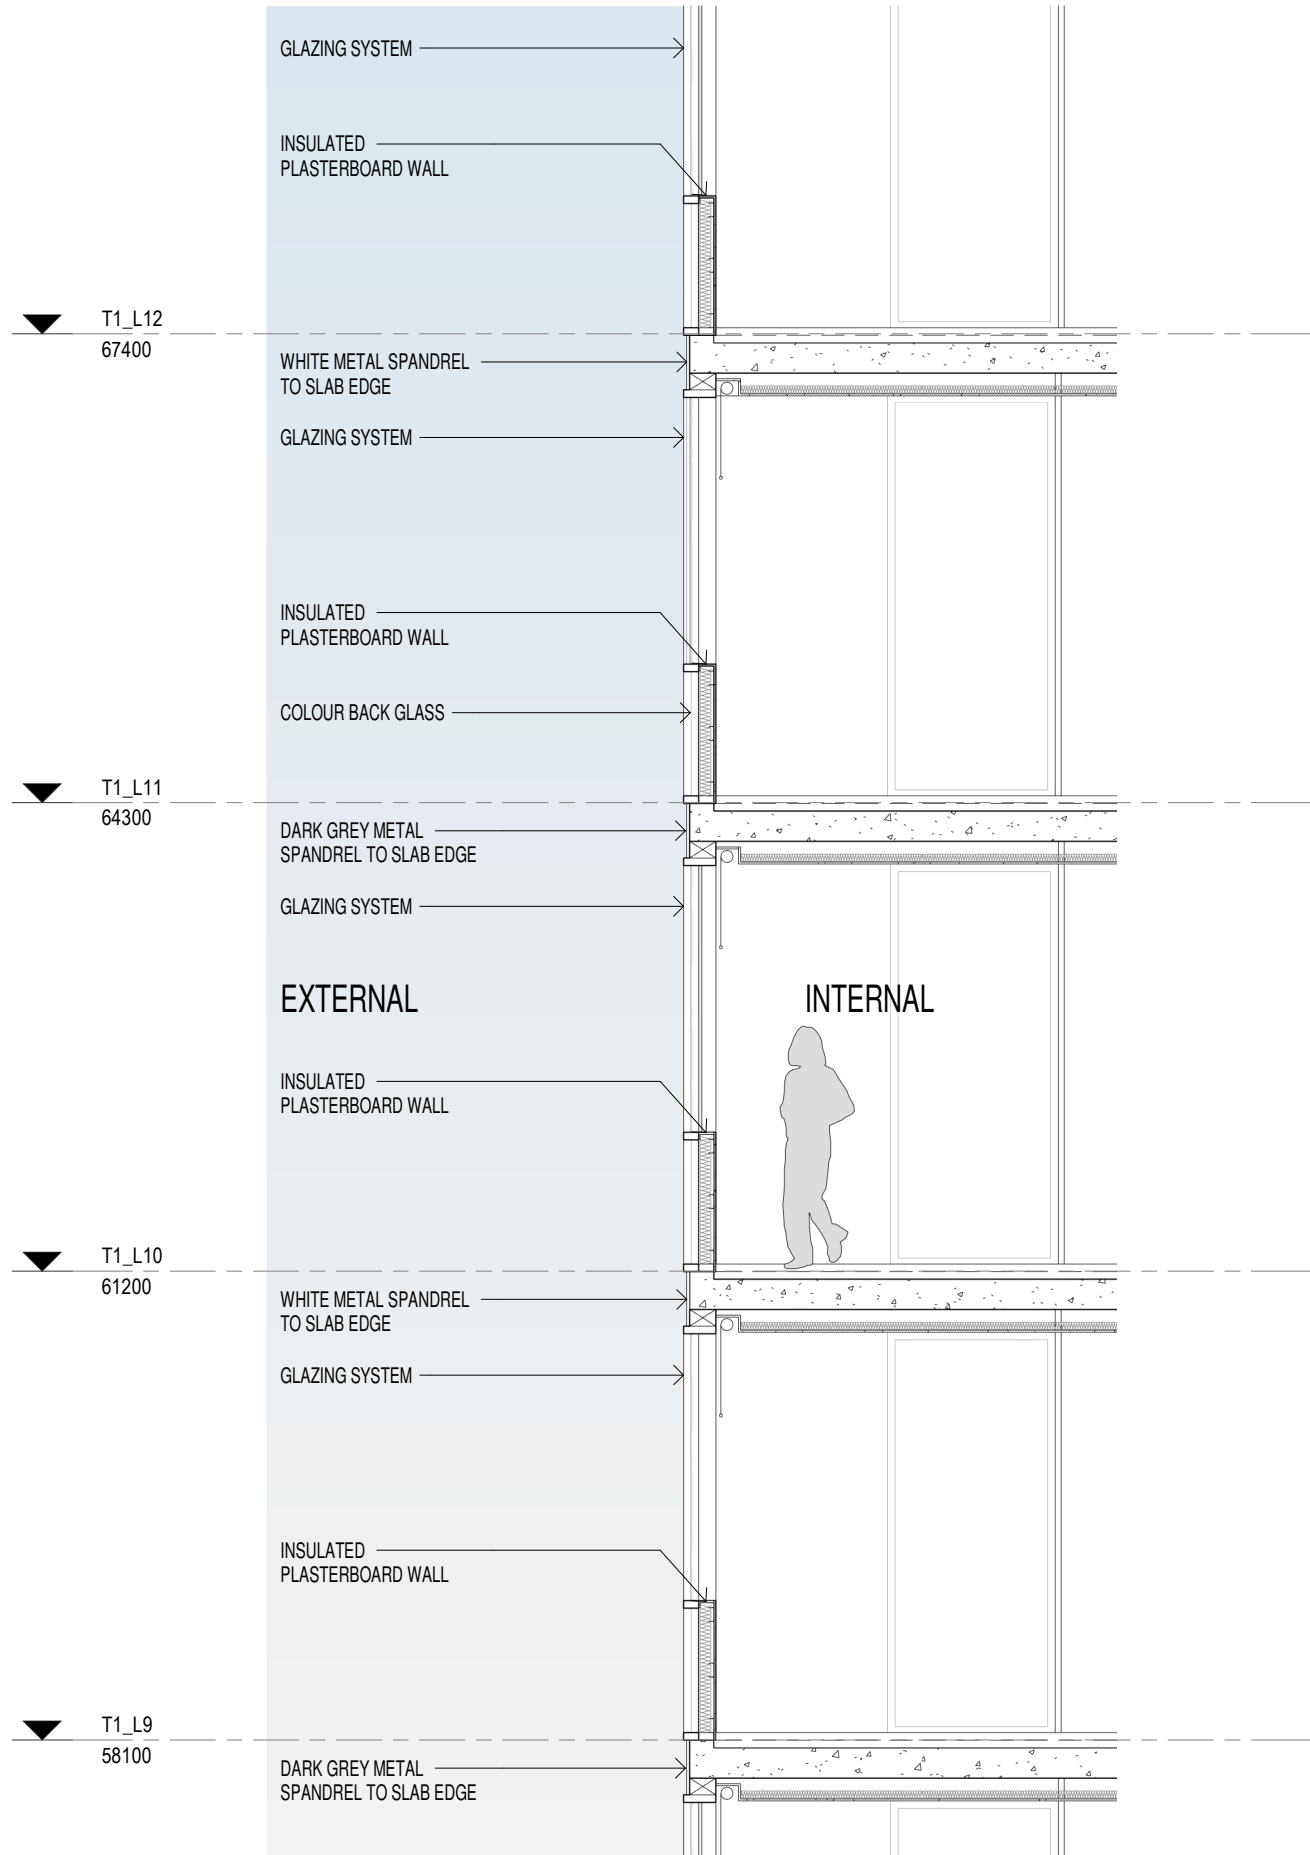

02 DETAIL SECTION - GLASS FACADE  
1: 50@A1

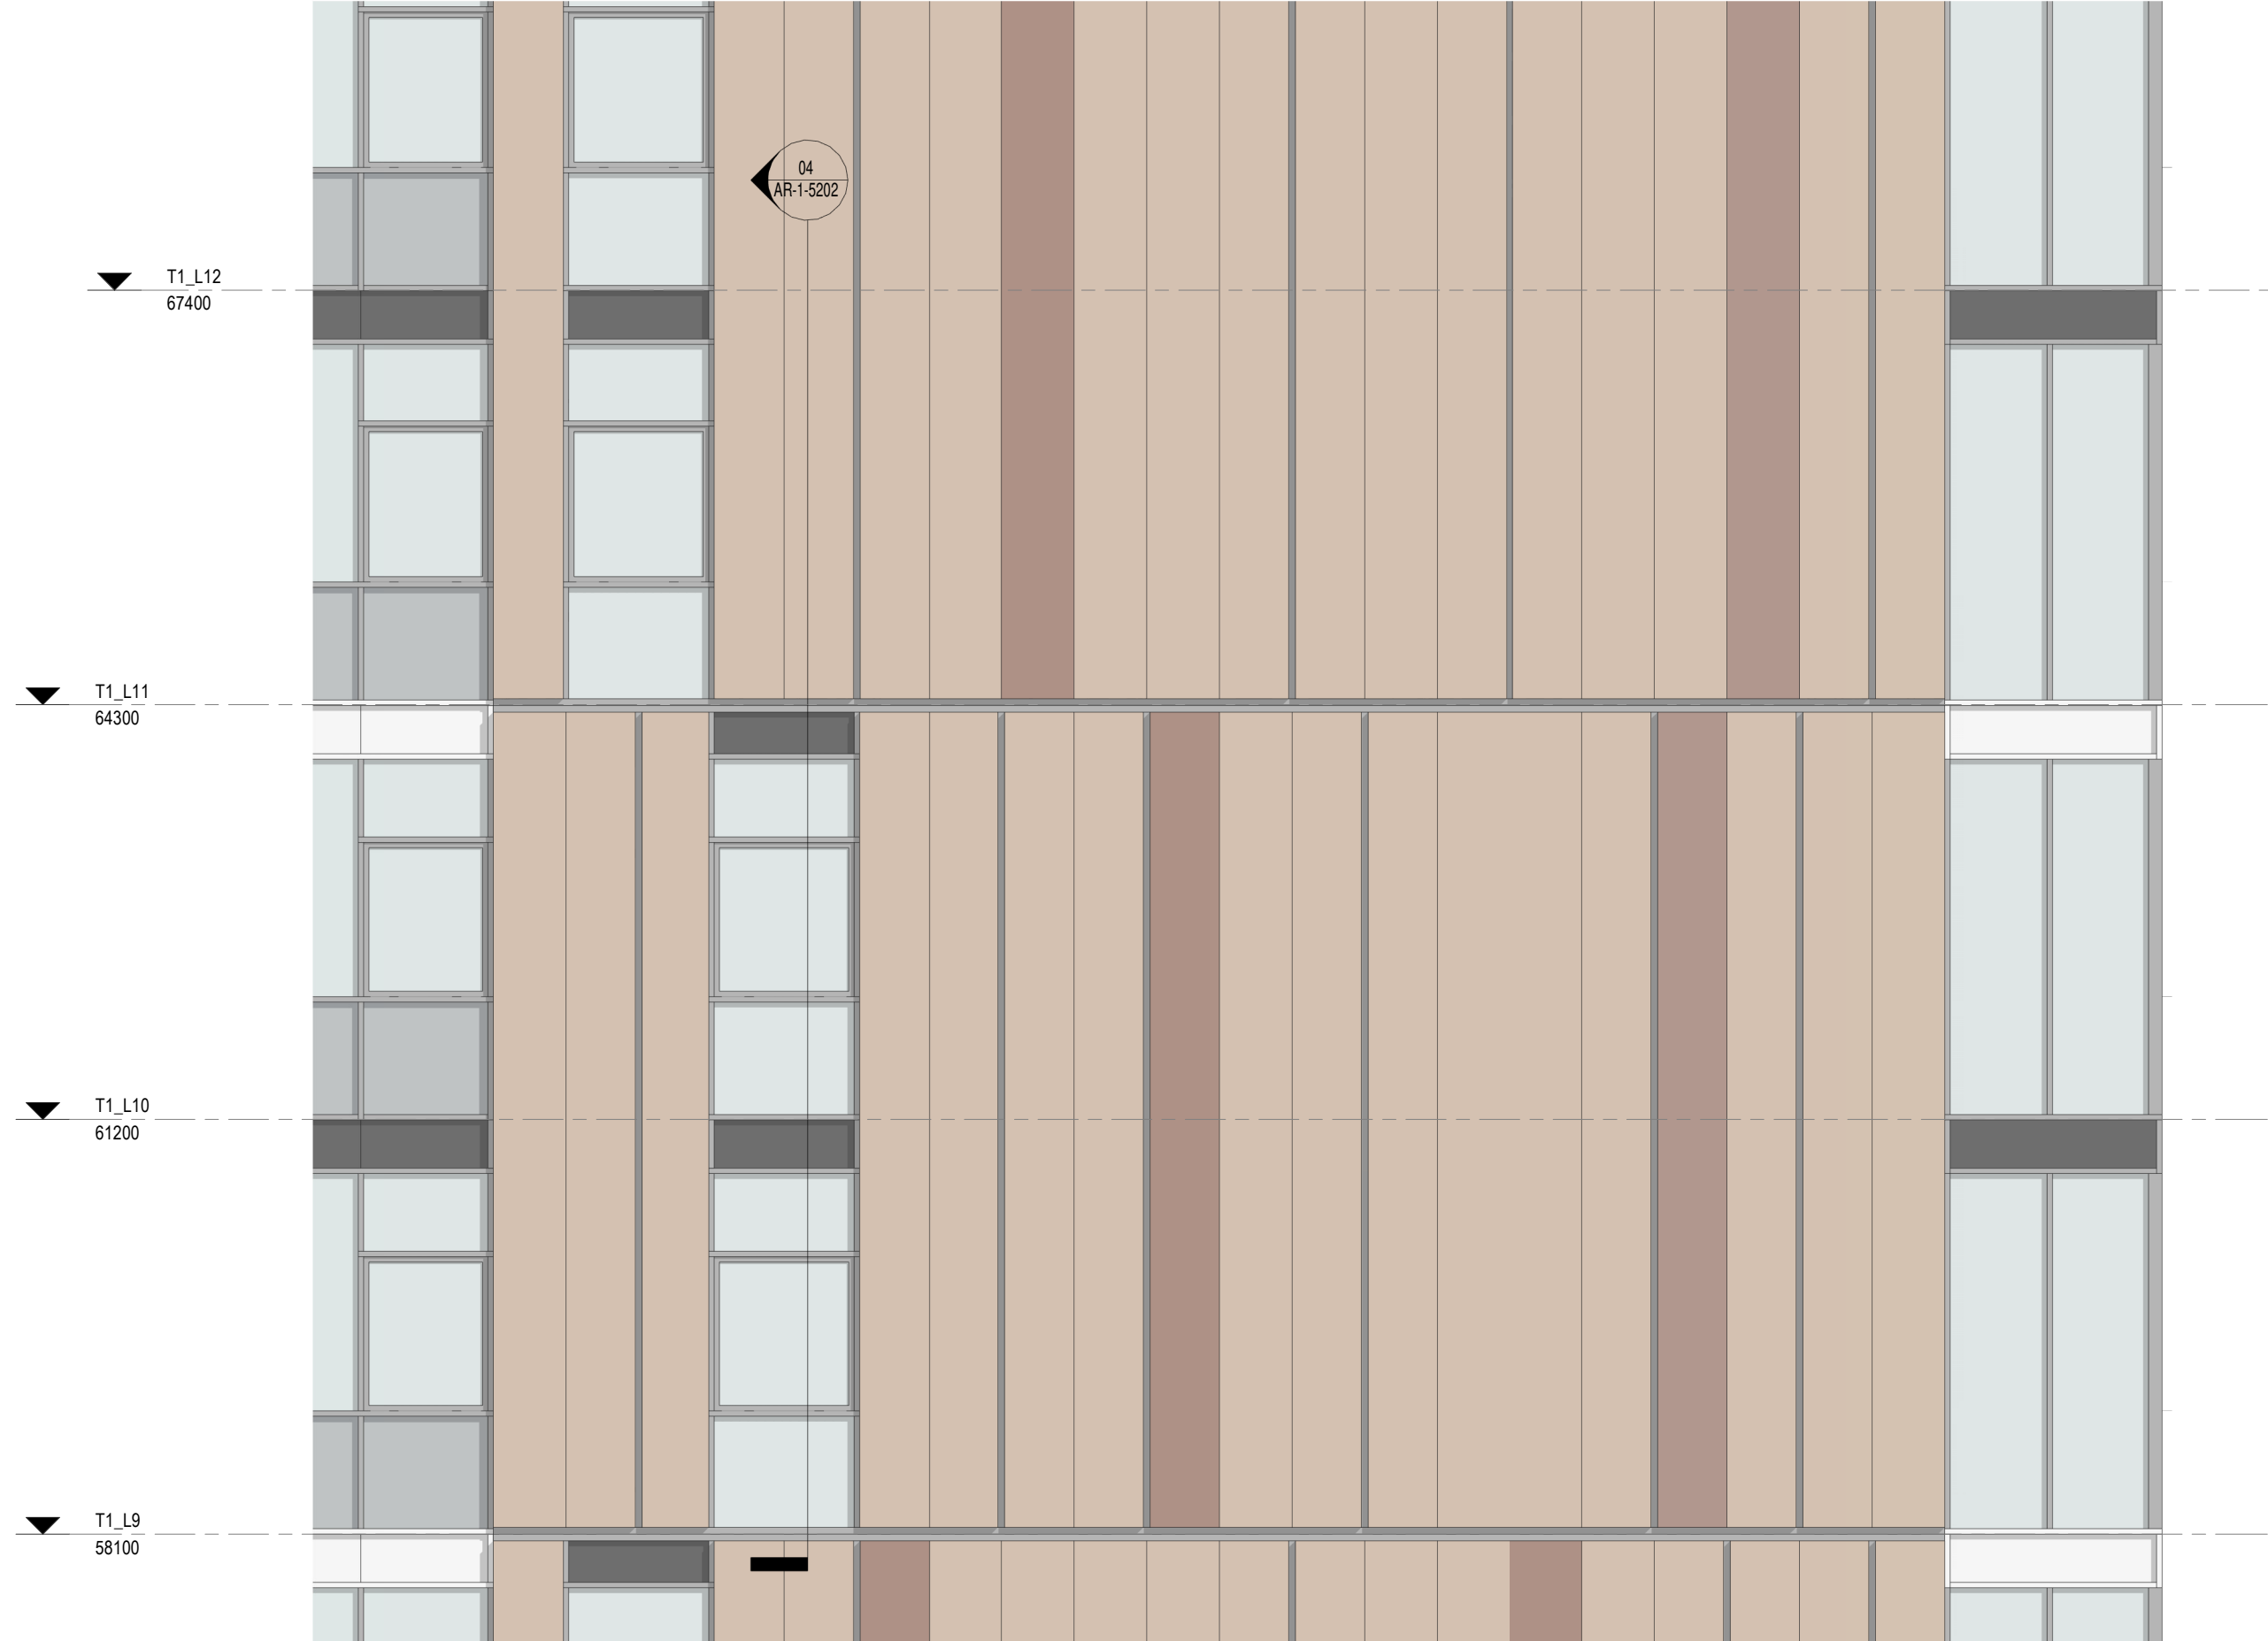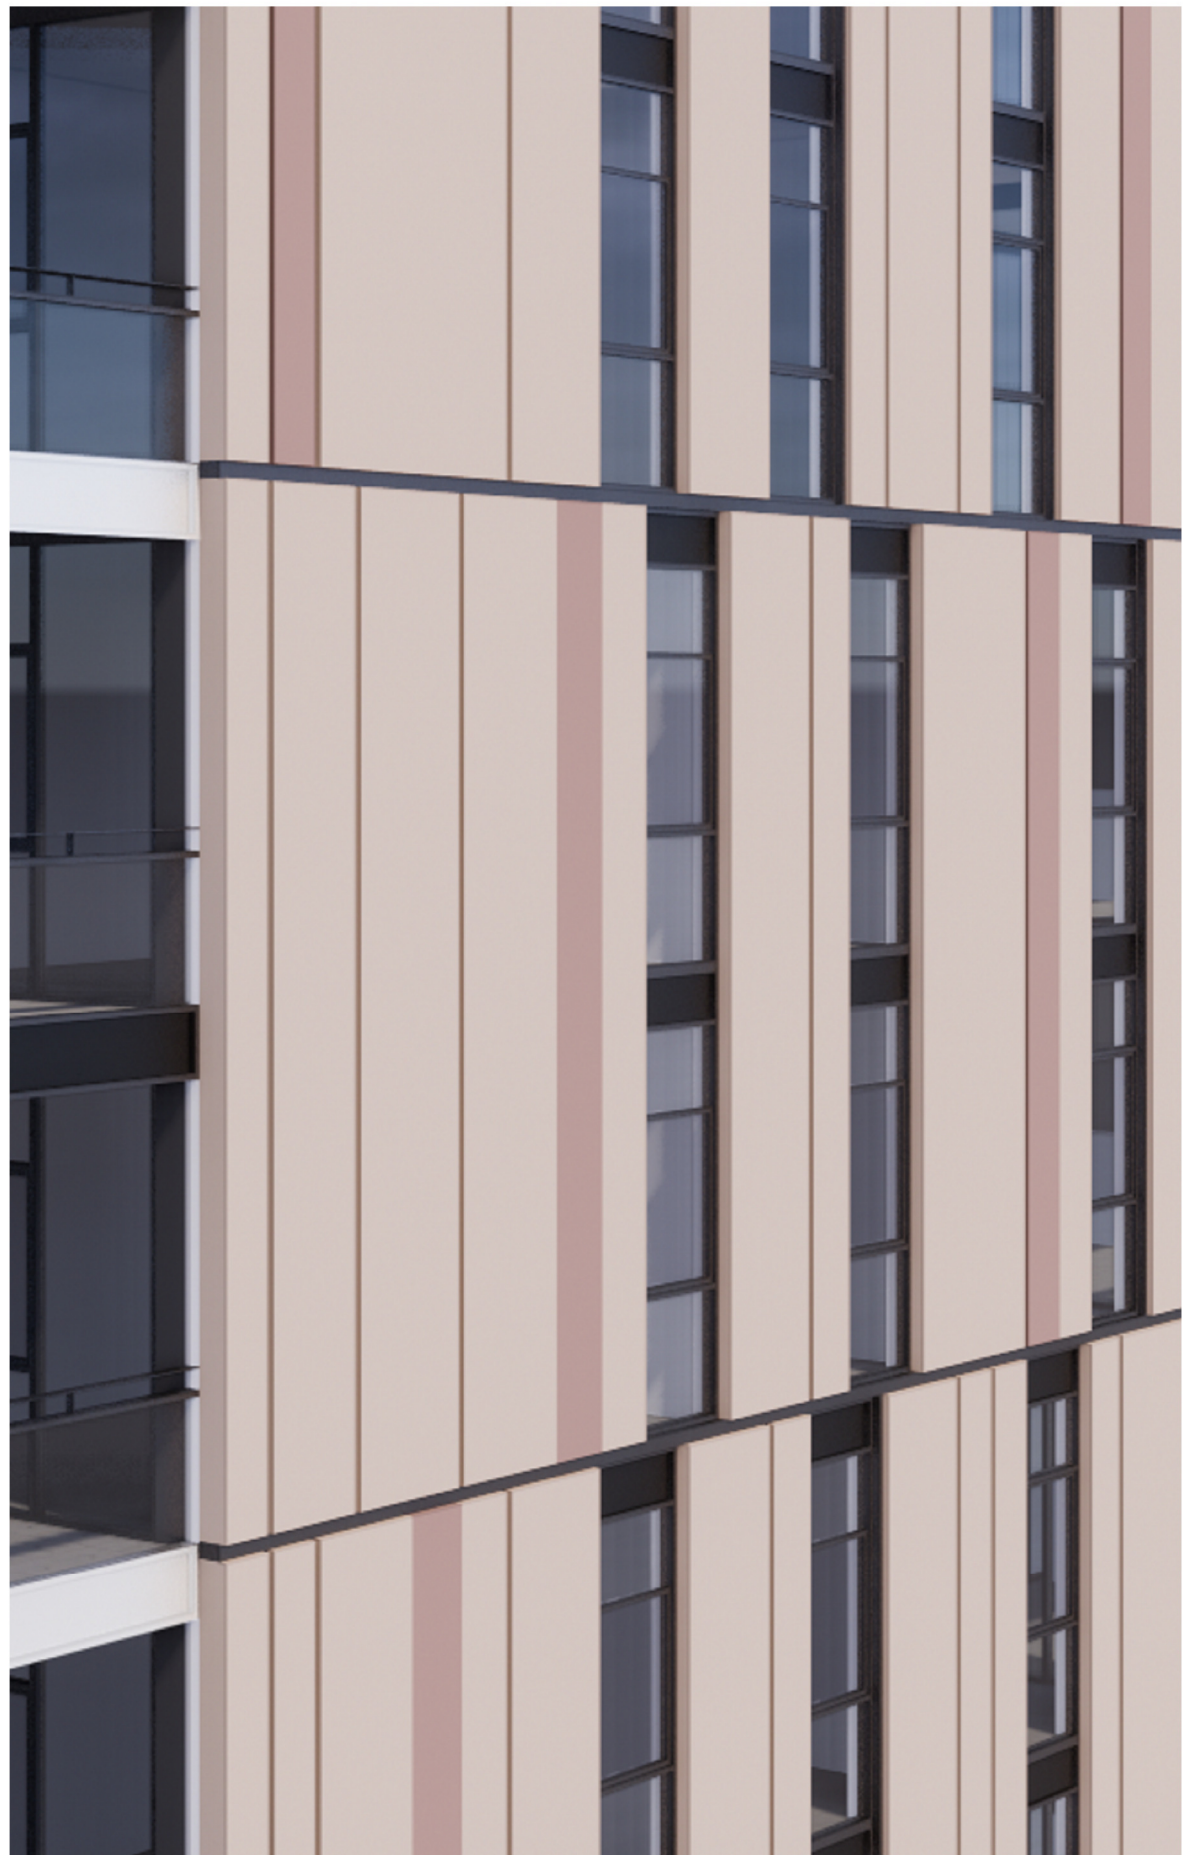

03 EAST ELEVATION - TYPICAL SOLID DETAIL  
SK-3020 1: 50@A1

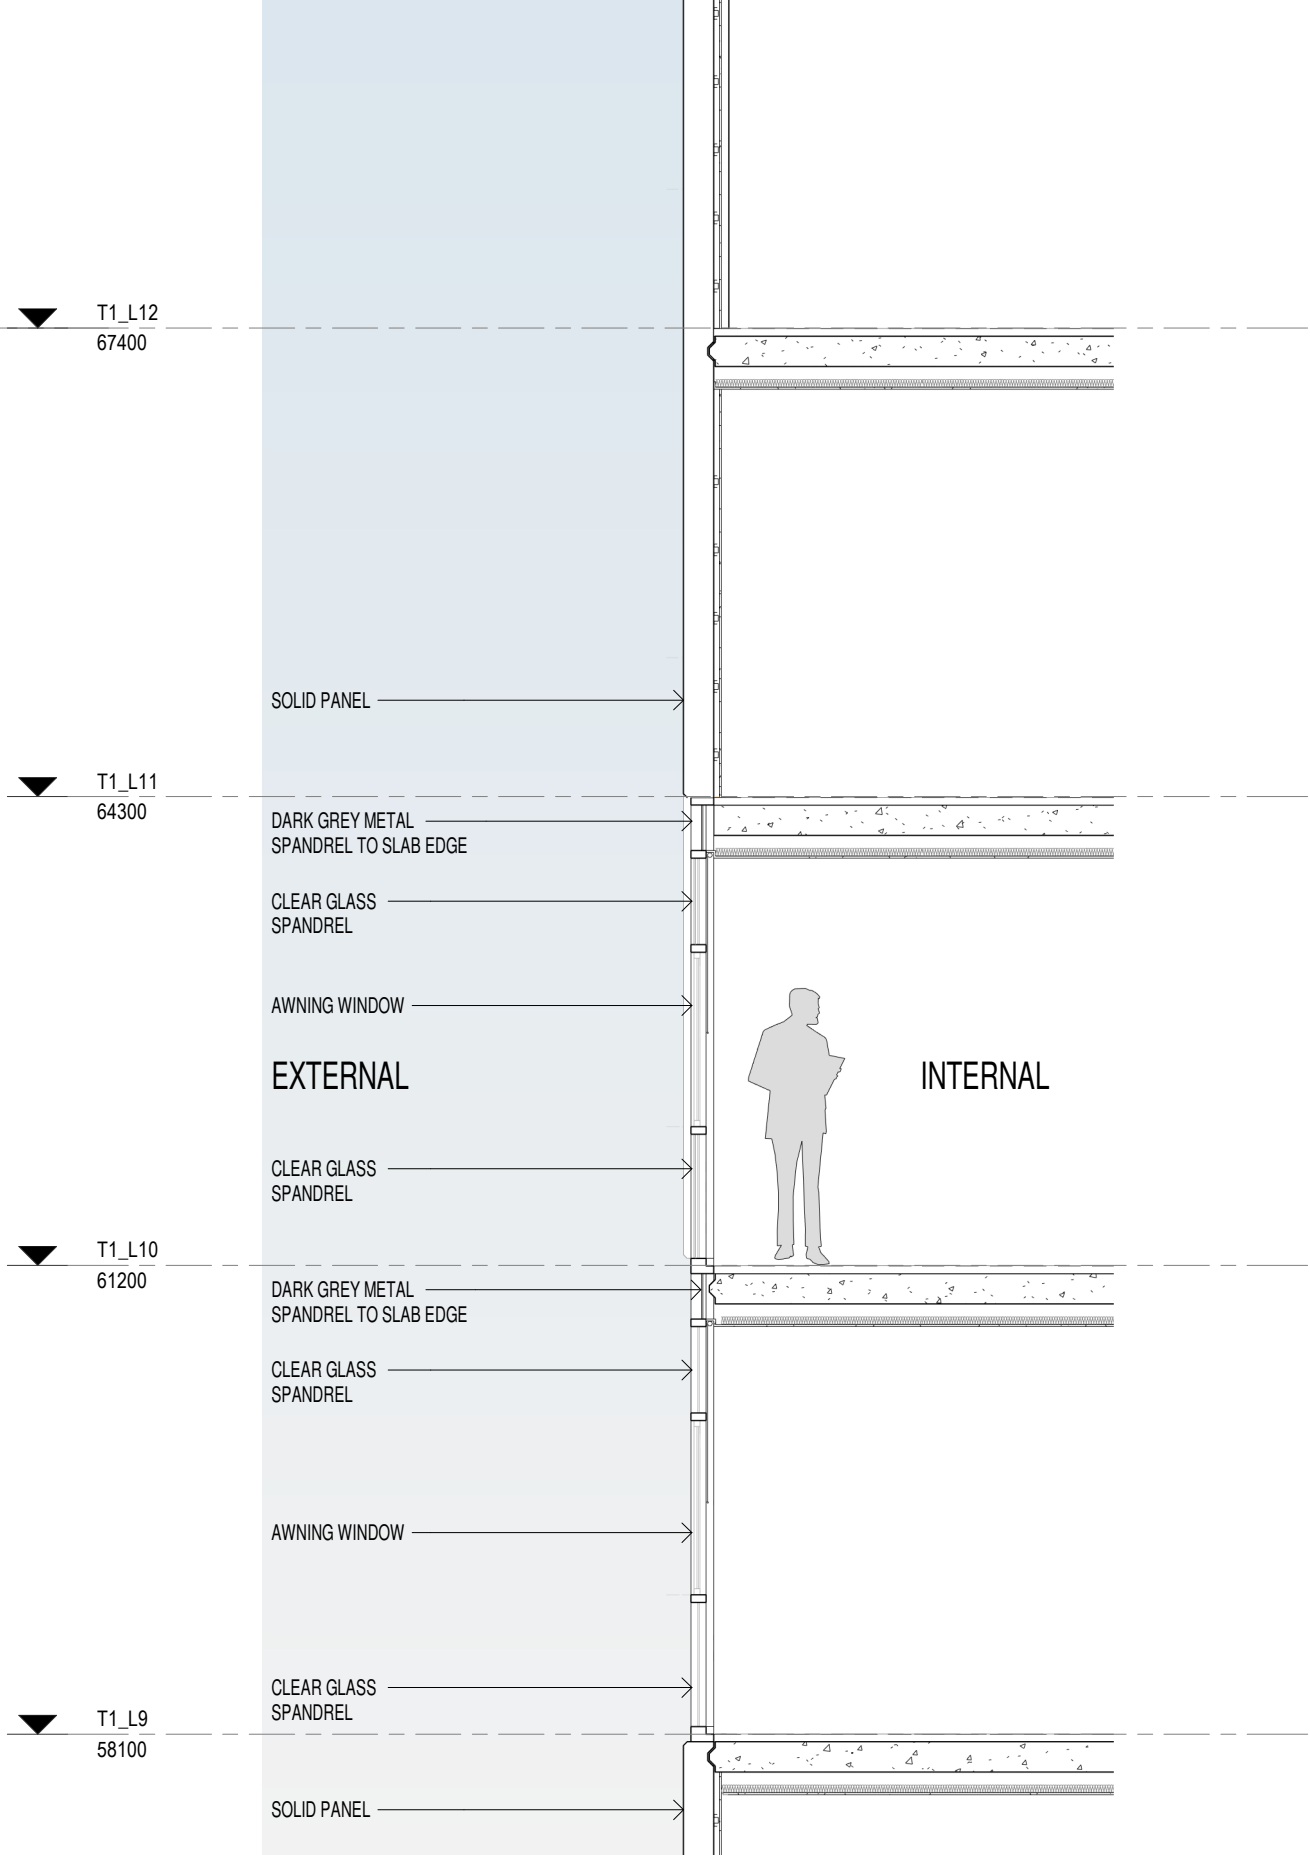

04 DETAIL SECTION - SOLID DETAIL  
SK-3020 1: 50@A1

In accepting and utilising this document the recipient agrees that SJB Architecture (NSW) Pty. Ltd. ACN 081 094 724 T/A SJB Architects, retain all common law, statutory law and other rights including copyright and intellectual property rights. The recipient agrees not to use this document for any purpose other than its intended use; to waive all claims against SJB Architects resulting from unauthorised changes; or to reuse the document on other projects without the prior written consent of SJB Architects. Under no circumstances shall transfer of this document be deemed a sale. SJB Architects makes no warranties of fitness for any purpose. The Builder/Contractor shall verify job dimensions prior to any work commencing. Use figured dimensions only. Do not scale drawings.

Nominated Architects: Adam Haddow-7188 | John Pradel-7004

## FOR APPROVAL

Rev	Date	Revision
81	28.02.2020	DRAFT DA ISSUE
83	04.03.2020	ISSUED FOR DA
85	07.05.2021	ISSUED FOR DA
86	04.10.2021	ISSUED FOR LEC

Structural Engineer	ROBERT BIRD GROUP
Mechanical / Hydraulic Engineer	JHA CONSULTING ENGINEERS
Electrical Engineer	JHA CONSULTING ENGINEERS
Fire Engineer	OLSSON FIRE & RISK
Access Consultant	ACCESSIBLE BUILDING SOLUTIONS
Basix	EMF GRIFFITHS
Building Key	

Client



Project

HIGH ST DEVELOPMENT

634-638 HIGH ST & 87-89  
UNION RD, PENRITH

Drawing Name

BUILDING 02 - FACADE DETAILS

Date 04.10.2021 Scale 1: 50 Sheet Size @ A1

Drawn GT Chk. MG


Job No. 6111 Drawing No. AR-1-5202 /86 Revision

SJB Architects  
Level 2  
490 Crown Street  
Surry Hills NSW  
2010 Australia  
T 61 2 9380 9911  
F 61 2 9380 9922  
www.sjb.com.au







PAINT FINISHES

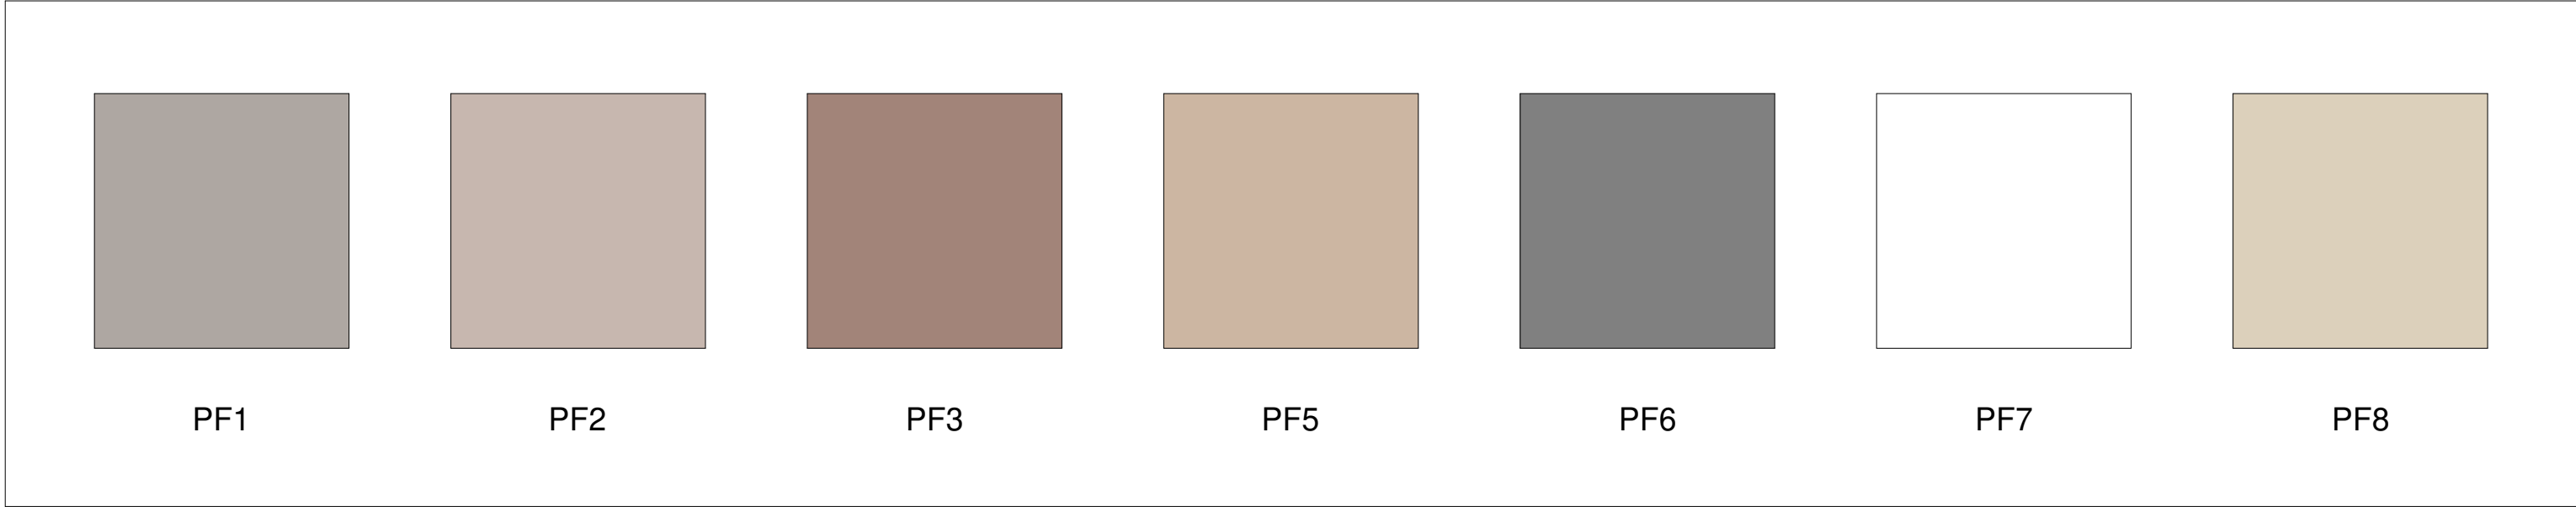


METAL FINISHES

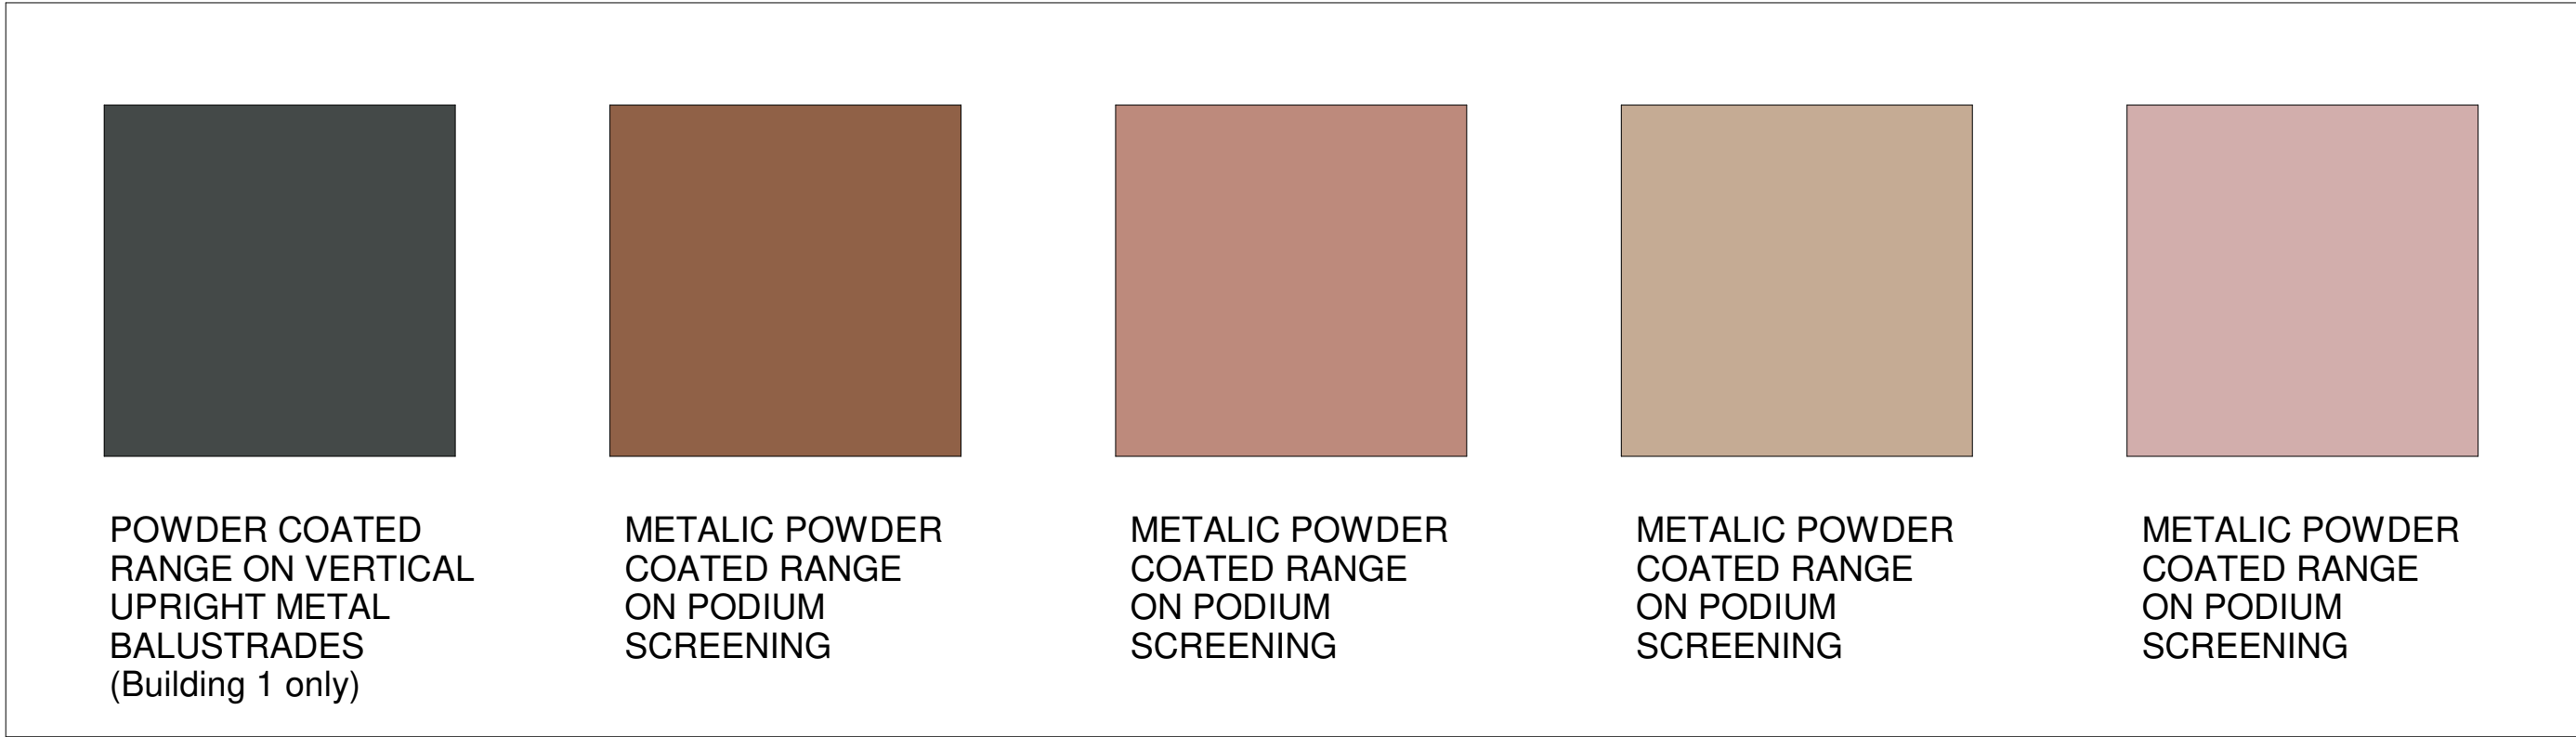

GLAZING SYSTEM

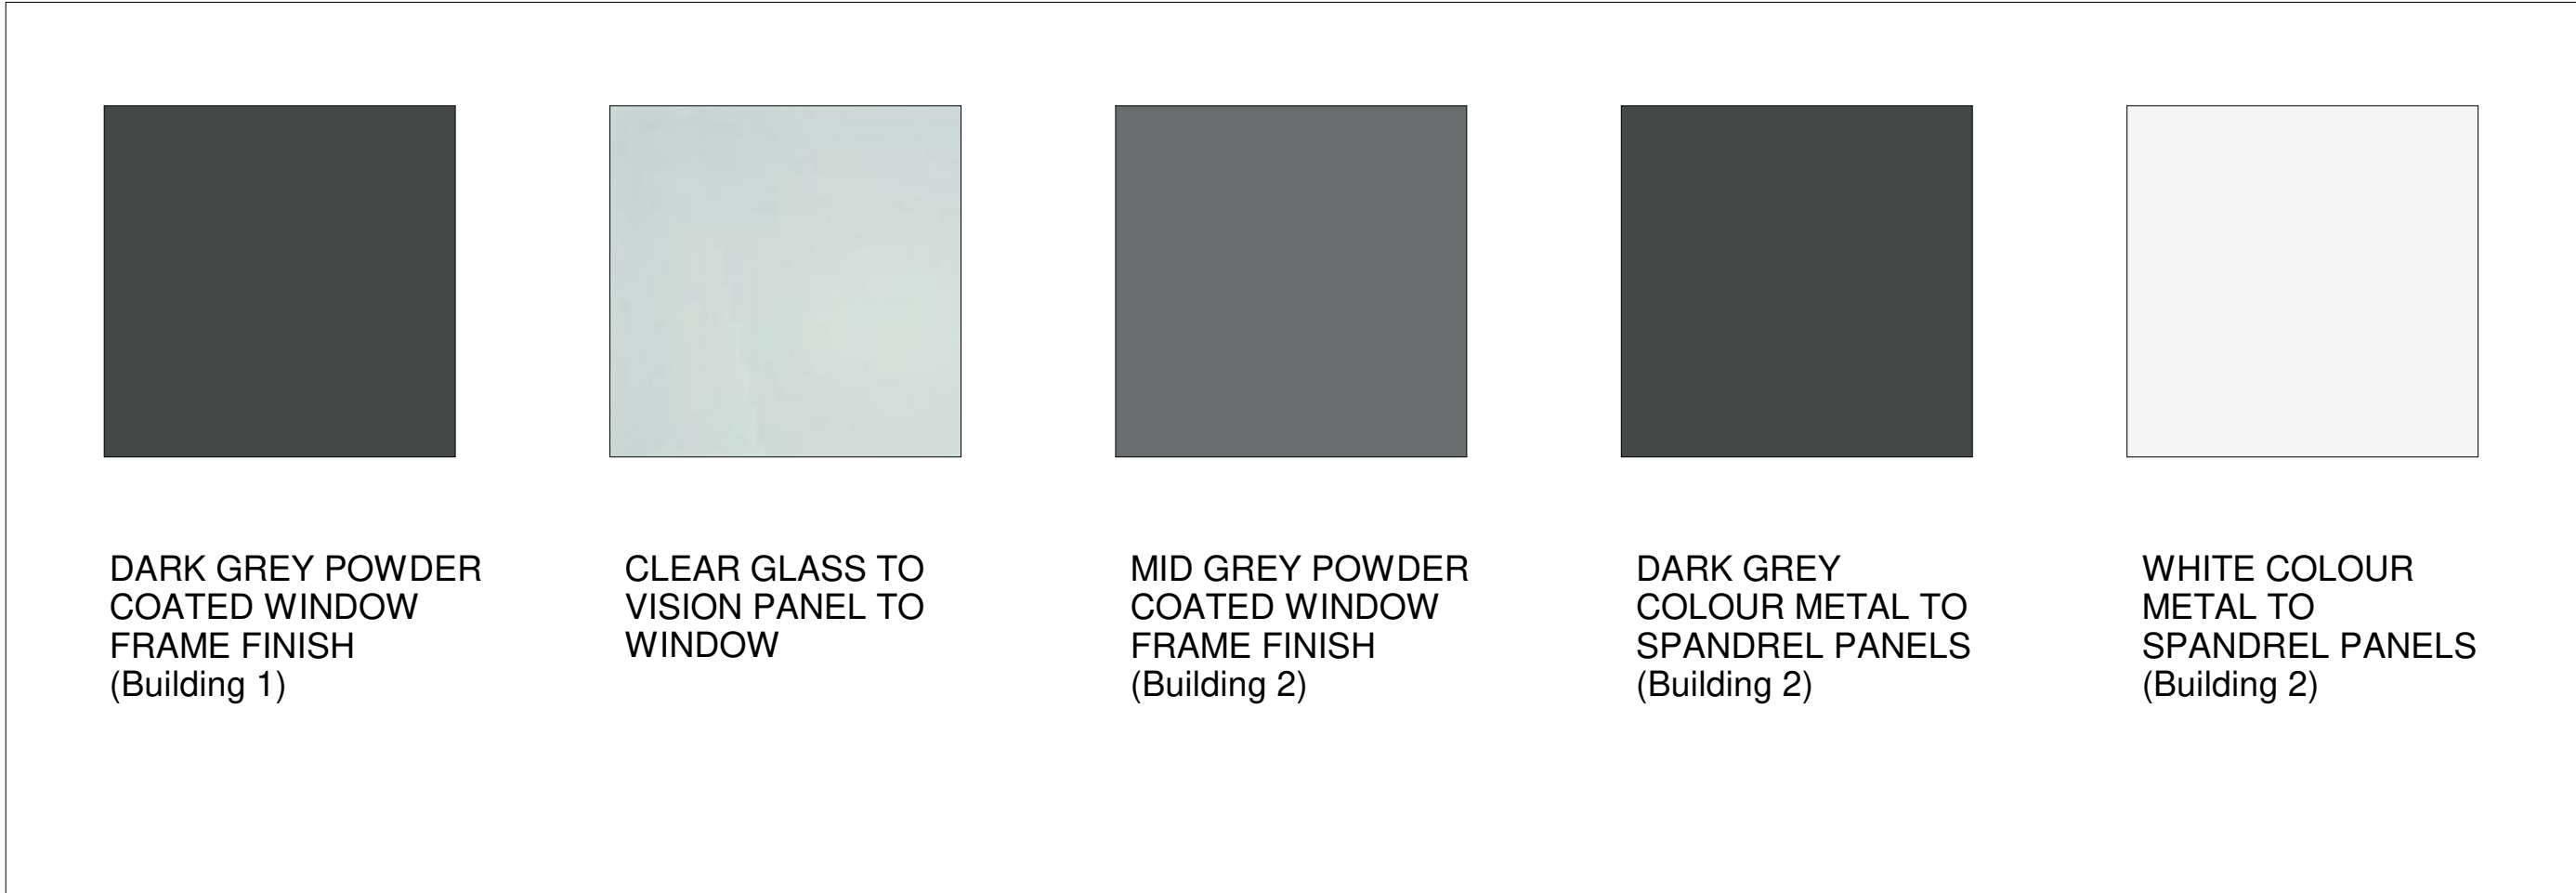

PRECEDENT IMAGES

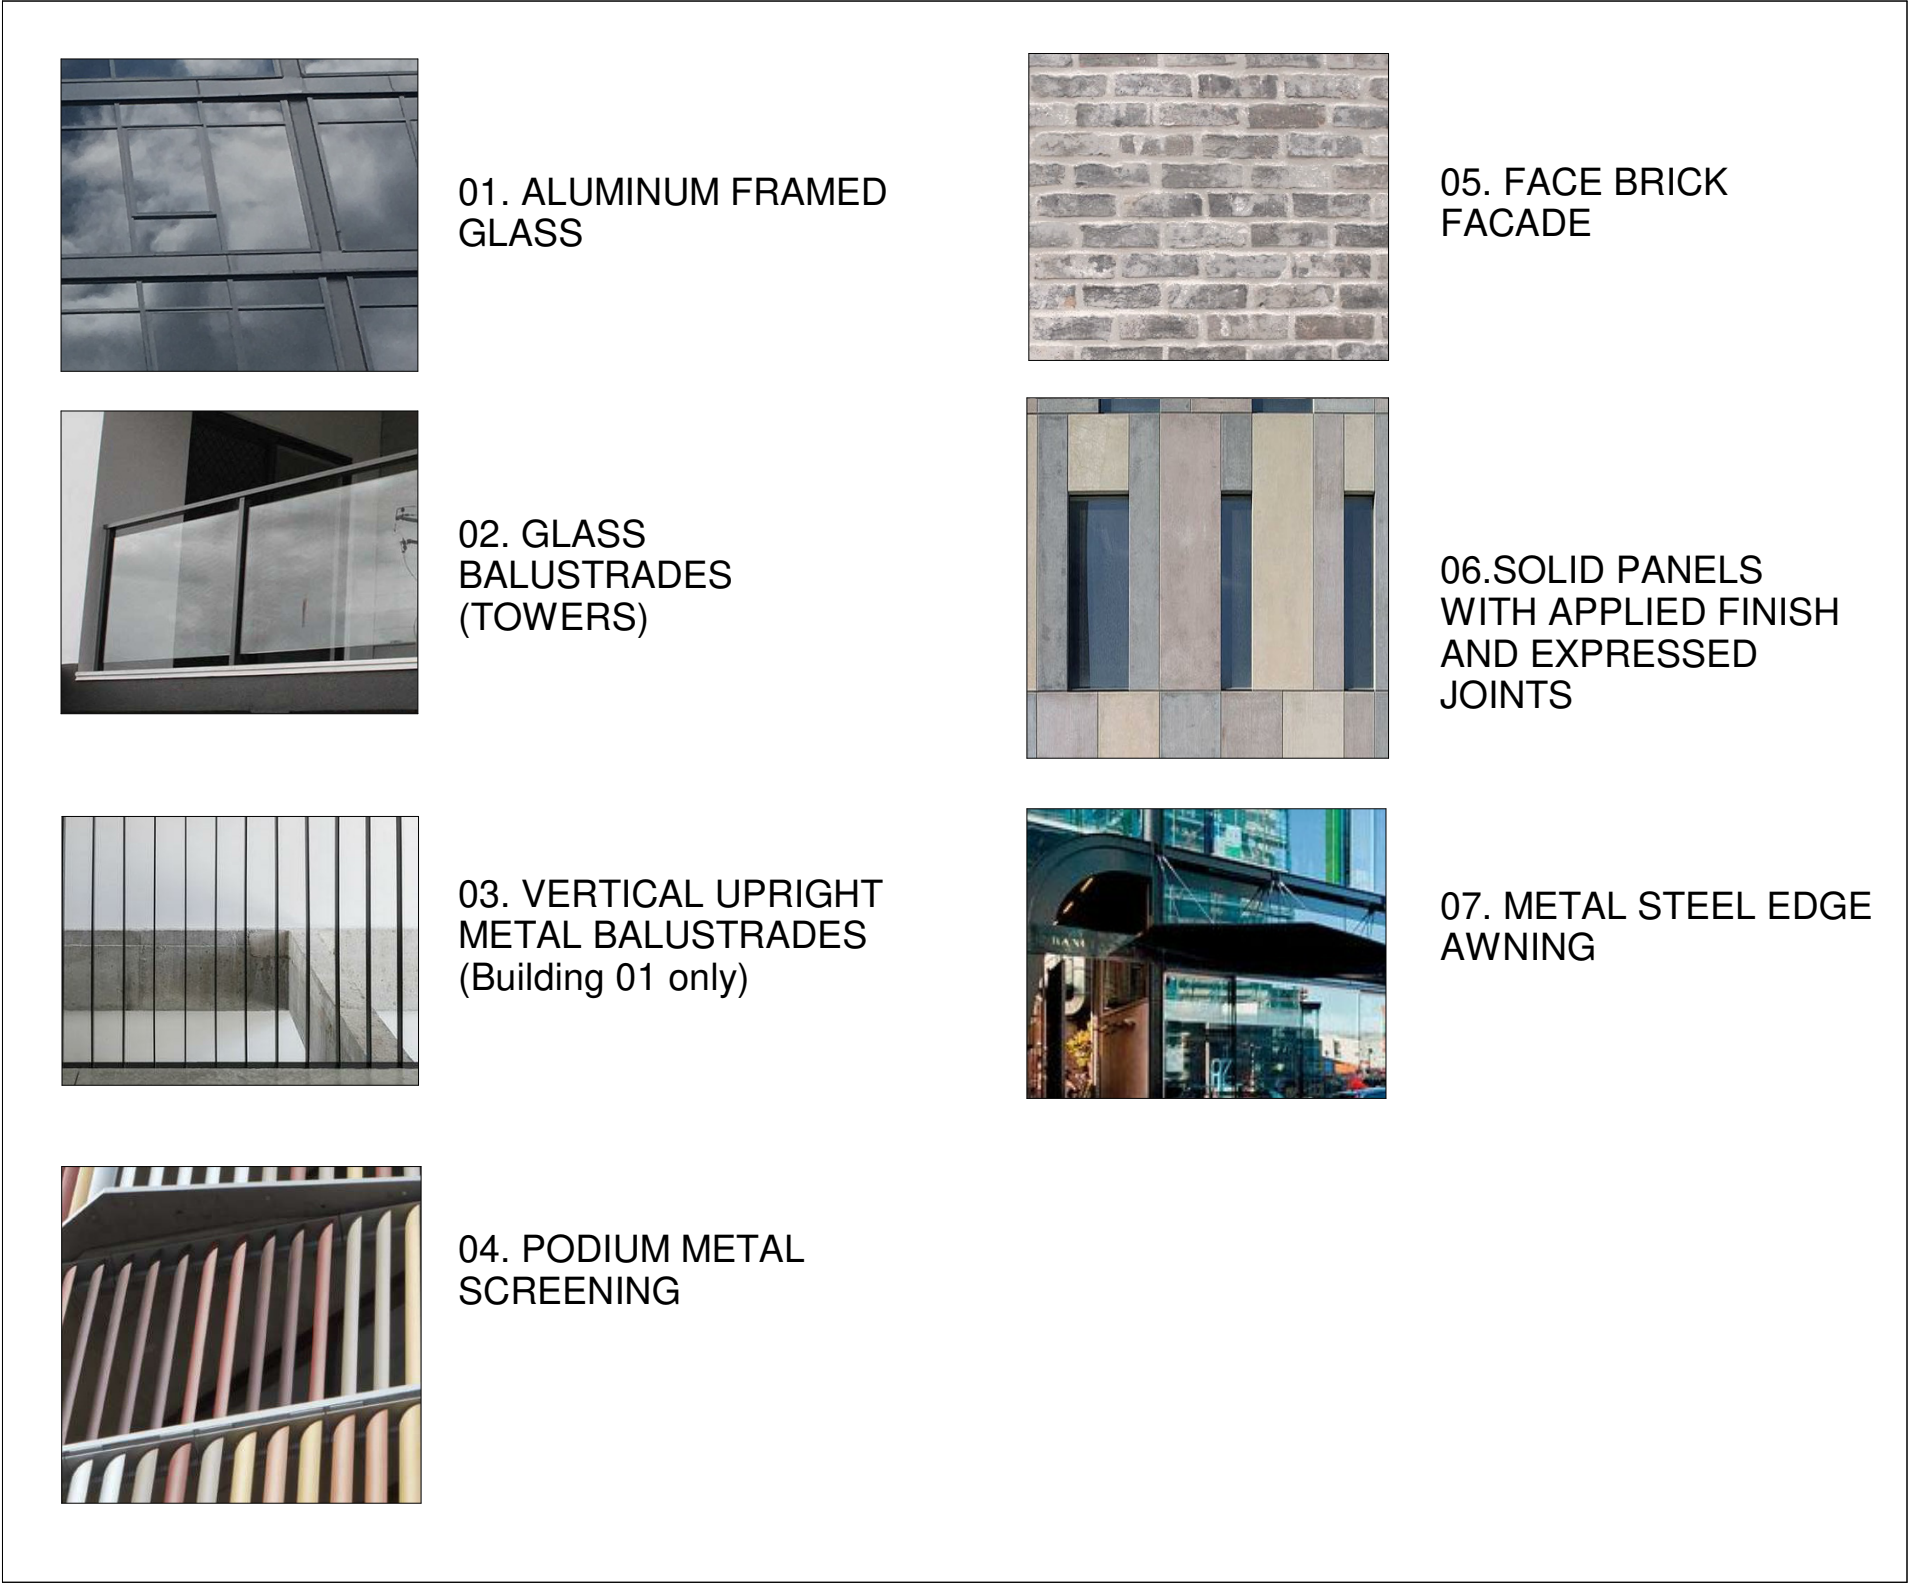

FINISHES LEGEND

EXTERNAL FINISHES

- 1 ALUMINUM FRAMED GLASS
- 2 SOLID WHITE BALLUSTRADES (TOWERS)
- 3 PODIUM INFILL PANEL
- 4 VERTICAL UPRIGHT METAL BALUSTRADES (B1)
- 5 VERTICAL METAL BATTENS
- 6 FACE BRICK FACADE
- 7 SOLID PANELS WITH APPLIED FINISH
- 8 METAL AWNING
- 9 METAL LOUVRES

PAINT FINISHES

- PF1 PAINT FINISH 1
- PF2 PAINT FINISH 2
- PF3 PAINT FINISH 3
- PF5 PAINT FINISH 5
- PF6 PAINT FINISH 6
- PF7 PAINT FINISH 7
- PF8 PAINT FINISH 8

GLAZING SYSTEM

- GC1 DARK GREY METAL FRAMED WINDOW SYSTEM
- GC2 MID GREY METAL FRAMED WINDOW SYSTEM
- GCB1 MID GREY METAL FRAMED SPANDREL WITH COLOURBACK GLASS
- GCB2 MID GREY METAL FRAMED SPANDREL WITH RED COLOURBACK GLASS
- GP1 DARK GREY METAL SPANDREL PANEL
- GP2 WHITE METAL SPANDREL PANEL

In accepting and utilising this document the recipient agrees that SJB Architecture (NSW) Pty. Ltd. ACN 081 094 724 T/A SJB Architects, retain all common law, statutory law and other rights including copyright and intellectual property rights. The recipient agrees not to use this document for any purpose other than its intended use; to waive all claims against SJB Architects resulting from unauthorised changes; or to reuse the document on other projects without the prior written consent of SJB Architects. Under no circumstances shall transfer of this document be deemed a sale. SJB Architects makes no warranties of fitness for any purpose. The Builder/Contractor shall verify job dimensions prior to any work commencing. Use figured dimensions only. Do not scale drawings.

Nominated Architects: Adam Haddow-7188 | John Pradel-7004

FOR APPROVAL

Rev	Date	Revision
81	28.02.2020	DRAFT DA ISSUE
83	04.03.2020	ISSUED FOR DA
85	07.05.2021	ISSUED FOR DA
86	04.10.2021	ISSUED FOR LEC

Structural Engineer
ROBERT BIRD GROUP

Mechanical / Hydraulic Engineer
JHA CONSULTING ENGINEERS

Electrical Engineer
JHA CONSULTING ENGINEERS

Fire Engineer
OLSSON FIRE & RISK

Access Consultant
ACCESSIBLE BUILDING SOLUTIONS

Basix
EMF GRIFFITHS

Building Key
--------------

Client



Project

HIGH ST DEVELOPMENT

634-638 HIGH ST & 87-89 UNION RD, PENRITH

Drawing Name

EXTERNAL FINISHES BOARD

Date	Scale	Sheet Size
04.10.2021	1 : 50	@ A1

Drawn	Chk.
CC	MG

Job No.	Drawing No.	Revision
6111	AR-1-5203	/86



In accepting and utilising this document the recipient agrees that SJB Architecture (NSW) Pty. Ltd. ACN 081 094 724 T/A SJB Architects, retain all common law, statutory law and other rights including copyright and intellectual property rights. The recipient agrees not to use this document for any purpose other than its intended use; to waive all claims against SJB Architects resulting from unauthorised changes; or to reuse the document on other projects without the prior written consent of SJB Architects. Under no circumstances shall transfer of this document be deemed a sale. SJB Architects makes no warranties of fitness for any purpose. The Builder/Contractor shall verify job dimensions prior to any work commencing. Use figured dimensions only. Do not scale drawings.

Nominated Architects: Adam Haddow-7188 | John Pradel-7004

FOR APPROVAL

Rev	Date	Revision
66	24.01.2020	PRELIMINARY ISSUE
81	28.02.2020	DRAFT DA ISSUE
83	04.03.2020	ISSUED FOR DA
85	07.05.2021	ISSUED FOR DA
86	04.10.2021	ISSUED FOR LEC

Structural Engineer  
ROBERT BIRD GROUP

Mechanical / Hydraulic Engineer  
JHA CONSULTING ENGINEERS



Electrical Engineer  
JHA CONSULTING ENGINEERS

Fire Engineer  
OLSSON FIRE & RISK

Access Consultant  
ACCESSIBLE BUILDING SOLUTIONS

Basix  
EMF GRIFFITHS

Building Key

	GROSS FLOOR AREA (GFA)
	GROSS FLOOR AREA (GFA) COMMERCIAL


Client



Project  
HIGH ST DEVELOPMENT

634-638 HIGH ST & 87-89  
UNION RD, PENRITH

Drawing Name  
GFA CALCULATIONS - SHEET 01

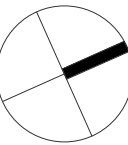


Date	Scale	Sheet Size
04.10.2021	As indicated	@ A1


Drawn	Chk.
GT	MG

Job No.	Drawing No.	Revision
6111	AR-1-8010	/86


SJB Architects  
Level 2  
490 Crown Street  
Surry Hills NSW  
2010 Australia  
T 61 2 9380 9911  
F 61 2 9380 9922  
www.sjb.com.au

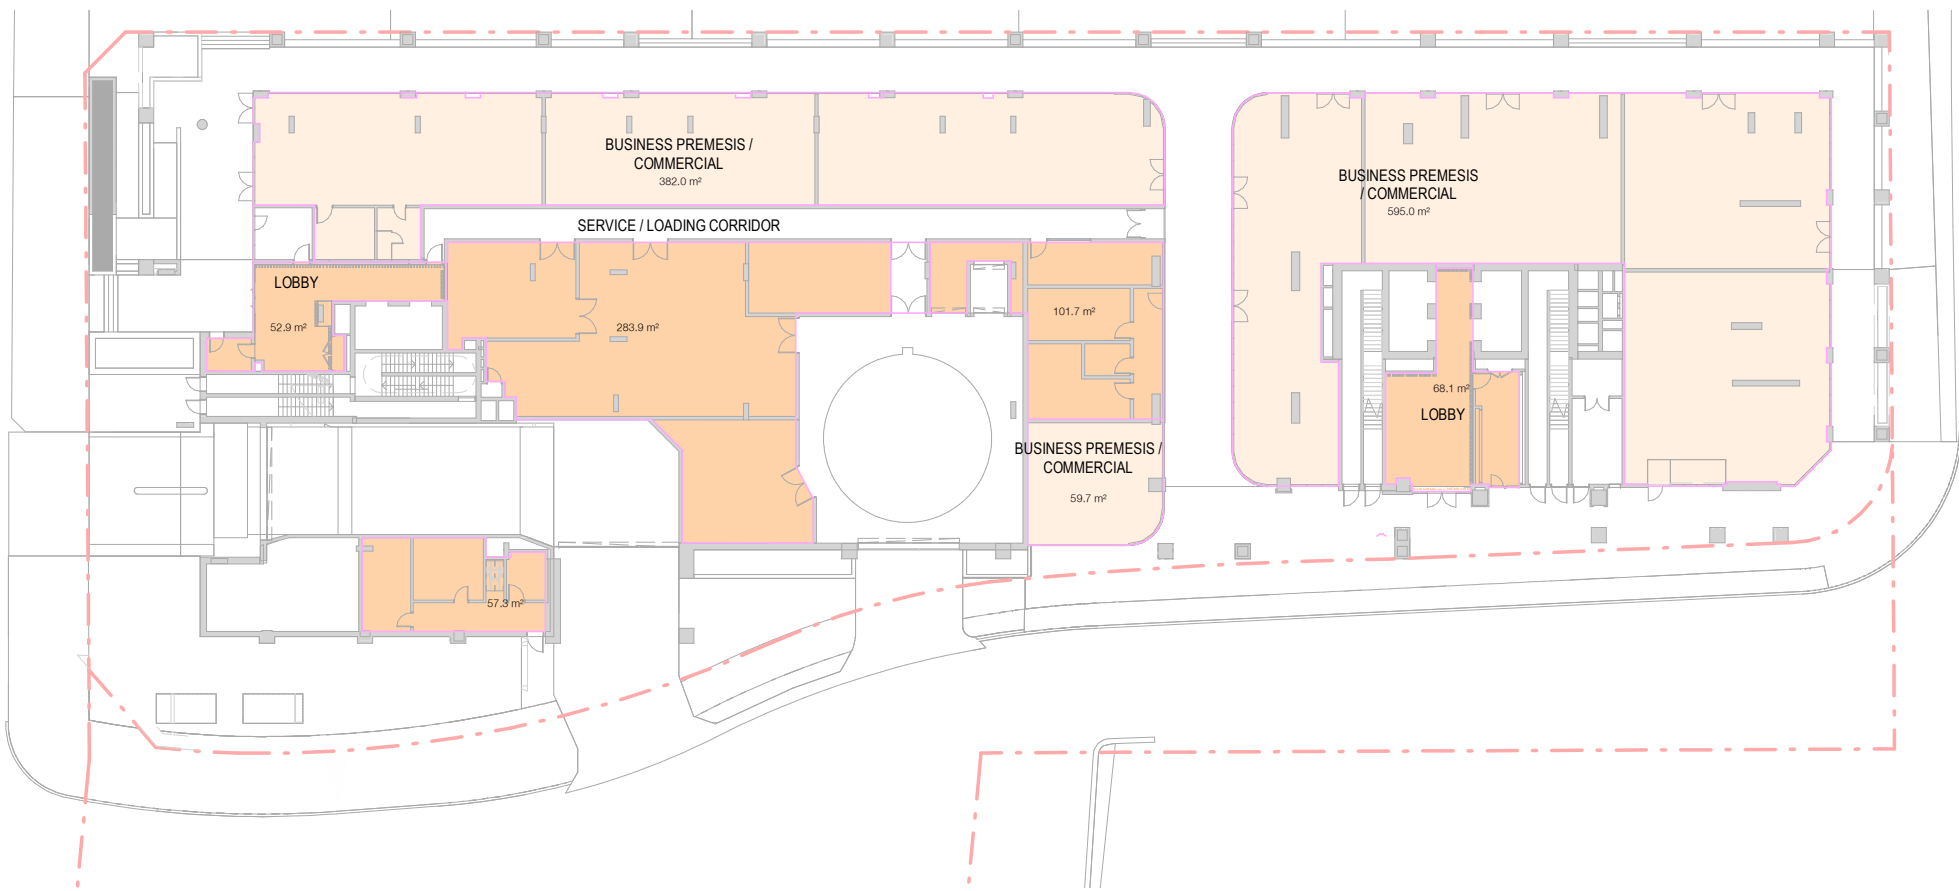


01 GROUND FLOOR  
1 : 450@A1

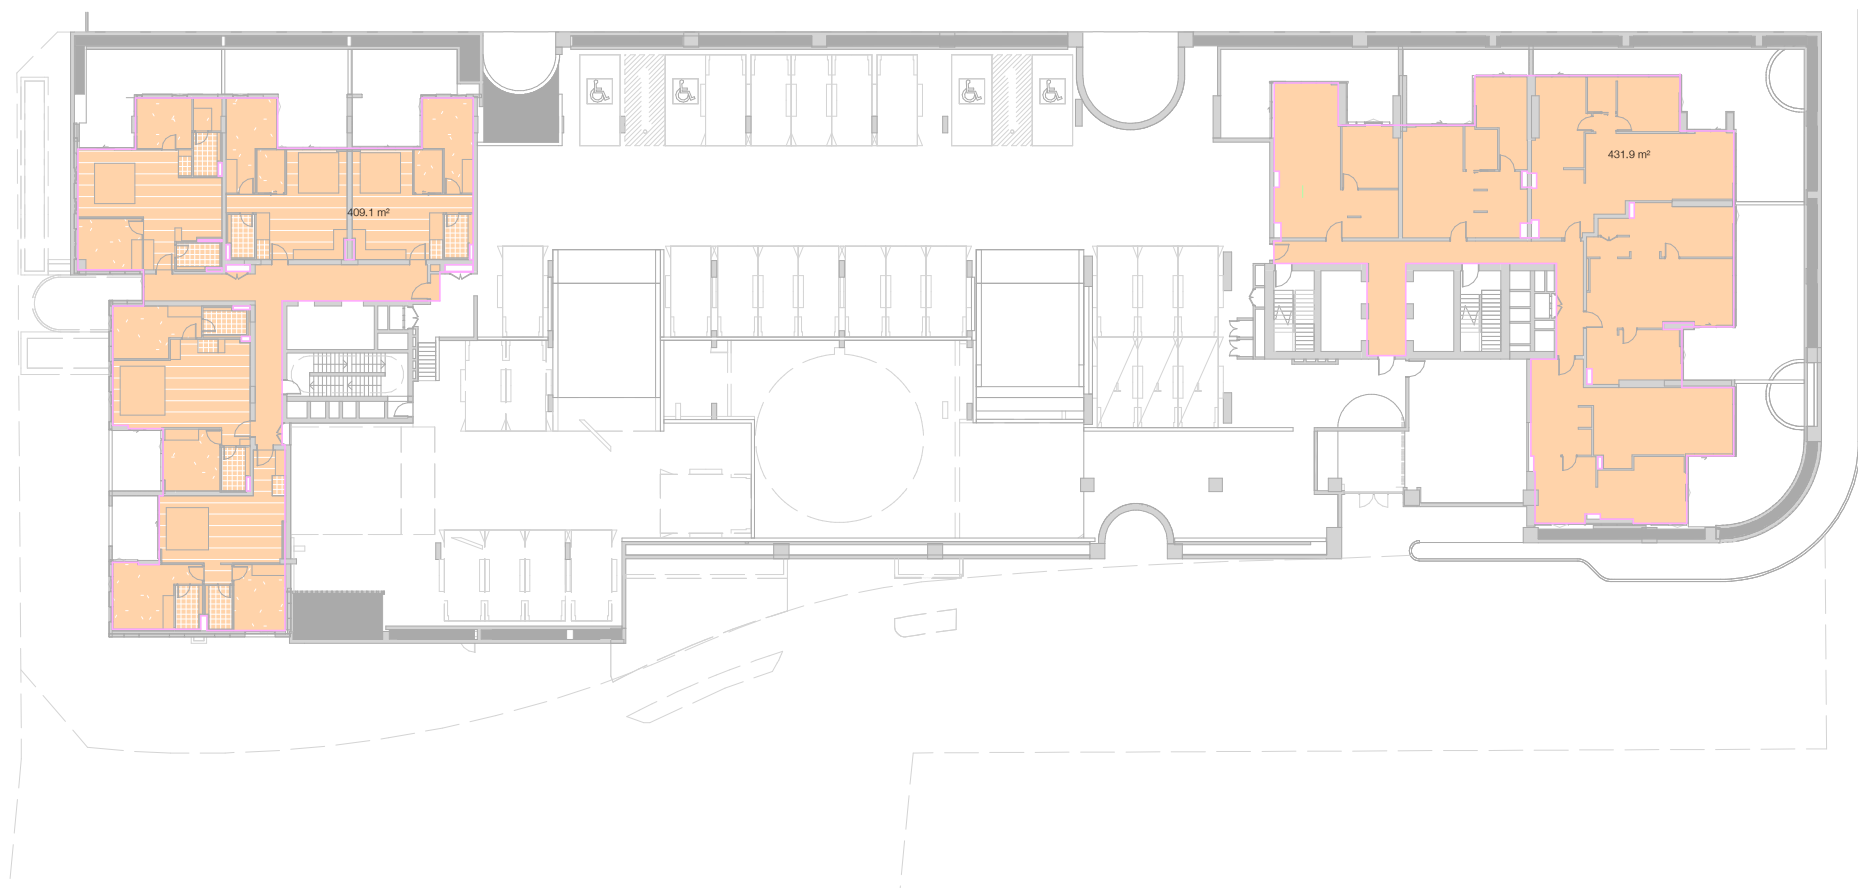

02 LEVEL 01  
1 : 450@A1

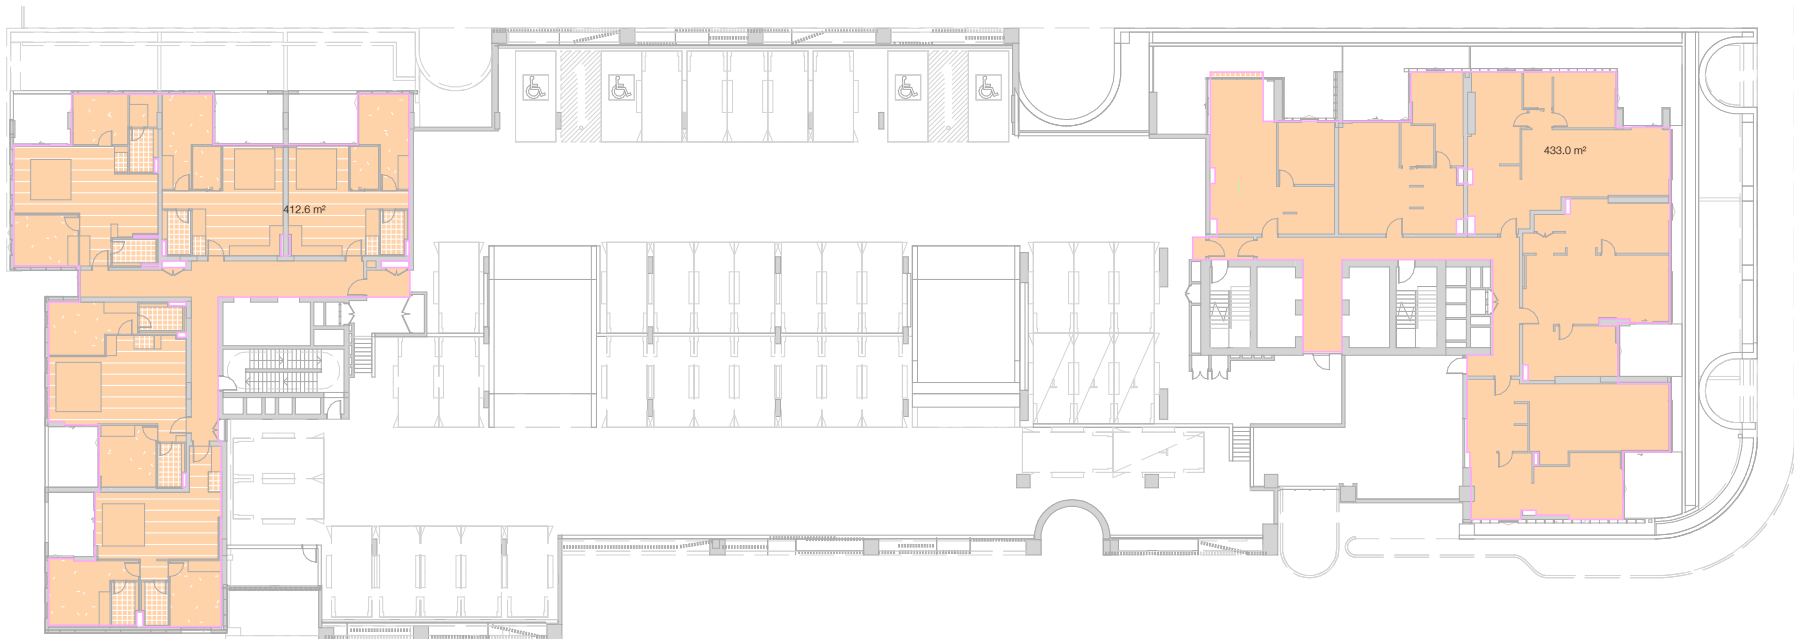


03 LEVEL 02  
1 : 450@A1

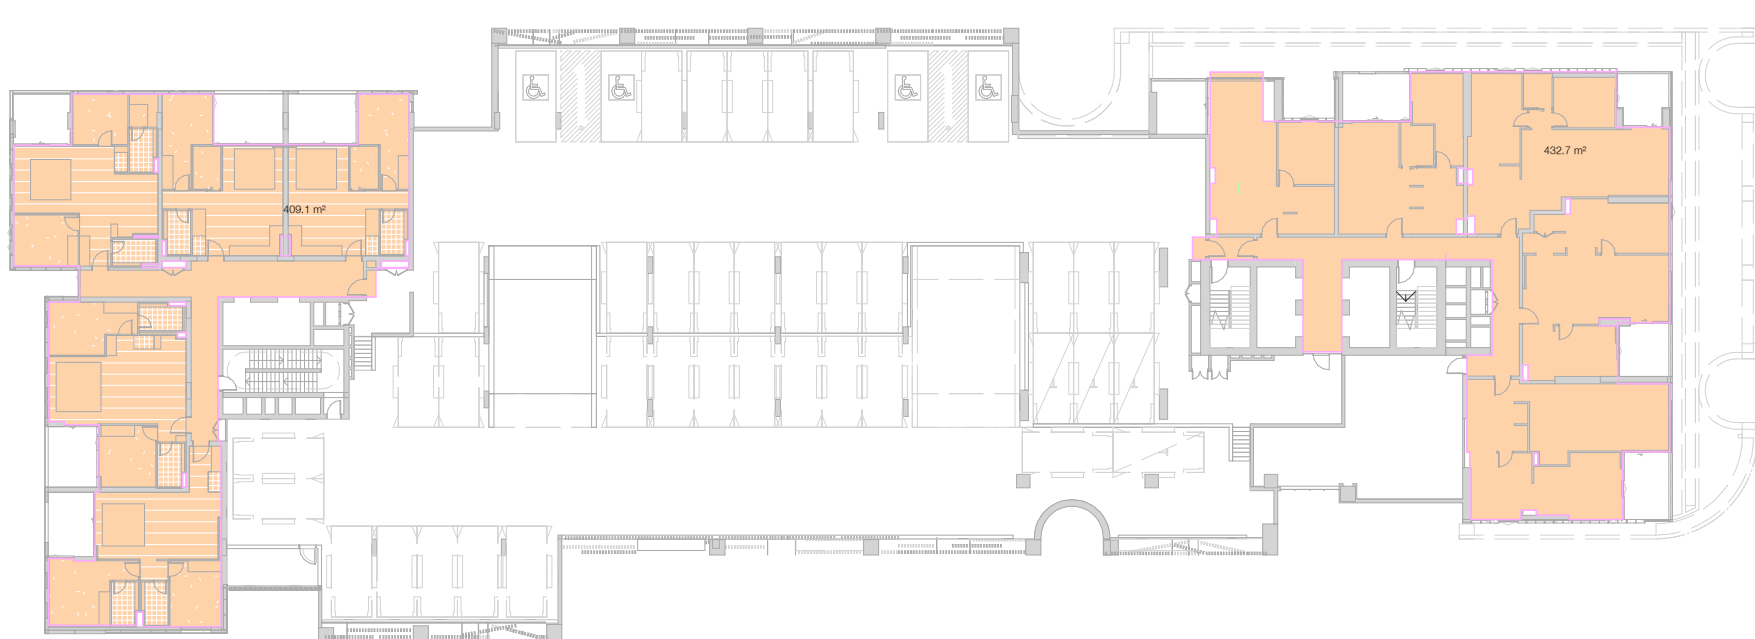

04 LEVEL 03  
1 : 450@A1



05 LEVEL 04  
1 : 450@A1

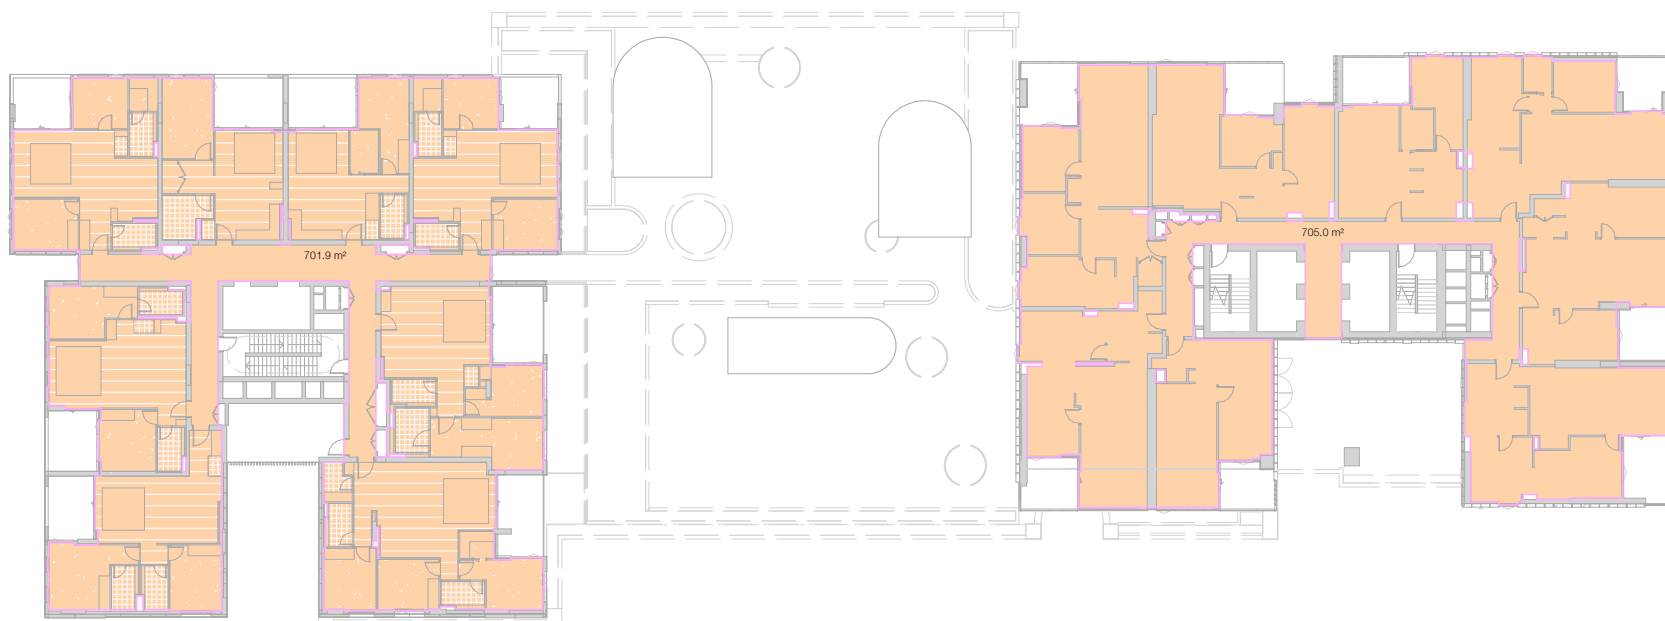

06 LEVEL 05  
1 : 450@A1



In accepting and utilising this document the recipient agrees that SJB Architecture (NSW) Pty. Ltd. ACN 081 094 724 T/A SJB Architects, retain all common law, statutory law and other rights including copyright and intellectual property rights. The recipient agrees not to use this document for any purpose other than its intended use; to waive all claims against SJB Architects resulting from unauthorised changes; or to reuse the document on other projects without the prior written consent of SJB Architects. Under no circumstances shall transfer of this document be deemed a sale. SJB Architects makes no warranties of fitness for any purpose. The Builder/Contractor shall verify job dimensions prior to any work commencing. Use figured dimensions only. Do not scale drawings.

Nominated Architects: Adam Haddow-7188 | John Pradel-7004

FOR APPROVAL

Rev	Date	Revision
66	24.01.2020	PRELIMINARY ISSUE
81	28.02.2020	DRAFT DA ISSUE
83	04.03.2020	ISSUED FOR DA
85	07.05.2021	ISSUED FOR DA
86	04.10.2021	ISSUED FOR LEC

Structural Engineer  
ROBERT BIRD GROUP

Mechanical / Hydraulic Engineer  
JHA CONSULTING ENGINEERS



Electrical Engineer  
JHA CONSULTING ENGINEERS

Fire Engineer  
OLSSON FIRE & RISK

Access Consultant  
ACCESSIBLE BUILDING SOLUTIONS

Basix  
EMF GRIFFITHS

Building Key

	GROSS FLOOR AREA (GFA)
	GROSS FLOOR AREA (GFA) COMMERCIAL


Client



Project  
HIGH ST DEVELOPMENT

634-638 HIGH ST & 87-89  
UNION RD, PENRITH

Drawing Name  
GFA CALCULATIONS - SHEET 02



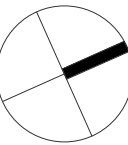


Date	Scale	Sheet Size
04.10.2021	As indicated	@ A1

Drawn	Chk.
GT	MG





Job No.	Drawing No.	Revision
6111	AR-1-8011	/86

SJB Architects  
Level 2  
490 Crown Street  
Surry Hills NSW  
2010 Australia  
T 61 2 9380 9911  
F 61 2 9380 9922  
www.sjb.com.au

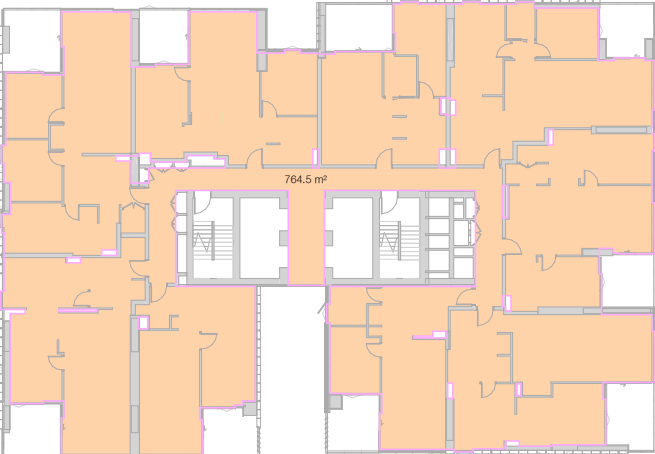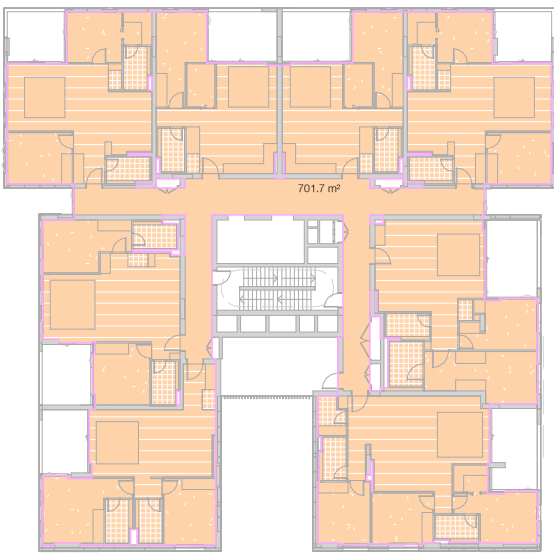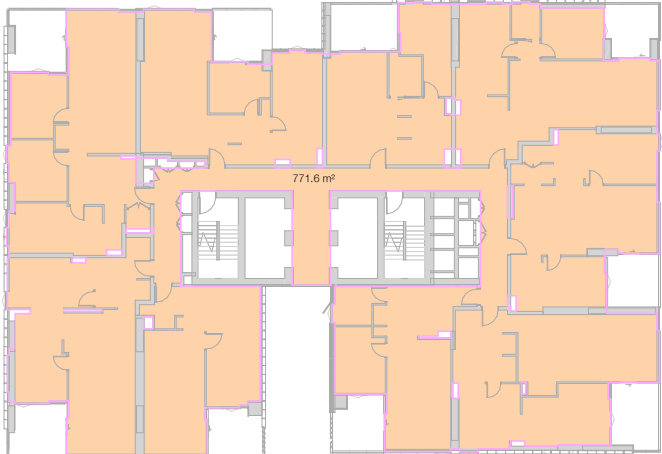





01 LEVEL 06-07  
1 : 450@A1

02 LEVEL 08  
1 : 450@A1

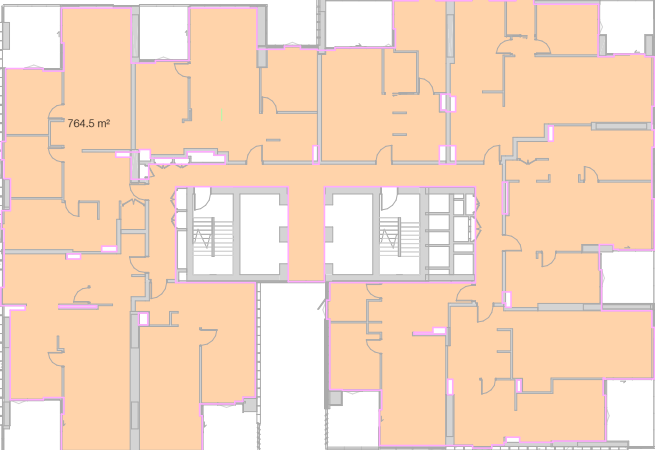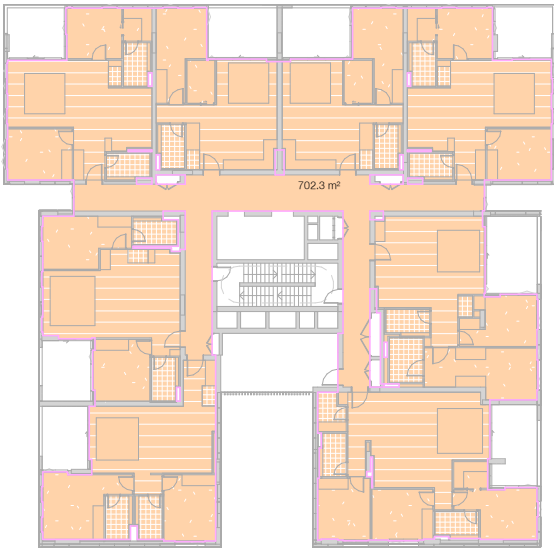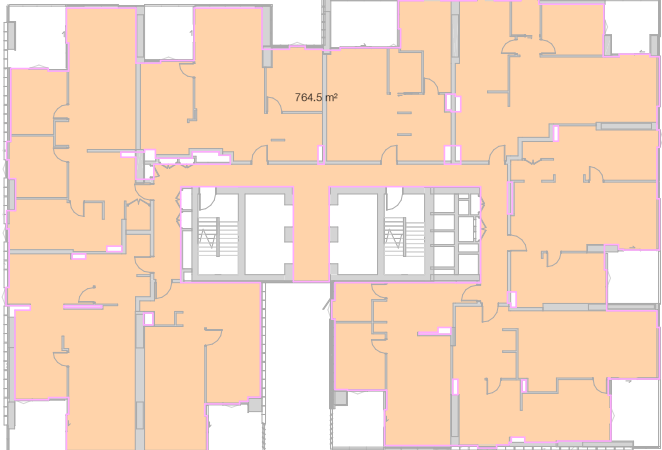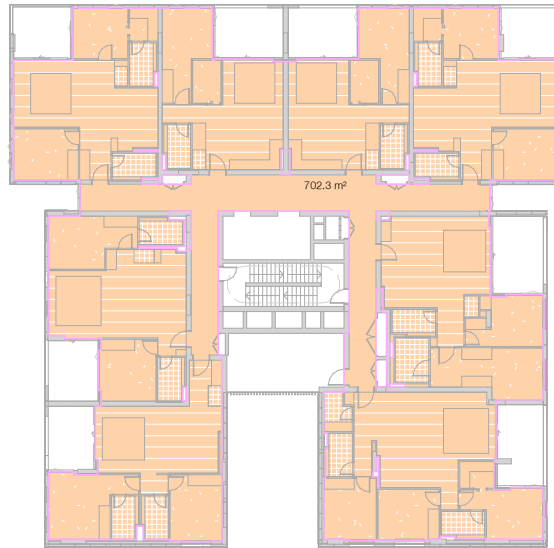

03 LEVEL 09  
1 : 450@A1

04 LEVEL 10  
1 : 450@A1

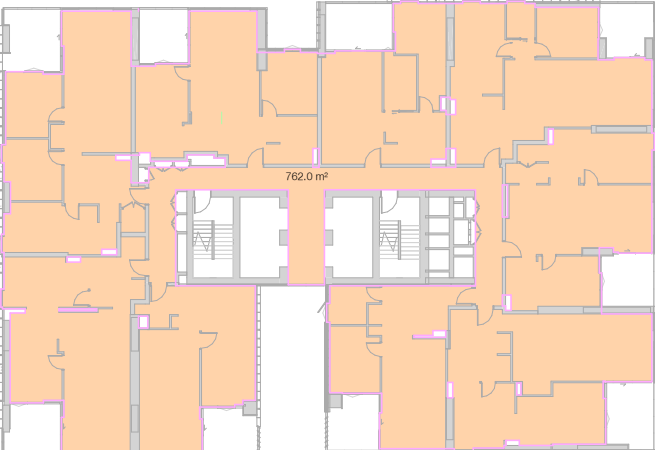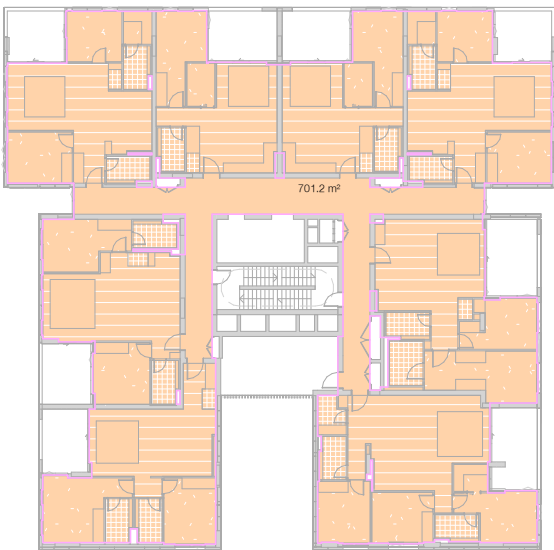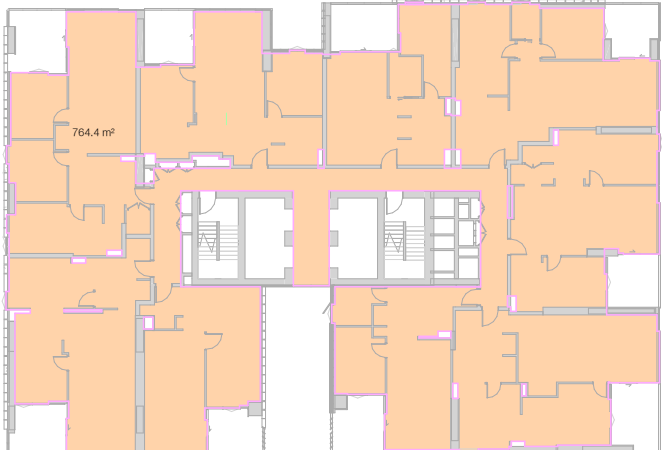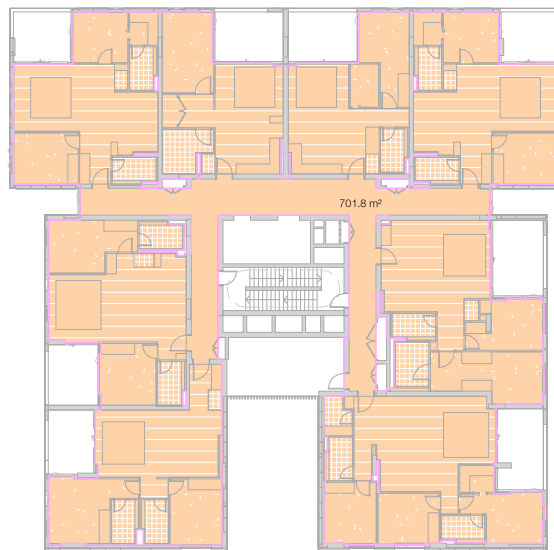

05 LEVEL 11  
1 : 450@A1

06 LEVEL 12  
1 : 450@A1



Nominated Architects: Adam Haddow-7188 | John Pradel-7004

Rev	Date	Revision
-----	------	----------

## Structural Engineer

Mechanical / Hydraulic Engineer

Electrical Engineer

JHA CONSULTING ENGINEERS

Fire Engineer

OLSSON FIRE &amp; RISK

Access Consultant

## ACCESSIBLE BUILDING SOLUTIONS

## Basis

EMF GRIFFITHS

### Building Key



GROSS FLOOR AREA (GFA) COMMERCIAL


Client



## HIGH ST DEVELOPMENT

Drawing Name

GFA CALCULATIONS - SHEET 03

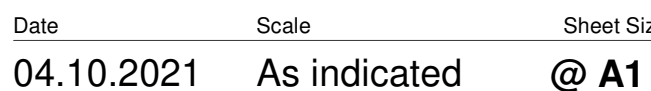



Drawn Chk

CT	MC
----	----



Job No.                      Drawing No.                      Revision

6111 AR-1-8012 /86


**SJB Architects**  
Level 2  
490 Crown Street  
Surry Hills NSW  
2010 Australia  
T 61 2 9380 9911  
F 61 2 9380 9922  
[www.sjb.com.au](http://www.sjb.com.au)

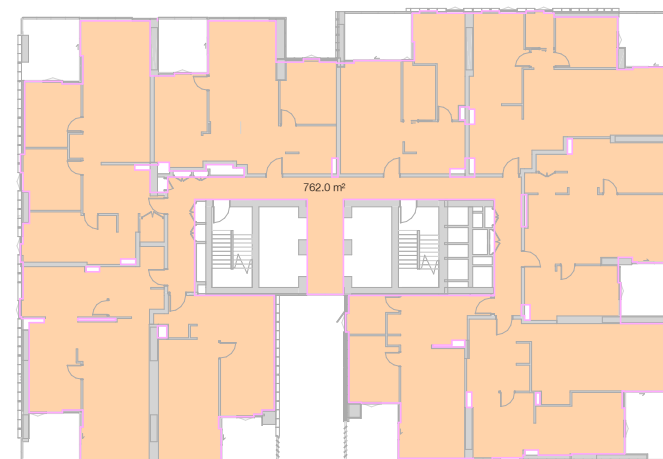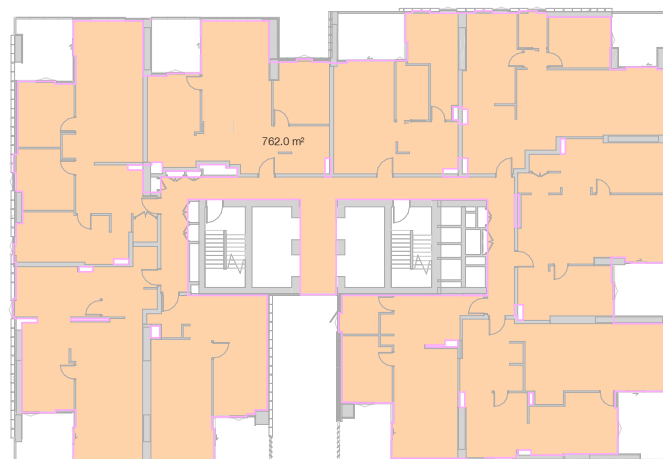

02 **LEVEL 14-28**

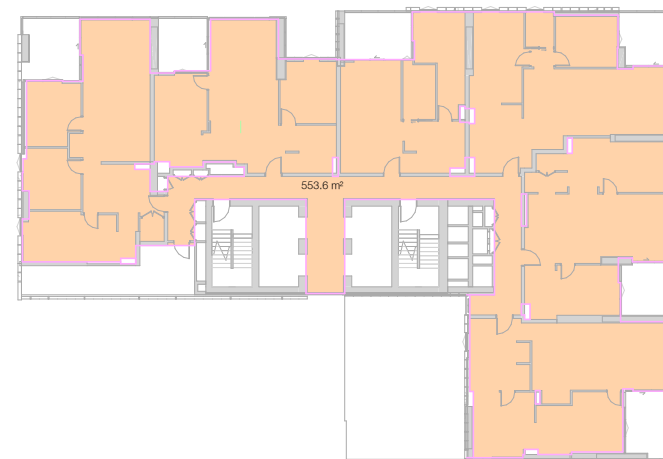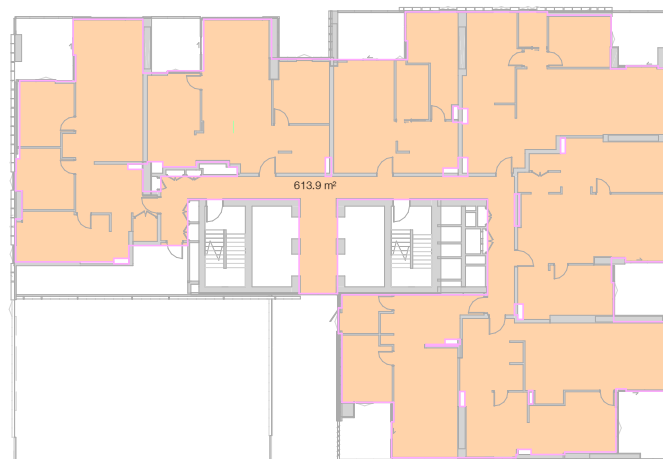

5 **LEVEL 31-32**  
1: 450@A1

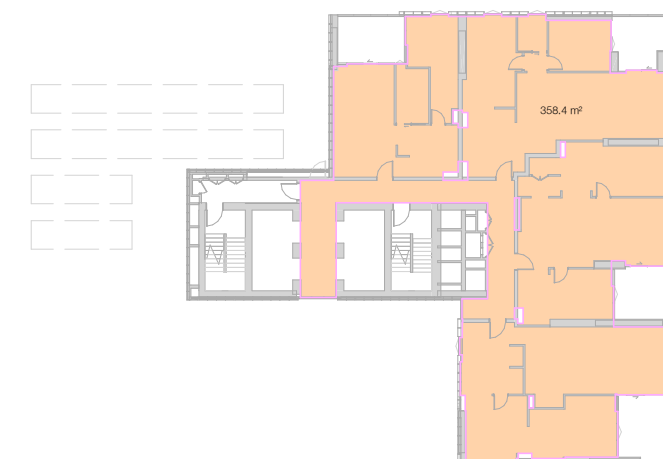[illegible]

PROPOSED GFA: 32,428.7  
DIFFERENCE: -11.5  
PROPOSED FSR: 6:1

**GROSS FLOOR AREA** means the sum of the floor area of each floor of a building measured from the internal face of external walls, or from the internal face of walls separating the building from any other building, measured at a height of 1.4 metres above the floor, and includes—  
(a) the area of a mezzanine, and

**GROSS FLOOR AREA** means the sum of the floor area of each floor of a building measured from the internal face of external walls, or from the internal face of walls separating the building from any other building, measured at a height of 1.4 metres above the floor, and includes—  
(a) the area of a mezzanine, and

- (b) habitable rooms in a basement or attic, and
- (c) any shop, auditorium, cinema, and the like, in a basement or attic, but excludes—
  - (d) any area for common vertical circulation, such as lifts and stairs, and
  - (e) any basement—
    - (i) storage, and
    - (ii) vehicular access, loading areas, garbage and services, and
- (f) plant rooms, lift towers and other areas used exclusively for mechanical services or ducting, and
- (g) car parking to meet any requirements of the consent authority (including access to that car parking), and
- (h) any space used for the loading or unloading of goods (including access to it), and
- (i) terraces and balconies with a clear width less than 1.4 metres high, and
- (j) voids above a floor at the level of a story or storey above.

## DI



In accepting and utilising this document the recipient agrees that SJB Architecture (NSW) Pty. Ltd. ACN 081 094 724 T/A SJB Architects, retain all common law, statutory law and other rights including copyright and intellectual property rights. The recipient agrees not to use this document for any purpose other than its intended use; to waive all claims against SJB Architects resulting from unauthorised changes; or to reuse the document on other projects without the prior written consent of SJB Architects. Under no circumstances shall transfer of this document be deemed a sale. SJB Architects makes no warranties of fitness for any purpose. The Builder/Contractor shall verify job dimensions prior to any work commencing. Use figured dimensions only. Do not scale drawings.

Nominated Architects: Adam Haddow-7188 | John Pradel-7004

FOR APPROVAL

Rev	Date	Revision
66	24.01.2020	PRELIMINARY ISSUE
81	28.02.2020	DRAFT DA ISSUE
83	04.03.2020	ISSUED FOR DA
85	07.05.2021	ISSUED FOR DA
86	04.10.2021	ISSUED FOR LEC

Structural Engineer	ROBERT BIRD GROUP
Mechanical / Hydraulic Engineer	JHA CONSULTING ENGINEERS
Electrical Engineer	JHA CONSULTING ENGINEERS
Fire Engineer	OLSSON FIRE & RISK
Access Consultant	ACCESSIBLE BUILDING SOLUTIONS
Basix	EMF GRIFFITHS
Building Key	

- AREAS ACHIEVING >2 HOURS SOLAR ACCESS
- PRINCIPLE USABLE SPACE
- COMMUNAL OPEN SPACE
- INDOOR OPEN SPACE

Client




Project

HIGH ST DEVELOPMENT

634-638 HIGH ST & 87-89 UNION RD, PENRITH

Drawing Name

COMMUNAL OPEN SPACE AREA

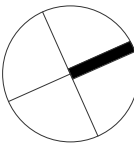

Date	Scale	Sheet Size
04.10.2021	1 : 200	@ A1

Drawn	Chk.
JS	MG


Job No.	Drawing No.	Revision
6111	AR-1-8030	/86

SJB Architects  
Level 2  
490 Crown Street  
Surry Hills NSW  
2010 Australia  
T 61 2 9380 9911  
F 61 2 9380 9922  
www.sjb.com.au



SUMMARY

SITE AREA	3,783 m²
COMMUNAL OPEN SPACE	867 m²
INTERNAL COMMUNAL SPACE	116 m²
TOTAL AREA	983 m²
COMMUNAL OPEN SPACE % PROVIDED	25.9%
PRINCIPAL OPEN SPACE AREA	663 m²
AREA OF PRINCIPAL OPEN SPACE RECIEVING 2+ HOURS SUNLIGHT	502 m²
% OF PRINCIPAL OPEN SPACE REQUIRED TO RECEIVE DIRECT SUNLIGHT	50%
% OF PRINCIPAL OPEN SPACE RECIEVING 2 HOURS DIRECT SUNLIGHT	75.7%

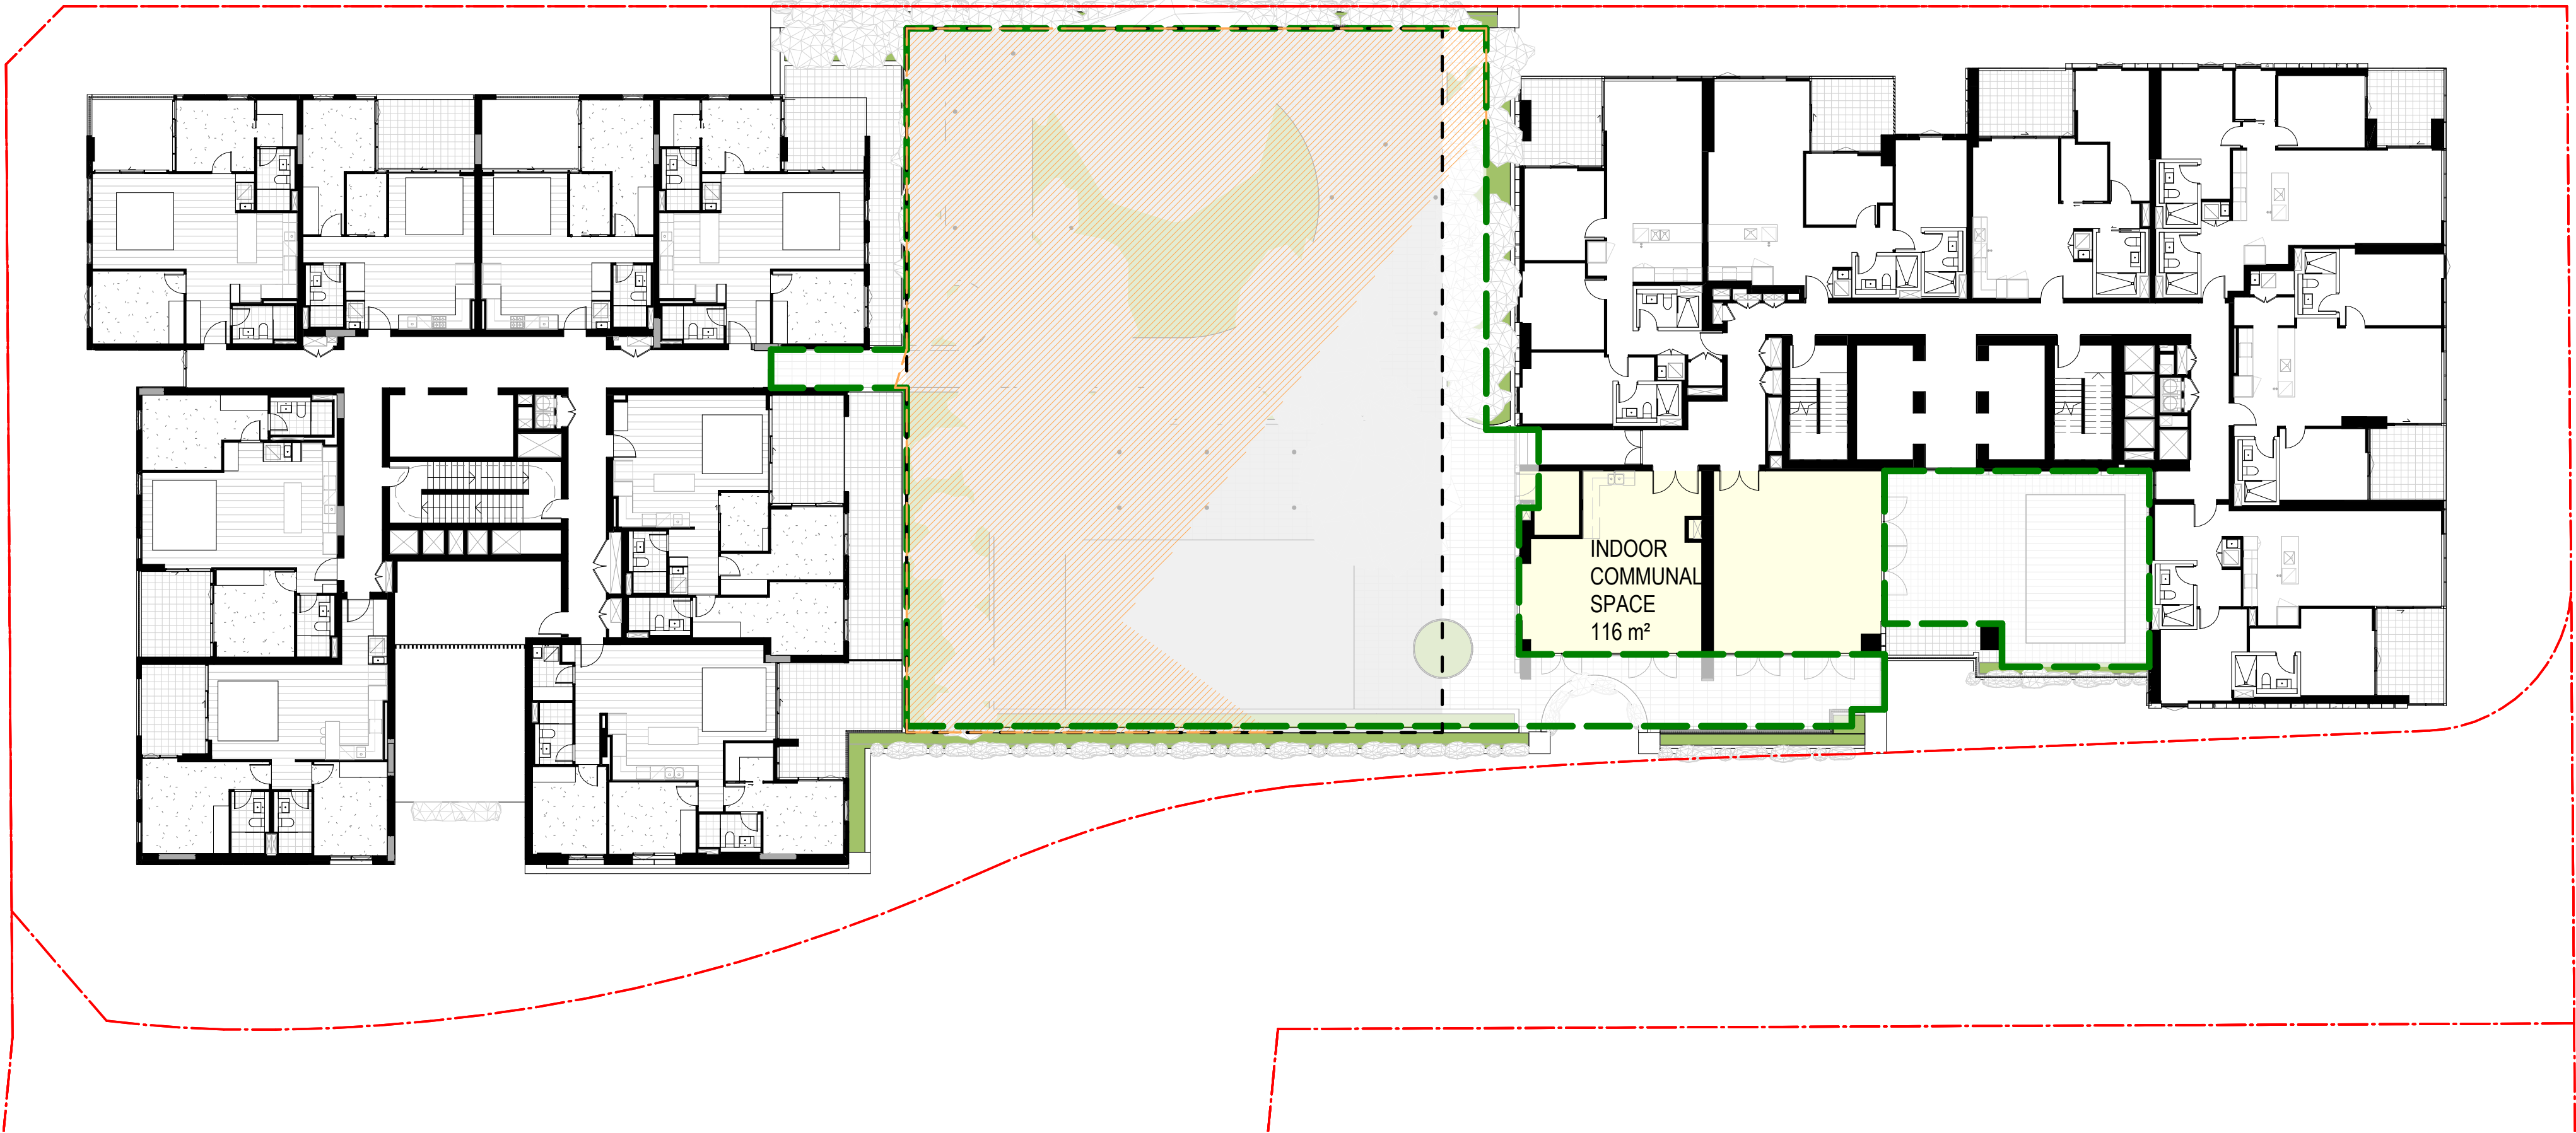

01 COMMUNAL OPEN SPACE - LEVEL 04  
AR-1-0102B 1 : 200@A1



In accepting and utilising this document the recipient agrees that SJB Architecture (NSW) Pty. Ltd. ACN 081 094 724 T/A SJB Architects, retain all common law, statutory law and other rights including copyright and intellectual property rights. The recipient agrees not to use this document for any purpose other than its intended use; to waive all claims against SJB Architects resulting from unauthorised changes; or to reuse the document on other projects without the prior written consent of SJB Architects. Under no circumstances shall transfer of this document be deemed a sale. SJB Architects makes no warranties of fitness for any purpose. The Builder/Contractor shall verify job dimensions prior to any work commencing. Use figured dimensions only. Do not scale drawings.

Nominated Architects: Adam Haddow-7188 | John Pradel-7004

FOR APPROVAL

Rev	Date	Revision
81	28.02.2020	DRAFT DA ISSUE
83	04.03.2020	ISSUED FOR DA
85	07.05.2021	ISSUED FOR DA
86	04.10.2021	ISSUED FOR LEC

Structural Engineer

ROBERT BIRD GROUP

Mechanical / Hydraulic Engineer

JHA CONSULTING ENGINEERS

Electrical Engineer

JHA CONSULTING ENGINEERS

Fire Engineer

OLSSON FIRE & RISK

Access Consultant

ACCESSIBLE BUILDING SOLUTIONS

Basix

EMF GRIFFITHS

Building Key

SUMMARY

SITE AREA	5,406.6 m <sup>2</sup>
DEEP SOIL AREA	271 m <sup>2</sup>
DEEP SOIL % PROVIDED	5%

Client




Project

HIGH ST DEVELOPMENT

634-638 HIGH ST & 87-89  
UNION RD, PENRITH

Drawing Name

DEEP SOIL AREA

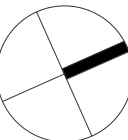


Date	Scale	Sheet Size
04.10.2021	1 : 200	@ A1

Drawn	Chk.
GT	MG

Job No.	Drawing No.	Revision
6111	AR-1-8031	/86

SJB Architects  
Level 2  
490 Crown Street  
Surry Hills NSW  
2010 Australia  
T 61 2 9380 9911  
F 61 2 9380 9922  
www.sjb.com.au

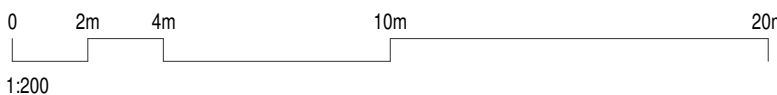



FOR APPROVAL

Rev	Date	Revision
66	24.01.2020	PRELIMINARY ISSUE
81	28.02.2020	DRAFT DA ISSUE
83	04.03.2020	ISSUED FOR DA
85	07.05.2021	ISSUED FOR DA
86	04.10.2021	ISSUED FOR LEC

Structural Engineer

ROBERT BIRD GROUP

Mechanical / Hydraulic Engineer

JHA CONSULTING ENGINEERS

Electrical Engineer

JHA CONSULTING ENGINEERS

Fire Engineer

OLSSON FIRE & RISK

Access Consultant

ACCESSIBLE BUILDING SOLUTIONS

Basix

EMF GRIFFITHS

Building Key

CROSS VENTILATION

NATURAL VENTILATION

Client




Project

HIGH ST DEVELOPMENT

634-638 HIGH ST & 87-89  
UNION RD, PENRITH

Drawing Name

CROSS VENTILATION ANALYSIS -  
UP TO LEVEL 08

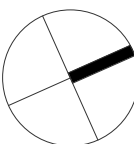

Date	Scale	Sheet Size
04.10.2021	As indicated	@ A1

Drawn

Chk.

GT

MG

Job No.

Drawing No.


Revision

6111


AR-1-8040 /86

SJB Architects


Level 2  
490 Crown Street  
Surry Hills NSW  
2010 Australia  
T 61 2 9380 9911  
F 61 2 9380 9922  
www.sjb.com.au

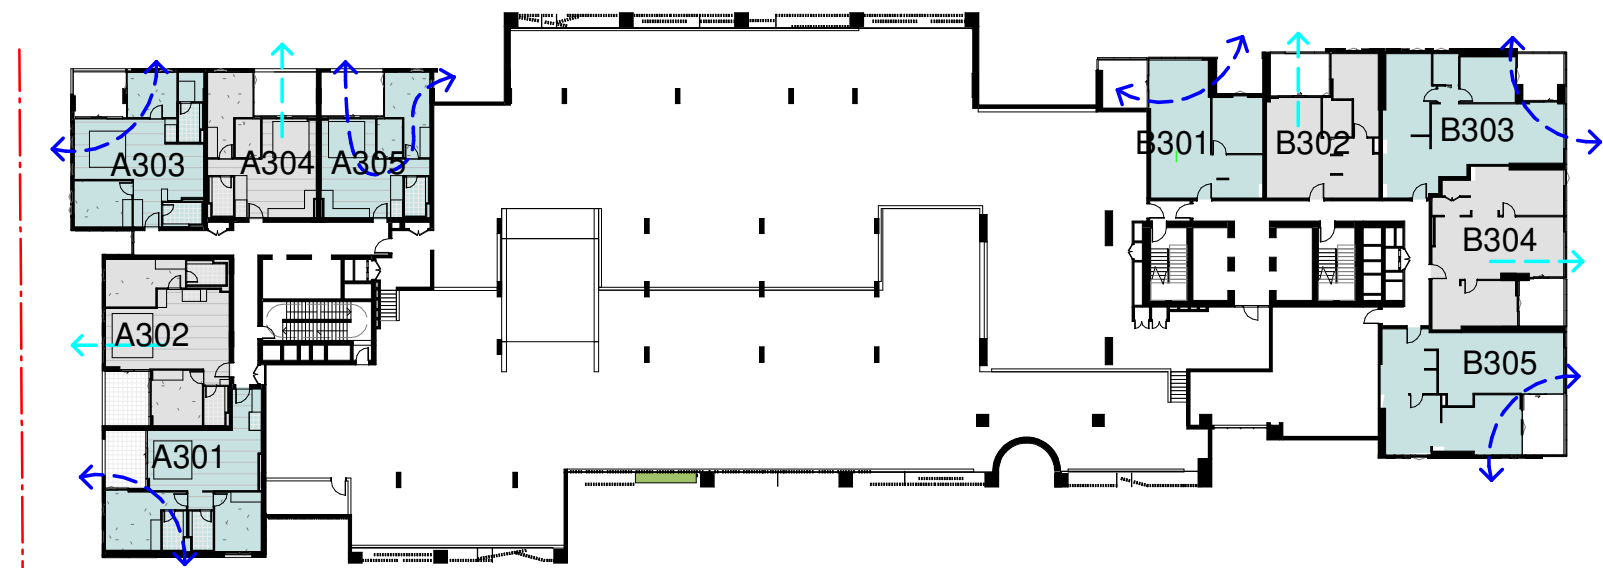


01 CROSS VENT - LEVEL 01-03  
1: 500@A1

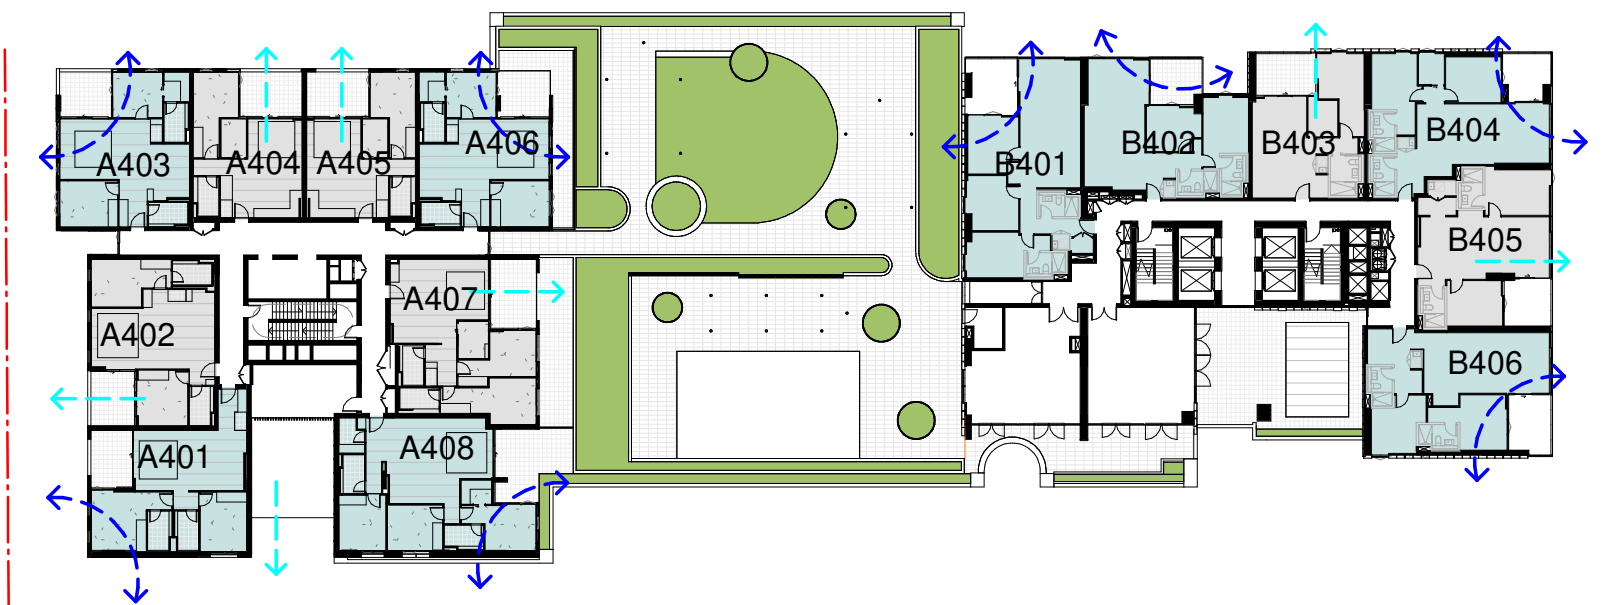


02 CROSS VENT - LEVEL 04  
1: 500@A1

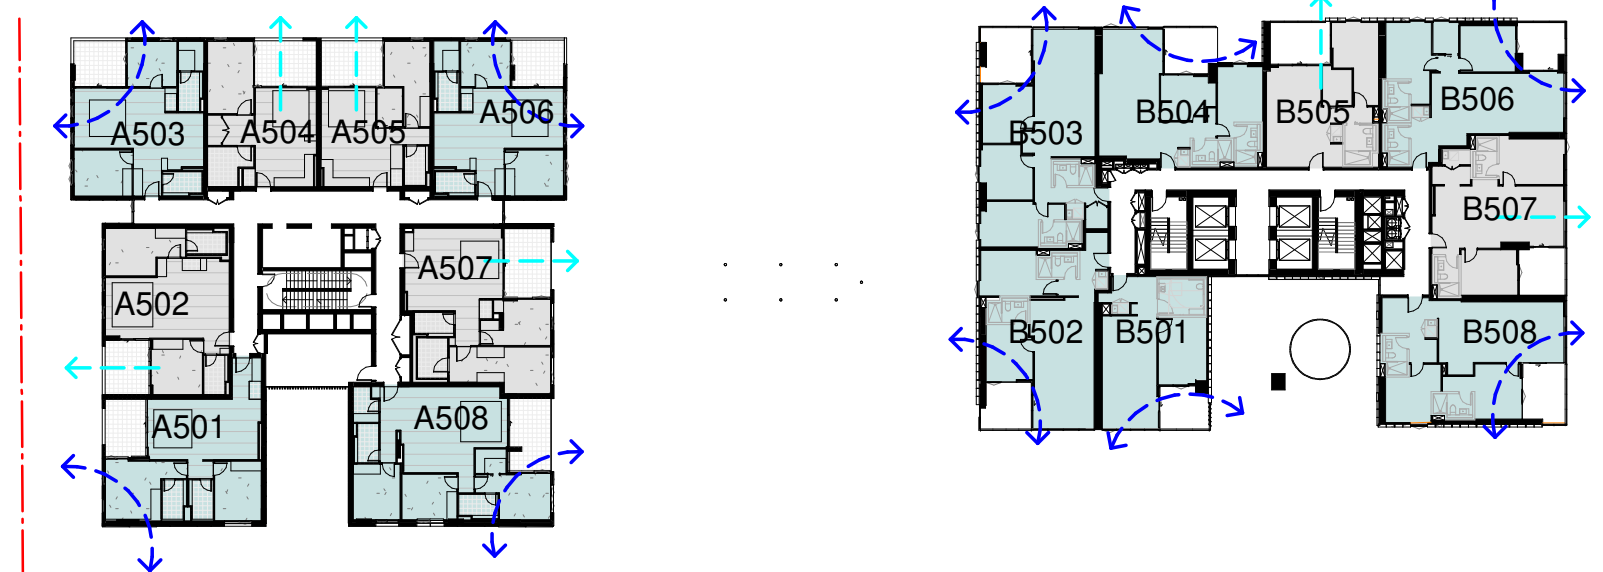


03 CROSS VENT - LEVEL 05  
1: 500@A1

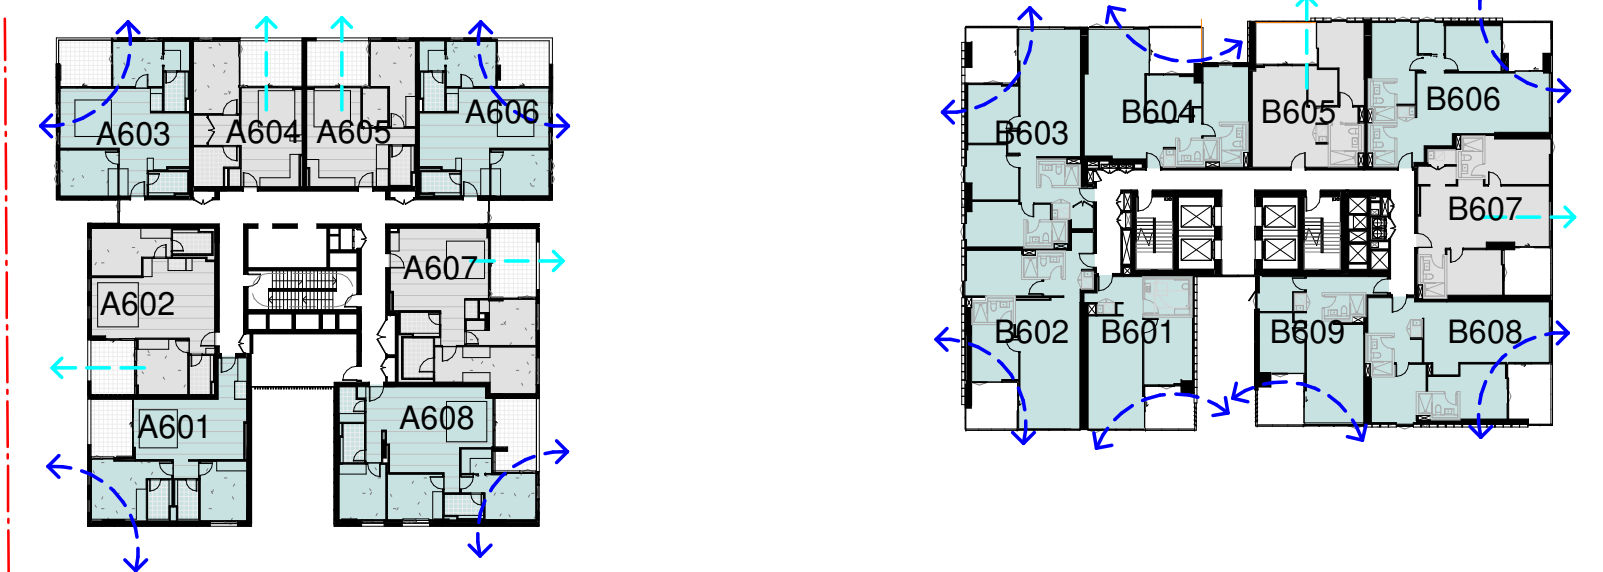

04 CROSS VENT - LEVEL 06  
1: 500@A1

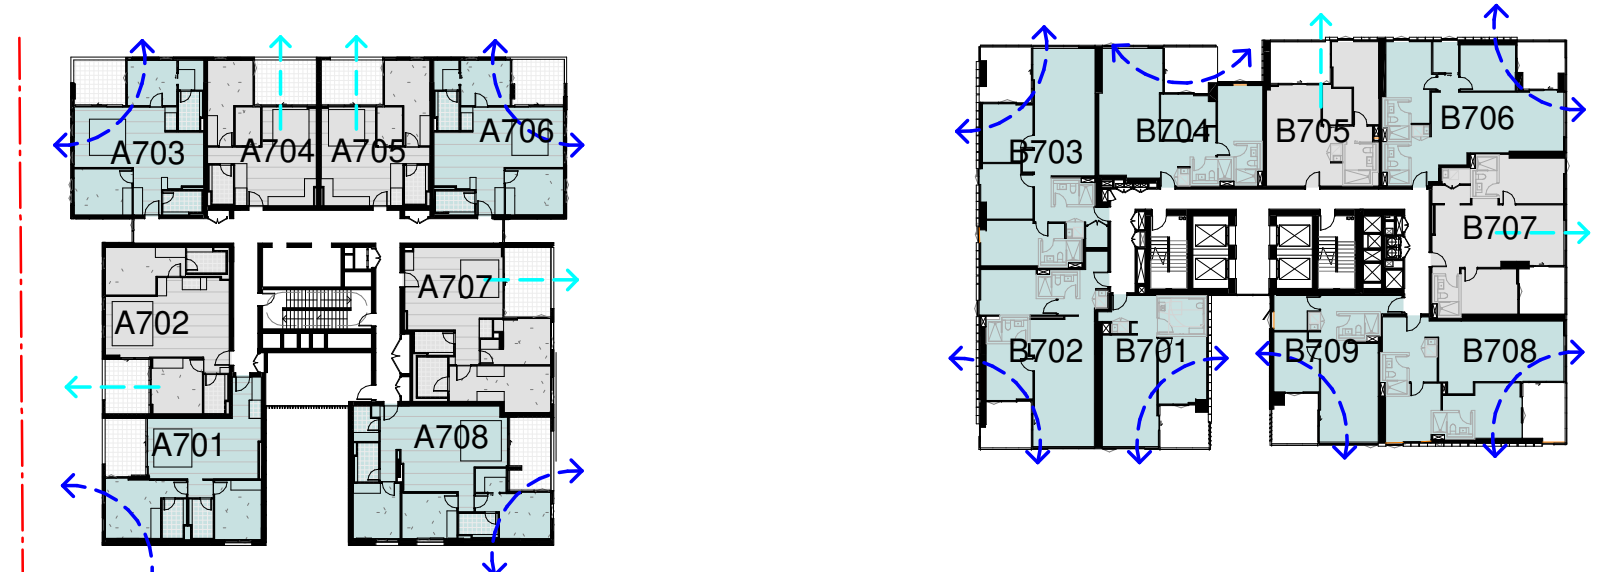

05 CROSS VENT - LEVEL 07  
1: 500@A1

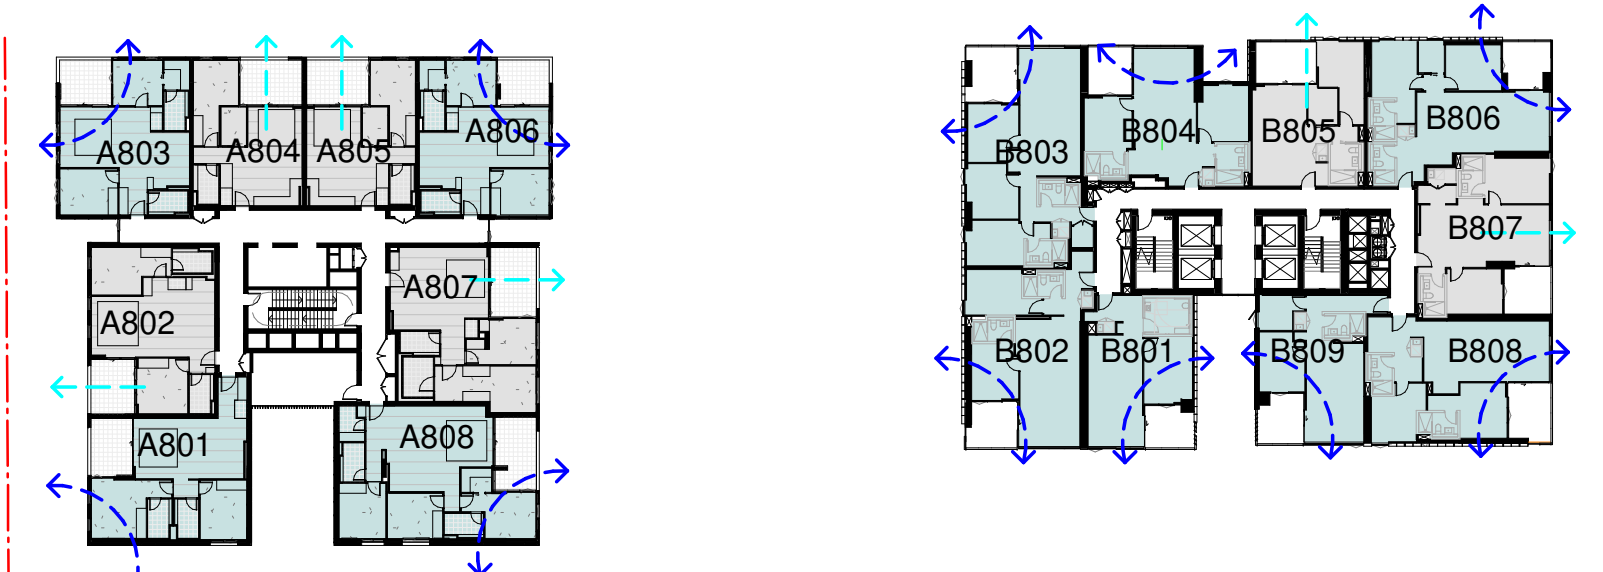

06 CROSS VENT - LEVEL 08  
1: 500@A1

SUMMARY

TOTAL NUMBER OF APARTMENTS UP TO 9TH STOREY	111
TOTAL NO. OF APARTMENTS RECEIVING CROSS VENTILATION UP TO 9TH STOREY	69
% OF APARTMENTS UP TO 9TH STOREY REQUIRED TO HAVE CROSS VENTILATION	60%
% OF APARTMENTS UP TO 9TH STOREY RECEIVING CROSS VENTILATION	62%



In accepting and utilising this document the recipient agrees that SJB Architecture (NSW) Pty. Ltd. ACN 081 694 724 T/A SJB Architects, retain all common law, statutory law and other rights including copyright and intellectual property rights. The recipient agrees not to use this document for any purpose other than its intended use; to waive all claims against SJB Architects resulting from unauthorised changes; or to reuse the document on other projects without the prior written consent of SJB Architects. Under no circumstances shall transfer of this document be deemed a sale. SJB Architects makes no warranties of fitness for any purpose. The Builder/Contractor shall verify job dimensions prior to any work commencing. Use figured dimensions only. Do not scale drawings.

Nominated Architects: Adam Haddow-7188 | John Pradel-7004

FOR APPROVAL

Rev	Date	Revision
66	24.01.2020	PRELIMINARY ISSUE
81	28.02.2020	DRAFT DA ISSUE
83	04.03.2020	ISSUED FOR DA
85	07.05.2021	ISSUED FOR DA
86	04.10.2021	ISSUED FOR LEC

Structural Engineer

ROBERT BIRD GROUP

Mechanical / Hydraulic Engineer

JHA CONSULTING ENGINEERS

Electrical Engineer

JHA CONSULTING ENGINEERS

Fire Engineer

OLSSON FIRE & RISK

Access Consultant

ACCESSIBLE BUILDING SOLUTIONS

Basix

EMF GRIFFITHS

Building Key

APARTMENTS RECEIVING A MINIMUM OF 2HRS DIRECT SUNLIGHT TO LIVING AREAS AND PRIVATE OPEN SPACE BETWEEN 9am-3pm MID WINTER

APARTMENTS RECEIVING A MINIMUM OF 2HRS DIRECT SUNLIGHT TO LIVING AREA AND PRIVATE OPEN SPACE BETWEEN 9am-3pm MID WINTER WITH SKYLIGHT

APARTMENTS RECEIVING BETWEEN 15MINS 2HRS SUNLIGHT TO LIVING AREA AND PRIVATE OPEN SPACE BETWEEN 9am-3pm MID WINTER

APARTMENTS RECEIVING <15MINS SUNLIGHT TO LIVING AREA AND PRIVATE OPEN SPACE BETWEEN 9am-3pm MID WINTER

Client



Project

HIGH ST DEVELOPMENT

634-638 HIGH ST & 87-89 UNION RD, PENRITH

Drawing Name


SOLAR ANALYSIS - SHEET 01

Date 04.10.2021 Scale As indicated Sheet Size @ A1

Drawn CC Chk. MG

Job No. 6111 Drawing No. AR-1-8050 /86 Revision


SJB Architects  
Level 2  
490 Crown Street  
Surry Hills NSW  
2010 Australia  
T 61 2 9380 9911  
F 61 2 9380 9922  
www.sjb.com.au

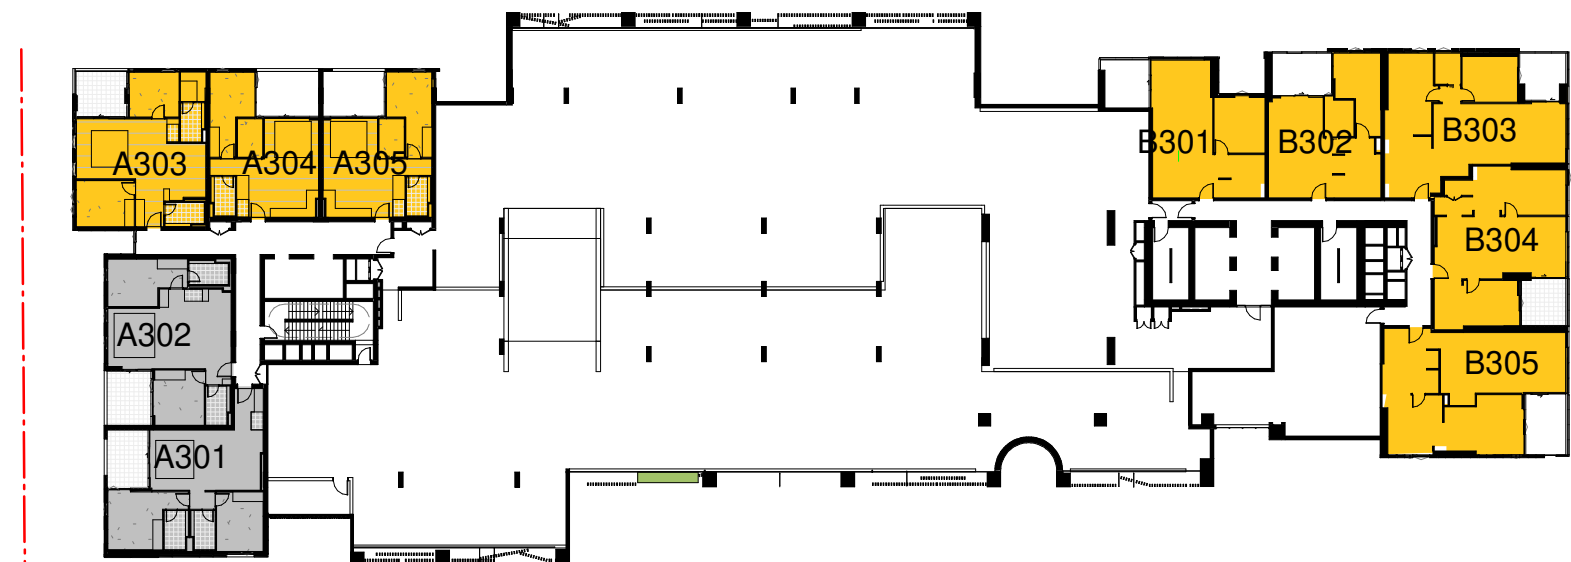



01 SOLAR - LEVEL 01-03  
1: 500@A1




02 SOLAR - LEVEL 04  
1: 500@A1

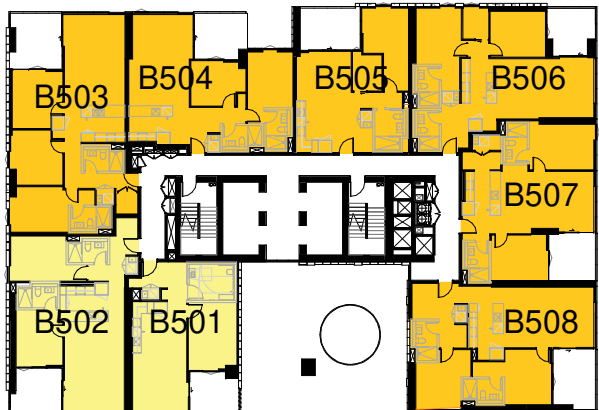


03 SOLAR - LEVEL 05  
1: 500@A1

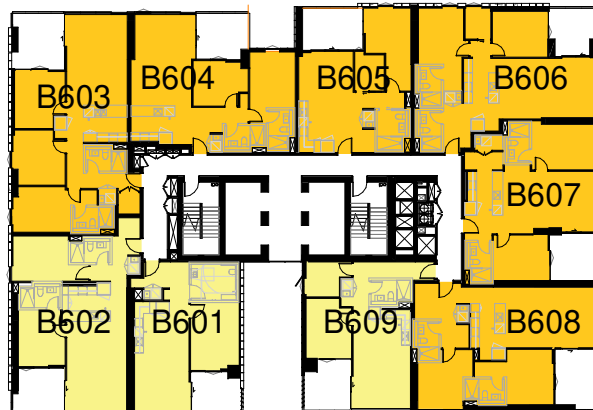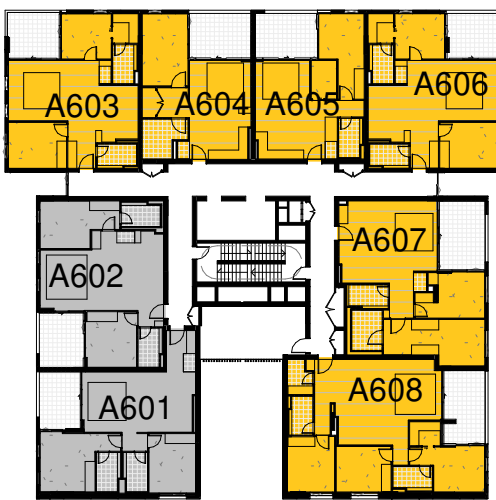


04 SOLAR - LEVEL 06-07  
1: 500@A1

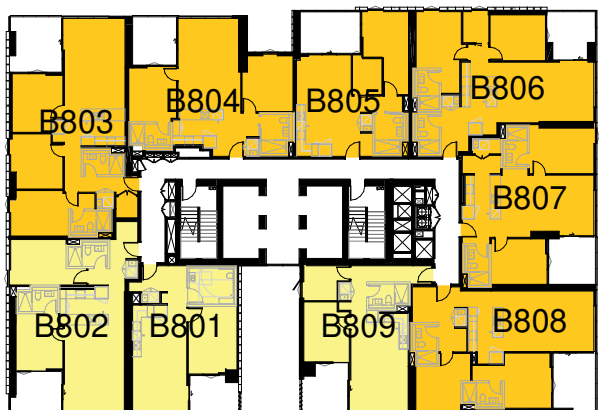

5 Solar - Level 8-12  
AR-1-0102B 1: 500@A1

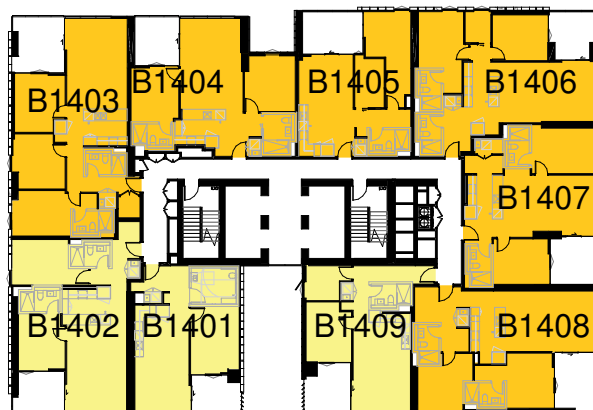

06 SOLAR - LEVEL 13-14  
1: 500@A1

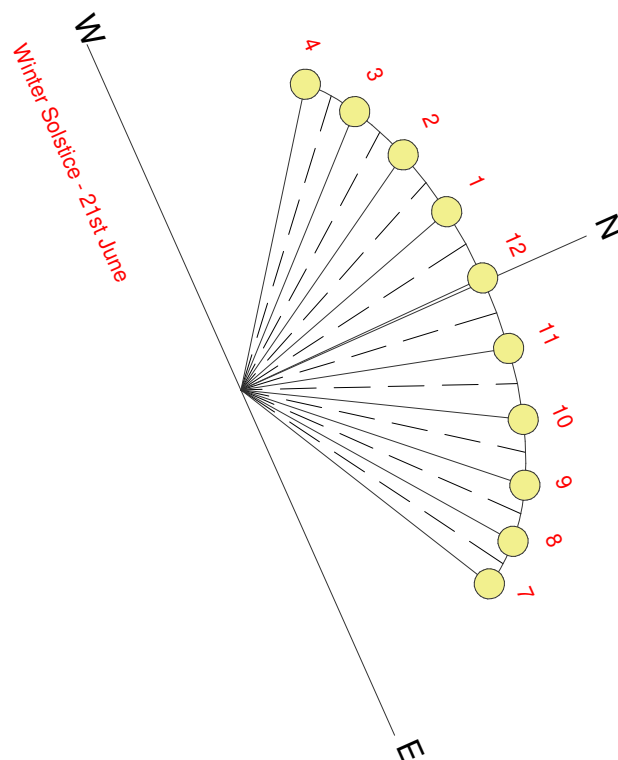



In accepting and utilising this document the recipient agrees that SJB Architecture (NSW) Pty. Ltd. ACN 081 094 724 T/A SJB Architects, retain all common law, statutory law and other rights including copyright and intellectual property rights. The recipient agrees not to use this document for any purpose other than its intended use; to waive all claims against SJB Architects resulting from unauthorised changes; or to reuse the document on other projects without the prior written consent of SJB Architects. Under no circumstances shall transfer of this document be deemed a sale. SJB Architects makes no warranties of fitness for any purpose. The Builder/Contractor shall verify job dimensions prior to any work commencing. Use figured dimensions only. Do not scale drawings.

Nominated Architects: Adam Haddow-7188 | John Pradel-7004

FOR APPROVAL

Rev	Date	Revision
66	24.01.2020	PRELIMINARY ISSUE
81	28.02.2020	DRAFT DA ISSUE
83	04.03.2020	ISSUED FOR DA
85	07.05.2021	ISSUED FOR DA
86	04.10.2021	ISSUED FOR LEC

Structural Engineer

ROBERT BIRD GROUP

Mechanical / Hydraulic Engineer

JHA CONSULTING ENGINEERS

Electrical Engineer

JHA CONSULTING ENGINEERS

Fire Engineer

OLSSON FIRE & RISK

Access Consultant

ACCESSIBLE BUILDING SOLUTIONS

Basix

EMF GRIFFITHS

Building Key

APARTMENTS RECEIVING A MINIMUM OF 2HRS DIRECT SUNLIGHT TO LIVING AREAS AND PRIVATE OPEN SPACE BETWEEN 9am-3pm MID WINTER

APARTMENTS RECEIVING A MINIMUM OF 2HRS DIRECT SUNLIGHT TO LIVING AREA AND PRIVATE OPEN SPACE BETWEEN 9am-3pm MID WINTER WITH SKYLIGHT

APARTMENTS RECEIVING BETWEEN 15MINS-2HRS SUNLIGHT TO LIVING AREA AND PRIVATE OPEN SPACE BETWEEN 9am-3pm MID WINTER

APARTMENTS RECEIVING <15MINS SUNLIGHT TO LIVING AREA AND PRIVATE OPEN SPACE BETWEEN 9am-3pm MID WINTER

Client



Project

HIGH ST DEVELOPMENT

634-638 HIGH ST & 87-89 UNION RD, PENRITH

Drawing Name





SOLAR ANALYSIS - SHEET 02

Date 04.10.2021 Scale As indicated Sheet Size @ A1

Drawn CC Chk. MG


Job No. 6111 Drawing No. AR-1-8051 Revision /86

SJB Architects  
Level 2  
490 Crown Street  
Surry Hills NSW  
2010 Australia  
T 61 2 9380 9911  
F 61 2 9380 9922  
www.sjb.com.au

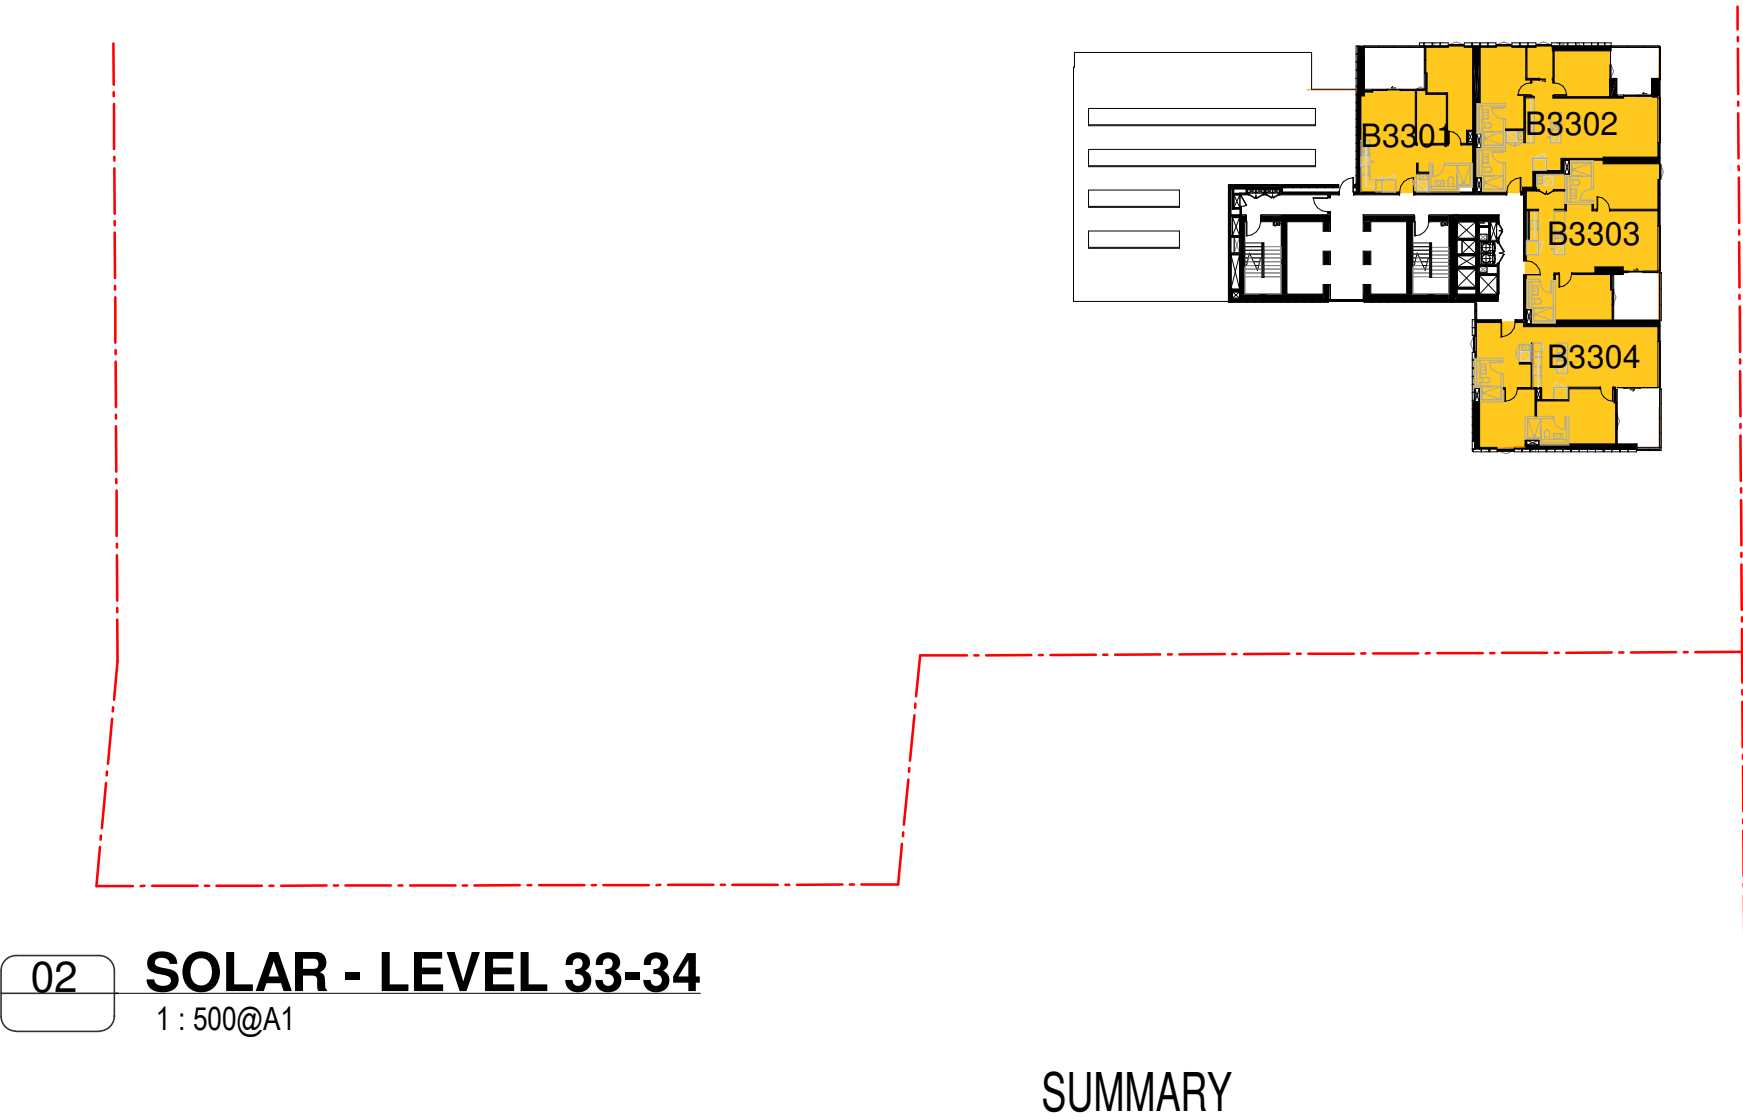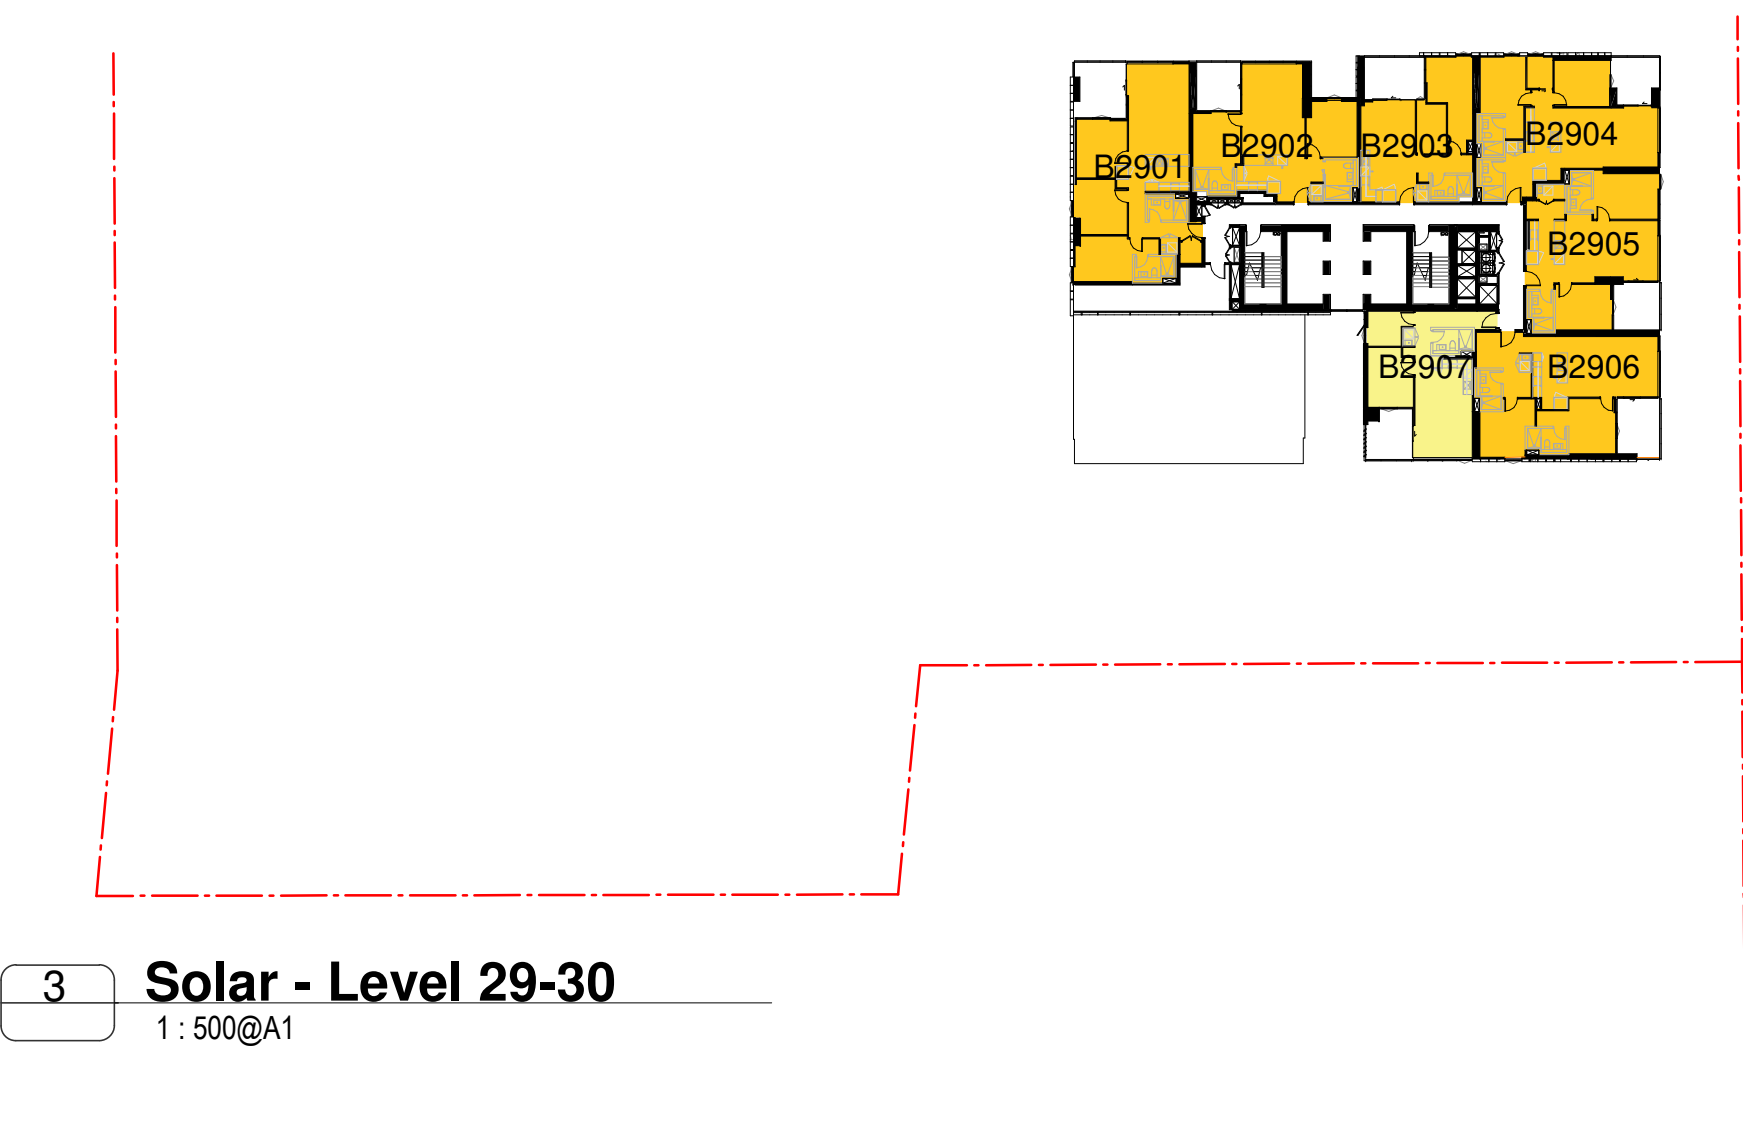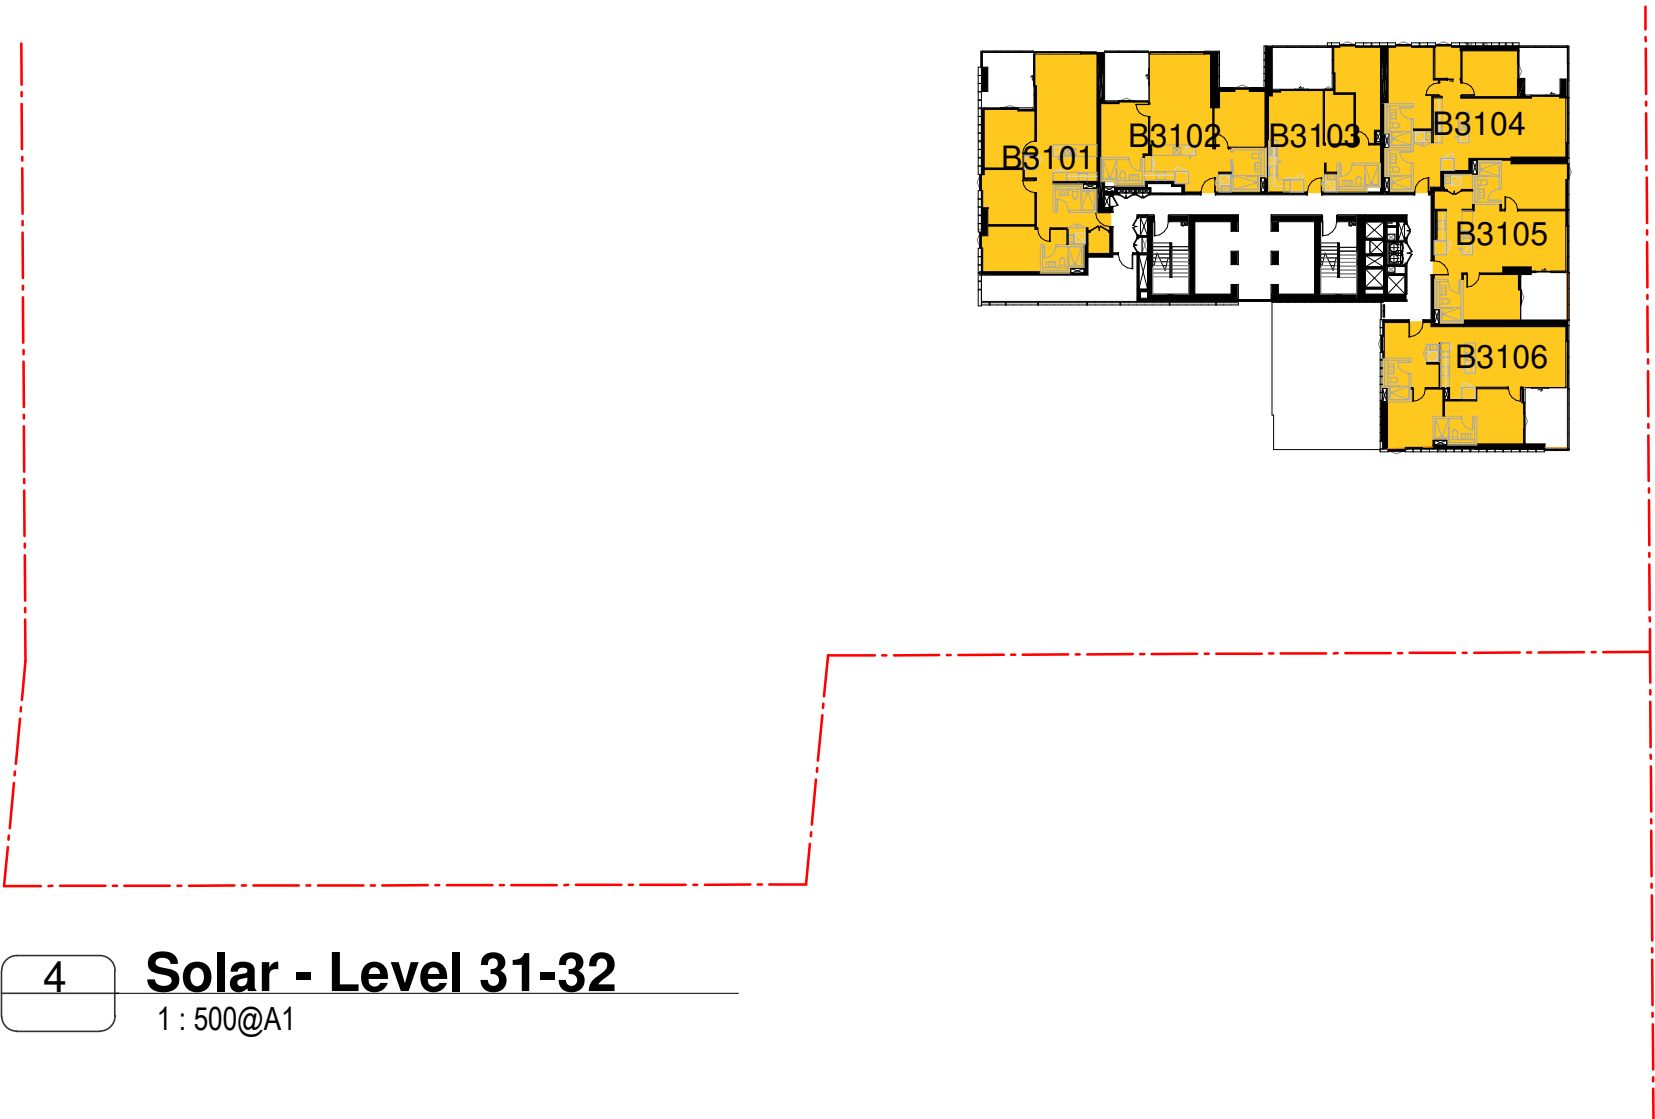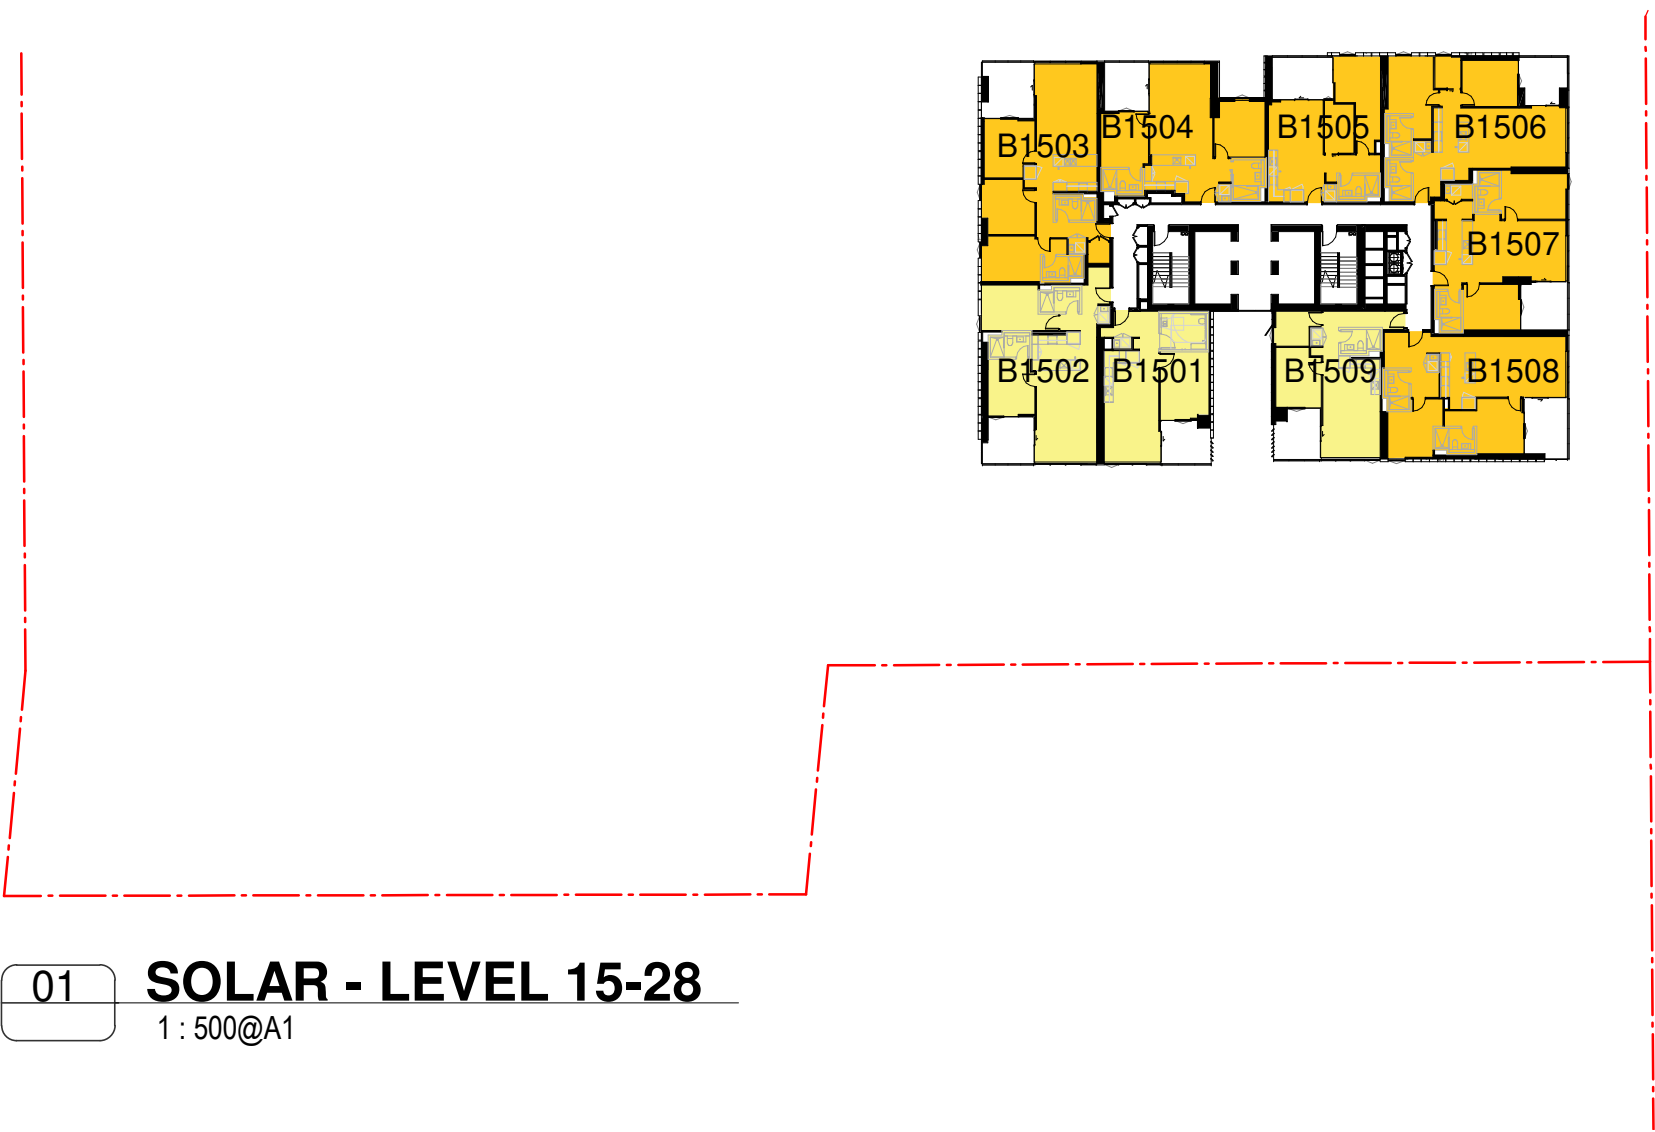

SUMMARY

TOTAL NO. OF APARTMENTS	357
TOTAL NO. OF APARTMENTS RECEIVING 2+ HRS DIRECT SUNLIGHT	260
MIN % OF APARTMENTS REQUIRED 2+ HRS DIRECT SUNLIGHT	70%
% OF APARTMENTS RECEIVING 2+ HRS DIRECT SUNLIGHT	73%
TOTAL NO. OF APARTMENTS RECEIVING <15 MINS DIRECT SUNLIGHT	24
MAX % OF APARTMENTS ALLOWED <15 MINS DIRECT SUNLIGHT	15%
% OF APARTMENTS RECEIVING <15 MINS DIRECT SUNLIGHT	7%

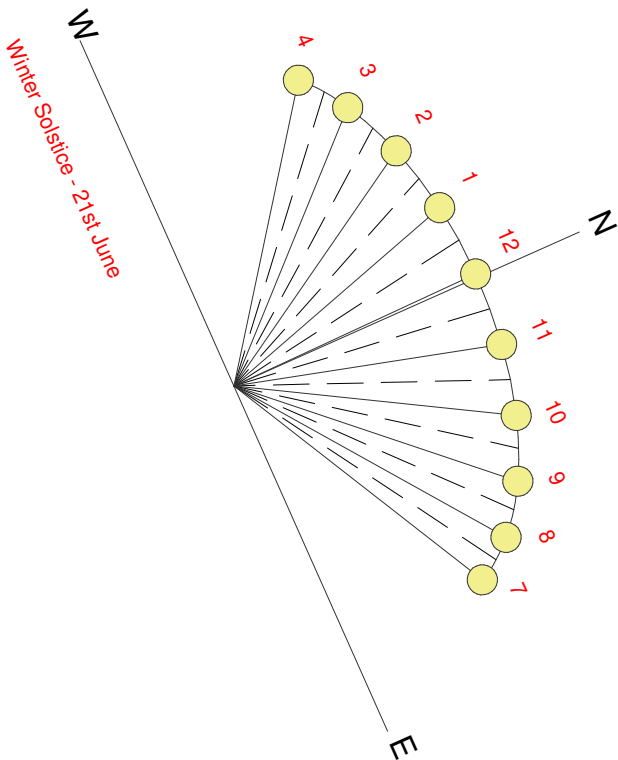






01 SOLAR VIEW - 9am  
@A1



02 SOLAR VIEW - 10am  
@A1



03 SOLAR VIEW - 11am  
@A1

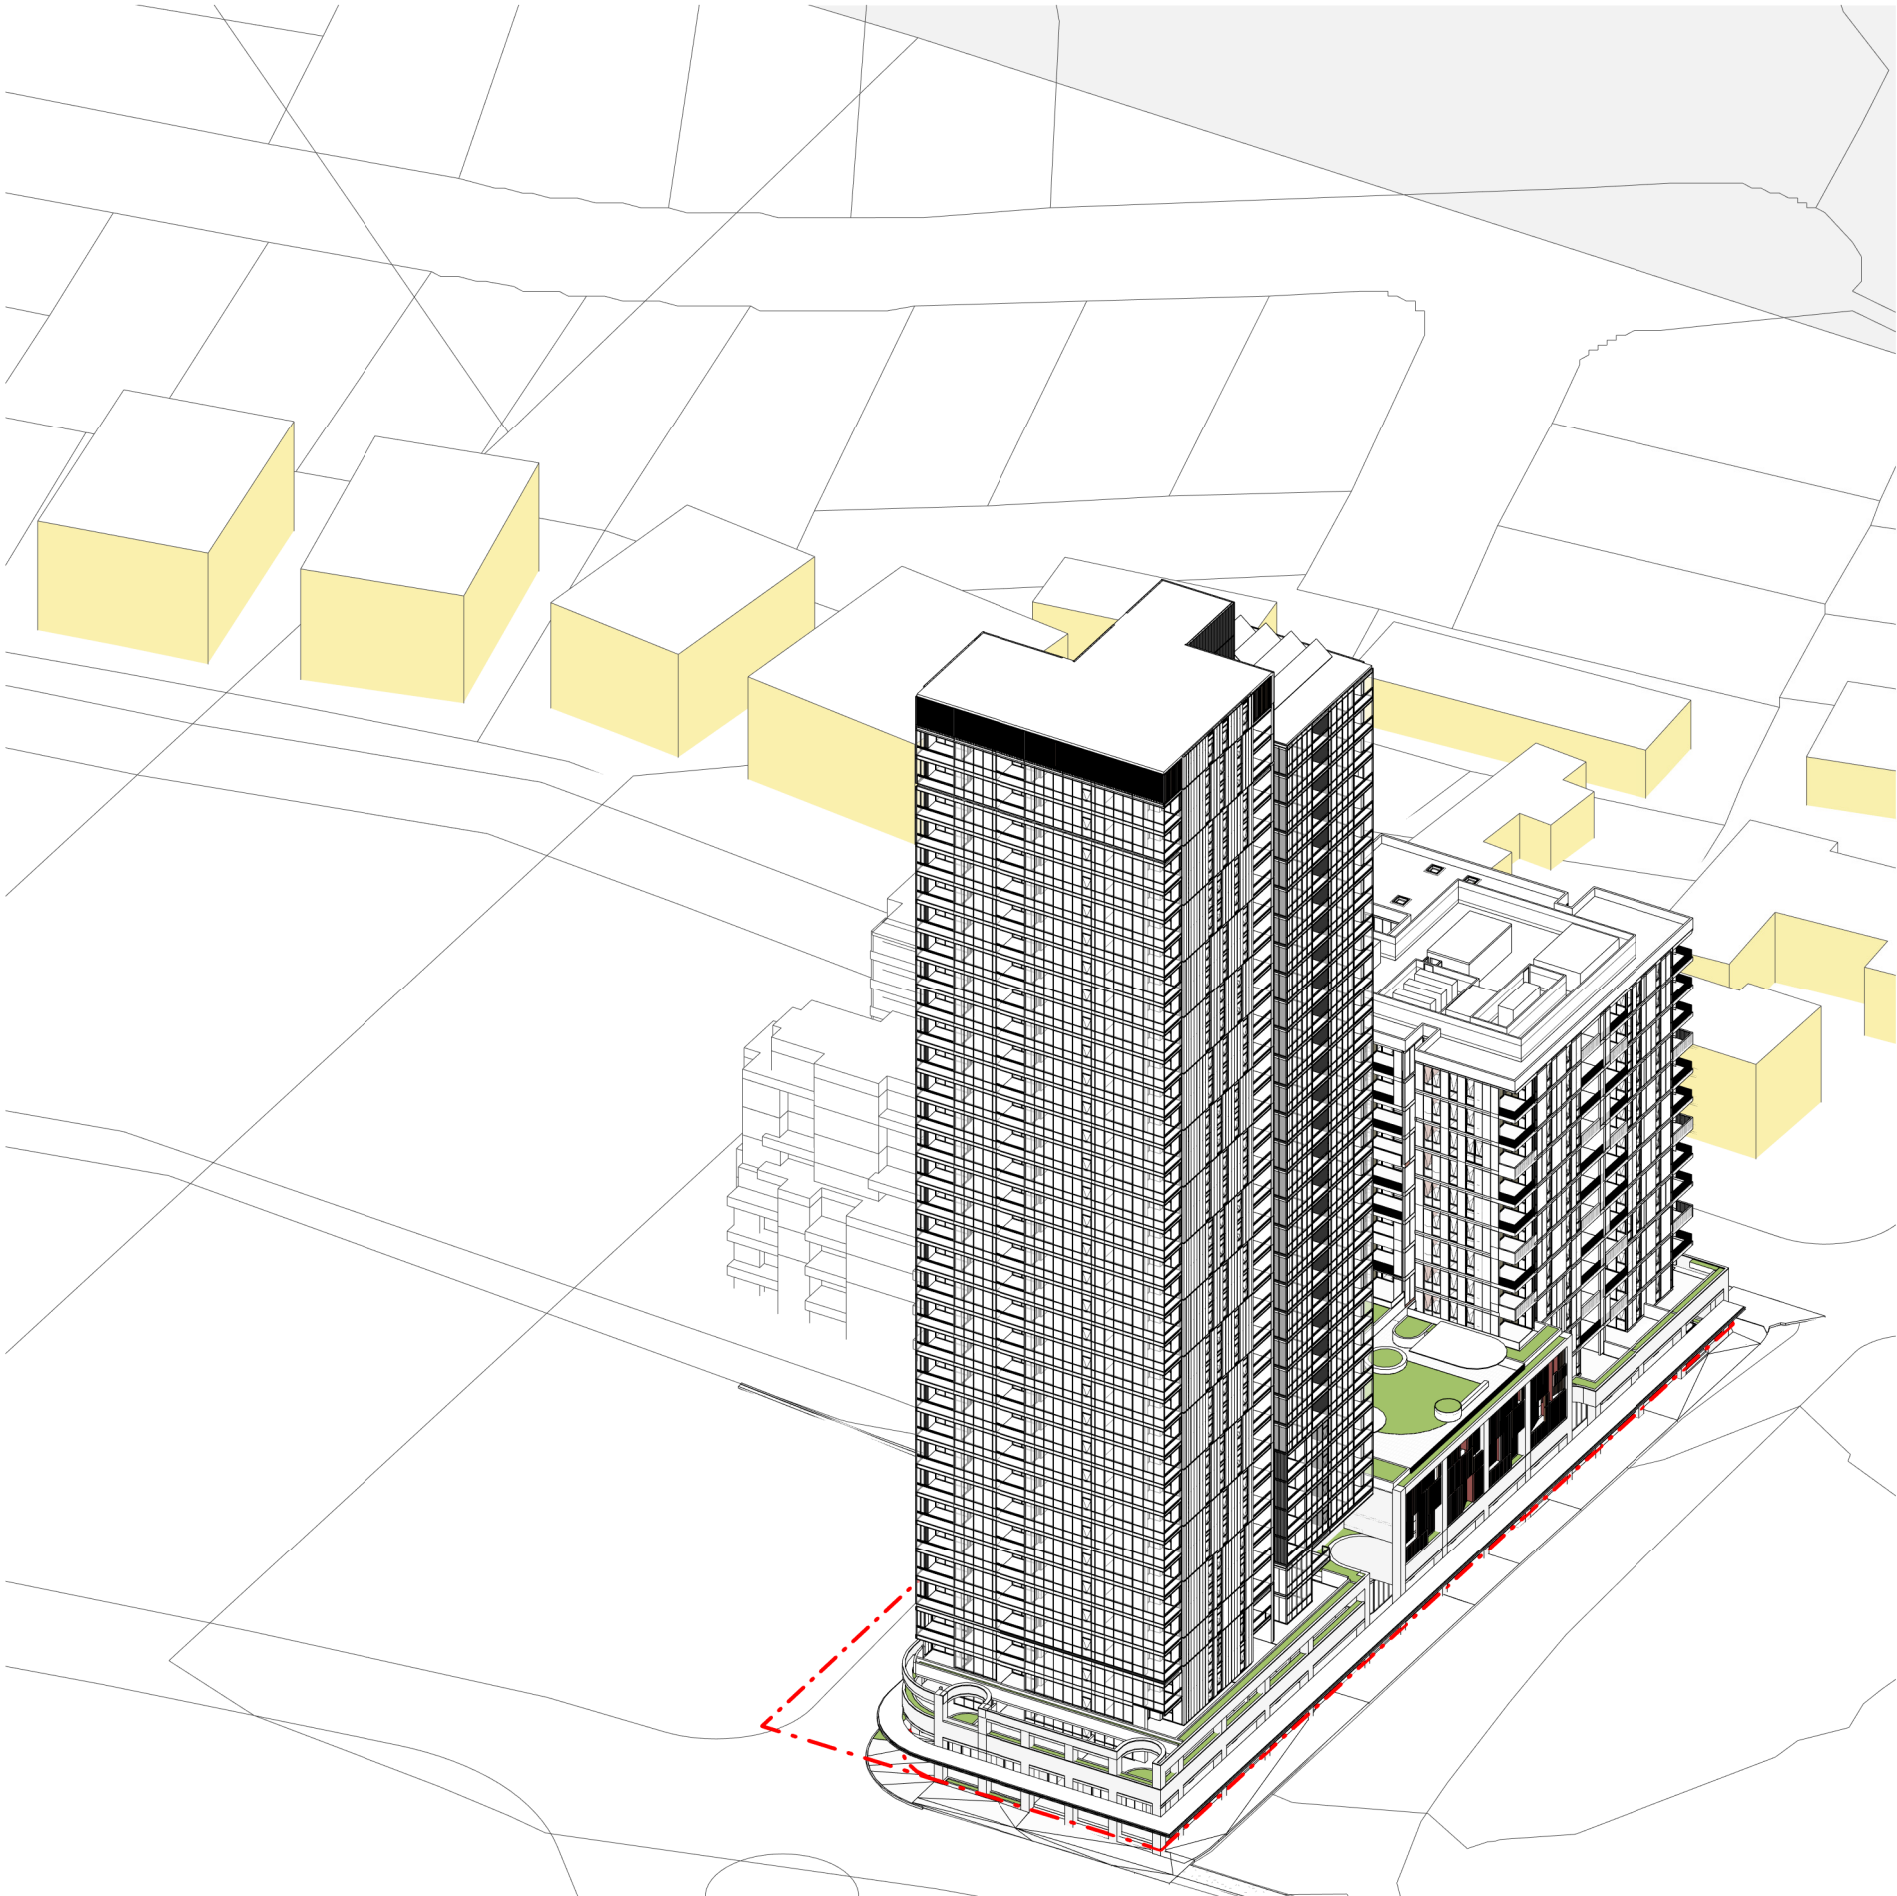

04 SOLAR VIEW - 12pm  
@A1

In accepting and utilising this document the recipient agrees that SJB Architecture (NSW) Pty. Ltd. ACN 081 094 724 T/A SJB Architects, retain all common law, statutory law and other rights including copyright and intellectual property rights. The recipient agrees not to use this document for any purpose other than its intended use, to waive all claims against SJB Architects resulting from unauthorised changes; or to reuse the document on other projects without the prior written consent of SJB Architects. Under no circumstances shall transfer of this document be deemed a sale. SJB Architects makes no warranties of fitness for any purpose. The Builder/Contractor shall verify job dimensions prior to any work commencing. Use figured dimensions only. Do not scale drawings.

Nominated Architects: Adam Haddow-7188 | John Pradel-7004

FOR APPROVAL

Rev	Date	Revision
66	24.01.2020	PRELIMINARY ISSUE
81	28.02.2020	DRAFT DA ISSUE
83	04.03.2020	ISSUED FOR DA
85	07.05.2021	ISSUED FOR DA
86	04.10.2021	ISSUED FOR LEC

Structural Engineer  
ROBERT BIRD GROUP

Mechanical / Hydraulic Engineer  
JHA CONSULTING ENGINEERS

Electrical Engineer  
JHA CONSULTING ENGINEERS

Fire Engineer  
OLSSON FIRE & RISK

Access Consultant  
ACCESSIBLE BUILDING SOLUTIONS

Basix  
EMF GRIFFITHS

Building Key



Project  
HIGH ST DEVELOPMENT

634-638 HIGH ST & 87-89  
UNION RD, PENRITH

Drawing Name  
SOLAR VIEWS - SHEET 01

Date  
04.10.2021

Scale  
@ A1

Drawn  
CC

Chk.  
MG

Job No.  
6111

Drawing No.  
AR-1-8052

Revision  
/86


SJB Architects  
Level 2  
490 Crown Street  
Surry Hills NSW  
2010 Australia  
T 61 2 9380 9911  
F 61 2 9380 9922  
www.sjb.com.au








01 SOLAR VIEW - 1pm  
@A1

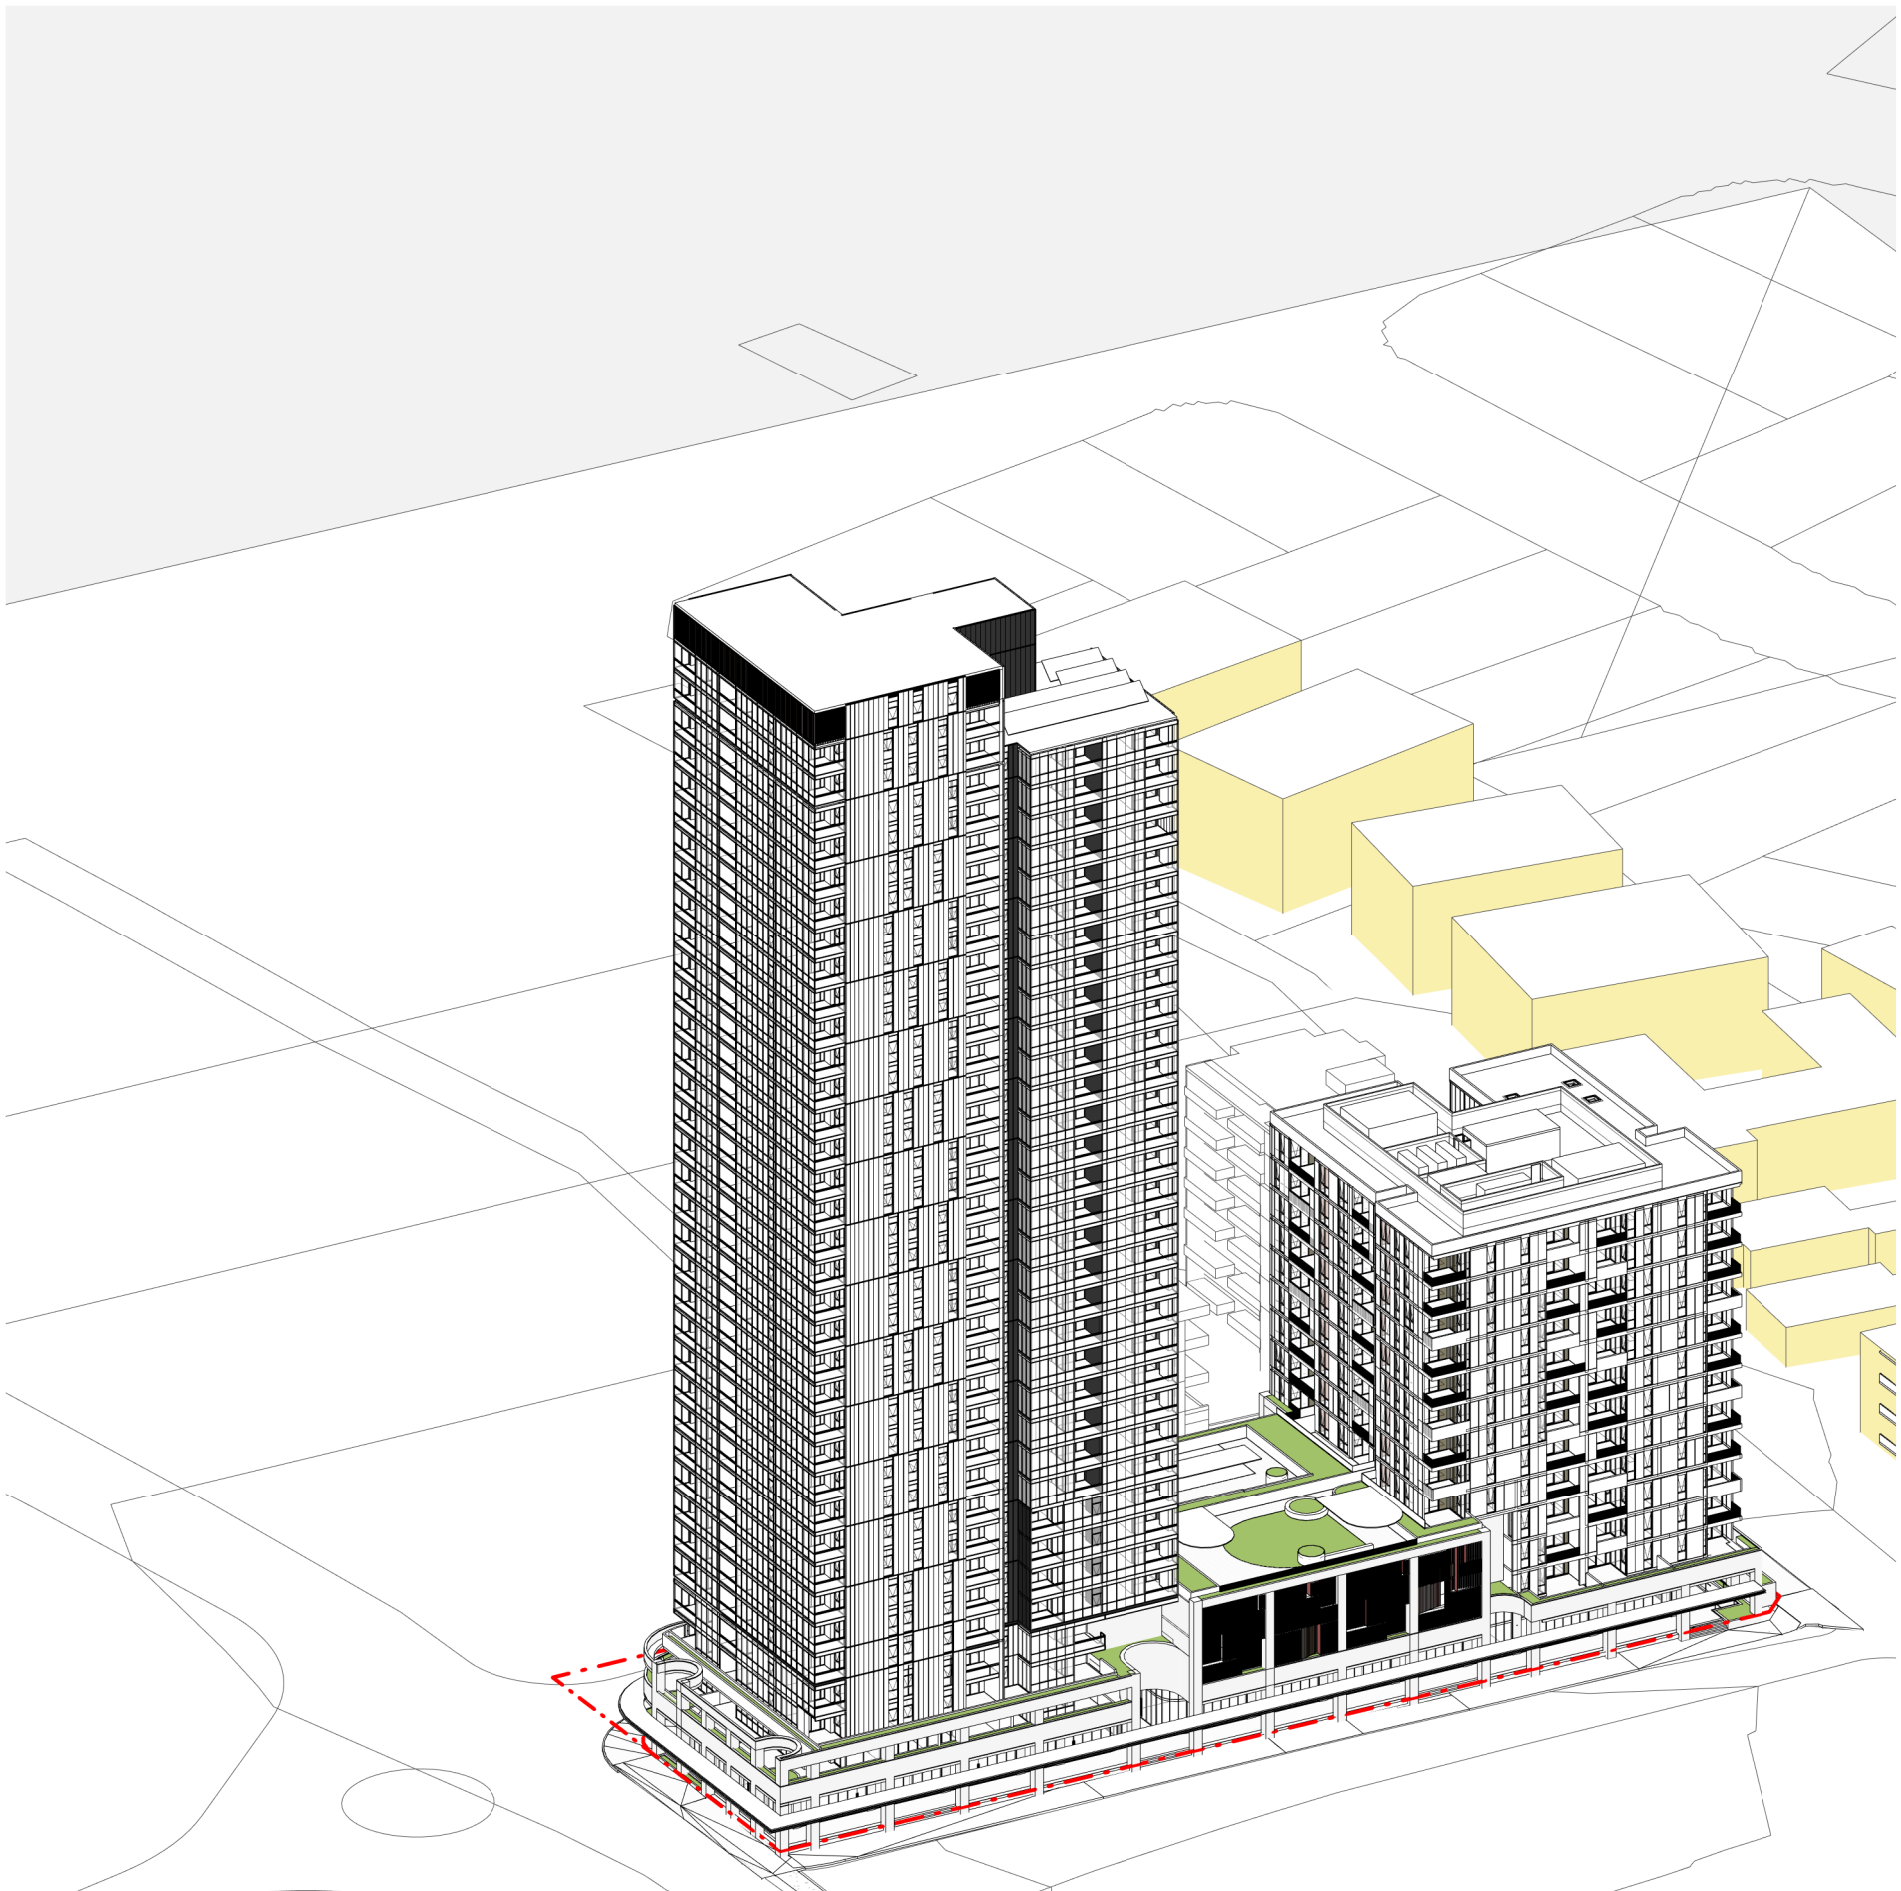

02 SOLAR VIEW - 2pm  
@A1

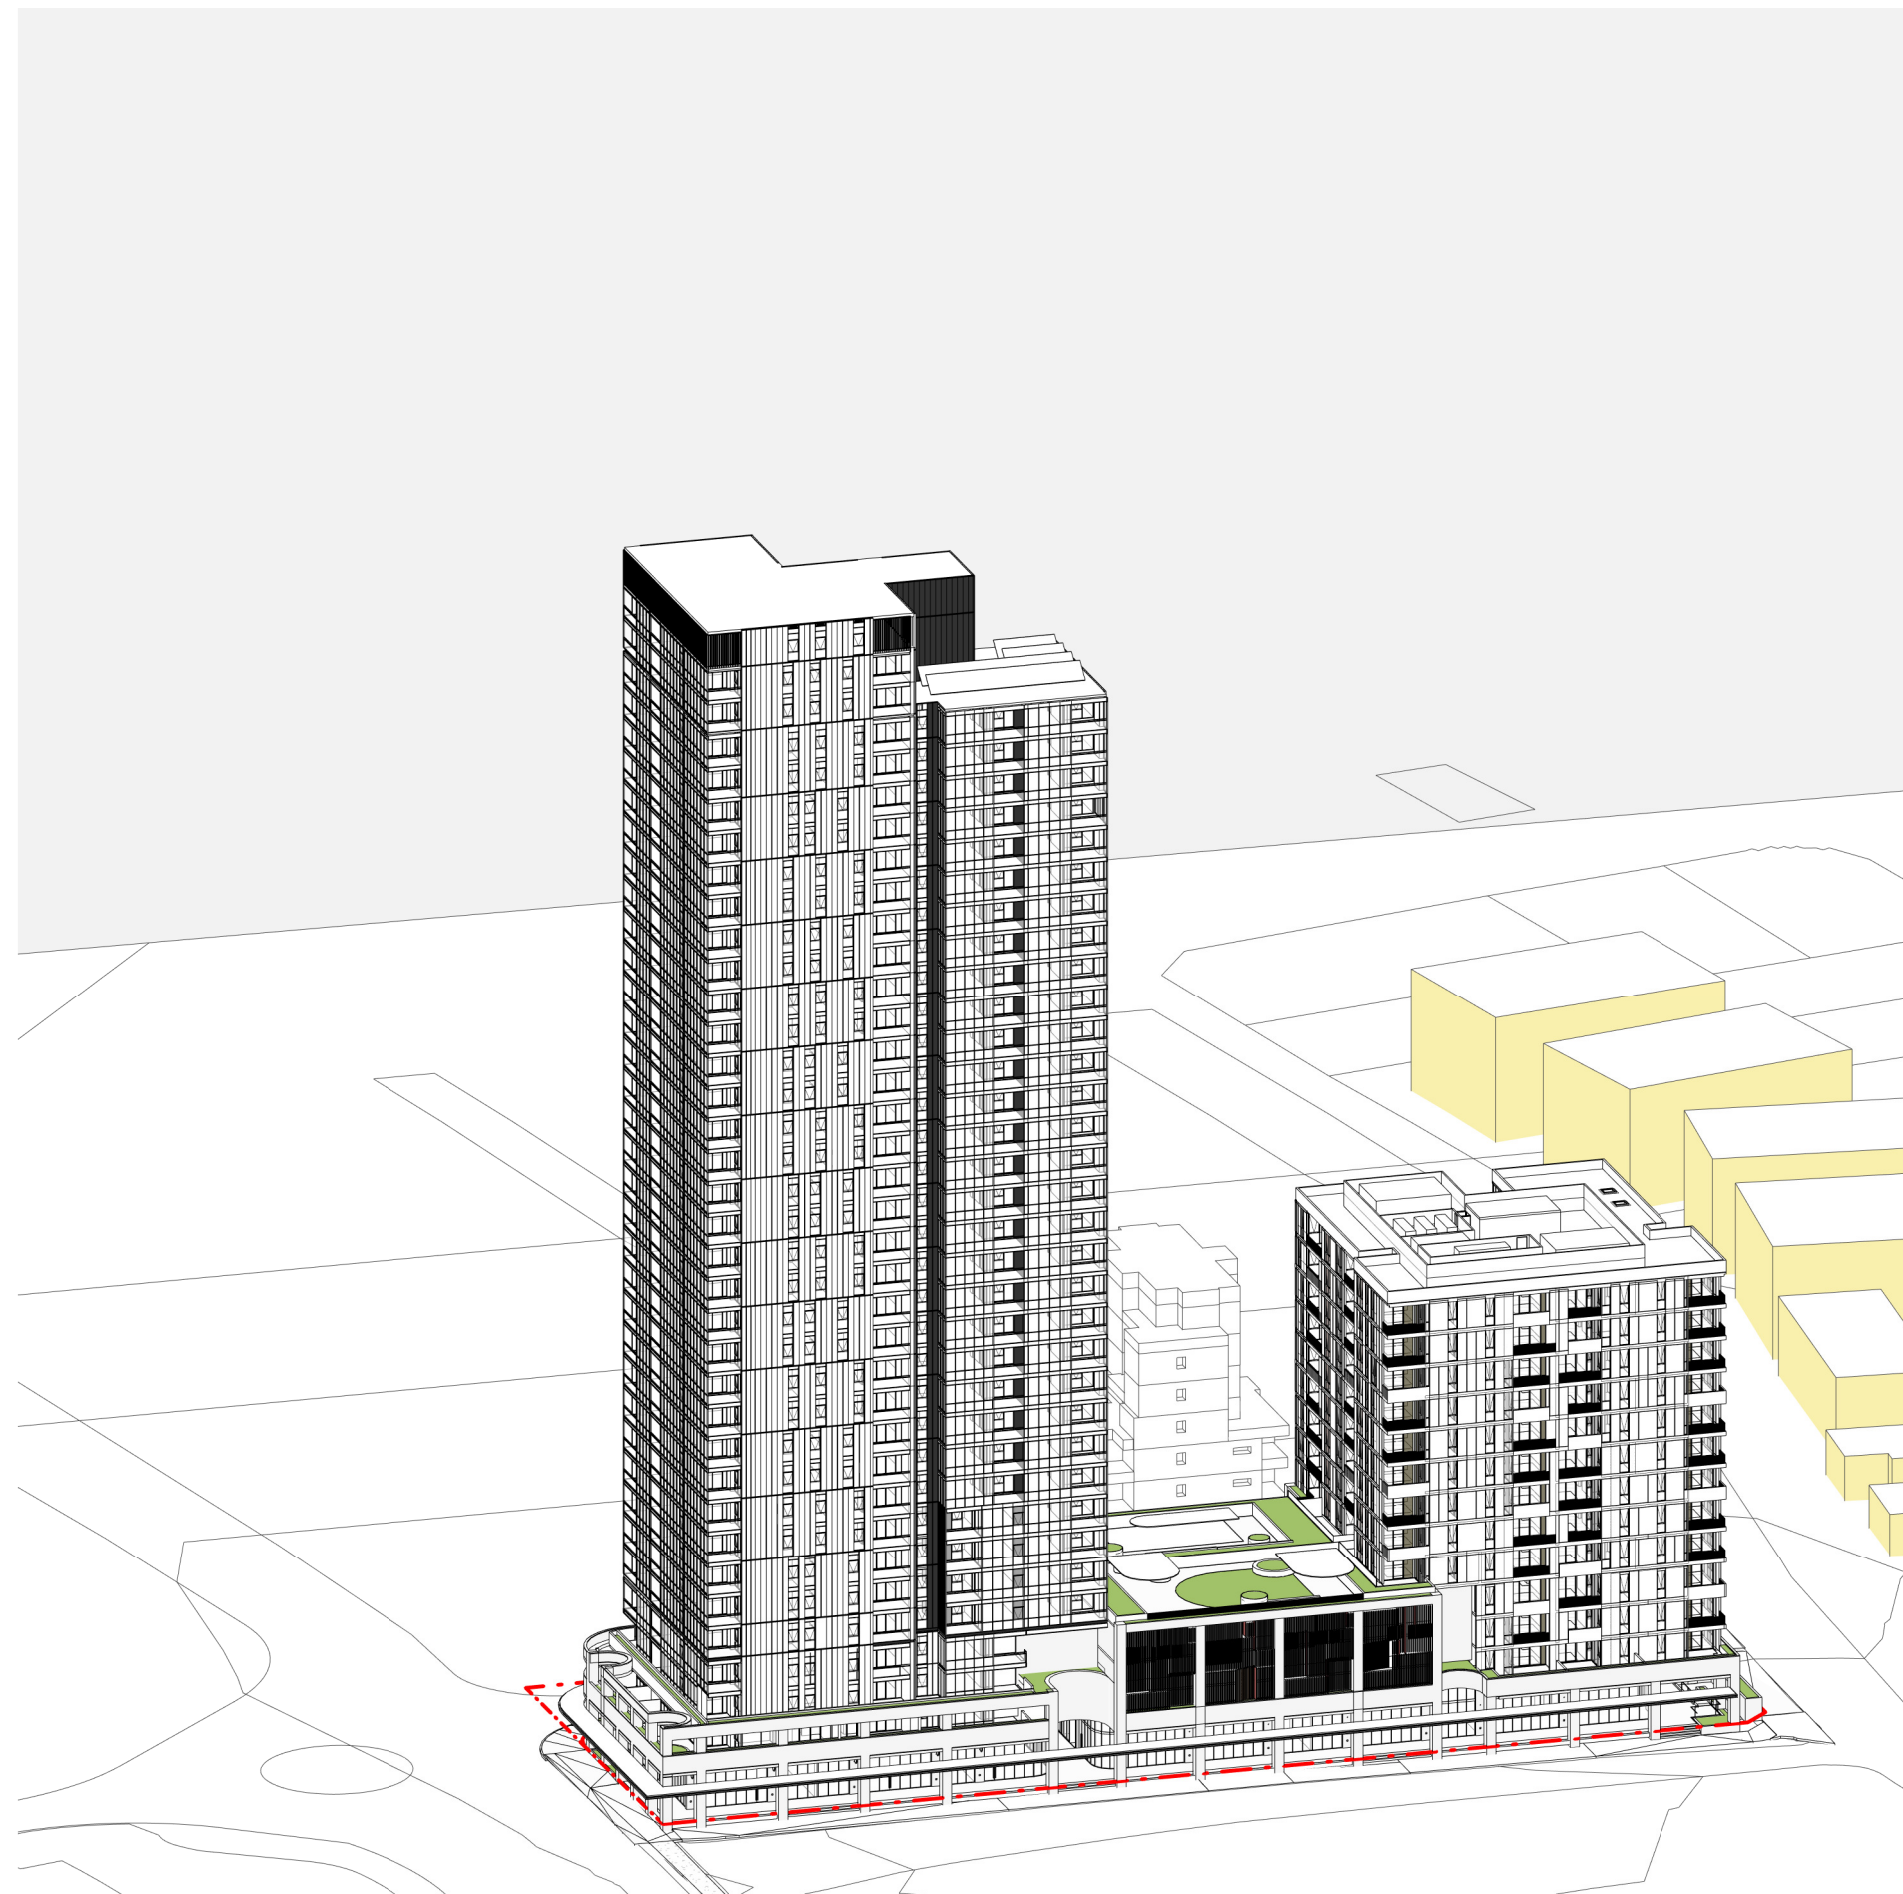

03 SOLAR VIEW - 3pm  
@A1

In accepting and utilising this document the recipient agrees that SJB Architecture (NSW) Pty. Ltd. ACN 081 094 724 T/A SJB Architects, retain all common law, statutory law and other rights including copyright and intellectual property rights. The recipient agrees not to use this document for any purpose other than its intended use; to waive all claims against SJB Architects resulting from unauthorised changes; or to reuse the document on other projects without the prior written consent of SJB Architects. Under no circumstances shall transfer of this document be deemed a sale. SJB Architects makes no warranties of fitness for any purpose. The Builder/Contractor shall verify job dimensions prior to any work commencing. Use figured dimensions only. Do not scale drawings.

Nominated Architects: Adam Haddow-7188 | John Pradel-7004

FOR APPROVAL

Rev	Date	Revision
66	24.01.2020	PRELIMINARY ISSUE
81	28.02.2020	DRAFT DA ISSUE
83	04.03.2020	ISSUED FOR DA
85	07.05.2021	ISSUED FOR DA
86	04.10.2021	ISSUED FOR LEC

Structural Engineer
ROBERT BIRD GROUP
Mechanical / Hydraulic Engineer
JHA CONSULTING ENGINEERS
Electrical Engineer
JHA CONSULTING ENGINEERS
Fire Engineer
OLSSON FIRE & RISK
Access Consultant
ACCESSIBLE BUILDING SOLUTIONS
Basix
EMF GRIFFITHS
Building Key

Client




Project

HIGH ST DEVELOPMENT

634-638 HIGH ST & 87-89  
UNION RD, PENRITH

Drawing Name

SOLAR VIEWS - SHEET 02

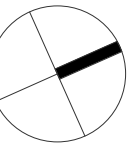


Date 04.10.2021 Scale Sheet Size @ A1

Drawn CC Chk. MG

Job No. 6111 Drawing No. AR-1-8053 Revision /86

SJB Architects  
Level 2  
490 Crown Street  
Surry Hills NSW  
2010 Australia  
T 61 2 9380 9911  
F 61 2 9380 9922  
www.sjb.com.au

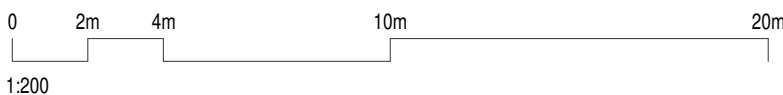



In accepting and utilising this document the recipient agrees that SJB Architects (NSW) Pty. Ltd. ACN 081 094 724 T/A SJB Architects, retain all common law, statutory law and other rights including copyright and intellectual property rights. The recipient agrees not to use this document for any purpose other than its intended use; to waive all claims against SJB Architects resulting from unauthorised changes; or to reuse the document on other projects without the prior written consent of SJB Architects. Under no circumstances shall transfer of this document be deemed a sale. SJB Architects makes no warranties of fitness for any purpose. The Builder/Contractor shall verify job dimensions prior to any work commencing. Use figured dimensions only. Do not scale drawings.

Nominated Architects: Adam Haddow-7188 | John Pradel-7004

FOR APPROVAL

Rev	Date	Revision
66	24.01.2020	PRELIMINARY ISSUE
81	28.02.2020	DRAFT DA ISSUE
83	04.03.2020	ISSUED FOR DA
85	07.05.2021	ISSUED FOR DA
86	04.10.2021	ISSUED FOR LEC

Structural Engineer  
ROBERT BIRD GROUP

Mechanical / Hydraulic Engineer  
JHA CONSULTING ENGINEERS

Electrical Engineer  
JHA CONSULTING ENGINEERS

Fire Engineer  
OLSSON FIRE & RISK

Access Consultant  
ACCESSIBLE BUILDING SOLUTIONS

Basix  
EMF GRIFFITHS

Building Key

Client




Project  
HIGH ST DEVELOPMENT

634-638 HIGH ST & 87-89  
UNION RD, PENRITH

Drawing Name

SHADOW ANALYSIS - 21 JUNE -  
9am & 10am

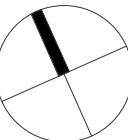


Date	Scale	Sheet Size
04.10.2021	1 : 1000	@ A1

Drawn	Chk.
CC	MG

Job No.	Drawing No.	Revision
6111	AR-1-8060	/86


SJB Architects  
Level 2  
490 Crown Street  
Surry Hills NSW  
2010 Australia  
T 61 2 9380 9911  
F 61 2 9380 9922  
www.sjb.com.au

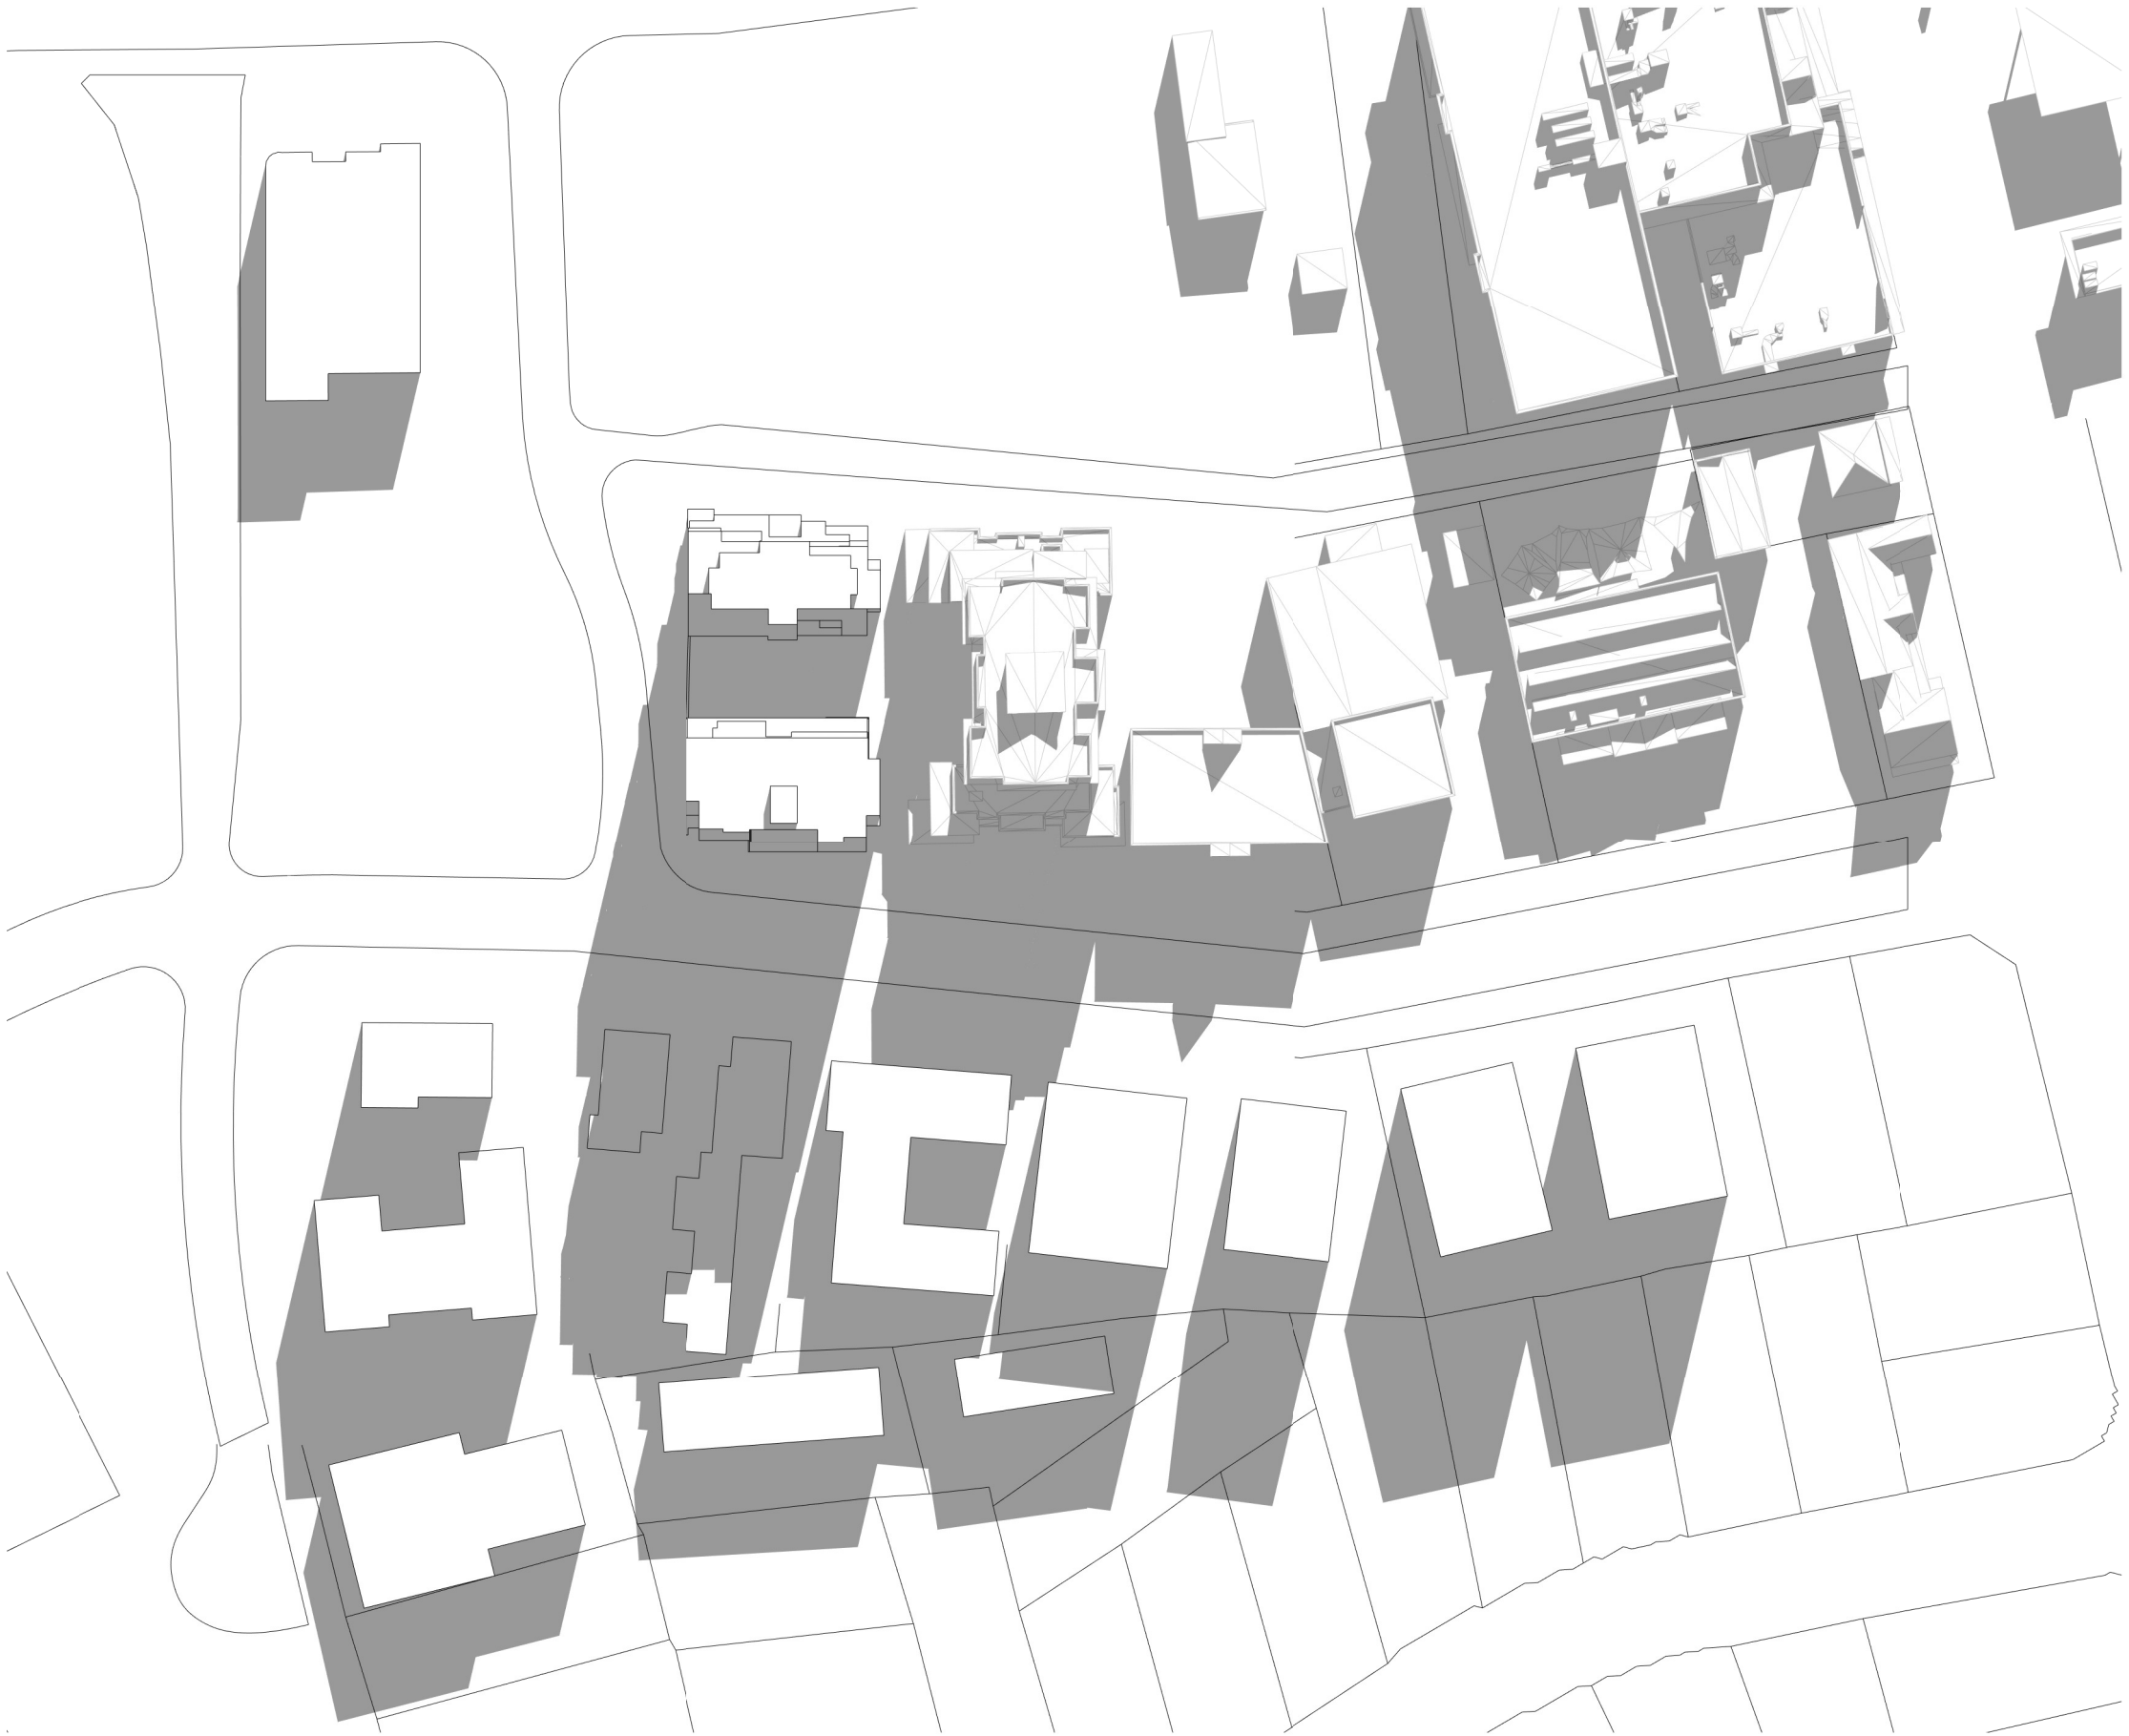

01 WINTER 9am - EXISTING  
1 : 1000@A1



03 WINTER 10am - EXISTING  
1 : 1000@A1

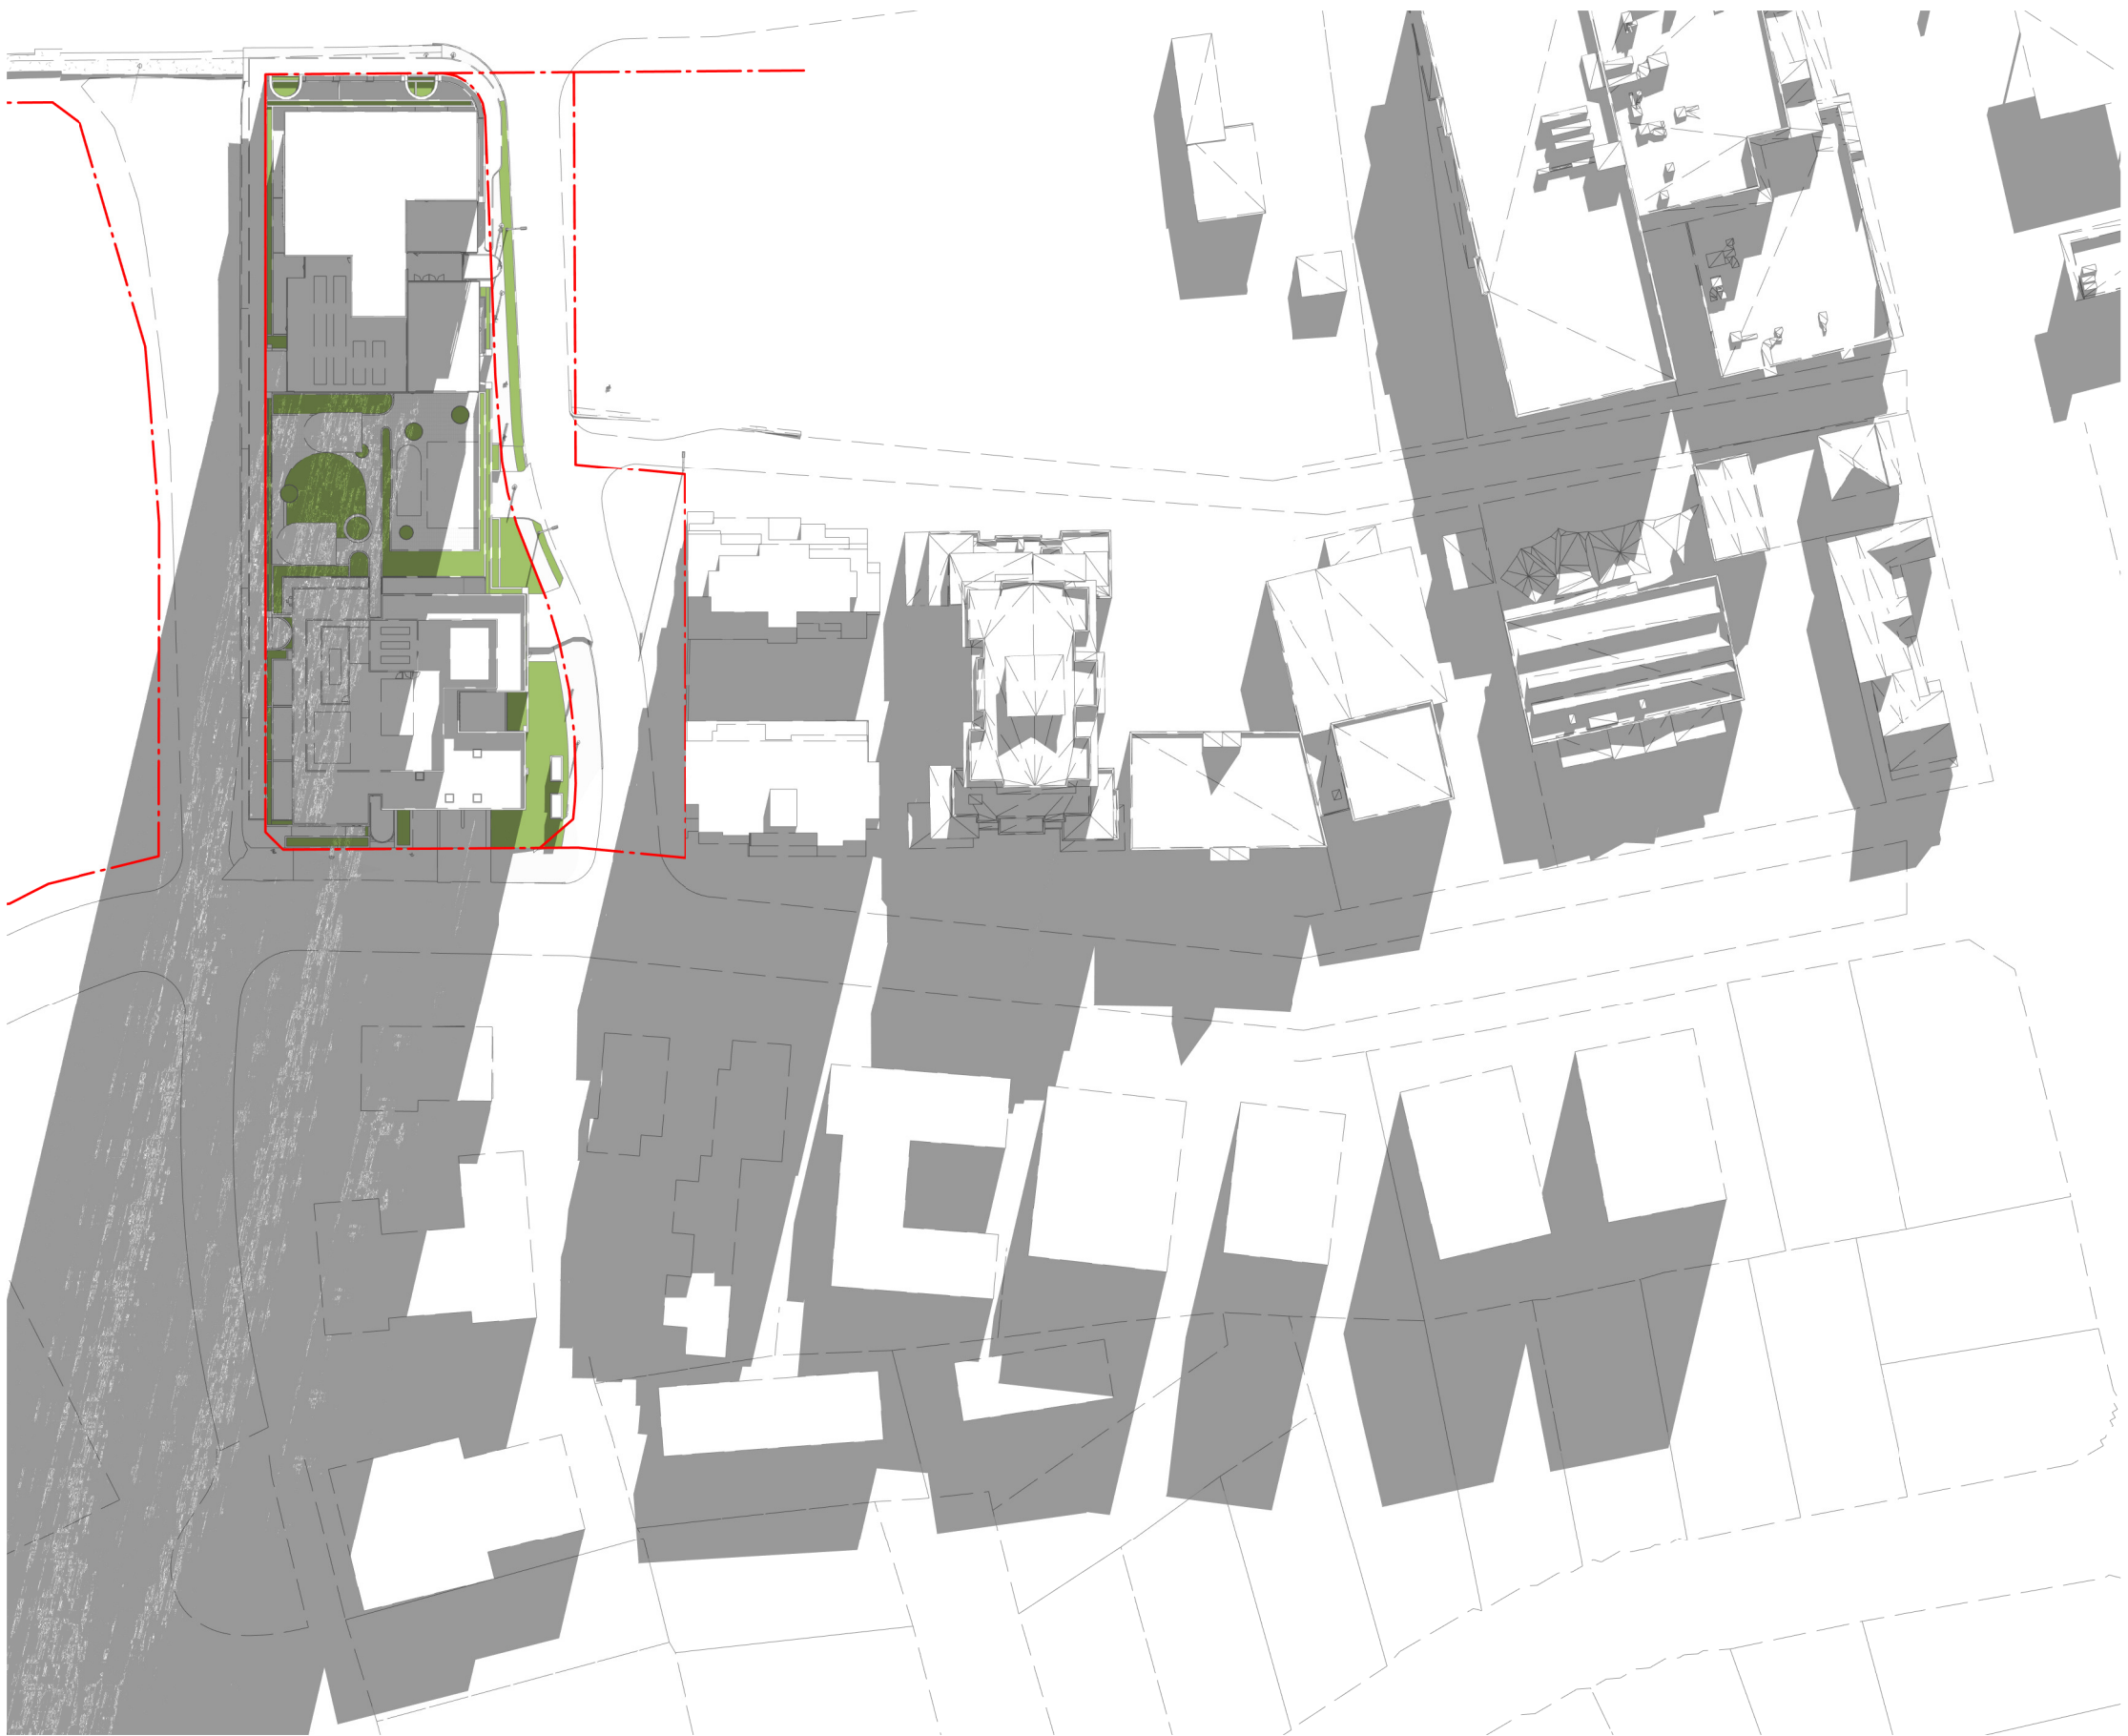

02 WINTER 9am - PROPOSED  
1 : 1000@A1



04 WINTER 10am - PROPOSED  
1 : 1000@A1



In accepting and utilising this document the recipient agrees that SJB Architecture (NSW) Pty. Ltd. ACN 081 094 724 T/A SJB Architects, retain all common law, statutory law and other rights including copyright and intellectual property rights. The recipient agrees not to use this document for any purpose other than its intended use; to waive all claims against SJB Architects resulting from unauthorised changes; or to reuse the document on other projects without the prior written consent of SJB Architects. Under no circumstances shall transfer of this document be deemed a sale. SJB Architects makes no warranties of fitness for any purpose. The Builder/Contractor shall verify job dimensions prior to any work commencing. Use figured dimensions only. Do not scale drawings.

Nominated Architects: Adam Haddow-7188 | John Pradel-7004

FOR APPROVAL

Rev	Date	Revision
66	24.01.2020	PRELIMINARY ISSUE
81	28.02.2020	DRAFT DA ISSUE
83	04.03.2020	ISSUED FOR DA
85	07.05.2021	ISSUED FOR DA
86	04.10.2021	ISSUED FOR LEC

Structural Engineer  
ROBERT BIRD GROUP

Mechanical / Hydraulic Engineer  
JHA CONSULTING ENGINEERS

Electrical Engineer  
JHA CONSULTING ENGINEERS

Fire Engineer  
OLSSON FIRE & RISK

Access Consultant  
ACCESSIBLE BUILDING SOLUTIONS

Basix  
EMF GRIFFITHS

Building Key


Client



Project  
HIGH ST DEVELOPMENT

634-638 HIGH ST & 87-89  
UNION RD, PENRITH

Drawing Name  
SHADOW ANALYSIS - 21 JUNE -  
11am & 12pm

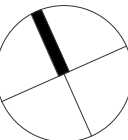

Date	Scale	Sheet Size
04.10.2021	1 : 1000	@ A1

Drawn	Chk.
CC	MG

Job No.	Drawing No.	Revision
6111	AR-1-8062	/86

SJB Architects  
Level 2  
490 Crown Street  
Surry Hills NSW  
2010 Australia  
T 61 2 9380 9911  
F 61 2 9380 9922  
www.sjb.com.au



01 WINTER 11am - EXISTING  
1 : 1000@A1



03 WINTER 12pm - EXISTING  
1 : 1000@A1



02 WINTER 11am - PROPOSED  
1 : 1000@A1



04 WINTER 12pm - PROPOSED  
1 : 1000@A1



In accepting and utilising this document the recipient agrees that SJB Architects (NSW) Pty. Ltd. ACN 081 094 724 T/A SJB Architects, retain all common law, statutory law and other rights including copyright and intellectual property rights. The recipient agrees not to use this document for any purpose other than its intended use; to waive all claims against SJB Architects resulting from unauthorised changes; or to reuse the document on other projects without the prior written consent of SJB Architects. Under no circumstances shall transfer of this document be deemed a sale. SJB Architects makes no warranties of fitness for any purpose. The Builder/Contractor shall verify job dimensions prior to any work commencing. Use figured dimensions only. Do not scale drawings.

Nominated Architects: Adam Haddow-7188 | John Pradel-7004

FOR APPROVAL

Rev	Date	Revision
66	24.01.2020	PRELIMINARY ISSUE
81	28.02.2020	DRAFT DA ISSUE
83	04.03.2020	ISSUED FOR DA
85	07.05.2021	ISSUED FOR DA
86	04.10.2021	ISSUED FOR LEC

Structural Engineer  
ROBERT BIRD GROUP

Mechanical / Hydraulic Engineer  
JHA CONSULTING ENGINEERS

Electrical Engineer  
JHA CONSULTING ENGINEERS

Fire Engineer  
OLSSON FIRE & RISK

Access Consultant  
ACCESSIBLE BUILDING SOLUTIONS

Basix  
EMF GRIFFITHS

Building Key


Client



Project  
HIGH ST DEVELOPMENT

634-638 HIGH ST & 87-89  
UNION RD, PENRITH

Drawing Name  
SHADOW ANALYSIS - 21 JUNE -  
1pm & 2pm

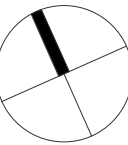

Date	Scale	Sheet Size
04.10.2021	1 : 1000	@ A1

Drawn	Chk.
CC	MG

Job No.	Drawing No.	Revision
6111	AR-1-8064	/86

SJB Architects  
Level 2  
490 Crown Street  
Surry Hills NSW  
2010 Australia  
T 61 2 9380 9911  
F 61 2 9380 9922  
www.sjb.com.au



01 WINTER 1pm - EXISTING  
1 : 1000@A1



03 WINTER 2pm -EXISTING  
1 : 1000@A1



02 WINTER 1pm - PROPOSED  
1 : 1000@A1



04 WINTER 2pm - PROPOSED  
1 : 1000@A1





01 WINTER 3pm - EXISTING  
1 : 1000@A1



02 WINTER 3pm - PROPOSED  
1 : 1000@A1

In accepting and utilising this document the recipient agrees that SJB Architecture (NSW) Pty. Ltd. ACN 081 094 724 T/A SJB Architects, retain all common law, statutory law and other rights including copyright and intellectual property rights. The recipient agrees not to use this document for any purpose other than its intended use; to waive all claims against SJB Architects resulting from unauthorised changes; or to reuse the document on other projects without the prior written consent of SJB Architects. Under no circumstances shall transfer of this document be deemed a sale. SJB Architects makes no warranties of fitness for any purpose. The Builder/Contractor shall verify job dimensions prior to any work commencing. Use figured dimensions only. Do not scale drawings.

Nominated Architects: Adam Haddow-7188 | John Pradel-7004

FOR APPROVAL

Rev	Date	Revision
66	24.01.2020	PRELIMINARY ISSUE
81	28.02.2020	DRAFT DA ISSUE
83	04.03.2020	ISSUED FOR DA
85	07.05.2021	ISSUED FOR DA
86	04.10.2021	ISSUED FOR LEC

Structural Engineer

ROBERT BIRD GROUP

Mechanical / Hydraulic Engineer

JHA CONSULTING ENGINEERS

Electrical Engineer

JHA CONSULTING ENGINEERS

Fire Engineer

OLSSON FIRE & RISK

Access Consultant

ACCESSIBLE BUILDING SOLUTIONS

Basix

EMF GRIFFITHS

Building Key

Client




Project

HIGH ST DEVELOPMENT

634-638 HIGH ST & 87-89  
UNION RD, PENRITH

Drawing Name

SHADOW ANALYSIS - 21 JUNE -  
3pm

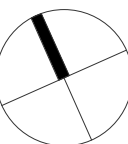

Date	Scale	Sheet Size
04.10.2021	1 : 1000	@ A1

Drawn	Chk.
-------	------

CC	MG
----	----

Job No.	Drawing No.	Revision
---------	-------------	----------

6111	AR-1-8066	/86
------	-----------	-----

SJB Architects  
Level 2  
490 Crown Street  
Surry Hills NSW  
2010 Australia  
T 61 2 9380 9911  
F 61 2 9380 9922  
www.sjb.com.au







View across John Tipping Grove looking east

In accepting and utilising this document the recipient agrees that SJB Architecture (NSW) Pty. Ltd. ACN 081 094 724 T/A SJB Architects, retain all common law, statutory law and other rights including copyright and intellectual property rights. The recipient agrees not to use this document for any purpose other than its intended use; to waive all claims against SJB Architects resulting from unauthorised changes; or to reuse the document on other projects without the prior written consent of SJB Architects. Under no circumstances shall transfer of this document be deemed a sale. SJB Architects makes no warranties of fitness for any purpose. The Builder/Contractor shall verify job dimensions prior to any work commencing. Use figured dimensions only. Do not scale drawings.

Nominated Architects: Adam Haddow-7188 | John Pradel-7004

FOR APPROVAL

Rev	Date	Revision
83	04.03.2020	ISSUED FOR DA
85	07.05.2021	ISSUED FOR DA
86	04.10.2021	ISSUED FOR LEC

Structural Engineer

ROBERT BIRD GROUP

Mechanical / Hydraulic Engineer

JHA CONSULTING ENGINEERS

Electrical Engineer

JHA CONSULTING ENGINEERS

Fire Engineer

OLSSON FIRE & RISK

Access Consultant

ACCESSIBLE BUILDING SOLUTIONS

Basix

EMF GRIFFITHS

Building Key

Client



Project

HIGH ST DEVELOPMENT

634-638 HIGH ST & 87-89  
UNION RD, PENRITH

Drawing Name

ARTIST IMPRESSION - SHEET 01

Date	Scale	Sheet Size
04.10.2021	1 : 1	@ A1

Drawn Chk.

GT MG

Job No. Drawing No. Revision

6111 AR-1-9000 /86

SJB Architects  
Level 2  
490 Crown Street  
Surry Hills NSW  
2010 Australia  
T 61 2 9380 9911  
F 61 2 9380 9922  
www.sjb.com.au







View along High Street looking east

In accepting and utilising this document the recipient agrees that SJB Architecture (NSW) Pty. Ltd. ACN 081 094 724 T/A SJB Architects, retain all common law, statutory law and other rights including copyright and intellectual property rights. The recipient agrees not to use this document for any purpose other than its intended use; to waive all claims against SJB Architects resulting from unauthorised changes; or to reuse the document on other projects without the prior written consent of SJB Architects. Under no circumstances shall transfer of this document be deemed a sale. SJB Architects makes no warranties of fitness for any purpose. The Builder/Contractor shall verify job dimensions prior to any work commencing. Use figured dimensions only. Do not scale drawings.

Nominated Architects: Adam Haddow-7188 | John Pradel-7004

FOR APPROVAL

Rev	Date	Revision
83	04.03.2020	ISSUED FOR DA
85	07.05.2021	ISSUED FOR DA
86	04.10.2021	ISSUED FOR LEC

Structural Engineer
ROBERT BIRD GROUP
Mechanical / Hydraulic Engineer
JHA CONSULTING ENGINEERS
Electrical Engineer
JHA CONSULTING ENGINEERS
Fire Engineer
OLSSON FIRE & RISK
Access Consultant
ACCESSIBLE BUILDING SOLUTIONS
Basix
EMF GRIFFITHS
Building Key

Client



Project

HIGH ST DEVELOPMENT

634-638 HIGH ST & 87-89  
UNION RD, PENRITH

Drawing Name

ARTIST IMPRESSION - SHEET 02

Date	Scale	Sheet Size
04.10.2021	1 : 1	@ A1

Drawn	Chk.
GT	MG

Job No.	Drawing No.	Revision
6111	AR-1-9001	/86

SJB Architects  
Level 2  
490 Crown Street  
Surry Hills NSW  
2010 Australia  
T 61 2 9380 9911  
F 61 2 9380 9922  
www.sjb.com.au







View Along High Street, looking west

In accepting and utilising this document the recipient agrees that SJB Architecture (NSW) Pty. Ltd. ACN 081 094 724 T/A SJB Architects, retain all common law, statutory law and other rights including copyright and intellectual property rights. The recipient agrees not to use this document for any purpose other than its intended use; to waive all claims against SJB Architects resulting from unauthorised changes; or to reuse the document on other projects without the prior written consent of SJB Architects. Under no circumstances shall transfer of this document be deemed a sale. SJB Architects makes no warranties of fitness for any purpose. The Builder/Contractor shall verify job dimensions prior to any work commencing. Use figured dimensions only. Do not scale drawings.

Nominated Architects: Adam Haddow-7188 | John Pradel-7004

FOR APPROVAL

Rev	Date	Revision
83	04.03.2020	ISSUED FOR DA
85	07.05.2021	ISSUED FOR DA
86	04.10.2021	ISSUED FOR LEC

Structural Engineer

ROBERT BIRD GROUP

Mechanical / Hydraulic Engineer

JHA CONSULTING ENGINEERS

Electrical Engineer

JHA CONSULTING ENGINEERS

Fire Engineer

OLSSON FIRE & RISK

Access Consultant

ACCESSIBLE BUILDING SOLUTIONS

Basix

EMF GRIFFITHS

Building Key

Client



Project

HIGH ST DEVELOPMENT

634-638 HIGH ST & 87-89  
UNION RD, PENRITH

Drawing Name

ARTIST IMPRESSION - SHEET 03

Date	Scale	Sheet Size
04.10.2021	1 : 1	@ A1

Drawn	Chk.
HL	NH

Job No.	Drawing No.	Revision
6111	AR-1-9002	/86

SJB Architects  
Level 2  
490 Crown Street  
Surry Hills NSW  
2010 Australia  
T 61 2 9380 9911  
F 61 2 9380 9922  
www.sjb.com.au







View Across Union Road, looking north

In accepting and utilising this document the recipient agrees that SJB Architecture (NSW) Pty. Ltd. ACN 081 094 724 T/A SJB Architects, retain all common law, statutory law and other rights including copyright and intellectual property rights. The recipient agrees not to use this document for any purpose other than its intended use; to waive all claims against SJB Architects resulting from unauthorised changes; or to reuse the document on other projects without the prior written consent of SJB Architects. Under no circumstances shall transfer of this document be deemed a sale. SJB Architects makes no warranties of fitness for any purpose. The Builder/Contractor shall verify job dimensions prior to any work commencing. Use figured dimensions only. Do not scale drawings.

Nominated Architects: Adam Haddow-7188 | John Pradel-7004

FOR APPROVAL

Rev	Date	Revision
83	04.03.2020	ISSUED FOR DA
85	07.05.2021	ISSUED FOR DA
86	04.10.2021	ISSUED FOR LEC

Structural Engineer
ROBERT BIRD GROUP
Mechanical / Hydraulic Engineer
JHA CONSULTING ENGINEERS
Electrical Engineer
JHA CONSULTING ENGINEERS
Fire Engineer
OLSSON FIRE & RISK
Access Consultant
ACCESSIBLE BUILDING SOLUTIONS
Basix
EMF GRIFFITHS
Building Key

Client



Project

HIGH ST DEVELOPMENT

634-638 HIGH ST & 87-89  
UNION RD, PENRITH

Drawing Name

ARTIST IMPRESSION - SHEET 04

Date	Scale	Sheet Size
04.10.2021	1 : 1	@ A1

Drawn	Chk.
HL	NH

Job No.	Drawing No.	Revision
6111	AR-1-9003	/86

SJB Architects  
Level 2  
490 Crown Street  
Surry Hills NSW  
2010 Australia  
T 61 2 9380 9911  
F 61 2 9380 9922  
www.sjb.com.au







New street View Ground Activation

In accepting and utilising this document the recipient agrees that SJB Architecture (NSW) Pty. Ltd. ACN 081 094 724 T/A SJB Architects, retain all common law, statutory law and other rights including copyright and intellectual property rights. The recipient agrees not to use this document for any purpose other than its intended use; to waive all claims against SJB Architects resulting from unauthorised changes; or to reuse the document on other projects without the prior written consent of SJB Architects. Under no circumstances shall transfer of this document be deemed a sale. SJB Architects makes no warranties of fitness for any purpose. The Builder/Contractor shall verify job dimensions prior to any work commencing. Use figured dimensions only. Do not scale drawings.

Nominated Architects: Adam Haddow-7188 | John Pradel-7004

FOR APPROVAL

Rev	Date	Revision
83	04.03.2020	ISSUED FOR DA
85	07.05.2021	ISSUED FOR DA
86	04.10.2021	ISSUED FOR LEC

Structural Engineer

ROBERT BIRD GROUP

Mechanical / Hydraulic Engineer

JHA CONSULTING ENGINEERS

Electrical Engineer

JHA CONSULTING ENGINEERS

Fire Engineer

OLSSON FIRE & RISK

Access Consultant

ACCESSIBLE BUILDING SOLUTIONS

Basix

EMF GRIFFITHS

Building Key

Client



Project

HIGH ST DEVELOPMENT

634-638 HIGH ST & 87-89  
UNION RD, PENRITH

Drawing Name

ARTIST IMPRESSION - SHEET 01

Date	Scale	Sheet Size
04.10.2021	1 : 1	@ A1

Drawn	Chk.
GT	MG

Job No.	Drawing No.	Revision
6111	AR-1-9004	/86

SJB Architects  
Level 2  
490 Crown Street  
Surry Hills NSW  
2010 Australia  
T 61 2 9380 9911  
F 61 2 9380 9922  
www.sjb.com.au







View along John Tipping Rd

In accepting and utilising this document the recipient agrees that SJB Architecture (NSW) Pty. Ltd. ACN 081 094 724 T/A SJB Architects, retain all common law, statutory law and other rights including copyright and intellectual property rights. The recipient agrees not to use this document for any purpose other than its intended use; to waive all claims against SJB Architects resulting from unauthorised changes; or to reuse the document on other projects without the prior written consent of SJB Architects. Under no circumstances shall transfer of this document be deemed a sale. SJB Architects makes no warranties of fitness for any purpose. The Builder/Contractor shall verify job dimensions prior to any work commencing. Use figured dimensions only. Do not scale drawings.

Nominated Architects: Adam Haddow-7188 | John Pradel-7004

FOR APPROVAL

Rev	Date	Revision
83	04.03.2020	ISSUED FOR DA
85	07.05.2021	ISSUED FOR DA
86	04.10.2021	ISSUED FOR LEC

Structural Engineer
ROBERT BIRD GROUP
Mechanical / Hydraulic Engineer
JHA CONSULTING ENGINEERS
Electrical Engineer
JHA CONSULTING ENGINEERS
Fire Engineer
OLSSON FIRE & RISK
Access Consultant
ACCESSIBLE BUILDING SOLUTIONS
Basix
EMF GRIFFITHS
Building Key

Client



Project

HIGH ST DEVELOPMENT

634-638 HIGH ST & 87-89  
UNION RD, PENRITH

Drawing Name

ARTIST IMPRESSION - SHEET 06

Date	Scale	Sheet Size
04.10.2021	1 : 1	@ A1

Drawn	Chk.
GT	MG

Job No.	Drawing No.	Revision
6111	AR-1-9005	/86



In accepting and utilising this document the recipient agrees that SJB Architecture (NSW) Pty. Ltd. ACN 081 094 724 T/A SJB Architects, retain all common law, statutory law and other rights including copyright and intellectual property rights. The recipient agrees not to use this document for any purpose other than its intended use, to waive all claims against SJB Architects resulting from unauthorised changes; or to reuse the document on other projects without the prior written consent of SJB Architects. Under no circumstances shall transfer of this document be deemed a sale. SJB Architects makes no warranties of fitness for any purpose. The Builder/Contractor shall verify job dimensions prior to any work commencing. Use figured dimensions only. Do not scale drawings.

Nominated Architects: Adam Haddow-7188 | John Pradel-7004

FOR APPROVAL

Rev	Date	Revision
84	16.09.2020	ISSUE FOR INFORMATION
85	07.05.2021	ISSUED FOR DA
86	04.10.2021	ISSUED FOR LEC

Structural Engineer

ROBERT BIRD GROUP

Mechanical / Hydraulic Engineer

JHA CONSULTING ENGINEERS

Electrical Engineer

JHA CONSULTING ENGINEERS

Fire Engineer

OLSSON FIRE & RISK

Access Consultant

ACCESSIBLE BUILDING SOLUTIONS

Basix

EMF GRIFFITHS

Building Key

- 1B S - STORAGE
- 1B + ST
- 2B/2BTH
- 2B
- 2B + ST/M
- 3B
- 1800mm PRIVACY SCREENS

Client



Project

HIGH ST DEVELOPMENT

634-638 HIGH ST & 87-89 UNION RD, PENRITH

Drawing Name

ADG COMPLIANCE PLAN - BLDG 1 TYPICAL PLAN

Date	Scale	Sheet Size
04.10.2021	As indicated	@ A1

Drawn	Chk.
JG	MG

Job No.	Drawing No.	Revision
6111	AR-1-9030	/86

SJB Architects  
Level 2  
490 Crown Street  
Surry Hills NSW  
2010 Australia  
T 61 2 9380 9911  
F 61 2 9380 9922  
www.sjb.com.au




STORAGE PROVIDED  
IN APARTMENT: 4.1M³  
  
STORAGE CAGE IN  
BASEMENT (50% MAX):  
4M³  
  
TOTAL PROVIDED: 8.1M³  
  
ADG REQ: 8 (M³)  
COMPLIES: Y

STORAGE PROVIDED  
IN APARTMENT: 5.4M³  
  
STORAGE CAGE IN  
BASEMENT (50% MAX):  
1M³  
  
TOTAL PROVIDED: 6.4M³  
  
ADG REQ: 6 (M³)  
COMPLIES: Y

STORAGE PROVIDED  
IN APARTMENT: 12.7M³  
  
STORAGE CAGE IN  
BASEMENT (50% MAX):  
N/A  
  
TOTAL PROVIDED: 12.7M³  
  
ADG REQ: 6 (M³)  
COMPLIES: Y

STORAGE PROVIDED  
IN APARTMENT: 4.1M³  
  
STORAGE CAGE IN  
BASEMENT (50% MAX):  
4M³  
  
TOTAL PROVIDED:  
8.1M³  
  
ADG REQ: 8 (M³)  
COMPLIES: Y

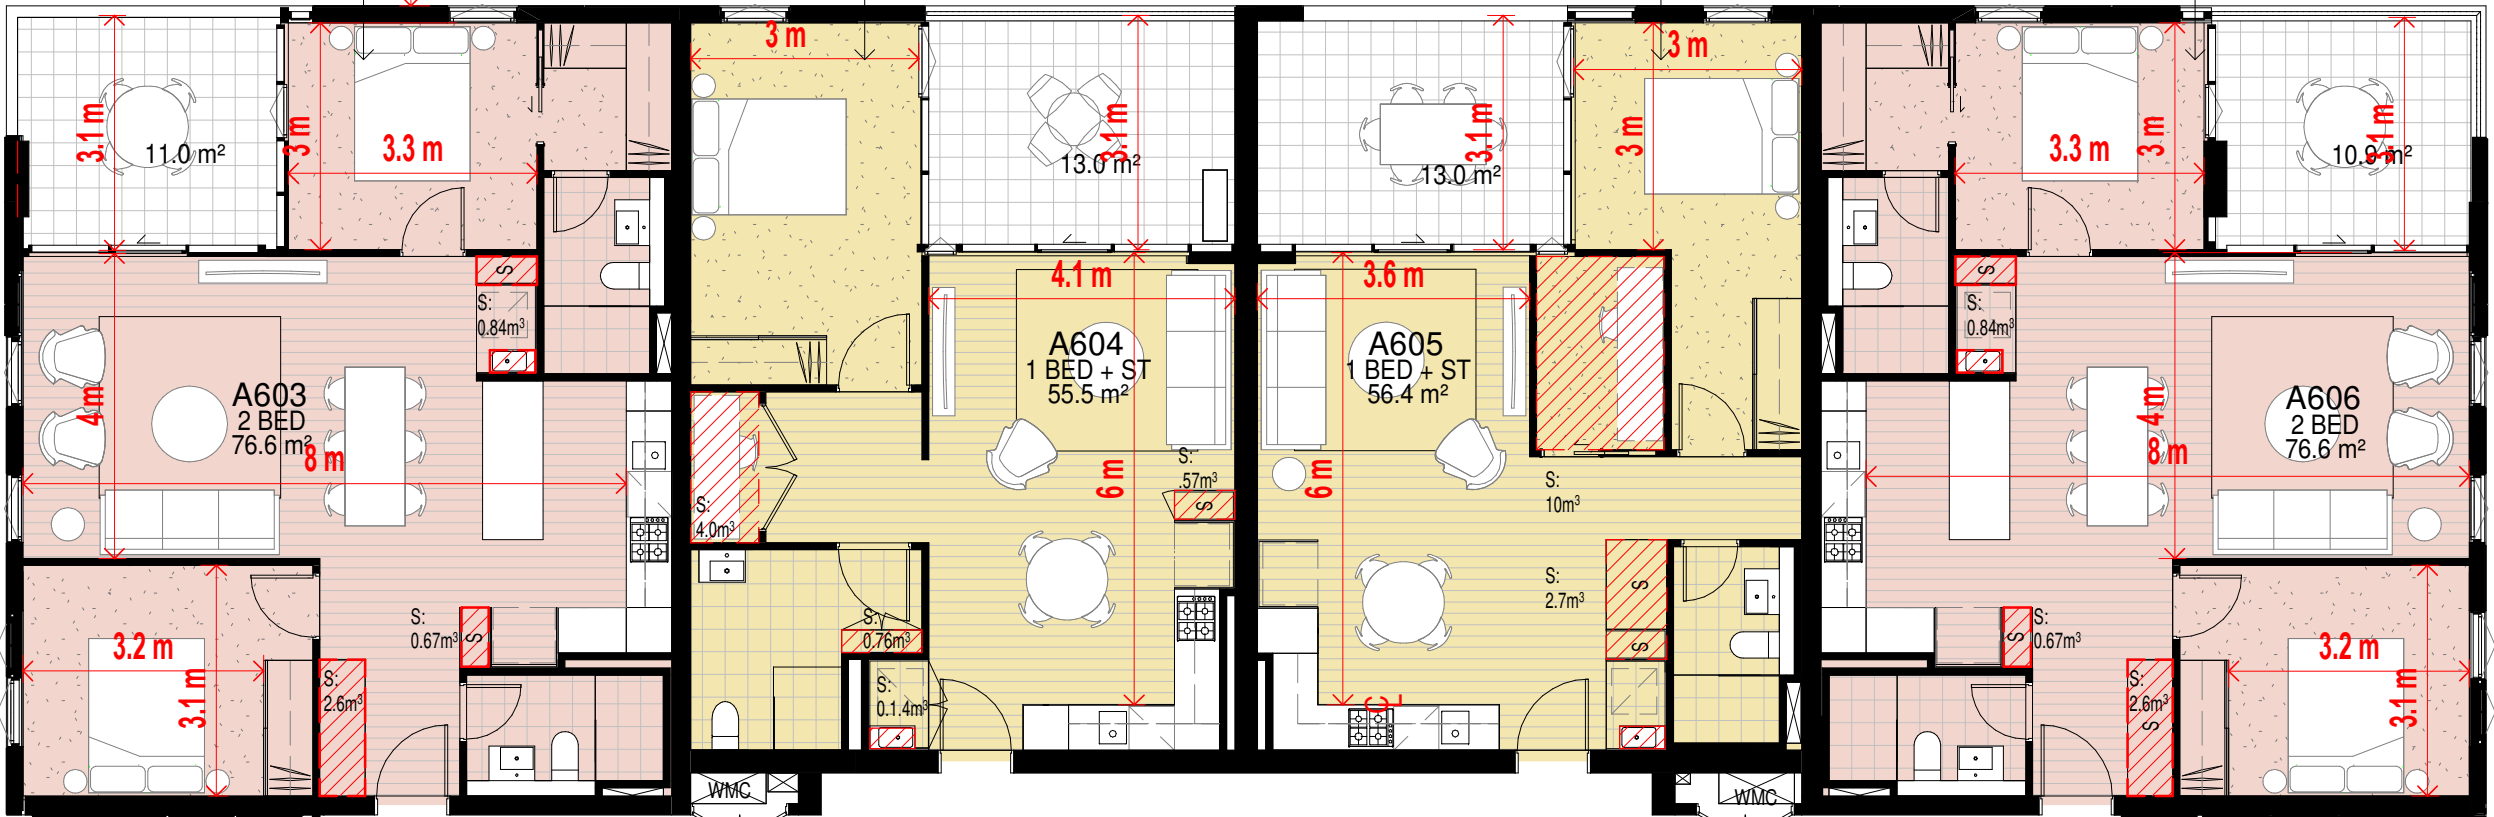

BUILDING 01  
+  
RL 48.800


STORAGE PROVIDED  
IN APARTMENT: 4.45M³  
  
STORAGE CAGE IN BASEMENT  
(50% MAX): 4M³  
  
TOTAL PROVIDED: 8.45M³  
  
ADG REQ: 8 (M³) COMPLIES: Y

STORAGE PROVIDED  
IN APARTMENT: 4.05M³  
  
STORAGE CAGE IN BASEMENT  
(50% MAX): 4M³  
  
TOTAL PROVIDED: 8.05M³  
  
ADG REQ: 8 (M³) COMPLIES: Y

STORAGE PROVIDED  
IN APARTMENT: 4M³  
  
STORAGE CAGE IN BASEMENT  
(50% MAX): 4M³  
  
TOTAL PROVIDED: 8.1M³  
  
ADG REQ: 8 (M³) COMPLIES: Y

STORAGE PROVIDED  
IN APARTMENT: 5.48M³  
  
STORAGE CAGE IN BASEMENT  
(50% MAX): 5M³  
  
TOTAL PROVIDED: 10.48M³  
  
ADG REQ: 10 (M³) COMPLIES: Y

1 BUILDING 1 TYPICAL  
AR-1-0102B 1: 100@A1

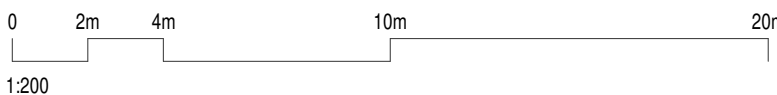



FOR APPROVAL

Rev	Date	Revision
84	16.09.2020	ISSUE FOR INFORMATION
85	07.05.2021	ISSUED FOR DA
86	04.10.2021	ISSUED FOR LEC

Structural Engineer

ROBERT BIRD GROUP

Mechanical / Hydraulic Engineer

JHA CONSULTING ENGINEERS

Electrical Engineer

JHA CONSULTING ENGINEERS

Fire Engineer

OLSSON FIRE & RISK

Access Consultant

ACCESSIBLE BUILDING SOLUTIONS

Basix

EMF GRIFFITHS

Building Key

- 1B S - STORAGE
- 1B + ST
- 2B/2BTH
- 2B
- 2B + ST/M
- 3B
- 1800mm PRIVACY SCREENS

Client



Project

HIGH ST DEVELOPMENT

634-638 HIGH ST & 87-89 UNION RD, PENRITH

Drawing Name



ADG COMPLIANCE PLAN - BLDG 2 TYPICAL PLAN

Date 04.10.2021 Scale As indicated Sheet Size @ A1

Drawn JG Chk. MG

Job No. 6111 Drawing No. AR-1-9031 /86 Revision

SJB Architects  
Level 2  
490 Crown Street  
Surry Hills NSW  
2010 Australia  
T 61 2 9380 9911  
F 61 2 9380 9922  
www.sjb.com.au

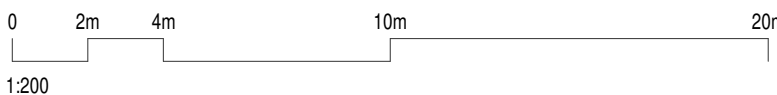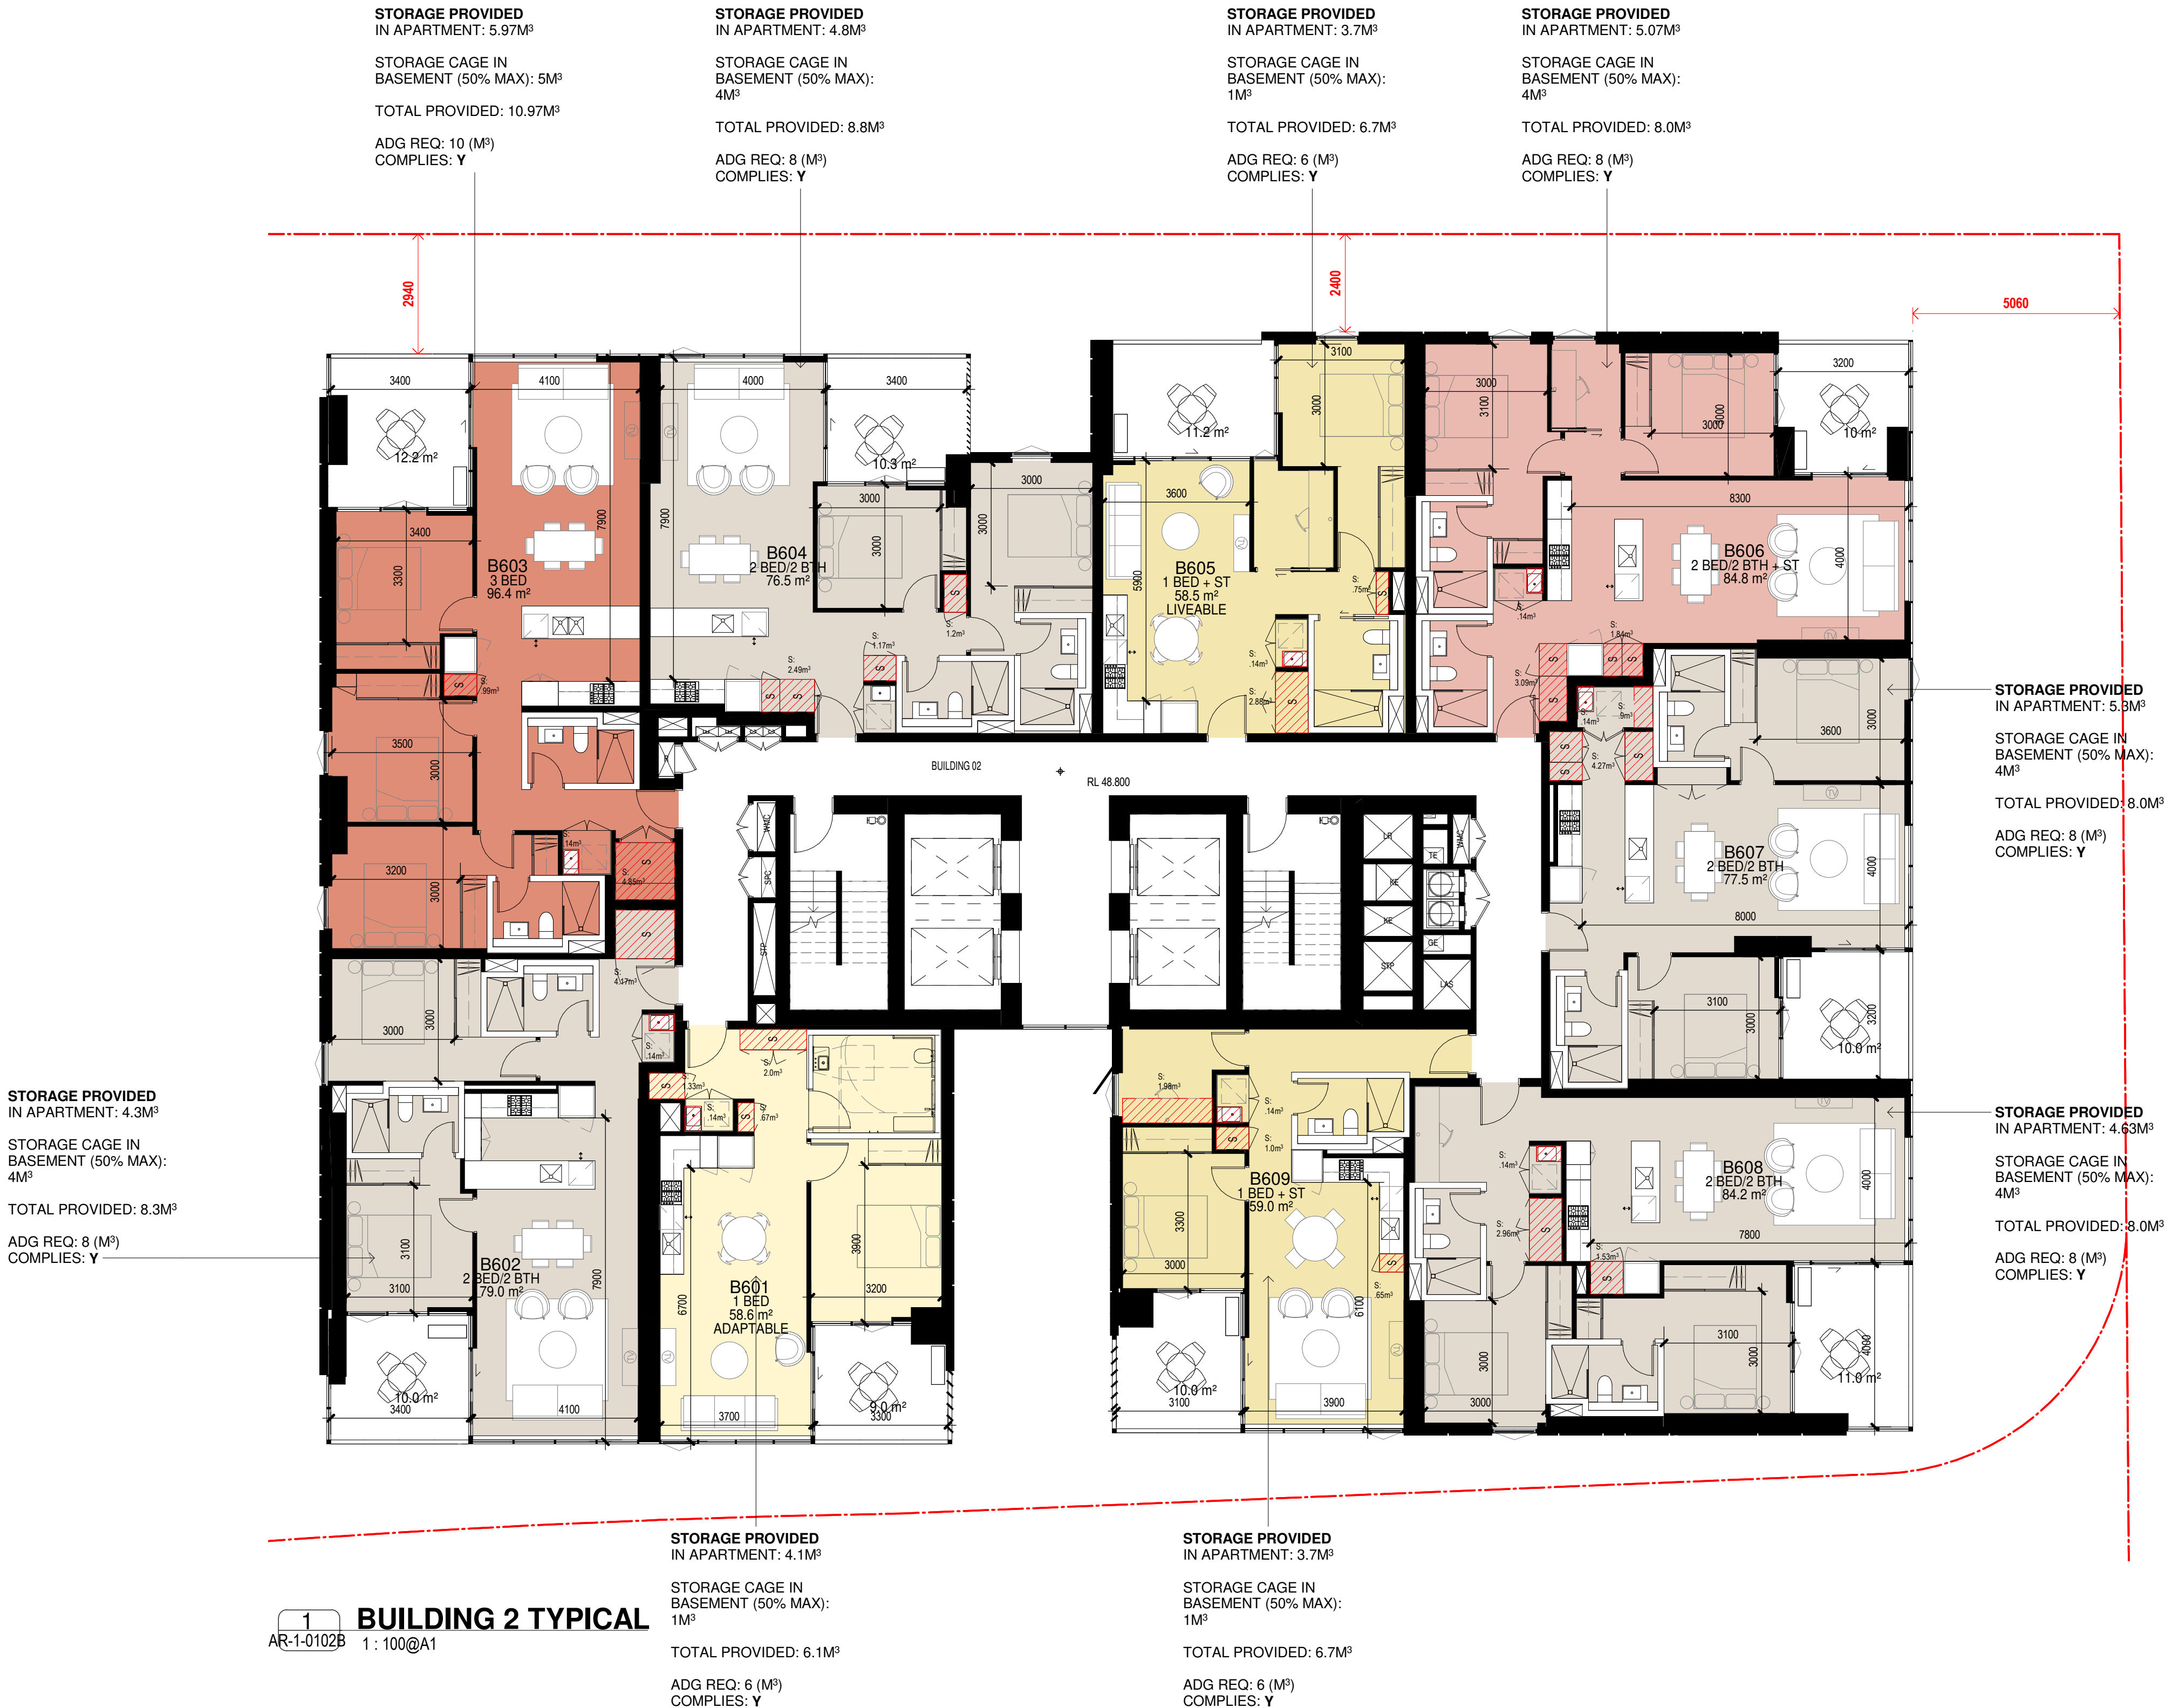



TOWER 02 - 35 STOREYS																			TOTALS	
GFA TOTALS PER BUILDING LEVEL	COMMERCIAL GFA GROUND LEVEL	NSA (m²)	GBA (m²)	STUDIO	1B	1B + ST	2B	2B + STUDY	3B	3B + ST	TOTALS	CROSS VENTILATION	SOLAR	<15 MIN SOLAR	ADAPTABLE	LIVABLE	Effic. GFA /GBA	Effic. NSA/GFA	GFA TOTAL PER LEVEL	APARTMENT PER LEVEL
663.1	595.0	595.0	2600.7								0								1600.6	0
431.0		366.0	3291.1		1	1	2	1			5	3	4			1			840.1	10
431.0		366.0	3201.0		1	1	2	1			5	3	4			1			840.1	10
431.0		366.0	2954.3		1	1	2	1			5	3	4	-		2			840.1	10
683.1		477.0	920.2			1	3	1	1		6	4	6	-		1	74%	70%	1385.1	14
705.0		615.0	920.2		1	1	4	1	1		8	6	6	-	1	1	77%	87%	1407.0	16
764.8		674.0	966		1	2	4	1	1		9	7	6	-	1	1	79%	88%	1466.8	17
771.6		672.0	966		1	2	4	1	1		9	7	6	-	1	1	80%	87%	1473.6	17
764.6		672.0	966		1	2	4	1	1		9	7	6	-	1	2	79%	88%	1466.6	17
764.6		672.0	966		1	2	4	1	1		9	6	-	1	2	79%	88%	1466.6	17	
764.6		672.0	966		1	2	4	1	1		9	6	-	1	2	79%	88%	1466.6	17	
762.0		672.0	966		1	2	4	1	1		9	6	-	1	2	79%	88%	1464.0	17	
762.0		672.0	966		1	2	4	1	1		9	6	-	1	1	79%	88%	762.0	9	
762.0		672.0	966		1	2	4	1	1		9	6	-	1	1	79%	88%	762.0	9	
762.0		672.0	966		1	2	4	1	1		9	6	-	1	1	79%	88%	762.0	9	
762.0		672.0	966		1	2	4	1	1		9	6	-	1	1	79%	88%	762.0	9	
762.0		672.0	966		1	2	4	1	1		9	6	-	1	1	79%	88%	762.0	9	
762.0		672.0	966		1	2	4	1	1		9	6	-	1	1	79%	88%	762.0	9	
762.0		672.0	966		1	2	4	1	1		9	6	-	1	1	79%	88%	762.0	9	
762.0		672.0	966		1	2	4	1	1		9	6	-	1	1	79%	88%	762.0	9	
762.0		672.0	966		1	2	4	1	1		9	6	-	1	1	79%	88%	762.0	9	
762.0		672.0	966		1	2	4	1	1		9	6	-	1	1	79%	88%	762.0	9	
762.0		672.0	966		1	2	4	1	1		9	6	-	1	1	79%	88%	762.0	9	
613.9		535.0	809			2	3	1	1		7	6	-	1	1	76%	87%	613.9	7	
613.9		535.0	809				3	1	1		7	6	-	1	0	76%	87%	613.9	7	
553.6		473.2	737.0		1	3	1	1			6	6	-		1	75%	85%	553.6	6	
553.6		476.0	737.0		1	3	1	1			6	6	-		0	75%	86%	553.6	6	
358.4		303.0	498.0		1	2	1				4	4	-		0	72%	85%	358.4	4	
358.4		303.0	498.0			1	2	1			4	4	-		0	72%	85%	358.4	4	
23944.8	595.0	20868.2	40193.5	0	27	59	121	34	29	0	270	40	194	0	26	36			32,428.1	357
% ACHIEVED					32%		57%		11%		100%		71%	72%	0%	10%	13%			
% DESIRED					30%		60%		10%				60%	70%	-	10%	10%			

APARTMENT MIX							PERFORMANCE		
ST	1B	1B+	2B	2B+	3B	3B+	CROSS VENT	2H SOLAR	<15 MIN SOLAR
0	27	83	174	35	38	0	69	259	30
		30.8%	58.5%		10.6%		62.2%	73%	8%
Total Units							357		
ADAPTABLE UNIT					10%				
LIVABLE UNIT					10%				

BICYCLE RATES				
RATE		REQUIRED (MIN-MAX%)		PROVIDED
20-30%	71.4	107	270	BICYCLES STORED IN STORAGE CAGES (CLASS A)
5-10%	18	36	18	CLASS B
-	-	-	-	
-	-	-	-	
-	-	-	-	
3-5%	1	2	2	CLASS B
5-10%	2	3	2	CLASS C
-	-	-	-	
	92	147	292	

SITE AREA LESS DEDICATED NEW ROAD LINK	3783	
COMMUNAL OPEN SPACE	25.9%	983 sqm
BASEMENT GBA PER LEVEL	3726.7	

GFA / GBA	78%
NSA/ GFA	87%
NSA/ GBA	68%