- ALL WORK TO COMPLY WITH BUILDING CODE OF AUSTRALIA, REQUIREMENTS OF RELEVANT STATUTORY AUTHORITIES / LOCAL GOVERNMENT &
 RELEVANT AUSTRALIAN BUILDING STANDARDS
 CONTRACTOR TO VERIFY ALL DIMENSIONS ON SITE BEFORE COMMENCING WORK SHOULD A DISCREPANCY BE IDENTIFIED PLEASE CONFIRM WITH
 ACHITECT PRIOR TO PROCEEDING IOD NOT SCALE FROM DRAWINGS!
 COPYRIGHT OF DESIGNS SHOWN HERBON IS RETAINED BY THIS OFFICE AND AUTHORITY IS REQUIRED FOR ANY REPRODUCTION
 DRAWINGS FOR THE PURPOSES OF DA ONLY FURTHER CONSULTANT / AUTHORITY COORDINATION WILL BE REQUIRED AT CC STAGE WHICH MAY
 MHACT ON DESIGN AND PLANNIC LAYOUTS
 WHEN PROPRIETARY PRODUCTS ARE REFERRED TO, INSTALL IN ACCORDANCE WITH THE MANUFACTURERS WRITTEN INSTRUCTIONS
 AREA SCHEDULES SUPPLIED AND APPROXIMATE ONLY FUTURE ALLOWANCE FOR VERTICAL SERVICE DUCTS, STRUCTURAL WALL SYSTEMS AND
 CONSULTANT INPUT WILL BE REQUIRED

PROPOSED SINGLE RESIDENTIAL DWELLING

22c BURRAN AVENUE, MOSMAN

DRAWING LIST

~~~~	~~~~~		
DA 000	COVER PAGE	DA 200	SITE ELEVATIONS 01
DA 001	DEMOLITION PLAN	DA 201	SITE ELEVATIONS 02
DA 002	SITE ANALYSIS PLAN	DA 202	SITE ELEVATIONS 03
~~~~	~~~~~~~~~~~~~~~~~~~~~~~~~~~~~~~~~~~~~~~	DA 210	ELEVATIONS 01
DA 011	LOWER GROUND FLOOR PLAN (1:200)	DA 211	ELEVATIONS 02
DA 012	GROUND FLOOR PLAN (1:200)	DA 212	ELEVATIONS 03
DA 013	LEVEL 1 PLAN (1:200)	DA 213	ELEVATIONS 04
DA 014	LEVEL 2 PLAN (1:200)	}}	\
DA 015	ROOF PLAN (1:200)	DA 300	SECTION A
{		DA 301	SECTION B
DA 101	LOWER GROUND FLOOR PLAN	DA 302	SECTION C
DA 102	GROUND FLOOR PLAN	DA 303	SECTION D
DA 103	LEVEL 1 PLAN		
DA 104	LEVEL 2 PLAN	DA 400	MATERIAL FINISHES SCHEDULE
DA 105	ROOF PLAN		
Luu		DA 500	GFA DIAGRAM

DA 530 HEIGHT PLANE DIAGRAM

DA 531 FORESHORE BUILDING LINE DIAGRAM

DA 610 SHADOW DIAGRAMS



DEVELOPMENT APPLICATION DRAWINGS DA000


DESCRIPTION DESCRIPTION PROPOSED SINGLE RESIDENTIAL DWELLING 22c BURRAN AVENUE, MOSMAN NSW 2088 Lot 1, DP 730301 CLIENT: SIT FAMILY TRUST & O'CONNELL STREET CADDENS UNIT TRUST


DA 510 LANDSCAPE AREA CALCULATION


COVER PAGE ISSUE: B JOB No. 1908

CLIENT: SIT FAMILY TRUST & O'CONNELL STREET CADDENS UNIT TRUST

- ALL WORK TO COMPLY WITH BUILDING CODE OF AUSTRALIA, REQUIREMENTS OF RELEVANT STATUTORY AUTHORITIES/LOCAL GOVERNMENT & RELEVANT AUSTRALIAN BUILDING STANDARDS (CONTRACTOR TO VERIEY ALL DIMENSIONS ON SITE BEFORE COMMENCING WORK—SHOULD A DISCREPANCY BE IDENTIFIED PLEASE CONFIRM WITH ARCHITECT PRIOR TO PROCEEDING ION ONT SCALE FROM DRAWINGS) (OPPRICH TO PEGISION SHOWN HEREON IS RETAINED BY THIS OFFICE AND AUTHORITY IS REQUIRED FOR ANY REPRODUCTION DRAWINGS FOR THE PURPOSES OF DA ONLY—FURTHER CONSULTANT/AUTHORITY COORDINATION WILL BE REQUIRED AT CC STAGE WHICH MAY IMPACT ON DESION AND PLANING LAYOUTS WHEN PROPRIETARY PRODUCTS ARE REFERRED TO, INSTALL IN ACCORDANCE WITH THE MANUFACTURERS WRITTEN INSTRUCTIONS AREA SCHEDULES SUPPLIED AND APPROXIMATE ONLY—FUTURE ALLOWANCE FOR VERTICAL SERVICE DUCTS, STRUCTURAL WALL SYSTEMS AND CONSULTANT INPUT WILL BE REQUIRED.

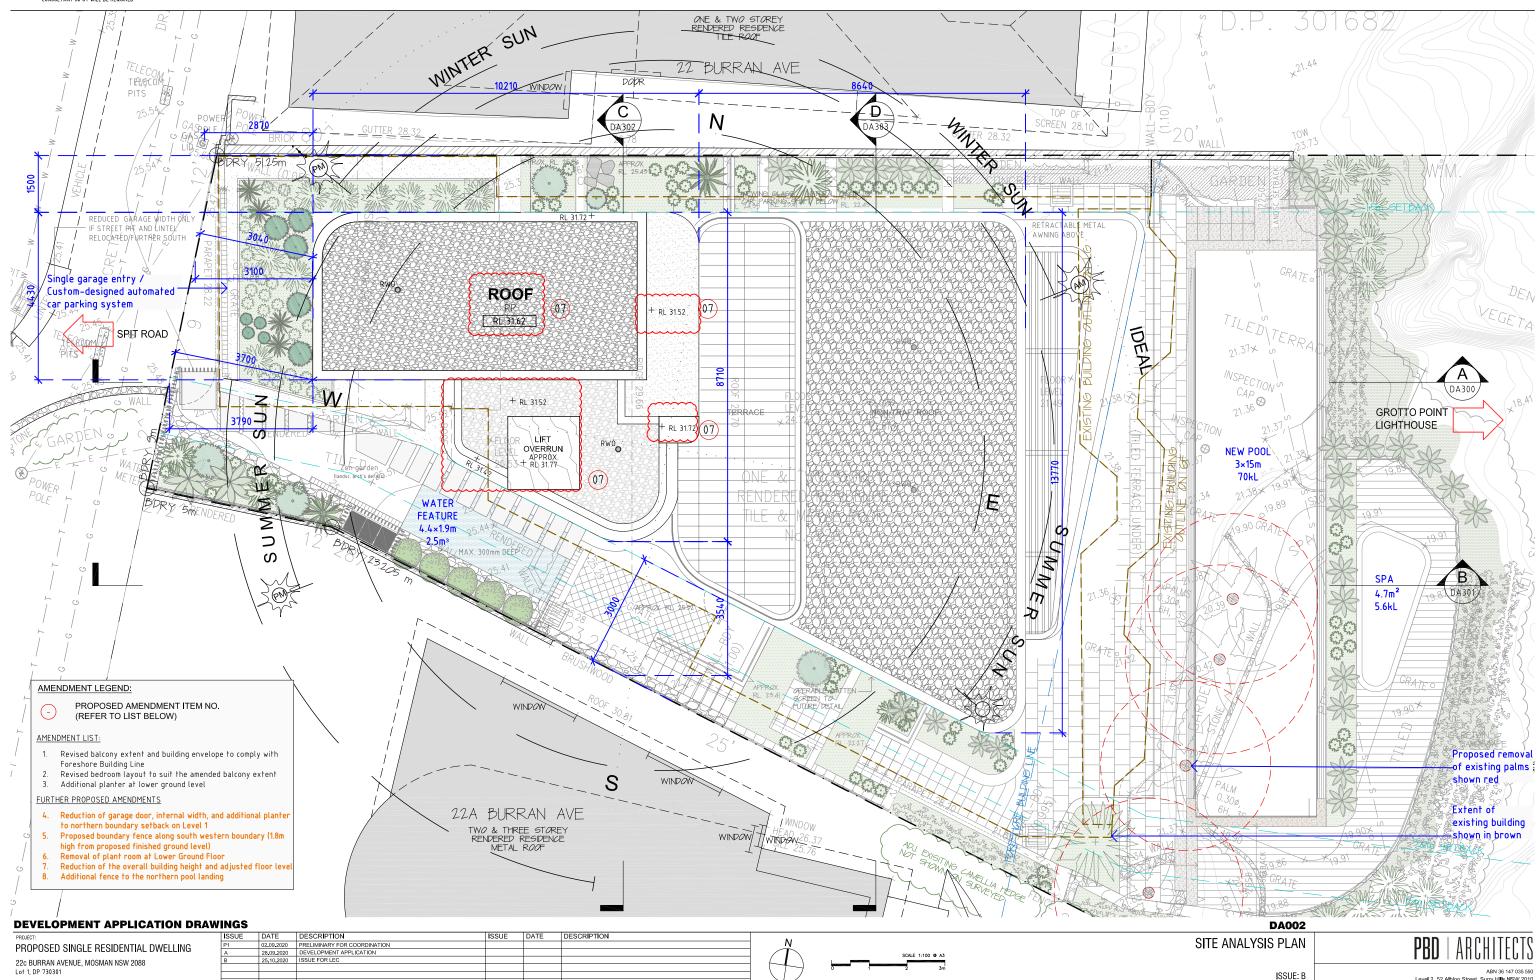

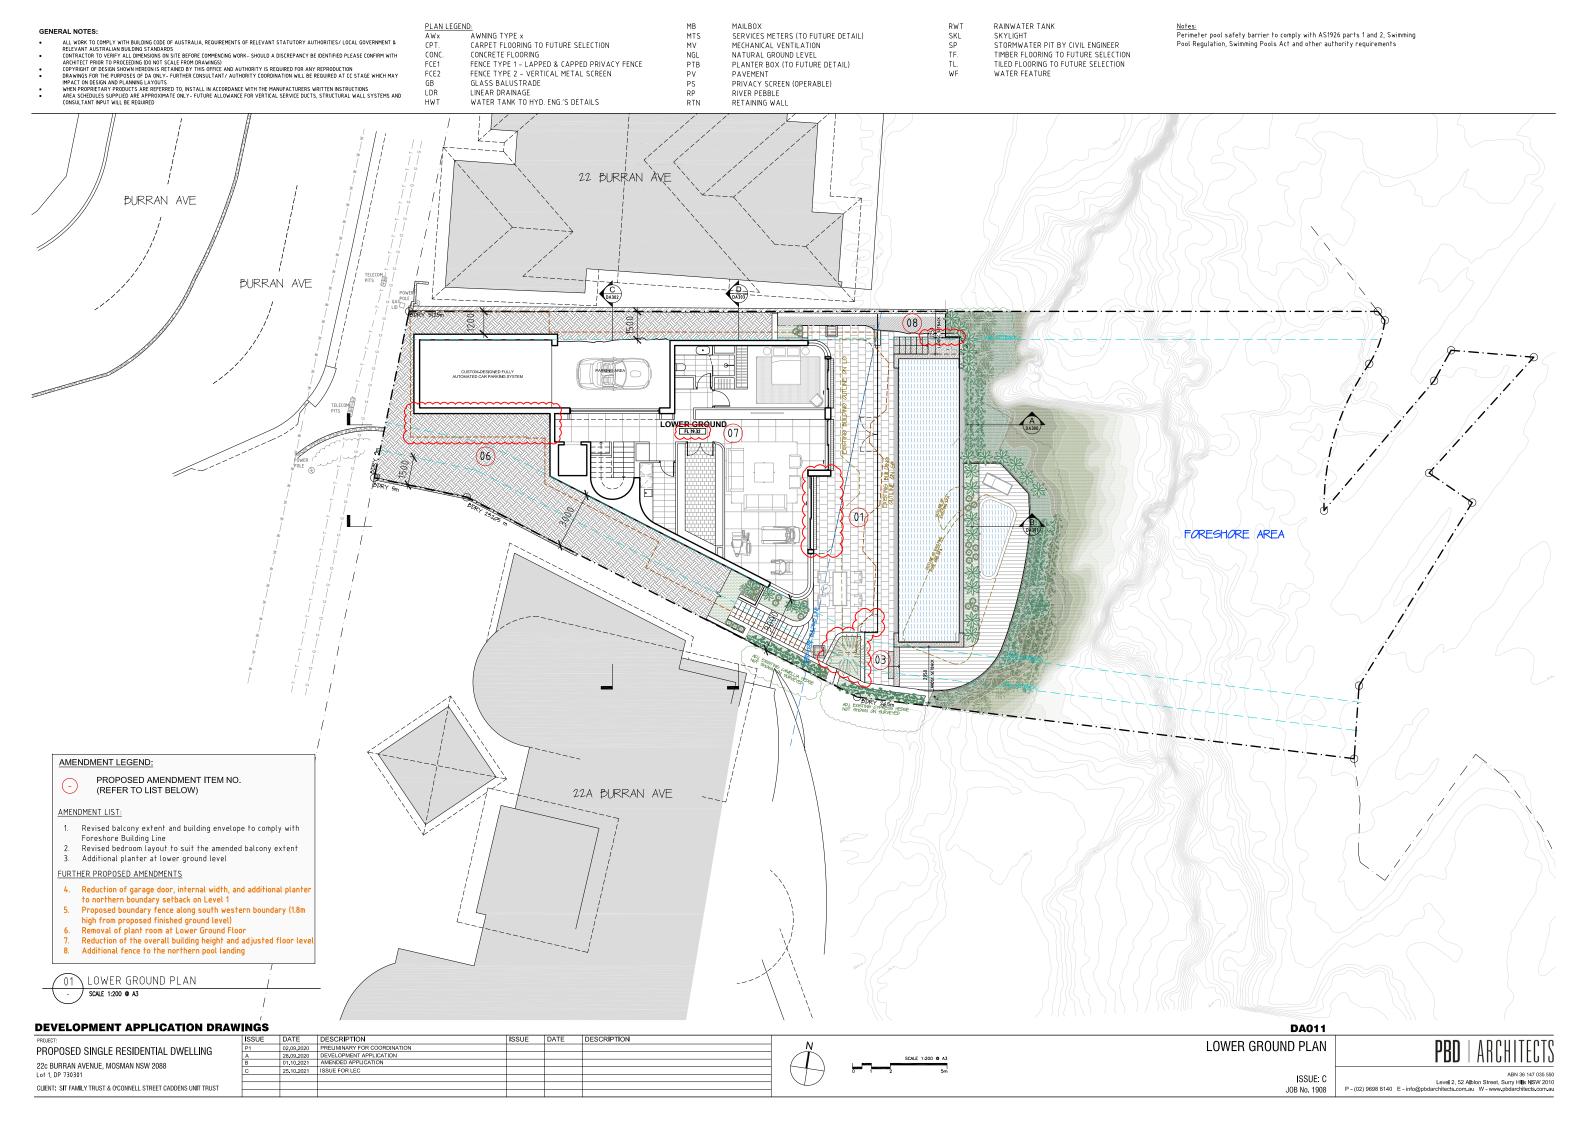

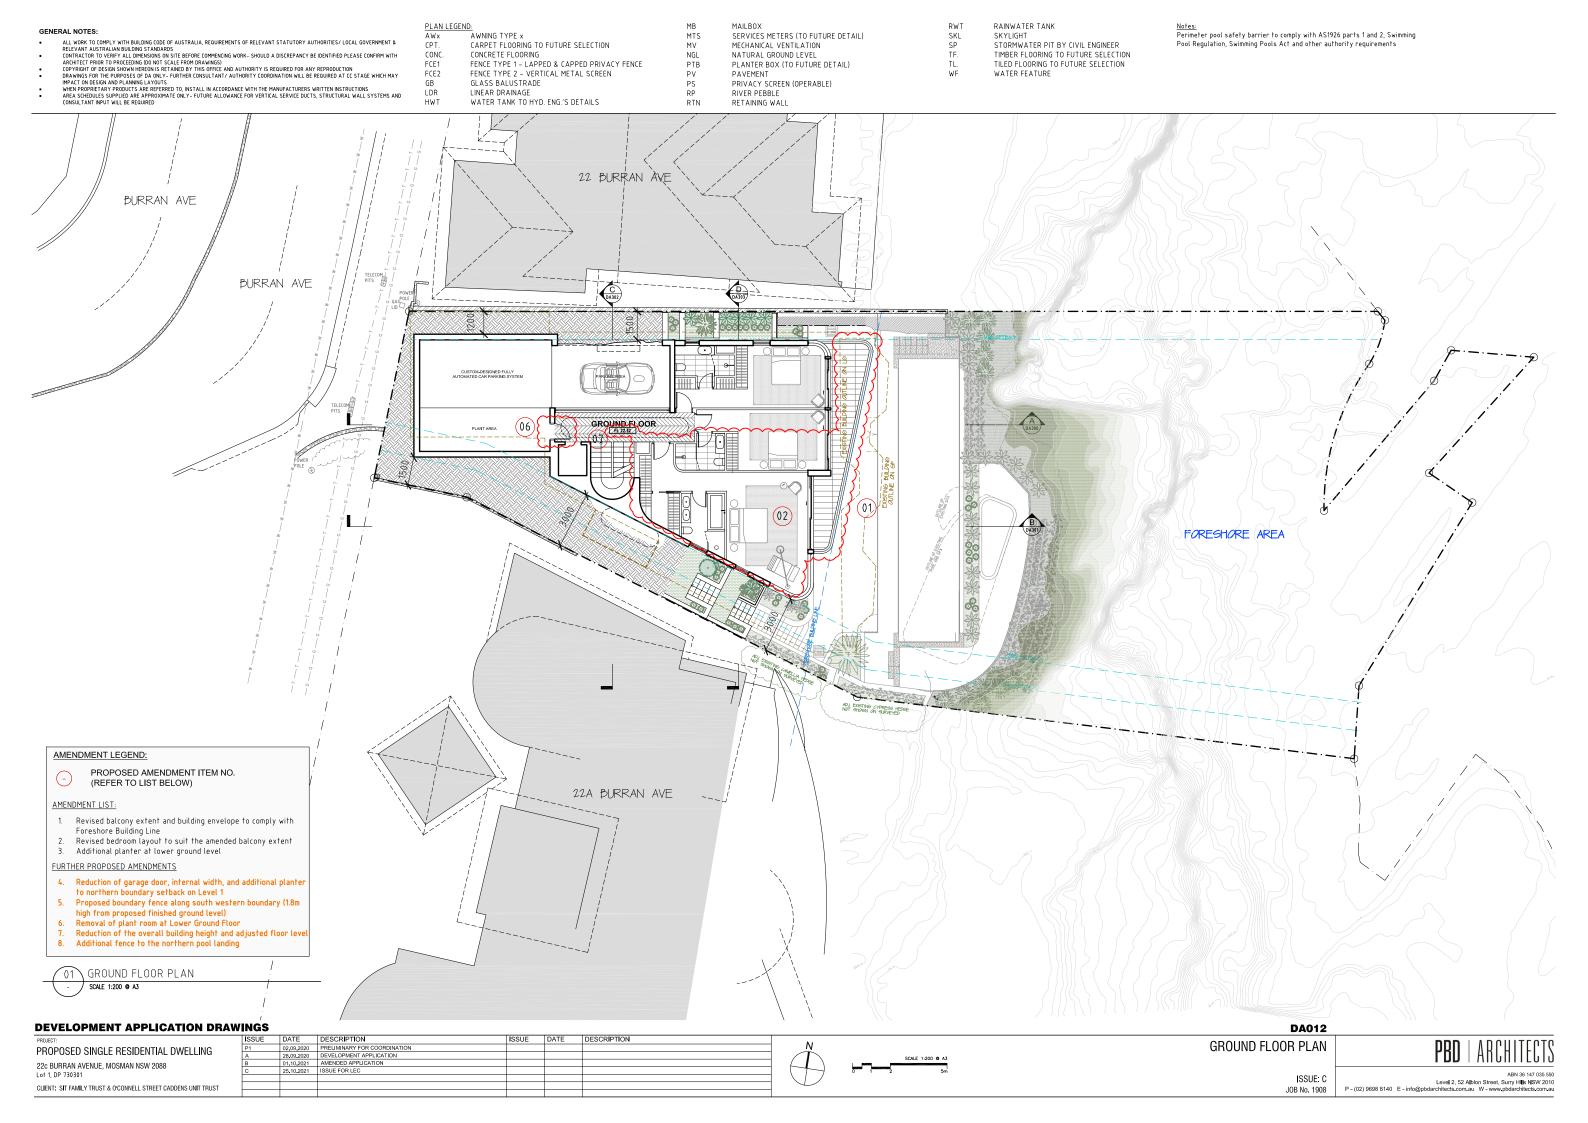

AWNING TYPE x
CARPET FLOORING TO FUTURE SELECTION
CONCRETE FLOORING
FENCE TYPE 1 - LAPPED & CAPPED PRIVACY FENCE
FENCE TYPE 2 - VERTICAL METAL SCREEN SERVICES METERS (TO FUTURE DETAIL)
MECHANICAL VENTILATION ALL WORK TO COMPLY WITH BUILDING CODE OF AUSTRALIA, REQUIREMENTS OF RELEVANT STATUTORY AUTHORITIES / LOCAL GOVERNMENT &
RELEVANT AUSTRALIAN BUILDING STANDARDS
CONTRACTOR TO VERIFY ALL DIMENSIONS ON SITE BEFORE COMMENCING WORK - SHOULD A DISCREPANCY BE IDENTIFIED PLEASE CONFIRM WITH
ACHITECT PRIOR TO PROCEEDING IOD NOT SCALE FROM DRAWINGS!
COPYRIGHT OF DESIGNS SHOWN HERBON IS RETAINED BY THIS OFFICE AND AUTHORITY IS REQUIRED FOR ANY REPRODUCTION
DRAWINGS FOR THE PURPOSES OF DA ONLY - FURTHER CONSULTANT / AUTHORITY COORDINATION WILL BE REQUIRED AT CC STAGE WHICH MAY
MHACT ON DESIGN AND PLANNIC LAYOUTS
WHEN PROPRIETARY PRODUCTS ARE REFERRED TO, INSTALL IN ACCORDANCE WITH THE MANUFACTURERS WRITTEN INSTRUCTIONS
AREA SCHEDULES SUPPLIED AND APPROXIMATE ONLY - FUTURE ALLOWANCE FOR VERTICAL SERVICE DUCTS, STRUCTURAL WALL SYSTEMS AND
CONSULTANT INPUT WILL BE REQUIRED STORMWATER PIT BY CIVIL ENGINEER Pool Regulation, Swimming Pools Act and other authority requirements NATURAL GROUND LEVEL PLANTER BOX (TO FUTURE DETAIL) TIMBER FLOORING TO FUTURE SELECTION FCE1 FCE2 GB TILED FLOORING TO FUTURE SELECTION PAVEMENT PRIVACY SCREEN (OPERABLE) WATER FEATURE GLASS BALUSTRADE PS RP RTN LDR HWT LINEAR DRAINAGE WATER TANK TO HYD. ENG.'S DETAILS RIVER PEBBLE RETAINING WALL 22 BURRAN ÀVE BURRAN AVE BURRAN AVE RL 25.47 FORESHORE AREA 00 AMENDMENT LEGEND: PROPOSED AMENDMENT ITEM NO. (REFER TO LIST BELOW) 22A BURRAN AVE AMENDMENT LIST: 1. Revised balcony extent and building envelope to comply with Foreshore Building Line Revised bedroom layout to suit the amended balcony extent
 Additional planter at lower ground level $\underline{\mathsf{FURTHER}\;\mathsf{PROPOSED}\;\mathsf{AMENDMENTS}}$ Reduction of garage door, internal width, and additional planter to northern boundary setback on Level 1 Proposed boundary fence along south western boundary (1.8m high from proposed finished ground level) Removal of plant room at Lower Ground Floor Reduction of the overall building height and adjusted floor level Additional fence to the northern pool landing 01 LEVEL 1 PLAN SCALE 1:200 @ A3 **DEVELOPMENT APPLICATION DRAWINGS DA013** DESCRIPTION LEVEL 1 PLAN PROPOSED SINGLE RESIDENTIAL DWELLING 22c BURRAN AVENUE, MOSMAN NSW 2088 Lot 1, DP 730301 ISSUE: C CLIENT: SIT FAMILY TRUST & O'CONNELL STREET CADDENS UNIT TRUST JOB No. 1908


GENERAL NOTES:


RAINWATER TANK


SKYLIGHT


Notes:


Perimeter pool safety barrier to comply with AS1926 parts 1 and 2, Swimming

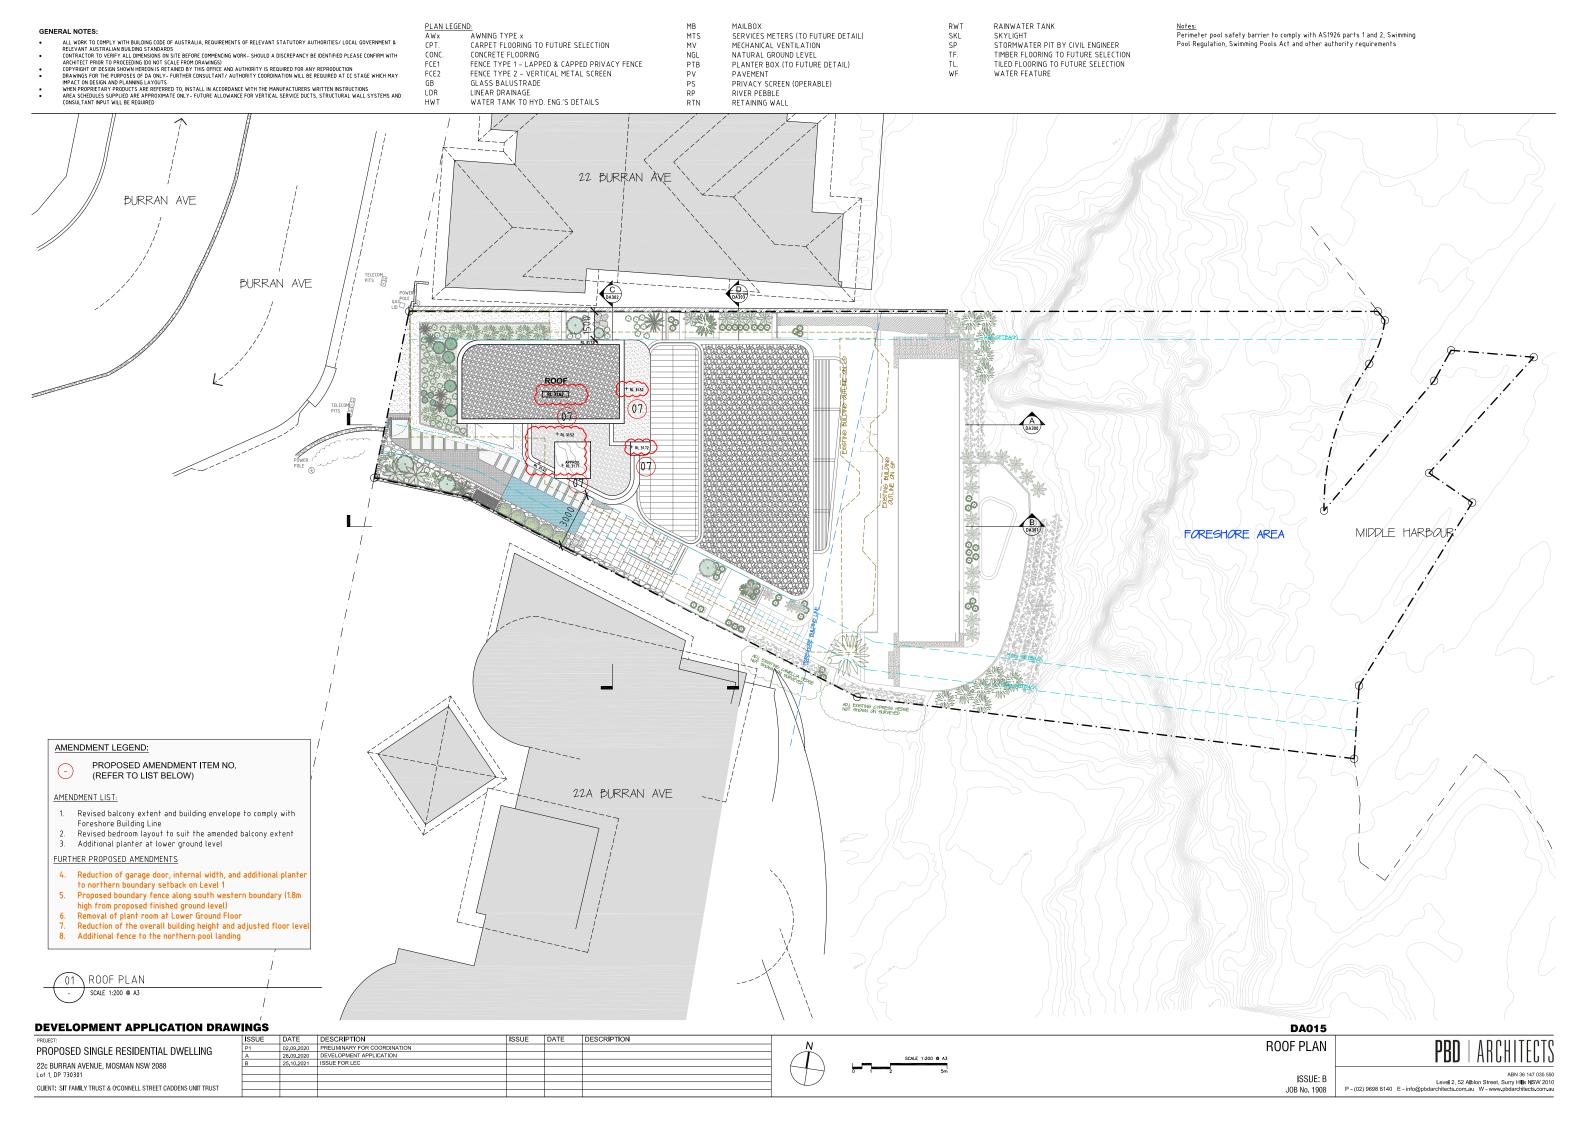


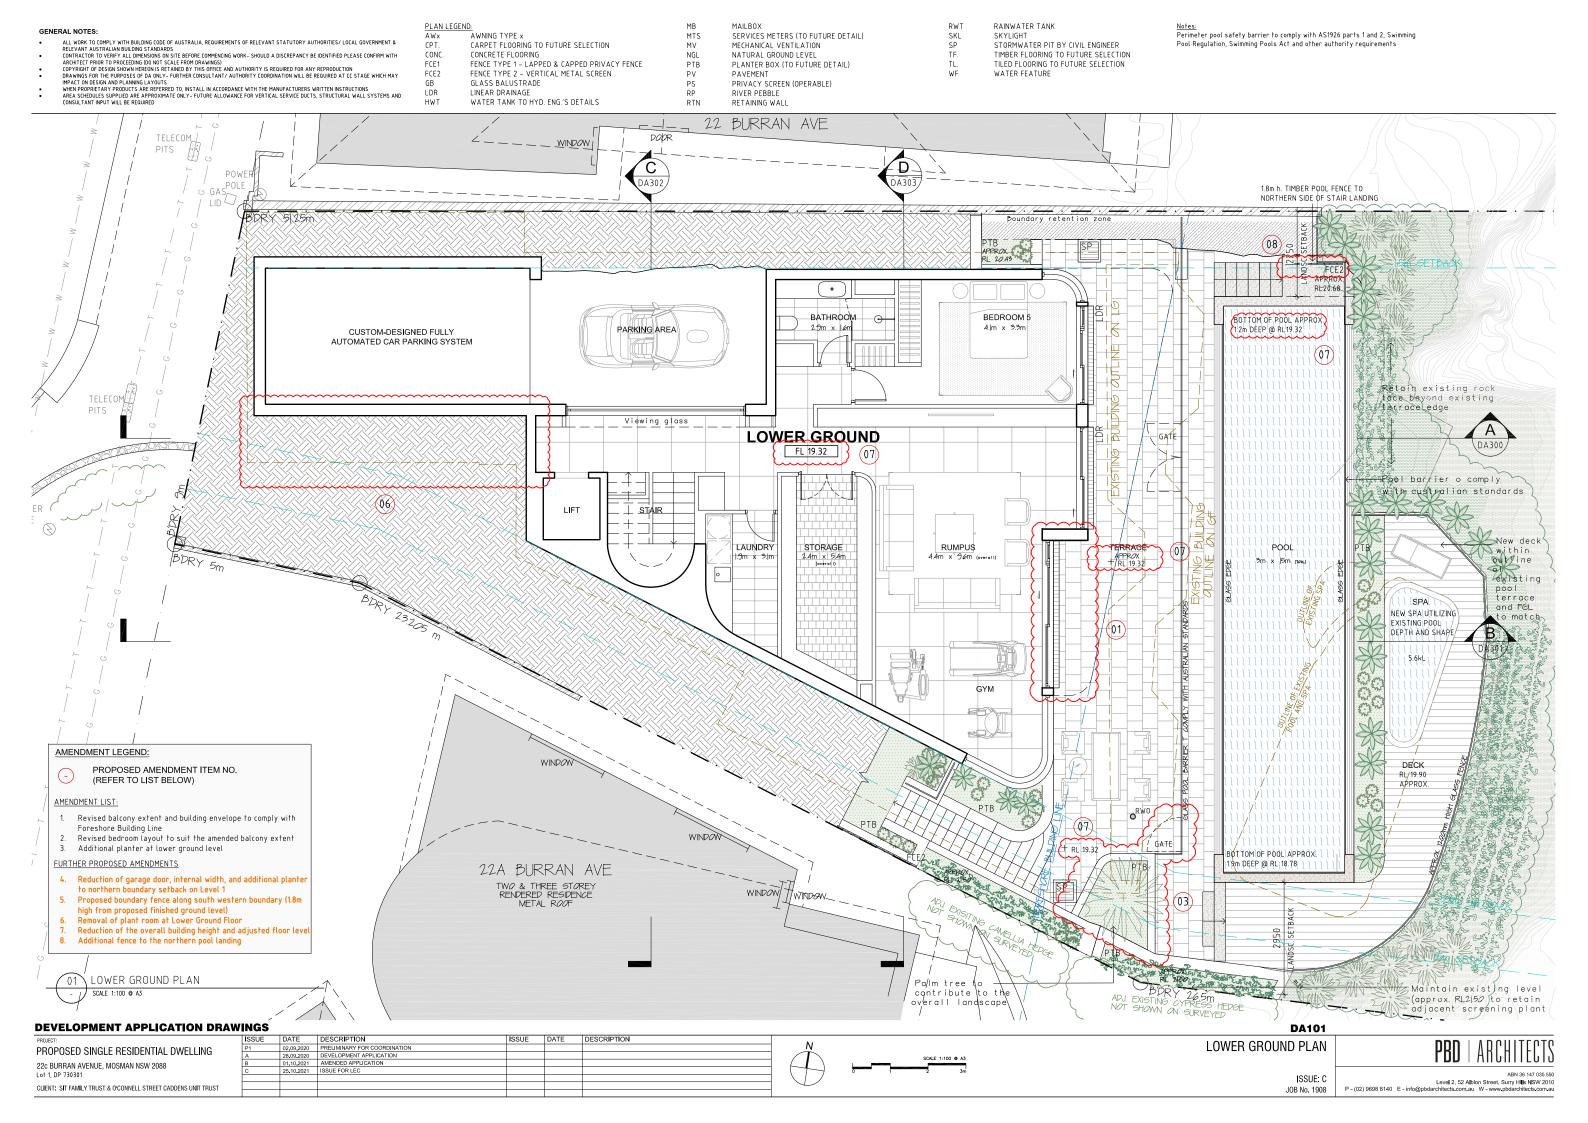

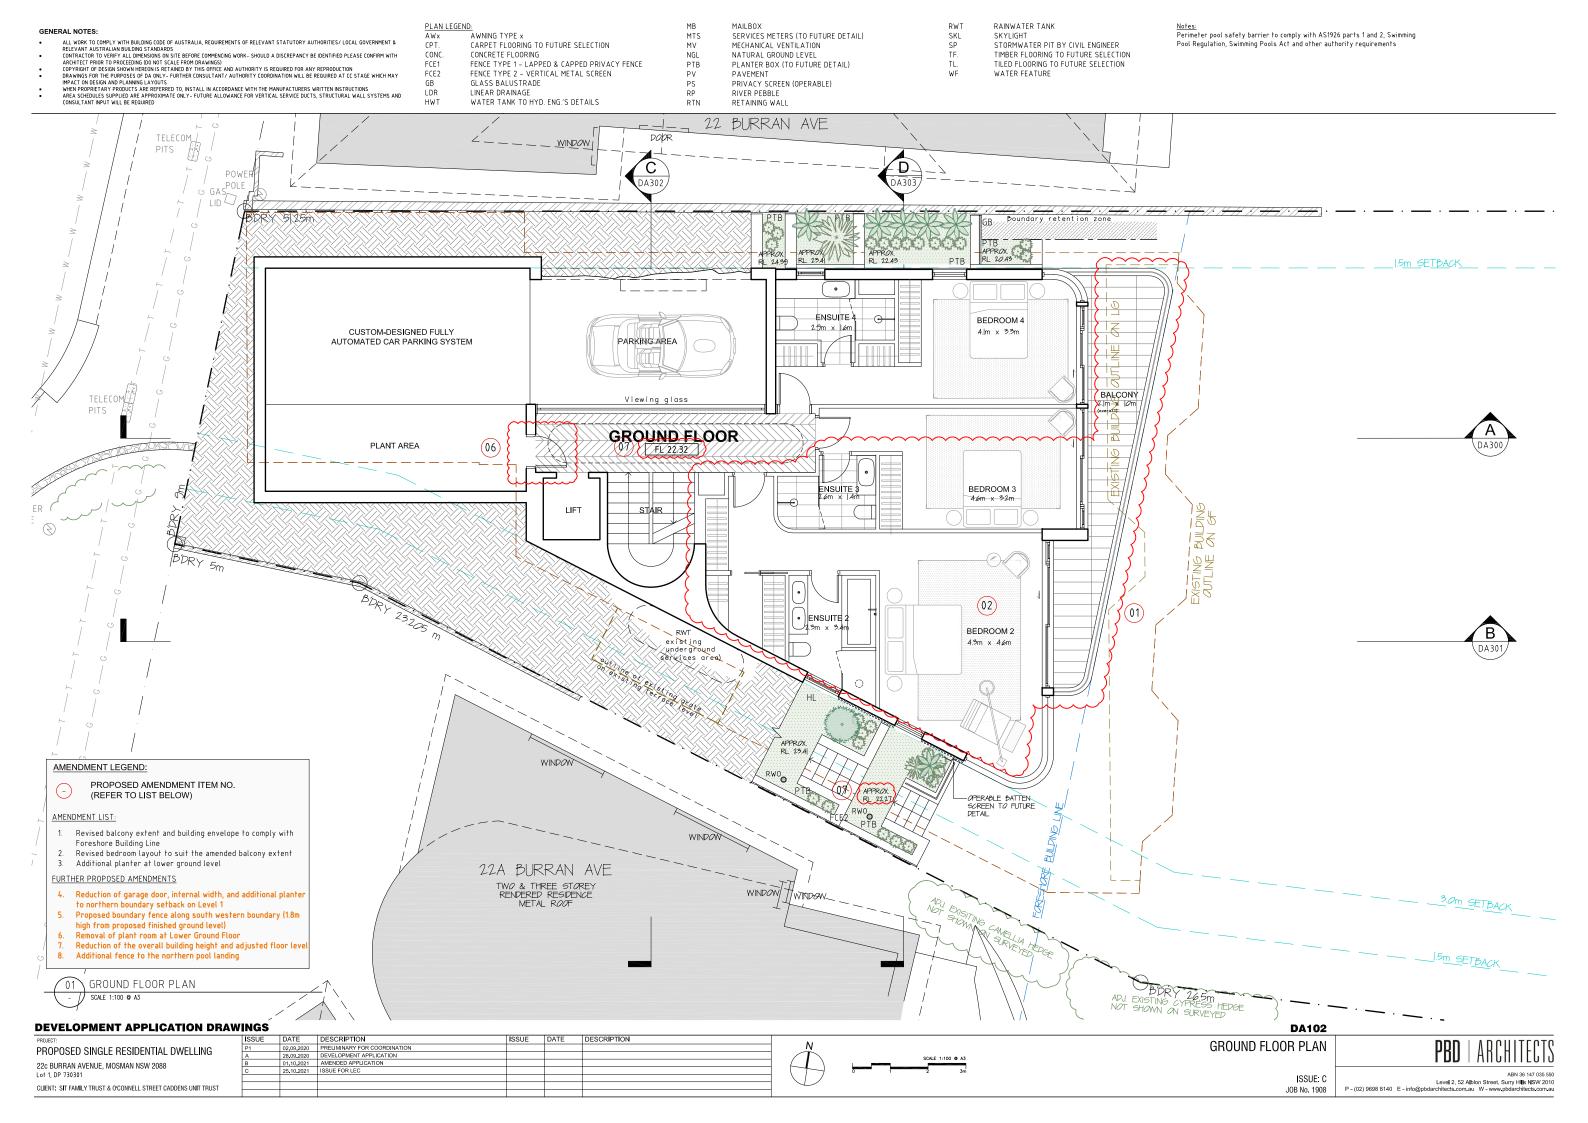

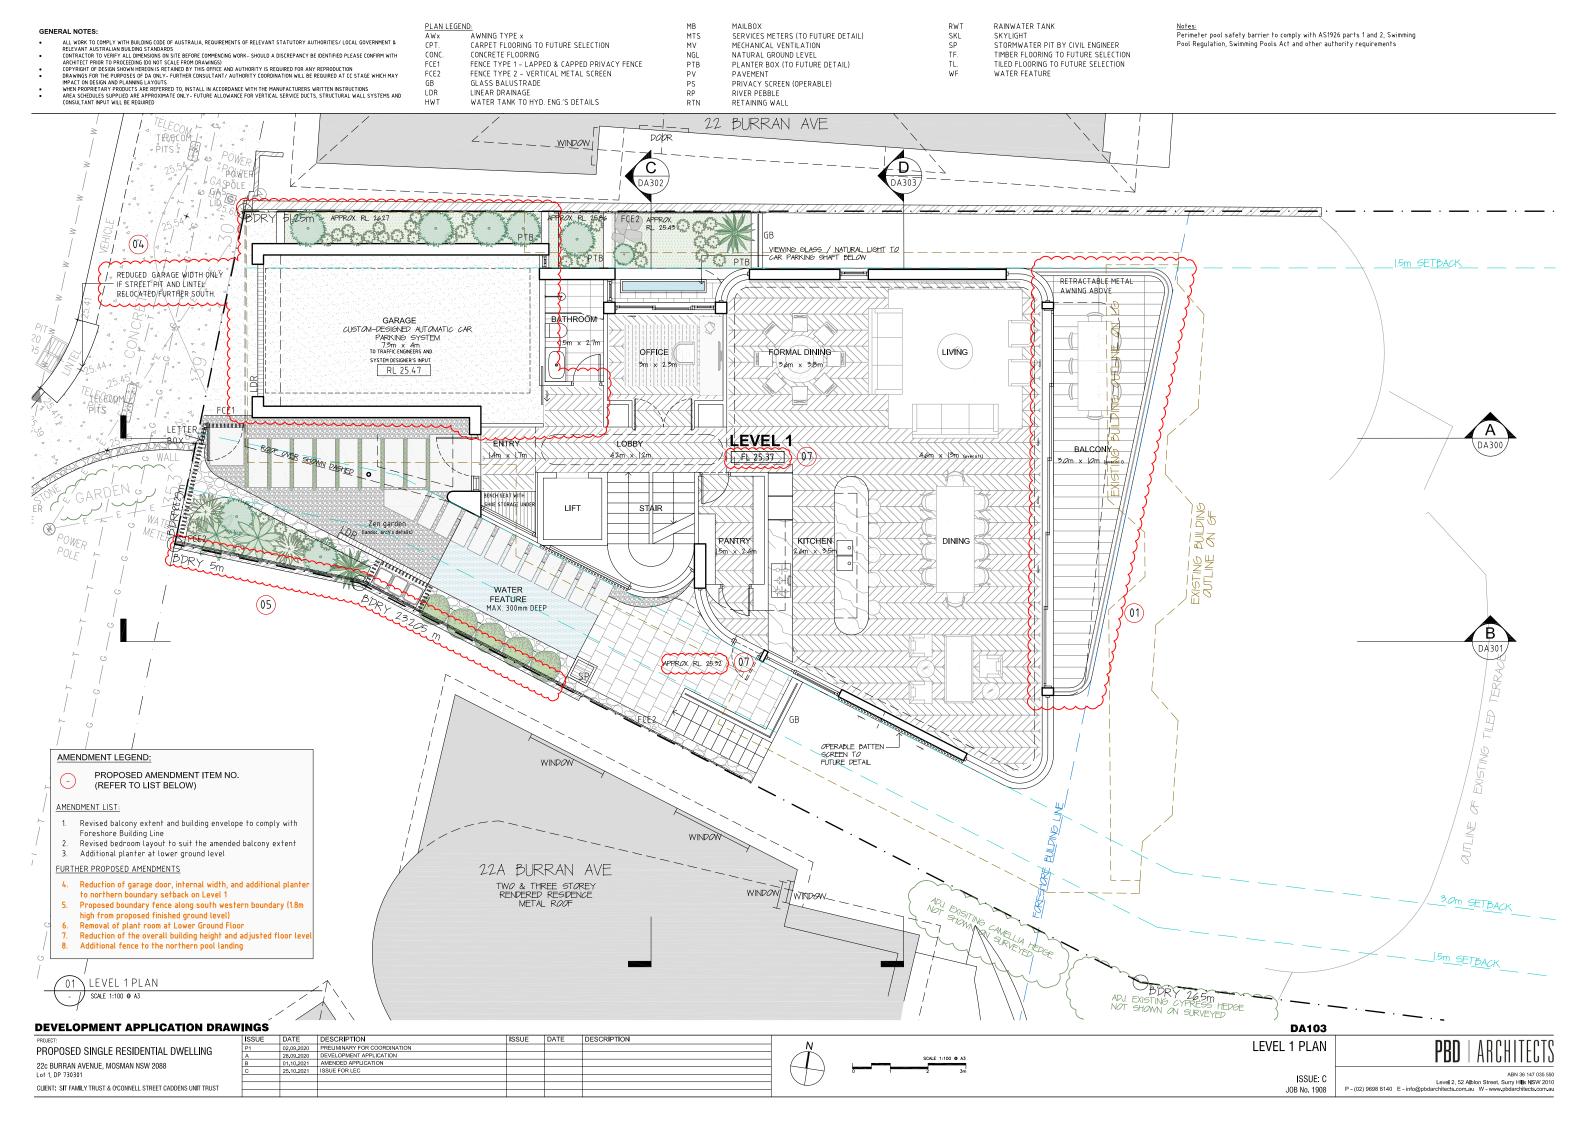

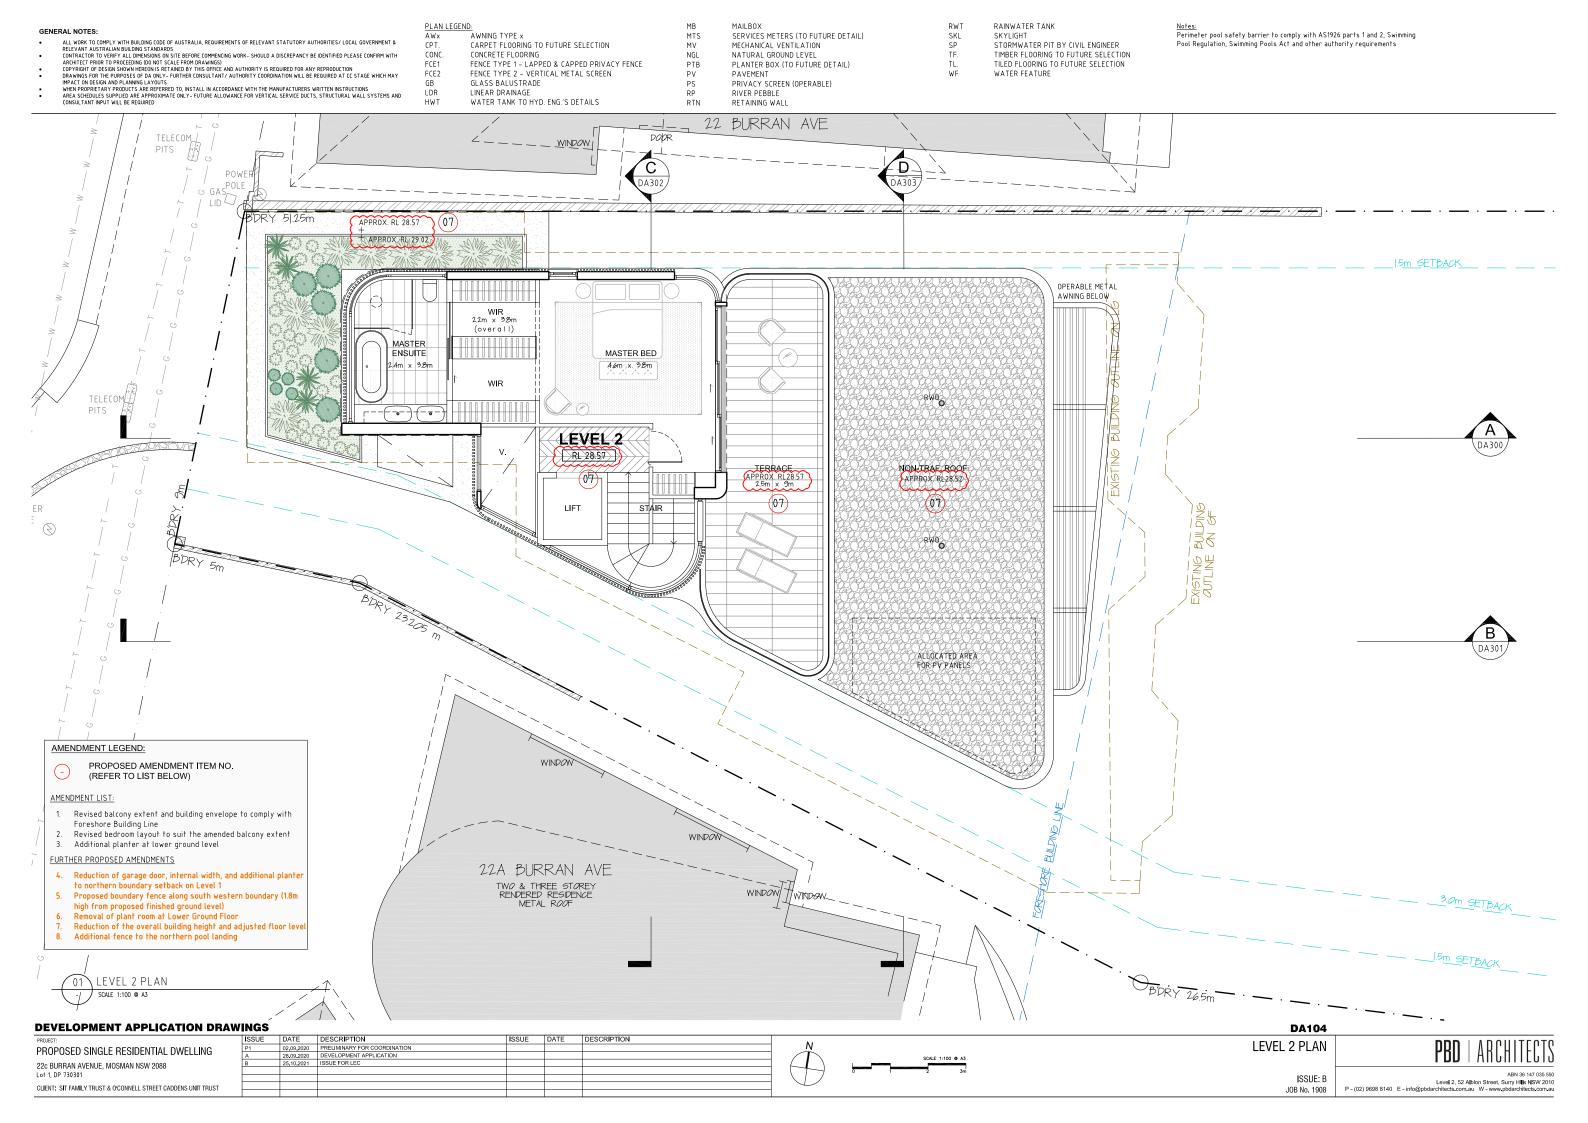

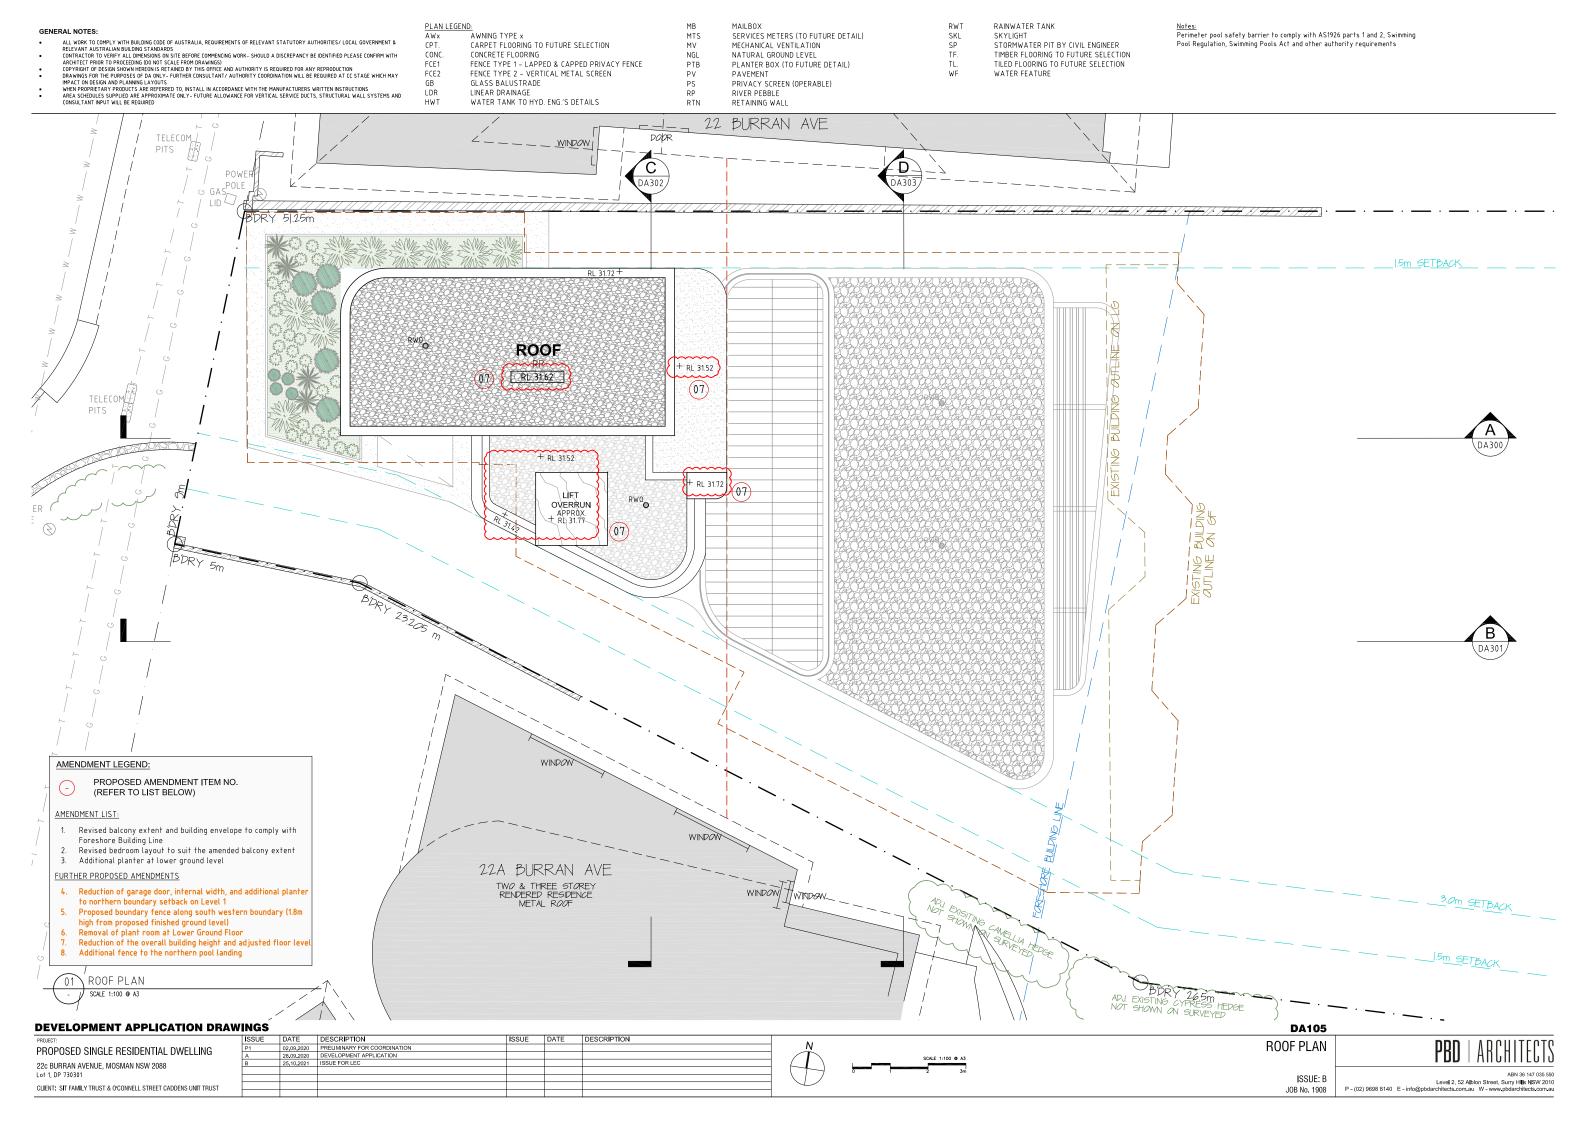

- ALL WORK TO COMPLY WITH BUILDING CODE OF AUSTRALIA, REQUIREMENTS OF RELEVANT STATUTORY AUTHORITIES/LOCAL GOVERNMENT & RELEVANT AUSTRALIAN BUILDING STANDARDS.

 CONTRACTOR TO VERFY ALL DIMENSIONS ON SITE BEFORE COMMENCING WORK—SHOULD A DISCREPANCY BE IDENTIFIED PLEASE CONFIRM WITH APCHITECT PRIOR TO PROCEEDING ION DAT SCALE FROM DRAWINGS!

 COPYRIGHT OF DESIGN SHOWN HERBON IS RETAINED BY THIS OFFICE AND AUTHORITY IS REQUIRED FOR ANY REPRODUCTION DRAWINGS FOR THE PURPOSES OF DA ONLY—FURTHER CONSULTANT/AUTHORITY COORDINATION WILL BE REQUIRED AT CC STAGE WHICH MAY IMPACT ON DESIGN AND PLANING LAYOUTS

 WHEN PROPRIETARY PRODUCTS ARE REFERRED TO, INSTALL IN ACCORDANCE WITH THE MANUFACTURERS WRITTEN INSTRUCTIONS AREA SCHEDULES SUPPLIED AND APPROXIMATE ONLY—FUTURE ALLOWANCE FOR VERTICAL SERVICE DUCTS, STRUCTURAL WALL SYSTEMS AND CONSULTANT INPUT WILL BE REQUIRED.

MATERIALS:

ALUMINIUM FRAMED GLAZING VERTICAL ALUMINIUM BATTENS BTN

EXISTING GROUND LEVEL NGL FCEx FENCE TYPE X

GLASS BLAUSTRADE GARAGE DOOR

POWDERCOAT FINISH X
PRIVACY SCREEN (OPERABLE)

VERTICAL ALUMINIUM BATTENS STONE CLADDING TYPE X

STx

TIMBER CLAD DOOR

Note: landscaping and shadow shown on elevations are indicative and for illustration purpose only.

AMENDMENT LEGEND:



PROPOSED AMENDMENT ITEM NO. (REFER TO LIST BELOW)


AMENDMENT LIST:

- 1. Revised balcony extent and building envelope to comply with Foreshore Building Line
- Revised bedroom layout to suit the amended balcony extent
 Additional planter at lower ground level

FURTHER PROPOSED AMENDMENTS

- 4. Reduction of garage door, internal width, and additional planter to northern boundary setback on Level 1
- 5. Proposed boundary fence along south western boundary (1.8m high from proposed finished ground level)

- 6. Removal of plant room at Lower Ground Floor
 7. Reduction of the overall building height and adjusted floor level
 8. Additional fence to the northern pool landing

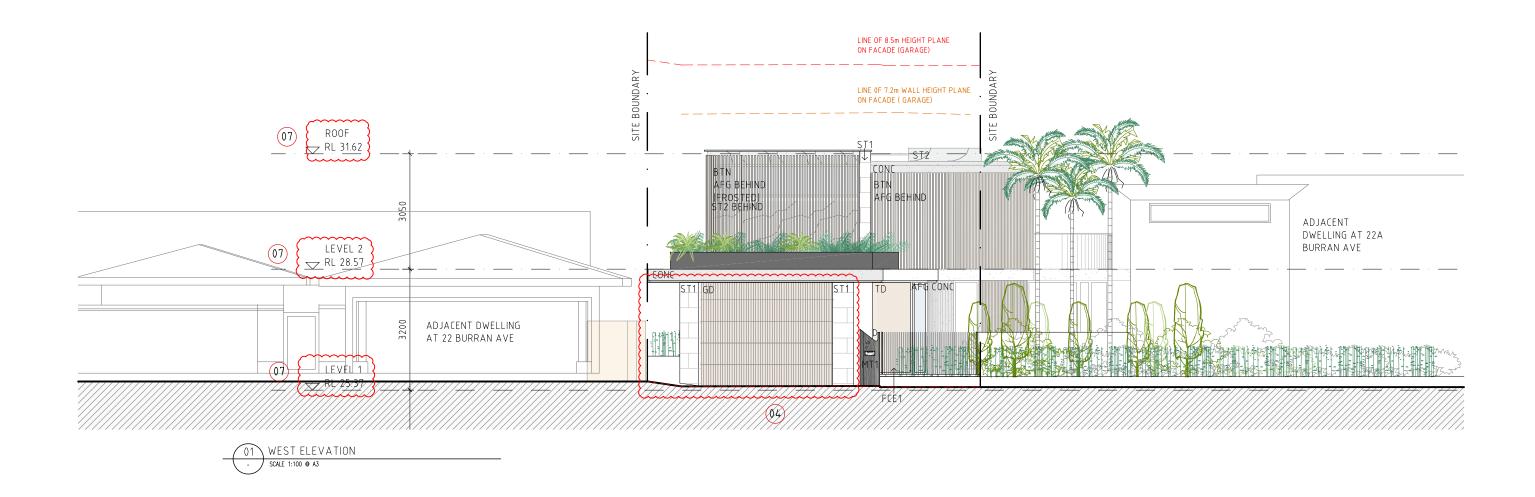


DEVELOPMENT APPLICATION DRAWINGS

PROPOSED SINGLE RESIDENTIAL DWELLING 22c BURRAN AVENUE, MOSMAN NSW 2088 Lot 1, DP 730301

CLIENT: SIT FAMILY TRUST & O'CONNELL STREET CADDENS UNIT TRUST

DESCRIPTION

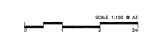

ELEVATIONS 01

DA210


ISSUE: B

- ALL WORK TO COMPLY WITH BUILDING CODE OF AUSTRALIA, REQUIREMENTS OF RELEVANT STATUTORY AUTHORITIES / LOCAL GOVERNMENT &
 RELEVANT AUSTRALIAN BUILDING STANDARDS
 CONTRACTOR TO VERIFY ALL DIMENSIONS ON SITE BEFORE COMMENCING WORK SHOULD A DISCREPANCY BE IDENTIFIED PLEASE CONFIRM WITH
 ACHITECT PRIOR TO PROCEEDING IOD NOT SCALE FROM DRAWINGS!
 COPYRIGHT OF DESIGNS SHOWN HERBON IS RETAINED BY THIS OFFICE AND AUTHORITY IS REQUIRED FOR ANY REPRODUCTION
 DRAWINGS FOR THE PURPOSES OF DA ONLY FURTHER CONSULTANT / AUTHORITY COORDINATION WILL BE REQUIRED AT CC STAGE WHICH MAY
 MHACT ON DESIGN AND PLANNIC LAYOUTS
 WHEN PROPRIETARY PRODUCTS ARE REFERRED TO, INSTALL IN ACCORDANCE WITH THE MANUFACTURERS WRITTEN INSTRUCTIONS
 AREA SCHEDULES SUPPLIED AND APPROXIMATE ONLY FUTURE ALLOWANCE FOR VERTICAL SERVICE DUCTS, STRUCTURAL WALL SYSTEMS AND
 CONSULTANT INPUT WILL BE REQUIRED

PROPOSED SINGLE RESIDENTIAL DWELLING

CLIENT: SIT FAMILY TRUST & O'CONNELL STREET CADDENS UNIT TRUST

22c BURRAN AVENUE, MOSMAN NSW 2088 Lot 1, DP 730301

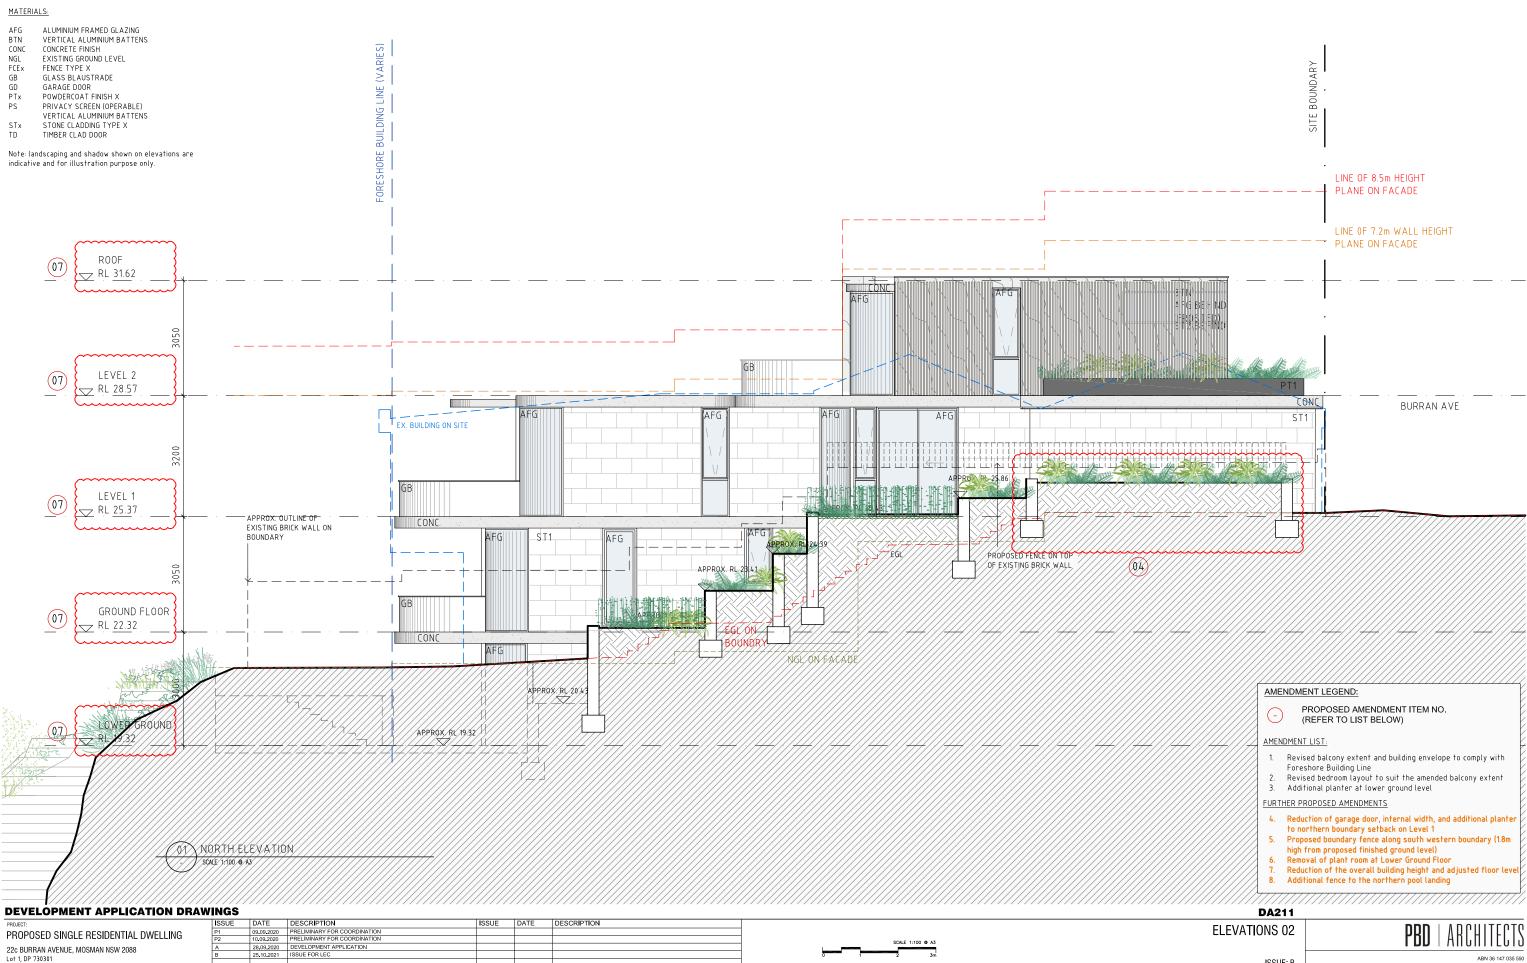


ISSUE: B

JOB No. 1908

Level 2, 52 Albion Street, Surry Hills NSW 2010 rchitects.com.au W - www.pbdarchitects.com.au

CLIENT: SIT FAMILY TRUST & O'CONNELL STREET CADDENS UNIT TRUST


- ALL WORK TO COMPLY WITH BUILDING CODE OF AUSTRALIA, REQUIREMENTS OF RELEVANT STATUTORY AUTHORITIES / LOCAL GOVERNMENT & RELEVANT AUSTRALIAN BUILDING STANDARDS (CONTRACTOR TO VERIFY ALL DIMENSIONS ON SITE BEFORE COMMENCING WORK—SHOULD A DISCREPANCY BE DENTIFIED PLEASE CONFIRM WITH ARCHITECT PRIOR TO PROCEEDING (DO NOT SCALE FROM DRAWNOS) (COPYRIGHT OF DESIGN SHOWN HEREON IS RETURNED BY THIS OFFICE AND AUTHORITY IS REQUIRED FOR ANY REPRODUCTION DRAWNIGS FOR THE PURPOSES OF DA ONLY FURTHER CONSULTANT / AUTHORITY COORDINATION WILL BE REQUIRED AT CC STAGE WHICH MAY IMPACT ON DESIGN AND PLANING LAYOUTS WHEN PROPRIETARY PRODUCTS ARE REFERRED TO, INSTALL IN ACCORDANCE WITH THE MANUFACTURERS WHITTEN INSTRUCTIONS AREA SCHEDULES SUPPLIED AND APPROXMATE ONLY FUTURE ALLOWANCE FOR VERTICAL SERVICE DUCTS, STRUCTURAL WALL SYSTEMS AND CONSULTANT INPUT WILL BE REQUIRED

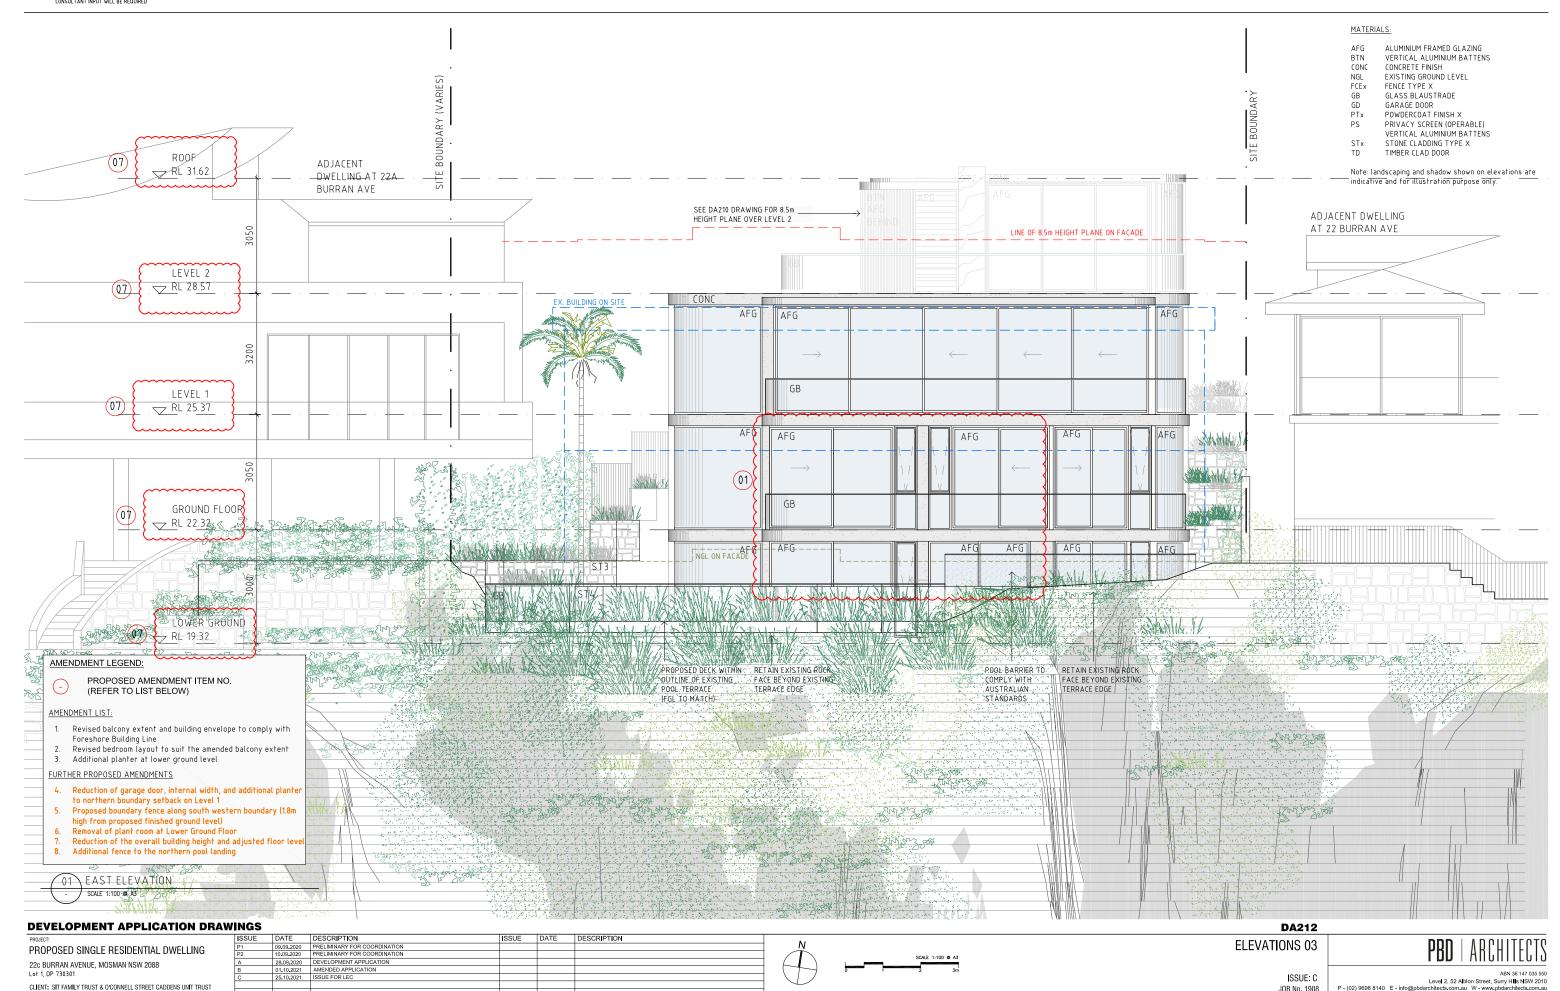

JOB No. 1908

P - (02) 9698 8140 E - info@p

- ALL WORK TO COMPLY WITH BUILDING CODE OF AUSTRALIA, REQUIREMENTS OF RELEVANT STATUTORY AUTHORITIES / LOCAL GOVERNMENT & RELEVANT AUSTRALIAN BUILDING STANDARDS (CONTRACTOR TO VERIFY ALL DIMENSIONS ON SITE BEFORE COMMENCING WORK—SHOULD A DISCREPANCY BE DENTIFIED PLEASE CONFIRM WITH ARCHITECT PRIOR TO PROCEEDING (DO NOT SCALE FROM DRAWNOS) (COPYRIGHT OF DESIGN SHOWN HEREON IS RETURNED BY THIS OFFICE AND AUTHORITY IS REQUIRED FOR ANY REPRODUCTION DRAWNIGS FOR THE PURPOSES OF DA ONLY FURTHER CONSULTANT / AUTHORITY COORDINATION WILL BE REQUIRED AT CC STAGE WHICH MAY IMPACT ON DESIGN AND PLANING LAYOUTS WHEN PROPRIETARY PRODUCTS ARE REFERRED TO, INSTALL IN ACCORDANCE WITH THE MANUFACTURERS WHITTEN INSTRUCTIONS AREA SCHEDULES SUPPLIED AND APPROXMATE ONLY FUTURE ALLOWANCE FOR VERTICAL SERVICE DUCTS, STRUCTURAL WALL SYSTEMS AND CONSULTANT INPUT WILL BE REQUIRED

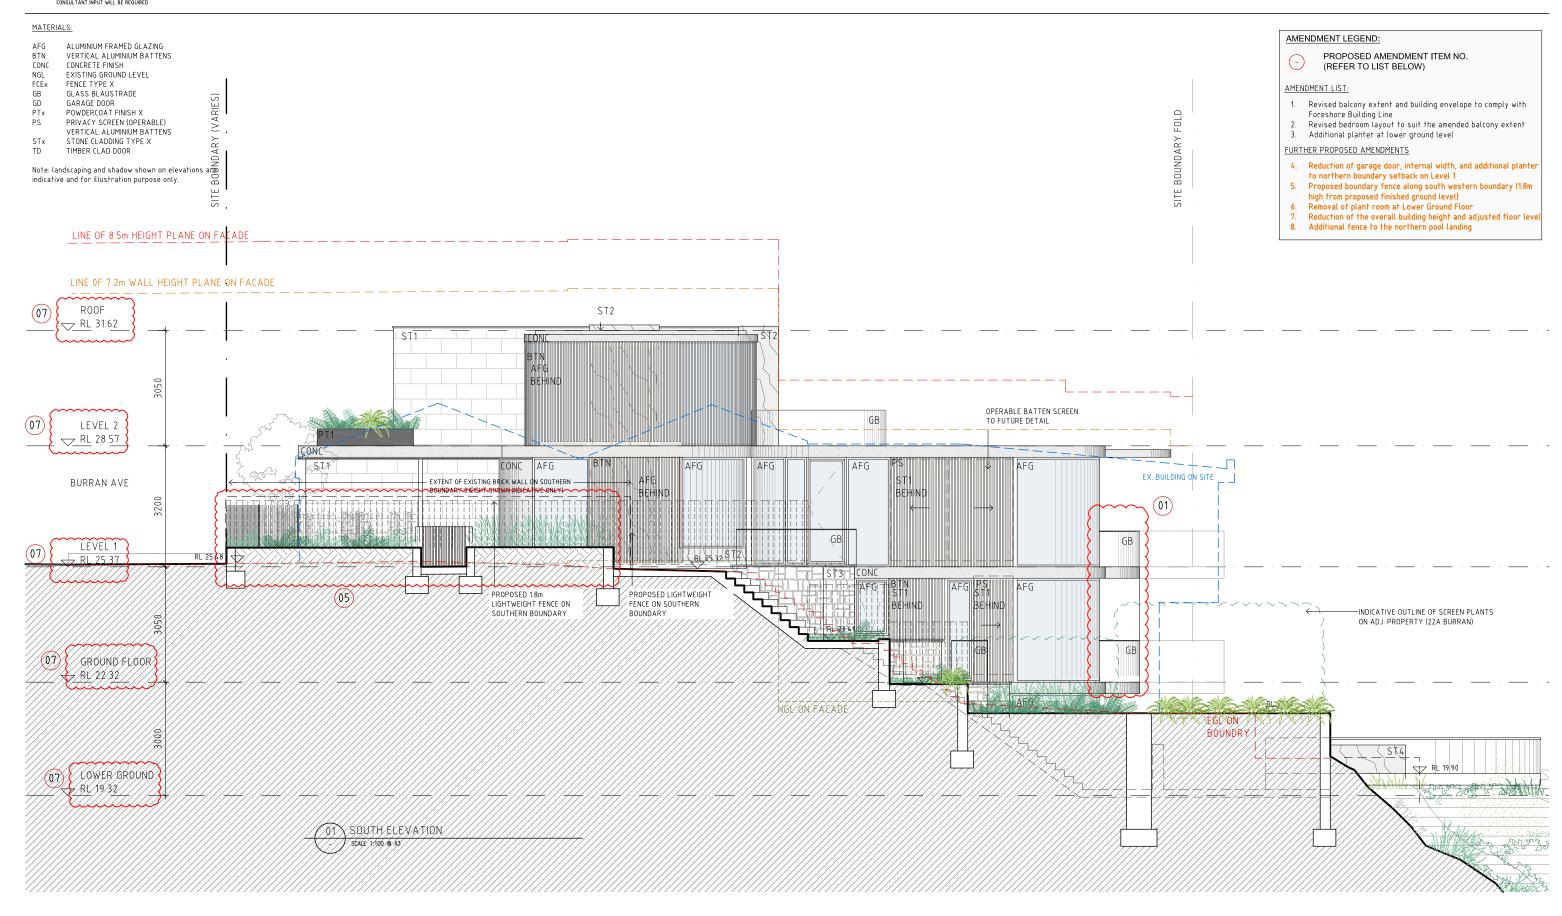

DEVELOPMENT APPLICATION DRAWINGS DA213 DESCRIPTION **ELEVATIONS 04** PROPOSED SINGLE RESIDENTIAL DWELLING 22c BURRAN AVENUE, MOSMAN NSW 2088 Lot 1, DP 730301 ABN 36 147 035 550 Level 2, 52 Albion Street, Surry H**li**s NSW 2010 architects.com.au W-www.pbdarchitects.com.au ISSUE: C CLIENT: SIT FAMILY TRUST & O'CONNELL STREET CADDENS UNIT TRUST JOB No. 1908


PROPOSED SINGLE RESIDENTIAL DWELLING

CLIENT: SIT FAMILY TRUST & O'CONNELL STREET CADDENS UNIT TRUST

25.10.2021 ISSUE FOR LEC

22c BURRAN AVENUE, MOSMAN NSW 2088 Lot 1, DP 730301

- ALL WORK TO COMPLY WITH BUILDING CODE OF AUSTRALIA, REQUIREMENTS OF RELEVANT STATUTORY AUTHORITIES / LOCAL GOVERNMENT &
 RELEVANT AUSTRALIAN BUILDING STANDARDS
 CONTRACTOR TO VERIFY ALL DIMENSIONS ON SITE BEFORE COMMENCING WORK SHOULD A DISCREPANCY BE IDENTIFIED PLEASE CONFIRM WITH
 ACHITECT PRIOR TO PROCEEDING IOD NOT SCALE FROM DRAWINGS!
 COPYRIGHT OF DESIGNS SHOWN HERBON IS RETAINED BY THIS OFFICE AND AUTHORITY IS REQUIRED FOR ANY REPRODUCTION
 DRAWINGS FOR THE PURPOSES OF DA ONLY FURTHER CONSULTANT / AUTHORITY COORDINATION WILL BE REQUIRED AT CC STAGE WHICH MAY
 MHACT ON DESIGN AND PLANNIC LAYOUTS
 WHEN PROPRIETARY PRODUCTS ARE REFERRED TO, INSTALL IN ACCORDANCE WITH THE MANUFACTURERS WRITTEN INSTRUCTIONS
 AREA SCHEDULES SUPPLIED AND APPROXIMATE ONLY FUTURE ALLOWANCE FOR VERTICAL SERVICE DUCTS, STRUCTURAL WALL SYSTEMS AND
 CONSULTANT INPUT WILL BE REQUIRED

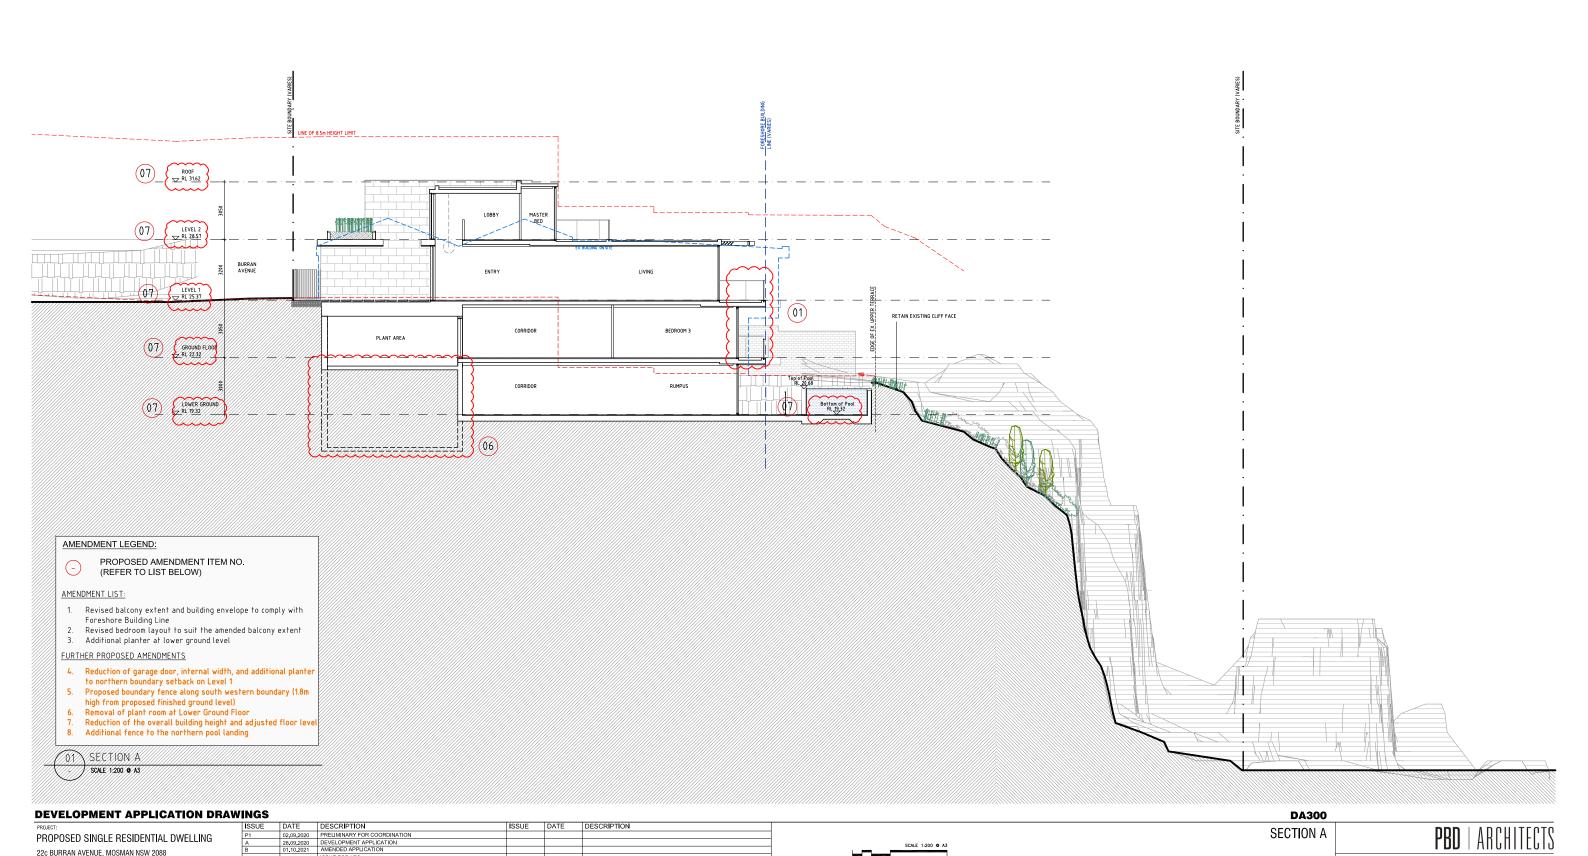


SECTION A

ISSUE: C

CLIENT: SIT FAMILY TRUST & O'CONNELL STREET CADDENS UNIT TRUST

- ALL WORK TO COMPLY WITH BUILDING CODE OF AUSTRALIA, REQUIREMENTS OF RELEVANT STATUTORY AUTHORITIES / LOCAL GOVERNMENT &
 RELEVANT AUSTRALIAN BUILDING STANDARDS
 CONTRACTOR TO VERIFY ALL DIMENSIONS ON SITE BEFORE COMMENCING WORK SHOULD A DISCREPANCY BE IDENTIFIED PLEASE CONFIRM WITH
 ACHITECT PRIOR TO PROCEEDING IOD NOT SCALE FROM DRAWINGS!
 COPYRIGHT OF DESIGNS SHOWN HERBON IS RETAINED BY THIS OFFICE AND AUTHORITY IS REQUIRED FOR ANY REPRODUCTION
 DRAWINGS FOR THE PURPOSES OF DA ONLY FURTHER CONSULTANT / AUTHORITY COORDINATION WILL BE REQUIRED AT CC STAGE WHICH MAY
 MHACT ON DESIGN AND PLANNIC LAYOUTS
 WHEN PROPRIETARY PRODUCTS ARE REFERRED TO, INSTALL IN ACCORDANCE WITH THE MANUFACTURERS WRITTEN INSTRUCTIONS
 AREA SCHEDULES SUPPLIED AND APPROXIMATE ONLY FUTURE ALLOWANCE FOR VERTICAL SERVICE DUCTS, STRUCTURAL WALL SYSTEMS AND
 CONSULTANT INPUT WILL BE REQUIRED

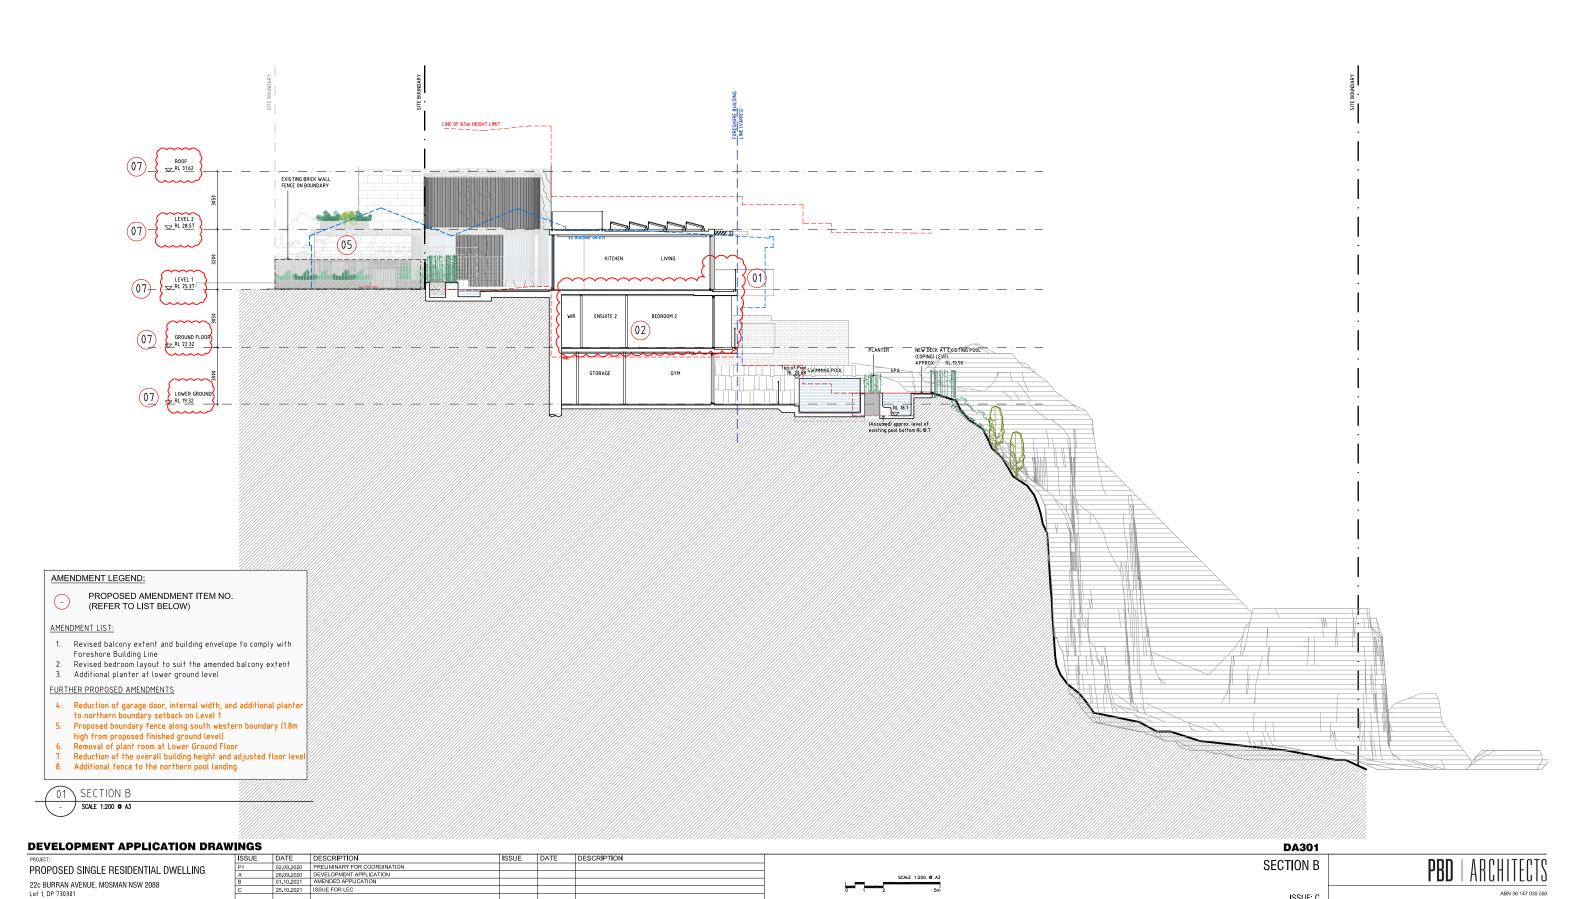


ISSUE: C

22c BURRAN AVENUE, MOSMAN NSW 2088 Lot 1, DP 730301


CLIENT: SIT FAMILY TRUST & O'CONNELL STREET CADDENS UNIT TRUST

- ALL WORK TO COMPLY WITH BUILDING CODE OF AUSTRALIA, REQUIREMENTS OF RELEVANT STATUTORY AUTHORITIES / LOCAL GOVERNMENT &
 RELEVANT AUSTRALIAN BUILDING STANDARDS
 CONTRACTOR TO VERIFY ALL DIMENSIONS ON SITE BEFORE COMMENCING WORK SHOULD A DISCREPANCY BE IDENTIFIED PLEASE CONFIRM WITH
 ACHITECT PRIOR TO PROCEEDING IOD NOT SCALE FROM DRAWINGS!
 COPYRIGHT OF DESIGNS SHOWN HERBON IS RETAINED BY THIS OFFICE AND AUTHORITY IS REQUIRED FOR ANY REPRODUCTION
 DRAWINGS FOR THE PURPOSES OF DA ONLY FURTHER CONSULTANT / AUTHORITY COORDINATION WILL BE REQUIRED AT CC STAGE WHICH MAY
 MHACT ON DESIGN AND PLANNIC LAYOUTS
 WHEN PROPRIETARY PRODUCTS ARE REFERRED TO, INSTALL IN ACCORDANCE WITH THE MANUFACTURERS WRITTEN INSTRUCTIONS
 AREA SCHEDULES SUPPLIED AND APPROXIMATE ONLY FUTURE ALLOWANCE FOR VERTICAL SERVICE DUCTS, STRUCTURAL WALL SYSTEMS AND
 CONSULTANT INPUT WILL BE REQUIRED

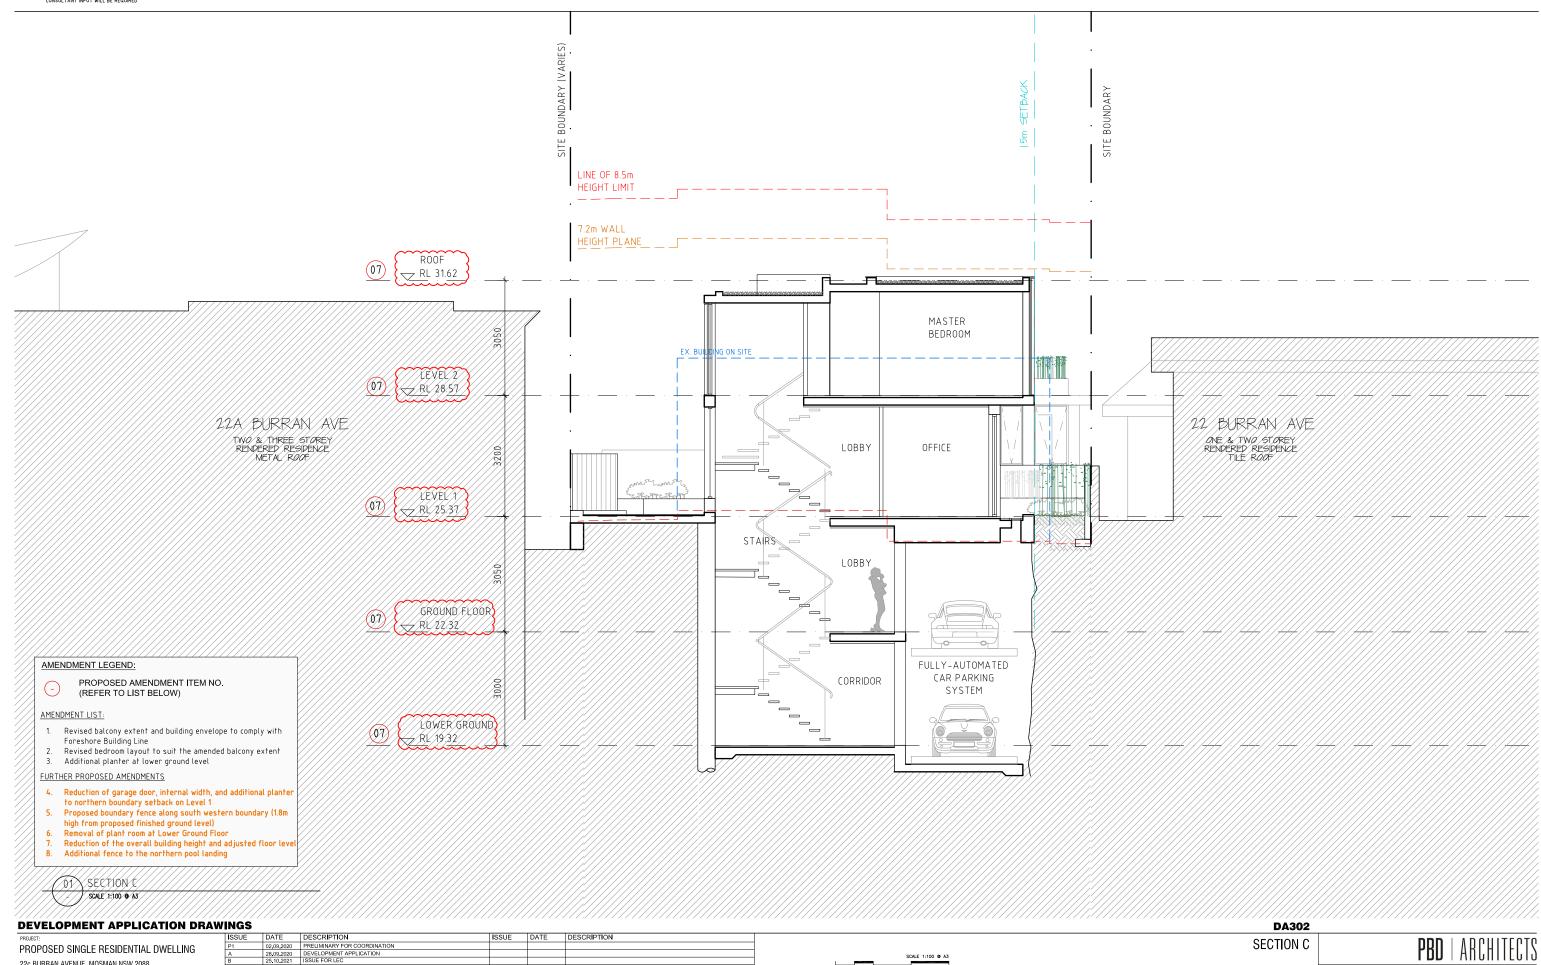

ISSUE: B

- ALL WORK TO COMPLY WITH BUILDING CODE OF AUSTRALIA, REQUIREMENTS OF RELEVANT STATUTORY AUTHORITIES / LOCAL GOVERNMENT &
 RELEVANT AUSTRALIAN BUILDING STANDARDS
 CONTRACTOR TO VERIFY ALL DIMENSIONS ON SITE BEFORE COMMENCING WORK SHOULD A DISCREPANCY BE IDENTIFIED PLEASE CONFIRM WITH
 ACHITECT PRIOR TO PROCEEDING IOD NOT SCALE FROM DRAWINGS!
 COPYRIGHT OF DESIGNS SHOWN HERBON IS RETAINED BY THIS OFFICE AND AUTHORITY IS REQUIRED FOR ANY REPRODUCTION
 DRAWINGS FOR THE PURPOSES OF DA ONLY FURTHER CONSULTANT / AUTHORITY COORDINATION WILL BE REQUIRED AT CC STAGE WHICH MAY
 MHACT ON DESIGN AND PLANNIC LAYOUTS
 WHEN PROPRIETARY PRODUCTS ARE REFERRED TO, INSTALL IN ACCORDANCE WITH THE MANUFACTURERS WRITTEN INSTRUCTIONS
 AREA SCHEDULES SUPPLIED AND APPROXIMATE ONLY FUTURE ALLOWANCE FOR VERTICAL SERVICE DUCTS, STRUCTURAL WALL SYSTEMS AND
 CONSULTANT INPUT WILL BE REQUIRED

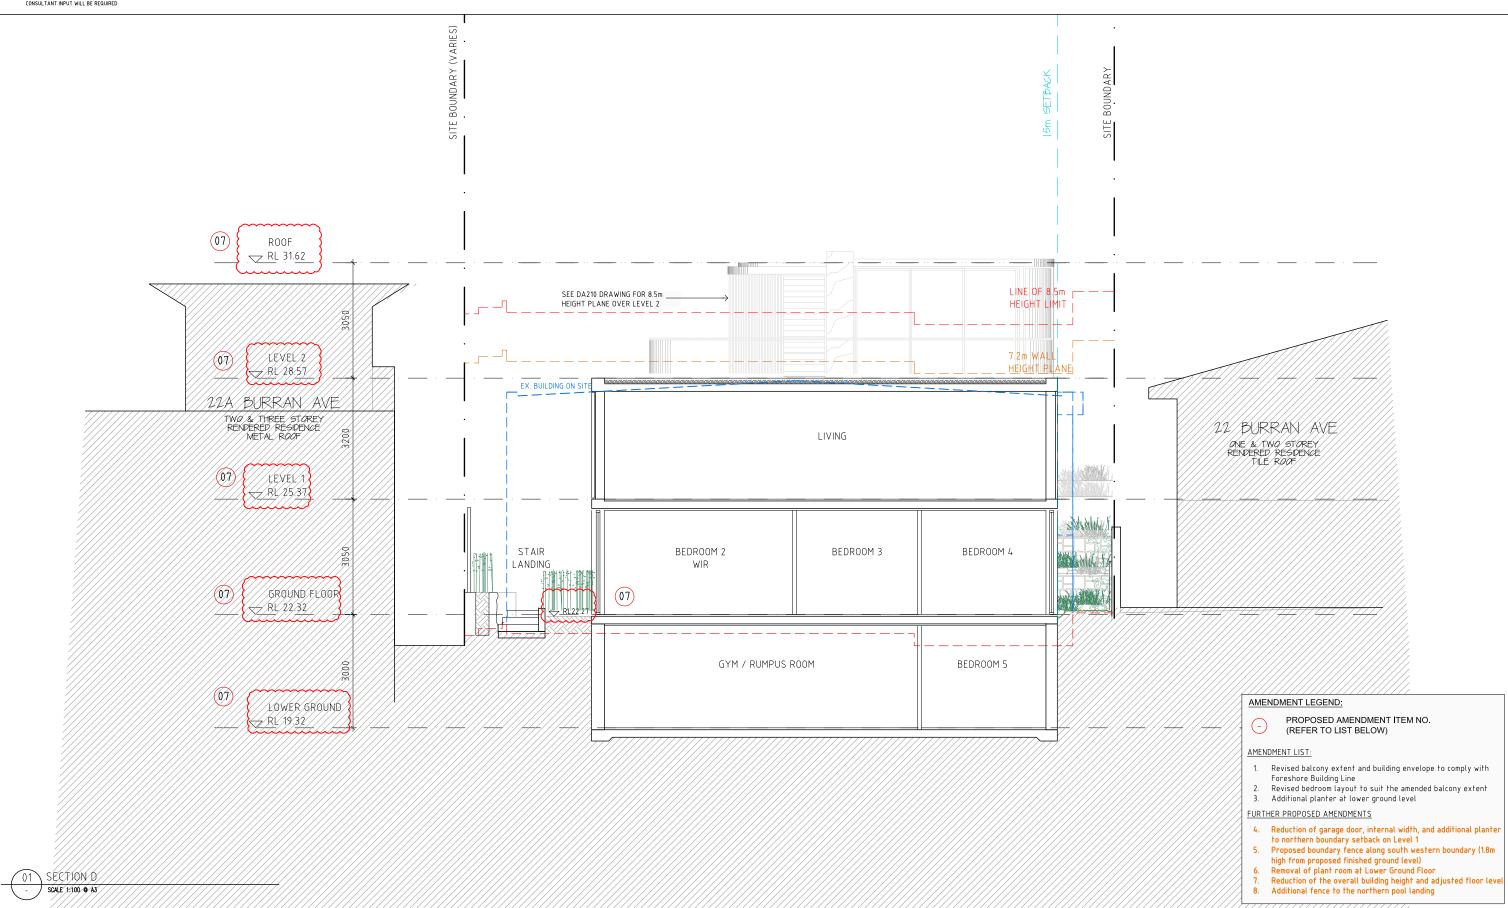

DEVELOPMENT APPLICATION DRAWINGS

PROPOSED SINGLE RESIDENTIAL DWELLING 22c BURRAN AVENUE, MOSMAN NSW 2088 Lot 1, DP 730301

CLIENT: SIT FAMILY TRUST & O'CONNELL STREET CADDENS UNIT TRUST

	P1	02.09.2020	DEVELOPMENT APPLICATION			
	Α	28.09.2020	DEVELOPMENT APPLICATION			
	В	25.10.2021	ISSUE FOR LEC			
[
I						


SECTION D


ISSUE: B

JOB No. 1908


DA303

- ALL WORK TO COMPLY WITH BUILDING CODE OF AUSTRALIA, REQUIREMENTS OF RELEVANT STATUTORY AUTHORITIES / LOCAL GOVERNMENT &
 RELEVANT AUSTRALIAN BUILDING STANDARDS
 CONTRACTOR TO VERIFY ALL DIMENSIONS ON SITE BEFORE COMMENCING WORK SHOULD A DISCREPANCY BE IDENTIFIED PLEASE CONFIRM WITH
 ACHITECT PRIOR TO PROCEEDING IOD NOT SCALE FROM DRAWINGS!
 COPYRIGHT OF DESIGNS SHOWN HERBON IS RETAINED BY THIS OFFICE AND AUTHORITY IS REQUIRED FOR ANY REPRODUCTION
 DRAWINGS FOR THE PURPOSES OF DA ONLY FURTHER CONSULTANT / AUTHORITY COORDINATION WILL BE REQUIRED AT CC STAGE WHICH MAY
 MHACT ON DESIGN AND PLANNIC LAYOUTS
 WHEN PROPRIETARY PRODUCTS ARE REFERRED TO, INSTALL IN ACCORDANCE WITH THE MANUFACTURERS WRITTEN INSTRUCTIONS
 AREA SCHEDULES SUPPLIED AND APPROXIMATE ONLY FUTURE ALLOWANCE FOR VERTICAL SERVICE DUCTS, STRUCTURAL WALL SYSTEMS AND
 CONSULTANT INPUT WILL BE REQUIRED

 

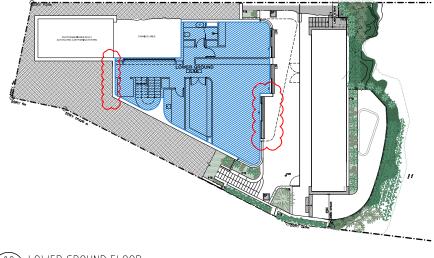


02 LOWER GROUND FLOOR

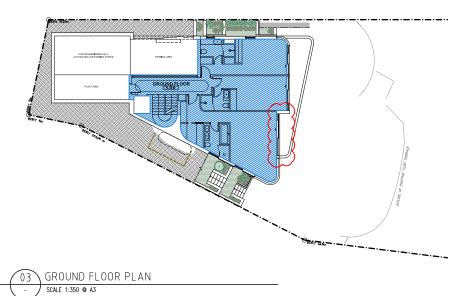





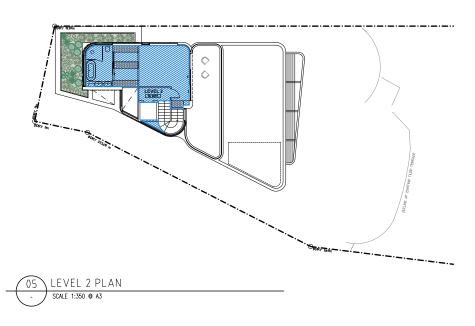

AMENDMENT LEGEND:


PROPOSED AMENDMENT ITEM NO. (REFER TO LIST BELOW)

AMENDMENT LIST:

- 1. Revised balcony extent and building envelope to comply with Foreshore Building Line
- 2. Revised bedroom layout to suit the amended balcony extent
- 3. Additional planter at lower ground level

FURTHER PROPOSED AMENDMENTS

- 4. Reduction of garage door, internal width, and additional planter to northern boundary setback on Level 1
 5. Proposed boundary fence along south western boundary (1.8m high from proposed finished ground level)
 6. Removal of plant room at Lower Ground Floor
 7. Reduction of the overall building height and adjusted floor level
 8. Additional fence to the northern pool landing

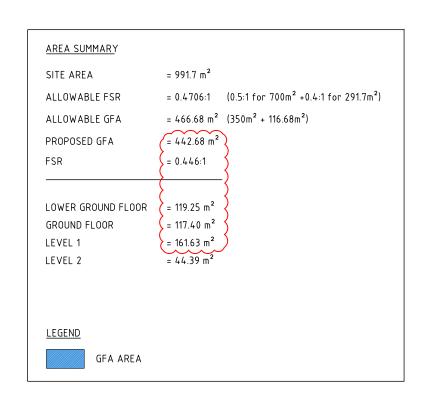

DEVELOPMENT APPLICATION DRAWINGS

PROPOSED SINGLE RESIDENTIAL DWELLING

22c BURRAN AVENUE, MOSMAN NSW 2088 Lot 1, DP 730301

CLIENT: SIT FAMILY TRUST & O'CONNELL STREET CADDENS UNIT TRUST

ISSUE	DATE	DESCRIPTION	ISSUE	DATE	DESCRIPTION	Γ
P1	23.09.2020	PRELIMINARY FOR COORDINATION				ĺ
Α	28.09.2020	DEVELOPMENT APPLICATION				ĺ
В	01.10.2021	AMENDED APPLICATION				ĺ
С	25.10.2021	ISSUE FOR LEC				ı
						ĺ
						ĺ
						Ĺ





ISSUE: C JOB No. 1908