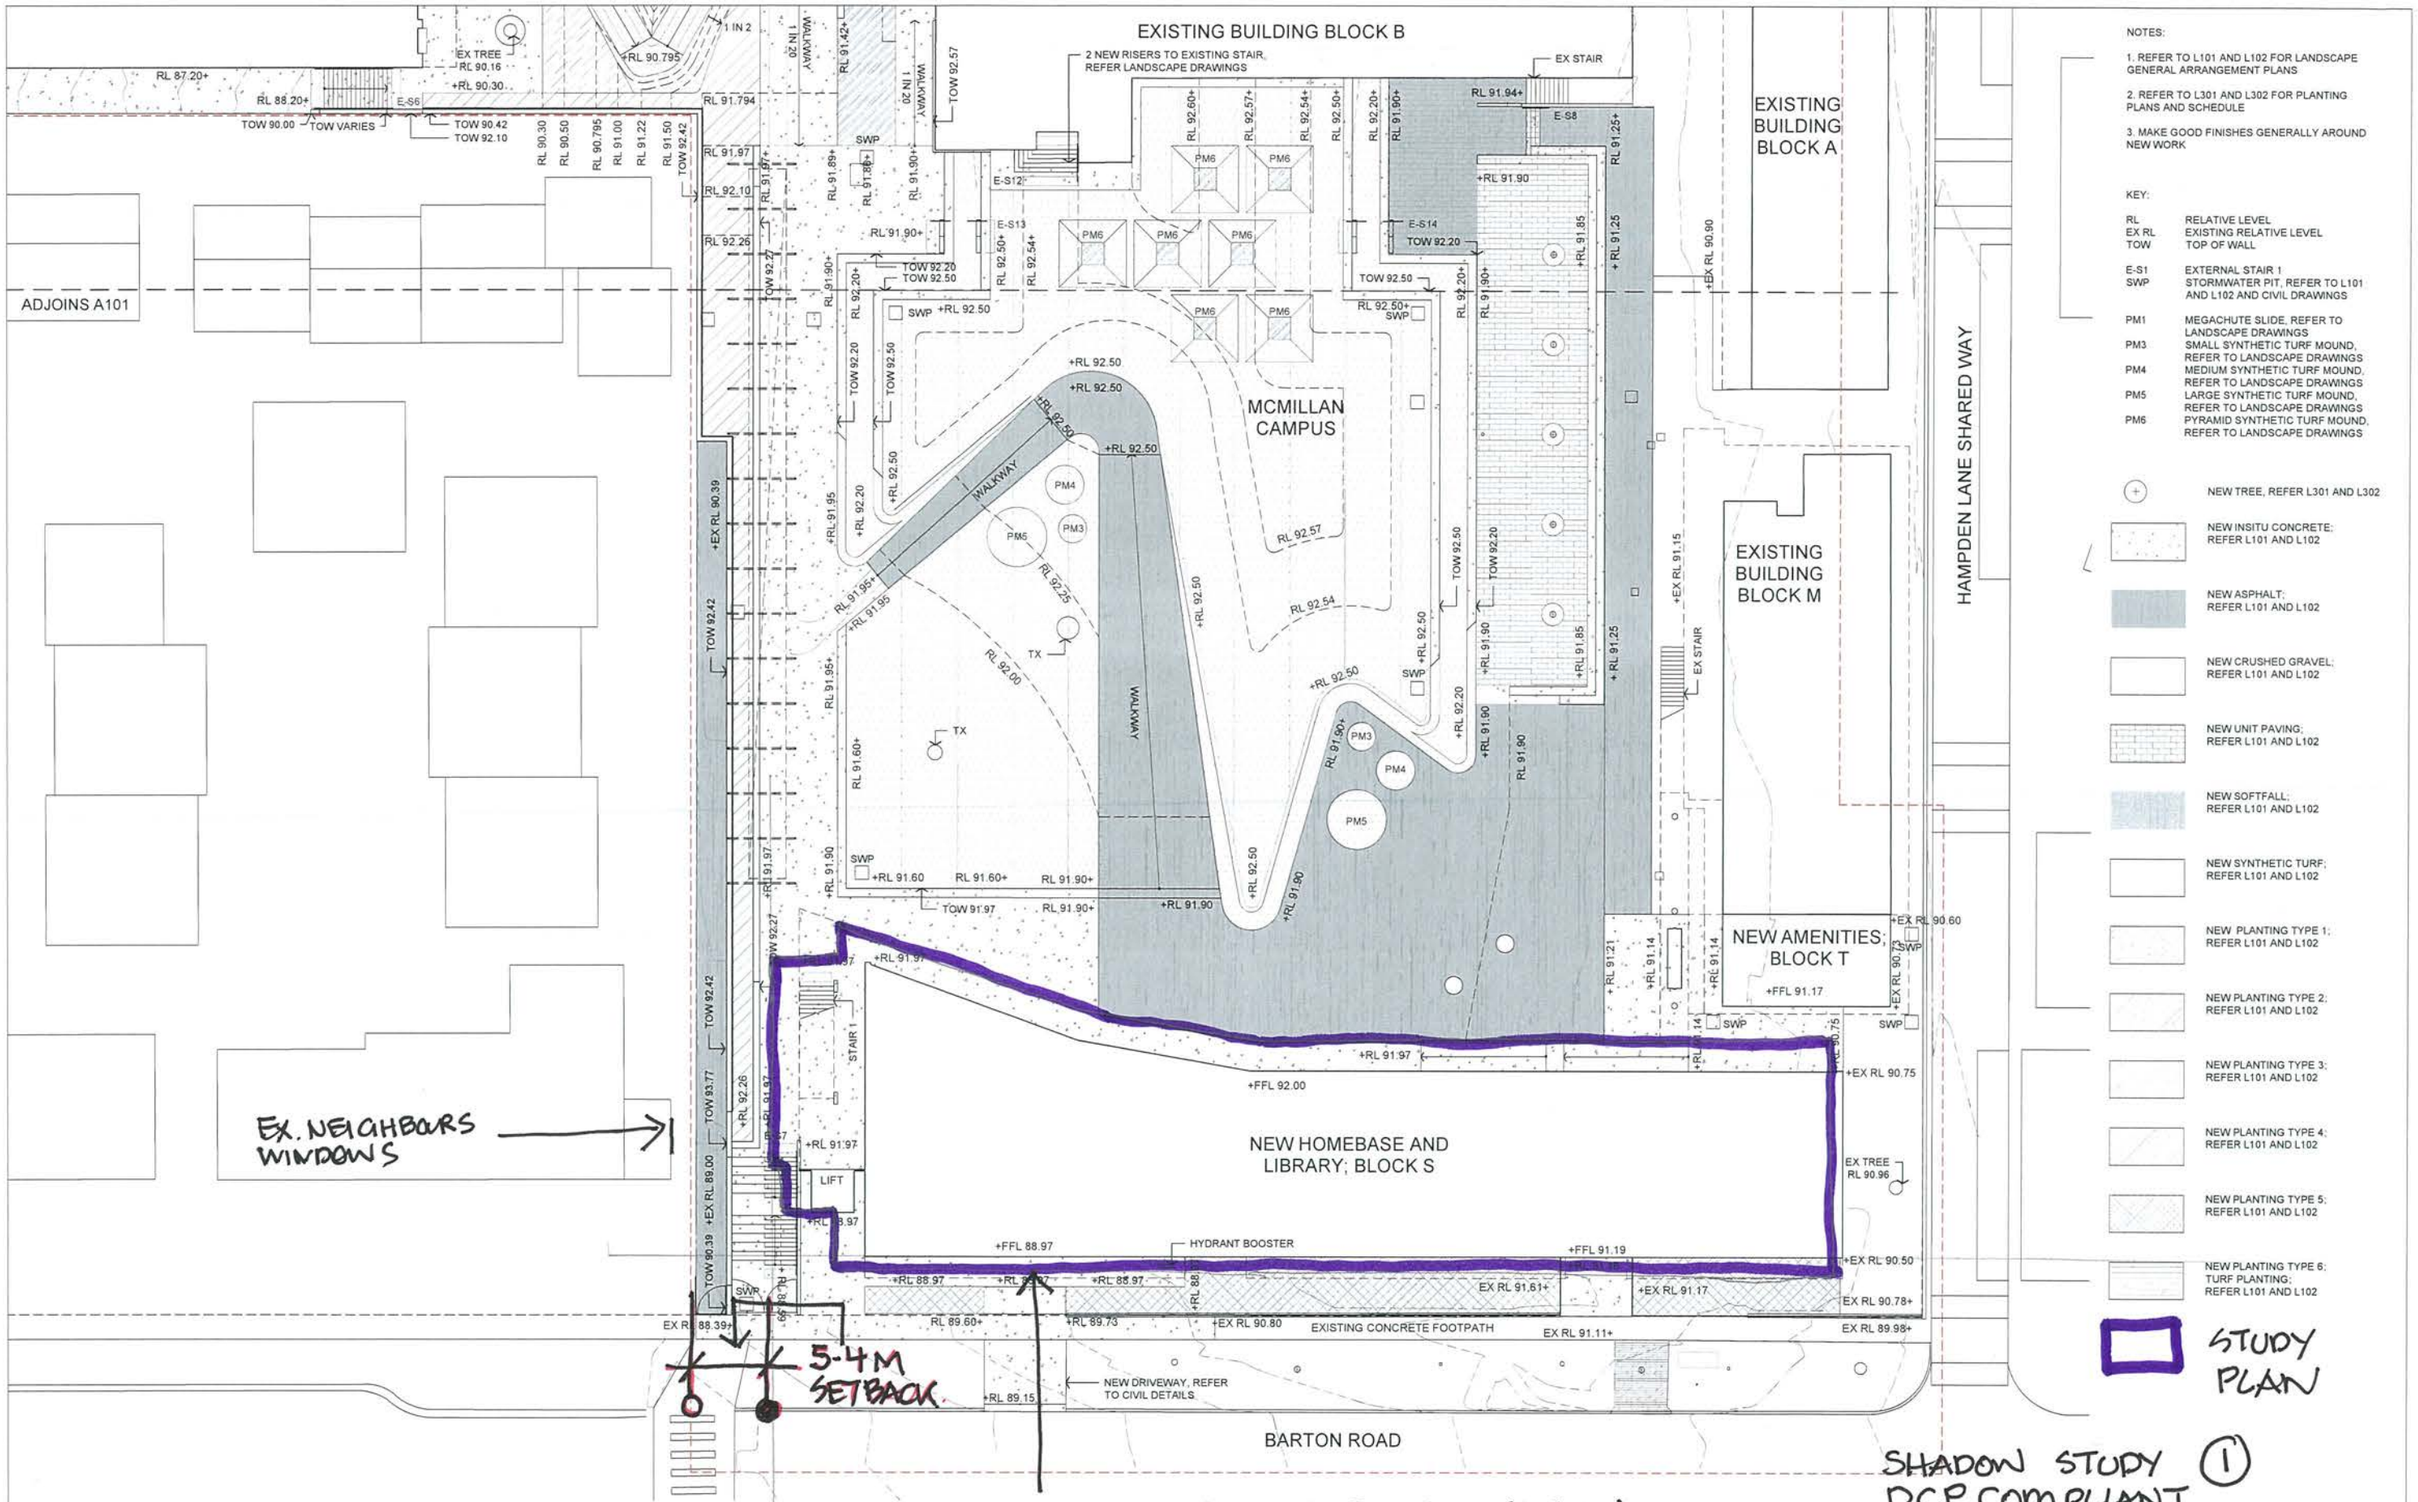

NOTES:

1. REFER TO L101 AND L102 FOR LANDSCAPE GENERAL ARRANGEMENT PLANS
2. REFER TO L301 AND L302 FOR PLANTING PLANS AND SCHEDULE
3. MAKE GOOD FINISHES GENERALLY AROUND NEW WORK

KEY:

RL	RELATIVE LEVEL
EX RL	EXISTING RELATIVE LEVEL
TOW	TOP OF WALL
E-S1	EXTERNAL STAIR 1
SWP	STORMWATER PIT, REFER TO L101 AND L102 AND CIVIL DRAWINGS
PM1	MEGACHUTE SLIDE, REFER TO LANDSCAPE DRAWINGS
PM3	SMALL SYNTHETIC TURF MOUND, REFER TO LANDSCAPE DRAWINGS
PM4	MEDIUM SYNTHETIC TURF MOUND, REFER TO LANDSCAPE DRAWINGS
PM5	LARGE SYNTHETIC TURF MOUND, REFER TO LANDSCAPE DRAWINGS
PM6	PYRAMID SYNTHETIC TURF MOUND, REFER TO LANDSCAPE DRAWINGS

NEW TREE, REFER L301 AND L302

NEW INSITU CONCRETE; REFER L101 AND L102

NEW ASPHALT; REFER L101 AND L102

NEW CRUSHED GRAVEL; REFER L101 AND L102

NEW UNIT PAVING; REFER L101 AND L102

NEW SOFTFALL; REFER L101 AND L102

NEW SYNTHETIC TURF; REFER L101 AND L102

NEW PLANTING TYPE 1; REFER L101 AND L102

NEW PLANTING TYPE 2; REFER L101 AND L102

NEW PLANTING TYPE 3; REFER L101 AND L102

NEW PLANTING TYPE 4; REFER L101 AND L102

NEW PLANTING TYPE 5; REFER L101 AND L102

NEW PLANTING TYPE 6; TURF PLANTING; REFER L101 AND L102

01 MCMILLAN CAMPUS SITE LEVELS AND GRADING PLAN
SCALE 1:200@A1

LEGEND
REFER TO COLOUR & FINISHES SCHEDULE FOR DETAIL OF TYPES & COLOURS

ACC1	ASPHALTIC CONCRETE COLOUR (Na INDICATES COLOUR)	CP1	CARPET TYPE 1 (Na INDICATES TYPE)	GL	GROUNDLINE	PN.1	PINBOARD LINING (Na INDICATES COLOUR & TYPE)	SC	STEEL COLUMN
AL1	ALUM LOUVRE (Na INDICATES TYPE)	DPL	DOOR PANEL LIFT	GLE	EXISTING GROUND LINE	PV1	PAVING TYPE 1 (Na INDICATES TYPE)	SKT	SKIRTINGS
AW	AWNING WINDOW	DSC	DOOR SOLID CORE	HR	HANDRAIL GENERALLY	PC 1	POWDER COATED STEEL (Na INDICATES TYPE)	SPR	SPREADER
BWC	BALUSTRADE WIRE MESH	DSG	DOOR SLIDING GLAZED	(P1)	INTERNAL PAINT COLOUR 1 (Na INDICATES COLOUR)	RBC	BARGE CAPPING	STF1	SYNTHETIC TURF (Na INDICATES TYPE)
BAL	BALUSTRADE	EDB	ELECTRICAL DISTRIBUTION BOARD	EP	EXTERNAL PAINT COLOUR 1 (Na INDICATES COLOUR)	RFS	FASCIA GENERALLY	TOW	TOP OF WALL
BV	BUILDING OUTLINE UNDER	E.P1	EXTERNAL PAINT COLOUR 1 (Na INDICATES COLOUR)	KG	KERB FLUSH	RF 1	RESILIENT FLOORING (Na INDICATES TYPE & COLOUR)	TGD	TACTILE GRID SURFACE INDICATORS
CHS	CIRCULAR HOLLOW SECTION	EQ	EQUAL	KR	KERB ROLLOVER			VP	VENT PIPE
COLA	COVERED OUTDOOR LEARNING AREA	F	FLUTING	LAM	LAMINATED (Na INDICATES COLOUR)	RHS	RECTANGULAR HOLLOW SECTION	WBL	WALL BLOCKWORK
CON	CONCRETE	FB	FACE BRICK (Na INDICATES TYPE)	GA	LOUVRE GLASS ADJUSTABLE	RL	RELATIVE LEVEL	WC	TOILET
CON-C	CONCRETE : COVED	FC 1	FIBRE CEMENT CLADDING/SOFFIT (Na INDICATES COLOUR)	LMF	LOUVRES METAL FIXED	RG	ROOF GUTTER	WCT 1	CERAMIC WALL TILING (Na INDICATES TYPE)
CON-H	CONCRETE : HONED	FCT	FLOOR CERAMIC TILES	MSB	MAIN SWITCH BOARD	RHC	ROOF RIDGE CAPPINGS	WS	WHEEL STOP
CON-G	CONCRETE : GRANOLITHIC TOPPING	FEN1	FENCE (Na INDICATES TYPE)	MSG-1	METAL SCREEN (Na INDICATES TYPE)	RS1	ROOF SHEETING (Na INDICATES TYPE)		
CON-S	CONCRETE : STEEL TROWELED	FFL	FINISHED FLOOR LEVEL	MSH 1	MESH CURTAIN (Na INDICATES TYPE)	RSF	ROOF FLASHING		
		FG	FIXED GLAZING	MVE	MECHANICAL VENT EXHAUST COWL	RW	RETAINING WALL		
		FL	FLASHING	NTS	NOT TO SCALE	RWG	RAINWATER GUTTER		
		FP	FLAG POLE	OFC	OFF FORM CONCRETE	RWP	RAINWATER DOWNPIPE 10 3.4m		
		FW	FLOOR WASTE	PB	PLASTERBOARD	RWP1	RAINWATER DOWNPIPE ABOVE 3.4m		
						RWT	RAINWATER TANK		

CP2	CHECK ON SITE	G1	GATE TYPE 1 (Na INDICATES TYPE)
DSG	DOOR GLAZED	(HR)	HANDRAIL GENERALLY
EX TREE	EXISTING TREE	KP	KERB PLUG

A1 0 10 20 30 40 50 60 70 80 90 100 — USE FIGURED DIMENSIONS IN PREFERENCE TO SCALING — CHECK ALL DIMENSIONS ON SITE — 200MM — 300MM ON ORIGINAL

REVISION		
ISS	DATE	COMMENT

DRAFT FOR COORDINATION

ARCHITECTURAL GOVERNMENT ARCHITECT'S OFFICE T 9372 6463	QUANTITY SURVEYOR GOVERNMENT ARCHITECT'S OFFICE T 9372 6382	LIFT GOVERNMENT ARCHITECT'S OFFICE T 9372 6103
LANDSCAPE TYRRELL STUDIO T 0410 528 528	STRUCTURAL GOVERNMENT ARCHITECT'S OFFICE T 9372 6227	FIRE ENGINEER OLSSON FIRE & RISK T 9372 6236 F 9372 6133
MECHANICAL GOVERNMENT ARCHITECT'S OFFICE T 9372 6101	BUILDING CODE CONSULTANT METRO BUILDING CONSULTANCY T 9892 8477 F 9299 4555	PROJECT MANAGEMENT NSW PUBLIC WORKS T 9852 6143
ELECTRICAL GOVERNMENT ARCHITECT'S OFFICE T 9372 6253	HYDRAULIC GOVERNMENT ARCHITECT'S OFFICE T 9372 6147	

NSW GOVERNMENT Public Works Government Architect's Office
BRUCE PETTMAN
Assistant Government Architect
Nominated Architect: ARN 7226
Level 15 Macquarie Building, 2-24 Rawson Place
Sydney NSW 2000 AUSTRALIA
A division of the Department of Finance, Services and Innovation
MARTIN HOFFMAN
Secretary

NSW GOVERNMENT Education

ARTARMON PUBLIC SCHOOL NEW FACILITIES PROJECT

SITE LEVELS & GRADING PLAN (1)

MCMILLAN CAMPUS

PLAN RW NO		CONTRACT NUMBER 15006 54
SCALES 1:200 @ A1		SHEET NO ~~A100~~
DESIGNED TYRRELL	PLOT DATE 07.04.2016	
DRAFTED TYRRELL	VERIFIED TYRRELL	REVISION

© CROWN IN RIGHT OF NSW THROUGH THE DEPARTMENT OF FINANCE, SERVICES AND INNOVATION

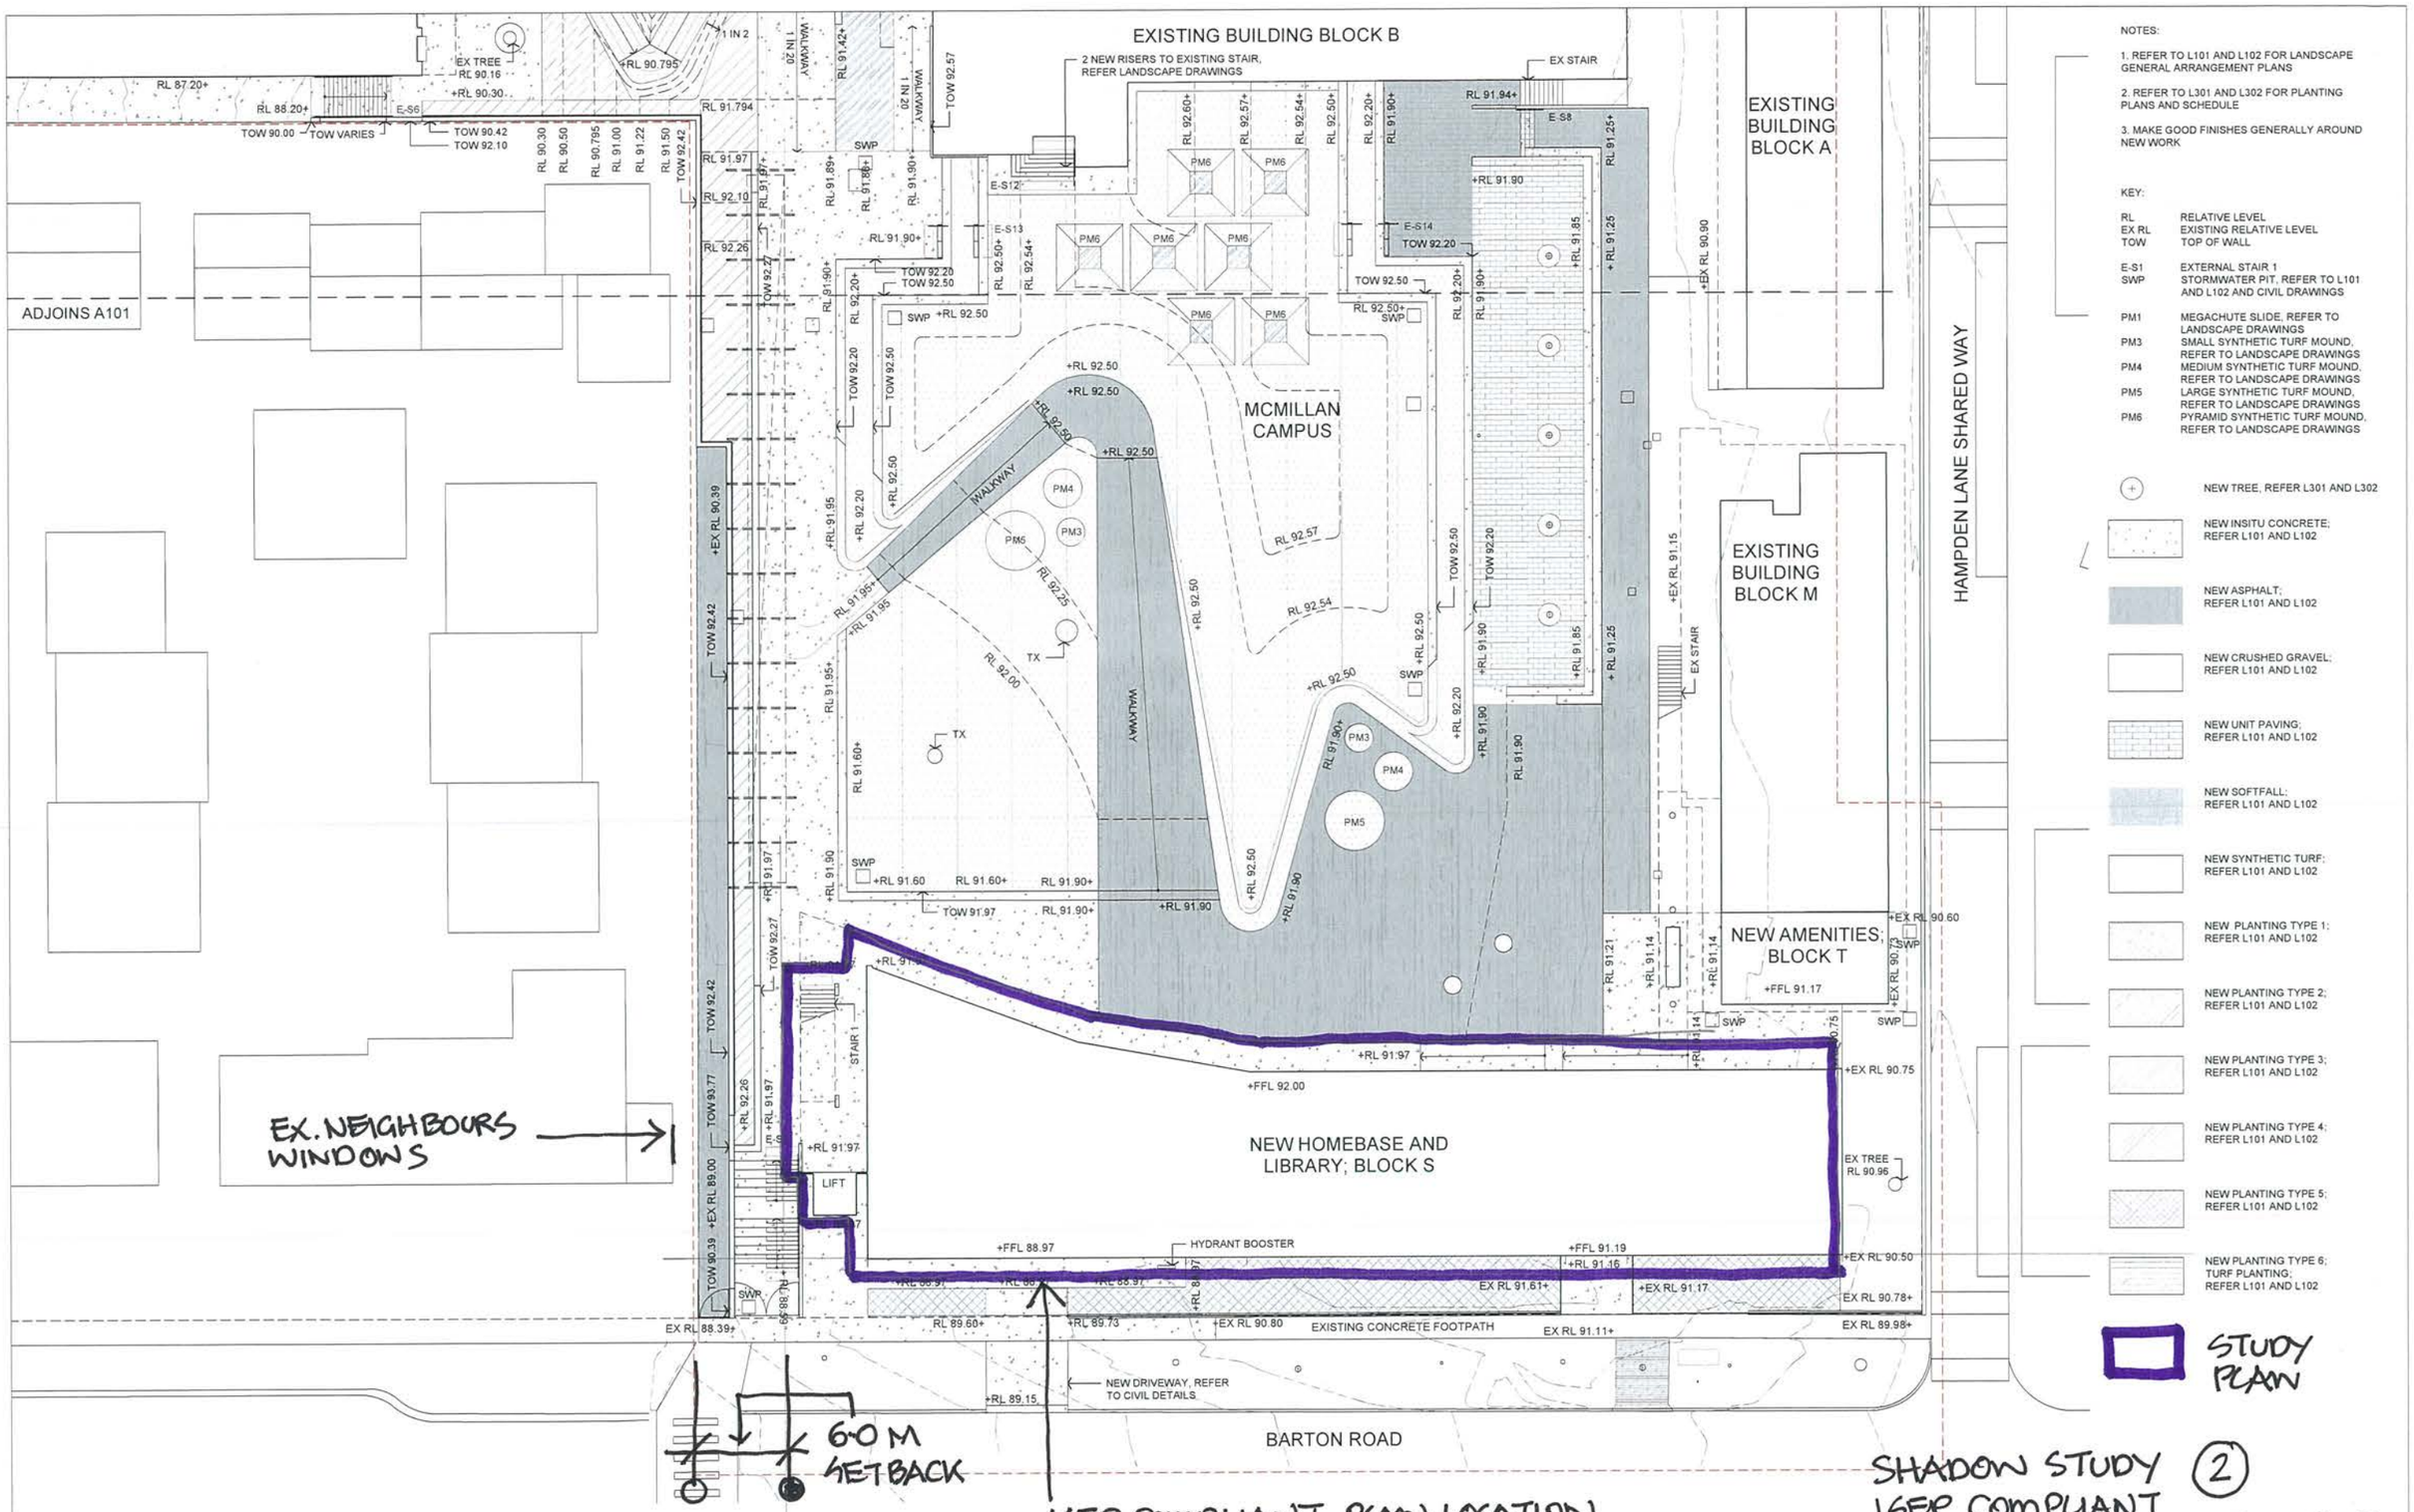

NOTES:

1. REFER TO L101 AND L102 FOR LANDSCAPE GENERAL ARRANGEMENT PLANS
2. REFER TO L301 AND L302 FOR PLANTING PLANS AND SCHEDULE
3. MAKE GOOD FINISHES GENERALLY AROUND NEW WORK

KEY:

RL	RELATIVE LEVEL
EX RL	EXISTING RELATIVE LEVEL
TOW	TOP OF WALL
E-S1	EXTERNAL STAIR 1
SWP	STORMWATER PIT, REFER TO L101 AND L102 AND CIVIL DRAWINGS
PM1	MEGACHUTE SLIDE, REFER TO LANDSCAPE DRAWINGS
PM3	SMALL SYNTHETIC TURF MOUND, REFER TO LANDSCAPE DRAWINGS
PM4	MEDIUM SYNTHETIC TURF MOUND, REFER TO LANDSCAPE DRAWINGS
PM5	LARGE SYNTHETIC TURF MOUND, REFER TO LANDSCAPE DRAWINGS
PM6	PYRAMID SYNTHETIC TURF MOUND, REFER TO LANDSCAPE DRAWINGS

NEW TREE, REFER L301 AND L302

NEW INSITU CONCRETE; REFER L101 AND L102

NEW ASPHALT; REFER L101 AND L102

NEW CRUSHED GRAVEL; REFER L101 AND L102

NEW UNIT PAVING; REFER L101 AND L102

NEW SOFTFALL; REFER L101 AND L102

NEW SYNTHETIC TURF; REFER L101 AND L102

NEW PLANTING TYPE 1; REFER L101 AND L102

NEW PLANTING TYPE 2; REFER L101 AND L102

NEW PLANTING TYPE 3; REFER L101 AND L102

NEW PLANTING TYPE 4; REFER L101 AND L102

NEW PLANTING TYPE 5; REFER L101 AND L102

NEW PLANTING TYPE 6; TURF PLANTING; REFER L101 AND L102

01 MCMILLAN CAMPUS SITE LEVELS AND GRADING PLAN
SCALE 1:200@A1

LEGEND
REFER TO COLOUR & FINISHES SCHEDULE FOR DETAIL OF TYPES & COLOURS

ACC1	ASPHALTIC CONCRETE COLOUR (№ INDICATES COLOUR)
AL /	ALUM LOUVRE (№ INDICATES TYPE)
AW	AWNING WINDOW
AWC	ACCESSIBLE WC
B	BOLLARD
BAL	BALUSTRADE
BU	BUILDING DOTTED UNDER
CHS	CIRCULAR HOLLOW SECTION
CLCA	CONCRETE OUTDOOR LEARNING AREA
CON	CONCRETE
CON-C	CONCRETE - COVED
CON-H	CONCRETE - HONED
CON-S	CONCRETE - SRAPNO/THAC TOPPING
CON-S	CONCRete - STEEL TROWELED
CQ	CHECK ON SITE
CPT /	CARPET TYPE 1 (№ INDICATES TYPE)
DPL	DOOR PANEL LIFT
DSC	DOOR SOLID CORE
DSG	DOOR SLIDING GLAZED
EDB	ELECTRICAL DISTRIBUTION BOARD
E.P.	EXTERNAL PAINT COLOUR / (№ INDICATES COLOUR)
EQ	EQUAL
ES	EXISTING
FB /	FACE BRICK (№ INDICATES TYPE)
FC /	FIBRE CEMENT CLADDING SOFFIT (№ INDICATES COLOUR)
FCT	FIBRE CEMENT TILE
FENC	FENCE (№ INDICATES TYPE)
FFL	FINISHED FLOOR LEVEL
FG	FIXED GLAZING
FL	FLASHING
FP	FLAG POLE
FW	FLOOR WASTE
GT	GATE TYPE 1 (№ INDICATES TYPE)
GL	GROUNDLINE
GLE	EXISTING GROUND LINE
HR	HANDRAIL GENERALLY
I.P /	INTERNAL PAINT COLOUR / (№ INDICATES COLOUR)
KF	KERB FLUSH
KG	KERB GUTTER
KR	KERB ROLLOVER
LAM	LAMINATE (№ INDICATES COLOUR)
LGA	LOUVRE GLASS ADJUSTABLE
LMF	LOUVRE METAL FIXED
MB	MAIL BOX - BANK
MSE /	METAL SCREEN (№ INDICATES TYPE)
MSH /	MESH CURTAIN (№ INDICATES TYPE)
MVE	MECHANICAL VENT EXHAUST COWL
NTS	NOT TO SCALE
OFC	OFF FORM CONCRETE
PB	PLASTERBOARD
PIN /	PINBOARD LINING (№ INDICATES COLOUR & TYPE)
PV /	PAVING TYPE 1 (№ INDICATES TYPE)
PC /	POWDER COATED STEEL (№ INDICATES TYPE)
RBC	BARGE CAPPING
RFS	FASCIA GENERALLY
RF /	RESILIENT FLOORING (№ INDICATES TYPE & COLOUR)
RHC	RECTANGULAR HOLLOW SECTION
RL	RELATIVE LEVEL
RS	ROOF SHEET
RRC	ROOF RIDGE CAPPING
RS1	ROOF SHEETING (№ INDICATES TYPE)
RSF	ROOF FLASHING
RW	RETAINING WALL
RWG	RAINWATER GUTTER
RWP	RAINWATER DOWNPIPE TO 2 kW
RWP /	RAINWATER DOWNPIPE ABOVE 2 kW
RWT	RAINWATER TANK
SC	STEEL COLUMN
SKT	SKIRTINGS
SPR	SPREADER
STF /	SYNTHETIC TURF (№ INDICATES TYPE)
TOW	TOP OF WALL
TGD	TACTILE GRND SURFACE INDICATORS
VP	VENT PIPE
WBL	WALL BLOCKWORK
WC	TOILET
WCT /	CERAMIC WALL TILING (№ INDICATES TYPE)
WS	WHEEL STOP

USE FIGURED DIMENSIONS IN PREFERENCE TO SCALING
CHECK ALL DIMENSIONS ON SITE

A1 — 300MM ON ORIGINAL — 200MM

REVISION		
ISS	DATE	COMMENT

DRAFT FOR COORDINATION

ARCHITECTURAL GOVERNMENT ARCHITECT'S OFFICE T 9372 8483	QUANTITY SURVEYOR GOVERNMENT ARCHITECT'S OFFICE T 9372 8382	LIFT GOVERNMENT ARCHITECT'S OFFICE T 9372 8163
LANDSCAPE TYRRELL STUDIO T 0419 928 928	STRUCTURAL GOVERNMENT ARCHITECT'S OFFICE T 9372 8227	FIRE ENGINEER DUDDON FIRE & RISK T 9372 8288 F 9372 8133
MECHANICAL GOVERNMENT ARCHITECT'S OFFICE T 9372 8161	BUILDING CODE CONSULTANT METRO BUILDING CONSULTANCY T 9652 6477 F 9299 4555	PROJECT MANANGEMENT NSW PUBLIC WORKS T 9852 9143
ELECTRICAL GOVERNMENT ARCHITECT'S OFFICE T 9372 8352	HYDRAULIC GOVERNMENT ARCHITECT'S OFFICE T 9372 8147	

NSW GOVERNMENT
Public Works
Government Architect's Office
BRUCE PETTMAN
Assistant Government Architect
Nominated Architect NRN 7228
Level 13 McKell Building, 2-24 Rawson Place
Sydney NSW 2000 AUSTRALIA
A division of the Department of Finance, Services and Innovation
MARTIN HOFFMAN
Secretary

NSW GOVERNMENT Education

ARTARMON PUBLIC SCHOOL NEW FACILITIES PROJECT
SITE LEVELS & GRADING PLAN (1)
MCMILLAN CAMPUS

PLAN RW NO		CONTRACT NUMBER 1500654
SCALES 1:200 @ A1		SHEET NO ~~A100~~
DESIGNED TYRRELL	PLOT DATE 07.04.2016	
DRAFTED TYRRELL	VERIFIED TYRRELL	REVISION

© CROWN IN RIGHT OF NSW THROUGH THE DEPARTMENT OF FINANCE, SERVICES AND INNOVATION

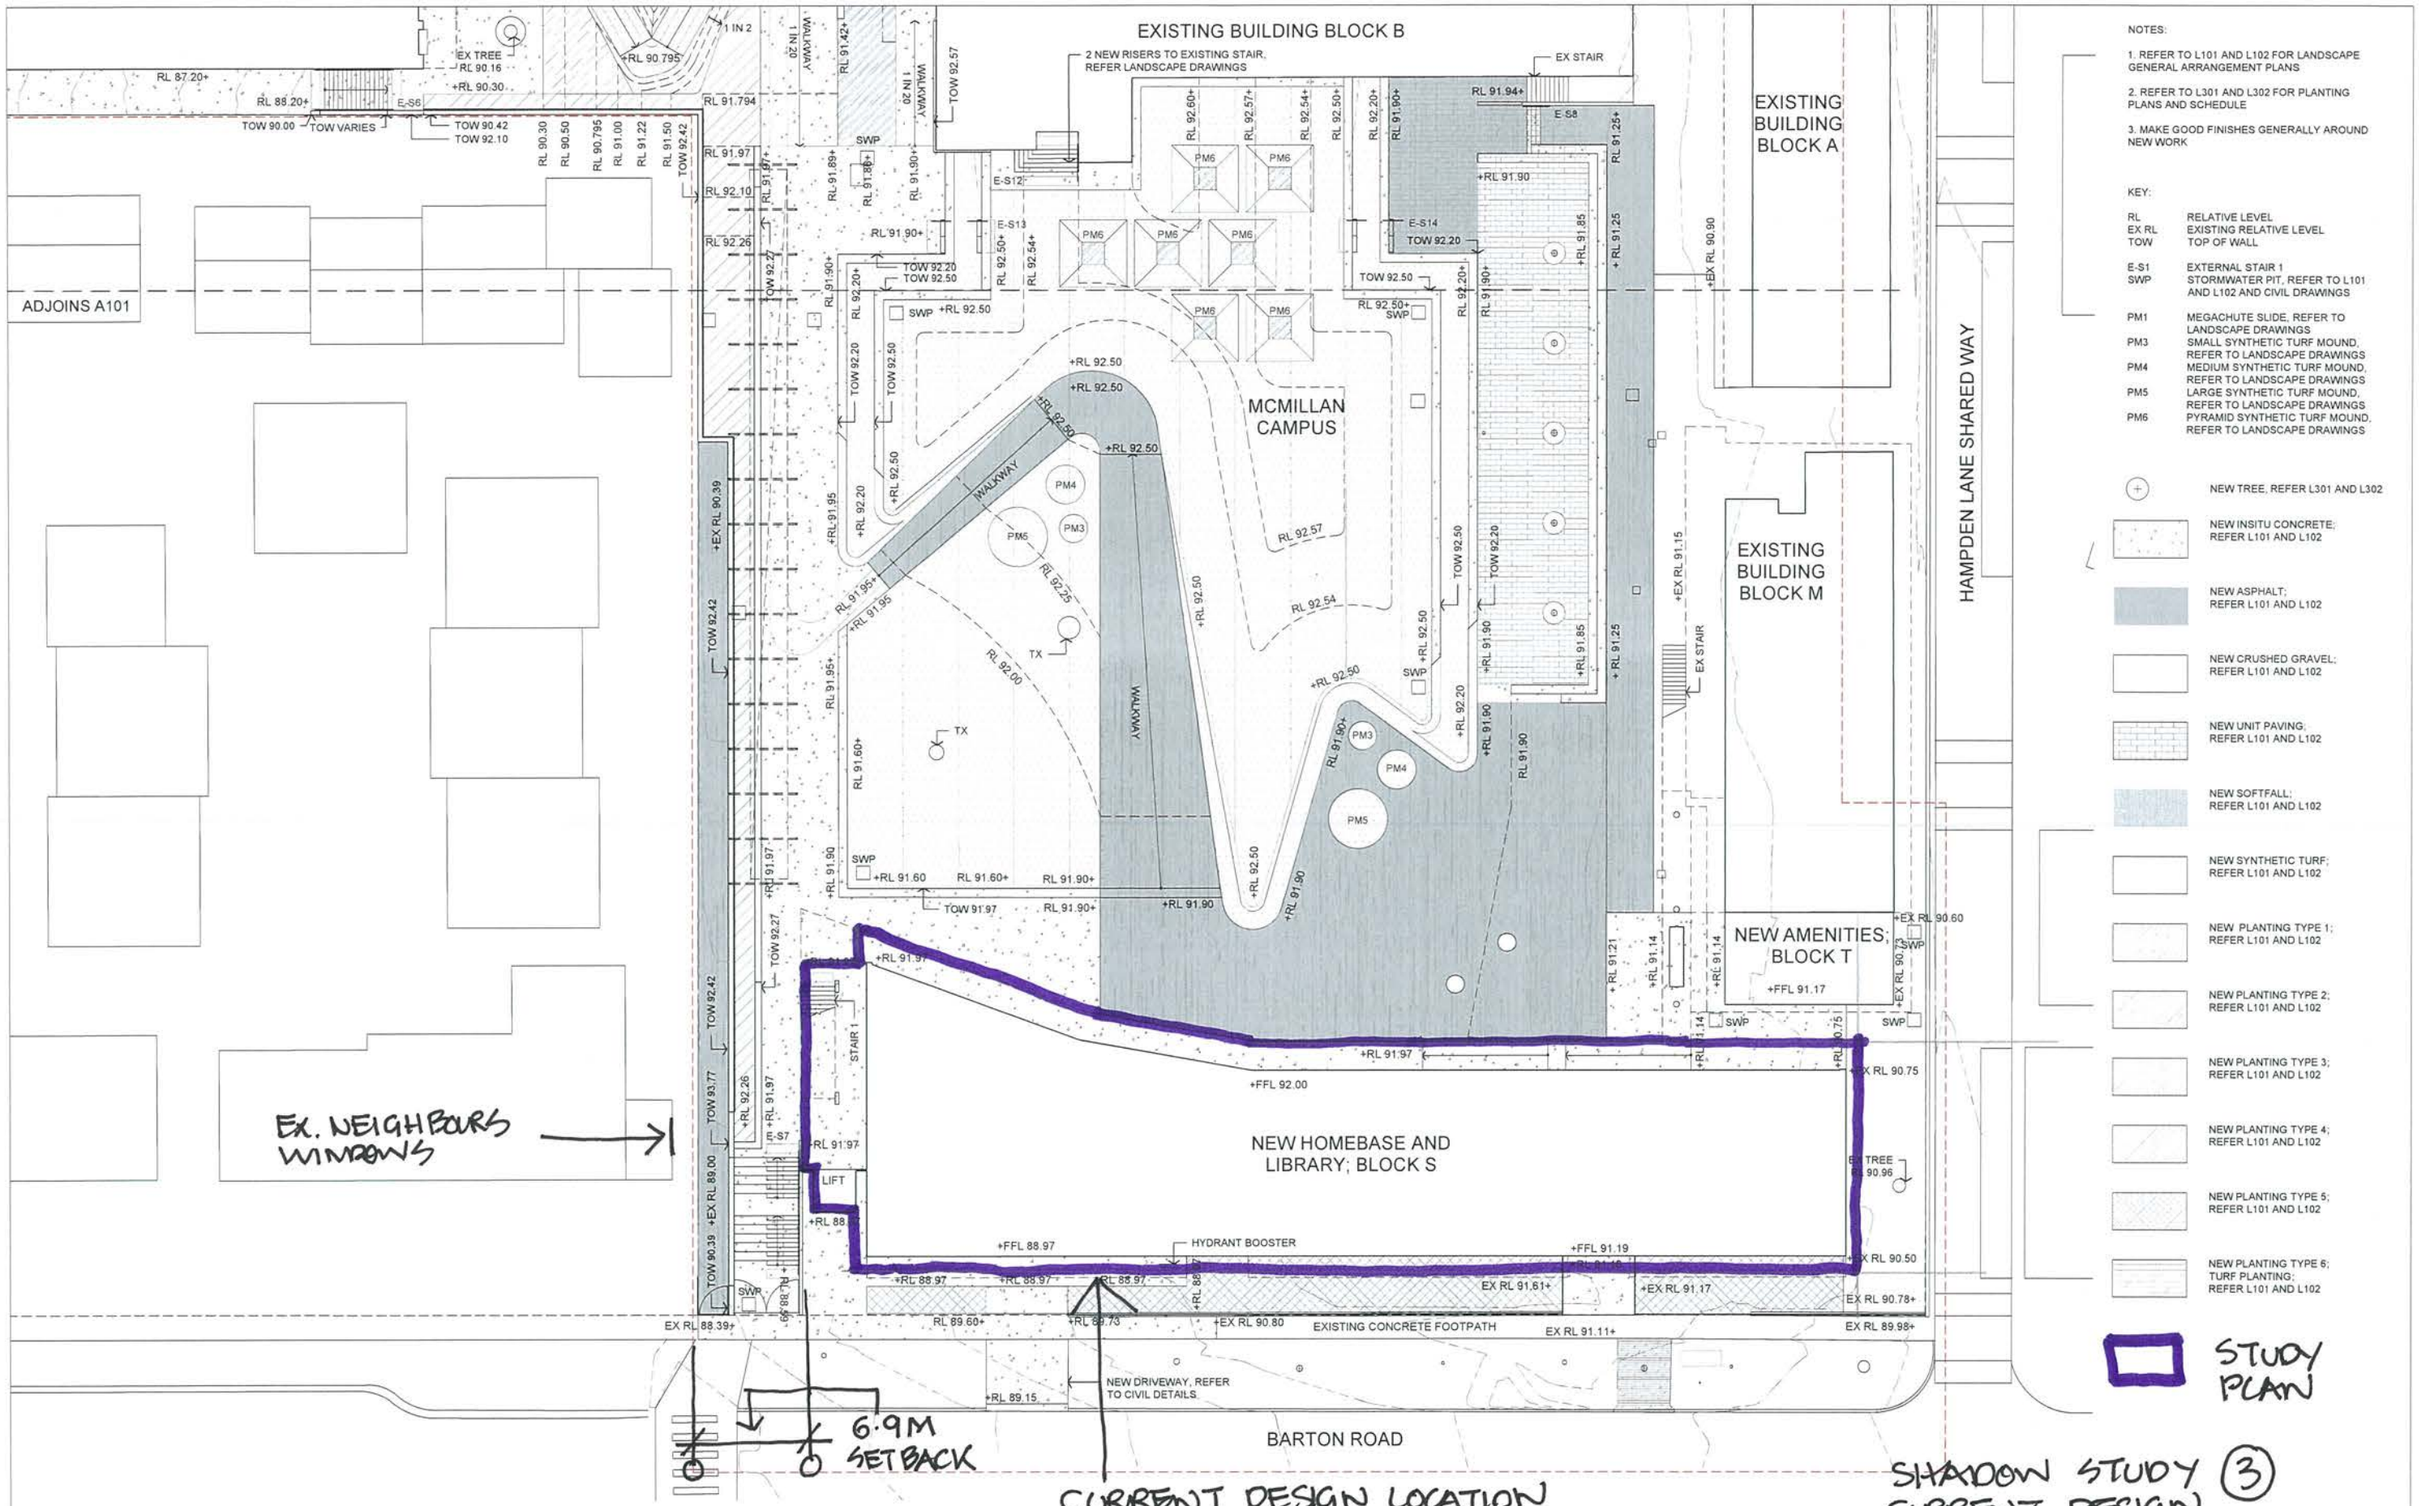

NOTES:

1. REFER TO L101 AND L102 FOR LANDSCAPE GENERAL ARRANGEMENT PLANS
2. REFER TO L301 AND L302 FOR PLANTING PLANS AND SCHEDULE
3. MAKE GOOD FINISHES GENERALLY AROUND NEW WORK

KEY:

RL	RELATIVE LEVEL
EX RL	EXISTING RELATIVE LEVEL
TOW	TOP OF WALL
E-S1	EXTERNAL STAIR 1
SWP	STORMWATER PIT, REFER TO L101 AND L102 AND CIVIL DRAWINGS
PM1	MEGACHUTE SLIDE, REFER TO LANDSCAPE DRAWINGS
PM3	SMALL SYNTHETIC TURF MOUND, REFER TO LANDSCAPE DRAWINGS
PM4	MEDIUM SYNTHETIC TURF MOUND, REFER TO LANDSCAPE DRAWINGS
PM5	LARGE SYNTHETIC TURF MOUND, REFER TO LANDSCAPE DRAWINGS
PM6	PYRAMID SYNTHETIC TURF MOUND, REFER TO LANDSCAPE DRAWINGS

NEW TREE, REFER L301 AND L302

NEW INSITU CONCRETE; REFER L101 AND L102

NEW ASPHALT; REFER L101 AND L102

NEW CRUSHED GRAVEL; REFER L101 AND L102

NEW UNIT PAVING; REFER L101 AND L102

NEW SOFTFALL; REFER L101 AND L102

NEW SYNTHETIC TURF; REFER L101 AND L102

NEW PLANTING TYPE 1; REFER L101 AND L102

NEW PLANTING TYPE 2; REFER L101 AND L102

NEW PLANTING TYPE 3; REFER L101 AND L102

NEW PLANTING TYPE 4; REFER L101 AND L102

NEW PLANTING TYPE 5; REFER L101 AND L102

NEW PLANTING TYPE 6; TURF PLANTING; REFER L101 AND L102

01 MCMILLAN CAMPUS SITE LEVELS AND GRADING PLAN
SCALE 1:200@A1

LEGEND

REFER TO COLOUR & FINISHES SCHEDULE FOR DETAIL OF TYPES & COLOURS.

ACC1	ASPHALTIC CONCRETE COLOUR (No INDICATES COLOUR)
AL-1	ALUM LOUVRE (No INDICATES TYPE)
AW	AWNING WINDOW
AWC	ACCESSIBLE WC
B	BOLLARD
BAL	BALUSTRADE(TO) UNDER
BU	BUILDING DOWN(TO) UNDER
CHS	CHAMBER HOLLOW SECTION
COLA	COVERED OUTDOOR LEARNING AREA
CON	CONCRETE
CON-C	CONCRETE - GUNITE
CON-H	CONCRETE - HONED
CON-G	CONCRETE - GRANOLITHIC TOPPING
CON-S	CONCRETE - STEEL TROWELED
COS	CHECK ON SITE
CP-1	CARPET TYPE 1 (No INDICATES TYPE)
DPL	DOOR PANEL LIFT
DSG	DOOR SOLID CORE
DGG	DOOR SIDING GLAZED
EDB	ELECTRICAL DISTRIBUTION BOARD
E.P.1	EXTERNAL PAINT COLOUR 1 (No INDICATES COLOUR)
EQ	EQUAL
EX	EXISTING
FB-1	FACE BRICK (No INDICATES TYPE)
FC-1	FIBRE CEMENT CLADDING/SOFFIT (No INDICATES COLOUR)
FCT	FIBRE CEMENT TILE (TO)
FENT	FENCE (No INDICATES TYPE)
FFL	FINISHED FLOOR LEVEL
FG	FIXED GLAZING
FL	FLASHING
FP	FLAG POLE
FW	FLOOR WASTE
G1	GATE TYPE 1 (No INDICATES TYPE)
GL	GROUND INF
GLE	EXISTING GROUND LINE
HR	HANDRAIL GENERALLY
LP1	INTERNAL PAINT COLOUR 1 (No INDICATES COLOUR)
KF	KERB FLUSH
KG	KERB GUTTER
KR	KERB ROLLOVER
LAM	LAMINATE (No INDICATES COLOUR)
LSA	LOUVRE SCASS ADJUSTABLE
LMF	LOUVRE METAL FIXED
MSB	MAIN SWITCH BOARD
MT	MESH TENSIONED (No INDICATES TYPE)
MSH	MESH CURTAIN (No INDICATES TYPE)
MVE	MECHANICAL VENT EXHAUST COWL
NTS	NOT TO SCALE
OFC	OFF FORM CONCRETE
PB	PLASTERBOARD
PIN-T	PINBOARD LINING (No INDICATES COLOUR & TYPE)
PV-1	PAVING TYPE 1 (No INDICATES TYPE)
PC-1	POWDER COATED STEEL (No INDICATES TYPE)
RBC	BARGE CAPPING
RFS	FASCIA GENERALLY
RF-1	RESILIENT FLOORING (No INDICATES TYPE & COLOUR)
RHC	RECTANGULAR HOLLOW SECTION
RL	RELATIVE LEVEL
RG	ROOF GUTTER
RBC	ROOF RIDGE CAPPINGS
RSC	ROOF SKYLIGHTING (No INDICATES TYPE)
RGF	ROOF FLASHING
RW	RETAINING WALL
RWG	RAINWATER GUTTER
RWP	RAINWATER DOWNPIPE TO 3 m
RWP1	RAINWATER DOWNPIPE ABOVE 3 m
RWT	RAINWATER TANK
SC	STEEL COLUMN
SKT	SKIRTINGS
SPR	SPREADER
STF1	SYNTHETIC TURF (No INDICATES TYPE)
TOW	TOP OF WALL
TGS	TACTILE GRID SURFACE INDICATORS
VP	VENT PIPE
WBL	WALL BLOCKWORK
WC	TOILET
WCT-1	CERAMIC WALL TILING (No INDICATES TYPE)
WS	WHEEL STOP

USE FIGURED DIMENSIONS IN PREFERENCE TO SCALING
CHECK ALL DIMENSIONS ON SITE

A1 — 200MM — 300MM ON ORIGINAL

REVISION		
ISS	DATE	COMMENT

DRAFT FOR COORDINATION

ARCHITECTURAL GOVERNMENT ARCHITECT'S OFFICE T 9372 6463	QUANTITY SURVEYOR GOVERNMENT ARCHITECT'S OFFICE T 9372 6382	LIFT GOVERNMENT ARCHITECT'S OFFICE T 9372 6103
LANDSCAPE TYRRELL STUDIO T 0415 528 505	STRUCTURAL GOVERNMENT ARCHITECT'S OFFICE T 9372 6227	FIRE ENGINEER OLSSON FIRE & RISK T 9372 6294 F 9372 6133
MECHANICAL GOVERNMENT ARCHITECT'S OFFICE T 9372 6101	BUILDING CODE CONSULTANT METRO BUILDING CONSULTANCY T 9692 6477 F 6209 4595	PROJECT MANAGEMENT NSW PUBLIC WORKS T 9692 6143
ELECTRICAL GOVERNMENT ARCHITECT'S OFFICE T 9372 6232	HYDRAULIC GOVERNMENT ARCHITECT'S OFFICE T 9372 6147	

NSW GOVERNMENT — Public Works
Government Architect's Office
BRUCE PETTMAN
Assistant Government Architect
Nominated Architect: ARN 7226
Level 13 Mirvac Building, 2-24 Rawson Place
Sydney NSW 2000 AUSTRALIA
A division of the Department of Finance, Services and Innovation
MARTIN HOFFMAN
Secretary

NSW GOVERNMENT Education

ARTARMON PUBLIC SCHOOL NEW FACILITIES PROJECT

SITE LEVELS & GRADING PLAN (1)

MCMILLAN CAMPUS

PLAN RM NO	
CONTRACT NUMBER	1500654
SCALES	1:200 @ A1
SHEET NO	~~A100~~
DESIGNED TYRRELL	PLOT DATE 07.04.2016
DRAFTED TYRRELL	VERIFIED TYRRELL
REVISION	

© CROWN IN RIGHT OF NSW THROUGH THE DEPARTMENT OF FINANCE, SERVICES AND INNOVATION

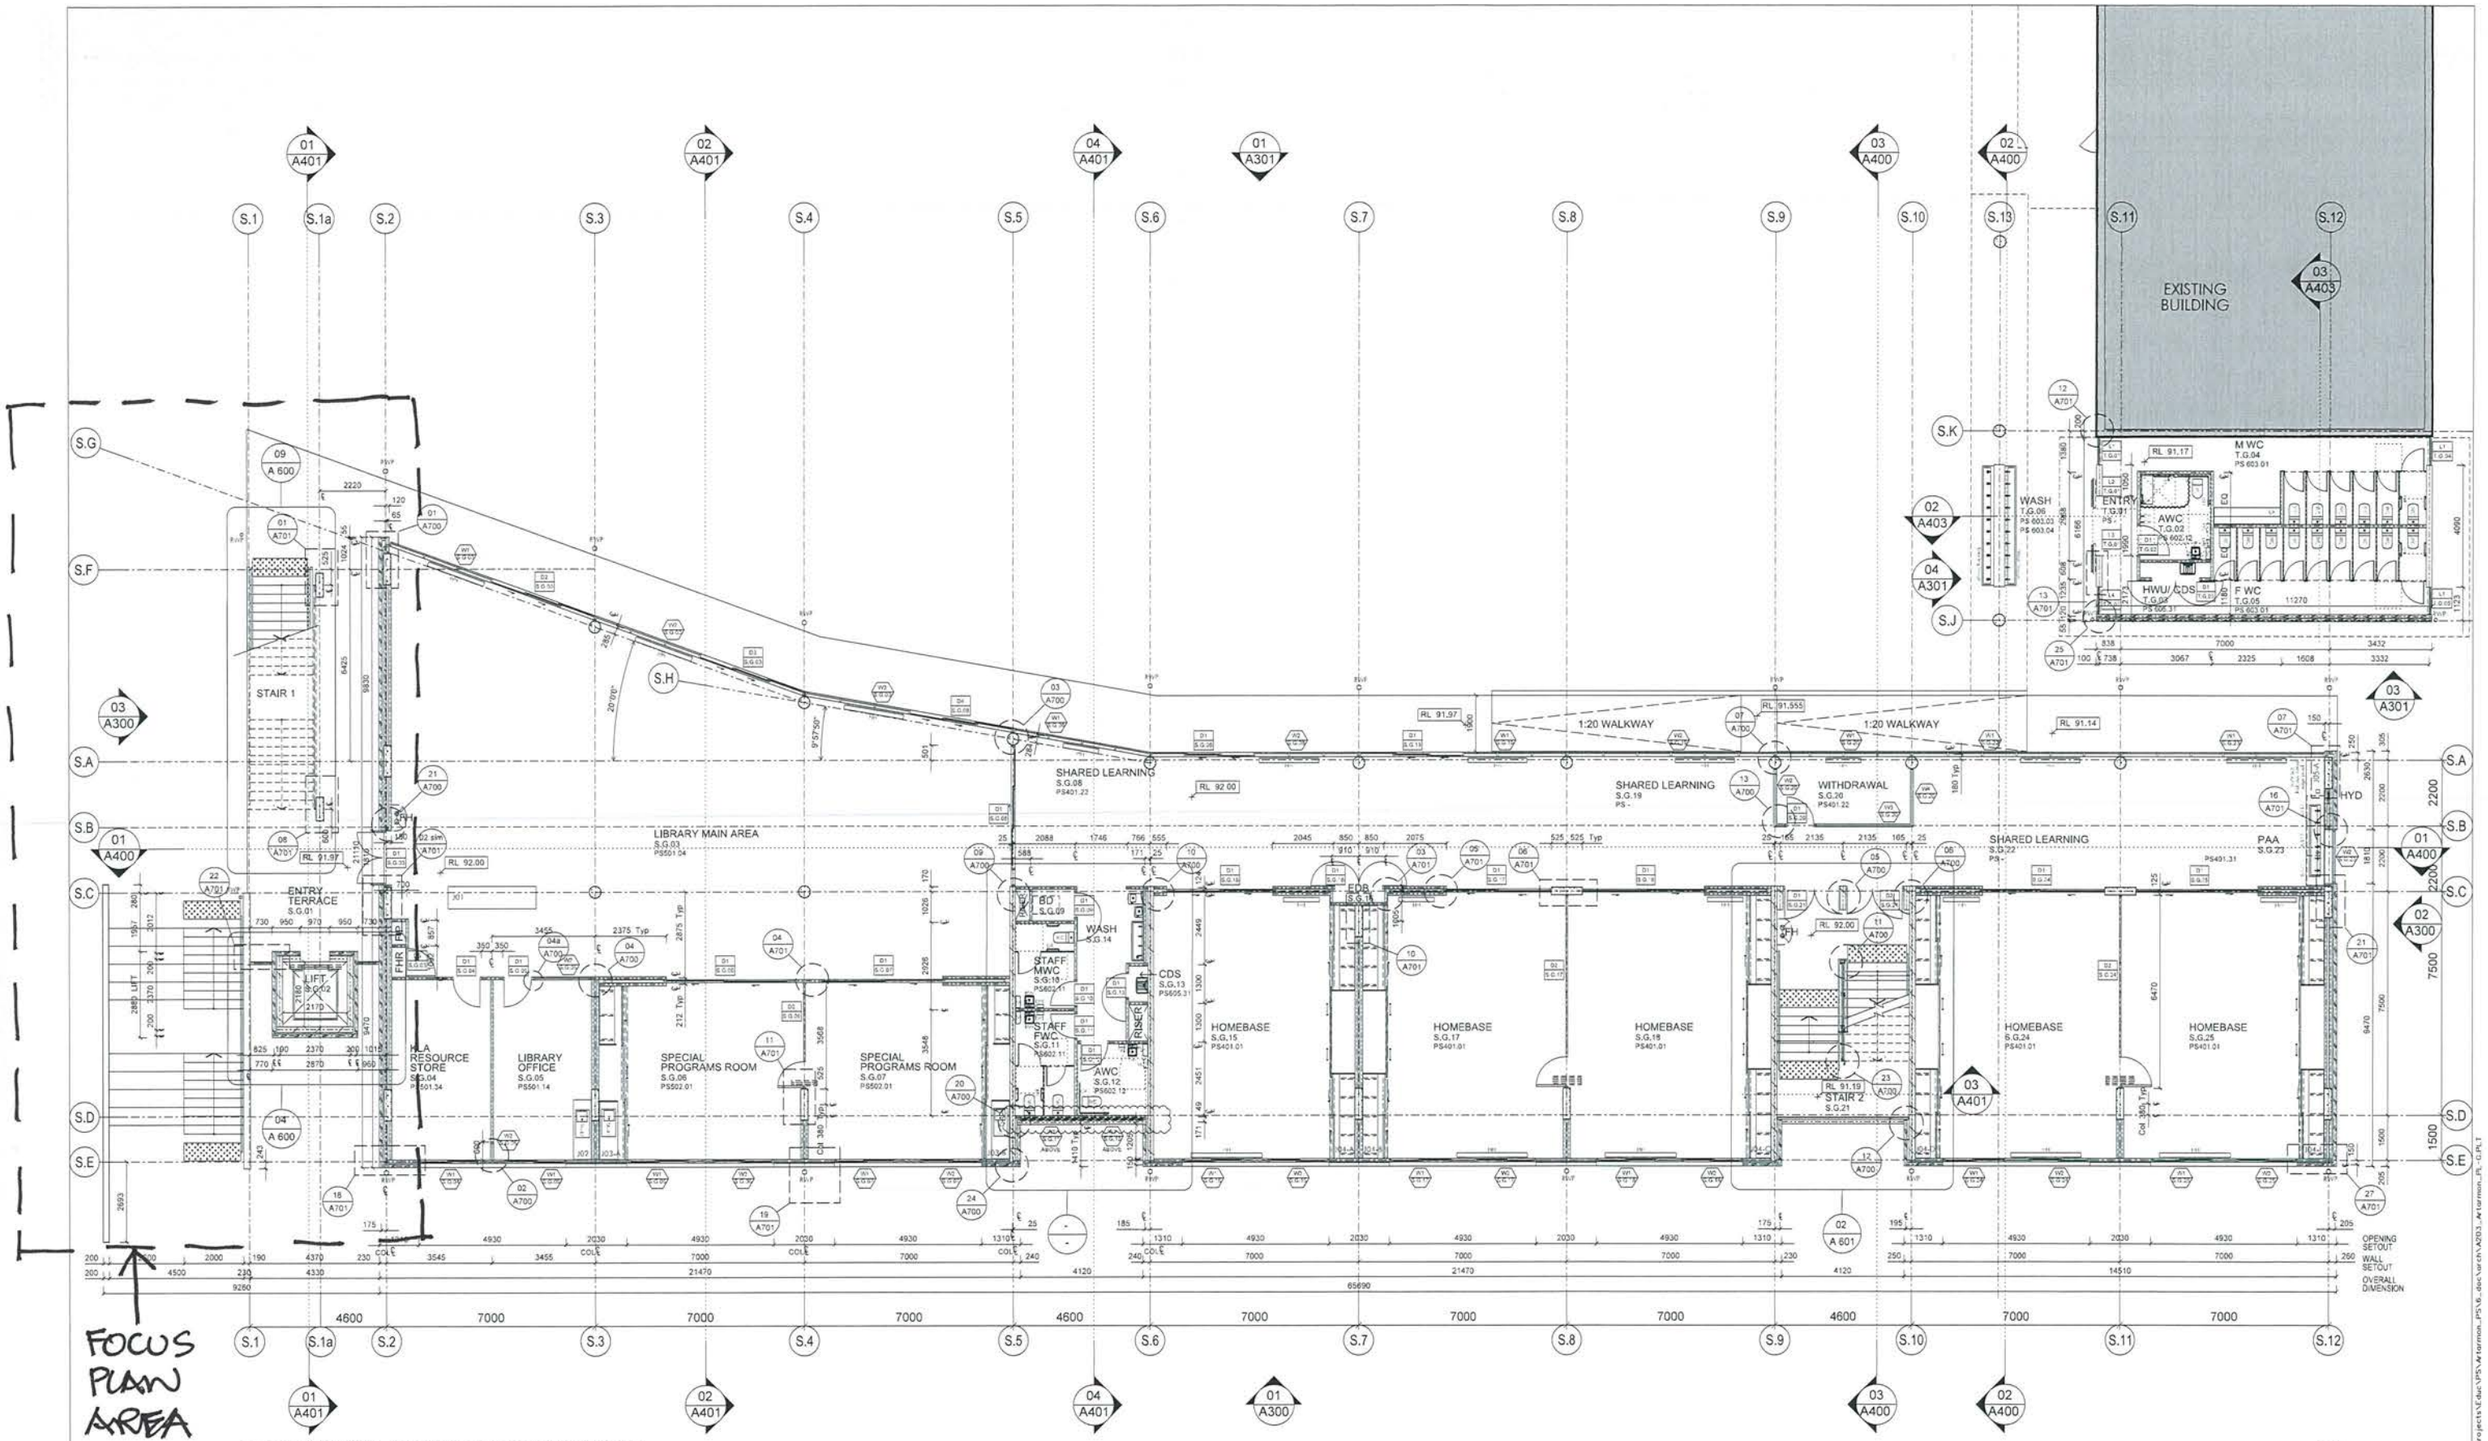

FOCUS PLAN AREA

01 BLOCKS S + T GROUND FLOOR PLAN
SCALE 1:100

SHADOW STUDY (3)
CURRENT DESIGN
GRN. FL RL = 92.00

LEGEND : WALL TYPES

- 200mm CONCRETE WALL
- 190mm CONC BLOCK WALL
- 110mm BRICK WALL
- 110mm BRICK WALL + 90mm CAVITY + 92mm STEEL STUD WALL
- 110mm BRICK WALL + 50mm CAVITY + 190mm CONC BLOCK WALL
- 230mm DOUBLE BRICK WALL
- 92mm STEEL STUD WALL
- RL 88.97 NEW RELATIVE LEVEL
- W1 (W1.01) ← WINDOW NUMBER
- ← ROOM NUMBER (Block Level.Room)
- D1 (S.1.09) ← DOOR NUMBER
- ← ROOM NUMBER (Block.Level.Room)

NOTES

1. REFER TO FINISHES PLAN FOR FLOOR & WALL FINISHES (INCLUDING PINBOARD LININGS)

LEGEND

REFER TO COLOUR & FINISHES SCHEDULE FOR DETAIL OF TYPES & COLOURS.

ACC1 ASPHALTIC CONCRETE COLOUR (No. INDICATES CO.OUR)
AL-1 ALUM.LOUVRE (No. INDICATES TYPE)
AW AWNING WINDOW
AWC ACCESSIBLE WC
B BOLLARD
BA BALUSTRADE
BU BUILDING DOTTED UNDER
CB CONCRETE BLOCK
CB-R CONCRETE BLOCK - RENDERED
CHS CHOLUX HOLLOW SECTION
CLA CARPET LAYOUT FOR LEARNING AREA
CON CONCRETE
CONC CONCRETE - COVED
CON-H CONCRETE - HONED
CON-G CONCRETE - GRANOLITHIC TOPPING
CPT CARPET TYPE (No. INDICATES TYPE)
DHC DOOR HANG LIFT
DSC DOOR SOLID CORE
DSG DOOR SLIDING GLASED
EDB ELECTRICAL DISTRIBUTION BOARD
E-P EXTERNAL PAINT COLOUR (No. INDICATES CO.OUR)
EQ EQUAL
EX EXISTING
FB-1 FACE BRICK (No. INDICATES TYPE)
FC-1 FIBRE CEMENT CLADDING SOFFIT (No. INDICATES CO.OUR)
FC FLOOR CONNECTIES
FENS FENCE (No. INDICATES TYPE)
FFL FINISHED FLOOR LEVEL
FG FIXED GLAZING
FL FLASHING
FP FLAG POLE
FW FLOOR WASTE
G1 GATE TYPE 1 (No. INDICATES TYPE)
GD GRATED DRAIN
GL GROUNDLINE
GLX EXISTING GROUND LINE
H-1 HYDRONIC HEATER PANEL
H.R. HANDRAIL GENERALLY
I-P INTERNAL PAINT CO.OUR 1 (No. INDICATES COLOUR)
KG KERB GUTTER
KR KERB HOLLOWER
LAM-1 LAMINATE (No. INDICATES COLOUR)
LGA LOUVRE GLASS ADJUSTABLE
LMF LOUVRES METAL FIXED
MH MANHOLE OR INSPECTION
MGS-1 MESH GATE SCREEN (No. INDICATES TYPE)
MSH-1 MESH CURTAIN (No. INDICATES TYPE)
MVE MECHANICAL VENT DO.KLST COVR.
NTS NOT TO SCALE
OFC OFF FOAM CONCRETE
PB PLASTERBOARD
PBW PINBOARD LINING (No. INDICATES COLOUR & TYPE)
PV PAVING TYPE (No. INDICATES TYPE)
PC-1 POWDER COATED STEEL (No. INDICATES TYPE)
RBC BARGE CAPPING
RFS FASCIA GENERALLY
RF-1 RESILIENT FLOORING (No. INDICATES TYPE & COLOUR)
R-HS RECTANGULAR HOLLOW SECTION
RL RELATIVE LEVEL
RO ROOF OVER
RSC ROOF SCREEN CAPPINGS
RSF ROOF SCREEN (No. INDICATES TYPE)
RSF ROOF FLASHING
RW RETAINING WALL
RWG RAINWATER GUTTER
RWP RAINWATER DOWNPIPE TO 3.0m
RWP1 RAINWATER DOWNPIPE ABOVE 3.0m
RW RAINWATER TANK
SC STEEL COLUMN
SKT SKIRTINGS
SPR SPRINGER
STT SYNTHETIC TILES (No. INDICATES TYPE)
TGW "GRIP" WALL
TGW "TACTILE GRID SURFACE INDICATORS
VP VENT PIPE
WBL WALL BLOCKWORK
WC "CLOSET
WCT-1 CERAMIC WALL TILING (No. INDICATES TYPE)
WS WHEEL STOP

USE FIGURED DIMENSIONS IN PREFERENCE TO SCALING
CHECK ALL DIMENSIONS ON SITE

A1 1 10 20 30 40 50 60 70 80 90 100

200MM

300MM ON ORIGINAL

REVISION

ISS	DATE	COMMENT

ARCHITECTURAL
GOVERNMENT ARCHITECT'S OFFICE
T 9372 5462

LANDSCAPE
TYRNELL STUDIO
T 0414 929 925

MECHANICAL
GOVERNMENT ARCHITECT'S OFFICE
T 9372 8751

ELECTRICAL
GOVERNMENT ARCHITECT'S OFFICE
T 9372 5232

QUANTITY SURVEYOR
GOVERNMENT ARCHITECT'S OFFICE
T 9372 5247

STRUCTURAL
GOVERNMENT ARCHITECT'S OFFICE
T 9372 8227

BUILDING CODE CONSULTANT
HALTING BUILDING CONSULTANCY
T 9552 8417 F 9229 4865

HYDRAULIC
GOVERNMENT ARCHITECT'S OFFICE
T 9372 8147

LIFT
GOVERNMENT ARCHITECT'S OFFICE
T 9372 8183

FIRE ENGINEER
OLSSON FIRE & RISK
T 9372 5266 F 9372 5133

PROJECT MANAGEMENT
NEW PUBLIC WORKS
T 9372 0143

NSW GOVERNMENT
Public Works
Government Architect's Office
BRUCE PETTMAN
Assistant Government Architect
Nominated Architect: ARN 7228
Level 15 MLC Building, 2-24 Rawson Place
Sydney NSW 2000 AUSTRALIA
A division of the Department of Finance, Services and Innovation
MARTIN HOFFMAN
Secretary

NSW GOVERNMENT Education

ARTARMON PUBLIC SCHOOL NEW FACILITIES PROJECT

BLOCKS S + T GROUND FLOOR PLAN

PLAN RM NO

CONTRACT NUMBER 1500654

SCALES 1:100 @ A1

SHEET NO A 203

DESIGNED GAO

PLOT DATE 18/03/2016

DRAFTED GAO

VERIFIED GAO

REVISION

© CROWN IN RIGHT OF NSW THROUGH THE DEPARTMENT OF FINANCE, SERVICES AND INNOVATION

18/03/2016 4:36:42 PM C:\Projects\Edac\PS\Artarmon_PS\6_doc\arch\A203_Artarmon_PL-G.PLT

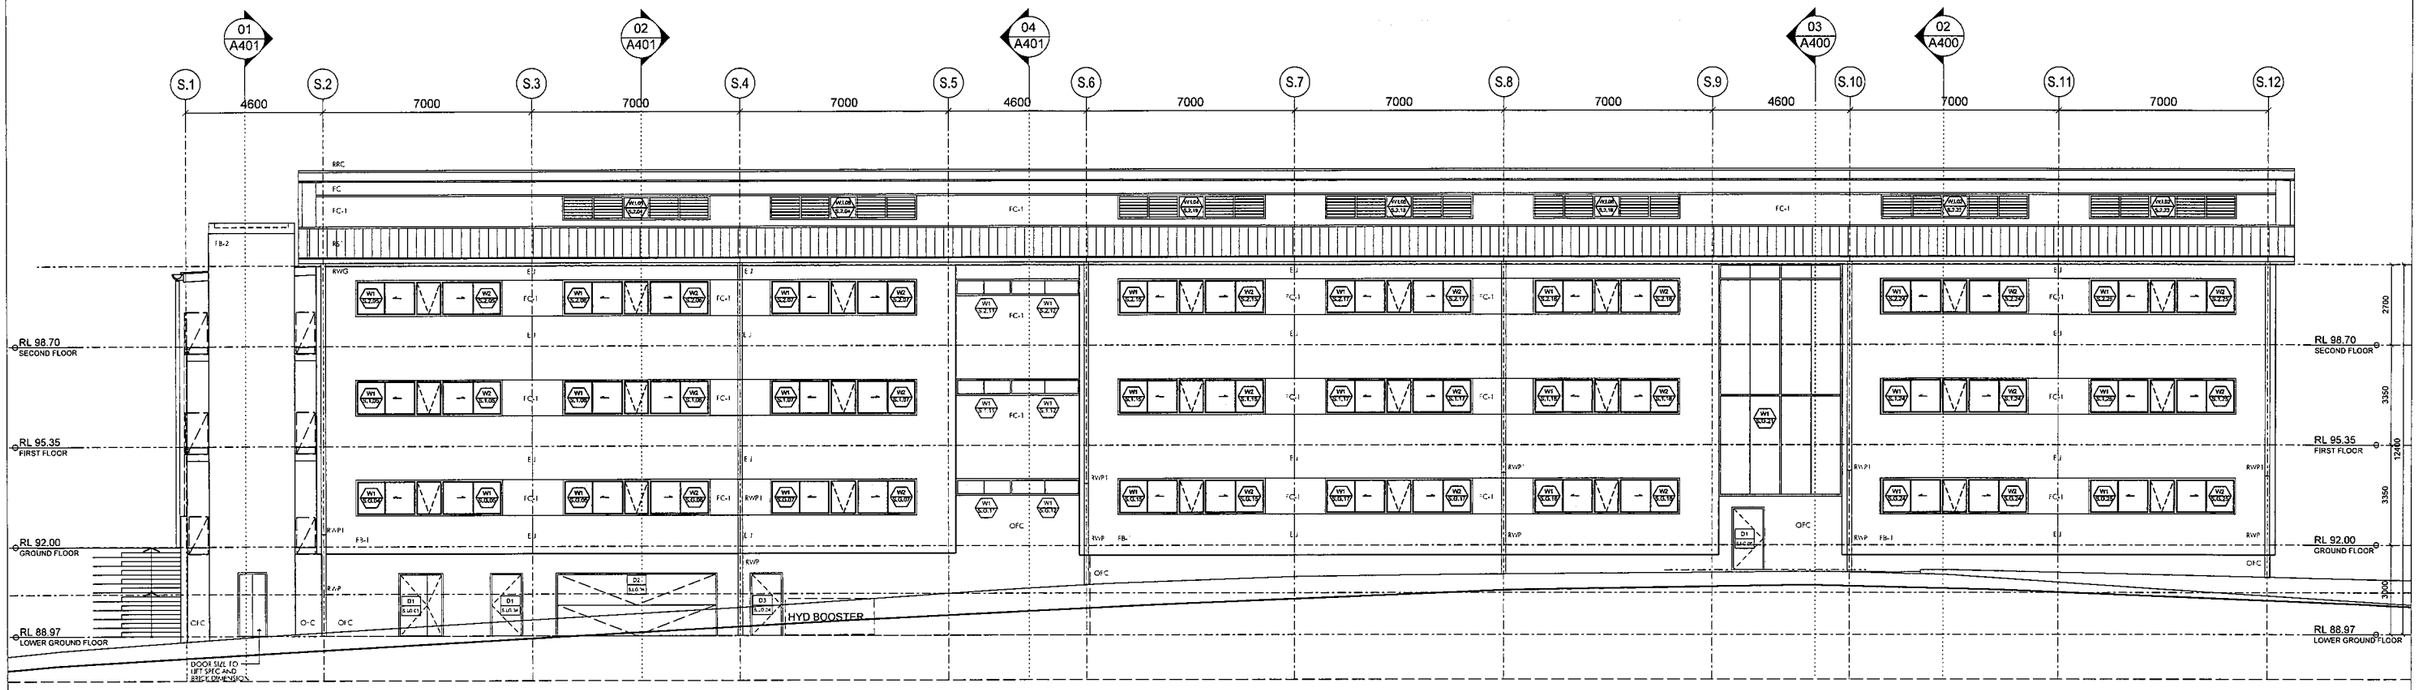

01 BLOCK S : SOUTH ELEVATION
SCALE 1:100

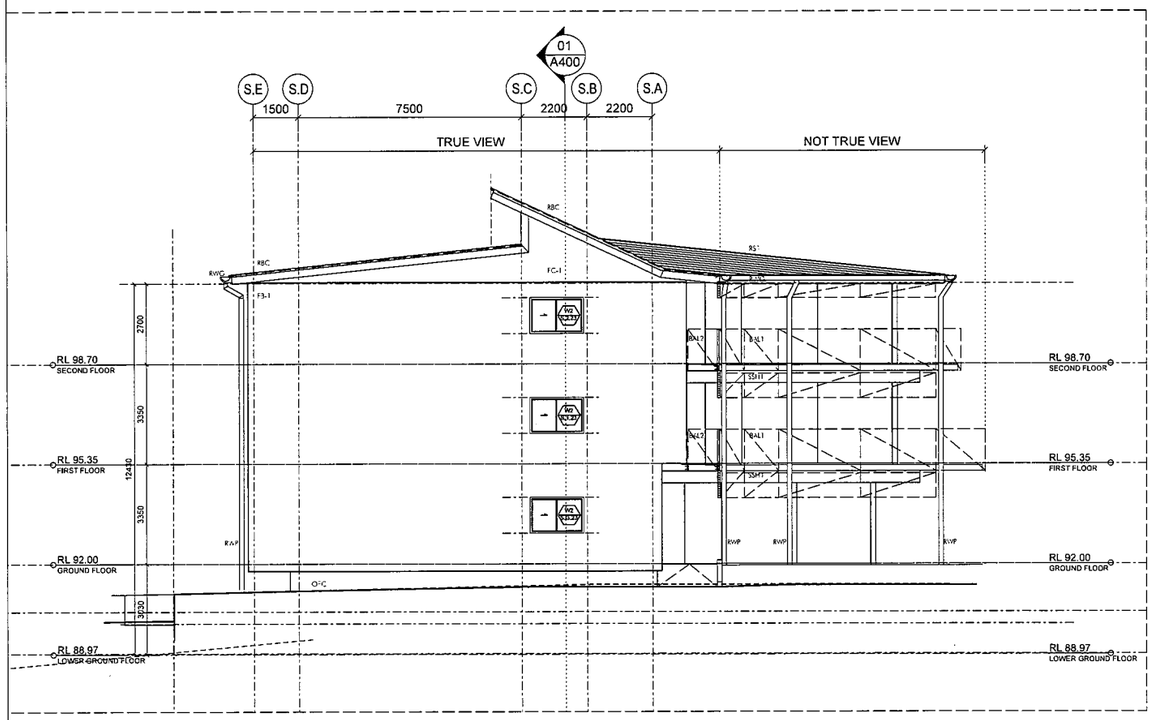

02 BLOCK S : EAST ELEVATION
SCALE 1:100

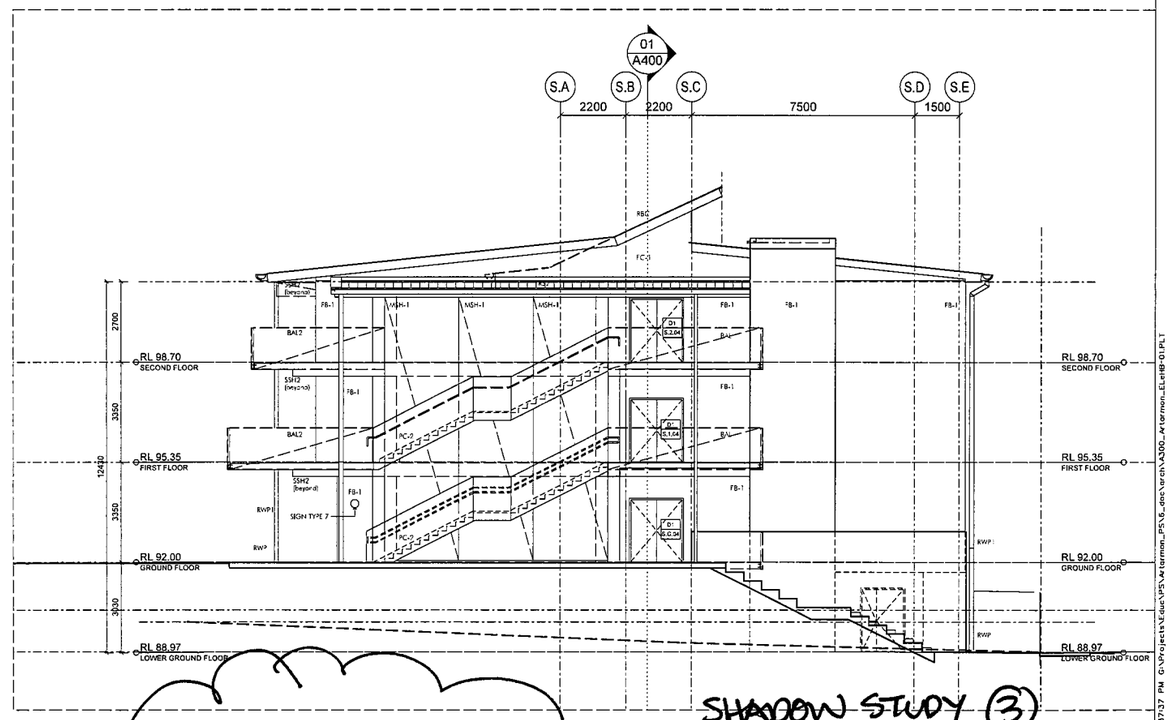

03 BLOCK S : WEST ELEVATION
SCALE 1:100

SHADOW STUDY (3)
CURRENT ELEVATION

1. The Government Architect's Office, a division of the Department of Finance & Services (the Department) shall not be liable or responsible for any loss or damage arising out of the conversion of any electronic document, data or program to any other format or medium, or arising out of any modification or changes that occur in the handling or use of the electronic document, data or program.
2. The recipient or user of any electronic document, data or program is solely responsible for ascertaining its accuracy and its suitability for their purposes.
3. The Department uses virus scanning software to prevent file and system virus attacks but gives no warranty. The recipient or user is solely responsible for their own virus protection.

LEGEND

REFER TO COLOUR & FINISHES SCHEDULE FOR DETAIL OF TYPES & COLOUR.

ASC -	ASPHALTIC CONCRETE COLOUR (No. INDICATES COLOUR)
AL-1	ALUM LOUVRE (No. INDICATES TYPE)
AW	AWNING WINDOW
AWC	ACCESSIBLE WC
B	BOLLARD
BA.	BALUSTRADE
BU	BUILDING DOTTED UNDER
CB	CONCRETE BLOCK
CB-H	CONCRETE BLOCK - HEXDORED
CHS	CIRCULAR HOLLOW SECTION
COLA	COVERED OUTDOOR LEARNING AREA
CON	CONCRETE
CON-C	CONCRETE - CONTR
CON-H	CONCRETE - HONED
CONG	CONCRETE - GRANOLITHIC TOPPING
CONG	CONCRETE/STEEL TROWELLED
COS	CHECK ON SITE
CPT-1	CARPET TYPE 1 (No. INDICATES TYPE)
DPL	DOOR PANEL LIFT
DSC	DOOR SOLID CORE
DSG	DOOR SLIDING GLAZED
ES	ELECTRICAL DISTRIBUTION BOARD
E-P	EXTERNAL PAINT COLOUR 1 (No. INDICATES COLOUR)
EQ	EQUAL
EX	EXISTING
FB-1	FACE BRICK (No. INDICATES TYPE)
FC-	FIBRE CEMENT CLADDING SOFFIT (No. INDICATES COLOUR)
FCT	FLOOR CERAMIC TILES
FEN-1	FENCE (No. INDICATES TYPE)
FFL	FINISHED FLOOR LEVEL
FG	FIXED GLAZING
FL	FLASHING
FP	FLAG POLE
FW	FLOOR WASTE
GT	GATE - TYPE 1 (No. INDICATES TYPE)
GD	GRATED DRAIN
GL	GROUNDLINE
GLX	EXISTING GROUND LINE
H-1	HYDRONIC HEATER PANEL
HR	HANDRAIL CENTRALLY
IP1	INTERNAL PAINT COLOUR 1 (No. INDICATES COLOUR)
KG	KERB GUTTER
KR	KERB ROLLOVER
LAM-	LAMINATE (No. INDICATES COLOUR)
LGA	LOUVRE GLASS ADJUSTABLE
LMF	LOUVRES METAL FIXED
MSB	MAIN SWITCH BOARD
MSG-1	METAL SCREEN (No. INDICATES TYPE)
MSH-1	METAL SHADE HOOD (No. INDICATES TYPE)
MVR	MECHANICAL VENT EXHAUST COWL
NTS	NOT TO SCALE
OFC	OFF FORM CONCRETE
PB	PLASTERBOARD
PBH-	PINEBOARD LINING (No. INDICATES COLOUR & TYPE)
PV-	PAVING TYPE - (No. INDICATES TYPE)
PC-1	POWDER COATED STEEL (No. INDICATES TYPE)
RBC	BARGE CAPPING
RFS	FASCIA OVERALLY
RS-1	RESILIENT FLOORING (No. INDICATES TYPE & COLOUR)
R-HS	RECTANGULAR HOLLOW SECTION
RL	RELATIVE LEVEL
RO	ROOF OVER
RRC	ROOF RIDGE CAPPING
RSI	ROOF SHEETING (No. INDICATES TYPE)
RW	ROOF WALKWAY
RWG	RAINWATER GUTTER
RWP	RAINWATER DOWNPIPE TO 3.0m
RWP1	RAINWATER DOWNPIPE ABOVE 3.0m
RWT	RAINWATER TANK
SC	STEEL COLUMN
S-C1	SKIRTINGS
SPR	SPREADER
STP	SYNTHETIC TILE (No. INDICATES TYPE)
TOW	TOP OF WALL
TGB	TACTILE GRAD SURFACE INDICATORS
VP	VENT PIPE
WBL	WALL BLOCKWORK
WC	TOILET
WCH	CERAMIC WALL TILING (No. INDICATES TYPE)
WS	WHEEL STOP

REVISION		
ISS	DATE	COMMENT

ARCHITECTURAL GOVERNMENT ARCHITECT'S OFFICE T 9372 8463	QUANTITY SURVEYOR GOVERNMENT ARCHITECT'S OFFICE T 9372 8362	LIFT GOVERNMENT ARCHITECT'S OFFICE T 9372 8103	
LANDSCAPE TURBELL STUDIOS T 0410 928 926	STRUCTURAL GOVERNMENT ARCHITECT'S OFFICE T 9372 8227	FIRE ENGINEER OLSSON FIRE & RISK T 9372 5296 F 9372 5133	
MECHANICAL GOVERNMENT ARCHITECT'S OFFICE T 9372 8101	BUILDING CODE CONSULTANT METRO BUILDING CONSULTANCY T 9662 8477 F 9299 4905	PROJECT MANANGEMENT NSW PUBLIC WORKS T 9852 5143	
ELECTRICAL GOVERNMENT ARCHITECT'S OFFICE T 9372 8232	HYDRAULIC GOVERNMENT ARCHITECT'S OFFICE T 9372 8147		

NSW GOVERNMENT
Public Works
Government Architect's Office
BRUCE PETTMAN
Assistant Government Architect
Nominated Architect: ARN 7228
Level 15 Macquarie Building, 2-24 Rawson Place
Sydney NSW 2000 AUSTRALIA
A division of the Department of Finance, Services and Innovation
MARTIN HOFFMAN
Secretary

NSW GOVERNMENT Education

ARTARMON PUBLIC SCHOOL NEW FACILITIES PROJECT

BLOCK S ELEVATIONS

PLAN RM NO	
CONTRACT NUMBER	1500654
SCALES	1:100 @ A1
SHEET NO	~~A300~~
DESIGNED	GAO
PLOT DATE	18/03/2016
DRAFTED	GAO
VERIFIED	GAO
REVISION	

A1 0 10 20 30 40 50 60 70 80 90 100
USE FIGURED DIMENSIONS IN PREFERENCE TO SCALING
CHECK ALL DIMENSIONS ON SITE
200MM
300MM ON ORIGINAL

© CROWN IN RIGHT OF NSW THROUGH THE DEPARTMENT OF FINANCE, SERVICES AND INNOVATION

18/03/2016 4:37:37 PM G:\Projects\Education\PS\Artarmon_PS\S_elev\Artarmon_Elev_BlockS.DWG

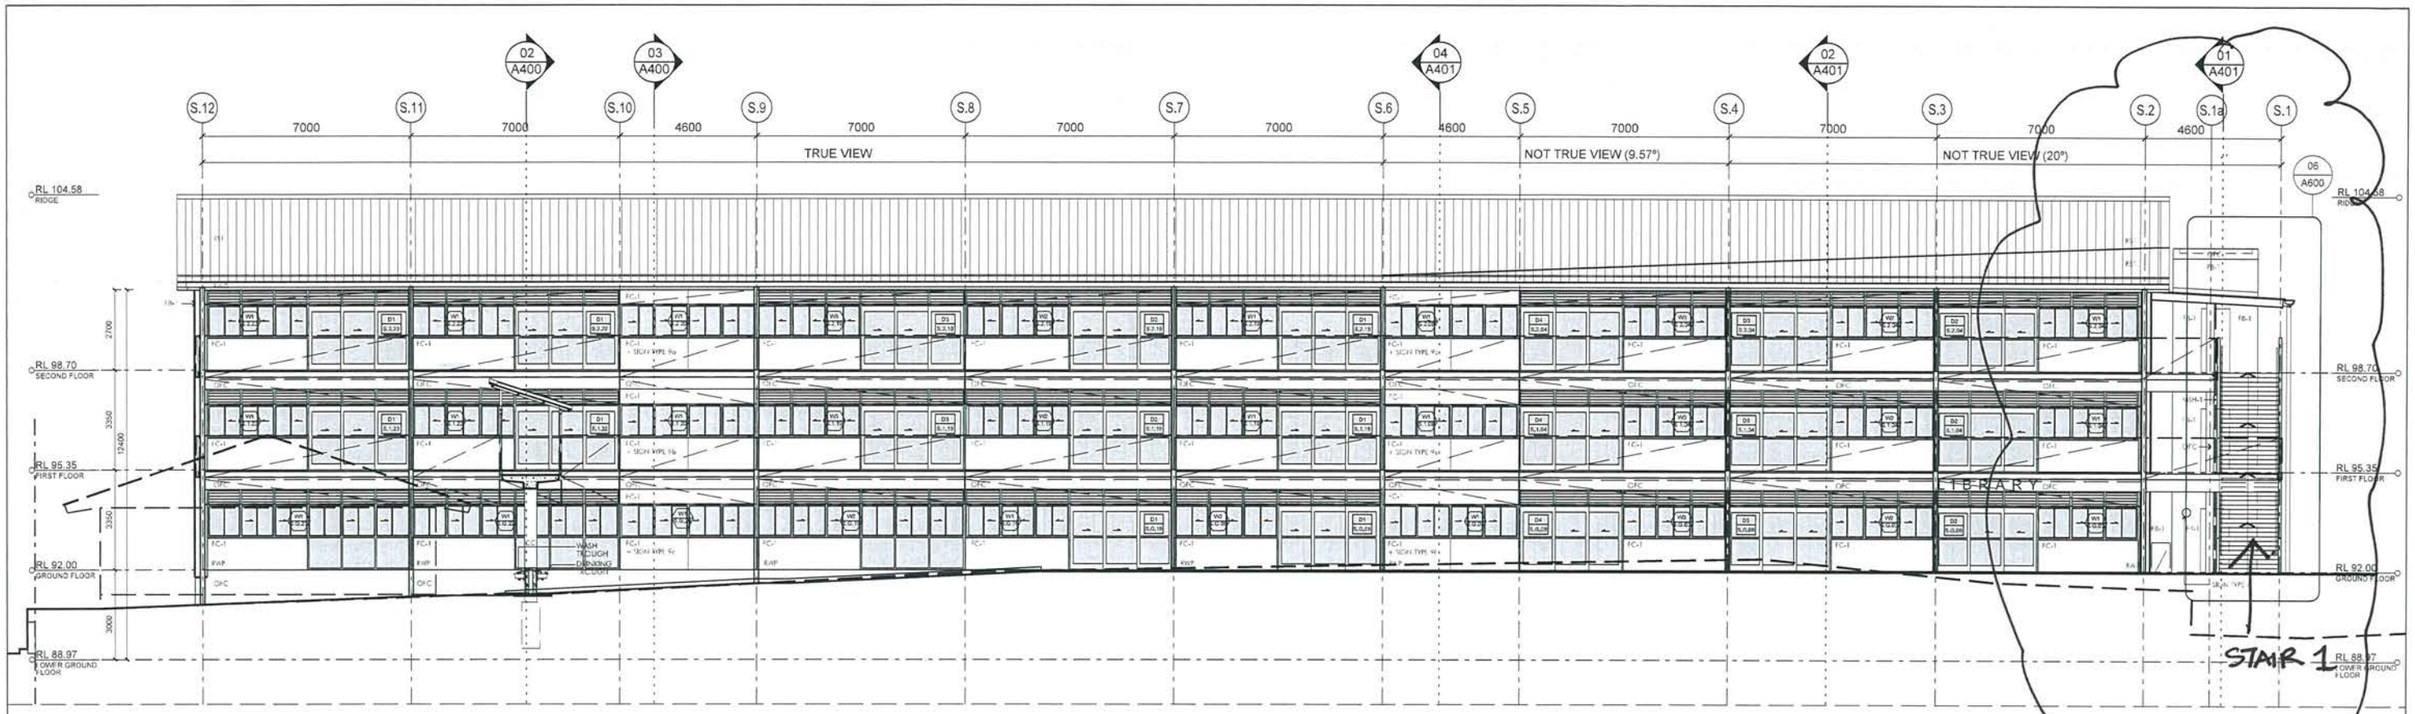

01 BLOCK S : NORTH ELEVATION
SCALE 1:100

CURRENT SECTION.

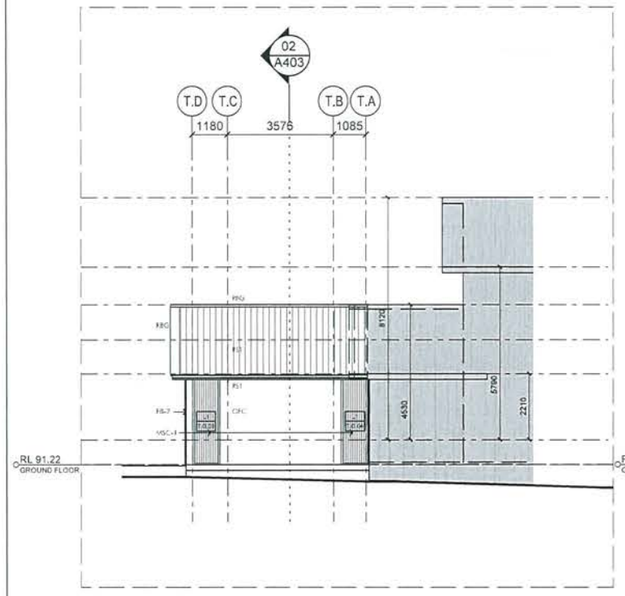

02 BLOCK T : EAST ELEVATION
SCALE 1:100

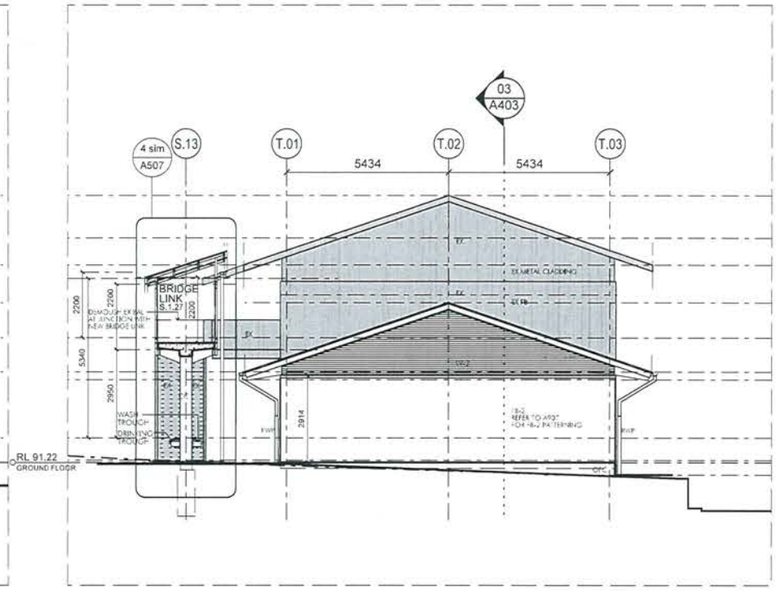

03 BLOCK T : SOUTH ELEVATION
SCALE 1:100

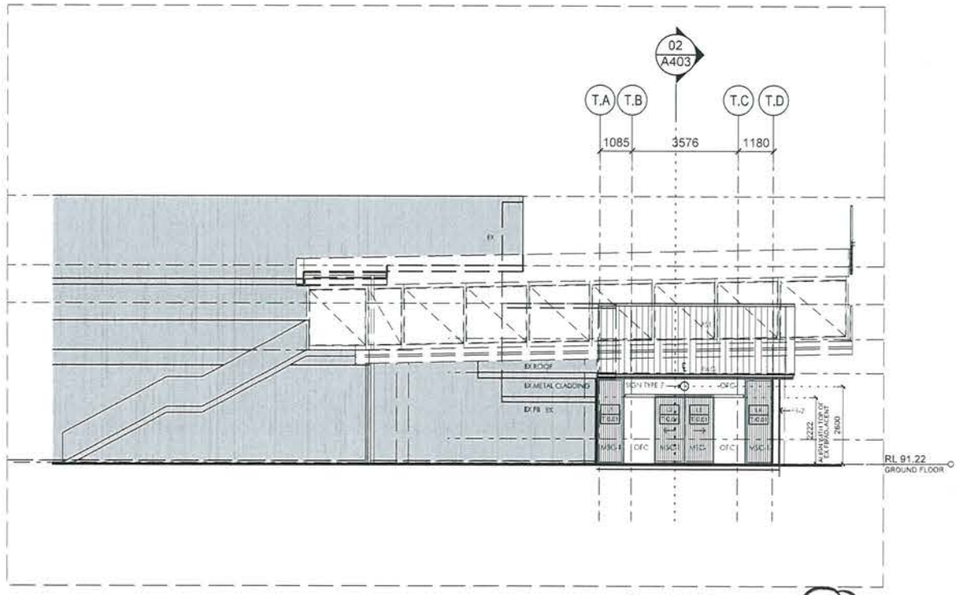

04 BLOCK T : WEST ELEVATION
SCALE 1:100

SHADOW STUDY (3)
CURRENT SECTION

LEGEND

ACM	ALL TO COLOUR & FINISHES SCHEDULE
ASP	ALL SKYHINES & COLOURS
ACS	ASPHALTIC CONCRETE COLOUR (NL INDICATES COLOUR)
AL	ALUMINIUM (NL INDICATES TYPE)
AW	AWNING WINDOW
AWC	ACCESSIBLE WC
B	BOLLARD
BA	BALUSTRADE
BL	BUILDING OUTLINE UNDER
CB	CONCRETE BLOCK
CBA	CONCRETE BLOCK ARCHITRAVES
CHS	CIRCULAR HOLLOW SECTION
CO-A	COVERED OUTDOOR EATING AREA
CON	CONCRETE
CONC	CONCRETE - COVCO
CON-H	CONCRETE - HONED
CON-G	CONCRETE - GRANULITHIC FINISH
CONC	CONCRETE - TROWELLED
COB	CHECK ON SITE
CPT	CARPET TYPE (NL INDICATES TYPE)
DP	DOOR PANEL LIFT
DSC	DOOR SLIDE CORE
DSG	DOOR SLIDING GLAZING
DSB	ELECTRICAL DISTRIBUTION BOARD
EP	EXTERNAL PAINT COLOUR (NL INDICATES COLOUR)
EG	EDGE GRATE
EL	ELEVATOR
FBR	FACE BRICK (NL INDICATES TYPE)
FCC	FIBRE CEMENT CLADDING SUPPORT (NL INDICATES CLADDING)
FCT	FLOOR CERAMIC TILES
FENC	FENCE (NL INDICATES TYPE)
FF	FINISH FLOOR LEVEL
FG	FIXED GLAZING
FL	FLASHING
FP	FLAT PICKET
FW	FLOOR WAYS
GT	GATE TYPE 1 (NL INDICATES TYPE)
GD	GRATED DRAIN
GL	GROUND LINE
MB	MAIN SWITCH BOARD
MSC	METAL SCREEN (NL INDICATES TYPE)
MS	METAL SCREEN (NL INDICATES TYPE)
MVS	MECHANICAL VENT EXHAUST CONC
NTS	NOT TO SCALE
OFC	OFF FORM CONCRETE
PB	PLASTERBOARD
PBW	PLASTERBOARD (NL INDICATES COLOUR & TYPE)
PL	PALING TYPE 1 (NL INDICATES TYPE)
PCT	POWDER COATED STEEL (NL INDICATES TYPE)
RBC	BARGE CAPPING
RFS	FASCIA SECTIONALLY
RT	RUBBER TILE FLOORING (NL INDICATES TYPE & COLOUR)
RHW	RAINWATER HEAD YELLOW SECTION
RL	RELATIVE LEVEL
RO	ROOF OVER
RWC	ROOF RIDGE CAPPINGS
RS	ROOF SLEEPING (NL INDICATES TYPE)
RSF	ROOF FLASHING
RV	ROOF VENT
RW	RETAINING WALL
RWG	RAINWATER GUTTER
RWP	RAINWATER DOWNPIPE TO 3.4m
RWP	RAINWATER DOWNPIPE ABOVE 3.4m
RWT	RAINWATER TANK
SC	STEEL COLUMN
SKT	SKIRTINGS
SPR	SPREADER
STT	SYNTHETIC TURF (NL INDICATES TYPE)
TOW	TOP OF WALL
TCB	TACTILE GRID SURFACE INDICATORS
VP	VENT PIPE
WBL	WALL BLOCKWORK
WC	WATER CLOSET
WCT	CERAMIC WALL TILING (NL INDICATES TYPE)
WS	WHEEL STOP

1. The Government Architect's Office, a division of the Department of Finance & Services ("the Department") shall not be liable or responsible for any loss or damage arising out of the conversion of any electronic document, data or program to any other format or version, or arising out of any modifications or changes that occur in the transfer of use of the electronic document, data or program.
2. The recipient or user of any electronic document, data or program is solely responsible for confirming its accuracy and its suitability for their purposes.
3. The Document and this cover sheet contain a watermark to prevent file data system virus attacks but does not warranty. The recipient or user is solely responsible for their own virus protection.

A1 0 10 20 30 40 50 60 70 80 90 100

LISE FIGURED DIMENSIONS IN PREFERENCE TO SCALING
CHECK ALL DIMENSIONS ON SITE

200MM 300MM ON ORIGINAL

REVISION		
REV	DATE	COMMENT

ARCHITECTURAL
GOVERNMENT ARCHITECT'S OFFICE
T: 9372 8453

LANDSCAPE
PYRTLE — STUDIO
T: 0418 926 924

MECHANICAL
GOVERNMENT ARCHITECT'S OFFICE
T: 9372 8131

ELECTRICAL
GOVERNMENT ARCHITECT'S OFFICE
T: 9372 8212

QUANTITY SURVEYOR
GOVERNMENT ARCHITECT'S OFFICE
T: 9372 8362

STRUCTURAL
DONN MARTIN ARCHITECTS PTY LTD
T: 9332 8227

BUILDING CODE CONSULTANT
VELORO BUILDING CONSULTANCY
T: 9692 8417 F: 9299 4555

HYDRAULIC
GOVERNMENT ARCHITECT'S OFFICE
T: 9372 8147

LIFT
GOVERNMENT ARCHITECT'S OFFICE
T: 9372 8181

FIRE ENGINEER
DUNCON — WEI - KINSTAT
T: 9332 8288 F: 9332 8131

PROJECT MANAGEMENT
NSW PUBLIC WORKS
T: 9682 6743

NSW GOVERNMENT

Public Works
Government Architect's Office

BRUCE PETTMAN
Assistant Government Architect
Nominated Architect: ARB 7038
Level 13 Macquarie Place
Sydney NSW 2000 AUSTRALIA

A division of the Department of Finance, Services and Innovation
MARTIN HOFFMAN
Secretary

NSW GOVERNMENT Education

ARTARMON
PUBLIC SCHOOL
NEW FACILITIES PROJECT

BLOCKS S + T
ELEVATIONS

PLAN NO	
CONTRACT NUMBER	1500654
SCALE	1:100 @ A1
SHEET NO	~~A301~~
DESIGNED	GAO
PLOT DATE	7/04/2016
DRAFTED	GAO
WRKSTD	GAO
REVISION	

7/04/2016 4:05:42 PM G:\Projects\Edu\PS\Artarmon_PS\BL-doc\arch\A301_Artarmon_Elevations-02.PL1

mat/usage: BASICS

OWN IN RIGHT OF NSW THROUGH THE DEPARTMENT OF FINANCE, SERVICES AND INNOVATION

EXISTING BUILDING BLOCK B

2 NEW RISERS TO EXISTING STAIR, REFER LANDSCAPE DRAWINGS

EX STAIR

EXISTING BUILDING BLOCK A

EXISTING BUILDING BLOCK M

HAMPDEN LANE SHARED WAY

ADJOINS A101

MCMILLAN CAMPUS

WALKWAY

NEW AMENITIES BLOCK T

NEW HOMEBASE AND LIBRARY; BLOCK S

LIFT

STAIR 1

HYDRANT BOOSTER

EXISTING CONCRETE FOOTPATH

NEW DRIVEWAY, REFER TO CIVIL DETAILS

BARTON STREET

EX. NEIGHBOURS WINDOWS

FOCUS PLAN AREA OF SHADOW STUDY (4)
EX. BUILDING DESIGN TURNED OFF

CURRENT DESIGN BUILDING FOOTPRINT TURNED OFF

SHADOW STUDY (4)
CURRENT BOUNDARY FENCE PLAN

NOTES:

1. REFER TO L101 AND L102 FOR LANDSCAPE GENERAL ARRANGEMENT PLANS
2. REFER TO L301 AND L302 FOR PLANTING PLANS AND SCHEDULE
3. MAKE GOOD FINISHES GENERALLY AROUND NEW WORK

KEY:

RL	RELATIVE LEVEL
EX RL	EXISTING RELATIVE LEVEL
TOW	TOP OF WALL
E-S1	EXTERNAL STAIR 1
SWP	STORMWATER PIT, REFER TO L101 AND L102 AND CIVIL DRAWINGS
PM1	MEGACHUTE SLIDE, REFER TO LANDSCAPE DRAWINGS
PM3	SMALL SYNTHETIC TURF MOUND, REFER TO LANDSCAPE DRAWINGS
PM4	MEDIUM SYNTHETIC TURF MOUND, REFER TO LANDSCAPE DRAWINGS
PM5	LARGE SYNTHETIC TURF MOUND, REFER TO LANDSCAPE DRAWINGS
PM6	PYRAMID SYNTHETIC TURF MOUND, REFER TO LANDSCAPE DRAWINGS

NEW TREE, REFER L301 AND L302

NEW INSITU CONCRETE; REFER L101 AND L102

NEW ASPHALT; REFER L101 AND L102

NEW CRUSHED GRAVEL; REFER L101 AND L102

NEW UNIT PAVING; REFER L101 AND L102

NEW SOFTFALL; REFER L101 AND L102

NEW SYNTHETIC TURF; REFER L101 AND L102

NEW PLANTING TYPE 1; REFER L101 AND L102

NEW PLANTING TYPE 2; REFER L101 AND L102

NEW PLANTING TYPE 3; REFER L101 AND L102

NEW PLANTING TYPE 4; REFER L101 AND L102

NEW PLANTING TYPE 5; REFER L101 AND L102

NEW PLANTING TYPE 6; TURF PLANTING; REFER L101 AND L102

01 MCMILLAN CAMPUS SITE LEVELS AND GRADING PLAN
SCALE 1:200@A1

LEGEND

	REFER TO COLOUR & FINISHES SCHEDULE FOR DETAIL OF TYPES & COLOURS	CO3	CHECK ON SITE	G1	GATE TYPE 1 (No. INDICATES TYPE)	FIN-T	PINBOARD LINING (No. INDICATES COLOUR & TYPE)
		CPT-1	CARPET TYPE 1 (No. INDICATES TYPE)	GL	GROUNDLINE	PV1	PAVING TYPE 1 (No. INDICATES TYPE)
		DPL	DOOR PANEL LIFT	GL3	EXISTING GROUND LINE	PC-1	POWDER COATED STEEL (No. INDICATES TYPE)
		DSC	DOOR SOLID CORE	HR	HANDRAIL GENERALLY		
ACC-1	ASPHALTIC CONCRETE COLOUR (No. INDICATES COLOUR)	DGG	DOOR GLAZING GLAZED	IP-1	INTERNAL PAINT COLOUR 1 (No. INDICATES COLOUR)	RBC	BARGE CAPPING
		EDB	ELECTRICAL DISTRIBUTION BOARD			RFS	FASCIA GENERALLY
AL-1	ALUM. LOUVRE (No. INDICATES TYPE)	E.P.1	EXTERNAL PAINT COLOUR 1 (No. INDICATES COLOUR)	KF	KERB FLUSH	RF-1	RESILIENT FLOORING (No. INDICATES TYPE & COLOUR)
AW	AWNING WINDOW	E2	EQUAL	KS	KERB GUTTER		
AWC	ACCESSIBLE W/C	E3	EXISTING	KR	KERB ROLLOVER		
BL	BOLLARD	FB-1	FACE BRICK (No. INDICATES TYPE)	LAM	LAMINATE (No. INDICATES COLOUR)	RHS	RECTANGULAR HOLLOW SECTION
BAL	BALUSTRADE	FC-1	FIBRE CEMENT CLADDING/ SOFFIT (No. INDICATES COLOUR)	LBR	LOUVRE BLADES ADJUSTABLE	RL	RELATIVE LEVEL
BU	BUILDING OUTLINE UNDER			LBF	LOUVRE BLADES FIXED	RO	ROOF
CHS	CIRCULAR HOLLOW SECTION	FCT	FLOOR CERAMIC TILES	MSB	MAIN SWITCH BOARD	RRC	ROOF RIDGE CAPPING
COLA	COVERED OUTDOOR LEARNING AREA	FEN1	FENCE (No. INDICATES TYPE)	MSC-1	METAL SCREEN (No. INDICATES TYPE)	RS1	ROOF SHEETING (No. INDICATES TYPE)
CON	CONCRETE	FFL	FINISHED FLOOR LEVEL	MSH-1	MESH CURTAIN (No. INDICATES TYPE)	RSF	ROOF FLASHING
CON-C	CONCRETE - COVED	FG	FIXED GLAZING	MVE	MECHANICAL VENT EXHAUST CORE	RW	RETAINING WALL
CON-H	CONCRETE - HONED	FL	FLASHING	NTS	NOT TO SCALE	RWG	RAINWATER GUTTER
CON-G	CONCRETE - GRANOLITHIC TOPPING	FP	FLAG POLE	OFC	OFF FORM CONCRETE	RWP	RAINWATER DOWNPIPE TO 2.1m
CON-S	CONCRETE - STEEL TROWELED	FW	FLOOR WASTE	PB	PLASTERBOARD	RWP1	RAINWATER DOWNPIPE ABOVE 2.4m
						RWT	RAINWATER TANK

SC	STEEL COLUMN				
SKT	SKIRTINGS				
SPR	SPREADER				
STT1	SYNTHETIC TURF (No. INDICATES TYPE)				
TOW	TOP OF WALL				
TGS	TACTILE GRND SURFACE INDICATORS				
VP	VENT PIPE				
WBL	WALL BLOCKWORK				
WC	TOILET				
WCT1	CERAMIC WALL TILING (No. INDICATES TYPE)				
WS	WHEEL STOP				

REVISION		
ISS	DATE	COMMENT
DRAFT FOR COORDINATION		

ARCHITECTURAL GOVERNMENT ARCHITECT'S OFFICE T 9372 6463	QUANTITY SURVEYOR GOVERNMENT ARCHITECT'S OFFICE T 9372 6362	LIFT GOVERNMENT ARCHITECT'S OFFICE T 9372 6103
LANDSCAPE TYRRELL STUDIO T 0410 528 505	STRUCTURAL GOVERNMENT ARCHITECT'S OFFICE T 9372 6227	FIRE ENGINEER OLSSON FIRE & RISK T 9372 6294 F 9372 6133
MECHANICAL GOVERNMENT ARCHITECT'S OFFICE T 9372 6161	BUILDING CODE CONSULTANT METRO BUILDING CONSULTANCY T 9692 8477 F 9209 4955	PROJECT MANANGEMENT NSW PUBLIC WORKS T 9692 0143
ELECTRICAL GOVERNMENT ARCHITECT'S OFFICE T 9372 6232	HYDRAULIC GOVERNMENT ARCHITECT'S OFFICE T 9372 6147	

Public Works
Government Architect's Office
BRUCE PETTMAN
Assistant Government Architect
Nominated Architect ABN 7226
Level 18 McKell Building, 2-24 Rawson Place
Sydney NSW 2000 AUSTRALIA
A division of the Department of Finance, Services and Innovation
MARTIN HOFFMAN
Secretary

NSW GOVERNMENT Education

ARTARMON PUBLIC SCHOOL NEW FACILITIES PROJECT

SITE LEVELS & GRADING PLAN (1)

MCMILLAN CAMPUS

PLAN RM. NO		CONTRACT NUMBER 1500654
SCALES 1:200 @ A1		SHEET NO ~~A100~~
DESIGNED TYRRELL	PLOT DATE 07.04.2016	REVISION
DRAFTED TYRRELL	VERIFIED TYRRELL	

A1 0 10 20 30 40 50 60 70 80 90 100 — USE FIGURED DIMENSIONS IN PREFERENCE TO SCALING. CHECK ALL DIMENSIONS ON SITE. 200MM. 300MM ON ORIGINAL

© DRAWN IN RIGHT OF NSW THROUGH THE DEPARTMENT OF FINANCE, SERVICES AND INNOVATION

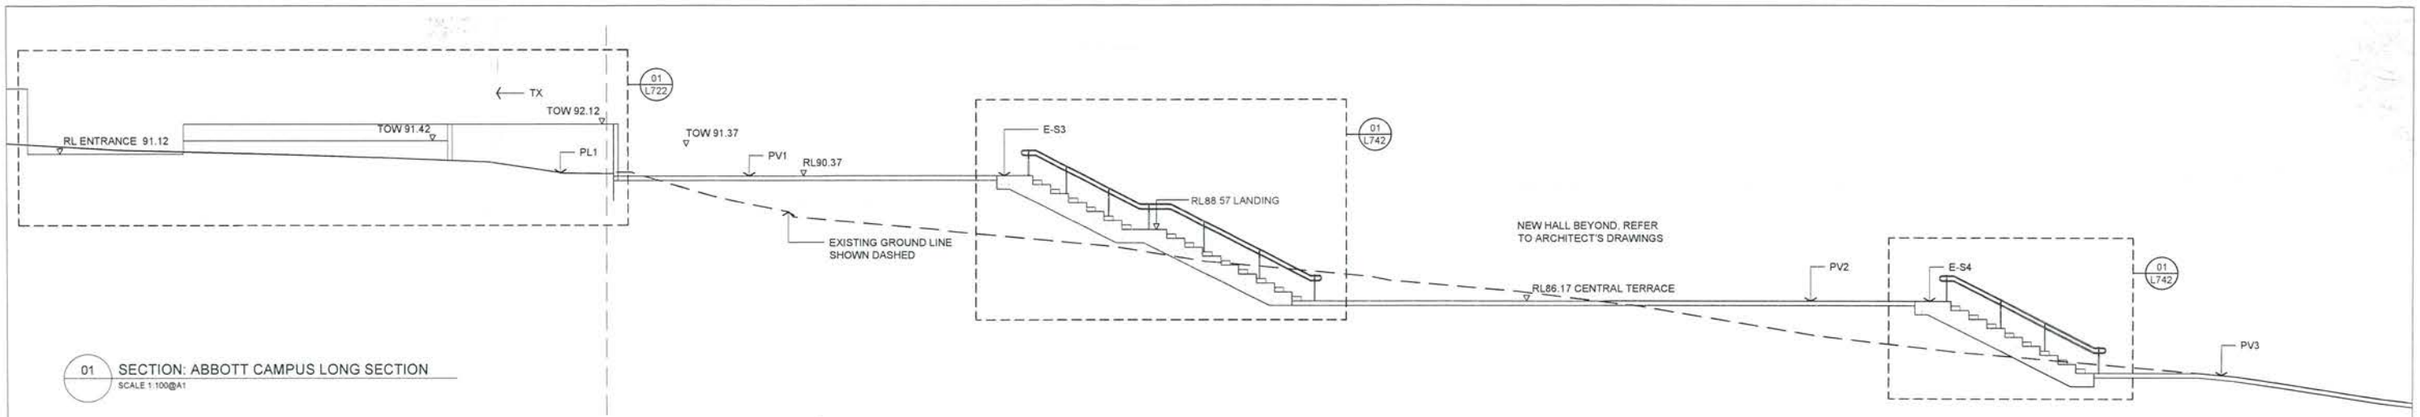

01 SECTION: ABBOTT CAMPUS LONG SECTION
SCALE 1:100@A1

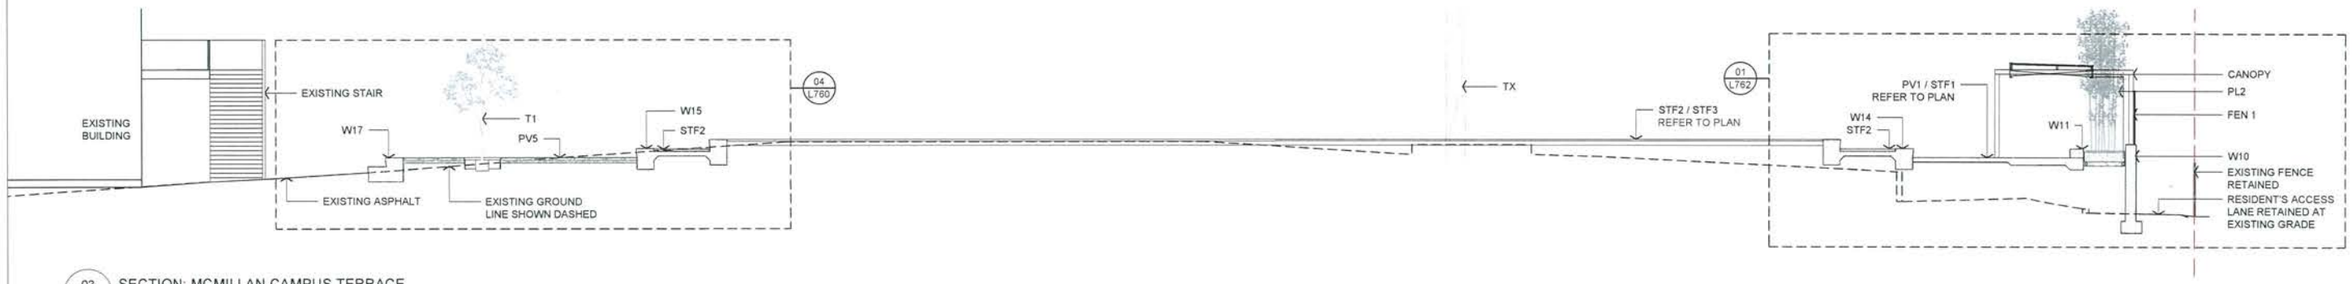

03 SECTION: MCMILLAN CAMPUS TERRACE
SCALE 1:100@A1

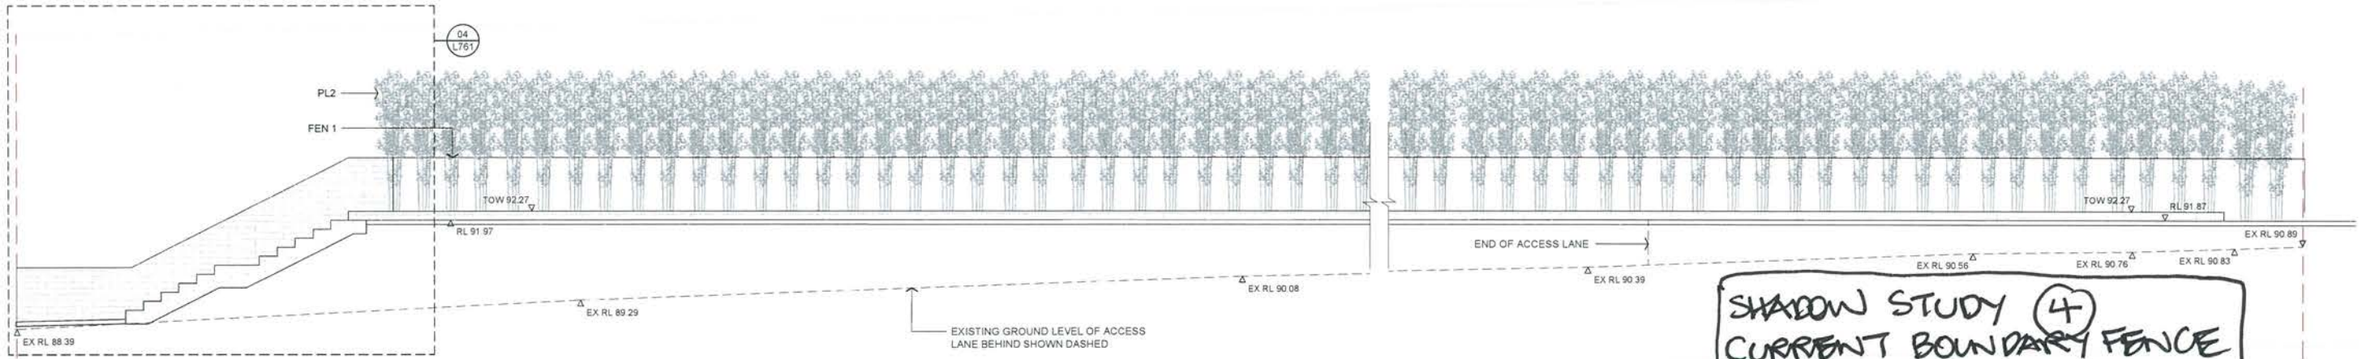

SCALE 1:100@A1

SHADOW STUDY (4)
CURRENT BOUNDARY FENCE
ELEVATION TO WESTERN
BOUNDARY

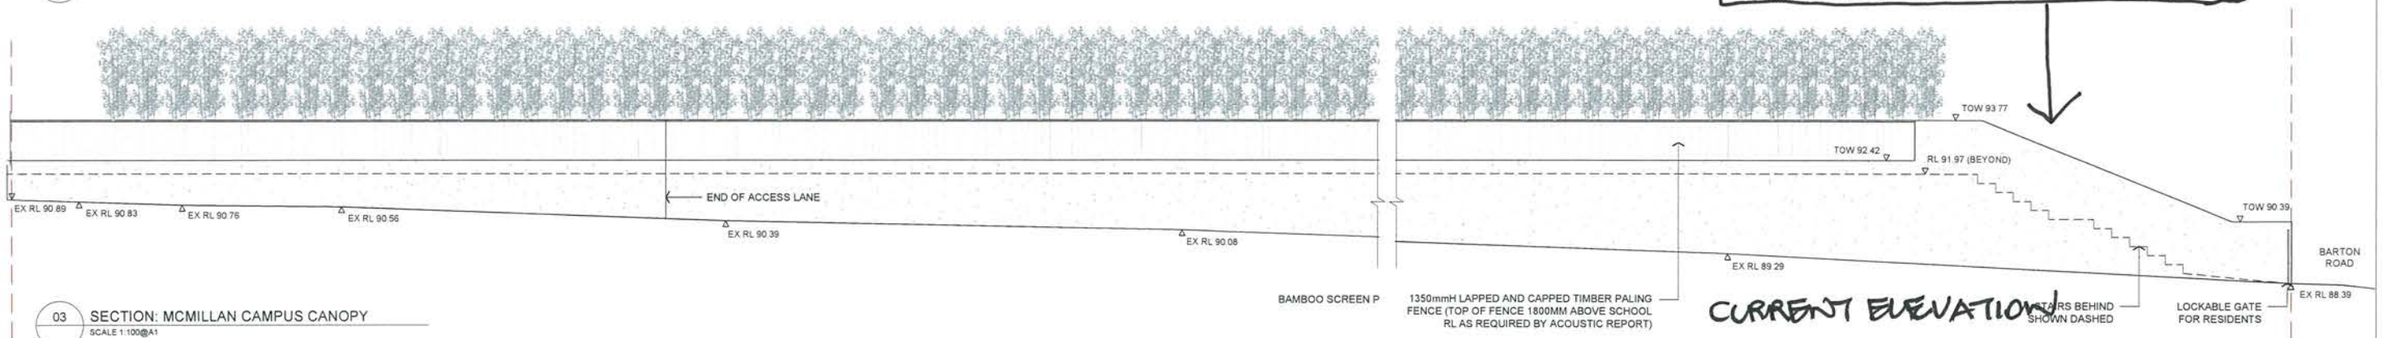

03 SECTION: MCMILLAN CAMPUS CANOPY
SCALE 1:100@A1

LEGEND

PV1	INSITU CONCRETE PAVING	E-S1	STAIR NUMBER 1	PL1	PLANTING TYPE 1	SIGN1	SIGNAGE TYPE 1
ABF	ABRASIVE BLAST FINISH	F1	CIRCULAR BENCH	PL2	PLANTING TYPE 2	SIGN2	SIGNAGE TYPE 2
PV2	ASPHALT	F2	TABLE AND BENCH SEATS	PL3	PLANTING TYPE 3	STF1	SYNTHETIC TURF TYPE 1
PV4	COMPACTED GRAVEL	F3	BENCH SEATS	PL4	PLANTING TYPE 4	STF1-W	SYNTHETIC TURF TYPE 1 - WHITE
PV5	PERMEABLE PAVING	F4	AGRICULTURAL PLANTERS	PL5	PLANTING TYPE 5	STF2	SYNTHETIC TURF TYPE 2
PV6	SOFTFALL	F5	TREE GRATE	PM1	MEGA CHUTE SLIDE	STF3	SYNTHETIC TURF TYPE 3
PV1_A	CONCRETE OXIDE COLOUR A	F6	BIKE RACKS	PM2	PLAY STRUCTURE	T1	TREE TYPE 1
PV1_B	CONCRETE OXIDE COLOUR B	FEN1	FENCE TYPE 1	PM3	SYNTHETIC TURF MOUND TYPE A	TX	EXISTING TREE RETAINED
PV1_C	CONCRETE OXIDE COLOUR C	FEN2	FENCE TYPE 2	PM4	SYNTHETIC TURF MOUND TYPE B	EP	ELECTRICAL POLE
PV1_D	CONCRETE OXIDE COLOUR D	FEN3	FENCE TYPE 3	PM5	SYNTHETIC TURF MOUND TYPE C	SBD	SUBSOIL DRAIN
PV6_A	SOFTFALL COLOUR A	GATE1-7	GATE TYPE 1-7	PM6	SYNTHETIC TURF PYRAMID MOUND	SWP	STORMWATER PIT
PV6_B	SOFTFALL COLOUR B	HR1	HANDRAIL TYPE 1	PP1	PRECAST CONCRETE STEP TYPE A	PIT	EXISTING SERVICE PIT
PV6_C	SOFTFALL COLOUR C	HR2	HANDRAIL TYPE 2	PP2	PRECAST CONCRETE STEP TYPE B	TOW	TOP OF WALL RL
W1	WALL NUMBER 1	HR3	HANDRAIL TYPE 3	PP3	PRECAST CONCRETE STEP TYPE C	EX RL	EXISTING RL
E1	EDGE TYPE 1	BAL1	BALUSTRADE TYPE 1	LP1	LIGHT TYPE 1	RL	RELATIVE LEVEL

Revision

ISS	DATE	COMMENT

DRAFT FOR COORDINATION

ARCHITECTURAL GOVERNMENT ARCHITECT'S OFFICE T 9372 5465	QUANTITY SURVEYOR GOVERNMENT ARCHITECT'S OFFICE T 9372 6582	LIFT GOVERNMENT ARCHITECT'S OFFICE T 9372 6183
LANDSCAPE TYRRELL STUDIO T 0418 928 926	STRUCTURAL GOVERNMENT ARCHITECT'S OFFICE T 9372 6227	FIRE ENGINEER OLSSON FIRE & RISK T 9372 6296 F 9372 6132
MECHANICAL GOVERNMENT ARCHITECT'S OFFICE T 9372 6181	BUILDING CODE CONSULTANT METRO BUILDING CONSULTANCY T 9662 8477 F 8209 4955	PROJECT MANANGEMENT NSW PUBLIC WORKS T 9662 8743
ELECTRICAL GOVERNMENT ARCHITECT'S OFFICE T 9372 6233	HYDRAULIC GOVERNMENT ARCHITECT'S OFFICE T 9372 6147	

NSW GOVERNMENT

Public Works
Government Architect's Office

BRUCE PETTMAN
Assistant Government Architect
Nominated Architect ARN 7228
Level 15 McKell Building - 2-24 Rawson Place
Sydney NSW 2000 AUSTRALIA

A division of the Department of Finance, Services and Innovation
MARTIN HOFFMAN
Secretary

NSW GOVERNMENT Education

ARTARMON
PUBLIC SCHOOL
NEW FACILITIES PROJECT

SITE SECTIONS

PLAN RM NO	
CONTRACT NUMBER	1500654
SCALES	1:100 @ A1
SHEET NO	~~L501~~
DESIGNED TYRRELL	PLOT DATE 07.04.2016
DRAFTED TYRRELL	VERIFIED TYRRELL
REVISION	

A1 0 10 20 30 40 50 60 70 80 90 100
USE FIGURED DIMENSIONS IN PREFERENCE TO SCALING
CHECK ALL DIMENSIONS ON SITE
200MM
300MM ON ORIGINAL

© DRAWN IN RIGHT OF NSW THROUGH THE DEPARTMENT OF FINANCE, SERVICES AND INNOVATION

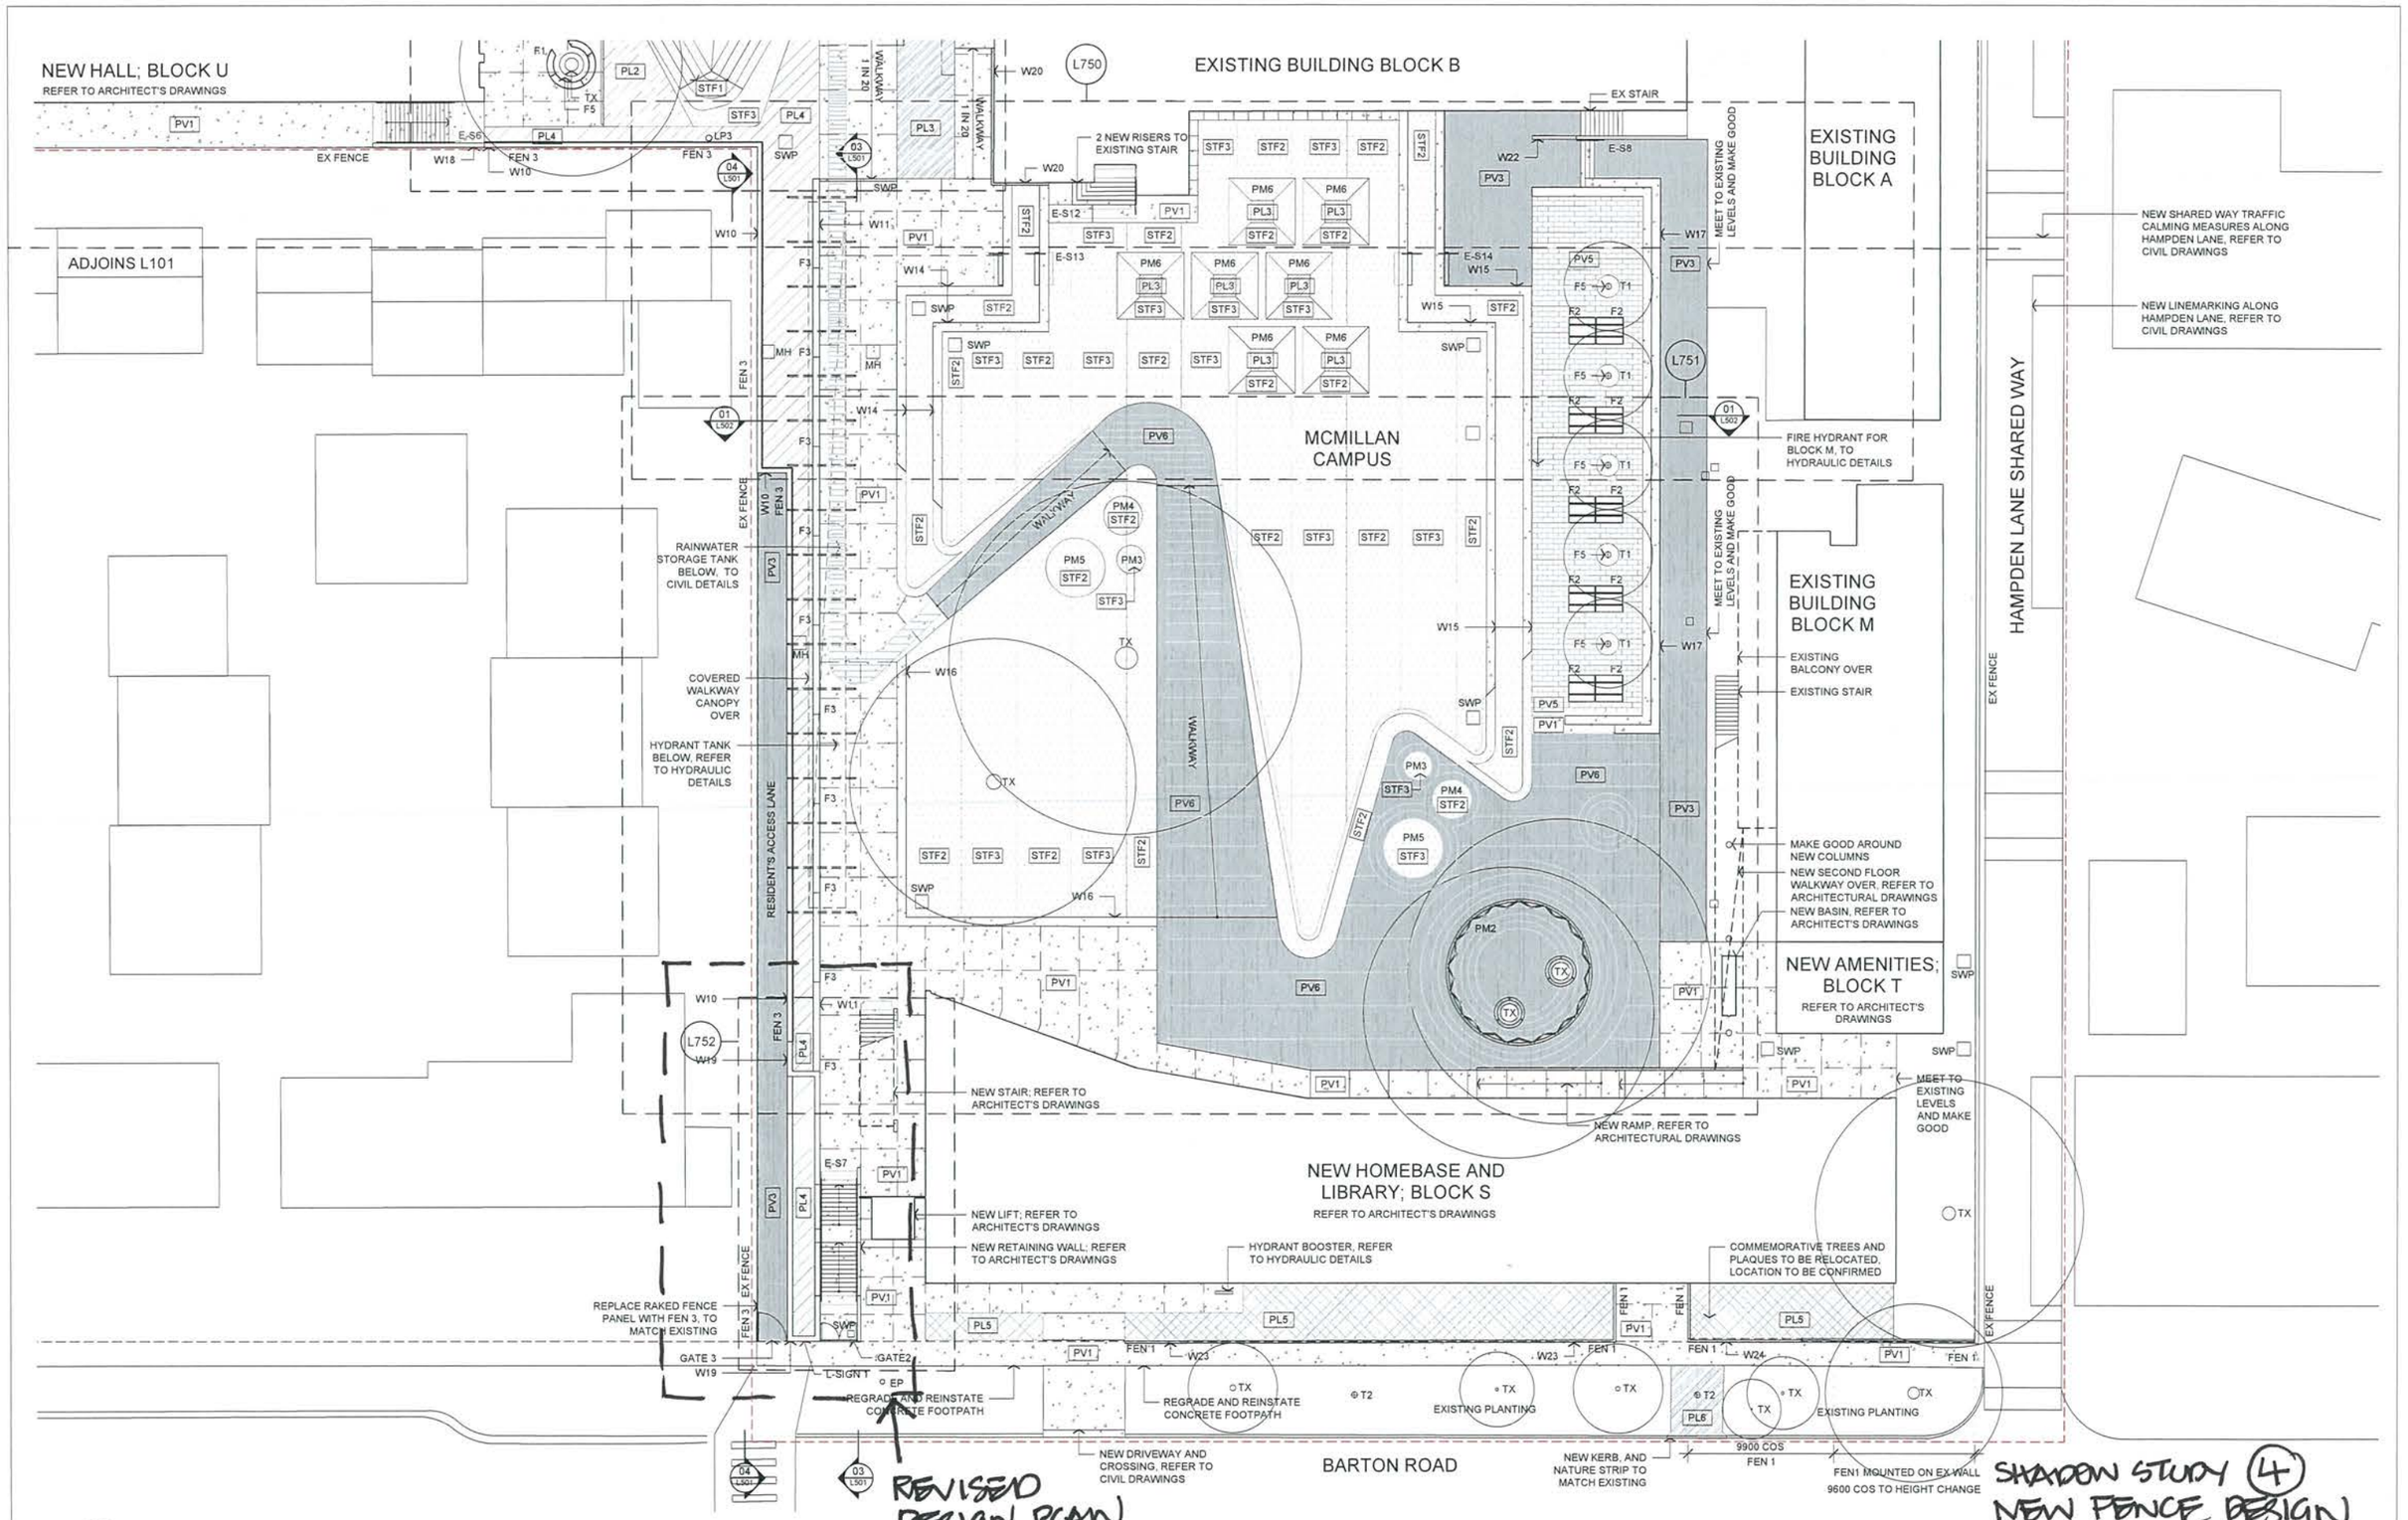

01 MCMILLAN CAMPUS GENERAL ARRANGEMENT PLAN
SCALE 1:200@A1

LEGEND

PV1, A-D	INSITU CONCRETE PAVING GAUGES A-D	F3	BENCH SEATS	PM3	SYNTHETIC TURF MOUND SMALL	CW-P	COVERED WAY PURLIN
ABF	ABRASIVE BLAST FINISH	F4	AGRICULTURAL PLANTERS	PM4	SYNTHETIC TURF MOUND MEDIUM	CW-R	COVERED WAY RAFTER
PV3	ASPHALT	F5	TREE GRATE	PM5	SYNTHETIC TURF MOUND LARGE	CW-CAN	COVERED WAY CANOPY
PV4	COMPACTED GRAVEL	F6	FLAG POLE	PM6	SYNTHETIC TURF PYRAMID MOUND	CW-CON	COVERED WAY CONNECTOR
PV5	PERMEABLE PAVING	F7	BIKE RACKS	PF1-3	PRECAST TREAD TYPES 1-3	CW-END1	COVERED WAY PANEL CAP
PV6, A-E	SOFTFALL PAVING COLOURS A-E	FEN1-3	FENCE TYPES 1-3	STF1-3	SYNTHETIC TURF TYPES 1-3	CW-END2	COVERED WAY CONNECTOR
		GATE1-7	GATES 1-7	STF1-WL	SYNTHETIC TURF WHITE LINES		
W1-24	WALL NUMBERS 1-24	HR1-3	HANDRAIL TYPES 1-3	SN1	STAIR NOSING TYPE 1	EP	ELECTRICAL POLE
E-S1-14	LANDSCAPE STAIR NUMBERS 1-14	J	CONCRETE PAVING JOINT	T1	TREE TYPE 1	EOW	EXTENT OF WORKS
		LP1-3	LIGHT TYPE 1-3	T2	TREE TYPE 2	SSD	SUBSOIL DRAINAGE
ACC1	ASPHALTIC CONCRETE COLOUR 1	L-SIGN1	SIGNAGE TYPE 1	TX	EXISTING TREE RETAINED	SWP	STORMWATER PIT
ACC2	ASPHALTIC CONCRETE COLOUR 2	L-SIGN2	SIGNAGE TYPE 2	TGSI	TACTILE SURFACE GROUND INDICATORS	PIT	EXISTING SERVICE PIT
E1	EDGE TYPE 1	PL1-6	PLANTING TYPES 1-6			TOW	TOP OF WALL, RL
F1	CIRCULAR BENCH	PM1	MEGA CHUTE SLIDE	CW-C	COVERED WAY COLUMN	RL	RELATIVE LEVEL
F2	TABLE AND BENCH SEATS	PM2	PLAY STRUCTURE	CW-B	COVERED WAY BEAM		

REVISION		
ISS	DATE	COMMENT

DRAFT FOR COORDINATION

ARCHITECTURAL GOVERNMENT ARCHITECT'S OFFICE T 9372 8483	QUANTITY SURVEYOR GOVERNMENT ARCHITECT'S OFFICE T 9372 8382	LIFT GOVERNMENT ARCHITECT'S OFFICE T 9372 8183
LANDSCAPE TYRRELL STUDIO T 9410 9125	STRUCTURAL GOVERNMENT ARCHITECT'S OFFICE T 9372 8227	FIRE ENGINEER DLSOBON FIRE & RISK T 9372 8296 F 9372 8133
MECHANICAL GOVERNMENT ARCHITECT'S OFFICE T 9372 8181	BUILDING CODE CONSULTANT METRO BUILDING CONSULTANCY T 9682 8477 F 9269 4555	PROJECT MANANGEMENT NSW PUBLIC WORKS T 9852 6142
ELECTRICAL GOVERNMENT ARCHITECT'S OFFICE T 9372 8232	HYDRAULIC GOVERNMENT ARCHITECT'S OFFICE T 9372 8147	

NSW GOVERNMENT

Public Works
Government Architect's Office
BRUCE PETTMAN
Assistant Government Architect
Nominated Architect: ARN 7228
Level 19 McKell Building - 2-24 Rawson Place
Sydney NSW 2000 AUSTRALIA
A division of the Department of Finance, Services and Innovation
MARTIN HOFFMAN
Secretary

NSW GOVERNMENT Education

ARTARMON PUBLIC SCHOOL NEW FACILITIES PROJECT

GENERAL ARRANGEMENT PLAN

MCMILLAN CAMPUS

PLAN RM NO	
CONTRACT NUMBER	1500654
SCALES	1:200 @ A1
SHEET NO	~~L102~~
DESIGNED	TYRRELL
PLOT DATE	20.04.2016
DRAFTED	TYRRELL
VERIFIED	TYRRELL
REVISION	

A1 USE FIGURED DIMENSIONS IN PREFERENCE TO SCALING CHECK ALL DIMENSIONS ON SITE 500MM 300MM ON ORIGINAL

© CROWN IN RIGHT OF NSW THROUGH THE DEPARTMENT OF FINANCE, SERVICES AND INNOVATION

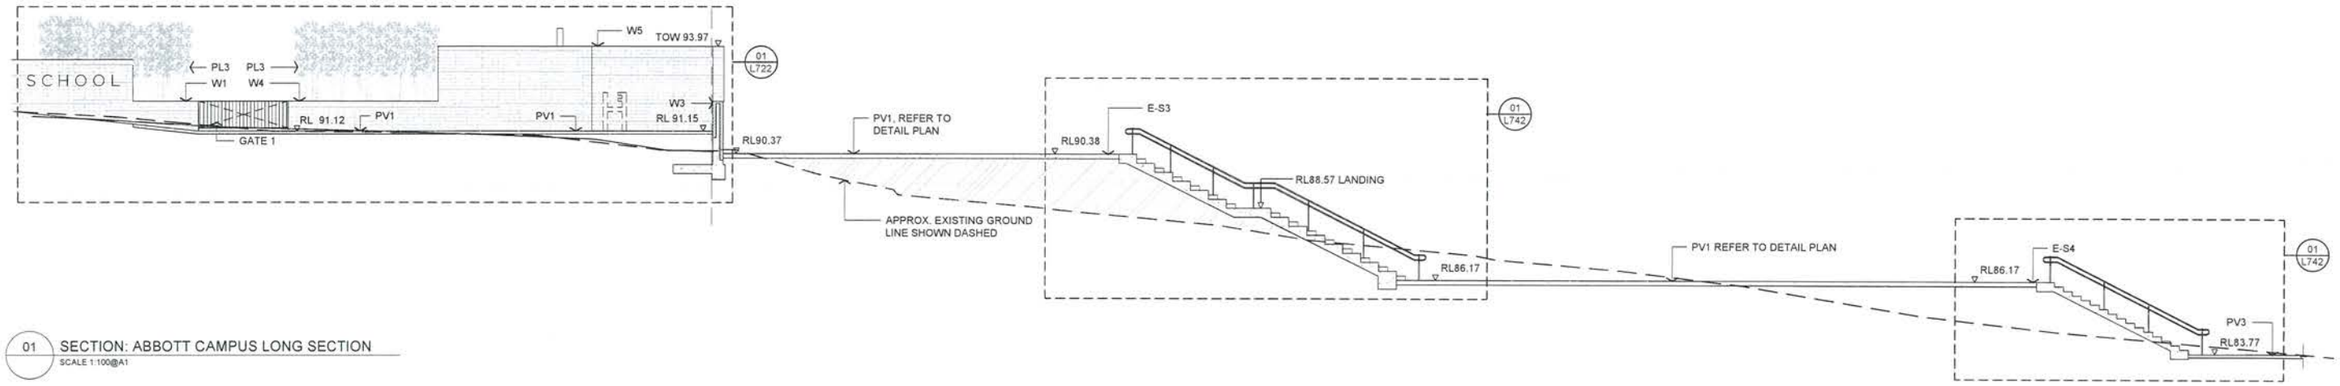

01 SECTION: ABBOTT CAMPUS LONG SECTION
SCALE 1:100@A1

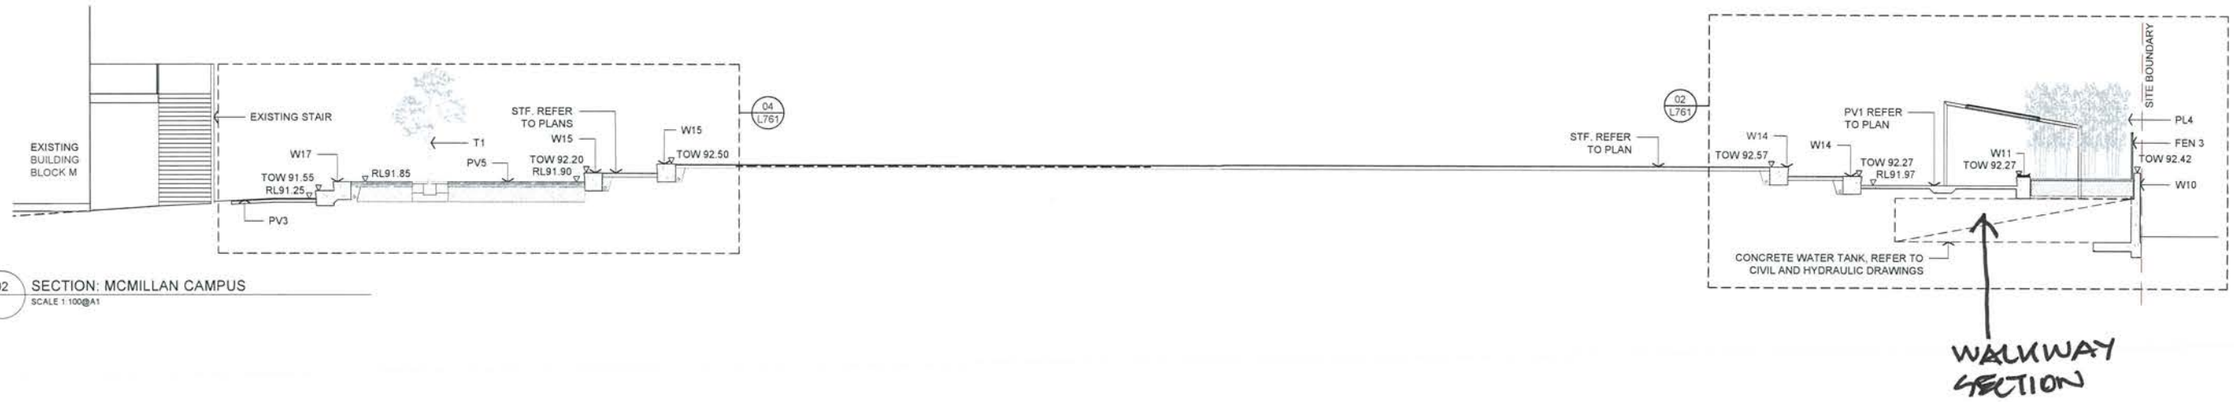

02 SECTION: MCMILLAN CAMPUS
SCALE 1:100@A1

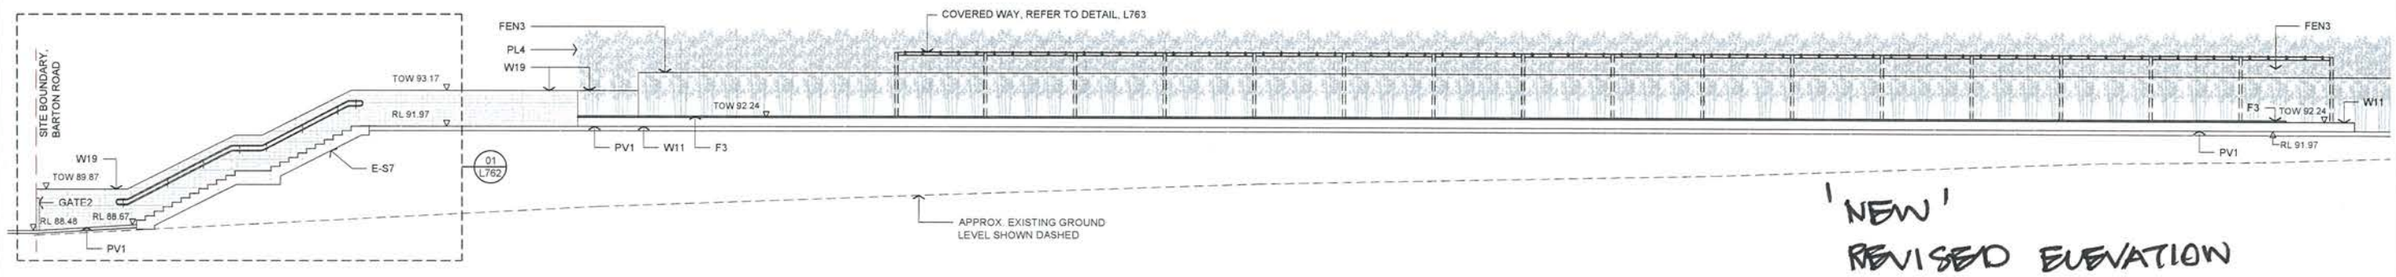

03 SECTION: MCMILLAN CAMPUS COVERED WAY
SCALE 1:100@A1

'NEW'
REVISED ELEVATION

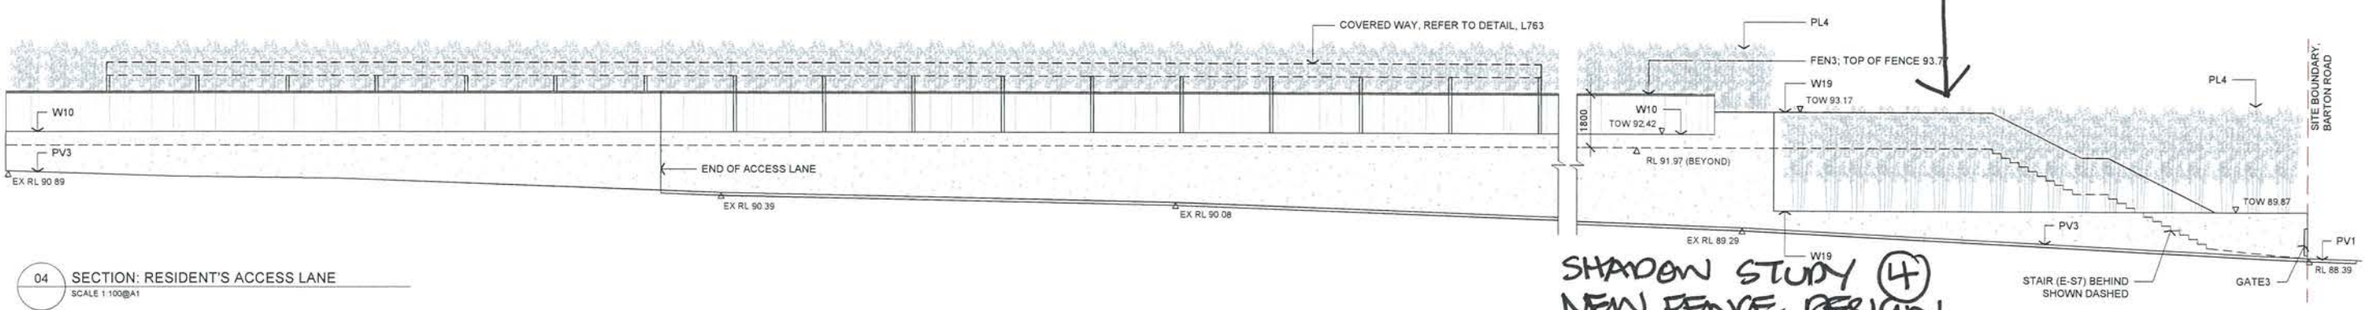

04 SECTION: RESIDENT'S ACCESS LANE
SCALE 1:100@A1

SHADOW STUDY (4)
NEW FENCE DESIGN

LEGEND

PV1_A-D	INSITU CONCRETE PAVING. GK/DES A-D	F3	BENCH SEATS	PM3	SYNTHETIC TURF MOUND SMALL	CW-P	COVERED WAY PURLIN
ABF	ABRASIVE BLAST FINISH	F4	AGRICULTURAL PLANTERS	PM4	SYNTHETIC TURF MOUND MEDIUM	CW-R	COVERED WAY RAFTER
PV3	ASPHALT	F5	TREE GRATE	PM5	SYNTHETIC TURF MOUND LARGE	CW-CAN	COVERED WAY CANOPY
PV4	COMPACTED GRAVEL	F6	FLAG POLE	PM6	SYNTHETIC TURF PYRAMID MOUND	CW-CON	COVERED WAY CONNECTOR
PV5	PERMEABLE PAVING	F7	BIKE RACKS	PP1-3	PRECAST TREAD TYPES 1-3	CW-END1	COVERED WAY PANEL CAP
PV6_A-E	SOFTFALL PAVING COLOURS A-E	FEN1-3	FENCE TYPES 1-3	STF1-3	SYNTHETIC TURF TYPES 1-3	CW-END2	COVERED WAY CONNECTOR
		GATE1-7	GATES 1-7	STF1-WL	SYNTHETIC TURF WHITE LINES		
W1-24	WALL NUMBERS 1-24	HR1-3	HANDRAIL TYPES 1-3	SN1	STAIR NOSING TYPE 1	EP	ELECTRICAL POLE
E-S1-14	LANDSCAPE STAIR NUMBERS 1-14	J	CONCRETE PAVING JOINT	T1	TREE TYPE 1	EOW	EXTENT OF WORKS
		LP1-3	LIGHT TYPE 1-3	T2	TREE TYPE 2	SSD	SUBSOIL DRAINAGE
ACC1	ASPHALTIC CONCRETE COLOUR 1	L-SIGN1	SIGNAGE TYPE 1	T4	EXISTING TREE RETAINED	SWP	STORMWATER PIT
ACC2	ASPHALTIC CONCRETE COLOUR 2	L-SIGN2	SIGNAGE TYPE 2	TGSI	TACTILE SURFACE GROUND	PIT	EXISTING SERVICE PIT
E1	EDGE TYPE 1	PL1-6	PLANTING TYPES 1-6		INDICATORS	TOW	TOP OF WALL RL
F1	CIRCULAR BENCH	PM1	MEGA CHUTE SLIDE	CW-C	COVERED WAY COLUMN	RL	RELATIVE LEVEL
F2	TABLE AND BENCH SEATS	PM2	PLAY STRUCTURE	CW-B	COVERED WAY BEAM		

REVISION		
ISS	DATE	COMMENT

DRAFT FOR COORDINATION

ARCHITECTURAL GOVERNMENT ARCHITECT'S OFFICE T 9372 8463	QUANTITY SURVEYOR GOVERNMENT ARCHITECT'S OFFICE T 9372 8362	LIFT GOVERNMENT ARCHITECT'S OFFICE T 9372 8153
LANDSCAPE TYRRELL STUDIO T 0418 928 926	STRUCTURAL GOVERNMENT ARCHITECT'S OFFICE T 9372 8227	FIRE ENGINEER OLSSON FIRE & RISK T 9372 8298 F 9372 8153
MECHANICAL GOVERNMENT ARCHITECT'S OFFICE T 9372 8191	BUILDING CODE CONSULTANT METRO BUILDING CONSULTANCY T 9692 8477 F 8209 4905	PROJECT MANANGEMENT NSW PUBLIC WORKS T 9852 9143
ELECTRICAL GOVERNMENT ARCHITECT'S OFFICE T 9372 8232	HYDRAULIC GOVERNMENT ARCHITECT'S OFFICE T 9372 8747	

NSW GOVERNMENT

Public Works
Government Architect's Office
BRUCE PETTMAN
Assistant Government Architect
Nominated Architect ARN 7228
Level 13 McKell Building, 2-24 Rawson Place
Sydney NSW 2000 AUSTRALIA
A division of the Department of Finance, Services and Innovation
MARTIN HOFFMAN
Secretary

NSW GOVERNMENT Education

ARTARMON
PUBLIC SCHOOL
NEW FACILITIES PROJECT

SITE SECTIONS

PLAN RM NO	
SCALES	1:100 @ A1
DESIGNED	TYRRELL
PLOT DATE	20.04.2016
DRAFTED	TYRRELL
VERIFIED	TYRRELL
CONTRACT NUMBER	1500654
SHEET NO	~~L501~~
REVISION	

A1 0 10 20 30 40 50 60 70 80 90 100
USE FIGURED DIMENSIONS IN PREFERENCE TO SCALING
CHECK ALL DIMENSIONS ON SITE
200MM
300MM ON ORIGINAL

© CROWN IN RIGHT OF NSW THROUGH THE DEPARTMENT OF FINANCE, SERVICES AND INNOVATION

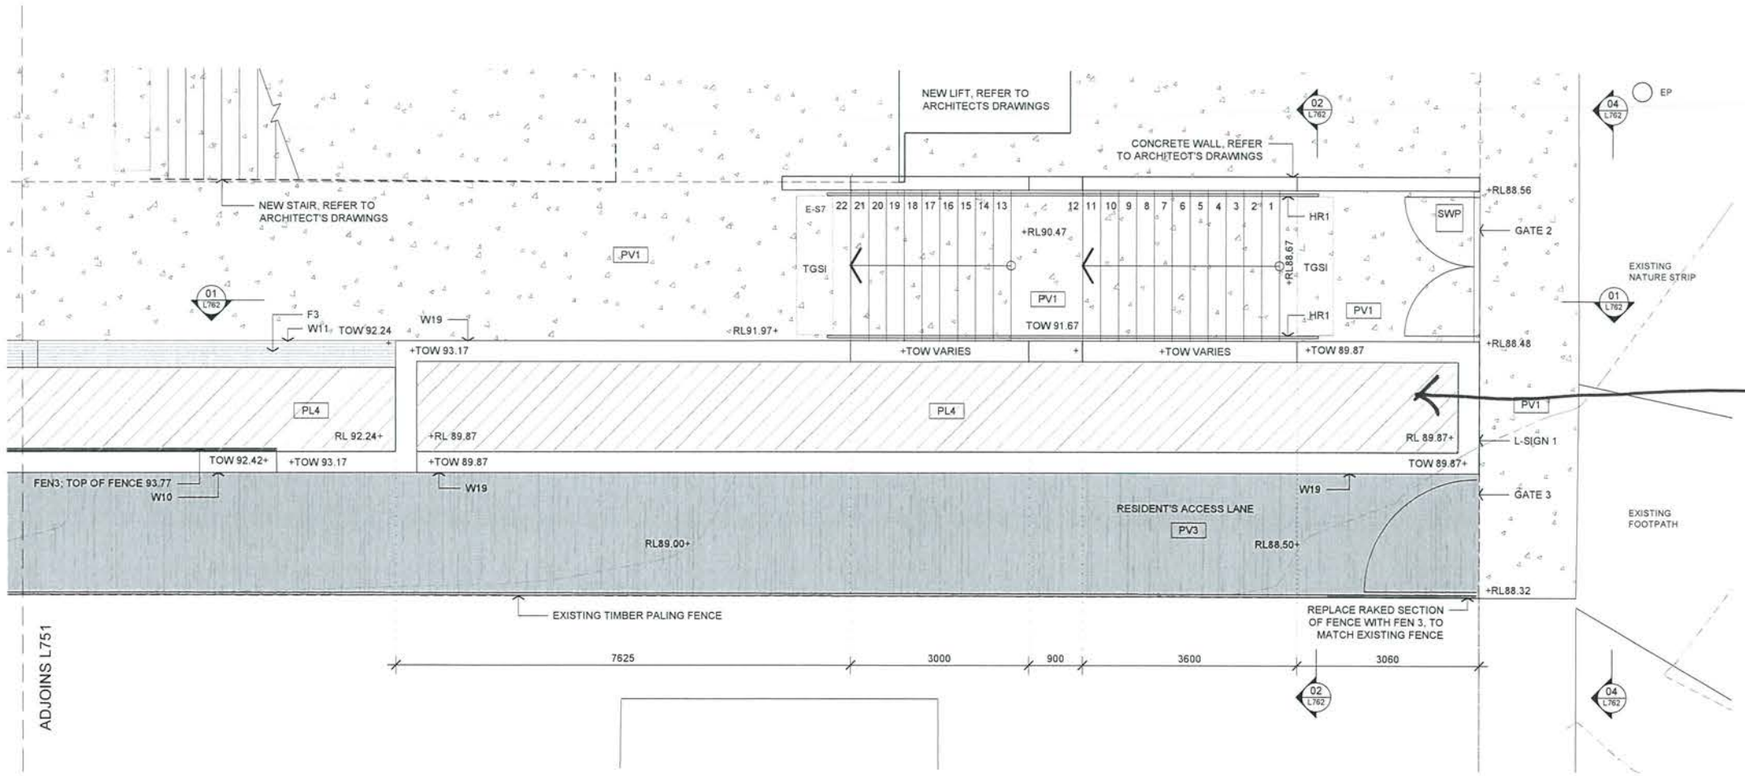

'NEW' REVISED PLAN

01 DETAIL PLAN: BARTON ROAD ENTRANCE
SCALE 1:50@A1

SHADOW STUDY (4)
NEW FENCE DESIGN

LEGEND

PV1, A-D	INSITU CONCRETE PAVING: OXIDES A-D	F3	BENCH SEATS	PM1	SYNTHETIC TURF MOUND SMALL	CW-P	COVERED WAY PURLIN
ABF	ABRASIVE BLAST FINISH	F4	AGRICULTURAL PLANTERS	PM4	SYNTHETIC TURF MOUND MEDIUM	CW-R	COVERED WAY RAFTER
PV1	ASPHALT	F5	TREE GRATE	PM5	SYNTHETIC TURF MOUND LARGE	CW-CAN	COVERED WAY CANOPY
PV4	COMPACTED GRAVEL	F6	FLAG POLE	PM6	SYNTHETIC TURF PYRAMID MOUND	CW-CON	COVERED WAY CONNECTOR
PV5	PERMEABLE PAVING	F7	BIKE RACKS	PP1-3	PRECAST TREAD TYPES 1-3	CW-END1	COVERED WAY PANEL CAP
PV6_A-E	SOFTFALL PAVING: COLOURS A-E	FEN1-3	FENCE TYPES 1-3	STF1-3	SYNTHETIC TURF TYPES 1-3	CW-END2	COVERED WAY CONNECTOR
		GATE1-7	GATES 1-7	STF1-WL	SYNTHETIC TURF WHITE LINES		
W1-24	WALL NUMBERS 1-24	HR1-3	HANDRAIL TYPES 1-3	SN1	STAIR NOSING TYPE 1	EP	ELECTRICAL POLE
E-S1-14	LANDSCAPE STAIR NUMBERS 1-14	J	CONCRETE PAVING JOINT	T1	TREE TYPE 1	EOW	EXTENT OF WORKS
		LP1-3	LIGHT TYPE 1-3	T2	TREE TYPE 2	SSD	SUBSOIL DRAINAGE
ACC1	ASPHALTIC CONCRETE COLOUR 1	L-SIGN1	SIGNAGE TYPE 1	TX	EXISTING TREE RETAINED	SWP	STORMWATER PIT
ACC2	ASPHALTIC CONCRETE COLOUR 2	L-SIGN2	SIGNAGE TYPE 2	TGSI	TACTILE SURFACE GROUND INDICATORS	PIT	EXISTING SERVICE PIT
E1	EDGE TYPE 1	PL1-6	PLANTING TYPES 1-6			TOW	TOP OF WALL RL
F1	CIRCULAR BENCH	PM1	MEGA CHUTE SLIDE	CW-C	COVERED WAY COLUMN	RL	RELATIVE LEVEL
F2	TABLE AND BENCH SEATS	PM2	PLAY STRUCTURE	CW-B	COVERED WAY BEAM		

REVISION		
ISS	DATE	COMMENT

DRAFT FOR COORDINATION

ARCHITECTURAL GOVERNMENT ARCHITECT'S OFFICE T 9372 6493	QUANTITY SURVEYOR GOVERNMENT ARCHITECT'S OFFICE T 9372 8362	LIFT GOVERNMENT ARCHITECT'S OFFICE T 9372 8165
LANDSCAPE TYRRELL STUDIO T 8418 928 926	STRUCTURAL GOVERNMENT ARCHITECT'S OFFICE T 9372 8227	FIRE ENGINEER OLSSON FIRE & RISK T 9372 8288 F 9372 8133
MECHANICAL GOVERNMENT ARCHITECT'S OFFICE T 9372 8161	BUILDING CODE CONSULTANT METRO BUILDING CONSULTANCY T 9692 8477 F 9299 4555	PROJECT MANANGEMENT NSW PUBLIC WORKS T 9852 9142
ELECTRICAL GOVERNMENT ARCHITECT'S OFFICE T 9372 8222	HYDRAULIC GOVERNMENT ARCHITECT'S OFFICE T 9372 8147	

NSW GOVERNMENT

Public Works
Government Architect's Office
BRUCE PETTMAN
Assistant Government Architect
Nominated Architect ARN 7228
Level 19 McKell Building, 2-24 Rawson Place
Sydney NSW 2000 AUSTRALIA
A division of the Department of Finance, Services and Innovation
MARTIN HOFFMAN
Secretary

NSW GOVERNMENT Education

ARTARMON PUBLIC SCHOOL NEW FACILITIES PROJECT

DETAIL PLAN

MCMILLAN CAMPUS 3

PLAN RW NO		CONTRACT NUMBER 1500654
SCALE 1:50 @ A1		SHEET NO ~~L752~~
DESIGNED TYRRELL	PLOT DATE 20.04.2016	
DRAFTED TYRRELL	VERIFIED TYRRELL	REVISION

A1 1 9 10 20 30 40 50 60 70 80 90 100
USE FIGURED DIMENSIONS IN PREFERENCE TO SCALING
CHECK ALL DIMENSIONS ON SITE
200MM
300MM ON ORIGINAL

© CROWN IN RIGHT OF NSW THROUGH THE DEPARTMENT OF FINANCE, SERVICES AND INNOVATION

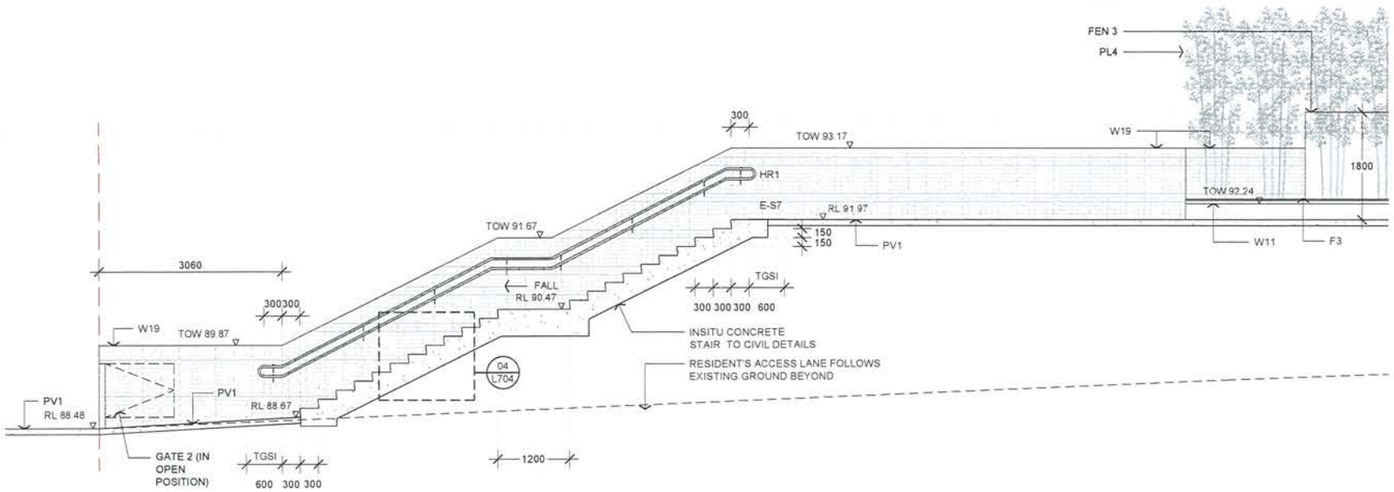

01 DETAIL SECTIONAL ELEVATION: BARTON ROAD ENTRANCE
SCALE 1:50@A1

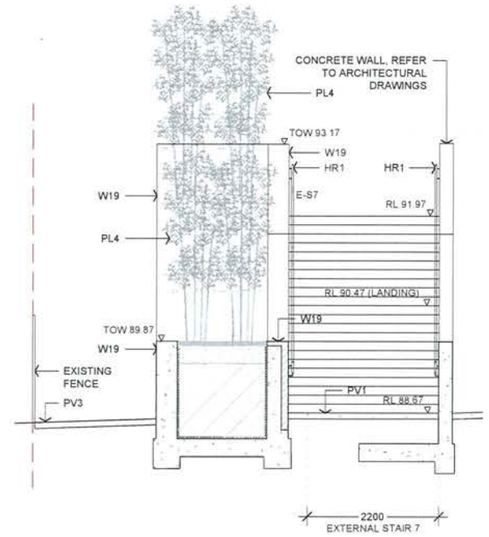

02 DETAIL SECTIONAL ELEVATION: BARTON ROAD ENTRANCE
SCALE 1:50@A1

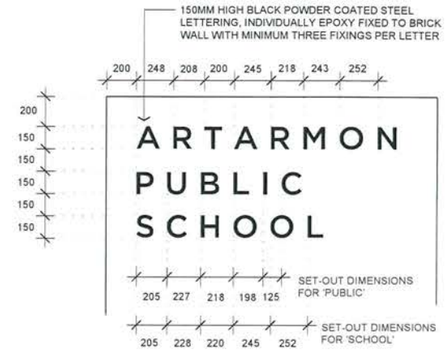

03 DETAIL: BARTON ROAD SIGNAGE
SCALE 1:20@A1

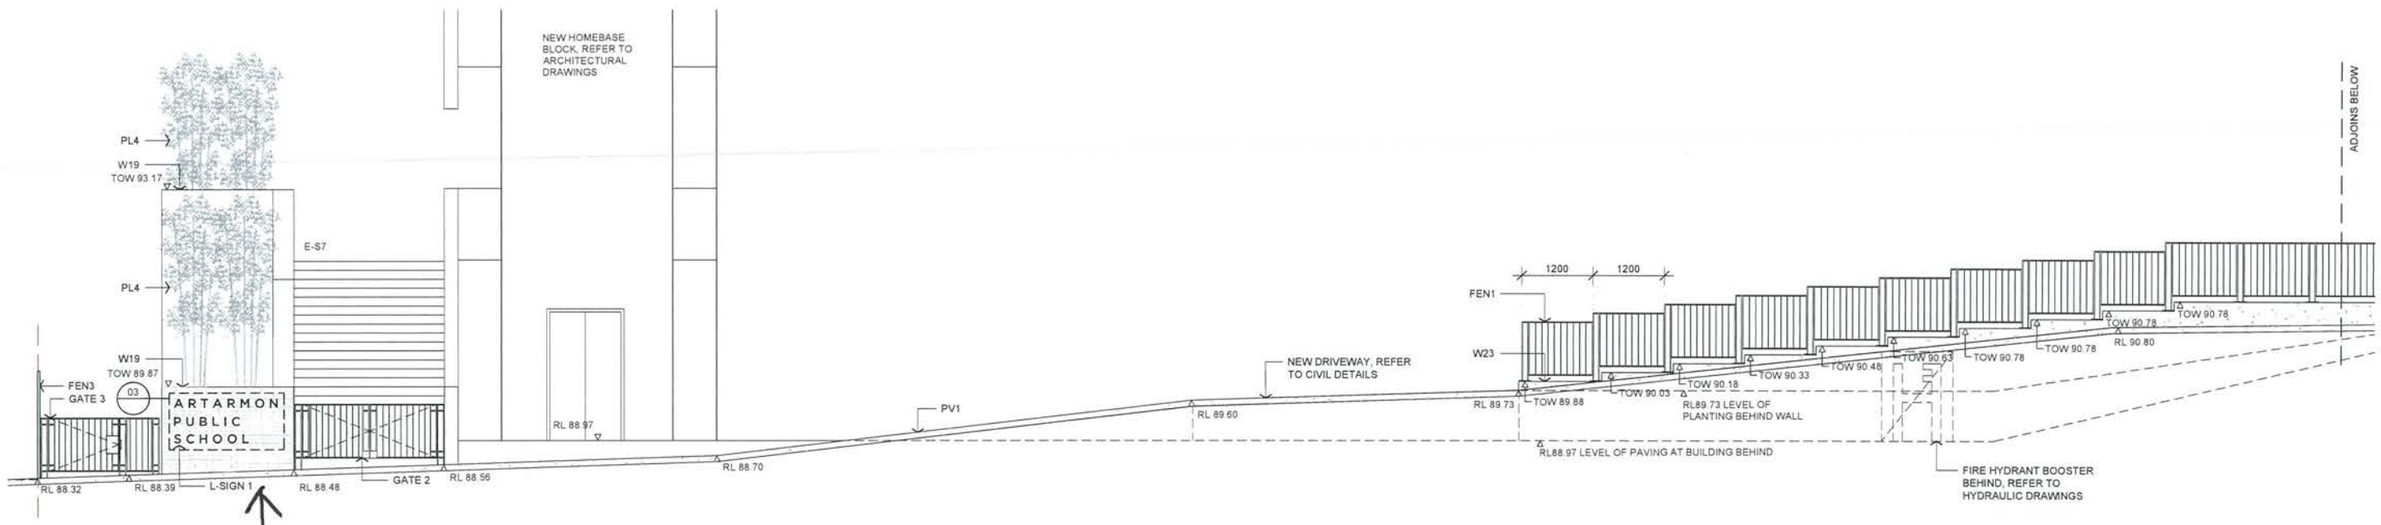

04 DETAIL ELEVATION: BARTON ROAD ENTRANCE
SCALE 1:50@A1

NEW!
REVISED ELEVATION
TO BARTON ROAD

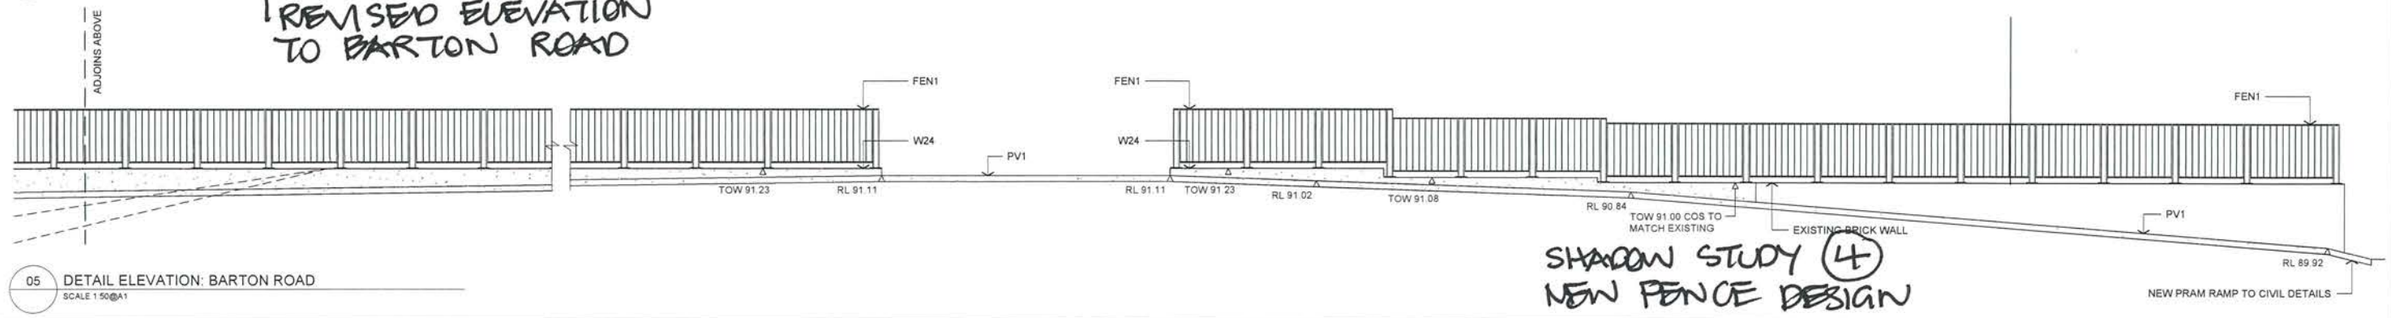

05 DETAIL ELEVATION: BARTON ROAD
SCALE 1:50@A1

SHADOW STUDY (4)
NEW FENCE DESIGN

LEGEND

PV1_A-D	INSITU CONCRETE PAVING. GRIDES A-D	P3	BENCH SEATS	PM3	SYNTHETIC TURF MOUND SMALL	CW-P	COVERED WAY PURLIN
ABF	ABRASIVE BLAST FINISH	P4	AGRICULTURAL PLANTERS	PM4	SYNTHETIC TURF MOUND MEDIUM	CW-R	COVERED WAY RAFTER
PV3	ASPHALT	P5	TREE GRATE	PM5	SYNTHETIC TURF MOUND LARGE	CW-CAN	COVERED WAY CANOPY
PV4	COMPACTED GRAVEL	P6	FLAG POLE	PM6	SYNTHETIC TURF PYRAMID MOUND	CW-CON	COVERED WAY CONNECTOR
PV5	PERMEABLE PAVING	P7	BIKE RACKS	PP1-2	PRECAST TREAD TYPES 1-3	CW-END1	COVERED WAY PANEL CAP
PV9_A-E	SOFTFALL PAVING. COLOURS A-E	FEN1-3	FENCE TYPES 1-3	STF1-3	SYNTHETIC TURF TYPES 1-3	CW-END2	COVERED WAY CONNECTOR
		GATE1-7	GATES 1-7	STF1-WL	SYNTHETIC TURF WHITE LINES		
W1-24	WALL NUMBERS 1-24	HR1-3	HANDRAIL TYPES 1-3	SN1	STAIR NOSING TYPE 1	EP	ELECTRICAL POLE
E-S1-14	LANDSCAPE STAIR NUMBERS 1-14	J	CONCRETE PAVING JOINT	T1	TREE TYPE 1	EOW	EXTENT OF WORKS
		LP1-3	LIGHT TYPE 1-3	T2	TREE TYPE 2	SSD	SUBSOIL DRAINAGE
ACC1	ASPHALTIC CONCRETE COLOUR 1	L-SIGN1	SIGNAGE TYPE 1	TX	EXISTING TREE RETAINED	SWP	STORMWATER PIT
ACC2	ASPHALTIC CONCRETE COLOUR 2	L-SIGN2	SIGNAGE TYPE 2	TGSI	TACTILE SURFACE GROUND	PIT	EXISTING SERVICE PIT
E1	EDGE TYPE 1	PL1-8	PLANTING TYPES 1-8		INDICATORS	TOW	TOP OF WALL RL
F1	CIRCULAR BENCH	PM1	MEGA CHUTE SLIDE	CW-C	COVERED WAY COLUMN	RL	RELATIVE LEVEL
F2	TABLE AND BENCH SEATS	PM2	PLAY STRUCTURE	CW-B	COVERED WAY BEAM		

REVISION		
ISS	DATE	COMMENT

DRAFT FOR
COORDINATION

ARCHITECTURAL GOVERNMENT ARCHITECT'S OFFICE T 9372 8463	QUANTITY SURVEYOR GOVERNMENT ARCHITECT'S OFFICE T 9372 8362	LIFT GOVERNMENT ARCHITECT'S OFFICE T 9372 8163	
LANDSCAPE TYRRELL STUDIO T 9419 9325	STRUCTURAL GOVERNMENT ARCHITECT'S OFFICE T 9372 8227	FIRE ENGINEER OLSSON FIRE & RISK T 9372 8298 F 9372 8133	
MECHANICAL GOVERNMENT ARCHITECT'S OFFICE T 9372 8151	BUILDING CODE CONSULTANT METRO BUILDING CONSULTANCY T 9692 4477 F 9299 4968	PROJECT MANANGEMENT NSW PUBLIC WORKS T 9852 6142	
ELECTRICAL GOVERNMENT ARCHITECT'S OFFICE T 9372 8222	HYDRAULIC GOVERNMENT ARCHITECT'S OFFICE T 9372 8143		

NSW GOVERNMENT

Public Works
Government Architect's Office
BRUCE PETTMAN
Assistant Government Architect
Nominated Architect ARN 7228
Level 18 Market Building - 2-24 Rawson Place
Sydney NSW 2000 AUSTRALIA
A division of the Department of Finance, Services and Innovation
MARTIN HOFFMAN
Secretary

NSW GOVERNMENT Education

ARTARMON
PUBLIC SCHOOL
NEW FACILITIES PROJECT

DETAIL SECTIONS
MCMILLAN CAMPUS

PLAN RM NO		CONTRACT NUMBER 1500654
SCALES 1:50 @ A1		SHEET NO L762
DESIGNED TYRRELL	PLOT DATE 20.04.2016	
DRAFTED TYRRELL	VERIFIED TYRRELL	REVISION

A1 0 10 20 30 40 50 60 70 80 90 100
USE FIGURED DIMENSIONS IN PREFERENCE TO SCALING
CHECK ALL DIMENSIONS ON SITE
200MM
300MM ON ORIGINAL

© CROWN IN RIGHT OF NSW THROUGH THE DEPARTMENT OF FINANCE, SERVICES AND INNOVATION

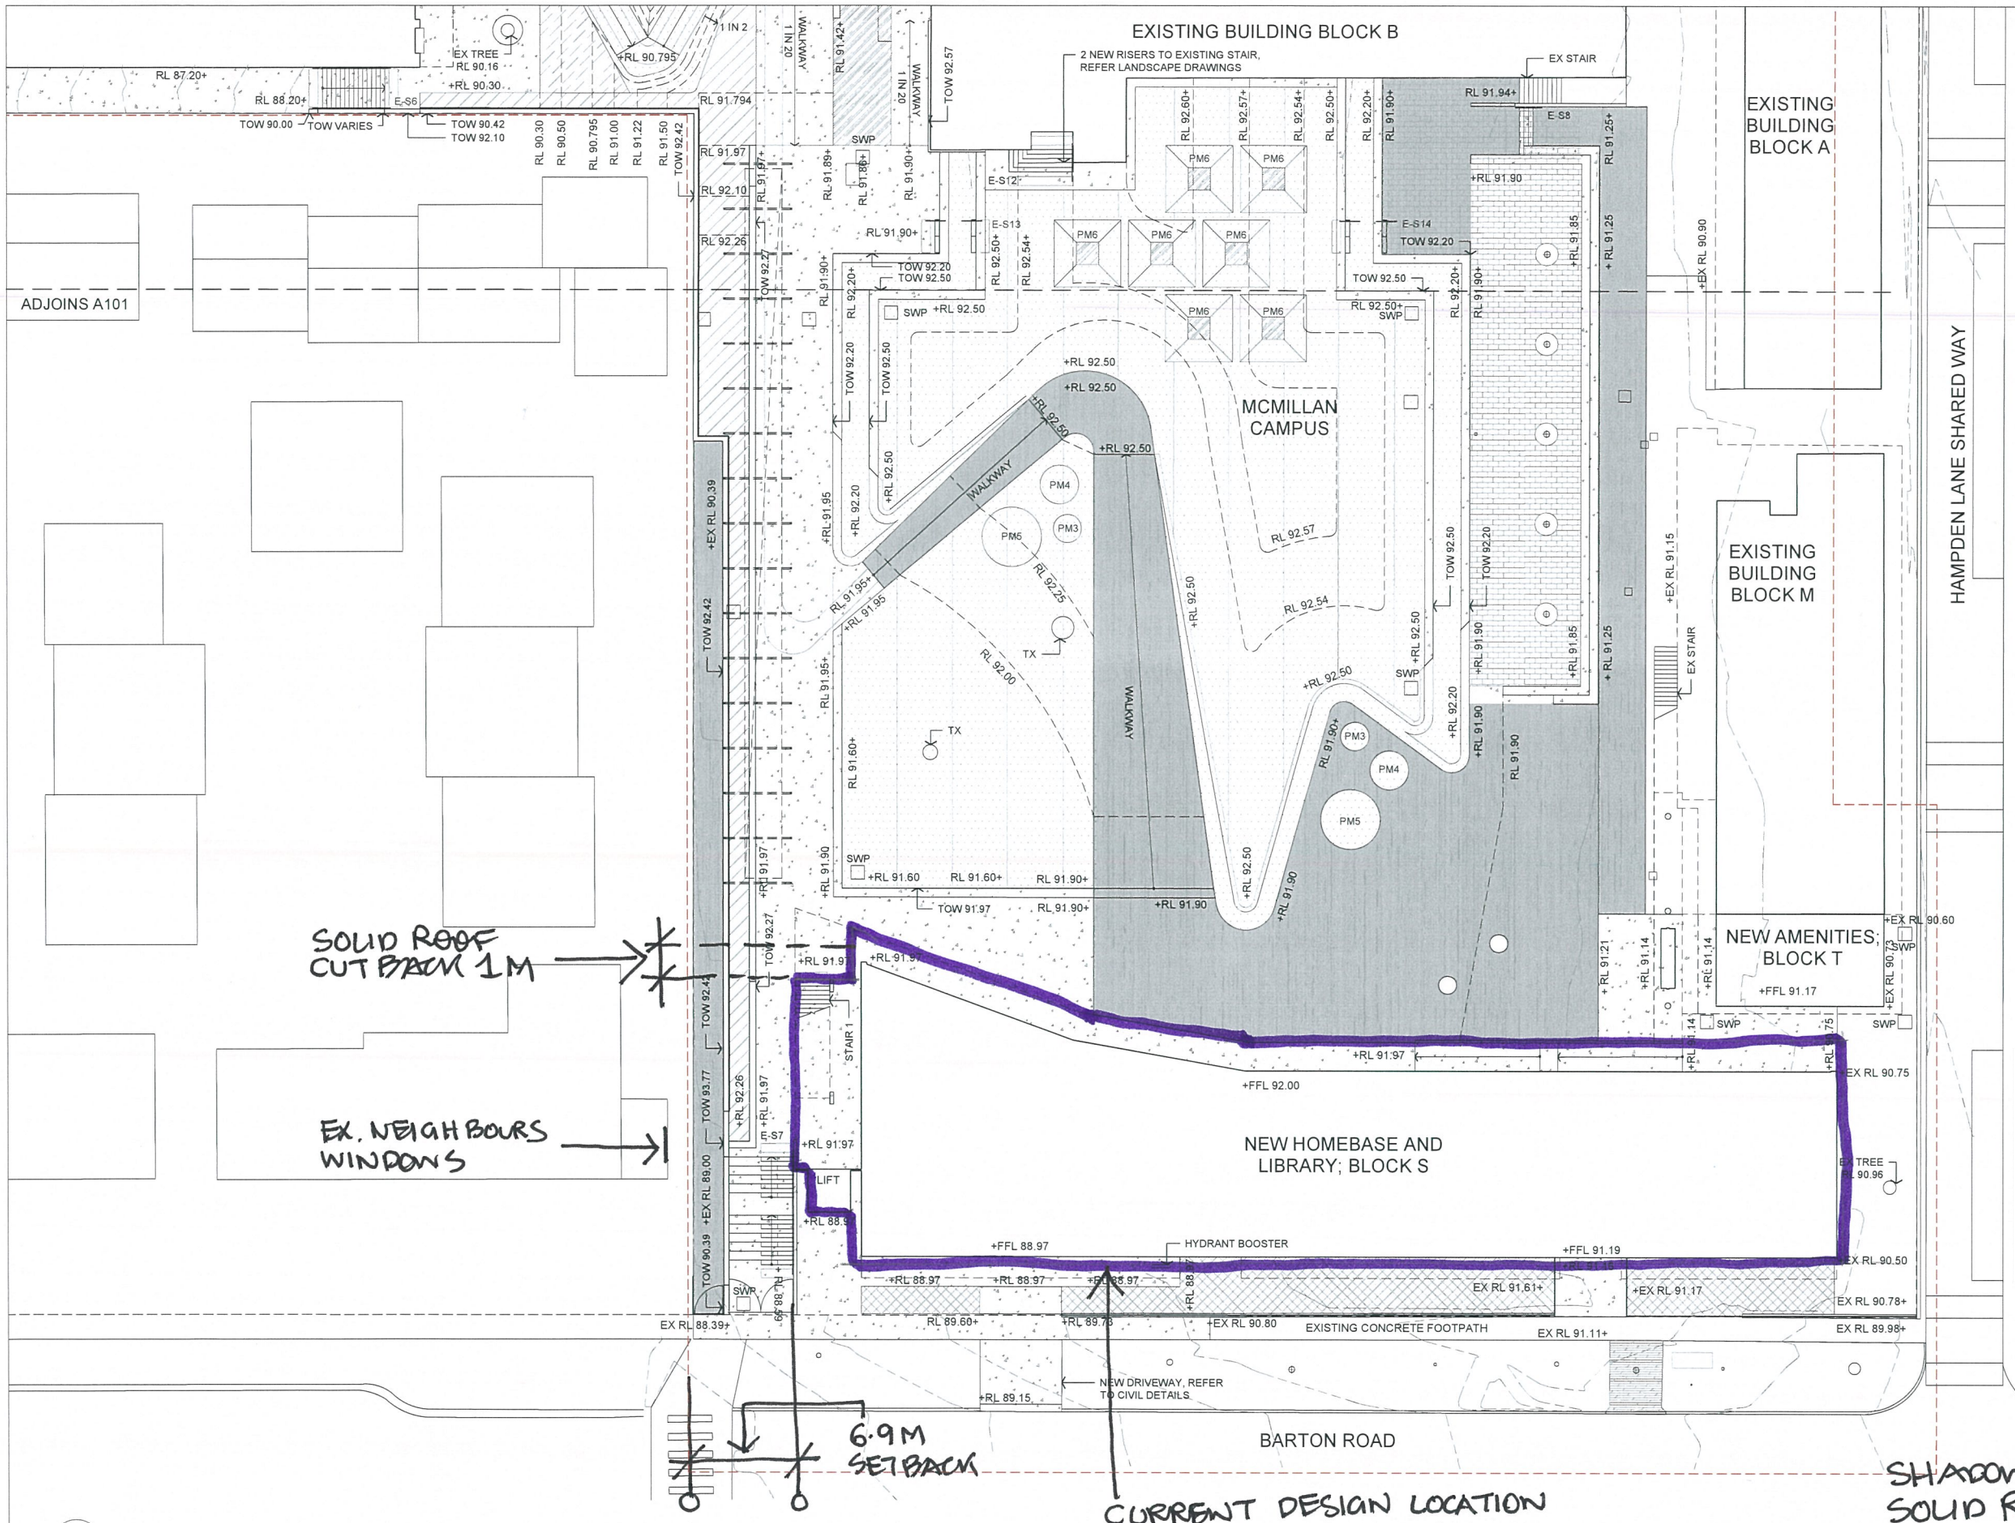

01 MCMILLAN CAMPUS SITE LEVELS AND GRADING PLAN
SCALE 1:200@A1

NOTES:

1. REFER TO L101 AND L102 FOR LANDSCAPE GENERAL ARRANGEMENT PLANS
2. REFER TO L301 AND L302 FOR PLANTING PLANS AND SCHEDULE
3. MAKE GOOD FINISHES GENERALLY AROUND NEW WORK

KEY:

RL	RELATIVE LEVEL
EX RL	EXISTING RELATIVE LEVEL
TOW	TOP OF WALL
E-S1	EXTERNAL STAIR 1
SWP	STORMWATER PIT, REFER TO L101 AND L102 AND CIVIL DRAWINGS
PM1	MEGACHUTE SLIDE, REFER TO LANDSCAPE DRAWINGS
PM3	SMALL SYNTHETIC TURF MOUND, REFER TO LANDSCAPE DRAWINGS
PM4	MEDIUM SYNTHETIC TURF MOUND, REFER TO LANDSCAPE DRAWINGS
PM5	LARGE SYNTHETIC TURF MOUND, REFER TO LANDSCAPE DRAWINGS
PM6	PYRAMID SYNTHETIC TURF MOUND, REFER TO LANDSCAPE DRAWINGS

NEW TREE, REFER L301 AND L302

NEW INSITU CONCRETE; REFER L101 AND L102

NEW ASPHALT; REFER L101 AND L102

NEW CRUSHED GRAVEL; REFER L101 AND L102

NEW UNIT PAVING; REFER L101 AND L102

NEW SOFTFALL; REFER L101 AND L102

NEW SYNTHETIC TURF; REFER L101 AND L102

NEW PLANTING TYPE 1; REFER L101 AND L102

NEW PLANTING TYPE 2; REFER L101 AND L102

NEW PLANTING TYPE 3; REFER L101 AND L102

NEW PLANTING TYPE 4; REFER L101 AND L102

NEW PLANTING TYPE 5; REFER L101 AND L102

NEW PLANTING TYPE 6; TURF PLANTING; REFER L101 AND L102

STUDY PLAN

LEGEND
REFER TO COLOUR & FINISHES SCHEDULE FOR DETAIL OF TYPES & COLOURS

ACC1	ASPHALTIC CONCRETE COLOUR (No INDICATES COLOUR)
AL1	ALUM LOUVRE (No INDICATES TYPE)
AW	AWNING WINDOW
AWC	ACCESSIBLE WC
B	BOLLARD
BAL	BALUSTRADE
BU	BUILDING DOTTED UNDER
CHG	CIRCULAR HOLLOW SECTION
COLA	COVERED OUTDOOR LEARNING AREA
CON	CONCRETE
CON-C	CONCRETE - COVED
CON-H	CONCRETE - HONED
CON-G	CONCRETE - GRANOLITHIC TOPPING
CON-S	CONCRETE - STEEL TROWELED
COS	CHECK ON SITE
CPT-1	CARPET TYPE 1 (No INDICATES TYPE)
DPL	DOOR PANEL LIFT
DSC	DOOR SOLID CORE
DSG	DOOR SOLID GLAZED
EGB	EXTERNAL GYPSUM BOARD
E-P1	EXTERNAL PAINT COLOUR 1 (No INDICATES COLOUR)
EQ	EQUAL
ES	EXISTING
FB-1	FACE BRICK (No INDICATES TYPE)
FC-1	FIBRE CEMENT CLADDING/SOFFIT (No INDICATES COLOUR)
FCT	FLOOR CERAMIC TILES
FEN1	FENCE (No INDICATES TYPE)
FFL	FINISHED FLOOR LEVEL
FG	FIXED GLAZING
FL	FLASHING
FP	FLAS POLE
FW	FLOOR WASTE
G1	GATE TYPE 1 (No INDICATES TYPE)
GL	GROUNDLINE
GLX	EXISTING GROUND LINE
HR	HANDRAIL GENERALLY
I-P1	INTERNAL PAINT COLOUR 1 (No INDICATES COLOUR)
KF	KERB FLUSH
KG	KERB GUTTER
KR	KERB ROLLOVER
LAM	LAMINATE (No INDICATES COLOUR)
LGA	LOUVRE GLASS ADJUSTABLE
LMF	LOUVRES METAL FIXED
MSB	MAIN SWITCH BOARD
MSC-1	METAL SCREEN (No INDICATES TYPE)
MSH-1	MESH CURTAIN (No INDICATES TYPE)
MVE	MECHANICAL VENT EXHAUST CONL
NTS	NOT TO SCALE
OFC	OFF FORM CONCRETE
PB	PLASTERBOARD
PIN-1	PINBOARD LINING (No INDICATES COLOUR & TYPE)
PV1	PAVING TYPE 1 (No INDICATES TYPE)
PC-1	POWDER COATED STEEL (No INDICATES TYPE)
RB1	RUBBER BASE (No INDICATES TYPE)
RFS	FASCIA GENERALLY
RF-1	RESILIENT FLOORING (No INDICATES TYPE & COLOUR)
RHS	RECTANGULAR HOLLOW SECTION
RL	RELATIVE LEVEL
RO	ROOF OVER
RRC	ROOF RIDGE CAPPINGS
RS1	ROOF SHEETING (No INDICATES TYPE)
RSF	ROOF FLASHING
RW	RETAINING WALL
RWG	RAINWATER GUTTER
RWP	RAINWATER DOWNPIPE TO 3.4m
RWP1	RAINWATER DOWNPIPE ABOVE 3.4m
RWT	RAINWATER TANK
SC	STEEL COLUMN
SKT	SKIRTINGS
SPR	SPREADER
STF1	SYNTHETIC TURF (No INDICATES TYPE)
TOW	TOP OF WALL
TSF	TACTILE STRIPING SURFACE INDICATORS
VP	VENT PIPE
WBL	WALL BLOCKWORK
WC	TOILET
WC1	CERAMIC WALL TILING (No INDICATES TYPE)
WS	WHEEL STOP

REVISION		
ISS	DATE	COMMENT

DRAFT FOR COORDINATION

ARCHITECTURAL GOVERNMENT ARCHITECT'S OFFICE T 9372 8443	QUANTITY SURVEYOR GOVERNMENT ARCHITECT'S OFFICE T 9372 8382	LIFT GOVERNMENT ARCHITECT'S OFFICE T 9372 8183	
LANDSCAPE TYRRELL STUDIO T 0418 928 928	STRUCTURAL GOVERNMENT ARCHITECT'S OFFICE T 9372 8227	FIRE ENGINEER OLSSON FIRE & RISK T 9372 8286 F 9372 8133	
MECHANICAL GOVERNMENT ARCHITECTS OFFICE T 9372 8191	BUILDING CODE CONSULTANT METRO BUILDING CONSULTANCY T 9882 8477 F 8209 4955	PROJECT MANANGEMENT NSW PUBLIC WORKS T 8852 9143	
ELECTRICAL GOVERNMENT ARCHITECT'S OFFICE T 9372 8232	HYDRAULIC GOVERNMENT ARCHITECT'S OFFICE T 9372 8147		

NSW GOVERNMENT
Public Works
Government Architect's Office
BRUCE PETTMAN
Assistant Government Architect
Nominated Architect ARN 7228
Level 19 McKell Building, 2-24 Rawson Place
Sydney NSW 2000 AUSTRALIA
A division of the Department of Finance, Services and Innovation
MARTIN HOFFMAN
Secretary

NSW GOVERNMENT Education

ARTARMON PUBLIC SCHOOL NEW FACILITIES PROJECT

SITE LEVELS & GRADING PLAN (1)

MCMILLAN CAMPUS

PLAN RM NO		CONTRACT NUMBER	1500654
SCALES	1:200 @ A1	SHEET NO	A100
DESIGNED TYRRELL	PLOT DATE 07.04.2016		
DRAFTED TYRRELL	VERIFIED TYRRELL	REVISION	

A1 0 10 20 30 40 50 60 70 80 90 100
USE FIGURED DIMENSIONS IN PREFERENCE TO SCALING
CHECK ALL DIMENSIONS ON SITE
200MM
300MM ON ORIGINAL

© CROWN IN RIGHT OF NSW THROUGH THE DEPARTMENT OF FINANCE, SERVICES AND INNOVATION

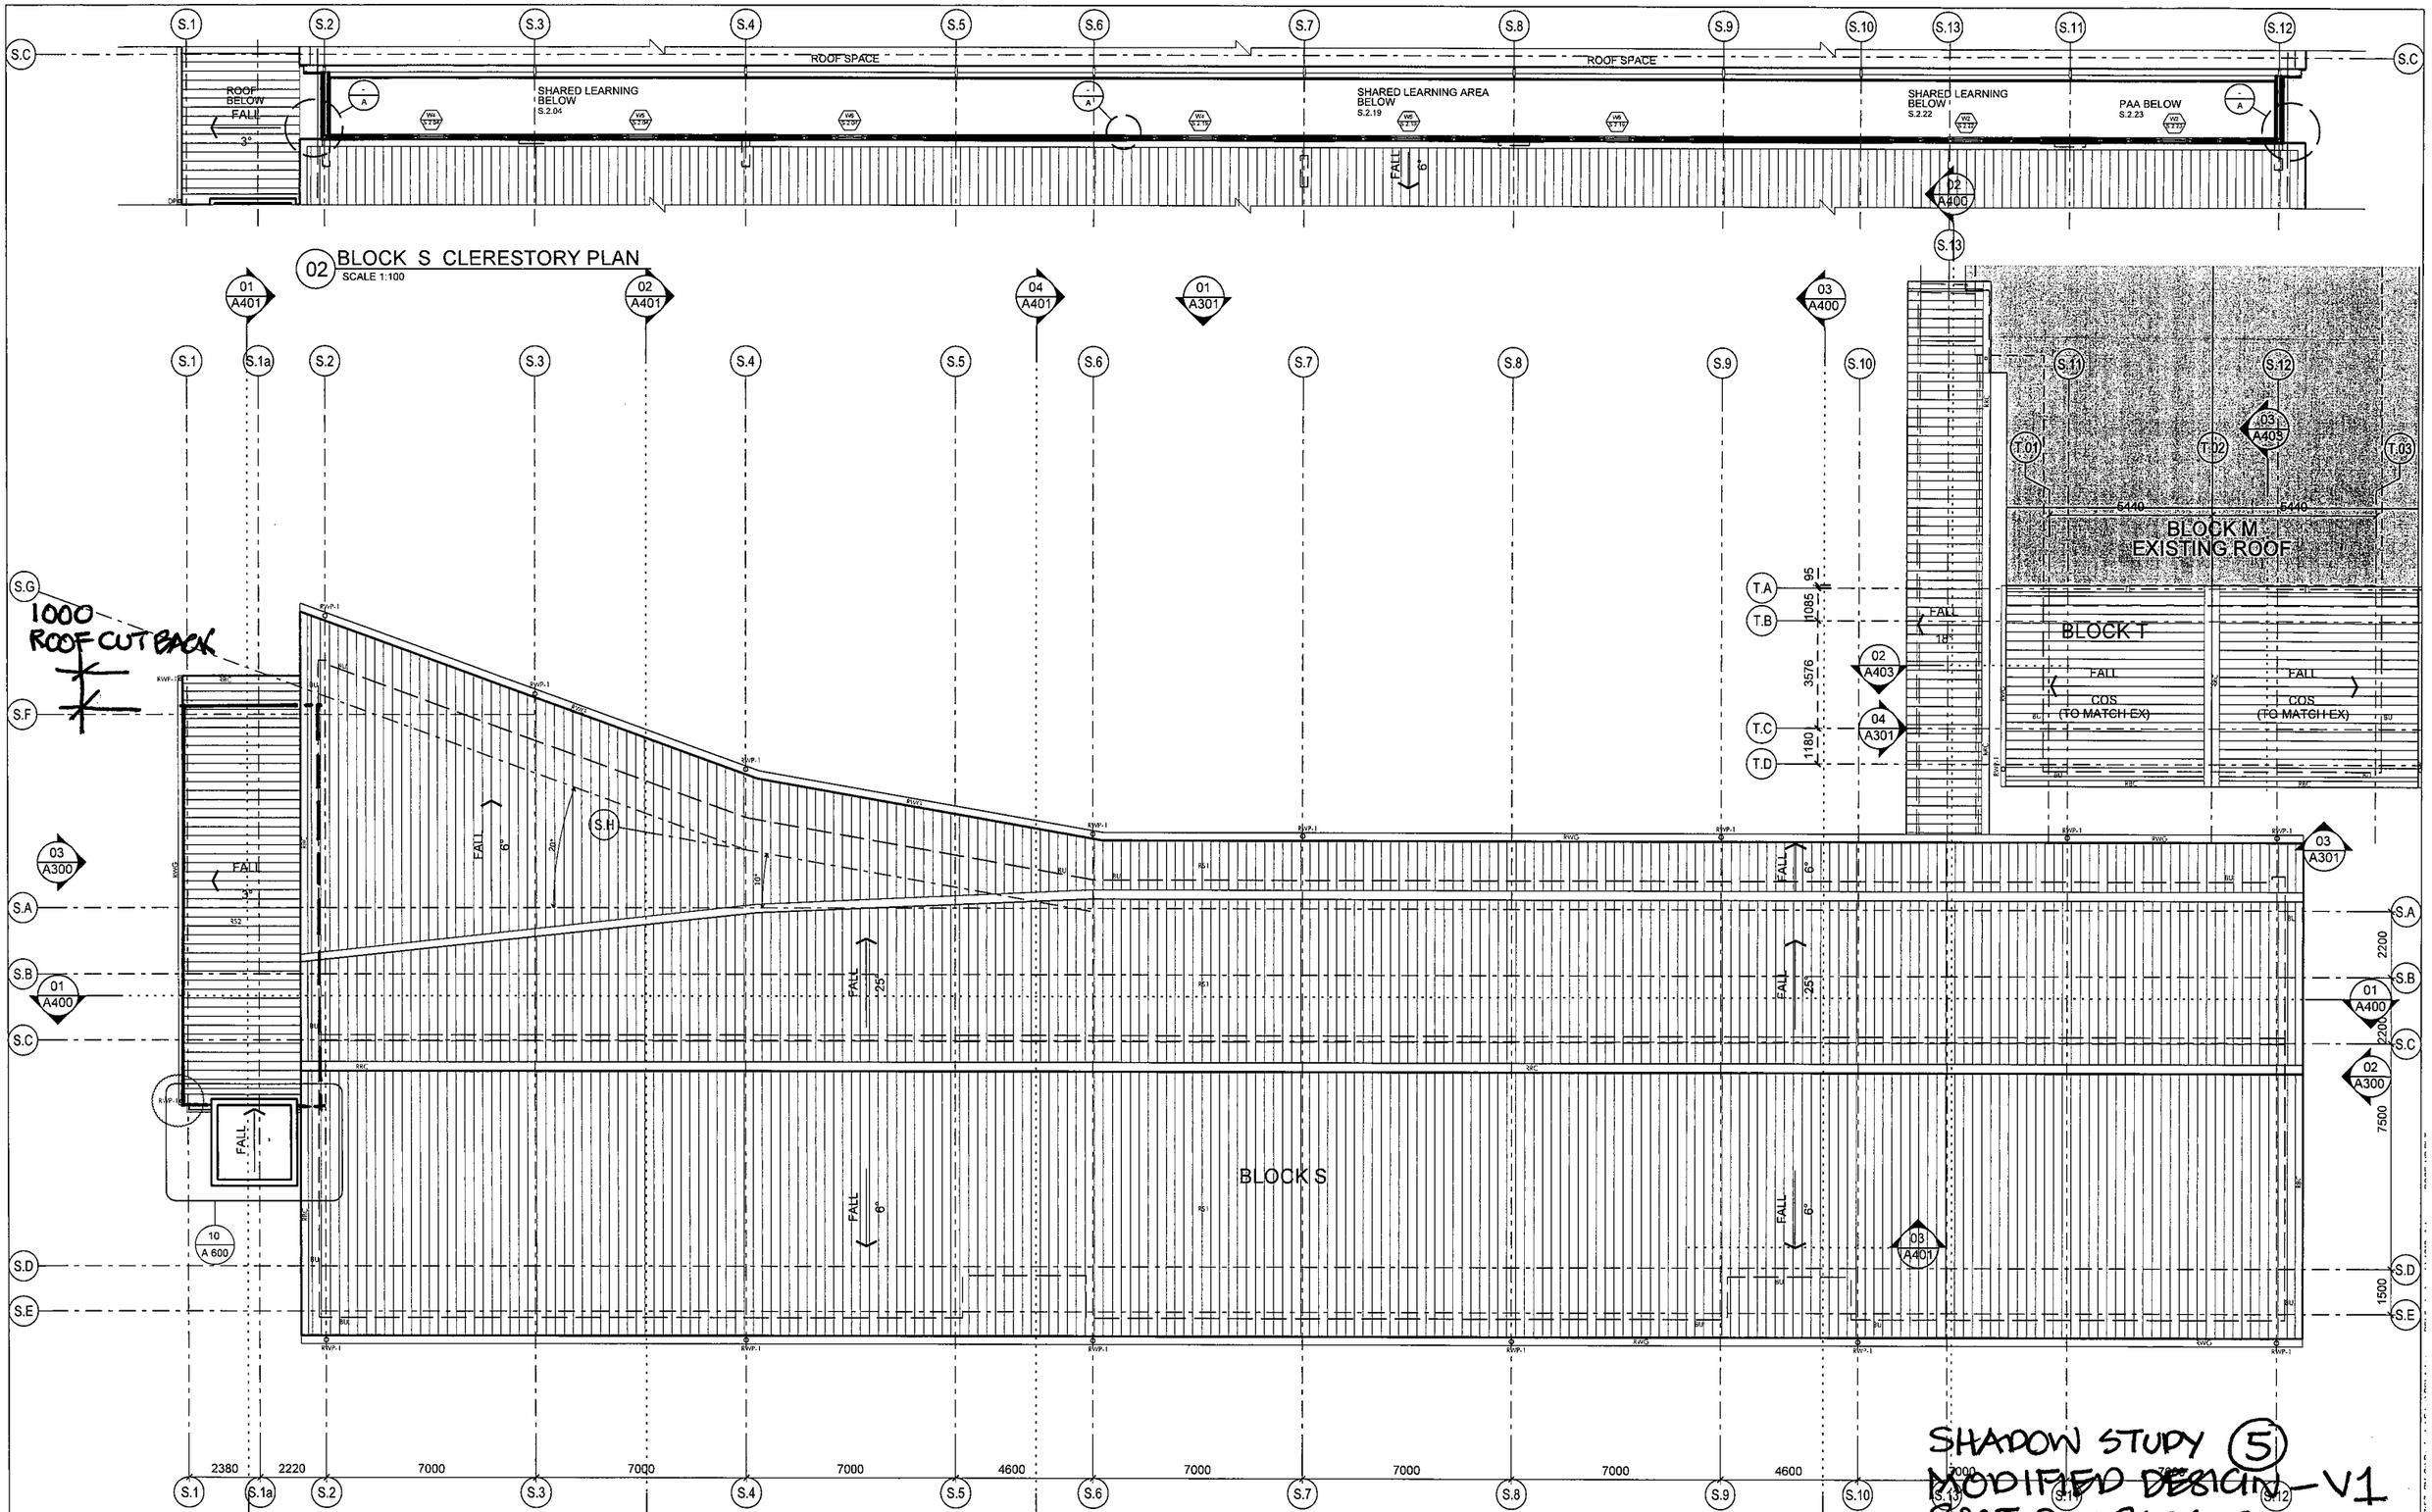

SHADOW STUDY (5)
~~MODIFIED DESIGN~~ - V1
ROOF CUT BACK - SOLID METAL ROOF.

1 The Government Architect's Office, a division of the Department of Finance & Services (the Department) shall not be liable or responsible for any loss or damage arising out of the conversion of any electronic document, data or program to any other format or medium, or arising out of any modification or changes that occur in the handling or use of the electronic document, data or program.

2 The recipient or user of any electronic document, data or program is solely responsible for ascertaining its accuracy and its suitability for their purposes.

3 The Department uses a virus scanning software in pre-net file and system virus attacks but gives no warranty. The recipient or user is solely responsible for their own virus protection.

LEGEND

REFER TO COLOUR & FINISHES SCHEDULE FOR DETAIL OF TYPES & COLOURS

ACC1	ASPHALTIC CONCRETE COLOUR (W INDICATES COLOUR)
AL-1	ALUM LOUVRE (W INDICATES TYPE)
AW	AWNING WINDOW
AWC	ACCESSIBLE WC
B	BOLLARD
BALI	BALUSTRADE (W INDICATES TYPE)
BU	BUILDING DOTTED UNDER
CB	CONCRETE BLOCK
CB-R	CONCRETE BLOCK - RENDERED
CFS	CIRCULAR HOLLOW SECTION
CO	COVERED OUTDOOR LEARNING AREA
CON	CONCRETE
CON-C	CONCRETE - COVED
CON-H	CONCRETE - HONED
CON-G	CONCRETE - GRANOLITHIC TOPPING
CON-S	CONCRETE-STEEL "NOWLED"
COS	CHECK ON SITE
CPT-1	CARPET TYPE 1 (W INDICATES TYPE)
DPL	DOOR PANEL LIFT
DSC	DOOR SOLID CORE
DSG	DOOR SLIDING GLASS
EDB	ELECTRICAL DISTRIBUTION BOARD
E-P1	EXTERNAL PAINT COLOUR 1 (W INDICATES COLOUR)
EQ	EQUAL
EX	EXISTING
FB-1	FACE BRICK (W INDICATES TYPE)
FC1	FIBRE CEMENT CLADD SOFFIT (NB INDICATES COLOUR)
FCT	FLOOR CERAMIC TILES
FEN	FENCE (W INDICATES TYPE)
FFL	FINISHED FLOOR LEVEL
FG	FIXED GLAZING
FL	FLASHING
FP	FLAG POLE
FW	FLOOR WASTE
G1	GATE TYPE 1 (W INDICATES TYPE)
GD	GRATED DRAIN
GL	GROUNDLINE
GLX	EXISTING GROUND LINE
HH	HYDRONIC HEATER PANEL
HR	HANDRAIL GENERALLY
IP1	INTERNAL PAINT COLOUR 1 (W INDICATES COLOUR)
KG	KERB GUTTER
KR	KERB ROLLOVER
LAM	LAMINATE (W INDICATES COLOUR)
LGA	LOUVRE GLASS ADJUSTABLE
LNP	LOUVRE METAL FIXED
MSB	MAIN SWITCH BOARD
MSC1	METAL SCREEN (W INDICATES TYPE)
MSH	MESH GRATE (W INDICATES TYPE)
NGR	NEW GRATE
NTS	NOT TO SCALE
OFC	OFF FORM CONCRETE
PB	PLASTERBOARD
PNL	PYNBOARD LINING (W INDICATES COLOUR & TYPE)
PV1	PAVING TYPE 1 (NB INDICATES TYPE)
PC-1	POWDER COATED STEEL (W INDICATES TYPE)
RBC	BARGE CAPPING
RF3	FASCIA GENERALLY
RF-1	RESILIENT FLOORING (W INDICATES TYPE & COLOUR)
RHS	RECTANGULAR HOLLOW SECTION
RL	RELATIVE LEVEL
RO	ROOF OVER
RRC	ROOF RIDGE CAPPINGS
RS1	ROOF SHEETING (W INDICATES TYPE)
RSF	ROOF FLASHING
RV	ROOF VENT
RW	RAINWATER WALL
RWG	RAINWATER GUTTER
RWP	RAINWATER DOWNPIPE - CHS
RWP	RAINWATER DOWNPIPE - ZINCALUME
RWT	RAINWATER TANK
SC	STEEL COLUMN
SKT	SKIRTINGS
SPR	SPREADER
SS	SUNSCREEN
STF	SYNTHETIC TURF (W INDICATES TYPE)
TOW	TOP OF WALL
TGS	TACTILE GRND SURFACE INDICATORS
VP	VENT PIPE
WB	WALL BLOCKWORK
WC	TOILET
WCH	CERAMIC WALL TILING (W IND CATES TYPE)
WS	WHEEL STOP

REVISION		
ISS	DATE	COMMENT
	10/03/2016	ISSUED FOR TENDER

ARCHITECTURAL
GOVERNMENT ARCHITECT'S OFFICE
T 9372 5463

LANDSCAPE
RYKRELL STUDIO
T 0410 928 526

MECHANICAL
GOVERNMENT ARCHITECT'S OFFICE
T 9372 8101

ELECTRICAL
GOVERNMENT ARCHITECT'S OFFICE
T 9372 8032

QUANTITY SURVEYOR
GOVERNMENT ARCHITECT'S OFFICE
T 9372 8382

STRUCTURAL
GOVERNMENT ARCHITECT'S OFFICE
T 9372 8227

BUILDING CODE CONSULTANT
METRO BUILDING CONSULTANCY
T 9652 6477 F 8209 4505

HYDRAULIC
GOVERNMENT ARCHITECT'S OFFICE
T 9372 8147

LIFT
GOVERNMENT ARCHITECT'S OFFICE
T 9372 8103

FIRE ENGINEER
CL STEIN FIRE & RISK
T 9372 8296 F 9372 8173

PROJECT MANANGEMENT
NSW PUBLIC WORKS
T 9852 6143

NSW GOVERNMENT
Public Works
Government Architect's Office

BRUCE PETTMAN
Assistant Government Architect
Nominated Architect ARN 7223
Level 15 McKell Building, 2-24 Rawson Place
Sydney NSW 2000 AUSTRALIA

A division of the Department of Finance, Services and Innovation
MARTIN HOFFMAN
Secretary

NSW GOVERNMENT Education

ARTARMON PUBLIC SCHOOL NEW FACILITIES PROJECT

BLOCKS S + T ROOF AND CLERESTORY PLANS

PLAN RM NO	
SCALES	1:100 @ A1
DESIGNED	GAO
PLOT DATE	29/04/2016
DRAFTED	GAO
VERIFIED	GAO
CONTRACT NUMBER	1500654
SHEET NO	~~A212~~
REVISION	

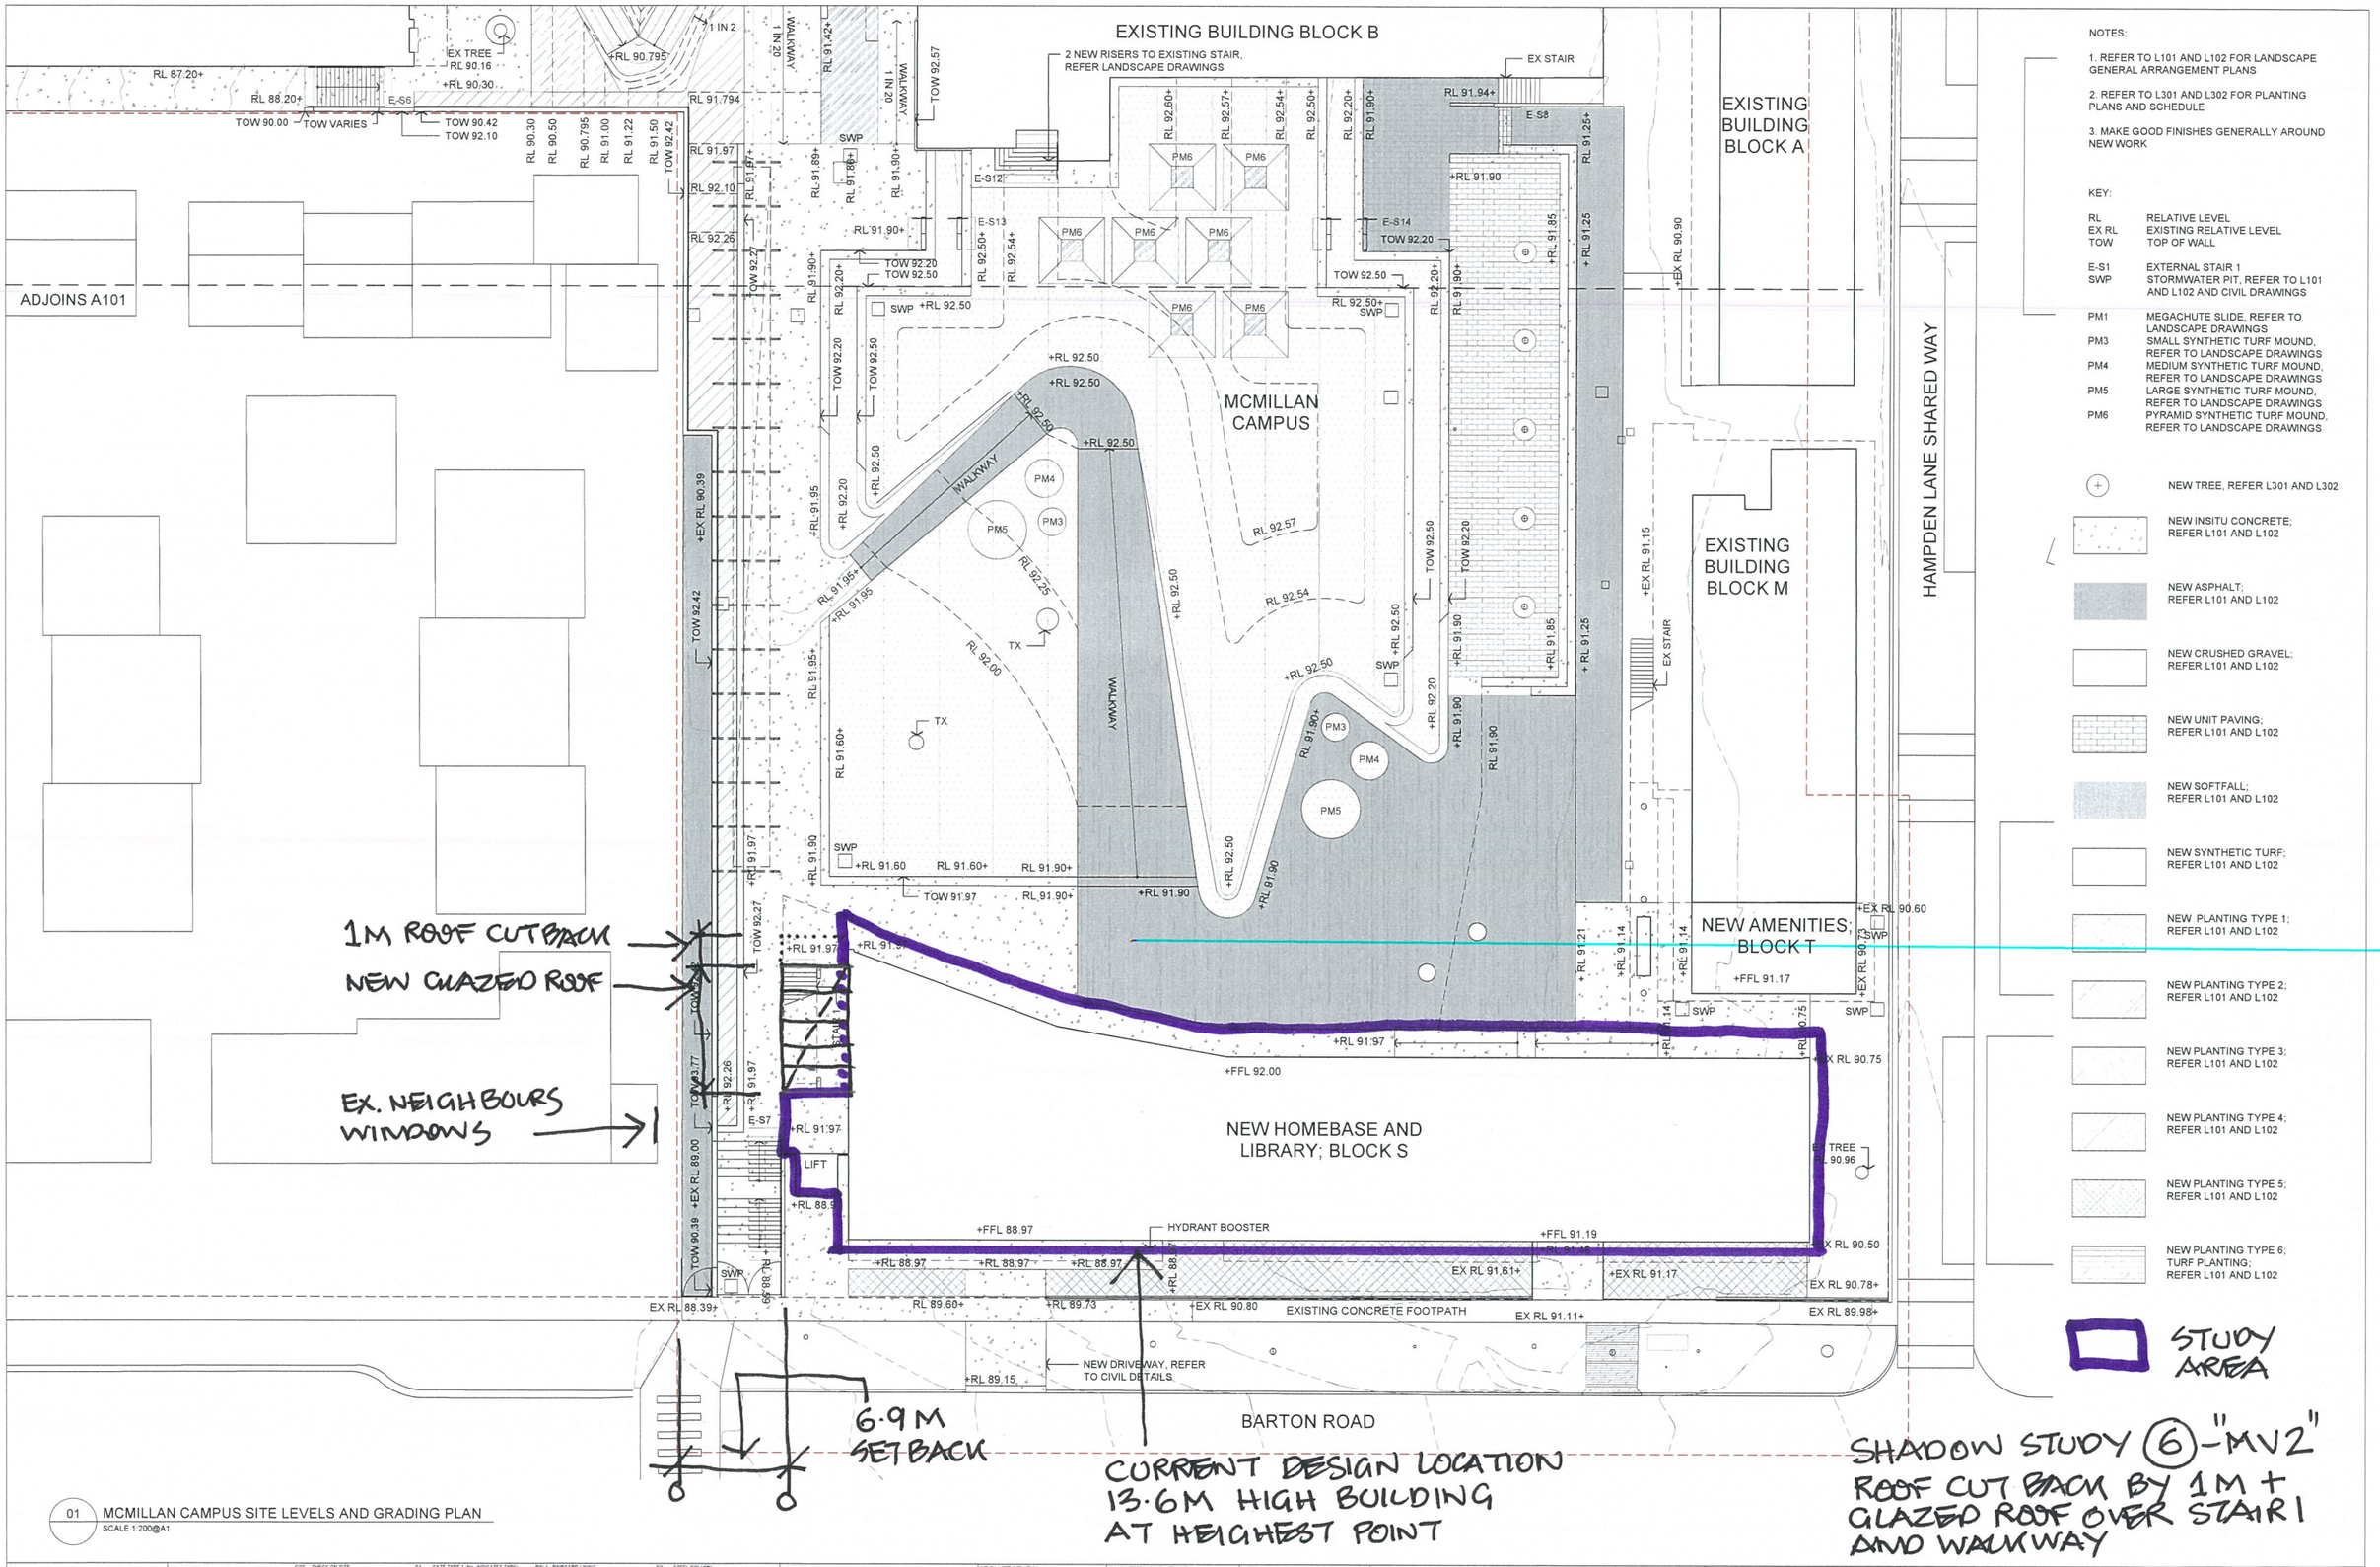

01 MCMILLAN CAMPUS SITE LEVELS AND GRADING PLAN
SCALE 1:200@A1

LEGEND
REFER TO COLOUR & FINISHES SCHEDULE FOR DETAIL OF TYPES & COLOURS

ACC1	ASPHALTIC CONCRETE COLOUR (/ni INDICATES COLOUR)
AL-1	ALUM LOUVRE (/ni INDICATES TYPE)
AW	AWNING WINDOW
AWC	ACCESSIBLE WC
B	BOLLARD
BAL	BALUSTRADE
BU	BUILDING DOTTED UNDER
CHG	CIRCULAR HOLLOW SECTION
CDLA	COVERED OUTDOOR LEARNING AREA
CON	CONCRETE
CON-C	CONCRETE - COVED
CON-H	CONCRETE - HONED
CON-G	CONCRETE - GRANOLITHIC TOPPING
CON-S	CONCRETE - STEEL TROWELED
COS	CHECK ON SITE
CPT	CARPET TYPE 1 (/ni INDICATES TYPE)
DPL	DOOR PANEL LIFT
DSC	DOOR SOLID CORE
DSG	DOOR SLIDING GLAZED
EDB	ELECTRICAL DISTRIBUTION BOARD
E.P.1	EXTERNAL PAINT COLOUR 1 (/ni INDICATES COLOUR)
EQ	EQUAL
EX	EXISTING
FB-1	FACE BRICK (/ni INDICATES TYPE)
FC-1	FIBRE CEMENT CLADDING SOFFIT (/ni INDICATES COLOUR)
FCT	FLOOR CERAMIC TILES
FEN1	FENCE (/ni INDICATES TYPE)
FFL	FINISHED FLOOR LEVEL
FG	FIXED GLAZING
FL	FLUORESCENT
FP	FLAG POLE
FW	FLOOR WASTE
G1	GATE TYPE 1 (/ni INDICATES TYPE)
GL	GROUNDLINE
GL1	EXISTING GROUND LINE
HR	HANDRAIL GENERALLY
I-P1	INTERNAL PAINT COLOUR 1 (/ni INDICATES COLOUR)
KF	KERB FLUSH
KG	KERB GUTTER
KR	KERB ROLLOVER
LAM	LAMINATE (/ni INDICATES COLOUR)
LGA	LOUVRE GLASS ADJUSTABLE
LMF	LOUVRES METAL FIXED
MSB	MAIN SWITCH BOARD
MSC-1	METAL SCREEN (/ni INDICATES TYPE)
MSH-1	MESH CURTAIN (/ni INDICATES TYPE)
MVE	MECHANICAL VENT EXHAUST COWL
NG	NOT TO GRADE
OFC	OFF FORM CONC
PB	PLASTERBOARD
PIN-1	PINBOARD LINING (/ni INDICATES COLOUR & TYPE)
PV1	PAVING TYPE 1 (/ni INDICATES TYPE)
PC-1	POWDER COATED STEEL (/ni INDICATES TYPE)
RBC	BARGE CAPPING
RFS	FASCIA GENERALLY
RF-1	RESILIENT FLOORING (/ni INDICATES TYPE & COLOUR)
RHS	RECTANGULAR HOLLOW SECTION
RL	RELATIVE LEVEL
RO	ROOF OVER
RRC	ROOF RIDGE CAPPINGS
RS1	ROOF SHEETING (/ni INDICATES TYPE)
RSF	ROOF FLASHING
RW	RETAINING WALL
RWG	RAINWATER GUTTER
RWP	RAINWATER DOWNPIPE TO 3.6m
RWP1	RAINWATER DOWNPIPE ABOVE 3.6m
RWT	RAINWATER TANK
SC	STEEL COLUMN
SKT	SKIRTINGS
SPR	SPREADER
STP-1	SYNTHETIC TURF (/ni INDICATES TYPE)
TOW	TOP OF WALL
TSD	TACTILE GRND SURFACE INDICATORS
VP	VENT PIPE
WBL	WALL BLOCKWORK
WC	TOILET
WC1	CERAMIC WALL TILING (/ni INDICATES TYPE)
WS	WHEEL STOP

REVISION		
ISS	DATE	COMMENT
		DRAFT FOR COORDINATION

ARCHITECTURAL — GOVERNMENT ARCHITECT'S OFFICE — T 9372 8463
LANDSCAPE — TYRRELL STUDIO — T 0410 926 926
MECHANICAL — GOVERNMENT ARCHITECT'S OFFICE — T 9372 8191
ELECTRICAL — GOVERNMENT ARCHITECT'S OFFICE — T 9372 8232
QUANTITY SURVEYOR — GOVERNMENT ARCHITECT'S OFFICE — T 9372 8382
STRUCTURAL — GOVERNMENT ARCHITECT'S OFFICE — T 9372 8227
BUILDING CODE CONSULTANT — METRO BUILDING CONSULTANCY — T 9682 8477 F 9209 4950
HYDRAULIC — GOVERNMENT ARCHITECT'S OFFICE — T 9372 8147
LIFT — GOVERNMENT ARCHITECT'S OFFICE — T 9372 8163
FIRE ENGINEER — OLSSON FIRE & RISK — T 9372 9266 F 9372 8133
PROJECT MANANGEMENT — NSW PUBLIC WORKS — T 9852 6143

NSW GOVERNMENT — Public Works Government Architect's Office
BRUCE PETTMAN
Assistant Government Architect
Nominated Architect ARN 7228
Level 19 McKell Building, 2-24 Rawson Place
Sydney NSW 2000 AUSTRALIA
A division of the Department of Finance, Services and Innovation
MARTIN HOFFMAN
Secretary

NSW GOVERNMENT Education

ARTARMON PUBLIC SCHOOL NEW FACILITIES PROJECT
SITE LEVELS & GRADING PLAN (1)
MCMILLAN CAMPUS

PLAN RM NO	
CONTRACT NUMBER	1500654
SCALES	1:200 @ A1
SHEET NO	~~A100~~
DESIGNED	TYRRELL
PLOT DATE	07.04.2016
DRAFTED	TYRRELL
VERIFIED	TYRRELL
REVISION	

A1 0 10 20 30 40 50 60 70 80 90 100
USE FIGURED DIMENSIONS IN PREFERENCE TO SCALING
CHECK ALL DIMENSIONS ON SITE
200MM
300MM ON ORIGINAL

© CROWN IN RIGHT OF NSW THROUGH THE DEPARTMENT OF FINANCE, SERVICES AND INNOVATION

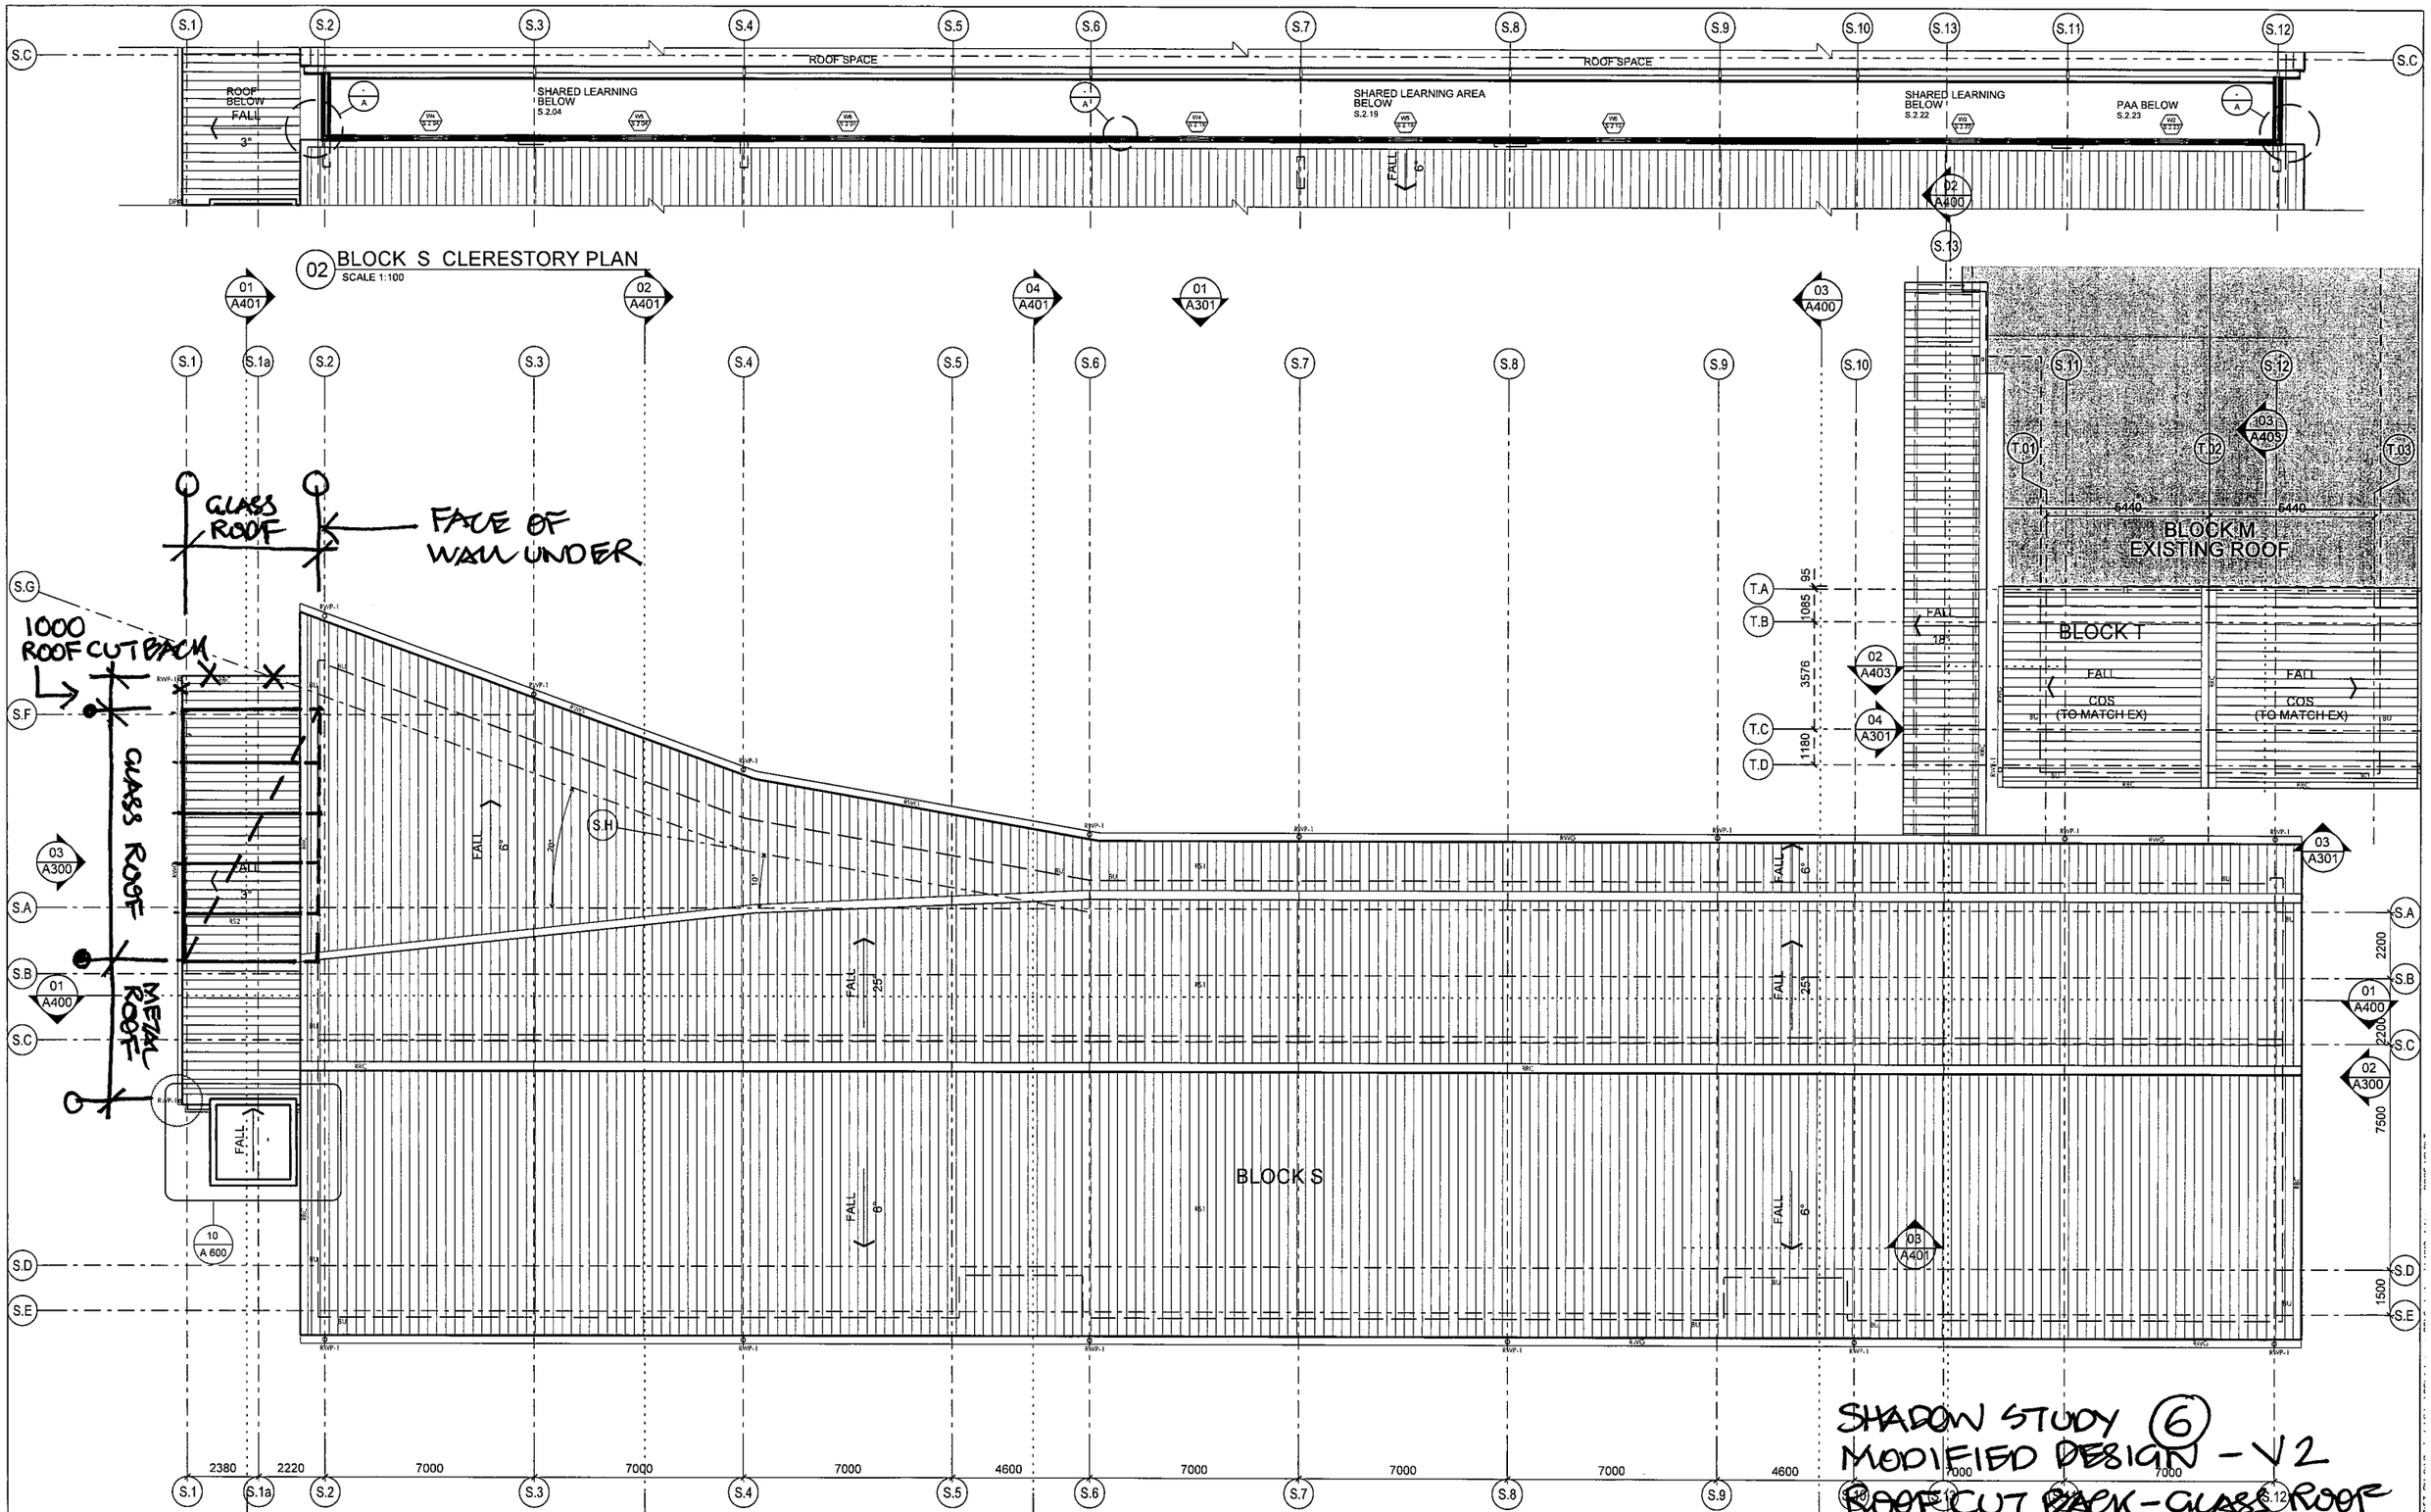

SHADOW STUDY (6)
MODIFIED DESIGN - V2
ROOF CUT BACK - GLASS ROOF OVER STAIR + WALKWAY

1 The Government Architect's Office, a division of the Department of Finance & Services (the Department) shall not be liable or responsible for any loss or damage arising out of the conversion of any electronic document, data or program to any other format or medium, or arising out of any modification or changes that occur in the handling or use of the electronic document, data or program.

2 The recipient or user of any electronic document, data or program is solely responsible for ascertaining its accuracy and its suitability for their purposes.

3 The Document uses a virus scanning software to prevent file and system virus attacks but gives no warranty. The recipient or user is solely responsible for their own virus protection.

LEGEND

REFER TO COLOUR & FINISHES SCHEDULE FOR DETAIL OF TYPES & COLOURS.

ACC1	ASPHALTIC CONCRETE COLOUR (/# INDICATES COLOUR)
AL-1	ALUM LOUVRE (/# INDICATES "TYPE)
AW	AWNING WINDOW
AWC	ACCESSIBLE WC
B	BOLLARD
BAL1	BALUSTRADE (/# INDICATES "TYPE)
BU	BUILDING OUTLINE UNDER
CB	CONCRETE BLOCK
CB-R	CONCRETE BLOCK - REINSERED
CHS	CIRCULAR HOLLOW SECTION
COLA	COVERED OUTDOOR LEARNING AREA
CON	CONCRETE
CON-C	CONCRETE - COVED
CON-H	CONCRETE - HONED
CON-G	CONCRETE - GRANOLITHIC TOPPING
CON-S	CONCRETE-STEEL "ROWLED)
COS	CHECK ON SITE
CPT-1	CARPET TYPE 1 (/# INDICATES TYPE)
DPL	DOOR PANEL LIFT
DSC	DOOR SOLID CORE
DSG	DOOR SLIDING GLAZED
EDB	ELECTRICAL DISTRIBUTION BOARD
E-1	EXTERNAL PAINT COLOUR 1 (/# INDICATES COLOUR)
EQ	EQUAL
EX	EXISTING
FB-1	FACE BRICK (/# INDICATES TYPE)
FC-1	FIBRE CEMENT CLADDING SOFFIT (No /#ND CATES COLOUR)
FCT	FLOOR CERAMIC TILES
FEN	FENCE (/# IN DICATES TYPE)
FFL	FINISHED FLOOR LEVEL
FG	FIXED GLAZING
FL	FLASHING
FP	FLAG POLE
FW	FLOOR WASTE
G1	GATE TYPE 1 (/# IN DICATES TYPE)
GD	GRATED DRAIN
GL	GROUNDLINE
GLX	EXISTING GROUND LINE
HH	HYDROMIC HEATER PANEL
HR	HANDRAIL GENERALLY
HP1	INTERNAL PAINT COLOUR 1 (/# INDICATES COLOUR)
KG	KERB GUTTER
KR	KERB ROLLOVER
LAM	LAMINATE (/# INDICATES COLOUR)
LGA	LOUVRE GLASS ADJUSTABLE
LWF	LOUVRE METAL FIXED
MSB	MAIN SWITCH BOARD
MSC-1	METAL SCREEN (/# INDICATES TYPE)
MSN-1	MESH CURTAIN (/# IND CATES TYPE)
MVT	MECHANICAL VENT EXHAUST COWL
NTS	NOT TO SCALE
OFC	OFF FORM CONCRETE
PB	PLASTERBOARD
PNW-1	PINBOARD LINING (/# INDICATES COLOUR & TYPE)
PV-1	PAVING TYPE 1 (No. INDICATES "TYPE)
PC-1	POWDER COATED STEEL (/# INDICATES TYPE)
RBC	RUBBER CAPPING
RFS	FASCIA GENERALLY
RF-1	RESILIENT FLOORING (/# INDICATES TYPE & COLOUR)
RHS	RECTANGULAR HOLLOW SECTION
RL	RELATIVE LEVEL
RO	ROOF OVER
RRC	ROOF R OOS CAPPINGS
RS1	ROOF SH EETING (/# INDICATES TYPE)
RSF	ROOF FLASHING
RV	ROOF VENT
RW	RETAINING WALL
RWG	RAINWATER GUTTER
RWP	RAINWATER DOWNPIPE - DHS
RWP-1	RAINWATER DOWNPIPE - ZACALUVE
RWT	RAINWATER TANK
SC	STEEL COLUMN
SKT	SKIRTINGS
SPR	SPREADER
SS	SUNSCREEN
STP	SYNTHETIC TURF (/# INDICATES TYPE)
TOW	TOP OF WALL
TCB	TILE GRND SURFACE INDICATORS
VP	VENT PIPE
WBL	WALL BLOCKWORK
WC	TOILET
WCT-1	CERAMIC WALL TILING (/# IND CATES TYPE)
WS	WHEEL STOP

REVISION		
ISS	DATE	COMMENT
	10/05/2016	ISSUED FOR TENDER

ARCHITECTURAL
GOVERNMENT ARCHITECT'S OFFICE
T 9372 8463

LANDSCAPE
TYRRELL STUDIO
T 04 10 928 926

MECHANICAL
GOVERNMENT ARCHITECT'S OFFICE
T 9372 8101

ELECTRICAL
GOVERNMENT ARCHITECT'S OFFICE
T 9372 8232

QUANTITY SURVEYOR
GOVERNMENT ARCHITECT'S OFFICE
T 9372 8362

STRUCTURAL
GOVERNMENT ARCHITECT'S OFFICE
T 9372 8227

BUILDING CODE CONSULTANT
METRO BUILDING CONSULTANCY
T 9692 8477 F 9299 4955

HYDRAULIC
GOVERNMENT ARCHITECT'S OFFICE
T 9372 8147

LIFT
GOVERNMENT ARCHITECT'S OFFICE
T 9372 8103

FIRE ENGINEER
OLSSON FIRE & RISK
T 9372 8296 F 9372 8133

PROJECT MANANGEMENT
NSW PUBLIC WORKS
T 9852 6143

NSW GOVERNMENT
Public Works
Government Architect's Office
BRUCE PETTMAN
Assistant Government Architect
Nominated Architect: ARN 7228
Level 19 McKell Building, 2-24 Rawson Place
Sydney NSW 2000 AUSTRALIA
A division of the Department of Finance, Services and Innovation
MARTIN HOFFMAN
Secretary

NSW GOVERNMENT Education

ARTARMON PUBLIC SCHOOL NEW FACILITIES PROJECT

BLOCKS S + T ROOF AND CLERESTORY PLANS

PLAN REF NO	
SCALES	1:100 @ A1
DESIGNED	GAO
PLOT DATE	29/04/2016
DRAFTED	GAO
VERIFIED	GAO
CONTRACT NUMBER	1500654
SHEET NO	~~A212~~
REVISION	

A1 FIGURED DIMENSIONS SCALE