


8371

PROPOSED MIXED-USE DEVELOPMENT


12 - 14 NORTHUMBERLAND ROAD
AUBURN, NSW 2144

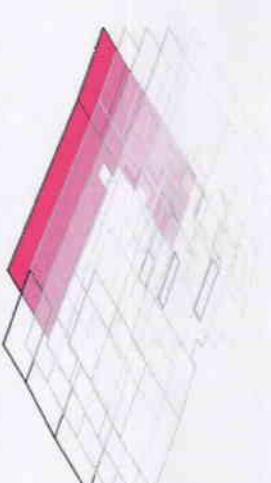



KEYPLAN B6

ISSUE
B

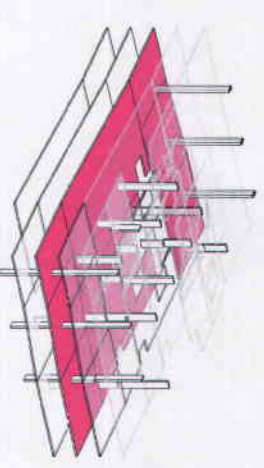

KEYPLAN B4

100

 **DIAL BEFORE
YOU DIG**
HAVE A TOOL, GET IT ALL

SHEET TITLE
BASEMENT 4

zhinar


ARCHITECTS

ZHINAR ARCHITECTS


ARN 28 462 964 78


ISSUE: **B**

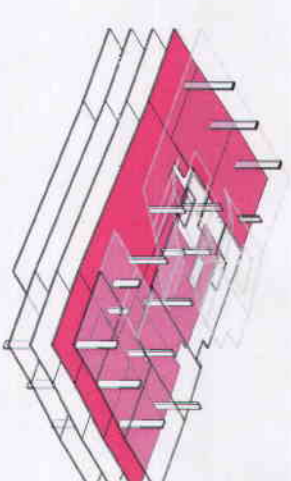

KEYPLAN B3


**PROPOSED MIXED-USE
DEVELOPMENT**
12 - 14 NORTHUMBERLAND ROAD
AUBURN, NSW 2144
JOB No. **8371** DRAWING No. **DA 06**

ISSUE
B

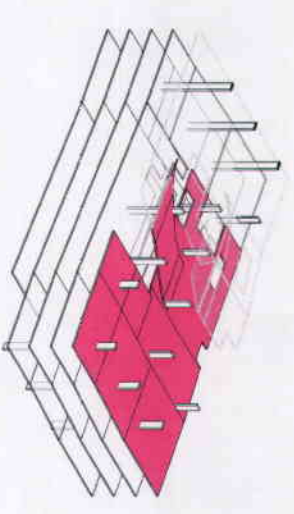

B2
1 : 100 @ A1 sheet
1 : 200 @ A3 sheet

ISSUE: **B**

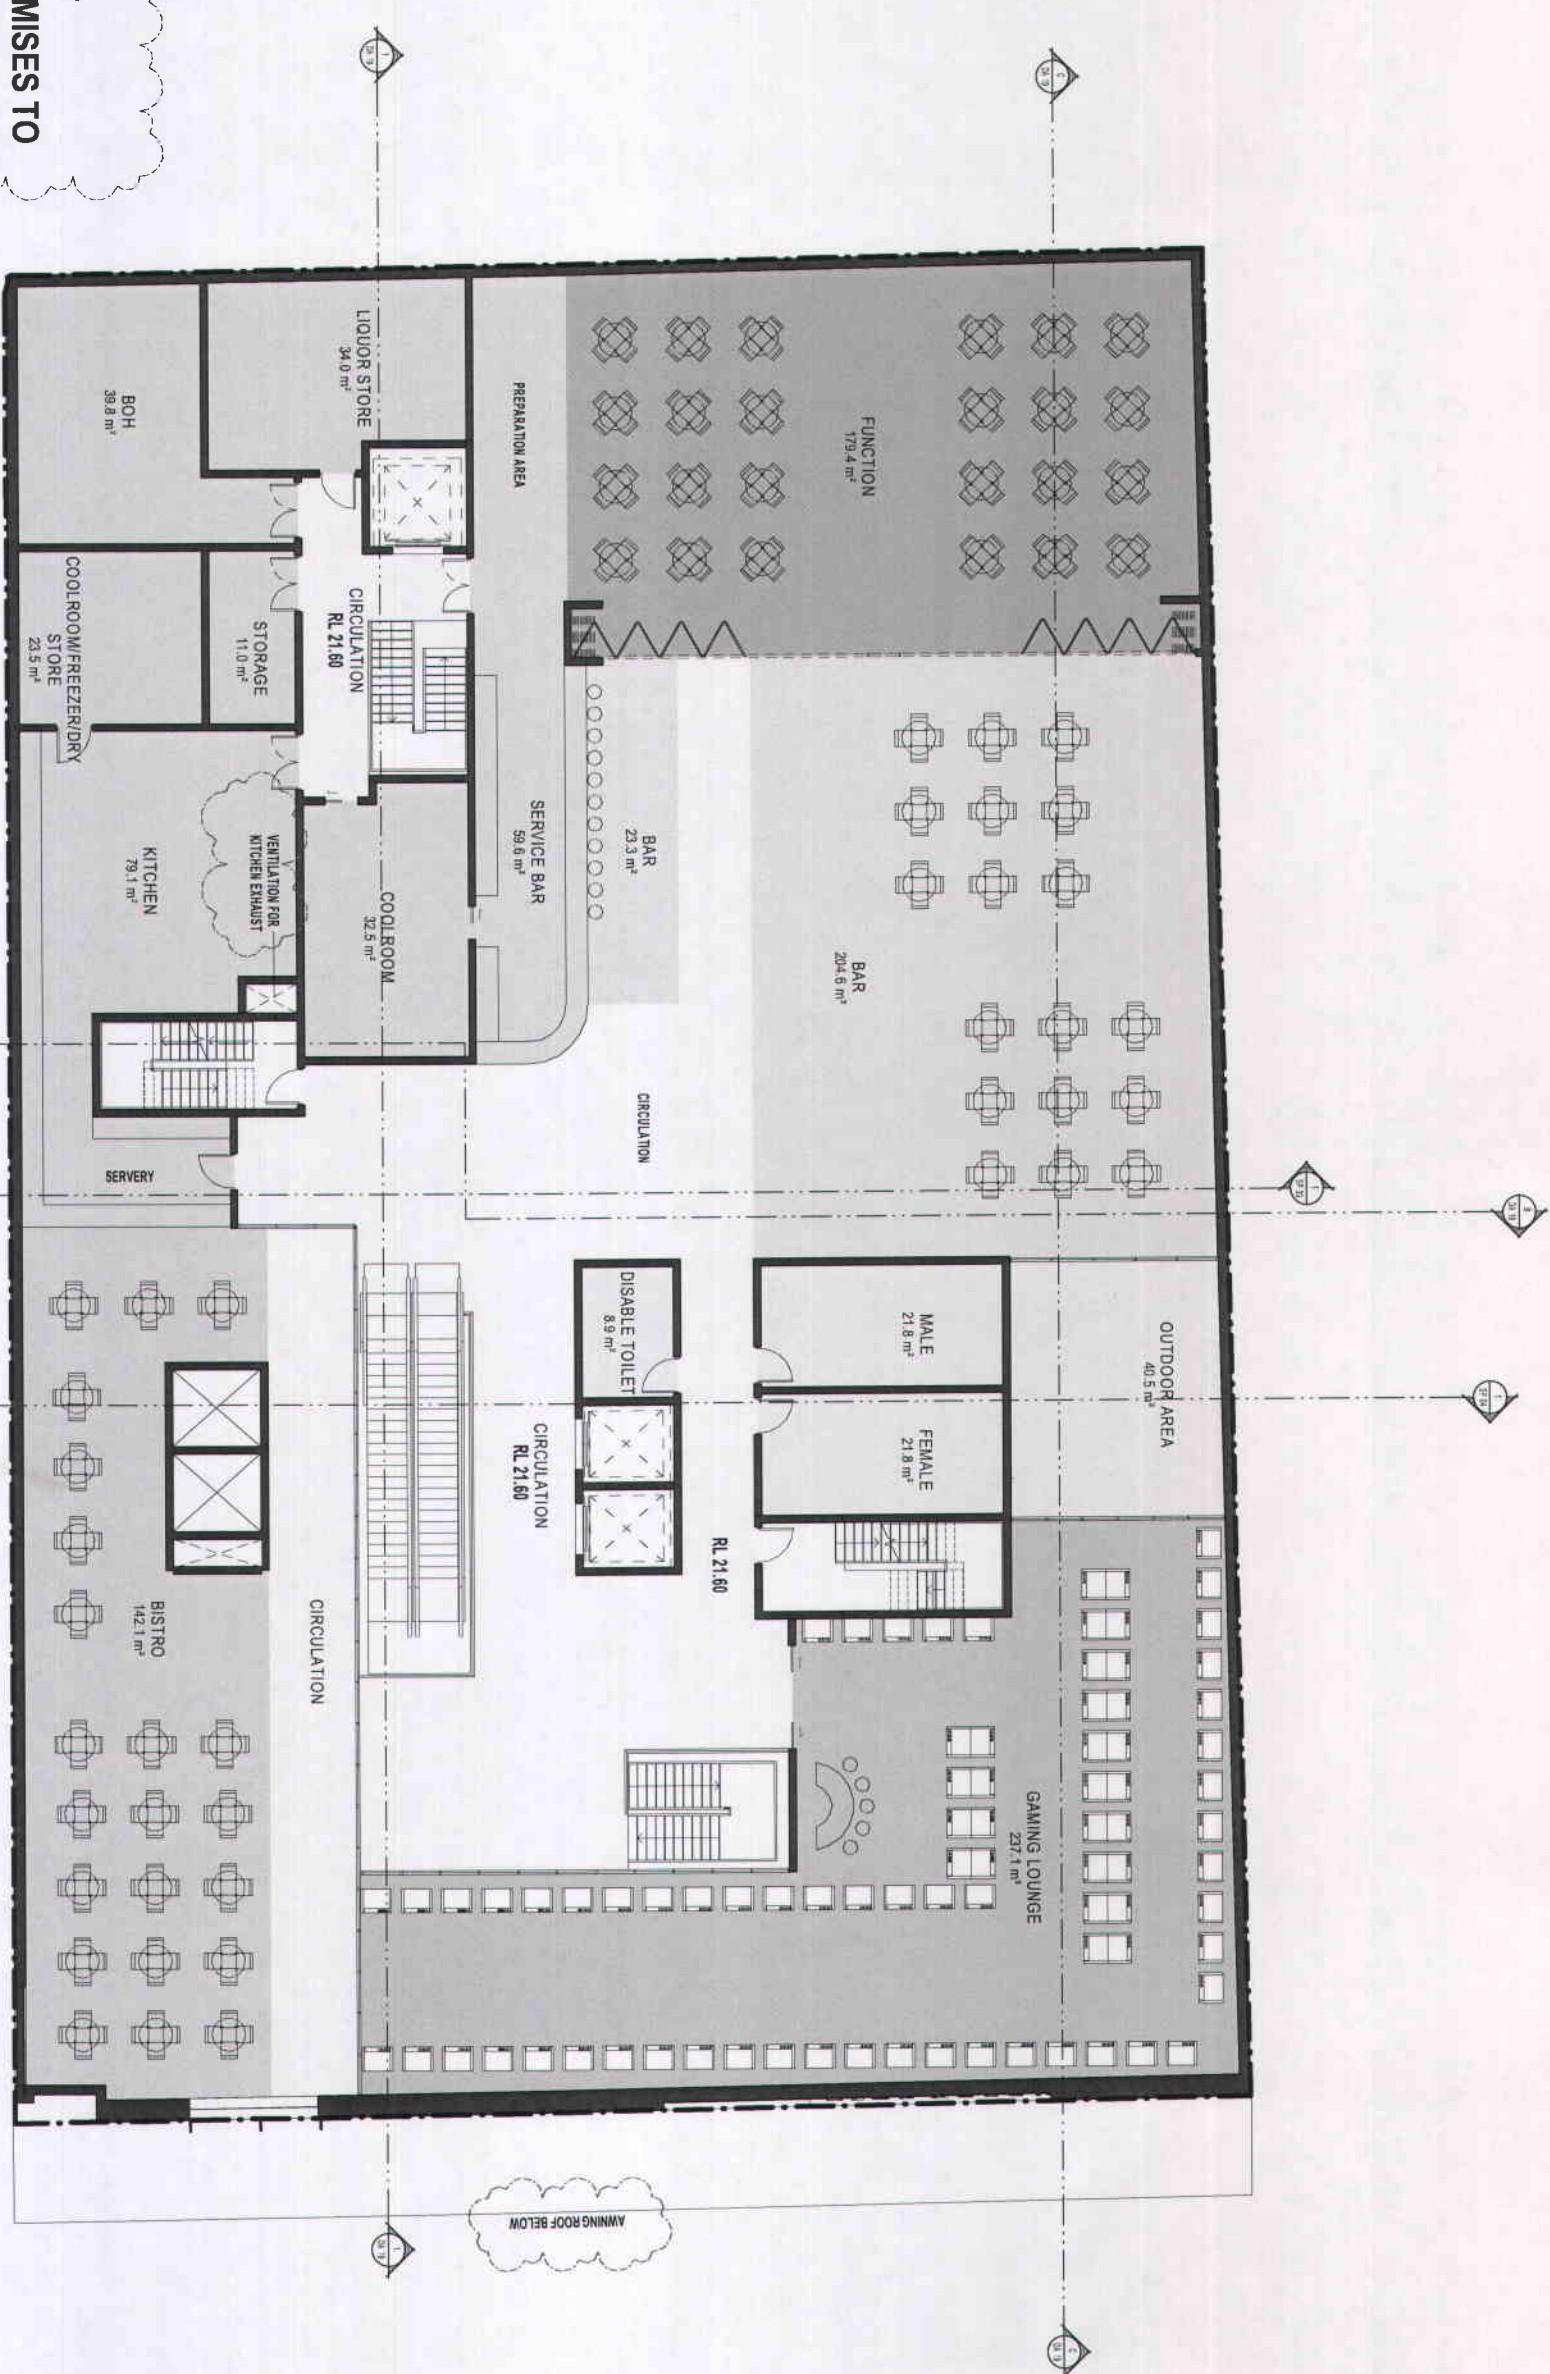

NOTE:
IN OCCUPANCY OF
COMMERCIAL PREMISES TO
BE SUBMITTED SEPARATE DA

L1
1 : 100 @ A1 sheet
1 : 200 @ A3 sheet

REVISION	DATE	BY	CHKD	DESCRIPTION
1	20/11/2015	JA	CWL	ISSUED FOR DA
2	20/11/2015	JA	CWL	ISSUED FOR DA







THE NORTH

Development Application


SHEET TITLE	LEVEL 1
DESIGNED	JA/VV/CW
CHECKED	JA/VV/CW
SCALE	1 : 100
DATE	20/11/2015
PROJECT	AUBURN COUNCIL

zhinar
ZHINAR ARCHITECTS
20/11/2015
12-14 NORTHUMBERLAND ROAD
AUBURN, NSW 2144
8371

PROPOSED MIXED-USE
DEVELOPMENT
12-14 NORTHUMBERLAND ROAD
AUBURN, NSW 2144
8371
DA 10
C

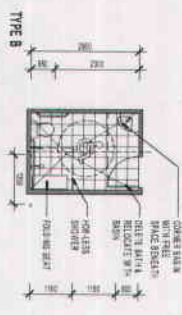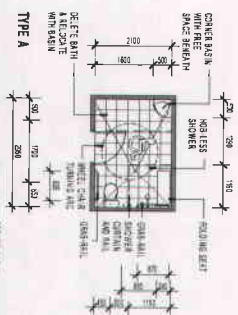

ALL FITTINGS AND INSTALLATION TO COMPLY AS 4-28;
 (INCLUDING ALL FITTINGS AND SHOWN I.E. G. ROLLER ROLL HOLDING)
 FLOOR GRADE TO 30" FOR AUTO DRAINAGE - CLAUSE 4-2
 DIMENSIONS SHOWN TO FINISHED SURFACE
 IN UNFINISHED BATHROOMS WHERE TYPING TEMPLATES CAN BE
 ACHIEVED AND COMPLIANCE WITH FINISHED BATHS NEED NOT BE
 DETECTED ONLY BATHS SUSPECTED

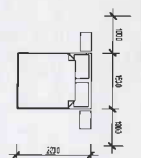


STANDARD AUSTRALIAN QUEEN SIZE BED - 1 570 x 2 020
MINIMUM SIDE CLEARANCE - 100mm

LEGEND

HL: HIGHLIGHT WINDOW
PAR: PARAPET WALLS
BAL: BLAUSTRADE

**NOTE:
SOLAR POWERED LIGHTINGS
WILL BE PROVIDED AT ALL
COMMON OPEN SPACES**

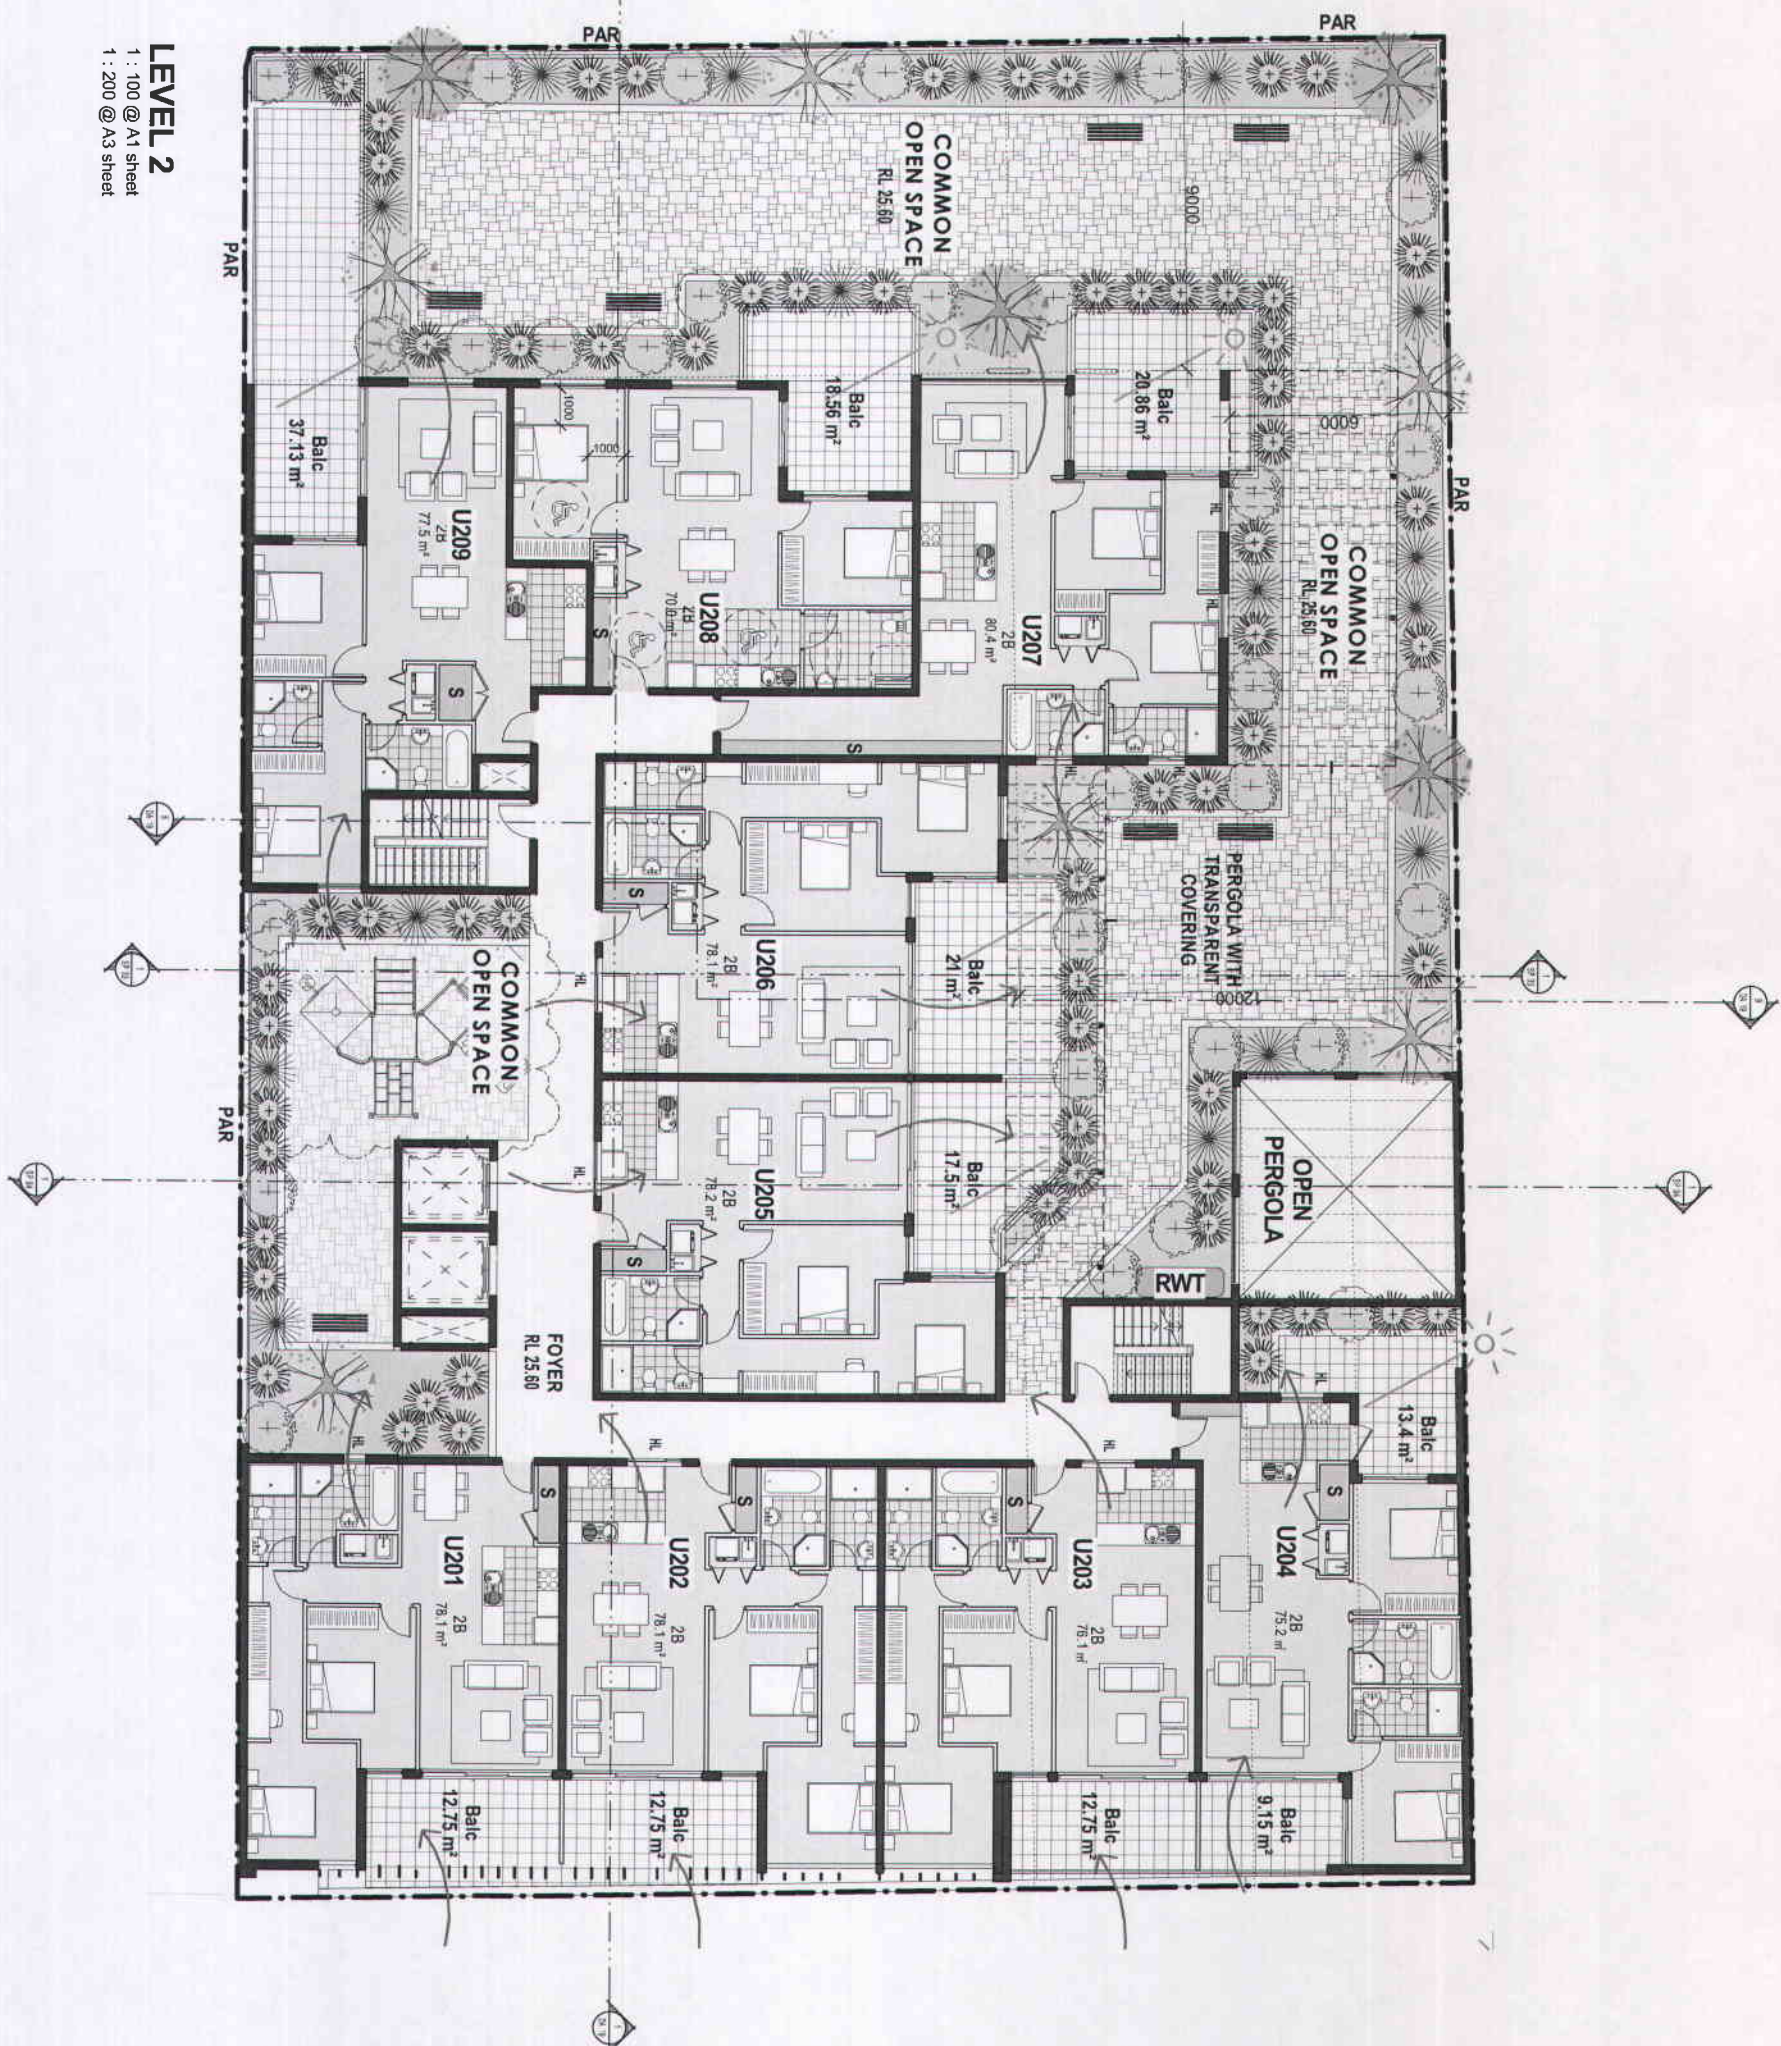

LEVEL 2
1 : 100 @ A1 sheet
1 : 200 @ A3 sheet

[illegible][illegible]

PROJECT STATUS

Development Application

SHEET TITLE
LEVEL 2

DESIGNED	DRAWN	COMMENCED
NS	JA, W, CW	

USA AUBURN COUNCIL


SCALE 1 : 100
PRINT: A1 SHEET




**PROPOSED MIXED-USE
DEVELOPMENT**
12 - 14 NORTHUMBERLAND ROAD
AUBURN, NSW 2144

JOB NO. **8371** DRAWING NO. **DA 11**

ISSUE C

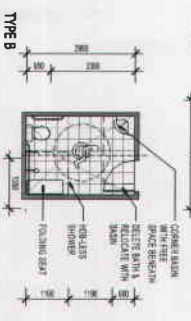

NOTE
STANDARD AUSTRALIAN QUEEN SIZE BED - 1500 x 2000
MINIMUM SIDE CLEARANCE = 100mm

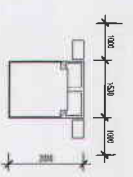

1




1: 100 @ A1 sheet
1: 200 @ A3 sheet



A diagram of a circle with a red line segment inside. The line segment is labeled 'N' at its right end, which is on the circle's circumference. The line segment is oriented diagonally from the bottom-left towards the top-right.

DESIGNED	DRAWN	COMMENCED	SCALE	PRINT
NS	JA,VV,CW		1:100	A1 SHEET
LGA AUBURN COUNCIL				

B SUE

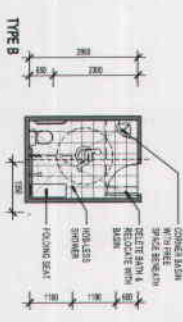

NOTE:
STANDARD AUSTRALIAN QUEEN SIZE BED - 1500 x 2000mm
MINIMUM SIDE CLEARANCE - 70mm



1: 100 @ A1 sheet
1: 200 @ A3 sheet

**DIAL BEFORE
YOU DIG**

SHEET TITLE:
TYPICAL PLAN

zhin ar

ARCHITECTS

SUITE 1 LEVEL 2 / 7 FLOOR STREET EASTWOOD 2122
TEL: (02) 8939 4888 FAX: (02) 8932 6152 WEB: WWW.ZHINAR.COM.AU

A/NR 28 48 661 78

ISSUE
B