# UNITING NAREEN GARDENS

# SEPTEMBER 2022



LOCATION MAP




Name	Drawing Number	Revision
Cover Sheet	L000	JJ
Design Report	L001	DD
Tree Management Plan	L002	НН
Existing Tree Schedule 1 of 2	L003	CC
Existing Tree Schedule 2 of 2	L004	CC
Proposed Tree Plan	L005	НН
Landscape Design Principles	L006	GG
Landscape Masterplan	L101	НН
Detailed Landscape Plan 1 of 3	L102	FF
Detailed Landscape Plan 2 of 3	L103	EE
Detailed Landscape Plan 3 of 3	L104	FF
RACF Level 1 Podium Landscape Plan	L105	CC
Landscape Sections 1 of 2	L111	CC
Landscape Sections 2 of 2	L112	CC
Precedent Images	L113	CC
Plant Schedule - General	L114	EE
Village Green Concept Plan	L115	DD
Screen/Buffer Planting Plan 1 of 3	L201	DD
Screen/Buffer Planting Plan 2 of 3	L202	EE
Screen/Buffer Planting Plan 3 of 3	L203	EE
Plant Schedule - Sceen/Buffer	L204	CC

**Council Guidelines** 

Central Coast Council (Formerly Gosford Council)

- Central Coast Council (Gosford) LEP 2014
- Central Coast Council (Gosford) DCP 2013
- SEPP Apartment Design Guide Deep Soil Zones & Planting on Structure
- SEPP Seniors Living
- Uniting Design Guide Part 1.3; General Site Planning & Design Principles



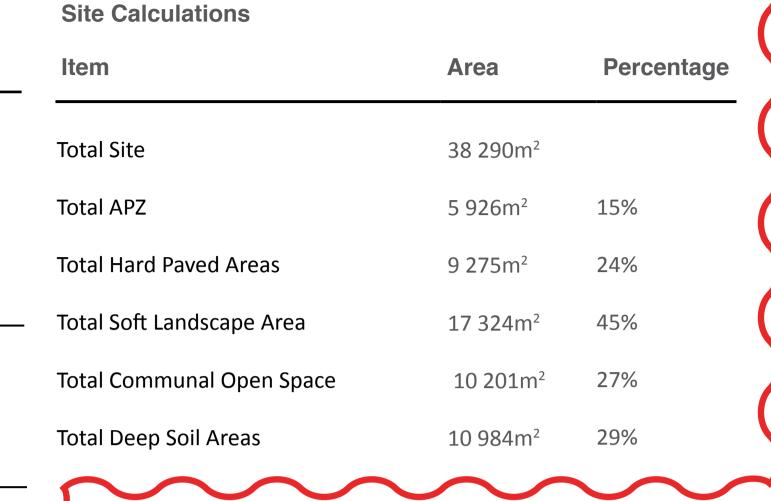



#### **EXISTING SITE CONDITIONS**

The existing site has a relative flat topography and a fall of approximately 5.54m. longitudinal fall (gradient 1:70) from the high point (SE corner) of the site subject site to the low point (NW) corner of the site. At its extreme, the cross fall of the existing site is 4.5m (gradient 1:50) from the eastern boundary to the west boundary.

The existing site consists of 114 single-storey brick & tile roof villas and a number of outbuildings such as garages and maintenance sheds which will all eventually be demolished as part of this redevelopment.

There is extensive mature vegetation located along the western boundary with this vegetation being retained, protected and managed as part of the Asset Protection Zone (APZ). The eastern boundary has extensive vegetation consisting of mature specimen trees with as many of these trees being retained & protected to assist in reducing the bulk & scale of this development.

Please refer to the Existing Tree Management Plan (Drawing L001) and the arboriculture tree assessment report for all trees being removed, retained & protected as part of this development.

There are a number of existing underground services such as water & sewer and other infrastructure includes the existing sewer and water easements running through the existing site. These easements are to be retained and have been considered in the landscape design of the proposed development.

# **BUSHFIRE HAZARD REDUCTION & ASSET PROTECTION** ZONE LANDSCAPE DESIGN

In accordance with the Bushfire Assessment Report prepared for the development (Peterson Bushfire, 20 May 2021), the vegetation and landscaping across the entire site is to be managed to satisfy the performance of an Inner Protection Area (IPA) standard as described within Section A4.1.1 of the document 'Planning for Bush Fire Protection 2019'. The landscape design has adopted the IPA principles and presents a strategy specific to the site and proposal that is commensurate with the bushfire

IPA parameters integrated within the landscape design include:

- Tree canopies to have adequate spacing to prevent the spread of fire form the bushfire hazard directly to the buildings,
- Tree canopies not overhanging or touching buildings:
- Trees to have lower limbs removed up to a height of 2.0 metres above the ground
- Areas of shrubs to be minimal in nature, be separated from buildings, and within garden beds that are discontinuous to prevent the spread of fire between the hazard and buildings.
- Landscape screening using shrubs and trees to only be parallel to the buildings,
- narrow in form and adequately separated from buildings on and off site. No proposed planting of shrubs, trees or other vegetation shall occur in such a
- manner as to compromise the integrity of the Asset Protection Zone, and No wood chip mulch to be used in garden beds and to promote use of in-organic (crushed gravel) mulch in garden beds within the direct vicinity of any proposed dwellings or buildings.

Whilst no plant is inflammable, the use of fire-retardant species will be included in the landscape design for this particular project.

It is also important to note that a high level of routine landscape maintenance is required to ensure these defendable spaces are not compromised. Some of the landscape maintenance required for bush fire hazard reduction is as follows:

- All shrubs must be trimmed and maintained. Shrubs should be retained as clumps or islands and should maintain a covering of no more than 20% of the area.
- Ground fuels such as fallen leaves, twigs (less than 6mm in diameter) and branches should be removed on a regular basis,
- Lawn areas needs to be kept closely mown and where possible green, and No future planting of shrubs, trees or other vegetation shall occur in such a

as to compromise the integrity of the asset protection zone

manner

# COMMON OPEN SPACE AREAS – GROUND FLOOR LANDSCAPE PLAN

The proposed landscape design for this particular development will need to consider equitable access and safety for all residents. Circulation, connectivity and materials & finishes; particularly in the public domain and community open space areas of this development, have been considered and will include the following:

#### Circulation:

Establish a path hierarchy for main pedestrian access, egress and maintenance

Segregation of pedestrian paths from vehicular roads and driveways, Implementation of 1:14 ramps (with handrails) 1:20 ramps (no handrails) to AS1428.1 Access & Mobility, and

Main pedestrian circulation path widths to be a minimum 2000mm width to allow mobile & less mobile residents to easily pass each other.

- Provide a main pedestrian spine (tree-lined boulevard) to connect the residents of the ILUs, and the wider community to the ground floor community & commercial activity spaces of the RACF.
- Implementation of 'Loop' paths (where practical),
- No dead—end paths,
- Regular rest stops with bench seats (including arm rests), and
- · Implementation of intersection nodes where paths intersect and which may include way-finding signage, shade & amenity and seating.

#### Materials & Finishes:

- Pre-cast unit paving (on grade) not to be implemented on any paths, entry areas, common open space areas, and courtyards as can potentially cause trip hazards. Any pre-cast unit pavers to be installed on a reinforced concrete base slab for stability and pavers to be checked regularly for any up-lifting.
- Use of exposed aggregate concrete paving to assist in reducing slip hazards,
- Use of broom finished concrete paving to assist in reducing slip hazards, and
- Use of colour oxide concrete paving to assist in reducing concrete glare.

# COMMUNITY OPEN SPACE, COMMON TERRACES & PRIVATE **OPEN SPACE AREAS**

### Community Open Space Areas:

The open space areas for this development are intended for the neighbouring community as well as for the residents (and visitors) of Nareen Gardens. The community open spaces areas to include the some of the following:

- Village Green Passive & Active Recreation
- Alresco Areas BBQ, Shade structures & Table Bench Settings
- Community Gardens
- Pocket Parks
- Childrens Playground
- Circulation & Fitness Paths

# Common Terraces (Level 1 RACF Courtyards):

Level 1 of the RACF consist of external common courtyard areas for residents, staff and visitors.

Courtyard 1 in particular, is a high dementia courtyard which has a sensory garden palette using a variety of plant species to stimulate the senses in terms of aroma, texture, colour and to evoke memory. This planting palette as well as ful selection of materials and finishes to assist in reducing levels of stress and anxiety. Planning of good circulation spaces are to ensure a balance of equitable accessibility, a degree of privacy and good surveillance by staff.

The other common open space areas (courtyards 2,3 & 4) all take advantage of also providing a secure podium level courtyard space for both residents and visitors to the RACF.

The common terrace areas will include raised planters on structure and provide 'screen' planting between common courtyard areas and private rooms of the RACF. Raised planters will set out around the perimeter of the level 1 courtyard areas will assist in reducing structural load.

The raised planters will be planted with suitable shrub species and will include a minimum of 500mm-600mm light weight soil media to promote plant growth and in accordance with NSW Planning & Environment; Apartment Design Guide; Part 4P, Planting on Structures.

#### Ground Floor Common Open Space Areas (RACF):

External 'break-out' spaces located on the ground floor of the RACF are associated with the proposed function/meeting rooms, the Gymnasium, Café, Swimming Pool and Chapel. These external courtyard spaces are predominantly 'hard paved areas with 'soft' landscaping to create separate courtyard spaces for the various activities that are accessible via the main pedestrian spine (tree-lined boulevard).

These courtyard spaces to include external landscape feature lighting such as discrete bollard lights for paving & paths and up-lights for trees so even if these spaces are not for nocturnal use they are seen as a landscape feature and extension of the RACF at night.

#### LANDSCAPE PLANTING STRATEGY

The proposed planting strategy for this development will take into consideration the following:

- IPA requirements from "Planning for Bush Fire Protection 2019" and any specific RFS approval conditions,
- Quality Brand Recognition maintaining a high-quality aesthetic of landscape that is associated with Uniting Villages,
- Value management & upfront capital costs,
- Low ongoing landscape maintenance,
- Planting zones in terms of irrigation (if applicable) and watering requirements,
- Security of the residents by implementing Crime Prevention Through Environmental Design (CPTED) initiatives, and
- Safety of residents using suitable plant species to assist in bush fire hazard reduction (as mentioned).

#### Quality Brand Recognition & Value Management:

- Install larger pot sizes (min. 45L pot size) for trees to provide immediate impact,
- Install smaller pot sizes (140mm -200mm) for medium size shrubs & ground covers as these plants are expected to mature relatively quickly within a short period of time which will save on upfront capital costs,
- Plant species selection in accordance with proven and successful plant species used in other Uniting Villages,
- Proposed exotic & native species to encourage birdlife & bio-diversity,
- Selected plant species to provide colour, form and texture,
- Use of deciduous trees to provide solar access and for seasonal change, Use of evergreen trees for shade, amenity and to assist in reducing the 'heat
- island' affect particularly in hard-paved and car park areas, Layering of plant species within gardens beds to implement low border planting
- near garden bed edge with low medium shrubs behind at larger shrubs and small
- Use of large screen shrubs to provide privacy between dwellings and to assist in screening fences and masonry retaining walls,
- Early plant procurement to ensure plants are ordered early within the contract and that the correct size plant stock is available at time of installation.
- Retain existing Trees where practical within a bush fire prone area.

### Presentation & Ongoing Landscape Maintenance:

- Greater densities & closer spacing's for groundcovers as to assist in reducing weed
- Use of shade tolerant, hard-wearing turf species with a low mowing frequency,
- Implementation of proven plant species that are easy to maintain and not prone to diseases or failure, and
- Good management of construction works to ensure that plant material is not installed too early and damaged by other trades.

### Watering of Planting Initiatives:

With this proposed development we would recommend that the raised planters located on structure would require an automatic drip line irrigation system.

We understand that as with other Uniting Villages, the Landscape Contractor does hand watering of plants within the first three months of the plant establishment period and additional watering is then done as required during dry spells or within periods of

Other water saving initiatives associated with the proposed landscape design is as

- Use of recycled and/or storm water that has been harvested and stored on site for
- Planting within zones that have separate watering requirements,
- Use of low water-use plants (both exotic & native species) where possible to
- reduce landscape watering requirements, and Use of drought tolerant turf species.

## Safety & Security Planting Initiatives:

With the proposed landscape design we recognize that the safety and security of the residents of the Uniting Nareen Gardens. The proposed landscape design for this development we would implement the following safety planting initiatives:

- Avoid planting tree species that are prone to potential limb drop
- Avoid planting species close to paths and hard paved areas that are known for excessive flower and foliage drop that may cause slip hazards
- Avoid planting species that are known for invasive root structure that may damage paths and hard paved areas, which may cause trip hazards
- Avoid planting species that are known to be toxic or may cause respiratory, allergy and/or skin irritations

#### **Crime Prevention Through Environmental Design (Cpted) Principles**

The landscape design for the proposed Uniting Nareen Gardens redevelopment will also include Crime Prevention Through Environmental Design (CPTED) principles, which are as

follows:

- Avoidance of plant species that creates hiding spaces such as implementing clear under-canopied trees with low shrubs and groundcovers,
- Ensure that proposed trees will not or in the future potentially obscure lighting, and
- Ensure sightlines for both vehicles and pedestrians are maintained in particular at pedestrian crossings and vehicular entry/ exit points.

### SUSTAINABILITY

The landscape design for this development at Nareen Gardens will encourage the use of best sustainable landscape practices. Some of these sustainable practices applicable to this particular project are as follows:

- Promote the use of soil testing and site improved top soil so as to reduce the extent of new top soil being imported onto site
- Promote the use of recycled landscape products wherever practical, such as shredded garden mulch from existing trees being removed,
- Implement proprietary items such as street furniture that have implemented the use of recycled materials and finishes, Reduce the extent of ongoing watering requirements by user of drought-tolerant
- plant species (both native & exotic) as mentioned, Reduce the excessive use of insecticides, fungicides and pesticides by using
- suitable plant species that are known to be more resistant to diseases & pests, Promote the use of endemic or native species (where practical) that are known to grow in local soil conditions to reduce the excessive use of watering agents, soil
- improvers and fertilizers. Use of local landscape materials from local landscape suppliers to reduce transportation and embodied energy associated with this development.

# STAGING OF THE DEVELOPMENT

We understand that Uniting have indicated that the new ILU's and RACF is likely to be constructed in separate stages to minimize the impacts of construction on the existing residents and adjacent neighbourhood, and to also ensure a smooth transition for the existing residents into the new facilities.

The proposed landscape design for this development is an overall landscape plan as it will indicate a more holistic approach to the landscape design intent for planning approval. Staging of the various landscape phases with the new development will ensure that a high quality landscape aesthetic is implemented

xeriscapes



**PROJECT** 

UNITING NAREEN GARDENS BIAS AVENUE, BATEAU BAY NSW

**DRAWING NAME** 

**DESIGN REPORT** 

UNITING CLIENT PROJECT NO 18128 DRAWING NO SCALE N/A

**REVISION** DD **DATE** 06.05.22


Level 3, 23 Watt Street (PO Box 958) Newcastle NSW 2300 P: 02 4302 0477 • ABN 12 129 231 269





UNITING NAREEN GARDENS BIAS AVENUE, BATEAU BAY NSW

**DRAWING NAME** 

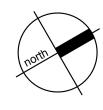

**CLIENT** UNITING PROJECT NO 18128 DRAWING NO L002 SCALE 1:400 @ A1

REVISION HH **DATE** 13.09.22

Tree # (Species) Botanical Name	EXISTI	NG TREE SCHEDULE- UN	IITING BATEAU BAY								
Contention commonly				Retain/Remove	HGT (m)	Opicaa	DBH (mm)	Health	TPZ (m)	SRZ (m)	Comments/Condition
A Confession contents	1	Casuarina glauca	Swamp She-oak	Retain and protect	10	<b>-</b>	590	Good	7.1	2.8	
Comparation according   Conference   Confe	2	Callistemon viminalis	Weeping Bottlebrush	Retain and protect	6	2.5	219	Good	2.6	1.8	Co-dominant stems at 0.5m, union appears stable.
Control of Section   Control of Processes	3	Callistemon viminalis	Weeping Bottlebrush	Remove	7	3.5	539	Good	6.5	2.7	None.
1.   Incorporation   Turn   Turn   Service   7   13   12   1000	4	Citharexylum spinosum	Fiddlewood	Remove	7	3.5	338	Good	4.1	2.2	None.
Processor of the company of the co	5	Leptospermum petersonii	Lemon Scented Tea Tree	Remove	7	3	280	Fair	3.4	2.5	Trunk leans to East. Stem removed at 1m.
Addresson autonomous   Processor   Proce	6	Tibouchina spp	Tibouchina	Remove	3	1.5	127	Good	2.0	1.7	None.
Construct planes	7	Podocarpus elatus	Plum Pine	Remove	7	3	330	Good	4.0	2.2	
10   Columbrie globase   Rearry Shr. cash   Rearr	8	Melaleuca quinquenervia	Broad-leaved Paperbark	Remove	11	3	470	Good	5.6	2.9	Co-dominant stems at near base with indicators of included bark at union. Asymmetric crown shape with bias to West.
Content contents   Content contents   Content conten	9	Casuarina glauca	Swamp She-oak	Retain and protect	11	4	460	Good	5.5	2.6	Co-dominant stems at 1m with open union that appears stable.
1   Consistence sellipses	10	Casuarina glauca	Swamp She-oak	Retain and protect	12	4	440	Fair	5.3	2.6	Reduced foliage density for species. Asymmetric crown shape
Page											with bias to West.
Machine projection   Project   Pro	11	Callistemon salignus	Willow Bottlebrush	Remove	8	3.5		Good		2.6	Deadwood in lower crown.
Material processor   Materia	12	Casuarina glauca	Swamp She-oak	Retain and protect	10	3	560	Good	6.7	2.8	Co-dominant stems near base with indicators of included bark
Methodological programming											
Social Section	13	Melaleuca quinquenervia	Broad-leaved Paperbark	Retain and protect	8	4	710	Good	8.5	3.1	
Second programment   Broad-leared Paperhark   Remove   13   3.5   630   Good   7.6   3.0   None.	32			Remove	12	4	+			•	Asymmetric crown shape with bias to North.
Net-lower quinquenervia   Dross-lewed Paperbark   Retain and protect   9   3.3   420   Good   9.8   3.3   Asymmetric crown mape with blast o North West.	-			Remove	12	3.5	630		7.6		
Adelaleuca quinquenervia   Broad-saved Paperbark   Remove   11   3   420   Good   5.0   2.5   Co-deminant stems at 2m with indicators of included bark at union.	34			Remove	13	5	570	Good	6.8	2.8	None.
Neblebuca quinquemeria   Strad-leaved Paperbark   Remove   9   4   390   Good   4   2.2   None.	35	Melaleuca quinquenervia	Broad-leaved Paperbark	Retain and protect	9	3.5	820	Good	9.8	3.3	Asymmetric crown shape with bias to North West.
38   Mellehuca quinquenervia   Brond-leaved Paperbark   Remove   11   3   346   390   Good   4.7   2.3   None.	36	Melaleuca quinquenervia	Broad-leaved Paperbark	Remove	11	3	420	Good	5.0	2.5	
	37	Melaleuca quinquenervia	Broad-leaved Paperbark	Retain and protect	6	2	330	Good	4	2.2	None.
40	38	Melaleuca quinquenervia	Broad-leaved Paperbark	Remove	9	4	390	Good	4.7	2.3	None.
41   X. Cupress ox paris keylandi   Leighton Green Cypress   Remove   7   1.5   260   Good   3.1   2.0   None.	39	Melaleuca quinquenervia	Broad-leaved Paperbark	Remove	11	3	340	Good	4.1	2.2	None.
Additional authority   Additional authori	40	x Cupressocyparis leylandii	Leighton Green Cypress	Remove	3	1	130	Good	2.0	1.5	None.
	41			Remove	7	1.5				-	None.
Hard-leaved Scribby Gum   Remove   8   3   290   Good   3.5   2.1   None,	42				11	4	-				
45   Melaletuca guinquenervia   Broad-leaved Paperbark   Remove   3   1.5   130   Good   2.0   1.5   None.					7					-	
44   Callisternon vininals   Weeping Bottlebrush   Remove   3   1.5   120   Good   2.0   1.5   None.     47   Callisternon vininals   Weeping Bottlebrush   Remove   3   1.5   120   Good   2.0   1.5   None.     48   Melaleuca quinquenervia   Broad-leaved Paperbark   Remove   10   5   672   Good   8.1   3.4   None.     49   Melaleuca quinquenervia   Broad-leaved Paperbark   Remove   11   5   530   Good   6.4   3.0   None.     50   Melaleuca quinquenervia   Broad-leaved Paperbark   Remove   12   4.5   743   Good   8.9   3.3   None.     51   Corymbia chirodora   Lemon Scented Gum   Remove   12   4.5   743   Good   8.9   3.3   None.     52   Melaleuca quinquenervia   Broad-leaved Paperbark   Remove   11   6   754   Good   9.1   3.3   None.     52   Melaleuca quinquenervia   Broad-leaved Paperbark   Remove   11   6   754   Good   2.4   2.0   None.     53   Podocarpus elatus   Plum Pine   Remove   4   1.5   198   Good   2.4   2.0   None.     54   Callisternon vininalis   Weeping Bottlebrush   Remove   6   3   437   Good   5.2   2.5   Crown previously topped at 1m.     55   Callisternon vininalis   Weeping Bottlebrush   Remove   4   1.5   268   Good   3.2   2.1   Crown previously topped at 1m.     56   Callisternon vininalis   Weeping Bottlebrush   Remove   7   3   3.0   Good   3.6   2.1   Crown previously topped at 1m.     57   Malus spp	44				<u> </u>	3					
AB	45					4	-			-	
Melaleuca quinquenervia   Broad-leaved Paperbark   Remove   10   5   672   Good   8.1   3.4   None.							+			-	
Melaleuca quinquenervia   Broad-leaved Paperbark   Remove   11   5   530   Good   6.4   3.0   None.	47					<del> </del>					
Social State	48						-			-	
Emove   Corymbia citriodora   Lemon Scented Gum   Remove   Corymbia citriodora   Lemon Scented Gum   Remove   Corymbia citriodora   Remove   Corymbia costata   Corymbia costata   Remove   Corymbia costata   Remove   Corymbia costata   Corymbia costata   Corymbia costata   Corymbia citriodora   Corymbia citr							1			-	
Melaleuca quinquenervia   Broad-leaved Paperbark   Remove   11   6   754   Good   9.1   3.3   None.										-	Apical dieback in centre of upper crown, approximately 20-30%
Callistemon viminalis   Weeping Bottlebrush   Remove   6   3   437   Good   5.2   2.5   Crown previously topped at 1m.							+				None.
Secondary   Seco					<u> </u>		+			<b>+</b>	
Second					<u> </u>					<b>+</b>	
ST					7	+				<b>+</b>	
Second   Cupressus sempervirens   Stricta'   Stricta'   Pencil Pine   Remove   Second   Sec					2		-			<u> </u>	
Cupressus sempervirens 'Stricta'  Pencil Pine  Remove  Remove  Remove  Solution  Remove  Remov		Cupressus sempervirens					+			<u> </u>	
Cupressus sempervirens Stricta'  Remove  Remov	59	Cupressus sempervirens	Pencil Pine	Remove	5	0.5	130	Good	2.0	1.5	None.
Broad-leaved Scribbly Gum Remove 11 5 470 Good 5.6 2.6 None.  62 Callistemon viminalis Weeping Bottlebrush Remove 4 2 266 Good 3.2 2.0 None.  63 Corymbia ficifolia Flowering Gum Remove 3 1.5 140 Good 2.0 1.5 None.  64 Callistemon viminalis Weeping Bottlebrush Remove 4 2 290 Fair 3.5 2.3 Decay at base of stems, West stem in decline.  65 Melaleuca quinquenervia Broad-leaved Paperbark Remove 10 5 577 Good 6.9 3.2 None.  66 Melaleuca quinquenervia Broad-leaved Paperbark Remove 6 1.5 260 Good 3.1 2.0 None.  67 Angophora costata Smooth-barked Apple Remove Remove 8 2 240 Good 2.9 1.9 None.  68 Corymbia gummifera Red Bloodwood Remove Remove 10 5 510 Good 6.1 2.7 None.	60	Cupressus sempervirens	Pencil Pine	Remove	5	0.5	150	Good	2.0	1.6	None.




67 Angophora costata Smooth-barked Apple Remove 12 4 425 Good 5.1 2.6 None. 68 Corymbia gummifera Red Bloodwood Remove 8 2 240 Good 2.9 1.9 None. 69 Angophora costata Smooth-barked Apple Remove 10 5 510 Good 6.1 2.7 None.					_		+			1	
68 Corymbia gummifera Red Bloodwood Remove 8 2 240 Good 2.9 1.9 None. 69 Angophora costata Smooth-barked Apple Remove 10 5 510 Good 6.1 2.7 None.						4	+			1	
			• • • • • • • • • • • • • • • • • • • •	Remove	8	2	240	Good	2.9		None.
70   Cryptomeria japonica   Japanese Cedar   Remove   4   2   160   Good   2.0   1.6   None.					10	5	+			1	
	70	Cryptomeria japonica	Japanese Cedar	Remove	4	2	160	Good	2.0	1.6	None.

	108	Eucalyptus haemastoma	,	Retain and protect	6	2	180	Good	2.2	1.8	None.
			Gum	Potain and protect							Main stores has field as diad has been at One Damaining Interest
10	109	Eucalyptus saligna	Sydney Blue Gum	Retain and protect	13	6	510	Fair	6.1	2.7	
112   Cassuring glasce	110	Melaleuca quinquenervia	Broad-leaved Paperbark	Retain and protect	9	3	350	Good	4.2	2.3	
131	111	Casuarina glauca		Retain and protect	12	3	+	Good	5.4	2.5	Co-dominant stems at 4m, union appears stable.
Malekeura numnuemenvia   Broad-leaved Paperbark   Rotain and protect   S					+						
116				· · · · · · · · · · · · · · · · · · ·							
Floral pytus hatemstorne   Broad-leaved Scribbly   Gum   Selan and protect   5   2   230   Good   28   1.9   Trunk leans to North West		, ,	•	· · · · · · · · · · · · · · · · · · ·							
Banksia integricios   Coast Banksia   Retain and protect   16   9   660   Fair   7, 9   3.0   None.	-			Retain and protect							
118											
19		<u> </u>		· ·	7						
		7,	· · ·								
Callisternon viminalis   Weeping Bottlebrush   Retain and protect   4   2   231   Good   2.8   2.1   None.				· ·		3					
		· .			4				2.8		
Allocasuarina ittoralis   Black She-oak   Retain and protect   7   3   311   Fair   3.7   2.2   Asymmetric crown shape with bias to West.					_						
Casuarina glauca   Swamp She-oak   Retain and protect   10   4   420   Fair   5.0   2.5   Asymmetric crown shape with bias to West. Low foliage density for species. Supressed.		-			11		+				
Retain and protect   10	-			· · · · · · · · · · · · · · · · · · ·	6				+		
127   Casuarina glauca   Swamp She-oak   Retain and protect   13   4   400   Good   4.8   2.5   None.     128   Casuarina glauca   Swamp She-oak   Retain and protect   11   3   310   Good   3.7   2.2   None.     129   Casuarina glauca   Swamp She-oak   Retain and protect   11   3   370   Good   4.4   2.4   None.     130   Casuarina glauca   Swamp She-oak   Retain and protect   14   4   450   Good   5.4   2.6   None.     131   Casuarina glauca   Swamp She-oak   Retain and protect   11   3   400   Good   4.8   2.4   None.     132   Bauhinia spp   Orchid Tree   Retain and protect   15   2   200   Fair   2.4   1.8   Supressed.     







			1 0	· · · · · · · · · · · · · · · · · · ·	4						
200   0000   2.7   1.0   NOTICE.				•	<del>                                     </del>						
	1-10	1. Jagan pag diatag		protoot						. 1.0	1





		_	T	T		1			
147 Corymbia maculata	Spotted Gum	Retain and protect	16	8	890	Good	10.7	3.3	None.
148 Lophostemon confertus	Brushbox	Retain and protect	6	3	330	Good	4.0	2.2	None.
149 Citharexylum spinosum	Fiddlewood	Retain and protect	8	4	239	Good	2.9		None.
150 Melaleuca quinquenervia	Broad-leaved Paperbark	Retain and protect	9	1	460	Good	5.5		None.
		•	1	4	-	1			
151 Corymbia gummifera	Red Bloodwood	Retain and protect	20	/	670	Good	8.0		Kino ooze from main union at 4m.
152 Corymbia maculata	Spotted Gum	Retain and protect	23	10	890	Good	10.7		None.
153 Lagunaria patersonii	Norfolk Island Hibiscus	Retain and protect	6	2.5	220	Good	2.6	1.8	None.
154 Citharexylum spinosum	Fiddlewood	Retain and protect	5	3	600	Good	7.2	2.7	Tree is formed from multiple shoots/basal sprouts that have
The state of the s		'							regrown from stump.
155 Callistaman viminalia	Wasning Dattlebrush	Retain and protect	4	1 5	255	Fair	3.1	1.9	None.
155 Callistemon viminalis	Weeping Bottlebrush	· '	<del></del>	1.5	255				
156 Callistemon viminalis	Weeping Bottlebrush	Retain and protect	6	3	220	Good	2.6	1.8	Asymmetric crown shape with bias to West.
157 Callistemon salignus	Willow Bottlebrush	Retain and protect	6	2.5	311	Fair	3.7	2.0	None.
158 Washingtonia robusta	Mexican Fan Palm	Retain and protect	5	1	390	Good	2.0	N/A	None.
159 Eucalyptus saligna	Sydney Blue Gum	Retain and protect	7	3	260	Good	3.1	2.0	None.
160 Eucalyptus saligna	Sydney Blue Gum	Retain and protect	7	3	250	Good	3.0		Asymmetric crown shape with bias to West.
<i>31</i>	Hills Weeping Fig	Retain and protect	0	4	354	Good	4.3		Co-dominant stems at 0.5m with indicators of included bark at
161 Ficus microcarpa var Hillii	Tills vveepling rig	Retain and protect	8	4	354	Good	4.3	2.1	
						_			union. Wound adjacent to union at base of trunk.
162 Melaleuca quinquenervia	Broad-leaved Paperbark	Retain and protect	6	1.5	170	Good	2.0		None.
163 Callistemon viminalis	Weeping Bottlebrush	Retain and protect	3	1	85	Good	2	1.5	None.
164 Callistemon citrinus	Crimson Bottlebrush	Retain and protect	3	1	106	Good	2	1.5	None.
165 Callistemon citrinus	Crimson Bottlebrush	Retain and protect	3	1.5	128	Good	2.0		None.
166 Callistemon viminalis	Weeping Bottlebrush	Retain and protect	1	1.5	120	Good	2.0		None.
			4		1		<del></del>		
167 Callistemon viminalis	Weeping Bottlebrush	Retain and protect	4	2	280	Good	3.4		Crown previously topped at 1m.
168 Callistemon viminalis	Weeping Bottlebrush	Retain and protect	3	2	380	Good	4.6	2.2	Crown previously topped at 1m. DBH estimated at ground
		<u> </u>			L				level.
169 Melaleuca quinquenervia	Broad-leaved Paperbark	Retain and protect	12	3	440	Good	5.3	2.6	None.
170 Xylosma spp	Xylosma	Retain and protect	6	2	230	Good	2.8		None.
·	<u> </u>	· · · · · · · · · · · · · · · · · · ·	-	_	220				
171 Xylosma spp	Xylosma Parantark	Retain and protect	6	2		Good	2.6	1.8	None.
172 Melaleuca quinquenervia	Broad-leaved Paperbark	Retain and protect	12	3	524	Good	6.3	3	None.
173 Melaleuca quinquenervia	Broad-leaved Paperbark	Retain and protect	12	4	566	Good	6.8	2.9	None.
174 Melaleuca quinquenervia	Broad-leaved Paperbark	Retain and protect	14	4	728	Good	8.7	3.1	None.
175 Melaleuca quinquenervia	Broad-leaved Paperbark	Retain and protect	9	2.5	240	Good	2.9	1.9	None.
176 Washingtonia robusta	Mexican Fan Palm	Remove	4	1	370	Good	2.0		None.
y				1					
177 Melaleuca quinquenervia	Broad-leaved Paperbark	Remove	10	2	290	Good	3.5		None.
178 Melaleuca quinquenervia	Broad-leaved Paperbark	Remove	12	3	250	Good	3.0	2.0	Asymmetric crown shape with bias to West.
179 Melaleuca quinquenervia	Broad-leaved Paperbark	Remove	12	3	375	Good	4.5	2.2	Asymmetric crown shape with bias to West.
180 Melaleuca quinquenervia	Broad-leaved Paperbark	Remove	12	3	310	Good	3.7	2.1	Asymmetric crown shape with bias to West.
181 Melaleuca quinquenervia	Broad-leaved Paperbark	Remove	14	4	770	Good	9.2		None.
, ,	Bangalay	Remove				1			None.
	I Danoaiav			6	F20	$C \sim c \sim d$	( 'C')		
182 Eucalyptus botryoides			20	6	520	Good	6.2		
183 Melaleuca quinquenervia	Broad-leaved Paperbark	Remove	13	6	389	Good	4.7	2.7	None.









183 Melaleuca quinquenervia 184 Melaleuca quinquenervia 185 Corymbia maculata 186 Corymbia gummifera 187 Casuarina glauca 188 Eucalyptus spp 189 Angophora costata 190 Casuarina glauca 191 Schefflera actinophylla 192 Melaleuca quinquenervia 193 Melaleuca quinquenervia 194 Melaleuca quinquenervia	Broad-leaved Paperbark Broad-leaved Paperbark Spotted Gum Red Bloodwood Swamp She-oak Eucalypt Smooth-barked Apple Swamp She-oak Umbrella Tree Broad-leaved Paperbark Broad-leaved Paperbark Broad-leaved Paperbark	Remove Retain and protect	13 14 25 21 15 17 13 12 6 8 8	4 4 8 6 3 2.5 4 2.5 3 3 3 3.5	389 634 550 500 270 260 320 375 620 450 420 450	Good Good Good Fair Good Good Good Good Good Good	4.7 7.6 6.6 6.0 3.2 3.1 3.8 4.5 7.4 5.4 5.0 5.4	2.7 2.8 2.7 2.1 2.0 2.2 2.3 2.7 2.5 2.4 2.5	None. None. Asymmetric crown shape with bias to West. Asymmetric crown shape with bias to West. Mulitple cankers on trunk. Asymmetric crown shape with bias to West. Multi stemmed, DBH measured at ground level. Exempt species. None. None. None. None.
183 Melaleuca quinquenervia 184 Melaleuca quinquenervia 185 Corymbia maculata 186 Corymbia gummifera 187 Casuarina glauca 188 Eucalyptus spp 189 Angophora costata 190 Casuarina glauca 191 Schefflera actinophylla 192 Melaleuca quinquenervia 193 Melaleuca quinquenervia 194 Melaleuca quinquenervia 195 Melaleuca quinquenervia	Broad-leaved Paperbark Broad-leaved Paperbark Spotted Gum Red Bloodwood Swamp She-oak Eucalypt Smooth-barked Apple Swamp She-oak  Umbrella Tree Broad-leaved Paperbark Broad-leaved Paperbark Broad-leaved Paperbark Broad-leaved Paperbark Broad-leaved Paperbark	Remove Retain and protect	13 14 25 21 15 17 13 12 6 8 8 9	4 4 8 6 3 2.5 4 2.5 3 3 3 3.5 2.5	389 634 550 500 270 260 320 375 620 450 450 450 290	Good Good Good Fair Good Good Good Good Good Good Good Goo	4.7 7.6 6.6 6.0 3.2 3.1 3.8 4.5 7.4 5.4 5.0 5.4 3.5	2.7 2.8 2.7 2.1 2.0 2.2 2.3 2.7 2.5 2.4 2.5 2.1	None. None. Asymmetric crown shape with bias to West. Asymmetric crown shape with bias to West. Mulitple cankers on trunk. Asymmetric crown shape with bias to West. Multi stemmed, DBH measured at ground level. Exempt species. None. None. None. None. None. None.
183 Melaleuca quinquenervia 184 Melaleuca quinquenervia 185 Corymbia maculata 186 Corymbia gummifera 187 Casuarina glauca 188 Eucalyptus spp 189 Angophora costata 190 Casuarina glauca 191 Schefflera actinophylla 192 Melaleuca quinquenervia 193 Melaleuca quinquenervia 194 Melaleuca quinquenervia 195 Melaleuca quinquenervia 196 Eucalyptus pilularis	Broad-leaved Paperbark Broad-leaved Paperbark Spotted Gum Red Bloodwood Swamp She-oak Eucalypt Smooth-barked Apple Swamp She-oak  Umbrella Tree Broad-leaved Paperbark Blackbutt	Remove Retain and protect	13 14 25 21 15 17 13 12 6 8 8	4 4 8 6 3 2.5 4 2.5 3 3 3 3.5 2.5 8	389 634 550 500 270 260 320 375 620 450 420 450 290 800	Good Good Good Fair Good Good Good Good Good Good Good Goo	4.7 7.6 6.6 6.0 3.2 3.1 3.8 4.5 7.4 5.4 5.0 5.4 3.5 9.6	2.7 2.8 2.7 2.1 2.0 2.2 2.3 2.7 2.5 2.4 2.5 2.1 3.2	None.  None.  Asymmetric crown shape with bias to West.  Asymmetric crown shape with bias to West.  Mulitple cankers on trunk.  Asymmetric crown shape with bias to West.  Multi stemmed, DBH measured at ground level. Exempt species.  None.  None.  None.  None.  None.  None.  None.
183 Melaleuca quinquenervia 184 Melaleuca quinquenervia 185 Corymbia maculata 186 Corymbia gummifera 187 Casuarina glauca 188 Eucalyptus spp 189 Angophora costata 190 Casuarina glauca 191 Schefflera actinophylla 192 Melaleuca quinquenervia 193 Melaleuca quinquenervia 194 Melaleuca quinquenervia 195 Melaleuca quinquenervia 196 Eucalyptus pilularis 197 Melaleuca quinquenervia	Broad-leaved Paperbark Broad-leaved Paperbark Spotted Gum Red Bloodwood Swamp She-oak Eucalypt Smooth-barked Apple Swamp She-oak  Umbrella Tree Broad-leaved Paperbark	Remove Retain and protect	13 14 25 21 15 17 13 12 6 8 8 9 8 15 7	4 4 8 6 3 2.5 4 2.5 3 3 3 3.5 2.5	389 634 550 500 270 260 320 375 620 450 420 450 290 800 260	Good Good Good Fair Good Good Good Good Good Good Good Goo	4.7 7.6 6.6 6.0 3.2 3.1 3.8 4.5 7.4 5.4 5.0 5.4 3.5 9.6 3.1	2.7 2.8 2.7 2.1 2.0 2.2 2.3 2.7 2.5 2.4 2.5 2.1 3.2 2.0	None. None. Asymmetric crown shape with bias to West. Asymmetric crown shape with bias to West. Mulitple cankers on trunk. Asymmetric crown shape with bias to West. Multi stemmed, DBH measured at ground level. Exempt species. None.
183 Melaleuca quinquenervia 184 Melaleuca quinquenervia 185 Corymbia maculata 186 Corymbia gummifera 187 Casuarina glauca 188 Eucalyptus spp 189 Angophora costata 190 Casuarina glauca 191 Schefflera actinophylla 192 Melaleuca quinquenervia 193 Melaleuca quinquenervia 194 Melaleuca quinquenervia 195 Melaleuca quinquenervia 196 Eucalyptus pilularis	Broad-leaved Paperbark Broad-leaved Paperbark Spotted Gum Red Bloodwood Swamp She-oak Eucalypt Smooth-barked Apple Swamp She-oak  Umbrella Tree Broad-leaved Paperbark Blackbutt	Remove Retain and protect	13 14 25 21 15 17 13 12 6 8 8 9	4 4 8 6 3 2.5 4 2.5 3 3 3 3.5 2.5 8	389 634 550 500 270 260 320 375 620 450 420 450 290 800	Good Good Good Fair Good Good Good Good Good Good Good Goo	7.6 6.6 6.0 3.2 3.1 3.8 4.5 7.4 5.4 5.0 5.4 3.5 9.6 3.1 4.6	2.7 2.8 2.7 2.1 2.0 2.2 2.3 2.7 2.5 2.4 2.5 2.1 3.2 2.0	None.  None.  Asymmetric crown shape with bias to West.  Asymmetric crown shape with bias to West.  Mulitple cankers on trunk.  Asymmetric crown shape with bias to West.  Multi stemmed, DBH measured at ground level. Exempt species.  None.  None.  None.  None.  None.  None.  None.
183 Melaleuca quinquenervia 184 Melaleuca quinquenervia 185 Corymbia maculata 186 Corymbia gummifera 187 Casuarina glauca 188 Eucalyptus spp 189 Angophora costata 190 Casuarina glauca 191 Schefflera actinophylla 192 Melaleuca quinquenervia 193 Melaleuca quinquenervia 194 Melaleuca quinquenervia 195 Melaleuca quinquenervia 196 Eucalyptus pilularis 197 Melaleuca quinquenervia	Broad-leaved Paperbark Broad-leaved Paperbark Spotted Gum Red Bloodwood Swamp She-oak Eucalypt Smooth-barked Apple Swamp She-oak  Umbrella Tree Broad-leaved Paperbark	Remove Retain and protect	13 14 25 21 15 17 13 12 6 8 8 9 8 15 7	4 4 8 6 3 2.5 4 2.5 3 3 3 3.5 2.5 8	389 634 550 500 270 260 320 375 620 450 420 450 290 800 260	Good Good Good Fair Good Good Good Good Good Good Good Goo	4.7 7.6 6.6 6.0 3.2 3.1 3.8 4.5 7.4 5.4 5.0 5.4 3.5 9.6 3.1	2.7 2.8 2.7 2.1 2.0 2.2 2.3 2.7 2.5 2.4 2.5 2.1 3.2 2.0 2.3	None. None. Asymmetric crown shape with bias to West. Asymmetric crown shape with bias to West. Mulitple cankers on trunk. Asymmetric crown shape with bias to West. Multi stemmed, DBH measured at ground level. Exempt species. None.
183 Melaleuca quinquenervia 184 Melaleuca quinquenervia 185 Corymbia maculata 186 Corymbia gummifera 187 Casuarina glauca 188 Eucalyptus spp 189 Angophora costata 190 Casuarina glauca 191 Schefflera actinophylla 192 Melaleuca quinquenervia 193 Melaleuca quinquenervia 194 Melaleuca quinquenervia 195 Melaleuca quinquenervia 196 Eucalyptus pilularis 197 Melaleuca quinquenervia 198 Melaleuca quinquenervia 199 Eucalyptus spp	Broad-leaved Paperbark Broad-leaved Paperbark Spotted Gum Red Bloodwood Swamp She-oak Eucalypt Smooth-barked Apple Swamp She-oak  Umbrella Tree Broad-leaved Paperbark Blackbutt Broad-leaved Paperbark Broad-leaved Paperbark Broad-leaved Paperbark Eucalypt	Remove Retain and protect	13 14 25 21 15 17 13 12 6 8 8 9 8 15 7	4 4 8 6 3 2.5 4 2.5 3 3 3 3.5 2.5 8 3 4 7	389 634 550 500 270 260 320 375 620 450 450 490 800 260 380 440	Good Good Good Fair Good Good Good Good Good Good Good Goo	4.7 7.6 6.6 6.0 3.2 3.1 3.8 4.5 7.4 5.4 5.0 5.4 3.5 9.6 3.1 4.6 5.3	2.7 2.8 2.7 2.1 2.0 2.2 2.3 2.7 2.5 2.4 2.5 2.1 3.2 2.0 2.3	None. None. Asymmetric crown shape with bias to West. Asymmetric crown shape with bias to West. Mulitple cankers on trunk. Asymmetric crown shape with bias to West. Multi stemmed, DBH measured at ground level. Exempt species. None. None. None. None. None. None. None. None. Rone. Rone. Rone. Reduced foliage density for species.
183 Melaleuca quinquenervia 184 Melaleuca quinquenervia 185 Corymbia maculata 186 Corymbia gummifera 187 Casuarina glauca 188 Eucalyptus spp 189 Angophora costata 190 Casuarina glauca 191 Schefflera actinophylla 192 Melaleuca quinquenervia 193 Melaleuca quinquenervia 194 Melaleuca quinquenervia 195 Melaleuca quinquenervia 196 Eucalyptus pilularis 197 Melaleuca quinquenervia 198 Melaleuca quinquenervia 199 Eucalyptus spp 200 Angophora costata	Broad-leaved Paperbark Broad-leaved Paperbark Spotted Gum Red Bloodwood Swamp She-oak Eucalypt Smooth-barked Apple Swamp She-oak  Umbrella Tree Broad-leaved Paperbark Blackbutt Broad-leaved Paperbark	Remove Retain and protect	13 14 25 21 15 17 13 12 6 8 8 9 8 15 7 11 14 9	4 4 8 6 3 2.5 4 2.5 3 3 3.5 2.5 8 3 4 7 2.5	389 634 550 500 270 260 320 375 620 450 420 450 290 800 260 380 440 250	Good Good Good Fair Good Good Good Good Good Good Good Goo	4.7 7.6 6.6 6.0 3.2 3.1 3.8 4.5 7.4 5.4 5.0 5.4 3.5 9.6 3.1 4.6 5.3 3.0	2.7 2.8 2.7 2.1 2.0 2.2 2.3 2.7 2.5 2.4 2.5 2.1 3.2 2.0 2.3 2.6 1.9	None. None. Asymmetric crown shape with bias to West. Asymmetric crown shape with bias to West. Mulitple cankers on trunk. Asymmetric crown shape with bias to West. Multi stemmed, DBH measured at ground level. Exempt species. None. Sone. None. None. None. None. None. None. None. Sone. None. None. None. None. None. None. Sone. None. None.
183 Melaleuca quinquenervia 184 Melaleuca quinquenervia 185 Corymbia maculata 186 Corymbia gummifera 187 Casuarina glauca 188 Eucalyptus spp 189 Angophora costata 190 Casuarina glauca 191 Schefflera actinophylla 192 Melaleuca quinquenervia 193 Melaleuca quinquenervia 194 Melaleuca quinquenervia 195 Melaleuca quinquenervia 196 Eucalyptus pilularis 197 Melaleuca quinquenervia 198 Melaleuca quinquenervia 199 Eucalyptus spp 200 Angophora costata 201 Eucalyptus pilularis	Broad-leaved Paperbark Broad-leaved Paperbark Spotted Gum Red Bloodwood Swamp She-oak Eucalypt Smooth-barked Apple Swamp She-oak  Umbrella Tree Broad-leaved Paperbark Blackbutt Broad-leaved Paperbark	Remove Retain and protect	13 14 25 21 15 17 13 12 6 8 9 8 15 7	4 4 8 6 3 2.5 4 2.5 3 3 3 3.5 2.5 8 3 4 7	389 634 550 500 270 260 320 375 620 450 450 450 290 800 260 380 440 250 600	Good Good Good Good Good Good Good Good	4.7 7.6 6.6 6.0 3.2 3.1 3.8 4.5 7.4 5.4 5.0 5.4 3.5 9.6 3.1 4.6 5.3 3.0 7.2	2.7 2.8 2.7 2.1 2.0 2.2 2.3 2.7 2.5 2.4 2.5 2.1 3.2 2.0 2.3 2.6 1.9 2.8	None. None. Asymmetric crown shape with bias to West. Asymmetric crown shape with bias to West. Mulitple cankers on trunk. Asymmetric crown shape with bias to West. Multi stemmed, DBH measured at ground level. Exempt species. None. None. None. None. None. None. None. None. Rone. None. Rone. Reduced foliage density for species. Supressed. None.
183 Melaleuca quinquenervia 184 Melaleuca quinquenervia 185 Corymbia maculata 186 Corymbia gummifera 187 Casuarina glauca 188 Eucalyptus spp 189 Angophora costata 190 Casuarina glauca 191 Schefflera actinophylla 192 Melaleuca quinquenervia 193 Melaleuca quinquenervia 194 Melaleuca quinquenervia 195 Melaleuca quinquenervia 196 Eucalyptus pilularis 197 Melaleuca quinquenervia 198 Melaleuca quinquenervia 199 Eucalyptus spp 200 Angophora costata 201 Eucalyptus pilularis 202 Archontophoenix	Broad-leaved Paperbark Broad-leaved Paperbark Spotted Gum Red Bloodwood Swamp She-oak Eucalypt Smooth-barked Apple Swamp She-oak  Umbrella Tree Broad-leaved Paperbark Blackbutt Broad-leaved Paperbark	Remove Retain and protect	13 14 25 21 15 17 13 12 6 8 8 9 8 15 7 11 14 9	4 4 8 6 3 2.5 4 2.5 3 3 3.5 2.5 8 3 4 7 2.5	389 634 550 500 270 260 320 375 620 450 420 450 290 800 260 380 440 250	Good Good Good Fair Good Good Good Good Good Good Good Goo	4.7 7.6 6.6 6.0 3.2 3.1 3.8 4.5 7.4 5.4 5.0 5.4 3.5 9.6 3.1 4.6 5.3 3.0	2.7 2.8 2.7 2.1 2.0 2.2 2.3 2.7 2.5 2.4 2.5 2.1 3.2 2.0 2.3 2.6 1.9 2.8	None. None. Asymmetric crown shape with bias to West. Asymmetric crown shape with bias to West. Mulitple cankers on trunk. Asymmetric crown shape with bias to West. Multi stemmed, DBH measured at ground level. Exempt species. None. Sone. None. None. None. None. None. None. None. Sone. None. None. None. None. None. None. Sone. None. None.
183 Melaleuca quinquenervia 184 Melaleuca quinquenervia 185 Corymbia maculata 186 Corymbia gummifera 187 Casuarina glauca 188 Eucalyptus spp 189 Angophora costata 190 Casuarina glauca 191 Schefflera actinophylla 192 Melaleuca quinquenervia 193 Melaleuca quinquenervia 194 Melaleuca quinquenervia 195 Melaleuca quinquenervia 196 Eucalyptus pilularis 197 Melaleuca quinquenervia 198 Melaleuca quinquenervia 199 Eucalyptus spp 200 Angophora costata 201 Eucalyptus pilularis 202 Archontophoenix cunninghamiana	Broad-leaved Paperbark Broad-leaved Paperbark Spotted Gum Red Bloodwood Swamp She-oak Eucalypt Smooth-barked Apple Swamp She-oak  Umbrella Tree Broad-leaved Paperbark Blackbutt Broad-leaved Paperbark Eucalypt Smooth-barked Apple Blackbutt Bangalow Palm	Remove Retain and protect	13 14 25 21 15 17 13 12 6 8 8 9 8 15 7 11 14 9	4 4 8 6 3 2.5 4 2.5 3 3 3.5 2.5 8 3 4 7 2.5	389 634 550 500 270 260 320 375 620 450 420 450 290 800 260 380 440 250 600 130	Good Good Good Fair Good Good Good Good Good Good Good Goo	4.7 7.6 6.6 6.0 3.2 3.1 3.8 4.5 7.4 5.4 5.0 5.4 3.5 9.6 3.1 4.6 5.3 3.0 7.2 2.0	2.7 2.8 2.7 2.1 2.0 2.2 2.3 2.7 2.5 2.4 2.5 2.1 3.2 2.0 2.3 2.6 1.9 2.8 N/A	None.  None.  None.  Asymmetric crown shape with bias to West.  Asymmetric crown shape with bias to West.  Mulitple cankers on trunk.  Asymmetric crown shape with bias to West.  Multi stemmed, DBH measured at ground level. Exempt species.  None.
183 Melaleuca quinquenervia 184 Melaleuca quinquenervia 185 Corymbia maculata 186 Corymbia gummifera 187 Casuarina glauca 188 Eucalyptus spp 189 Angophora costata 190 Casuarina glauca 191 Schefflera actinophylla 192 Melaleuca quinquenervia 193 Melaleuca quinquenervia 194 Melaleuca quinquenervia 195 Melaleuca quinquenervia 196 Eucalyptus pilularis 197 Melaleuca quinquenervia 198 Melaleuca quinquenervia 199 Eucalyptus spp 200 Angophora costata 201 Eucalyptus pilularis 202 Archontophoenix	Broad-leaved Paperbark Broad-leaved Paperbark Spotted Gum Red Bloodwood Swamp She-oak Eucalypt Smooth-barked Apple Swamp She-oak  Umbrella Tree Broad-leaved Paperbark Blackbutt Broad-leaved Paperbark	Remove Retain and protect	13 14 25 21 15 17 13 12 6 8 8 9 8 15 7 11 14 9	4 4 8 6 3 2.5 4 2.5 3 3 3.5 2.5 8 3 4 7 2.5	389 634 550 500 270 260 320 375 620 450 450 450 290 800 260 380 440 250 600	Good Good Good Good Good Good Good Good	4.7 7.6 6.6 6.0 3.2 3.1 3.8 4.5 7.4 5.4 5.0 5.4 3.5 9.6 3.1 4.6 5.3 3.0 7.2	2.7 2.8 2.7 2.1 2.0 2.2 2.3 2.7 2.5 2.4 2.5 2.1 3.2 2.0 2.3 2.6 1.9 2.8 N/A	None. None. Asymmetric crown shape with bias to West. Asymmetric crown shape with bias to West. Mulitple cankers on trunk. Asymmetric crown shape with bias to West. Multi stemmed, DBH measured at ground level. Exempt species. None. None. None. None. None. None. None. None. Rone. None. Rone. Reduced foliage density for species. Supressed. None.
183 Melaleuca quinquenervia 184 Melaleuca quinquenervia 185 Corymbia maculata 186 Corymbia gummifera 187 Casuarina glauca 188 Eucalyptus spp 189 Angophora costata 190 Casuarina glauca 191 Schefflera actinophylla 192 Melaleuca quinquenervia 193 Melaleuca quinquenervia 194 Melaleuca quinquenervia 195 Melaleuca quinquenervia 196 Eucalyptus pilularis 197 Melaleuca quinquenervia 198 Melaleuca quinquenervia 199 Eucalyptus spp 200 Angophora costata 201 Eucalyptus pilularis 202 Archontophoenix cunninghamiana	Broad-leaved Paperbark Broad-leaved Paperbark Spotted Gum Red Bloodwood Swamp She-oak Eucalypt Smooth-barked Apple Swamp She-oak  Umbrella Tree Broad-leaved Paperbark Blackbutt Broad-leaved Paperbark Eucalypt Smooth-barked Apple Blackbutt Bangalow Palm	Remove Retain and protect	13 14 25 21 15 17 13 12 6 8 8 9 8 15 7 11 14 9	4 4 8 6 3 2.5 4 2.5 3 3 3.5 2.5 8 3 4 7 2.5	389 634 550 500 270 260 320 375 620 450 420 450 290 800 260 380 440 250 600 130	Good Good Good Fair Good Good Good Good Good Good Good Goo	4.7 7.6 6.6 6.0 3.2 3.1 3.8 4.5 7.4 5.4 5.0 5.4 3.5 9.6 3.1 4.6 5.3 3.0 7.2 2.0	2.7 2.8 2.7 2.1 2.0 2.2 2.3 2.7 2.5 2.4 2.5 2.1 3.2 2.0 2.3 2.6 1.9 2.8 N/A	None.  None.  None.  Asymmetric crown shape with bias to West.  Asymmetric crown shape with bias to West.  Mulitple cankers on trunk.  Asymmetric crown shape with bias to West.  Multi stemmed, DBH measured at ground level. Exempt species.  None.
183 Melaleuca quinquenervia 184 Melaleuca quinquenervia 185 Corymbia maculata 186 Corymbia gummifera 187 Casuarina glauca 188 Eucalyptus spp 189 Angophora costata 190 Casuarina glauca 191 Schefflera actinophylla 192 Melaleuca quinquenervia 193 Melaleuca quinquenervia 194 Melaleuca quinquenervia 195 Melaleuca quinquenervia 196 Eucalyptus pilularis 197 Melaleuca quinquenervia 198 Melaleuca quinquenervia 199 Eucalyptus spp 200 Angophora costata 201 Eucalyptus pilularis 202 Archontophoenix cunninghamiana 203 Archontophoenix cunninghamiana	Broad-leaved Paperbark Broad-leaved Paperbark Spotted Gum Red Bloodwood Swamp She-oak Eucalypt Smooth-barked Apple Swamp She-oak  Umbrella Tree Broad-leaved Paperbark Broad-leaved Paperbark Broad-leaved Paperbark Broad-leaved Paperbark Broad-leaved Paperbark Broad-leaved Paperbark Blackbutt Broad-leaved Paperbark Eucalypt Smooth-barked Apple Blackbutt Bangalow Palm  Bangalow Palm	Remove Retain and protect	13 14 25 21 15 17 13 12 6 8 8 9 8 15 7 11 14 9	4 4 8 6 3 2.5 4 2.5 3 3 3.5 2.5 8 3 4 7 2.5	389 634 550 500 270 260 320 375 620 450 450 290 800 260 380 440 250 600 130	Good Good Good Good Fair Good Good Good Good Good Good Good Goo	4.7 7.6 6.6 6.0 3.2 3.1 3.8 4.5 7.4 5.4 5.0 5.4 3.5 9.6 3.1 4.6 5.3 3.0 7.2 2.0	2.7 2.8 2.7 2.1 2.0 2.2 2.3 2.7 2.5 2.4 2.5 2.1 3.2 2.0 2.3 2.6 1.9 2.8 N/A	None.  None. Asymmetric crown shape with bias to West. Asymmetric crown shape with bias to West. Mulitple cankers on trunk. Asymmetric crown shape with bias to West. Multi stemmed, DBH measured at ground level. Exempt species. None. None. None. None. None. None. None. Rone. Reduced foliage density for species. Supressed. None. None. None.
183 Melaleuca quinquenervia 184 Melaleuca quinquenervia 185 Corymbia maculata 186 Corymbia gummifera 187 Casuarina glauca 188 Eucalyptus spp 189 Angophora costata 190 Casuarina glauca 191 Schefflera actinophylla 192 Melaleuca quinquenervia 193 Melaleuca quinquenervia 194 Melaleuca quinquenervia 195 Melaleuca quinquenervia 196 Eucalyptus pilularis 197 Melaleuca quinquenervia 198 Melaleuca quinquenervia 199 Eucalyptus spp 200 Angophora costata 201 Eucalyptus pilularis 202 Archontophoenix cunninghamiana 203 Archontophoenix cunninghamiana 204 Archontophoenix	Broad-leaved Paperbark Broad-leaved Paperbark Spotted Gum Red Bloodwood Swamp She-oak Eucalypt Smooth-barked Apple Swamp She-oak  Umbrella Tree Broad-leaved Paperbark Blackbutt Broad-leaved Paperbark Eucalypt Smooth-barked Apple Blackbutt Bangalow Palm	Remove Retain and protect	13 14 25 21 15 17 13 12 6 8 8 9 8 15 7 11 14 9 14 7	4 4 8 6 3 2.5 4 2.5 3 3 3.5 2.5 8 3 4 7 2.5	389 634 550 500 270 260 320 375 620 450 420 450 290 800 260 380 440 250 600 130	Good Good Good Fair Good Good Good Good Good Good Good Goo	4.7 7.6 6.6 6.0 3.2 3.1 3.8 4.5 7.4 5.4 5.0 5.4 3.5 9.6 3.1 4.6 5.3 3.0 7.2 2.0	2.7 2.8 2.7 2.1 2.0 2.2 2.3 2.7 2.5 2.4 2.5 2.1 3.2 2.0 2.3 2.6 1.9 2.8 N/A	None.  None.  None.  Asymmetric crown shape with bias to West.  Asymmetric crown shape with bias to West.  Mulitple cankers on trunk.  Asymmetric crown shape with bias to West.  Multi stemmed, DBH measured at ground level. Exempt species.  None.
183 Melaleuca quinquenervia 184 Melaleuca quinquenervia 185 Corymbia maculata 186 Corymbia gummifera 187 Casuarina glauca 188 Eucalyptus spp 189 Angophora costata 190 Casuarina glauca 191 Schefflera actinophylla 192 Melaleuca quinquenervia 193 Melaleuca quinquenervia 194 Melaleuca quinquenervia 195 Melaleuca quinquenervia 196 Eucalyptus pilularis 197 Melaleuca quinquenervia 198 Melaleuca quinquenervia 199 Eucalyptus spp 200 Angophora costata 201 Eucalyptus pilularis 202 Archontophoenix cunninghamiana 203 Archontophoenix cunninghamiana 204 Archontophoenix cunninghamiana	Broad-leaved Paperbark  Broad-leaved Paperbark  Spotted Gum  Red Bloodwood  Swamp She-oak  Eucalypt  Smooth-barked Apple  Swamp She-oak  Umbrella Tree  Broad-leaved Paperbark  Broad-leaved Paperbark  Broad-leaved Paperbark  Broad-leaved Paperbark  Broad-leaved Paperbark  Blackbutt  Broad-leaved Paperbark  Broad-leaved Paperbark  Blackbutt  Broad-leaved Paperbark  Broad-leaved Paperbark  Broad-leaved Paperbark  Broad-leaved Paperbark  Bangalow Palm  Bangalow Palm  Bangalow Palm	Remove Retain and protect	13 14 25 21 15 17 13 12 6 8 8 9 8 15 7 11 14 9 14 7	4 4 8 6 3 2.5 4 2.5 3 3 3.5 2.5 8 3 4 7 2.5	389 634 550 500 270 260 320 375 620 450 450 420 450 290 800 260 380 440 250 600 130	Good Good Good Fair Good Good Good Good Good Good Good Goo	4.7 7.6 6.6 6.0 3.2 3.1 3.8 4.5 7.4 5.4 5.0 5.4 3.5 9.6 3.1 4.6 5.3 3.0 7.2 2.0	2.7 2.8 2.7 2.1 2.0 2.2 2.3 2.7 2.5 2.4 2.5 2.1 3.2 2.0 2.3 2.6 1.9 2.8 N/A N/A	None. None. None. Asymmetric crown shape with bias to West. Asymmetric crown shape with bias to West. Mulitple cankers on trunk. Asymmetric crown shape with bias to West. Multi stemmed, DBH measured at ground level. Exempt species. None.
183 Melaleuca quinquenervia 184 Melaleuca quinquenervia 185 Corymbia maculata 186 Corymbia gummifera 187 Casuarina glauca 188 Eucalyptus spp 189 Angophora costata 190 Casuarina glauca 191 Schefflera actinophylla 192 Melaleuca quinquenervia 193 Melaleuca quinquenervia 194 Melaleuca quinquenervia 195 Melaleuca quinquenervia 196 Eucalyptus pilularis 197 Melaleuca quinquenervia 198 Melaleuca quinquenervia 199 Eucalyptus spp 200 Angophora costata 201 Eucalyptus pilularis 202 Archontophoenix cunninghamiana 203 Archontophoenix cunninghamiana 204 Archontophoenix cunninghamiana 205 Archontophoenix	Broad-leaved Paperbark Broad-leaved Paperbark Spotted Gum Red Bloodwood Swamp She-oak Eucalypt Smooth-barked Apple Swamp She-oak  Umbrella Tree Broad-leaved Paperbark Broad-leaved Paperbark Broad-leaved Paperbark Broad-leaved Paperbark Broad-leaved Paperbark Broad-leaved Paperbark Blackbutt Broad-leaved Paperbark Eucalypt Smooth-barked Apple Blackbutt Bangalow Palm  Bangalow Palm	Remove Retain and protect	13 14 25 21 15 17 13 12 6 8 8 9 8 15 7 11 14 9 14 7	4 4 8 6 3 2.5 4 2.5 3 3 3.5 2.5 8 3 4 7 2.5	389 634 550 500 270 260 320 375 620 450 450 290 800 260 380 440 250 600 130	Good Good Good Good Fair Good Good Good Good Good Good Good Goo	4.7 7.6 6.6 6.0 3.2 3.1 3.8 4.5 7.4 5.4 5.0 5.4 3.5 9.6 3.1 4.6 5.3 3.0 7.2 2.0	2.7 2.8 2.7 2.1 2.0 2.2 2.3 2.7 2.5 2.4 2.5 2.1 3.2 2.0 2.3 2.6 1.9 2.8 N/A N/A	None.  None. Asymmetric crown shape with bias to West. Asymmetric crown shape with bias to West. Mulitple cankers on trunk. Asymmetric crown shape with bias to West. Multi stemmed, DBH measured at ground level. Exempt species. None. None. None. None. None. None. None. Rone. Reduced foliage density for species. Supressed. None. None. None.
183 Melaleuca quinquenervia 184 Melaleuca quinquenervia 185 Corymbia maculata 186 Corymbia gummifera 187 Casuarina glauca 188 Eucalyptus spp 189 Angophora costata 190 Casuarina glauca 191 Schefflera actinophylla 192 Melaleuca quinquenervia 193 Melaleuca quinquenervia 194 Melaleuca quinquenervia 195 Melaleuca quinquenervia 196 Eucalyptus pilularis 197 Melaleuca quinquenervia 198 Melaleuca quinquenervia 199 Eucalyptus spp 200 Angophora costata 201 Eucalyptus pilularis 202 Archontophoenix cunninghamiana 203 Archontophoenix cunninghamiana 204 Archontophoenix cunninghamiana 205 Archontophoenix cunninghamiana 205 Archontophoenix cunninghamiana	Broad-leaved Paperbark Broad-leaved Paperbark Spotted Gum Red Bloodwood Swamp She-oak Eucalypt Smooth-barked Apple Swamp She-oak  Umbrella Tree Broad-leaved Paperbark Broad-leaved Paperbark Broad-leaved Paperbark Broad-leaved Paperbark Broad-leaved Paperbark Blackbutt Broad-leaved Paperbark Broad-leaved Paperbark Broad-leaved Paperbark Blackbutt Broad-leaved Paperbark Broad-leaved Paperbark Broad-leaved Paperbark Broad-leaved Paperbark Broad-leaved Paperbark Broad-leaved Paperbark Bangalow Palm  Bangalow Palm  Bangalow Palm  Bangalow Palm	Remove Retain and protect	13 14 25 21 15 17 13 12 6 8 8 9 8 15 7 11 14 9 14 7	4 4 8 6 3 2.5 4 2.5 3 3 3.5 2.5 8 3 4 7 2.5	389 634 550 500 270 260 320 375 620 450 420 450 290 800 260 380 440 250 600 130	Good Good Good Fair Good Good Good Good Good Good Good Goo	4.7 7.6 6.6 6.0 3.2 3.1 3.8 4.5 7.4 5.4 5.0 5.4 3.5 9.6 3.1 4.6 5.3 3.0 7.2 2.0 2.0	2.7 2.8 2.7 2.1 2.0 2.2 2.3 2.7 2.5 2.4 2.5 2.1 3.2 2.0 2.3 2.6 1.9 2.8 N/A N/A	None.  None.  Asymmetric crown shape with bias to West.  Asymmetric crown shape with bias to West.  Mulitple cankers on trunk.  Asymmetric crown shape with bias to West.  Multi stemmed, DBH measured at ground level. Exempt species.  None.
183 Melaleuca quinquenervia 184 Melaleuca quinquenervia 185 Corymbia maculata 186 Corymbia gummifera 187 Casuarina glauca 188 Eucalyptus spp 189 Angophora costata 190 Casuarina glauca 191 Schefflera actinophylla 192 Melaleuca quinquenervia 193 Melaleuca quinquenervia 194 Melaleuca quinquenervia 195 Melaleuca quinquenervia 196 Eucalyptus pilularis 197 Melaleuca quinquenervia 198 Melaleuca quinquenervia 199 Eucalyptus spp 200 Angophora costata 201 Eucalyptus pilularis 202 Archontophoenix cunninghamiana 203 Archontophoenix cunninghamiana 204 Archontophoenix cunninghamiana 205 Archontophoenix	Broad-leaved Paperbark  Broad-leaved Paperbark  Spotted Gum  Red Bloodwood  Swamp She-oak  Eucalypt  Smooth-barked Apple  Swamp She-oak  Umbrella Tree  Broad-leaved Paperbark  Broad-leaved Paperbark  Broad-leaved Paperbark  Broad-leaved Paperbark  Broad-leaved Paperbark  Blackbutt  Broad-leaved Paperbark  Broad-leaved Paperbark  Blackbutt  Broad-leaved Paperbark  Broad-leaved Paperbark  Broad-leaved Paperbark  Broad-leaved Paperbark  Bangalow Palm  Bangalow Palm  Bangalow Palm	Remove Retain and protect	13 14 25 21 15 17 13 12 6 8 8 9 8 15 7 11 14 9 14 7	4 4 8 6 3 2.5 4 2.5 3 3 3.5 2.5 8 3 4 7 2.5	389 634 550 500 270 260 320 375 620 450 450 420 450 290 800 260 380 440 250 600 130	Good Good Good Fair Good Good Good Good Good Good Good Goo	4.7 7.6 6.6 6.0 3.2 3.1 3.8 4.5 7.4 5.4 5.0 5.4 3.5 9.6 3.1 4.6 5.3 3.0 7.2 2.0	2.7 2.8 2.7 2.1 2.0 2.2 2.3 2.7 2.5 2.4 2.5 2.1 3.2 2.0 2.3 2.6 1.9 2.8 N/A N/A	None. None. None. Asymmetric crown shape with bias to West. Asymmetric crown shape with bias to West. Mulitple cankers on trunk. Asymmetric crown shape with bias to West. Multi stemmed, DBH measured at ground level. Exempt species. None.
183 Melaleuca quinquenervia 184 Melaleuca quinquenervia 185 Corymbia maculata 186 Corymbia gummifera 187 Casuarina glauca 188 Eucalyptus spp 189 Angophora costata 190 Casuarina glauca 191 Schefflera actinophylla 192 Melaleuca quinquenervia 193 Melaleuca quinquenervia 194 Melaleuca quinquenervia 195 Melaleuca quinquenervia 196 Eucalyptus pilularis 197 Melaleuca quinquenervia 198 Melaleuca quinquenervia 199 Eucalyptus spp 200 Angophora costata 201 Eucalyptus pilularis 202 Archontophoenix cunninghamiana 203 Archontophoenix cunninghamiana 204 Archontophoenix cunninghamiana 205 Archontophoenix cunninghamiana 206 Eucalyptus pilularis	Broad-leaved Paperbark Broad-leaved Paperbark Spotted Gum Red Bloodwood Swamp She-oak Eucalypt Smooth-barked Apple Swamp She-oak  Umbrella Tree Broad-leaved Paperbark Broad-leaved Paperbark Broad-leaved Paperbark Broad-leaved Paperbark Broad-leaved Paperbark Broad-leaved Paperbark Blackbutt Broad-leaved Paperbark	Remove Retain and protect	13 14 25 21 15 17 13 12 6 8 8 9 8 15 7 11 14 9 14 7	4 4 8 6 3 2.5 4 2.5 3 3 3.5 2.5 8 3 4 7 2.5	389 634 550 500 270 260 320 375 620 450 420 450 290 800 260 380 440 250 600 130	Good Good Good Fair Good Good Good Good Good Good Good Goo	4.7 7.6 6.6 6.0 3.2 3.1 3.8 4.5 7.4 5.4 5.0 5.4 3.5 9.6 3.1 4.6 5.3 3.0 7.2 2.0 2.0	2.7 2.8 2.7 2.1 2.0 2.2 2.3 2.7 2.5 2.4 2.5 2.1 3.2 2.0 2.3 2.6 1.9 2.8 N/A N/A N/A N/A	None.  None.  None.  Asymmetric crown shape with bias to West.  Asymmetric crown shape with bias to West.  Mulitple cankers on trunk.  Asymmetric crown shape with bias to West.  Multi stemmed, DBH measured at ground level. Exempt species.  None.
183 Melaleuca quinquenervia 184 Melaleuca quinquenervia 185 Corymbia maculata 186 Corymbia gummifera 187 Casuarina glauca 188 Eucalyptus spp 189 Angophora costata 190 Casuarina glauca 191 Schefflera actinophylla 192 Melaleuca quinquenervia 193 Melaleuca quinquenervia 194 Melaleuca quinquenervia 195 Melaleuca quinquenervia 196 Eucalyptus pilularis 197 Melaleuca quinquenervia 198 Melaleuca quinquenervia 199 Eucalyptus spp 200 Angophora costata 201 Eucalyptus pilularis 202 Archontophoenix cunninghamiana 203 Archontophoenix cunninghamiana 204 Archontophoenix cunninghamiana 205 Archontophoenix cunninghamiana 206 Eucalyptus pilularis 207 Angophora costata	Broad-leaved Paperbark  Broad-leaved Paperbark  Spotted Gum  Red Bloodwood  Swamp She-oak  Eucalypt  Smooth-barked Apple  Swamp She-oak  Umbrella Tree  Broad-leaved Paperbark  Broad-leaved Paperbark  Broad-leaved Paperbark  Broad-leaved Paperbark  Broad-leaved Paperbark  Blackbutt  Broad-leaved Paperbark  Eucalypt  Smooth-barked Apple  Blackbutt  Bangalow Palm  Bangalow Palm  Bangalow Palm  Blackbutt  Smooth-barked Apple	Remove Retain and protect	13 14 25 21 15 17 13 12 6 8 8 9 8 15 7 11 14 9 14 7 7	4 4 8 6 3 2.5 4 2.5 3 3 3.5 2.5 8 3 4 7 2.5 6 1 1	389 634 550 500 270 260 320 375 620 450 420 450 290 800 260 380 440 250 600 130 130 130 650 530	Good Good Good Good Good Good Good Good	4.7 7.6 6.6 6.0 3.2 3.1 3.8 4.5 7.4 5.4 5.0 5.4 3.5 9.6 3.1 4.6 5.3 3.0 7.2 2.0 2.0 2.0 7.8 6.4	2.7 2.8 2.7 2.1 2.0 2.2 2.3 2.7 2.5 2.4 2.5 2.1 3.2 2.0 2.3 2.6 1.9 2.8 N/A N/A N/A	None.  None.  None.  Asymmetric crown shape with bias to West.  Asymmetric crown shape with bias to West.  Mulitiple cankers on trunk.  Asymmetric crown shape with bias to West.  Multi stemmed, DBH measured at ground level. Exempt species.  None.
183 Melaleuca quinquenervia 184 Melaleuca quinquenervia 185 Corymbia maculata 186 Corymbia gummifera 187 Casuarina glauca 188 Eucalyptus spp 189 Angophora costata 190 Casuarina glauca 191 Schefflera actinophylla 192 Melaleuca quinquenervia 193 Melaleuca quinquenervia 194 Melaleuca quinquenervia 195 Melaleuca quinquenervia 196 Eucalyptus pilularis 197 Melaleuca quinquenervia 198 Melaleuca quinquenervia 199 Eucalyptus spp 200 Angophora costata 201 Eucalyptus pilularis 202 Archontophoenix cunninghamiana 203 Archontophoenix cunninghamiana 204 Archontophoenix cunninghamiana 205 Archontophoenix cunninghamiana 206 Eucalyptus pilularis 207 Angophora costata 208 Eucalyptus pilularis	Broad-leaved Paperbark  Broad-leaved Paperbark  Spotted Gum  Red Bloodwood  Swamp She-oak  Eucalypt  Smooth-barked Apple  Swamp She-oak  Umbrella Tree  Broad-leaved Paperbark  Broad-leaved Paperbark  Broad-leaved Paperbark  Broad-leaved Paperbark  Blackbutt  Broad-leaved Paperbark  Broad-leaved Paperbark  Blackbutt  Broad-leaved Paperbark  Bangalow Palm  Bangalow Palm  Bangalow Palm  Blackbutt  Bangalow Palm  Blackbutt  Bangalow Palm  Blackbutt  Bangalow Palm	Remove Retain and protect	13 14 25 21 15 17 13 12 6 8 8 9 8 15 7 11 14 9 14 7 7	4 4 8 6 3 2.5 4 2.5 3 3 3.5 2.5 8 3 4 7 2.5 6 1 1	389 634 550 500 270 260 320 375 620 450 420 450 290 800 260 380 440 250 600 130 130 130 650 530 500	Good Good Good Good Good Good Good Good	4.7 7.6 6.6 6.0 3.2 3.1 3.8 4.5 7.4 5.4 5.0 5.4 3.5 9.6 3.1 4.6 5.3 3.0 7.2 2.0 2.0 2.0 7.8 6.4 6.0	2.7 2.8 2.7 2.1 2.0 2.2 2.3 2.7 2.5 2.4 2.5 2.1 3.2 2.0 2.3 2.6 1.9 2.8 N/A N/A N/A N/A 3.0 2.8 2.7	None. None. None. Asymmetric crown shape with bias to West. Asymmetric crown shape with bias to West. Mulitiple cankers on trunk. Asymmetric crown shape with bias to West. Mulitistemmed, DBH measured at ground level. Exempt species. None.











Denotes Existing Tree to be Retained Denotes Existing Tree to be Removed











UNITING NAREEN GARDENS BIAS AVENUE, BATEAU BAY NSW DRAWING NAME

PROPOSED TREE PLAN

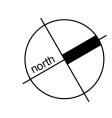

CLIENT UNITING
PROJECT NO 18128
DRAWING NO L005

SCALE 1:400 @ A1

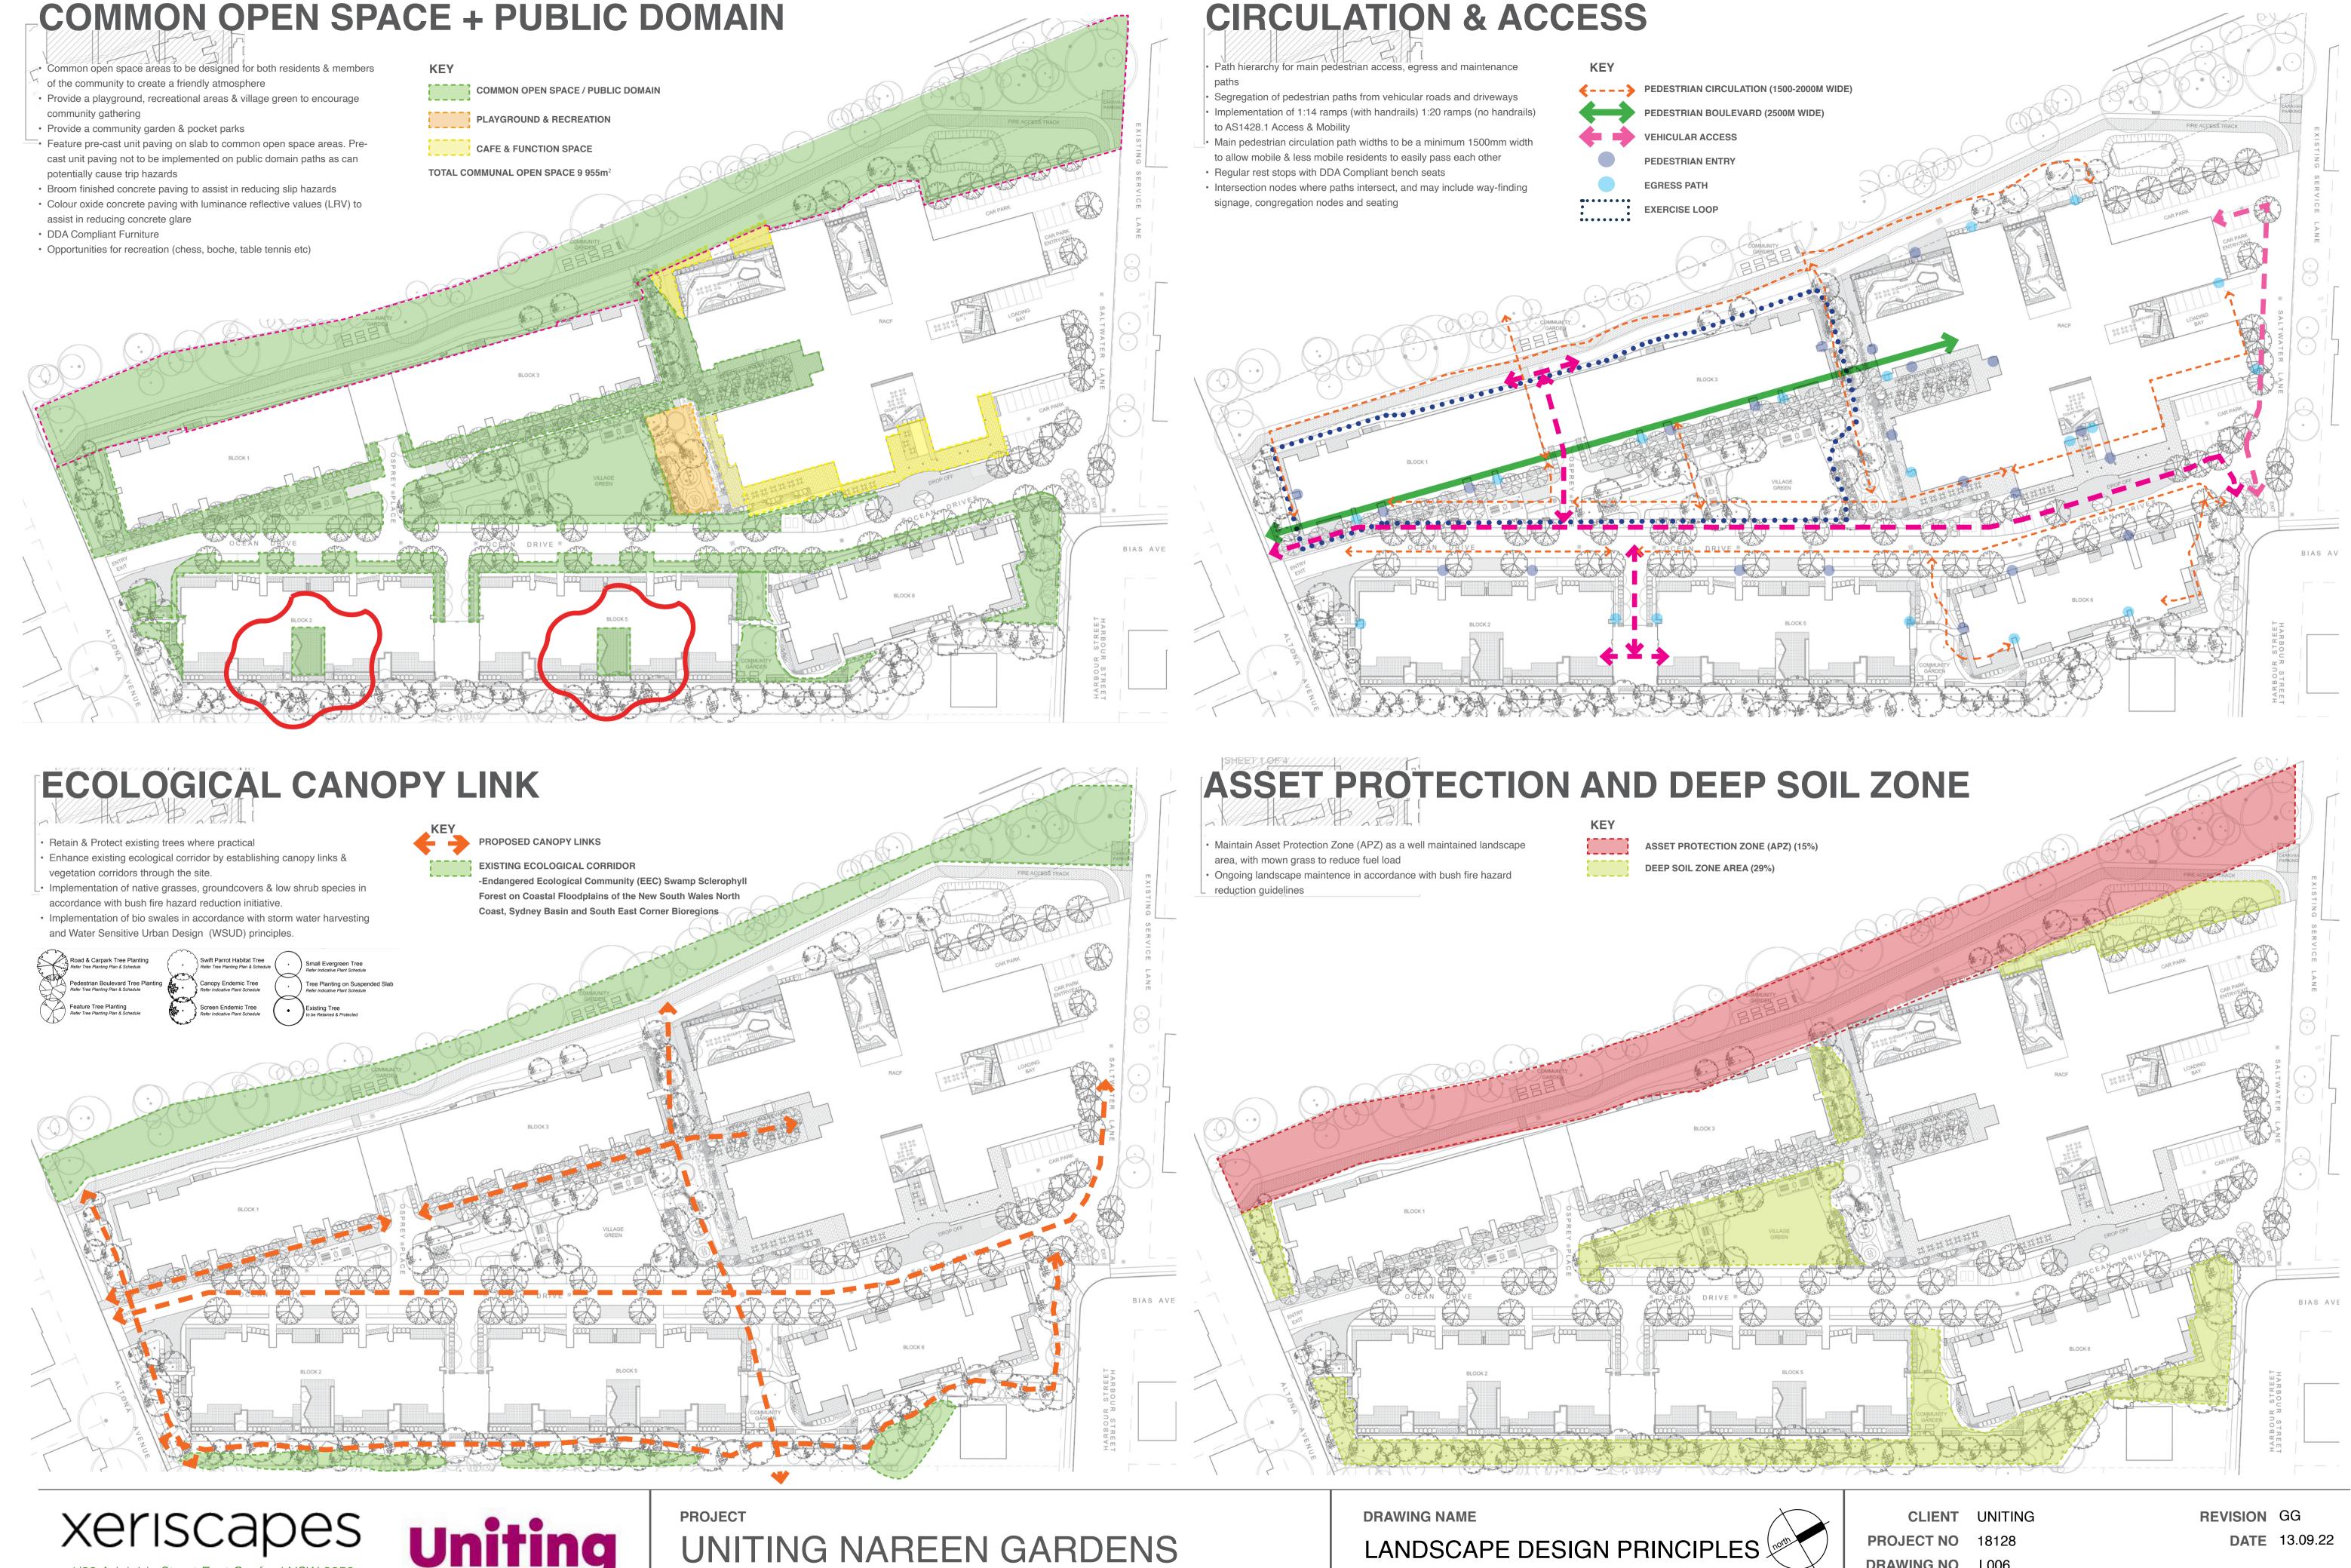

Level 3, 23 Watt Street (PO Box 958) Newcastle NSW 2300 P: 02 4302 0477 • ABN 12 129 231 269



BIAS AVENUE, BATEAU BAY NSW





DAIE 13.08








UNITING NAREEN GARDENS BIAS AVENUE, BATEAU BAY NSW **DRAWING NAME** 

DETAILED LANDSCAPE PLAN 2 of 3

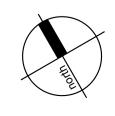

CLIENT UNITING
PROJECT NO 18128
DRAWING NO L103

REVISION EE

DATE 13.09.22

SCALE 1:250 @ A1








UNITING NAREEN GARDENS
BIAS AVENUE, BATEAU BAY NSW

**DRAWING NAME** 


DETAILED LANDSCAPE PLAN 3 of 3

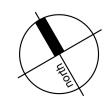

CLIENT UNITING
PROJECT NO 18128

REVISION FF
DATE 13.09.22

DRAWING NO L104

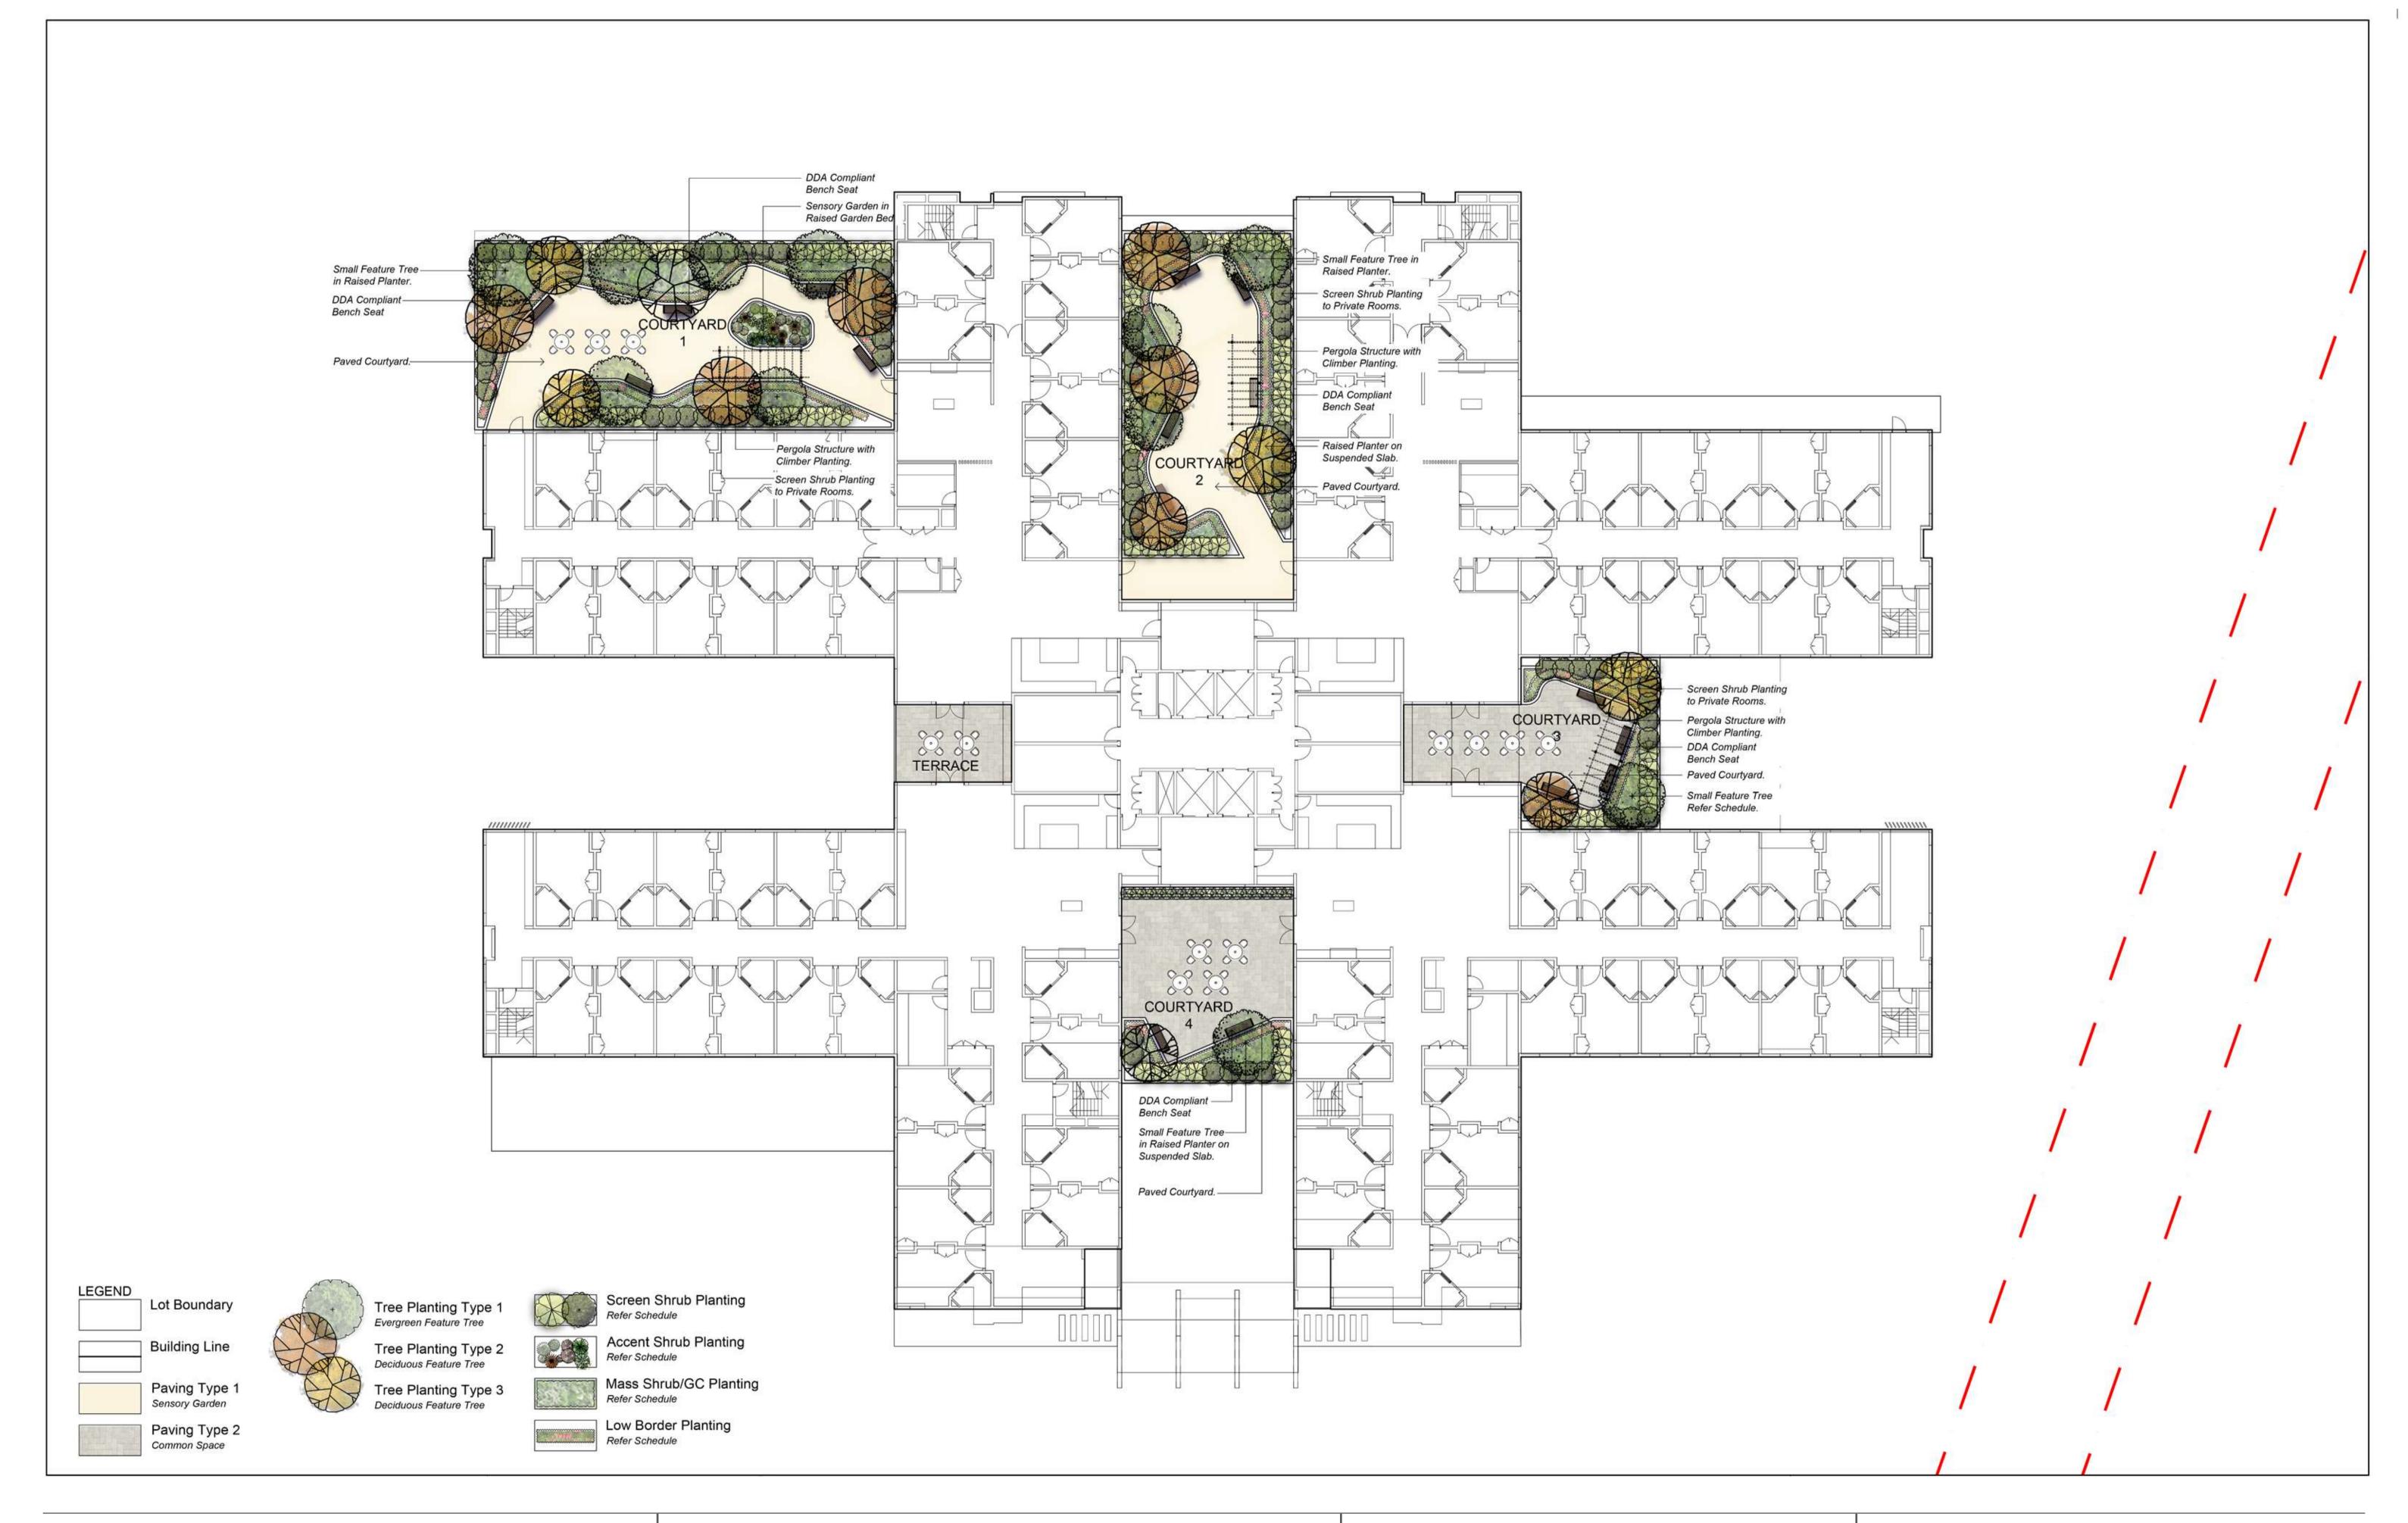



UNITING NAREEN GARDENS
BIAS AVENUE, BATEAU BAY NSW


**DRAWING NAME** 

RACF LEVEL 1 PODIUM LANDSCAPE PLAN

CLIENT UNITING REVISION CC
PROJECT NO 18128 DATE 28.04.22
DRAWING NO L105

SCALE 1:200 @ A1 0 1 2 4 6 10m



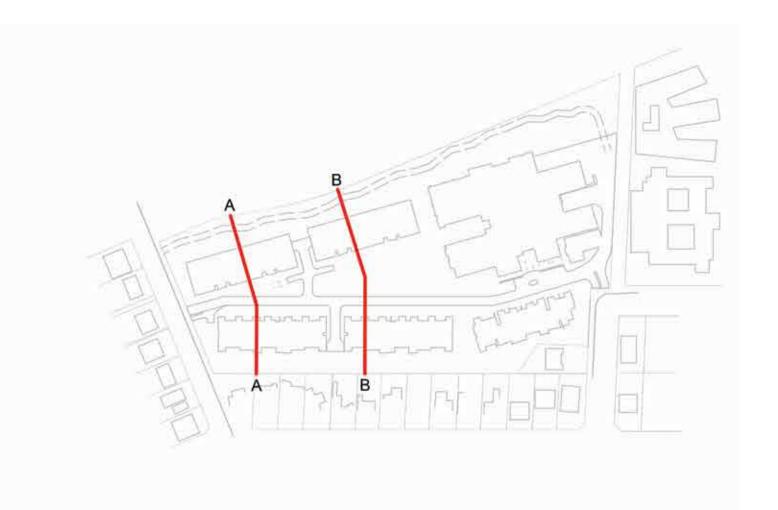

**SECTION AA** 1:250 @ A1





P: 02 4302 0477 • ABN 12 129 231 269









P: 02 4302 0477 • ABN 12 129 231 269



SCALE AS SHOWN @ A1

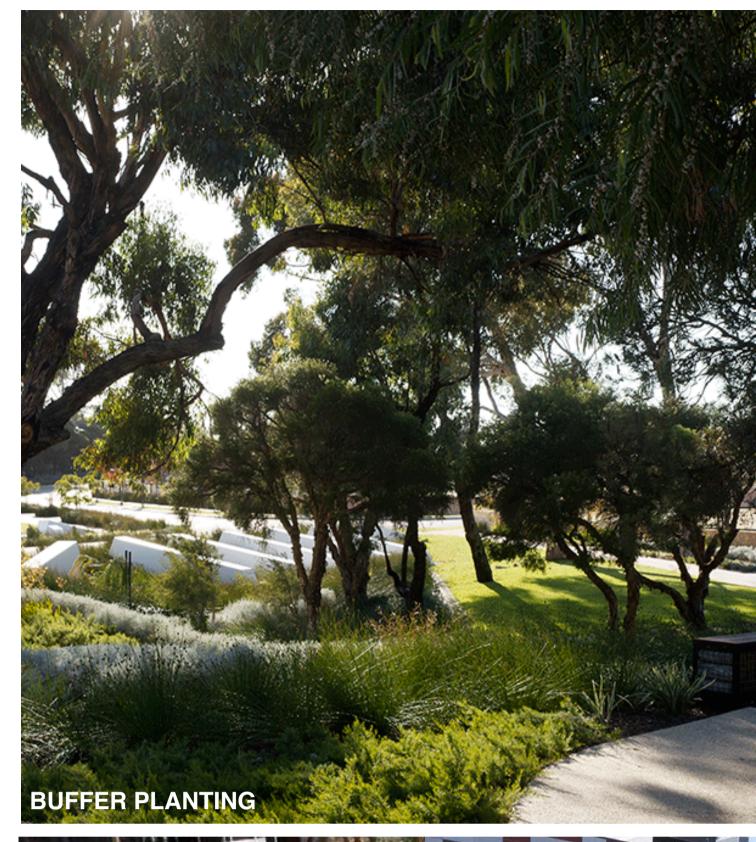



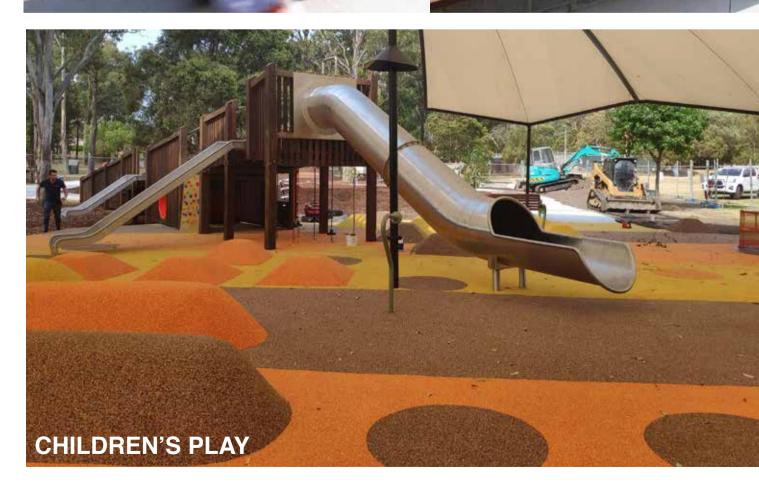























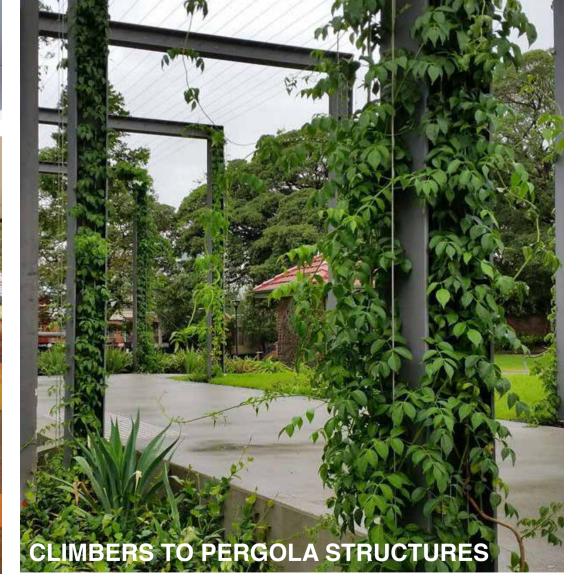












Image	Botanical Name	Common Name	Mature Height (m.)	Mature Spread (m.)	Pot Size (At Installation)	<b>Quantity</b> (*Proposed Trees Only)	Canopy Shape (Trees)
Trees							
Road & (	Carpark Tree Planting						
	Lophostemon confertus	Brush Box	25	10	45L	52	Open/Irregular
Pedestri	an Boulevard Tree Planting						
	Pyrus ussuriensis	Manchurian Pear	9	7	75L	39	Dense/Rounded
Feature <sup>1</sup>	Tree Planting						
	Fraxinus oxycarpa 'Raywoodii'	Claret Ash	10	8	75L	4	Layered/Spreadin
Swift Pa	rrot Habitat Tree						
	Eucalyptus pilularis	Blackbutt	30	20	200L	2	Open/Irregular
	Eucalyptus robusta	Swamp Mahognay	12	10	200L	18	Open/Irregular
Canopy	Endemic Tree						
01	Angophora costata	Smooth-barked Apple	15 - 25	15	150L	8	Open/Round
	Corymbia gummifera	Red Bloodwood	30	10	200L	2	Open/Irregular
	Corymbia maculata 'Variegata'	Spotted Gum	30	10	300L	6	Open/Irregular
02	Glochidion ferdinandi	Cheese Tree	8	6	45L	3	Broad/Shrubby
	Livistona australis	Cabbage Tree Palm	25	6	45L	2	Fountain
	Eucalyptus piperita	Sydney Peppermint	20	10	200L	3	Open/Irregular
	Eucalyptus punctata	Grey Gum	15	10	200L	3	Open/Irregular
03	Melaleuca quinquenervia	Broad-leaf Paperbark	15	7	45L	2	Open/Oval
Screen E	Endemic Tree						
	Allocasuarina littoralis	Black She-oak	10	4	200L	28	Open/Oval
	Casuarina glauca	Swamp She-oak	8	6	200L	21	Open/Oval
Small Ev	vergreen Tree						
04	Acacia longifolia	Sydney Golden Wattle	4	2	45L	7	Spreading/Layere
	Backhousia citriodora	Lemon Scented Myrtle	5-10	2-5	45L	10	Pyramidal/Layere
05	Callistemon salignus	Willow Bottlebrush	6	1-5	45L	12	Oval
	Corymbia eximia 'Nana'	Dwarf Yellow Bloodwood	7	6	45L	12	Weeping/Vase
	Cupaniopsis anacardioides	Tuckeroo	7	5	45L	8	Vase/Layered
	Melaleuca linariifolia	Snow in Summer	10	5	45L	10	Round
Γree Pla	nting on Suspended Slab						
06	Acer x freemanii 'Jeffersred'	Autumn Blaze	10	8	75L	7	Pyramidal
07	Elaeocarpus reticulatus	Blueberry Ash	10	5	45L	10	Columar/Pyramid
	'Cascade'	Lilly Pilly Cascade	3	2	45L	4	Weeping
08	Lagerstroemia indica x L. fauriei	Crepe Myrtle Luscious Water Gum	5	3-4	75L 45L	8	Vase Columar/Pyramid
10	Tristaniopsis 'Luscious'	Luscious Water Gum	8	5	40L	8	Columat/Fyramid
Shrubs	on Ohanka i 4 San						
Iall Scre	een Shrubs > 1.5m  Acmena smithii 'Sublime'	Sublime Lilly Pilly	5	2.5	300mm		
			-				

Harpin Banksia

Gymea Lily

Orange Jasmine

Dense Fence

Raphiolepis indica 'Cosmic White' Cosmic White India Hawtorn 2 1.5 300mm


Tantoon

Large Leaf Hop Bush 3

Callistemon viminalis 'Red Alert' Red Alert Bottlebrush

Image	Botanical Name	Common Name	Mature Height (m.)	Mature Spread (m.)	Pot Size (At Installation)	Quantity (*Proposed Trees Only)	Canopy Shape (Trees)
Shrubs <	1.5m						
10	Banksia oblongifolia	Fern-leaved Banksia	1	1	200mm		
	Breynia oblongifolia	Coffee Bush	2	2	200mm		
	Callistemon 'Better John'	Better John Bottlebrush	1.2	0.9	200mm		
	Callistemon salignus	White Bottlebrush	8	4	200mm		
12	Lambertia formosa	Mountain Devil	1.5	1.5	300mm		
12	Leucospermum cordifolium 'Scarlet	Woditalii Devii	1.5	1.5	300111111		
13	Ribbon'	Scarlet Ribbon	2	1.5	300mm		
11	Westringia fruiticosa 'Zena'	Westringia 'Zena'	1.2	1.2	200mm		
Groundco	overs						
	nted Groundcovers						
14	Alternanthera dentata 'Little Ruby'	Littly Ruby	0.5	0.5	140mm		
15	Convolvulus cneorum	Silver Bush	0.5	1	140mm		
10	Dianella caerulea	Blue flax-lily	0.8	1	140mm		
16	Dichondra repens	Kidney Weed	0.1	1.5	100mm		
10	Grevillea 'Bronze Rambler'	Bronze Rambler Grevillea	0.4	4	140mm		
	Grevillea juniperina 'Gold Cluster'	Gold Cluster Spider Flower	0.3	0.7	140mm		
	Isolepis nodosa	Knobbly Clubrush	1	0.5	140mm		
	Juncus usitatus	Tussock Rush	1	0.3	140mm		
	Liriope muscari 'Isabella'	Isabella Fine Leaf Liriope	0.4	0.5	140mm		
	Liriope muscari 'Just Right'	Just Right Liriope	0.5	0.5	140mm		
	Lomandra longifolia	Mat Rush	1	1	140mm		
	Lomandra 'Tanika'	Fine Leaf Lomandra	0.5	0.6	140mm		
	Myoporum parvifolum Ýareena'	Yareena Creeping Boobialla	0.1	1	140mm		
	Neomarica gracilis	Walking Iris	0.5	0.5	140mm		
	Poa labillardieri 'Eskdale'	Green Tussock Grass	0.6	0.5	140mm		
	Poa labillardieri 'Kingsdale'	Blue Tussock Grass	0.45	0.45	140mm		
	Westringia 'Mundi'	Westringia 'Mundi'	0.6	1.5	140mm		
	Pennisetum alopecurodies	Fine Leaf Varigated Sw.	0.0	1.0	140111111		
	'Pennstripe'	Foxtail	0.45	0.45	140mm		
	Themeda australis	Kangaroo Grass	0.8	0.3	140mm		
Basin Pla	nting						
	Baumea juncea	Bare Twig Rush	1	1	140mm		
	Blechnum camfieldii	Water Fern	1.5	1	140mm		
	Carex appressa	Tall Sedge	1	1	140mm		
	Gahnia clarkei	Tall Saw Sedge	2.5	2	140mm		
I ow Bord	ler Planting						
_00 0	Chrysocephalum apiculatum 'Desert						
	Flame'	Yellow Buttons	0.5	0.3	140mm		
	Lomandra confertifolia 'Wingarra'	Lomandra Wingarra	0.4	0.6	140mm		
	Viola hederacea	Native Violet	0.1	0.3	140mm		
Cascadin	g Planting						
	Casuarina glauca 'Cousin It'	Cousin It	0.3	1	140mm		
	Rosmarinus officinalis 'Blue Lagoon'	Blue Lagoon Rosemary	0.3	1	140mm		

Image	Botanical Name	Common Name	Mature Height (m.)	Mature Spread (m.)	Pot Size (At Installation
Shade To	elerant Planting				
	Adiantum aethiopicum	Maidenhair Fern			
	Asplenium australasicum	Birds Nest Fern	1	1	140mm
	Calochlaena dubia	Bracken Fern	1	1	140mm
	Centella asiatica	Gotu Kola	.2	1	140mm
	Doodia aspera	Rasp Fern	0.4	0.6	140mm
	Macrozamia communis	Burrawang	1	1.5	140mm
	Philodendron 'Xanadu'	Xanadu Dwarf Philodendron	8.0	0.8	140mm
Climbers					
	Cissus antartica	Kangaroo Vine	6		140mm
	Glycine clandestina	Twining Glycine	1.5		140mm
	Hardenbergia violacea 'Meema'	Meema Snake Vine	0.5	2	140mm
	Morinda jasminoides	Sweet Morinda	3		140mm
	Pyrostegia venusta	Orange Trumpet Vine	10		140mm
Flowering	g Perennials & Sensory Plants				
	Aster sp.	Daisy	0.4	0.3	140mm
	Impatiens balsamina	Busy Lizzie	0.5	0.6	140mm
	Melissa officinalis	Lemon Balm	0.6	0.6	140mm
	Lavender officinialis	English Lavender	1.2	1	140mm
	Salvia officinalis Varieties	Common Sage Varieties	0.3	0.3	140mm
	Stachys byzantina	Lambs Ears	0.3	0.9	140mm

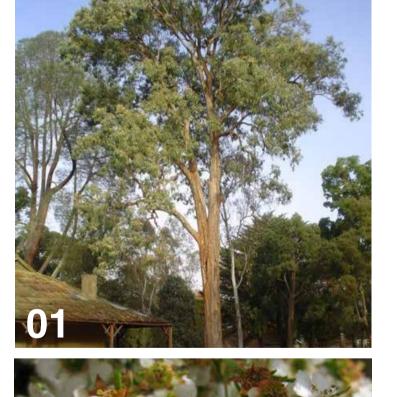

Banksia spinulosa

Dodonaea triquetra

Doryanthes excelsa

Murraya paniculata

Leptospermum polygalifolium

Syzigium australe 'Pinnacle'

Viburnum odaratissimum



300mm

2.5 300mm

2 1.5 300mm

3 1.5 300mm

2.5 2 300mm

2-4 2-3

Pinnacle Narrow Lilly Pilly 7.5 1.5 300mm












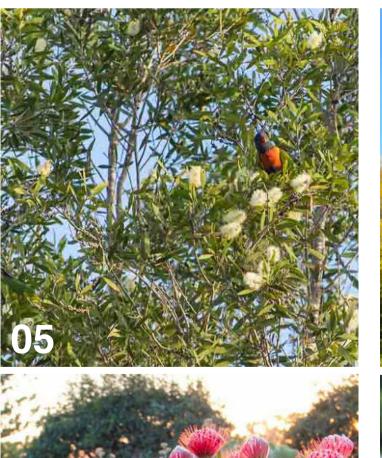



















UNITING NAREEN GARDENS
BIAS AVENUE, BATEAU BAY NSW

DRAWING NAME

PLANT SCHEDULE - GENERAL

CLIENT UNITING
PROJECT NO 18128
DRAWING NO L114
SCALE N/A


REVISION EE

DATE 13.09.22








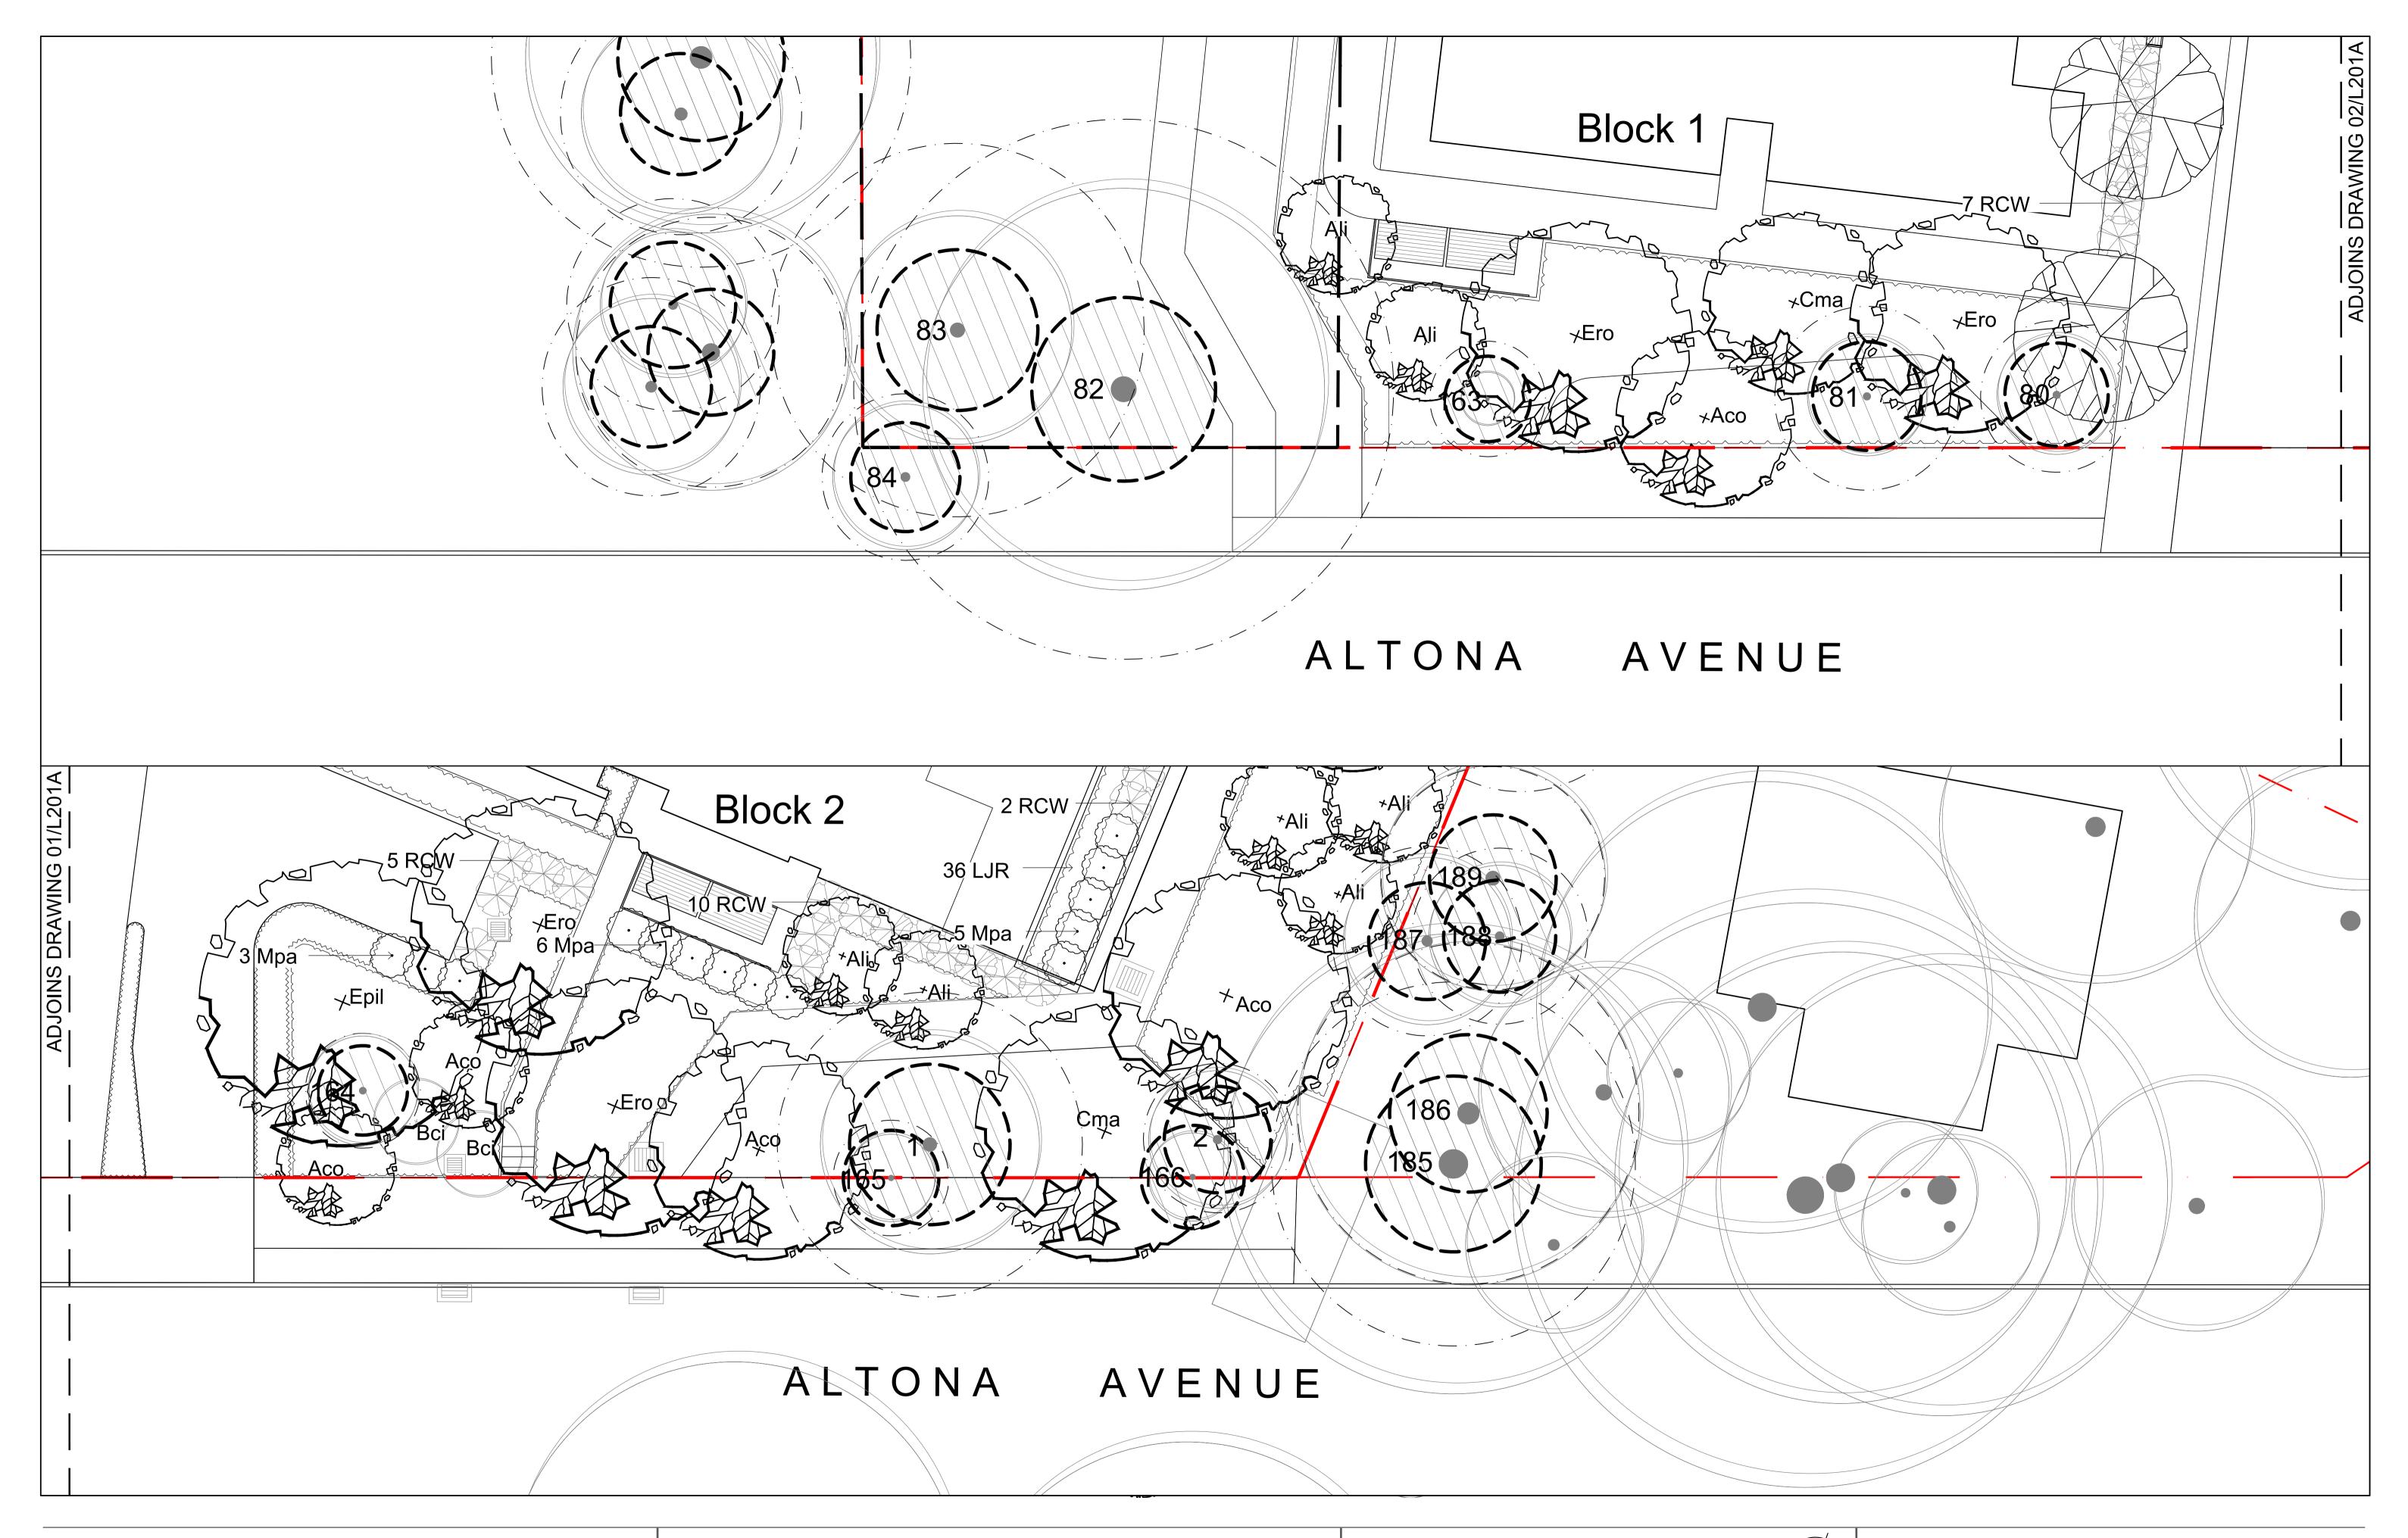



**SCALE** 1:100 @ A1

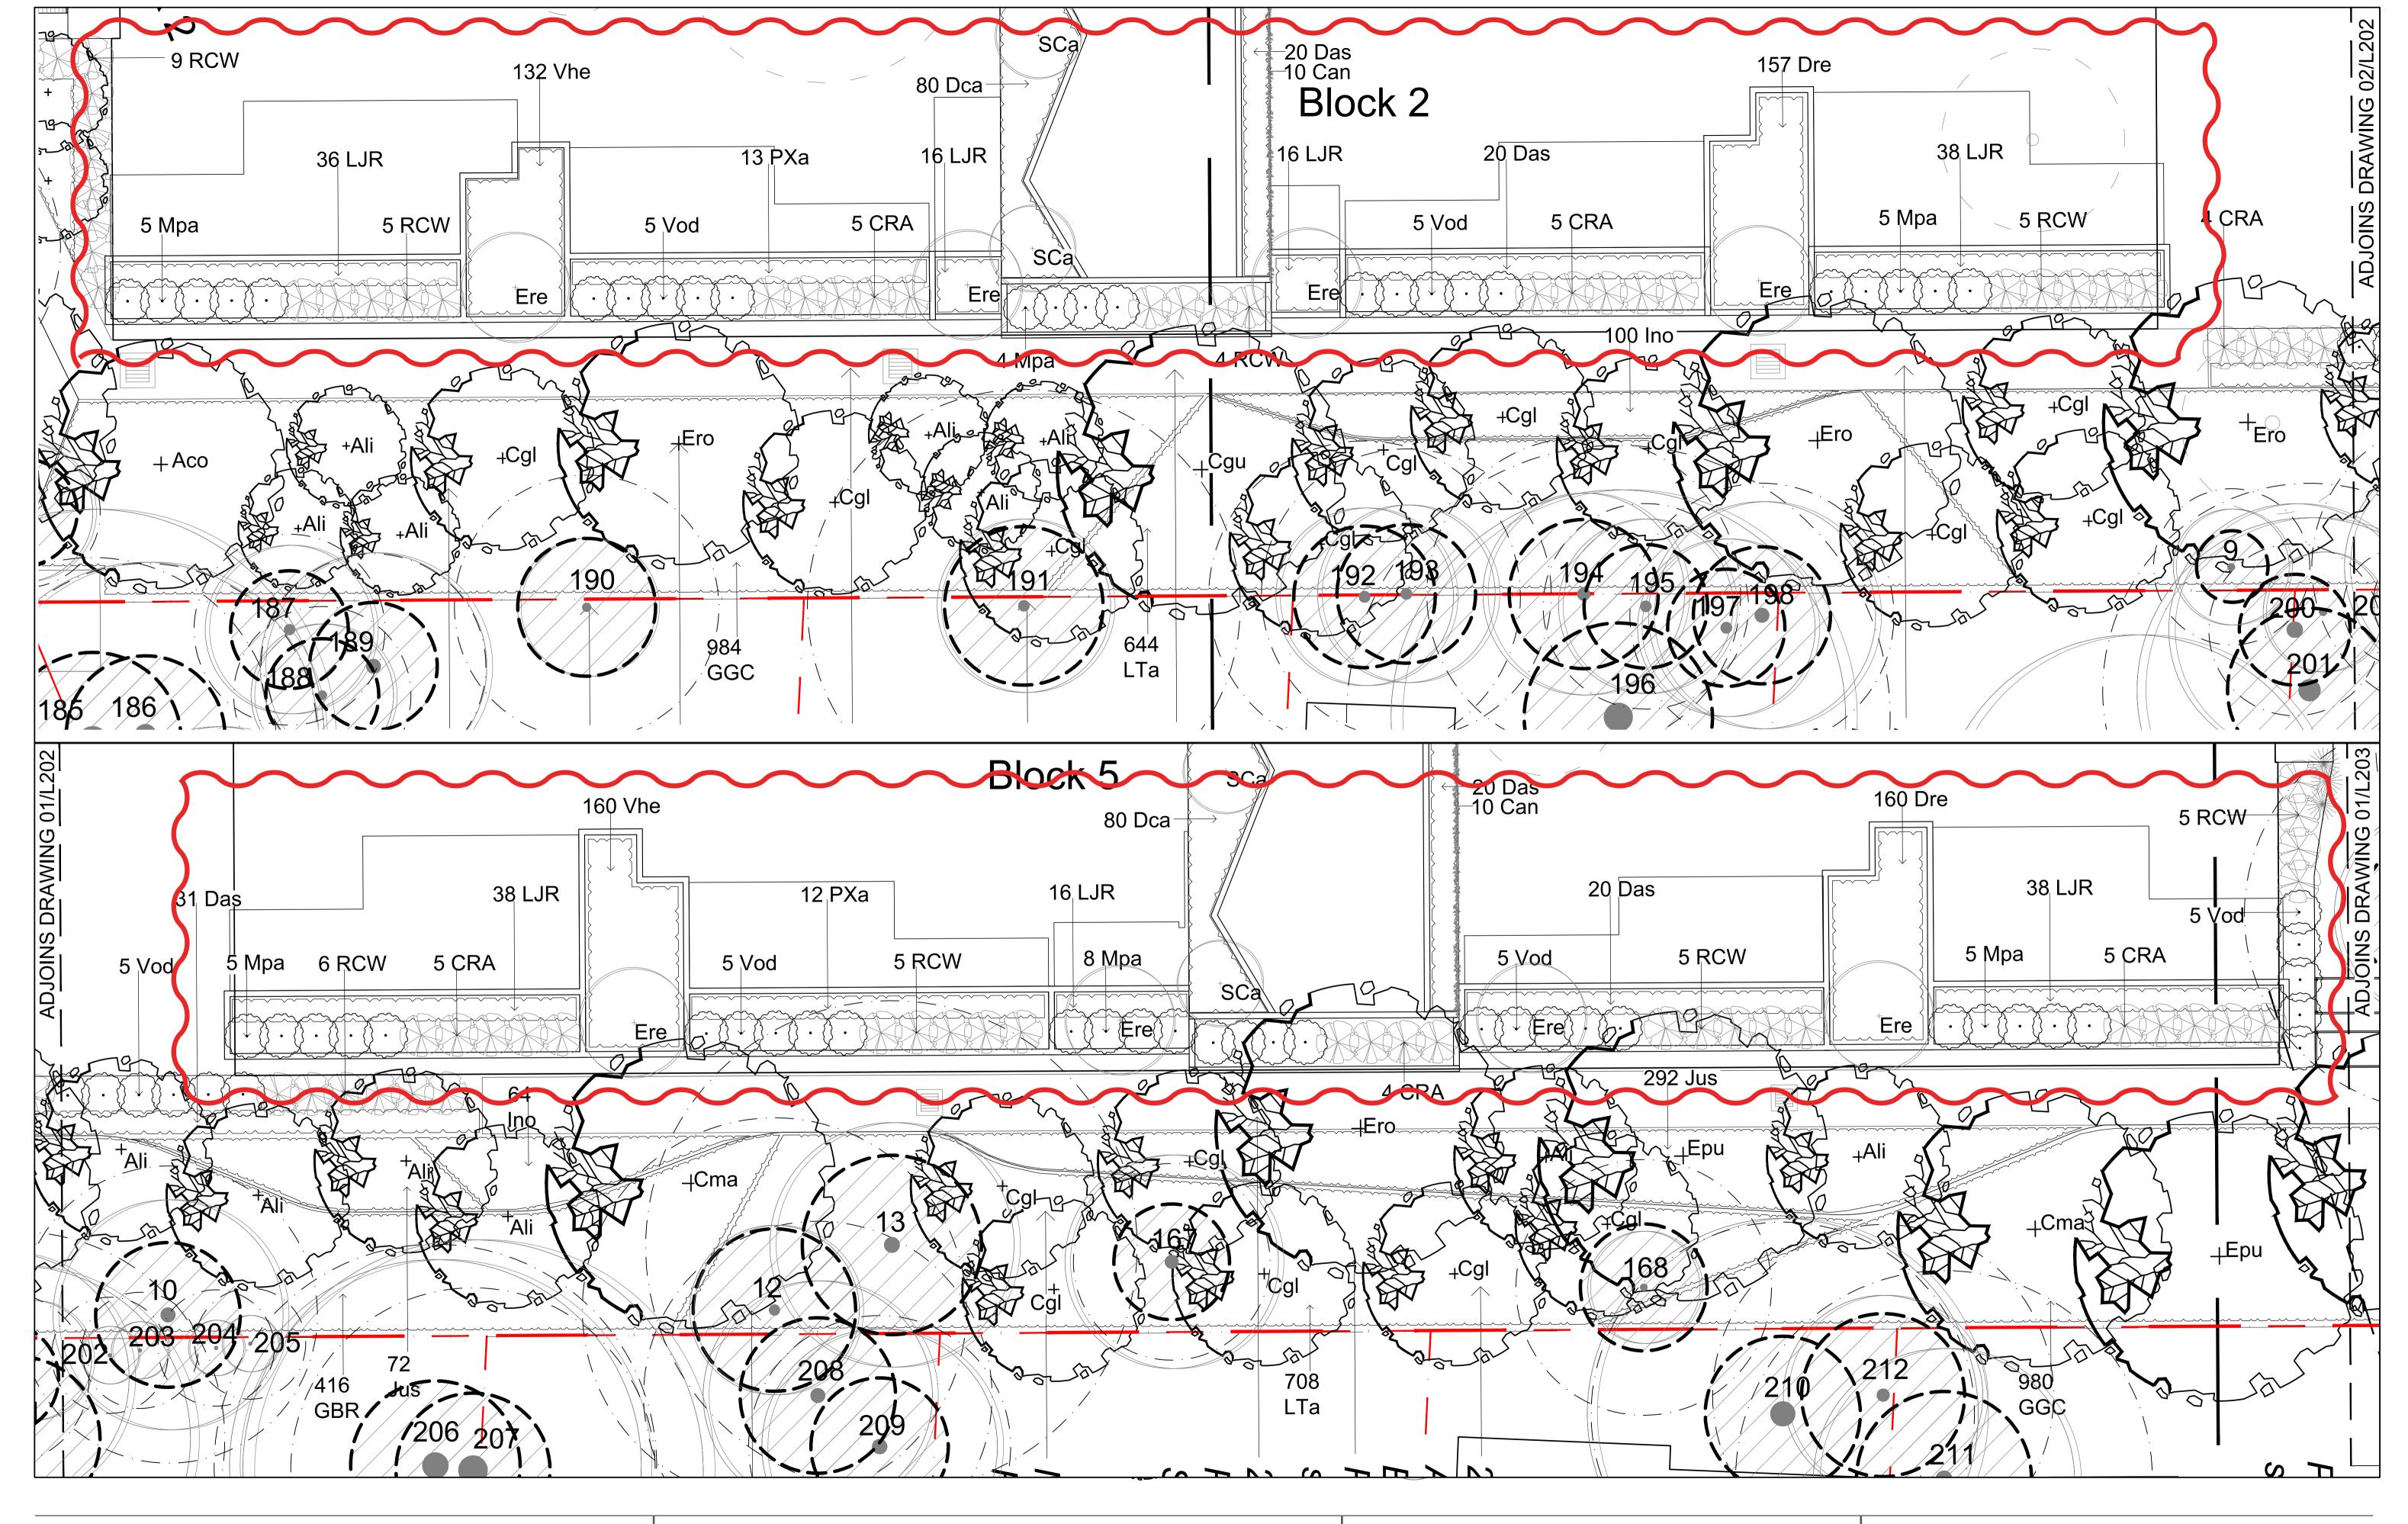



**SCALE** 1:100 @ A1



xeriscapes



UNITING NAREEN GARDENS
BIAS AVENUE, BATEAU BAY NSW

DRAWING NAME

CLIENT UNITING
PROJECT NO 18128
DRAWING NO L203

**SCALE** 1:100 @ A1

REVISION EE

DATE 13.09.22

Key	Botanic Name	Common Name	MatureHeight (m)	Mature Spread	Minimum Pot Size (Install.)	Height (m) Install.	Spread (m) Install.	Calliper Install.	Canopy Shape (Trees)	Quantity	Spacing
Trees											
Aco	Angophora costata	Smooth-barked Apple	15	12	150L	3.0	1.6	50mm	Open/Round	7	As Shown
Ali	Allocasuarina littoralis	Black She-oak	10	4	200L	3.5	1.8	55mm	Pyramidal/Open	20	As Showr
Bci	Backhousia citriodora	Lemon Scented Myrtle	6	4	150L	3.0	1.6	50mm	Pyramidal/Layered	3	As Showr
Cgl	Casuarina glauca	Swamp She-oak	8	6	200L	3.5	1.8	55mm	Columnar/Weeping	17	As Showr
Cgu	Corymbia gummifera	Red Bloodwood	30	10	200L	3.5	1.8	55mm	Open/Irregular	2	As Showr
Cma	Corymbia maculata 'Variegata'	Spotted Gum	30	10	300L	4.2	2.2	65mm	Open/Irregular	6	As Showr
Epi	Eucalyptus piperita	Sydney Peppermint	20	10	200L	3.5	1.8	55mm	Open/Irregular	1	As Showr
Epil	Eucalyptus pilularis	Blackbutt	30	20	200L	3.5	1.8	55mm	Open/Irregular	1	As Showr
Epu	Eucalyptus punctata	Grey Gum	15	10	200L	3.5	1.8	55mm	Open/Irregular	3	As Showr
Ere	Elaeocarpus reticulatus	Blueberry Ash	10	5	150L	3.0	1.6	50mm	Columnar/Pyramidal	4	As Showr
Ero	Eucalyptus robusta	Swamp Mahogany	12	10	200L	3.5	1.8	55mm	Open/Irregular	13	As Showr
	Denotes Trees as per AS2303 (2018) 75th percentile). Estimates shown are AS2303-2018 Tree Supply for Lands	e on the 50th Percentile Size Ind	ex and is subject to	•							
Shrubs	<u> </u>										
CBA	Callistemon viminalis 'Red Alert'	Red Alert Bottlebrush	2.4	2	300mm					49	As Show

				per	ce			
Shrubs								
CRA	Callistemon viminalis 'Red Alert'	Red Alert Bottlebrush	2.4	2	300mm		49	As Show
Мра	Murraya paniculata	Orange Jasmine	3	1.5	300mm		54	As Show
Vod	Viburnum odaratissimum	Dense Fence	2.5	2	300mm		41	As Show
RCW	Raphiolepis indica 'Cosmic White'	Cosmic White India Hawtorn	2	1.5	300mm		68	As Show
Ground	lcovers							
Das	Doodia aspera	Rasp Fern	0.4	0.6	140mm		71	2/m2
Dre	Dichondra repens	Kidney Weed	0.1	0.5	140mm		317	8/m2
GBR	Grevillea 'Bronze Rambler'	Bronze Rambler Grevillea	0.4	4	140mm		416	2/m2
GGC	Grevillea juniperina 'Gold Cluster'	Gold Cluster Spider Flower	0.3	0.7	140mm		1964	4/m2
Ino	Isolepis nodosa	Knobbly Clubrush	1	0.5	140mm		440	4/m2
Jus	Juncus usitatus	Tussock Rush	1	0.3	140mm		364	4/m2
LJR	Liriope muscari 'Just Right'	Just Right Liriope	0.5	0.5	140mm		238	4/m2
LTa	Lomandra 'Tanika'	Fine Leaf Lomandra	0.5	0.6	140mm		1352	4/m2
Pes	Poa labillardieri 'Eskdale'	Green Tussock Grass	0.6	0.5	140mm		70	4/m2
Pki	Poa labillardieri 'Kingsdale'	Blue Tussock Grass	0.45	0.45	140mm		70	4/m2
PPe	Pennisetum alopecurodies 'Pennstripe'	Fine Leaf Varigated Sw. Foxtail	0.45	0.45	140mm		446	4/m2
PXa	Philodendron 'Xanadu'	Xanadu Dwarf Philodendron	0.8	0.8	140mm		25	2/m2
Tau	Themeda australis	Kangaroo Grass	0.8	0.3	140mm		446	4/m2
Vhe	Viola hederacea	Native Violet	0.1	0.3	140mm		292	8/m2

