


# SummitCare Monterey

NCC 2019 Section J  
DTS Compliance Report

**Project No:** SYD1462  
**Date:** 15 September 2021  
**Revision:** 03

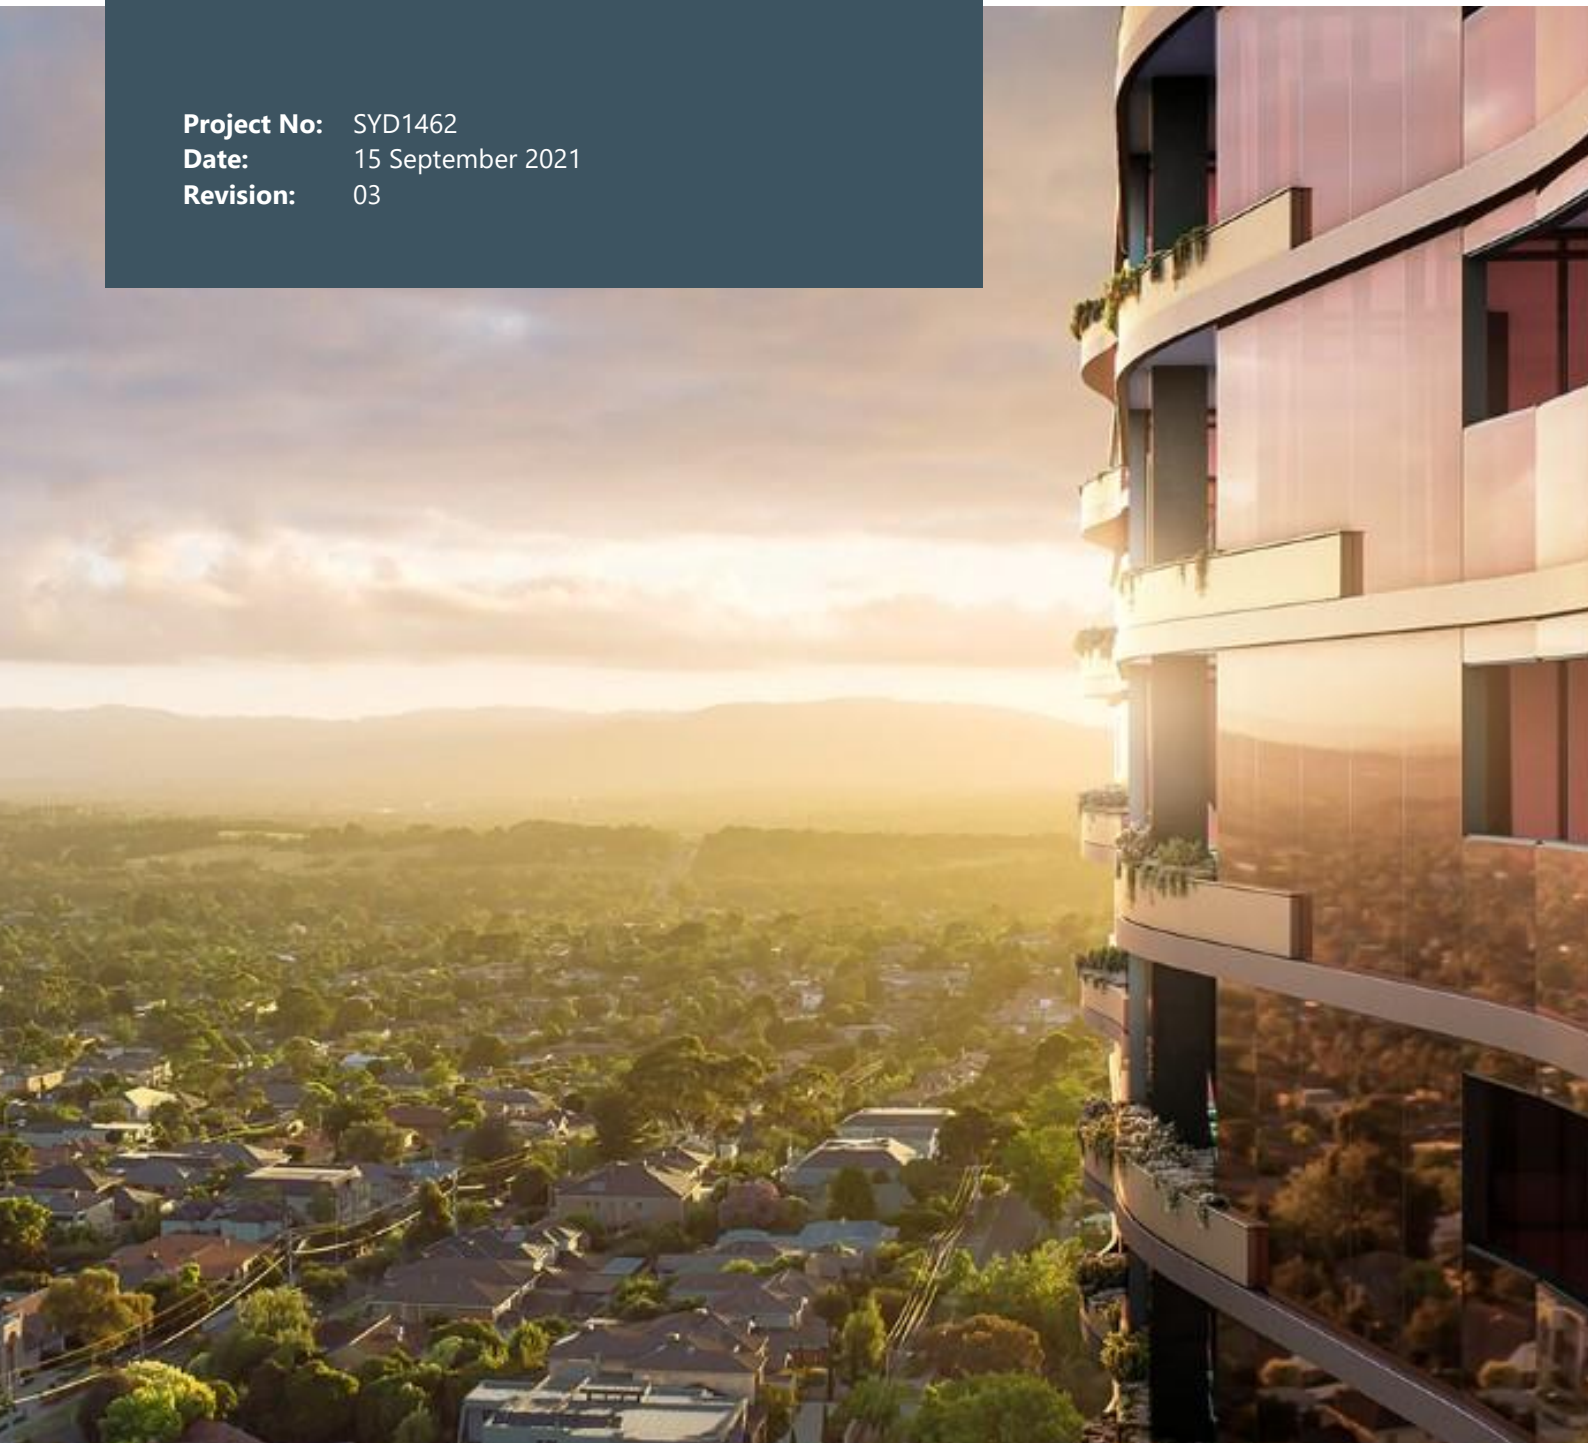

**Project:** SummitCare Monterey

**Location:** 119 Barton Street  
Monterey, NSW 2217

**Prepared by:** ADP Consulting Pty Ltd  
Level 3, 8 Spring Street  
Sydney NSW 2000

**Project No:** SYD1462

**Revision:** 03

**Date:** 15 September 2021

Rev	Date	Comment	Author	Technical Review	Authorisation
01	06/11/2020	DA Issue	KS	BBO	RR
02	09/12/2020	DA Issue updated drawings	KS	BBO	RR
03	15/09/2021	DA Re-issue updated drawings	KS	BBO	RR

### Project Team

**Client / Principal** SummitCare

**Architect** Boffa Robertson Group



# Contents

<b>Executive Summary</b>	<b>3</b>
<b>1. Introduction</b>	<b>5</b>
1.1 Project Background	5
1.2 Site Context	5
1.3 Assessment Assumptions and References	5
<b>2. Section J DTS Compliance</b>	<b>6</b>
2.1 Overview	6
2.2 Terminology	6
<b>3. Part J1 Building Fabric</b>	<b>7</b>
3.1 Responsible Designer	7
3.2 Summary of Requirements	7
3.3 J1.1 Application of Part	7
3.4 J1.2 Thermal Construction Installations	7
3.5 J1.3 Roof & Ceiling Constructions	8
3.6 J1.4 Roof lights	8
3.7 J1.5 Wall-Glazing Construction System	8
3.8 J1.6 Floors	9
<b>4. Part J3 Building Sealing</b>	<b>10</b>
4.1 Building Fabric	10
<b>5. Conclusions &amp; Recommendations</b>	<b>11</b>

# Executive Summary

ADP Consulting has been engaged to undertake the following Section J report detailing the Deemed-to-Satisfy (DTS) Wall-Glazing performance requirements for the proposed SummitCare development to be located at 119 Barton Street, Monterey NSW.

This Section J report has been prepared to support the DA submission as a legislative requirement in accordance with NCC Section J 2019 provisions and has been provided to advise on the minimum Part J1 & J3 (Building Fabric) requirements needed for compliance.

Based on a review of the proposed updated Architectural drawings and the DTS calculations carried out in this report the following minimum Part J1 performance requirements have been provided.

Fabric insulation to be provided as follows:

Envelope Construction	Total System R-Value (m <sup>2</sup> K/W)
<b>J1.3</b> Roof and ceiling construction (Roof absorptance $\leq 0.45$ )	$\geq 3.70$
<b>J1.4</b> Roof lights	Not Applicable
<b>J1.5a</b> External wall construction (Wall area less than 80%)	$\geq 1.00$
<b>J1.5a</b> External wall construction (Wall area more than 80%)	$\geq 1.40$
<b>J1.5b</b> Internal wall construction (between conditioned & unconditioned areas)	$\geq 1.40$
<b>J1.6a</b> Floor construction (above an unconditioned zone)	$\geq 2.00$
<b>J1.6b</b> Floor construction (concrete slab on ground)	$\geq 2.00$

Glazing performance has been assessed as per the Section J wall-glazing calculator. The following performance is to be provided for the relevant orientations outlined below:

Glazing – Frame Construction (Uniform solution)	Orientation	Total System U-Value (W/m <sup>2</sup> K)	Total System SHGC
Total Window Frame construction	All facades	$\leq 3.70$	$\leq 0.29$

**Please Note:** the above window frame construction values are AFRC total system values and include both the glazing and frame.



Please note the following:

- > It is assumed that all other NCC Section J requirements (J5 to J8) will be designed to meet the minimum Deem-to-Satisfy (DTS) requirements
- > Compliance is subject to confirmation from the D&C contractor that all as-installed details pertaining to the thermal performance are within the performance requirements as detailed in this report. It is the responsibility of the D&C contractor, architect and building surveyor to ensure all final construction selections are compliant
- > Any changes to the architecture plans may result in a change to the wall-glazing performance specifications detailed in this report

# 1. Introduction

## 1.1 Project Background

ADP Consulting has been engaged by SummitCare to undertake the following Section J report detailing Deemed-to-Satisfy (DTS) wall-glazing performance requirements for the proposed development to be located at 119 Barton Street, Monterey NSW.

The purpose of this report is to demonstrate that all proposed construction elements meet the minimum DTS requirements outlined in the NCC 2019 Section J, Part J1 & J3 provisions.

## 1.2 Site Context

The new development comprises of a three-storey building proposed to be located in Monterey, south of Sydney. The proposed development is to be situated to the east of Scarborough Park and west of Botany Bay.

Figure 1 Proposed Development Site Plan



## 1.3 Assessment Assumptions and References

This Section J Report has been based on the following documents:

- > Provided by Boffa Robertson Architects:
  - Architectural Development application Reissue – (25/08/2021)

This report should be read in conjunction with all the relevant plans and specifications, and any supplementary regulatory information as nominated further within the body of this report.

## 2. Section J DTS Compliance

### 2.1 Overview

Section J of the NCC was introduced to set minimum energy efficiency measures for the various classifications of building types while still maintaining acceptable internal environmental conditions for occupants. The measures were designed to reduce the use of artificial heating and cooling, improve the energy performance of lighting, conditioning, and ventilation, and reduce energy loss through air leakage.

These reductions are achieved by setting specific prescriptive design criteria for the building fabric (section J1 & J3) and the building services (section J5 to J8). Compliance is the achieved when these minimum prescriptive requirements are met.

### 2.2 Terminology

#### 2.2.1 Thermal Performance of a Wall-Glazing Construction

When determining an appropriate wall-glazing construction for a building project, the building's thermal envelope will be required to comply with certain performance values for energy efficiency and occupant thermal comfort. The two heat transfer mechanisms that determine the performance of a wall-glazing construction include conduction and solar heat gain.

In order to comply with the Section J provisions, the wall-glazing system must achieve a specified U-value and Solar Heat Gain coefficient (SHGC). It is important to note, that these values are to be read as "total system values" and are inclusive of both the frame and glazing<sup>1</sup>.

#### 2.2.2 U-Value

U-value is the measure of a wall-glazing constructions ability to conduct heat. The lower the U-value, the greater the insulation properties of the construction. In all cases regardless of climate zone, a façade construction with high performance insulation properties will assist with improving a buildings occupant thermal comfort and energy efficiency. It is also to be noted that the conductive U-value is equal to the inverse of insulative R-value ( $U = 1/R$ ).

#### 2.2.3 R-Value

R-value is the measure of a wall-glazing constructions resistance to heat flow. The higher the R-value, the higher the level of insulation and thermal performance. It is also to be noted that the insulative R-value is equal to the inverse of the conductive U-value ( $R = 1/U$ ).

#### 2.2.4 Solar Heat Gain Coefficient (SHGC)

Solar Heat Gain Coefficient (SHGC) is the fraction of incident solar radiation admitted through a window. In a warm climate, windows which have a low SHGC allow less solar radiation to pass through. This reduces the buildings heat load and need for active cooling<sup>2</sup>.

---

<sup>1</sup> Thermal Performance values are available for all aluminium window and door products as part of their WERS rating (<http://www.wers.net/wers-home>).

<sup>2</sup> Further information on glazing performance can be found at (<https://www.yourhome.gov.au/passive-design/glazing>)

## 3. Part J1 Building Fabric

### 3.1 Responsible Designer

For the purposes of Part J1 – Building Fabric Compliance, the responsible designers are identified as the project Architect and Façade Engineer (where applicable). The minimum insulation and glazing recommendations outlined in this report must be addressed for construction.

It is assumed that all other NCC Section J requirements (J5 to J8) will be designed to meet the minimum Deem-to-Satisfy (DTS) requirements and will be the responsibility of the D&C contractor, services sub-contractors and building surveyor to ensure the final construction incorporates a compliant solution.

### 3.2 Summary of Requirements

Part J1 establishes minimum construction and performance provisions required for the projects specific climate zone and building classification. This will apply to the following Part J1 criteria:

- > J1.2 Thermal construction installations
- > J1.3 Roof and ceiling construction
- > J1.4 Roof lights
- > J1.5 Combined wall & glazing system
- > J1.6 Floor constructions

Insulation and glazing performance requirements have been provided to meet the minimum compliance measures for the above areas.

### 3.3 J1.1 Application of Part

Section J 2019, Part J1 is applicable to the scope of construction works identified for the project. The proposed works consist of the development of a new three-storey aged care facility.

This report is intended to provide an analysis of the building elements forming the envelope of the development as required under Part J1 and will demonstrate compliance using the NCC 2019 Wall-Glazing calculator shown in (Figure 2).

### 3.4 J1.2 Thermal Construction Installations

All insulation installed for the project must comply with section J1.2 of the BCA. Please note that for the purpose of this report, the following provisions only apply to new constructions. All Installed insulation must adhere to the following requirements:

- > Form a continuous barrier with ceilings, walls bulkheads, floors or similar that inherently contribute to the building's thermal envelope
- > Abut or overlaps all adjoining insulation other than insulation located at supporting members such as studs, noggings, furring channels or similar
- > It is important that the insulation provided must not hinder the safe or effective operation of any service or fittings
- > All insulation must comply with AS4859.1.

Specific installation requirements further referring to bulk or reflective insulation are outlined in Part J1.2 of the NCC 2019 Section J provisions.

### 3.5 J1.3 Roof & Ceiling Constructions

Roofs or ceilings must achieve a minimum total R-value greater than or equal to R3.7 for a downward direction of heat flow. The solar absorptance of the upper surface of the roof must not be more than 0.45.

### 3.6 J1.4 Roof lights

There are no roof lights designed in this project. No compliance applicable.

### 3.7 J1.5 Wall-Glazing Construction System

Part J1.5 establishes the minimum external wall and window construction performance required for the proposed building. This is assessed against the projects location and climate as per the Australian Building Codes Board (ABCB) Climate Zone Map (Figure 3).

- > The development is situated in climate zone 5 – warm temperate.
- > The building classification is Class 9c - Aged care building (dining, café and other areas of minor floor area in support of the main function are deemed to be categorised under the same class)

Compliance for each wall orientation is identified as the Total System U-Value of the wall-glazing construction and is determined through the use of the NCC Section J 2019 Wall-Glazing Calculator (Figure 2). Section J1.5 (a)(ii)(B) stipulates that the Total System U-value of the wall-glazing construction should not exceed a maximum value of 2.0.

Figure 2 NCC 2019 Wall-Glazing Calculator

**Façade (beta)**  
General information

Calculator

**General Information**

Name	Khyati Saxena
Position	Sustainability Consultant
Company	ADP Consulting
Building Name / Address	Summitcare Monterey, 119 Barton Street Monterey, NSW 2217
Building State	NSW
Building Classification	Class 9c - aged care building
Climate Zone	Climate Zone 5 - Warm temperate
Stores Above Ground	3


**IMPORTANT NOTICE AND DISCLAIMER IN RESPECT OF THIS CALCULATOR**

By accessing or using this calculator, you agree to the following: While care has been taken in the preparation of this calculator, it may not be complete or up-to-date. You can ensure that you are using a complete and up-to-date version by checking the Australian Building Codes Board website (www.abcb.gov.au). The Australian Building Codes Board, the Commonwealth of Australia and States and Territories of Australia do not accept any liability, including liability for negligence, for any loss (recoverable, damages, injury, expense or cost) incurred by any person as a result of accessing, using or relying upon this calculator, to the maximum extent permitted by law. No representation or warranty is made or given as to the currency, accuracy, reliability, reasonableness, fitness, safety, purpose or completeness of this calculator, or any information which may appear on any third website, or in other third party sources, and all such representations and warranties are excluded to the extent permitted by law. This calculator is not legal or professional advice. Persons may upon this calculator entirely at their own risk and must take responsibility for assessing the relevance and accuracy of the information in relation to their particular circumstances.

© Commonwealth of Australia and the States and Territories of Australia 2019, published by the Australian Building Codes Board.

The material in this calculator is licensed under a Creative Commons Attribution-NonCommercial-4.0 International licence, with the exception of third party materials and any trade marks. It is provided for general information only and without warranties of any kind. You may not make derivatives of this calculator, but may only use a verbatim copy. More information on this CC BY-NC licence is set out at the Creative Commons Website. For information regarding this calculator, see www.abcb.gov.au.

Figure 3 ABCB Climate Zone

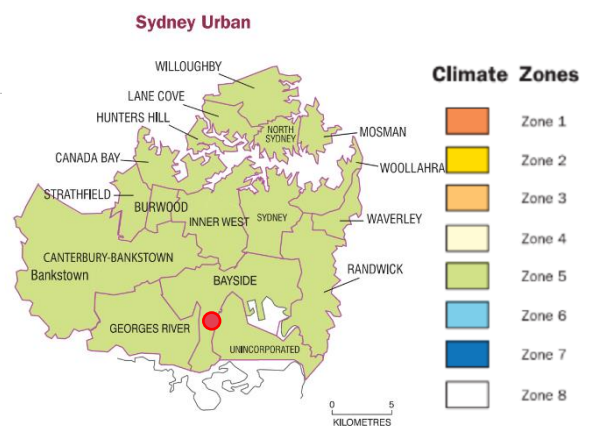

Based on a review of the proposed Architectural drawings, the following minimum Part J1 performance requirements have been provided for the building fabric elements.

Fabric insulation to be provided as follows:

Envelope Construction	Total System R-Value (m <sup>2</sup> K/W)
<b>J1.5a (i)</b> External wall construction (Wall area less than 80%)	≥ 1.00
<b>J1.5a (ii)</b> External wall construction (Wall area more than 80%)	≥ 1.40
<b>J1.5a</b> Total System internal wall construction (between conditioned & unconditioned areas)	≥ 1.40

Glazing performance has been assessed as per the Section J wall-glazing calculator. The following performance is to be provided for the relevant orientations outlined below:

Glazing – Frame Construction (Uniform solution)	Orientation	Total System U-Value (W/m <sup>2</sup> K)	Total System SHGC
Total Window Frame construction	All facades	≤ 3.70	≤ 0.29

**Please Note:** the above window frame construction values are AFRC total system values and include both the glazing and frame.

The maximum solar admittance for the above solution is calculated as a percentage of incident solar irradiance allowed on a wall-glazing construction. Part J1.5b stipulates that the solar admittance for each façade aspect must not exceed a maximum value of 0.13.

### 3.8 J1.6 Floors

Floors must achieve the minimum total R-values specified in the table below:

Envelope Construction	Total System R-Value (m <sup>2</sup> K/W)
<b>J1.6a</b> Floor construction (above an unconditioned zone)	≥ 2.00 (downwards heat flow)
<b>J1.6b</b> Floor construction (concrete slab on ground)	≥ 2.00



## 4. Part J3 Building Sealing

### 4.1 Building Fabric

The building sealing requirements for any new works are as follows:

- > Seals must be fitted to each edge of a door, operable window, or the like
- > An entrance to a building, if leading to a conditioned space must have an airlock, self-closing door, revolving door, or the like.
- > Ceilings, walls, floors, and any opening such as a window frame, door frame, roof light frame or the like must be:
  - constructed to minimise air leakage in accordance with when forming part of the building envelope
  - enclosed by internal lining systems that are close fitting at ceiling, wall, and floor junctions; or:
  - sealed at junctions and penetrations with close fitting architrave, skirting or cornice; or expanding foam, rubber compressible strip, caulking or the like.

## 5. Conclusions & Recommendations

Based on a full review of the Architectural drawings provided by Boffa Robertson Group and the calculations carried out in this report the following minimum Part J1 performance requirements have been provided as detailed in the report.

Glazing performance has been assessed as per the Section J wall-glazing calculator. The following performance is to be provided for the relevant orientations outlined below:

Glazing – Frame Construction (Uniform solution)	Orientation	Total System U-Value (W/m <sup>2</sup> K)	Total System SHGC
Total Window Frame construction	All facades	≤ 3.70	≤ 0.29

**Please Note:** the above window frame construction values are AFRC total system values and include both the glazing and frame.

We understand that the detailed glazing systems may not be a desirable solution for the project. Should the project wish to consider a less stringent uniform glazing system, a JV3 energy modelling solution can be undertaken.

# **Appendix A**

## **DTS Façade-Glazing Report**

### **(Uniform Solution)**

# SummitCare - Monterey

## Uniform Solution - Ground Floor



Façade  
Report



Calculator

### Project Summary

Date  
15/09/2021

Name  
Khyati Saxena

Company  
ADP Consulting

Position  
Sustainability Consultant

Building Name / Address  
Summitcare Monterey  
0

Building State  
NSW

Climate Zone  
Climate Zone 5 - Warm  
temperate

Building Classification  
Class 9c - aged care building


Class 9c - aged care building

Storeys Above Ground  
3

The summary below provides an overview of where compliance has been achieved for Specification J1.5a - Calculation of U-Value and solar admittance - Method 1 (Single Aspect) and Method 2 (Multiple Aspects).

Compliant Solution =  
Non-Compliant Solution =

	North	East	Method 1	South	West	Method 2
Wall-glazing U-Value (W/m <sup>2</sup> .K)	2.06	1.92		1.84	1.93	All 1.93
Solar Admittance	0.11	0.10		0.09	0.10	
AC Energy						251

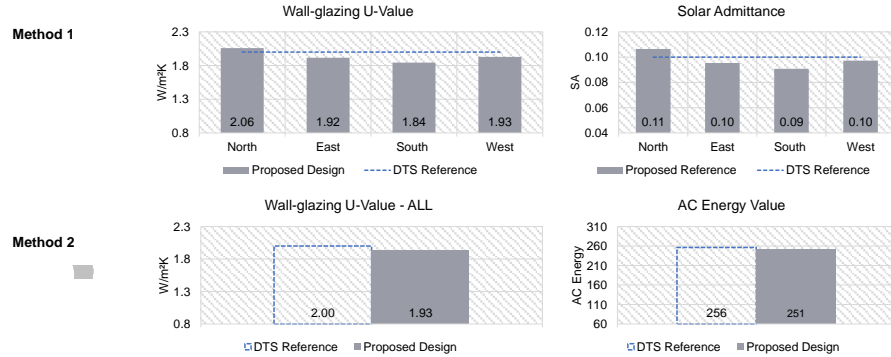

Method of  
compliance

### Project Details

	North	East	South	West
Glazing Area (m <sup>2</sup> )	119.5	179.48	94.01	208.45
Glazing to Façade Ratio	39%	34%	32%	35%
Glazing References	North + SH-08a + SH-47 + SH-32 +	East + SH-08a + SH-03 + SH-130 +	South + SH-03 + SH-08b +	West + SH-08a + SH-03 + SH-130 +
Glazing System Types	0 +	0 +	0 +	0 +
Glass Types	0 +	0 +	0 +	0 +
Frame Types	0 +	0 +	0 +	0 +
Methodology	AFRC (True module size)			
Average Glazing U-Value (W/m <sup>2</sup> .K)	3.70	3.70	3.70	3.70
Average Glazing SHGC	0.29	0.29	0.29	0.29
Shading Systems	Horizontal	Horizontal	Horizontal	Horizontal
Wall Area (m <sup>2</sup> )	183.7	345.9	204.14	393.7
Wall Types	Wall +	Wall +	Wall +	Wall +
Methodology	NCC Specification J1.5b			
Wall Construction	Wall <80% +	Wall <80% +	Wall <80% +	Wall <80% +
Wall Thickness	0 +	0 +	0 +	0
Average Wall R-value (m <sup>2</sup> .K/W)	1.01	1.01	1.01	1.01
Solar Absorptance	0.6	0.6	0.6	0.6

DTS Construction  
Values

#### IMPORTANT NOTICE AND DISCLAIMER IN RESPECT OF THIS CALCULATOR

By accessing or using this calculator, you agree to the following: While care has been taken in the preparation of this calculator, it may not be complete or up-to-date. You can ensure that you are using a complete and up-to-date version by checking the Australian Building Codes Board website ([www.abcb.gov.au](http://www.abcb.gov.au)). The Australian Building Codes Board, the Commonwealth of Australia and States and Territories of Australia do not accept any liability, including liability for negligence, for any loss (howsoever caused), damage, injury, expense or cost incurred by any person as a result of accessing, using or relying upon this calculator, to the maximum extent permitted by law. No representation or warranty is made or given as to the currency, accuracy, reliability, merit, suitability, fitness for any purpose or completeness of this calculator or any information which may appear on any linked websites, or in other linked information sources, and all such representations and warranties are excluded to the extent permitted by law. This calculator is not legal or professional advice. Persons rely upon this calculator entirely at their own risk and must take responsibility for assessing the relevance and accuracy of the information in relation to their particular circumstances.



© Commonwealth of Australia and the States and Territories of Australia 2019, published by the Australian Building Codes Board.  
The material in this calculator is licensed under a Creative Commons Attribution-NonCommercial-NoDerivatives 4.0 International licence, with the exception of third party materials and any trade marks. It is provided for general information only and without warranties of any kind. You may not make derivatives of this calculator, but may only use a verbatim copy. More information on this CC BY-NC licence is set out at the Creative Commons Website. For information regarding this calculator, see [www.abcb.gov.au](http://www.abcb.gov.au).

# SummitCare - Monterey

## Uniform Solution - First Floor



Façade  
Report



Calculator

### Project Summary

Date  
15/09/2021

Name  
Khyati Saxena

Company  
ADP Consulting

Position  
Sustainability Consultant

Building Name / Address  
Summitcare Monterey  
0

Building State  
NSW

Climate Zone  
Climate Zone 5 - Warm  
temperate


Building Classification  
Class 9c - aged care building

Storeys Above Ground  
3

The summary below provides an overview of where compliance has been achieved for Specification J1.5a - Calculation of U-Value and solar admittance - Method 1 (Single Aspect) and Method 2 (Multiple Aspects).

Compliant Solution =  
Non-Compliant Solution =

	North	East	Method 1	South	West	Method 2
Wall-glazing U-Value (W/m².K)	1.96	1.91		2.07	2.04	All 1.99
Solar Admittance	0.08	0.09		0.11	0.10	
AC Energy						196

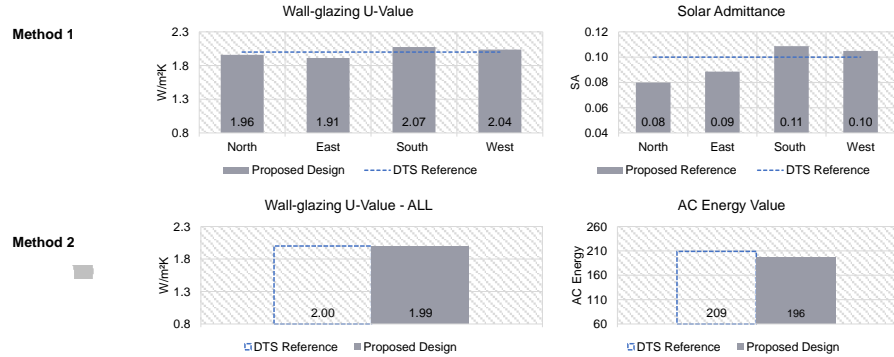

Method of compliance

### Project Details

	North	East	South	West
Glazing Area (m²)	100.955	154.445	93.2	165.77
Glazing to Façade Ratio	36%	34%	40%	39%
Glazing References	SH-08a + SH-08b + WINDOWS + SH-08d + SH-08e + SH-08f + SH-08g + SH-09 +	East + WINDOWS + SH-08d + SH-08e + SH-08f + SH-08g + SH-09 +	South + SH-08a + WINDOWS + SH-08d + SH-08e + SH-08f + SH-08g + SH-09 +	West + SH-08b + WINDOWS + SH-08c + SH-08d + SH-08f + SH-08g + SH-09 +
Glazing System Types	0 +	0 +	0 +	0 +
Glass Types	0 +	0 +	0 +	0 +
Frame Types	0 +	0 +	0 +	0 +
Methodology	AFRC (True module size)			
Average Glazing U-Value (W/m².K)	3.70	3.70	3.70	3.70
Average Glazing SHGC	0.29	0.29	0.29	0.29
Shading Systems	Horizontal	Horizontal	Horizontal	Horizontal
Wall Area (m²)	181.5	299.755	139.6	263.64
Wall Types	Wall +	Wall +	Wall +	Wall +
Methodology	NCC Specification J1.5b			
Wall Construction	Wall <80% +	Wall <80% +	Wall <80% +	Wall <80% +
Wall Thickness	0 +	0 +	0 +	0
Average Wall R-value (m²K/W)	1.01	1.01	1.01	1.01
Solar Absorptance	0.6	0.6	0.6	0.6

DTS Construction Values

#### IMPORTANT NOTICE AND DISCLAIMER IN RESPECT OF THIS CALCULATOR

By accessing or using this calculator, you agree to the following: While care has been taken in the preparation of this calculator, it may not be complete or up-to-date. You can ensure that you are using a complete and up-to-date version by checking the Australian Building Codes Board website (www.abcb.gov.au). The Australian Building Codes Board, the Commonwealth of Australia and States and Territories of Australia do not accept any liability, including liability for negligence, for any loss (howsoever caused), damage, injury, expense or cost incurred by any person as a result of accessing, using or relying upon this calculator, to the maximum extent permitted by law. No representation or warranty is made or given as to the currency, accuracy, reliability, merit, suitability, fitness for any purpose or completeness of this calculator or any information which may appear on any linked websites, or in other linked information sources, and all such representations and warranties are excluded to the extent permitted by law. This calculator is not legal or professional advice. Persons rely upon this calculator entirely at their own risk and must take responsibility for assessing the relevance and accuracy of the information in relation to their particular circumstances.



© Commonwealth of Australia and the States and Territories of Australia 2019, published by the Australian Building Codes Board.  
The material in this calculator is licensed under a Creative Commons Attribution-NonCommercial-NoDerivatives 4.0 International licence, with the exception of third party materials and any trade marks. It is provided for general information only and without warranties of any kind. You may not make derivatives of this calculator, but may only use a verbatim copy. More information on this CC BY-ND licence is set out at the Creative Commons Website. For information regarding this calculator, see www.abcb.gov.au.

# SummitCare - Monterey Uniform Solution - Second Floor



## Façade Report



Calculator

### Project Summary

Date  
15/09/2021

Name  
Khyati Saxena

Company  
ADP Consulting

Position  
Sustainability Consultant

Building Name / Address  
Summitcare Monterey  
0

Building State  
NSW

Climate Zone  
Climate Zone 5 - Warm  
temperate

Building Classification  
Class 9c - aged care building



Storeys Above Ground  
3

The summary below provides an overview of where compliance has been achieved for Specification J1.5a - Calculation of U-Value and solar admittance - Method 1 (Single Aspect) and Method 2 (Multiple Aspects).



Compliant Solution =  
Non-Compliant Solution =

	North	East	Method 1	South	West	Method 2
Wall-glazing U-Value (W/m².K)	1.47	1.79		1.56	1.39	All 1.56
Solar Admittance	0.05	0.08		0.06	0.04	
AC Energy						33

Method 1

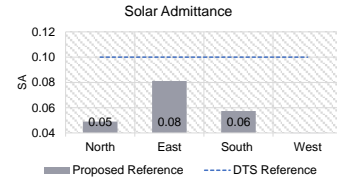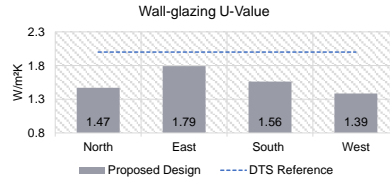

Method 2

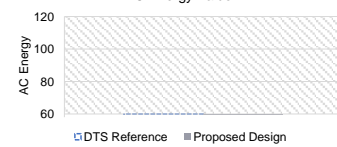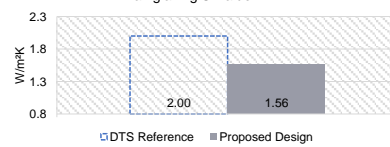

Method of  
compliance

### Project Details

	North	East	South	West
Glazing Area (m²)	22.59	61.97	29.3	30.29
Glazing to Façade Ratio	18%	30%	21%	15%
Glazing References	SH-08a + SH-08b + SH-08c +	SH-08a + SH-08b + SH-08d + SH-08e + BALCONY DOOR +	SH-08d + SH-06 +	SH-08b + SH-08e + BALCONY DOOR +
Glazing System Types	0 +	0 +	0 +	0 +
Glass Types	0 +	0 +	0 +	0 +
Frame Types	0 +	0 +	0 +	0 +
Methodology	AFRC (True module size)			
Average Glazing U-Value (W/m².K)	3.70	3.70	3.70	3.70
Average Glazing SHGC	0.29	0.29	0.29	0.29
Shading Systems	Horizontal	Horizontal	Horizontal	Horizontal
Wall Area (m²)	104.95	147.8	109.58	177.54
Wall Types	Wall +	Wall +	Wall +	Wall +
Methodology	NCC Specification J1.5b			
Wall Construction	Wall <80% +	Wall <80% +	Wall <80% +	Wall <80% +
Wall Thickness	0 +	0 +	0 +	0
Average Wall R-value (m²K/W)	1.01	1.01	1.01	1.01
Solar Absorptance	0.6	0.6	0.6	0.6

DTS Construction  
Values

#### IMPORTANT NOTICE AND DISCLAIMER IN RESPECT OF THIS CALCULATOR

By accessing or using this calculator, you agree to the following: While care has been taken in the preparation of this calculator, it may not be complete or up-to-date. You can ensure that you are using a complete and up-to-date version by checking the Australian Building Codes Board website ([www.abcb.gov.au](http://www.abcb.gov.au)). The Australian Building Codes Board, the Commonwealth of Australia and States and Territories of Australia do not accept any liability, including liability for negligence, for any loss (howsoever caused), damage, injury, expense or cost incurred by any person as a result of accessing, using or relying upon this calculator, to the maximum extent permitted by law. No representation or warranty is made or given as to the currency, accuracy, reliability, merit, suitability, fitness for any purpose or completeness of this calculator or any information which may appear on any linked websites, or in other linked information sources, and all such representations and warranties are excluded to the extent permitted by law. This calculator is not legal or professional advice. Persons rely upon this calculator entirely at their own risk and must take responsibility for assessing the relevance and accuracy of the information in relation to their particular circumstances.



© Commonwealth of Australia and the States and Territories of Australia 2019, published by the Australian Building Codes Board.  
The material in this calculator is licensed under a Creative Commons Attribution-NonCommercial-NoDerivatives 4.0 International licence, with the exception of third party materials and any trade marks. It is provided for general information only and without warranties of any kind. You may not make derivatives of this calculator, but may only use a verbatim copy. More information on this CC BY-NC licence is set out at the Creative Commons Website. For information regarding this calculator, see [www.abcb.gov.au](http://www.abcb.gov.au).



# **Appendix B**




 
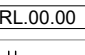

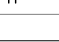

## **Insulation Mark-up**

## Basement floor

### Wall insulation Markup



DEVELOPMENT STATISTICS		
SITE AREA		7,218.7 m <sup>2</sup>
	BICA FLOOR AREA	SEPP 2004 GROSS FLOOR AREA
BASEMENT FL.	2,595.5 m <sup>2</sup>	-
GROUND FL.	3,270.2 m <sup>2</sup>	3,270.2 m <sup>2</sup>
FIRST FL.	2,758.7 m <sup>2</sup>	2,758.7 m <sup>2</sup>
SECOND FL.	1,109.7m <sup>2</sup>	1,109.7m <sup>2</sup>
TOTAL	9,734.1 m <sup>2</sup>	7,138.6 m <sup>2</sup>
FSR		0.99 : 1
CARPARKING / AMBULANCE		39+1 = 40 spaces

LEGEND	
	BOUNDARY
	OUTLINE OF WALL ABOVE / BELOW
	ROOF OUTLINE
+ ex.RL.00.00	EXISTING LEVELS
	PROPOSED LEVELS
	PROPOSED DOOR
	PROPOSED WINDOW
	ELEVATION TAG
	SECTION / ELEVATION TAG

LANDSCAPE AREA (incl. over basement)	3,620.9 m <sup>2</sup>
LANDSCAPE AREA PER BED	28.7 m <sup>2</sup>
LANDSCAPE AREA (excl. over basement)	3,223.3 m <sup>2</sup>
LANDSCAPE AREA PER BED	25.6 m <sup>2</sup>

RESIDENT ACCOMMODATION			
	1 BED	2 BED	TOTAL
GROUND FL.	57	2 x 2B	61
FIRST FL.	45	2 x 2B	49
SECOND FL.	14	1 x 2B	16
TOTAL No. of BEDS	116	10	126
TOTAL No. of ROOMS	116	5	121

PRIVATE ACTIVITIES	776.0 m <sup>2</sup>
COMMON ACTIVITIES	245.0 m <sup>2</sup>
STORAGE	323.6 m <sup>2</sup>






NCC 2019 - SECTION J REQUIREMENTS			
Envelope Construction		Total System R-Value (m <sup>2</sup> K/W)	
J1.3 Roof and ceiling construction (Roof absorbance)		≥ 3.20	
J1.4 Roof lights		Compliant	
J1.5a Total System external wall construction		≥ 2.00	
J1.5b Total System internal wall construction (between conditioned & unconditioned areas)		≥ 1.40	
J1.6a Floor construction (above an unconditioned zone)		≥ 2.00	
J1.6b Floor construction (concrete slab on ground)		≥ 2.00	


  

Glazing - Frame Construction (Uniform solution)	Orientation	Total System U-Value (m <sup>2</sup> K/W)	Total System SHGC
Total window frame construction	All facades	≤ 2.10	≤ 0.18

ACOUSTIC REQUIREMENTS	
Space / Activity Type	Recommended Design Sound Levels
Common Areas (e.g. foyer, lobby)	45 - 50 dB (A) Leq
Living Areas (e.g. common, lounges)	35 - 45 dB (A) Leq
Sleeping Areas (night time)	35 - 40 dB (A) Leq
Work areas (e.g. concierge, administration)	35 - 45 dB (A) Leq

### Insulation Legend

	Internal Wall Insulation Total R1.4
	External Wall Insulation Total R1.0
	External Wall Insulation Total R1.4
	Roof Insulation Total R3.7
	Floor Insulation Total R2.0

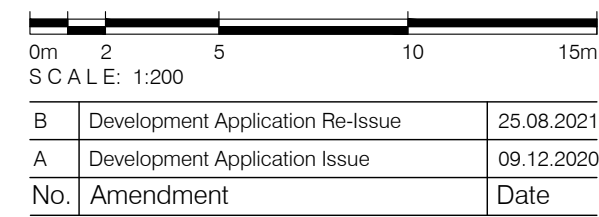

Project  
SUMMITCARE - MONTEREY  
119 Barton Street, Monterey, N.S.W 2217


---

Drawing  
BASEMENT FLOOR PLAN



**boffa robertson group**  
architecture, health and aged care planning, project management

 Suite 7, Level 1, Epica, 9 Railway Street  
Chatswood NSW 2067  
AUSTRALIA  
Tel. (02) 9406 7000  
Fax. (02) 9406 7099  
Email: [brgroup@brgr.net](mailto:brgroup@brgr.net)

	Date	JULY 2021	Job No. : Drawing  2014 / DA04
	Scale	1:200 @ A1	
	Drawn	AL	
	Amendment	B	



Basement floor  
Floor insulation Markup



This document, information and design concepts shown in it are copyright to Boffa Robertson Group. Any inconsistencies between drawn information and current Codes and Standards are to be notified immediately.

DEVELOPMENT STATISTICS		
SITE AREA		7,218.7 m²
	BCA FLOOR AREA	SEPP 2004 GROSS FLOOR AREA
BASEMENT FL.	2,595.5 m²	-
GROUND FL.	3,270.2 m²	3,270.2 m²
FIRST FL.	2,758.7 m²	2,758.7 m²
SECOND FL.	1,109.7m²	1,109.7m²
TOTAL	9,734.1 m²	7,138.6 m²
FSR		0.99 : 1
CARPARKING / AMBULANCE		39+1 = 40 spaces
LANDSCAPE AREA (incl. over basement)		3,620.9 m²
LANDSCAPE AREA PER BED		28.7 m²
LANDSCAPE AREA (excl. over basement)		3,223.3 m²
LANDSCAPE AREA PER BED		25.6 m²

RESIDENT ACCOMMODATION			
	1 BED	2 BED	TOTAL
GROUND FL.	57	2 x 2B	61
FIRST FL.	45	2 x 2B	49
SECOND FL.	14	1 x 2B	16
TOTAL No. of BEDS	116	10	126
TOTAL No. of ROOMS	116	5	121
PRIVATE ACTIVITIES		776.0 m²	
COMMON ACTIVITIES		245.0 m²	
STORAGE		323.6 m²	

LEGEND	
---	BOUNDARY
-----	OUTLINE OF WALL ABOVE / BELOW
-----	ROOF OUTLINE
+ ex.RL.00.00	EXISTING LEVELS
RL.00.00	PROPOSED LEVELS
	PROPOSED DOOR
	PROPOSED WINDOW
	ELEVATION TAG
	SECTION / ELEVATION TAG

NCC 2019 - SECTION J REQUIREMENTS	
Envelope Construction	Total System R-Value (m²K/W)
J1.3 Roof and ceiling construction (Roof absorbance)	≥ 3.20
J1.4 Roof lights	Compliant
J1.5a Total System external wall construction	≥ 2.00
J1.5b Total System internal wall construction (between conditioned & unconditioned areas)	≥ 1.40
J1.6a Floor construction (above an unconditioned zone)	≥ 2.00
J1.6b Floor construction (concrete slab on ground)	≥ 2.00

Glazing - Frame Construction (Uniform solution)	Orientation	Total System U-Value (m²K/W)	Total System SHGC
Total window frame construction	All facades	≤ 2.10	≤ 0.18

ACOUSTIC REQUIREMENTS	
Space / Activity Type	Recommended Design Sound Levels
Common Areas (e.g. foyer, lobby)	45 - 50 dB (A) Leq
Living Areas (e.g. common, lounges)	35 - 45 dB (A) Leq
Sleeping Areas (night time)	35 - 40 dB (A) Leq
Work areas (e.g. concierge, administration)	35 - 45 dB (A) Leq

Internal Wall Insulation  
Total R1.4

External Wall Insulation  
Total R1.0

External Wall Insulation  
Total R1.4

Roof Insulation Total  
R3.7

Floor Insulation Total  
R2.0

0m 2 5 10 15m		
SCALE: 1:200		
B	Development Application Re-Issue	25.08.2021
A	Development Application Issue	09.12.2020
No.	Amendment	Date

Project  
SUMMITCARE - MONTEREY  
119 Barton Street, Monterey, N.S.W 2217

Drawing  
BASEMENT FLOOR PLAN




boffa robertson group  
architecture, health and aged care planning, project management

boffa robertson group  
Suite 7, Level 1 Epica, 9 Railway Street  
Chadstone NSW 2067  
AUSTRALIA  
Tel: (02) 9406 7000  
Fax: (02) 9406 7099  
Email: brgroup@brgr.net

Date	JULY 2021	Job No.	Drawing
Scale	1:200 @ A1		
Drawn	AL	2014 /	DA04
Amendment	B		



Ground floor  
Wall insulation Markup

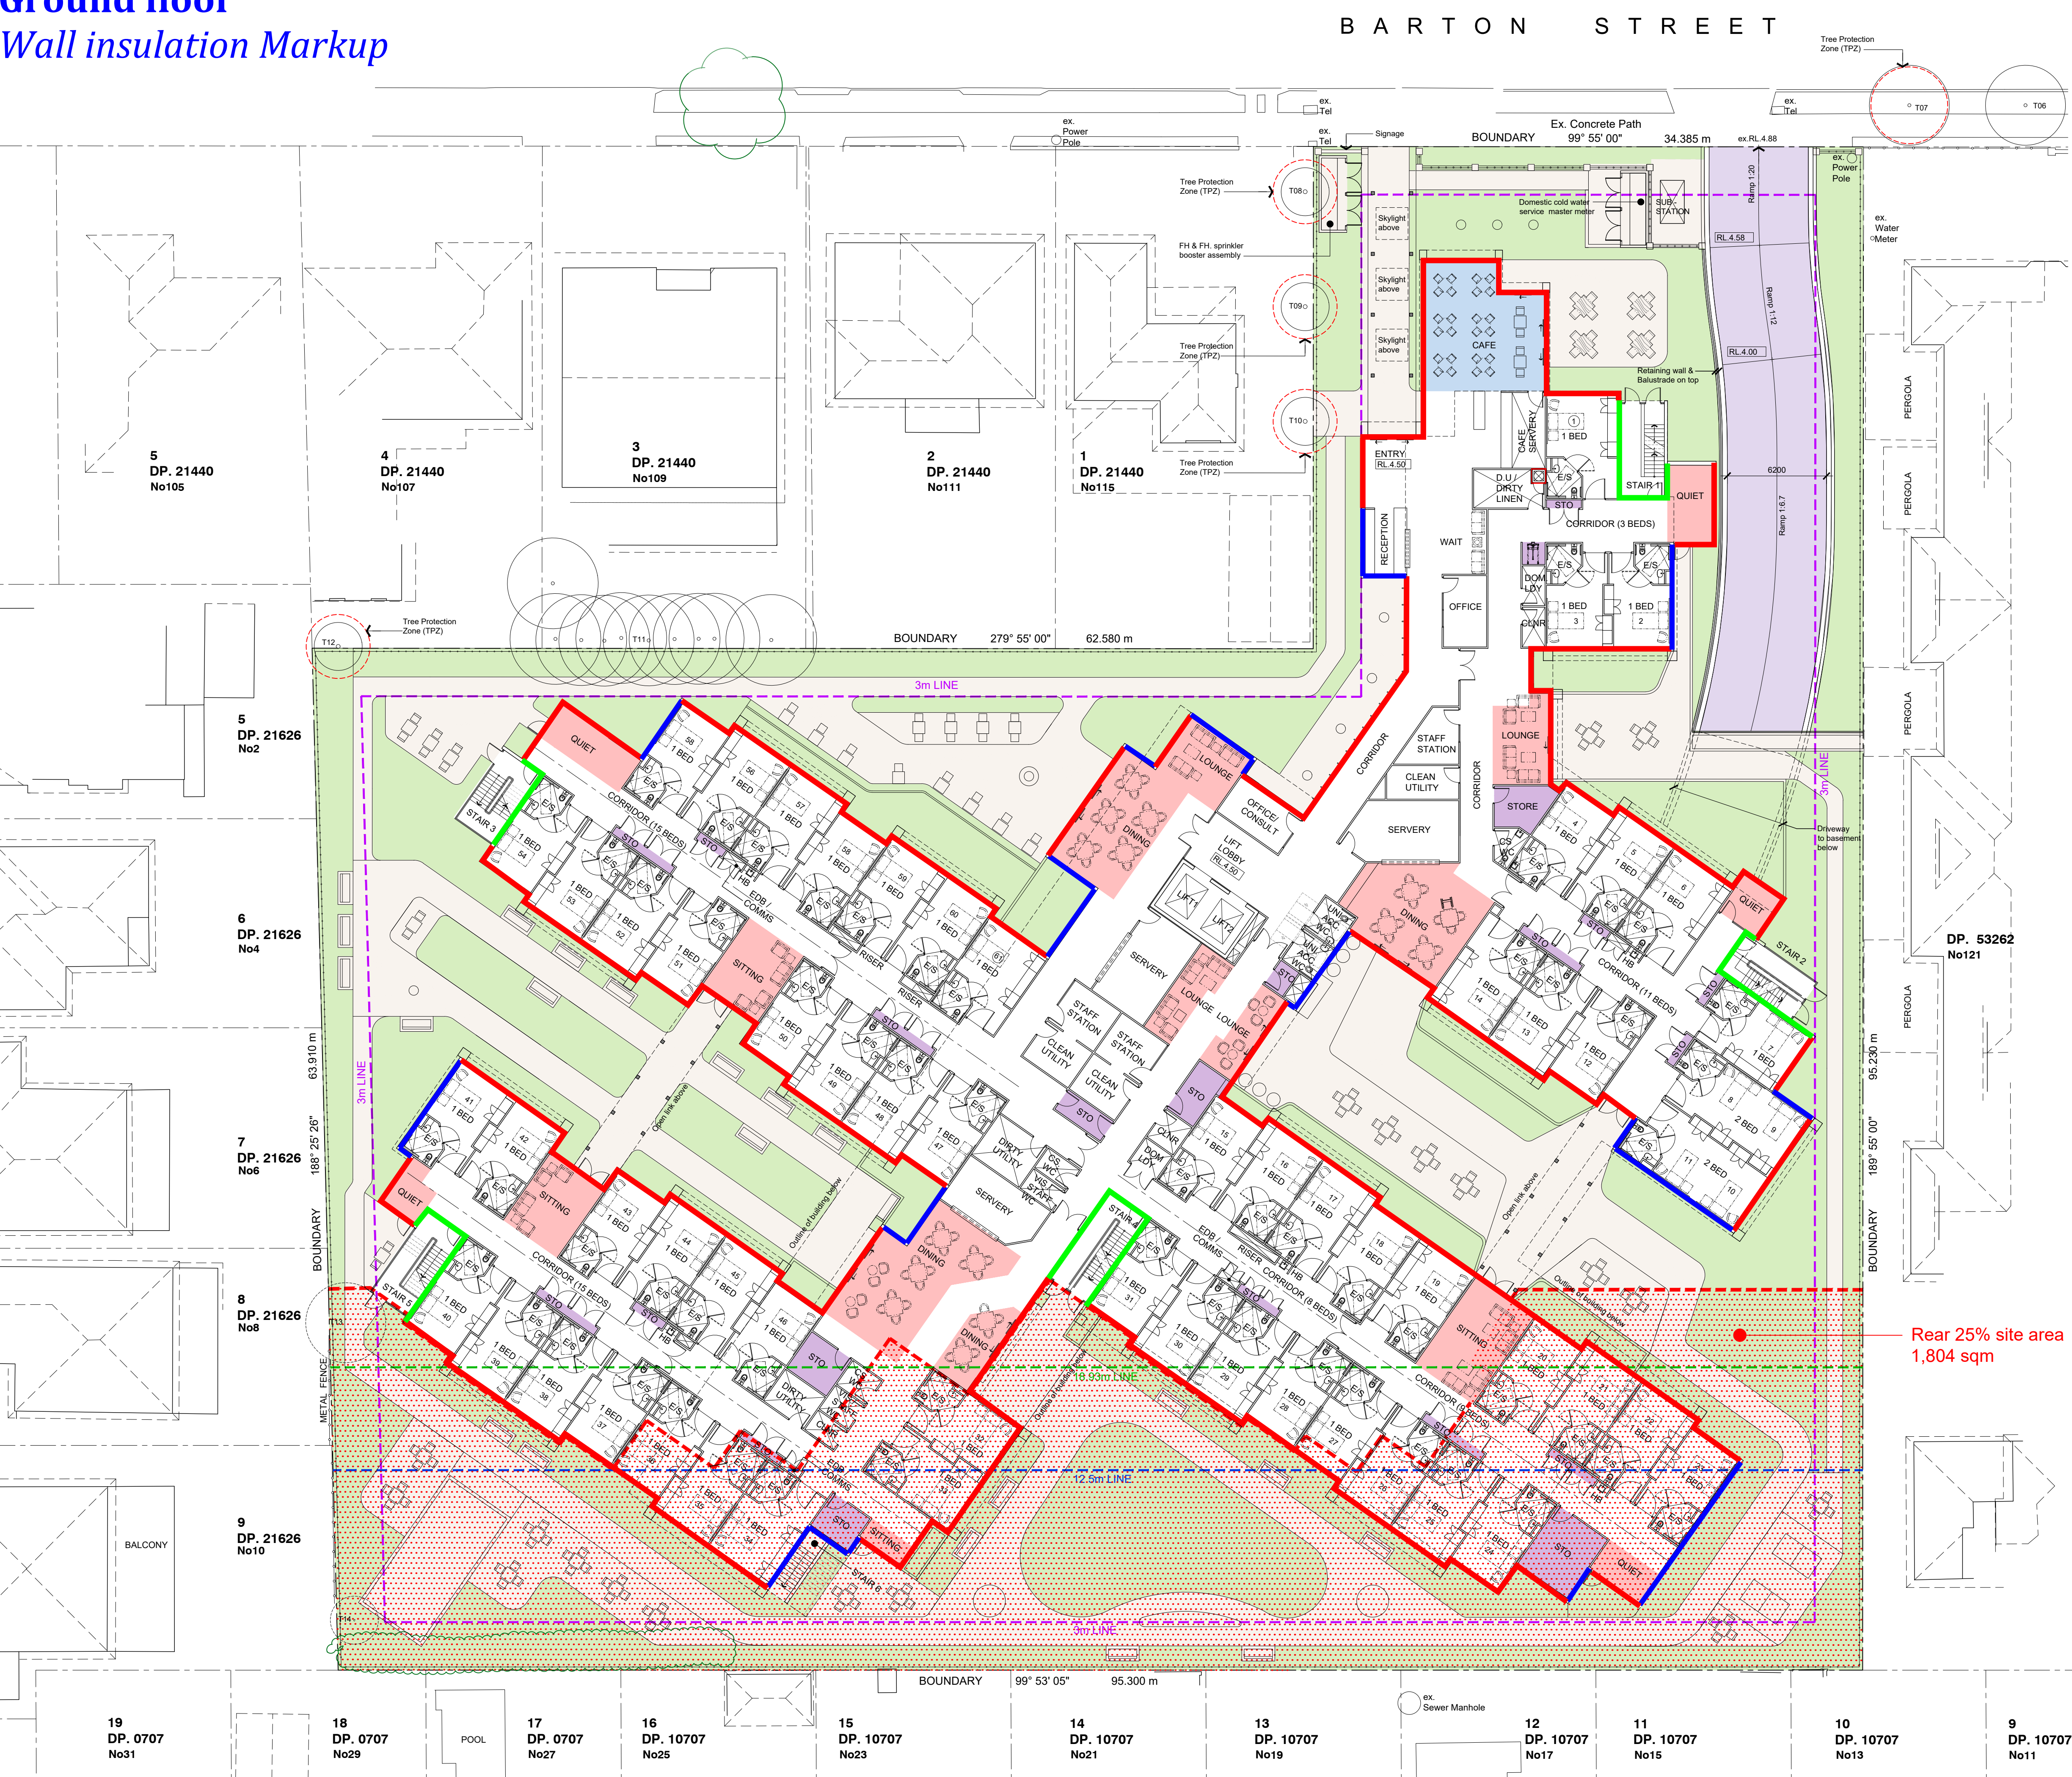

Insulation Legend	
Internal Wall Insulation Total R1.4	
External Wall Insulation Total R1.0	
External Wall Insulation Total R1.4	
Roof Insulation Total R3.7	
Floor Insulation Total R2.0	

0m 2 5 10 15m  
SCALE: 1:200

B	Development Application Re-Issue	25.08.2021
A	Development Application Issue	09.12.2020
No.	Amendment	Date

Project  
SUMMITCARE - MONTEREY  
119 Barton Street, Monterey, N.S.W 2217

Drawing  
GROUND FLOOR PLAN

CENTURION GROUP  
YOUR TRUSTED ADVISOR

SUMMITCARE  
WORTH WORTH WELLBEING


boffa robertson group  
architecture, health and aged care planning, project management

br  
rpg

Date	JULY 2021	Job No.	- Drawing
Scale	1:200 @ A1		
Drawn	AL		2014 / DA05
Amendment	B		



Ground floor  
Floor insulation Markup

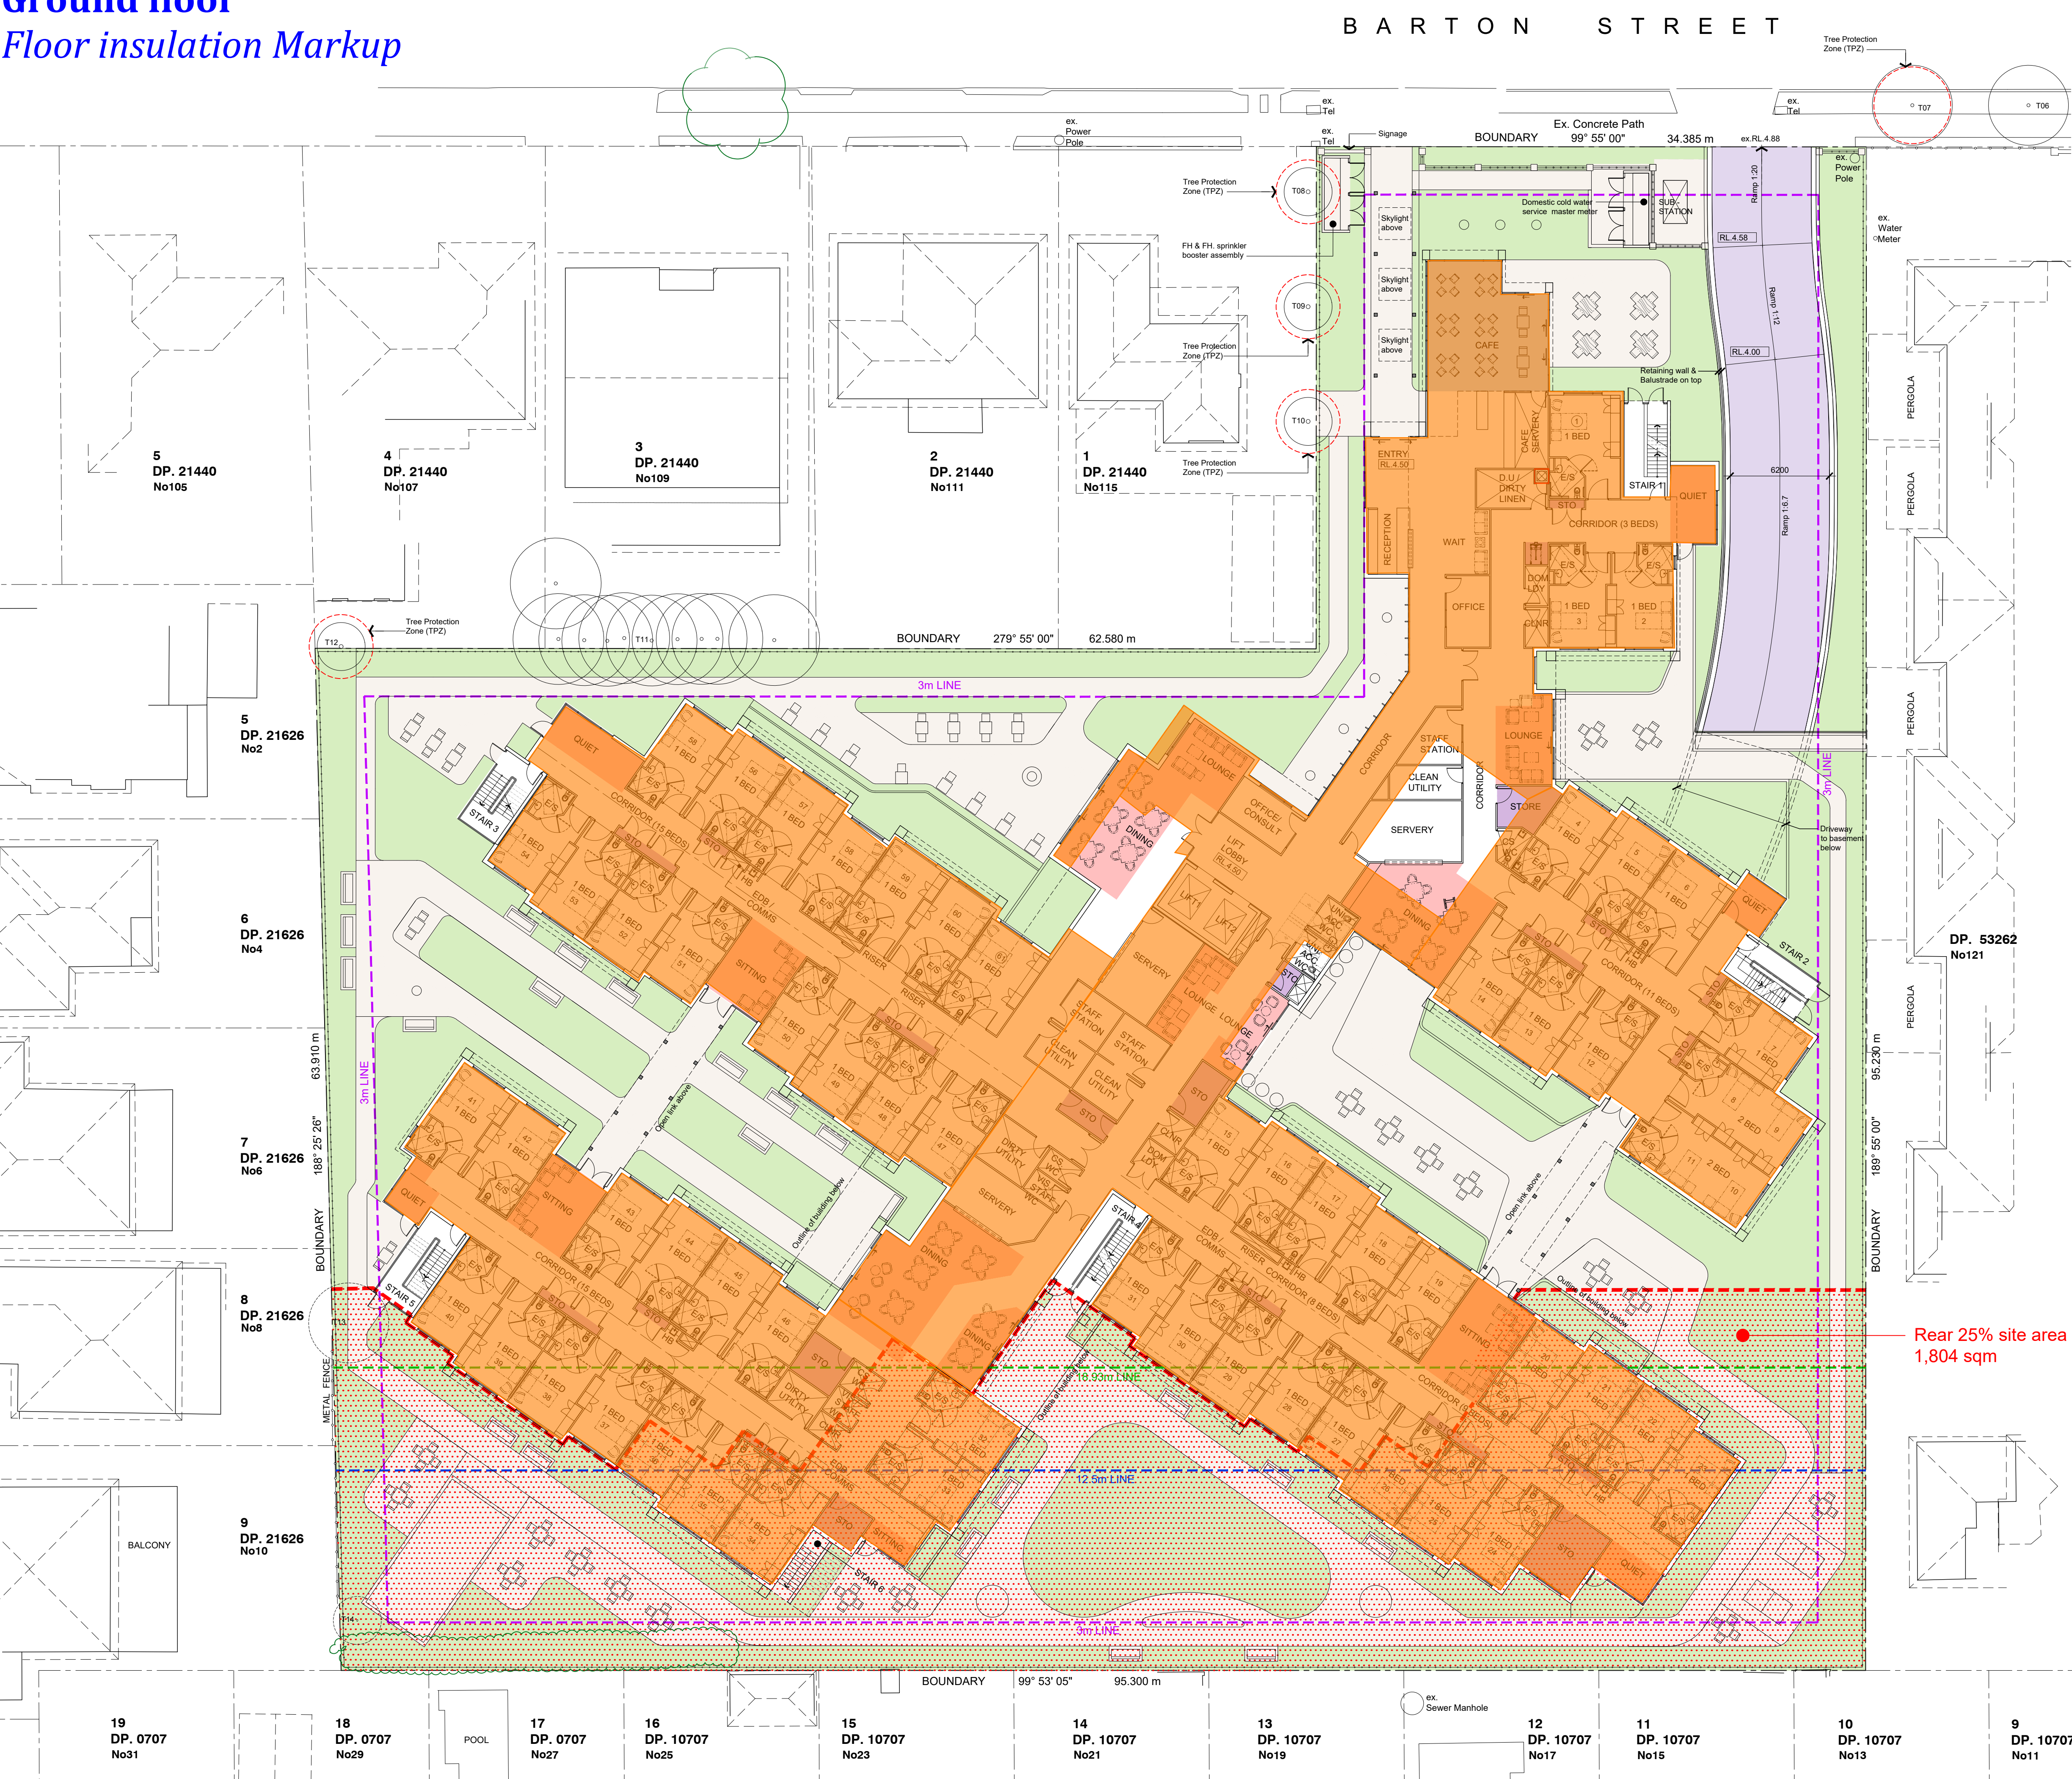

</

Insulation Legend	
	Internal Wall Insulation Total R1.4
	External Wall Insulation Total R1.0
	External Wall Insulation Total R1.4
	Roof Insulation Total R3.7
	Floor Insulation Total R2.0

0m 2 5 10 15m  
SCALE: 1:200

B	Development Application Re-Issue	25.08.2021
A	Development Application Issue	09.12.2020
No.	Amendment	Date

Project  
SUMMITCARE - MONTEREY  
119 Barton Street, Monterey, N.S.W 2217

Drawing  
GROUND FLOOR PLAN

CENTURION GROUP  
YOUR TRUSTED ADVISOR

SUMMITCARE  
WORTH WORTH WELLBEING


boffa robertson group  
architecture, health and aged care planning, project management

br  
rpg

Date	JULY 2021	Job No.	- Drawing
Scale	1:200 @ A1		
Drawn	AL		2014 / DA05
Amendment	B		



Ground floor  
Roof insulation Markup

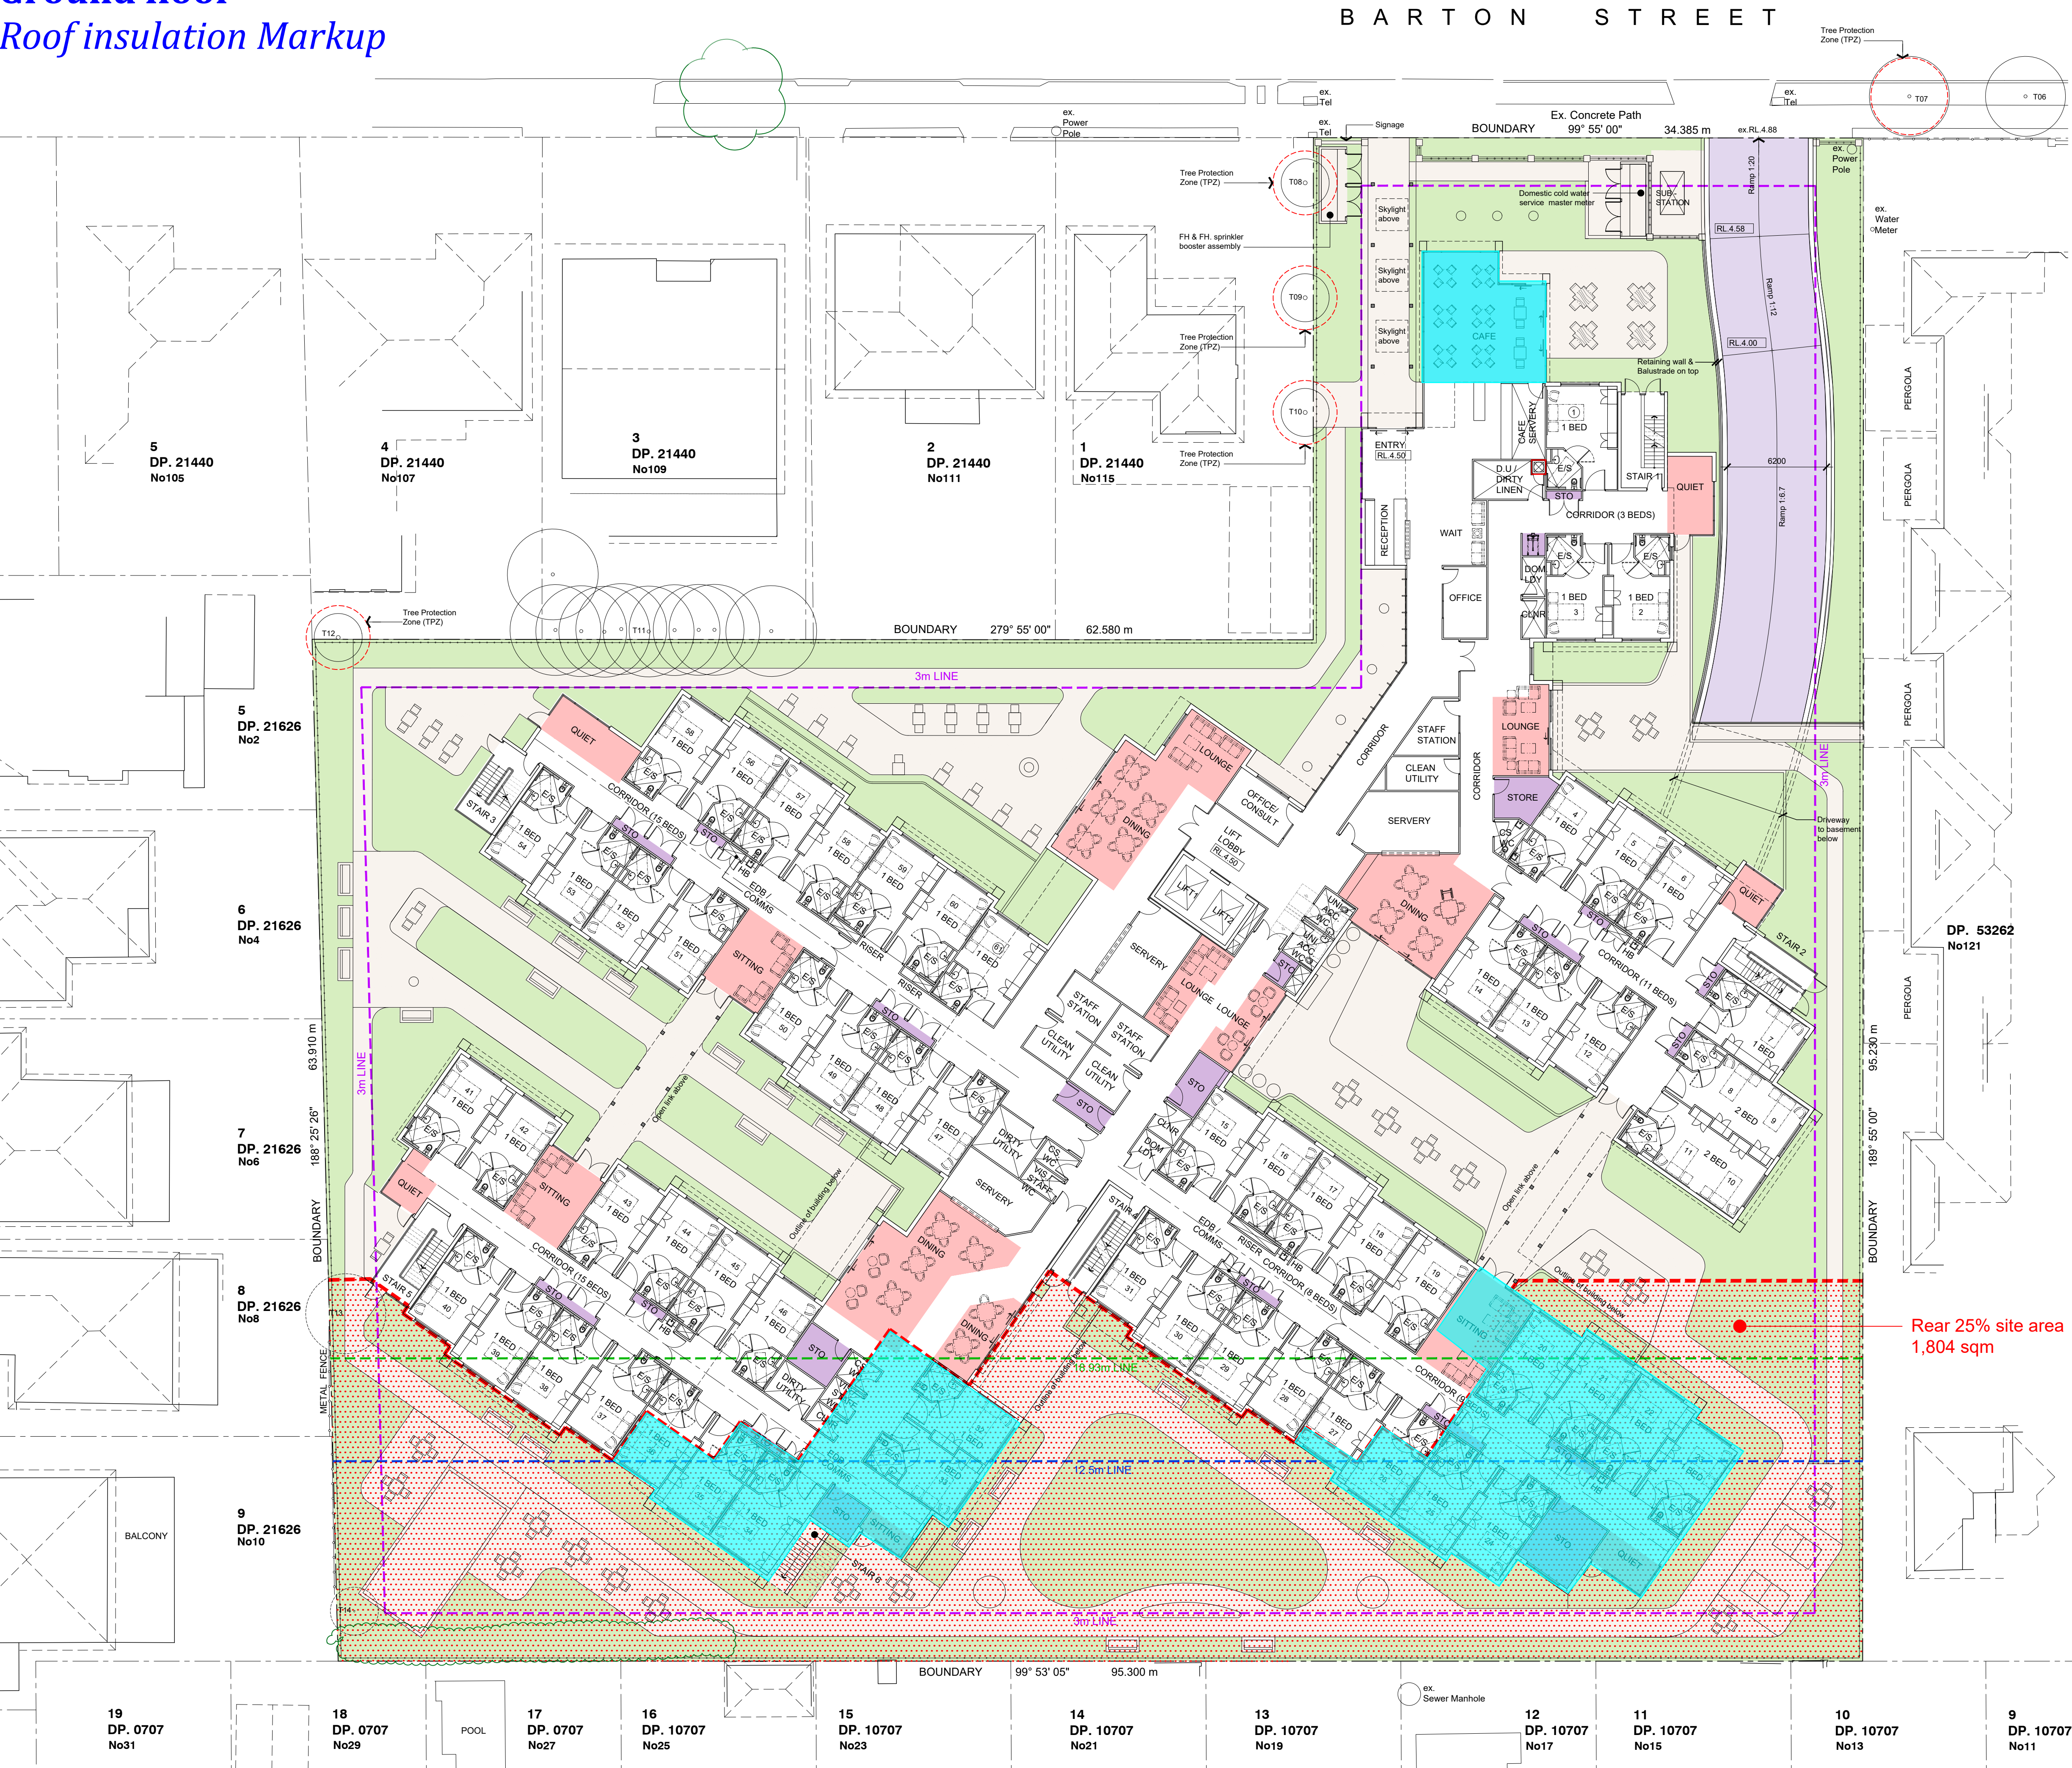

**DEVELOPMENT STATISTICS**

SITE AREA		7,218.7 m <sup>2</sup>
BASEMENT FL.	2,595.5 m <sup>2</sup>	-
GROUND FL.	3,270.2 m <sup>2</sup>	3,270.2 m <sup>2</sup>
FIRST FL.	2,758.7 m <sup>2</sup>	2,758.7 m <sup>2</sup>
SECOND FL.	1,109.7 m <sup>2</sup>	1,109.7 m <sup>2</sup>
TOTAL	9,734.1 m <sup>2</sup>	7,138.6 m <sup>2</sup>
FSR	0.99 : 1	
CARPARKING / AMBULANCE	39+1 = 40 spaces	
LANDSCAPE AREA (incl. over basement)	3,620.9 m <sup>2</sup>	
LANDSCAPE AREA PER BED	28.7 m <sup>2</sup>	
LANDSCAPE AREA (excl. over basement)	3,223.3 m <sup>2</sup>	
LANDSCAPE AREA PER BED	25.6 m <sup>2</sup>	

**RESIDENT ACCOMMODATION**

	1 BED	2 BED	TOTAL
GROUND FL.	57	2 x 2B	61
FIRST FL.	45	2 x 2B	49
SECOND FL.	14	1 x 2B	16
TOTAL No. of BEDS	116	10	126
TOTAL No. of ROOMS	116	5	121

	PRIVATE ACTIVITIES	COMMON ACTIVITIES	STORAGE
	776.0 m <sup>2</sup>	245.0 m <sup>2</sup>	323.6 m <sup>2</sup>

**LEGEND**

- BOUNDARY
- OUTLINE OF WALL ABOVE / BELOW
- ROOF OUTLINE
- EXISTING LEVELS
- PROPOSED LEVELS
- PROPOSED DOOR
- PROPOSED WINDOW
- ELEVATION TAG
- SECTION / ELEVATION TAG

**NCC 2019 - SECTION J REQUIREMENTS**

Envelope Construction	Total System R-Value (m <sup>2</sup> K/W)
J1.3 Roof and ceiling construction (Roof absorbance)	≥ 3.20
J1.4 Roof lights	Compliant
J1.5a Total System external wall construction	≥ 2.00
J1.5b Total System internal wall construction (between conditioned & unconditioned areas)	≥ 1.40
J1.6a Floor construction (above an unconditioned zone)	≥ 2.00
J1.6b Floor construction (concrete slab on ground)	≥ 2.00

Glazing - Frame Construction (Uniform solution)	Orientation	Total System U-Value (m <sup>2</sup> K/W)	Total System SHGC
Total window frame construction	All facades	≤ 2.10	≤ 0.18

**ACOUSTIC REQUIREMENTS**

Space / Activity Type	Recommended Design Sound Levels
Common Areas (e.g. foyer, lobby)	45 - 50 dB (A) Leq
Living Areas (e.g. common, lounges)	35 - 45 dB (A) Leq
Sleeping Areas (night time)	35 - 40 dB (A) Leq
Work areas (e.g. concierge, administration)	35 - 45 dB (A) Leq

**Insulation Legend**

- Internal Wall Insulation  
Total R1.4
- External Wall Insulation  
Total R1.0
- External Wall Insulation  
Total R1.4
- Roof Insulation Total  
R3.7
- Floor Insulation Total  
R2.0

0m 2 5 10 15m  
SCALE: 1:200

No.	Amendment	Date
B	Development Application Re-Issue	25.08.2021
A	Development Application Issue	09.12.2020

Project  
SUMMITCARE - MONTEREY  
119 Barton Street, Monterey, N.S.W 2217

Drawing  
GROUND FLOOR PLAN

CENTURION GROUP  
YOUR TRUSTED ADVISOR

SUMMITCARE  
WORTH WORTH WELLBEING

boffa robertson group  
architecture, health and aged care planning, project management

br  
rpg


Date	Job No.	Drawing
JULY 2021		
Scale 1:200 @ A1		
Drawn AL		
Amendment B		




2014 / DA05



First floor  
Wall insulation Markup

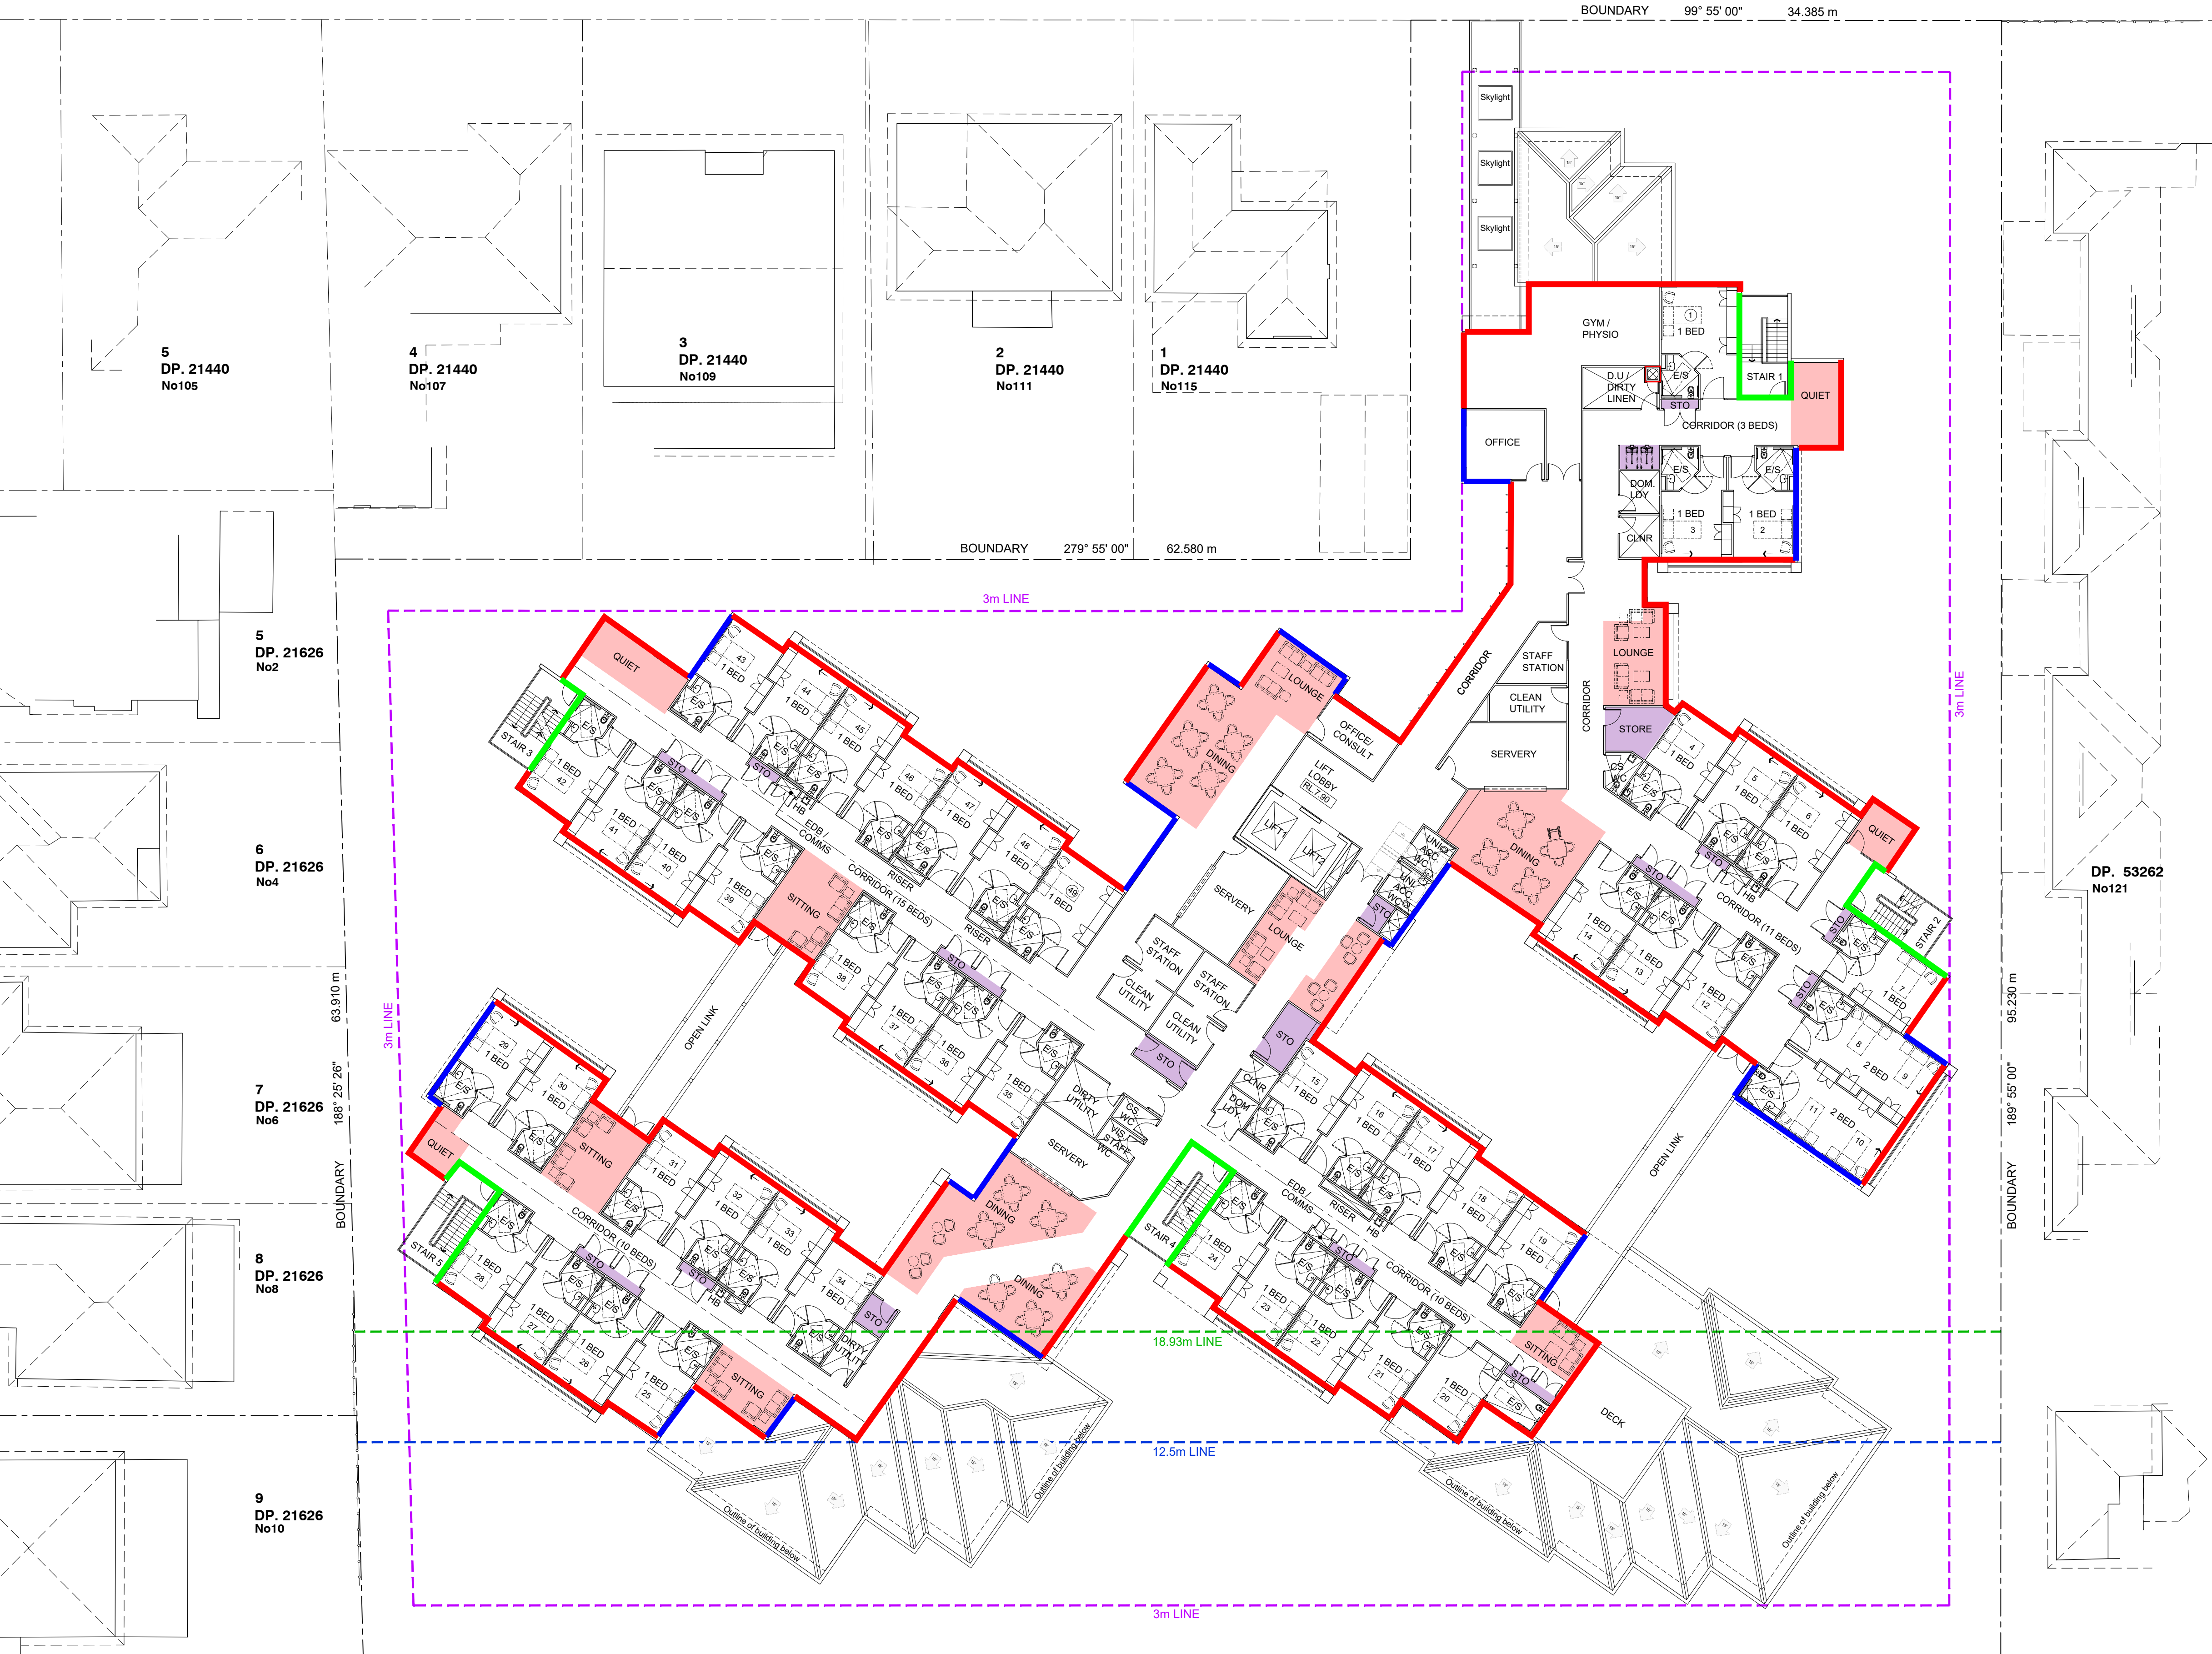BARTON STREET

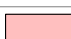

DEVELOPMENT STATISTICS			
SITE AREA		7,218.7 m²	
	BCA FLOOR AREA	SEPP 2004 GROSS FLOOR AREA	
BASEMENT FL.	2,595.5 m²	-	
GROUND FL.	3,270.2 m²	3,270.2 m²	
FIRST FL.	2,758.7 m²	2,758.7 m²	
SECOND FL.	1,109.7m²	1,109.7m²	
TOTAL	9,734.1 m²	7,138.6 m²	
FSR	0.99 : 1		
CARPARKING / AMBULANCE		39+1 = 40 spaces	
LANDSCAPE AREA (incl. over basement)		3,620.9 m²	
LANDSCAPE AREA PER BED		28.7 m²	
LANDSCAPE AREA (excl. over basement)		3,223.3 m²	
LANDSCAPE AREA PER BED		25.6 m²	
RESIDENT ACCOMMODATION			
	1 BED	2 BED	TOTAL
GROUND FL.	57	2 x 2B	61
FIRST FL.	45	2 x 2B	49
SECOND FL.	14	1 x 2B	16
TOTAL No. of BEDS	116	10	126
TOTAL No. of ROOMS	116	5	121
	PRIVATE ACTIVITIES		776.0 m²
	COMMON ACTIVITIES		245.0 m²
	STORAGE		323.6 m²

LEGEND	
---	BOUNDARY
----	OUTLINE OF WALL ABOVE / BELOW
-----	ROOF OUTLINE
+ ex RL.00.00	EXISTING LEVELS
RL.00.00	PROPOSED LEVELS
---	PROPOSED DOOR
---	PROPOSED WINDOW
---	ELEVATION TAG
---	SECTION / ELEVATION TAG

NCC 2019 - SECTION J REQUIREMENTS			
Envelope Construction		Total System R-Value (m²K/W)	
J1.3	Roof and ceiling construction (Roof absorbance)	≥ 3.20	
J1.4	Roof lights	Compliant	
J1.5a	Total System external wall construction	≥ 2.00	
J1.5b	Total System internal wall construction (between conditioned & unconditioned areas)	≥ 1.40	
J1.6a	Floor construction (above unconditioned zone)	≥ 2.00	
J1.6b	Floor construction (concrete slab on ground)	≥ 2.00	
Glazing - Frame Construction (Uniform solution)	Orientation	Total System U-Value (m²K/W)	Total System SHGC
Total window	All facades	≤ 2.10	≤ 0.18

ACOUSTIC REQUIREMENTS	
Space / Activity Type	Recommended Design Sound Levels
Common Areas (e.g. foyer, lobby)	45 - 50 dB (A) Leq
Living Areas (e.g. common, lounges)	35 - 45 dB (A) Leq
Sleeping Areas (night time)	35 - 40 dB (A) Leq
Work areas (e.g. concierge, administration)	35 - 45 dB (A) Leq

**Insulation Legend**

- Internal Wall Insulation  
Total R1.4
- External Wall Insulation  
Total R1.0
- External Wall Insulation  
Total R1.4
- Roof Insulation Total  
R3.7
- Floor Insulation Total  
R2.0

0m	2	5	10	15m
SCALE: 1:200				
B	Development Application Re-Issue			25.08.2021
A	Development Application Issue			09.12.2020
No.	Amendment			Date

Project  
SUMMITCARE - MONTEREY  
119 Barton Street, Monterey, N.S.W 2217

Drawing  
FIRST FLOOR PLAN

**CENTURION GROUP**  
YOUR TRUSTED ADVISOR

**SUMMITCARE**  
WORTH WORTH WELLBEING

**boffa robertson group**  
architecture, health and aged care planning, project management

**br**  
rsg

Suite 7, Level 1, Epica, 9 Railway Street  
Cherrywood NSW 2067  
AUSTRALIA  
Tel: (02) 9406 7000  
Fax: (02) 9406 7009  
Email: brgroup@brgr.net

Date: JULY 2021  
Scale: 1:200 @ A1  
Drawn: AL  
Amendment: B



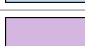
Job No.: Drawing  
2014 / DA06



First floor  
Roof insulation Markup

BARTON STREET

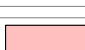

DEVELOPMENT STATISTICS			
SITE AREA		7,218.7 m²	
	BCA FLOOR AREA	SEPP 2004 GROSS FLOOR AREA	
BASEMENT FL.	2,595.5 m²	-	
GROUND FL.	3,270.2 m²	3,270.2 m²	
FIRST FL.	2,758.7 m²	2,758.7 m²	
SECOND FL.	1,109.7m²	1,109.7m²	
TOTAL	9,734.1 m²	7,138.6 m²	
FSR		0.99 : 1	
CARPARKING / AMBULANCE		39+1 = 40 spaces	
LANDSCAPE AREA (incl. over basement)		3,620.9 m²	
LANDSCAPE AREA PER BED		28.7 m²	
LANDSCAPE AREA (excl. over basement)		3,223.3 m²	
LANDSCAPE AREA PER BED		25.6 m²	
RESIDENT ACCOMMODATION			
	1 BED	2 BED	TOTAL
GROUND FL.	57	2 x 2B	61
FIRST FL.	45	2 x 2B	49
SECOND FL.	14	1 x 2B	16
TOTAL No. of BEDS	116	10	126
TOTAL No. of ROOMS	116	5	121
	PRIVATE ACTIVITIES		776.0 m²
	COMMON ACTIVITIES		245.0 m²
	STORAGE		323.6 m²

LEGEND	
---	BOUNDARY
----	OUTLINE OF WALL ABOVE / BELOW
-----	ROOF OUTLINE
+ ex RL.00.00	EXISTING LEVELS
[RL.00.00]	PROPOSED LEVELS
[DOOR]	PROPOSED DOOR
[WINDOW]	PROPOSED WINDOW
[TAG]	ELEVATION TAG
[SECTION TAG]	SECTION / ELEVATION TAG

NCC 2019 - SECTION J REQUIREMENTS			
Envelope Construction		Total System R-Value (m²K/W)	
J1.3 Roof and ceiling construction (Roof absorbance)		≥ 3.20	
J1.4 Roof lights		Compliant	
J1.5a Total System external wall construction		≥ 2.00	
J1.5b Total System internal wall construction (between conditioned & unconditioned areas)		≥ 1.40	
J1.6a Floor construction (above an unconditioned zone)		≥ 2.00	
J1.6b Floor construction (concrete slab on ground)		≥ 2.00	
Glazing - Frame Construction (Uniform solution)	Orientation	Total System U-Value (m²K/W)	Total System SHGC
Total window frame construction	All facades	≤ 2.10	≤ 0.18

ACOUSTIC REQUIREMENTS	
Space / Activity Type	Recommended Design Sound Levels
Common Areas (e.g. foyer, lobby)	45 - 50 dB (A) Leq
Living Areas (e.g. common, lounges)	35 - 45 dB (A) Leq
Sleeping Areas (night time)	35 - 40 dB (A) Leq
Work areas (e.g. concierge, administration)	35 - 45 dB (A) Leq

**Insulation Legend**

- Internal Wall Insulation  
Total R1.4
- External Wall Insulation  
Total R1.0
- External Wall Insulation  
Total R1.4
- Roof Insulation Total  
R3.7
- Floor Insulation Total  
R2.0

0m	2	5	10	15m
SCALE: 1:200				
B	Development Application Re-Issue			25.08.2021
A	Development Application Issue			09.12.2020
No.	Amendment			Date

Project  
SUMMITCARE - MONTEREY  
119 Barton Street, Monterey, N.S.W 2217

Drawing  
FIRST FLOOR PLAN

**CENTURION GROUP**  
YOUR TRUSTED ADVISOR

**SUMMITCARE**  
WORTH WORTH WELLBEING

**boffa robertson group**  
architecture, health and aged care planning, project management

**br**  
iqg


Suite 7, Level 1, Epica, 9 Railway Street  
Chadwood NSW 2067  
AUSTRALIA  
Tel: (02) 9406 7000  
Fax: (02) 9406 7099  
Email: brgroup@brgr.net




Date: JULY 2021  
Scale: 1:200 @ A1  
Drawn: AL  
Amendment: B

Job No.: Drawing  
2014 / DA06



Second floor  
Wall insulation Markup

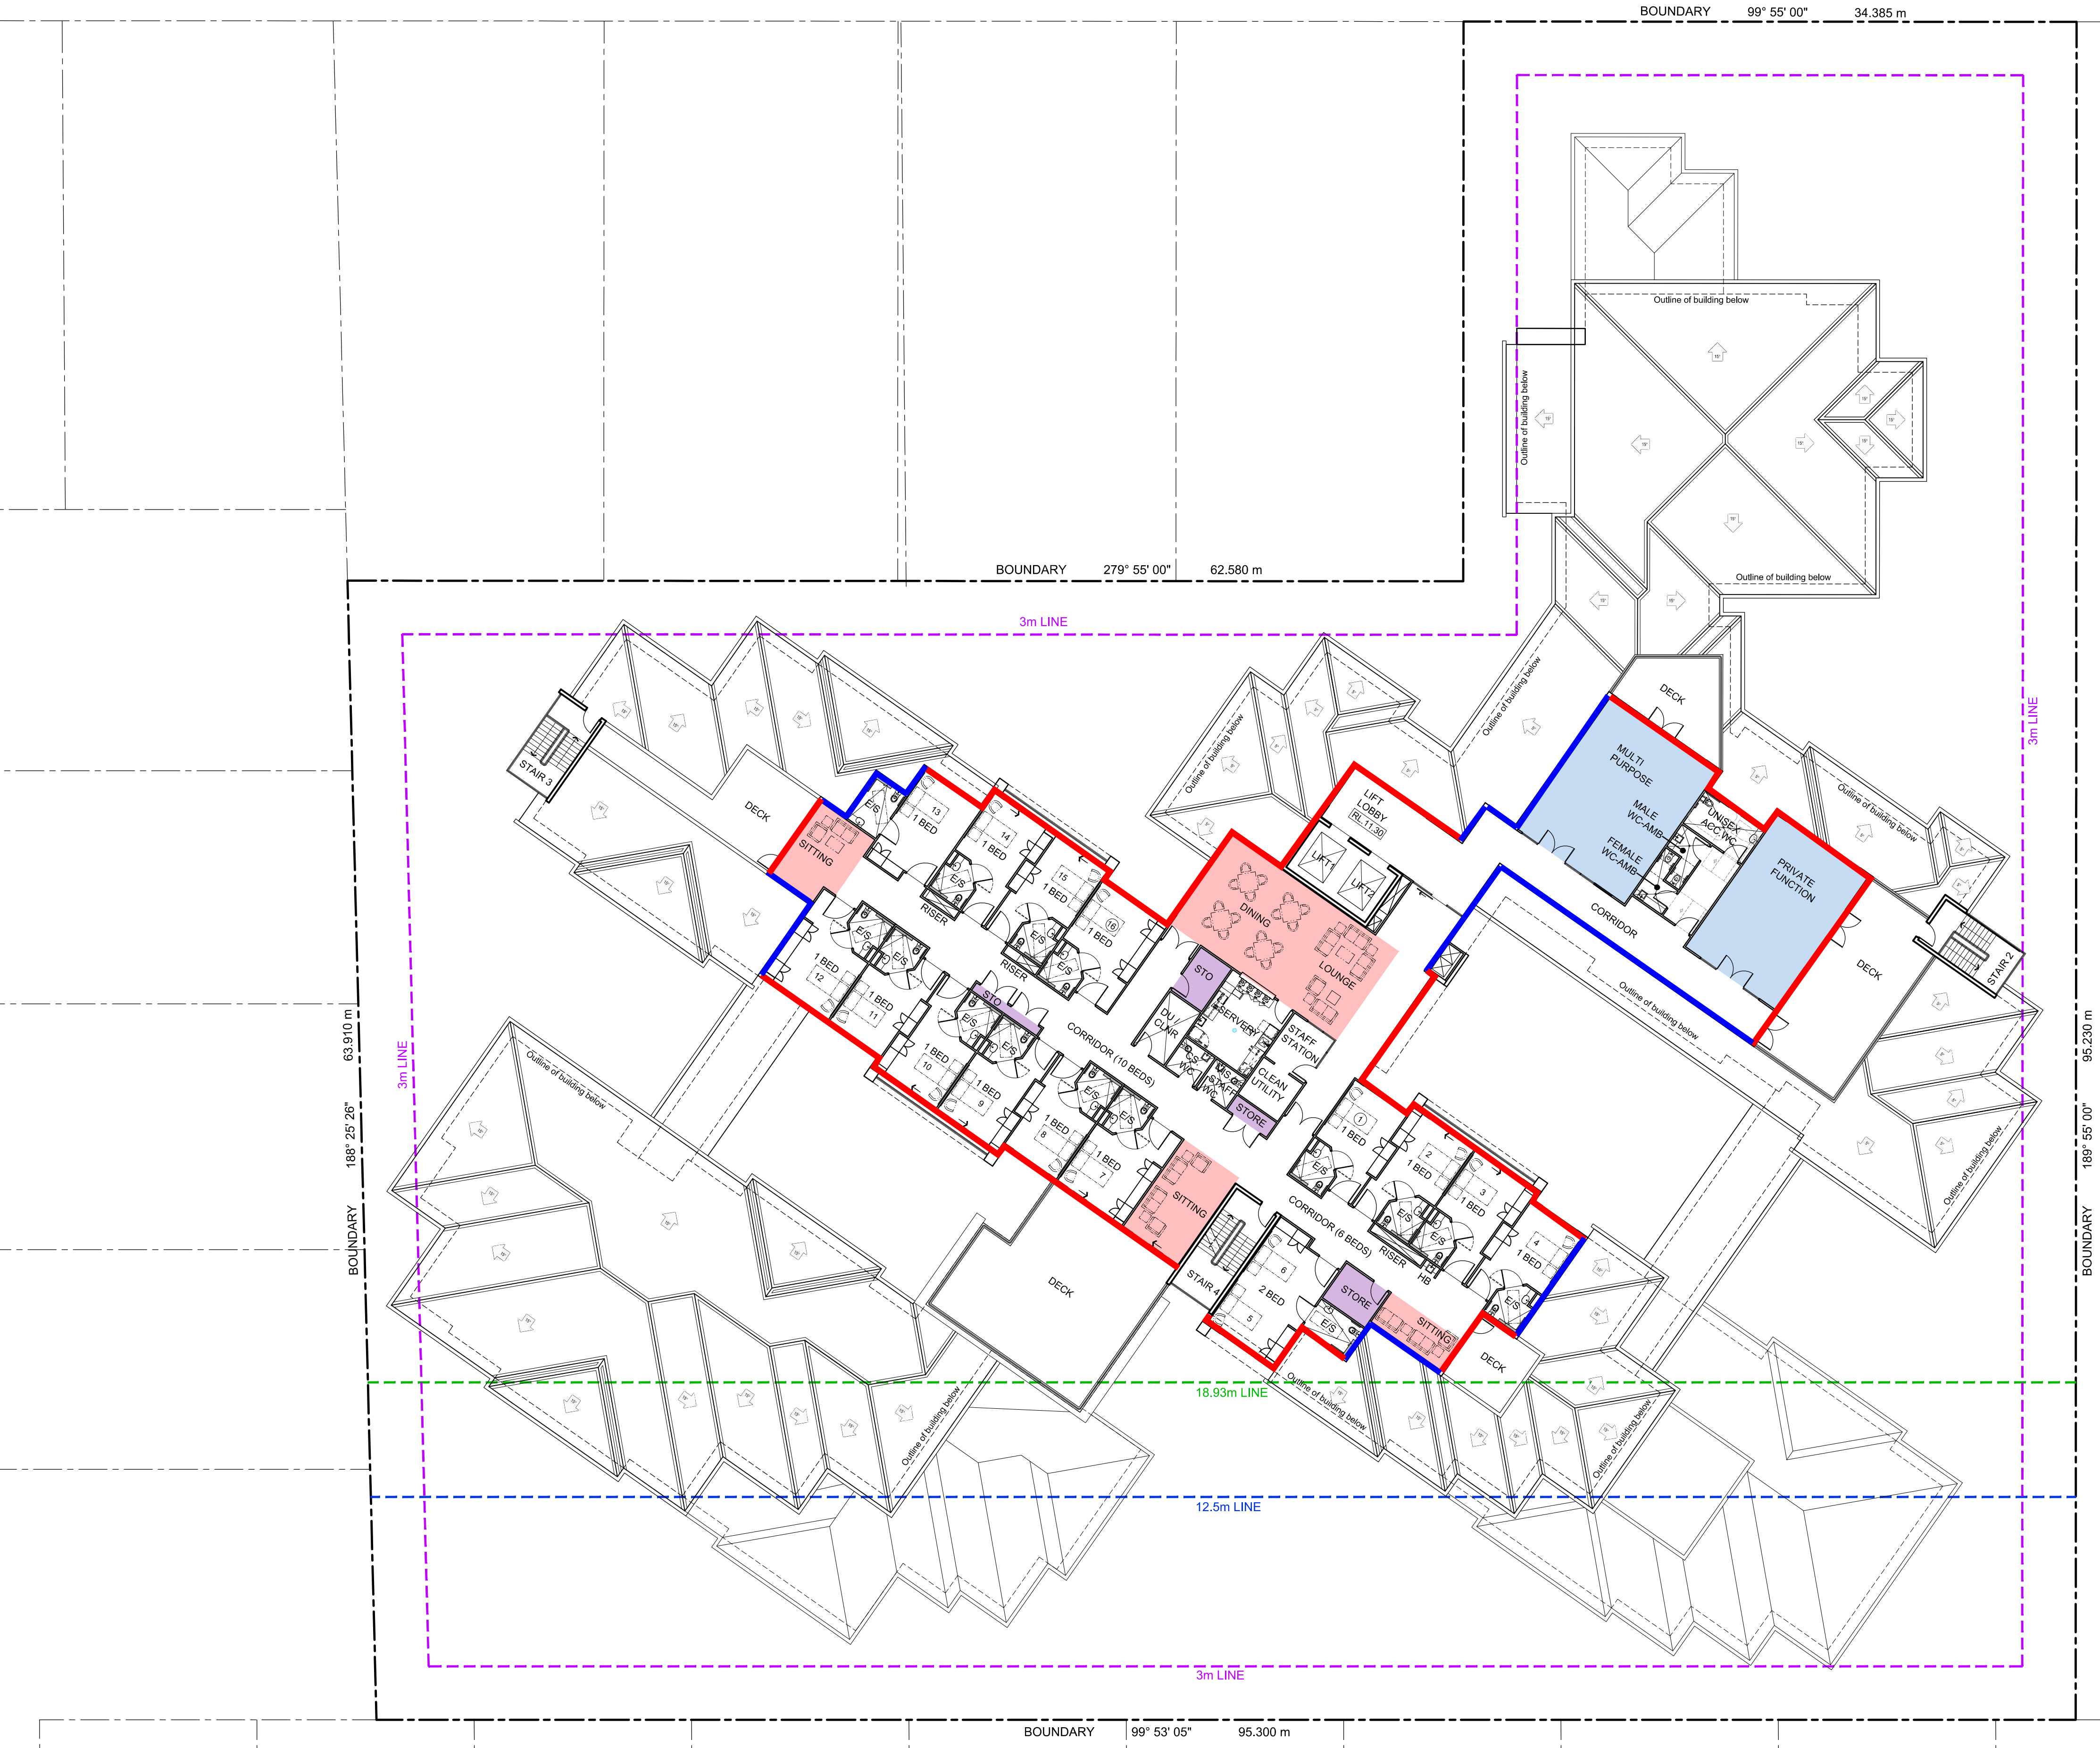

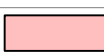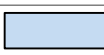DEVELOPMENT STATISTICS			
SITE AREA		7,218.7 m²	
	BCA FLOOR AREA	SEPP 2004 GROSS FLOOR AREA	
BASEMENT.FL.	2,595.5 m²	-	
GROUND FL.	3,270.2 m²	3,270.2 m²	
FIRST FL.	2,758.7 m²	2,758.7 m²	
SECOND FL.	1,109.7m²	1,109.7m²	
TOTAL	9,734.1 m²	7,138.6 m²	
FSR	0.99 : 1		
CARPARKING / AMBULANCE		39+1 = 40 spaces	
LANDSCAPE AREA (incl.over basement)		3,620.9 m²	
LANDSCAPE AREA PER BED		28.7 m²	
LANDSCAPE AREA (excl.over basement)		3,223.3 m²	
LANDSCAPE AREA PER BED		25.6 m²	
RESIDENT ACCOMMODATION			
	1 BED	2 BED	TOTAL
GROUND FL.	57	2 x 2B	61
FIRST FL.	45	2 x 2B	49
SECOND FL.	14	1 x 2B	16
TOTAL No.of BEDS	116	10	126
TOTAL No.of ROOMS	116	5	121
	PRIVATE ACTIVITIES		776.0 m²
	COMMON ACTIVITIES		245.0 m²
	STORAGE		323.6 m²

LEGEND			
---	BOUNDARY		
---	OUTLINE OF WALL ABOVE / BELOW		
---	ROOF OUTLINE		
+ ex.RL.00.00	EXISTING LEVELS		
[RL.00.00]	PROPOSED LEVELS		
U	PROPOSED DOOR		
W	PROPOSED WINDOW		
E	ELEVATION TAG		
S	SECTION / ELEVATION TAG		
NCC 2019 - SECTION J REQUIREMENTS			
Envelope Construction		Total System R-Value (m²K/W)	
J1.3	Roof and ceiling construction (Roof absorbance)	≥ 3.20	
J1.4	Roof lights	Compliant	
J1.5a	Total System external wall construction	≥ 2.00	
J1.5b	Total System internal wall construction (between conditioned & unconditioned areas)	≥ 1.40	
J1.6a	Floor construction (above an unconditioned zone)	≥ 2.00	
J1.6b	Floor construction (concrete slab on ground)	≥ 2.00	
Glazing - Frame Construction (Uniform solution)	Orientation	Total System U-Value (m²K/W)	Total System SHGC
Total window frame construction	All facades	≤ 2.10	≤ 0.18
ACOUSTIC REQUIREMENTS			
Space / Activity Type		Recommended Design Sound Levels	
Common Areas (e.g. foyer, lobby)		45 - 50 dB (A) Leq	
Living Areas (e.g. common, lounges)		35 - 45 dB (A) Leq	
Sleeping Areas (night time)		35 - 40 dB (A) Leq	
Work areas (e.g. concierge, administration)		35 - 45 dB (A) Leq	

Internal Wall Insulation  
Total R1.4

External Wall Insulation  
Total R1.0

External Wall Insulation  
Total R1.4

Roof Insulation Total  
R3.7

Floor Insulation Total  
R2.0

0m 2 5 10 15m

SCALE: 1:200

B	Development Application Re-Issue	25.08.2021
A	Development Application Issue	09.12.2020
No.	Amendment	Date

Project

SUMMITCARE - MONTEREY  
119 Barton Street, Monterey, N.S.W 2217

Drawing

SECOND FLOOR PLAN

CENTURION GROUP

YOUR TRUSTED ADVISOR

SUMMITCARE

WORTH WORTH WELLBEING

boffa robertson group

architecture, health and aged care planning, project management

br




Suite 7, Level 1, Epica, 9 Railway Street  
Chadstone, NSW 2067  
AUSTRALIA  
Tel: (02) 9406 7000  
Fax: (02) 9406 7099  
Email: brgroup@brgr.net

Date	JULY 2021	Job No.	Drawing
Scale	1:200 @ A1		
Drawn	AL	2014 /	DA07
Amendment	B		



Second floor  
Roof insulation Markup

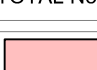

DEVELOPMENT STATISTICS			
SITE AREA		7,218.7 m²	
	BCA FLOOR AREA	SEPP 2004 GROSS FLOOR AREA	
BASEMENT.FL.	2,595.5 m²	-	
GROUND FL.	3,270.2 m²	3,270.2 m²	
FIRST FL.	2,758.7 m²	2,758.7 m²	
SECOND FL.	1,109.7m²	1,109.7m²	
TOTAL	9,734.1 m²	7,138.6 m²	
FSR		0.99 : 1	
CARPARKING / AMBULANCE		39+1 = 40 spaces	
LANDSCAPE AREA (incl.over basement)		3,620.9 m²	
LANDSCAPE AREA PER BED		28.7 m²	
LANDSCAPE AREA (excl.over basement)		3,223.3 m²	
LANDSCAPE AREA PER BED		25.6 m²	
RESIDENT ACCOMMODATION			
	1 BED	2 BED	TOTAL
GROUND FL.	57	2 x 2B	61
FIRST FL.	45	2 x 2B	49
SECOND FL.	14	1 x 2B	16
TOTAL No.of BEDS	116	10	126
TOTAL No.of ROOMS	116	5	121
	PRIVATE ACTIVITIES		776.0 m²
	COMMON ACTIVITIES		245.0 m²
	STORAGE		323.6 m²

LEGEND	
	BOUNDARY
	OUTLINE OF WALL ABOVE / BELOW
	ROOF OUTLINE
	EXISTING LEVELS
	PROPOSED LEVELS
	PROPOSED DOOR
	PROPOSED WINDOW
	ELEVATION TAG
	SECTION / ELEVATION TAG

NCC 2019 - SECTION J REQUIREMENTS	
Envelope Construction	Total System R-Value (m²K/W)
J1.3 Roof and ceiling construction (Roof absorbance)	≥ 3.20
J1.4 Roof lights	Compliant
J1.5a Total System external wall construction	≥ 2.00
J1.5b Total System internal wall construction (between conditioned & unconditioned areas)	≥ 1.40
J1.6a Floor construction (above an unconditioned zone)	≥ 2.00
J1.6b Floor construction (concrete slab on ground)	≥ 2.00

Glazing - Frame Construction (Uniform solution)	Orientation	Total System U-Value (m²K/W)	Total System SHGC
Total window frame construction	All facades	≤ 2.10	≤ 0.18

ACOUSTIC REQUIREMENTS	
Space / Activity Type	Recommended Design Sound Levels
Common Areas (e.g. foyer, lobby)	45 - 50 dB (A) Leq
Living Areas (e.g. common, lounges)	35 - 45 dB (A) Leq
Sleeping Areas (night time)	35 - 40 dB (A) Leq
Work areas (e.g. concierge, administration)	35 - 45 dB (A) Leq

Internal Wall Insulation  
Total R1.4

External Wall Insulation  
Total R1.0

External Wall Insulation  
Total R1.4

Roof Insulation Total  
R3.7

Floor Insulation Total  
R2.0

0m 2 5 10 15m		
S C A L E : 1:200		
B	Development Application Re-Issue	25.08.2021
A	Development Application Issue	09.12.2020
No.	Amendment	Date

Project  
SUMMITCARE - MONTEREY  
119 Barton Street, Monterey, N.S.W 2217

Drawing  
SECOND FLOOR PLAN

CENTURION GROUP  
YOUR TRUSTED ADVISOR




SUMMITCARE  
WORTH WORTH WELLBEING

boffa robertson group  
architecture, health and aged care planning, project management  
Suite 7, Level 1, Epica, 9 Railway Street  
Chadwood NSW 2067  
AUSTRALIA  
Tel: (02) 9406 7000  
Fax: (02) 9406 7009  
Email: brgroup@brgr.net

Date	JULY 2021	Job No.	Drawing
Scale	1:200 @ A1	2014 / DA07	
Drawn	AL		
Amendment	B		



DEVELOPMENT STATISTICS

SITE AREA		7,218.7 m²	
	BCA FLOOR AREA	SEPP 2004 GROSS FLOOR AREA	
BASEMENT FL.	2,595.5 m²	-	
GROUND FL.	3,270.2 m²	3,270.2 m²	
FIRST FL.	2,758.7 m²	2,758.7 m²	
SECOND FL.	1,109.7m²	1,109.7m²	
TOTAL	9,734.1 m²	7,138.6 m²	
FSR		0.99 : 1	
CARPARKING / AMBULANCE		39+1 = 40 spaces	
LANDSCAPE AREA (incl. over basement)		3,620.9 m²	
LANDSCAPE AREA PER BED		28.7 m²	
LANDSCAPE AREA (excl. over basement)		3,223.3 m²	
LANDSCAPE AREA PER BED		25.6 m²	
RESIDENT ACCOMMODATION			
	1 BED	2 BED	TOTAL
GROUND FL.	57	2 x 2B	61
FIRST FL.	45	2 x 2B	49
SECOND FL.	14	1 x 2B	16
TOTAL No. of BEDS	116	10	126
TOTAL No. of ROOMS	116	5	121
	PRIVATE ACTIVITIES		776.0 m²
	COMMON ACTIVITIES		245.0 m²
	STORAGE		323.6 m²

LEGEND


	PROPOSED ROOF PITCH AND FALL DIRECTION
	OUTLINE OF BUILDING BELOW
	NEW ROOF
	PROPOSED LEVELS
	DOWNPIPE
	ROOF COWL
	SOLAR PANELS

NOTE:

J1.3	Roof and ceiling construction (Roof absorptance)	≥ 3.20	
J1.4	Roof lights	Compliant	
J1.5a	Total System external wall construction	≥ 2.00	
J1.5b	Total System internal wall construction (between conditioned & unconditioned areas)	≥ 1.40	
J1.6a	Floor construction (above an unconditioned zone)	≥ 2.00	
J1.6b	Floor construction (concrete slab on ground)	≥ 2.00	
Glazing - Frame Construction (Uniform solution)	Orientation	Total System U-Value (m <sup>2</sup> K/W)	Total System SHGC
Total window frame construction	All facades	≤ 2.10	≤ 0.18

ACOUSTIC REQUIREMENTS

Space / Activity Type	Recommended Design Sound Levels
Common Areas (e.g. foyer, lobby)	45 - 50 dB (A) Leq
Living Areas (e.g. common, lounges)	35 - 45 dB (A) Leq
Sleeping Areas (night time)	35 - 40 dB (A) Leq
Work areas (e.g. concierge, administration)	35 - 45 dB (A) Leq

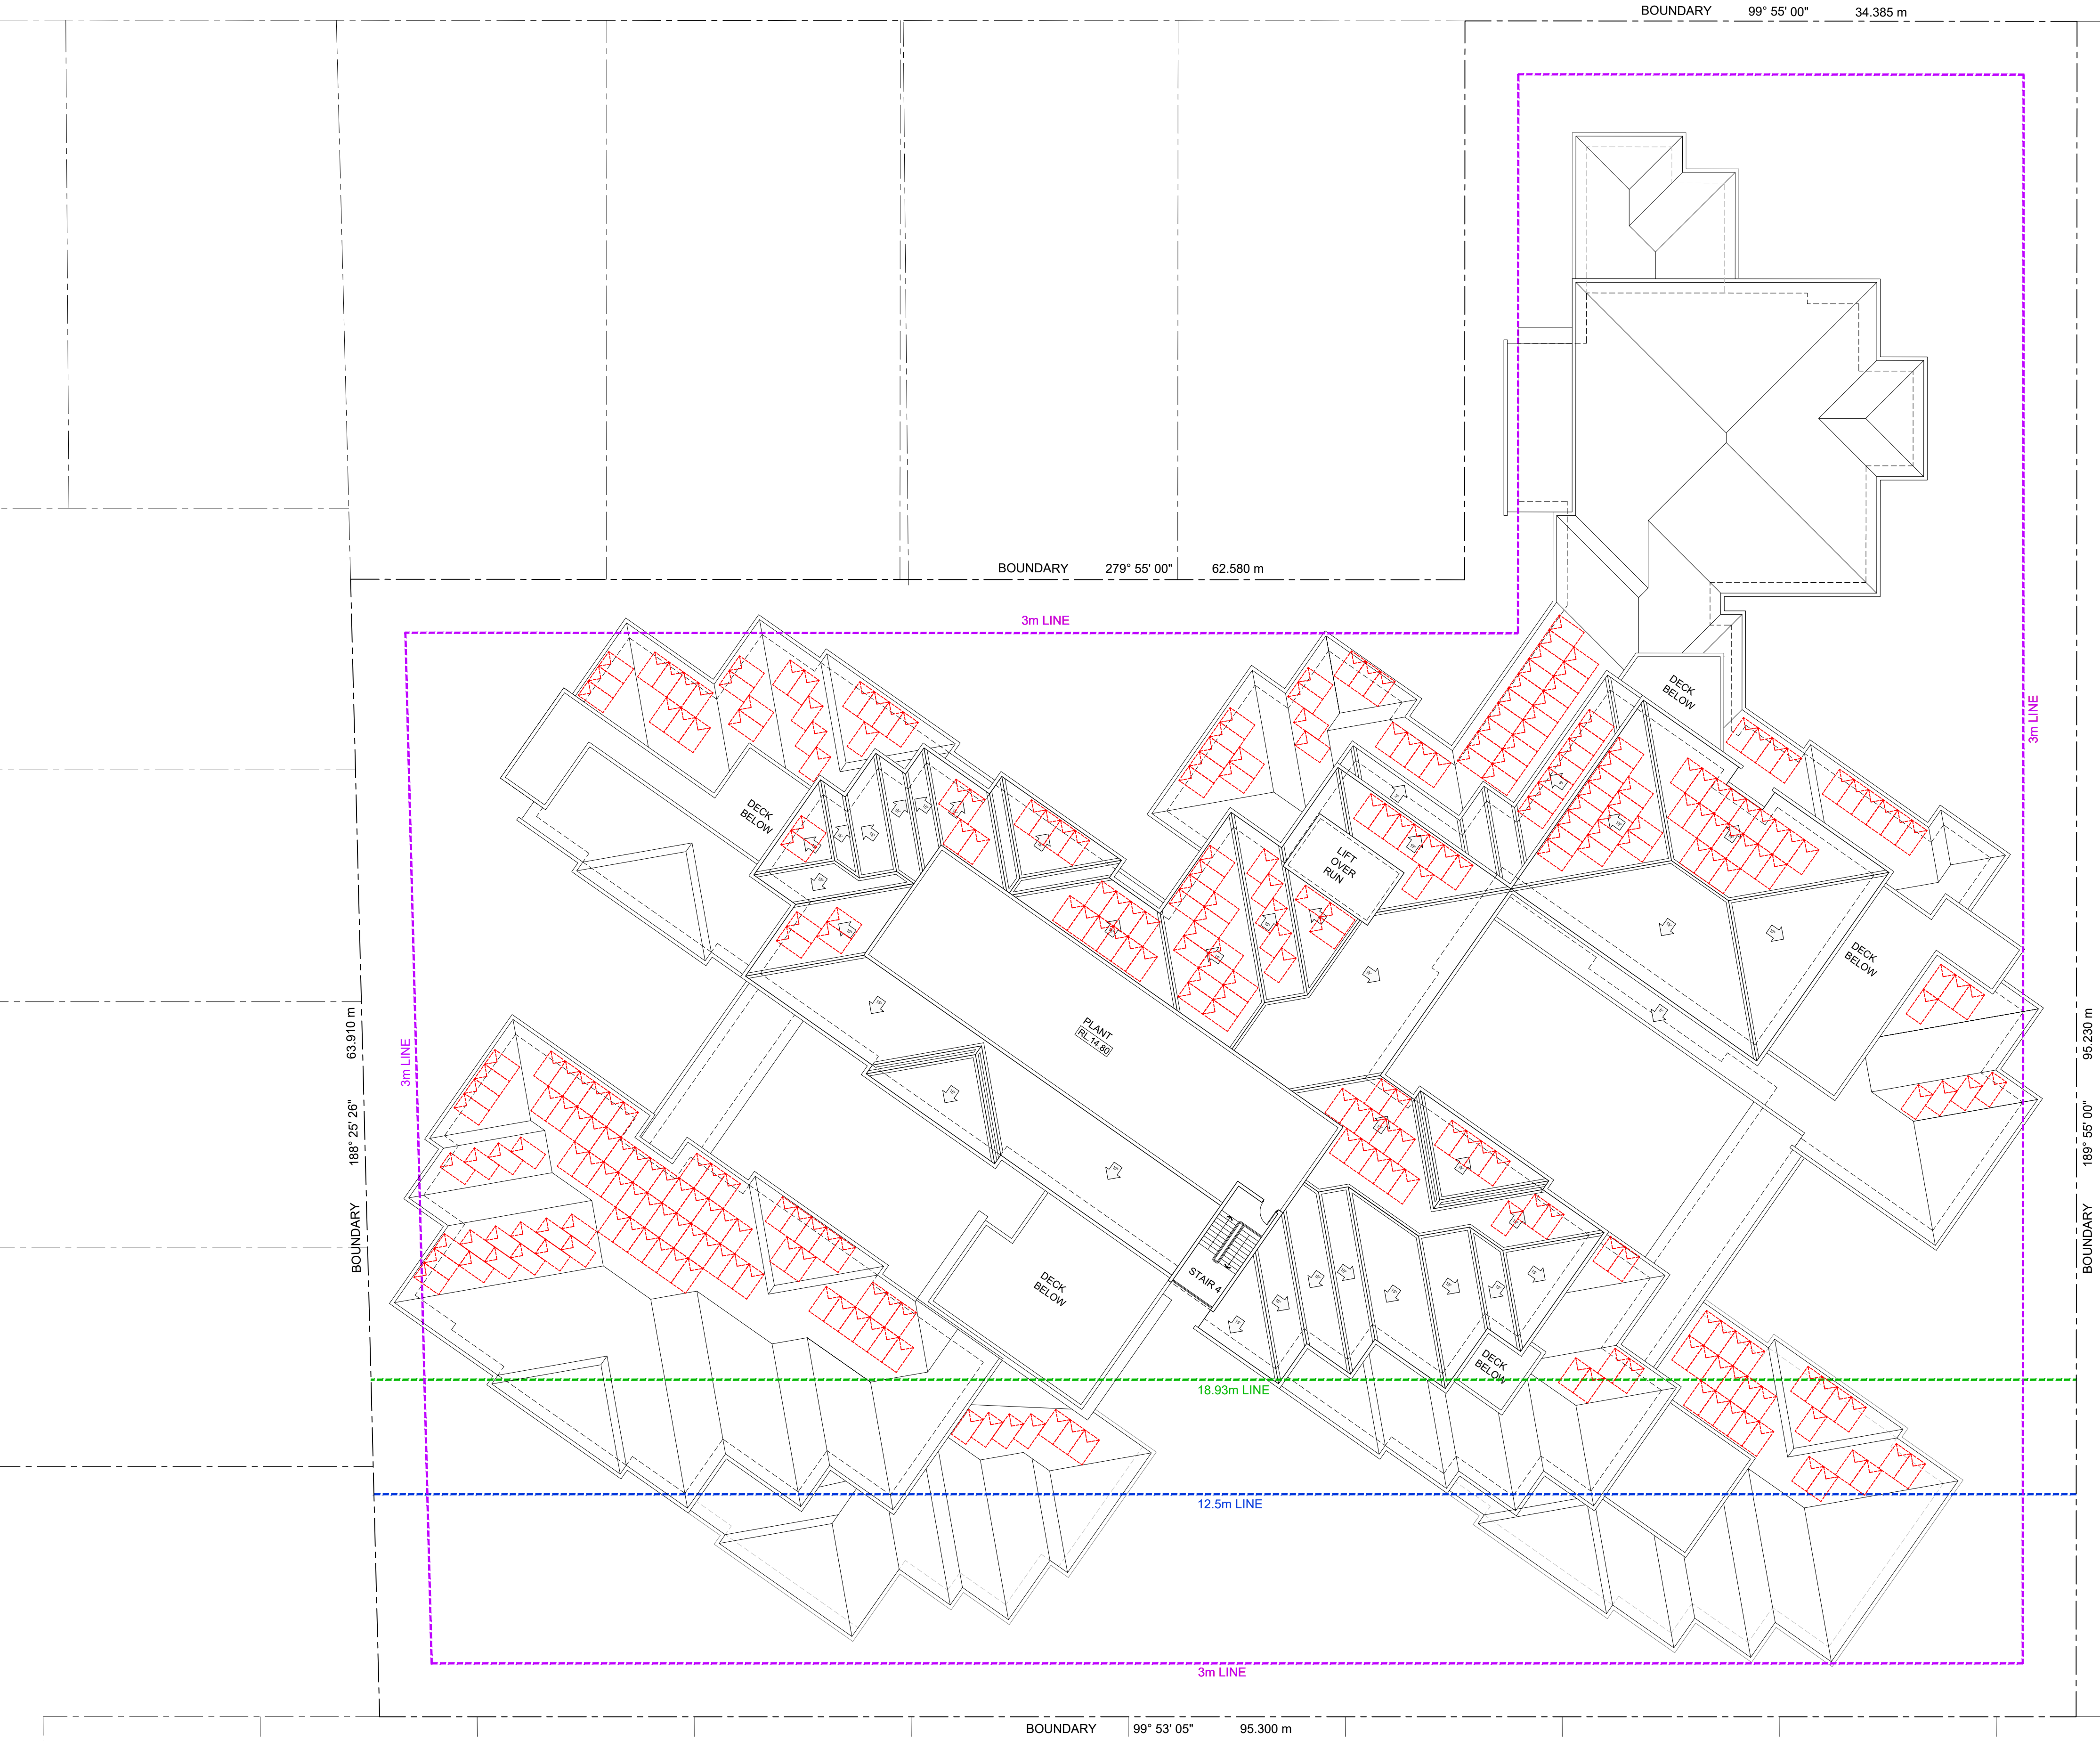

0m	2	5	10	15m
SCALE: 1:200				
B	Development Application Re-Issue			18.08.2021
A	Development Application Issue			09.12.2020
No.	Amendment			Date

Project  
SUMMITCARE - MONTEREY  
119 Barton Street, Monterey, N.S.W 2217

Drawing  
ROOF PLAN

CENTURION GROUP  
YOUR TRUSTED ADVISOR

SUMMITCARE  
WORTH WORTH WELLBEING

boffa robertson group  
architecture, health and aged care planning, project management  
Suite 7, Level 1, Epica, 9 Railway Street  
Chadstone NSW 2067  
AUSTRALIA  
Tel: (02) 9406 7000  
Fax: (02) 9406 7009  
Email: brgroup@brgr.net

Date	JULY 2021	Job No.	: Drawing
Scale	1:200 @ A1		
Drawn	JN	2014 /	DA08
Amendment	B		

---

# Creating great environments with great people

**Melbourne**  
Level 11, 60 Albert Road  
South Melbourne VIC 3205  
t. 03 9521 1195

**Sydney**  
Level 3, 8 Spring Street  
Sydney NSW 2000  
t. 02 8203 5447

**Brisbane**  
Ground Floor, 102 Adelaide Street  
Brisbane QLD 4000  
t. 07 3088 4022

[adpconsulting.com.au](http://adpconsulting.com.au)