



Do not scale drawing, figured dimensions only to be used. Dimensions to be verified on site before the fabrication of any building components. These designs & plans are copyright & are not to be used or reproduced wholly or in part without the written permission of P.R.D Architects.

FOR
INFORMATION

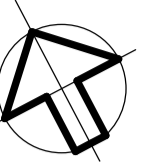

AMENDMENTS			
No.	Revision Description	Date	Issued by
1	Issued For QS review	30.09.19	
2	80% REVIEW	18.10.19	
3	80% ISSUE	14.11.19	
4	TENDER - DRAFT	11.12.19	
5	TENDER ISSUE	18.12.19	
6	MARKED UP WITH FENCING DETAILS	21.06.20	

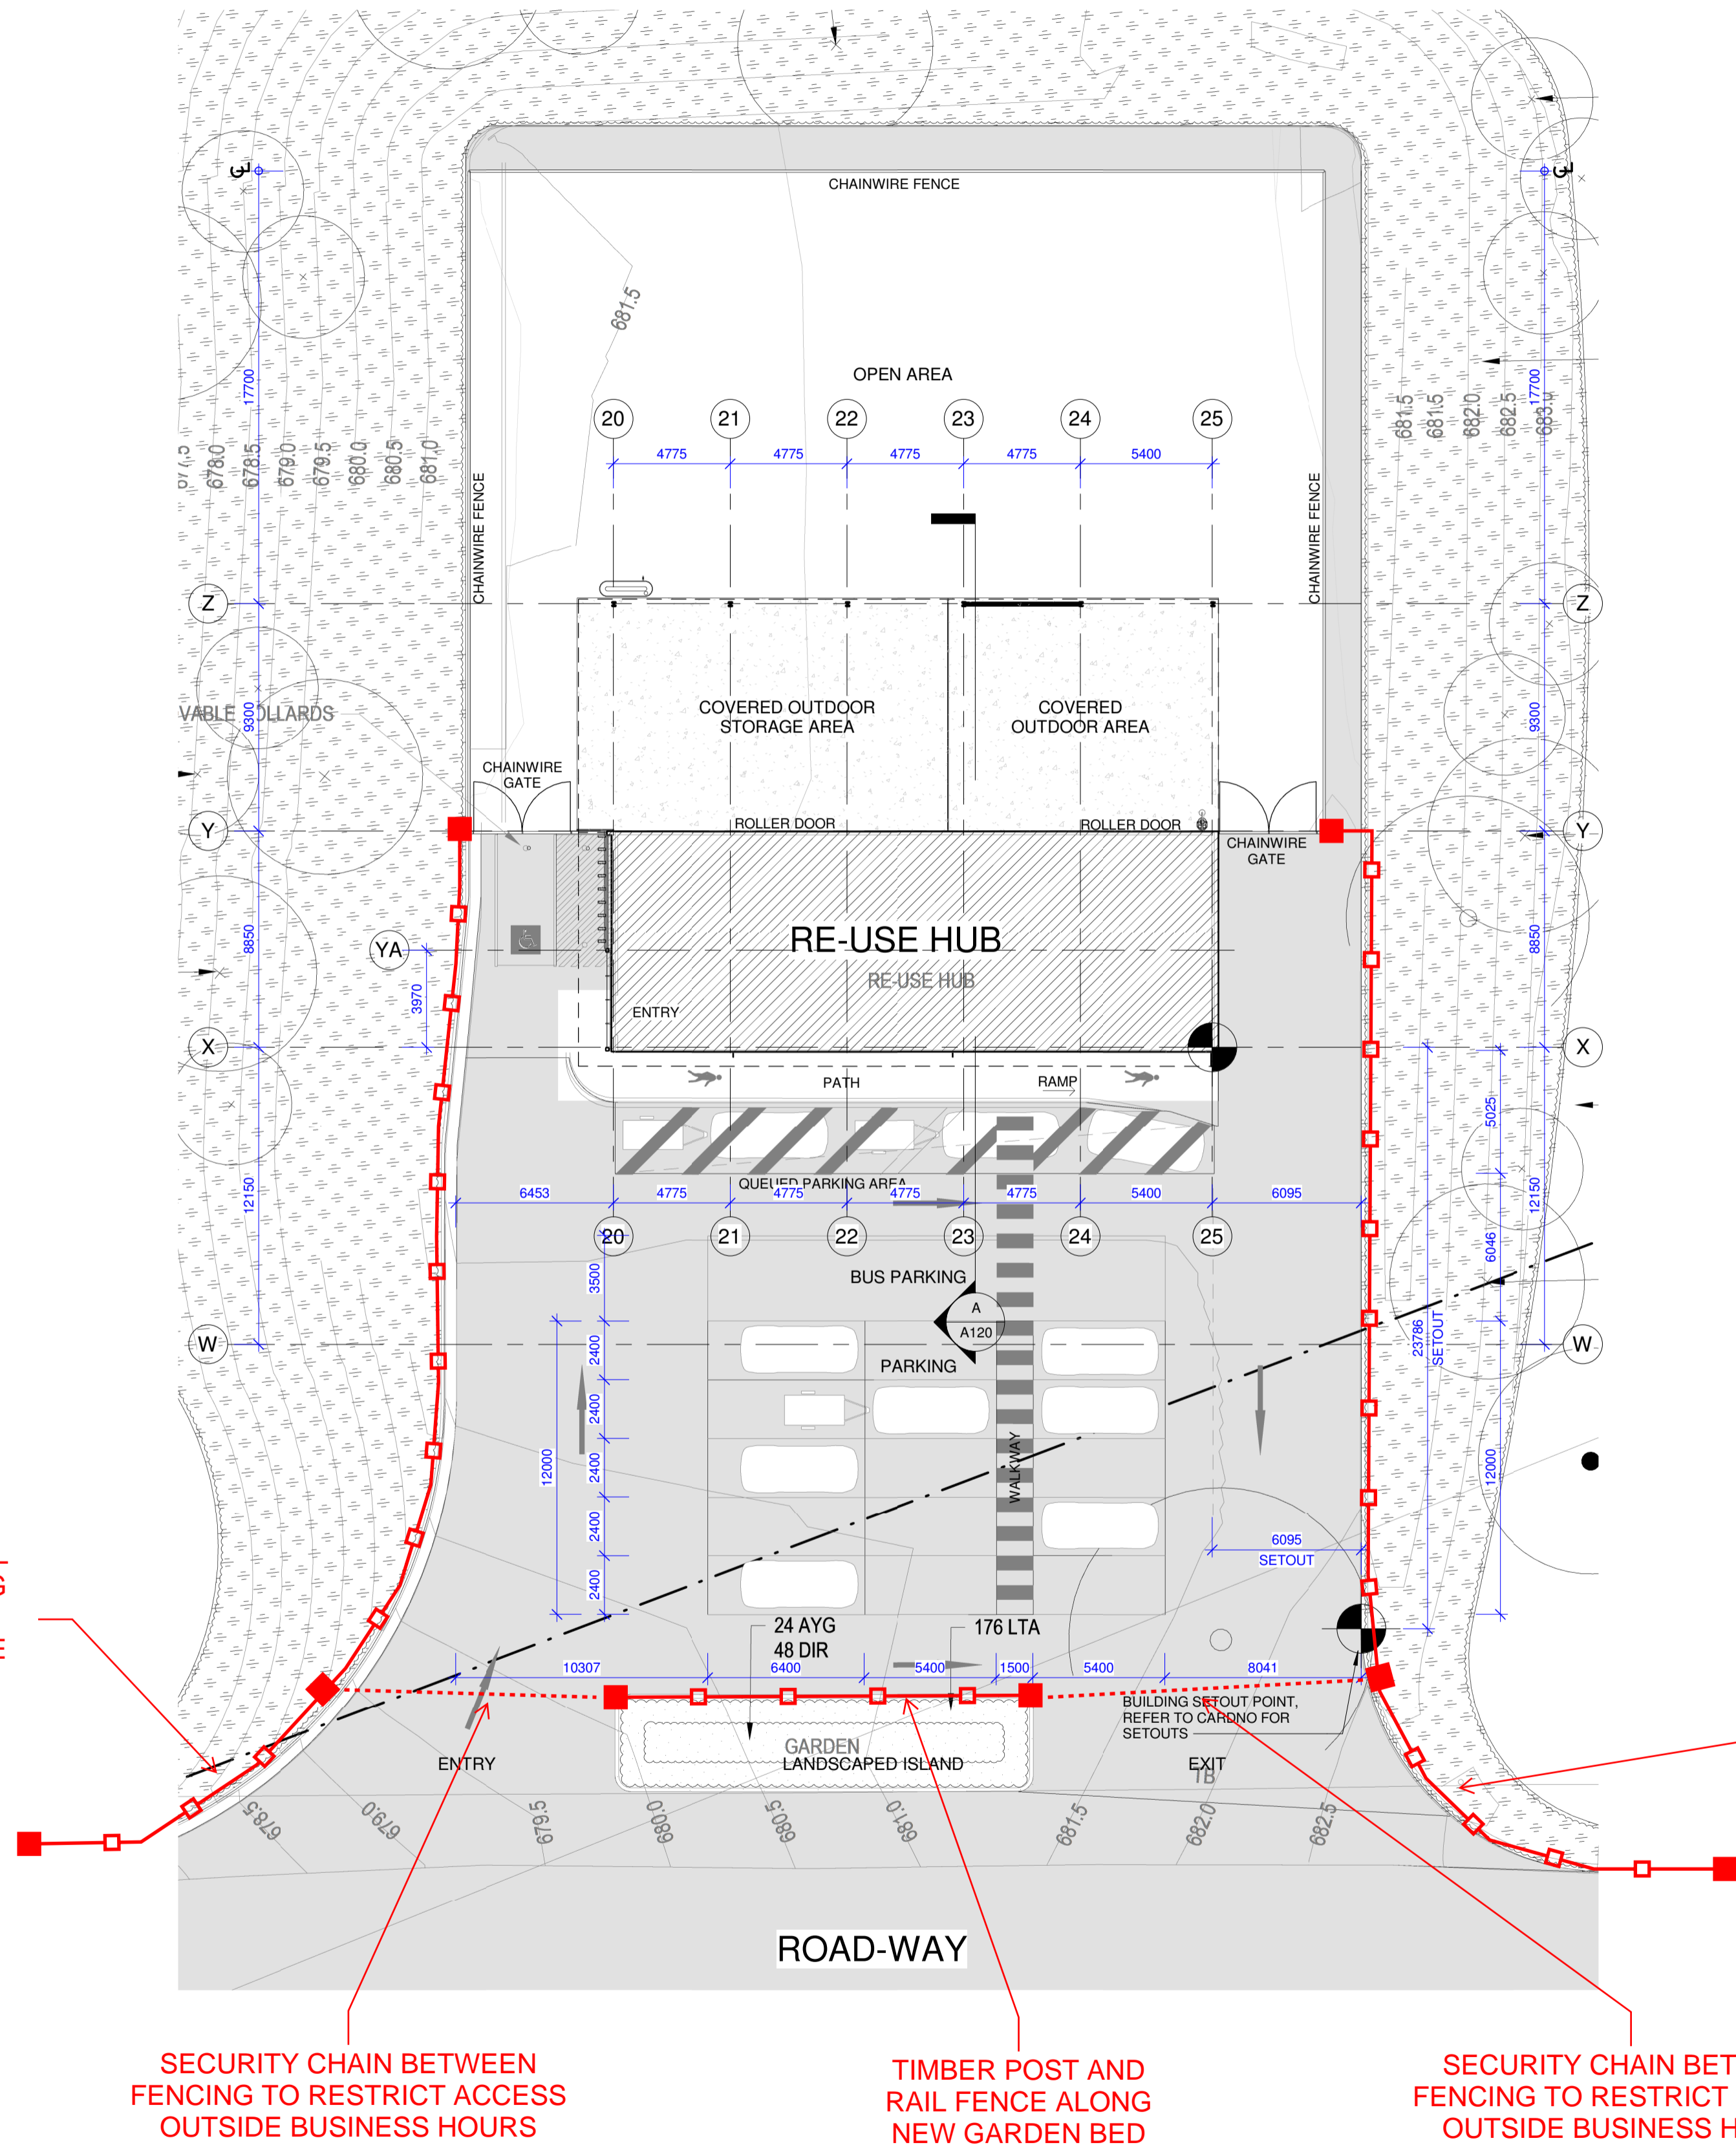

INDICATIVE TIMBER POST AND RAIL FENCE TYPES



TIMBER POST AND RAIL FENCE FROM EXISTING BOUNDARY FENCE ON SINCLAIR ST TO REUSE HUB FENCING

TIMBER POST AND RAIL FENCE FROM EXISTING BOUNDARY FENCE ON SINCLAIR ST TO REUSE HUB FENCING

SECURITY CHAIN BETWEEN FENCING TO RESTRICT ACCESS OUTSIDE BUSINESS HOURS

TIMBER POST AND RAIL FENCE ALONG NEW GARDEN BED

SECURITY CHAIN BETWEEN FENCING TO RESTRICT ACCESS OUTSIDE BUSINESS HOURS



Project:

GMC RUG
SINCLAIR STREET, GOULBURN

Client:
CARDNO



Title:
RH - SITE PLAN

PROPOSED SITE FENCING DETAILS

Date: 25.09.19	Design: Designer	Job No:	Dwg:	Rev:
Scale: @A1	Drawn: SG/HS	1 : 200	018-056	A100
Checked: PR				5

(note: scale reduced half @A3)

