
## Cover Sheet + Drawing Index

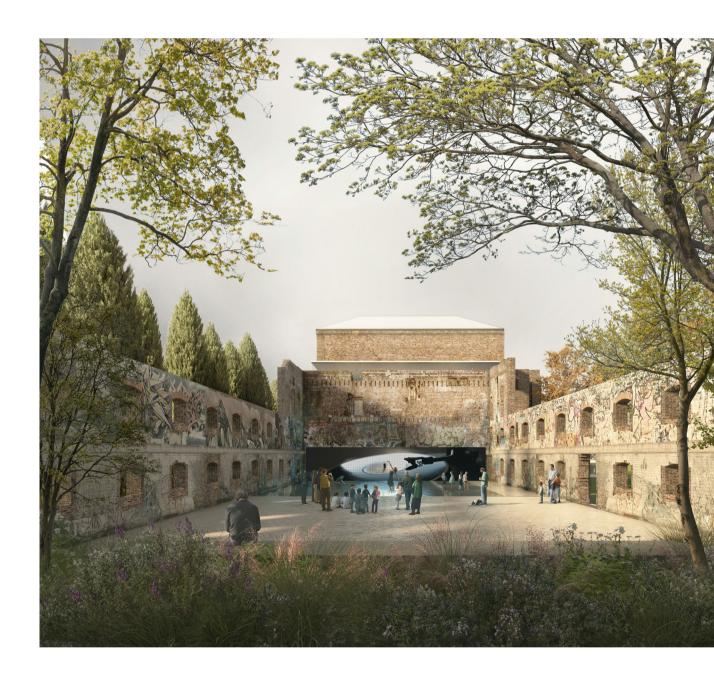

# The Maltings


### Mittagong, NSW M1, M2, MALTSTER'S HOUSE

		SHEET LIST S	S.4.55 SERIES		
No.	Title	Current Revision	Sheet Sequence SNØ	Sheet Series SNØ	Current Revision Date
M1/2 000	Cover Sheet + Drawing Index	G	0000 - Preliminaries	Cover	25.10.2024
	GFA Schedules	E	0000 - Preliminaries	Legends	12.02.2024
	M1/M2 Site plan	E	0100 - Overview Precinct	Site	12.02.2024
	M1/2 Demolition Plan - Ground (L00) - L01	F	0300 - Demolition	1-300	13.09.2024
	M1/2 Demolition Plan - L02 - L03	E	0300 - Demolition	1-300	12.02.2024
	M1/2 Demolition Plan - Roof	E	0300 - Demolition	1-300	12.02.2024
	M1/2 Plan Ground (L00)-01	G	1100 - General Arrangement - Floor Plans	1-300	25.10.2024
	M1/2 Plan L02-03	F	1100 - General Arrangement - Floor Plans	1-300	13.09.2024
	M1/2 Plan Roof	F	1100 - General Arrangement - Floor Plans	1-300	13.09.2024
	M1/2 GFA Plans	E	1800 - Other Project Required Plans	1-300	12.02.2024
M1/2 2000	M1/2 Elevations (Exterior)	G	2000 - Elevations (Exterior)	1-100	25.10.2024
	M1/2 Sections	G	3000 - Sections	1-100	25.10.2024
	M1/2 + MH Materials Schedule	E	6000 - Schedules & Diagrams	Schedules	12.02.2024
M1/2 + MH 8000	M1/2 + MH Shadow Study - June 21	G	8000 - Shadows	Shadows	25.10.2024
M1/2 + MH 8001	M1/2 + MH Shadow Study Comparison - June 21	G	8000 - Shadows	Shadows	25.10.2024
	Maltster's House Demolition Plan - Ground (L00)	E	0300 - Demolition	1-100	12.02.2024
	Maltster's House Plan - Ground (L00)	E	1100 - General Arrangement - Floor Plans	1-100	12.02.2024
	Maltster's House Plan Roof	E	1100 - General Arrangement - Floor Plans	1-100	12.02.2024
MH 1801	Maltster's House Area Plans	E	1800 - Other Project Required Plans	1-200	12.02.2024
MH 2000	Maltster's House Elevations (Exterior)	G	2000 - Elevations (Exterior)	1-100	25.10.2024
MH 3000	Maltster's House Sections	G	3000 - Sections	1-300	25.10.2024


0 1	2	5		10 m
Scale 1:10	0			
millimetres to Project C writing for d	unless noted ot commencement ecision before p	recedence to scaled read herwise.   Dimensions ar t.   Any discrepancies are proceeding with work.   D	e to be verified of to be reported f rawing is to be r	on Site prior o Snøhetta in ead in
and Drawing	gs.   This drawi	t and associated materia ng is an uncontrolled cop	y, unless noted	otherwise.
© Copyright	of this drawing	j is vested in Snøhetta un	lless otherwise i	ndicated.
G Res	nonse to Counc	nil DEI		25 10 2024
F Res	ponse to Counc ponse to Counc S 4 55 Applicat	cil RFI		25.10.2024 13.09.2024 12.02.2024
F Res E For		cil RFI		
F Res E For D Fina	ponse to Counc S.4.55 Applicat	cil RFI ion		13.09.2024 12.02.2024 20.12.2023








Reference Map 0 1 2 5 10 m Scale 1:100 Notes Figured dimensions take precedence to scaled readings.| All dimensions are in millimetres unless noted otherwise. | Dimensions are to be verified on Site prior to Project Commencement. | Any discrepancies are to be reported to Snøhetta in writing for decision before proceeding with work. | Drawing is to be read in conjunction with all relevant and associated material, Contracts, Specifications and Drawings. | This drawing is an uncontrolled copy, unless noted otherwise. © Copyright of this drawing is vested in Snøhetta unless otherwise indicated. E For S.4.55 Application 12.02.2024 D Final Draft Revision 20.12.2023 Date Description Consultant Consultant Consultant THE MALTINGS MITTAGONG NSW 2575 MEDICH FAMILY OFFICE Consultant Snøhetta D Snøhetta Australasia Pty Ltd ABN 74 612 295 735 178 Sturt Street, Adelaide SA 5000 Australia Statu For S.4.55 Application 0000 - Preliminaries GFA Schedules Scale @ A1 Drawn Approved Reviewed SNO SM KK Sheet Number M1/2 002 Project Number Rev 18-17 Е Original Sheet Format A1 | 841 x 594mm

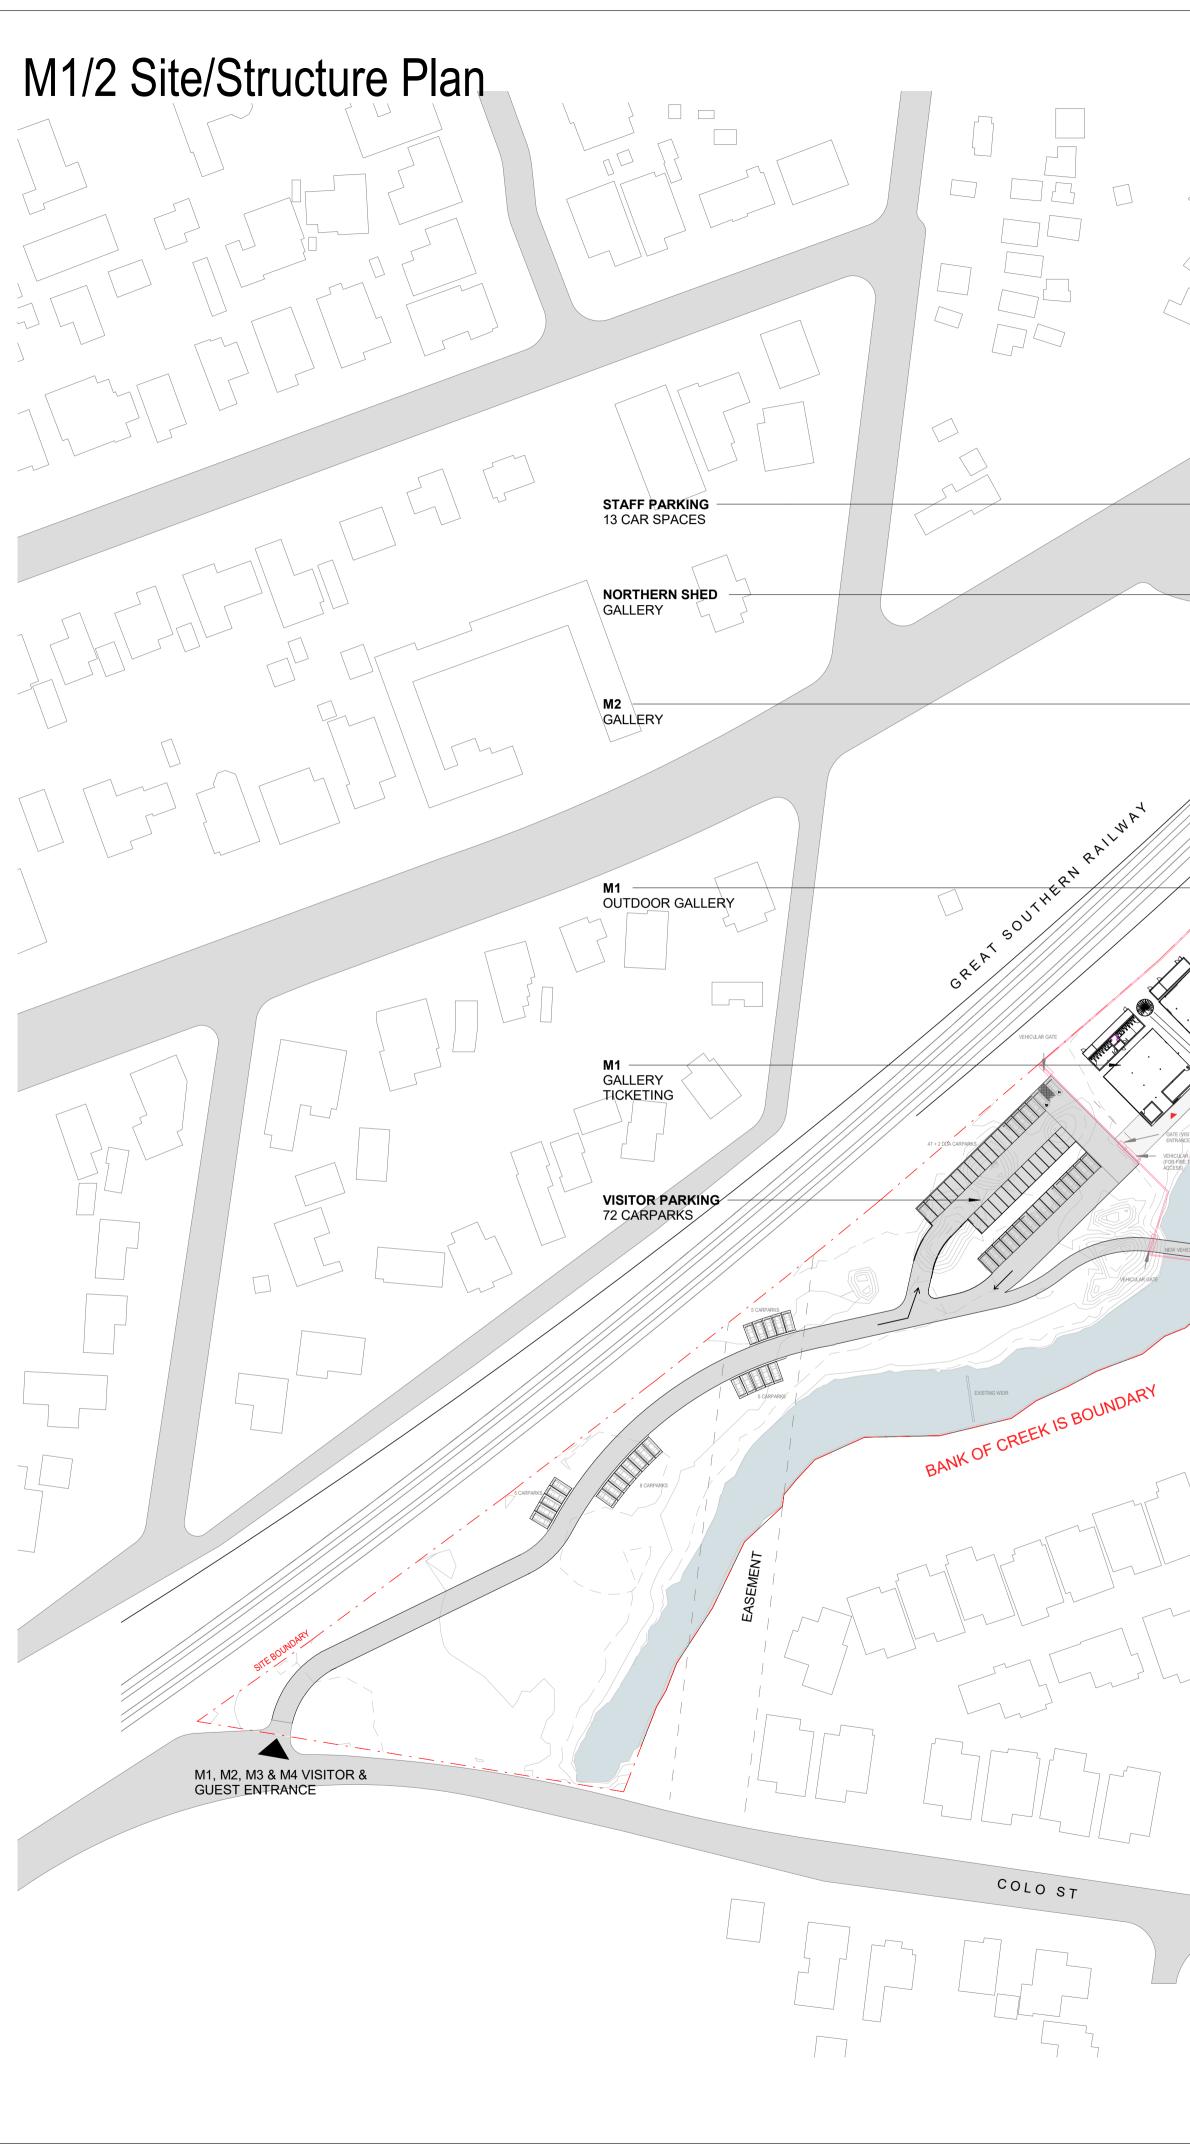


BOH ENTRANCE FITZROY INN O J H EXISTING BRICK S EXISTING UNDERGROUND RUNWATER TANK ADJACENT PROPERTIES M3 & M4 BOH ENTRANCE S ш SOUTH 

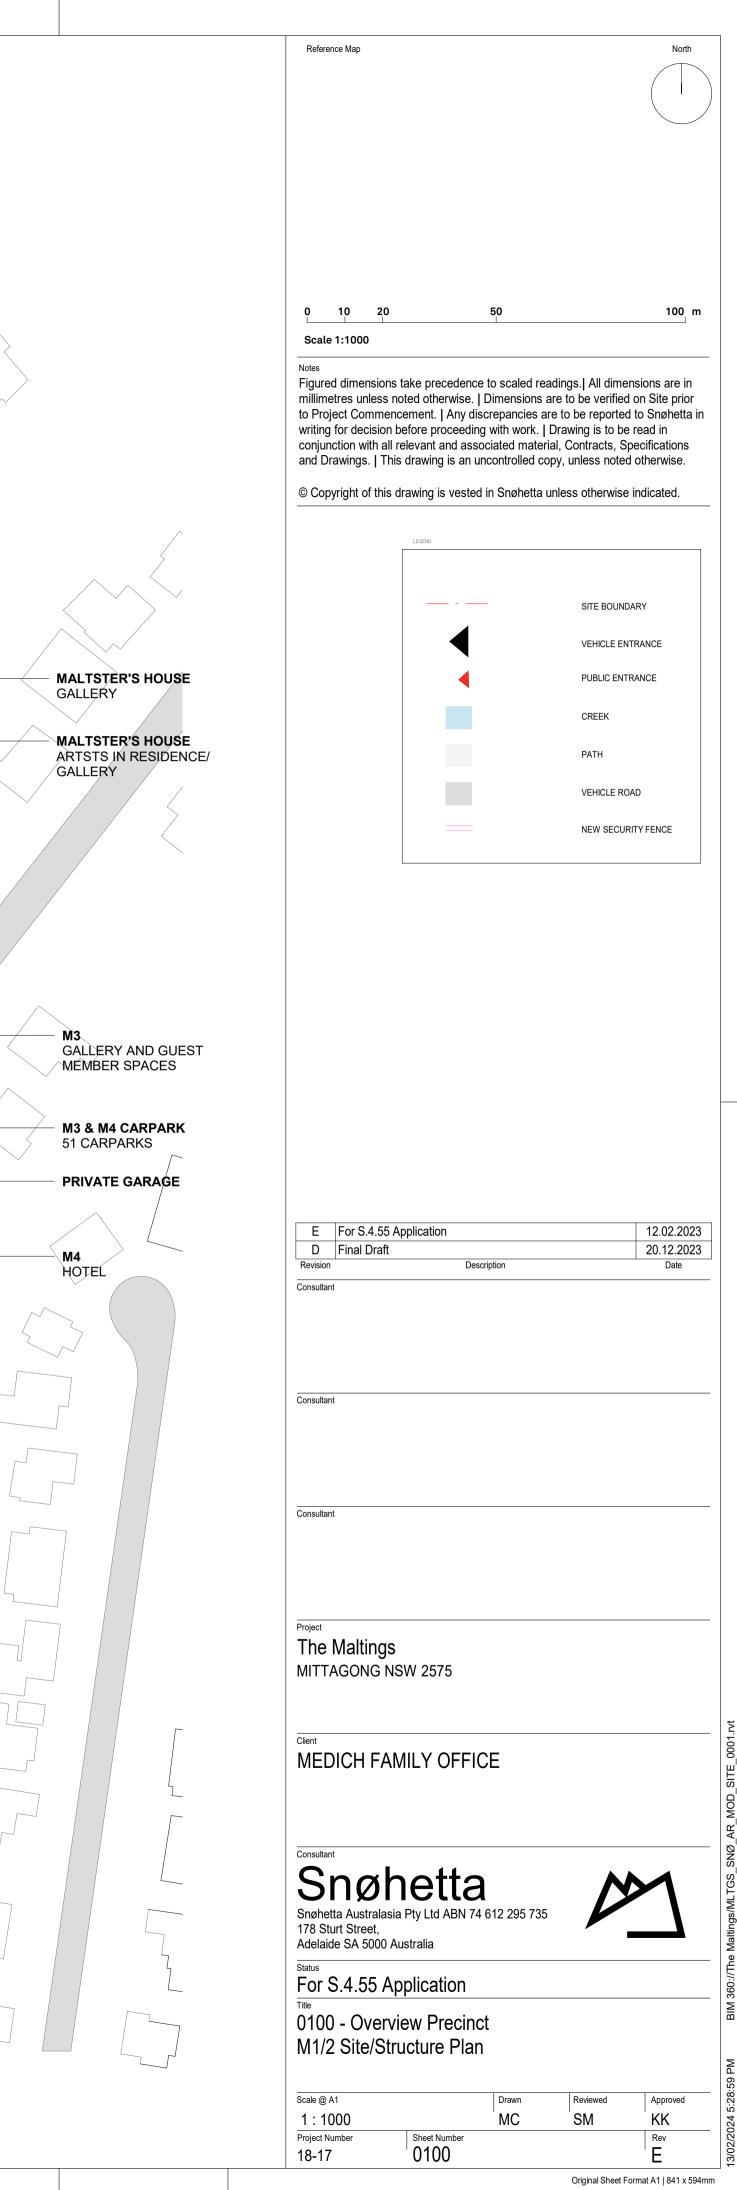

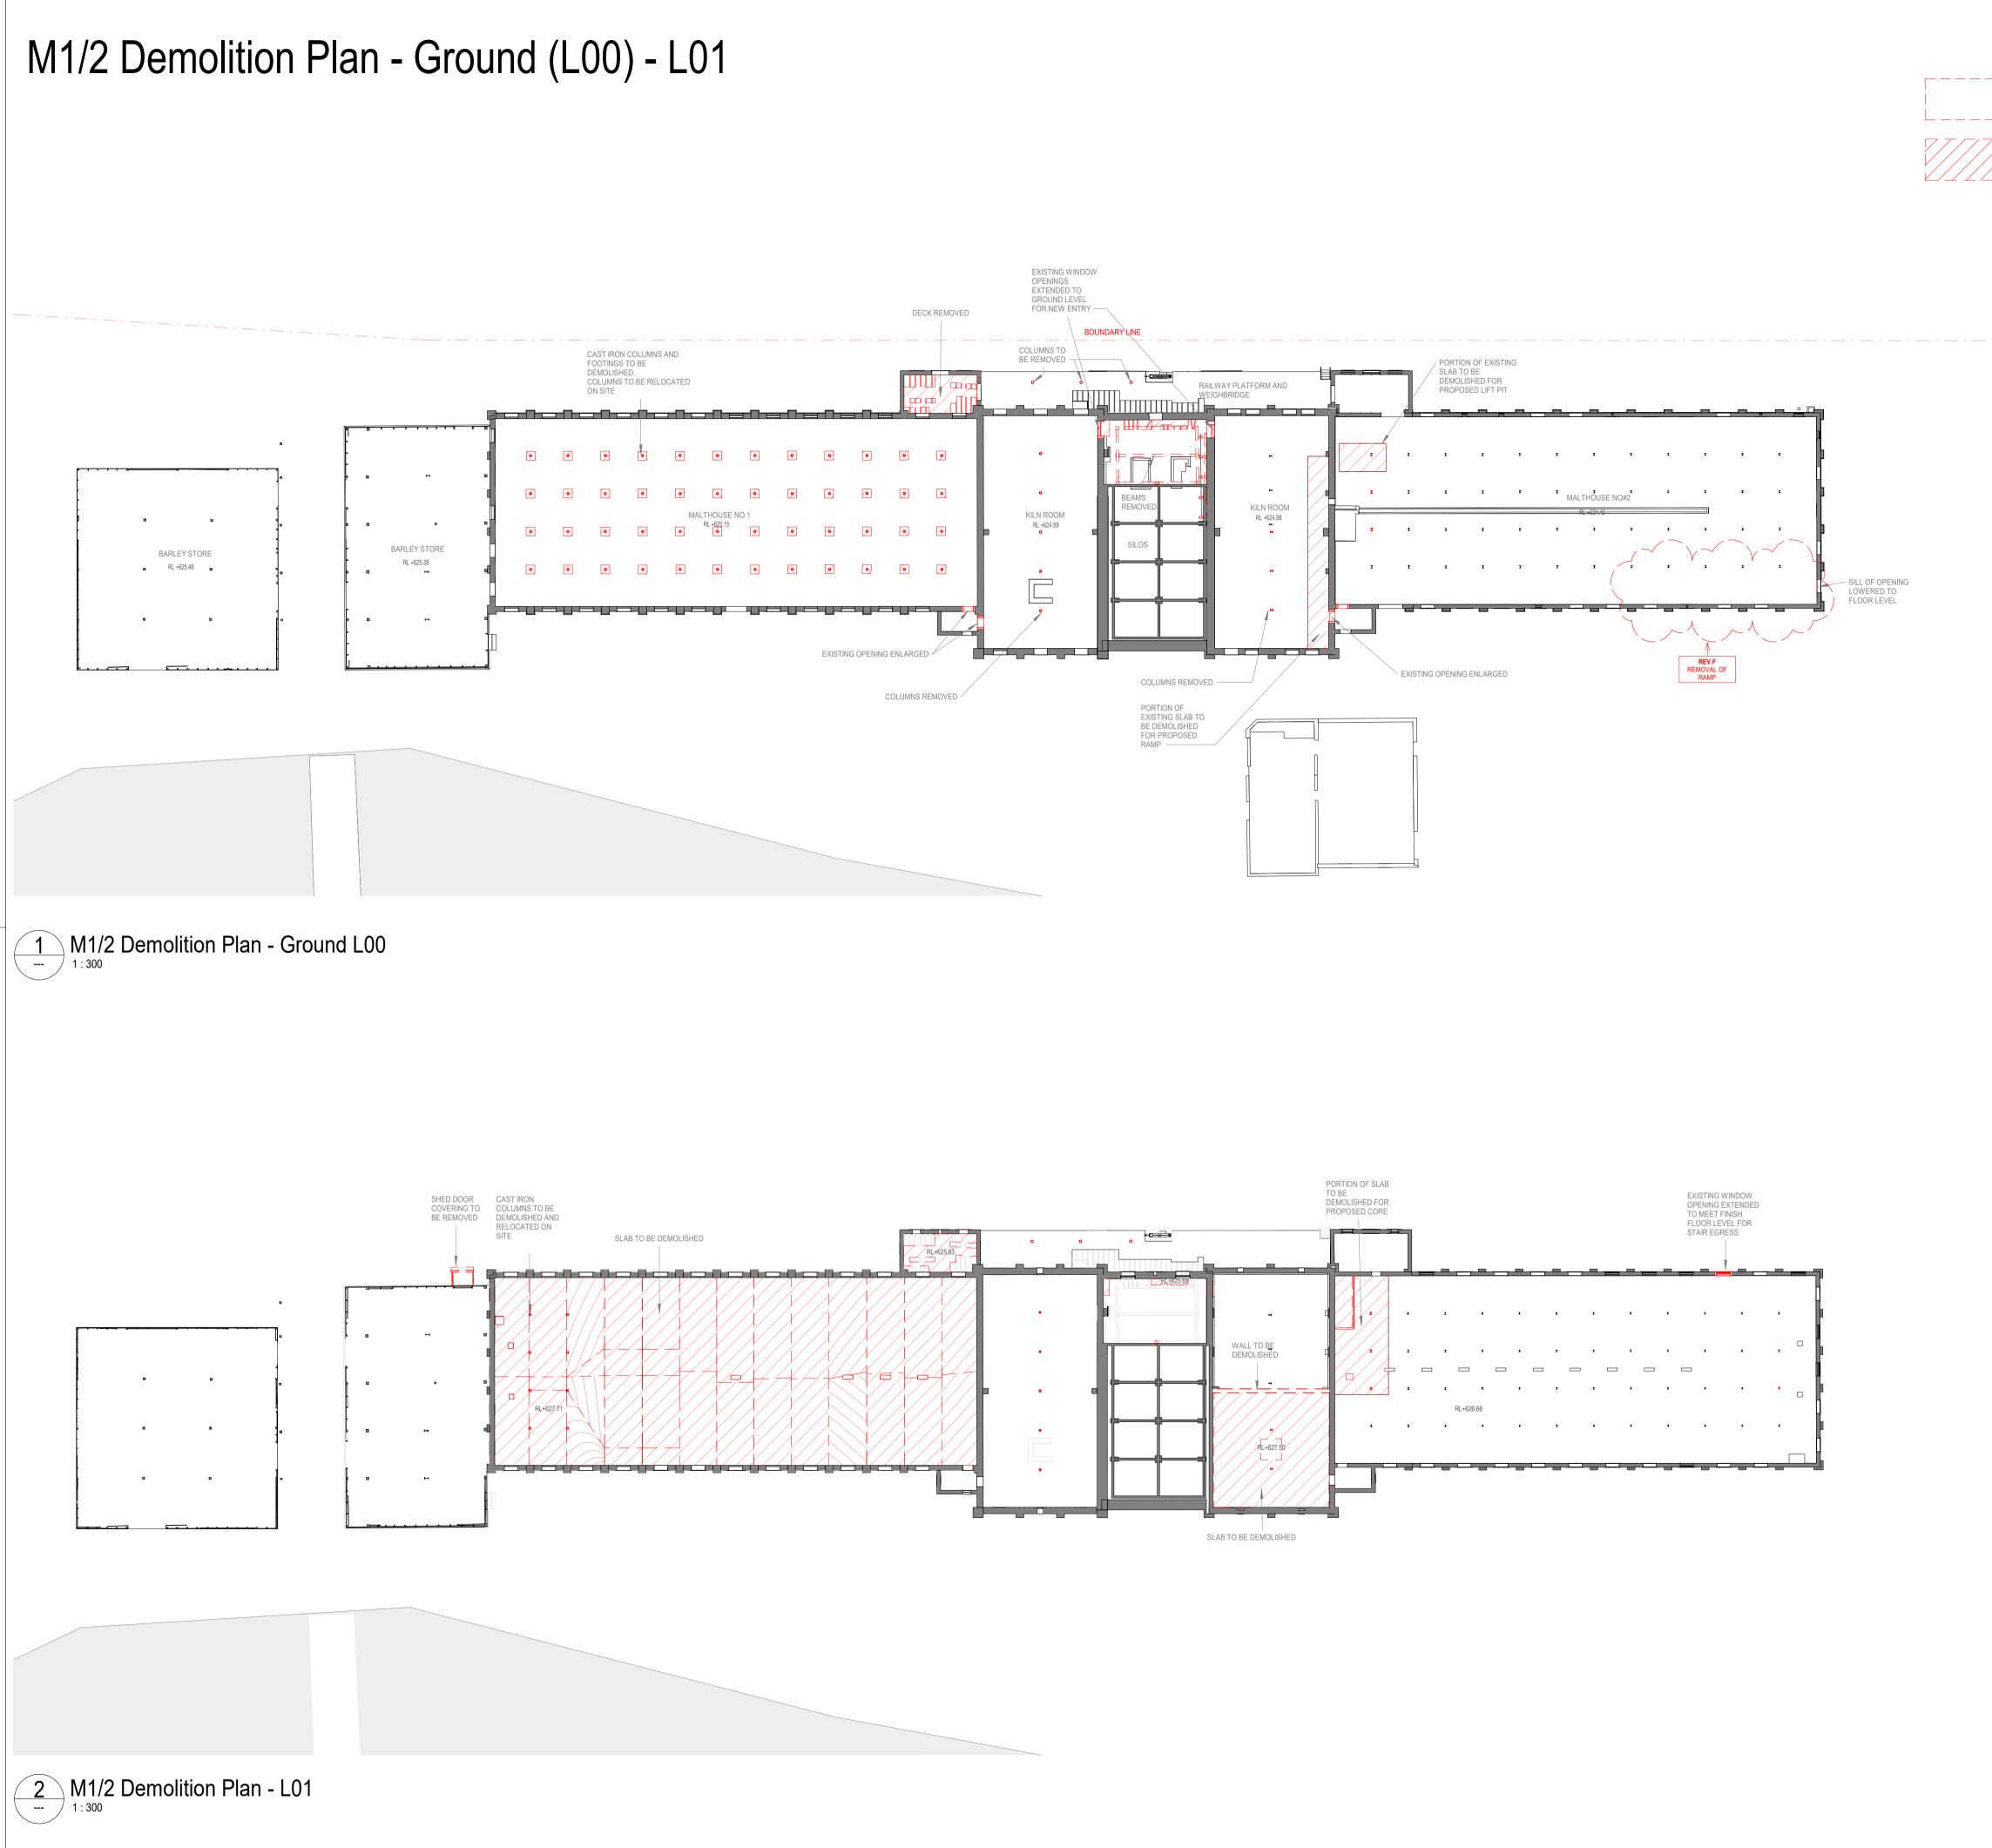

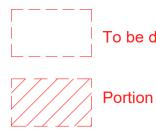

	Reference Map	North
nolished		
slab/roof to be demolished		
		30 m
	Scale 1:300 Notes	
	Figured dimensions take precedence to scaled readings.   All dimensions and millimetres unless noted otherwise.   Dimensions are to be verified on Site to Project Commencement.   Any discrepancies are to be reported to Snøh	prior hetta i
	writing for decision before proceeding with work.   Drawing is to be read in conjunction with all relevant and associated material, Contracts, Specification and Drawings.   This drawing is an uncontrolled copy, unless noted otherwise	ions
	© Copyright of this drawing is vested in Snøhetta unless otherwise indicated	
~		
	F Response to Council RFI 13.09	9.2024
	EFor S.4.55 Application12.02DFinal Draft20.12	2.2024 2.2023
	B For Coordination 29.11	2.2023 1.2023 1.2023
		)ate
	Consultant	
	Consultant	
	Project THE MALTINGS	
	MITTAGONG NSW 2575	
	Client	
	Consultant	
	Consultant	
	Consultant Snøhetta Australasia Pty Ltd ABN 74 612 295 735 178 Sturt Street,	
	Consultant <b>Snøhetta</b> Australasia Pty Ltd ABN 74 612 295 735 178 Sturt Street, Adelaide SA 5000 Australia Status	
	Consultant           Snøhetta Australasia Pty Ltd ABN 74 612 295 735         Image: Consultant Street           Snøhetta Australasia Pty Ltd ABN 74 612 295 735         Image: Consultant Street           Adelaide SA 5000 Australia         Image: Consultant Stratus           Status         For S.4.55 Application           Title         Title	
	Consultant <b>Snøhetta</b> Australasia Pty Ltd ABN 74 612 295 735 178 Sturt Street, Adelaide SA 5000 Australia Status For S.4.55 Application	
	Consultant Snøhetta Australasia Pty Ltd ABN 74 612 295 735 178 Sturt Street, Adelaide SA 5000 Australia Status For S.4.55 Application Title 0300 - Demolition	

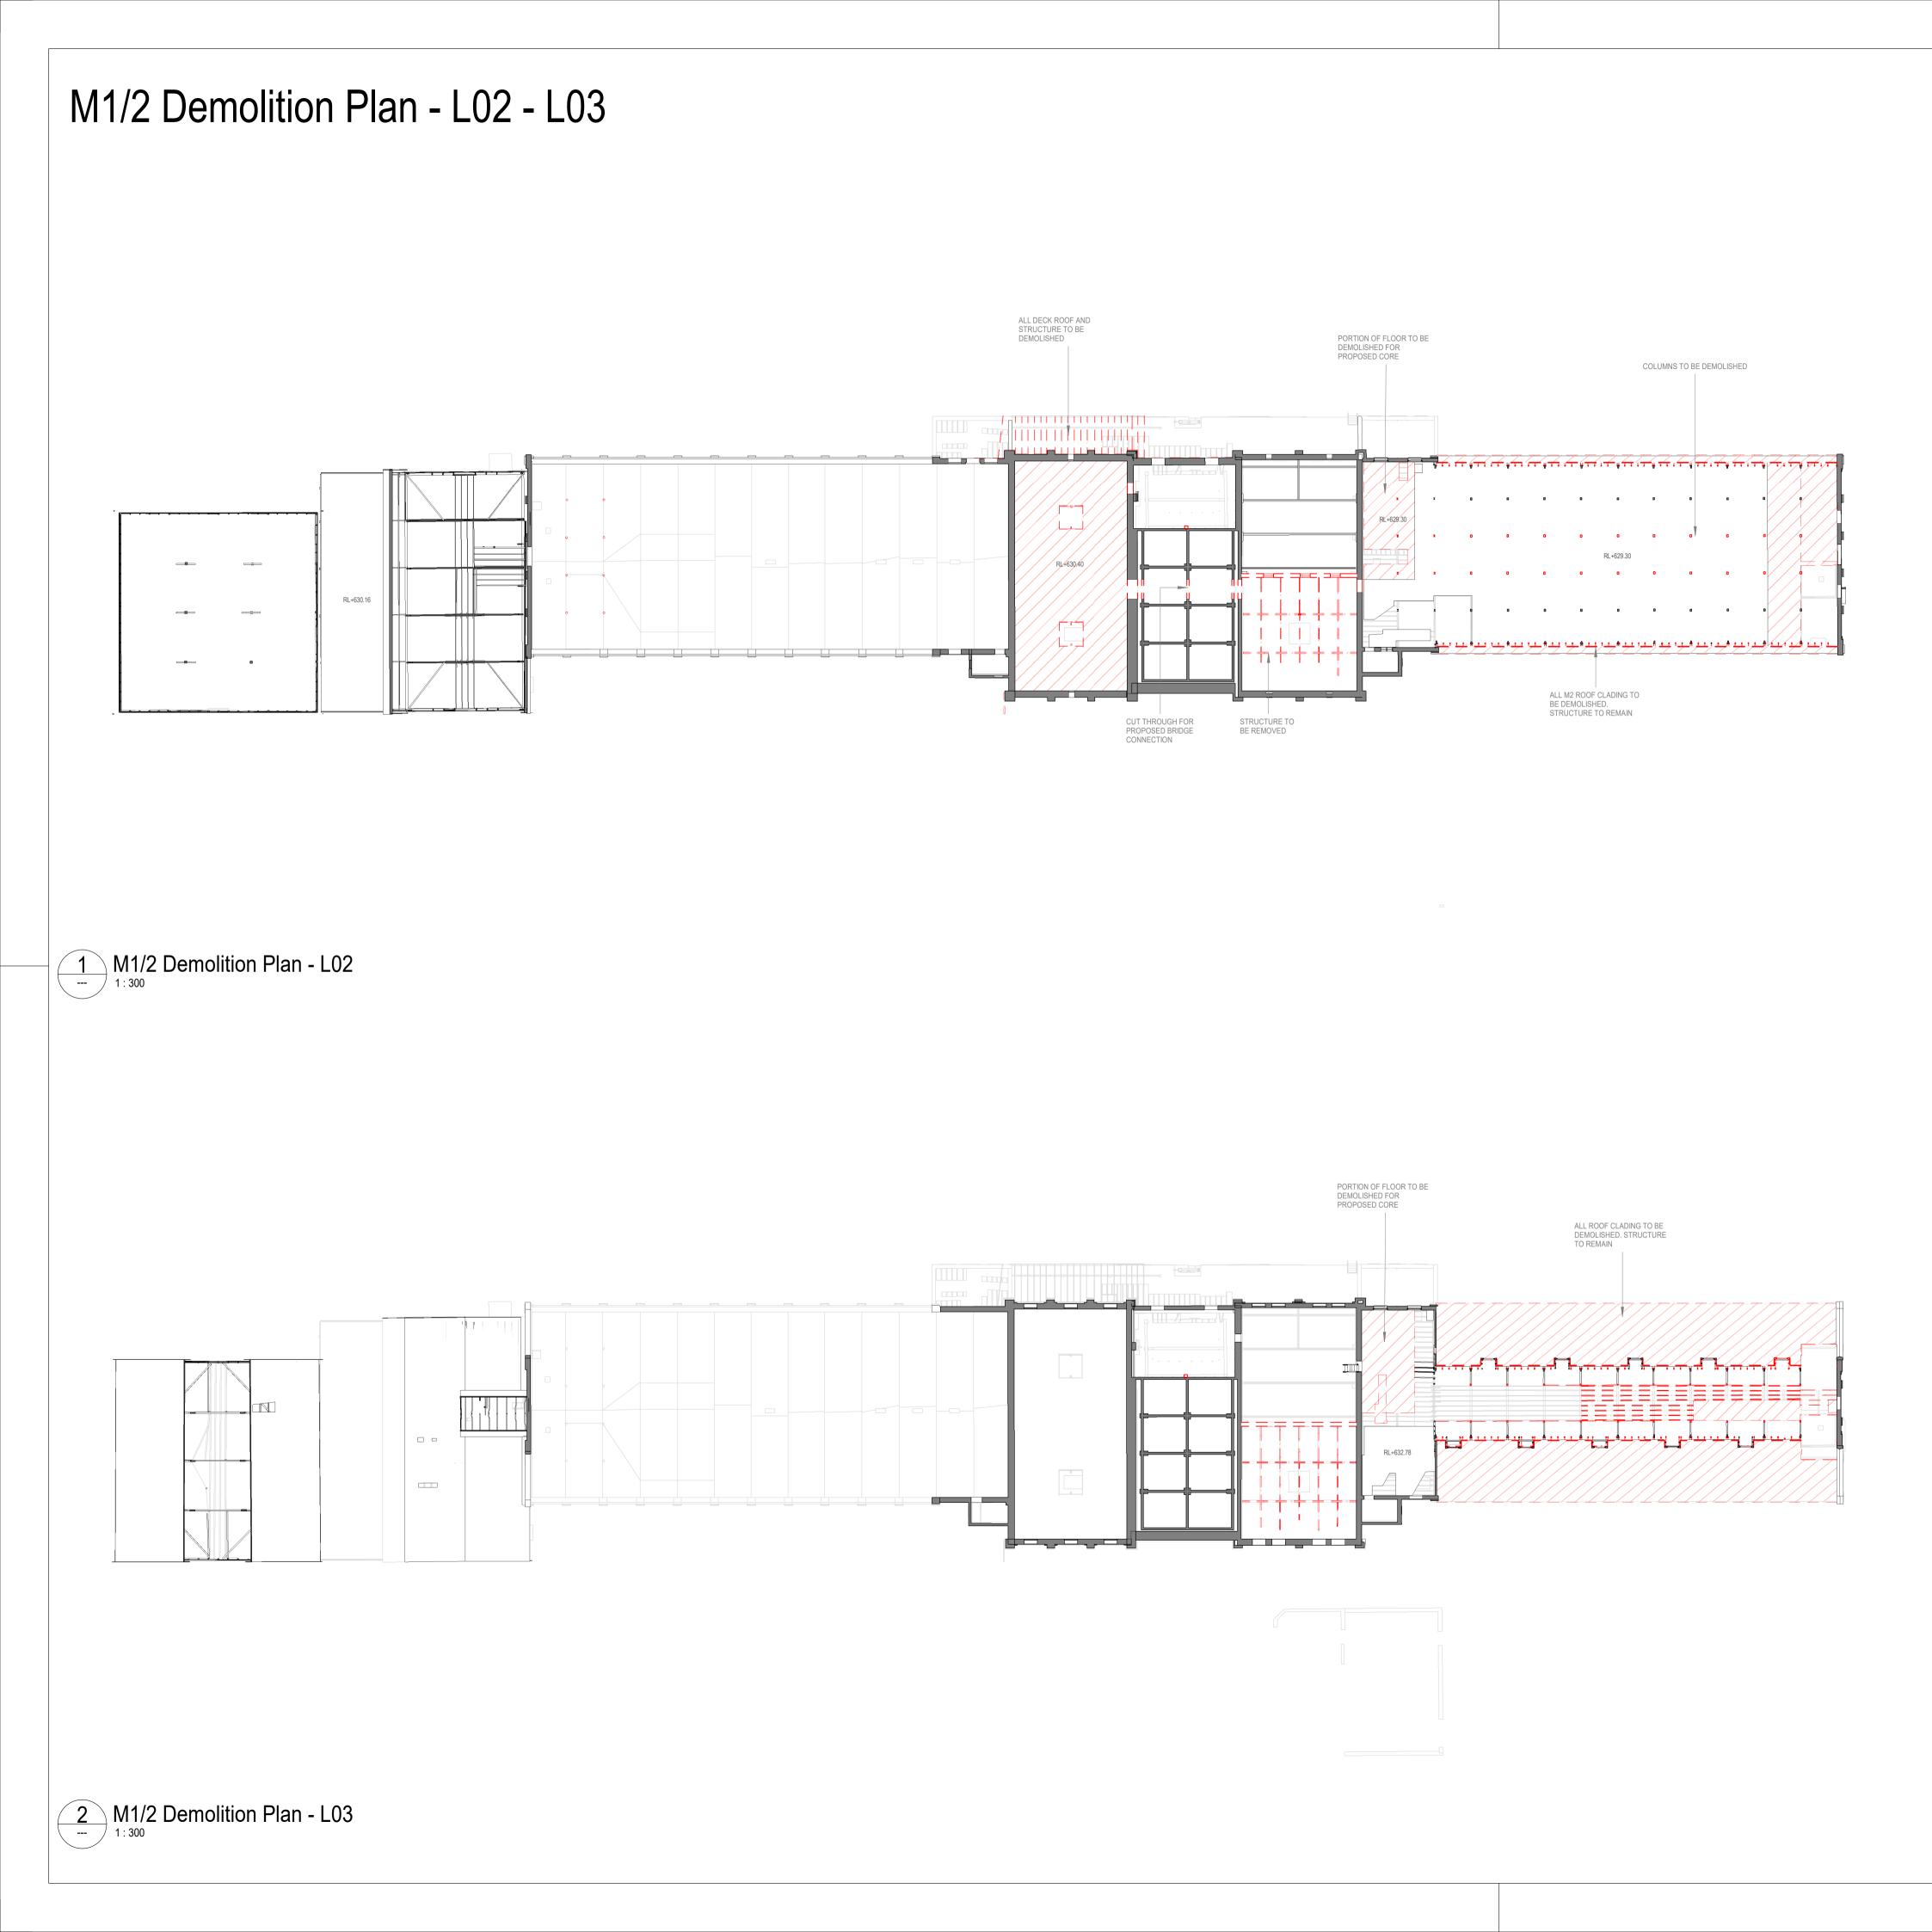

To be dem


nolished		
slab/roof to be demolished	0       3       6       15         Scale 1:300         Notes         Figured dimensions take precedence to scaled millimetres unless noted otherwise.   Dimensio to Project Commencement.   Any discrepancie writing for decision before proceeding with wor conjunction with all relevant and associated marked and Drawings.   This drawing is an uncontrolled         © Copyright of this drawing is vested in Snøher	ns are to be verified on Site prior es are to be reported to Snøhetta ir k.   Drawing is to be read in aterial, Contracts, Specifications d copy, unless noted otherwise.
	E       For S.4.55 Application         D       Final Draft         C       For Coordination         B       For Coordination         A       For Coordination	12.02.2024 20.12.2023 08.12.2023 29.11.2023 03.11.2023
	Revision     Description       Consultant	Date
	Project THE MALTINGS MITTAGONG NSW 2575	
	Consultant Snøhetta Australasia Pty Ltd ABN 74 612 295 7 178 Sturt Street, Adelaide SA 5000 Australia Status For S.4.55 Application Title 0300 - Demolition M1/2 Demolition Plan - L02 - L0	

Original Sheet Format A1 | 841 x 594mm






	Reference Map North
edemolished	
on of slab/roof to be demolished	0 3 6 15 30 r Scale 1:300
	Notes Figured dimensions take precedence to scaled readings.   All dimensions are in millimetres unless noted otherwise.   Dimensions are to be verified on Site prior to Project Commencement.   Any discrepancies are to be reported to Snøhetta writing for decision before proceeding with work.   Drawing is to be read in conjunction with all relevant and associated material, Contracts, Specifications and Drawings.   This drawing is an uncontrolled copy, unless noted otherwise. © Copyright of this drawing is vested in Snøhetta unless otherwise indicated.
	EFor S.4.55 Application12.02.202DFinal Draft20.12.202CFor Coordination08.12.202BFor Coordination29.11.202AFor Coordination03.11.202RevisionDescriptionDateConsultant
	Consultant
	Consultant Project
	THE MALTINGS MITTAGONG NSW 2575
	Consultant Snøhetta Australasia Pty Ltd ABN 74 612 295 735
	Shøhetta Australasia Pty Ltd ABN 74 612 295 735 178 Sturt Street, Adelaide SA 5000 Australia Status For S.4.55 Application Title 0300 - Demolition M1/2 Demolition Plan - Roof
	Scale @ A1     Drawn     Reviewed     Approved       As indicated     SNO     SM     KK       Project Number     Sheet Number     Rev       18-17     M1/2 0302     E       Original Sheet Format A1   841 x 55

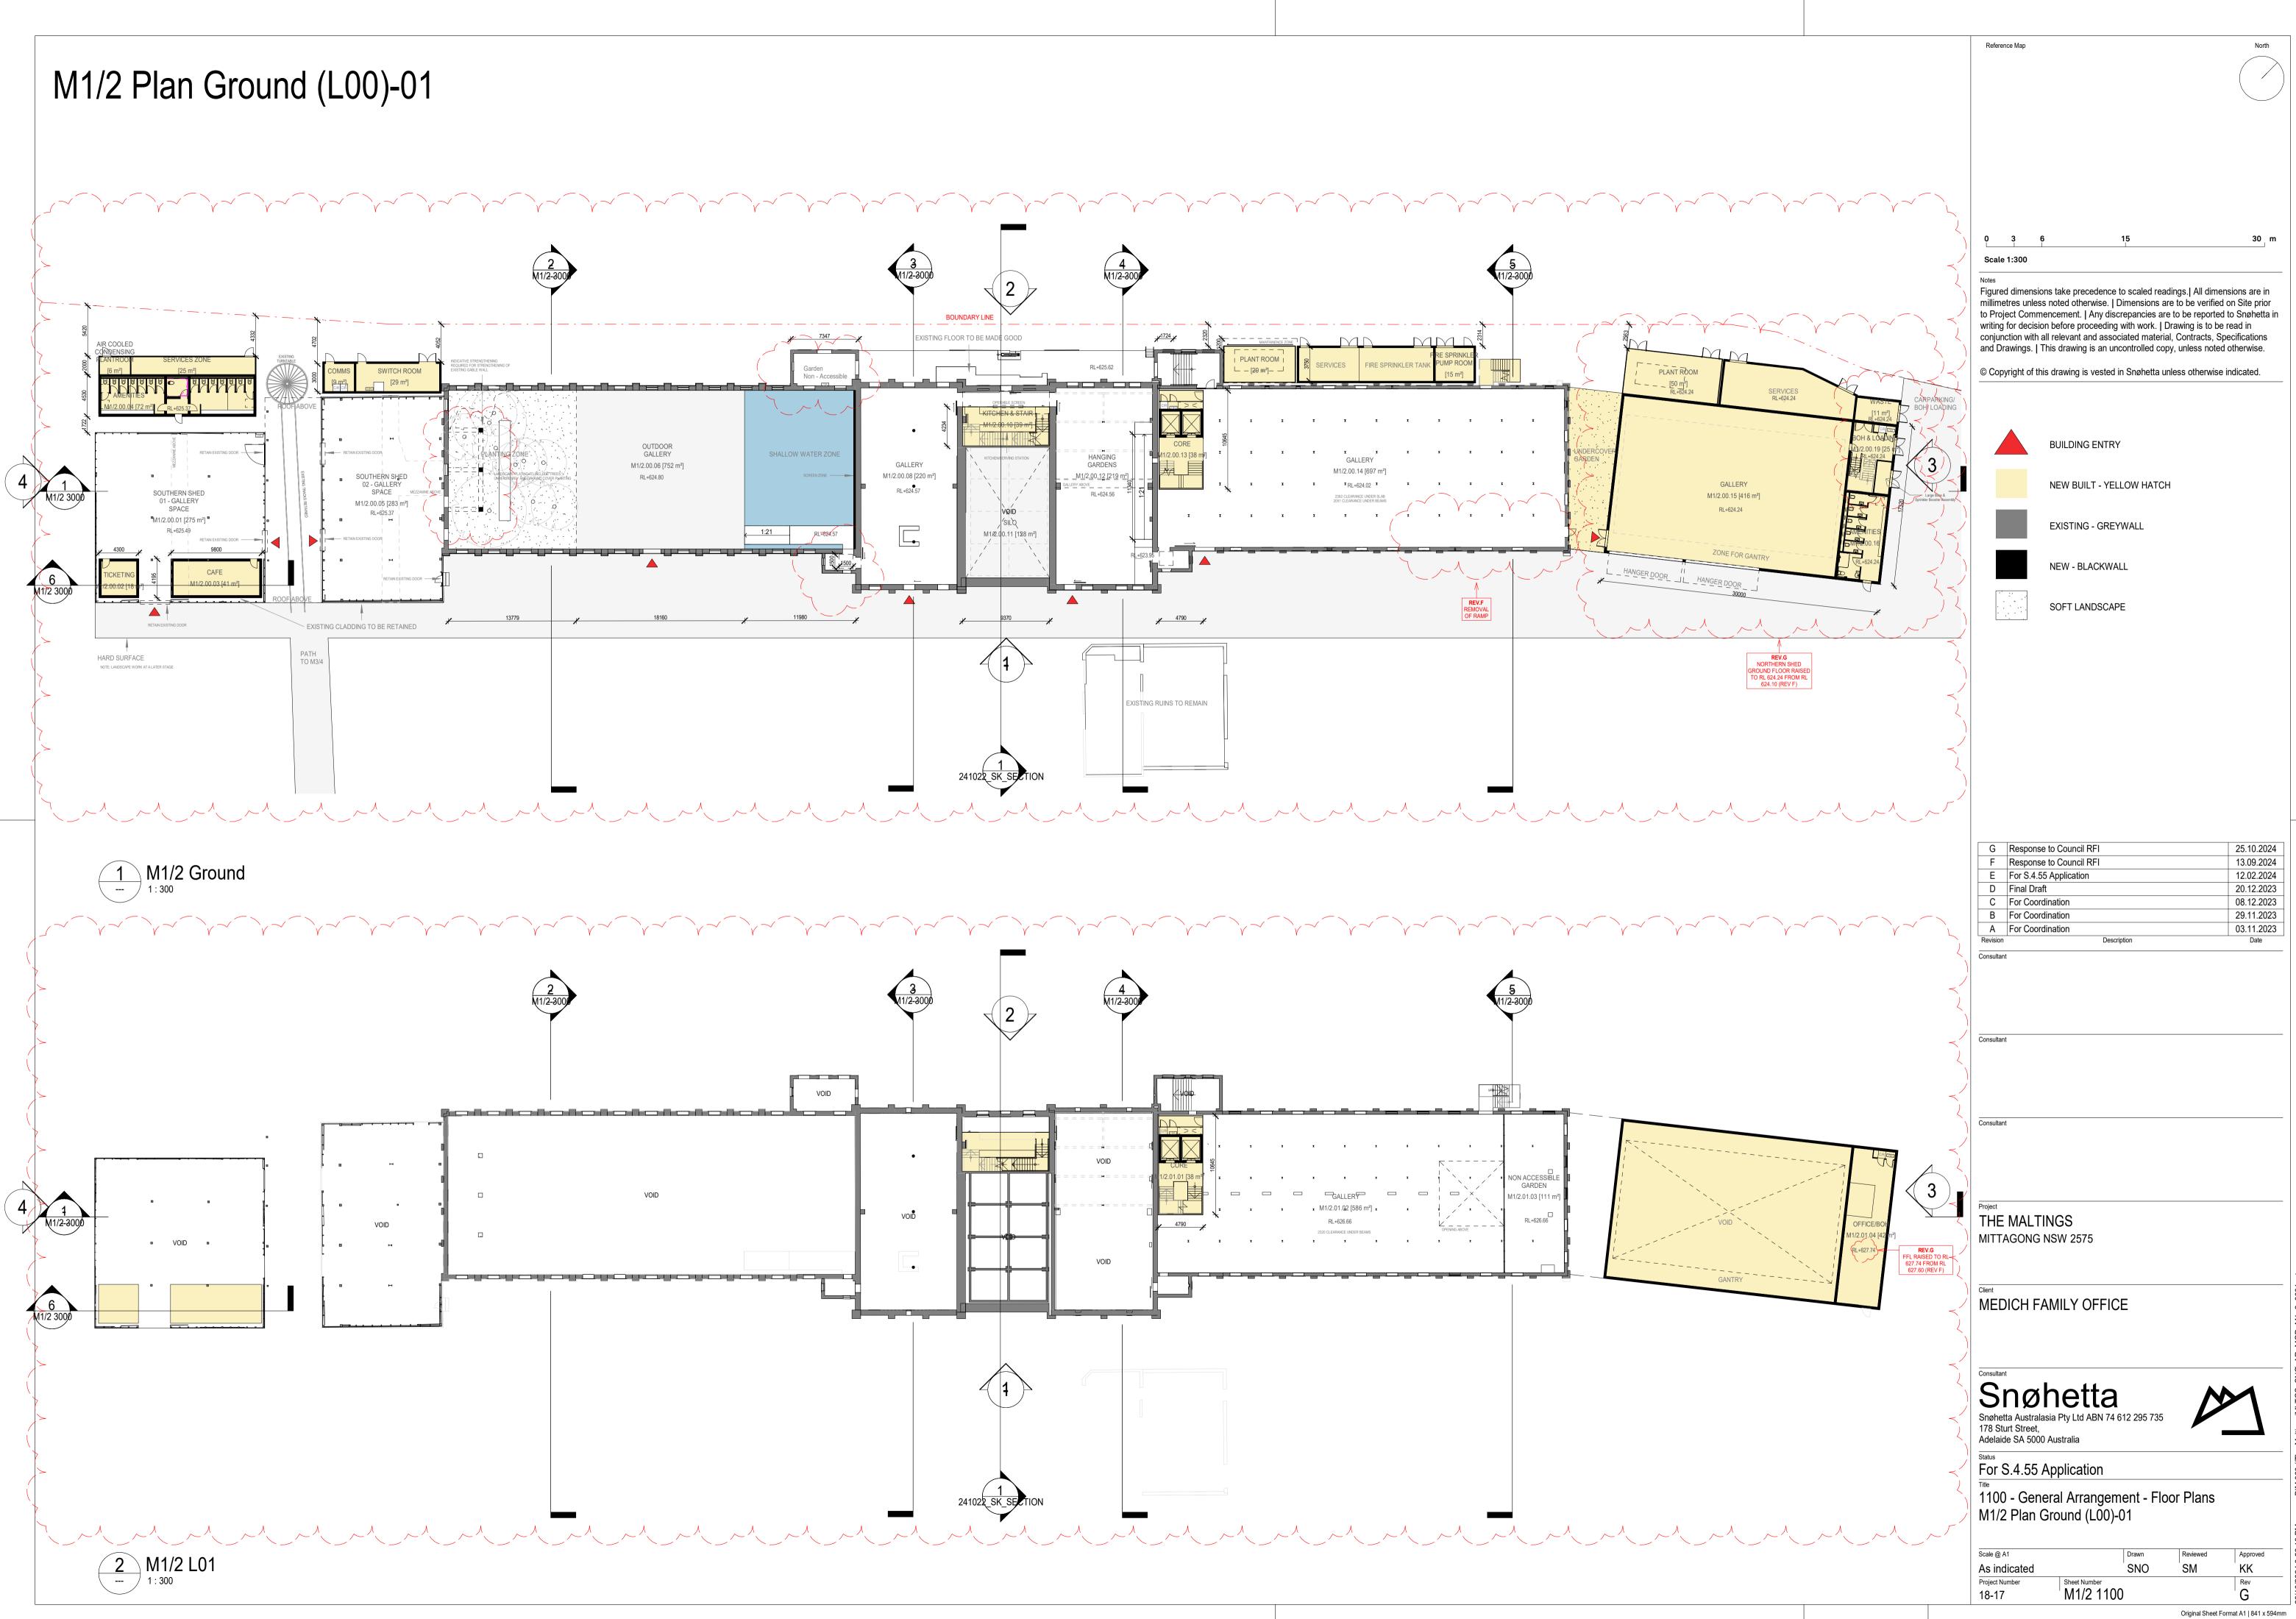



Reference Map North
0       3       6       15       30       m         Scale 1:300         Notes         Figured dimensions take precedence to scaled readings.] All dimensions are in millimetres unless noted otherwise.   Dimensions are to be verified on Site prior to Project Commencement.   Any discrepancies are to be reported to Snøhetta in writing for decision before proceeding with work.   Drawing is to be read in conjunction with all relevant and associated material, Contracts, Specifications and Drawings.   This drawing is an uncontrolled copy, unless noted otherwise.         © Copyright of this drawing is vested in Snøhetta unless otherwise indicated.
FResponse to Council RFI13.09.2024EFor S.4.55 Application12.02.2024DFinal Draft20.12.2023CFor Coordination08.12.2023BFor Coordination29.11.2023AFor Coordination03.11.2023RevisionDateConsultant
Consultant Consultant Project
THE MALTINGS MITTAGONG NSW 2575 Client MEDICH FAMILY OFFICE Consultant Consultant Consultant Status Snøhetta Australasia Pty Ltd ABN 74 612 295 735 178 Sturt Street, Adelaide SA 5000 Australia
1100 - General Arrangement - Floor Plans         M1/2 Plan L02-03         Scale @ A1       Drawn       Reviewed       Approved         As indicated       SNO       SM       KK         Project Number       Sheet Number       Rev       Rev         18-17       M1/2 1101       F       Original Sheet Format A1 [841 x 594m

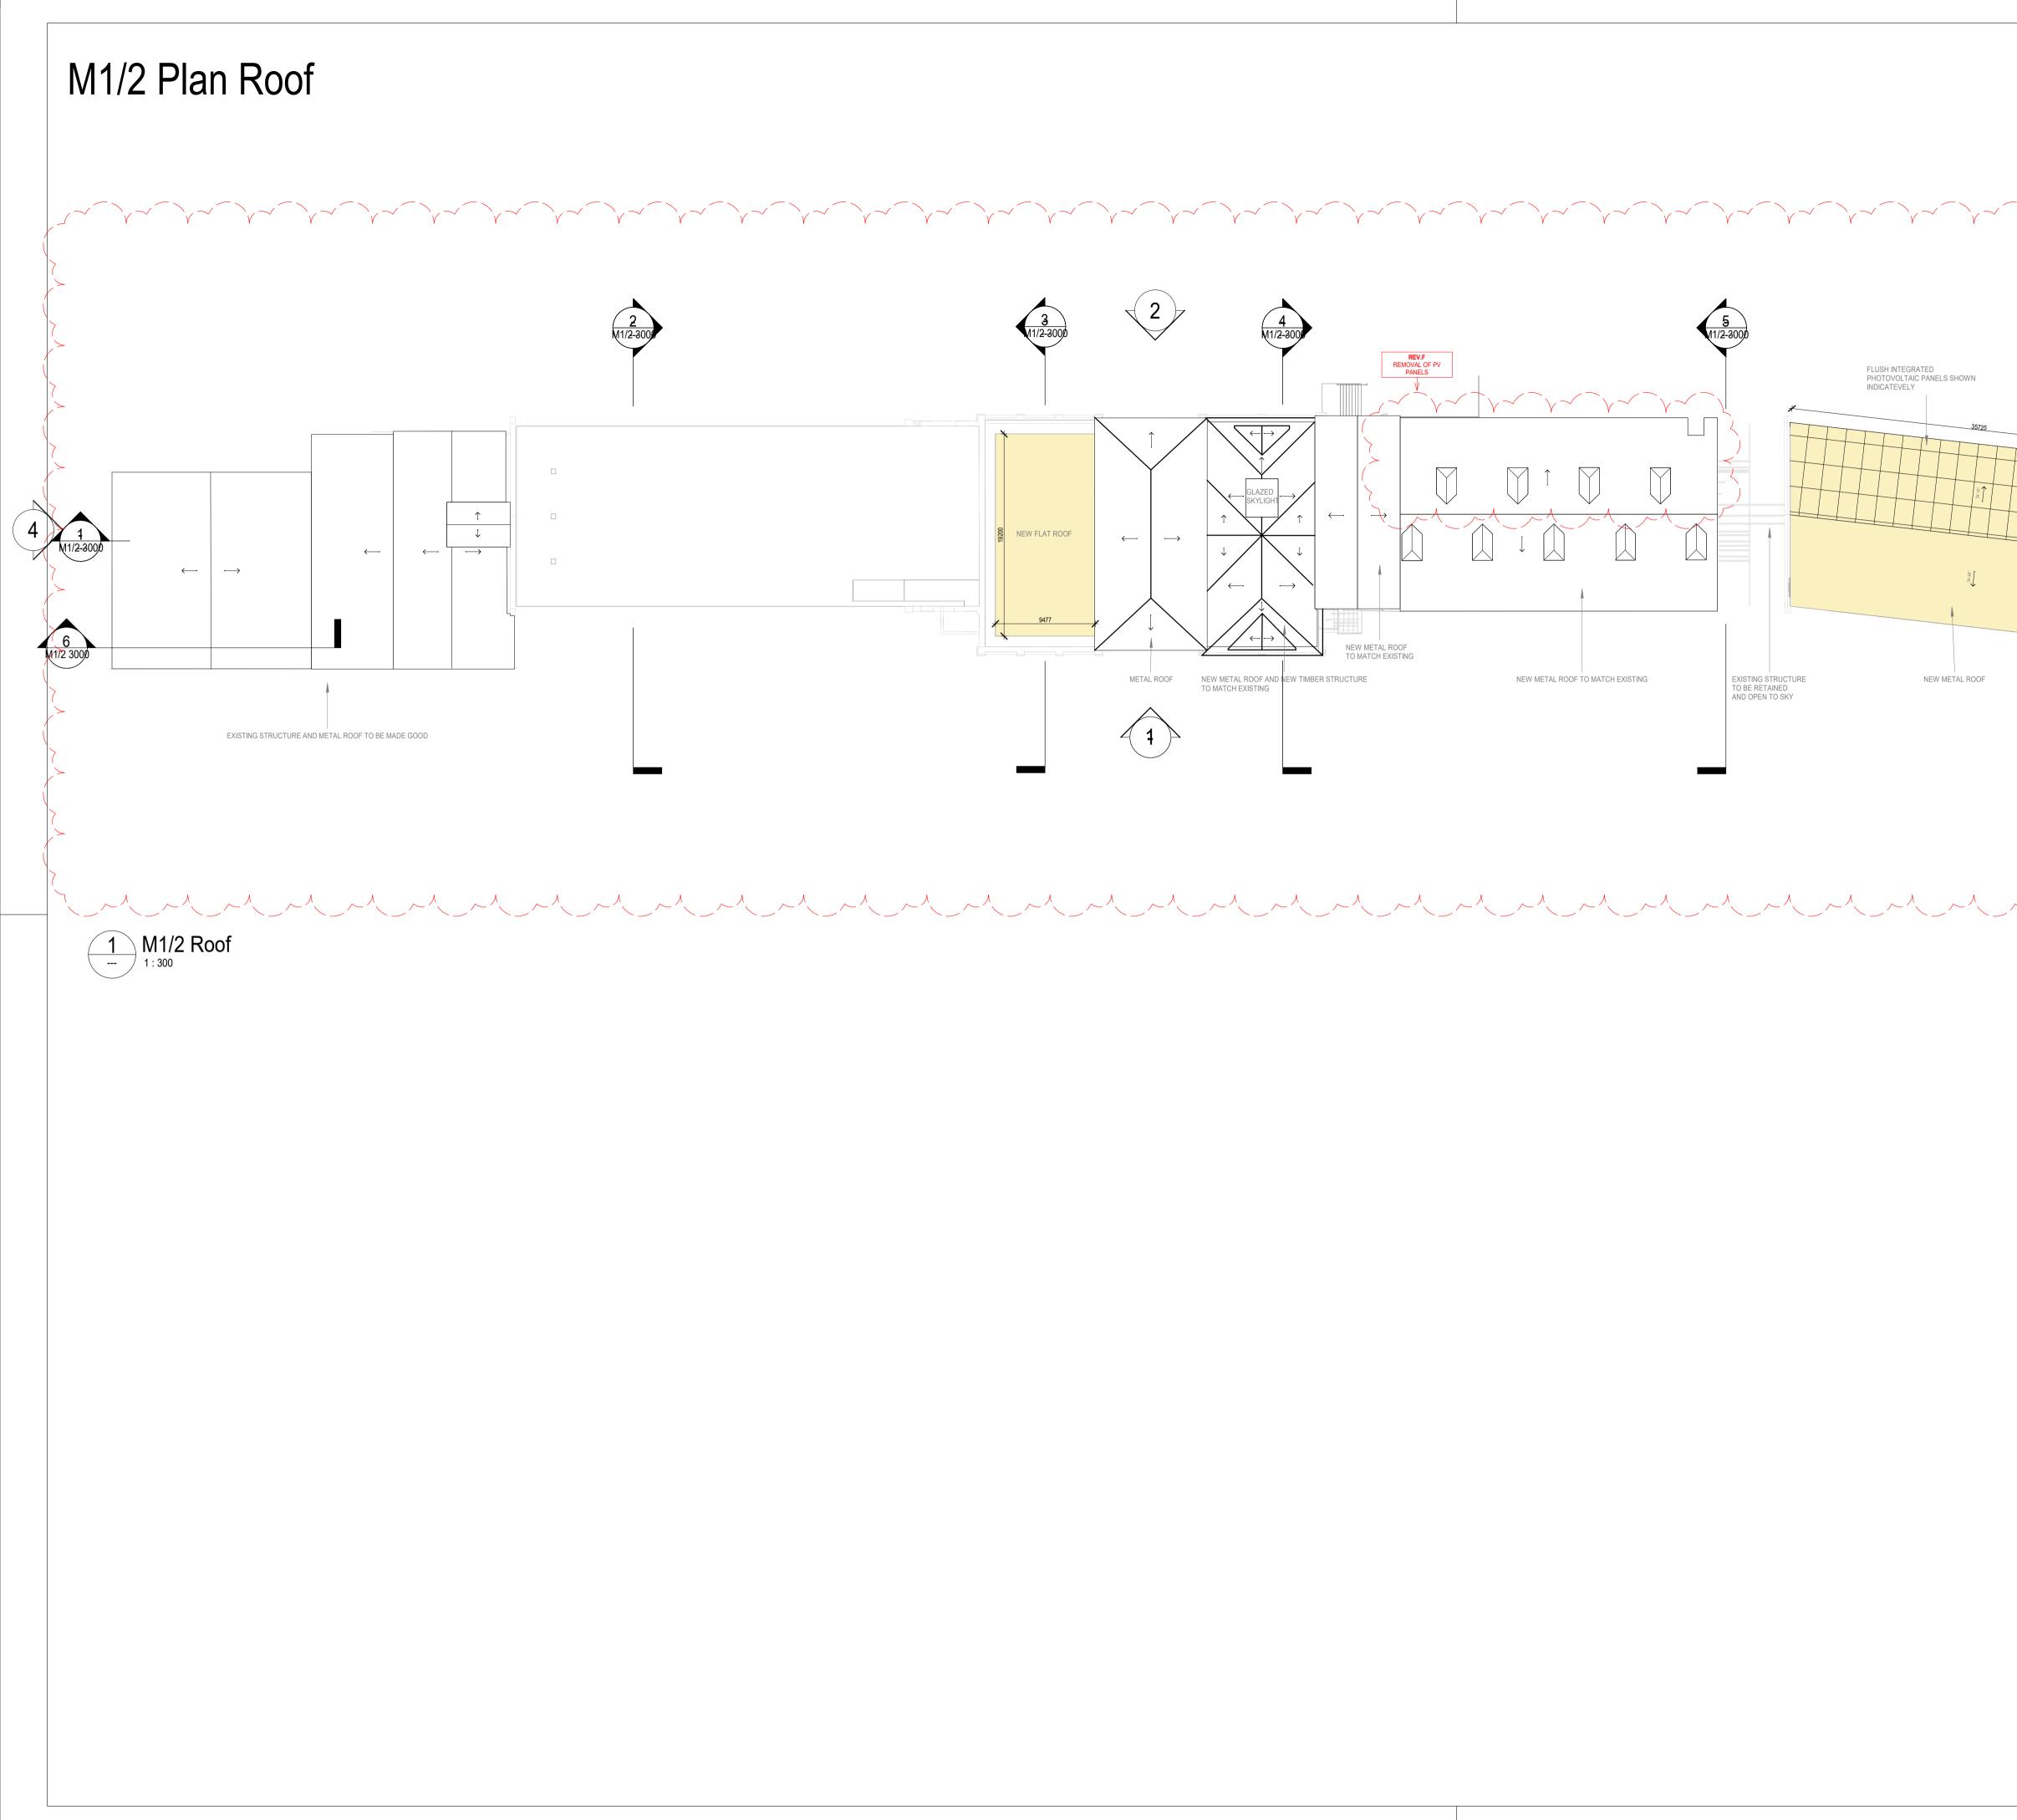



Reference Map	North
0       3       6       15         Scale 1:300         Notes         Figured dimensions take precedence to scaled readings.] All dimen millimetres unless noted otherwise.   Dimensions are to be verified to Project Commencement.   Any discrepancies are to be reported writing for decision before proceeding with work.   Drawing is to be a conjunction with all relevant and associated material, Contracts, Sp and Drawings.   This drawing is an uncontrolled copy, unless noted         © Copyright of this drawing is vested in Snøhetta unless otherwise i         © Copyright of this drawing is vested in Snøhetta unless otherwise i         EXISTING - GREYWALL         EXISTING - GREYWALL         SOFT LANDSCAPE	on Site prior to Snøhetta in read in ecifications otherwise.
F       Response to Council RFI         E       For S.4.55 Application         D       Final Draft         C       For Coordination         B       For Coordination         A       For Coordination         Revision       Description         Consultant	13.09.2024 12.02.2024 20.12.2023 08.12.2023 29.11.2023 03.11.2023 Date
Consultant	
Project THE MALTINGS MITTAGONG NSW 2575 Client MEDICH FAMILY OFFICE	
Consultant Snøhetta Australasia Pty Ltd ABN 74 612 295 735 178 Sturt Street, Adelaide SA 5000 Australia Status For S.4.55 Application Title 1100 - General Arrangement - Floor Plans M1/2 Plan Roof	2
Scale @ A1     Drawn     Reviewed       As indicated     SNO     SM       Project Number     Sheet Number     Sheet Number       18-17     M1/2 1102	Approved KK Rev F



				North
7				
	0 3 6	15 I		30
X Z	Scale 1:300 Notes	o procedence to coo	ed readings.  All dimensic	
	millimetres unless note to Project Commencen writing for decision befor conjunction with all rele	d otherwise.   Dimension nent.   Any discrepan ore proceeding with w vant and associated	sions are to be verified on cies are to be reported to ork.   Drawing is to be rea material, Contracts, Speci led copy, unless noted oth	Site prio Snøhetta ad in ifications
E.		-	hetta unless otherwise ind	
	Previous (	GFA V~		
>	م	rea Schedule (A	REA_GFA)	
	Name	Level	Area	
	M1+M2 Sh M1+M2	eds A-00 A-00	402 m² 2524 m²	
	M1+M2	A-01	286 m²	
$\mathbf{i}$	M1+M2 M1+M2	A-01 A-01	599 m <sup>2</sup> 667 m <sup>2</sup>	
(	M1+M2 Grand tota	A-02_MEZ	392 m <sup>2</sup> 4869 m <sup>2</sup>	
R Y	Current G			
		Area Schedule (A		
	Name	Level	Area	
	M1/2 Ground M1 + M2	M1/2 Ground	2385 m <sup>2</sup>	
$\langle \rangle$	M1 + M2 Shec	ls M1/2 Ground	698 m <sup>2</sup> 3083 m <sup>2</sup>	
(	M1/2 L01 M1 + M2	M1/2 L01	651 m²	
	M1/2 L02		651 m²	
	M1 + M2	M1/2 L02	913 m <sup>2</sup> 913 m <sup>2</sup>	
	M1/2 L03 M1 + M2	M1/2 L03	107 m <sup>2</sup>	
	Grand total		107 m² 4754 m²	
	E For S 4 55 App	ication		12 02 20
	E For \$.4.55 Appl D Final Draft Revision Consultant	Description		~


2/2024 12:22:27 PM BIM 360://The Maltings/MLTGS SNØ AR MOD M1+2

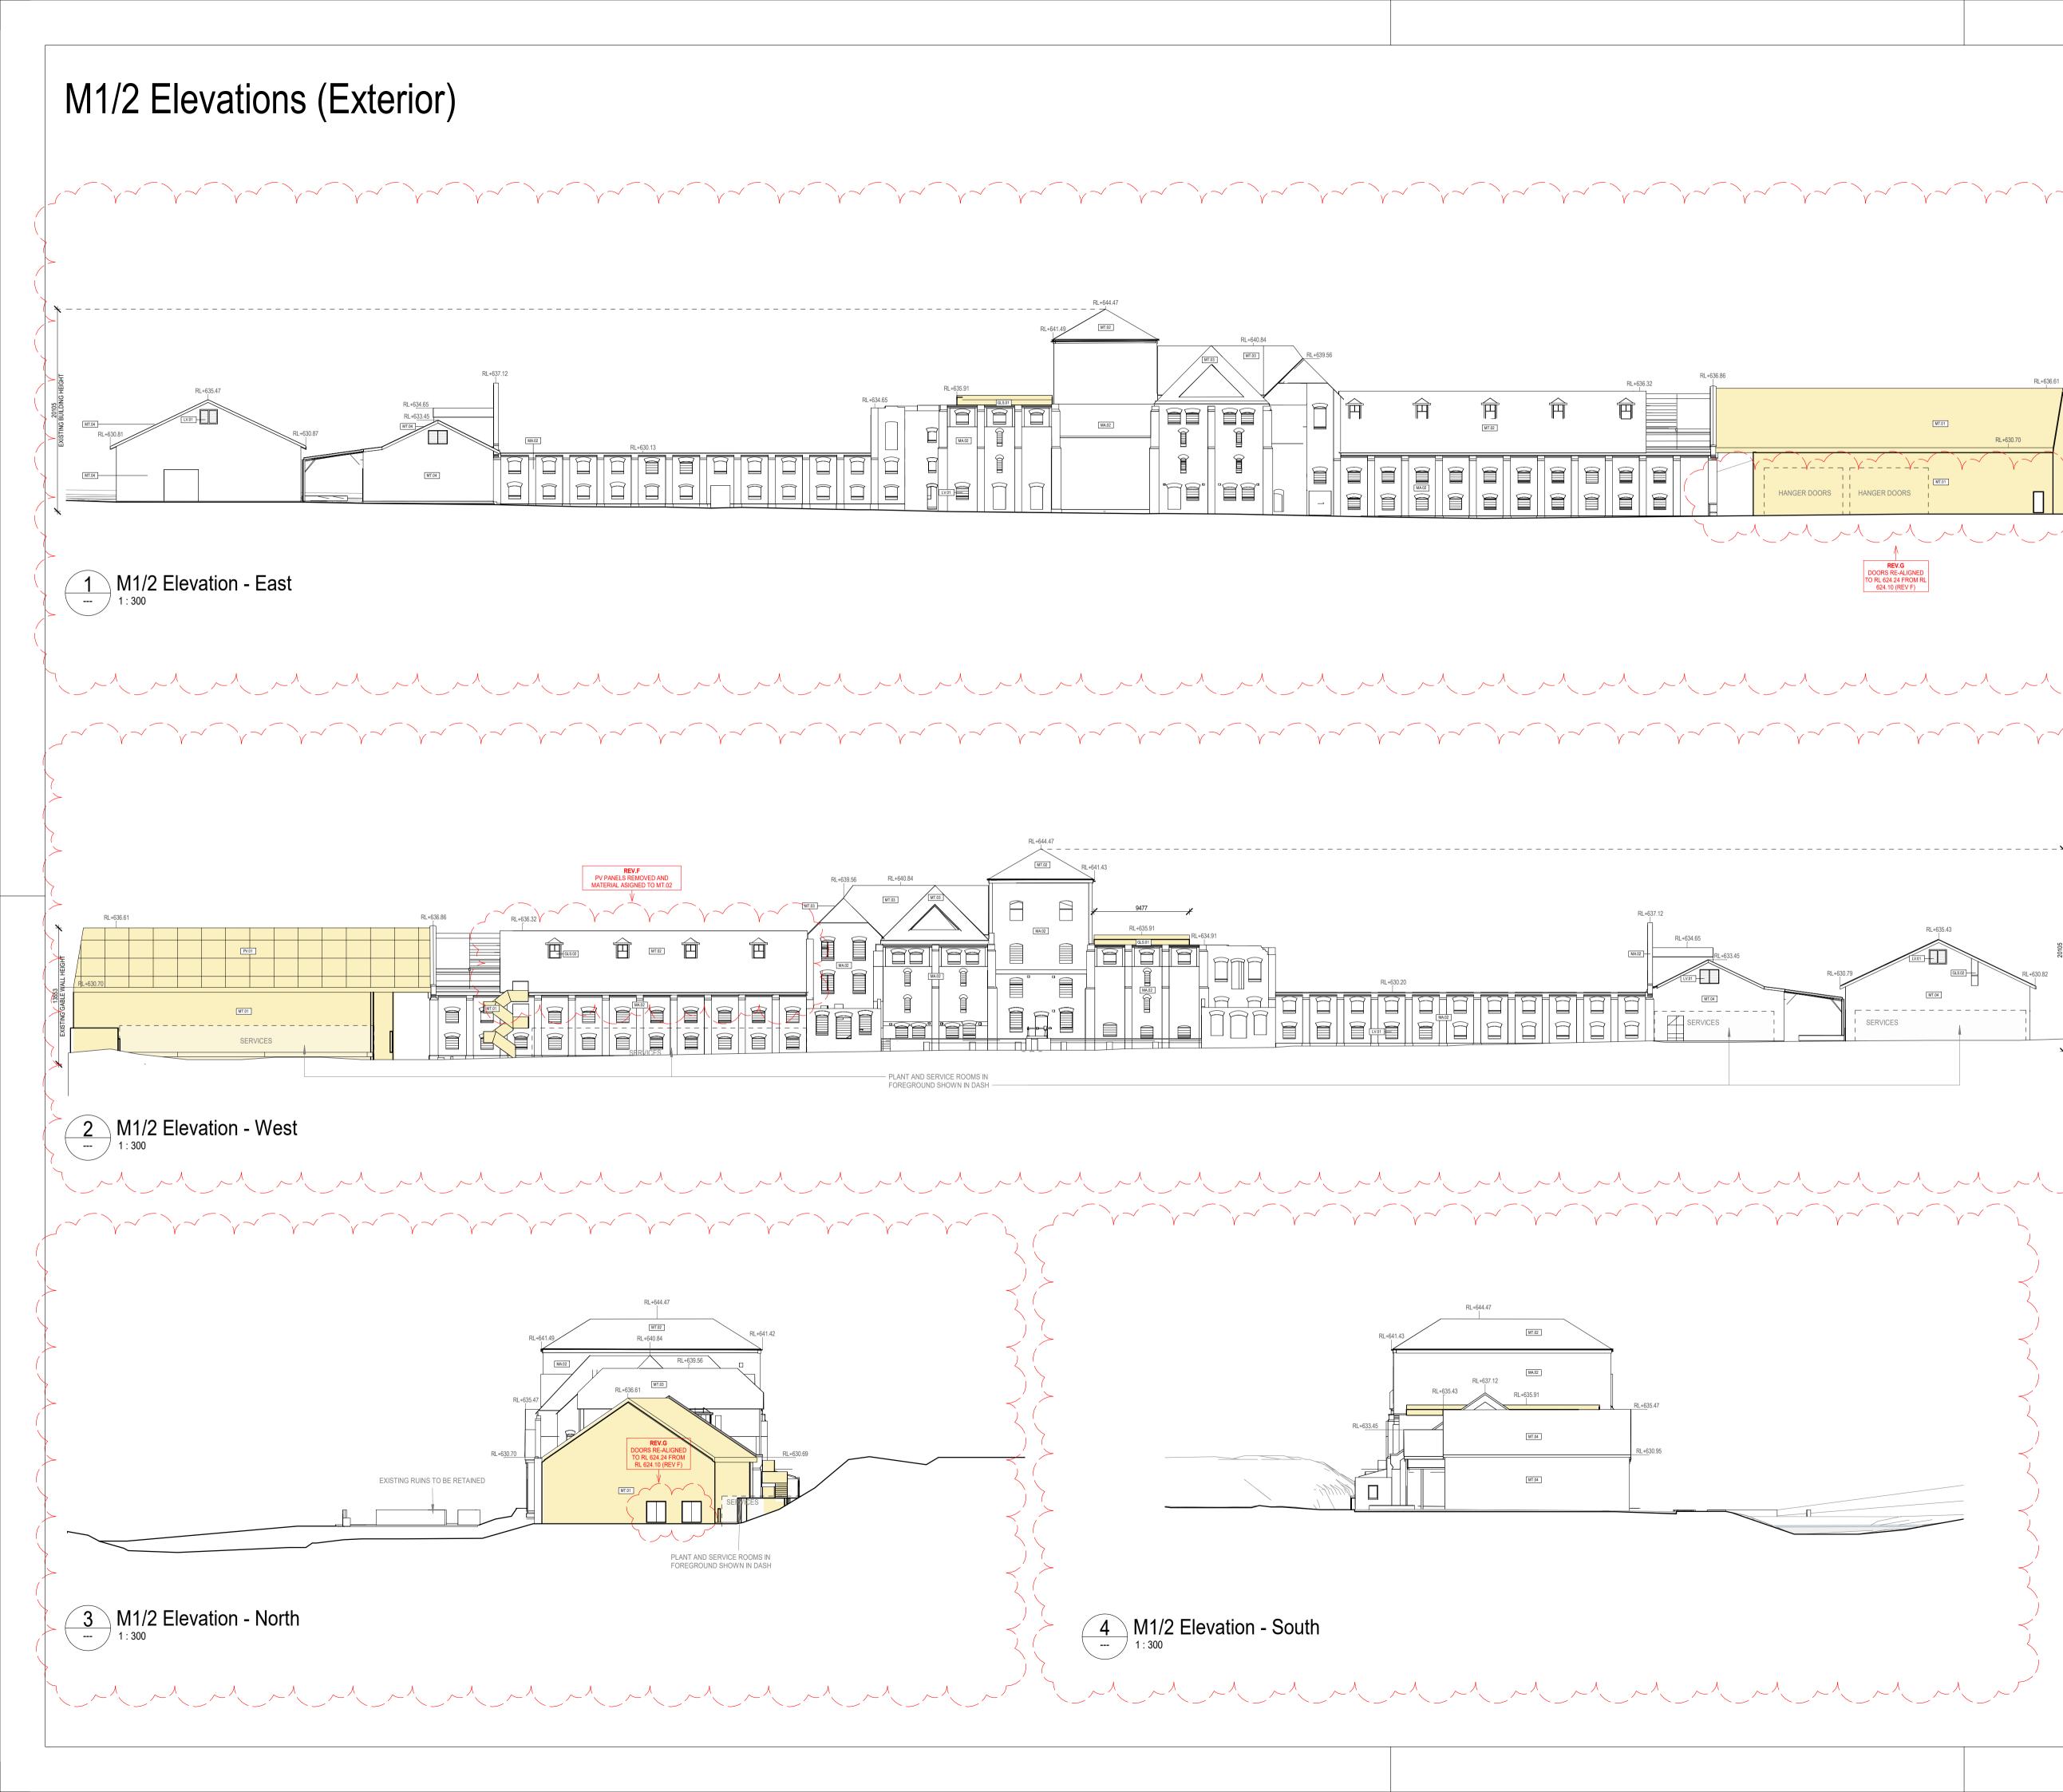

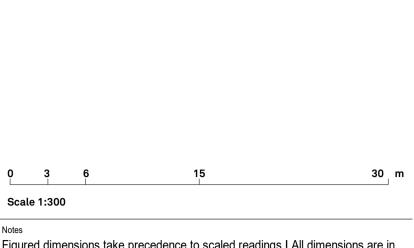

Reference Map

RL+636.61

Figured dimensions take precedence to scaled readings.| All dimensions are in millimetres unless noted otherwise. | Dimensions are to be verified on Site prior to Project Commencement. | Any discrepancies are to be reported to Snøhetta in writing for decision before proceeding with work. | Drawing is to be read in conjunction with all relevant and associated material, Contracts, Specifications and Drawings. | This drawing is an uncontrolled copy, unless noted otherwise.

© Copyright of this drawing is vested in Snøhetta unless otherwise indicated.

Keynote Legend			
Key Value	Keynote Text		
GLS.01 Glass (Clear double galzing for new fenestration)			
GLS.02 Glass (Glazing for restored fenetration as per heritage consultant's specification)			
LV.01 Louvres (Metal Louvres / bespoke Metal louvres to match the xisting timber louvres)			
MA.02	Brick (Existing and restored brick facade)		
MT.01 Metal (Solid Metal Panel with applied finish / AxolotI steel metal - Dark tones)			
MT.02 Metal (Corrugated metal roofing / Colour tone to match existing)			
MT.03 Metal (Corrugated metal roofing + new Timber structure / Colour tone to match existing)			
MT.04	Metal (Existing and restored corrugated metal)		
PV.01 Photo Voltaic Panels (Photovoltaic panels / Flush integral photovolatic panels)			

G	Response to Council RFI	25.10.2024
F	Response to Council RFI	13.09.2024
E	For S.4.55 Application	12.02.2024
D	Final Draft	20.12.2023
Revision	Description	Date

Consultant

Consultant

Consultant

THE MALTINGS MITTAGONG NSW 2575


MEDICH FAMILY OFFICE

## Snøhetta

Snøhetta Australasia Pty Ltd ABN 74 612 295 735 178 Sturt Street, Adelaide SA 5000 Australia

For S.4.55 Application 2000 - Elevations (Exterior) M1/2 Elevations (Exterior)

Scale @ A1		Drawn	Reviewed	Approved
1:300		SNO	SM	KK
Project Number 18-17	Sheet Number M1/2 2000	0		Rev G
			Original Sheet F	ormat A1   841 x 594mm

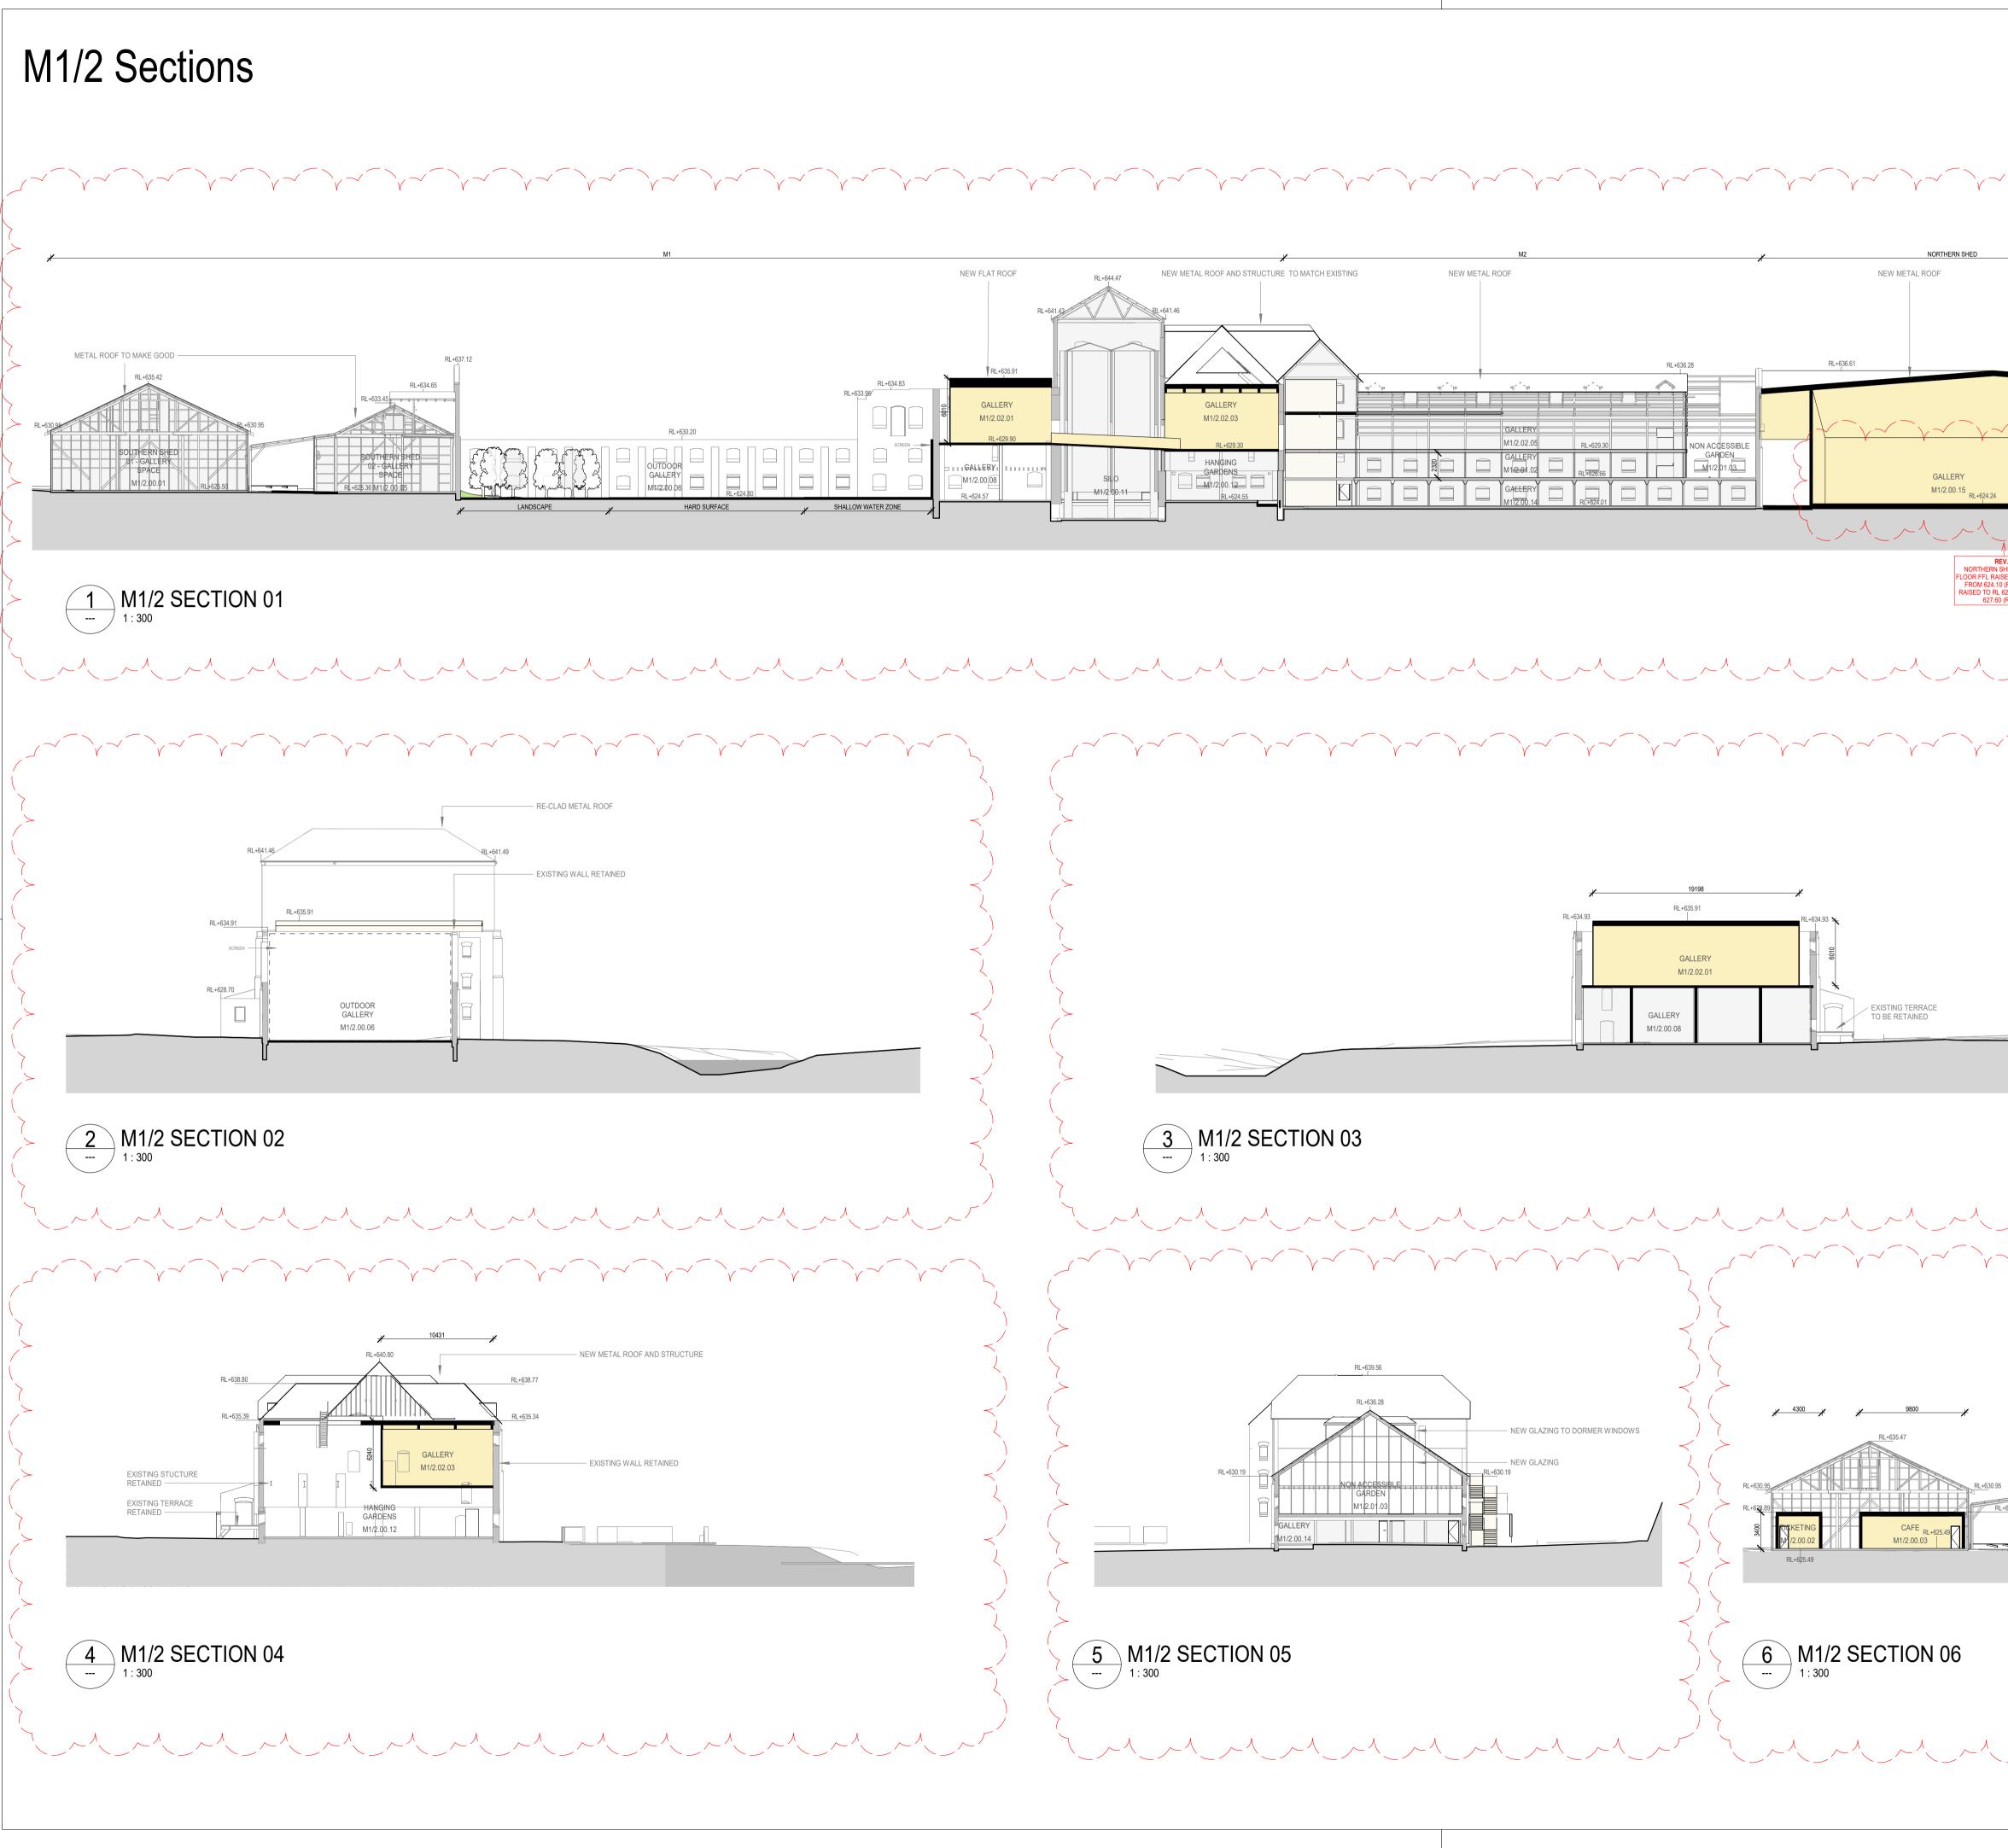

	Reference Map
	0 3 6 15 30 m
	Scale 1:300         Notes         Figured dimensions take precedence to scaled readings.  All dimensions are in millimetres unless noted otherwise.   Dimensions are to be verified on Site prior to Project Commencement.   Any discrepancies are to be reported to Snøhetta in writing for decision before proceeding with work.   Drawing is to be read in conjunction with all relevant and associated material, Contracts, Specifications and Drawings.   This drawing is an uncontrolled copy, unless noted otherwise.         © Copyright of this drawing is vested in Snøhetta unless otherwise indicated.
	G       Response to Council RFI       25.10.2024         F       Response to Council RFI       13.09.2024         F       For 0.4.55 Application       40.00.2024
	E       For S.4.55 Application       12.02.2024         D       Final Draft       20.12.2023         A       For Coordination       03.11.2023         Revision       Description       Date         Consultant       One that the second
	Consultant Consultant
	Project THE MALTINGS MITTAGONG NSW 2575
	Cuent         MEDICH FAMILY OFFICE         Consultant         Snøhetta Australasia Pty Ltd ABN 74 612 295 735         Snøhetta Australasia Pty Ltd ABN 74 612 295 735         178 Sturt Street, Adelaide SA 5000 Australia
	Status         For S.4.55 Application         Title         3000 - Sections         M1/2 Sections         Scale @ A1         Drawn       Reviewed         Approved
	1:300     SNO     SM     KK       Project Number     Sheet Number     Rev       18-17     M1/2 3000     G   Original Sheet Format A1   841 x 594mm

## M1/2 + MH Materials Schedule



GLS.01 Clear Double glazing



MT.02/ MT.03 Corrugated Metal roofing/ Colour tone to match existing Corrugated Metal roofing + New timber structure/ Colour tone to match existing



**MA.υ⊶** Masonry - to be confirmed at detailed design stage



**GLS.02** Glazing for restored fenetration as per heritage consultant's specification



**MT.04** Existing and restored corrugated metal



**PV.01** Photo Voltaic Panels (Photovaltaic panels/ flush integrated photovolatic panels



**LV.01** Timber louvers/ Bespoke timber louvres to match the existing louvres



**MA.01** New Brick



**CON.01** Concrete - Sustainable concrete or equivalent, opportunity to use Ashcrete



MA.02 Brick - Existing and restored brick facade



**MT.01** Metal - Solid Metal Panel with applied finish/ Axolotl steel metal - Dark tones





**MA.03** Brick - New Brick, Uniform textured appearance, hit and miss open to minimum 16%, recessed and extruded bricks pattern



TIM.03 Lightweight construction - to be confirmed at detailed design stage


Reference Map					
Notes	uns taka nracada	ence to scaled rea	dinge I All dim	ensions are in	-
millimetres unles to Project Comm	s noted otherwis encement.   Any	e.   Dimensions a discrepancies ar	re to be verifie e to be reporte	ed on Site prior ed to Snøhetta i	in
conjunction with	all relevant and a	ding with work.   [ associated materia n uncontrolled cop	al, Contracts,	Specifications	
		sted in Snøhetta u			
17.0					—
E For S.4.5 Revision	5 Application	Description		12.02.2024 Date	4
		Description			4

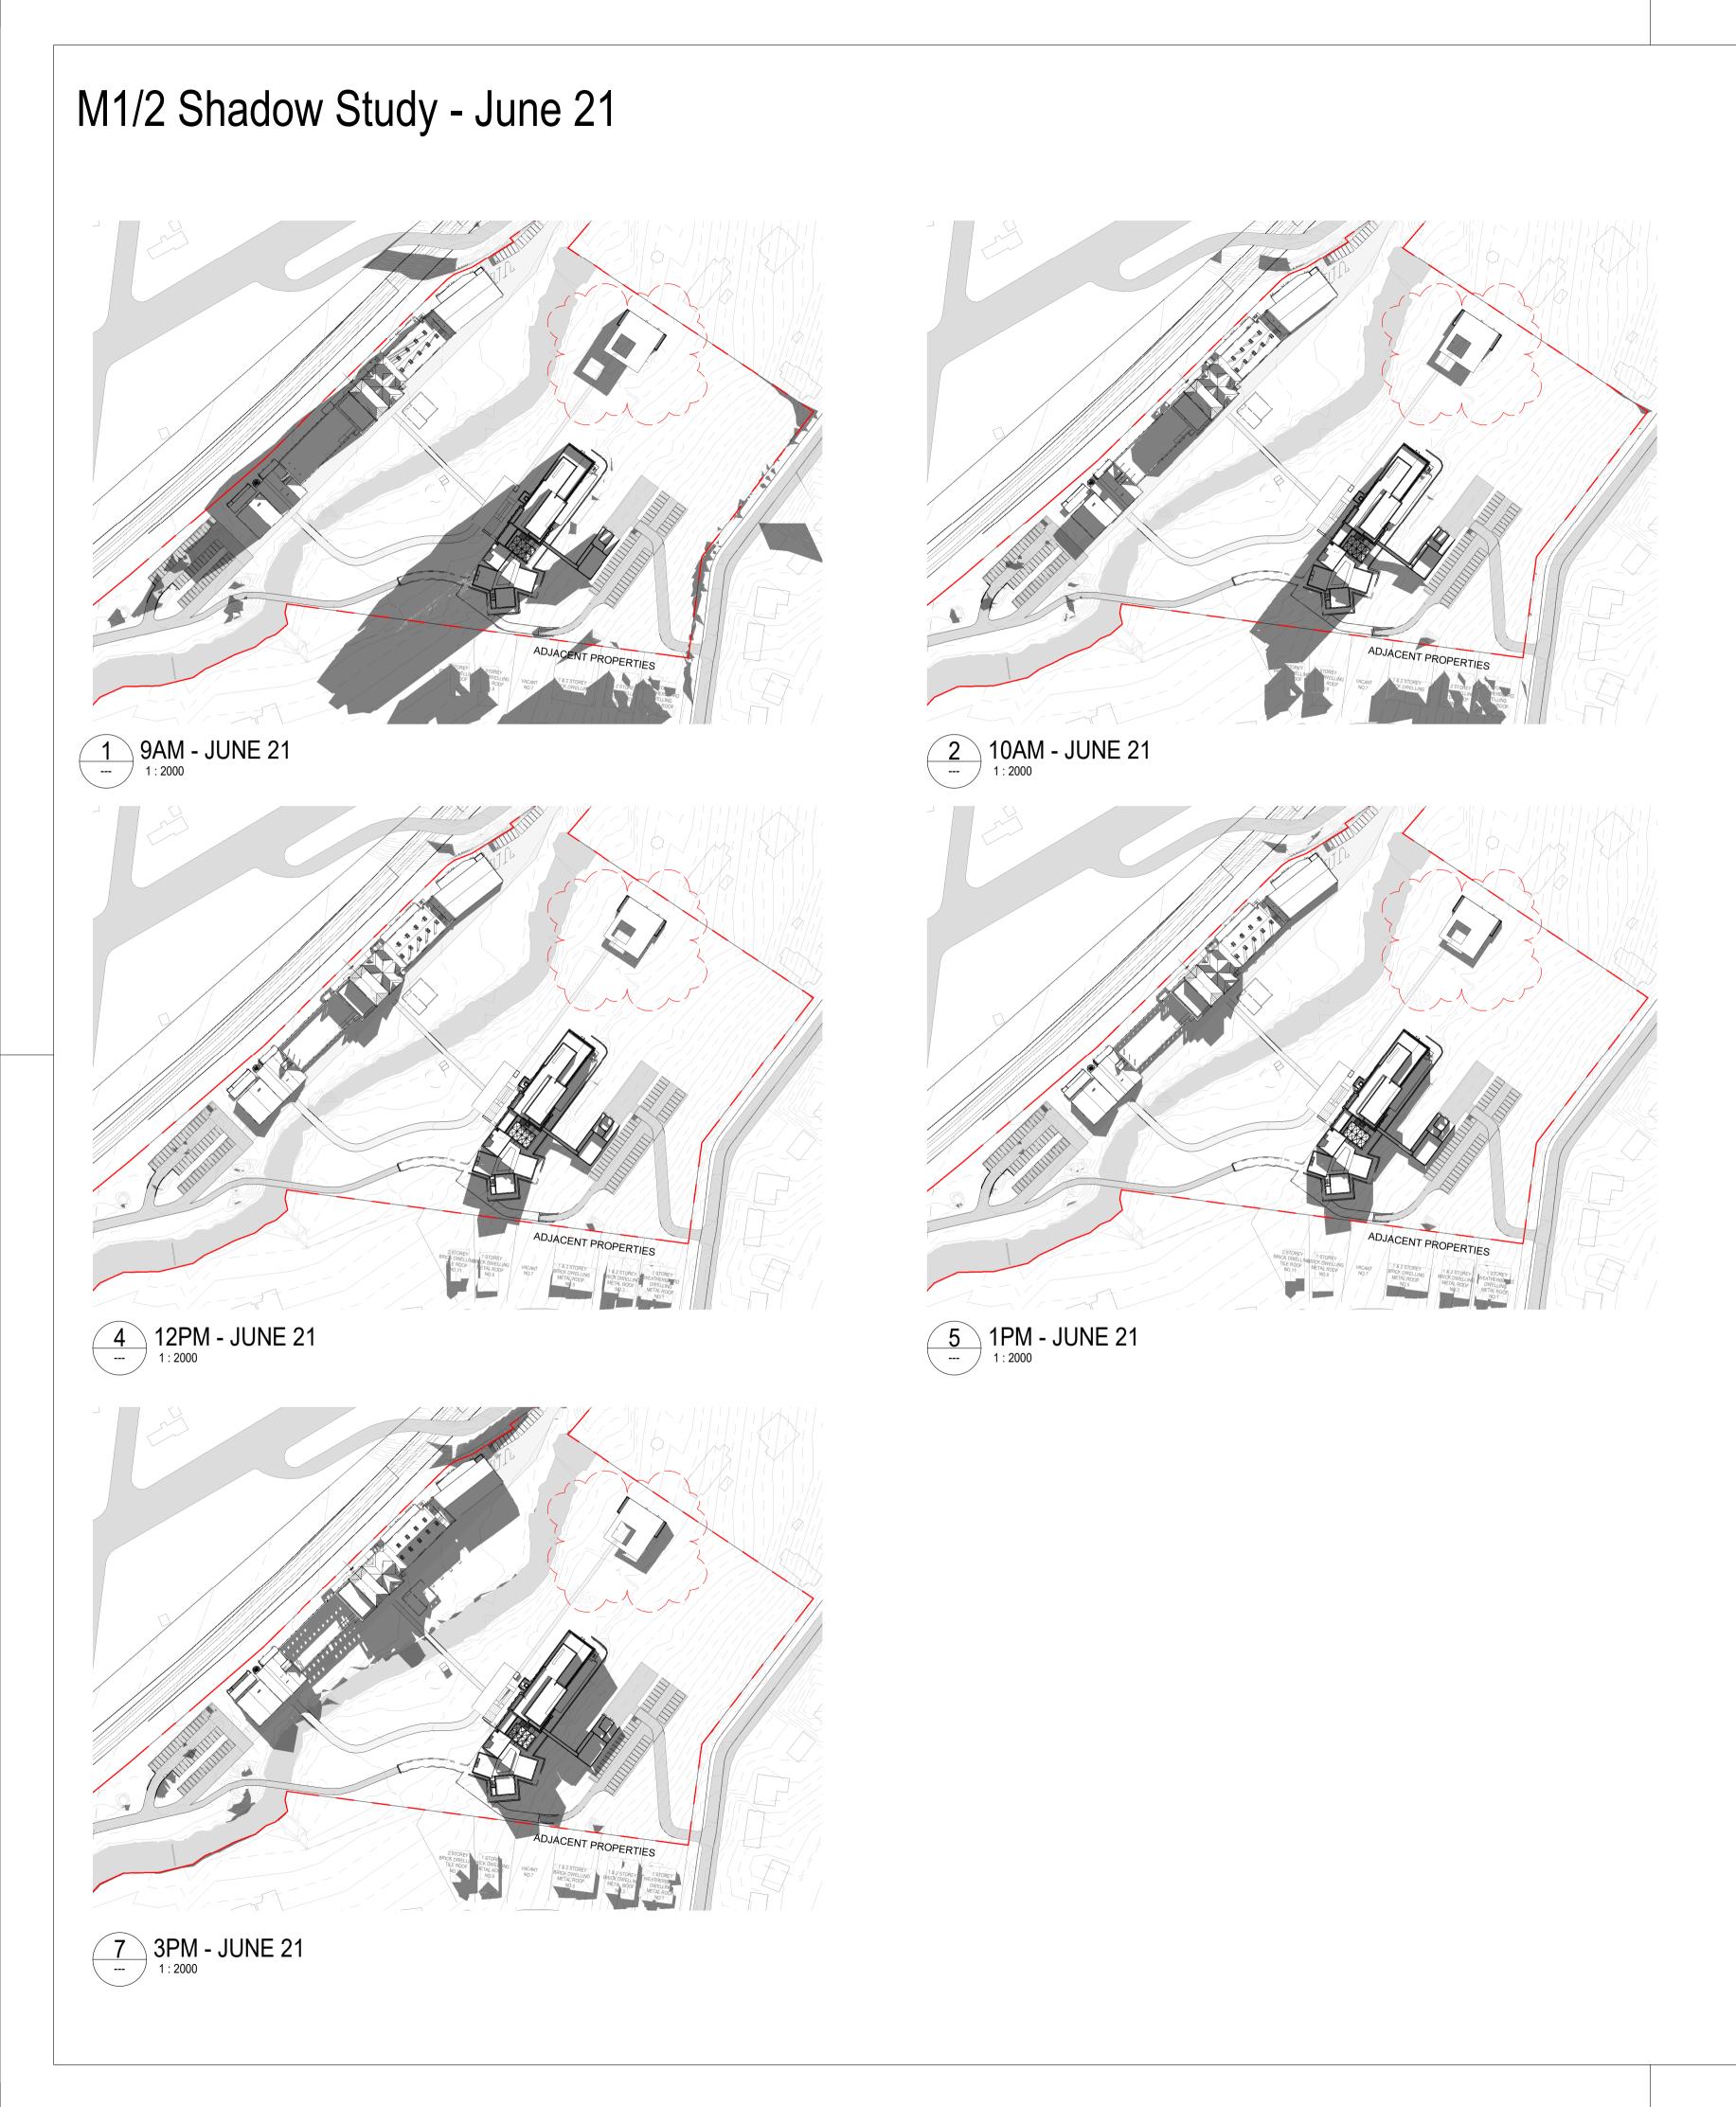


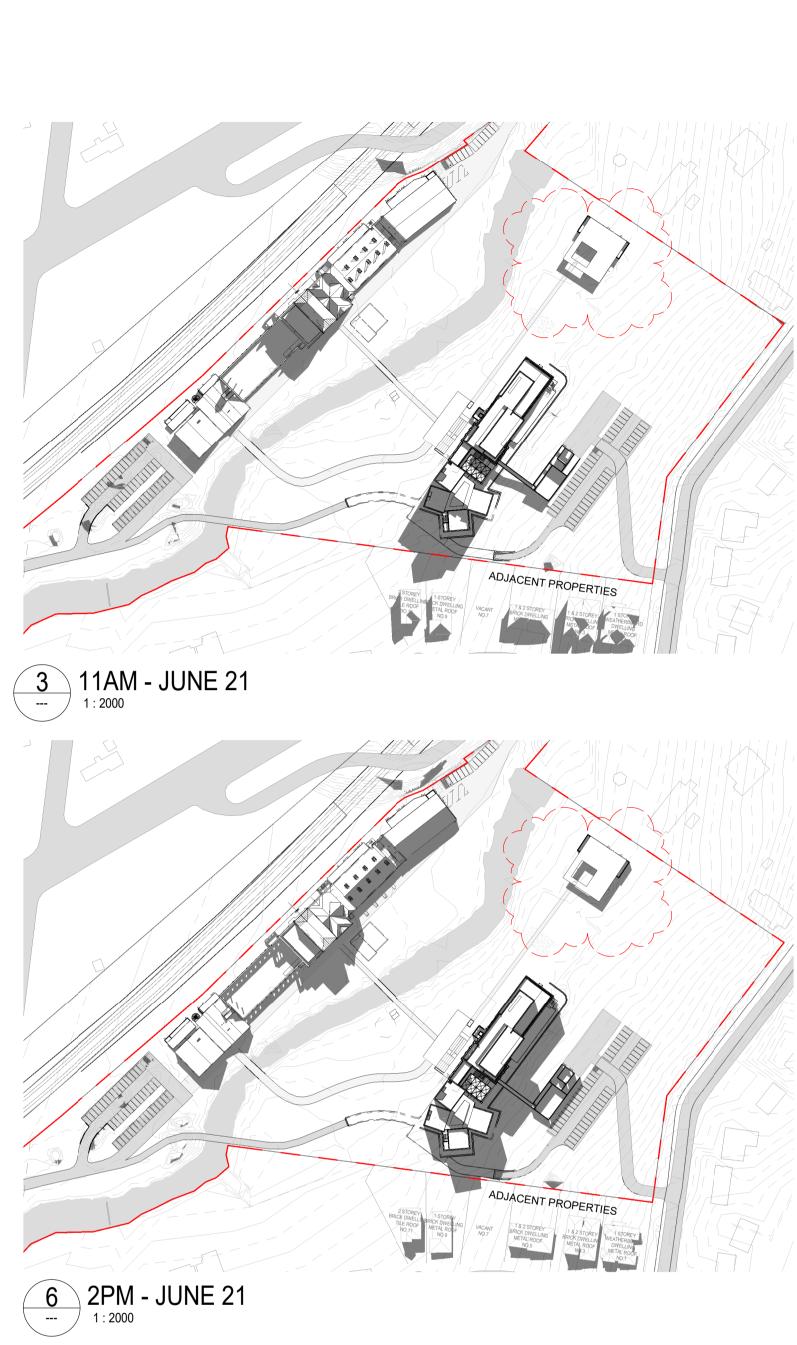

Reference Map	North
0 1 2 5	10 m
Scale 1:100	
Notes	
Figured dimensions take precedence to scaled readings. A millimetres unless noted otherwise. Dimensions are to be v	
to Project Commencement.   Any discrepancies are to be rewriting for decision before proceeding with work.   Drawing is	ported to Snøhetta in
conjunction with all relevant and associated material, Contra	cts, Specifications
and Drawings.   This drawing is an uncontrolled copy, unless	s noted otherwise.
© Copyright of this drawing is vested in Snøhetta unless oth	erwise indicated.
G     Response to Council RFI       E     For S.4.55 Application	25.10.2024
Revision Description	Date
Consultant	

Consultant           Project           The Maltings           MITTAGONG NSW 2575           Clent           MEDICH FAMILY OFFICE           Consultant           Snøhetta Australasia Pty Ltd ABN 74 612 295 735 178 Sturt Street, Adelaide SA 5000 Australia           Status           For S.4.55 Application           Title           8000 - Shadows           M1/2 Shadow Study - June 21           Scale @ A1           1: 2000           Project Number           18-17	KK

26/10/2024 3:56:28 PM BIM 360://The Maltings/MLTGS\_SNØ\_AR\_MOD\_SITE\_000

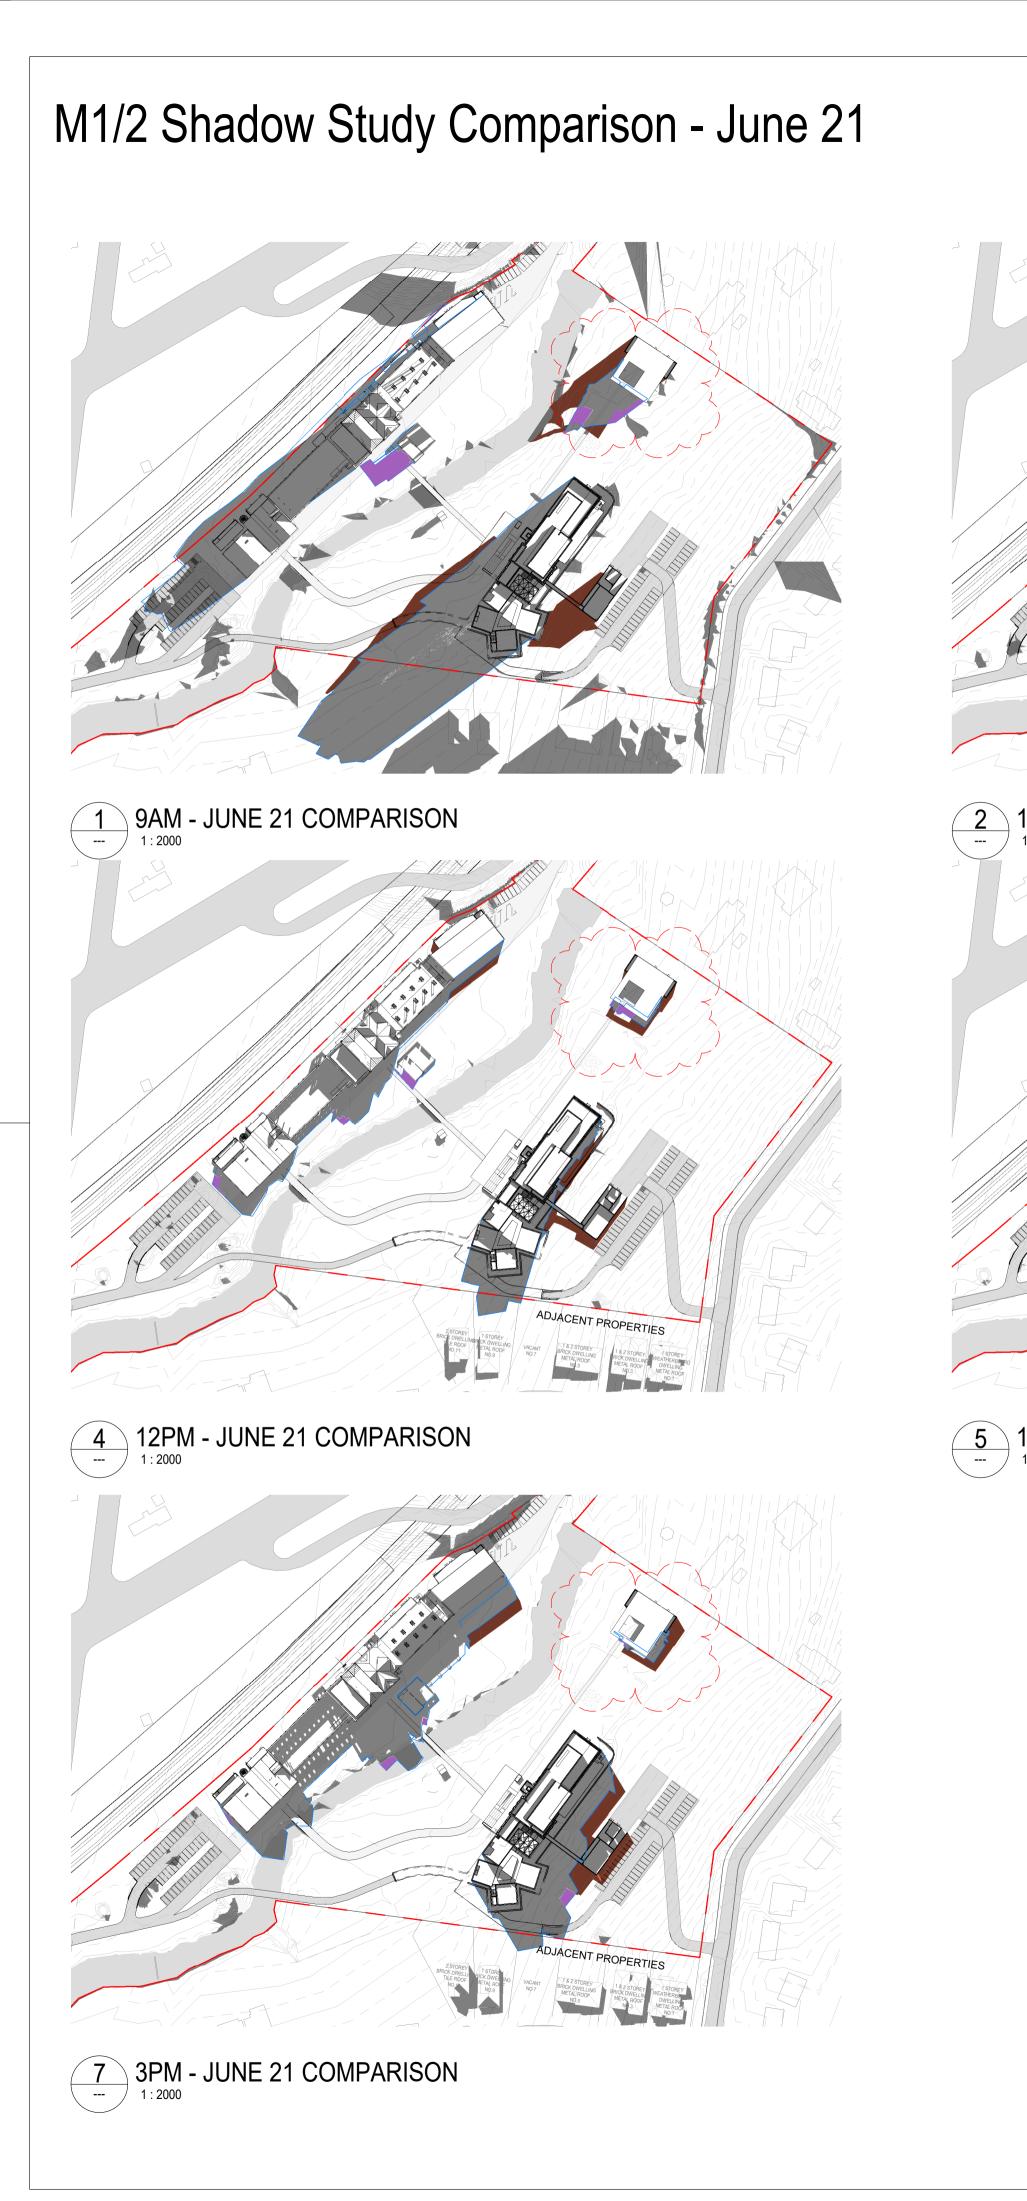


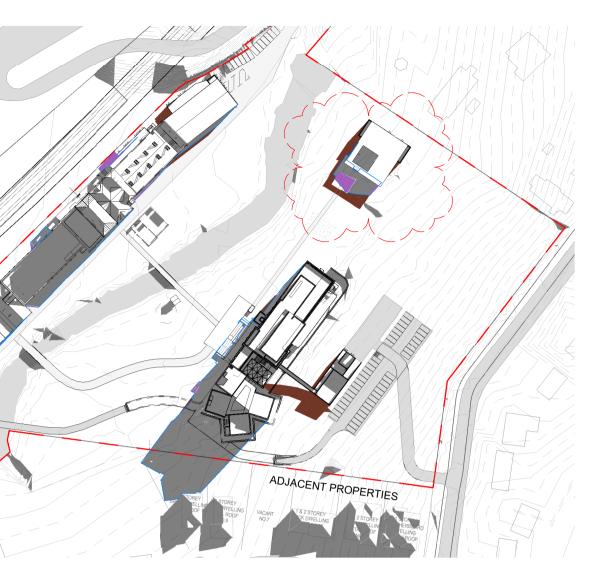


10AM - JUNE 21 COMPARISON



5 1PM - JUNE 21 COMPARISON

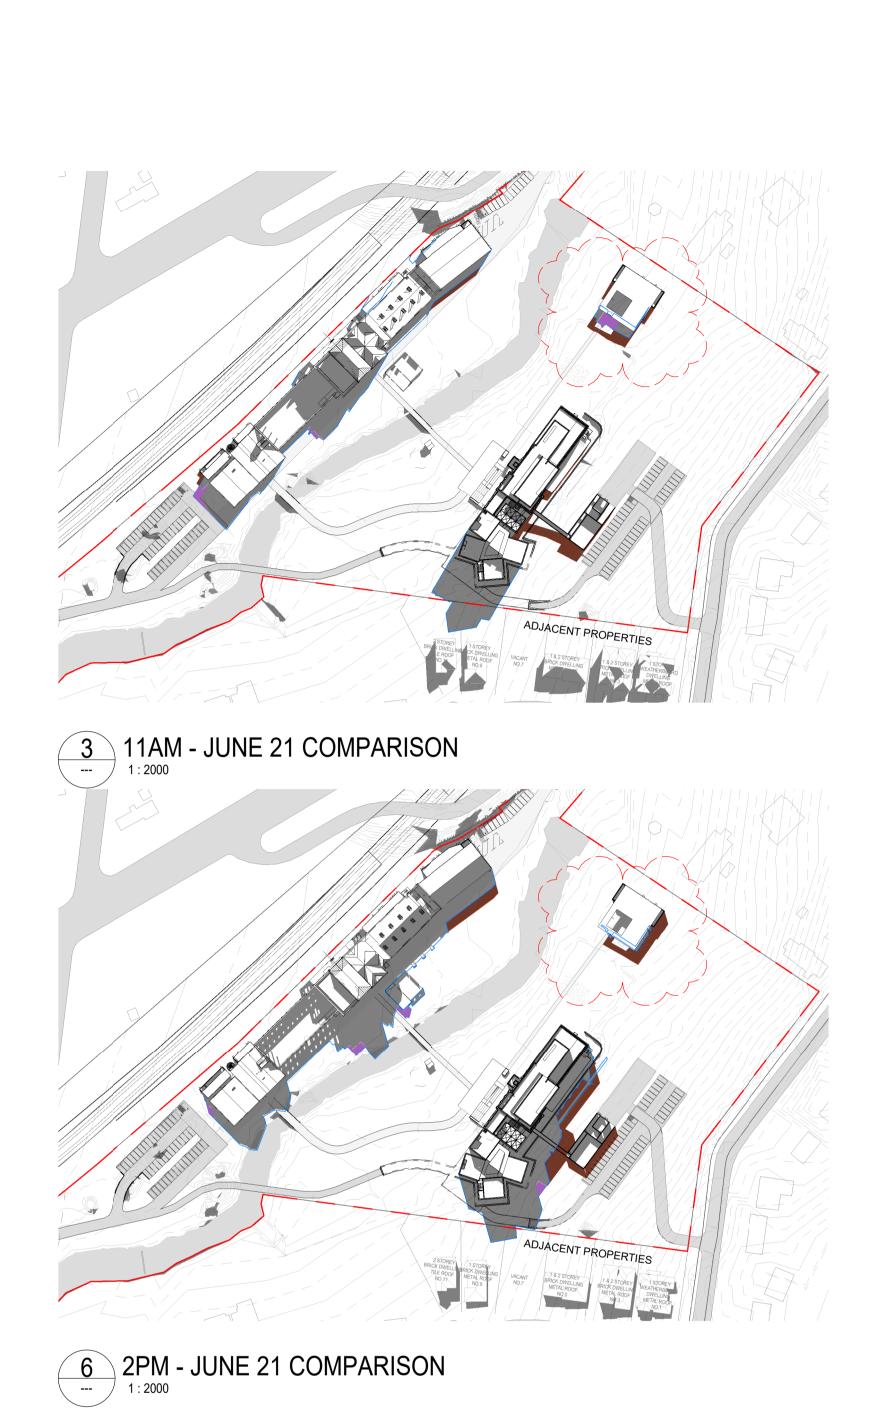


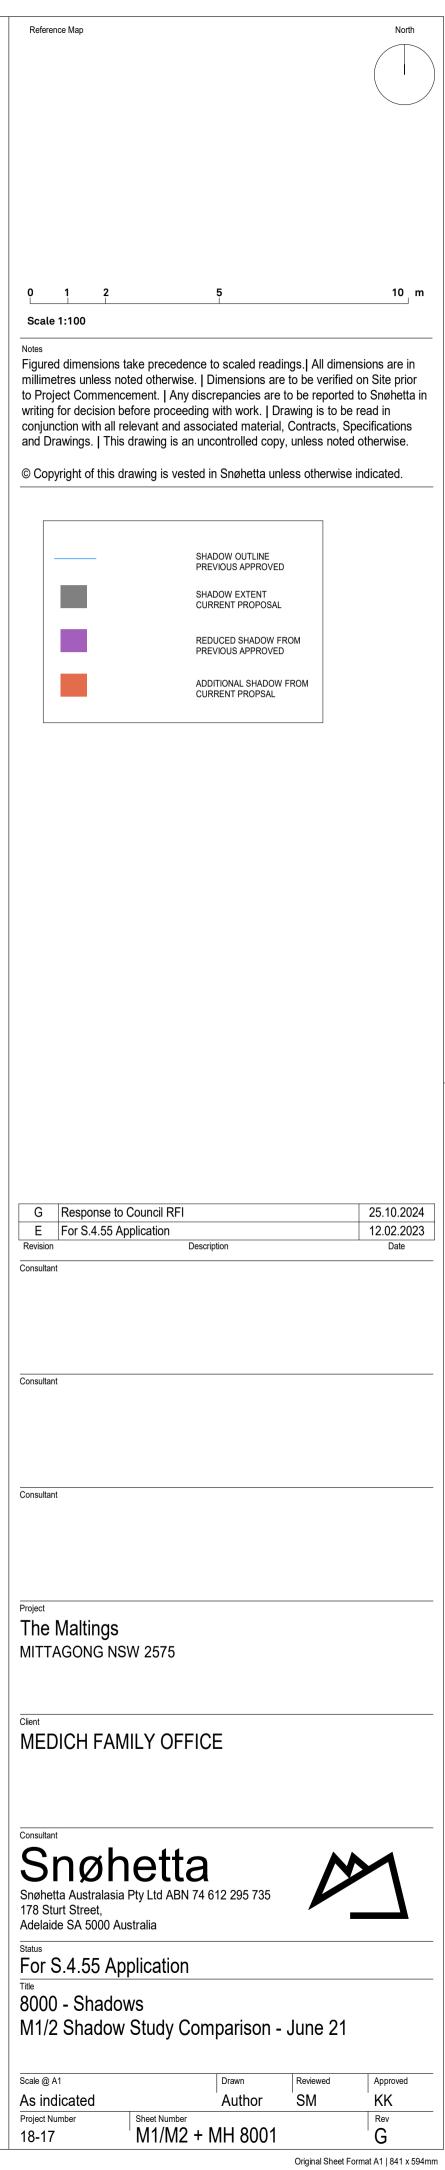

## Maltster's House Demolition Plan - Ground (L00)






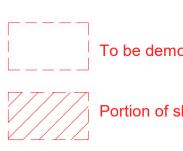


	Reference Map	
shed		
	0 1 2 5	10 m
b/roof to be demolished	Scale 1:100 Notes	
	Figured dimensions take precedence to scaled readings.] All dia millimetres unless noted otherwise.   Dimensions are to be verif to Project Commencement.   Any discrepancies are to be repor writing for decision before proceeding with work.   Drawing is to conjunction with all relevant and associated material, Contracts and Drawings.   This drawing is an uncontrolled copy, unless no	fied on Site prior rted to Snøhetta in be read in , Specifications oted otherwise.
	© Copyright of this drawing is vested in Snøhetta unless otherw	vise indicated.
	E For S.4.55 Application	
	D Final draft C For Coordination	20.12.2023 08.12.2023
	DFinal draftCFor CoordinationBFor CoordinationAFor Coordination	20.12.2023 08.12.2023 29.11.2023
	DFinal draftCFor CoordinationBFor CoordinationAFor Coordination	20.12.2023 08.12.2023 29.11.2023 31.08.2022
	D       Final draft         C       For Coordination         B       For Coordination         A       For Coordination         Revision       Description	20.12.2023 08.12.2023 29.11.2023 31.08.2022




2/2024 5:18:14 PM BIM 360://The Maltings/MLTGS SNØ AR MOD MALTS1

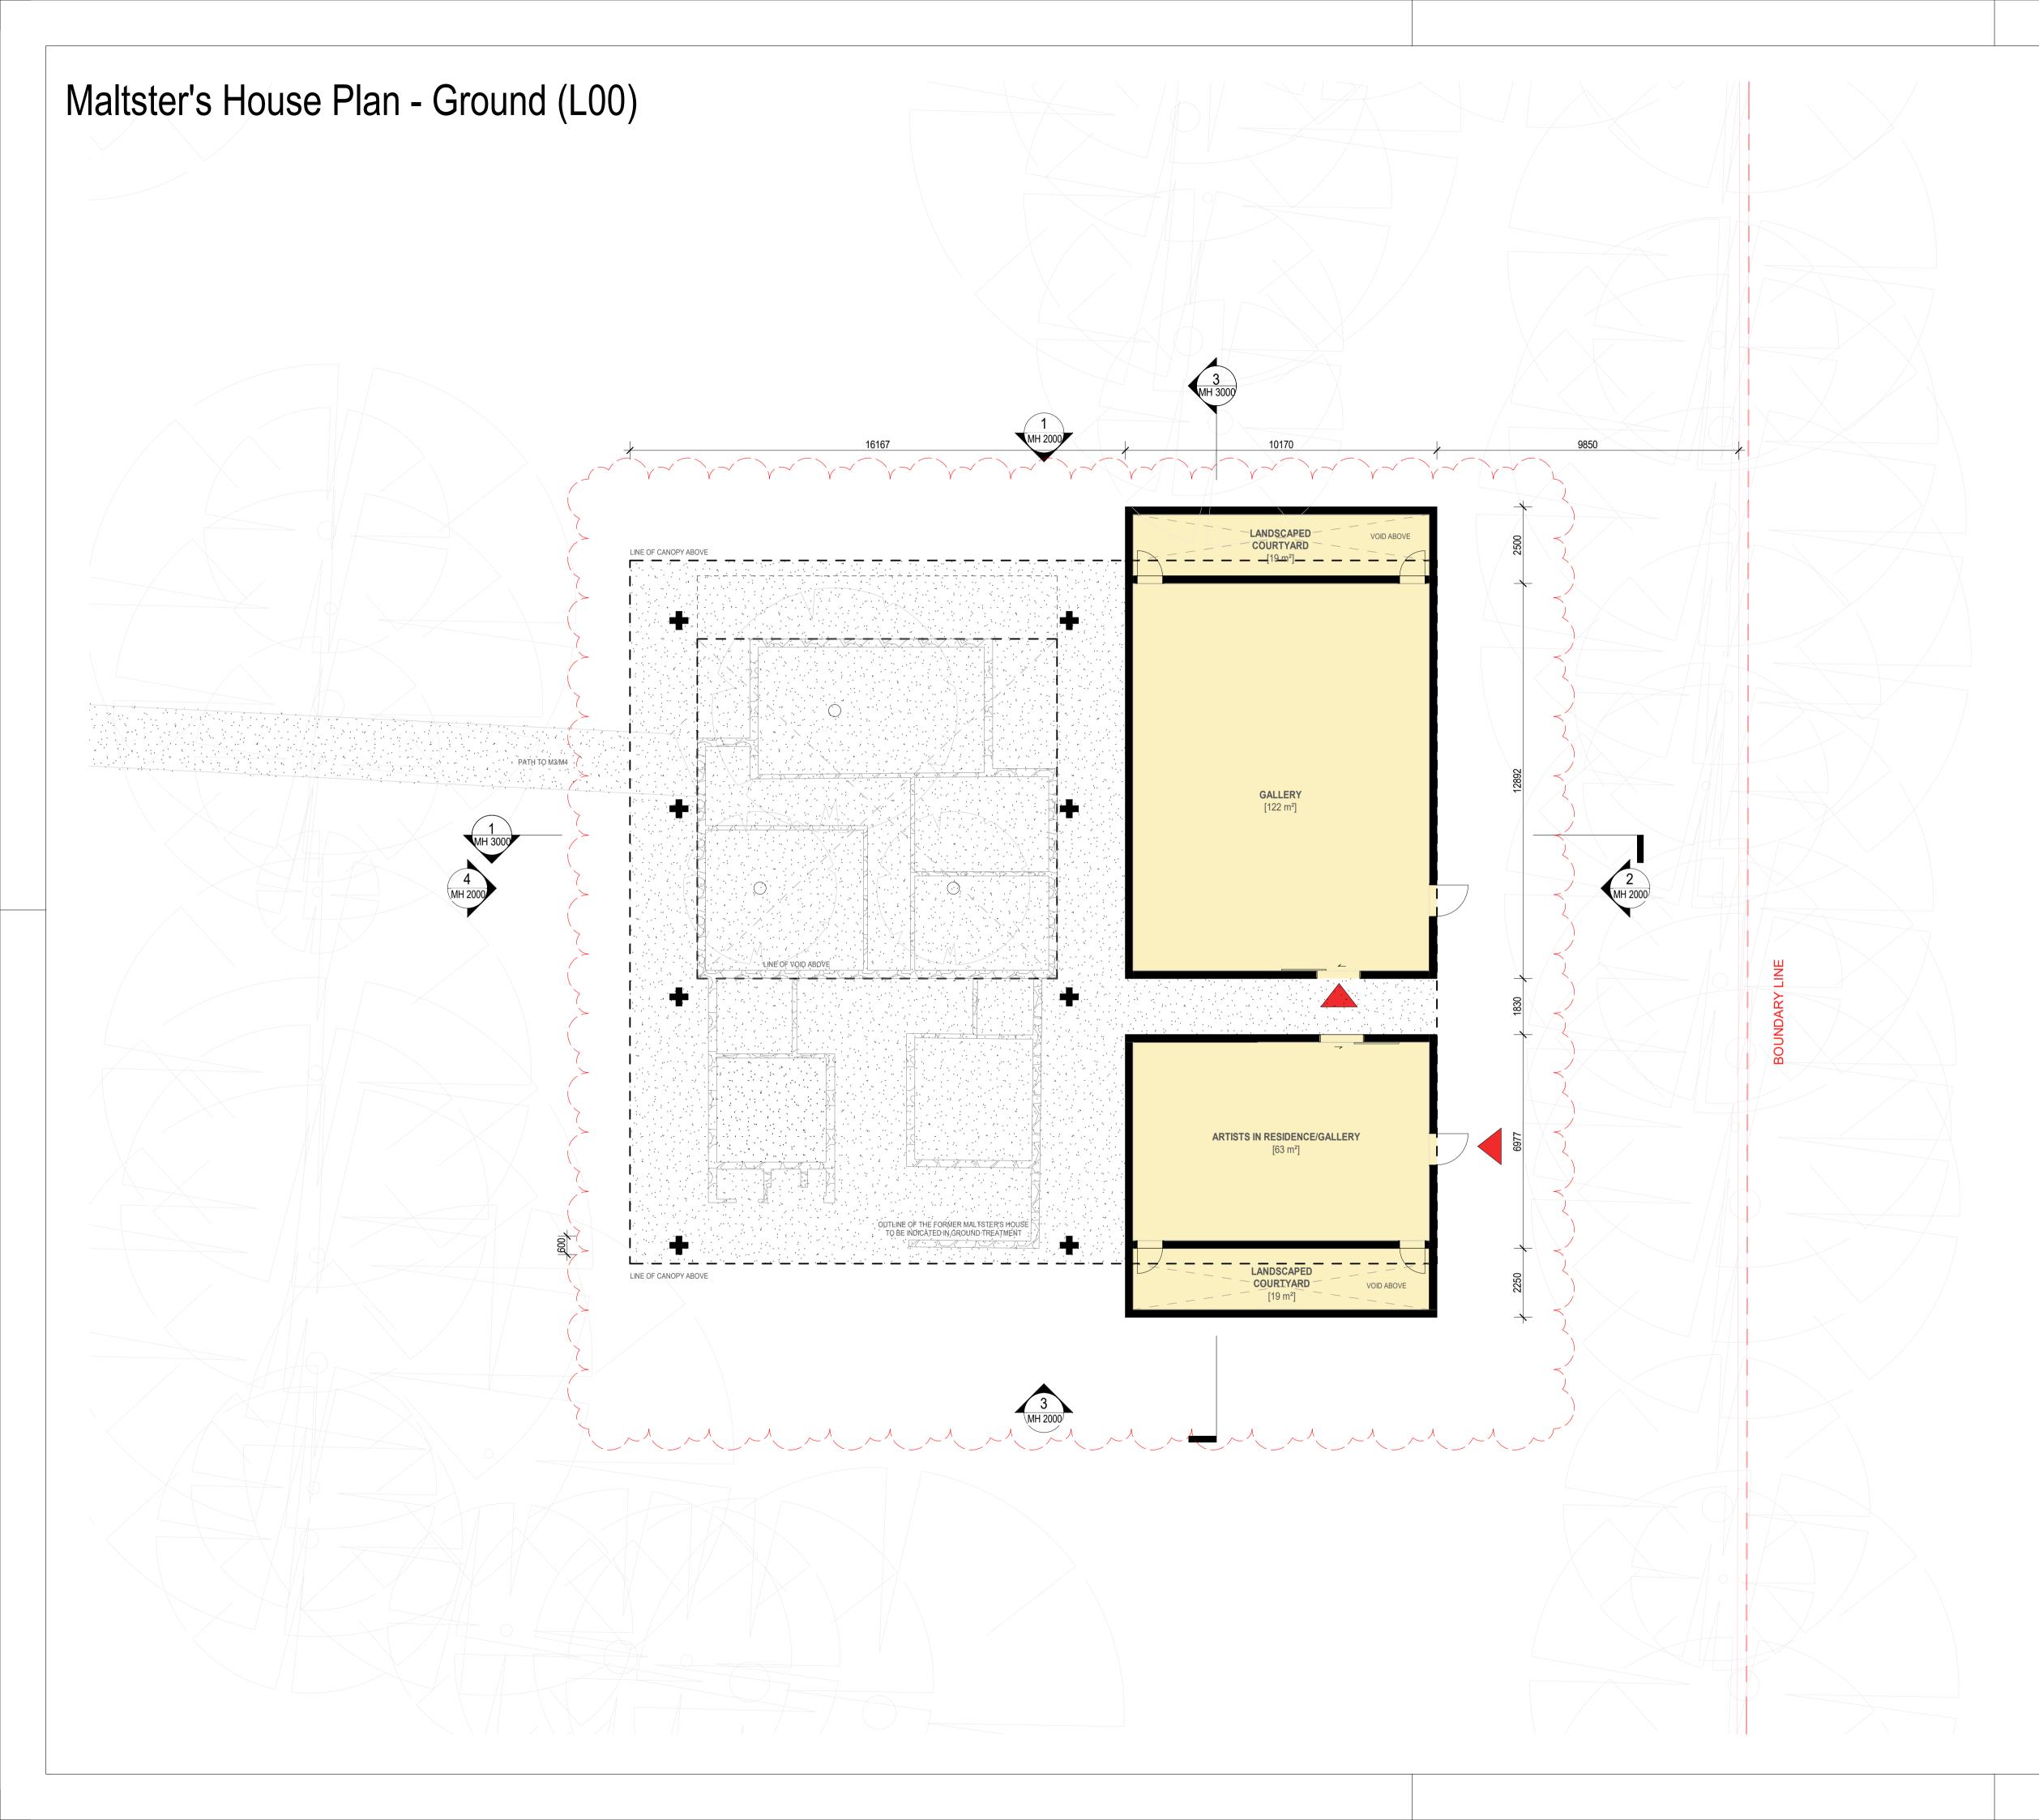


Reference	е Мар					North
0 Scale 1	1 2 :100		5	5		10 m
millimetr to Projec writing fo conjunct and Drav	es unless ct Commer or decision cion with all wings.   Th	noted otherv ncement.   A before proc relevant and is drawing is	wise.   Dir any discre eeding w d associa s an unco	mensions an epancies are ith work.   E ated materia introlled cop	dings.] All dime re to be verified e to be reported Drawing is to be al, Contracts, S by, unless noted nless otherwise	on Site prior I to Snøhetta in read in pecifications I otherwise.
		BUILDING I	ENTRY			
		NEW BUILT	T - YELL(	OW HATCH	1	
		EXISTING -	- GREYW	/ALL		
		NEW - BLA	CKWALL	-		
(* * * - 	· · · · · · · · · · · · · · · · · · ·	SOFT LANI	DSCAPE			
DI	Final draft	Application				12.02.2024 20.12.2023
BI	For Coordiı For Coordiı For Coordiı	nation				08.12.2023 29.11.2023 31.08.2022
Revision Consultant			Descripti	on		Date
Consultant						
Consultant						
Project						
	<mark>/laltings</mark> GONG N	<b>s</b> ISW 2575				
Client MEDI	CH FA	MILY O	FFICE	:		
-						
Consultant	nøł	net	ta			
	a Australas	ia Pty Ltd Al		2 295 735	P	
Adelaide <sub>Status</sub>	SA 5000 /					
Title		pplicatio		ont El-	or Plana	
		ral Arrar buse Pla	-		or Plans .00)	
Scale @ A1				Drawn	Reviewed	Approved
1:100 Project Num		Sheet Num	ber	SNØ	SM	KK Rev
18-17		'MH 1	100			'E

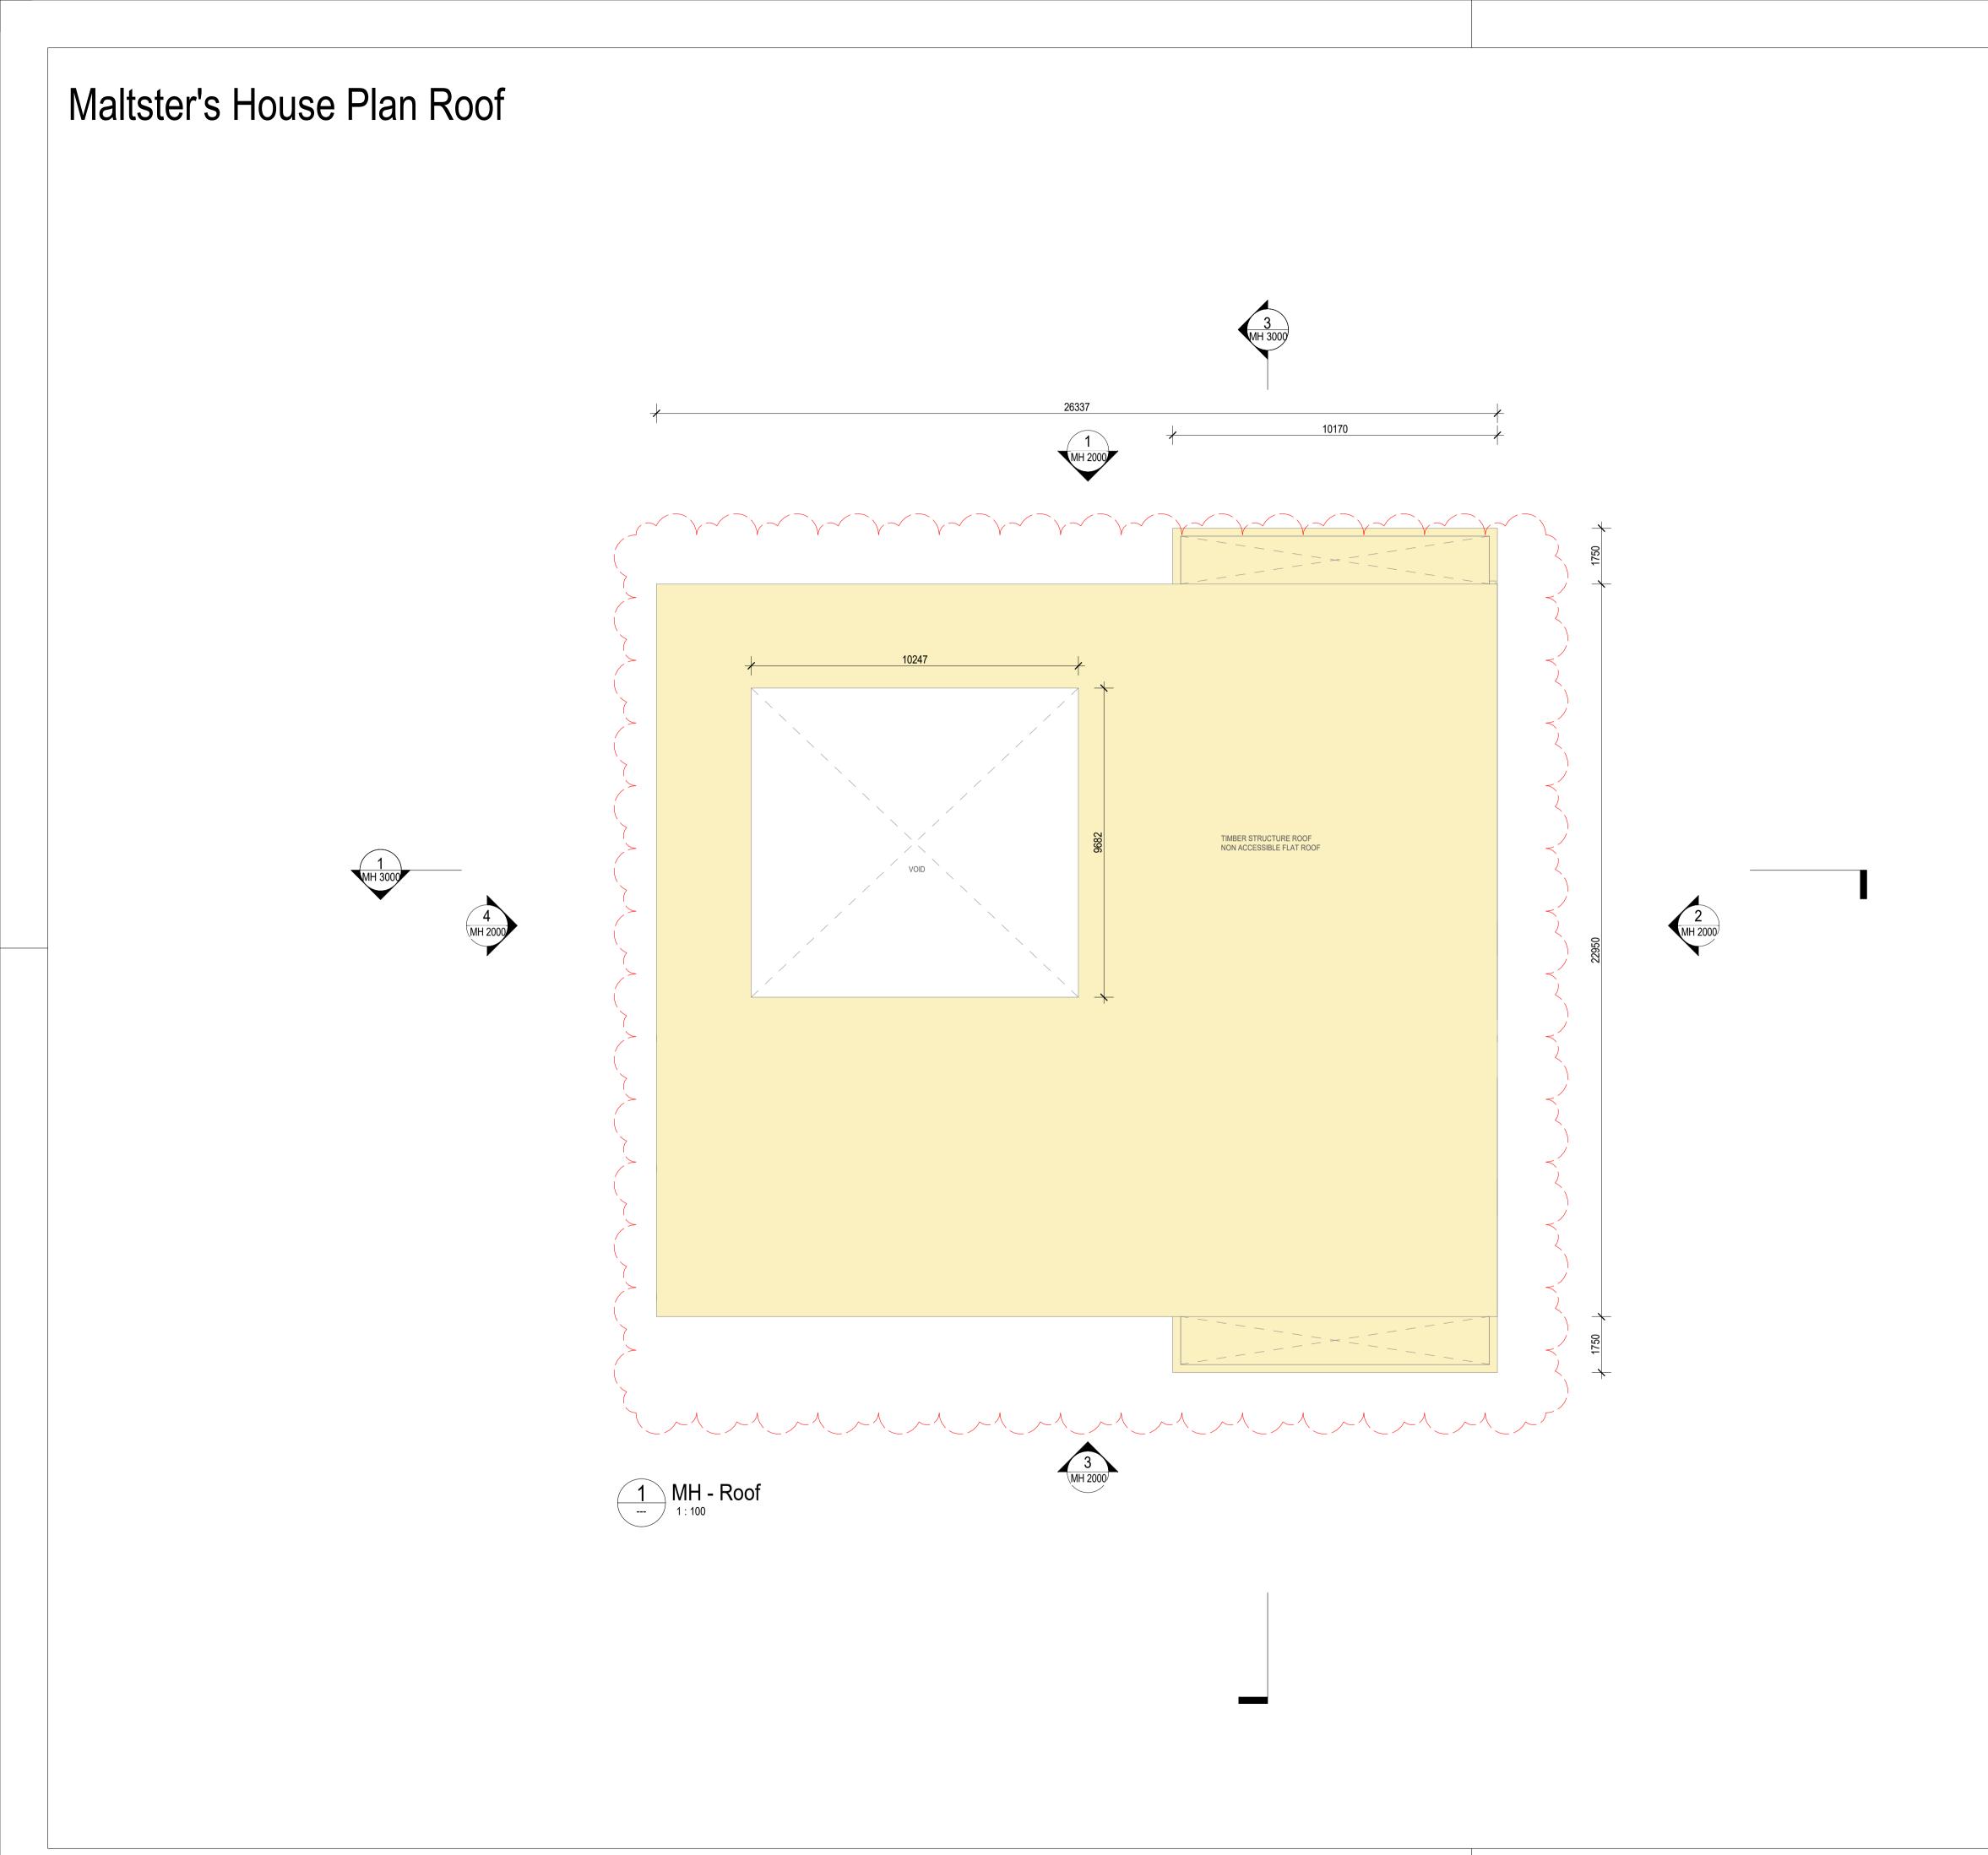




EXISTING - GREYWALL         NEW - BLACKWALL         SOFT LANDSCAPE         E For S 4.55 Application       12.02.2         D Final draft       20.12         C For Coordination       29.12         A For Coordination       29.






Consultant Project The Maltings MITTAGONG NSW 2575 Client MEDICH FAMILY OFFICE Consultant Consultant MEDICH FAMILY OFFICE Snøbetta Australasia Pty Ltd ABN 74 612 295 735 Snøbetta Australasia Pty Ltd ABN 74 612 295 735 Snøb		
Consultant Project The Maltings MITTAGONG NSW 2575 Client MEDICH FAMILY OFFICE Consultant Consultant Consultant Solution Single ta Australasia Pty Ltd ABN 74 612 295 735 178 Sturf Street, Adelaide SA 5000 Australia Status For S.4.55 Application Tite 1100 - General Arrangement - Floor Plans		
Project The Maltings MITTAGONG NSW 2575 Client MEDICH FAMILY OFFICE Consultant Consultant Consultant Snøhetta Australasia Pty Ltd ABN 74 612 295 735 178 Sturt Street, Adelaide SA 5000 Australia Status For S.4.55 Application Tite 1100 - General Arrangement - Floor Plans		
The Maltings MITTAGONG NSW 2575 Client MEDICH FAMILY OFFICE Consultant Consultant Snøhetta Australasia Pty Ltd ABN 74 612 295 735 178 Sturt Street, Adelaide SA 5000 Australia Status For S.4.55 Application Title 1100 - General Arrangement - Floor Plans		
For S.4.55 Application ™ 1100 - General Arrangement - Floor Plans		
1100 - General Arrangement - Floor Plans		
•		
	4 612 295 735	
Scale @ A1 Drawn Reviewed Approved	ement - Floor Plans	

Original	Sheet	Format A	11	841	x 594	mm

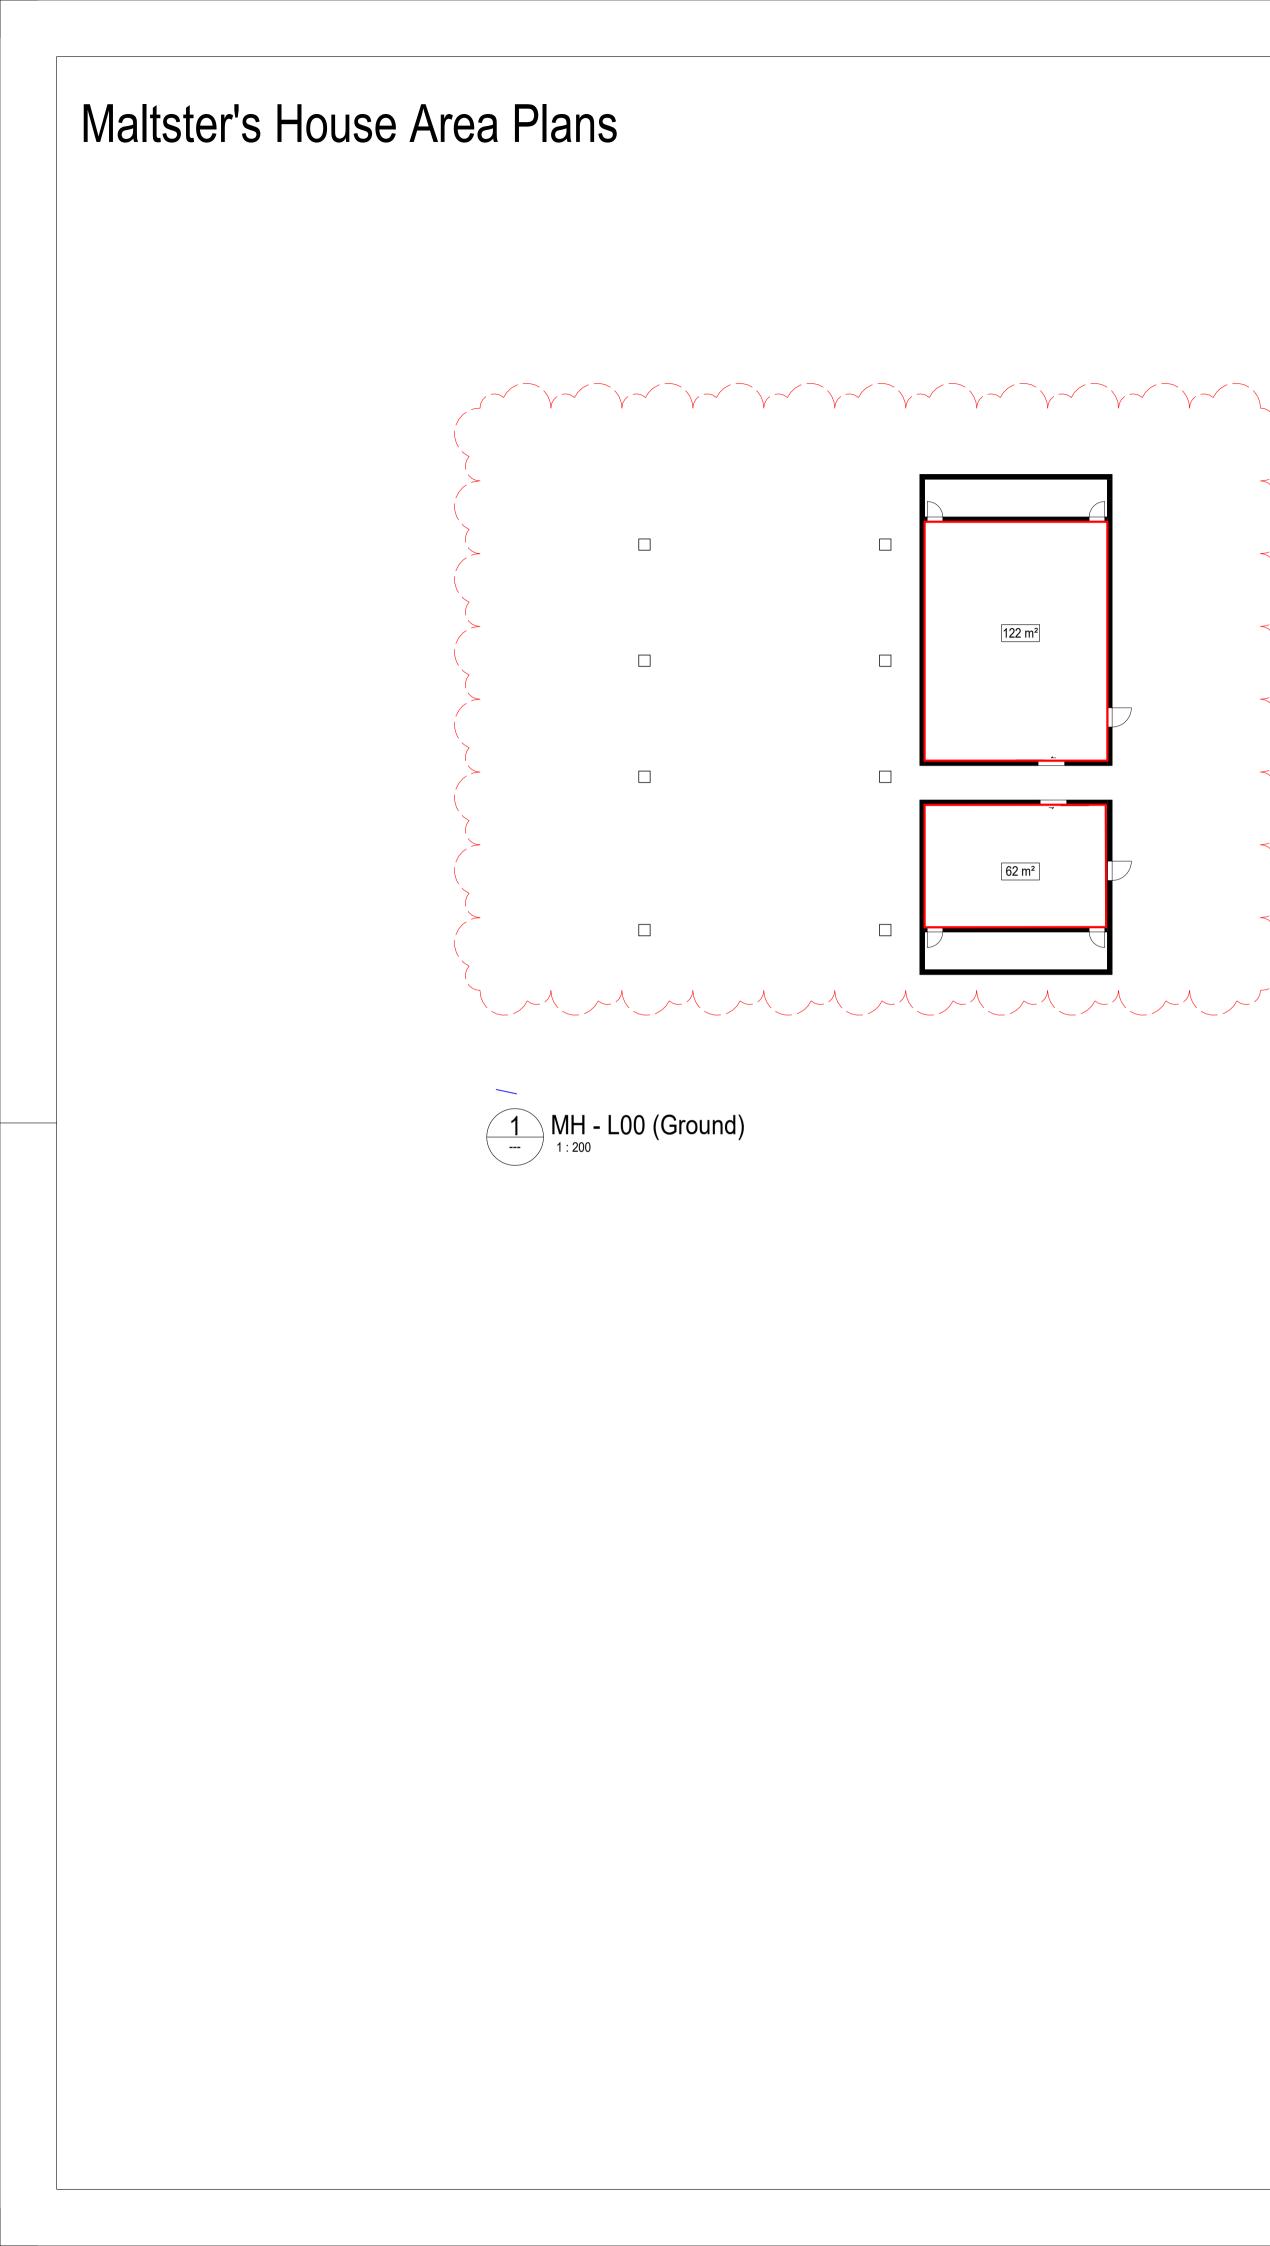


### Previous GFA


Area	Schedule (ARE	EA_GFA)
bb	Level	Area
MH Ground	A-00	189 m²
MH L01	A-01	28 m²
Grand total: 2		217 m²


	Area Schedule (AREA_0	GFA)
Name	Level	Area
VH Ground	MH - L00 (Ground)	122 m²
VH Ground	MH - L00 (Ground)	62 m²
Grand total: 2		184 m²

0 2	4	10		20 m
Scale 1:200				
	ons take preceden ss noted otherwise.			
to Project Comn writing for decisi	nencement.   Any c on before proceedi	iscrepancies ar ing with work.   [	e to be reported Drawing is to be	to Snøhetta in read in
	all relevant and as This drawing is an			
© Copyright of the	his drawing is veste	ed in Snøhetta u	nless otherwise i	ndicated.
				-
D Final dra				12.02.2024 20.12.2023
C For Coor B For Coor	rdination			08.12.2023 29.11.2023
A For Coor Revision		escription		31.08.2022 Date
Consultant				
Consultant				
Consultant				
Consultant Consultant Consultant				
Consultant				
Consultant				
Consultant Consultant Project The Malting	•			
Consultant Consultant Consultant Client MEDICH F MEDICH F Consultant Consultant Snøhetta Austral 178 Sturt Street, Adelaide SA 500 Status For S.4.55 Title 1800 - Other	AMILY OFF AMILY OFF hetta lasia Pty Ltd ABN 7 0 Australia Application er Project Re	<b>A</b> 74 612 295 735 equired Pla	ans	
Consultant Consultant Consultant The Malting MITTAGONG Client MEDICH F MEDICH F Snøhetta Austral 178 Sturt Street, Adelaide SA 500 Status For S.4.55 Title 1800 - Othe	AMILY OFF AMILY OFF hetta lasia Pty Ltd ABN 7 0 Australia Application	<b>A</b> 74 612 295 735 equired Pla	ans	Approved SM Rev E

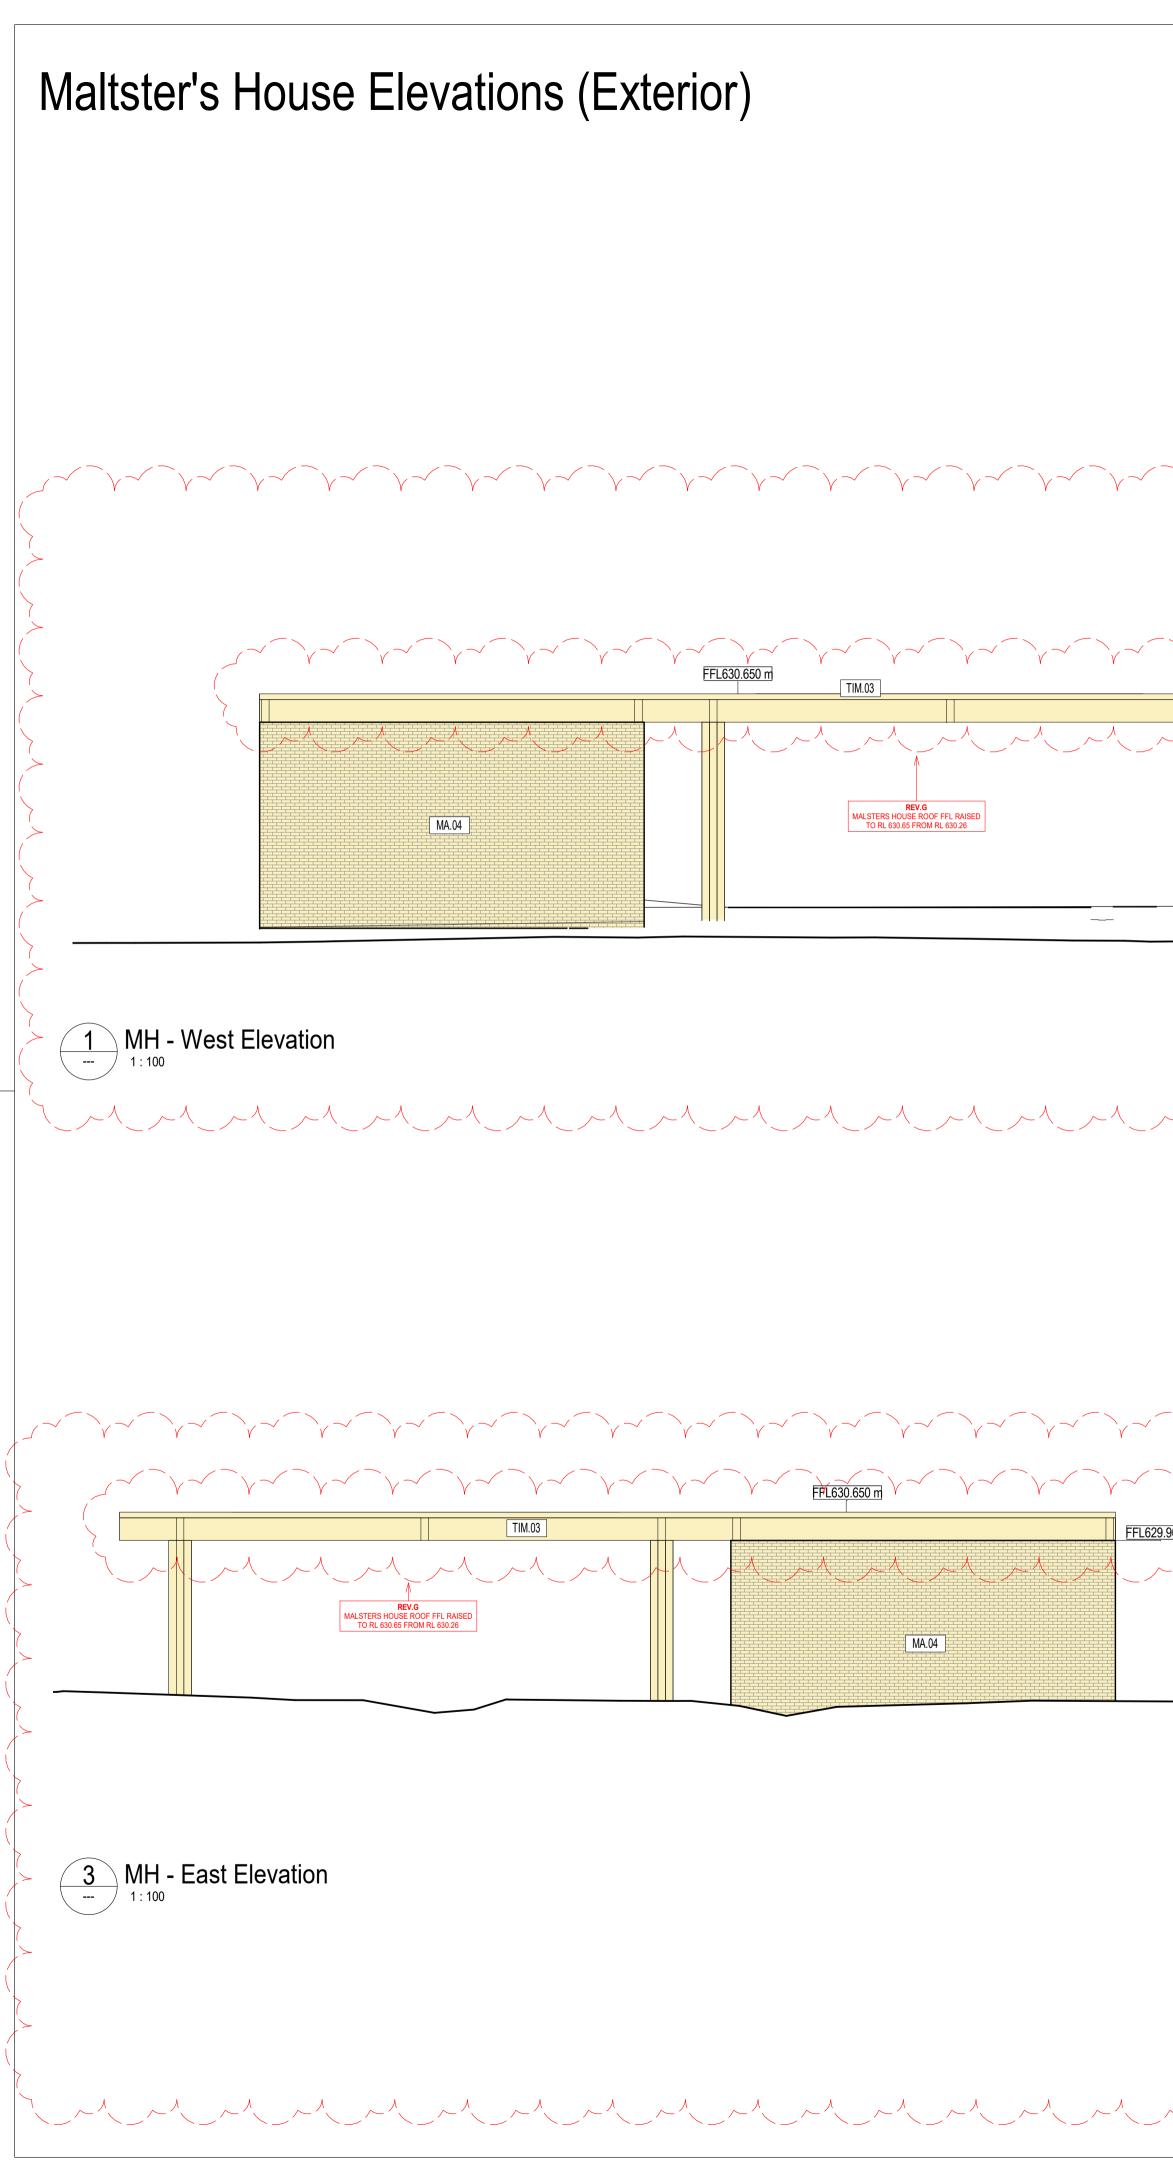

						Key Value	Keyno	te Legend Keynote Text	
						MA.02 MA.04 TIM.03	Brick (Existing and Masonry Lightweight constru	restored brick facade)	
								REV.G ALSTERS HOUSE ROOF FFL RAISED TO RL 630.65 FROM RL 630.26	
								FFL630.650	Īm
			REV.G MALSTERS HOUSE DC RAISED TO RL 625.90 FF 625.01	DORS ROM RL	LAN	DSCAPE TO BE DEVELOPED			
~^		Elevation							
			γ ~						5
		$\gamma \sim \gamma \sim \gamma$		`γ ~ `Y -	~``Y~	FFL630.650 m	`v~```v~		<
<u>, ()</u>			MA.04	TIM.03					
	I - South Eleva	ition							
		. <b></b>							

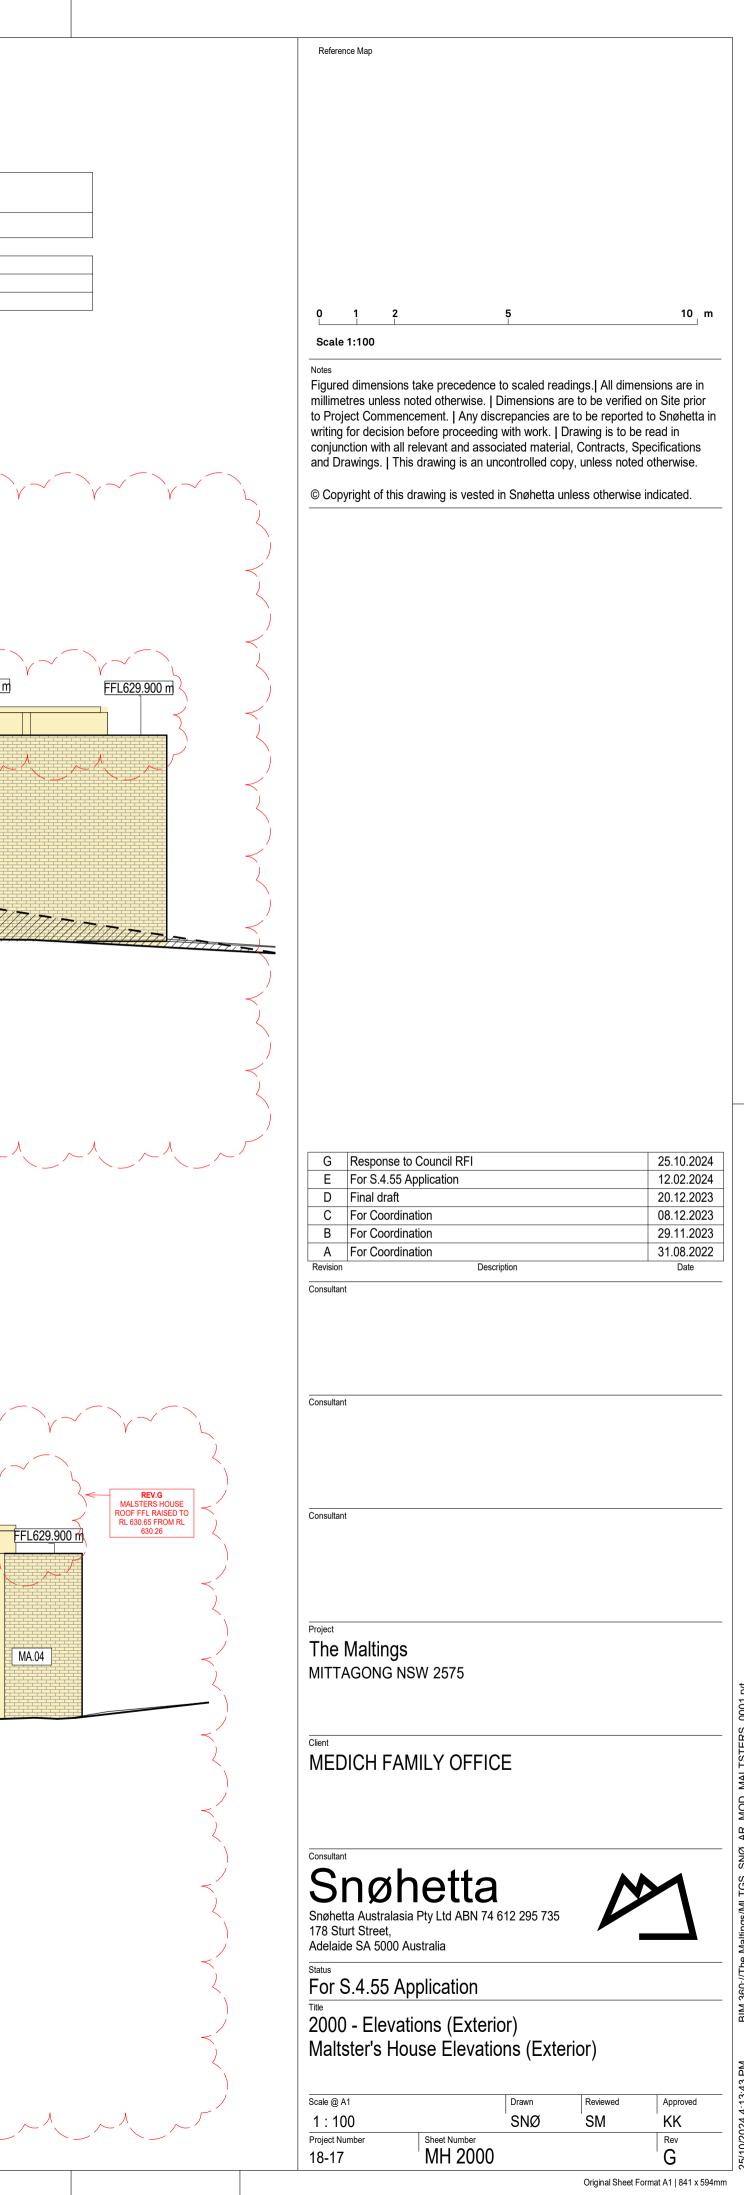

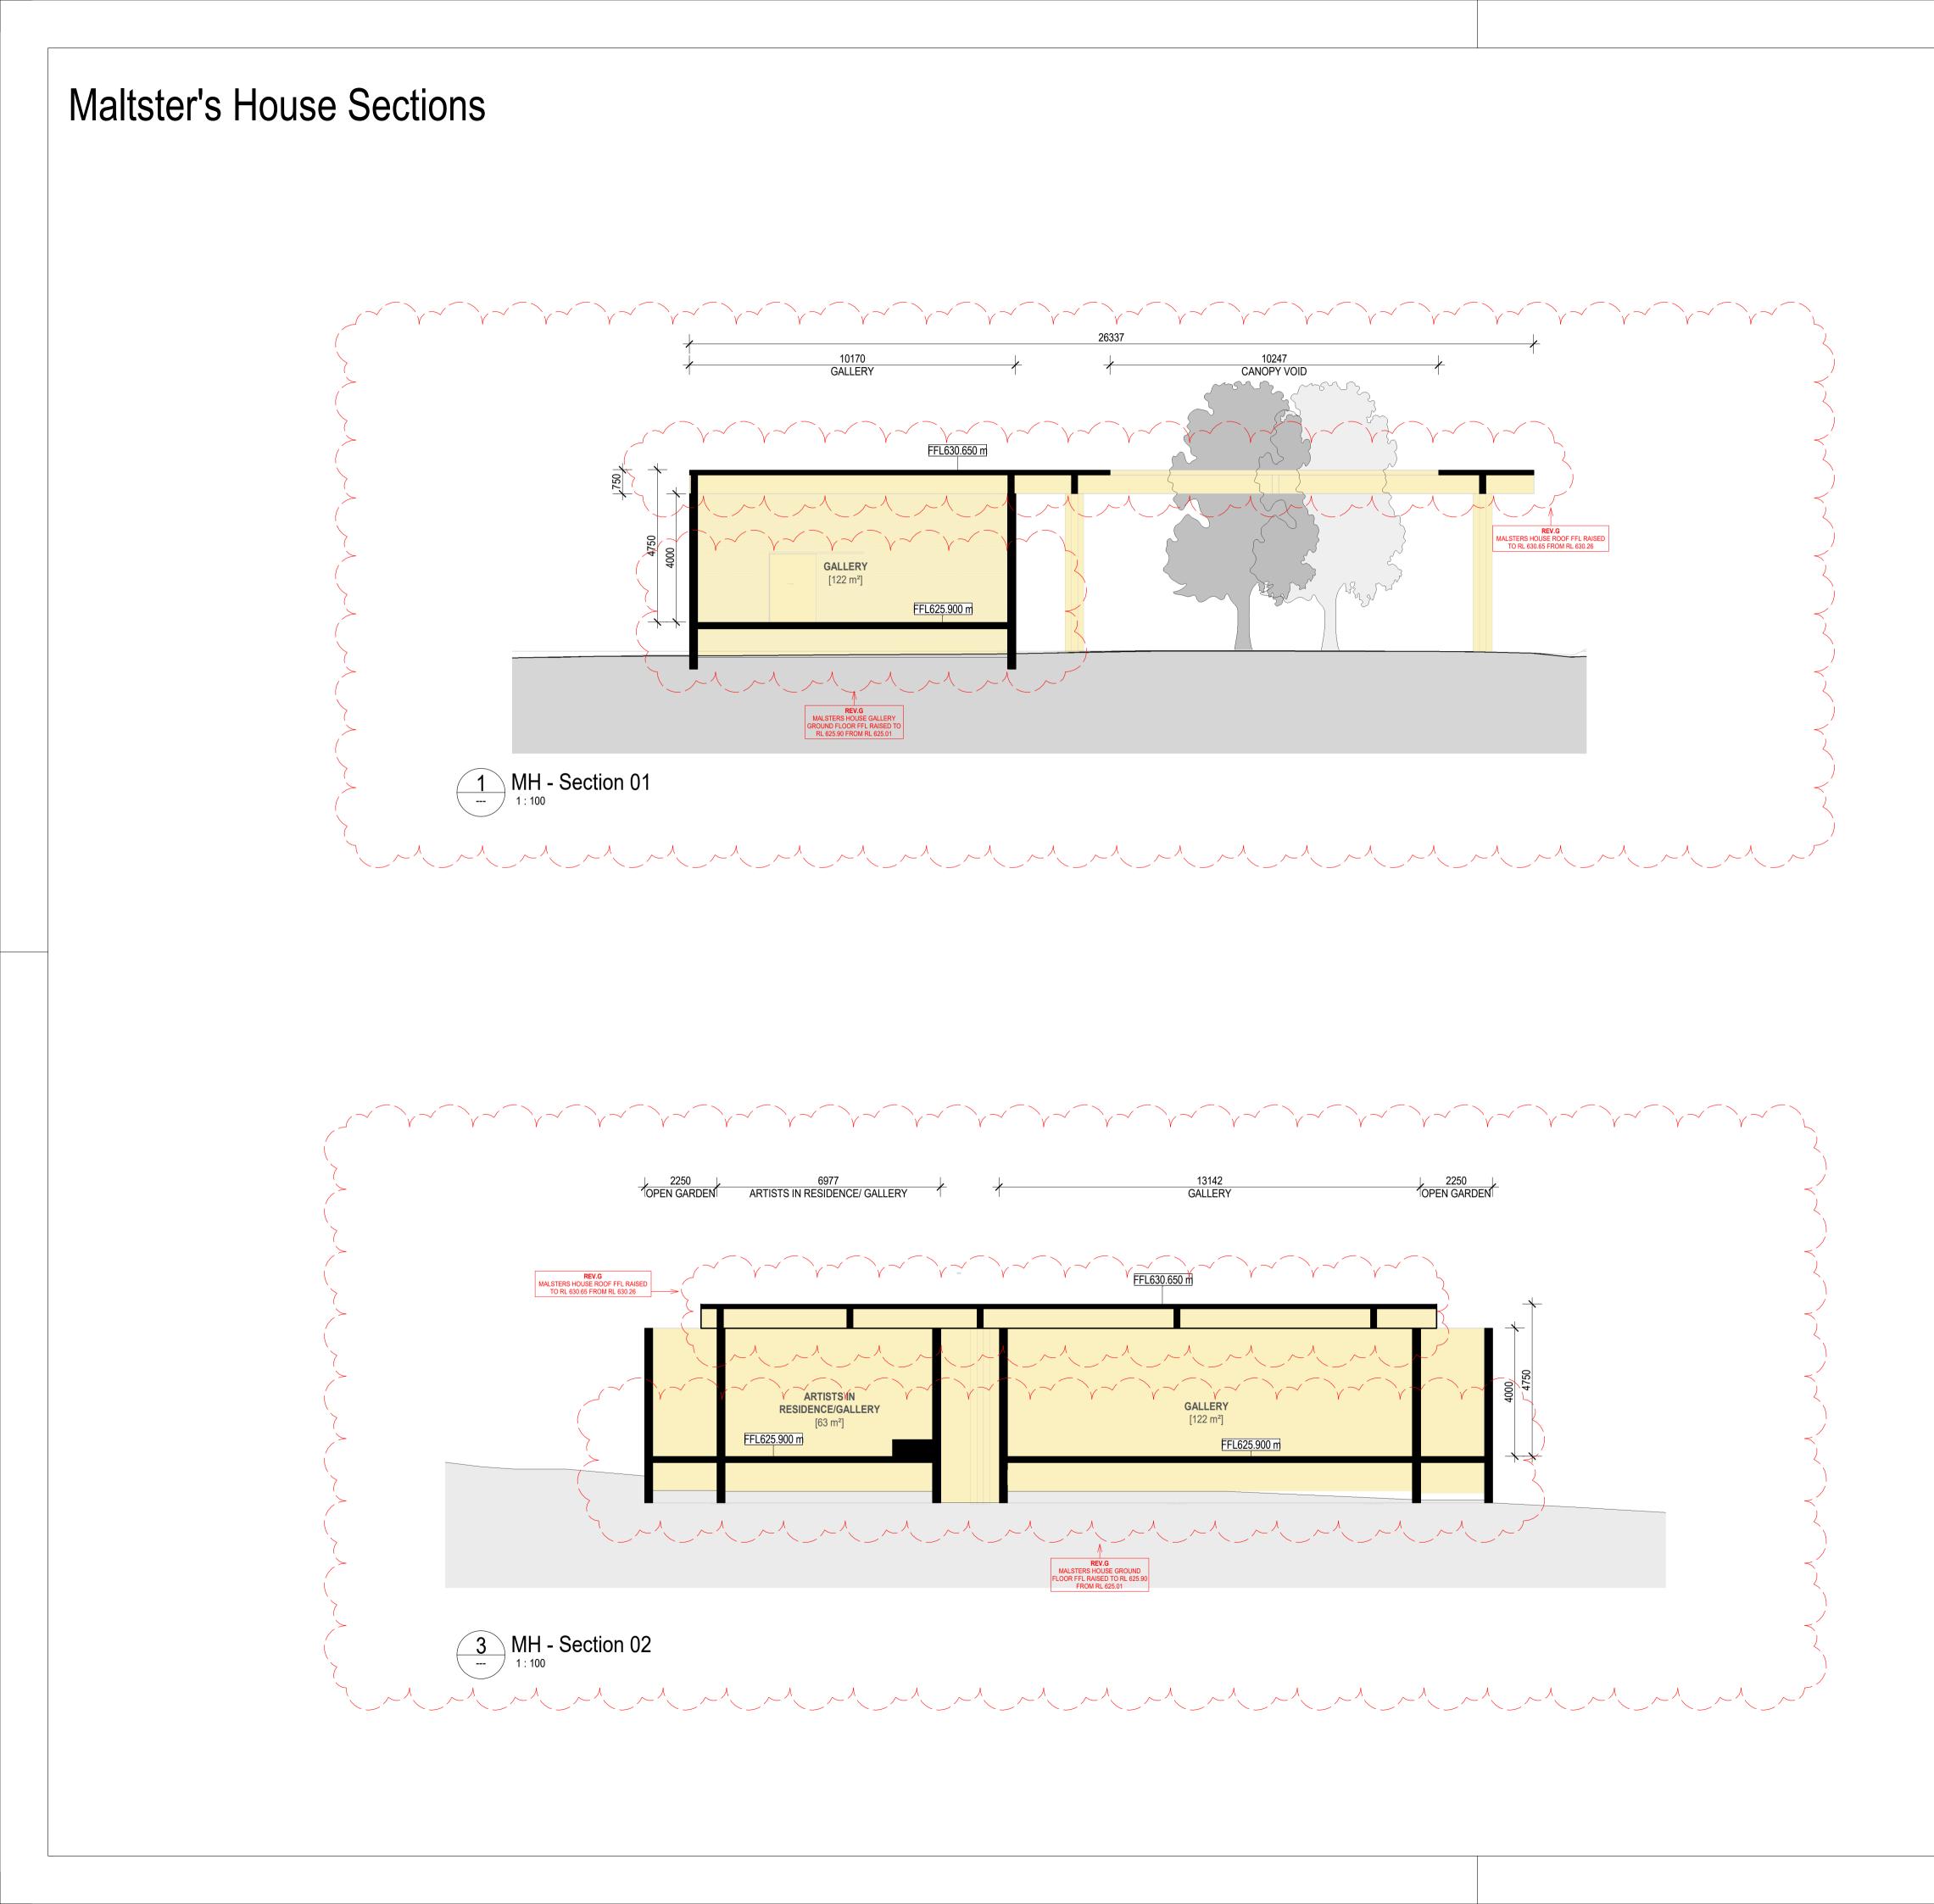

0	1	2		5			10 m
Notes	1:100						
Figure				e to scaled r   Dimensions			
to Proj	ect Com	mencemer	nt.   Any di	screpancies	are to be re	ported to	Snøhetta in
conjun	ction witl	n all releva	nt and ass	ociated mate	erial, Contra	cts, Spec	ifications
				d in Snøhetta			
	, .		•				
G		use to Cour					25.10.2024
G E D		.55 Applica					12.02.2024 20.12.2023
E D C	For S.4 Final dr For Coo	.55 Applica aft ordination					12.02.2024 20.12.2023 08.12.2023
E D C B A	For S.4 Final dr For Coo For Coo For Coo	.55 Applica aft	ition	scription			12.02.2024 20.12.2023 08.12.2023 29.11.2023 31.08.2022

