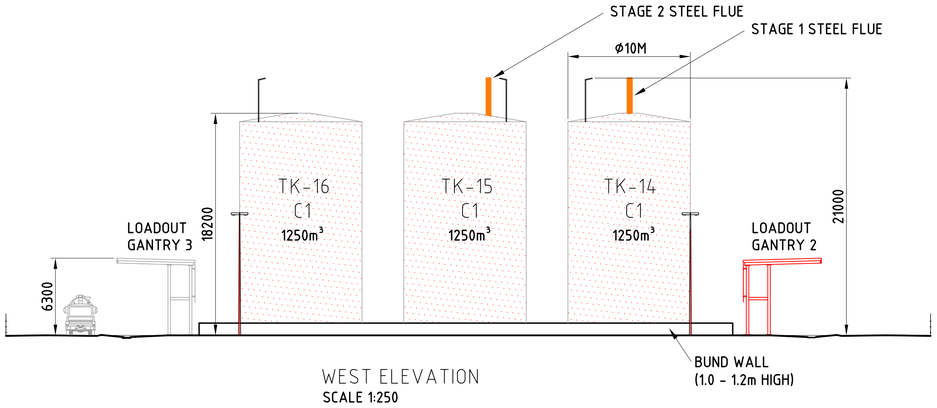


WEST ELEVATION
SCALE 1:250


STAGE 1 TANKS

STAGE 1 LOADOUTS

STAGE 2 TANKS

STAGE 2 LOADOUTS

CONSTRUCTION ITEM	ITEM USE	ABCB CLASS
PILING	TANK SUPPORT	10(b)
INTERNAL ROADS	SITE ACCESS	10(b)
LOADOUT GANTRIES	STRUCTURAL SUPPORT & PROTECTION OF PIPING & EQPT.	10(b)
SITE HUT	STORAGE & SITE CONTROL EQUIPMENT - NOT OCCUPIED FREQUENTLY OR FOR LONG PERIODS	10(a)
BOILER HOUSE	WEATHER PROTECTION OF BOILER & ASSOC. EQUIPMENT - NOT OCCUPIED FREQUENTLY OR FOR LONG PERIODS	10(a)
TANK BASES	TANK SUPPORT	10(b)
TANKS	STORAGE OF COMBUSTIBLE LIQUIDS	10(b)
TERMINAL PIPEWORK	TRANSFER OF COMBUSTIBLE LIQUIDS	10(b)
BERTH PIPELINE	TRANSFER OF COMBUSTIBLE LIQUIDS	10(b)
BERTH MANIFOLD	TRANSFER OF COMBUSTIBLE LIQUIDS	10(b)
BUNDS	SECONDARY CONTAINMENT OF COMBUSTIBLE LIQUIDS	10(b)
LABORATORY	TESTING OF PRODUCTS	8
FLUE GAS STACK	EXHAUST BOILER GASES	10(b)

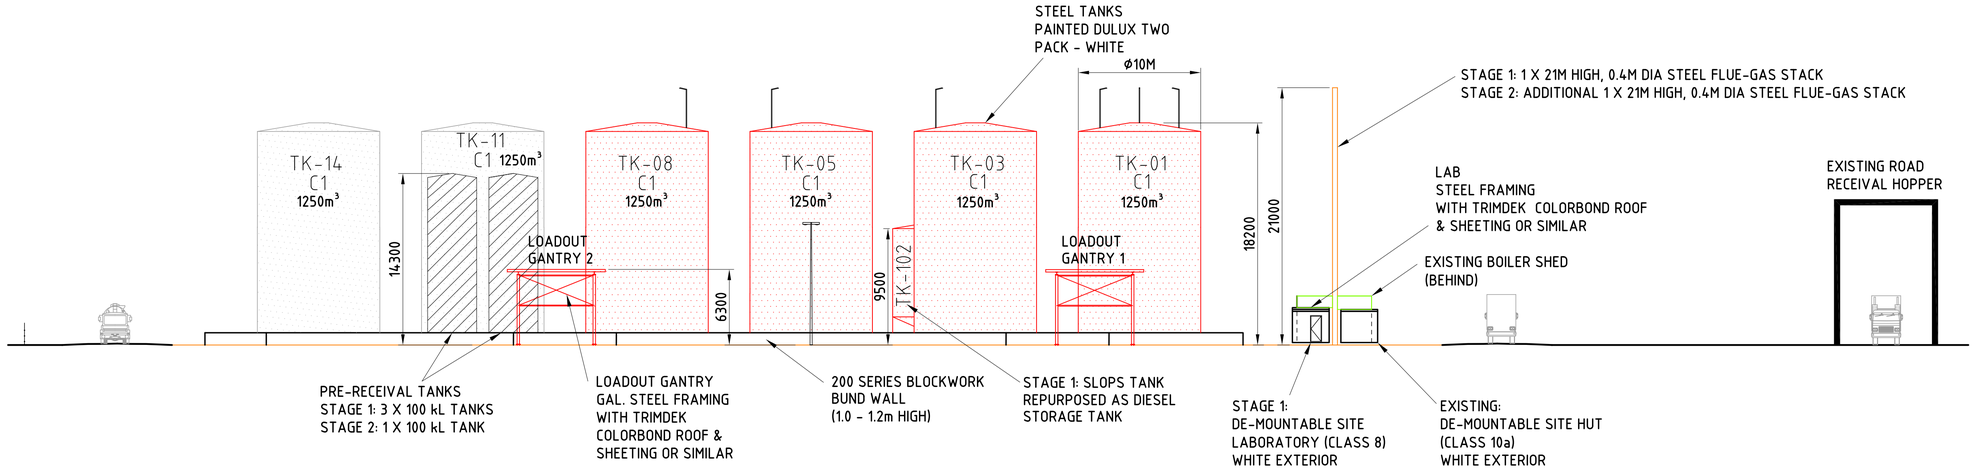

SOUTH ELEVATION
SCALE 1:250

0 2.5 5 10 15 20 25m
1:250

REV	DATE	DESCRIPTION	DRAWN	CHECKED	ENGR	APP'D	REFERENCE DRAWINGS	DWG. No.
2	18.02.14	SITE HUT MIRROR REVERSED	BWD	WA	NDH			
8	29.01.26	FOR PLANNING SUBMISSION	DL					
6	15.09.25	2 x TANKS, 2 x HUTS ADDED	PT		NDH			
5	13.07.15	AS BUILT ISSUE	TB		NDH			
4	12.05.14	PRELIMINARY ISSUE	TB		NDH			
3	12.05.14	PRELIMINARY ISSUE	TB		NDH			

CONSULTANT REF:

©Copyright 2006. All rights reserved by provider of this drawing. This drawing is subject to obligations of confidentiality, and is and shall remain the property of the provider, as set out in the Services Agreement or other terms of engagement between the provider and the recipient of this drawing. Unauthorised use of this drawing in any way is prohibited.

DOCUMENT UNCONTROLLED UNLESS STAMPED OTHERWISE
WHEN CONTROLLED - COPY ISSUED TO ALL ON DISTRIBUTION STAMP

3RD ANGLE PROJECTION U.N.O.

SCALE —1:250

GrainCorp

PROJECT
GRAINCORP LIQUID TERMINALS
PORT KEMBLA

TITLE
TANK FARM ELEVATIONS

SHEET SIZE A1 | DRAWING No. PT-PK00-99002 | REVISION 8

CAD REF: