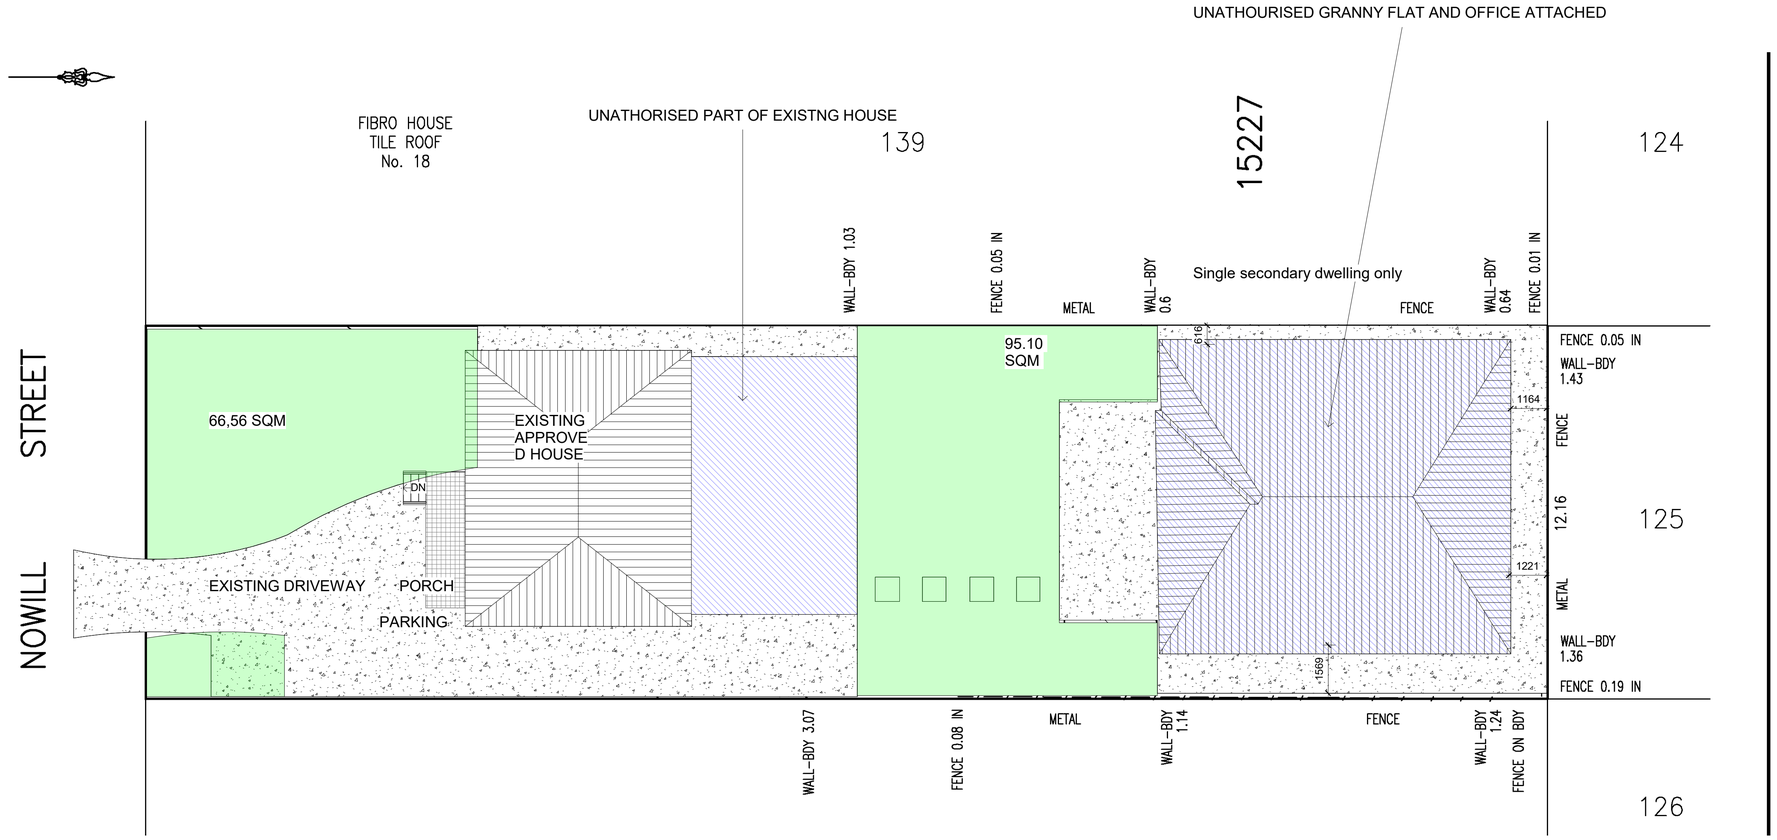


1 Site Plan
1 : 100






CONSENT AUTHORITY STAMP

REV	DATE	DESCRIPTION	BY
REV	DATE	DESCRIPTION	BY

DO NOT SCALE THESE DRAWINGS,
READ ALL DEMENSIONS SHOWN.

ALL RIGHTS RESERVED.
THESE DRAWINGS, PLANS AND SPECIFICATION AND COPYRIGHT ARE THE PROPERTY OF GREEN DESIGN SYDNEY AND MUST NOT BE USED, REPRODUCED OR COPIED WHOLLY OR IN PART WITHOUT THE WRITTEN PREMISSION OF GREEN DESIGN SYDNEY

Level 13
Building 465
Vistoria Avenue
Chatswood NSW
2067 Australia

(02) 82871288
www.GreenDesignSydney.com.au

PROPOSED WORK
Existing Site & Building Plan (As Built – Subject to Approval)

ADDRESS
16 Nowill Street Condell Park, NSW 2200

SHEET NAME
SITEPLAN

Job Number **2154**	Drawing Number SD04.1
Scale **1:100**	Page Total **8**
Drawn By **FARSHID HOSSEINI**	Checked By **A.P**
Date **20/06/2026**	Revision **B**

Sheet scale **A1**

North